


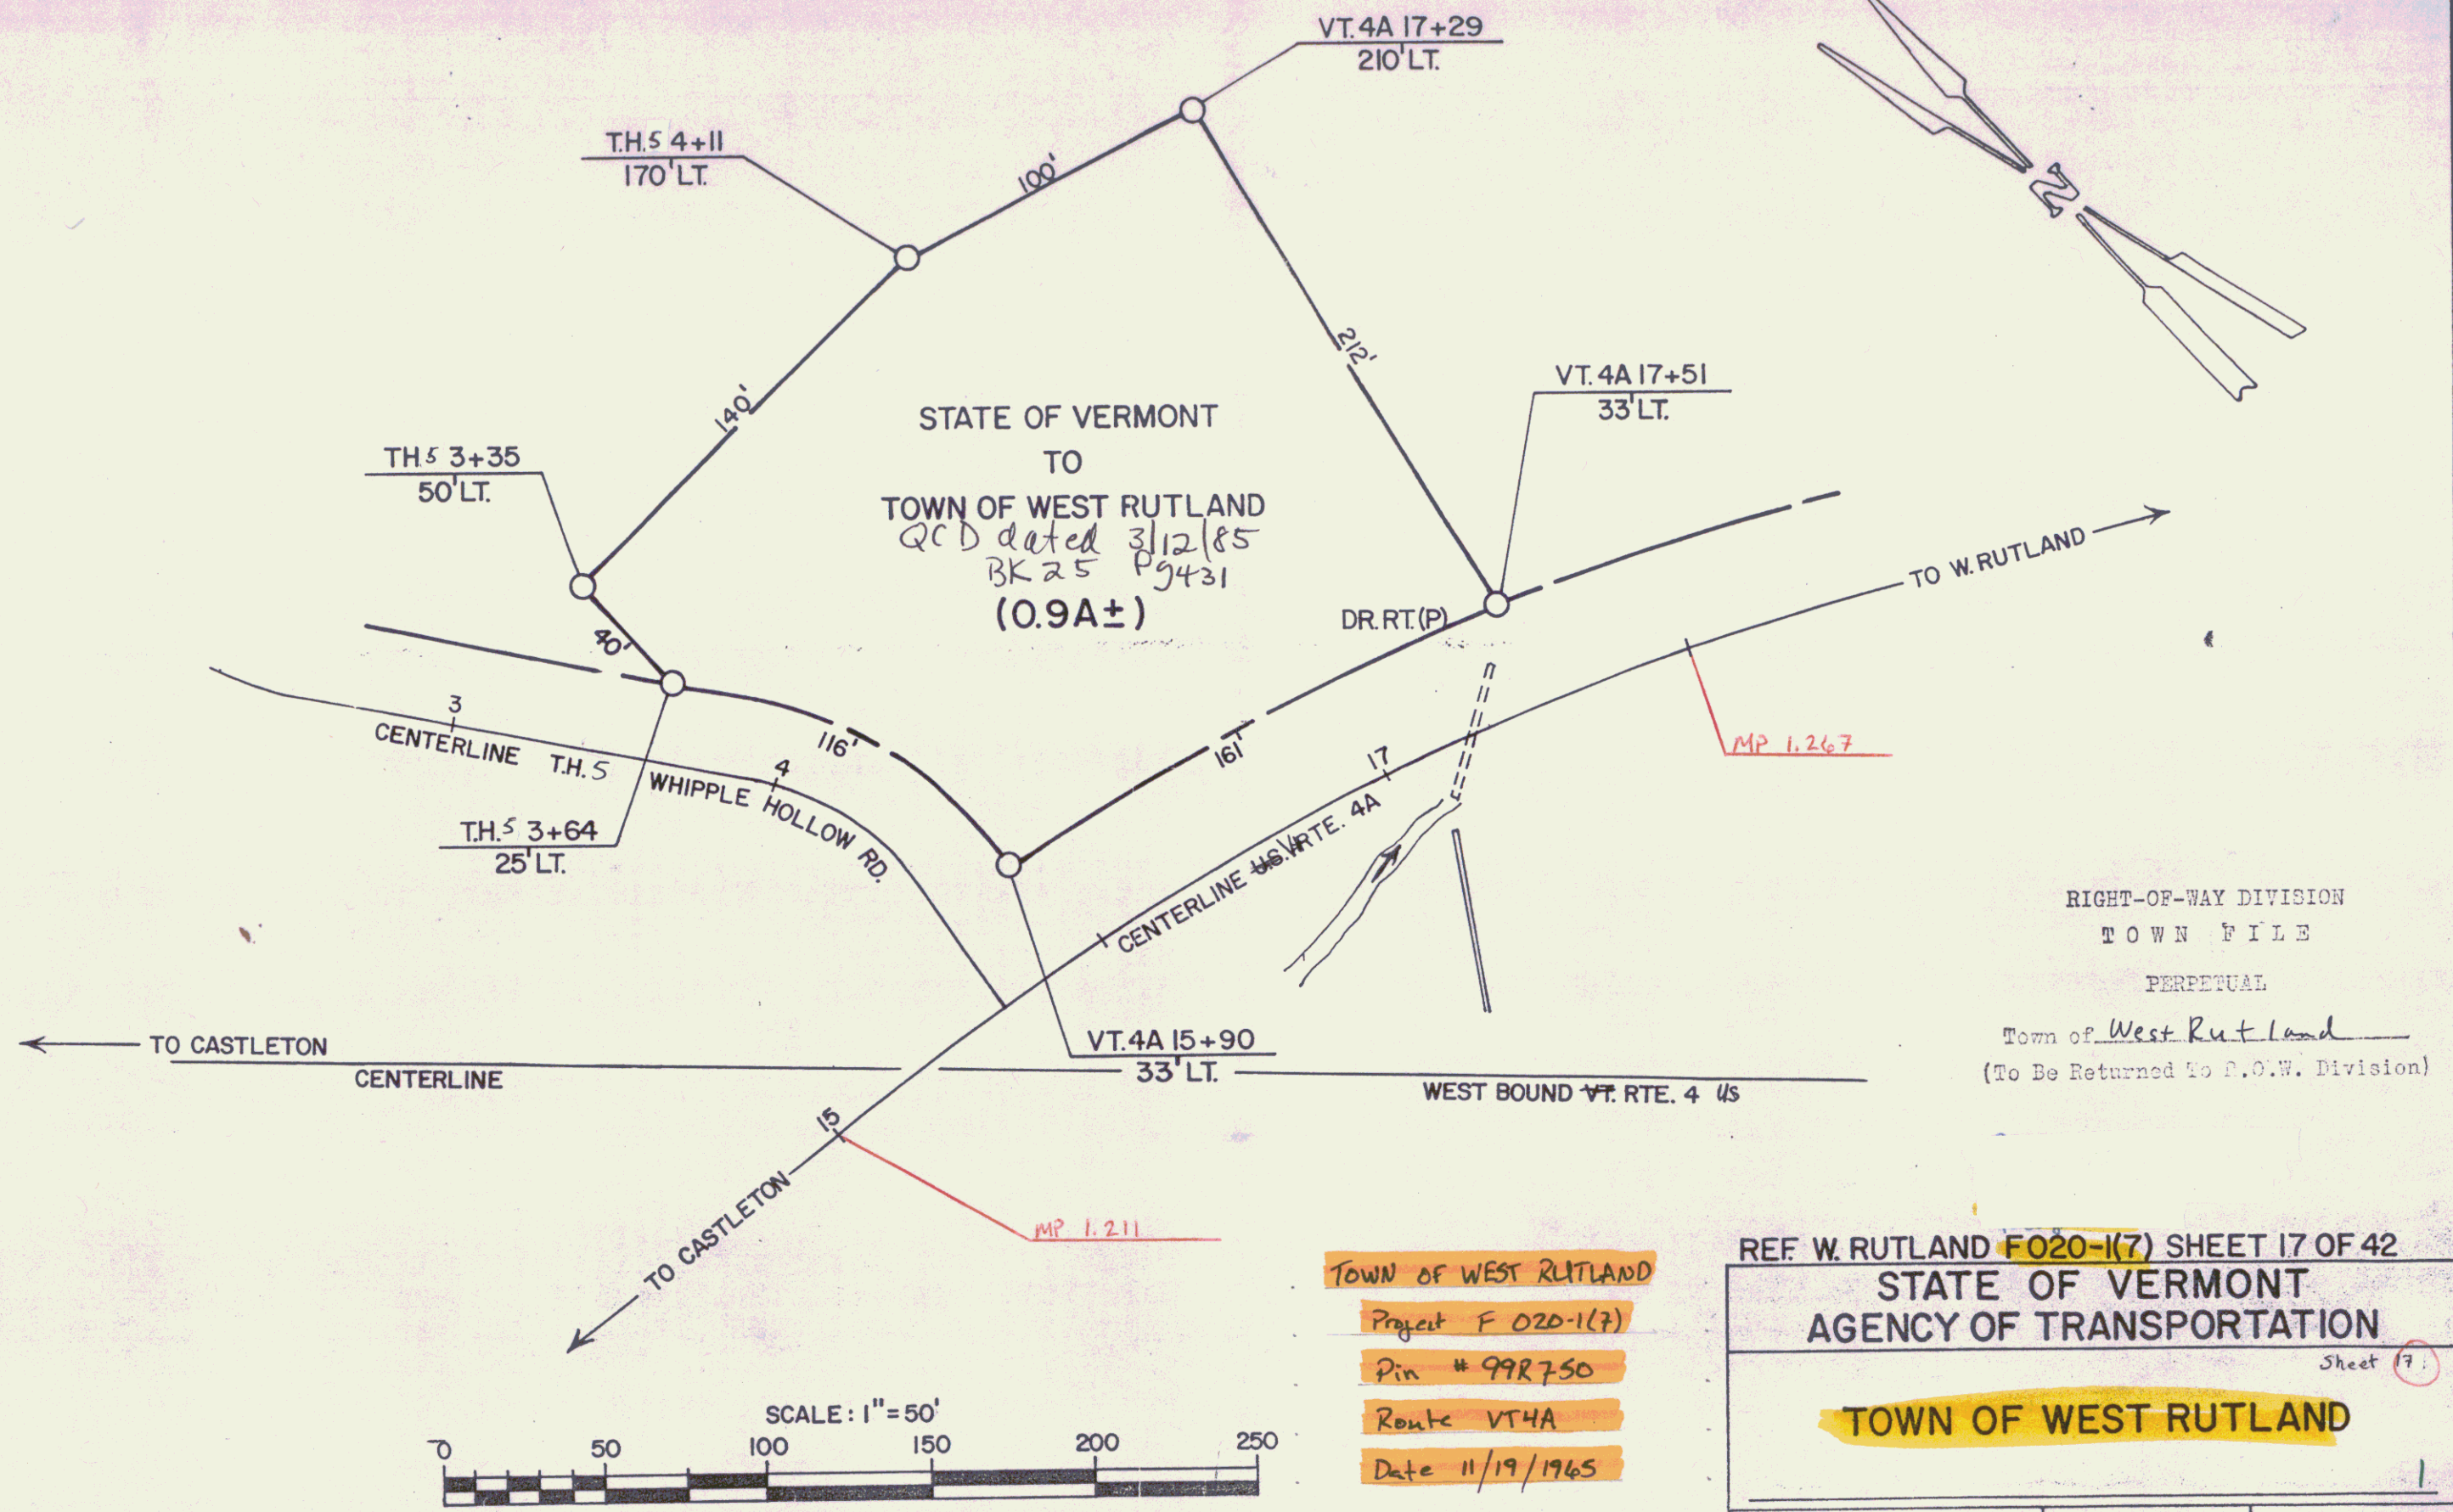


BEING PART OF THE SAME LAND AND PREMISES ACQUIRED BY W.D. FROM STEVEN GODLESKI & MARY S. GODLESKI DATED SEPT. 9, 1966 AND RECORDED IN BK. 17, PAGE 100;
AND BY W.D. FROM GENEVIEVE BURNS & IRENE BURNS, SOLE HEIRS OF THE ESTATES OF THOMAS BURNS & JOHN BURNS DATED OCT. 31, 1966 AND RECORDED IN BK. 17, PAGE 164;

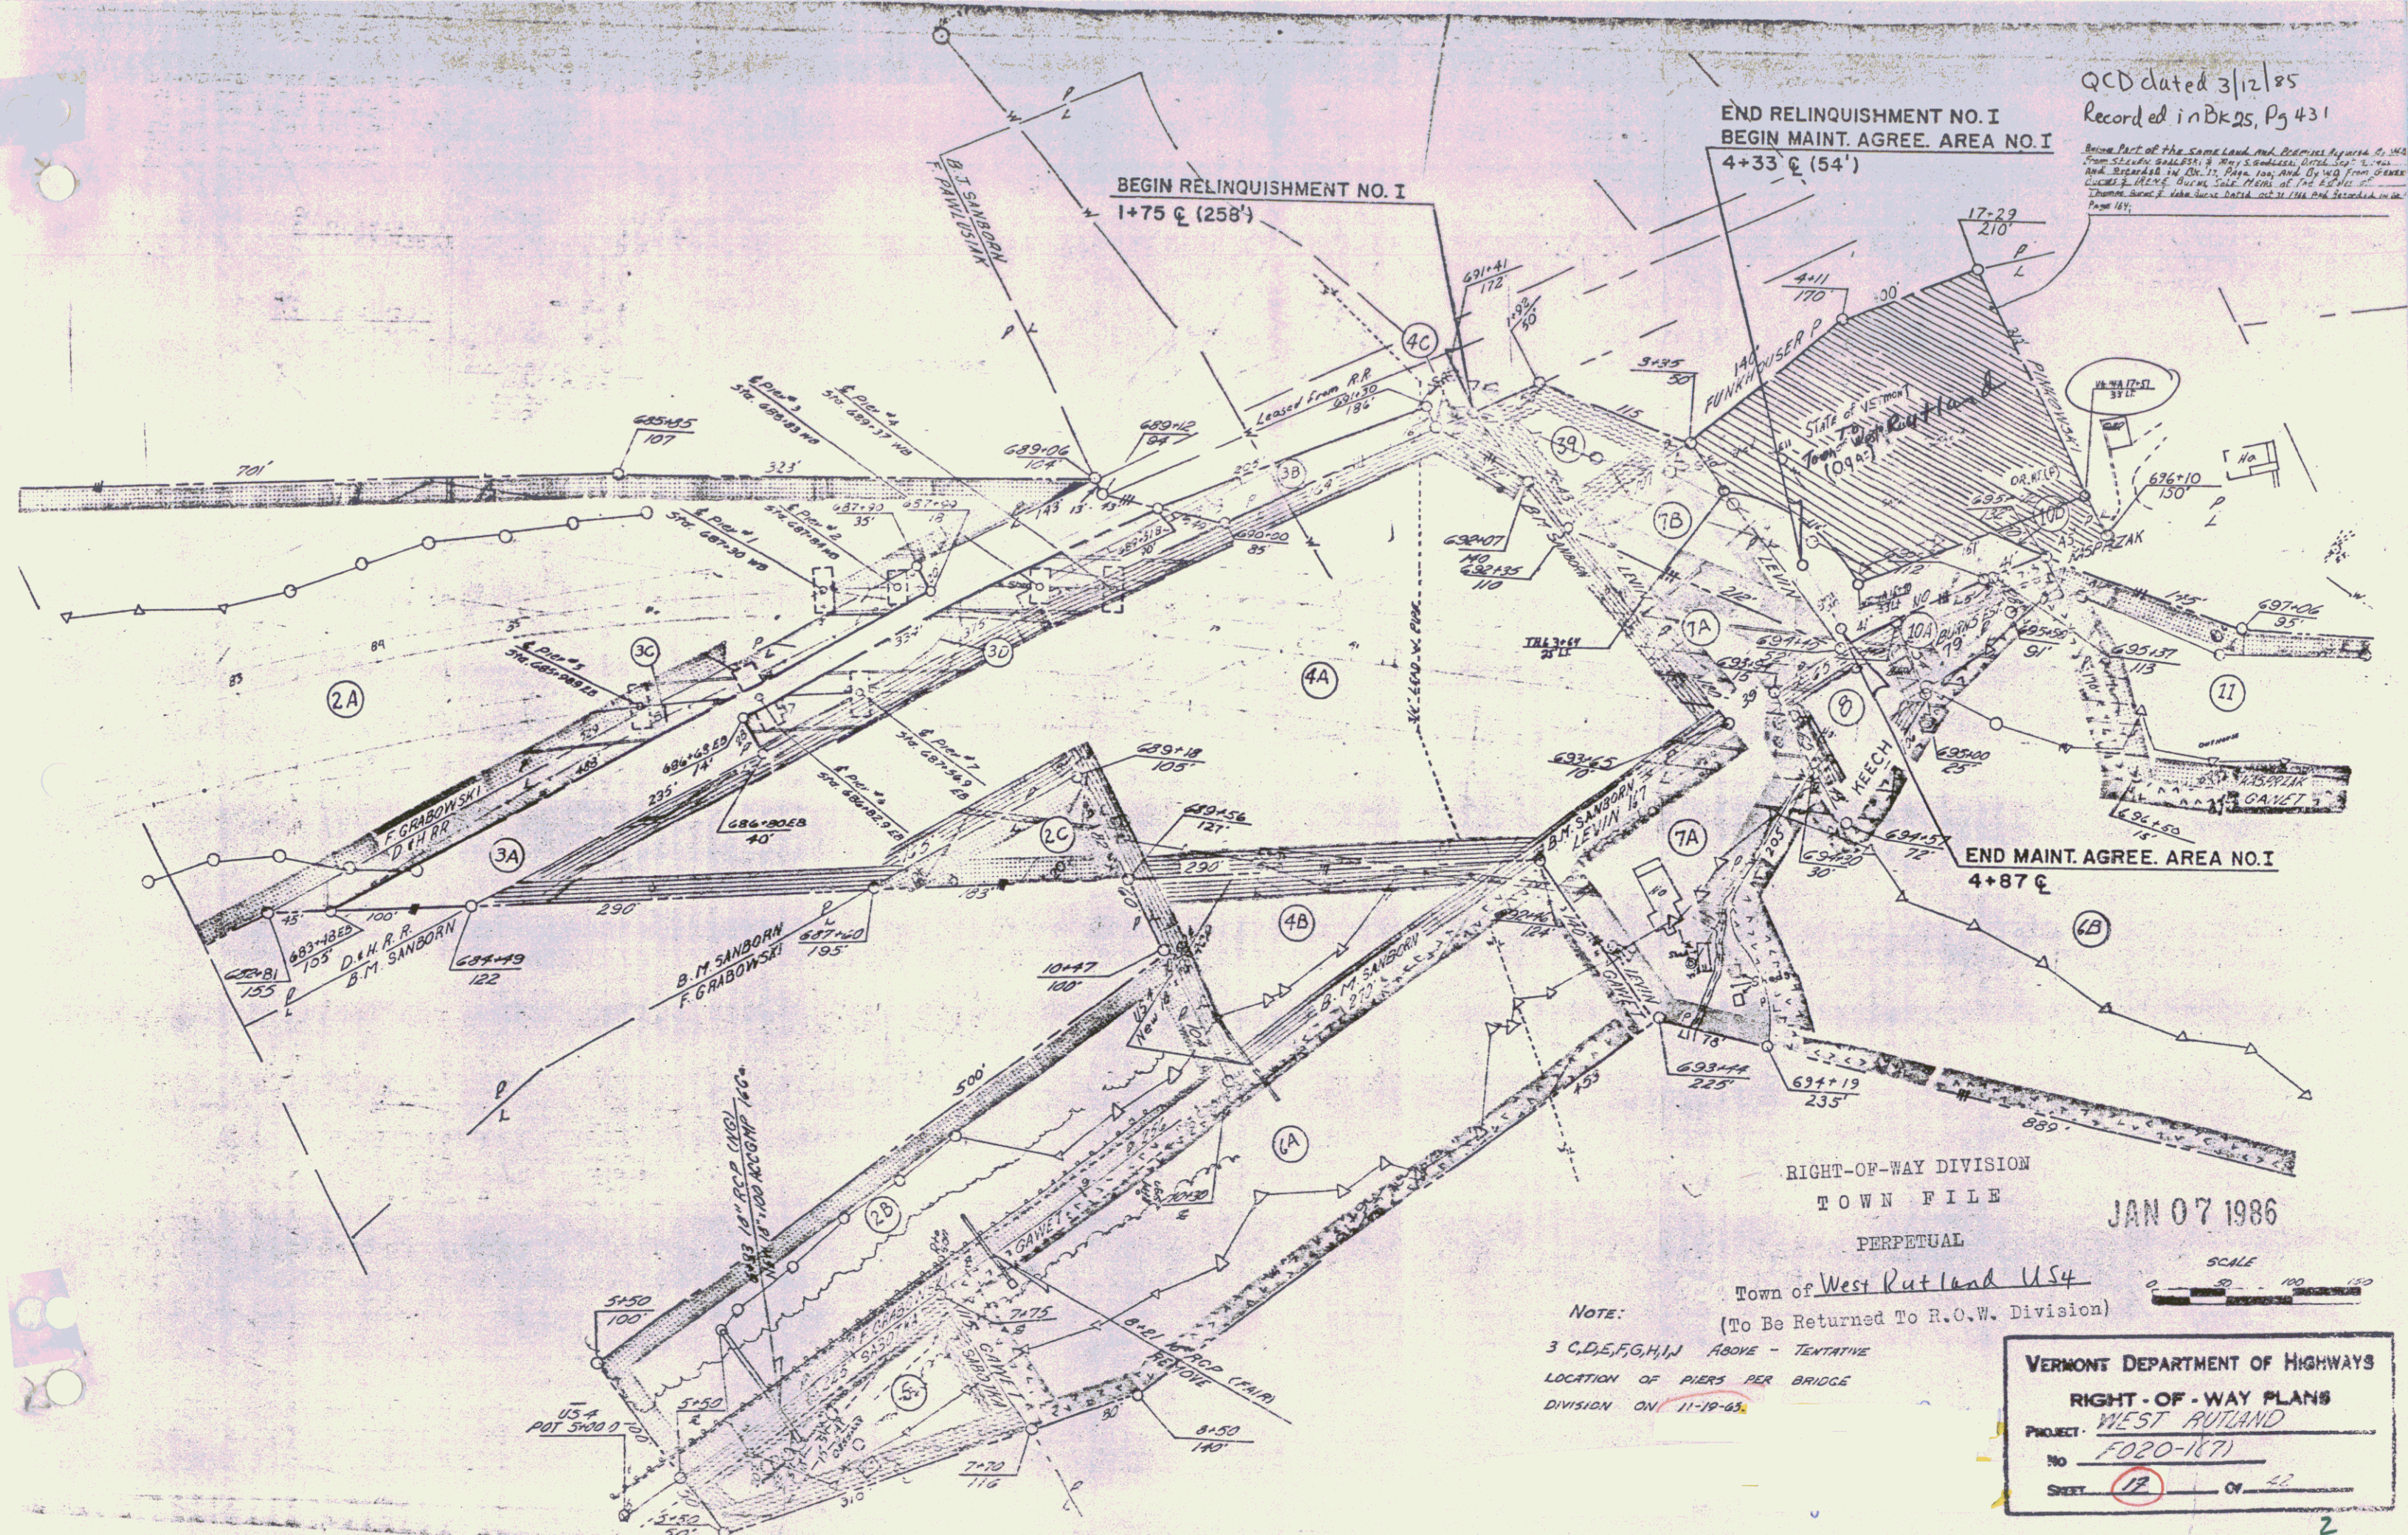

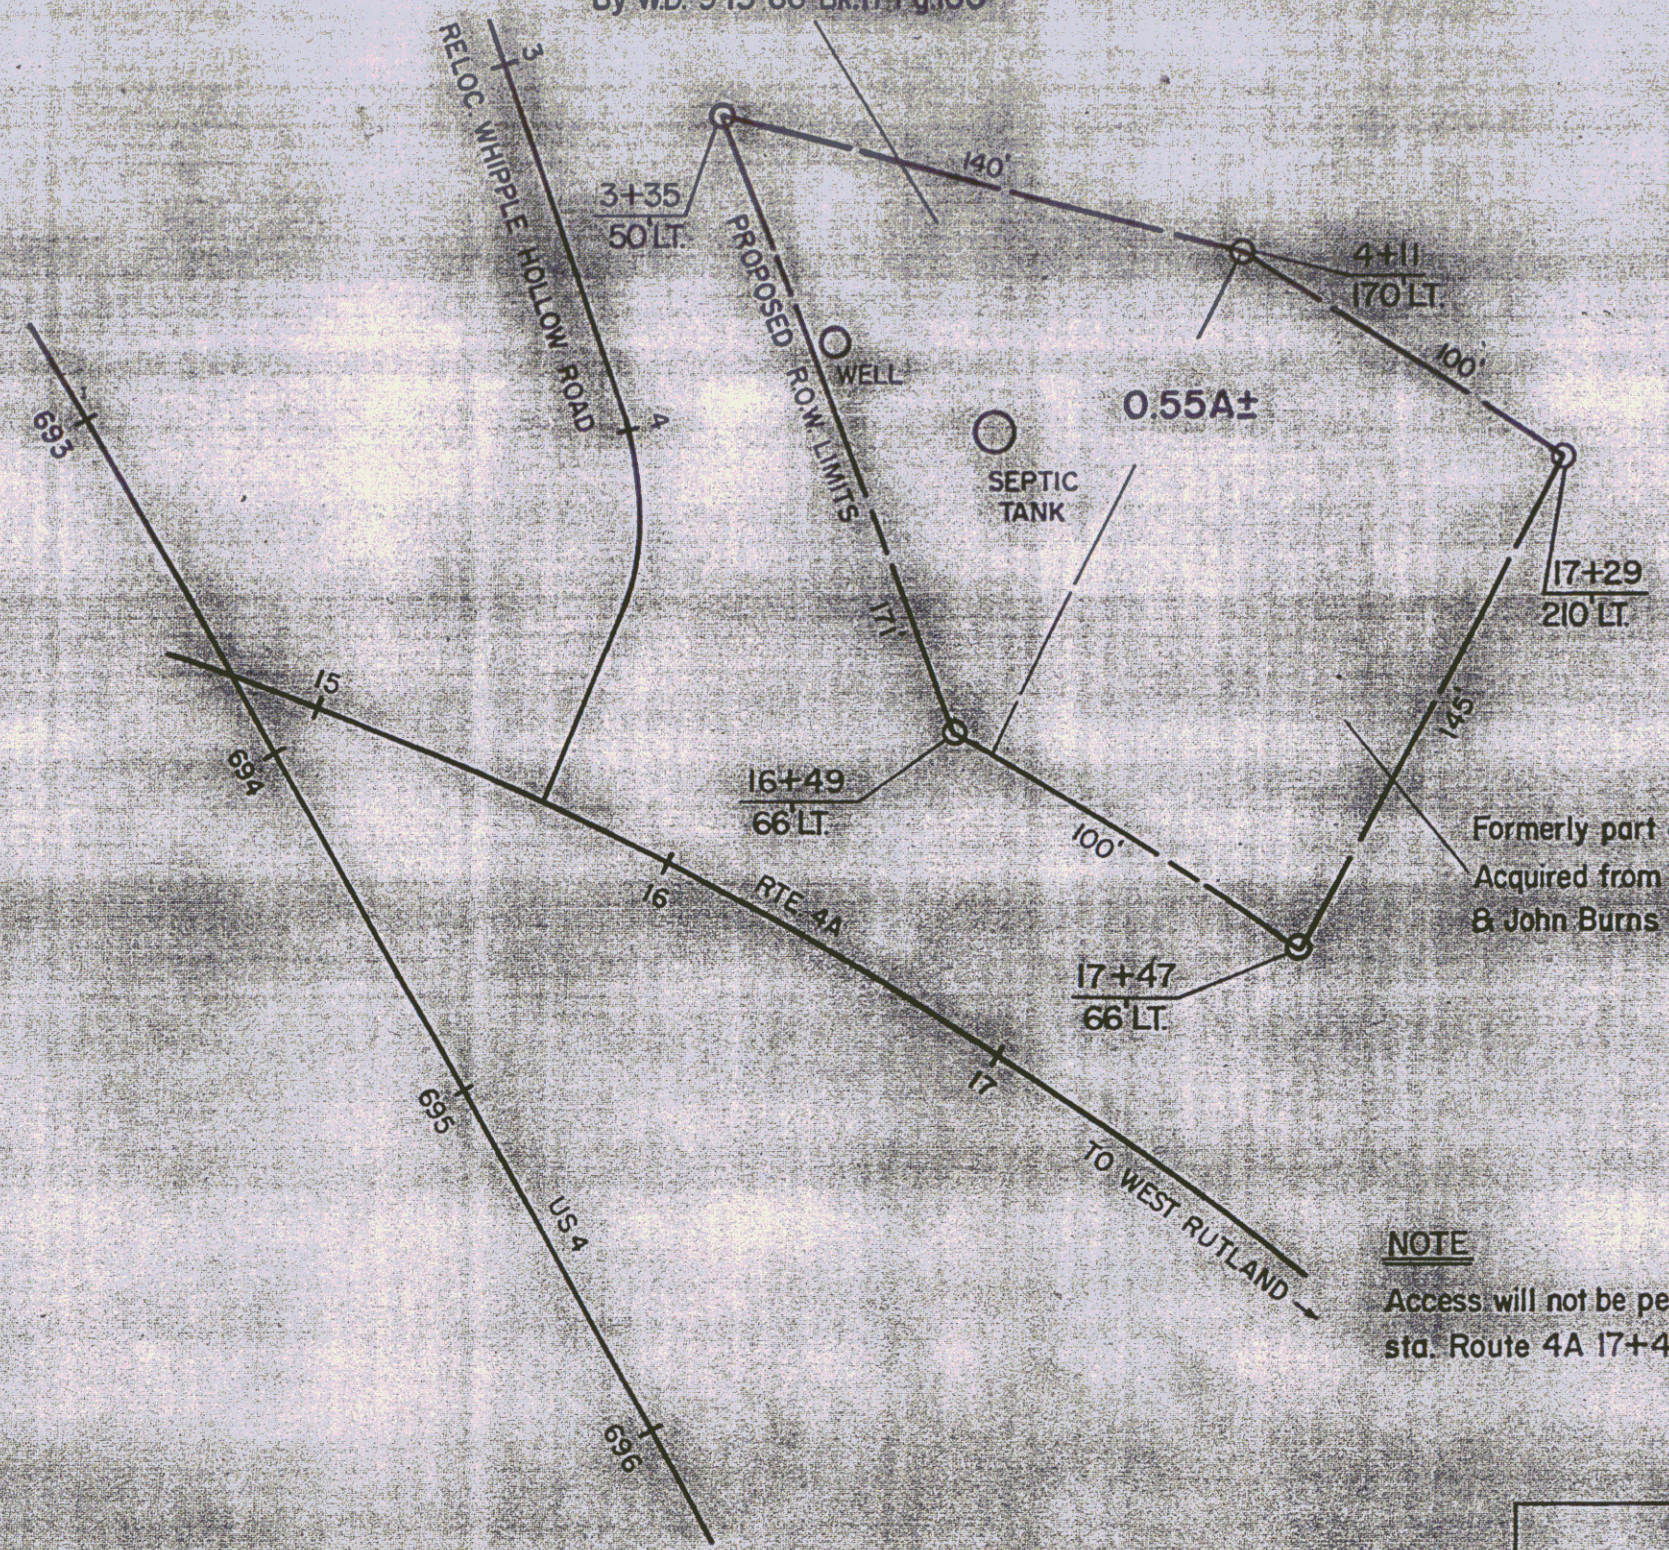

Formerly part of parcel no. 9
Acquired from Steven & Mary Godleski
By WD. 9-15-66 Bk. 17 Pg. 100

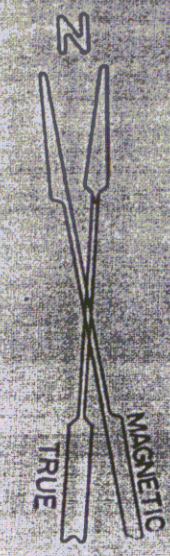

NOTE
Access will not be permitted between
sta. Route 4A 17+49L and Route 4A 18+47L.


STATE OF VERMONT
DEPT OF HIGHWAYS

Town of West Rutland

PROJECT WEST RUTLAND (F020-1(7))

APPROX. SCALE 1" = 50' DATE 2-3-75 DRAWN BY ROD S.

R.O.W. PROJECT NO. 57-1974

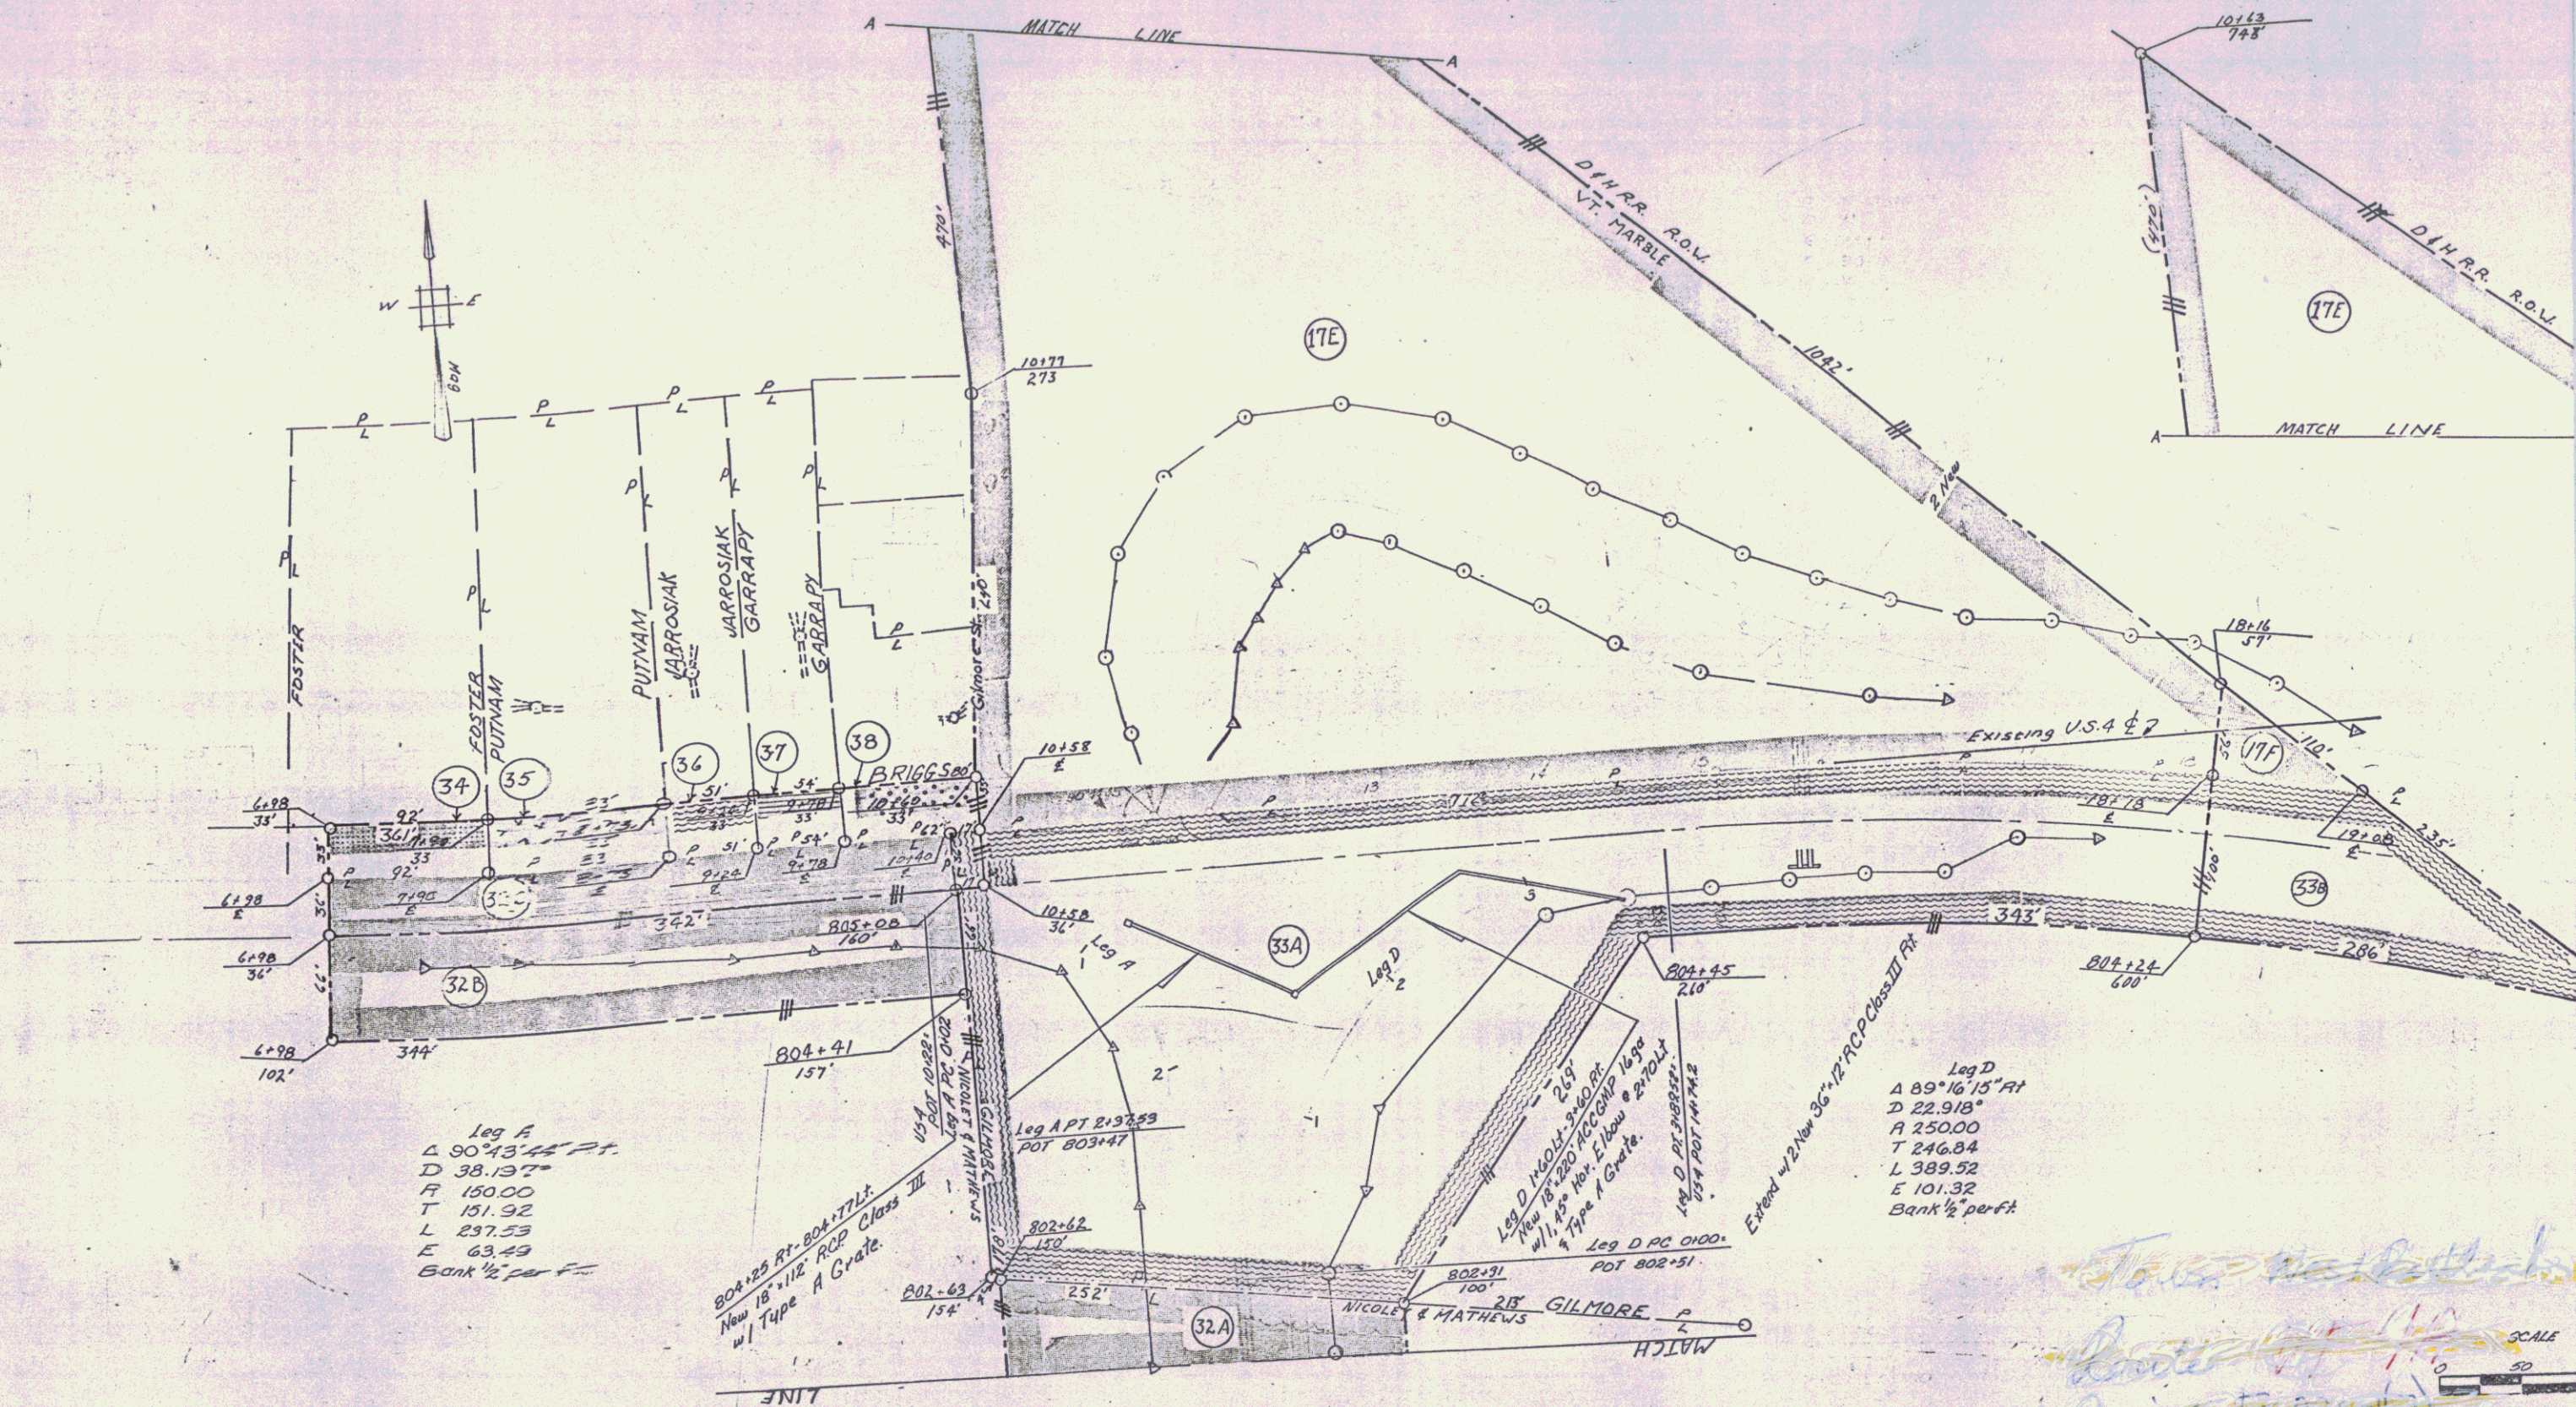

Leg A
 Δ 90°43'44" Rt.
 D 38.137°
 R 150.00
 T 151.92
 L 237.53
 E 63.49
 Bank 1/2 per ft.

Leg D
 Δ 89°16'15" Rt.
 D 22.918°
 R 250.00
 T 246.04
 L 389.52
 E 101.32
 Bank 1/2 per ft.

VERMONT DEPARTMENT
 RIGHT-OF-WAY
 PROJECT WEST RUT.
 No. F020-117
 SHEET 25