


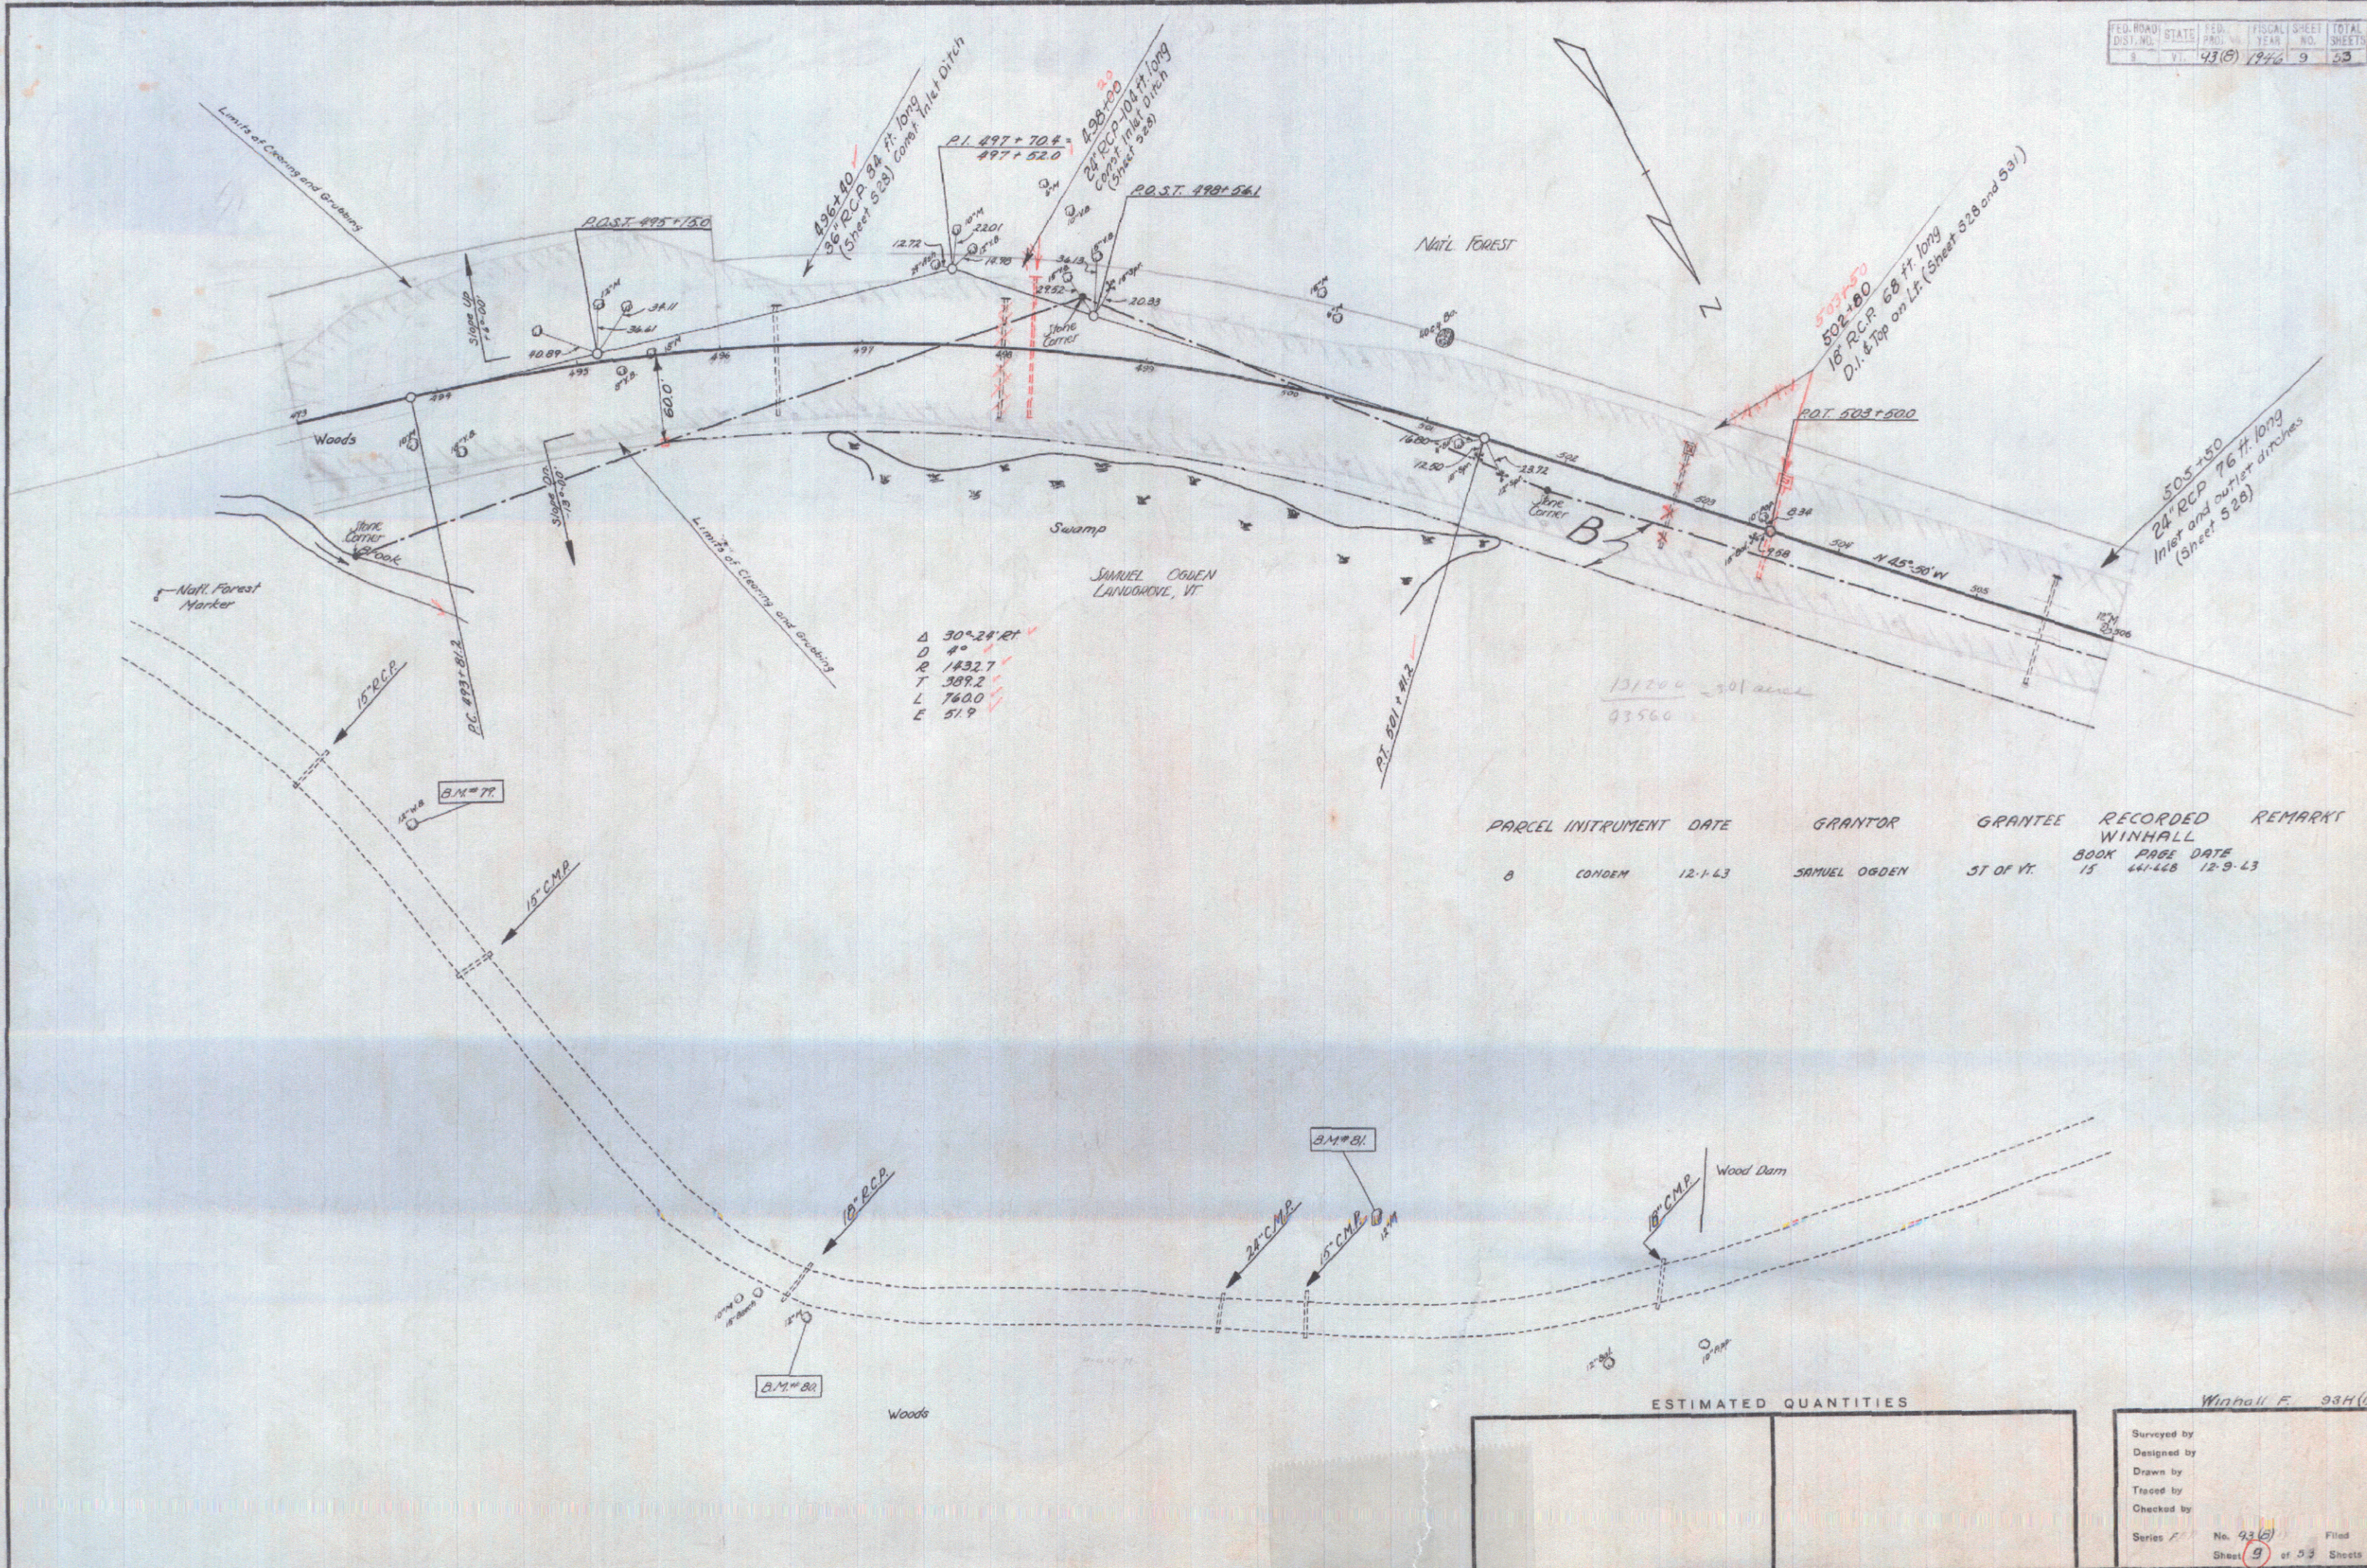

PARCEL	INSTRUMENT	DATE	GRANTOR	GRANTEE	RECORDED	REMARKS
8	CONDEM	12-1-43	SAMUEL OGDEN	ST OF VT.	WINHALL BOOK 15 PAGE 448 DATE 12-9-43	

Δ 30° 24' 21"
 D 4°
 R 1432.7
 E 51.9