


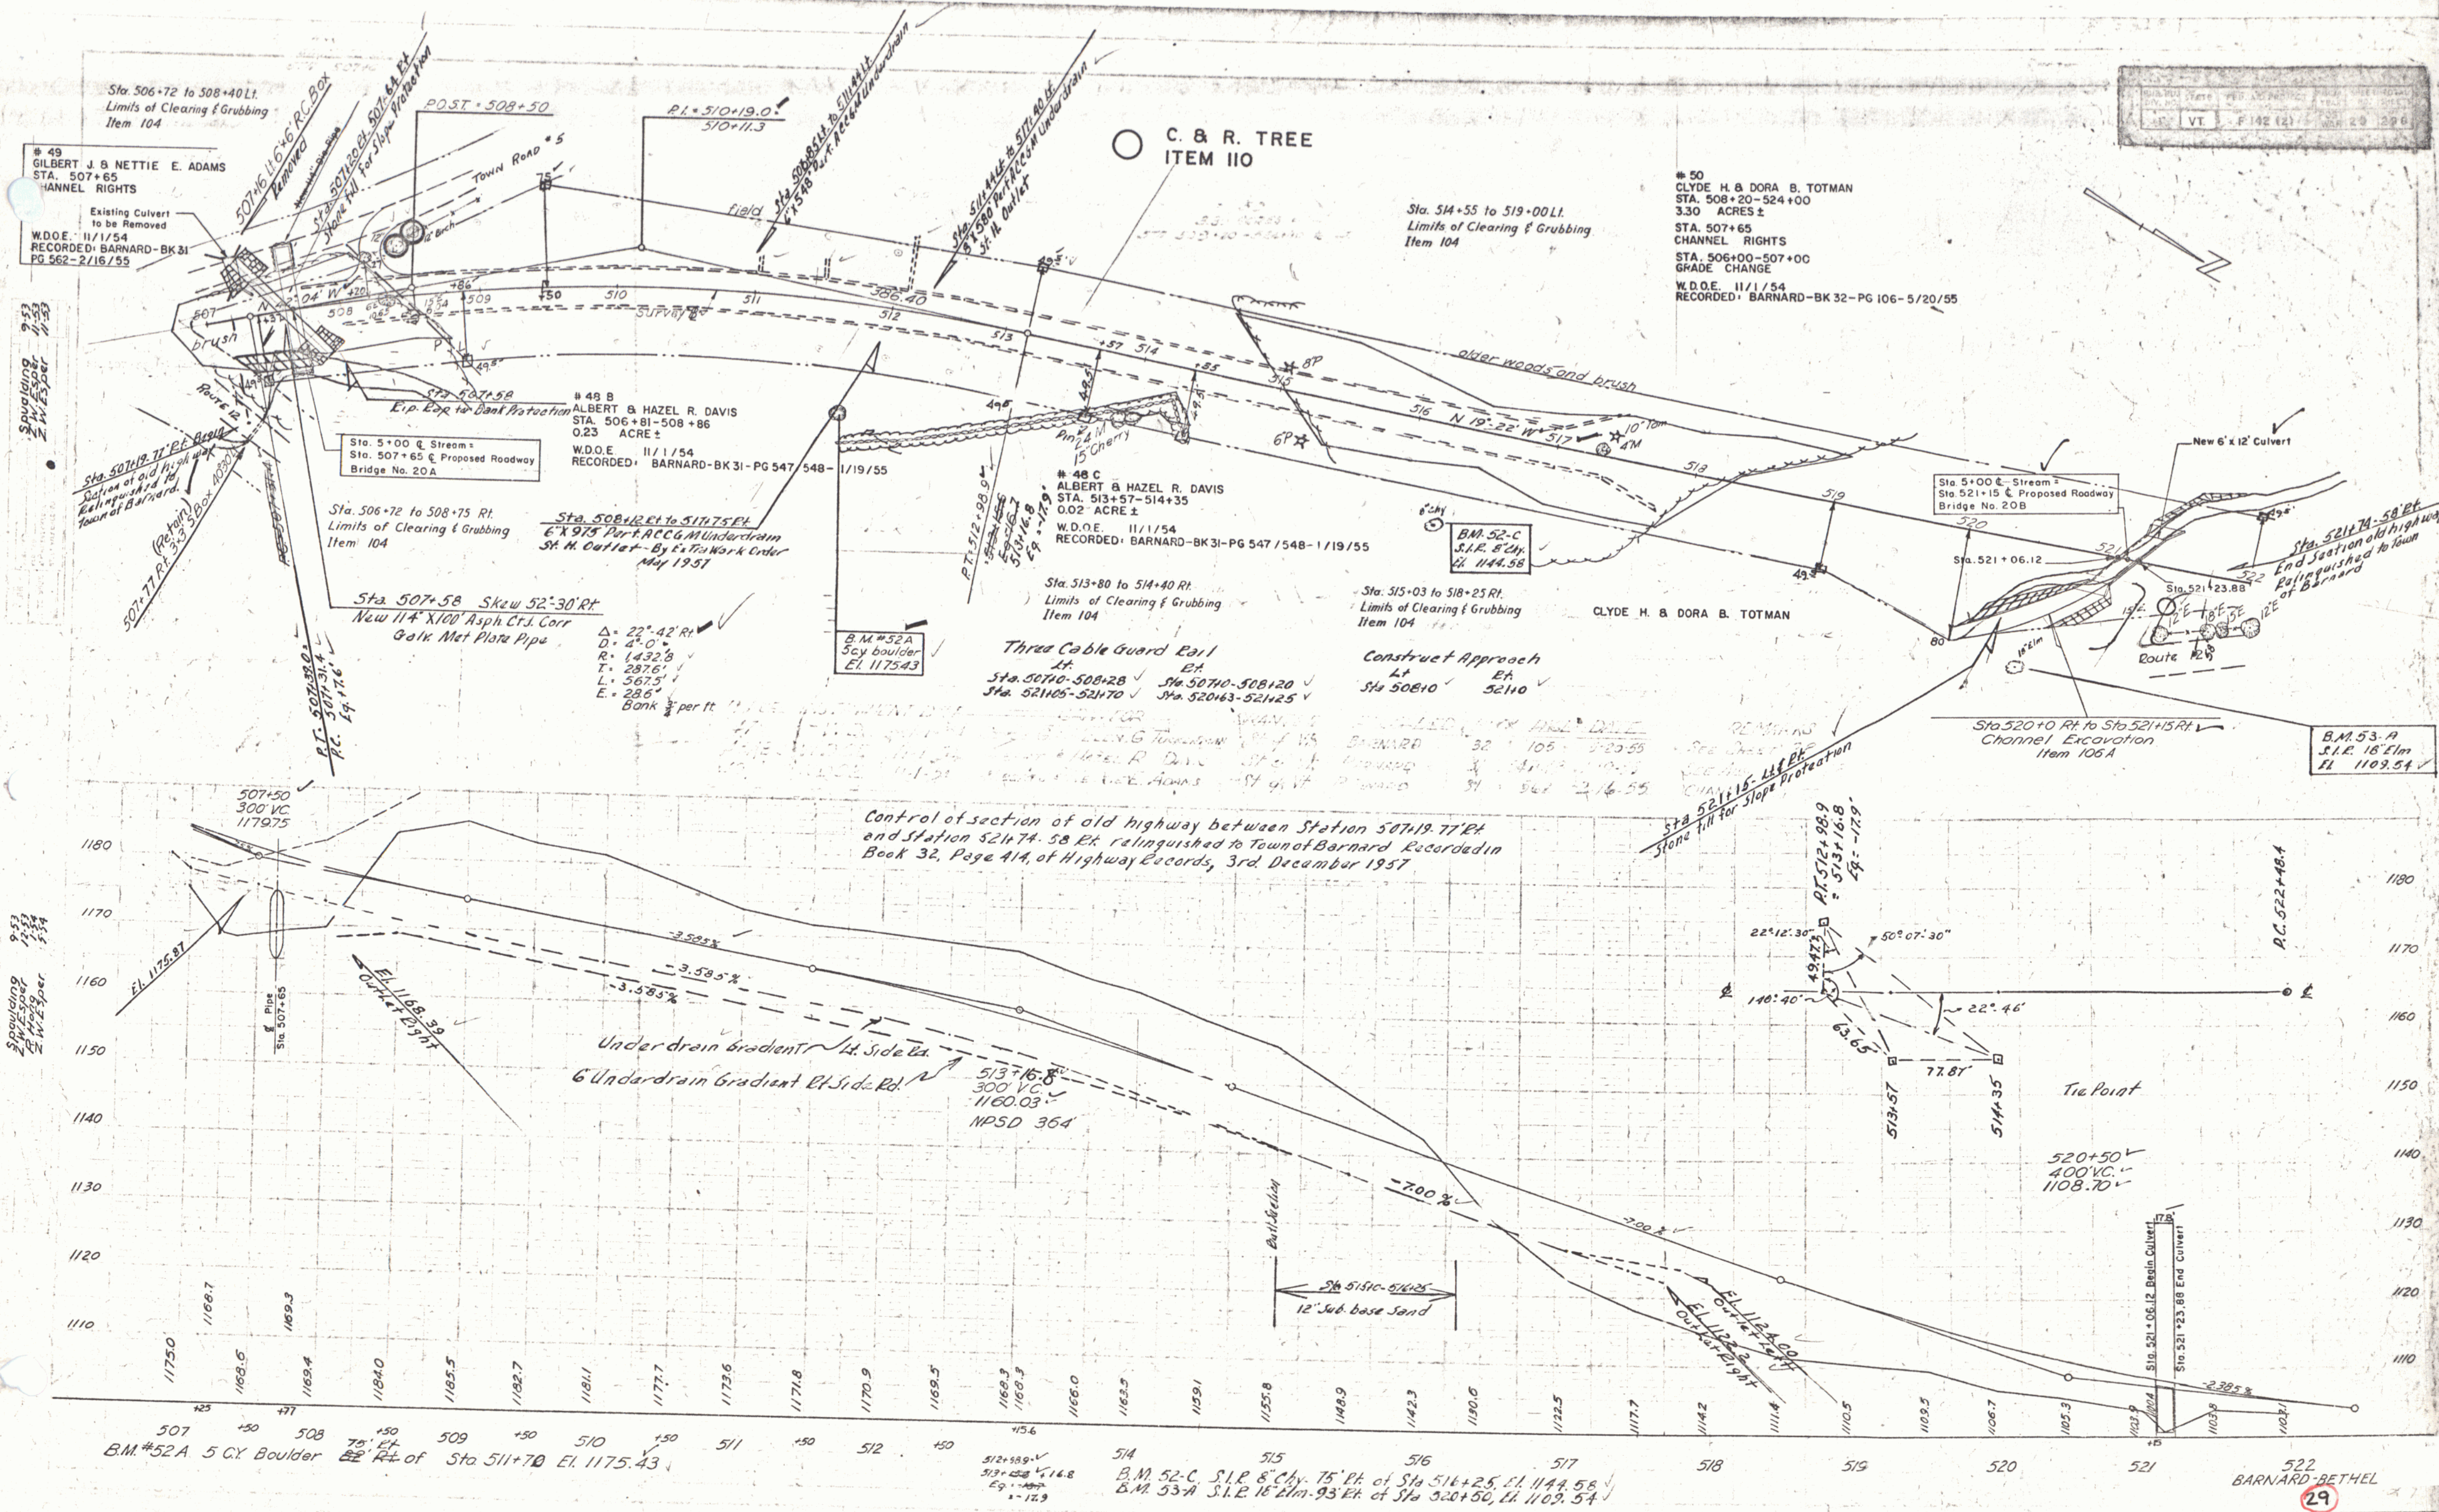

VT F 142 (2) JAN 20 1966

49
GILBERT J. & NETTIE E. ADAMS
STA. 507+65
CHANNEL RIGHTS
W.D.O.E. 11/1/54
RECORDED: BARNARD-BK 31
PG 562-2/16/55

50
CLYDE H. & DORA B. TOTMAN
STA. 508+20-524+00
3.30 ACRES ±
STA. 507+65
CHANNEL RIGHTS
STA. 506+00-507+00
GRADE CHANGE
W.D.O.E. 11/1/54
RECORDED: BARNARD-BK 32-PG 106-5/20/55

48 B
ALBERT & HAZEL R. DAVIS
STA. 506+81-508+86
0.23 ACRE ±
W.D.O.E. 11/1/54
RECORDED: BARNARD-BK 31-PG 547-548-1/19/55

48 C
ALBERT & HAZEL R. DAVIS
STA. 513+57-514+35
0.02 ACRE ±
W.D.O.E. 11/1/54
RECORDED: BARNARD-BK 31-PG 547-548-1/19/55

B.M. 53-A
S.I.R. 18' ELM
EL. 1109.54

Control of section of old highway between Station 507+19.77' Pk and Station 521+74.58' Pk relinquished to Town of Barnard Recorded in Book 32, Page 414, of Highway Records, 3rd December 1957