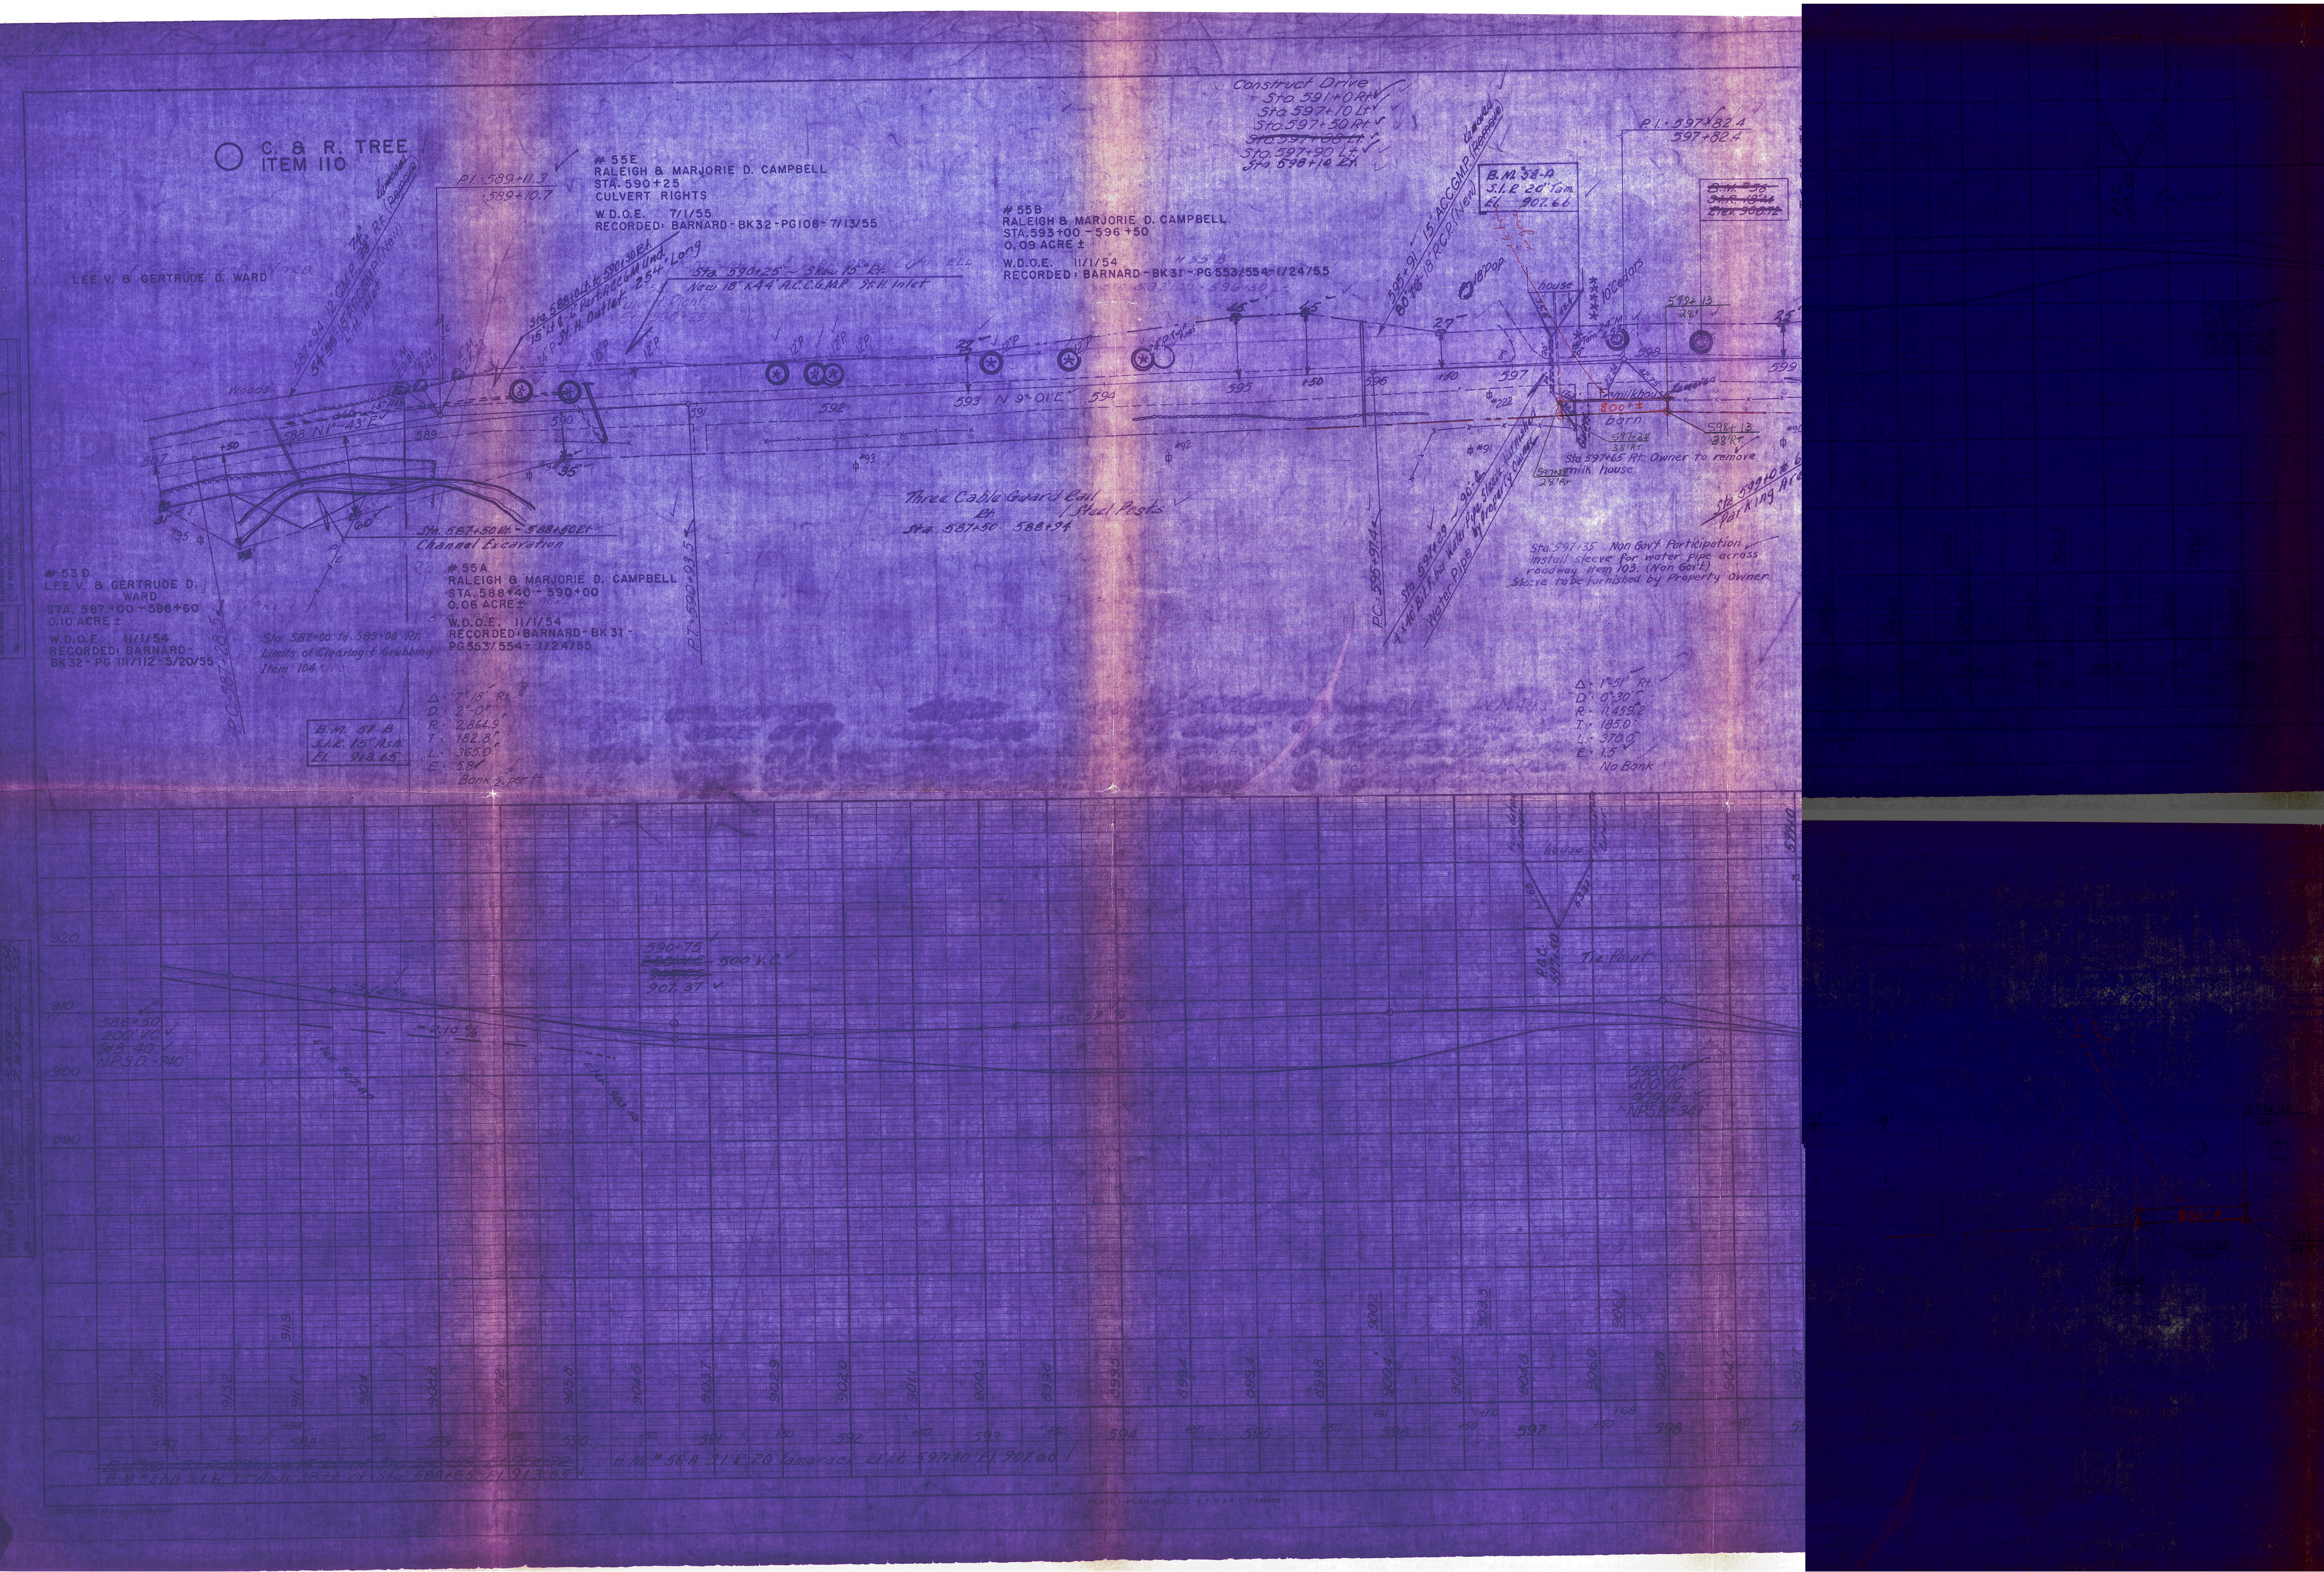
C. & R. TREE
ITEM 110
LEE V. & GERTRUDE D. WARD
P.I. = 589+11.3
= 589+10.7
587+94 12" C.M.P. 74° Rt. (Remove) Removed
54' 58" 18" A.C.C.G.M.P. (New) L.H. Inlet
#55E
RALEIGH & MARJORIE D. CAMPBELL
STA. 590+25
CULVERT RIGHTS
W.D.O.E. 7/1/55
RECORDED: BARNARD - BK32 - PG108 - 7/13/55
Sta. 588+10 Lt. to 590+30 Rt.
15' Lt. & 6" Part. A.C.C.G.M. Und.
24" P. St. H. Outlet 254' Long
Sta. 590+25 ~ Skew 15° Rt.
New 18" X 44' A.C.C.G.M.P. St. H. Inlet
#55B
RALEIGH & MARJORIE D. CAMPBELL
STA. 593+00 - 596+50
0.09 ACRE ±
W.D.O.E. 11/1/54
RECORDED: BARNARD - BK31 - PG 553/554 - 1/24/55
Construct Drive
Sta. 591+0 Rt.
Sta. 597+10 Lt.
Sta. 597+50 Rt.
~~Sta. 597+88 Lt.~~
Sta. 597+90 Lt.
Sta. 598+10 Rt.
595+91 15" A.C.C.G.M.P. (Remove) Removed
80' 76" 18" R.C.P. (New)
B.M. 58-A
S.I.R. 20" Tam.
El. 907.66
~~B.M. #58~~
~~S.I.R. 18" M.~~
~~Elev. 900.72~~
P.I. = 597+82.4
597+82.4
Woods
5"M 29.81
12"M 24.14
4"M 26.23
15" Ash
588 N 1°-43' E
587
+50
589
590
591
592
593 N 9°-01' E
594
595
+50
596
+50
597
598
599
12"P
18"P
24"P
24"P Twin Pines
18" Pop.
22
27
45
45
27
25
31'
60'
35'
#95
#94
#93
#92
#91
#222
#90
house
10" Cedars
24"M
18" Tam
598+13
28'
milkhouse
Removed
800' ±
barn
597+34
38' Rt.
598+13
38' Rt.
597+34
28' Rt.
Sta. 597+65 Rt. Owner to remove milk house.
Sta. 599+0 to 6
Parking Area
Sta. 587+50 Rt. - 588+50 Rt.
Channel Excavation
Three Cable Guard Rail
Rt. / Steel Posts
Sta. 587+50 - 588+94
#53D
LEE V. & GERTRUDE D.
WARD
STA. 587+00 - 588+60
0.10 ACRE ±
W.D.O.E. 11/1/54
RECORDED: BARNARD -
BK32 - PG 111/112 - 5/20/55
Sta. 587+00 to 589+00 Rt.
Limits of Clearing & Grubbing
Item 104
#55A
RALEIGH & MARJORIE D. CAMPBELL
STA. 588+40 - 590+00
0.06 ACRE ±
W.D.O.E. 11/1/54
RECORDED: BARNARD - BK 31 -
PG553/554 - 1/24/55
P.C. = 587+28.5
P.T. = 590+93.5
P.C. = 595+97.4
Sta. 597+29 ~ 90° Lt.
4" x 40' Bit. F. bar Water Pipe Sleeve furnished
Water Pipe by Property Owner
B.M. 57-B
S.I.R. 15" Ash.
El. 913.65
Δ: 7°-18' Rt.
D: 2°-0'
R: 2,864.9
T: 182.8
L: 365.0
E: 5.8
Bank ½" per ft.
Sta. 597+35 Non Gov't Participation
Install sleeve for water pipe across roadway. Item 103. (Non Gov't.)
Sleeve to be furnished by Property Owner.
Δ: 1°-51' Rt.
D: 0°-30'
R: 11,459.2
T: 185.0
L: 370.0
E: 1.5
No Bank
920
910
900
890
586+50
200' V.C.
918.40
N.P.S.D. = 740'
-3.14 %
-2.10 %
+0.57 %
590+75
~~200' V.C.~~ 500' V.C.
907.37
598+0
400' V.C.
909.19
N.P.S.D. = 341'
house
P.O.C. 597+30
Tie Point
915.0
913.2
911.7
911.9
910.4
908.8
907.2
905.8
904.5
903.7
902.9
902.0
901.1
900.3
899.6
899.5
899.4
899.4
899.8
900.4
900.2
902.3
903.3
904.8
906.0
906.1
906.8
904.7
587
+50
588
+50
589
+50
590
+50
591
+50
592
+50
593
+50
594
+50
595
+50
596
+50
597
+50
598
+50
~~B.M. #58 S.I.R. 18" Maple 21' Lt. of Sta. 598+80 El. 900.72~~
B.M. #58-A S.I.R. 20" Tamarack 21' Lt. 597+50 El. 907.66
B.M. #57B S.I.R. 15" Ash 25' Lt. of Sta. 588+85 El. 913.65
PLATE 1 - PLAN-PROFILE - U.P.S. & R.C. STANDARD
Z. W. Esper
Z. W. Esper