

193-14

WOOD GUARD RAIL REQUIRED

CULVERT STATION	LEFT	RIGHT
207+50	-	24'
209+50	-	24'


CABLE GUARD RAIL REQUIRED

STATIONING	LEFT	RIGHT
207+35 - 214+00	665'	-

NEW REIN. CONCRETE PIPE CULVERTS REQUIRED

STA.	DIAM.	LENG.	CONC. A	CONC. C	REIN. STEEL	D.I.	PROPOSED TOP
207+50	18"	40'	1.8 CY	-	54 lbs.	-	-
209+50	18"	48'	2.3 CY	-	104 lbs.	1	1

FILE NO. 17-14
VI. 78-C-1930 17

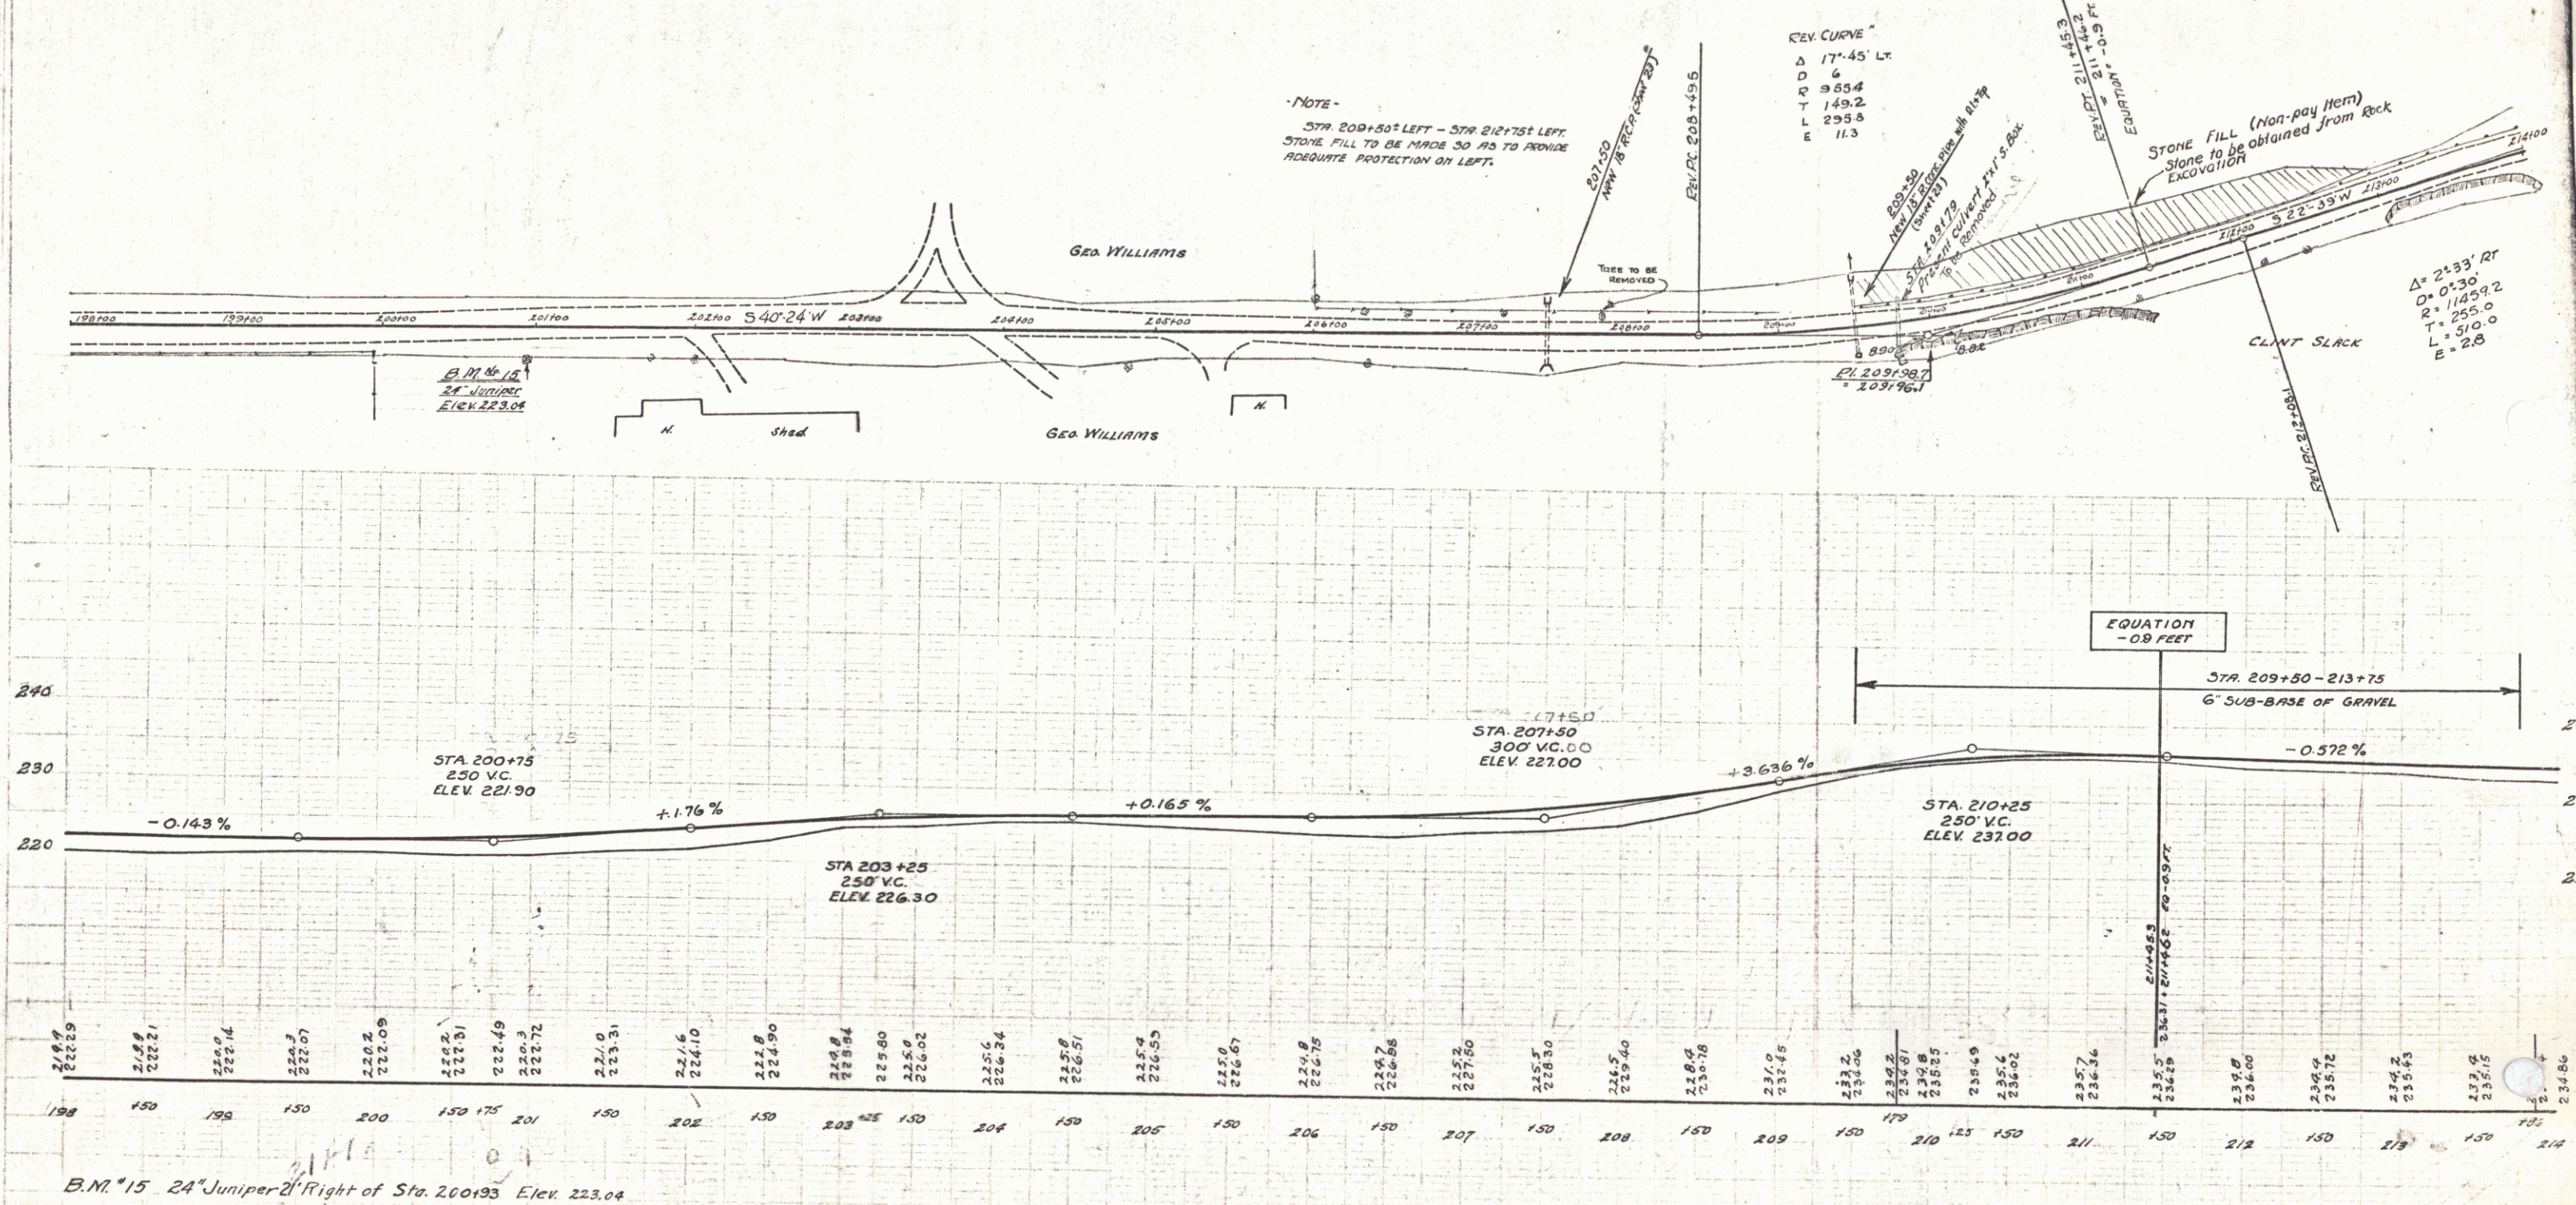

B.M. 15 24" Juniper 2' Right of Sta. 200+93 Elev. 223.04

SERIES F No 78C
SHEET 17 OF 66