


PLAN	SURVYED	BY	DATE
	NOTED		
NOTE BOOK	NO. _____	REVISIONS	
		BY _____	

PROFILE	SURVYED	BY	DATE
	NOTED		
NOTE BOOK	NO. _____	REVISIONS	
		BY _____	

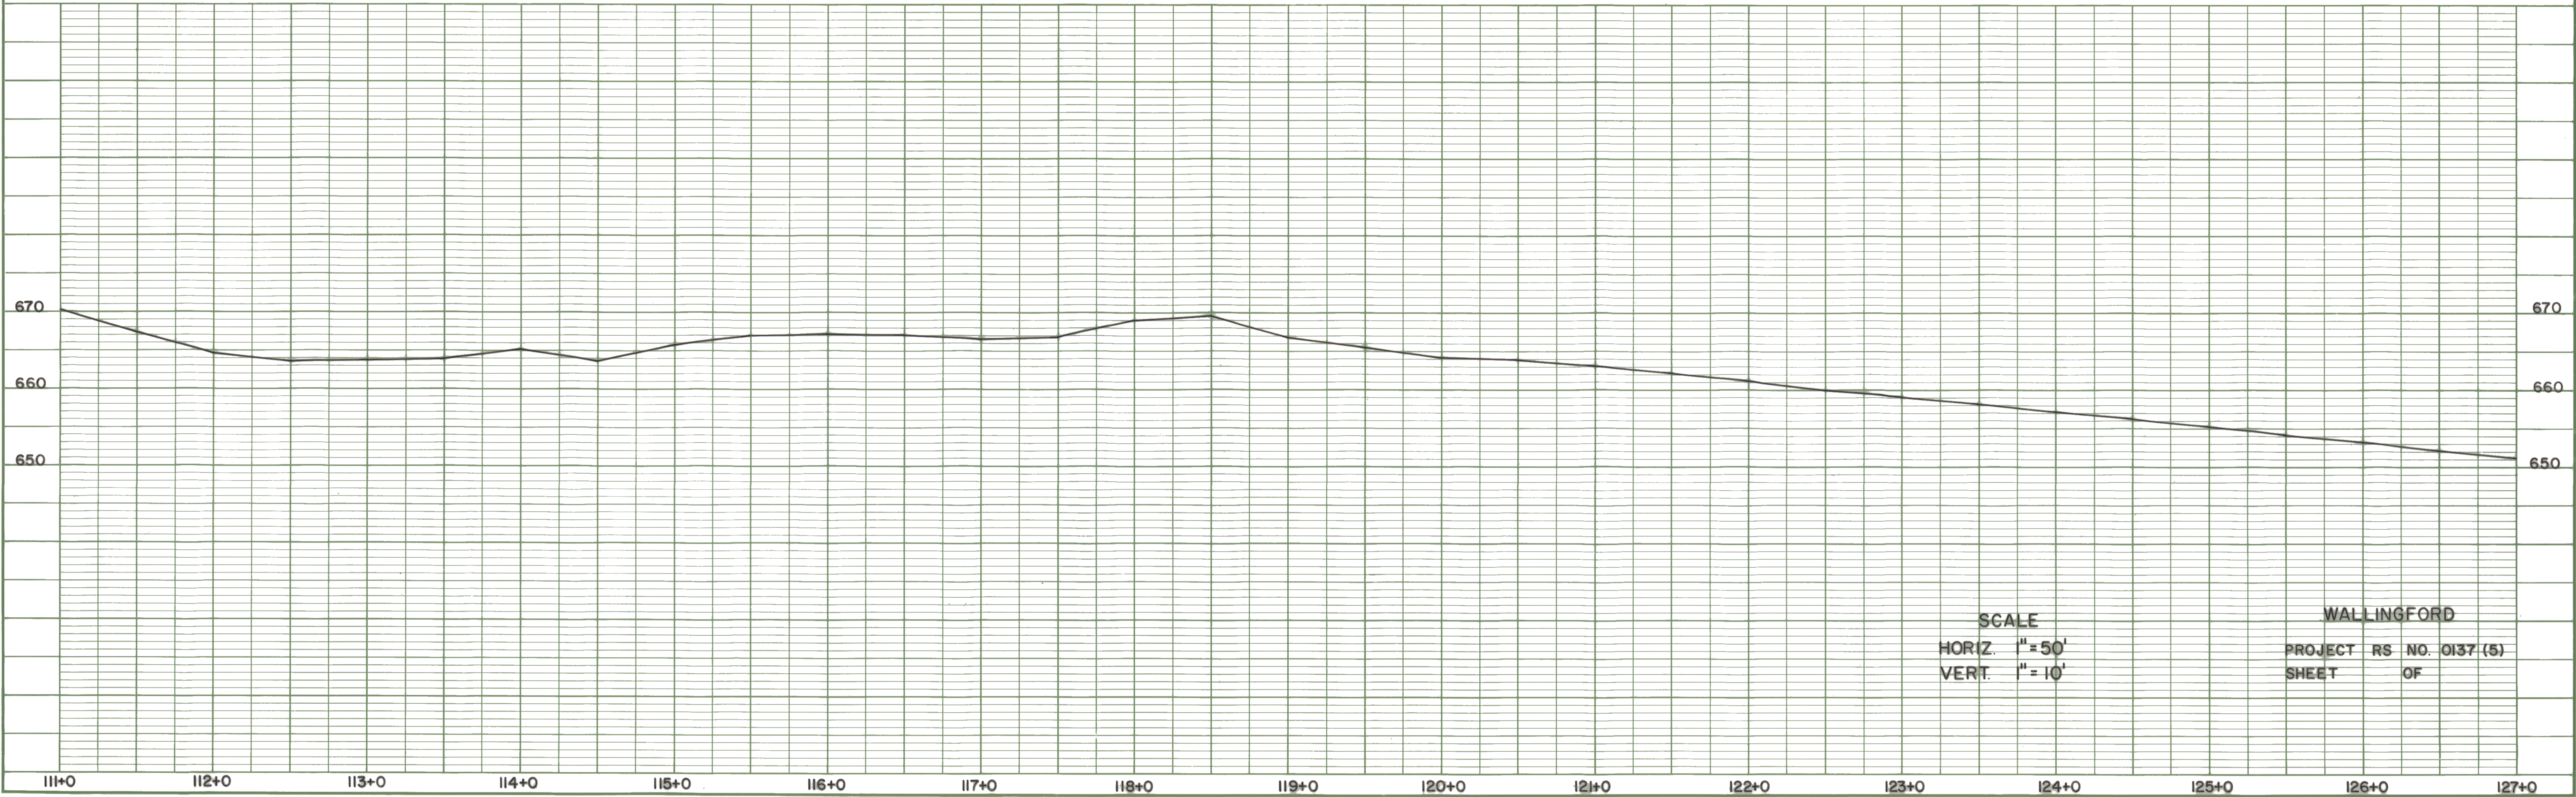

SCALE
HORIZ. 1"=50'
VERT. 1"=10'

WALLINGFORD
PROJECT RS NO. 0137 (5)
SHEET OF