


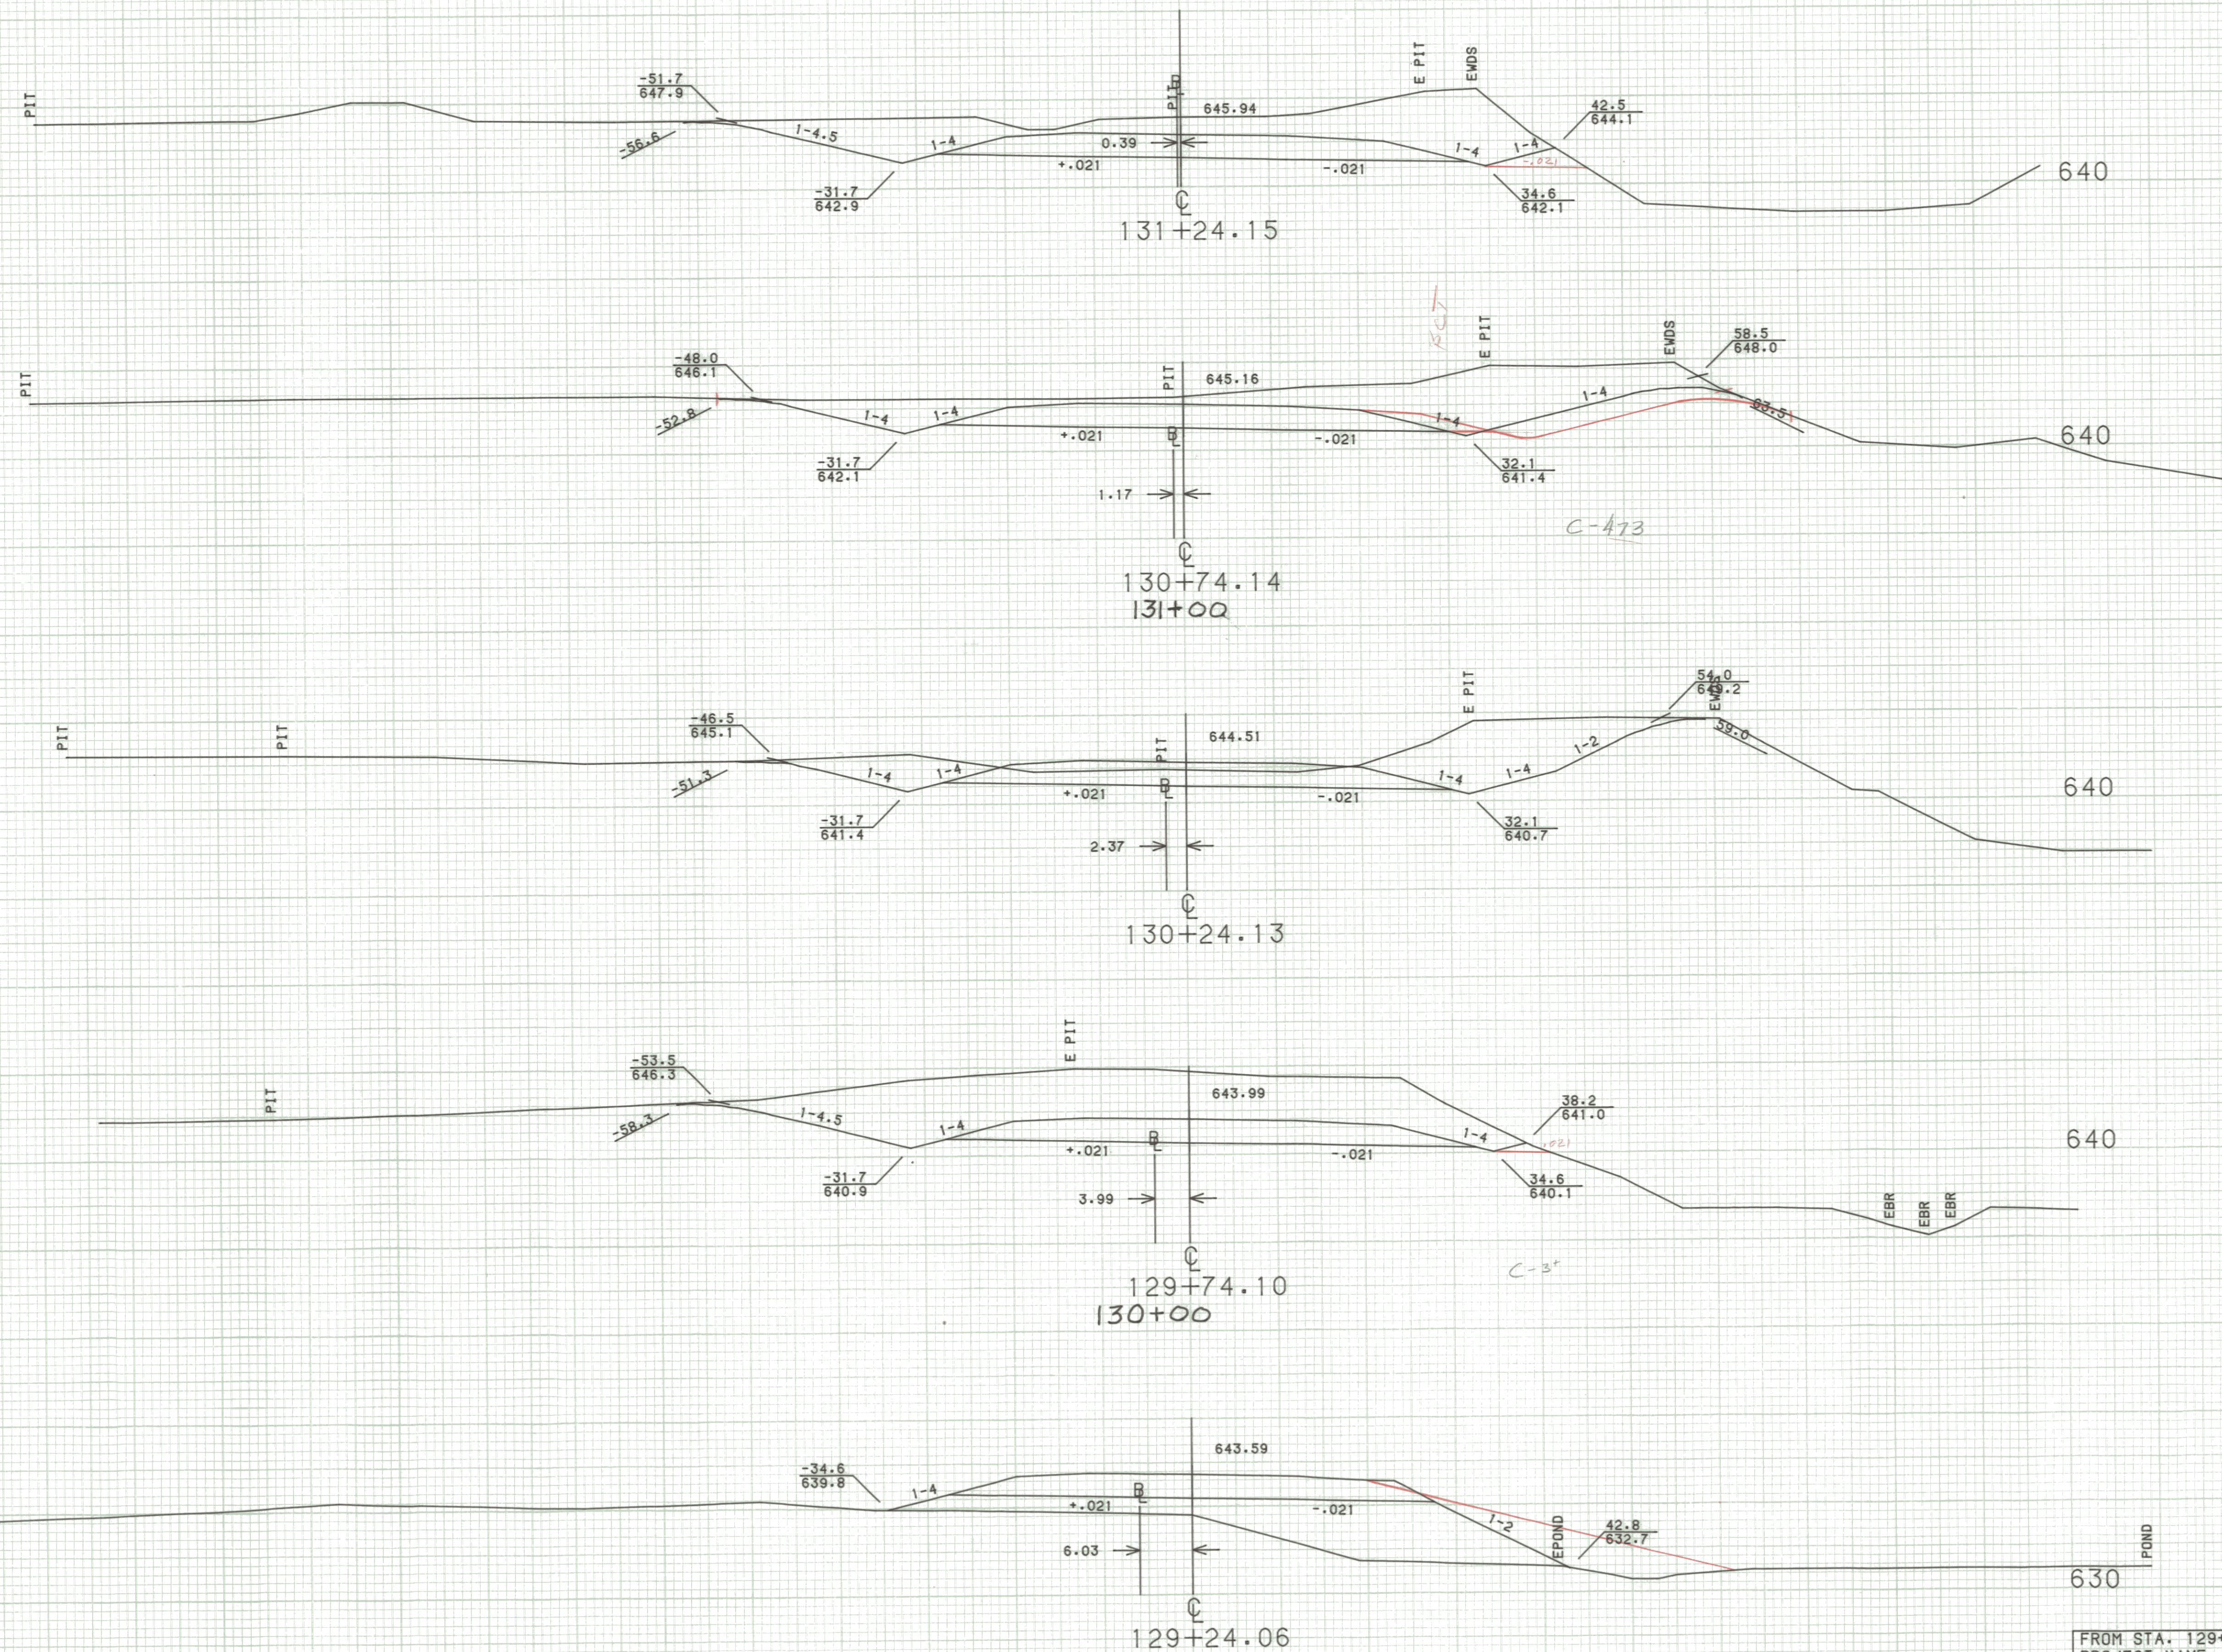

SCALE 1" = 10 FEET

FROM STA. 129+24.06	TO STA. 131+24.15
PROJECT NAME WALLINGFORD	
NO. RS0137 (5)	PLOTTED 11/13/85
SURVEYED BY FANTONI	MAY - 85
SHEET OF SHEETS	