


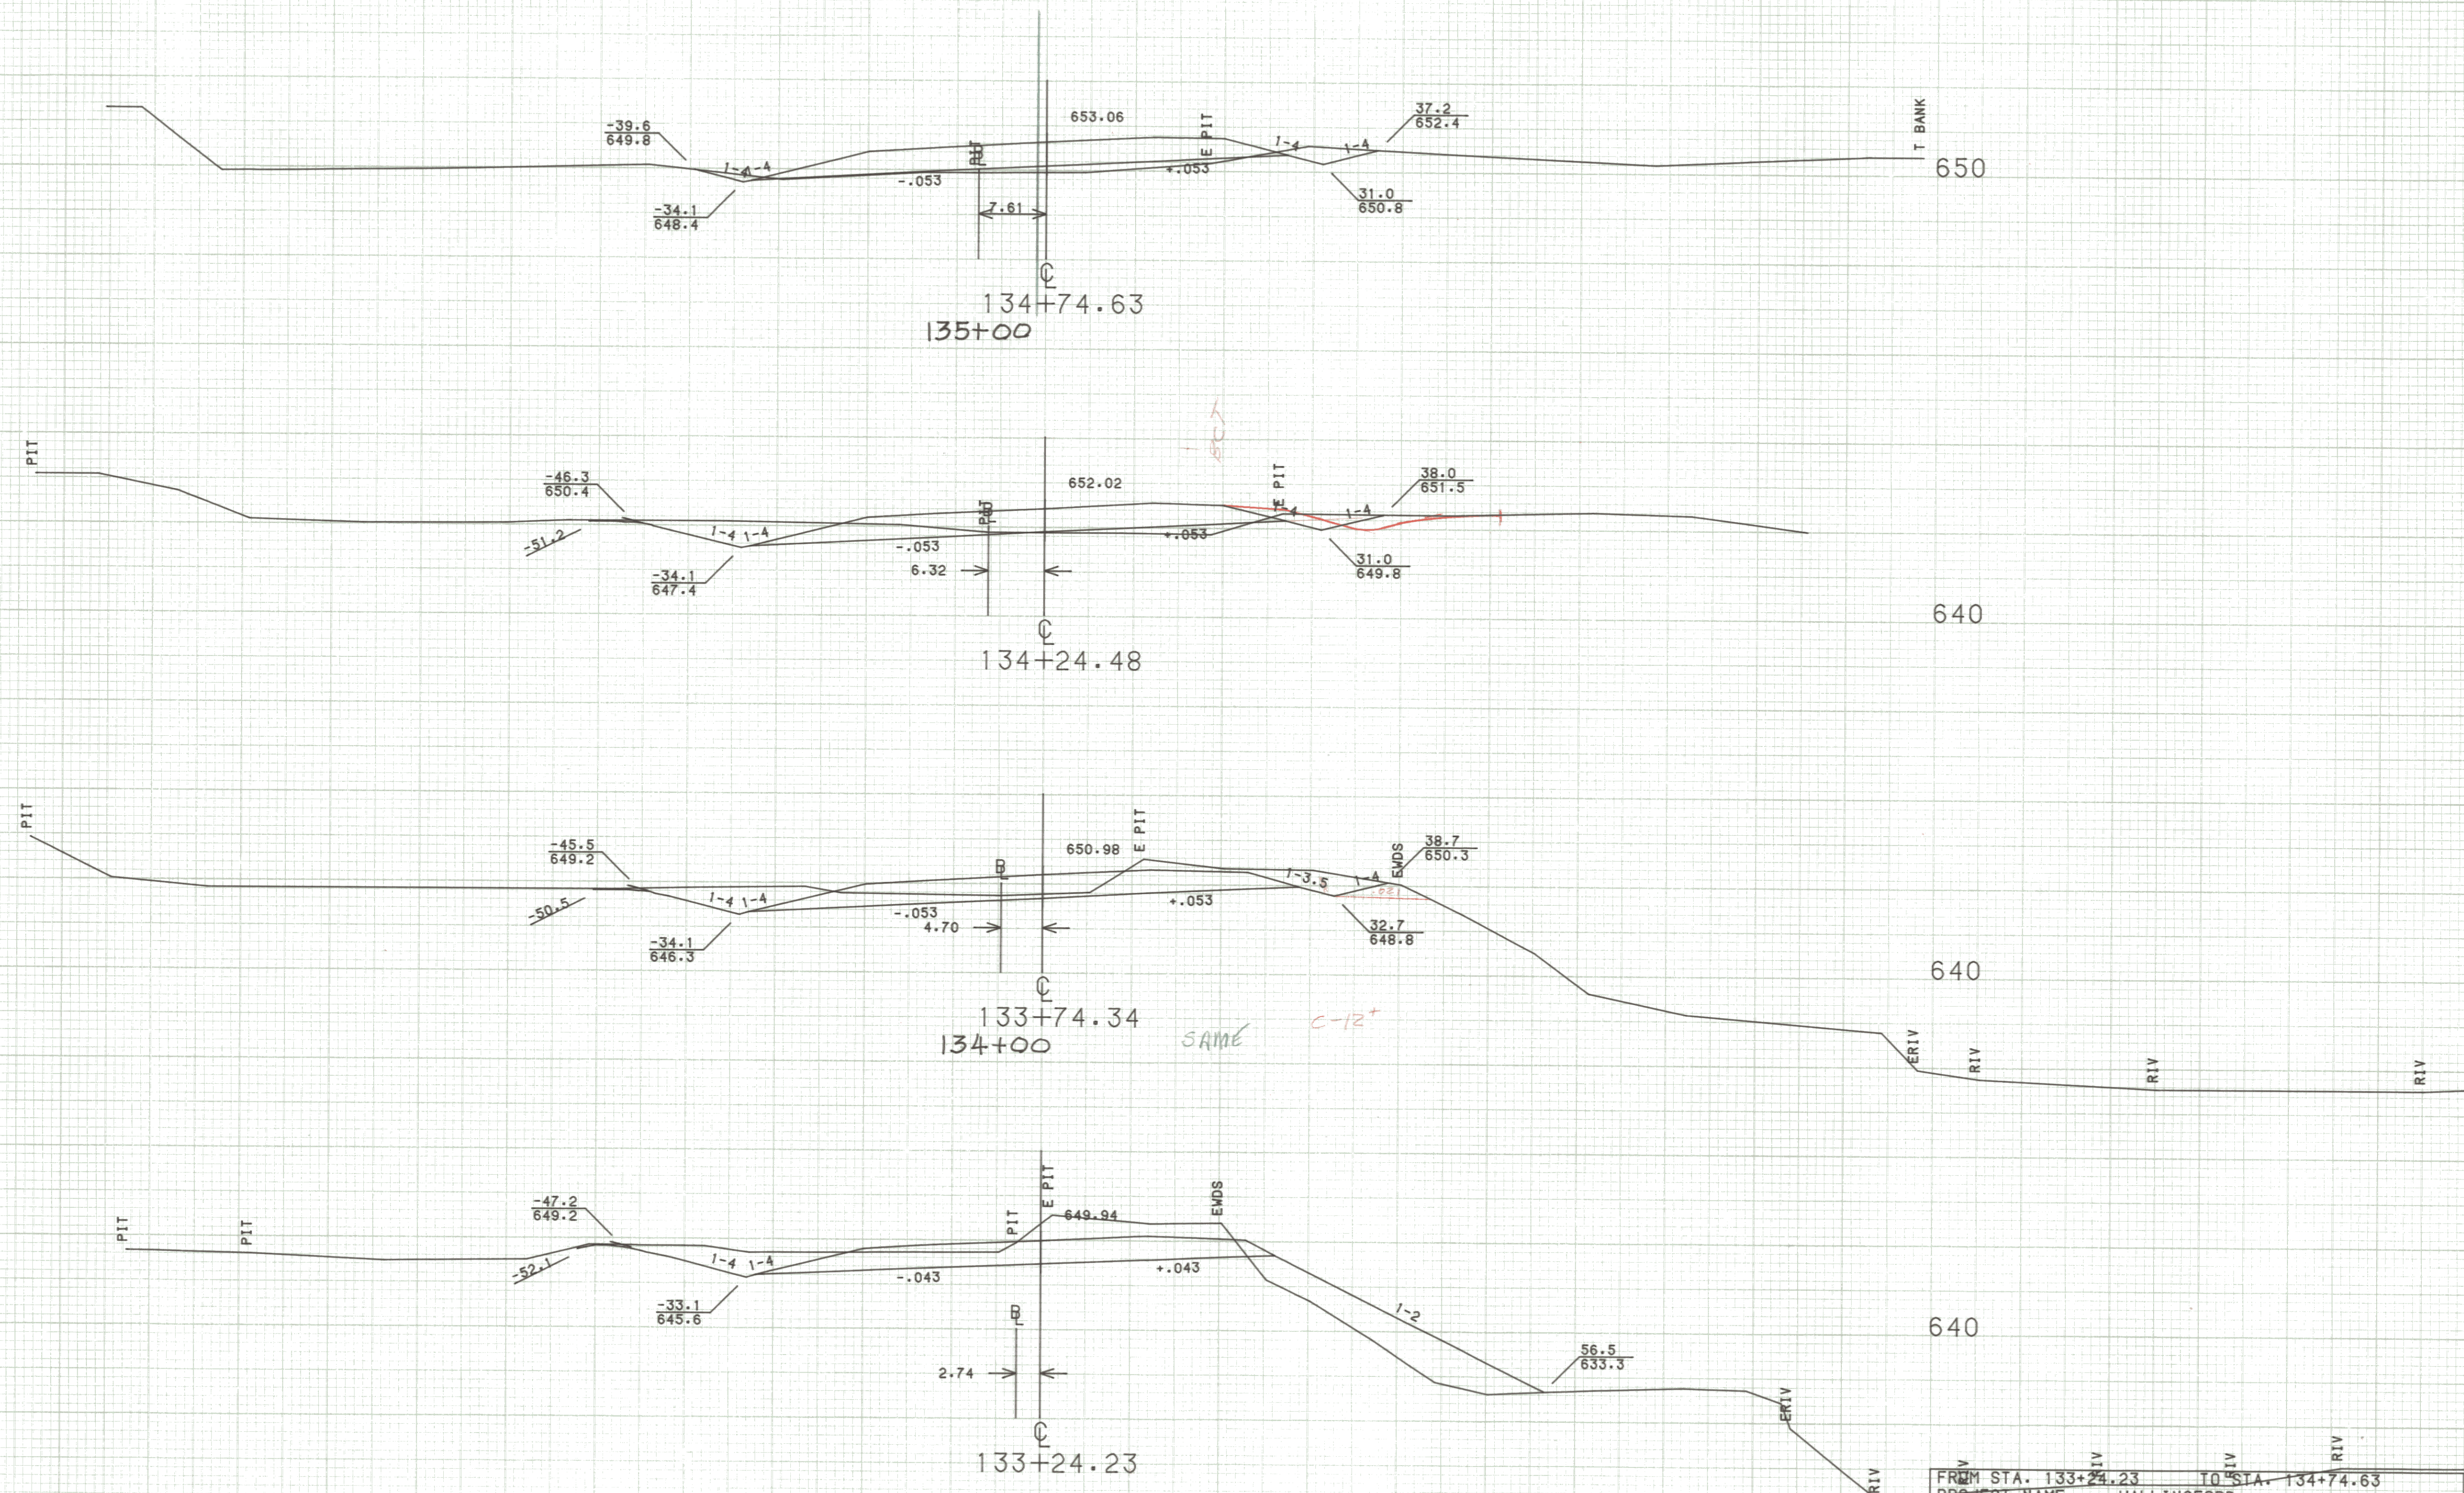

SCALE 1" = 10 FEET

FROM STA. 133+24.23	TO STA. 134+74.63
PROJECT NAME	WALLINGFORD
NO.	RS0137 (5)
SURVEYED BY	FANTONI
SHEET OF	SHEETS
	PLOTTED 11/13/85
	MAY - 85