


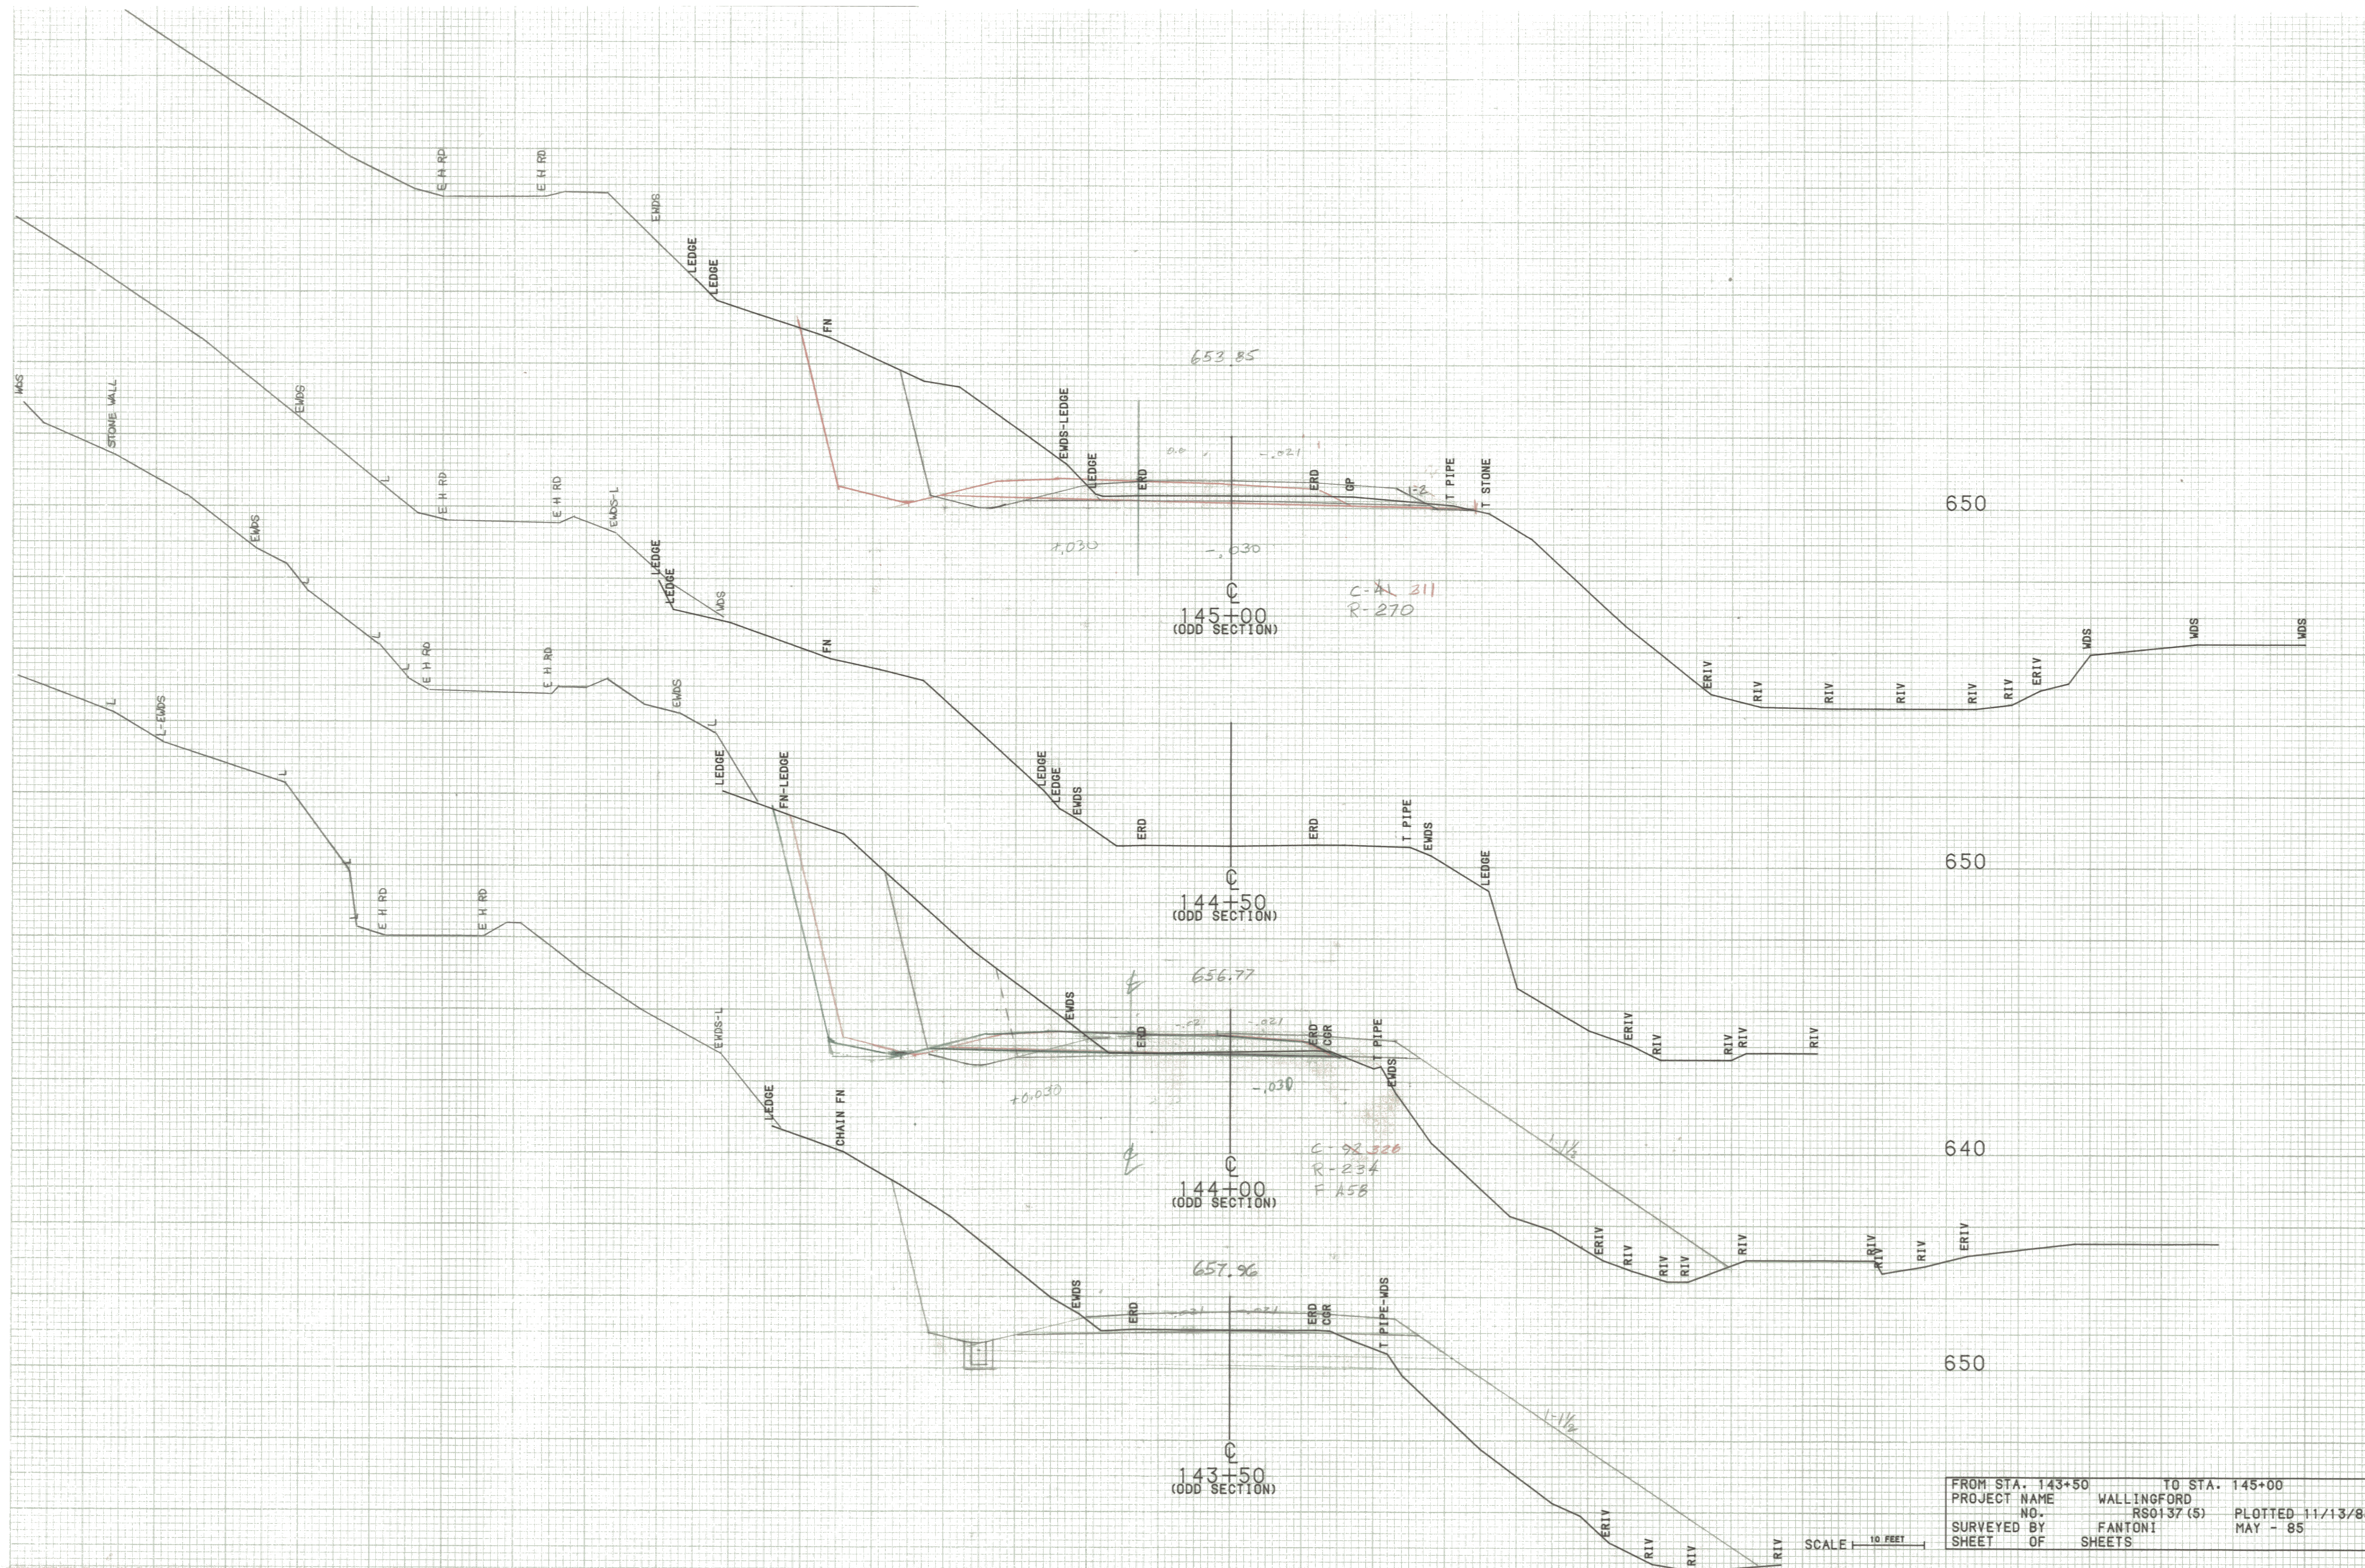

FROM STA. 143+50		TO STA. 145+00	
PROJECT NAME		WALLINGFORD	
NO.		RS0137 (5)	
SURVEYED BY		FANTONI	
SHEET		OF SHEETS	
		PLOTTED 11/13/85	
		MAY - 85	

SCALE 1" = 10 FEET