


PUB. RD. DIV. NO.	STATE	FED. AID PROJ. NO.	FISCAL YEAR	SHEET NO.	TOTAL SHEET
1	VT		19		

SURVEY CURVE DATA #10

$\Delta = 17^{\circ}08'19''$ LT.
D = $2^{\circ}00'00''$
R = 2864.79'
T = 431.69'
L = 856.93'
E = 32.34'

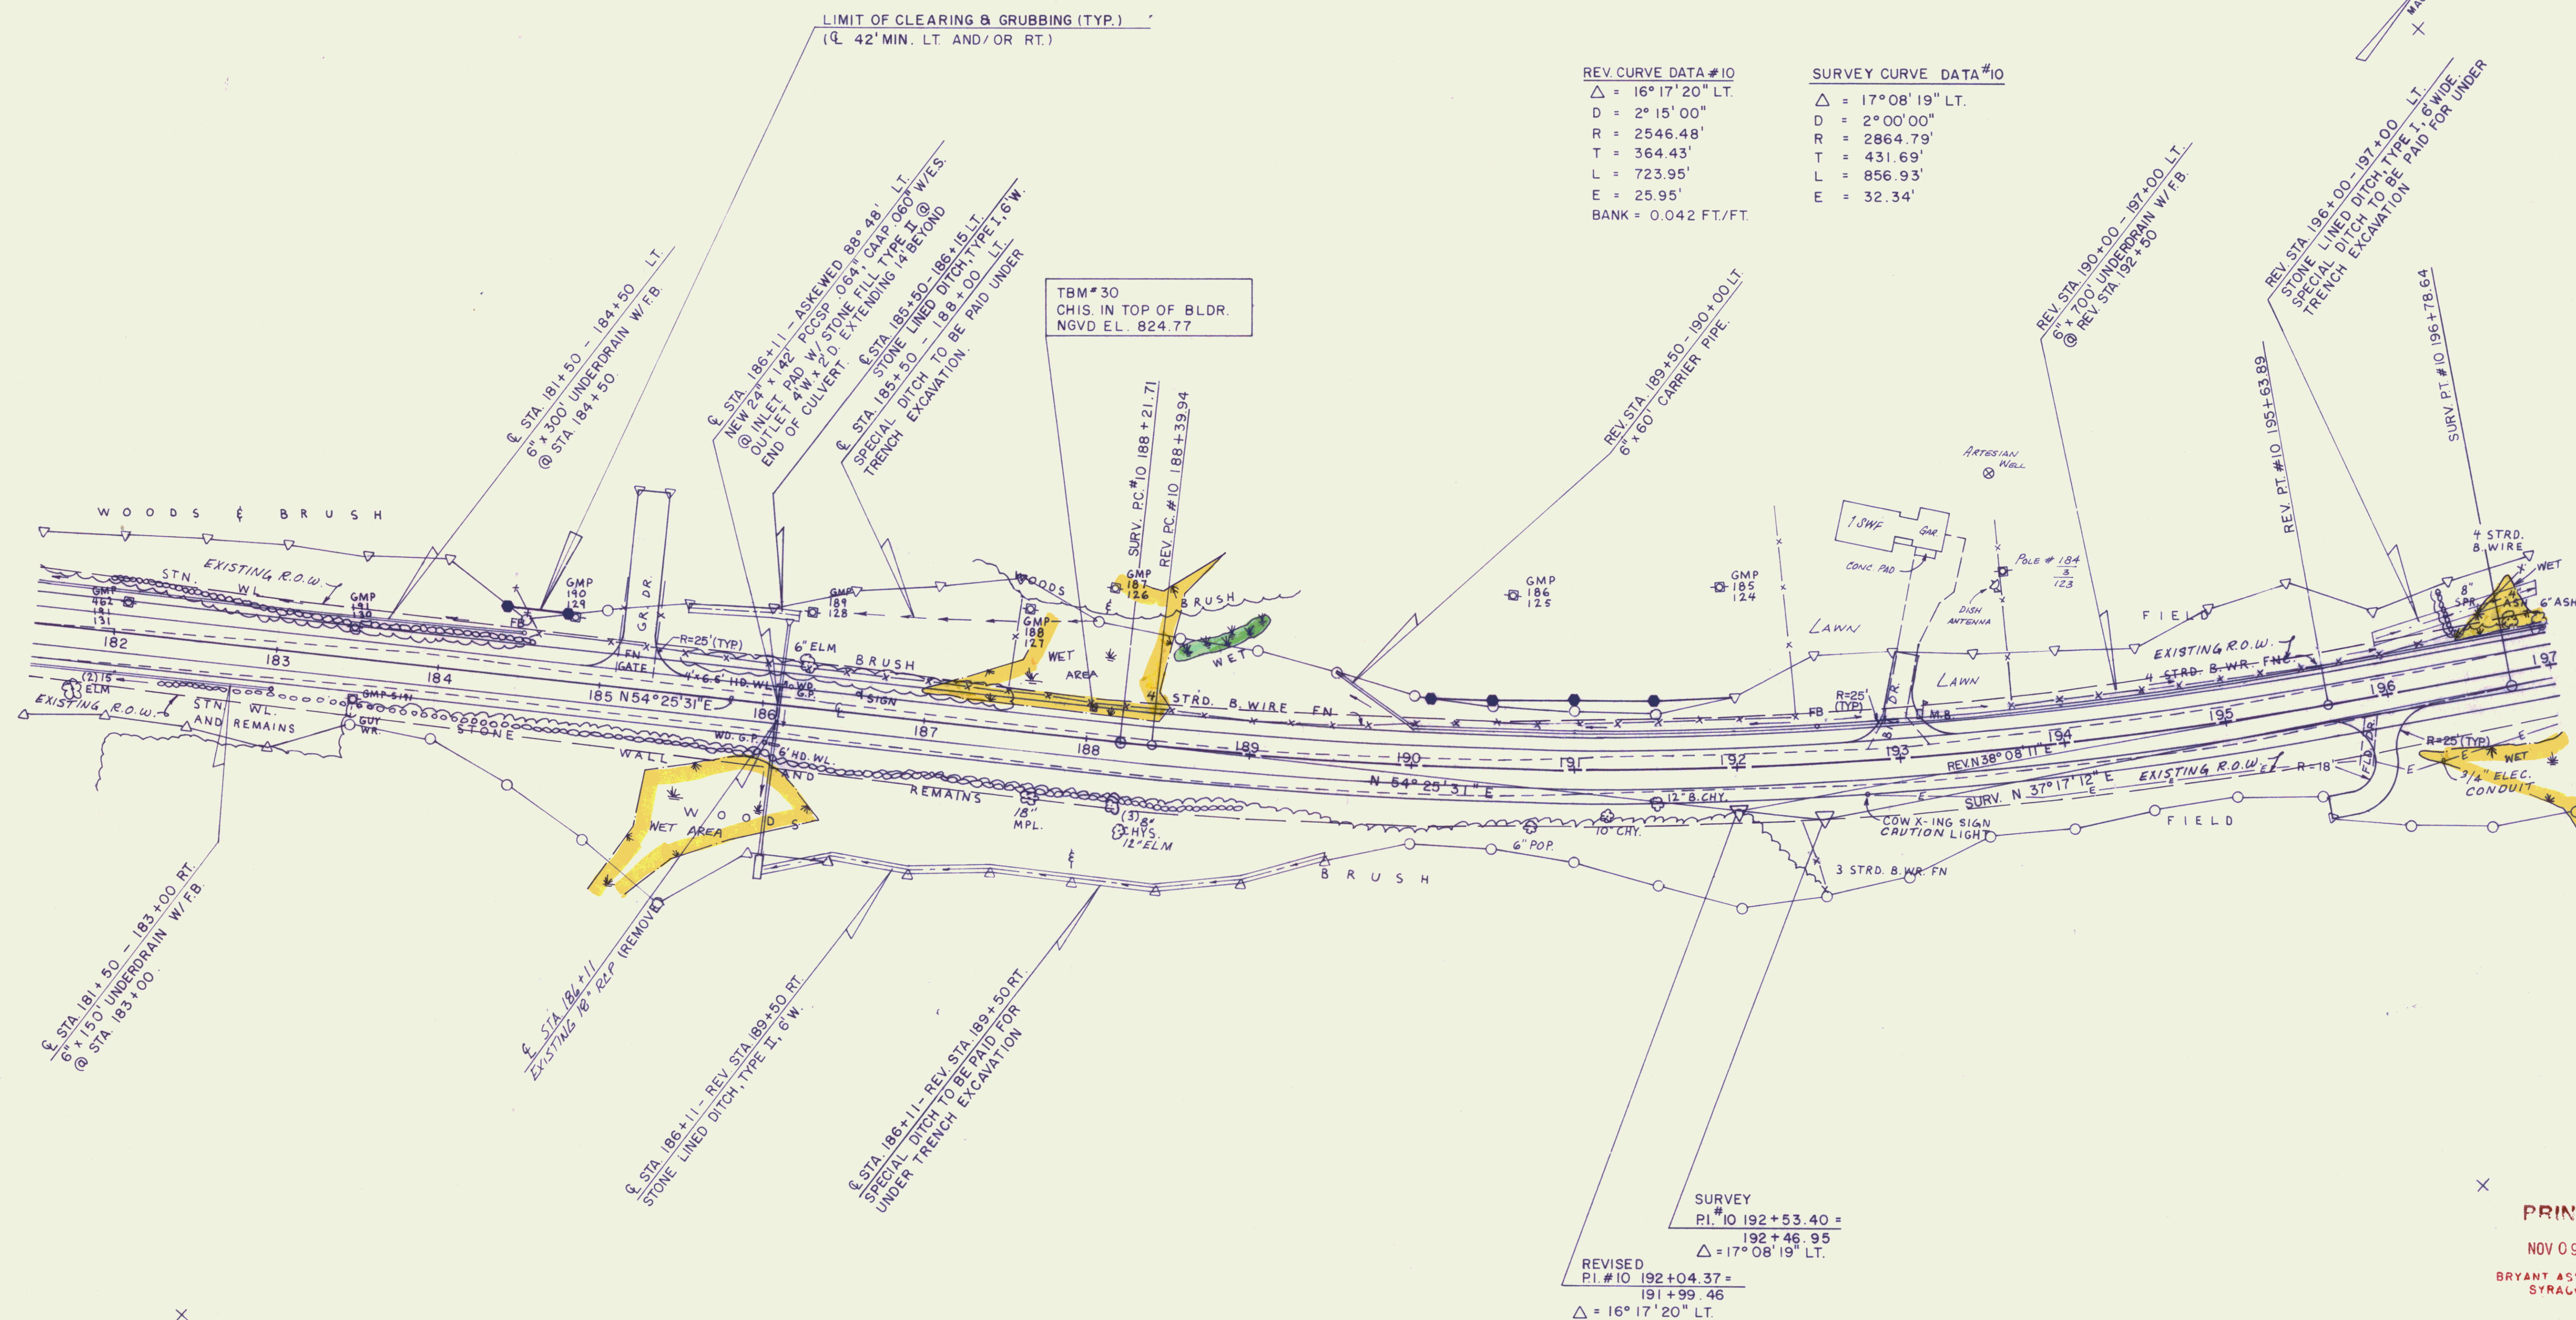

PRINTED
NOV 09 1992
RYANT ASSOCIATES, P.C.
SYRACUSE

VT. SURVEY
SURVEYED BY CONSULTANTS DATE 3/87
DRAWN BY BRYANT ASSOC DATE 6/87
TRACED BY _____ DATE _____

U.S. ROUTE 2 - MARSHFIELD

PROJ. NO. FEGC F028 - 3(28)

SHEET 03 OF 352