


$$\begin{aligned} C &= 0 \text{ Sq Ft} \\ F &= 461 \text{ Sq Ft} \\ R &= 0 \text{ Sq Ft} \end{aligned}$$
$$\begin{aligned} C &= 172 \text{ Sq Ft} \\ F &= 411 \text{ Sq Ft} \\ R &= 0 \text{ Sq Ft} \end{aligned}$$

STA. 100+00 STA. 101+00
TOWN MARSHFIELD
PROJECT F NO. 028-3(28)
SHEET 153 OF 352 SHEETS
HORIZ. AND VERT. SCALE
0 10 20
VT. SURVEY
SURVEYED BY: CONSULTANTS DATE 8/86

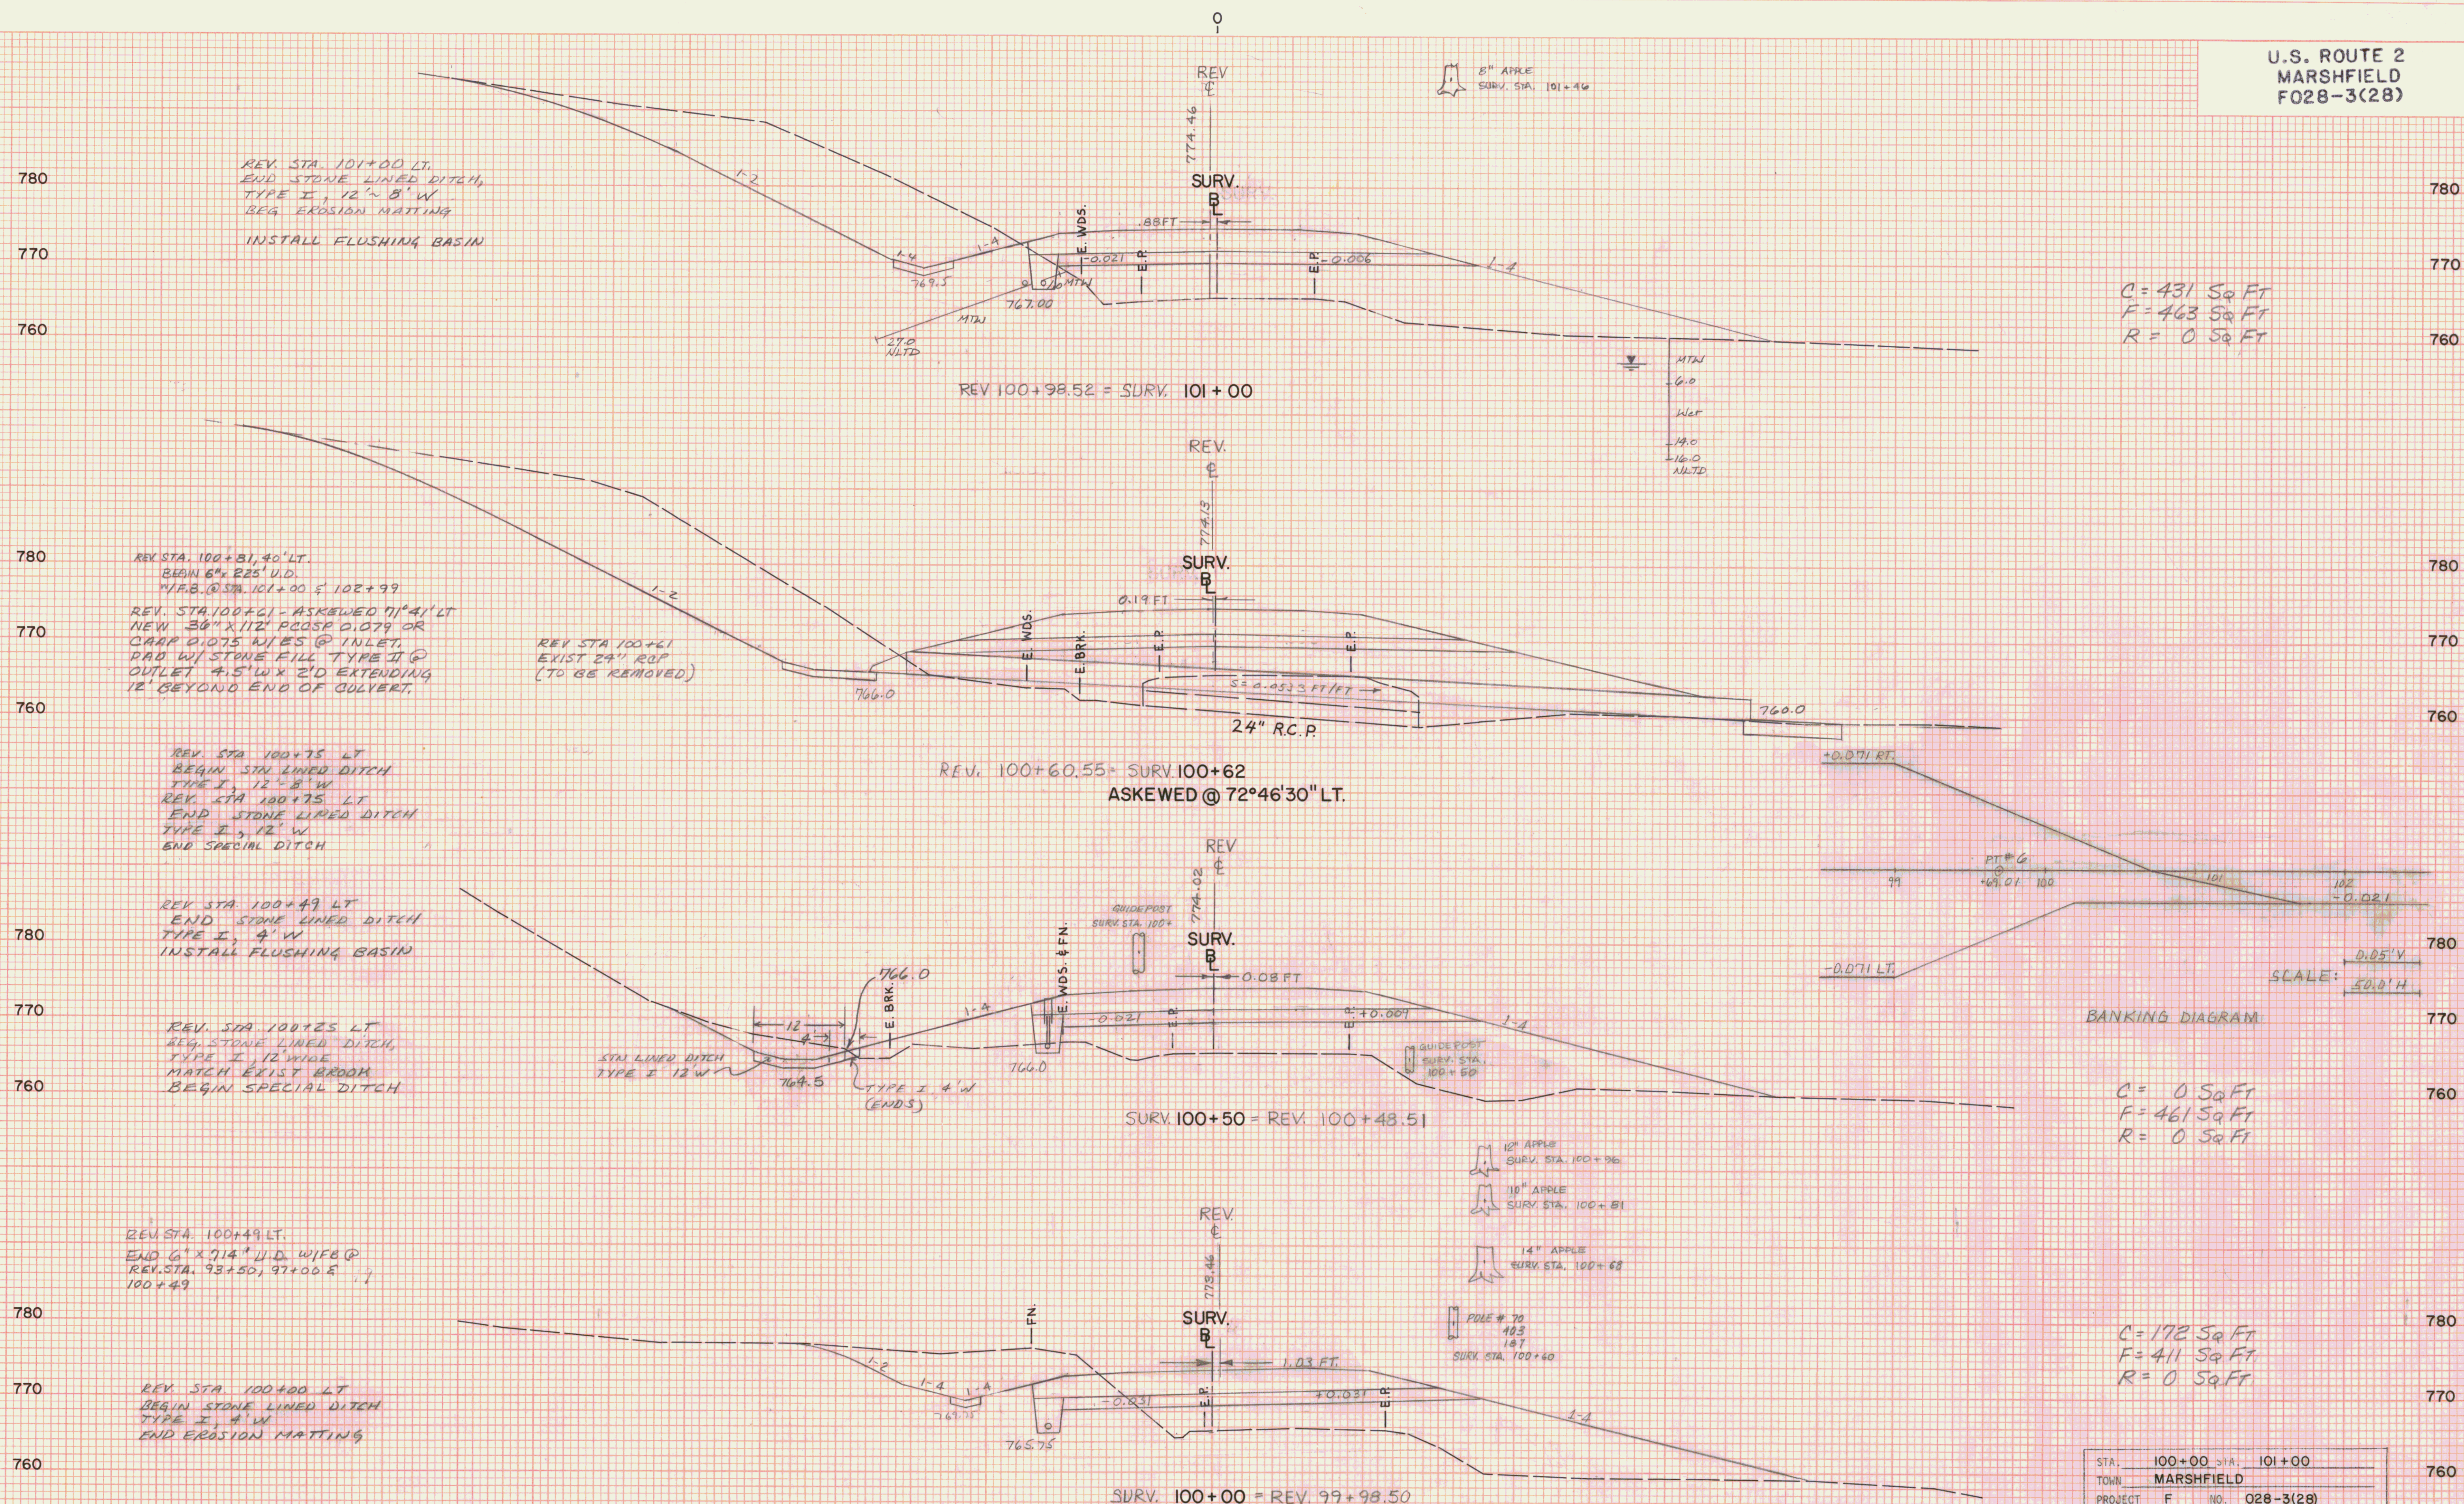

FINAL SURVEY NOTE BOOK No. _____	SURVEYED	BY	DATE
	PLOTTED		
	TEMPLATE		
	AREAS		
	AREAS CHECKED		

ORIGINAL SURVEY	SURVEYED	BY	DATE
	PLOTTED	VT. SURVEY CONSUL.	8/86
	TEMPLATE	BRYANT ASSOC.	9/86
	AREAS		
	AREAS CHECKED		
NOTE BOOK			
10.			