


FINAL SURVEY	DATE	
	BY	
	REVIEWED	
	PLOTTED	
NOTE BOOK	NO.	
	DATE	
	BY	
	REVIEWED	
NO.	DATE	
	BY	
	REVIEWED	
	PLOTTED	

ORIGINAL SURVEY	DATE	
	BY	
	REVIEWED	
	PLOTTED	
NOTE BOOK	NO.	
	DATE	
	BY	
	REVIEWED	
NO.	DATE	
	BY	
	REVIEWED	
	PLOTTED	

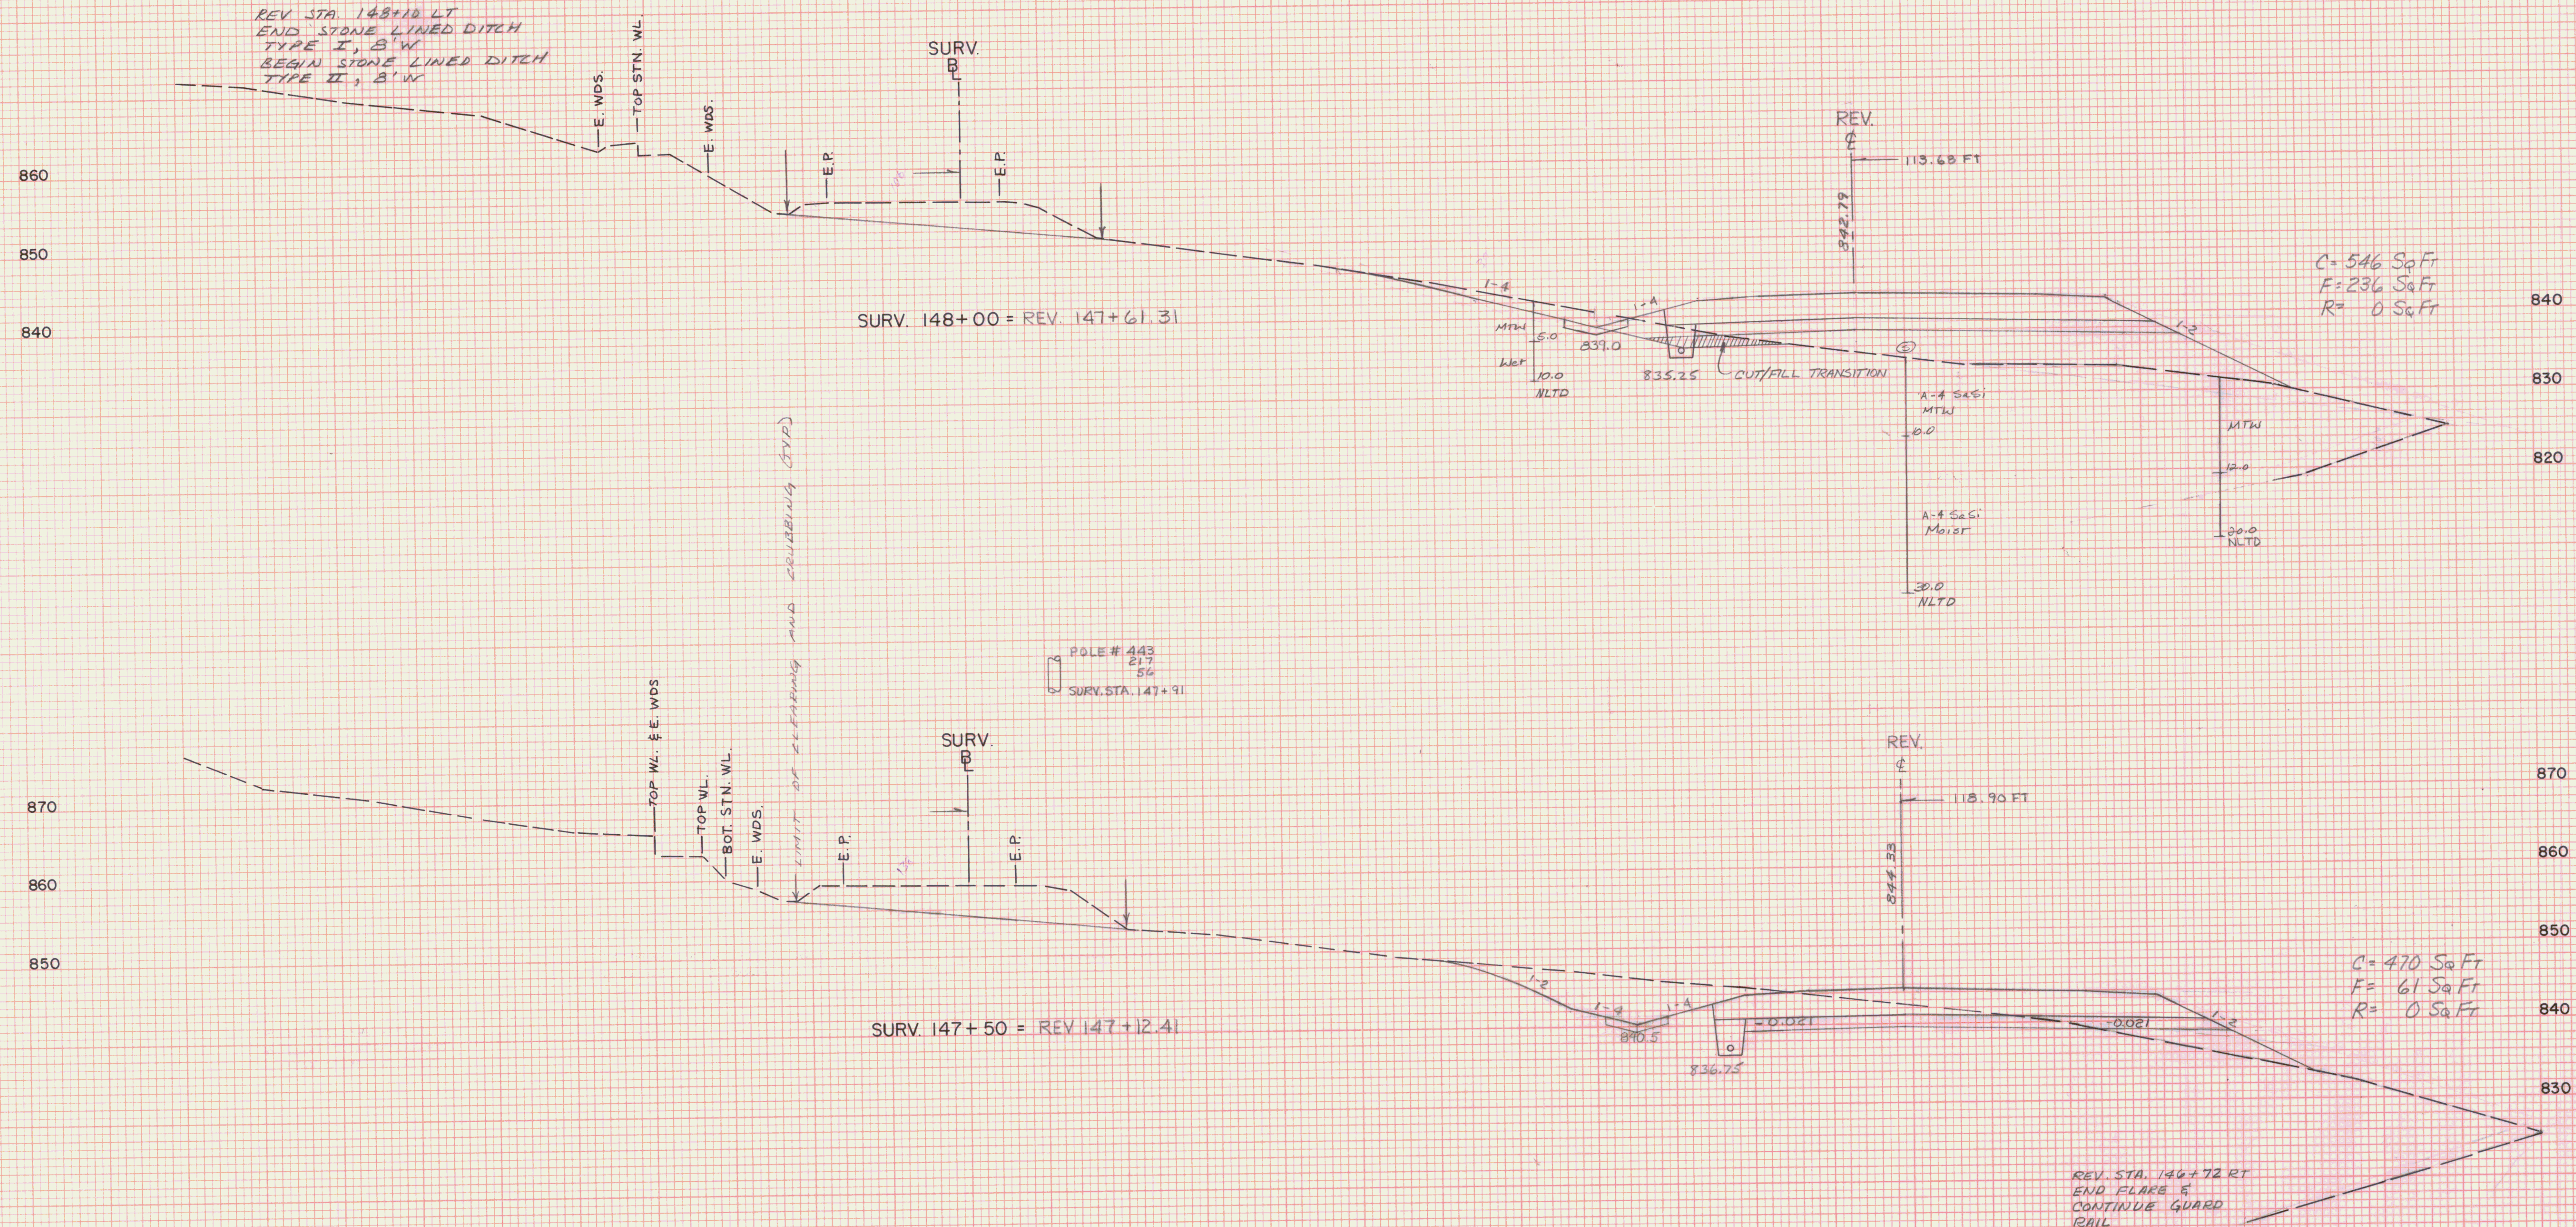

STA. 147+50	STA. 148+00
TOWN MARSHFIELD	
PROJECT F	NO. 028-3(28)
SHEET 191	OF 352 SHEETS
HORIZ. AND VERT. SCALE	
0 10 20	
VT. SURVEY	
SURVEYED BY: CONSULTANTS	DATE 10/86