


DATE	
BY	
SURVEYED	
NOTED	
TEMPERATURE	
WIND	
MOON	
NO.	

DATE	10/86
BY	VT SURVEY CONSULT.
SURVEYED	
NOTED	
TEMPERATURE	
WIND	
MOON	
NO.	

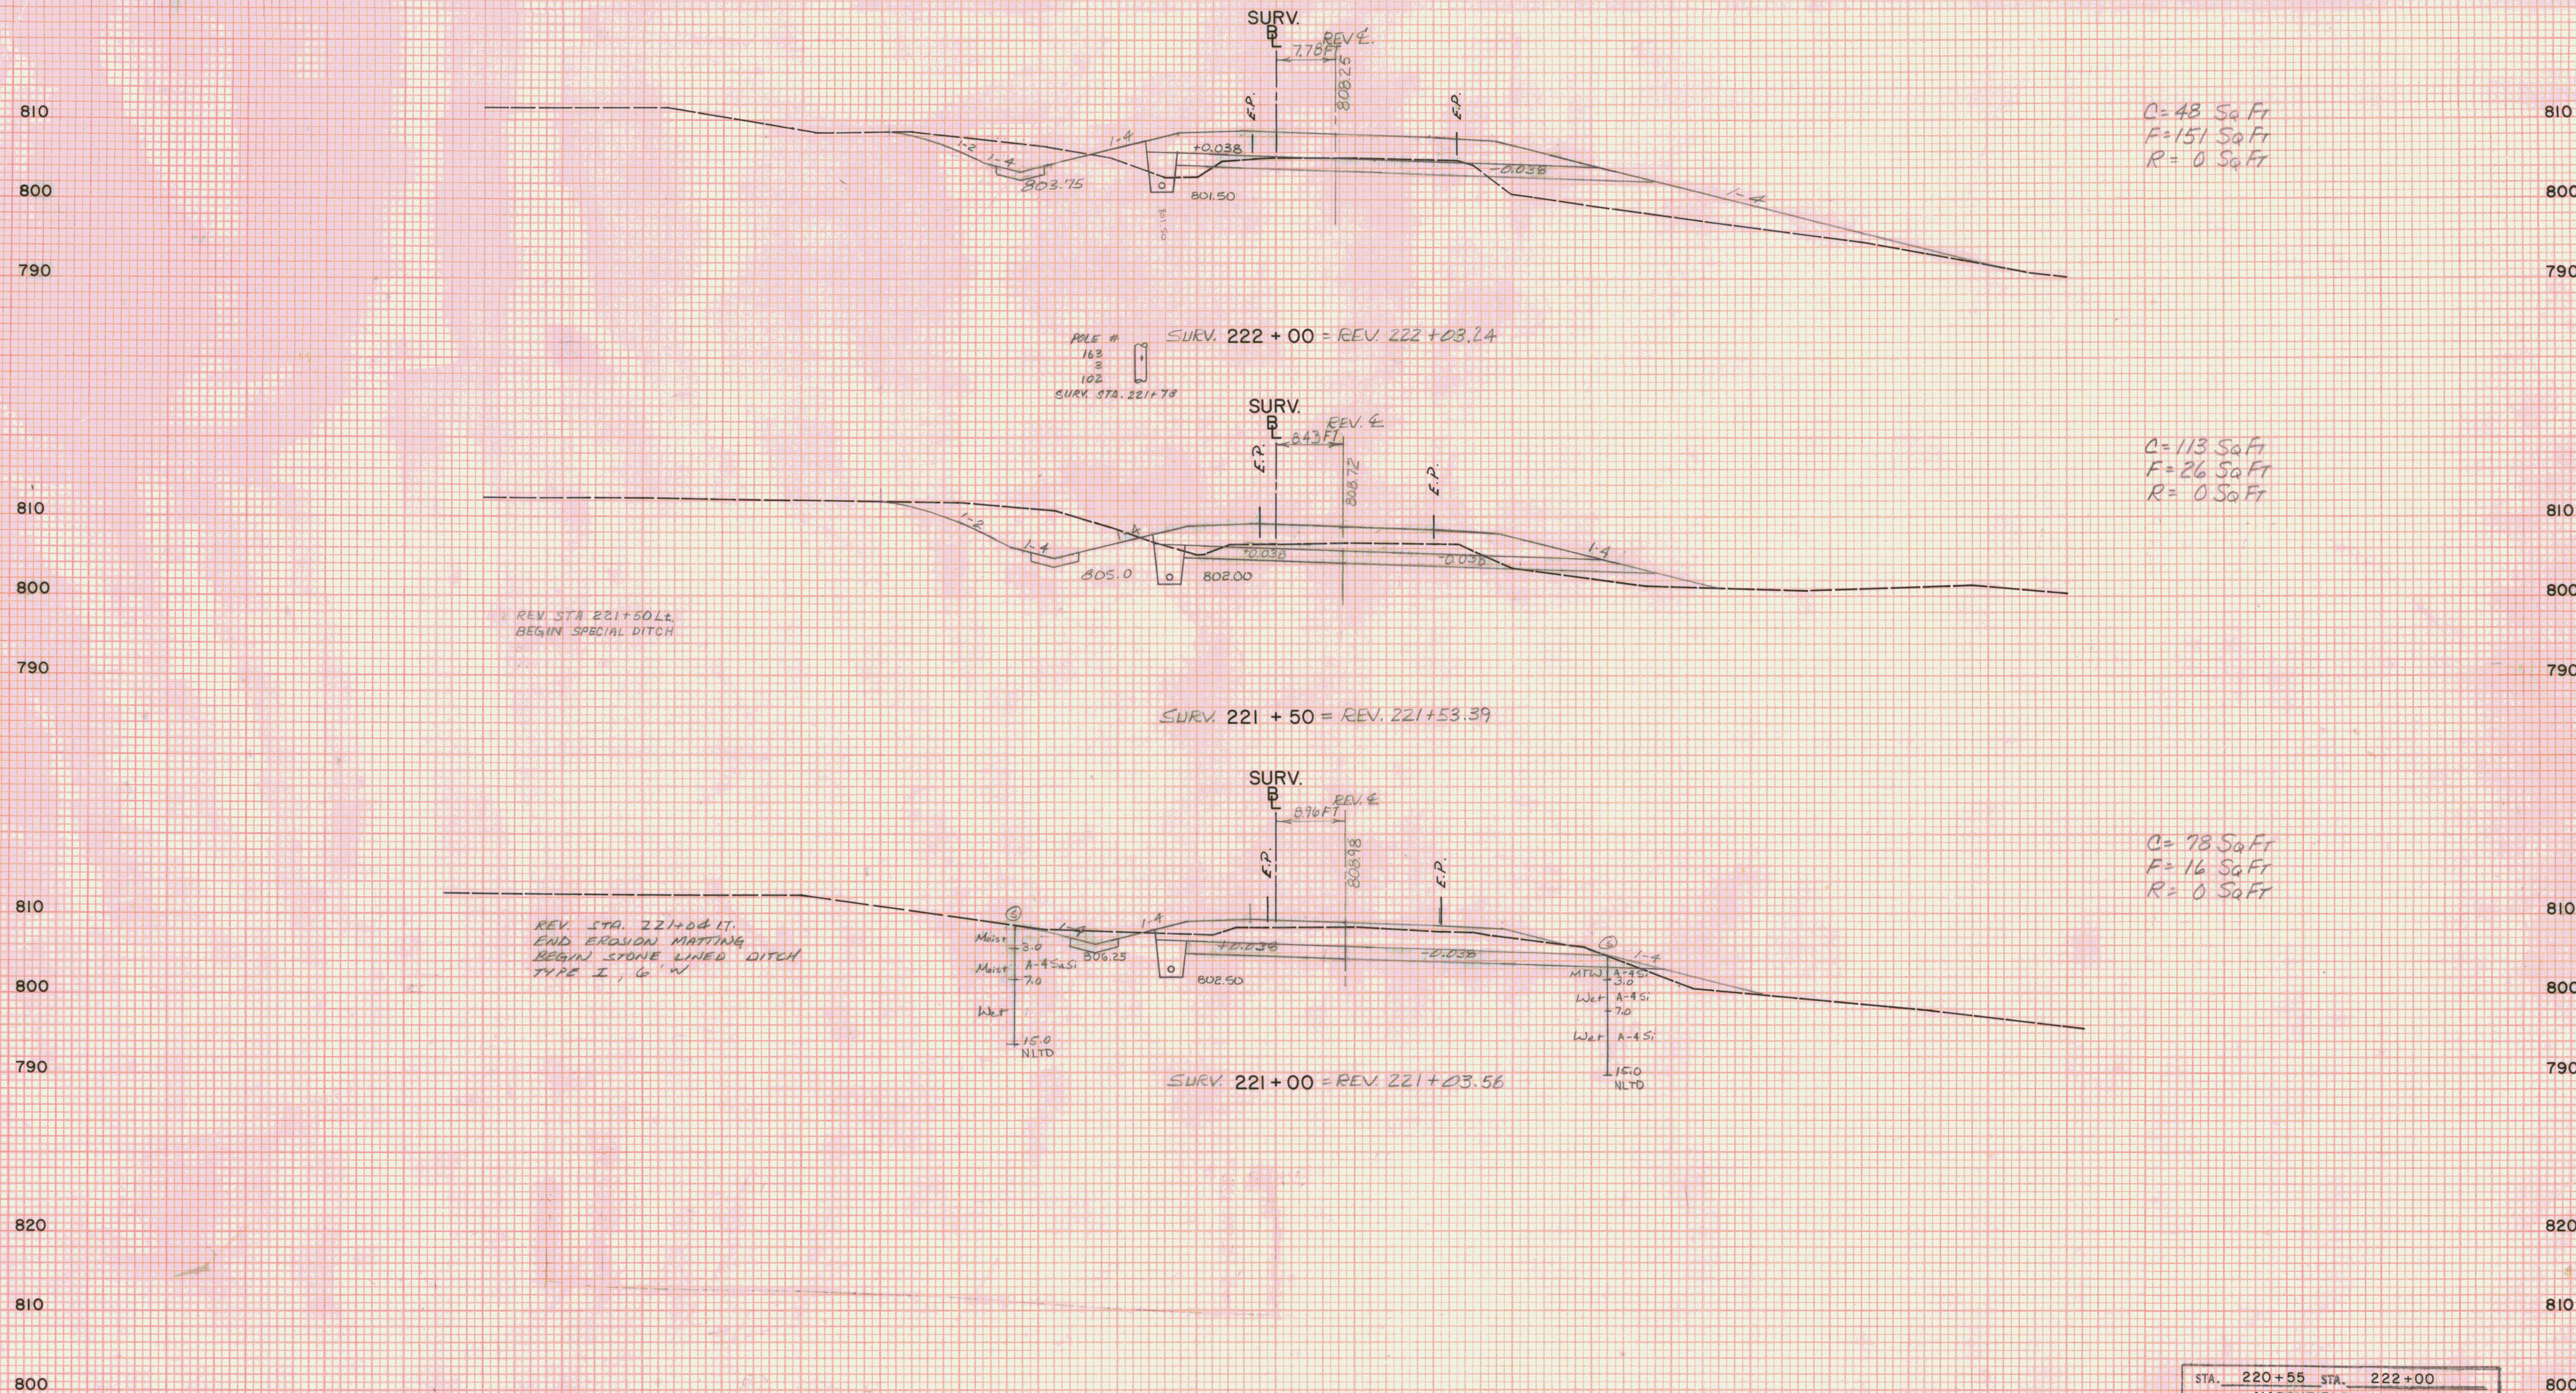

STA.	220+55	STA.	222+00
TOWN	MARSHFIELD		
PROJECT	F	NO.	028-3(28)
SHEET	246	OF	1352
HORIZ. AND VERT. SCALE			
0 10 20			
VT. SURVEY			
SURVEYED BY: CONSULTANTS DATE 10/86			