


DATE	BY	SURVEYED	NOTED	AREA	CHECKED
FINAL SURVEY NOTE BOOK NO.					

DATE	BY	SURVEYED	NOTED	AREA	CHECKED
ORIGINAL SURVEY NOTE BOOK NO.					

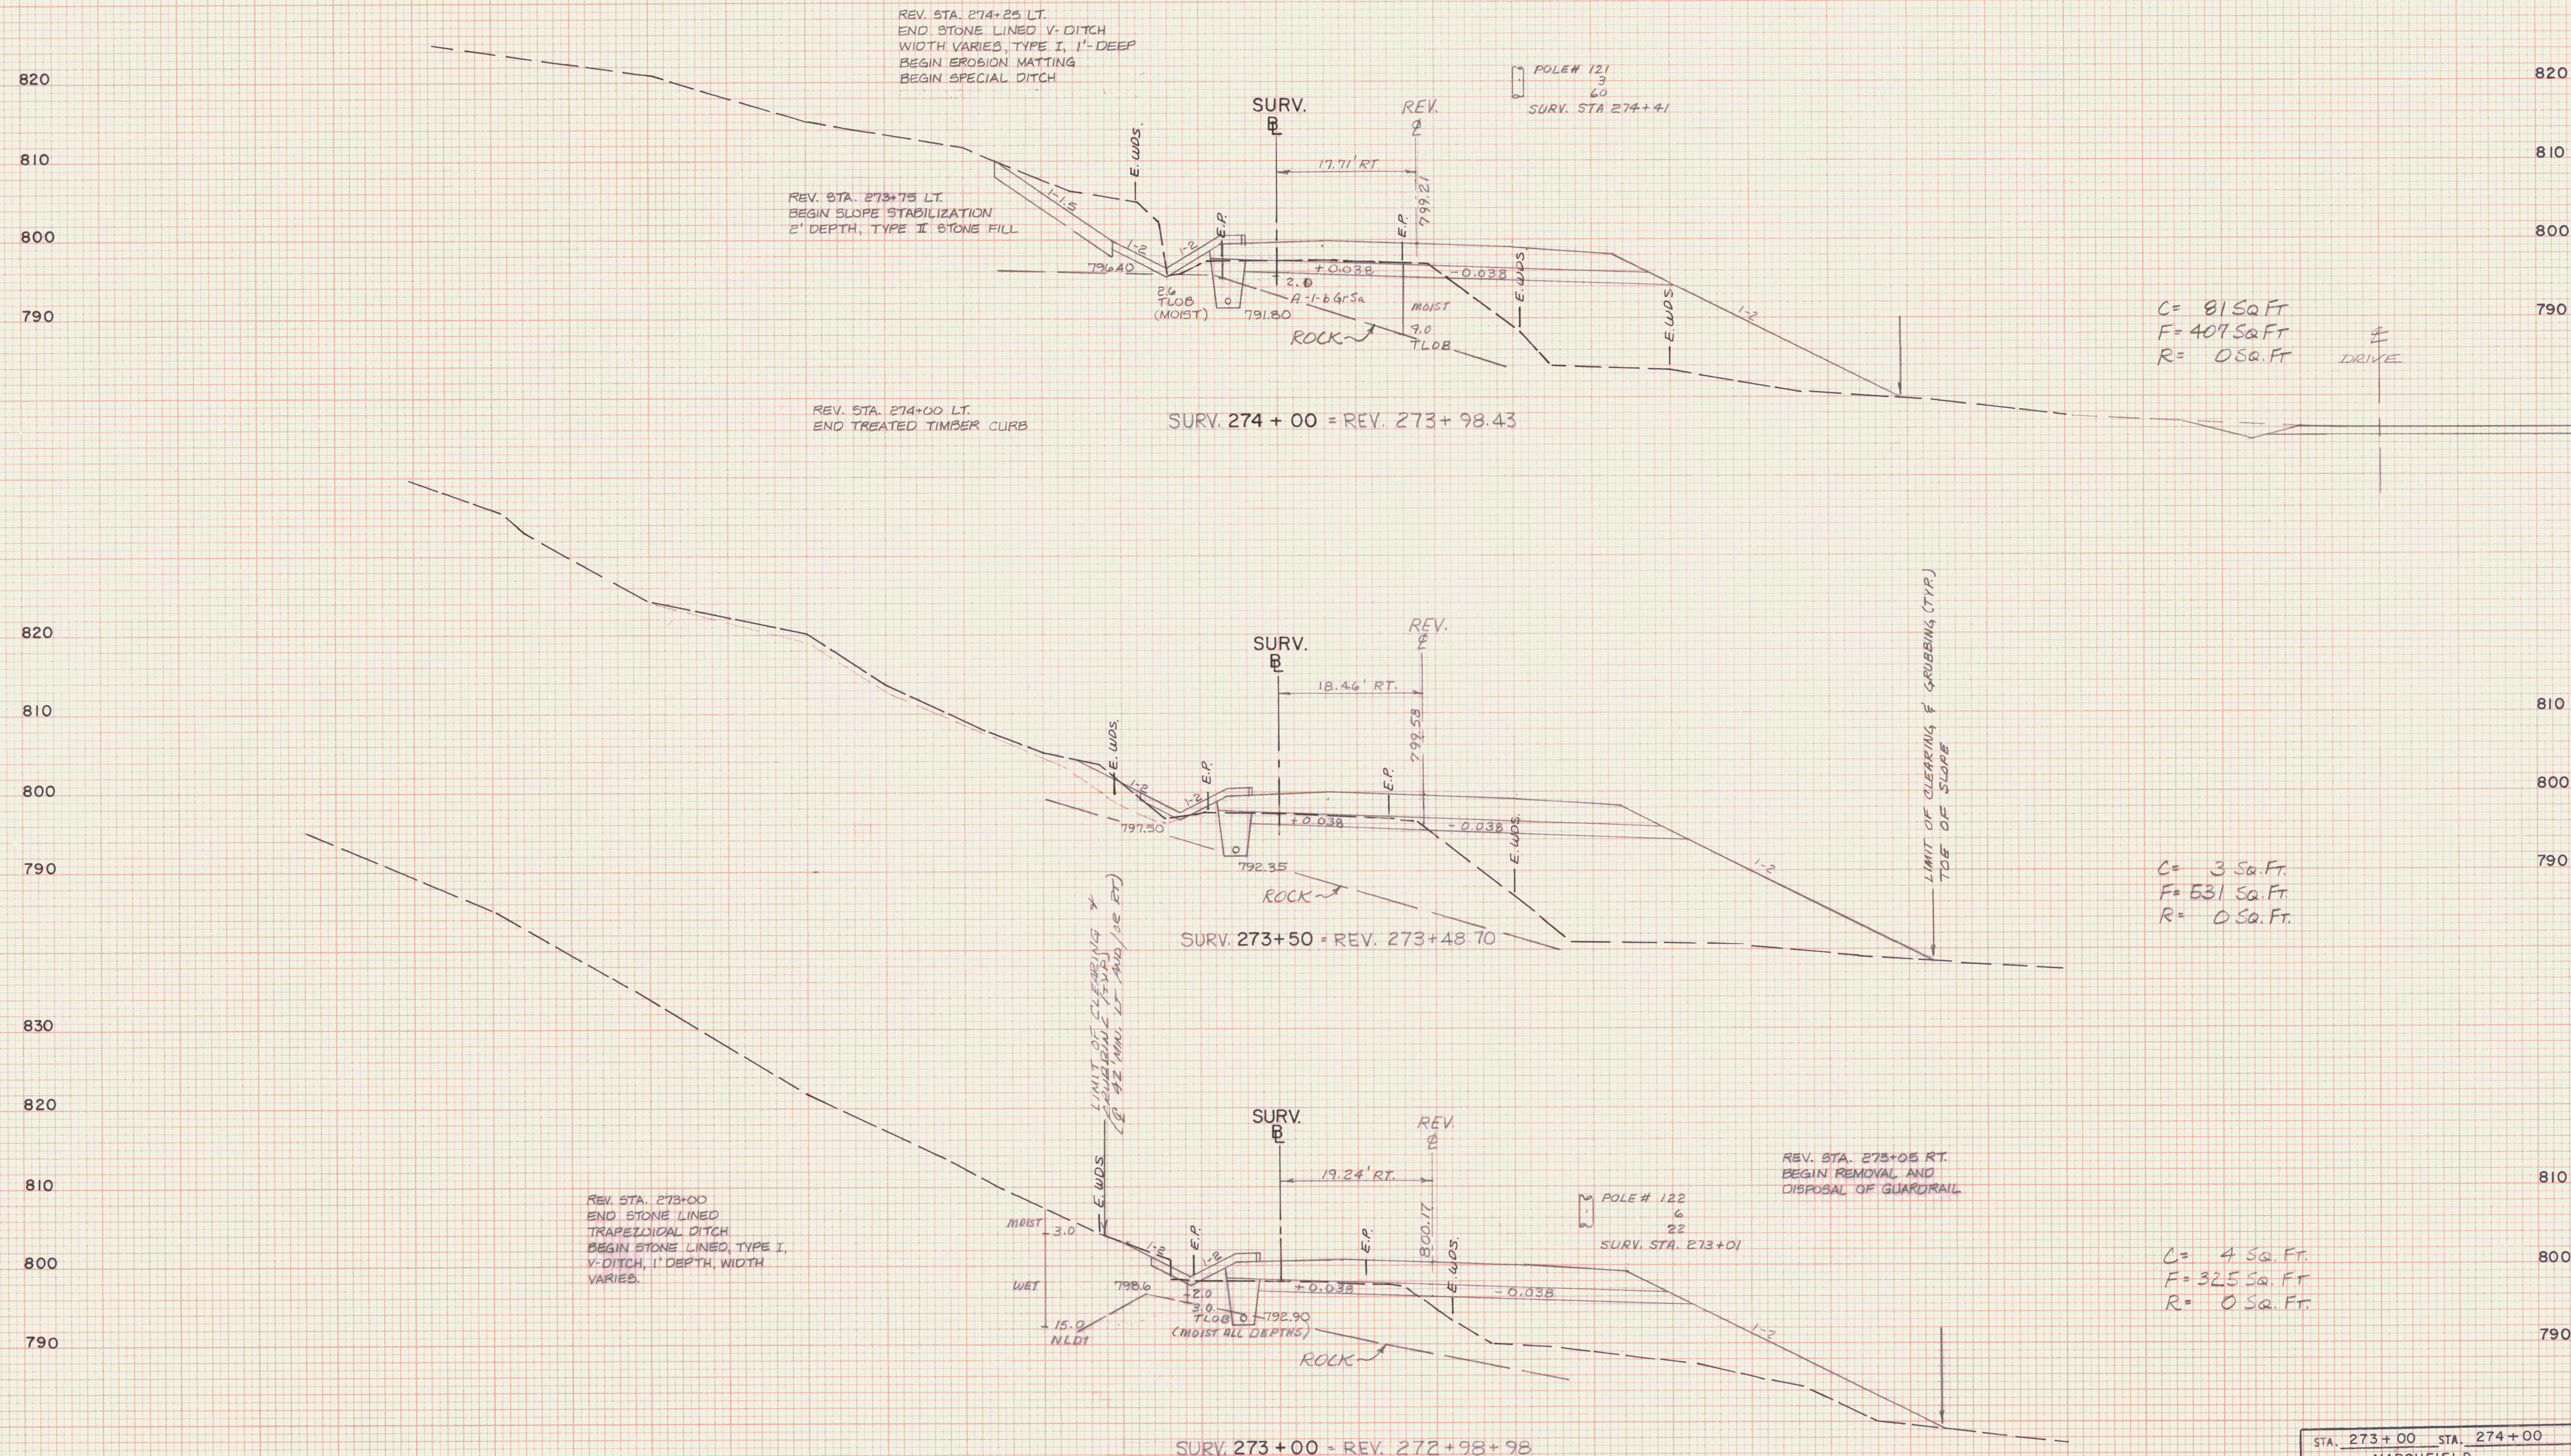

STA. 273+00	STA. 274+00
TOWN MARSHFIELD	
PROJECT F	NO. 028-3(28)
SHEET 288	OF 382 SHEETS
HORIZ. AND VER. SCALE 0 10 20	
VT. SURVEY SURVEYED BY: CONSULTANTS DATE	