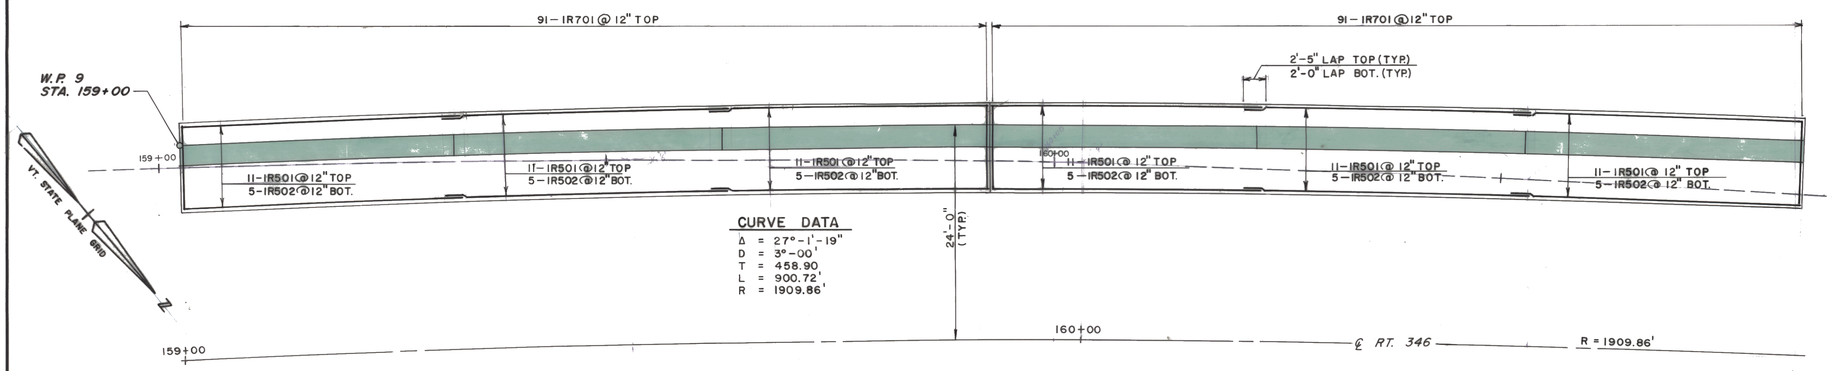

CURVE DATA

Δ = 27°-1'-19"
D = 3°-00'
T = 458.90'
L = 900.72'
R = 1909.86'

FOOTING REINFORCING PLAN

SCALE: 1/8" = 1'-0"

MATCH LINE STA. 160+80
SEE SHT. 158

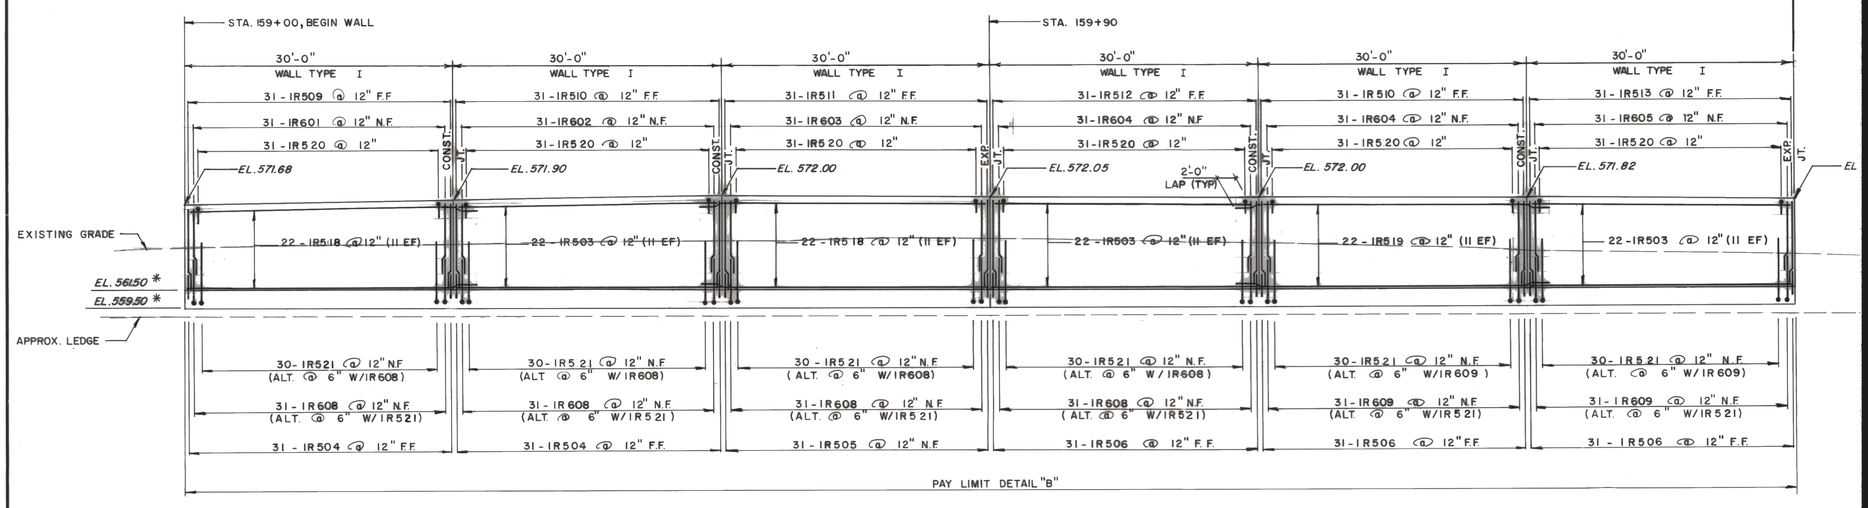

ELEVATION (VIEW FACING SOUTH)

SCALE: 1/8" = 1'-0"

*ELEVATIONS GIVEN HERE ARE AT THE TOP AND BOTTOM OF FOOTING (TYP.)

NOTES

1. FOR WALL TYPE SECTIONS, SEE SHT. 158
2. FOR PAY LIMIT DETAILS, SEE SHT. 157 & 159
3. FOR EXPANSION AND CONTRACTION JOINT DETAILS, SEE SHT. 154.
4. FOR BORING LOCATIONS & BORING LOGS, SEE SHTS. 168 & 169
5. FOR TYPICAL WEEPHOLE LOCATION, SEE SHT. 158
6. HORIZONTAL DIMENSIONS ON PLAN VIEW ARE GIVEN RADIAL TO ℄ RT. 346.
7. HORIZONTAL DIMENSIONS ON ELEVATION VIEW ARE GIVEN ALONG TOP OF WALL AND ARE CONCENTRIC WITH ℄ RT. 346
8. N.F. = NEAR FACE
   F.F. = FAR FACE
   E.F. = EACH FACE

PARE ENGINEE
Engineers – Plann
8 Blackstone Valley
401/334/4100

BRUNING 44-232 64442