


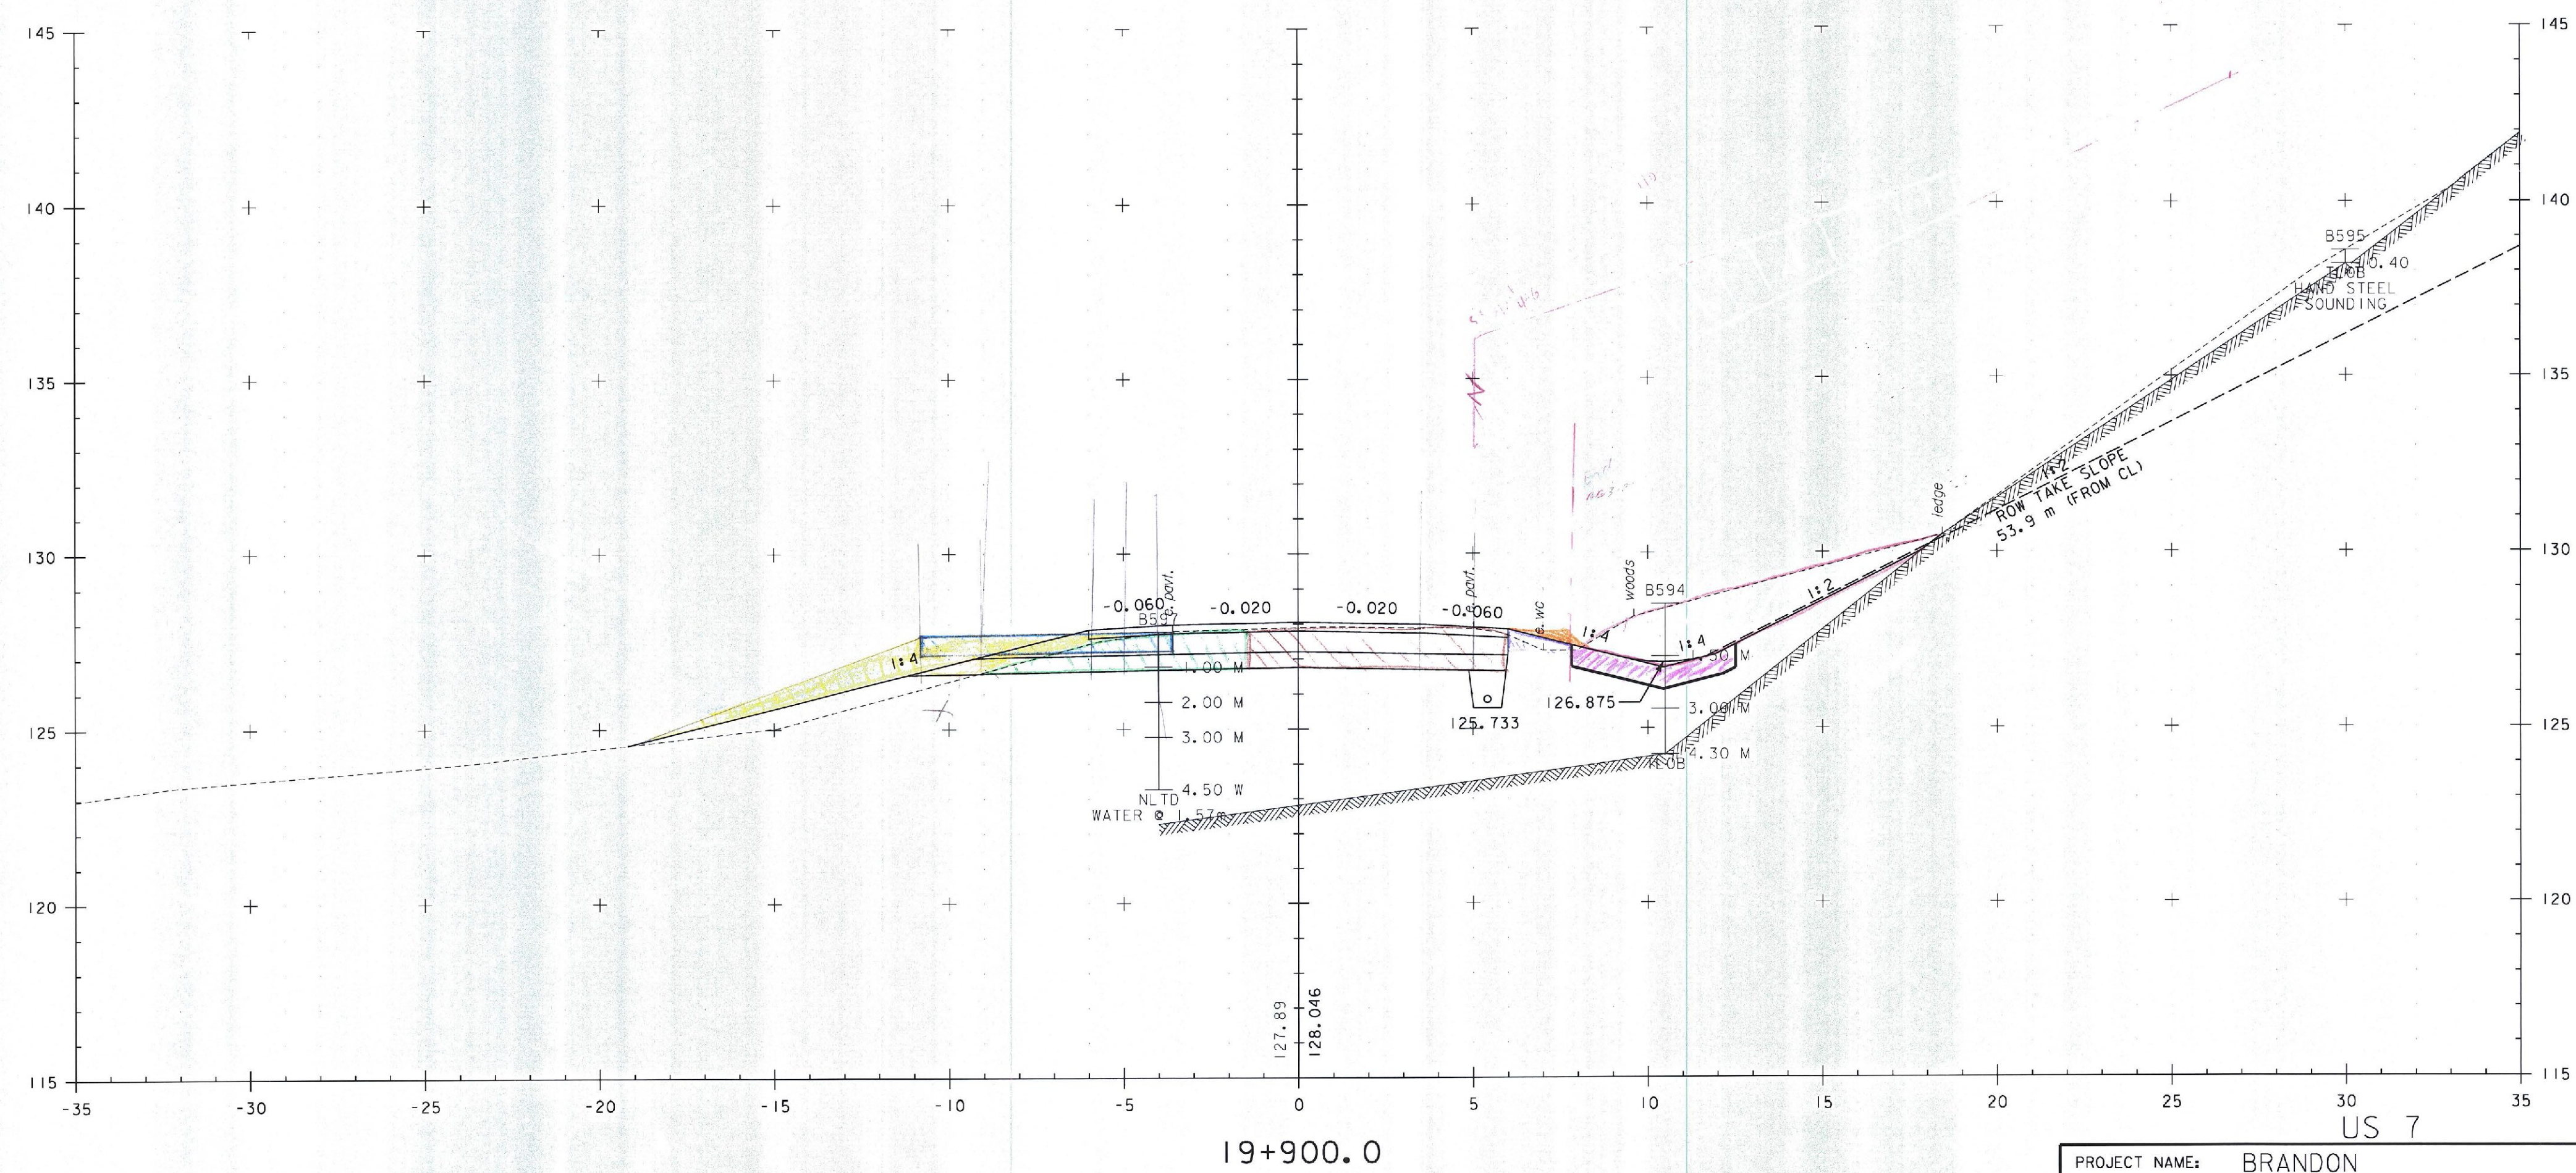

PROJECT NAME: BRANDON	FILE NAME: zb008s5-xs226.dgn	PLOT DATE: 9/3/2009
PROJECT NUMBER: NH 019-3(495)	PROJECT LEADER: CRB	DRAWN BY: NLL
	DESIGNED BY: PTS	CHECKED BY: DAM
	CLD 02-0149	SHEET 497 OF 546