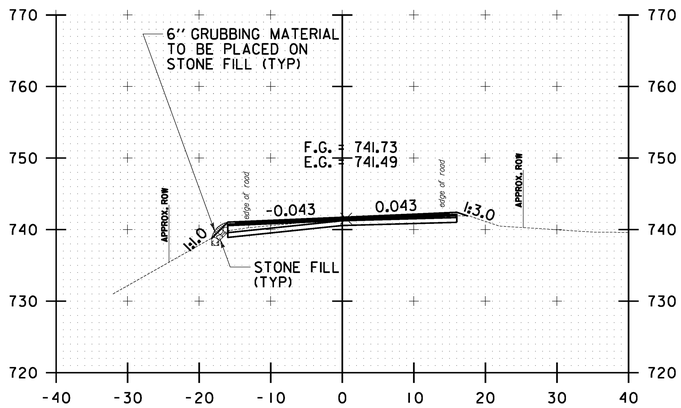

88+50.00

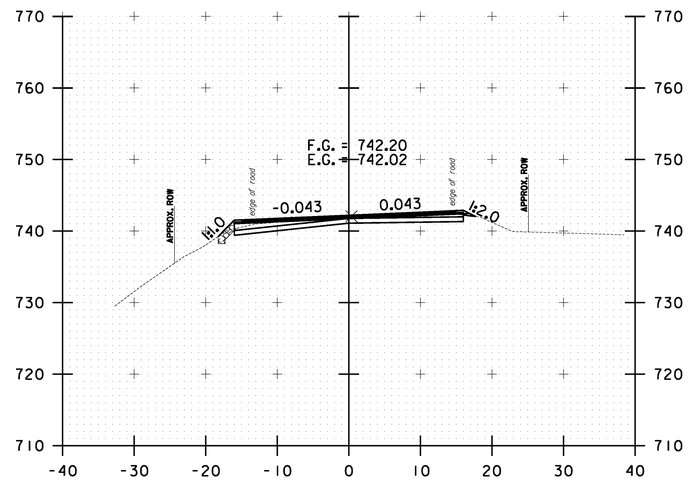

89+50.00

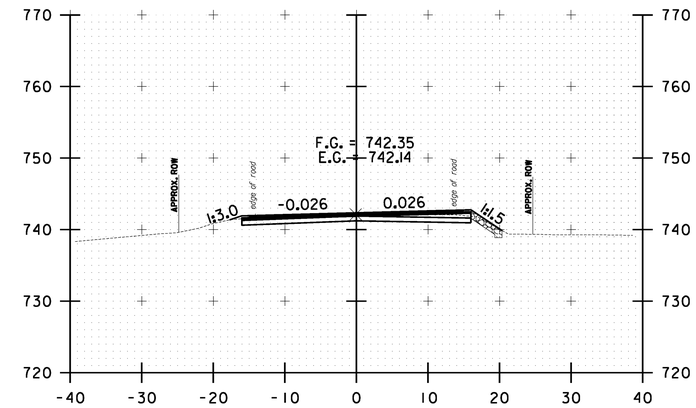

90+50.00

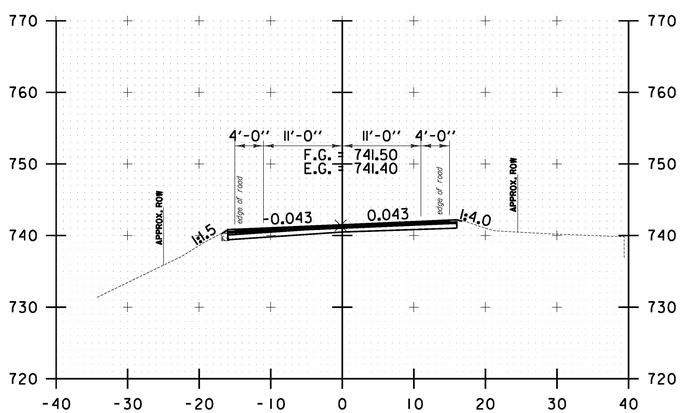

88+00.00

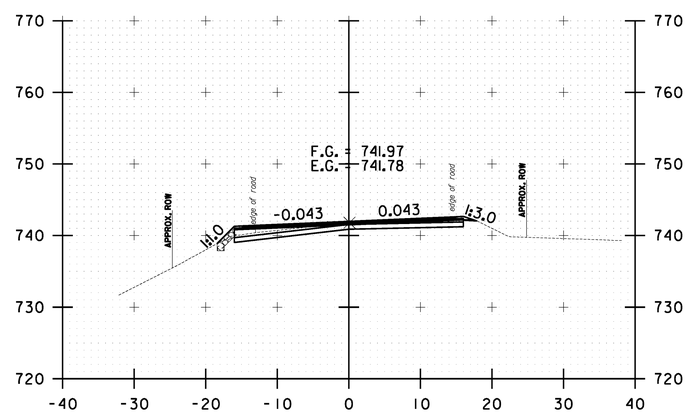

89+00.00

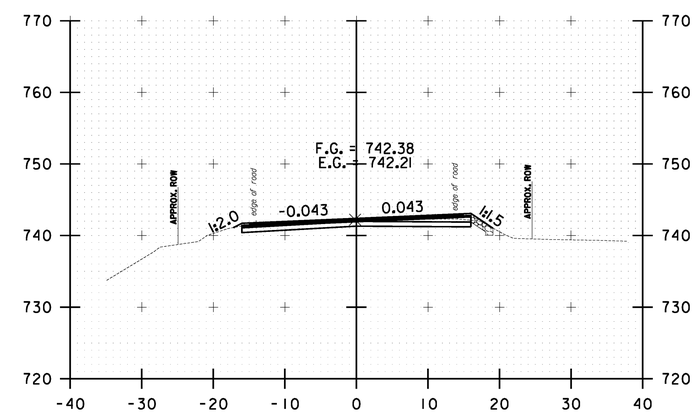

90+00.00

10 0 10
SCALE IN FEET

WAITSFIELD CROSS SECTION SHEET #28

PROJECT NAME: WARREN-WAITSFIELD

PROJECT NUMBER: STP 2506(1)

FILE NAME: p05b048.dgn
PROJECT LEADER: D.E.G.
DESIGNED BY: M.J.M.
IPARM FILE: p05b048xsl21.i

PLOT DATE: 12/20/2012
DRAWN BY: W.G.P.
CHECKED BY: D.E.G.
SHEET 284 OF 310

FILE NAME = U:\1762\CADD\MSTN\STP 2506\p05b048_Contract Plans.dgn
DATE/TIME = 12/20/2012
USER = 4866