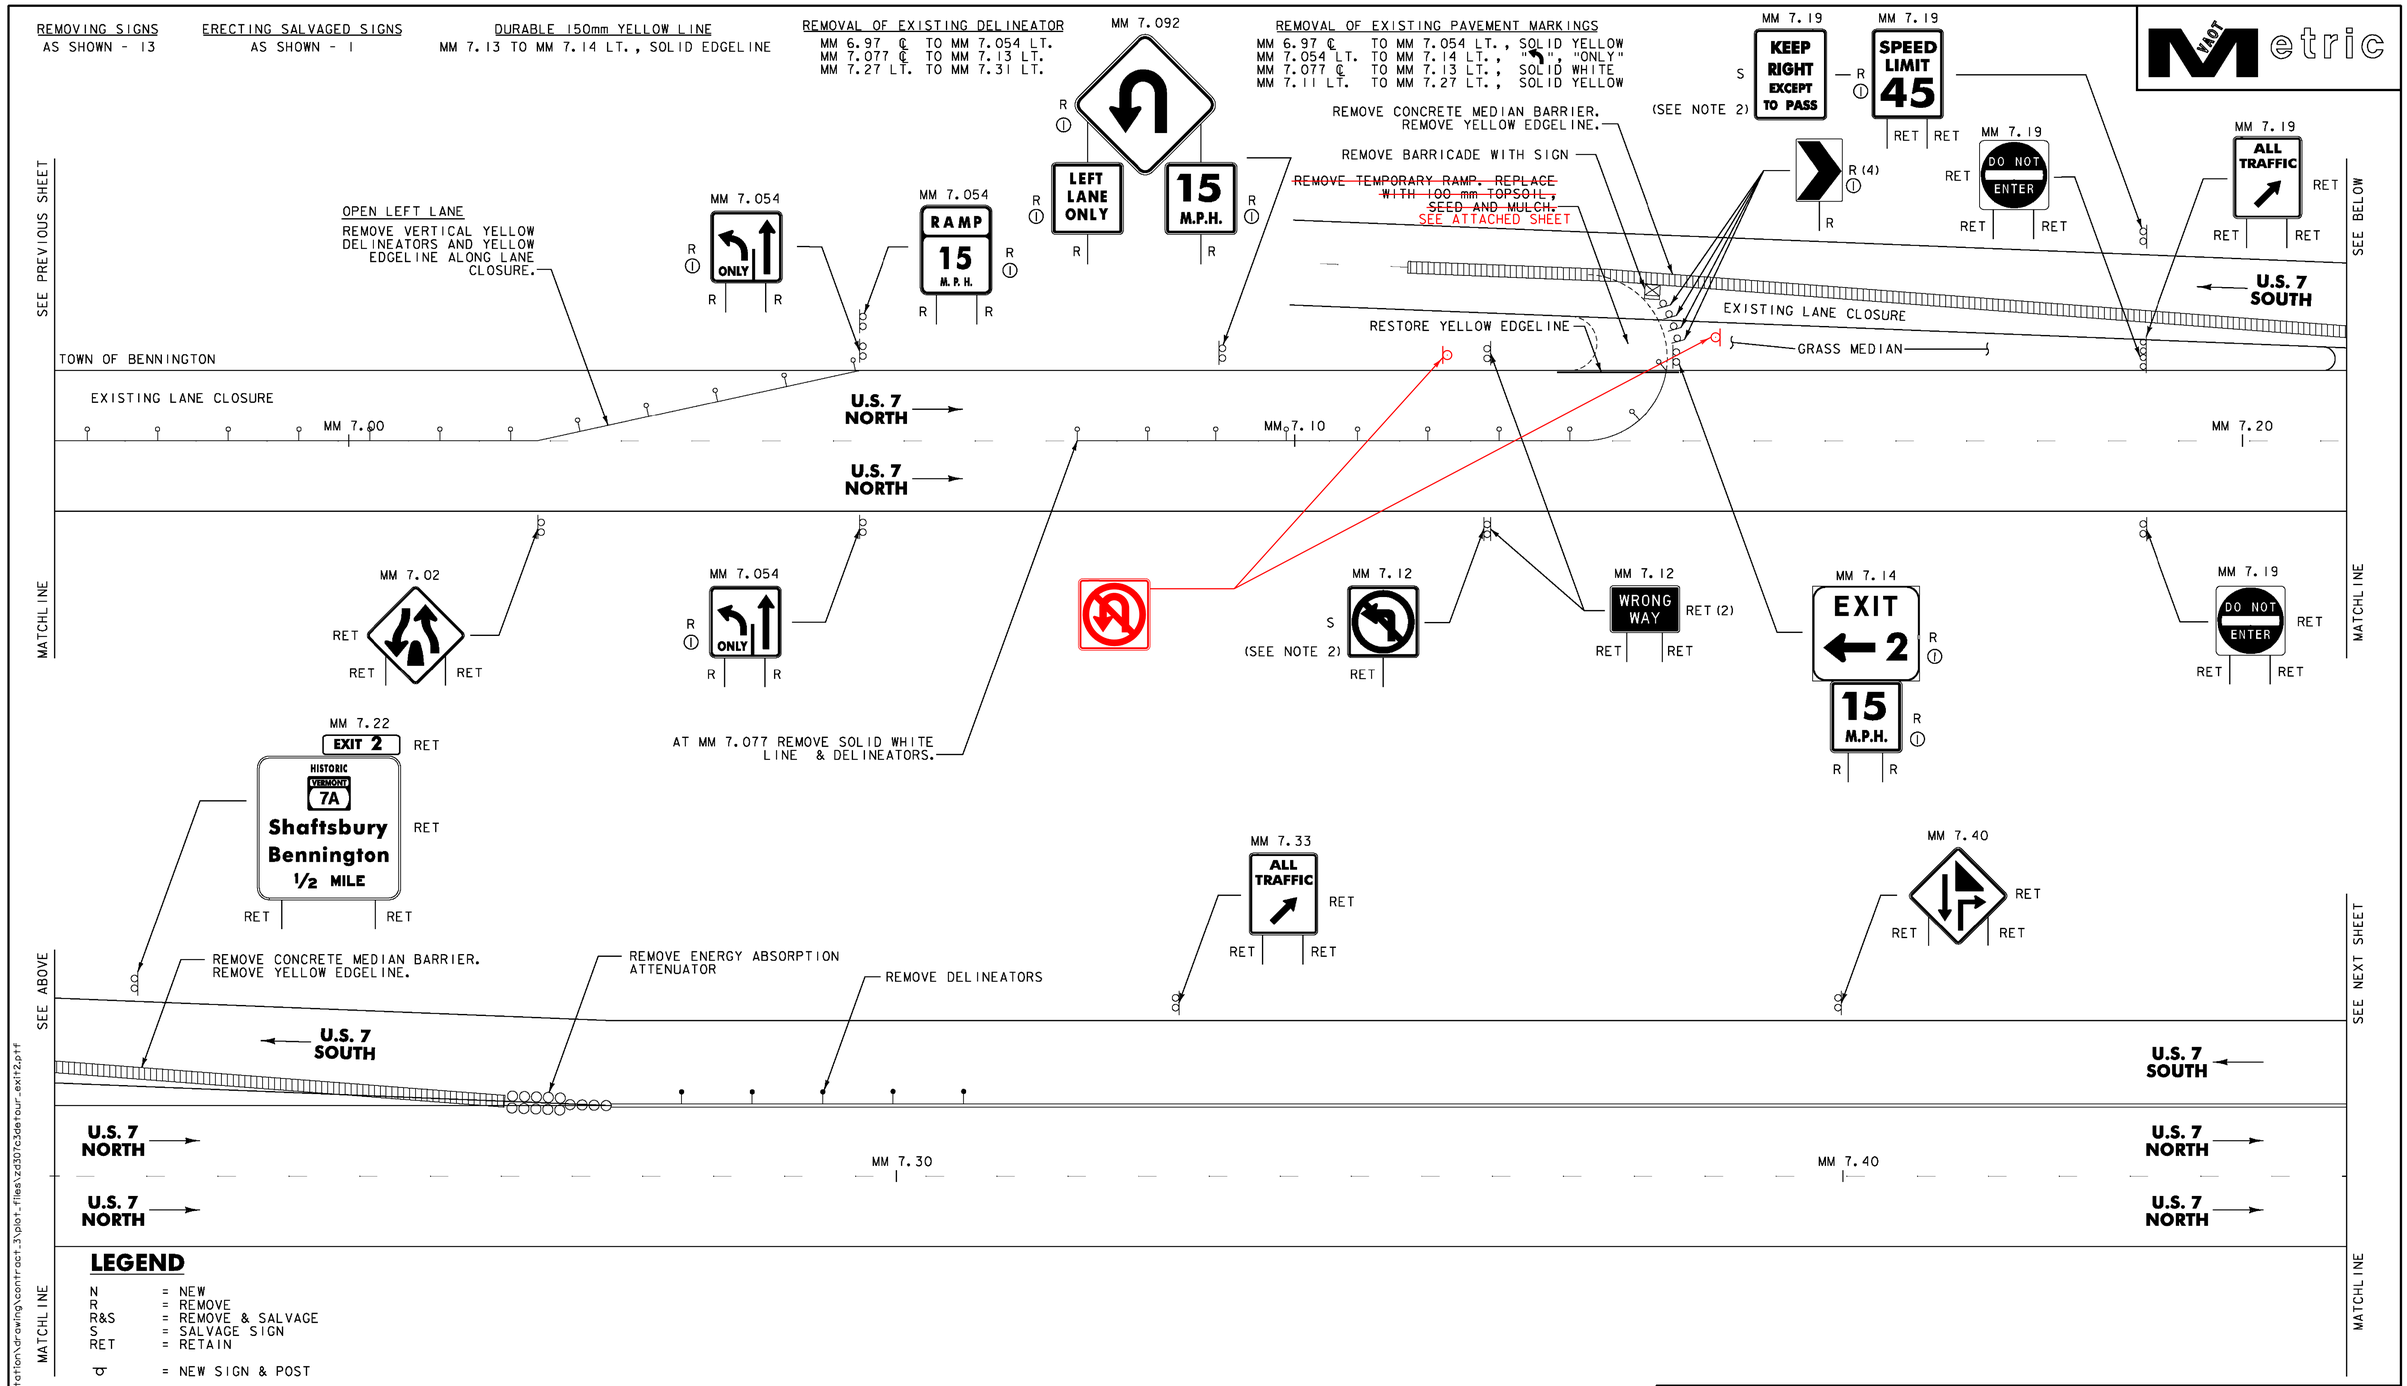

LEGEND

N	= NEW
R	= REMOVE
R&S	= REMOVE & SALVAGE
S	= SALVAGE SIGN
RET	= RETAIN
	= NEW SIGN & POST
	= EXISTING SIGN & POST
	= RETURN TO DISTRICT 1 MAINTENANCE FACILITY
	= EXISTING TYPE 1 (WHITE) DELINEATOR
	= EXISTING TYPE 1 (YELLOW) DELINEATOR
	= EXISTING CONCRETE MEDIAN BARRIER
	= EXISTING TYPE III BARRICADES
	= EXISTING TYPE III BARRICADES (MOD.)

NOTE:

1. AT MM 7.054 TO MM 7.14 REMOVE LEFT ARROW AND "ONLY" PAVEMENT MARKING STENCILS.
2. THIS SIGN WAS REMOVED DURING INSTALLATION OF THE DETOUR AND WAS STORED AT THE DISTRICT 1 GARAGE. THE CONTACT PERSON AT THE DISTRICT GARAGE IS NELSON BLANCHARD 447-2790. INSTALL SALVAGED SIGNS AS SHOWN OR AS DIRECTED BY RESIDENT ENGINEER.

NOT TO SCALE

VERMONT AGENCY OF TRANSPORTATION

Stantec

PROJECT NAME: BENNINGTON
PROJECT NUMBER: AC NH 019-1(53)

FILE NAME: ...\zd307c3detour_exit2.ptf
PLOT DATE: 5/25/2011
DESIGN SUPERVISOR: GREG EDWARDS
DRAWN BY: STANTEC
DESIGNED BY: MARC FOISY
CHECKED BY: GARY SANTY
EXIT 2 DETOUR REMOVAL SHEET 3
SHEET 181 OF 577

v:\1953\active\053002\transportation\drawing\contract_3\plot_files\zd307c3detour_exit2.ptf