INDEX OF SHEETS
SEE SHEET 2

STATE OF VERMONT
AGENCY OF TRANSPORTATION

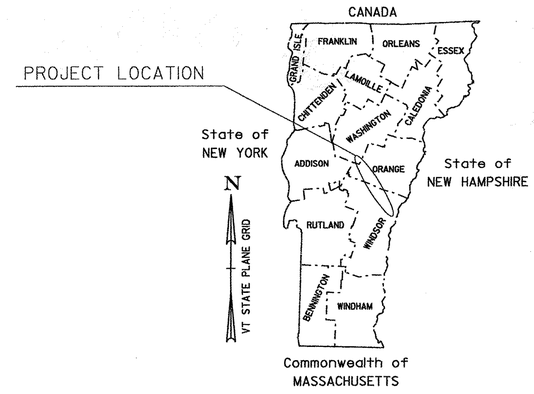
PROPOSED IMPROVEMENT

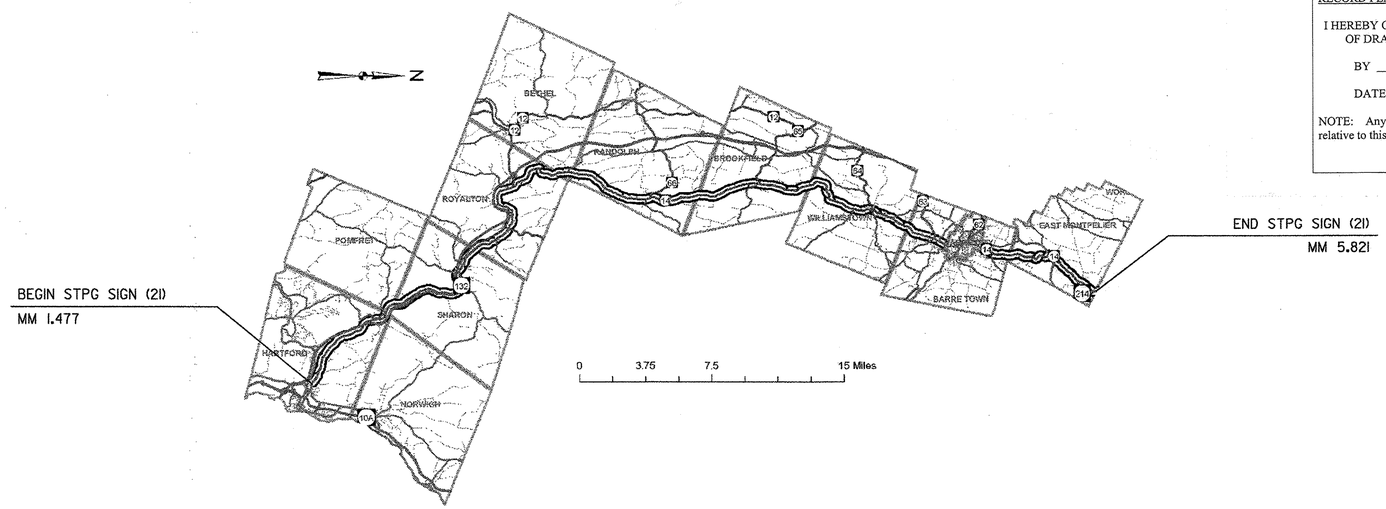
TOWNS OF HARTFORD – EAST MONTPELIER
COUNTIES OF WINDSOR, ORANGE, AND WASHINGTON
VERMONT ROUTE 14

BEGINNING NORTH OF THE INTERSECTION OF US ROUTE 4, US ROUTE 5, AND VT ROUTE 14 IN THE TOWN OF HARTFORD AT MILE MARKER 1.477 AND EXTENDING NORTHERLY ALONG VT ROUTE 14 FOR A DISTANCE OF 56.53 MILES TO THE EAST MONTPELIER - CALAIS TOWN LINE AT MILE MARKER 5.821. EXCLUDING CLASS I SECTIONS WITHIN THE PROJECT CORRIDOR.

LENGTH OF ROADWAY = 56.530 MILES
LENGTH OF PROJECT = 53.576 MILES

WORK TO BE PERFORMED UNDER THIS PROJECT INCLUDES THE REMOVAL OF EXISTING SIGNS AND POSTS AND THE INSTALLATION OF NEW SIGNS AND SIGN POSTS AND INCIDENTAL ITEMS.





BEGIN STPG SIGN (21)
MM 1.477

END STPG SIGN (21)
MM 5.821

CONVENTIONAL SYMBOLS

COUNTY LINE	COUNTY LINE
TOWN LINE	TOWN LINE
LIMITS OF ACCESS	
POINT OF ACCESS	X
FENCE LINE	
STONE WALL	
TRAVELED WAY	
GUARD RAIL	
RAILROAD	
SURVEY LINE	
CULVERT	
POWER POLE	
TELEPHONE POLE	
TREES	
CONTROL OF ACCESS	
PROPERTY LINE	
R.O.W. TAKING LINE	
SLOPE RIGHTS	SR SR SR
TOP OF CUT	
TOE OF SLOPE	

SURVEYED BY : N/A
SURVEYED DATE : N/A

DATUM
VERTICAL N/A
HORIZONTAL N/A

RECORD PLANS

CONTRACTOR: F. R. LAFAYETTE, INC.- ESSEX JUNCTION, VT
RESIDENT ENGINEER: PAUL PERRY
CONSTRUCTION BEGAN: SEPTEMBER 28, 2009
CONSTRUCTION COMPLETE: JUNE 16, 2011
RECORD PLANS BY: PAUL PERRY & AMOS KEMPTON

I HEREBY CERTIFY THAT ALL THE CONSTUCTION REQUIRED BY THIS SET OF DRAWINGS HAS BEEN ACCOMPLISHED AS INDICATED HEREIN.
BY Paul K. Perry RESIDENT ENGINEER
DATE 9/12/11

NOTE: Any further information concerning final quantities, amounts or other details relative to this project may be found at Central Files in the electronic archives.

THESE PLANS ARE SUBJECT TO SUCH ENGINEERING CHANGES AS MAY BE REQUIRED BY THE FEDERAL HIGHWAY ADMINISTRATION OR THE DIRECTOR OF PROGRAM DEVELOPMENT.

CONSTRUCTION IS TO BE CARRIED ON IN ACCORDANCE WITH THESE PLANS AND THE STANDARD SPECIFICATIONS FOR CONSTRUCTION DATED 2006, AS APPROVED BY THE FEDERAL HIGHWAY ADMINISTRATION ON JUNE 15, 2006 FOR USE ON THIS PROJECT, INCLUDING ALL SUBSEQUENT REVISIONS AND SUCH REVISED SPECIFICATIONS AND SPECIAL PROVISIONS AS ARE INCORPORATED IN THESE PLANS.

DIRECTOR OF PROGRAM DEVELOPMENT
APPROVED [signature] DATE 6-25-09

PROJECT MANAGER : AMY GAMBLE

PROJECT NAME : HARTFORD - EAST MONTPELIER
PROJECT NUMBER : STPG SIGN (21)

SHEET 1 OF 162 SHEETS

INDEX SHEETS

1	TITLE SHEET
2	GENERAL NOTES
3	QUANTITY SHEET
4	COUNTY/ TOWN LINE DESIGN
5-6	SIGN DETAILS
7	GUIDE SIGN ASSEMBLY
8-15	HARTFORD TRAFFIC SIGN SUMMARY SHEETS 1-8
16-29	SHARON TRAFFIC SIGN SUMMARY SHEETS 1-14
30-60	ROYALTON TRAFFIC SIGN SUMMARY SHEETS 1-31
61-63	BETHEL TRAFFIC SIGN SUMMARY SHEETS 1-3
64-87	RANDOLPH TRAFFIC SIGN SUMMARY SHEETS 1-24
88-96	BROOKFIELD TRAFFIC SIGN SUMMARY SHEETS 1-9
97-114	WILLIAMSTOWN TRAFFIC SIGN SUMMARY SHEETS 1-18
115-135	BARRE TOWN TRAFFIC SIGN SUMMARY SHEETS 1-22
136-159	EAST BARRE TRAFFIC SIGN SUMMARY SHEETS 1-24
160	TOWN TOTAL SIGN SUMMARY SHEET
161-162	TRAFFIC CONTROL SHEETS

STANDARDS

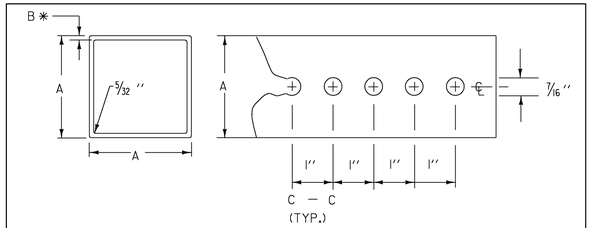
E-120	STANDARD SIGN PLACEMENT EXPRESSWAY AND FREEWAY	08/08/1995
E-121	STANDARD SIGN PLACEMENT CONVENTIONAL ROAD	08/08/1995
E-123	GUIDE SIGN PLACEMENT	03/16/2004
E-127	ROUTE MARKINGS AT RURAL INTERSECTIONS	08/08/1995
E-128A	VILLAGE SIGNS A-M	08/08/1995
E-128B	VILLAGE SIGNS N-W	08/08/1995
E-136B	STATE ROUTE MARKER SIGN DETAILS	08/08/1995
E-138	MILEMARKER DETAILS STATE AND TOWN HIGHWAYS	05/30/2003
E-141	REGULATORY SIGN DETAILS	09/20/1995
E-144	REGULATORY SIGN DETAILS	03/29/1999
E-145A	REGULATORY SIGN DETAILS LANE USE CONTROL SIGNS	12/23/1994
E-145B	REGULATORY SIGN DETAILS LANE USE CONTROL SIGNS	12/23/1994
E-153	WARNING SIGN DETAILS	05/01/2004
E-154	WARNING SIGN DETAILS	05/01/2004
E-164	SQUARE STEEL POSTS	05/20/1999

CLASS I SECTIONS OF HIGHWAY TO BE EXCLUDED FROM THIS PROJECT

TOWN	BEGIN MM	END MM	DISTANCE
HARTFORD	0.000	1.477	1.477

TOTAL CLASS I MILEAGE 1.477

- BARRE CITY IN ITS ENTIRETY IS CLASS I AND WILL NOT APPEAR IN THIs PROJECT.



SIGN POST NOTES :

THE POSTS SHALL BE CAREFULLY FORMED OF STEEL WITH A MINIMUM YIELD OF 55,000 PSI, INTO A SIZE AND SHAPE WITH CORNERS INDUCTION WELDED IN SUCH A MANNER THAT NEITHER FLASH NOR WELD SHALL INTERFERE WITH THE TELESCOPING PROPERTIES, NOR DAMAGE THE GALVANIZING.

*THE WALL THICKNESS TOLERANCES SHALL BE +.005'' AND -.010'' FOR THE 12 GAUGE.

*THE WALL THICKNESS TOLERANCES SHALL BE +.002'' AND -.008'' FOR THE 14 GAUGE.

DIMENSION DETAILS AND POST SELECTION CHART

POST SELECTION CHART								
SIGN AREA (FT^2) X H (FT) ≤ SV (SELECTION VALUE)								
POST SIZE	DIMENSIONS			SECTION MODULUS IN^3	ONE POST S v	TWO POST S v	THREE POST S v	NUMBER PERMITTED IN 8' PATH
LBS/FT.	A	*B	GAUGE					
1.88	1 3/4''	.083	14	0.230	47	94	141	TWO
2.42	2''	.105	12	0.381	77	154	231	TWO
3.35	2 1/2''	.105	12	0.642	130	260	390	ONE

DESIGN CRITERIA:

WIND SPEED = 70 MPH (10 -YEAR MEAN RECURRENCE INTERVAL)
WIND PRESSURE = 19 PSF
STEEL MINIMUM YIELD = 55,000 PSI
ALLOWABLE STRESS = (1.4) 0.60 FY

GENERAL NOTES

1. ALL NEW SIGNS SHALL BE IN ACCORDANCE WITH THESE PLANS, THE LATEST EDITION OF THE 2003 MANUAL ON UNIFORM TRAFFIC CONTROL DEVICES, THE STANDARD HIGHWAY SIGN BOOK (SHS) PUBLISHED BY THE FEDERAL HIGHWAY ADMINISTRATION (FHWA), AND APPLICABLE VTRANS E-SERIES STANDARDS OR AS DIRECTED BY THE ENGINEER. SIGN LOCATIONS AS SHOWN ON THE PLANS ARE APROXIMATE. EXACT LOCATIONS TO BE DETERMINED BY THE ENGINEER IN THE FIELD.

2. ALL SIGNS WITHIN THE PROJECT LIMITS ARE TO BE REPLACED UNLESS OTHERWISE NOTED OR AS DIRECTED BY THE RESIDENT ENGINEER.

3. THE CONTRACTOR SHALL BE RESPONSIBLE FOR REPAIRING ANY DAMAGE TO PRIVATE OR PUBLIC PROPERTY CAUSED BY THE CONTRACTOR, AT THEIR EXPENSE.

4. ALL EXISTING MILE MARKER PLAQUES ATTACHED TO A DELINEATOR POST OR ATTACHED TO A RETAINED STAND ALONE SIGN POST ASSEMBLY SHALL BE RETAINED. IF AN EXISTING MILE MARKER PLAQUE IS ATTACHED TO A SIGN POST THAT IS TO BE REMOVED AND REPLACED IN THE SAME LOCATION, THE MILE MARKER PLAQUE SHALL BE REMOVED, SALVAGED AND INSTALLED TO THE NEW SIGN POST. IF AN EXISTING MILE MARKER PLAQUE IS ATTACHED TO A SIGN POST THAT IS TO BE RELOCATED TO A DIFFERENT LOCATION, THE MILE MARKER PLAQUE SHALL BE REMOVED, UNLESS OTHERWISE DIRECTED BY THE ENGINEER. PAYMENT FOR ANY OF THIS WORK SHALL BE INCIDENTAL TO ITEM 675.341 SQUARE TUBE POST AND ANCHOR. PAYMENT FOR NEW MILE MARKERS AS SHOWN ON THESE PLANS SHALL BE PAID FOR AS ITEM 675.20 TRAFFIC SIGN, TYPE A.

5. SALVAGED SIGN TOTALS HAS BEEN ADDED TO THE TOTAL SIGN REMOVAL COLUMN ON THE TOWN TOTAL SIGN SUMMARY SHEET.

6. EXISTING STREET NAME SIGNS ATTACHED TO SIGN POSTS THAT ARE TO BE REMOVED, SHALL BE REMOVED AND INSTALLED ONTO NEW POST. ALL WORK AND MARTERIALS NECESSARY TO REMOVE AND INSTALL THE STREET NAME PALQUES SHALL BE PAID FOR UNDER ITEM 675.60 ERECTING SALVAGED SIGNS. AN ESTIMATED QUANTITY HAS BEEN ADDED TO ITEM 675.60 TO PAY FOR THIS WORK.

7. ALL EXISTING STREET NAME PLAQUES INSTALLED ON STAND ALONE SIGN POSTS SHALL BE RETAINED WITHIN THE PROJECT LIMITS.

8. ALL SIGN PLACEMENT SHALL BE IN CONFORMANCE WITH STATE STANDARD E-120 STANDARD SIGN PLACEMENT CONVENTIOAL ROADS AND E-121STANDARD SIGN PLACEMENT EXPRESSWAY AND FREEWAY.

9. ALL SIGN LETTERING, DIGITS, ARROWS, AND DESIGN OF SYMBOLS FOR SIGNS DETAILED REFERENCED IN THESE PLANS SHALL CONFORM WITH THE "STANDARD ALPHABET FOR HIGHWAY SIGNS AND PAVEMENT MARKING" AS ADOPTED BY THE U.S. DEPARTMENT OF TRANSPORTATION AND THE FEDERAL HIGHWAY ADMINISTRATION (FHWA). UNLESS DETAILED WITHIN THESE PLANS.

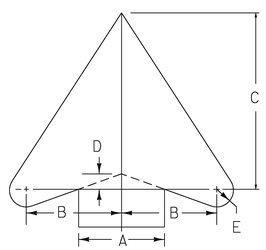
10. ALL COLORS SHALL CONFORM WITH THE STANDARD COLORS ADOPTED BY THE AMERICAN ASSOCIATION OF STATE HIGHWAY AND TRANSPORTATION OFFICIALS (AASHTO) AND APPROVED BY FHWA. UNLESS OTHERWISE NOTED.

11. WITHIN THE TRAFFIC SIGN SUMMARY SHEETS FY= FLUORESCENT YELLOW SHEETING (ASTM VII, VIII, OR IX) AND FYG = FLUORESCENT YELLOW-GREEN SHEETING (ASTM TYPE VII, VIII, OR IX).

12. SALVAGED SIGNS CALCULATED IN THE TRAFFIC SIGN SUMMARY SHEET HAVE BEEN INCLUDED INTO THE TOTAL FOR REMOVING SIGNS.

13. UNLESS OTHERWISE DETAILED ON THE PLANS, ALL SIGN BASE MATERIAL SHALL BE FLAT SHEET ALUMINUM WITH THE FOLLOWING MINIMUM THICKNESSES:

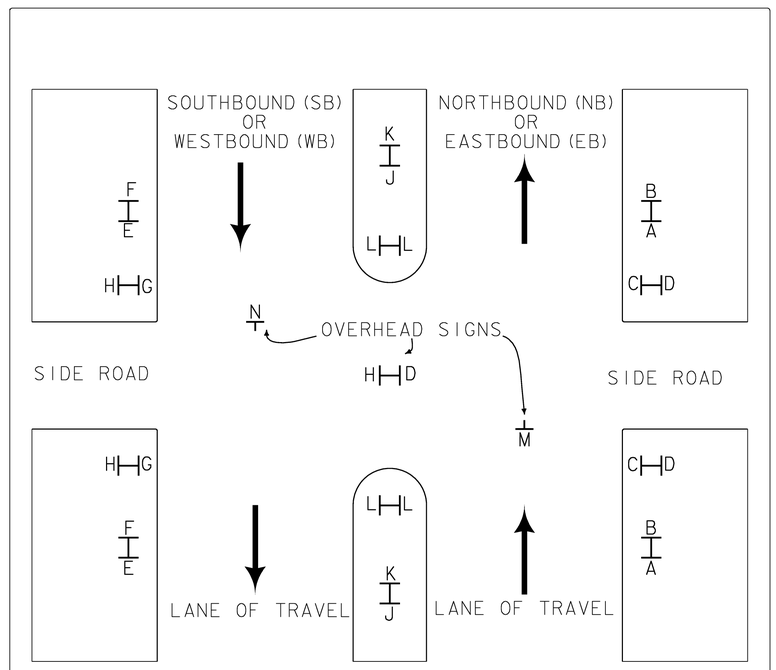
SIZES				
		24" X 10"		
		24" X 12"	36" X 12"	
		24" X 18"	36" X 15"	
		24" X 24"	36" X 18"	48" X 18"
		24" X 30"	36" X 24"	48" X 24"
	9" X 12"	30" X 15"	30" X 42"	48" X 30"
	12" X 12"	30" X 18"	36" X 36"	48" X 42"
	18" X 18"	30" X 30"	36" X 48"	48" X 48"
	21" X 15"	30" X 42"	36" X 54"	48" X 60"
THICKNESS	0.060"	0.080"	0.100"	0.125"



ARROW NOTES :

ARROW DIMENSIONS ARE BASED ON "A" DIMENSION. SEE BASE SIGN DETAIL FOR MORE INFORMATION. BASE SIGN DETAILS CAN BE FOUND ON SHEET 6 AND 7 OF THESE PROJECT PLANS.

DIMENSIONS (INCHES)				
A	B	C	D	E
2 5/8	3	5 1/4	3/8	1/2
3	3 1/2	6 1/8	7/16	9/16
3 1/8	1 5/8	6 3/8	1/2	5/8
3 1/4	3 3/4	6 5/8	1/2	5/8
3 5/16	13 13/16	6 11/16	1/2	11/16
3 1/2	4	7 1/8	9/16	11/16
3 3/4	4 5/16	7 5/8	9/16	3/4
4	4 5/8	8 1/8	5/8	13/16
4 3/8	5	8 7/8	11/16	7/8
4 1/2	5 3/16	9 1/8	11/16	7/8
4 3/4	5 7/16	9 5/8	3/4	1
5	5 3/4	10 1/8	3/4	1
5 1/4	6	10 5/8	13/16	1 1/16
6	6 7/8	12 3/16	15/16	1 3/16
6 1/2	7 1/2	13 3/16	1	1 5/16
7	8	14 3/16	1 1/16	1 3/8
8	9 3/16	16 1/4	1 1/4	1 5/8



THE TRAFFIC SIGN LOCATION CODES ARE TO BE USED INCONJUNCTION WITH THE SIGN SUMMARY SHEETS TO ESTABLISH PROPER SIGN INSTALLATION IN THE FILED.

TRAFFIC SIGN LOCATION CODES

NOT TO SCALE

PROJECT NAME: HARTFORD - EAST MONTPELIER

PROJECT NUMBER: STPG SIGN (21)

FILE NAME: 09c024_TS.DGN
PROJECT LEADER: N. AVERY
DESIGNED BY: N. AVERY
GENERAL NOTES

PLOT DATE: 11-JUN-2009
DRAWN BY: N. AVERY
CHECKED BY: A. GAMBLE
SHEET 2 OF 162

STATE OF VERMONT
AGENCY OF TRANSPORTATION

QUANTITY SHEET 1

SUMMARY OF ESTIMATED QUANTITIES	TOTALS		DESCRIPTIONS				DETAILED SUMMARY OF QUANTITIES		
ROADWAY	GRAND TOTAL	FINAL	UNIT	ITEMS	ITEM NUMBER	ROUND	QUANTITIES	UNIT	ITEMS
1	1		CY	TRENCH EXCAVATION OF EARTH, EXPLORATORY (N.A.B.I.)	204.22				
48	48		HR	UNIFORMED TRAFFIC OFFICERS	630.10				
792	792		HR	FLAGGERS	630.15				
1	1		LS	MOBILIZATION/DEMOBILIZATION	635.11				
1	1		LS	TRAFFIC CONTROL	641.10				
4642.4	4642.4		SF	TRAFFIC SIGNS, TYPE A	675.20				
11520	11520		LF	SQUARE TUBE SIGN POST AND ANCHOR	675.341				
932	932		EACH	REMOVING SIGNS	675.50				
61	61		EACH	ERECTING SALVAGED SIGNS	675.60				

PROJECT NAME: HARTFORD- EAST MONTPELIER

PROJECT NUMBER: STPG SIGN (21)

FILE NAME: 09c024_TS.DGN
PROJECT LEADER: N. AVERY
DESIGNED BY: N. AVERY
QUNATITY SHEET

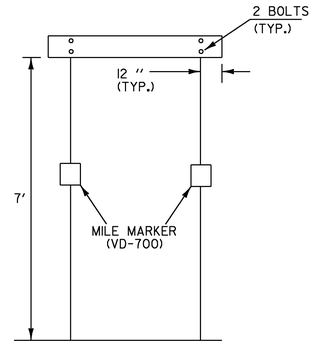
PLOT DATE: 23-JUN-2009
DRAWN BY: N. AVERY
CHECKED BY: A. GAMBLE
SHEET 3 OF 162

TEXT	SERIES	DIMENSIONS
ADDISON	C	28.27
ALBANY	C	25.88
ALBURGH	C	29.99
ANDOVER	C	30.05
ARLINGTON	B	29.35
ATHENS	C	24.49
AVERILL	C	26.44
BAKERSFIELD	B	32.50
BARNARD	C	30.49
BARNET	C	24.83
BARRE CITY	B	32.50
BARRE TOWN	B	32.50
BARTON	C	25.38
BELVIDERE	C	32.50
BENNINGTON	B	32.50
BENSON	C	25.41
BERKSHIRE	B	29.04
BERLIN	C	22.50
BETHEL	C	23.80
BLOOMFIELD	B	32.13
BOLTON	C	24.39
BRADFORD	C	32.50
BRAINTREE	C	32.50
BRANDON	C	30.46
BRATTLEBORO	B	32.50
BRIDGEWATER	B	32.50
BRIDPORT	C	32.06
BRIGHTON	C	32.06
BRISTOL	C	27.24
BROOKFIELD	B	31.91
BROWNINGTON	B	31.22
BRUNSWICK	B	30.60
BURKE	C	20.93
BUELS GORE	B	32.50
BURLINGTON	B	32.50
CABOT	C	20.50
CALAIS	C	22.22
CAMBRIDGE	B	29.74
CANAAN	C	25.15
CASTLETON	B	29.32
CAVENDISH	C	32.50
CHARLESTON	B	32.50
CHARLOTTE	B	29.32
CHELSEA	C	28.84
CHESTER	C	28.46
CHITTENDEN	B	30.56
CLARENDON	B	30.32
COLCHESTER	B	32.50
CONCORD	C	30.42
CORINTH	C	27.27
CORNWALL	C	32.50
COVENTRY	C	32.50
CRAFTSBURY	B	32.50
DANBY	C	21.65
DANVILLE	C	31.16
DERBY	C	21.15
DORSET	C	24.55
DOVER	C	20.74
DUMMERSTON	B	32.50
DUXBURY	C	30.75
EDEN	C	15.85
ENOSBURG	C	32.50
EAST HAVEN	B	32.50
E. MONTPELIER	B (5'')	32.50
ELMORE	C	25.46
ESSEX	C	20.38
FAIRFAX	C	27.05
FAIRFIELD	C	32.50
FAIR HAVEN	B	32.50
FAIRLEE	C	26.12
FAYSTON	C	28.85
FERDINAND	B	29.17
FERRISBURGH	B	32.50
FLETCHER	C	31.85
FRANKLIN	C	31.31

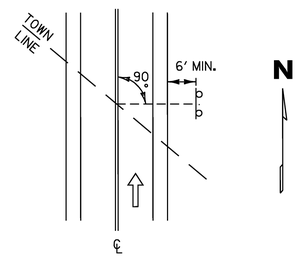
TEXT	SERIES	DIMENSIONS
GEORGIA	C	27.74
GLOVER	C	25.00
GOSHEN	C	25.16
GLASTENBURY	B (5'')	31.32
GRAFTON	C	29.31
GRAND ISLE	B	32.50
GRANVILLE	C	32.50
GREENSBORO	B	32.50
GROTON	C	25.35
GUILDHALL	C	32.50
GUILFORD	C	31.78
HALIFAX	C	27.14
HANCOCK	C	29.96
HARDWICK	C	32.50
HARTFORD	C	32.50
HARTLAND	C	32.50
HIGHGATE	C	31.14
HINESBURG	B	29.23
HOLLAND	C	29.22
HUBBARDTON	B	31.42
HYDE PARK	B	32.50
IRA	C	10.15
IRASBURG	C	32.37
ISLE LA MOTTE	B (5'')	32.50
JAMAICA	C	28.26
JAY	C	11.85
JERICHO	C	27.24
JOHNSON	C	30.39
KILLINGTON	B	30.16
KIRBY	C	18.99
LANDGROVE	B	30.33
LEICESTER	C	32.50
LEMINGTON	B	28.79
LONDONDERRY	B (5'')	32.18
LOWELL	C	25.04
LUDLOW	C	26.10
LUNENBERG	B	30.01
LYNDON	C	24.96
MAIDSTONE	B	29.51
MANCHESTER	B	32.50
MARLBORO	C	32.50
MARSHFIELD	B	32.47
MENDON	C	26.02
MIDDLEBURY	B	32.50
MIDDLESEX	B	29.06
MIDDLETOWN SPR	B (5'')	32.50
MILTON	C	22.63
MONTGOMERY	B	32.50
MONTPELIER	B	31.94
MORETOWN	C	32.50
MORGAN	C	26.52
MORRISTOWN	B	32.50
MOUNT HOLLY	B (5'')	31.97
MOUNT TABOR	B	32.02
NEWARK	C	25.65
NEWBURY	C	30.87
NEWFANE	C	29.73
NEW HAVEN	B	32.50
NEWPORT CITY	B (5'')	32.50
NEWPORT TOWN	B (5'')	32.50
NORTH HERO	B	32.50
NORTHFIELD	B	31.57
NORTON	C	25.60
NORWICH	C	28.77
ORANGE	C	25.88
ORWELL	C	25.57
PANTON	C	25.38
PAWLET	C	24.59
PEACHAM	C	30.23
PERU	C	16.38
PITTSFIELD	C	32.50
PITTSFORD	C	32.50
PLAINFIELD	B	29.65
PLYMOUTH	C	32.50
POMFRET	C	29.42

TEXT	SERIES	DIMENSIONS
POULTNEY	C	32.50
POWNAL	C	26.35
PROCTOR	C	29.31
PUTNEY	C	24.83
RANDOLPH	C	32.50
READING	C	27.47
READSBORO	B	31.09
RICHFORD	C	32.06
RICHMOND	C	32.50
RIPTON	C	22.97
ROCHESTER	B	29.54
ROCKINGHAM	B	32.50
ROXBURY	C	30.44
ROYALTON	C	32.50
RUPERT	C	24.94
RUTLAND CITY	B (5'')	32.50
RUTLAND TOWN	B (5'')	32.50
RYEGATE	C	28.47
ST. ALBANS CITY	B (5'')	32.50
ST. ALBANS TOWN	B (5'')	32.50
ST. GEORGE	B	32.50
ST. JOHNSBURY	B (5'')	32.50
SALISBURY	C	32.50
SEARSBURG	B	30.93
SHAFTSBURY	B	32.50
SHARON	C	25.91
SHEFFIELD	C	32.50
SHELDON	C	29.42
SHOREHAM	C	32.50
SHREWSBURY	B	32.50
S. BURLINGTON	B (5'')	32.50
SOUTH HERO	B	32.50
SPRINGFIELD	B	32.50
STAMFORD	C	32.50
STARKSBORO	B	32.50
STOCKBRIDGE	B	32.50
STOWE	C	21.30
STRAFFORD	B	30.42
STRATTON	C	32.06
SUDBURY	C	30.77
SUNDERLAND	B	32.50
SUTTON	C	24.21
SWANTON	C	30.22
THETFORD	C	32.50
TINMOUTH	C	32.14
TOPSHAM	C	30.53
TOWNSHEND	B	31.70
TROY	C	16.54
TUNBRIDGE	C	32.50
UNDERHILL	C	32.50
VERGENNES	B	30.03
VERNON	C	25.79
VERSHIRE	C	31.72
WAITSFIELD	B	30.44
WALDEN	C	25.46
WALLINGFORD	B	32.50
WALTHAM	C	29.91
WARDSBORO	B	32.29
WARREN	C	25.99
WARRENS GORE	B (5'')	32.50
WASHINGTON	B	32.50
WATERBURY	B	31.40
WATERFORD	B	30.65
WATERVILLE	B	31.35
WEATHERSFIELD	B (5'')	32.50
WELLS	C	20.83
WEST FAIRLEE	B (5'')	32.50
WESTFIELD	C	32.50
WEST HAVEN	B	32.50
WESTFORD	C	32.50
WESTMINISTER	B	32.50
WESTMORE	C	32.50
WESTON	C	25.85

TEXT	SERIES	DIMENSIONS
WEST RUTLAND	B (5'')	32.50
WEST WINDSOR	B (5'')	32.50
WEYBRIDGE	C	32.50
WHEELOCK	C	32.50
WHITING	C	25.86
WHITINGHAM	B	32.50
WILLIAMSTOWN	B (5'')	32.50
WILLISTON	C	32.50
WILMINGTON	B	32.16
WINDHAM	C	29.66
WINDSOR	C	28.77
WINHALL	C	28.24
WINOOSKI	C	30.81
WOLCOTT	C	29.38
WOODBURY	C	32.50
WOODFORD	C	32.50
WOODSTOCK	B	31.79
WORCESTER	B	30.76



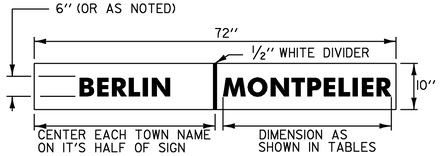
WHEN CROSSING COUNTY BOUNDARIES AN ADDITIONAL COUNTY LINE SIGN SHALL BE MOUNTED BELOW THE TOWN LINE SIGN MAINTAINING AN SEVEN FOOT CLEARANCE.



THE SIGN SHALL BE MOUNTED PARALLEL WITH THE ROADWAY, NORMALLY ON RIGHT SIDE TRAVELING WEST TO EAST OR SOUTH TO NORTH.

NOTES:

1. WORD TO WORD SPACING FOR MULTIPLE TEXT TOWN NAMES IS ADJUSTABLE TO ACCOMMODATE DIMENSION REQUIREMENTS.
2. DIMENSIONS SHOWN ARE APPROXIMATE AND MAY BE ADJUSTED SLIGHTLY TO ACCOMMODATE VARIOUS MANUFACTURER'S LETTER WIDTHS.
3. ALL DIMENSIONS ARE IN INCHES UNLESS OTHERWISE NOTED



VD-024
VD-025 SIMILIAR

COUNTY NAMES

TEXT	SERIES	DIMENSIONS
ADDISON CO.	B	32.50
BENNINGTON CO.	B (5'')	32.50
CALEDONIA CO.	B (5'')	32.50
CHITTENDEN CO.	B (5'')	32.50
ESSEX CO.	C	32.50
FRANKLIN CO.	B (5'')	32.50
GRAND ISLE CO.	B (5'')	32.50
LAMOILLE CO.	B (5'')	32.50
ORANGE CO.	B	32.50
ORLEANS CO.	B	32.50
RUTLAND CO.	B	32.50
WASHINGTON CO.	B (5'')	32.50
WINDHAM CO.	B	32.50
WINDSOR CO.	B	32.50

VD-025

TOWN/COUNTY LINE SIGN NOTES:

1. THE SIGN BASE MATERIAL SHALL BE HIGH DENSITY OVERLAID PLYWOOD ⅝ INCH THICK OR ALUMINUM SHEETING 0.125'' MINIMUM THICKNESS. THE RETROREFLECTIVE MATERIAL SHALL BE SHEETING APPLIED TO THE ENTIRE BACKGROUND OF THE SIGN. THE LEGEND SHALL BE CUT-OUT RETROREFLECTIVE LEGEND. ALL RETROREFLECTIVE MATERIAL SHALL BE EQUAL TO OR EXCEEDING THE ''THE AMERICAN SOCIETY OF TESTING AND MATERIALS'' (ASTM) TYPE III.
2. SIGNS SHALL HAVE A MINIMUM ASTM TYPE III SHEETING WITH A WHITE LEGEND ON A GREEN BACKGROUND.
3. LEGEND SHALL CONFORM WITH THE STANDARD ALPHABETS FOR HIGHWAY SIGNS APPROVED BY THE NATIONAL JOINT COMMITTEE ON UNIFORM TRAFFIC CONTROL DEVICES.
4. ALL SIGNS SHALL BE IN ACCORDANCE WITH ''THE MANUAL ON UNIFORM TRAFFIC CONTROL DEVICES'' (2003 MUTCD) AND THE ''STANDARD HIGHWAY SIGNS'' BOOK (SHS) PUBLISHED BY THE FEDERAL HIGHWAY ADMINISTRATION (FHWA).

PROJECT NAME: HARTFORD-EAST MONTPELIER

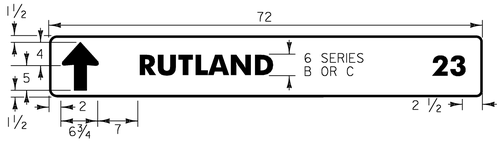
PROJECT NUMBER: STPG SIGN (21)

FILE NAME: 09c024_TS.DGN
PROJECT LEADER: N. AVERY
DESIGNED BY: N. AVERY
COUNTY/ TOWNLINE DESIGN

PLOT DATE: 11-JUN-2009
DRAWN BY: N. AVERY
CHECKED BY: A. GAMBLE
SHEET 4 OF 162



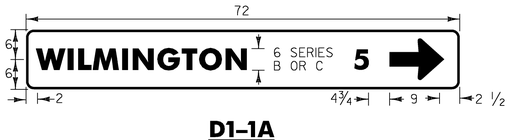
D1-1



D1-1A

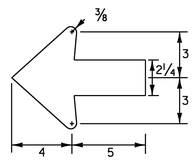


D1-1A

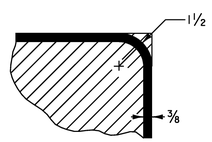


D1-1A

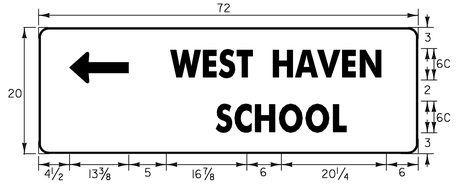
D2-1



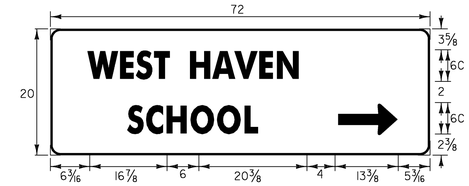
STANDARD ARROW



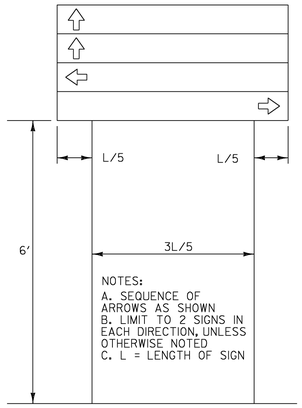
BORDER DETAIL



D1-2 (L)



D1-2 (R)



DESTINATION ASSEMBLY

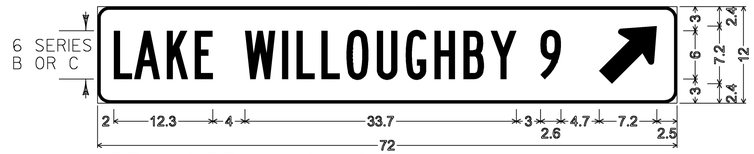
STANDARD DESTINATION SIGN NOTES
D1-1, D1-1A, D2-1, D2-2

1. ALL SIGNS SHALL BE IN ACCORDANCE WITH THE MUTCD AND THE " STANDARD HIGHWAY SIGNS" BOOK (SHS) PUBLISHED BY THE FEDERAL HIGHWAY ADMINISTRATION (FHWA).
2. THE SIGN BASE MATERIAL FOR STANDARD DESTINATION SIGNS SHALL BE HIGH DENSITY OVERLAYED PLYWOOD 5/8 INCH THICK OR FLAT SHEET ALUMINUM 1/8 INCH THICK.
3. THE DESTINATION SIGNS SHOWN ON THIS SHEET SHALL HAVE WHITE RETROREFLECTIVE ASTM TYPE III TEXT, ARROWS AND BORDERS ON A GREEN RETROREFLECTIVE ASTM TYPE III BACKGROUND. THE COLORS SHALL CONFORM WITH THE COLORS ADOPTED BY AASHTO AND APPROVED BY THE FHWA.
4. MULTIPLE ASSEMBLIES SHALL USE THE SAME SIZE THROUGHOUT. DO NOT MIX AND MATCH OLDER SIGN SIZES WITH NEW SIGN HEIGHTS AND WIDTHS.
5. ALL DIMENSIONS SHOWN IN INCHES EXCEPT WHERE NOTED.



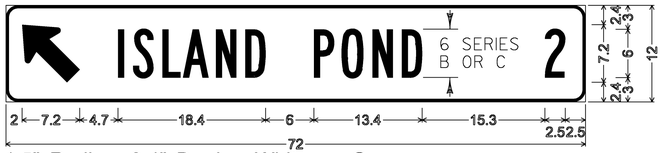
1.5" Radius, 0.4" Border, White on Green;
"MORGAN, VT" C; "9" C; 90 Deg Advanced Turn Arrow Custom 9.0" X 9.0";

D1-1A



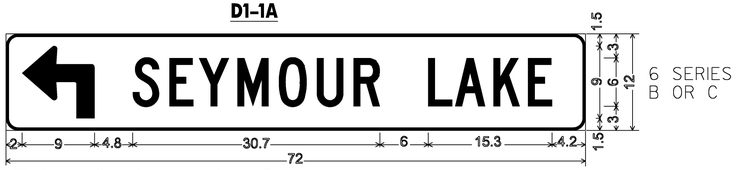
1.5" Radius, 0.4" Border, White on Green;
"LAKE WILLOUGHBY" B specified length; "9" B;
Standard Arrow Custom 9.0" X 6.0" 45°;

D1-1A



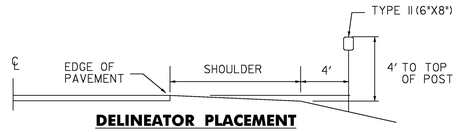
1.5" Radius, 0.4" Border, White on Green;
Standard Arrow Custom 9.0" X 6.0" 135°; "ISLAND POND" B; "2" B;

D1-1A

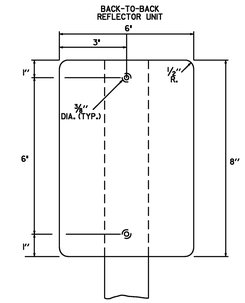


1.5" Radius, 0.4" Border, White on Green;
90 Deg Advanced Turn Arrow Custom 9.0" X 9.0"; "SEYMOUR LAKE" C;

D1-1



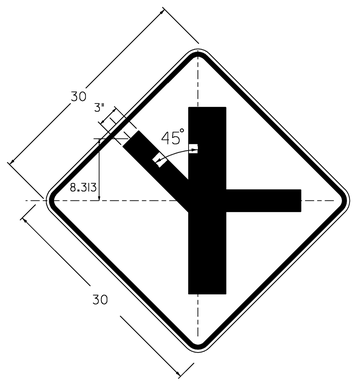
DELINEATOR PLACEMENT



TYPE II (6"X8")

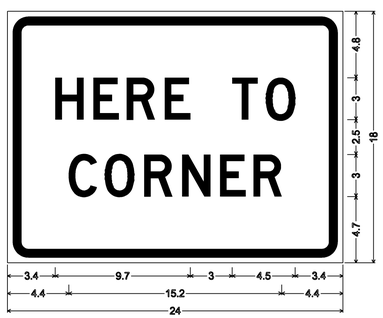
DELINEATORS WITH REFLECTIVE SHEETING

MATERIAL FOR RETROREFLECTIVE SHEETING FOR DELINEATORS SHALL BE A 0.063" ALUMINUM BACKING WITH A WHITE ASTM TYPE III OR TYPE IV.



W2-1MJ L(R)

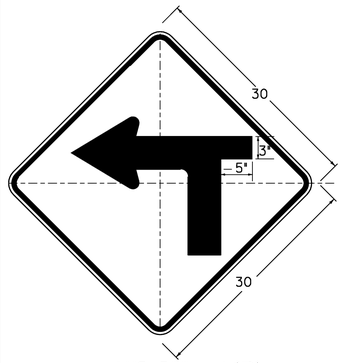
DIMENSIONS NOT SHOWN FOR THIS DETAIL SHALL CONFORM TO THE LATEST EDITION OF THE 2003 MUTCD FOR SIGN DETAIL W1-1. UNLESS OTHERWISE NOTED FOR THIS DETAIL



1.5" RADIUS, 0.625" BORDER, 0.375" INDENT
COLORS: LEGEND - RED
BACKGROUND - WHITE
TEXT STYLE: "HERE TO" D; "CORNER" D

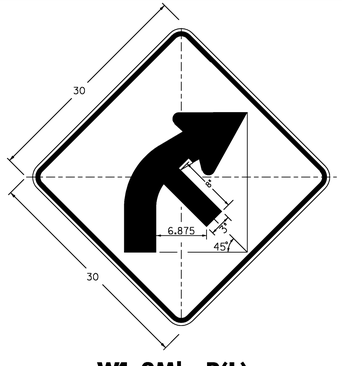
VR-345p

PROJECT NAME:	HARTFORD - EAST MONTPELIER
PROJECT NUMBER:	STPG SIGN (21)
FILE NAME: 09c024_TS.DGN	PLOT DATE: 11-JUN-2009
PROJECT LEADER: N. AVERY	DRAWN BY: N. AVERY
DESIGNED BY: N. AVERY	CHECKED BY: A. GAMBLE
SIGN DETAILS I	SHEET 5 OF 162



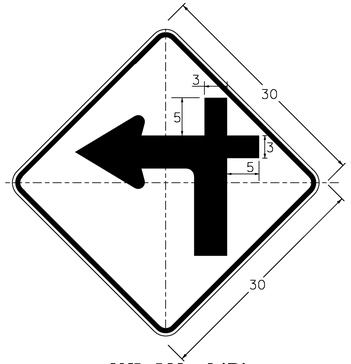
W1-1Ma L(R)

DIMENSIONS NOT SHOWN
FOR THIS DETAIL SHALL CONFORM
TO THE LATEST EDITION OF THE 2003 MUTCD
FOR SIGN DETAIL W1-1.
UNLESS OTHERWISE NOTED FOR THIS DETAIL



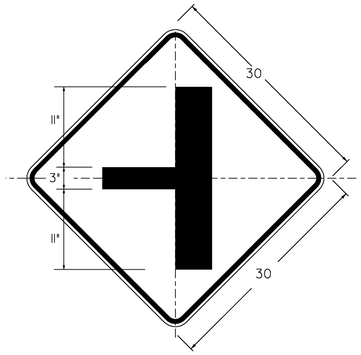
W1-2Mb R(L)

DIMENSIONS NOT SHOWN
FOR THIS DETAIL SHALL CONFORM
TO THE LATEST EDITION OF THE 2003 MUTCD
FOR SIGN DETAIL W1-2.
UNLESS OTHERWISE NOTED FOR THIS DETAIL



W1-1Mc L(R)

DIMENSIONS NOT SHOWN
FOR THIS DETAIL SHALL CONFORM
TO THE LATEST EDITION OF THE 2003 MUTCD
FOR SIGN DETAIL W1-1.
UNLESS OTHERWISE NOTED FOR THIS DETAIL



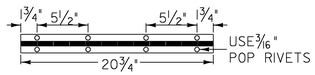
W2-2Ma L(R)

DIMENSIONS NOT SHOWN
FOR THIS DETAIL SHALL CONFORM
TO THE LATEST EDITION OF THE 2003 MUTCD
FOR SIGN DETAIL W2-2.
UNLESS OTHERWISE NOTED FOR THIS DETAIL

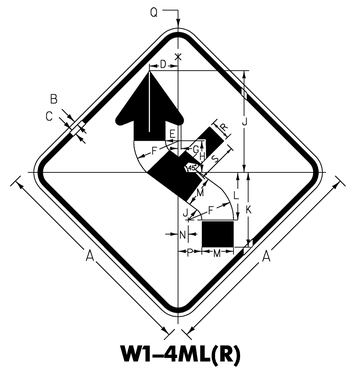


1.5" RADIUS, 0.625" BORDER, 0.375" INDENT
COLORS: LEGEND - RED
BACKGROUND - WHITE
TEXT STYLE: 'BEGIN' C

VR-644p



USE STANDARD 2" (YELLOW) PIANO HINGE



W1-4ML(R)

COLORS: LEGEND - BLACK
BACKGROUND - YELLOW

SIGN	DIMENSIONS (INCHES)															
	A	B	C	D	E	F	G	H	J	K	L	M	N	P	Q	R	S
STD.	30	½	¾	3 15/16	1 7/8	6¼	⅜	4 3/8	14 1/16	10 5/8	6 9/16	4 3/8	1 13/16	3 9/32	1 7/8	2 9/32	6
EXPWY	36	5/8	⅞	4 23/32	2¼	7½	15/32	5¼	16 7/8	12 3/8	7 7/8	5¼	1 11/16	3 11/16	2¼	3	8
FWY	48	¾	1¼	6 5/16	3	10	5/8	7	22½	16½	10½	7	2¼	5¼	3	4	10



W2-1Mb

DIMENSIONS NOT SHOWN
FOR THIS DETAIL SHALL CONFORM
TO THE LATEST EDITION OF THE 2003 MUTCD
FOR SIGN DETAIL W2-1.
UNLESS OTHERWISE NOTED FOR THIS DETAIL

SIGN	DIMENSIONS (IN)		
	A	G	H
MIN & STD.	30	11	3
SPECIAL	36	13	4



VW-268

COLORS: LEGEND - BLACK
BACKGROUND - YELLOW
• REDUCE SPACING BY 25%

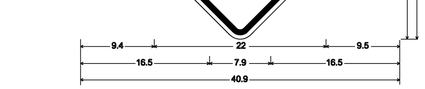
SIGN	DIMENSIONS (INCHES)									
	A	B	C	D	E	F	G	H	J	K
MIN	30	⅜	5/8	5B•	3¾	1¾	5C•	1⅞	15¼	8⅝
STD	36	5/8	⅞	6B	4	2	6C•	2¼	18½	10½



VW-353

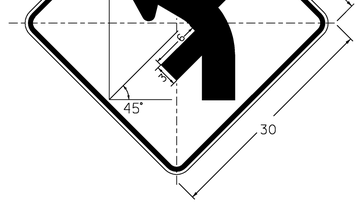
COLORS: LEGEND - BLACK
BACKGROUND - YELLOW

SIGN	DIMENSIONS(INCHES)								
	A	B	C	D	E	F	G	H	J
STD.	30	½	¾	5D	2 5/8	6 1/8	6 1/8	9 25/32	1 7/8
EXPWY	36	5/8	⅞	6D	3¼	8	7 11/32	12 13/16	2¼
FWY	48	¾	1¼	8D	4	8 19/32	10 11/32	13 25/32	3



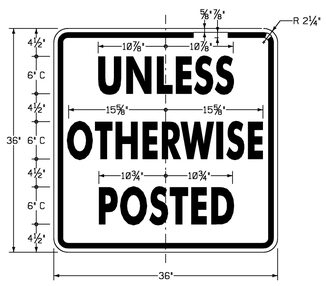
30" X 30" SIGN FACE
1.875" RADIUS, 0.75" BORDER, 0.50" INDENT
COLORS: LEGEND - BLACK
BACKGROUND - YELLOW
TEXT STYLE: "FALLING" C; "ICE" C

VW-347-H



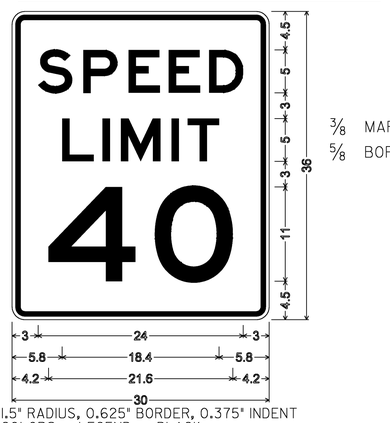
W1-2Mk R(L)

DIMENSIONS NOT SHOWN
FOR THIS DETAIL SHALL CONFORM
TO THE LATEST EDITION OF THE 2003 MUTCD
FOR SIGN DETAIL W1-2.
UNLESS OTHERWISE NOTED FOR THIS DETAIL



COLORS: LEGEND - BLACK
BACKGROUND - WHITE

VR-208



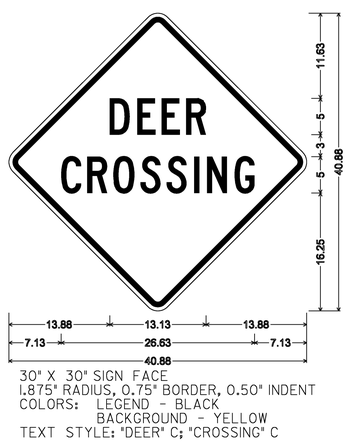
1.5" RADIUS, 0.625" BORDER, 0.375" INDENT
COLORS: LEGEND - BLACK
BACKGROUND - WHITE
TEXT STYLE: "SPEED" E; "LIMIT" E; "40" E

R2-1



* REDUCE SPACING 40%
** REDUCE SPACING 60%
COLORS: LEGEND - BLACK
BACKGROUND - WHITE

VR-023b



30" X 30" SIGN FACE
1.875" RADIUS, 0.75" BORDER, 0.50" INDENT
COLORS: LEGEND - BLACK
BACKGROUND - YELLOW
TEXT STYLE: "DEER" C; "CROSSING" C

W11-3A

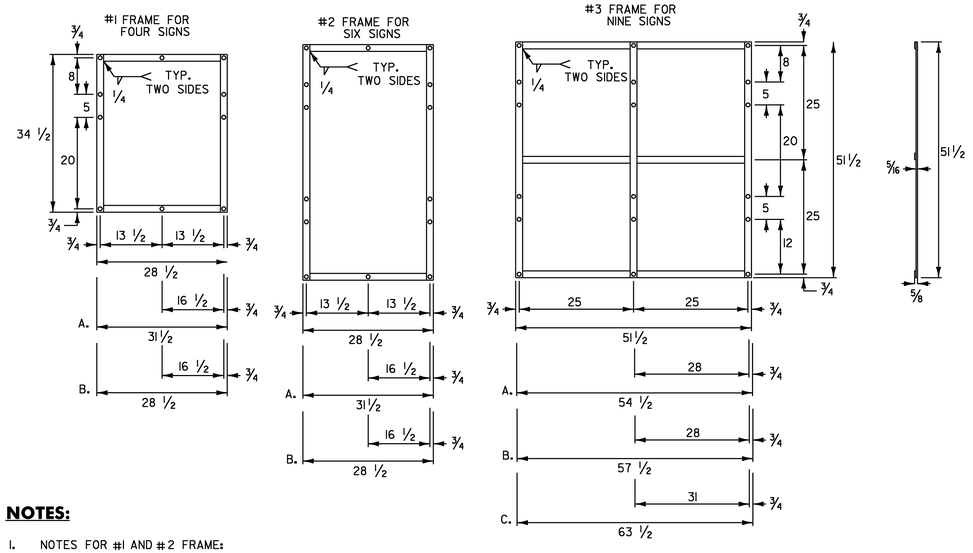
PROJECT NAME: HARTFORD - EAST MONTPELIER

PROJECT NUMBER: STPG SIGN (21)

FILE NAME: 09c024_TS.DGN
PROJECT LEADER: N. AVERY
DESIGNED BY: N. AVERY
SIGN DETAILS 2

PLOT DATE: 11-JUN-2009
DRAWN BY: N. AVERY
CHECKED BY: A. GAMBLE
SHEET 6 OF 162

ROUTE MARKER ASSEMBLY FRAMES



NOTES:

1. NOTES FOR #1 AND #2 FRAME:

   A. WITH ONE 30 INCH THREE DIGIT SIGN
   B. WITH TWO 30 INCH THREE DIGIT SIGNS

2. NOTES FOR #3 FRAME:

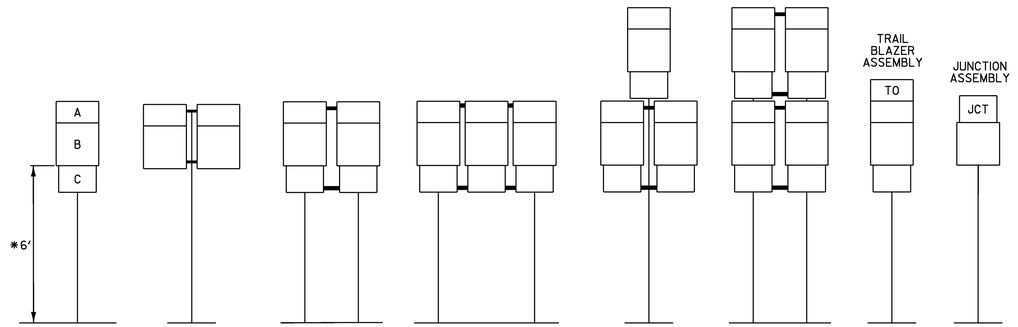
   A. WITH ONE 30 INCH THREE DIGIT SIGN IN AN OUTSIDE POSITION.
   B. WITH ONE 30 INCH THREE DIGIT SIGN IN THE CENTER POSITION OR TWO SUCH SIGNS IN THE OUTSIDE POSITIONS.
   C. WITH THREE 30 INCH THREE DIGIT SIGNS.

3. ALL HOLES SHALL BE 7/16 INCH DIAMETER. FOR OTHER SIGN COMBINATIONS THAN ABOVE, THE FRAME DIMENSIONS AND HOLE SPACING SHALL BE MODIFIED AS NECESSARY. THE FRAME SHALL BE PAINTED WITH ONE COAT OF PRIMER AND A SECOND COAT OF BLACK PAINT. THE PAINT SHALL BE OF THE TYPE USED ON EXTERIOR METAL SURFACES TO PREVENT METAL CORROSION.

4. STANDARD FRAMES SHALL BE 5/16 INCH × 1 1/2 INCH WELDED A-36 STEEL.

5. ALL DIMENSIONS SHOWN IN INCHES UNLESS OTHERWISE NOTED.

STANDARD MOUNTING OF ROUTE MARKER ASSEMBLIES



A - CARDINAL DIRECTION MARKER
B - ROUTE NUMBER
C - ADVANCE TURN ARROW OR DIRECTIONAL ARROW

* WHERE PARKING OR PEDESTRIAN TRAFFIC WILL OCCUR IN THE IMMEDIATE VICINITY OF THESE SIGNS MINIMUM VERTICAL CLEARANCE SHALL BE INCREASED TO SEVEN FEET

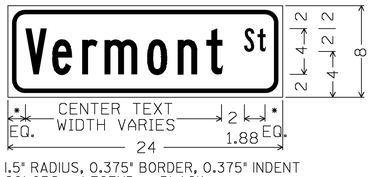
INSTALLATION SEQUENCE:

IN MULTIPLE HORIZONTAL MOUNTINGS PLACE A ROUTE MARKER ASSEMBLY INDICATING A LEFT TURN ON THE LEFT SIDE OF THE ASSEMBLY; RIGHT TURN ON THE RIGHT SIDE. FOR VERTICALLY STACKED MOUNTINGS PLACE THE STRAIGHT THROUGH MOVE INDICATION ON TOP, THE LEFT OR RIGHT TURNS AS APPROPRIATE BENEATH.

NOTES:

1. ALL DIMENSIONS SHOWN IN INCHES UNLESS OTHERWISE NOTED.

2. VERTICAL FRAME MEMBERS SHALL LINE UP WITH SIGN POST ON WHICH THEY ARE MOUNTED.



1.5" RADIUS, 0.375" BORDER, 0.375" INDENT
COLORS: LEGEND - BLACK
BACKGROUND - YELLOW
TEXT STYLE: B

* LATERAL SPACING TO OUTSIDE OF PANEL SHALL BE A MINIMUM OF 1.5"

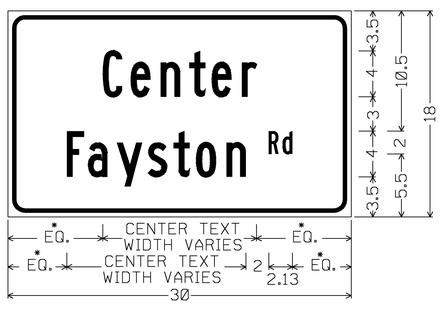
W16-8



1.5" RADIUS, 0.375" BORDER, 0.375" INDENT
COLORS: LEGEND - BLACK
BACKGROUND - YELLOW
TEXT STYLE: B

* LATERAL SPACING TO OUTSIDE OF PANEL SHALL BE A MINIMUM OF 1.5"

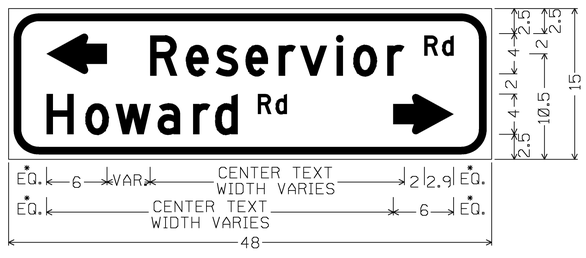
W16-8



1.5" RADIUS, 0.375" BORDER, 0.375" INDENT
COLORS: LEGEND - BLACK
BACKGROUND - YELLOW
TEXT STYLE: B

* LATERAL SPACING TO OUTSIDE OF PANEL SHALL BE A MINIMUM OF 1.5"

W16-8



3" RADIUS, 0.75" BORDER, 0.50" INDENT
COLORS: LEGEND - BLACK
BACKGROUND - YELLOW
TEXT STYLE: D; STANDARD ARROW CUSTOM 6" WIDE X 4" HIGH

* LATERAL SPACING TO OUTSIDE OF PANEL SHALL BE A MINIMUM OF 3"

W16-8a

PROJECT NAME: HARTFORD - EAST MONTPELIER	
PROJECT NUMBER: STPG SIGN (21)	
FILE NAME: 09c024_TS.DGN	PLOT DATE: 11-JUN-2009
PROJECT LEADER: N. AVERY	DRAWN BY: N. AVERY
DESIGNED BY: N. AVERY	CHECKED BY: A. GAMBLE
GUIDE SIGN ASSEMBLY	SHEET 7 OF 162

DIRECTION	MILEPOINT	LOCATION CODE (SHEET 2)	SIGN CODE	WIDTH (IN)	HEIGHT (IN)	SHEETING REMARKS	SIGN LEGEND FOR ALL INSTALLATION DATES AND POST LENGTHS SEE ORIGINAL RECORD PLANS	NEW SIGNS "A"	NEW SIGNS "B"	EXISTING SIGNS RETAIN	EXISTING SIGNS SALVAGE FROM	EXISTING SIGNS SALVAGE TO	EXISTING SIGNS REMOVE	EXIST POST RETAIN	EXIST POST REMOVE	NUMBER OF NEW POSTS	SQUARE STEEL (IN) (LB / FT) 1.75 / 1.88	SQUARE STEEL (IN) (LB / FT) 2.00 / 2.42	SQUARE STEEL (IN) (LB / FT) 2.50 / 3.35	TUBULAR STEEL Ø (IN) FOUNDATION	TUBULAR STEEL Ø (IN) (LB / FT) 3.00 / 7.60	TUBULAR STEEL Ø (IN) (LB / FT) 3.50 / 9.00	TUBULAR STEEL Ø (IN) (LB / FT) 4.00 / 10.80	TUBULAR STEEL Ø (IN) (LB / FT) 5.00 / 14.60	SIGN FRAME REQUIRED	REMARKS	SIGN DETAIL: DETAIL IN SHS	SIGN DETAIL: DETAIL ON SHEET NUMBER	SIGN DETAIL: DETAIL ON STD SHEET NUMBER
HARTFORD VT 14							FY-FLUORESCENT YELLOW FYG-FLUORESCENT YELLOW GREEN																			"SHS"-STANDARD HIGHWAY SIGNS			
NB	1.481	A	VR-039	24	18		STATE HIGHWAY BEGINS			1				X														
		A	R2-1	24	30		SPEED LIMIT 50			1																		
NB	1.533	A	M1-5	24	24		VERMONT 14			1				X														
		A	M3-1S	24	12		NORTH			1																		
NB	1.791	C	VR-017	24	24		LEGAL LOAD LIMIT 24,000 POUNDS						1		X												DOTHAN RD TH-28		
		C	VR-017	24	30			5.00								1		X										E-141
NB	1.800	D	R1-1	30	30		STOP			1				X														
NB	2.074	C	VR-017	24	30		LEGAL LOAD LIMIT 24,000 POUNDS						1		X												JERICHO RD TH-11		
		C	VR-017	24	30			5.00								1		X										E-141
NB	2.082	D	R1-1	30	30		STOP			1				X														
NB	3.010	A	VW-205	30	30		WATCH FOR TURNING VEHICLES	6.25		1				X													SIGN MISSING		
NB	3.220	C	VR-017	24	30		LEGAL LOAD LIMIT 24,000 LBS			1				X													BYRON ~~BRYON~~ HILL TH-187		
NB	3.226	D	R1-1	30	30		STOP			1				X														
NB	3.726	A	W2-2R	30	30		RIGHT SIDE ROAD			1				X														
		A	W16-8A	30	10		RUNNALS RD.	1.33		1			1														PAINTBALL DAMAGE REDO		
SIGN SUMMARY SHEET							SHEET TOTALS	17.58 ~~10.00~~ SF	0.00 SF	11 EA	0 EA	0 EA	3 ~~2~~ EA	0 EA	0 EA	2 EA	30 FT											
VERMONT AGENCY OF TRANSPORTATION							TOWN TOTALS	130.2	0.0	41.0	13.0	9.0	26	0.0	0.0	26	390.0											

PROJECT NAME: **Hartford-East Montpelier VT14**
PROJECT NUMBER: **STPG SIGN(21)**

FILE NAME: **Hartford.xls** PLOT DATE: **6/10/2009**
PROJECT MANAGER: **N. Averv** DRAWN BY: **I. Shea**
DESIGNED BY: **D. Crossley** CHECKED BY: **S. Menard**
HARTFORD SHEET 1 SHEET **8** OF **162**

DIRECTION	MILEPOINT	LOCATION CODE (SHEET 2)	SIGN CODE	WIDTH (IN)	HEIGHT (IN)	SHEETING REMARKS	SIGN LEGEND FOR ALL POST LENGTHS AND INSTALLATION DATES SEE ORIGINAL RECORD PLANS	NEW SIGNS "A"	NEW SIGNS "B"	EXISTING SIGNS RETAIN	EXISTING SIGNS SALVAGE FROM	EXISTING SIGNS SALVAGE TO	EXISTING SIGNS REMOVE	EXIST POST RETAIN	EXIST POST REMOVE	NUMBER OF NEW POSTS	SQUARE STEEL (IN) 1.75 (LB / FT) 1.88	SQUARE STEEL (IN) 2.00 (LB / FT) 2.42	SQUARE STEEL (IN) 2.50 (LB / FT) 3.35	TUBULAR STEEL Ø (IN) FOUNDATION	TUBULAR STEEL Ø (IN) 3.00 (LB / FT) 7.60	TUBULAR STEEL Ø (IN) 3.50 (LB / FT) 9.00	TUBULAR STEEL Ø (IN) 4.00 (LB / FT) 10.80	TUBULAR STEEL Ø (IN) 5.00 (LB / FT) 14.60	SIGN FRAME REQUIRED	REMARKS	SIGN DETAIL: DETAIL IN SHS	SIGN DETAIL: DETAIL ON SHEET NUMBER	SIGN DETAIL: DETAIL ON STD SHEET NUMBER
HARTFORD VT 14							FY-FLUORESCENT YELLOW FYG-FLUORESCENT YELLOW GREEN																				"SHS"-STANDARD HIGHWAY SIGNS			
NB	3.841	C	VR-017	24	30		LEGAL LOAD LIMIT 24,000 LBS			1				X												RUNNELS RD TH-22			
NB	3.847	D	R1-1	30	30		STOP			1				X															
NB	4.334	A	W1-2R	30	30		RIGHT CURVE				1				X												SALVAGED TO 4.360 NB			
		A	W13-1	24	24		40 MPH PLAQUE				1																		
NB	4.360	A	W1-2R	30	30		RIGHT CURVE				~~1~~	1			X												INSTALL 150'+/- NORTH OF ORIGINAL LOCATION			
		A	W13-1	24	24		40 MPH PLAQUE				~~1~~	1				1											SALVAGED FROM 4.334 NB			
NB	4.440	A	OM-3R	12	36		RIGHT OBJECT MARKER			1				X															
NB	4.734	A	W1-10R	30	30		MODIFIED RIGHT CURVE			1				X															
		A	W16-8A	30	10		JERICHO ST.			1																			
NB	4.832	C	VR-017	24	30		LEGAL LOAD LIMIT 16,000 LBS			1				X													JERICHO ST TH-18			
NB	4.842	D	R1-1	30	30		STOP			1				X															
NB	4.990	C	VR-017	24	30		LEGAL LOAD LIMIT 16,000 LBS			1				X													JERICHO ST TH-69			
NB	5.011	D	R1-1	30	30		STOP			1				X															
NB	5.783	A	W1-2L	30	30		LEFT CURVE	6.25		1			1	X													SHOTGUN DAMAGE REDO			
NB	5.830	A	VW-133R	30	30		HIDDEN DRIVES RIGHT	6.25		1			1	X													SHOTGUN DAMAGE REDO			
							SHEET TOTALS	~~12.5~~ 0.00 SF	0.00 SF	11 EA	~~2~~ 4 EA	~~2~~ 0 EA	~~2~~ 0 EA	0 EA	0 EA	~~1~~ 0 EA	0 FT												
							TOWN TOTALS	130.2	0.0	41.0	13.0	9.0	26	0.0	0.0	26	390.0												

SIGN SUMMARY SHEET

VERMONT AGENCY OF TRANSPORTATION

PROJECT NAME: **Hartford-East Montpelier VT14**
PROJECT NUMBER: **STPG SIGN(21)**

FILE NAME: **Hartford.xls** PLOT DATE: **6/10/2009**
PROJECT MANAGER: **N. Averv** DRAWN BY: **I. Shea**
DESIGNED BY: **D. Crossley** CHECKED BY: **S. Menard**
HARTFORD SHEET 2 SHEET **9** OF **162**

DIRECTION	MILEPOINT	LOCATION CODE (SHEET 2)	SIGN CODE	WIDTH (IN)	HEIGHT (IN)	SHEETING REMARKS	SIGN LEGEND FOR ALL POST LENGTHS AND INSTALLATION DATES SEE ORIGINAL RECORD PLANS	NEW SIGNS "A"	NEW SIGNS "B"	EXISTING SIGNS RETAIN	EXISTING SIGNS SALVAGE FROM	EXISTING SIGNS SALVAGE TO	EXISTING SIGNS REMOVE	EXIST POST RETAIN	EXIST POST REMOVE	NUMBER OF NEW POSTS	SQUARE STEEL (IN) 1.75 (LB / FT) 1.88	SQUARE STEEL (IN) 2.00 (LB / FT) 2.42	SQUARE STEEL (IN) 2.50 (LB / FT) 3.35	TUBULAR STEEL Ø (IN) FOUNDATION	TUBULAR STEEL Ø (IN) 3.00 (LB / FT) 7.60	TUBULAR STEEL Ø (IN) 3.50 (LB / FT) 9.00	TUBULAR STEEL Ø (IN) 4.00 (LB / FT) 10.80	TUBULAR STEEL Ø (IN) 5.00 (LB / FT) 14.60	SIGN FRAME REQUIRED	REMARKS	SIGN DETAIL: DETAIL IN SHS	SIGN DETAIL: DETAIL ON SHEET NUMBER	SIGN DETAIL: DETAIL ON STD SHEET NUMBER
HARTFORD VT 14							FY-FLUORESCENT YELLOW FYG-FLUORESCENT YELLOW GREEN																			"SHS"-STANDARD HIGHWAY SIGNS			
NB	6.040	C	VR-398	24	30		NO PARKING THIS SIDE						1		X													
NB	6.350	A	W3-5	36	36		SPEED REDUCTION SPEED LIMIT 35	9.00		1			1	X													SHOTGUN DAMAGE REDO			
NB	6.400	A	VD-018	30	18								1		X															
		A	VD-018	30	18			3.75								1		X										E-128B
NB	6.460	A	W1-4R	30	30		RIGHT REVERSE CURVE			1				X														
NB	6.483	A	R2-1	24	30								1		X														
		A	R2-1	30	36			7.50								1		X										6
NB	6.620	A	W11-2	30	30								1		X													
		A	W7-3A	24	18								1															
		A	W11-2	30	30	F-Y-G		6.25								1		X										X
		A	W7-3A	24	18	F-Y-G		3.00																				X
NB	6.667	A	R2-1	24	30		SPEED LIMIT 35			1				X														
NB	6.858	A	M3-1S	24	12		NORTH			1				X														
		A	M1-5	24	24		VERMONT 14			1																		
NB	6.978	C	VR-017	24	30		LEGAL LOAD LIMIT 24,000 LBS			1				X													HARPER SAVAGE LN TH-35			
							SHEET TOTALS	29.50 ~~20.50~~ SF	0.00 SF	6 EA	0 EA	0 EA	6 ~~5~~ EA	0 EA	0 EA	3 EA	45 FT											
							TOWN TOTALS	130.2 SF	0.0 SF	41.0 EA	13.0 EA	9.0 EA	26 EA	0.0 EA	0.0 EA	26 EA	390.0 FT													

SIGN SUMMARY SHEET

VERMONT AGENCY OF TRANSPORTATION

PROJECT NAME: **Hartford-East Montpelier VT14**
PROJECT NUMBER: **STPG SIGN(21)**

FILE NAME: **Hartford.xls** PLOT DATE: **6/10/2009**
PROJECT MANAGER: **N. Avery** DRAWN BY: **I. Shea**
DESIGNED BY: **D. Crossley** CHECKED BY: **S. Menard**
HARTFORD SHEET 3 SHEET **10** OF **162**

DIRECTION	MILEPOINT	LOCATION CODE (SHEET 2)	SIGN CODE	WIDTH (IN)	HEIGHT (IN)	SHEETING REMARKS	SIGN LEGEND FOR ALL POST LENGTHS AND INSTALLATION DATES SEE ORIGINAL RECORD PLANS	NEW SIGNS "A"	NEW SIGNS "B"	EXISTING SIGNS RETAIN	EXISTING SIGNS SALVAGE FROM	EXISTING SIGNS SALVAGE TO	EXISTING SIGNS REMOVE	EXIST POST RETAIN	EXIST POST REMOVE	NUMBER OF NEW POSTS	SQUARE STEEL (IN) 1.75 (LB / FT) 1.88	SQUARE STEEL (IN) 2.00 (LB / FT) 2.42	SQUARE STEEL (IN) 2.50 (LB / FT) 3.35	TUBULAR STEEL Ø (IN) FOUNDATION	TUBULAR STEEL Ø (IN) 3.00 (LB / FT) 7.60	TUBULAR STEEL Ø (IN) 3.50 (LB / FT) 9.00	TUBULAR STEEL Ø (IN) 4.00 (LB / FT) 10.80	TUBULAR STEEL Ø (IN) 5.00 (LB / FT) 14.60	SIGN FRAME REQUIRED	REMARKS	SIGN DETAIL DETAIL IN SHS	SIGN DETAIL DETAIL ON SHEET NUMBER	SIGN DETAIL DETAIL ON STD SHEET NUMBER
HARTFORD VT 14							FY-FLUORESCENT YELLOW FYG-FLUORESCENT YELLOW GREEN																				"SHS"-STANDARD HIGHWAY SIGNS			
NB	6.981	D	R1-1	30	30		STOP			1				X															
NB	6.982	A	R2-1	24	30		SPEED LIMIT 35			1				X															
NB	7.216	A	R2-1	24	30		SPEED LIMIT 35			1				X															
NB	7.256	C	VR-017	24	30		LEGAL LOAD LIMIT 24,000 POUNDS						1		X												TIGER TOWN RD TH-13		
		C	VR-017	24	30			5.00								1		X											E-141
NB	7.262	D	R1-1	30	30		STOP			X				X													TIGER TOWN RD TH-13		
NB	7.437	A	R2-1	24	30		SPEED LIMIT 50 MPH				1				X												SALVAGE TO 7.530 NB		
NB	7.500	A	W1-2L	30	30		LEFT CURVE				1				X												SALVAGE TO 7.590 NB		
		A	W13-1	18	18		40 MPH PLAQUE				1																		
NB	7.530	A	R2-1	24	30		SPEED LIMIT 50 MPH					1				1	X										INSTALL 0.28 MILES (1478') NORTH OF INTERSECTION TIGER TOWN RD. TH-13 SALVAGE FROM 7.437 NB		
NB	7.590	A	W1-2L	30	30		LEFT CURVE					1				1	X										INSTAL L 475' +/- NORTH OF ORIGINAL LOCATION		
		A	W13-1	18	18		40 MPH PLAQUE					1															SALVAGE FROM 7.500 NB		
NB	7.632	A	W1-6	48	24								1	X															
		A	W1-6	48	24			8.00								2													X	
NB	7.665	B	W1-6	48	24								1	X															
SIGN SUMMARY SHEET							SHEET TOTALS	13.00	0.00	~~4~~ 3	3	3	3	0	0	~~5~~ 3	45											
								SF	SF	EA	EA	EA	EA	EA	EA	EA	FT											
VERMONT AGENCY OF TRANSPORTATION							TOWN TOTALS	130.2	0.0	41.0	13.0	9.0	26	0.0	0.0	26	390.0											

PROJECT NAME: **Hartford-East Montpelier VT14**
PROJECT NUMBER: **STPG SIGN(21)**

FILE NAME: **Hartford.xls** PLOT DATE: **6/10/2009**
PROJECT MANAGER: **N. Avery** DRAWN BY: **I. Shea**
DESIGNED BY: **D. Crossley** CHECKED BY: **S. Menard**
HARTFORD SHEET 4 SHEET **11** OF **162**

DIRECTION	MILEPOINT	LOCATION CODE (SHEET 2)	SIGN CODE	WIDTH (IN)	HEIGHT (IN)	SHEETING REMARKS	SIGN LEGEND FOR ALL POST LENGTHS AND INSTALLATION DATES SEE ORIGINAL RECORD PLANS	NEW SIGNS "A"	NEW SIGNS "B"	EXISTING SIGNS RETAIN	EXISTING SIGNS SALVAGE FROM	EXISTING SIGNS SALVAGE TO	EXISTING SIGNS REMOVE	EXIST POST RETAIN	EXIST POST REMOVE	NUMBER OF NEW POSTS	SQUARE STEEL (IN) 1.75 (LB / FT) 1.88	SQUARE STEEL (IN) 2.00 (LB / FT) 2.42	SQUARE STEEL (IN) 2.50 (LB / FT) 3.35	TUBULAR STEEL Ø (IN) FOUNDATION	TUBULAR STEEL Ø (IN) 3.00 (LB / FT) 7.60	TUBULAR STEEL Ø (IN) 3.50 (LB / FT) 9.00	TUBULAR STEEL Ø (IN) 4.00 (LB / FT) 10.80	TUBULAR STEEL Ø (IN) 5.00 (LB / FT) 14.60	SIGN FRAME REQUIRED	REMARKS	SIGN DETAIL DETAIL IN SHS	SIGN DETAIL DETAIL ON SHEET NUMBER	SIGN DETAIL DETAIL ON STD SHEET NUMBER
HARTFORD VT 14							FY-FLUORESCENT YELLOW FYG-FLUORESCENT YELLOW GREEN																			"SHS"-STANDARD HIGHWAY SIGNS			
		B	W1-6	48	24			8.00																		X		
NB	7.679	A	W1-6	48	24								1	X															
		A	W1-6	48	24			8.00																		X		
NB	7.790	A	S3-1	30	30		SCHOOL BUS STOP AHEAD						1		X														
SB	7.761	F	W1-2R	30	30		RIGHT CURVE				1				X												SALVAGED TO 7.720 SB			
		F	W13-1	18	18		40 MPH PLAQUE				1																		
SB	7.720	F	W1-2R	30	30		RIGHT CURVE					1				1	X										INSTALL 200' +/- SOUTH OF ORIGINAL LOCATION			
		F	W13-1	18	18		40 MPH PLAQUE					1															SALVAGED FROM 7.761 SB			
SB	7.665	F	W3-5	36	36			9.00								2	X										INSTALL OPPOSITE RIGHT ARROW	X		
SB	7.586	F	R2-5A	24	30								1		X														
SB	7.586	F	VD-018	30	18			3.75								1	X													E-128B
SB	7.520	F	VD-018	30	18								1		X														
SB	7.530	F	R2-1	30	36			7.50								1	X										INSTALL 0.28 MILES (1478') NORTH OF INTERSECTION TIGER TOWN RD. TH-13		6	
SB	7.440	F	R2-1	24	30								1		X														
SB	7.360	F	W2-2L	30	30		SIDE ROAD LEFT						1		X														
							SHEET TOTALS	36.25 SF	0.00 SF	0 EA	2 EA	2 EA	6 EA	0 EA	0 EA	5 EA	75 FT											
							TOWN TOTALS	130.2	0.0	41.0	13.0	9.0	26	0.0	0.0	26	390.0											

SIGN SUMMARY SHEET

VERMONT AGENCY OF TRANSPORTATION

PROJECT NAME: **Hartford-East Montpelier VT14**
PROJECT NUMBER: **STPG SIGN(21)**

FILE NAME: **Hartford.xls** PLOT DATE: **6/10/2009**
PROJECT MANAGER: **N. Avery** DRAWN BY: **I. Shea**
DESIGNED BY: **D. Crossley** CHECKED BY: **S. Menard**
HARTFORD SHEET 5 SHEET **12** OF **162**

DIRECTION	MILEPOINT	LOCATION CODE (SHEET 2)	SIGN CODE	WIDTH (IN)	HEIGHT (IN)	SHEETING REMARKS	SIGN LEGEND	NEW SIGNS "A"	NEW SIGNS "B"	EXISTING SIGNS RETAIN	EXISTING SIGNS SALVAGE FROM	EXISTING SIGNS SALVAGE TO	EXISTING SIGNS REMOVE	EXIST POST RETAIN	EXIST POST REMOVE	NUMBER OF NEW POSTS	SQUARE STEEL (IN) 1.75 (LB / FT) 1.88	SQUARE STEEL (IN) 2.00 (LB / FT) 2.42	SQUARE STEEL (IN) 2.50 (LB / FT) 3.35	TUBULAR STEEL Ø (IN) FOUNDATION	TUBULAR STEEL Ø (IN) 3.00 (LB / FT) 7.60	TUBULAR STEEL Ø (IN) 3.50 (LB / FT) 9.00	TUBULAR STEEL Ø (IN) 4.00 (LB / FT) 10.80	TUBULAR STEEL Ø (IN) 5.00 (LB / FT) 14.60	SIGN FRAME REQUIRED	REMARKS	SIGN DETAIL: DETAIL IN SHS	SIGN DETAIL: DETAIL ON SHEET NUMBER	SIGN DETAIL: DETAIL ON STD SHEET NUMBER
HARTFORD VT 14							FY-FLUORESCENT YELLOW FYG-FLUORESCENT YELLOW GREEN																				"SHS"-STANDARD HIGHWAY SIGNS			
SB	7.330	F	W11-2	30	30								1																
		F	W7-3A	24	18								1																
		F	W11-2	30	30			6.25								1		X									X		
		F	W7-3A	24	18			3.00																			X		
SB	7.310	F	W2-2L	30	30		SIDE ROAD LEFT	6.25								1		X									INSTALL 100'+/- SOUTH OF PEDESTRIAN SIGN	X		
SB	7.216	F	R2-1	24	30		SPEED LIMIT 35 MPH			1				X															
SB	6.899	H	R1-1	30	30		STOP			1				X															
SB	6.858	F	M3-3S	24	12								1		X														
		F	M1-5	24	24								1																
		F	M3-3	24	12			2.00								1		X									GREEN ON WHITE SHEETING	X		
		F	M1-5	24	24			4.00																				X		E-136B
SB	6.830	F	R2-1	24	30								1		X														
		F	R2-1	24	30			5.00								1		X										X		
SB	6.757	F	W1-4R	30	30		RIGHT REVERSE CURVE			1				X															
SB	6.471	F	R2-1	24	30		SPEED LIMIT 50			1				X															
							SHEET TOTALS	26.50	0.00	4	0	0	5	0	0	4		60											
								SF	SF	EA	EA	EA	EA	EA	EA	EA		FT											
							TOWN TOTALS	130.2	0.0	41.0	13.0	9.0	26	0.0	0.0	26		390.0											









SIGN SUMMARY SHEET

VERMONT AGENCY OF TRANSPORTATION

PROJECT NAME: Hartford-East Montpelier VT14
PROJECT NUMBER: STPG SIGN(21)

FILE NAME: Hartford.xls
PROJECT MANAGER: N. Averv
DESIGNED BY: D. Crossley
HARTFORD SHEET 6

PLOT DATE: 6/10/2009
DRAWN BY: I. Shea
CHECKED BY: S. Menard
SHEET 13 OF 162

DIRECTION	MILEPOINT	LOCATION CODE (SHEET 2)	SIGN CODE	WIDTH (IN)	HEIGHT (IN)	SHEETING REMARKS	SIGN LEGEND FOR ALL POST LENGTHS AND INSTALLATION DATES SEE ORIGINAL RECORD PLANS	NEW SIGNS "A"	NEW SIGNS "B"	EXISTING SIGNS RETAIN	EXISTING SIGNS SALVAGE FROM	EXISTING SIGNS SALVAGE TO	EXISTING SIGNS REMOVE	EXIST POST RETAIN	EXIST POST REMOVE	NUMBER OF NEW POSTS	SQUARE STEEL (IN) 1.75 (LB / FT) 1.88	SQUARE STEEL (IN) 2.00 (LB / FT) 2.42	SQUARE STEEL (IN) 2.50 (LB / FT) 3.35	TUBULAR STEEL Ø (IN) FOUNDATION	TUBULAR STEEL Ø (IN) 3.00 (LB / FT) 7.60	TUBULAR STEEL Ø (IN) 3.50 (LB / FT) 9.00	TUBULAR STEEL Ø (IN) 4.00 (LB / FT) 10.80	TUBULAR STEEL Ø (IN) 5.00 (LB / FT) 14.60	SIGN FRAME REQUIRED	REMARKS	SIGN DETAIL: DETAIL IN SHS	SIGN DETAIL: DETAIL ON SHEET NUMBER	SIGN DETAIL: DETAIL ON STD SHEET NUMBER
HARTFORD VT 14							FY-FLUORESCENT YELLOW FYG-FLUORESCENT YELLOW GREEN																			"SHS"-STANDARD HIGHWAY SIGNS			
SB	6.378	F	S3-1	30	30								1		X														
		F	S3-1	30	30			6.25								1		X									X		
SB	5.970	F	W1-2R	30	30		RIGHT CURVE				1				X												SALVAGED TO 5.940 SB		
SB	5.940	F	W1-2R	30	30		RIGHT CURVE	6.25				1	1			1		X									INSTALL 150' +/- SOUTH OF ORIGINAL LOCATION SALVAGED FROM 5.970 SB		SHOTGUN DAMAGE
SB	4.940	F	W1-10L	30	30		MODIFIED LEFT CURVE						~~1~~ 0		X												NO EXISTING		
		F	W16-8A	30	10								~~1~~ 0														NO EXISTING		
		F	W1-2MbL	30	30			6.25								1		X											6
		F	W16-8A	24	8			1.33																		JERICHO ST.		7
SB	4.610	F	W1-2L	30	30		LEFT CURVE	6.25		1			1	X													SHOTGUN DAMAGE		
		F	W13-1	24	24		40 MPH PLAQUE			1																			
SB	4.471	F	W1-6	48	24		<=== LEFT LARGE ARROW	8.00			1	1	1			2		X									SHOTGUN DAMAGE INSTALL SIGN ON NEW POSTS		
		E	W1-6	48	24		RIGHT ===> LARGE ARROW				1	1															INSTALL SIGN ON NEW POSTS		
SB	4.436	F	W1-6	48	24		<=== LEFT LARGE ARROW	8.00			1	1	1			2		X									SHOTGUN DAMAGE INSTALL SIGN ON NEW POSTS		
SB	3.992	F	W2-2L	30	30		LEFT SIDE ROAD	6.25		1				X															
		F	W16-8A	30	10								1																
							SHEET TOTALS	~~13.83~~ 48.58 SF	0.00 SF	3 EA	4 EA	4 EA	~~4~~ 5 EA	0 EA	0 EA	7 EA	105 FT											
							TOWN TOTALS	130.2	0.0	41.0	13.0	9.0	26	0.0	0.0	26	390.0												

SIGN SUMMARY SHEET

VERMONT AGENCY OF TRANSPORTATION

PROJECT NAME: Hartford-East Montpelier VT14
PROJECT NUMBER: STPG SIGN(21)

FILE NAME: Hartford.xls
PROJECT MANAGER: N. Avery
DESIGNED BY: D. Crossley
HARTFORD SHEET 7

PLOT DATE: 6/10/2009
DRAWN BY: I. Shea
CHECKED BY: S. Menard
SHEET 14 OF 162

DIRECTION	MILEPOINT	LOCATION CODE (SHEET 2)	SIGN CODE	WIDTH (IN)	HEIGHT (IN)	SHEETING REMARKS	SIGN LEGEND FOR ALL POST LENGTHS AND INSTALLATION DATES SEE ORIGINAL RECORD PLANS	NEW SIGNS "A"	NEW SIGNS "B"	EXISTING SIGNS RETAIN	EXISTING SIGNS SALVAGE FROM	EXISTING SIGNS SALVAGE TO	EXISTING SIGNS REMOVE	EXIST POST RETAIN	EXIST POST REMOVE	NUMBER OF NEW POSTS	SQUARE STEEL (IN) 1.75 (LB / FT) 1.88	SQUARE STEEL (IN) 2.00 (LB / FT) 2.42	SQUARE STEEL (IN) 2.50 (LB / FT) 3.35	TUBULAR STEEL Ø (IN) FOUNDATION	TUBULAR STEEL Ø (IN) 3.00 (LB / FT) 7.60	TUBULAR STEEL Ø (IN) 3.50 (LB / FT) 9.00	TUBULAR STEEL Ø (IN) 4.00 (LB / FT) 10.80	TUBULAR STEEL Ø (IN) 5.00 (LB / FT) 14.60	SIGN FRAME REQUIRED	REMARKS	SIGN DETAIL DETAIL IN SHS	SIGN DETAIL DETAIL ON SHEET NUMBER	SIGN DETAIL DETAIL ON STD SHEET NUMBER
HARTFORD VT 14							FY-FLUORESCENT YELLOW FYG-FLUORESCENT YELLOW GREEN																			"SHS"-STANDARD HIGHWAY SIGNS			
		F	W16-8A	24	8			1.33																				7	
SB	2.144	G	VR-023B	24	30								0 ~~1~~		0 ~~X~~											NO EXISTING			
		G	VR-023B	24	30			5.00								1		X										E-144
SB	1.603	F	W3-5	36	36		SPEED REDUCTION AHEAD SPEED LIMIT 30			1				X															
SB	1.533	F	VD-018	30	18			3.75								1		X							INSTALL ACROSS FROM VT 14 SIGN			E-128B
SB	1.477	F	VR-038	24	18		STATE HIGHWAY ENDS			1				X															
		F	R2-1	24	30		SPEED LIMIT 30			1																			
SIGN SUMMARY SHEET							SHEET TOTALS	10.08	0.00	3	0	0	0 ~~1~~	0	0	2	30											
								SF	SF	EA	EA	EA	EA	EA	EA	EA	FT											
VERMONT AGENCY OF TRANSPORTATION							TOWN TOTALS	130.2	0.0	41.0	13.0	9.0	26	0.0	0.0	26	390.0											

PROJECT NAME: **Hartford-East Montpelier VT14**
PROJECT NUMBER: **STPG SIGN(21)**

FILE NAME: **Hartford.xls** PLOT DATE: **6/10/2009**
PROJECT MANAGER: **N. Avery** DRAWN BY: **I. Shea**
DESIGNED BY: **D. Crossley** CHECKED BY: **S. Menard**
HARTFORD SHEET 8 SHEET **15** OF **162**

DIRECTION	MILEPOINT	LOCATION CODE (SHEET 2)	SIGN CODE	WIDTH (IN)	HEIGHT (IN)	SHEETING REMARKS	SIGN LEGEND FOR ALL POST LENGTHS AND INSTALLATION DATES SEE ORIGINAL RECORD PLANS	NEW SIGNS "A"	NEW SIGNS "B"	EXISTING SIGNS RETAIN	EXISTING SIGNS SALVAGE FROM	EXISTING SIGNS SALVAGE TO	EXISTING SIGNS REMOVE	EXIST POST RETAIN	EXIST POST REMOVE	NUMBER OF NEW POSTS	SQUARE STEEL (IN) 1.75 (LB / FT) 1.88	SQUARE STEEL (IN) 2.00 (LB / FT) 2.42	SQUARE STEEL (IN) 2.50 (LB / FT) 3.35	TUBULAR STEEL Ø (IN) FOUNDATION	TUBULAR STEEL Ø (IN) 3.00 (LB / FT) 7.60	TUBULAR STEEL Ø (IN) 3.50 (LB / FT) 9.00	TUBULAR STEEL Ø (IN) 4.00 (LB / FT) 10.80	TUBULAR STEEL Ø (IN) 5.00 (LB / FT) 14.60	SIGN FRAME REQUIRED	REMARKS	SIGN DETAIL: DETAIL IN SHS	SIGN DETAIL: DETAIL ON SHEET NUMBER	SIGN DETAIL: DETAIL ON STD SHEET NUMBER
SHARON VT14							FY-FLUORESCENT YELLOW FYG-FLUORESCENT YELLOW GREEN																			"SHS"-STANDARD HIGHWAY SIGNS			
NB	0.000																									(SEE SHEET 29)			
NB	0.008	C	VR-017	24	30		LEGAL LOAD LIMIT 24,000 LBS			1				X												SHAREHART RD TH-43			
NB	0.014	D	R1-1	30	30		STOP			1				X															
NB	0.600	A	VW-054	30	30		HIDDEN DRIVE RIGHT 						1		X														
NB	0.620	A	VW-054	30	30			6.25								1		X								INSTALL 100' +/- NORTH OF ORIGINAL SIGN LOCATION			E-154
NB	2.775	A	W1-4R	30	30								1		X														
		A	W13-1	18	18								1																
NB	2.805	A	W1-4R	30	30			6.25								1		X								INSTALL 160' NORTH OF ORIGINAL SIGN LOCATION		X	
		A	W13-1	18	18			2.25																				X	
NB	2.864	A	S3-1	30	30		SCHOOL BUS STOP AHEAD						1		X														
NB	2.906	A	W12-2	36	36								1		X														
		A	W12-2	30	30			6.25								1		X										X	
NB	2.948	A	OM-3R	12	36								1		X														
		A	OM-3R	12	36	FY		3.00								1		X										X	
NB	2.960	B	W1-6	48	24								1		X														
		B	W1-6	48	24			8.00								2		X										X	
							SHEET TOTALS	32.00	0.00	2	0	0	7	0	0	6		90											
								SF	SF	EA	EA	EA	EA	EA	EA	EA		FT											
							TOWN TOTALS	447.0	0.0	11.0	1.0	1.0	93	0.0	0.0	64		960.0											

SIGN SUMMARY SHEET

VERMONT AGENCY OF TRANSPORTATION

PROJECT NAME: **Hartford-East Montpelier VT14**
PROJECT NUMBER: **STPG SIGN(21)**

FILE NAME: **Sharon.xls**
PROJECT MANAGER: **N. Avery**
DESIGNED BY: **D. Crossley**
SHARON SHEET 1

PLOT DATE: **6/10/2009**
DRAWN BY: **T. Guazzoni**
CHECKED BY: **S. Menard**
SHEET **16** OF **162**

DIRECTION	MILEPOINT	LOCATION CODE (SHEET 2)	SIGN CODE	WIDTH (IN)	HEIGHT (IN)	SHEETING REMARKS	SIGN LEGEND FOR ALL POST LENGTHS AND INSTALLATION DATES SEE ORIGINAL RECORD PLANS	NEW SIGNS "A"	NEW SIGNS "B"	EXISTING SIGNS RETAIN	EXISTING SIGNS SALVAGE FROM	EXISTING SIGNS SALVAGE TO	EXISTING SIGNS REMOVE	EXIST POST RETAIN	EXIST POST REMOVE	NUMBER OF NEW POSTS	SQUARE STEEL (IN) 1.75 (LB / FT) 1.88	SQUARE STEEL (IN) 2.00 (LB / FT) 2.42	SQUARE STEEL (IN) 2.50 (LB / FT) 3.35	TUBULAR STEEL Ø (IN) FOUNDATION	TUBULAR STEEL Ø (IN) 3.00 (LB / FT) 7.60	TUBULAR STEEL Ø (IN) 3.50 (LB / FT) 9.00	TUBULAR STEEL Ø (IN) 4.00 (LB / FT) 10.80	TUBULAR STEEL Ø (IN) 5.00 (LB / FT) 14.60	SIGN FRAME REQUIRED	REMARKS	SIGN DETAIL DETAIL IN SHS	SIGN DETAIL DETAIL ON SHEET NUMBER	SIGN DETAIL DETAIL ON STD SHEET NUMBER
SHARON VT14							FY-FLUORESCENT YELLOW FYG-FLUORESCENT YELLOW GREEN																			"SHS"-STANDARD HIGHWAY SIGNS			
NB	3.660	A	W7-1B	30	30								1		X													
		A	W7-1B	30	30			6.25								1		X								X		
NB	3.762	C	VR-017	24	30								1		X											QUIMBY MOUNTAIN RD TH-11			
		C	VR-017	24	30			5.00								1		X										E-141
NB	3.768	D	R1-1	30	30		STOP			1				X														
NB	4.006	A	S3-1	30	30		SCHOOL BUS STOP AHEAD						1		X													
NB	4.250	A	R2-5A	24	30								1		X													
		A	W3-5	36	36			9.00								2		X								X		
NB	4.390	A	R2-1	24	30								1		X													
		A	R2-1	30	36			7.50								1		X										6
NB	4.530	A	W11-2	30	30								~~1~~ 2		X											REMOVED MM PLAQUE			
		A	W11-2	30	30	FYG		6.25								1		X								X		
		A	W7-3A	18	24	FYG		3.00																		X		
NB	4.600	A	R2-1	24	30								1		X													
		A	R2-1	30	36			7.50								1		X										6
SIGN SUMMARY SHEET							SHEET TOTALS	44.50 SF	0.00 SF	1 EA	0 EA	0 EA	~~8~~ 7 EA	0 EA	0 EA	7 EA		105 FT										
VERMONT AGENCY OF TRANSPORTATION							TOWN TOTALS	447.0	0.0	11.0	1.0	1.0	93	0.0	0.0	64		960.0										

PROJECT NAME: **Hartford-East Montpelier VT14**
PROJECT NUMBER: **STPG SIGN(21)**

FILE NAME: **Sharon.xls** PLOT DATE: **6/10/2009**
PROJECT MANAGER: **N. Avery** DRAWN BY: **T. Guazzoni**
DESIGNED BY: **D. Crossley** CHECKED BY: **S. Menard**
SHARON SHEET 2 SHEET **17** OF **162**

DIRECTION	MILEPOINT	LOCATION CODE (SHEET 2)	SIGN CODE	WIDTH (IN)	HEIGHT (IN)	SHEETING REMARKS	SIGN LEGEND	NEW SIGNS "A"	NEW SIGNS "B"	EXISTING SIGNS RETAIN	EXISTING SIGNS SALVAGE FROM	EXISTING SIGNS SALVAGE TO	EXISTING SIGNS REMOVE	EXIST POST RETAIN	EXIST POST REMOVE	NUMBER OF NEW POSTS	SQUARE STEEL (IN) 1.75 (LB / FT) 1.88	SQUARE STEEL (IN) 2.00 (LB / FT) 2.42	SQUARE STEEL (IN) 2.50 (LB / FT) 3.35	TUBULAR STEEL Ø (IN) FOUNDATION	TUBULAR STEEL Ø (IN) 3.00 (LB / FT) 7.60	TUBULAR STEEL Ø (IN) 3.50 (LB / FT) 9.00	TUBULAR STEEL Ø (IN) 4.00 (LB / FT) 10.80	TUBULAR STEEL Ø (IN) 5.00 (LB / FT) 14.60	SIGN FRAME REQUIRED	REMARKS	SIGN DETAIL: DETAIL IN SHS	SIGN DETAIL: DETAIL ON SHEET NUMBER	SIGN DETAIL: DETAIL ON STD SHEET NUMBER
SHARON VT14							FY-FLUORESCENT YELLOW FYG-FLUORESCENT YELLOW GREEN																				"SHS"-STANDARD HIGHWAY SIGNS			
NB	4.782	A	R2-1	24	30								1		X														
		A	R2-1	24	30			5.00								1		X									X		
NB	4.820	A	VD-062A	72	16		BUSINESS SIGN			1				X															
NB	4.910	A	M2-1S	21	15								1		X														
		A	M1-5	30	24								1																
		A	M4-5	24	12								1		X														
		A	M1-1	24	24								1																
		A	M5-1	21	15								1																
		A	M2-1S	21	15			2.19								1		X							1A	GREEN ON WHITE SHEETING	X	7	
		A	M1-5	30	24			5.00																					E-136B
		A	M4-5	24	12			2.00								1		X									WHITE ON BLUE SHEETING	X		
		A	M1-1	24	24			4.00																				X		
		A	M5-1	21	15			2.19																			WHITE ON BLUE SHEETING	X		
NB	4.950	A	D1-1A	72	10								1		X														
		A	D1-1A	72	10								1																
							SHEET TOTALS	20.38	0.00	1	0	0	8	0	0	3		45										
								SF	SF	EA	EA	EA	EA	EA	EA	EA		FT										
							TOWN TOTALS	447.0	0.0	11.0	1.0	1.0	93	0.0	0.0	64		960.0										

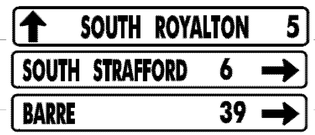
SIGN SUMMARY SHEET

VERMONT AGENCY OF TRANSPORTATION

PROJECT NAME: Hartford-East Montpelier VT14
PROJECT NUMBER: STPG SIGN(21)

FILE NAME: Sharon.xls
PROJECT MANAGER: N. Avery
DESIGNED BY: D. Crossley
SHARON SHEET 3

PLOT DATE: 6/10/2009
DRAWN BY: T. Guazzoni
CHECKED BY: S. Menard

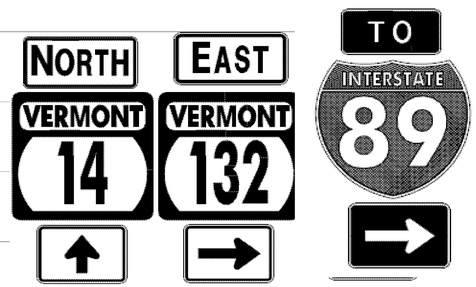
DIRECTION	MILEPOINT	LOCATION CODE (SHEET 2)	SIGN CODE	WIDTH (IN)	HEIGHT (IN)	SHEETING REMARKS	SIGN LEGEND	NEW SIGNS "A"	NEW SIGNS "B"	EXISTING SIGNS RETAIN	EXISTING SIGNS SALVAGE FROM	EXISTING SIGNS SALVAGE TO	EXISTING SIGNS REMOVE	EXIST POST RETAIN	EXIST POST REMOVE	NUMBER OF NEW POSTS	SQUARE STEEL (IN) 1.75 (LB / FT) 1.88	SQUARE STEEL (IN) 2.00 (LB / FT) 2.42	SQUARE STEEL (IN) 2.50 (LB / FT) 3.35	TUBULAR STEEL Ø (IN) FOUNDATION	TUBULAR STEEL Ø (IN) 3.00 (LB / FT) 7.60	TUBULAR STEEL Ø (IN) 3.50 (LB / FT) 9.00	TUBULAR STEEL Ø (IN) 4.00 (LB / FT) 10.80	TUBULAR STEEL Ø (IN) 5.00 (LB / FT) 14.60	SIGN FRAME REQUIRED	REMARKS	SIGN DETAIL: DETAIL IN SHS	SIGN DETAIL: DETAIL ON SHEET NUMBER	SIGN DETAIL: DETAIL ON STD SHEET NUMBER
SHARON VT14							FY-FLUORESCENT YELLOW FYG-FLUORESCENT YELLOW GREEN																			"SHS"-STANDARD HIGHWAY SIGNS			
		A	D1-1A	72	10								1															
		A	D1-1A	72	12			6.00								2		X									5	
		A	D1-1A	72	12			6.00																				5	
		A	D1-1A	72	12			6.00																				5	
NB	4.990	A	M3-1S	24	12								1	X														
		A	M1-5	24	24								1															
		A	M6-3S	21	15								1															
		A	M3-2S	24	12								1															
		A	M1-5	30	24								1															
		A	M6-1S	21	15								1															
		A	M4-5	24	12								1															
		A	M1-1	24	24								1															
		A	M6-1	21	15								1															
		A	M3-1S	24	12			2.00																		3B	GREEN ON WHITE SHEETING	X	7	
		A	M1-5	24	24			4.00																					E-136B
							SHEET TOTALS	24.00	0.00	0	0	0	10	0	0	2		30										
								SF	SF	EA	EA	EA	EA	EA	EA	EA		FT										
							TOWN TOTALS	447.0	0.0	11.0	1.0	1.0	93	0.0	0.0	64		960.0										

SIGN SUMMARY SHEET

VERMONT AGENCY OF TRANSPORTATION

PROJECT NAME: **Hartford-East Montpelier VT14**
PROJECT NUMBER: **STPG SIGN(21)**

FILE NAME: **Sharon.xls** PLOT DATE: **6/10/2009**
PROJECT MANAGER: **N. Avery** DRAWN BY: **T. Guazzoni**
DESIGNED BY: **D. Crossley** CHECKED BY: **S. Menard**
SHARON SHEET 4 SHEET **19** OF **162**

DIRECTION	MILEPOINT	LOCATION CODE (SHEET 2)	SIGN CODE	WIDTH (IN)	HEIGHT (IN)	SHEETING REMARKS	SIGN LEGEND	NEW SIGNS "A"	NEW SIGNS "B"	EXISTING SIGNS RETAIN	EXISTING SIGNS SALVAGE FROM	EXISTING SIGNS SALVAGE TO	EXISTING SIGNS REMOVE	EXIST POST RETAIN	EXIST POST REMOVE	NUMBER OF NEW POSTS	SQUARE STEEL (IN) 1.75 (LB / FT) 1.88	SQUARE STEEL (IN) 2.00 (LB / FT) 2.42	SQUARE STEEL (IN) 2.50 (LB / FT) 3.35	TUBULAR STEEL Ø (IN) FOUNDATION	TUBULAR STEEL Ø (IN) 3.00 (LB / FT) 7.60	TUBULAR STEEL Ø (IN) 3.50 (LB / FT) 9.00	TUBULAR STEEL Ø (IN) 4.00 (LB / FT) 10.80	TUBULAR STEEL Ø (IN) 5.00 (LB / FT) 14.60	SIGN FRAME REQUIRED	REMARKS	SIGN DETAIL: DETAIL IN SHS	SIGN DETAIL: DETAIL ON SHEET NUMBER	SIGN DETAIL: DETAIL ON STD SHEET NUMBER
SHARON VT14							FY-FLUORESCENT YELLOW FYG-FLUORESCENT YELLOW GREEN																			"SHS"-STANDARD HIGHWAY SIGNS			
		A	M6-3S	21	15			2.19																		GREEN ON WHITE SHEETING	X		
		A	M3-2S	24	12			2.00																		GREEN ON WHITE SHEETING	X		
		A	M1-5	30	24			5.00																				E-136B
		A	M6-1S	21	15			2.19																		GREEN ON WHITE SHEETING	X		
		A	M4-5	24	12			2.00																		BLUE ON WHITE SHEETING	X		
		A	M1-1	24	24			4.00																			X		
		A	M6-1	21	15			2.19																		BLUE ON WHITE SHEETING	X		
		B	M3-2	24	12								1																
		B	M1-5	30	24								1																
		B	M6-1S	21	15								1																
		B	M4-5	24	12								1																
		B	M1-1	24	24								1																
		B	M6-1	21	15								1																
		B	M3-3	24	12								1																
		B	M1-5	24	24								1																
							SHEET TOTALS	19.57	0.00	0	0	0	8	0	0	0	0												
								SF	SF	EA	EA	EA	EA	EA	EA	EA	FT												
							TOWN TOTALS	447.0	0.0	11.0	1.0	1.0	93	0.0	0.0	64	960.0												

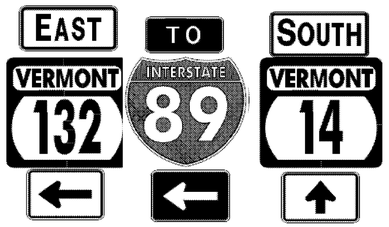
SIGN SUMMARY SHEET

VERMONT AGENCY OF TRANSPORTATION

PROJECT NAME: Hartford-East Montpelier VT14
PROJECT NUMBER: STPG SIGN(21)

FILE NAME: Sharon.xls
PROJECT MANAGER: N. Avery
DESIGNED BY: D. Crossley
SHARON SHEET 5

PLOT DATE: 6/10/2009
DRAWN BY: T. Guazzoni
CHECKED BY: S. Menard

DIRECTION	MILEPOINT	LOCATION CODE (SHEET 2)	SIGN CODE	WIDTH (IN)	HEIGHT (IN)	SHEETING REMARKS	SIGN LEGEND FOR ALL POST LENGTHS AND INSTALLATION DATES SEE ORIGINAL RECORD PLANS	NEW SIGNS "A"	NEW SIGNS "B"	EXISTING SIGNS RETAIN	EXISTING SIGNS SALVAGE FROM	EXISTING SIGNS SALVAGE TO	EXISTING SIGNS REMOVE	EXIST POST RETAIN	EXIST POST REMOVE	NUMBER OF NEW POSTS	SQUARE STEEL (IN) 1.75 (LB / FT) 1.88	SQUARE STEEL (IN) 2.00 (LB / FT) 2.42	SQUARE STEEL (IN) 2.50 (LB / FT) 3.35	TUBULAR STEEL Ø (IN) FOUNDATION	TUBULAR STEEL Ø (IN) 3.00 (LB / FT) 7.60	TUBULAR STEEL Ø (IN) 3.50 (LB / FT) 9.00	TUBULAR STEEL Ø (IN) 4.00 (LB / FT) 10.80	TUBULAR STEEL Ø (IN) 5.00 (LB / FT) 14.60	SIGN FRAME REQUIRED	REMARKS	SIGN DETAIL: DETAIL IN SHS	SIGN DETAIL: DETAIL ON SHEET NUMBER	SIGN DETAIL: DETAIL ON STD SHEET NUMBER
SHARON VT14							FY-FLUORESCENT YELLOW FYG-FLUORESCENT YELLOW GREEN																			"SHS"-STANDARD HIGHWAY SIGNS			
		B	M6-3S	21	15								1																
		B	M3-2	24	12			2.00																	3B	GREEN ON WHITE SHEETING	X	7	
		B	M1-5	30	24			5.00																				E-136B
		B	M6-1	21	15			2.19																		GREEN ON WHITE SHEETING	X		
		B	M4-5	24	12			2.00																WHITE ON BLUE SHEETING	X		
		B	M1-1	24	24			4.00																			X		
		B	M6-1	21	15			2.19																		WHITE ON BLUE SHEETING	X		
		B	M3-3	24	12			2.00																		GREEN ON WHITE SHEETING	X		
		B	M1-5	24	24			4.00																				E-136B
		B	M6-3	21	15			2.19																		GREEN ON WHITE SHEETING	X		
NB	5.050	A	M3-1S	24	12								1		X													
		A	M1-5	24	24								1															
		A	M3-1S	24	12			2.00								1	X									GREEN ON WHITE SHEETING	X		
		A	M1-5	24	24			4.00																				E-136B
NB	5.092	A	R2-1	24	30								~~1~~ 0		X													
							SHEET TOTALS	31.57 SF	0.00 SF	0 EA	0 EA	0 EA	~~4~~ 3 EA	0 EA	0 EA	1 EA	15 FT											
							TOWN TOTALS	447.0	0.0	11.0	1.0	1.0	93	0.0	0.0	64	960.0											

SIGN SUMMARY SHEET

VERMONT AGENCY OF TRANSPORTATION

PROJECT NAME: **Hartford-East Montpelier VT14**
PROJECT NUMBER: **STPG SIGN(21)**

FILE NAME: **Sharon.xls**
PROJECT MANAGER: **N. Averv**
DESIGNED BY: **D. Crossley**
SHARON SHEET 6

PLOT DATE: **6/10/2009**
DRAWN BY: **T. Guazzoni**
CHECKED BY: **S. Menard**
SHEET **21** OF **162**

DIRECTION	MILEPOINT	LOCATION CODE (SHEET 2)	SIGN CODE	WIDTH (IN)	HEIGHT (IN)	SHEETING REMARKS	SIGN LEGEND FOR ALL POST LENGTHS AND INSTALLATION DATES SEE ORIGINAL RECORD PLANS	NEW SIGNS "A"	NEW SIGNS "B"	EXISTING SIGNS RETAIN	EXISTING SIGNS SALVAGE FROM	EXISTING SIGNS SALVAGE TO	EXISTING SIGNS REMOVE	EXIST POST RETAIN	EXIST POST REMOVE	NUMBER OF NEW POSTS	SQUARE STEEL (IN) 1.75 (LB / FT) 1.88	SQUARE STEEL (IN) 2.00 (LB / FT) 2.42	SQUARE STEEL (IN) 2.50 (LB / FT) 3.35	TUBULAR STEEL Ø (IN) FOUNDATION	TUBULAR STEEL Ø (IN) 3.00 (LB / FT) 7.60	TUBULAR STEEL Ø (IN) 3.50 (LB / FT) 9.00	TUBULAR STEEL Ø (IN) 4.00 (LB / FT) 10.80	TUBULAR STEEL Ø (IN) 5.00 (LB / FT) 14.60	SIGN FRAME REQUIRED	REMARKS	SIGN DETAIL DETAIL IN SHS	SIGN DETAIL DETAIL ON SHEET NUMBER	SIGN DETAIL DETAIL ON STD SHEET NUMBER
SHARON VT14							FY-FLUORESCENT YELLOW FYG-FLUORESCENT YELLOW GREEN																				"SHS"-STANDARD HIGHWAY SIGNS			
		A	NA	12	18								1													REMOVE ILLEGAL SIGN			
		A	R2-1	24	30			5.00								1		X									X		
NB	5.322	C	VR-017	24	30		LEGAL LOAD LIMIT 24,000 LBS			1				X													FAY BROOK RD TH-17			
NB	5.332	D	R1-1	30	30		STOP			1				X																
NB	5.370	A	D2-1	72	10								1		X															
		A	D2-1	72	12			6.00								2		X										5	
NB	5.470	A	R2-1	24	30								1		X															
		A	R2-1	24	30			5.00								1		X									X		
NB	5.670	A	R2-1	24	30								1		X															
		A	R2-1	24	30			5.00								1		X									X		
NB	5.695	A	W11-8	30	30								1		X															
		A	W11-8	30	30			6.25								1		X									X		
NB	6.000	A	R2-1	24	30								1		X															
		A	R2-1	24	30			5.00								1		X									X		
NB	6.030	A	W1-2L	30	30								1		X			~~X~~											
							SHEET TOTALS	32.25	0.00	2	0	0	7	0	0	7		105											
								SF	SF	EA	EA	EA	EA	EA	EA	EA		FT											
							TOWN TOTALS	447.0	0.0	11.0	1.0	1.0	93	0.0	0.0	64		960.0											

SIGN SUMMARY SHEET

VERMONT AGENCY OF TRANSPORTATION

PROJECT NAME: **Hartford-East Montpelier VT14**
PROJECT NUMBER: **STPG SIGN(21)**

FILE NAME: **Sharon.xls** PLOT DATE: **6/10/2009**
PROJECT MANAGER: **N. Avery** DRAWN BY: **T. Guazzoni**
DESIGNED BY: **D. Crossley** CHECKED BY: **S. Menard**
SHARON SHEET 7 SHEET **22** OF **162**

DIRECTION	MILEPOINT	LOCATION CODE (SHEET 2)	SIGN CODE	WIDTH (IN)	HEIGHT (IN)	SHEETING REMARKS	SIGN LEGEND FOR ALL POST LENGTHS AND INSTALLATION DATES SEE ORIGINAL RECORD PLANS	NEW SIGNS "A"	NEW SIGNS "B"	EXISTING SIGNS RETAIN	EXISTING SIGNS SALVAGE FROM	EXISTING SIGNS SALVAGE TO	EXISTING SIGNS REMOVE	EXIST POST RETAIN	EXIST POST REMOVE	NUMBER OF NEW POSTS	SQUARE STEEL (IN) 1.75 (LB / FT) 1.88	SQUARE STEEL (IN) 2.00 (LB / FT) 2.42	SQUARE STEEL (IN) 2.50 (LB / FT) 3.35	TUBULAR STEEL Ø (IN) FOUNDATION	TUBULAR STEEL Ø (IN) 3.00 (LB / FT) 7.60	TUBULAR STEEL Ø (IN) 3.50 (LB / FT) 9.00	TUBULAR STEEL Ø (IN) 4.00 (LB / FT) 10.80	TUBULAR STEEL Ø (IN) 5.00 (LB / FT) 14.60	SIGN FRAME REQUIRED	REMARKS	SIGN DETAIL DETAIL IN SHS	SIGN DETAIL DETAIL ON SHEET NUMBER	SIGN DETAIL DETAIL ON STD SHEET NUMBER
SHARON VT14							FY-FLUORESCENT YELLOW FYG-FLUORESCENT YELLOW GREEN																				"SHS"-STANDARD HIGHWAY SIGNS			
NB	6.100	A	W1-2L	30	30			6.25								1		X								INSTALL 425'+/- NORTH OF ORIGINAL SIGN LOCATION	X		
NB	6.160	A	W1-8L	18	24			3.00								1		X								INSTALL AT APEX OF CURVE	X		
		B	W1-8R	18	24			3.00								1		X								INSTALL AT APEX OF CURVE	X		
NB	6.516	C	VR-017	24	30								0 ~~1~~		~~X~~											WHITE BROOK RD TH-7			
		C	VR-017	24	30			5.00								1		X											E-141
NB	6.523	D	R1-1	30	30								1			~~X~~													
		D	R1-1	30	30			6.25								1		X									X		
NB	6.630	A	D1-1E	72	20		THE SHARON ACADEMY --->			1				X															
NB	6.773	D	R1-1	30	30								1		X														
		D	R1-1	30	30			6.25								1		X									X		
SB	7.000	G	VR-023B	20	30			5.00								1		X										6	
SB	6.990	F	VW-202	30	30								1		X														
		F	VW-202	30	30			6.25								1		X											E-154
SB	6.870	F	D1-1E	72	20		<--- THE SHARON ACADEMY			1				X															
SB	6.530	G	VR-278	24	36		PROHIBITED DUMPING HOUSEHOLD TRASH IN OR ABOUT CONTAINER						1		X														
							SHEET TOTALS	41.00 SF	0.00 SF	2 EA	0 EA	0 EA	~~4~~ 5 EA	0 EA	0 EA	8 EA		120 FT										
							TOWN TOTALS	447.0	0.0	11.0	1.0	1.0	93	0.0	0.0	64		960.0										

SIGN SUMMARY SHEET

VERMONT AGENCY OF TRANSPORTATION

PROJECT NAME: **Hartford-East Montpelier VT14**
PROJECT NUMBER: **STPG SIGN(21)**

FILE NAME: **Sharon.xls** PLOT DATE: **6/10/2009**
PROJECT MANAGER: **N. Avery** DRAWN BY: **T. Guazzoni**
DESIGNED BY: **D. Crossley** CHECKED BY: **S. Menard**
SHARON SHEET 8 SHEET **23** OF **162**

DIRECTION	MILEPOINT	LOCATION CODE (SHEET 2)	SIGN CODE	WIDTH (IN)	HEIGHT (IN)	SHEETING REMARKS	SIGN LEGEND	NEW SIGNS "A"	NEW SIGNS "B"	EXISTING SIGNS RETAIN	EXISTING SIGNS SALVAGE FROM	EXISTING SIGNS SALVAGE TO	EXISTING SIGNS REMOVE	EXIST POST RETAIN	EXIST POST REMOVE	NUMBER OF NEW POSTS	SQUARE STEEL (IN) 1.75 (LB / FT) 1.88	SQUARE STEEL (IN) 2.00 (LB / FT) 2.42	SQUARE STEEL (IN) 2.50 (LB / FT) 3.35	TUBULAR STEEL Ø (IN) FOUNDATION	TUBULAR STEEL Ø (IN) 3.00 (LB / FT) 7.60	TUBULAR STEEL Ø (IN) 3.50 (LB / FT) 9.00	TUBULAR STEEL Ø (IN) 4.00 (LB / FT) 10.80	TUBULAR STEEL Ø (IN) 5.00 (LB / FT) 14.60	SIGN FRAME REQUIRED	REMARKS	SIGN DETAIL: DETAIL IN SHS	SIGN DETAIL: DETAIL ON SHEET NUMBER	SIGN DETAIL: DETAIL ON STD SHEET NUMBER
SHARON VT14							FY-FLUORESCENT YELLOW FYG-FLUORESCENT YELLOW GREEN																			"SHS"-STANDARD HIGHWAY SIGNS			
		G	VR-023B	24	30		$500 FINE FOR THROWING TRASH ON HIGHWAYS AND STREAMS	5.00								1		X									6	
SB	6.350	F	W1-4L	30	30		LEFT REVERSE CURVE						1		X													
SB	6.120	F	R2-5A	24	30		REDUCED SPEED AHEAD						1		X													
		F	W3-5	36	36		SPEED LIMIT 40	9.00								2		X									X	
SB	6.000	F	R2-1	24	30								1		X													
		F	R2-1	30	36		SPEED LIMIT 40	7.50								1												6	
SB	5.670	F	R2-1	24	30								1		X													
		F	R2-1	24	30		SPEED LIMIT 40	5.00								1		X									X	
SB	5.520	F	VD-018	30	18								1		X													
		F	VD-018	30	18		SHARON WEST HARTFORD 6	3.75								1		X											E-128B
SB	5.490	F	W11-2	30	30								1		X													
		F	W11-2	30	30	FYG		6.25								1		X									X	
		F	W7-3A	18	24	FYG	NEXT 1 MILE	3.00																			X	
SB	5.450	F	R2-1	24	30								1		X													
		F	R2-1	30	36		SPEED LIMIT 35	7.50								1		X										6	
SIGN SUMMARY SHEET							SHEET TOTALS	47.00	0.00	0	0	0	7	0	0	8		120									
VERMONT AGENCY OF TRANSPORTATION								SF	SF	EA	EA	EA	EA	EA	EA	EA		FT									
							TOWN TOTALS	447.0	0.0	11.0	1.0	1.0	93	0.0	0.0	64		960.0									

PROJECT NAME: **Hartford-East Montpelier VT14**
PROJECT NUMBER: **STPG SIGN(21)**

FILE NAME: **Sharon.xls** PLOT DATE: **6/10/2009**
PROJECT MANAGER: **N. Averv** DRAWN BY: **T. Guazzoni**
DESIGNED BY: **D. Crossley** CHECKED BY: **S. Menard**
SHARON SHEET 9 SHEET **24** OF **162**

DIRECTION	MILEPOINT	LOCATION CODE (SHEET 2)	SIGN CODE	WIDTH (IN)	HEIGHT (IN)	SHEETING REMARKS	SIGN LEGEND	NEW SIGNS "A"	NEW SIGNS "B"	EXISTING SIGNS RETAIN	EXISTING SIGNS SALVAGE FROM	EXISTING SIGNS SALVAGE TO	EXISTING SIGNS REMOVE	EXIST POST RETAIN	EXIST POST REMOVE	NUMBER OF NEW POSTS	SQUARE STEEL (IN) 1.75 (LB / FT) 1.88	SQUARE STEEL (IN) 2.00 (LB / FT) 2.42	SQUARE STEEL (IN) 2.50 (LB / FT) 3.35	TUBULAR STEEL Ø (IN) FOUNDATION	TUBULAR STEEL Ø (IN) 3.00 (LB / FT) 7.60	TUBULAR STEEL Ø (IN) 3.50 (LB / FT) 9.00	TUBULAR STEEL Ø (IN) 4.00 (LB / FT) 10.80	TUBULAR STEEL Ø (IN) 5.00 (LB / FT) 14.60	SIGN FRAME REQUIRED	REMARKS	SIGN DETAIL DETAIL IN SHS	SIGN DETAIL DETAIL ON SHEET NUMBER	SIGN DETAIL DETAIL ON STD SHEET NUMBER
SHARON VT14							FY-FLUORESCENT YELLOW FYG-FLUORESCENT YELLOW GREEN																				"SHS"-STANDARD HIGHWAY SIGNS			
SB	5.355	G	UNK	24	30		BRIDGE WEIGHT LIMIT 60,000 POUNDS			1				X															
SB	5.349	H	R1-1	30	30		STOP			1				X															
SB	5.279	F	VD-062A	72	16		BUSINESS SIGN			1				X															
SB	5.260	F	R2-1	24	30								1		X														
		F	R2-1	24	30			5.00								1		X									X		
SB	5.130	F	M2-1	21	15								1		X														
		F	M1-5	24	30								1																
		F	M2-1	21	15			2.19								1		X						GREEN ON WHITE SHEETING	X		
		F	M1-5	24	30			5.00																					E-136B
SB	5.097	F	D1-1A	72	10								1	X															
		F	D1-1A	72	10								1																
		F	D1-1A	72	10								1																
		F	M3-2S	24	12								1																
		F	M1-5	30	24								1																
		F	M6-1S	21	15								1																
							SHEET TOTALS	12.19	0.00	3	0	0	9	0	0	2		30											
								SF	SF	EA	EA	EA	EA	EA	EA	EA		FT											
							TOWN TOTALS	447.0	0.0	11.0	1.0	1.0	93	0.0	0.0	64		960.0											

SIGN SUMMARY SHEET

VERMONT AGENCY OF TRANSPORTATION

PROJECT NAME: **Hartford-East Montpelier VT14**
PROJECT NUMBER: **STPG SIGN(21)**

FILE NAME: **Sharon.xls** PLOT DATE: **6/10/2009**
PROJECT MANAGER: **N. Avery** DRAWN BY: **T. Guazzoni**
DESIGNED BY: **D. Crossley** CHECKED BY: **S. Menard**
SHARON SHEET 10 SHEET **25** OF **162**

DIRECTION	MILEPOINT	LOCATION CODE (SHEET 2)	SIGN CODE	WIDTH (IN)	HEIGHT (IN)	SHEETING REMARKS	SIGN LEGEND FOR ALL POST LENGTHS AND INSTALLATION DATES SEE ORIGINAL RECORD PLANS	NEW SIGNS "A"	NEW SIGNS "B"	EXISTING SIGNS RETAIN	EXISTING SIGNS SALVAGE FROM	EXISTING SIGNS SALVAGE TO	EXISTING SIGNS REMOVE	EXIST POST RETAIN	EXIST POST REMOVE	NUMBER OF NEW POSTS	SQUARE STEEL (IN) (LB / FT) 1.75 / 1.88	SQUARE STEEL (IN) (LB / FT) 2.00 / 2.42	SQUARE STEEL (IN) (LB / FT) 2.50 / 3.35	TUBULAR STEEL Ø (IN) FOUNDATION	TUBULAR STEEL Ø (IN) (LB / FT) 3.00 / 7.60	TUBULAR STEEL Ø (IN) (LB / FT) 3.50 / 9.00	TUBULAR STEEL Ø (IN) (LB / FT) 4.00 / 10.80	TUBULAR STEEL Ø (IN) (LB / FT) 5.00 / 14.60	SIGN FRAME REQUIRED	REMARKS	SIGN DETAIL: DETAIL IN SHS	SIGN DETAIL: DETAIL ON SHEET NUMBER	SIGN DETAIL: DETAIL ON STD SHEET NUMBER
SHARON VT14							FY-FLUORESCENT YELLOW FYG-FLUORESCENT YELLOW GREEN																			"SHS"-STANDARD HIGHWAY SIGNS			
		F	M4-5	24	12								1															
		F	M1-1	24	24								1															
		F	M5-1	21	15								1															
		F	M3-3S	24	12								1															
		F	M1-5	24	24								1															
		F	M6-3S	21	15								1															
		F	D1-1A	72	12			6.00																				5
		F	D1-1A	72	12			6.00																				5
		F	D1-1A	72	12			6.00																				5
		F	M3-2S	24	12			2.00																		3A	GREEN ON WHITE SHEETING	X	7	
		F	M1-5	30	24			5.00																					E-136B
		F	M6-1S	21	15			2.19																			GREEN ON WHITE SHEETING	X		
		F	M4-5	24	12			2.00																			WHITE ON BLUE SHEETING	X		
		F	M1-1	24	24			4.00																				X		
		F	M5-1	21	15			2.19 2.19					1														PLAN ERROR WHITE ON BLUE SHEETING	X		
							SHEET TOTALS	37.57 ~~35.38~~	0.00	0	0	0	7 ~~6~~	0	0	0	0									
								SF	SF	EA	EA	EA	EA	EA	EA	EA	FT									
							TOWN TOTALS	447.0	0.0	11.0	1.0	1.0	93	0.0	0.0	64	960.0									

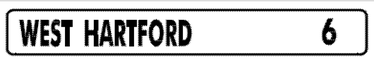


SIGN SUMMARY SHEET

VERMONT AGENCY OF TRANSPORTATION

PROJECT NAME: **Hartford-East Montpelier VT14**
PROJECT NUMBER: **STPG SIGN(21)**

FILE NAME: **Sharon.xls** PLOT DATE: **6/10/2009**
PROJECT MANAGER: **N. Avery** DRAWN BY: **T. Guazzoni**
DESIGNED BY: **D. Crossley** CHECKED BY: **S. Menard**
SHARON SHEET 11 SHEET **26** OF **162**

DIRECTION	MILEPOINT	LOCATION CODE (SHEET 2)	SIGN CODE	WIDTH (IN)	HEIGHT (IN)	SHEETING REMARKS	SIGN LEGEND	NEW SIGNS "A"	NEW SIGNS "B"	EXISTING SIGNS RETAIN	EXISTING SIGNS SALVAGE FROM	EXISTING SIGNS SALVAGE TO	EXISTING SIGNS REMOVE	EXIST POST RETAIN	EXIST POST REMOVE	NUMBER OF NEW POSTS	SQUARE STEEL (IN) 1.75 (LB / FT) 1.88	SQUARE STEEL (IN) 2.00 (LB / FT) 2.42	SQUARE STEEL (IN) 2.50 (LB / FT) 3.35	TUBULAR STEEL Ø (IN) FOUNDATION	TUBULAR STEEL Ø (IN) 3.00 (LB / FT) 7.60	TUBULAR STEEL Ø (IN) 3.50 (LB / FT) 9.00	TUBULAR STEEL Ø (IN) 4.00 (LB / FT) 10.80	TUBULAR STEEL Ø (IN) 5.00 (LB / FT) 14.60	SIGN FRAME REQUIRED	REMARKS	SIGN DETAIL: DETAIL IN SHS	SIGN DETAIL: DETAIL ON SHEET NUMBER	SIGN DETAIL: DETAIL ON STD SHEET NUMBER
SHARON VT14							FY-FLUORESCENT YELLOW FYG-FLUORESCENT YELLOW GREEN																			"SHS"-STANDARD HIGHWAY SIGNS			
		F	M3-3S	24	12			2.00																		GREEN ON WHITE SHEETING	X		
		F	M1-5	24	24			4.00																					E-136B
		F	M6-3S	21	15			2.19																		GREEN ON WHITE SHEETING	X		
SB	4.960	F	M3-3S	24	12								1		X															
		F	M1-5	24	24								1																
		F	M3-3S	24	12			2.00								1		X								GREEN ON WHITE SHEETING	X		
		F	M1-5	24	24			4.00																					E-136B
SB	4.930	F	R2-1	24	30								1		X															
		F	R2-1	24	30			5.00								1		X									X		
SB	4.910	F	D2-1	72	10								1		X														
		F	D2-1	72	12			6.00								2		X										5	
SB	4.800	F	VW-054R	30	30								1		X															
		F	VW-054R	30	30			6.25								1		X											E-154
SB	4.610	F	R2-1	24	30								1		X															
		F	R2-1	24	30			5.00								1		X									X		
SIGN SUMMARY SHEET							SHEET TOTALS	36.44	0.00	0	0	0	6	0	0	6		90									
								SF	SF	EA	EA	EA	EA	EA	EA	EA		FT									
VERMONT AGENCY OF TRANSPORTATION							TOWN TOTALS	447.0	0.0	11.0	1.0	1.0	93	0.0	0.0	64		960.0									

PROJECT NAME: Hartford-East Montpelier VT14
PROJECT NUMBER: STPG SIGN(21)

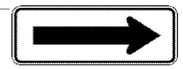
FILE NAME: Sharon.xls
PROJECT MANAGER: N. Avery
DESIGNED BY: D. Crossley
SHARON SHEET 12

PLOT DATE: 6/10/2009
DRAWN BY: T. Guazzoni
CHECKED BY: S. Menard

DIRECTION	MILEPOINT	LOCATION CODE (SHEET 2)	SIGN CODE	WIDTH (IN)	HEIGHT (IN)	SHEETING REMARKS	SIGN LEGEND FOR ALL POST LENGTHS AND INSTALLATION DATES SEE ORIGINAL RECORD PLANS	NEW SIGNS "A"	NEW SIGNS "B"	EXISTING SIGNS RETAIN	EXISTING SIGNS SALVAGE FROM	EXISTING SIGNS SALVAGE TO	EXISTING SIGNS REMOVE	EXIST POST RETAIN	EXIST POST REMOVE	NUMBER OF NEW POSTS	SQUARE STEEL (IN) 1.75 (LB / FT) 1.88	SQUARE STEEL (IN) 2.00 (LB / FT) 2.42	SQUARE STEEL (IN) 2.50 (LB / FT) 3.35	TUBULAR STEEL Ø (IN) FOUNDATION	TUBULAR STEEL Ø (IN) 3.00 (LB / FT) 7.60	TUBULAR STEEL Ø (IN) 3.50 (LB / FT) 9.00	TUBULAR STEEL Ø (IN) 4.00 (LB / FT) 10.80	TUBULAR STEEL Ø (IN) 5.00 (LB / FT) 14.60	SIGN FRAME REQUIRED	REMARKS	SIGN DETAIL: DETAIL IN SHS	SIGN DETAIL: DETAIL ON SHEET NUMBER	SIGN DETAIL: DETAIL ON STD SHEET NUMBER
SHARON VT14							FY-FLUORESCENT YELLOW FYG-FLUORESCENT YELLOW GREEN																			"SHS"-STANDARD HIGHWAY SIGNS			
SB	4.390	F	R2-1	24	30		SPEED LIMIT 50	5.00			1	1	1		X	1		X								PLAN ERROR			
SB	3.649	F	VW-059	30	30		HIDDEN DRIVE						1		X														
SB	3.610	F	W7-1	30	30								1		X														
		F	W7-1	30	30			6.25								2		X									X		
		F	VW-054R	30	30			6.25																					E-154
SB	3.138	F	W1-4R	30	30								1		X														
		F	W13-1	18	18								1																
		F	W1-4R	30	30			6.25								1		X									X		
		F	W13-1	18	18			2.25																				X		
SB	3.050	F	VW-054R	30	30		HIDDEN DRIVE RIGHT						1		X														
SB	3.004	F	S3-1	30	30								1		X														
		F	S3-1	30	30			6.25								2		X									X		
		F	VW-054R	30	30			6.25																					E-154
SB	2.977	F	W12-2	36	36								1		X														
		F	W12-2	30	30			6.25								1		X									X		
SIGN SUMMARY SHEET							SHEET TOTALS	44.75 ~~39.75~~ SF	0.00 SF	0 EA	1 EA	1 EA	~~8~~ 7 EA	0 EA	0 EA	7 EA	105 FT												
VERMONT AGENCY OF TRANSPORTATION							TOWN TOTALS	447.0	0.0	11.0	1.0	1.0	93	0.0	0.0	64	960.0												

PROJECT NAME: **Hartford-East Montpelier VT14**
PROJECT NUMBER: **STPG SIGN(21)**

FILE NAME: **Sharon.xls** PLOT DATE: **6/10/2009**
PROJECT MANAGER: **N. Avery** DRAWN BY: **T. Guazzoni**
DESIGNED BY: **D. Crossley** CHECKED BY: **S. Menard**
SHARON SHEET 13 SHEET **28** OF **162**

DIRECTION	MILEPOINT	LOCATION CODE (SHEET 2)	SIGN CODE	WIDTH (IN)	HEIGHT (IN)	SHEETING REMARKS	SIGN LEGEND FOR ALL POST LENGTHS AND INSTALLATION DATES SEE ORIGINAL RECORD PLANS	NEW SIGNS "A"	NEW SIGNS "B"	EXISTING SIGNS RETAIN	EXISTING SIGNS SALVAGE FROM	EXISTING SIGNS SALVAGE TO	EXISTING SIGNS REMOVE	EXIST POST RETAIN	EXIST POST REMOVE	NUMBER OF NEW POSTS	SQUARE STEEL (IN) 1.75 (LB / FT) 1.88	SQUARE STEEL (IN) 2.00 (LB / FT) 2.42	SQUARE STEEL (IN) 2.50 (LB / FT) 3.35	TUBULAR STEEL Ø (IN) FOUNDATION	TUBULAR STEEL Ø (IN) 3.00 (LB / FT) 7.60	TUBULAR STEEL Ø (IN) 3.50 (LB / FT) 9.00	TUBULAR STEEL Ø (IN) 4.00 (LB / FT) 10.80	TUBULAR STEEL Ø (IN) 5.00 (LB / FT) 14.60	SIGN FRAME REQUIRED	REMARKS	SIGN DETAIL: DETAIL IN SHS	SIGN DETAIL: DETAIL ON SHEET NUMBER	SIGN DETAIL: DETAIL ON STD SHEET NUMBER
SHARON VT14							FY-FLUORESCENT YELLOW FYG-FLUORESCENT YELLOW GREEN																			"SHS"-STANDARD HIGHWAY SIGNS			
SB	2.970	F	OM-3R	12	36			3.00					1		X	1		X								INSTALL ON POST IN FRONT OF ABUTMENT	X		
SB	2.960	E	W1-6	48	24								1		X													
		E	W1-6	48	24			8.00								2		X									X		
SB	1.575	G	VR-023B	24	30			5.00								1		X									INSTALL IN CENTER OF PULL OFF		6	
SB	0.640	G	VR-023B	24	30			5.00								1		X									INSTALL IN CENTER OF PULL OFF		6	
SB	0.540	G	VR-023B	24	30			5.00								1		X									INSTALL IN CENTER OF PULL OFF		6	
SB	0.440	G	VR-023B	24	30			5.00								1		X									INSTALL IN CENTER OF PULL OFF		6	
SB	0.120	F	S3-1	30	30		SCHOOL BUS STOP AHEAD						1		X													
SB	0.000						TOWN LINE SIGN & 2 MM PLAQUES						3																
NB	0.000			72	10		TOWN LINE	5.00								2												
				6	10		MM PLAQUE	0.42																				
				6	10		MM PLAQUE	0.42																				
							SHEET TOTALS	~~36.84~~ 31.00	0.00	0	0	0	~~6~~ 2	0	0	~~9~~ 7		105											
								SF	SF	EA	EA	EA	EA	EA	EA	EA		FT										
							TOWN TOTALS	447.0	0.0	11.0	1.0	1.0	93	0.0	0.0	64		960.0										

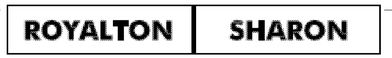
SIGN SUMMARY SHEET

VERMONT AGENCY OF TRANSPORTATION

PROJECT NAME: Hartford-East Montpelier VT14
PROJECT NUMBER: STPG SIGN(21)

FILE NAME: Sharon.xls
PROJECT MANAGER: N. Avery
DESIGNED BY: D. Crossley
SHARON SHEET 14

PLOT DATE: 6/10/2009
DRAWN BY: T. Guazzoni
CHECKED BY: S. Menard
SHEET 29 OF 162

DIRECTION	MILEPOINT	LOCATION CODE (SHEET 2)	SIGN CODE	WIDTH (IN)	HEIGHT (IN)	SHEETING REMARKS	SIGN LEGEND FOR ALL POST LENGTHS AND INSTALLATION DATES SEE ORIGINAL RECORD PLANS	NEW SIGNS "A"	NEW SIGNS "B"	EXISTING SIGNS RETAIN	EXISTING SIGNS SALVAGE FROM	EXISTING SIGNS SALVAGE TO	EXISTING SIGNS REMOVE	EXIST POST RETAIN	EXIST POST REMOVE	NUMBER OF NEW POSTS	SQUARE STEEL (IN) 1.75 (LB / FT) 1.88	SQUARE STEEL (IN) 2.00 (LB / FT) 2.42	SQUARE STEEL (IN) 2.50 (LB / FT) 3.35	TUBULAR STEEL Ø (IN) FOUNDATION	TUBULAR STEEL Ø (IN) 3.00 (LB / FT) 7.60	TUBULAR STEEL Ø (IN) 3.50 (LB / FT) 9.00	TUBULAR STEEL Ø (IN) 4.00 (LB / FT) 10.80	TUBULAR STEEL Ø (IN) 5.00 (LB / FT) 14.60	SIGN FRAME REQUIRED	REMARKS	SIGN DETAIL: DETAIL IN SHS	SIGN DETAIL: DETAIL ON SHEET NUMBER	SIGN DETAIL: DETAIL ON STD SHEET NUMBER
ROYALTON VT 14							FY-FLUORESCENT YELLOW FYG-FLUORESCENT YELLOW GREEN																			"SHS"-STANDARD HIGHWAY SIGNS			
								0.84																		2 MM PLAQUES @ 0.42 SF EA.			
NB	0.000	C	VD-024	60	7.5								1		X													
		C	VD-024	72	10			5.00								2		X									4	
NB	0.600	A	S3-1	30	30								1		X													
		A	S3-1	30	30			6.25 ~~6.25~~					1 ~~1~~			1		X								PAINTBALL DAMAGE	X		
NB	0.760	A	W1-2L	30	30								0 ~~1~~		~~X~~													
		A	W1-2L	30	30			6.25								1		X								INSTALL 150' +/- NORTH OF ORIGINAL LOCATION	X		
NB	0.900	A	R2-5A	24	30								0 ~~1~~		~~X~~													
		A	W3-5	36	36			9.00								2		X									X	
NB	1.130	A	R2-1	24	30								1		X													
		A	R2-1	30	36			7.50								1		X									6	
NB	1.137	A	VD-062B	72	16		BUSINESS SIGN			1				X														
NB	1.200	A	W2-2R	30	30		SIDE ROAD RIGHT						1		X													
		A	W13-1	18	18		40 MPH PLAQUE						1															
NB	1.260	A	VW-060	30	30		HIDDEN DRIVES						1		X													
SIGN SUMMARY SHEET							SHEET TOTALS	~~34.00~~ 41.09 SF	0.00 SF	1 EA	0 EA	0 EA	~~8~~ 7 EA	0 EA	0 EA	7 EA	105 FT											
VERMONT AGENCY OF TRANSPORTATION							TOWN TOTALS	973.5	0.0	62.0	9.0	9.0	190	0.0	0.0	152	2280.0											

PROJECT NAME: East Montpelier-Hartford VT14
PROJECT NUMBER: STPG SIGN(21)

FILE NAME: Royalton.xls
PROJECT MANAGER: N. Avery
DESIGNED BY: D. Crossley
ROYALTON SHEET 1

PLOT DATE: 6/10/2009
DRAWN BY: T. Guazzoni
CHECKED BY: S. Menard
SHEET 30 OF 162

DIRECTION	MILEPOINT	LOCATION CODE (SHEET 2)	SIGN CODE	WIDTH (IN)	HEIGHT (IN)	SHEETING REMARKS	SIGN LEGEND FOR ALL POST LENGTHS AND INSTALLATION DATES SEE ORIGINAL RECORD PLANS	NEW SIGNS "A"	NEW SIGNS "B"	EXISTING SIGNS RETAIN	EXISTING SIGNS SALVAGE FROM	EXISTING SIGNS SALVAGE TO	EXISTING SIGNS REMOVE	EXIST POST RETAIN	EXIST POST REMOVE	NUMBER OF NEW POSTS	SQUARE STEEL (IN) 1.75 (LB / FT) 1.88	SQUARE STEEL (IN) 2.00 (LB / FT) 2.42	SQUARE STEEL (IN) 2.50 (LB / FT) 3.35	TUBULAR STEEL Ø (IN) FOUNDATION	TUBULAR STEEL Ø (IN) 3.00 (LB / FT) 7.60	TUBULAR STEEL Ø (IN) 3.50 (LB / FT) 9.00	TUBULAR STEEL Ø (IN) 4.00 (LB / FT) 10.80	TUBULAR STEEL Ø (IN) 5.00 (LB / FT) 14.60	SIGN FRAME REQUIRED	REMARKS	SIGN DETAIL DETAIL IN SHS	SIGN DETAIL DETAIL ON SHEET NUMBER	SIGN DETAIL DETAIL ON STD SHEET NUMBER
ROYALTON VT 14							FY-FLUORESCENT YELLOW FYG-FLUORESCENT YELLOW GREEN																			"SHS"-STANDARD HIGHWAY SIGNS			
		A	W2-2R	30	30			6.25								1		X								X		
		A	W13-1	18	18			2.25																				X		
NB	1.290	A	VW-060	30	30			6.25								1		X											E-154
NB	1.335	C	VR-017	24	30		LEGAL LOAD LIMIT 24,000 LBS			1				X													DAIRY HILL RD TH-3			
NB	1.341	D	R1-1	30	30								1		X															
		D	R1-1	30	30			6.25								1		X										X		
NB	1.380	A	R2-1	24	30								1		X															
		A	R2-1	24	30			5.00								1		X										X		
NB	1.520	A	R2-1	24	30								1		X															
		A	R2-1	24	30			5.00								1		X										X		
NB	1.940	A	VD-062B	72	16		BUSINESS SIGN			1				X																
NB	1.961	A	W3-5	36	36		SPEED REDUCTION SPEED LIMIT 35	9.00		1			1	X													SHOTGUN DAMAGE			
NB	1.980	A	VD-062B	72	16		BUSINESS SIGN			1				X																
		A	VD-062AL	72	16		BUSINESS SIGN			1				X																
NB	2.048	A	R2-1	24	30								1		X															
SIGN SUMMARY SHEET							SHEET TOTALS	~~31.00~~ 40.00 SF	0.00 SF	5 EA	0 EA	0 EA	~~4~~ 5 EA	0 EA	0 EA	5 EA	75 FT												
VERMONT AGENCY OF TRANSPORTATION							TOWN TOTALS	973.5	0.0	62.0	9.0	9.0	190	0.0	0.0	152	2280.0												

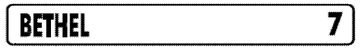
PROJECT NAME: East Montpelier-Hartford VT14
PROJECT NUMBER: STPG SIGN(21)

FILE NAME: Royalton.xls
PROJECT MANAGER: N. Avery
DESIGNED BY: D. Crossley
ROYALTON SHEET 2

PLOT DATE: 6/10/2009
DRAWN BY: T. Guazzoni
CHECKED BY: S. Menard

DIRECTION	MILEPOINT	LOCATION CODE (SHEET 2)	SIGN CODE	WIDTH (IN)	HEIGHT (IN)	SHEETING REMARKS	SIGN LEGEND	NEW SIGNS "A"	NEW SIGNS "B"	EXISTING SIGNS RETAIN	EXISTING SIGNS SALVAGE FROM	EXISTING SIGNS SALVAGE TO	EXISTING SIGNS REMOVE	EXIST POST RETAIN	EXIST POST REMOVE	NUMBER OF NEW POSTS	SQUARE STEEL (IN) 1.75 (LB / FT) 1.88	SQUARE STEEL (IN) 2.00 (LB / FT) 2.42	SQUARE STEEL (IN) 2.50 (LB / FT) 3.35	TUBULAR STEEL Ø (IN) FOUNDATION	TUBULAR STEEL Ø (IN) 3.00 (LB / FT) 7.60	TUBULAR STEEL Ø (IN) 3.50 (LB / FT) 9.00	TUBULAR STEEL Ø (IN) 4.00 (LB / FT) 10.80	TUBULAR STEEL Ø (IN) 5.00 (LB / FT) 14.60	SIGN FRAME REQUIRED	REMARKS	SIGN DETAIL DETAIL IN SHS	SIGN DETAIL DETAIL ON SHEET NUMBER	SIGN DETAIL DETAIL ON STD SHEET NUMBER
ROYALTON VT 14							FY-FLUORESCENT YELLOW FYG-FLUORESCENT YELLOW GREEN																			"SHS"-STANDARD HIGHWAY SIGNS			
		A	R2-1	30	36		SPEED LIMIT 35	7.50								1		X										6	
NB	2.100	A	W11-2YG	30	30		PEDESTRIAN			1				X														
		A	W16-9YG	24	10		AHEAD			1																		
NB	2.213	A	M2-1S	21	15		JCT			1				X														
		A	M1-5	30	24		VT 110			1																		
NB	2.160	A	VD-018	30	18		SOUTH ROYALTON ROYALTON 2	3.75								1		X										E-128B
NB	2.244	A	D1-1A	72	12		BETHEL 7						1	X														
		A	D1-1A	72	12		BETHEL 7	6.00																				5
		A	D1-1	72	12		<== SOUTH ROYALTON			1																		
		A	D1-1A	72	12		TUNBRIDGE 6 ==>			1																		
NB	2.273	A	D4-2	30	36		PARK & RIDE CAR SYMBOL			1				X														
NB	2.289	A	M3-1S	24	12		NORTH			1				X														
		A	M1-5	24	24		VERMONT 14			1																		
		A	M6-3S	21	15		^ UP ARROW			1																		
		A	M3-1S	24	12		NORTH			1																		
SIGN SUMMARY SHEET							SHEET TOTALS	17.25	0.00	11	0	0	1	0	0	2		30								
								SF	SF	EA	EA	EA	EA	EA	EA	EA		FT								
VERMONT AGENCY OF TRANSPORTATION							TOWN TOTALS	973.5	0.0	62.0	9.0	9.0	190	0.0	0.0	152		2280.0								

PROJECT NAME: East Montpelier-Hartford VT14
PROJECT NUMBER: STPG SIGN(21)
FILE NAME: Royalton.xls
PROJECT MANAGER: N. Avery
DESIGNED BY: D. Crossley
ROYALTON SHEET 3
PLOT DATE: 6/10/2009
DRAWN BY: T. Guazzoni
CHECKED BY: S. Menard
SHEET 32 OF 162

DIRECTION	MILEPOINT	LOCATION CODE (SHEET 2)	SIGN CODE	WIDTH (IN)	HEIGHT (IN)	SHEETING REMARKS	SIGN LEGEND FOR ALL POST LENGTHS AND INSTALLATION DATES SEE ORIGINAL RECORD PLANS	NEW SIGNS "A"	NEW SIGNS "B"	EXISTING SIGNS RETAIN	EXISTING SIGNS SALVAGE FROM	EXISTING SIGNS SALVAGE TO	EXISTING SIGNS REMOVE	EXIST POST RETAIN	EXIST POST REMOVE	NUMBER OF NEW POSTS	SQUARE STEEL (IN) 1.75 (LB / FT) 1.88	SQUARE STEEL (IN) 2.00 (LB / FT) 2.42	SQUARE STEEL (IN) 2.50 (LB / FT) 3.35	TUBULAR STEEL Ø (IN) FOUNDATION	TUBULAR STEEL Ø (IN) 3.00 (LB / FT) 7.60	TUBULAR STEEL Ø (IN) 3.50 (LB / FT) 9.00	TUBULAR STEEL Ø (IN) 4.00 (LB / FT) 10.80	TUBULAR STEEL Ø (IN) 5.00 (LB / FT) 14.60	SIGN FRAME REQUIRED	REMARKS	SIGN DETAIL: DETAIL IN SHS	SIGN DETAIL: DETAIL ON SHEET NUMBER	SIGN DETAIL: DETAIL ON STD SHEET NUMBER
ROYALTON VT 14							FY-FLUORESCENT YELLOW FYG-FLUORESCENT YELLOW GREEN																				"SHS"-STANDARD HIGHWAY SIGNS			
		A	M1-5	30	24		VERMONT 110			1																			
		A	M6-1S	21	15		RIGHT ---->			1																			
NB	2.345	A	W11-2YG	30	30		PEDESTRIAN			1				X															
		A	W16-7YG	30	30		DIAGONAL ARROW			1																			
NB	2.351	A	M3-1S	24	12		NORTH				1				X												SALVAGE TO 2.360 NB		
		A	M1-5	24	24		VERMONT 14				1																SALVAGE TO 2.360 NB		
NB	2.360	A	M3-1S	24	12		NORTH					1				1		X									INSTALL SIGNS 50' +/- NORTH OF ORIGINAL LOCATION SALVAGED FROM 2.351 NB		
		A	M1-5	24	24		VERMONT 14					1															INSTALL SIGNS 50' +/- NORTH OF ORIGINAL LOCATION SALVAGED FROM 2.351 NB		
NB	2.410	A	R2-1	24	30								1		X															
		A	R2-1	24	30			5.00								1		X										X	
NB	2.477	A	D2-1	72	10								1	X															
		A	D2-1	72	12			6.00 6.00					1			2										REDO PAINTBALL DAMAGE		5
NB	2.590	A	R2-1	24	30		SPEED LIMIT 50			1				X															
NB	2.733	A	W1-10L	30	30		MODIFIED LEFT CURVE	6.25		1			1	X													REDO SHOTGUN DAMAGE		
NB	2.800	C	VR-017	24	30		LEGAL LOAD LIMIT 24,000 LBS			~~1~~ 0	1	1		X		1											HAPPY HOLLOW RD TH-7		
							SHEET TOTALS	~~11.00~~ 23.25 SF	0.00 SF	~~7~~ 6 EA	~~2~~ 3 EA	~~2~~ 3 EA	~~2~~ 4 EA	0 EA	0 EA	~~2~~ 5 EA		30 FT									
							TOWN TOTALS	973.5	0.0	62.0	9.0	9.0	190	0.0	0.0	152		2280.0											

SIGN SUMMARY SHEET

VERMONT AGENCY OF TRANSPORTATION

PROJECT NAME: **East Montpelier-Hartford VT14**
PROJECT NUMBER: **STPG SIGN(21)**

FILE NAME: **Royalton.xls** PLOT DATE: **6/10/2009**
PROJECT MANAGER: **N. Avery** DRAWN BY: **T. Guazzoni**
DESIGNED BY: **D. Crossley** CHECKED BY: **S. Menard**
ROYALTON SHEET 4 SHEET **33** OF **162**

DIRECTION	MILEPOINT	LOCATION CODE (SHEET 2)	SIGN CODE	WIDTH (IN)	HEIGHT (IN)	SHEETING REMARKS	SIGN LEGEND FOR ALL POST LENGTHS AND INSTALLATION DATES SEE ORIGINAL RECORD PLANS	NEW SIGNS "A"	NEW SIGNS "B"	EXISTING SIGNS RETAIN	EXISTING SIGNS SALVAGE FROM	EXISTING SIGNS SALVAGE TO	EXISTING SIGNS REMOVE	EXIST POST RETAIN	EXIST POST REMOVE	NUMBER OF NEW POSTS	SQUARE STEEL (IN) (LB / FT) 1.75 / 1.88	SQUARE STEEL (IN) (LB / FT) 2.00 / 2.42	SQUARE STEEL (IN) (LB / FT) 2.50 / 3.35	TUBULAR STEEL Ø (IN) FOUNDATION	TUBULAR STEEL Ø (IN) (LB / FT) 3.00 / 7.60	TUBULAR STEEL Ø (IN) (LB / FT) 3.50 / 9.00	TUBULAR STEEL Ø (IN) (LB / FT) 4.00 / 10.80	TUBULAR STEEL Ø (IN) (LB / FT) 5.00 / 14.60	SIGN FRAME REQUIRED	REMARKS	SIGN DETAIL: DETAIL IN SHS	SIGN DETAIL: DETAIL ON SHEET NUMBER	SIGN DETAIL: DETAIL ON STD SHEET NUMBER
ROYALTON VT 14							FY-FLUORESCENT YELLOW FYG-FLUORESCENT YELLOW GREEN																			"SHS"-STANDARD HIGHWAY SIGNS			
NB	2.804	D	R1-1	30	30		STOP	6.25					1			1		X									X		
NB	2.850	A	W12-2	36	36		12' - 1" CLEARANCE UP/DOWN ARROWS			1				X															
		A	VW-730	36	24		2 MILES AHEAD			1																			
NB	2.980	A	W1-4R	30	30		RIGHT REVERSE CURVE	6.25		1			1	X													REDO SHOTGUN DAMAGE			
		A	W13-1	24	24		35 MPH PLAQUE			1																			
NB	3.178	A	W1-6	48	24		<---- LEFT LARGE ARROW				1	1			X	2		X								REPLACE BENT POST			
		B	W1-6	48	24		RIGHT ---> LARGE ARROW				1	1		X															
NB	3.322	A	W1-2L	30	30		LEFT CURVE			1				X															
		A	W13-1	24	24		35 MPH PLAQUE			1																			
NB	3.406	A	W1-6	48	24		<--- LEFT LARGE ARROW			1				X															
NB	3.409	B	W1-6	48	24		RIGHT ---> LARGE ARROW			1				X															
NB	3.620	A	VD-062B	72	16		STANDING STONE <=== (45 DEG) PERENNIAL FARM 6/10			1				X															
NB	3.645	A	W1-3L	30	30		LEFT REVERSE TURN						0 1	X															
		A	W13-1	18	18		25 MPH PLAQUE						1																
		A	W3-5	36	36		SPEED LIMIT 35	9.00								2		X									X		
							SHEET TOTALS	21.50 ~~15.25~~	0.00	9	2	2	3 ~~2~~	0	0	5		75										
								SF	SF	EA	EA	EA	EA	EA	EA	EA		FT										
							TOWN TOTALS	973.5	0.0	62.0	9.0	9.0	190	0.0	0.0	152		2280.0										

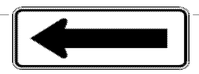
SIGN SUMMARY SHEET

VERMONT AGENCY OF TRANSPORTATION

PROJECT NAME: East Montpelier-Hartford VT14
PROJECT NUMBER: STPG SIGN(21)

FILE NAME: Royalton.xls
PROJECT MANAGER: N. Avery
DESIGNED BY: D. Crossley
PLOT DATE: 6/10/2009
DRAWN BY: T. Guazzoni
CHECKED BY: S. Menard

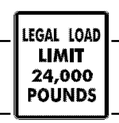
ROYALTON SHEET 5

DIRECTION	MILEPOINT	LOCATION CODE (SHEET 2)	SIGN CODE	WIDTH (IN)	HEIGHT (IN)	SHEETING REMARKS	SIGN LEGEND	NEW SIGNS "A"	NEW SIGNS "B"	EXISTING SIGNS RETAIN	EXISTING SIGNS SALVAGE FROM	EXISTING SIGNS SALVAGE TO	EXISTING SIGNS REMOVE	EXIST POST RETAIN	EXIST POST REMOVE	NUMBER OF NEW POSTS	SQUARE STEEL (IN) 1.75 (LB / FT) 1.88	SQUARE STEEL (IN) 2.00 (LB / FT) 2.42	SQUARE STEEL (IN) 2.50 (LB / FT) 3.35	TUBULAR STEEL Ø (IN) FOUNDATION	TUBULAR STEEL Ø (IN) 3.00 (LB / FT) 7.60	TUBULAR STEEL Ø (IN) 3.50 (LB / FT) 9.00	TUBULAR STEEL Ø (IN) 4.00 (LB / FT) 10.80	TUBULAR STEEL Ø (IN) 5.00 (LB / FT) 14.60	SIGN FRAME REQUIRED	REMARKS	SIGN DETAIL: DETAIL IN SHS	SIGN DETAIL: DETAIL ON SHEET NUMBER	SIGN DETAIL: DETAIL ON STD SHEET NUMBER
ROYALTON VT 14							FY-FLUORESCENT YELLOW FYG-FLUORESCENT YELLOW GREEN																			"SHS"-STANDARD HIGHWAY SIGNS			
NB	3.680	A	VD-018	30	18								1		X														
		A	VD-018	30	18			3.75								1		X										E-128B
NB	3.713	A	R2-5A	24	30		REDUCED SPEED AHEAD 						1		X														
		A	W1-3L	36	36	FY		9.00								2		X								X		
		A	W13-1	24	24	FY		4.00																		X		
NB	3.756	A	VW-268	30	30								1		X														
		A	VW-268	30	30			6.25								1		X									6	
NB	3.810	A	W1-6	48	24								1		X														
		A	W1-6	48	24			8.00								2		X								X		
NB	3.825	A	OM-3R	12	36								1		X														
		A	OM-3R	12	36	FY		3.00								1		X								X		
NB	3.835	B	OM-3L	12	36								1		X														
		B	OM-3L	12	36	FY		3.00								1		X								X		
NB	3.855	A	R2-1	24	30								1		X														
		A	R2-1	30	36			7.50								1		X									6	
SIGN SUMMARY SHEET							SHEET TOTALS	44.50	0.00	0	0	0	7	0	0	9		135									
								SF	SF	EA	EA	EA	EA	EA	EA	EA		FT									
VERMONT AGENCY OF TRANSPORTATION							TOWN TOTALS	973.5	0.0	62.0	9.0	9.0	190	0.0	0.0	152		2280.0									

PROJECT NAME: East Montpelier-Hartford VT14
PROJECT NUMBER: STPG SIGN(21)

FILE NAME: Royalton.xls
PROJECT MANAGER: N. Avery
DESIGNED BY: D. Crossley
ROYALTON SHEET 6

PLOT DATE: 6/10/2009
DRAWN BY: T. Guazzoni
CHECKED BY: S. Menard

DIRECTION	MILEPOINT	LOCATION CODE (SHEET 2)	SIGN CODE	WIDTH (IN)	HEIGHT (IN)	SHEETING REMARKS	SIGN LEGEND FOR ALL POST LENGTHS AND INSTALLATION DATES SEE ORIGINAL RECORD PLANS	NEW SIGNS "A"	NEW SIGNS "B"	EXISTING SIGNS RETAIN	EXISTING SIGNS SALVAGE FROM	EXISTING SIGNS SALVAGE TO	EXISTING SIGNS REMOVE	EXIST POST RETAIN	EXIST POST REMOVE	NUMBER OF NEW POSTS	SQUARE STEEL (IN) 1.75 (LB / FT) 1.88	SQUARE STEEL (IN) 2.00 (LB / FT) 2.42	SQUARE STEEL (IN) 2.50 (LB / FT) 3.35	TUBULAR STEEL Ø (IN) FOUNDATION	TUBULAR STEEL Ø (IN) 3.00 (LB / FT) 7.60	TUBULAR STEEL Ø (IN) 3.50 (LB / FT) 9.00	TUBULAR STEEL Ø (IN) 4.00 (LB / FT) 10.80	TUBULAR STEEL Ø (IN) 5.00 (LB / FT) 14.60	SIGN FRAME REQUIRED	REMARKS	SIGN DETAIL DETAIL IN SHS	SIGN DETAIL DETAIL ON SHEET NUMBER	SIGN DETAIL DETAIL ON STD SHEET NUMBER
ROYALTON VT 14							FY-FLUORESCENT YELLOW FYG-FLUORESCENT YELLOW GREEN																			"SHS"-STANDARD HIGHWAY SIGNS			
NB	3.890	D	R1-1	30	30								1		X													
		D	R1-1	30	30			6.25								1		X									X		
NB	3.900	C	VR-017	24	30								1		X												GEE HILL RD TH-5			
		C	VR-017	24	30			5.00								1		X											E-141
NB	4.090	A	R2-1	24	30								1		X															
		A	R2-1	24	30			5.00								1		X									X		
NB	4.170	A	VW-054R	30	30								1		X															
		A	VW-054R	30	30	FY		6.25								1		X											E-154
NB	4.240	A	R2-1	24	30								1		X															
		A	R2-1	24	30			5.00								1		X									X		
NB	4.390	C	VR-017	24	30		LEGAL LOAD LIMIT 24,000 LBS						0 ~~1~~		X												LYON RD			
		D	R1-1	24	24								1																	
		D	R1-1	30	30			6.25								1		X									X		
NB	4.395	C	VR-017	24	30			5.00								1		X											E-141
NB	4.520	A	R2-1	24	30								1		X														
							SHEET TOTALS	38.75 SF	0.00 SF	0 EA	0 EA	0 EA	7 ~~8~~ EA	0 EA	0 EA	7 EA	105 FT												
							TOWN TOTALS	973.5	0.0	62.0	9.0	9.0	190	0.0	0.0	152	2280.0												

SIGN SUMMARY SHEET

VERMONT AGENCY OF TRANSPORTATION

PROJECT NAME: East Montpelier-Hartford VT14
PROJECT NUMBER: STPG SIGN(21)

FILE NAME: Royalton.xls
PROJECT MANAGER: N. Avery
DESIGNED BY: D. Crossley
PLOT DATE: 6/10/2009
DRAWN BY: T. Guazzoni
CHECKED BY: S. Menard

ROYALTON SHEET 7

DIRECTION	MILEPOINT	LOCATION CODE (SHEET 2)	SIGN CODE	WIDTH (IN)	HEIGHT (IN)	SHEETING REMARKS	SIGN LEGEND	NEW SIGNS "A"	NEW SIGNS "B"	EXISTING SIGNS RETAIN	EXISTING SIGNS SALVAGE FROM	EXISTING SIGNS SALVAGE TO	EXISTING SIGNS REMOVE	EXIST POST RETAIN	EXIST POST REMOVE	NUMBER OF NEW POSTS	SQUARE STEEL (IN) 1.75 (LB / FT) 1.88	SQUARE STEEL (IN) 2.00 (LB / FT) 2.42	SQUARE STEEL (IN) 2.50 (LB / FT) 3.35	TUBULAR STEEL Ø (IN) FOUNDATION	TUBULAR STEEL Ø (IN) 3.00 (LB / FT) 7.60	TUBULAR STEEL Ø (IN) 3.50 (LB / FT) 9.00	TUBULAR STEEL Ø (IN) 4.00 (LB / FT) 10.80	TUBULAR STEEL Ø (IN) 5.00 (LB / FT) 14.60	SIGN FRAME REQUIRED	REMARKS	SIGN DETAIL: DETAIL IN SHS	SIGN DETAIL: DETAIL ON SHEET NUMBER	SIGN DETAIL: DETAIL ON STD SHEET NUMBER
ROYALTON VT 14							FY-FLUORESCENT YELLOW FYG-FLUORESCENT YELLOW GREEN																				"SHS"-STANDARD HIGHWAY SIGNS			
		A	R2-1	24	30			5.00								1		X								X		
NB	4.940	A	W12-2	36	36								1	X																
		A	VW-268	36	36								1																	
		A	W12-2	36	36	FY		9.00																		X		
		A	VW-268	36	36	FY		9.00																				6	
NB	5.000	A	W1-3R	36	36								1		X															
		A	W13-1	24	24								1																	
		A	W1-3R	36	36	FY		9.00								2		X								X		
		A	W13-1	24	24	FY		4.00																		X		
NB	5.040	A	VW-353	30	30								1		X															
		A	W16-2	30	24								1																	
		A	VW-353	36	36	FY		9.00								2		X										6	
		A	W-16-2	30	24	FY		5.00																		X			
NB	5.120	A	W12-2	36	36		12' - 1" CLEARANCE UP/DOWN ARROWS			1				X												X			
NB	5.128	A	OM-3R	12	36								1	NA													SIGN BOLTED TO ABUTMENT		
SIGN SUMMARY SHEET							SHEET TOTALS	50.00 SF	0.00 SF	1 EA	0 EA	0 EA	7 EA	0 EA	0 EA	5 EA	75 FT												
VERMONT AGENCY OF TRANSPORTATION							TOWN TOTALS	973.5	0.0	62.0	9.0	9.0	190	0.0	0.0	152	2280.0												

PROJECT NAME: East Montpelier-Hartford VT14
PROJECT NUMBER: STPG SIGN(21)

FILE NAME: Royalton.xls
PROJECT MANAGER: N. Avery
DESIGNED BY: D. Crossley
ROYALTON SHEET 8

PLOT DATE: 6/10/2009
DRAWN BY: T. Guazzoni
CHECKED BY: S. Menard

DIRECTION	MILEPOINT	LOCATION CODE (SHEET 2)	SIGN CODE	WIDTH (IN)	HEIGHT (IN)	SHEETING REMARKS	SIGN LEGEND FOR ALL POST LENGTHS AND INSTALLATION DATES SEE ORIGINAL RECORD PLANS	NEW SIGNS "A"	NEW SIGNS "B"	EXISTING SIGNS RETAIN	EXISTING SIGNS SALVAGE FROM	EXISTING SIGNS SALVAGE TO	EXISTING SIGNS REMOVE	EXIST POST RETAIN	EXIST POST REMOVE	NUMBER OF NEW POSTS	SQUARE STEEL (IN) 1.75 (LB / FT) 1.88	SQUARE STEEL (IN) 2.00 (LB / FT) 2.42	SQUARE STEEL (IN) 2.50 (LB / FT) 3.35	TUBULAR STEEL Ø (IN) FOUNDATION	TUBULAR STEEL Ø (IN) 3.00 (LB / FT) 7.60	TUBULAR STEEL Ø (IN) 3.50 (LB / FT) 9.00	TUBULAR STEEL Ø (IN) 4.00 (LB / FT) 10.80	TUBULAR STEEL Ø (IN) 5.00 (LB / FT) 14.60	SIGN FRAME REQUIRED	REMARKS	SIGN DETAIL: DETAIL IN SHS	SIGN DETAIL: DETAIL ON SHEET NUMBER	SIGN DETAIL: DETAIL ON STD SHEET NUMBER
ROYALTON VT 14							FY-FLUORESCENT YELLOW FYG-FLUORESCENT YELLOW GREEN																			"SHS"-STANDARD HIGHWAY SIGNS			
		A	OM-3R	12	36	FY		3.00								1										BOLT SIGN TO ABUTMENT	X		
NB	5.132	B	OM-3R	12	36								1	NA												SIGN BOLTED TO ABUTMENT			
		B	OM-3R	12	36	FY		3.00								1										BOLT SIGN TO ABUTMENT	X		
NB	5.149	B	W1-6	48	24								1		X														
		B	W1-6	48	24			8.00								2		X									X		
NB	5.150	C	VR-017	24	30								~~0~~ 1		X														
		D	R1-1	30	30		STOP LEGAL LOAD LIMIT 24,000 POUNDS						1																
		C	VR-017	24	30			5.00								1		X										E-141
NB	5.158	D	R1-1	30	30		STOP	6.25								1		X									X		
NB	5.160	A	W1-6	48	24								1		X														
		A	W1-6	48	24			8.00								2		X									X		
NB	5.160	B	W1-6	48	24								1		X														
		B	W1-6	48	24			8.00								2		X									X		
NB	5.185	A	R2-1	24	30		SPEED LIMIT 40						1		X														
		A	R2-1	24	30			5.00								1		X									X		
							SHEET TOTALS	46.25 SF	0.00 SF	0 EA	0 EA	0 EA	~~6~~ 7 EA	0 EA	0 EA	~~11~~ 9 EA	135 FT											
							TOWN TOTALS	973.5	0.0	62.0	9.0	9.0	190	0.0	0.0	152	2280.0											

SIGN SUMMARY SHEET

VERMONT AGENCY OF TRANSPORTATION

PROJECT NAME: East Montpelier-Hartford VT14
PROJECT NUMBER: STPG SIGN(21)

FILE NAME: Royalton.xls
PROJECT MANAGER: N. Avery
DESIGNED BY: D. Crossley
PLOT DATE: 6/10/2009
DRAWN BY: T. Guazzoni
CHECKED BY: S. Menard

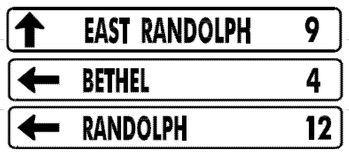
DIRECTION	MILEPOINT	LOCATION CODE (SHEET 2)	SIGN CODE	WIDTH (IN)	HEIGHT (IN)	SHEETING REMARKS	SIGN LEGEND	NEW SIGNS "A"	NEW SIGNS "B"	EXISTING SIGNS RETAIN	EXISTING SIGNS SALVAGE FROM	EXISTING SIGNS SALVAGE TO	EXISTING SIGNS REMOVE	EXIST POST RETAIN	EXIST POST REMOVE	NUMBER OF NEW POSTS	SQUARE STEEL (IN) 1.75 (LB / FT) 1.88	SQUARE STEEL (IN) 2.00 (LB / FT) 2.42	SQUARE STEEL (IN) 2.50 (LB / FT) 3.35	TUBULAR STEEL Ø (IN) FOUNDATION	TUBULAR STEEL Ø (IN) 3.00 (LB / FT) 7.60	TUBULAR STEEL Ø (IN) 3.50 (LB / FT) 9.00	TUBULAR STEEL Ø (IN) 4.00 (LB / FT) 10.80	TUBULAR STEEL Ø (IN) 5.00 (LB / FT) 14.60	SIGN FRAME REQUIRED	REMARKS	SIGN DETAIL: DETAIL IN SHS	SIGN DETAIL: DETAIL ON SHEET NUMBER	SIGN DETAIL: DETAIL ON STD SHEET NUMBER
ROYALTON VT 14							FY-FLUORESCENT YELLOW FYG-FLUORESCENT YELLOW GREEN																			"SHS"-STANDARD HIGHWAY SIGNS			
NB	5.210	A	W11-6	30	30								1		X													
		A	W11-6H	30	30			6.25								1		X								HINGED			E-153
NB	5.270	B	W1-3R	36	36		RIGHT REVERSE TURN						1		X													
		B	W13-1	24	24		20 MPH PLAQUE						1															
NB	5.480	A	VW-054	30	30		HIDDEN DRIVES RIGHT						1		X													
		A	R2-1	24	30			5.00								1		X								X		
NB	5.520	A	R2-1	24	30		SPEED LIMIT 40						1		X													
		A	VW-054	30	30			6.25								1		X											E-154
NB	5.580	B	OM1-1	18	18		YELLOW CLUSTER						1		X													
NB	5.660	A	R8-3A	24	24								1		X													
		A	VR-644	24	12								1															
		A	R8-3A	24	24			4.00								1		X								X		
		A	VR-644	24	12		BEGIN	2.00																				6	
NB	5.760	A	M2-1	21	15								1		X													
		A	M1-5A	24	24								1															

SIGN SUMMARY SHEET	SHEET TOTALS	23.50	0.00	0	0	0	10	0	0	4	60
		SF	SF	EA	EA	EA	EA	EA	EA	EA	FT
VERMONT AGENCY OF TRANSPORTATION	TOWN TOTALS	973.5	0.0	62.0	9.0	9.0	190	0.0	0.0	152	2280.0

PROJECT NAME: East Montpelier-Hartford VT14
PROJECT NUMBER: STPG SIGN(21)

FILE NAME: Royalton.xls
PROJECT MANAGER: N. Averv
DESIGNED BY: D. Crossley
ROYALTON SHEET 10

PLOT DATE: 6/10/2009
DRAWN BY: T. Guazzoni
CHECKED BY: S. Menard
SHEET 39 OF 162

DIRECTION	MILEPOINT	LOCATION CODE (SHEET 2)	SIGN CODE	WIDTH (IN)	HEIGHT (IN)	SHEETING REMARKS	SIGN LEGEND	NEW SIGNS "A"	NEW SIGNS "B"	EXISTING SIGNS RETAIN	EXISTING SIGNS SALVAGE FROM	EXISTING SIGNS SALVAGE TO	EXISTING SIGNS REMOVE	EXIST POST RETAIN	EXIST POST REMOVE	NUMBER OF NEW POSTS	SQUARE STEEL (IN) 1.75 (LB / FT) 1.88	SQUARE STEEL (IN) 2.00 (LB / FT) 2.42	SQUARE STEEL (IN) 2.50 (LB / FT) 3.35	TUBULAR STEEL Ø (IN) FOUNDATION	TUBULAR STEEL Ø (IN) 3.00 (LB / FT) 7.60	TUBULAR STEEL Ø (IN) 3.50 (LB / FT) 9.00	TUBULAR STEEL Ø (IN) 4.00 (LB / FT) 10.80	TUBULAR STEEL Ø (IN) 5.00 (LB / FT) 14.60	SIGN FRAME REQUIRED	REMARKS	SIGN DETAIL: DETAIL IN SHS	SIGN DETAIL: DETAIL ON SHEET NUMBER	SIGN DETAIL: DETAIL ON STD SHEET NUMBER
ROYALTON VT 14							FY-FLUORESCENT YELLOW FYG-FLUORESCENT YELLOW GREEN																			"SHS"-STANDARD HIGHWAY SIGNS			
		A	M2-1	21	15			2.19								1		X							GREEN ON WHITE SHEETING	X		
		A	M1-5	24	24			4.00																				E-136B
NB	5.790	A	D1-1A	72	10								1		X													
		A	D1-1A	72	10								1															
		A	D1-1A	72	10								1															
		A	D1-1A	72	12			6.00								2		X									5
		A	D1-1A	72	12			6.00																				5
		A	D1-1A	72	12			6.00																				5
NB	5.794	B	W12-2	36	36								1	X														
		B	W16-3	24	18								1															
		B	W12-2	36	36	FY		9.00																			X	
		B	W16-3	24	18	FY		3.00																			X	
NB	5.810	A	R8-3	24	30								1		X													
		A	R8-3	24	30			5.00								1		X									X	
NB	5.830	A	M4-5	24	12								1	X														
							SHEET TOTALS	41.19 SF	0.00 SF	0 EA	0 EA	0 EA	7 EA	0 EA	0 EA	4 EA		60 FT										
							TOWN TOTALS	973.5	0.0	62.0	9.0	9.0	190	0.0	0.0	152		2280.0										

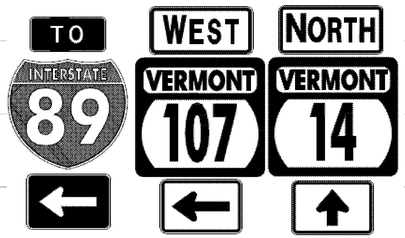
SIGN SUMMARY SHEET

VERMONT AGENCY OF TRANSPORTATION

PROJECT NAME: East Montpelier-Hartford VT14
PROJECT NUMBER: STPG SIGN(21)

FILE NAME: Royalton.xls
PROJECT MANAGER: N. Avery
DESIGNED BY: D. Crossley
ROYALTON SHEET 11

PLOT DATE: 6/10/2009
DRAWN BY: T. Guazzoni
CHECKED BY: S. Menard

DIRECTION	MILEPOINT	LOCATION CODE (SHEET 2)	SIGN CODE	WIDTH (IN)	HEIGHT (IN)	SHEETING REMARKS	SIGN LEGEND FOR ALL POST LENGTHS AND INSTALLATION DATES SEE ORIGINAL RECORD PLANS	NEW SIGNS "A"	NEW SIGNS "B"	EXISTING SIGNS RETAIN	EXISTING SIGNS SALVAGE FROM	EXISTING SIGNS SALVAGE TO	EXISTING SIGNS REMOVE	EXIST POST RETAIN	EXIST POST REMOVE	NUMBER OF NEW POSTS	SQUARE STEEL (IN) (LB / FT) 1.75 / 1.88	SQUARE STEEL (IN) (LB / FT) 2.00 / 2.42	SQUARE STEEL (IN) (LB / FT) 2.50 / 3.35	TUBULAR STEEL Ø (IN) FOUNDATION	TUBULAR STEEL Ø (IN) (LB / FT) 3.00 / 7.60	TUBULAR STEEL Ø (IN) (LB / FT) 3.50 / 9.00	TUBULAR STEEL Ø (IN) (LB / FT) 4.00 / 10.80	TUBULAR STEEL Ø (IN) (LB / FT) 5.00 / 14.60	SIGN FRAME REQUIRED	REMARKS	SIGN DETAIL: DETAIL IN SHS	SIGN DETAIL: DETAIL ON SHEET NUMBER	SIGN DETAIL: DETAIL ON STD SHEET NUMBER
ROYALTON VT 14							FY-FLUORESCENT YELLOW FYG-FLUORESCENT YELLOW GREEN																			"SHS"-STANDARD HIGHWAY SIGNS			
		A	M1-1	24	24								1															
		A	M6-1	21	15								1															
		A	M3-4	24	12								1															
		A	M1-5	30	24								1															
		A	M6-1	21	15								1															
		A	M3-1	24	12								1															
		A	M1-5	24	24								1															
		A	M6-3	21	15								1															
		A	M4-5	24	12			2.00																	3B	WHITE ON BLUE SHEETING	X	7	
		A	M1-1	24	24			4.00																			X		
		A	M6-1	21	15			~~2.19~~ 2.18																		WHITE ON BLUE SHEETING	X		
		A	M3-4	24	12			2.00																GREEN ON WHITE SHEETING	X		
		A	M1-5	30	24			5.00																					E-136B
		A	M6-1	21	15			~~2.19~~ 2.18																		GREEN ON WHITE SHEETING	X		
		A	M3-1	24	12			2.00																		GREEN ON WHITE SHEETING	X		
							SHEET TOTALS	~~19.38~~ 19.36 SF	0.00 SF	0 EA	0 EA	0 EA	8 EA	0 EA	0 EA	0 EA	0 FT									
							TOWN TOTALS	973.5	0.0	62.0	9.0	9.0	190	0.0	0.0	152	2280.0									

SIGN SUMMARY SHEET

VERMONT AGENCY OF TRANSPORTATION

PROJECT NAME: East Montpelier-Hartford VT14
PROJECT NUMBER: STPG SIGN(21)

FILE NAME: Royalton.xls
PROJECT MANAGER: N. Avery
DESIGNED BY: D. Crossley
PLOT DATE: 6/10/2009
DRAWN BY: T. Guazzoni
CHECKED BY: S. Menard

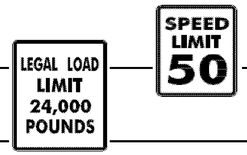
DIRECTION	MILEPOINT	LOCATION CODE (SHEET 2)	SIGN CODE	WIDTH (IN)	HEIGHT (IN)	SHEETING REMARKS	SIGN LEGEND FOR ALL POST LENGTHS AND INSTALLATION DATES SEE ORIGINAL RECORD PLANS	NEW SIGNS "A"	NEW SIGNS "B"	EXISTING SIGNS RETAIN	EXISTING SIGNS SALVAGE FROM	EXISTING SIGNS SALVAGE TO	EXISTING SIGNS REMOVE	EXIST POST RETAIN	EXIST POST REMOVE	NUMBER OF NEW POSTS	SQUARE STEEL (IN) (LB / FT) 1.75 / 1.88	SQUARE STEEL (IN) (LB / FT) 2.00 / 2.42	SQUARE STEEL (IN) (LB / FT) 2.50 / 3.35	TUBULAR STEEL Ø (IN) FOUNDATION	TUBULAR STEEL Ø (IN) (LB / FT) 3.00 / 7.60	TUBULAR STEEL Ø (IN) (LB / FT) 3.50 / 9.00	TUBULAR STEEL Ø (IN) (LB / FT) 4.00 / 10.80	TUBULAR STEEL Ø (IN) (LB / FT) 5.00 / 14.60	SIGN FRAME REQUIRED	REMARKS	SIGN DETAIL: DETAIL IN SHS	SIGN DETAIL: DETAIL ON SHEET NUMBER	SIGN DETAIL: DETAIL ON STD SHEET NUMBER
ROYALTON VT 14							FY-FLUORESCENT YELLOW FYG-FLUORESCENT YELLOW GREEN																			"SHS"-STANDARD HIGHWAY SIGNS			
		A	M1-5	24	24			4.00																				E-136B
		A	M6-3	21	15			2.18 ~~2.19~~																		GREEN ON WHITE SHEETING	X		
NB	5.870	A	R8-3A	24	24								1		X													
		A	M4-6	24	12								1															
		A	R8-3A	24	24			4.00								1		X									X	
		A	M4-6	24	12		END	2.00																			X	
NB	5.890	A	R2-1	24	30		SPEED LIMIT 40						1		X													
		A	R2-1	24	30			5.00								1		X									X	
NB	5.940	A	D1-1	72	10								1	X														
		A	M3-1	24	12								1															
		A	M1-5	24	24		EAST RANDOLPH 9						1															
		A	D1-1	72	12		NORTH VERMONT 14	6.00																			X	
		A	M3-1	24	12			2.00																		GREEN ON WHITE SHEETING	X		
		A	M1-5	24	24			4.00								2												E-136B
							SHEET TOTALS	29.18 ~~29.19~~ SF	0.00 SF	0 EA	0 EA	0 EA	6 EA	0 EA	0 EA	4 ~~2~~ EA	30 FT									
							TOWN TOTALS	973.5	0.0	62.0	9.0	9.0	190	0.0	0.0	152	2280.0											

SIGN SUMMARY SHEET

VERMONT AGENCY OF TRANSPORTATION

PROJECT NAME: **East Montpelier-Hartford VT14**
PROJECT NUMBER: **STPG SIGN(21)**

FILE NAME: **Rovalton.xls**
PROJECT MANAGER: **N. Avery**
DESIGNED BY: **D. Crossley**
PLOT DATE: **6/10/2009**
DRAWN BY: **T. Guazzoni**
CHECKED BY: **S. Menard**
ROYALTON SHEET 13
SHEET **42** OF **162**

DIRECTION	MILEPOINT	LOCATION CODE (SHEET 2)	SIGN CODE	WIDTH (IN)	HEIGHT (IN)	SHEETING REMARKS	SIGN LEGEND FOR ALL POST LENGTHS AND INSTALLATION DATES SEE ORIGINAL RECORD PLANS	NEW SIGNS "A"	NEW SIGNS "B"	EXISTING SIGNS RETAIN	EXISTING SIGNS SALVAGE FROM	EXISTING SIGNS SALVAGE TO	EXISTING SIGNS REMOVE	EXIST POST RETAIN	EXIST POST REMOVE	NUMBER OF NEW POSTS	SQUARE STEEL (IN) 1.75 (LB / FT) 1.88	SQUARE STEEL (IN) 2.00 (LB / FT) 2.42	SQUARE STEEL (IN) 2.50 (LB / FT) 3.35	TUBULAR STEEL Ø (IN) FOUNDATION	TUBULAR STEEL Ø (IN) 3.00 (LB / FT) 7.60	TUBULAR STEEL Ø (IN) 3.50 (LB / FT) 9.00	TUBULAR STEEL Ø (IN) 4.00 (LB / FT) 10.80	TUBULAR STEEL Ø (IN) 5.00 (LB / FT) 14.60	SIGN FRAME REQUIRED	REMARKS	SIGN DETAIL: DETAIL IN SHS	SIGN DETAIL: DETAIL ON SHEET NUMBER	SIGN DETAIL: DETAIL ON STD SHEET NUMBER
ROYALTON VT 14							FY-FLUORESCENT YELLOW FYG-FLUORESCENT YELLOW GREEN																			"SHS"-STANDARD HIGHWAY SIGNS			
NB	6.020	A	R2-1	24	30								1	X															
		A	R2-1	24	30			5.00																		X	
NB	6.376	C	VR-017	24	30			5.00					1			1		X									RUSS HILL RD TH-23			E-141
NB	6.380	C	VR-017	24	30		LEGAL LOAD LIMIT 24,000 LBS						0 ~~1~~		X												NO EXISTING			
		D	R1-1	24	24		STOP 						0 ~~1~~																	
NB	6.384	D	R1-1	30	30			6.25								1		X										X		
NB	6.700	A	W1-2L	30	30		LEFT CURVE						1		X															
		A	W13-1	18	18		35 MPH PLAQUE						1																	
NB	6.770	A	W1-2L	30	30			6.25								1		X									INSTALL 350'+/- NORTH OF ORIGINAL LOCATION			
		A	W13-1	18	18			2.25																				X		
NB	6.820	A	W1-8L	12	18			5.00					1		X												NEW 24X30			
		B	W1-8R	12	18			5.00					1		X												NEW 24X30			
		A	W1-8L	12	18			1.50					1			1		X									WRONG SIZE PLAN ERROR			
		B	W1-8R	12	18			1.50					1			1		X										X		
NB	6.840	A	W1-8L	12	18								1		X															
							SHEET TOTALS	37.75 ~~27.75~~ SF	0.00 SF	0 EA	0 EA	0 EA	9 ~~8~~ EA	0 EA	0 EA	5 EA	75 FT													
							TOWN TOTALS	973.5	0.0	62.0	9.0	9.0	190	0.0	0.0	152	2280.0													

SIGN SUMMARY SHEET

VERMONT AGENCY OF TRANSPORTATION

PROJECT NAME: East Montpelier-Hartford VT14
PROJECT NUMBER: STPG SIGN(21)

FILE NAME: Rovalton.xls
PROJECT MANAGER: N. Avery
DESIGNED BY: D. Crossley
PLOT DATE: 6/10/2009
DRAWN BY: T. Guazzoni
CHECKED BY: S. Menard
ROYALTON SHEET 14
SHEET 43 OF 162

DIRECTION	MILEPOINT	LOCATION CODE (SHEET 2)	SIGN CODE	WIDTH (IN)	HEIGHT (IN)	SHEETING REMARKS	SIGN LEGEND FOR ALL POST LENGTHS AND INSTALLATION DATES SEE ORIGINAL RECORD PLANS	NEW SIGNS "A"	NEW SIGNS "B"	EXISTING SIGNS RETAIN	EXISTING SIGNS SALVAGE FROM	EXISTING SIGNS SALVAGE TO	EXISTING SIGNS REMOVE	EXIST POST RETAIN	EXIST POST REMOVE	NUMBER OF NEW POSTS	SQUARE STEEL (IN) (LB / FT) 1.75 1.88	SQUARE STEEL (IN) (LB / FT) 2.00 2.42	SQUARE STEEL (IN) (LB / FT) 2.50 3.35	TUBULAR STEEL Ø (IN) FOUNDATION	TUBULAR STEEL Ø (IN) (LB / FT) 3.00 7.60	TUBULAR STEEL Ø (IN) (LB / FT) 3.50 9.00	TUBULAR STEEL Ø (IN) (LB / FT) 4.00 10.80	TUBULAR STEEL Ø (IN) (LB / FT) 5.00 14.60	SIGN FRAME REQUIRED	REMARKS	SIGN DETAIL: DETAIL IN SHS	SIGN DETAIL: DETAIL ON SHEET NUMBER	SIGN DETAIL: DETAIL ON STD SHEET NUMBER
ROYALTON VT 14							FY-FLUORESCENT YELLOW FYG-FLUORESCENT YELLOW GREEN																			"SHS"-STANDARD HIGHWAY SIGNS			
		B	W1-8R	12	18			5.00 5.00					1		X											(2) NEW 24X30			
		A	W1-8L	12	18			1.50					1			1		X								WRONG SIZE PLAN ERROR	X		
		B	W1-8R	12	18			1.50					1			1		X									X		
NB	7.300	A	W5-2	30	30		NARROW BRIDGE 	6.25 3.00					1		X	1													
NB	7.350	A	W5-2	30	30			6.25 6.25					1			1		X								INSTALL 260' +/- NORTH OF ORIGINAL LOCATION REDO PAINTBALL DAMAGE	X		
NB	7.400	A	OM-3R	12	36								1		X														
		A	OM-3R	12	36			3.00								1		X									X		
NB	7.420	B	OM-3L	12	36								1		X														
		B	OM-3L	12	36			3.00								1		X									X		
NB	7.730	A	W5-2	30	30		NARROW BRIDGE						1		X														
NB	7.770	A	W1-1R	30	30								1		X														
		A	W13-1	18	18								1																
		A	W1-1McR	30	30			6.25								1		X										7	
		A	W13-1	18	18			2.25																		X		
NB	7.780	A	W5-2	30	30			6.25								1		X								INSTALL 260' +/- NORTH OF ORIGINAL LOCATION	X		
							SHEET TOTALS	55.50 ~~30.00~~	0.00	0	0	0	10 ~~7~~	0	0	8 ~~7~~		105							
								SF	SF	EA	EA	EA	EA	EA	EA	EA		FT										
							TOWN TOTALS	973.5	0.0	62.0	9.0	9.0	190	0.0	0.0	152		2280.0										

SIGN SUMMARY SHEET

VERMONT AGENCY OF TRANSPORTATION

PROJECT NAME: East Montpelier-Hartford VT14
PROJECT NUMBER: STPG SIGN(21)

FILE NAME: Royalton.xls
PROJECT MANAGER: N. Avery
DESIGNED BY: D. Crossley
ROYALTON SHEET 15

PLOT DATE: 6/10/2009
DRAWN BY: T. Guazzoni
CHECKED BY: S. Menard
SHEET 44 OF 162

DIRECTION	MILEPOINT	LOCATION CODE (SHEET 2)	SIGN CODE	WIDTH (IN)	HEIGHT (IN)	SHEETING REMARKS	SIGN LEGEND FOR ALL POST LENGTHS AND INSTALLATION DATES SEE ORIGINAL RECORD PLANS	NEW SIGNS "A"	NEW SIGNS "B"	EXISTING SIGNS RETAIN	EXISTING SIGNS SALVAGE FROM	EXISTING SIGNS SALVAGE TO	EXISTING SIGNS REMOVE	EXIST POST RETAIN	EXIST POST REMOVE	NUMBER OF NEW POSTS	SQUARE STEEL (IN) 1.75 (LB / FT) 1.88	SQUARE STEEL (IN) 2.00 (LB / FT) 2.42	SQUARE STEEL (IN) 2.50 (LB / FT) 3.35	TUBULAR STEEL Ø (IN) FOUNDATION	TUBULAR STEEL Ø (IN) 3.00 (LB / FT) 7.60	TUBULAR STEEL Ø (IN) 3.50 (LB / FT) 9.00	TUBULAR STEEL Ø (IN) 4.00 (LB / FT) 10.80	TUBULAR STEEL Ø (IN) 5.00 (LB / FT) 14.60	SIGN FRAME REQUIRED	REMARKS	SIGN DETAIL: DETAIL IN SHS	SIGN DETAIL: DETAIL ON SHEET NUMBER	SIGN DETAIL: DETAIL ON STD SHEET NUMBER
ROYALTON VT 14							FY-FLUORESCENT YELLOW FYG-FLUORESCENT YELLOW GREEN																			"SHS"-STANDARD HIGHWAY SIGNS			
NB	7.870	A	OM-3R	12	36								1		X													
		A	OM-3R	12	36			3.00								1		X									X		
NB	7.895	B	OM-3L	12	36								1		X													
		B	OM-3L	12	36			3.00								1		X									X		
NB	7.975	C	VR-017	24	30		LEGAL LOAD LIMIT 24,000 POUNDS						0 ~~1~~		X											SLACK HILL RD TH-10			
		C	VR-017	24	30			5.00								1		X											E-141
NB	7.985	D	R1-1	24	24		STOP						1		X													
		D	R1-1	30	30			6.25								1		X									X		
NB	8.095	A	W1-2L	30	30		35 M.P.H.	6.25								1		X									INSTALL 600'+/- NORTH OF SLACK HILL ROAD.	X		
		A	W13-1	18	18			2.25																			X		
NB	8.150	A	W1-6L	48	24			8.00								2		X									INSTALL 50' +/- NORTH OF GUARD RAIL BEGINNING	X		
NB	8.195	B	W1-6R	48	24			8.00								2		X									INSTALL 100' +/- SOUTH OF GUARD RAIL END	X		
NB	9.070	C	VR-017	24	30		LEGAL LOAD LIMIT 24,000 POUNDS						1		X											POST FARM RD TH-9			
		C	VR-017	24	30			5.00								1		X											E-141
NB	9.080	D	R1-1	24	24								1		X													
							SHEET TOTALS	46.75 SF	0.00 SF	0 EA	0 EA	0 EA	~~5~~ 6 EA	0 EA	0 EA	10 EA	150 FT												
							TOWN TOTALS	973.5	0.0	62.0	9.0	9.0	190	0.0	0.0	152	2280.0												

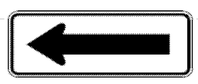
SIGN SUMMARY SHEET

VERMONT AGENCY OF TRANSPORTATION

PROJECT NAME: **East Montpelier-Hartford VT14**
PROJECT NUMBER: **STPG SIGN(21)**

FILE NAME: **Royalton.xls**
PROJECT MANAGER: **N. Avery**
DESIGNED BY: **D. Crossley**
PLOT DATE: **6/10/2009**
DRAWN BY: **T. Guazzoni**
CHECKED BY: **S. Menard**

ROYALTON SHEET 16

DIRECTION	MILEPOINT	LOCATION CODE (SHEET 2)	SIGN CODE	WIDTH (IN)	HEIGHT (IN)	SHEETING REMARKS	SIGN LEGEND FOR ALL POST LENGTHS AND INSTALLATION DATES SEE ORIGINAL RECORD PLANS	NEW SIGNS "A"	NEW SIGNS "B"	EXISTING SIGNS RETAIN	EXISTING SIGNS SALVAGE FROM	EXISTING SIGNS SALVAGE TO	EXISTING SIGNS REMOVE	EXIST POST RETAIN	EXIST POST REMOVE	NUMBER OF NEW POSTS	SQUARE STEEL (IN) 1.75 (LB / FT) 1.88	SQUARE STEEL (IN) 2.00 (LB / FT) 2.42	SQUARE STEEL (IN) 2.50 (LB / FT) 3.35	TUBULAR STEEL Ø (IN) FOUNDATION	TUBULAR STEEL Ø (IN) 3.00 (LB / FT) 7.60	TUBULAR STEEL Ø (IN) 3.50 (LB / FT) 9.00	TUBULAR STEEL Ø (IN) 4.00 (LB / FT) 10.80	TUBULAR STEEL Ø (IN) 5.00 (LB / FT) 14.60	SIGN FRAME REQUIRED	REMARKS	SIGN DETAIL: DETAIL IN SHS	SIGN DETAIL: DETAIL ON SHEET NUMBER	SIGN DETAIL: DETAIL ON STD SHEET NUMBER
ROYALTON VT 14							FY-FLUORESCENT YELLOW FYG-FLUORESCENT YELLOW GREEN																			"SHS"-STANDARD HIGHWAY SIGNS			
		D	R1-1	30	30			6.25								1		X									X		
NB	9.090	D	R1-1	24	24								1		X															
		D	R1-1	30	30			6.25								1		X									X		
SB	8.280	F	W1-2R	30	30		RIGHT CURVE	6.25					1		X	1		X									NEW "COW X-ING"			
		F	W13-1	18	18		35 MPH PLAQUE	3.00					1														NEW "NEXT 1 MILE"			
SB	8.250	F	W1-2R	30	30			6.25								1		X									INSTALL 160'+/- SOUTH OF ORIGINAL SIGN LOCATION			
		F	W13-1	18	18			2.25																				X		
SB	8.060	F	W1-1MaL	30	30		LEFT TURN						1		X															
		F	W13-1	18	18		25 MPH PLAQUE						1																	
SB	7.930	F	W5-2	30	30		NARROW BRIDGE						1		X															
		F	W1-1McL	30	30			6.25								1		X												7	
		F	W13-1	18	18			2.25																				X		
SB	7.935	A	W1-6L	48	24								1		X															
		A	W1-6L	48	24			8.00								2		X									INSTALL 50' +/- NORTH OF GUARD RAIL BEGINNING			
SB	7.934	B	W1-6R	48	24								1		X															
							SHEET TOTALS	46.75 ~~37.50~~ SF	0.00 SF	0 EA	0 EA	0 EA	8 EA	0 EA	0 EA	7 ~~6~~ EA		90 FT											
							TOWN TOTALS	973.5	0.0	62.0	9.0	9.0	190	0.0	0.0	152		2280.0												

SIGN SUMMARY SHEET

VERMONT AGENCY OF TRANSPORTATION

PROJECT NAME: East Montpelier-Hartford VT14
PROJECT NUMBER: STPG SIGN(21)

FILE NAME: Rovalton.xls
PROJECT MANAGER: N. Avery
DESIGNED BY: D. Crossley
PLOT DATE: 6/10/2009
DRAWN BY: T. Guazzoni
CHECKED BY: S. Menard
ROYALTON SHEET 17
SHEET 46 OF 162

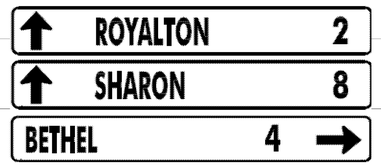
DIRECTION	MILEPOINT	LOCATION CODE (SHEET 2)	SIGN CODE	WIDTH (IN)	HEIGHT (IN)	SHEETING REMARKS	SIGN LEGEND	NEW SIGNS "A"	NEW SIGNS "B"	EXISTING SIGNS RETAIN	EXISTING SIGNS SALVAGE FROM	EXISTING SIGNS SALVAGE TO	EXISTING SIGNS REMOVE	EXIST POST RETAIN	EXIST POST REMOVE	NUMBER OF NEW POSTS	SQUARE STEEL (IN) 1.75 (LB / FT) 1.88	SQUARE STEEL (IN) 2.00 (LB / FT) 2.42	SQUARE STEEL (IN) 2.50 (LB / FT) 3.35	TUBULAR STEEL Ø (IN) FOUNDATION	TUBULAR STEEL Ø (IN) 3.00 (LB / FT) 7.60	TUBULAR STEEL Ø (IN) 3.50 (LB / FT) 9.00	TUBULAR STEEL Ø (IN) 4.00 (LB / FT) 10.80	TUBULAR STEEL Ø (IN) 5.00 (LB / FT) 14.60	SIGN FRAME REQUIRED	REMARKS	SIGN DETAIL: DETAIL IN SHS	SIGN DETAIL: DETAIL ON SHEET NUMBER	SIGN DETAIL: DETAIL ON STD SHEET NUMBER
ROYALTON VT 14							FY-FLUORESCENT YELLOW FYG-FLUORESCENT YELLOW GREEN																			"SHS"-STANDARD HIGHWAY SIGNS			
		B	W1-6R	48	24			8.00								2		X								INSTALL 100' +/- SOUTH OF GUARD RAIL END	X		
SB	7.930	F	W5-2	30	30			6.25								1		X								INSTALL 10'+/- SOUTH OF GUARD RAIL BEGINNING	X		
SB	7.895	F	OM-3R	12	36								1		X														
		F	OM-3R	12	36			3.00								1		X									X		
SB	7.870	E	OM-3L	12	36								1		X														
		E	OM-3L	12	36			3.00								1		X									X		
SB	7.868	G	VR-017	24	30								1		X												MORSE RD TH-20			
		G	VR-017	24	30			5.00								1		X											E-141
SB	7.864	H	R1-1	24	24								1		X												MORSE RD TH-20			
		H	R1-1	30	30			6.25								1		X									X		
SB	7.863	G	VR-017	24	30								1		X												WATERMANN RD TH-21			
		G	VR-017	24	30			5.00								1		X											E-141
SB	7.860	H	R1-1	24	24								1		X												WATERMANN RD TH-21			
		H	R1-1	30	30			6.25								1		X									X		
SB	7.860	E	R1-1	48	24								1		X														
SIGN SUMMARY SHEET							SHEET TOTALS	42.75	0.00	0	0	0	7	0	0	9		135									
								SF	SF	EA	EA	EA	EA	EA	EA	EA		FT									
VERMONT AGENCY OF TRANSPORTATION							TOWN TOTALS	973.5	0.0	62.0	9.0	9.0	190	0.0	0.0	152		2280.0									

PROJECT NAME: **East Montpelier-Hartford VT14**
PROJECT NUMBER: **STPG SIGN(21)**

FILE NAME: **Royalton.xls** PLOT DATE: **6/10/2009**
PROJECT MANAGER: **N. Averv** DRAWN BY: **T. Guazzoni**
DESIGNED BY: **D. Crossley** CHECKED BY: **S. Menard**
ROYALTON SHEET 18 SHEET **47** OF **162**

DIRECTION	MILEPOINT	LOCATION CODE (SHEET 2)	SIGN CODE	WIDTH (IN)	HEIGHT (IN)	SHEETING REMARKS	SIGN LEGEND FOR ALL POST LENGTHS AND INSTALLATION DATES SEE ORIGINAL RECORD PLANS	NEW SIGNS "A"	NEW SIGNS "B"	EXISTING SIGNS RETAIN	EXISTING SIGNS SALVAGE FROM	EXISTING SIGNS SALVAGE TO	EXISTING SIGNS REMOVE	EXIST POST RETAIN	EXIST POST REMOVE	NUMBER OF NEW POSTS	SQUARE STEEL (IN) 1.75 (LB / FT) 1.88	SQUARE STEEL (IN) 2.00 (LB / FT) 2.42	SQUARE STEEL (IN) 2.50 (LB / FT) 3.35	TUBULAR STEEL Ø (IN) FOUNDATION	TUBULAR STEEL Ø (IN) 3.00 (LB / FT) 7.60	TUBULAR STEEL Ø (IN) 3.50 (LB / FT) 9.00	TUBULAR STEEL Ø (IN) 4.00 (LB / FT) 10.80	TUBULAR STEEL Ø (IN) 5.00 (LB / FT) 14.60	SIGN FRAME REQUIRED	REMARKS	SIGN DETAIL: DETAIL IN SHS	SIGN DETAIL: DETAIL ON SHEET NUMBER	SIGN DETAIL: DETAIL ON STD SHEET NUMBER
ROYALTON VT 14							FY-FLUORESCENT YELLOW FYG-FLUORESCENT YELLOW GREEN																			"SHS"-STANDARD HIGHWAY SIGNS			
		E	W1-6	48	24			8.00								2		X									X		
SB	7.530	F	W5-2	30	30		NARROW BRIDGE 						1		X														
SB	7.465	F	W5-2	30	30			6.25								1		X								INSTALL 350'+/- SOUTH OF ORIGINAL SIGN LOCATION		6	
SB	7.420	F	OM-3R	12	36								1		X														
		F	OM-3R	12	36			3.00								1		X									X		
SB	7.400	E	OM-3L	12	36								1		X														
		E	OM-3L	12	36			3.00								1		X									X		
SB	6.930	F	W1-2R	30	30		RIGHT CURVE						1		X														
		F	W13-1	18	18		35 MPH PLAQUE 						~~1~~ 0																
SB	6.980	F	W1-2R	30	30			6.25								1		X								INSTALL 200'+/- SOUTH OF ORIGINAL SIGN LOCATION	X		
		F	W13-1	18	18			2.25																			X		
SB	6.220	F	W3-5	36	36			9.00								2		X								INSTALL AT GUARD RAIL END SOUTH OF BRIDGE #26	X		
SB	6.020	F	R2-1	24	30								1		X														
		F	R2-1	30	36			7.50								1		X										6	
SB	6.000	F	M2-1	21	15								1		X														
SIGN SUMMARY SHEET							SHEET TOTALS	45.25 SF	0.00 SF	0 EA	0 EA	0 EA	~~6~~ 7 EA	0 EA	0 EA	9 EA	135 FT												
VERMONT AGENCY OF TRANSPORTATION							TOWN TOTALS	973.5	0.0	62.0	9.0	9.0	190	0.0	0.0	152	2280.0												

PROJECT NAME: **East Montpelier-Hartford VT14**
PROJECT NUMBER: **STPG SIGN(21)**
FILE NAME: **Royalton.xls**
PROJECT MANAGER: **N. Avery**
DESIGNED BY: **D. Crossley**
PLOT DATE: **6/10/2009**
DRAWN BY: **T. Guazzoni**
CHECKED BY: **S. Menard**
ROYALTON SHEET 19
SHEET **48** OF **162**

DIRECTION	MILEPOINT	LOCATION CODE (SHEET 2)	SIGN CODE	WIDTH (IN)	HEIGHT (IN)	SHEETING REMARKS	SIGN LEGEND	NEW SIGNS "A"	NEW SIGNS "B"	EXISTING SIGNS RETAIN	EXISTING SIGNS SALVAGE FROM	EXISTING SIGNS SALVAGE TO	EXISTING SIGNS REMOVE	EXIST POST RETAIN	EXIST POST REMOVE	NUMBER OF NEW POSTS	SQUARE STEEL (IN) 1.75 (LB / FT) 1.88	SQUARE STEEL (IN) 2.00 (LB / FT) 2.42	SQUARE STEEL (IN) 2.50 (LB / FT) 3.35	TUBULAR STEEL Ø (IN) FOUNDATION	TUBULAR STEEL Ø (IN) 3.00 (LB / FT) 7.60	TUBULAR STEEL Ø (IN) 3.50 (LB / FT) 9.00	TUBULAR STEEL Ø (IN) 4.00 (LB / FT) 10.80	TUBULAR STEEL Ø (IN) 5.00 (LB / FT) 14.60	SIGN FRAME REQUIRED	REMARKS	SIGN DETAIL: DETAIL IN SHS	SIGN DETAIL: DETAIL ON SHEET NUMBER	SIGN DETAIL: DETAIL ON STD SHEET NUMBER
ROYALTON VT 14							FY-FLUORESCENT YELLOW FYG-FLUORESCENT YELLOW GREEN																			"SHS"-STANDARD HIGHWAY SIGNS			
		F	M1-5	30	24								1															
		F	M2-1	21	15			2.19								1		X								GREEN ON WHITE SHEETING	X		
		F	M1-5	30	24			5.00																					E-136B
SB	5.950	F	D1-1A	72	10								1		X														
		F	D1-1A	72	10								1																
		F	D1-1A	72	10								1																
		F	D1-1A	72	12			6.00								2		X									5	
		F	D1-1A	72	12			6.00																					5
		F	D1-1A	72	12			6.00																					5
SB	5.910	F	M3-3	24	12								1	X															
		F	M1-5	24	24								1																
		F	M6-3	21	15								1																
		F	M3-4	24	12								1																
		F	M1-5	30	24								1																
		F	M6-1L	21	15								1																
							SHEET TOTALS	25.19	0.00	0	0	0	10	0	0	3		45											
								SF	SF	EA	EA	EA	EA	EA	EA	EA		FT											
							TOWN TOTALS	973.5	0.0	62.0	9.0	9.0	190	0.0	0.0	152		2280.0											

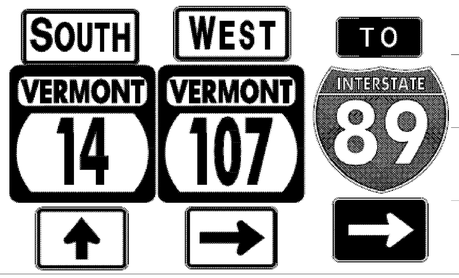
SIGN SUMMARY SHEET

VERMONT AGENCY OF TRANSPORTATION

PROJECT NAME: East Montpelier-Hartford VT14
PROJECT NUMBER: STPG SIGN(21)

FILE NAME: Royalton.xls
PROJECT MANAGER: N. Avery
DESIGNED BY: D. Crossley
ROYALTON SHEET 20

PLOT DATE: 6/10/2009
DRAWN BY: T. Guazzoni
CHECKED BY: S. Menard

DIRECTION	MILEPOINT	LOCATION CODE (SHEET 2)	SIGN CODE	WIDTH (IN)	HEIGHT (IN)	SHEETING REMARKS	SIGN LEGEND FOR ALL POST LENGTHS AND INSTALLATION DATES SEE ORIGINAL RECORD PLANS	NEW SIGNS "A"	NEW SIGNS "B"	EXISTING SIGNS RETAIN	EXISTING SIGNS SALVAGE FROM	EXISTING SIGNS SALVAGE TO	EXISTING SIGNS REMOVE	EXIST POST RETAIN	EXIST POST REMOVE	NUMBER OF NEW POSTS	SQUARE STEEL (IN) (LB / FT) 1.75 / 1.88	SQUARE STEEL (IN) (LB / FT) 2.00 / 2.42	SQUARE STEEL (IN) (LB / FT) 2.50 / 3.35	TUBULAR STEEL Ø (IN) FOUNDATION	TUBULAR STEEL Ø (IN) (LB / FT) 3.00 / 7.60	TUBULAR STEEL Ø (IN) (LB / FT) 3.50 / 9.00	TUBULAR STEEL Ø (IN) (LB / FT) 4.00 / 10.80	TUBULAR STEEL Ø (IN) (LB / FT) 5.00 / 14.60	SIGN FRAME REQUIRED	REMARKS	SIGN DETAIL: DETAIL IN SHS	SIGN DETAIL: DETAIL ON SHEET NUMBER	SIGN DETAIL: DETAIL ON STD SHEET NUMBER
ROYALTON VT 14							FY-FLUORESCENT YELLOW FYG-FLUORESCENT YELLOW GREEN																			"SHS"-STANDARD HIGHWAY SIGNS			
		F	M4-5	24	12								1															
		F	M1-1	24	24								1															
		F	M6-1L	21	15								1															
		F	M3-3	24	12			2.00																	3B	GREEN ON WHITE SHEETING	X	7	
		F	M1-5	24	24			4.00																				E-136B
		F	M6-3	21	15			~~2.19~~ 2.18																		GREEN ON WHITE SHEETING	X		
		F	M3-4	24	12			2.00																		GREEN ON WHITE SHEETING	X		
		F	M1-5	30	24			5.00																			E-136B
		F	M6-1L	21	15			~~2.19~~ 2.18																		GREEN ON WHITE SHEETING	X		
		F	M4-5	24	12			2.00																		WHITE ON BLUE SHEETING	X		
		F	M1-1	24	24			4.00																			X		
		F	M6-1L	21	15			~~2.19~~ 2.18																		WHITE ON BLUE SHEETING	X		
SB	5.830	F	M3-3	24	12								1		X										3B			7	
		F	M1-5	24	24								1															
		F	M3-3	24	12			2.00								1	X									GREEN ON WHITE SHEETING	X		
							SHEET TOTALS	~~27.57~~ 27.54 SF	0.00 SF	0 EA	0 EA	0 EA	5 EA	0 EA	0 EA	1 EA	15 FT								
							TOWN TOTALS	973.5	0.0	62.0	9.0	9.0	190	0.0	0.0	152	2280.0								

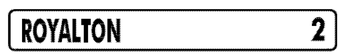
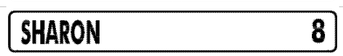
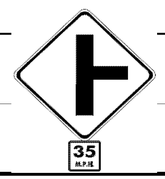
SIGN SUMMARY SHEET

VERMONT AGENCY OF TRANSPORTATION

PROJECT NAME: East Montpelier-Hartford VT14
PROJECT NUMBER: STPG SIGN(21)

FILE NAME: Royalton.xls
PROJECT MANAGER: N. Avery
DESIGNED BY: D. Crossley
ROYALTON SHEET 21

PLOT DATE: 6/10/2009
DRAWN BY: T. Guazzoni
CHECKED BY: S. Menard
SHEET 50 OF 162

DIRECTION	MILEPOINT	LOCATION CODE (SHEET 2)	SIGN CODE	WIDTH (IN)	HEIGHT (IN)	SHEETING REMARKS	SIGN LEGEND	NEW SIGNS "A"	NEW SIGNS "B"	EXISTING SIGNS RETAIN	EXISTING SIGNS SALVAGE FROM	EXISTING SIGNS SALVAGE TO	EXISTING SIGNS REMOVE	EXIST POST RETAIN	EXIST POST REMOVE	NUMBER OF NEW POSTS	SQUARE STEEL (IN) 1.75 (LB / FT) 1.88	SQUARE STEEL (IN) 2.00 (LB / FT) 2.42	SQUARE STEEL (IN) 2.50 (LB / FT) 3.35	TUBULAR STEEL Ø (IN) FOUNDATION	TUBULAR STEEL Ø (IN) 3.00 (LB / FT) 7.60	TUBULAR STEEL Ø (IN) 3.50 (LB / FT) 9.00	TUBULAR STEEL Ø (IN) 4.00 (LB / FT) 10.80	TUBULAR STEEL Ø (IN) 5.00 (LB / FT) 14.60	SIGN FRAME REQUIRED	REMARKS	SIGN DETAIL: DETAIL IN SHS	SIGN DETAIL: DETAIL ON SHEET NUMBER	SIGN DETAIL: DETAIL ON STD SHEET NUMBER
ROYALTON VT 14							FY-FLUORESCENT YELLOW FYG-FLUORESCENT YELLOW GREEN																			"SHS"-STANDARD HIGHWAY SIGNS			
		F	M1-5	24	24			4.00																				E-136B
SB	5.793	F	W12-2	36	36								1	X														
		F	W16-3	24	18								1															
		F	W12-2	36	36	FY		9.00																		X		
		F	W16-3	24	18	FY		3.00																		X		
SB	5.730	F	R2-1	24	30								1		X													
		F	R2-1	24	30			5.00								1		X								X		
SB	5.700	F	D1-1	72	10								1		X													
		F	D1-1	72	10								1															
		F	D1-1	72	12			6.00								2		X								5	
		F	D1-1	72	12			6.00																		5	
SB	5.660	F	W2-2R	30	30		RIGHT SIDE ROAD						1		X													
		F	W13-1	18	18		35 MPH PLAQUE						1															
SB	5.625	F	W2-2R	30	30			6.25								1		X								INSTALL 185'+/- SOUTH OF ORIGINAL SIGN LOCATION	X		
		F	W13-1	18	18			2.25																			X	
SIGN SUMMARY SHEET							SHEET TOTALS	41.50	0.00	0	0	0	7	0	0	4		60									
								SF	SF	EA	EA	EA	EA	EA	EA	EA		FT									
VERMONT AGENCY OF TRANSPORTATION							TOWN TOTALS	973.5	0.0	62.0	9.0	9.0	190	0.0	0.0	152		2280.0									

PROJECT NAME: East Montpelier-Hartford VT14
PROJECT NUMBER: STPG SIGN(21)
FILE NAME: Royalton.xls
PROJECT MANAGER: N. Avery
DESIGNED BY: D. Crossley
ROYALTON SHEET 22
PLOT DATE: 6/10/2009
DRAWN BY: T. Guazzoni
CHECKED BY: S. Menard
SHEET 51 OF 162

DIRECTION	MILEPOINT	LOCATION CODE (SHEET 2)	SIGN CODE	WIDTH (IN)	HEIGHT (IN)	SHEETING REMARKS	SIGN LEGEND FOR ALL POST LENGTHS AND INSTALLATION DATES SEE ORIGINAL RECORD PLANS	NEW SIGNS "A"	NEW SIGNS "B"	EXISTING SIGNS RETAIN	EXISTING SIGNS SALVAGE FROM	EXISTING SIGNS SALVAGE TO	EXISTING SIGNS REMOVE	EXIST POST RETAIN	EXIST POST REMOVE	NUMBER OF NEW POSTS	SQUARE STEEL (IN) 1.75 (LB / FT) 1.88	SQUARE STEEL (IN) 2.00 (LB / FT) 2.42	SQUARE STEEL (IN) 2.50 (LB / FT) 3.35	TUBULAR STEEL Ø (IN) FOUNDATION	TUBULAR STEEL Ø (IN) 3.00 (LB / FT) 7.60	TUBULAR STEEL Ø (IN) 3.50 (LB / FT) 9.00	TUBULAR STEEL Ø (IN) 4.00 (LB / FT) 10.80	TUBULAR STEEL Ø (IN) 5.00 (LB / FT) 14.60	SIGN FRAME REQUIRED	REMARKS	SIGN DETAIL: DETAIL IN SHS	SIGN DETAIL: DETAIL ON SHEET NUMBER	SIGN DETAIL: DETAIL ON STD SHEET NUMBER
ROYALTON VT 14							FY-FLUORESCENT YELLOW FYG-FLUORESCENT YELLOW GREEN																			"SHS"-STANDARD HIGHWAY SIGNS			
SB	5.539	C	UNK	24	30		BRIDGE WEIGHT LIMITS (TOWN SIGN)					1				1		X								ROYALTON HILL RD TH-6			
SB	5.547	C	UNK	24	30		BRIDGE WEIGHT LIMITS (TOWN SIGN) ON BACK OF STOP SIGN				1																		
SB	5.547	H	R1-1	24	24								1		X												ROYALTON HILL RD TH-6			
		H	R1-1	30	30			6.25								1		X										X		
SB	5.440	F	R2-1	24	30								1	X																
		F	R2-1	24	30			5.00								1		X										X		
SB	5.300	A	W12-2	36	36								1		X															
		A	VW-268	30	30								1																	
		A	W12-2	36	36	FY		9.00								2		X								X		
		A	VW-268	30	30	FY		6.25																					6	
SB	5.260	F	W1-3R	30	48								1		X															
		F	W13-1	18	18								1																	
		F	W1-3R	36	36	FY		9.00								2		X										X		
		F	W13-1	24	24	FY		4.00																				X		
SB	5.210	F	VW-353	36	36	FY		9.00					2			2		X									INSTALL ACROSS FROM SNOWMOBILE SIGN		6	
							SHEET TOTALS	48.50 SF	0.00 SF	0 EA	1 EA	1 EA	8 ~~6~~ EA	0 EA	0 EA	9 EA	135 FT									
							TOWN TOTALS	973.5	0.0	62.0	9.0	9.0	190	0.0	0.0	152	2280.0									

SIGN SUMMARY SHEET

VERMONT AGENCY OF TRANSPORTATION

PROJECT NAME: East Montpelier-Hartford VT14
PROJECT NUMBER: STPG SIGN(21)

FILE NAME: Rovalton.xls
PROJECT MANAGER: N. Avery
DESIGNED BY: D. Crossley
PLOT DATE: 6/10/2009
DRAWN BY: T. Guazzoni
CHECKED BY: S. Menard

DIRECTION	MILEPOINT	LOCATION CODE (SHEET 2)	SIGN CODE	WIDTH (IN)	HEIGHT (IN)	SHEETING REMARKS	SIGN LEGEND FOR ALL POST LENGTHS AND INSTALLATION DATES SEE ORIGINAL RECORD PLANS	NEW SIGNS "A"	NEW SIGNS "B"	EXISTING SIGNS RETAIN	EXISTING SIGNS SALVAGE FROM	EXISTING SIGNS SALVAGE TO	EXISTING SIGNS REMOVE	EXIST POST RETAIN	EXIST POST REMOVE	NUMBER OF NEW POSTS	SQUARE STEEL (IN) 1.75 (LB / FT) 1.88	SQUARE STEEL (IN) 2.00 (LB / FT) 2.42	SQUARE STEEL (IN) 2.50 (LB / FT) 3.35	TUBULAR STEEL Ø (IN) FOUNDATION	TUBULAR STEEL Ø (IN) 3.00 (LB / FT) 7.60	TUBULAR STEEL Ø (IN) 3.50 (LB / FT) 9.00	TUBULAR STEEL Ø (IN) 4.00 (LB / FT) 10.80	TUBULAR STEEL Ø (IN) 5.00 (LB / FT) 14.60	SIGN FRAME REQUIRED	REMARKS	SIGN DETAIL: DETAIL IN SHS	SIGN DETAIL: DETAIL ON SHEET NUMBER	SIGN DETAIL: DETAIL ON STD SHEET NUMBER
ROYALTON VT 14							FY-FLUORESCENT YELLOW FYG-FLUORESCENT YELLOW GREEN																				"SHS"-STANDARD HIGHWAY SIGNS			
		F	W16-2	30	24	FY		5.00																		X		
SB	5.140	F	W12-2	36	36								1	X															
		F	W12-2	36	36	FY		9.00																				X	
SB	5.132	B	OM-3R	12	36								1	NA													SIGN BOLTED TO ABUTMENT		
		B	OM-3R	12	36	FY		3.00								1 ~~NA~~											BOLT SIGN TO ABUTMENT	X	
SB	5.128	A	OM-3R	12	36								1	NA													SIGN BOLTED TO ABUTMENT		
		A	OM-3R	12	36	FY		3.00								1		X									INSTALL ON POST IN FRONT OF ABUTMENT	X	
SB	5.120	E	W1-6	48	24								1		X														
		E	W1-6	48	24	FY		8.00								2		X										X	
SB	5.110	E	W1-6	48	24								1		X	1													
		E	W1-6	48	24	FY		8.00								2		X										X	
SB	5.080	F	R2-1	24	30								1		X	1													
		F	R2-1	24	30			~~5.00~~ 5.00								~~1~~ 2		X									NEW MISSING, HIT/STOLEN REDO	X	
SB	5.000	E	W1-3R	36	36		RIGHT REVERSE TURN						1		X														
		E	W13-1	24	24		20 MPH PLAQUE						1																
SIGN SUMMARY SHEET							SHEET TOTALS	~~41.00~~ 46.00	0.00	0	0	0	8	0	0	~~6~~ 10		90										
VERMONT AGENCY OF TRANSPORTATION								SF	SF	EA	EA	EA	EA	EA	EA	EA		FT										
							TOWN TOTALS	973.5	0.0	62.0	9.0	9.0	190	0.0	0.0	152		2280.0										

PROJECT NAME: East Montpelier-Hartford VT14
PROJECT NUMBER: STPG SIGN(21)

FILE NAME: Royalton.xls
PROJECT MANAGER: N. Avery
DESIGNED BY: D. Crossley
ROYALTON SHEET 24

PLOT DATE: 6/10/2009
DRAWN BY: T. Guazzoni
CHECKED BY: S. Menard
SHEET 53 OF 162

DIRECTION	MILEPOINT	LOCATION CODE (SHEET 2)	SIGN CODE	WIDTH (IN)	HEIGHT (IN)	SHEETING REMARKS	SIGN LEGEND FOR ALL POST LENGTHS AND INSTALLATION DATES SEE ORIGINAL RECORD PLANS	NEW SIGNS "A"	NEW SIGNS "B"	EXISTING SIGNS RETAIN	EXISTING SIGNS SALVAGE FROM	EXISTING SIGNS SALVAGE TO	EXISTING SIGNS REMOVE	EXIST POST RETAIN	EXIST POST REMOVE	NUMBER OF NEW POSTS	SQUARE STEEL (IN) 1.75 (LB / FT) 1.88	SQUARE STEEL (IN) 2.00 (LB / FT) 2.42	SQUARE STEEL (IN) 2.50 (LB / FT) 3.35	TUBULAR STEEL Ø (IN) FOUNDATION	TUBULAR STEEL Ø (IN) 3.00 (LB / FT) 7.60	TUBULAR STEEL Ø (IN) 3.50 (LB / FT) 9.00	TUBULAR STEEL Ø (IN) 4.00 (LB / FT) 10.80	TUBULAR STEEL Ø (IN) 5.00 (LB / FT) 14.60	SIGN FRAME REQUIRED	REMARKS	SIGN DETAIL: DETAIL IN SHS	SIGN DETAIL: DETAIL ON SHEET NUMBER	SIGN DETAIL: DETAIL ON STD SHEET NUMBER
ROYALTON VT 14							FY-FLUORESCENT YELLOW FYG-FLUORESCENT YELLOW GREEN																			"SHS"-STANDARD HIGHWAY SIGNS			
SB	4.725	F	W3-5	36	36			9.00								2		X								INSTALL 350'+/- NORTH OF STANDING STONE PERENNIAL FARM SIGN.	X		
SB	4.650	F	VD-062B	72	16		BUSINESS SIGN			1				X															
SB	4.610	F	VD-018	30	18								1	~~X~~	X															
		F	VD-018	30	18			3.75								1													E-128B
SB	4.520	F	R2-1	24	30								1		X															
		F	R2-1	30	36			7.50								1		X										6	
SB	4.530	F	W10-3L	30	30		LEFT SIDE ROAD W/TRACKS						1		X															
SB	4.323	G	VR-017	24	24								1		X												BRIDGE STREET TH-101			
		G	VR-017	24	30			5.00								1		X											
SB	4.320	H	R1-1	24	24								1		X															
		H	R1-1	30	30			6.25								1		X											
SB	4.300	F	R2-1	24	30								1		X															
		F	R2-1	24	30			5.00								1		X										X	
SB	4.267	G	VR-017	24	30			5.00					~~1~~			1		X									BRIDGE STREET FORK TH-5			E-141
SB	4.250	H	R1-1	30	30		STOP						1		X															
							SHEET TOTALS	41.50 SF	0.00 SF	1 EA	0 EA	0 EA	~~8~~ 7 EA	0 EA	0 EA	~~8~~ 7 EA	105 FT												
							TOWN TOTALS	973.5	0.0	62.0	9.0	9.0	190	0.0	0.0	152	2280.0												

SIGN SUMMARY SHEET

VERMONT AGENCY OF TRANSPORTATION

PROJECT NAME: **East Montpelier-Hartford VT14**
PROJECT NUMBER: **STPG SIGN(21)**

FILE NAME: **Rovalton.xls** PLOT DATE: **6/10/2009**
PROJECT MANAGER: **N. Avery** DRAWN BY: **T. Guazzoni**
DESIGNED BY: **D. Crossley** CHECKED BY: **S. Menard**
ROYALTON SHEET 25 SHEET **54** OF **162**

DIRECTION	MILEPOINT	LOCATION CODE (SHEET 2)	SIGN CODE	WIDTH (IN)	HEIGHT (IN)	SHEETING REMARKS	SIGN LEGEND FOR ALL POST LENGTHS AND INSTALLATION DATES SEE ORIGINAL RECORD PLANS	NEW SIGNS "A"	NEW SIGNS "B"	EXISTING SIGNS RETAIN	EXISTING SIGNS SALVAGE FROM	EXISTING SIGNS SALVAGE TO	EXISTING SIGNS REMOVE	EXIST POST RETAIN	EXIST POST REMOVE	NUMBER OF NEW POSTS	SQUARE STEEL (IN) 1.75 (LB / FT) 1.88	SQUARE STEEL (IN) 2.00 (LB / FT) 2.42	SQUARE STEEL (IN) 2.50 (LB / FT) 3.35	TUBULAR STEEL Ø (IN) FOUNDATION	TUBULAR STEEL Ø (IN) 3.00 (LB / FT) 7.60	TUBULAR STEEL Ø (IN) 3.50 (LB / FT) 9.00	TUBULAR STEEL Ø (IN) 4.00 (LB / FT) 10.80	TUBULAR STEEL Ø (IN) 5.00 (LB / FT) 14.60	SIGN FRAME REQUIRED	REMARKS	SIGN DETAIL: DETAIL IN SHS	SIGN DETAIL: DETAIL ON SHEET NUMBER	SIGN DETAIL: DETAIL ON STD SHEET NUMBER
ROYALTON VT 14							FY-FLUORESCENT YELLOW FYG-FLUORESCENT YELLOW GREEN																			"SHS"-STANDARD HIGHWAY SIGNS			
		G	VR-017	24	30		LEGAL LOAD LIMIT 24,000 LBS						1															
		H	R1-1	30	30			6.25								1		X								X	
SB	4.182	G	VR-017	24	30								1	X													ROYALTON COMMON RD TH-101			
		G	VR-017	24	30			5.00																					E-141
SB	4.181	H	R1-1	30	30								1	X																
		H	R1-1	30	30			6.25																				X	
SB	4.180	F	R2-1	24	30								1	X																
		F	R2-1	24	30			5.00																				X	
SB	3.980	F	VW-268	30	30		NARROW UNDERPASS						1		X														6
SB	3.930	F	W1-3L	30	30		LEFT REVERSE TURN						1		X														
		F	W13-1	18	18		25 MPH PLAQUE						1																
SB	3.890	F	W1-3L	30	30			6.25								1		X									INSTALL 200' +/- SOUTH OF ORIGINAL SIGN LOCATION	X		
		F	W13-1	18	18			2.25																				X	
SB	3.840	F	VW-268	30	30			6.25								1		X									INSTALL 50' NORTH OF LARGE ARROW SIGN.			6
SB	3. 840	F	W1-6	48	24								1		X														
SIGN SUMMARY SHEET							SHEET TOTALS	37.25	0.00	0	0	0	8	0	0	3			45									
VERMONT AGENCY OF TRANSPORTATION								SF	SF	EA	EA	EA	EA	EA	EA	EA			FT									
							TOWN TOTALS	973.5	0.0	62.0	9.0	9.0	190	0.0	0.0	152			2280.0									

PROJECT NAME: **East Montpelier-Hartford VT14**
PROJECT NUMBER: **STPG SIGN(21)**

FILE NAME: **Royalton.xls** PLOT DATE: **6/10/2009**
PROJECT MANAGER: **N. Avery** DRAWN BY: **T. Guazzoni**
DESIGNED BY: **D. Crossley** CHECKED BY: **S. Menard**
ROYALTON SHEET 26 SHEET **55** OF **162**

DIRECTION	MILEPOINT	LOCATION CODE (SHEET 2)	SIGN CODE	WIDTH (IN)	HEIGHT (IN)	SHEETING REMARKS	SIGN LEGEND FOR ALL POST LENGTHS AND INSTALLATION DATES SEE ORIGINAL RECORD PLANS	NEW SIGNS "A"	NEW SIGNS "B"	EXISTING SIGNS RETAIN	EXISTING SIGNS SALVAGE FROM	EXISTING SIGNS SALVAGE TO	EXISTING SIGNS REMOVE	EXIST POST RETAIN	EXIST POST REMOVE	NUMBER OF NEW POSTS	SQUARE STEEL (IN) 1.75 (LB / FT) 1.88	SQUARE STEEL (IN) 2.00 (LB / FT) 2.42	SQUARE STEEL (IN) 2.50 (LB / FT) 3.35	TUBULAR STEEL Ø (IN) FOUNDATION	TUBULAR STEEL Ø (IN) 3.00 (LB / FT) 7.60	TUBULAR STEEL Ø (IN) 3.50 (LB / FT) 9.00	TUBULAR STEEL Ø (IN) 4.00 (LB / FT) 10.80	TUBULAR STEEL Ø (IN) 5.00 (LB / FT) 14.60	SIGN FRAME REQUIRED	REMARKS	SIGN DETAIL: DETAIL IN SHS	SIGN DETAIL: DETAIL ON SHEET NUMBER	SIGN DETAIL: DETAIL ON STD SHEET NUMBER
ROYALTON VT 14							FY-FLUORESCENT YELLOW FYG-FLUORESCENT YELLOW GREEN																			"SHS"-STANDARD HIGHWAY SIGNS			
		F	W1-6	48	24			8.00								2		X									X		
SB	3.835	A	OM-3R	12	36								1		X														
		A	OM-3R	12	36	FY		3.00								1		X									X		
SB	3.825	B	OM-3L	12	36								1		X														
		B	OM-3L	12	36	FY		3.00								1		X									X		
SB	3.750	F	R2-1	24	30								1		X														
		F	R2-1	24	30			5.00								1		X									X		
SB	3.640	E	W1-3L	30	30		LEFT REVERSE TURN						1		X														
		E	W13-1	18	18		25 MPH PLAQUE						1																
SB	3.526	F	W1-2R	30	30		RIGHT CURVE				1	1			X	1		X											
		F	W13-1	24	24		35 MPH PLAQUE				1	1																	
SB	3.500	C	UNK	24	30		NO PARKING BETWEEN SIGNS						1		X														
SB	3.310	F	W1-4R	30	30		RIGHT REVERSE CURVE			1				X															
SB	3.300	F	W13-1	24	24		35 MPH			1				X															
SB	3.118	G	VR-023B	24	30		$500 FINE FOR THROWING TRASH ON HIGHWAYS AND STREAMS			1				X															
							SHEET TOTALS	19.00	0.00	3	2	2	6	0	0	6		90											
								SF	SF	EA	EA	EA	EA	EA	EA	EA		FT											
							TOWN TOTALS	973.5	0.0	62.0	9.0	9.0	190	0.0	0.0	152		2280.0											

SIGN SUMMARY SHEET

VERMONT AGENCY OF TRANSPORTATION

PROJECT NAME: East Montpelier-Hartford VT14
PROJECT NUMBER: STPG SIGN(21)

FILE NAME: Royalton.xls
PROJECT MANAGER: N. Avery
DESIGNED BY: D. Crossley
ROYALTON SHEET 27

PLOT DATE: 6/10/2009
DRAWN BY: T. Guazzoni
CHECKED BY: S. Menard
SHEET 56 OF 162

DIRECTION	MILEPOINT	LOCATION CODE (SHEET 2)	SIGN CODE	WIDTH (IN)	HEIGHT (IN)	SHEETING REMARKS	SIGN LEGEND FOR ALL POST LENGTHS AND INSTALLATION DATES SEE ORIGINAL RECORD PLANS	NEW SIGNS "A"	NEW SIGNS "B"	EXISTING SIGNS RETAIN	EXISTING SIGNS SALVAGE FROM	EXISTING SIGNS SALVAGE TO	EXISTING SIGNS REMOVE	EXIST POST RETAIN	EXIST POST REMOVE	NUMBER OF NEW POSTS	SQUARE STEEL (IN) 1.75 (LB / FT) 1.88	SQUARE STEEL (IN) 2.00 (LB / FT) 2.42	SQUARE STEEL (IN) 2.50 (LB / FT) 3.35	TUBULAR STEEL Ø (IN) FOUNDATION	TUBULAR STEEL Ø (IN) 3.00 (LB / FT) 7.60	TUBULAR STEEL Ø (IN) 3.50 (LB / FT) 9.00	TUBULAR STEEL Ø (IN) 4.00 (LB / FT) 10.80	TUBULAR STEEL Ø (IN) 5.00 (LB / FT) 14.60	SIGN FRAME REQUIRED	REMARKS	SIGN DETAIL DETAIL IN SHS	SIGN DETAIL DETAIL ON SHEET NUMBER	SIGN DETAIL DETAIL ON STD SHEET NUMBER
ROYALTON VT 14							FY-FLUORESCENT YELLOW FYG-FLUORESCENT YELLOW GREEN																			"SHS"-STANDARD HIGHWAY SIGNS			
SB	2.890	F	W1-10R	30	30		MODIFIED RIGHT CURVE			1				X														
SB	2.820	C	R1-1	30	30		STOP						1		X														
SB	2.750	F	VD-062B	72	16		BUSNESS SIGN			1				X															
		F	VD-062AL	72	16		BUSNESS SIGN			1																			
		F	VD-062B	72	16		BUSNESS SIGN			1																			
SB	2.695	F	W3-5	36	36		SPEED REDUCTION SPEED LIMIT 35			1				X															
SB	2.610	F	VW-054L	30	30		HIDDEN DRIVE LEFT						1		X														
		F	VW-202	30	30		TRUCKS ENTERING						1																
SB	2.590	F	R2-1	24	30		SPEED LIMIT 35						1	X															
		F	R2-1	30	36			7.50																				6	
SB	2.520	F	VD-018	30	18		SOUTH ROYALTON SHARON 5	3.75					1			1	X									REDO PAINTBALL DAMAGE INSTALL AT PAVEMENT CHANGE.			E-128B
SB	2.484	F	M2-1S	21	15		JCT			1				X															
		F	M1-5	30	24		VERMONT 110			1																			
SB	2.443	F	W11-2YG	30	30		PEDESTRIAN SYMBOL			1				X															
		F	W16-9	24	10		AHEAD			1																			
							SHEET TOTALS	~~11.25~~ 15.00 SF	0.00 SF	9 EA	0 EA	0 EA	~~4~~ 5 EA	0 EA	0 EA	1 EA	15 FT											
							TOWN TOTALS	973.5	0.0	62.0	9.0	9.0	190	0.0	0.0	152	2280.0												

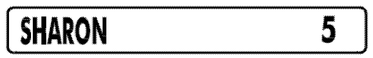
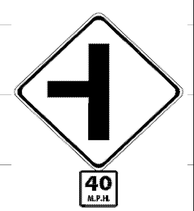
SIGN SUMMARY SHEET

VERMONT AGENCY OF TRANSPORTATION

PROJECT NAME: East Montpelier-Hartford VT14
PROJECT NUMBER: STPG SIGN(21)

FILE NAME: Royalton.xls
PROJECT MANAGER: N. Avery
DESIGNED BY: D. Crossley
ROYALTON SHEET 28

PLOT DATE: 6/10/2009
DRAWN BY: T. Guazzoni
CHECKED BY: S. Menard
SHEET 57 OF 162

DIRECTION	MILEPOINT	LOCATION CODE (SHEET 2)	SIGN CODE	WIDTH (IN)	HEIGHT (IN)	SHEETING REMARKS	SIGN LEGEND	NEW SIGNS "A"	NEW SIGNS "B"	EXISTING SIGNS RETAIN	EXISTING SIGNS SALVAGE FROM	EXISTING SIGNS SALVAGE TO	EXISTING SIGNS REMOVE	EXIST POST RETAIN	EXIST POST REMOVE	NUMBER OF NEW POSTS	SQUARE STEEL (IN) 1.75 (LB / FT) 1.88	SQUARE STEEL (IN) 2.00 (LB / FT) 2.42	SQUARE STEEL (IN) 2.50 (LB / FT) 3.35	TUBULAR STEEL Ø (IN) FOUNDATION	TUBULAR STEEL Ø (IN) 3.00 (LB / FT) 7.60	TUBULAR STEEL Ø (IN) 3.50 (LB / FT) 9.00	TUBULAR STEEL Ø (IN) 4.00 (LB / FT) 10.80	TUBULAR STEEL Ø (IN) 5.00 (LB / FT) 14.60	SIGN FRAME REQUIRED	REMARKS	SIGN DETAIL: DETAIL IN SHS	SIGN DETAIL: DETAIL ON SHEET NUMBER	SIGN DETAIL: DETAIL ON STD SHEET NUMBER
ROYALTON VT 14							FY-FLUORESCENT YELLOW FYG-FLUORESCENT YELLOW GREEN																			"SHS"-STANDARD HIGHWAY SIGNS			
SB	2.276	F	D2-1	72	10								1		X													
		F	D2-1	72	12			6.00								2		X								5	
		F	M3-3S	24	12		SOUTH					1														INSTALL ON LEFT POST		
		F	M1-5	24	24		VERMONT 14					1														INSTALL ON LEFT POST		
SB	2.048	F	R2-1	24	30		SPEED LIMIT 50			1				X														
SB	1.660	F	R2-5A	24	30		REDUCED SPEED AHEAD						1		X													
SB	1.610	F	VD-062B	72	16		BUSINESS SIGN			1				X														
SB	1.560	F	VW-060	30	30								1		X													
		F	VW-060	30	30			6.25		1						1		X										E-154
SB	1.520	F	R2-1	24	30								1	X														
		F	R2-1	30	36			7.50																			6	
SB	1.460	F	W2-2L	30	30								1		X													
		F	W13-1	18	18								1															
		F	W2-2L	30	30			6.25								1		X									X	
		F	W13-1	18	18			2.25																			X	
SIGN SUMMARY SHEET							SHEET TOTALS	28.25 SF	0.00 SF	3 EA	0 EA	2 EA	6 EA	0 EA	0 EA	4 EA		60 FT									
VERMONT AGENCY OF TRANSPORTATION							TOWN TOTALS	973.5	0.0	62.0	9.0	9.0	190	0.0	0.0	152		2280.0									

PROJECT NAME: **East Montpelier-Hartford VT14**
PROJECT NUMBER: **STPG SIGN(21)**

FILE NAME: **Royalton.xls** PLOT DATE: **6/10/2009**
PROJECT MANAGER: **N. Averv** DRAWN BY: **T. Guazzoni**
DESIGNED BY: **D. Crossley** CHECKED BY: **S. Menard**
ROYALTON SHEET 30 SHEET **59** OF **162**

DIRECTION	MILEPOINT	LOCATION CODE (SHEET 2)	SIGN CODE	WIDTH (IN)	HEIGHT (IN)	SHEETING REMARKS	SIGN LEGEND	NEW SIGNS "A"	NEW SIGNS "B"	EXISTING SIGNS RETAIN	EXISTING SIGNS SALVAGE FROM	EXISTING SIGNS SALVAGE TO	EXISTING SIGNS REMOVE	EXIST POST RETAIN	EXIST POST REMOVE	NUMBER OF NEW POSTS	SQUARE STEEL (IN) 1.75 (LB / FT) 1.88	SQUARE STEEL (IN) 2.00 (LB / FT) 2.42	SQUARE STEEL (IN) 2.50 (LB / FT) 3.35	TUBULAR STEEL Ø (IN) FOUNDATION	TUBULAR STEEL Ø (IN) 3.00 (LB / FT) 7.60	TUBULAR STEEL Ø (IN) 3.50 (LB / FT) 9.00	TUBULAR STEEL Ø (IN) 4.00 (LB / FT) 10.80	TUBULAR STEEL Ø (IN) 5.00 (LB / FT) 14.60	SIGN FRAME REQUIRED	REMARKS	SIGN DETAIL: DETAIL IN SHS	SIGN DETAIL: DETAIL ON SHEET NUMBER	SIGN DETAIL: DETAIL ON STD SHEET NUMBER
ROYALTON VT 14							FY-FLUORESCENT YELLOW FYG-FLUORESCENT YELLOW GREEN																			"SHS"-STANDARD HIGHWAY SIGNS			
SB	1.300	F	R2-1	24	30								1	X															
		F	R2-1	24	30			5.00																			X		
SB	1.130	F	R2-1	24	30								1	X															
		F	R2-1	24	30			5.00																			X		
SB	0.960	F	W1-2R	30	30								1	X															
		F	W1-2R	30	30			6.25																					
SIGN SUMMARY SHEET							SHEET TOTALS	16.25	0.00	0	0	0	3	0	0	0	0											
VERMONT AGENCY OF TRANSPORTATION								SF	SF	EA	EA	EA	EA	EA	EA	EA	FT											
							TOWN TOTALS	973.5	0.0	62.0	9.0	9.0	190	0.0	0.0	152	2280.0											

PROJECT NAME: East Montpelier-Hartford VT14
PROJECT NUMBER: STPG SIGN(21)
FILE NAME: Royalton.xls
PROJECT MANAGER: N. Avery
DESIGNED BY: D. Crossley
ROYALTON SHEET 31
PLOT DATE: 6/10/2009
DRAWN BY: T. Guazzoni
CHECKED BY: S. Menard
SHEET 60 OF 162

DIRECTION	MILEPOINT	LOCATION CODE (SHEET 2)	SIGN CODE	WIDTH (IN)	HEIGHT (IN)	SHEETING REMARKS	SIGN LEGEND FOR ALL POST LENGTHS AND INSTALLATION DATES SEE ORIGINAL RECORD PLANS	NEW SIGNS "A"	NEW SIGNS "B"	EXISTING SIGNS RETAIN	EXISTING SIGNS SALVAGE FROM	EXISTING SIGNS SALVAGE TO	EXISTING SIGNS REMOVE	EXIST POST RETAIN	EXIST POST REMOVE	NUMBER OF NEW POSTS	SQUARE STEEL (IN) 1.75 (LB / FT) 1.88	SQUARE STEEL (IN) 2.00 (LB / FT) 2.42	SQUARE STEEL (IN) 2.50 (LB / FT) 3.35	TUBULAR STEEL Ø (IN) FOUNDATION	TUBULAR STEEL Ø (IN) 3.00 (LB / FT) 7.60	TUBULAR STEEL Ø (IN) 3.50 (LB / FT) 9.00	TUBULAR STEEL Ø (IN) 4.00 (LB / FT) 10.80	TUBULAR STEEL Ø (IN) 5.00 (LB / FT) 14.60	SIGN FRAME REQUIRED	REMARKS	SIGN DETAIL: DETAIL IN SHS	SIGN DETAIL: DETAIL ON SHEET NUMBER	SIGN DETAIL: DETAIL ON STD SHEET NUMBER
BETHEL VT 14							FY-FLUORESCENT YELLOW FYG-FLUORESCENT YELLOW GREEN																			"SHS"-STANDARD HIGHWAY SIGNS			
NB	0.000	C	VD-024	72	10			5.00					1			2		X										E-128B
NB	0.120	A	W1-4L	30	30								1		X													
NB	0.190	A	W1-4L	30	30			6.25								1		X									INSTALL 425' +/- NORT OF ORIGINAL SIGN LOCATION	X		
NB	0.400	A	VD-018	30	18								1		X														
		A	VD-018	30	18			3.75								1		X										E-128B
NB	0.570	A	S3-1	30	30		SCHOOL BUS STOP AHEAD						1		X													
NB	0.585	C	VR-017	24	24								1		X										GAGE RD TH-18			
		C	VR-017	24	24			~~4.00~~ 5.00								1		X										E-141
NB	0.590	D	R1-1	24	24								1		X													
		D	R1-1	30	30			6.25								1		X								INSTALL CLOSER TO ROUTE 14 IN ISLAND	X	
NB	0.595	D	R1-1	30	30			6.25					1			1		X								INSTALL AT NORMAL LOCATION	X	
NB	0.600	A	W11-2	30	30								1		X													
		A	W11-2	30	30	FYG		6.25								1		X									X	
		A	W16-9	24	12	FYG		2.00																			X	
NB	0.720	A	M3-1	24	12								1		X													
							SHEET TOTALS	~~39.75~~ 40.75 SF	0.00 SF	0 EA	0 EA	0 EA	~~9~~ 7 EA	0 EA	0 EA	8 EA	120 FT											
							TOWN TOTALS	99.8 SF	0.0 SF	0.0 EA	0.0 EA	0.0 EA	20 EA	0.0 EA	0.0 EA	17 EA	255.0 FT											

SIGN SUMMARY SHEET

VERMONT AGENCY OF TRANSPORTATION

PROJECT NAME: **Hartford-East Montpelier VT14**
PROJECT NUMBER: **STPG SIGN(21)**

FILE NAME: **Bethel.xls** PLOT DATE: **6/10/2009**
PROJECT MANAGER: **N. Avery** DRAWN BY: **T. Guazzoni**
DESIGNED BY: **D. Crossley** CHECKED BY: **S. Menard**
BETHEL SHEET 1 SHEET **61** OF **162**

DIRECTION	MILEPOINT	LOCATION CODE (SHEET 2)	SIGN CODE	WIDTH (IN)	HEIGHT (IN)	SHEETING REMARKS	SIGN LEGEND	NEW SIGNS "A"	NEW SIGNS "B"	EXISTING SIGNS RETAIN	EXISTING SIGNS SALVAGE FROM	EXISTING SIGNS SALVAGE TO	EXISTING SIGNS REMOVE	EXIST POST RETAIN	EXIST POST REMOVE	NUMBER OF NEW POSTS	SQUARE STEEL (IN) 1.75 (LB / FT) 1.88	SQUARE STEEL (IN) 2.00 (LB / FT) 2.42	SQUARE STEEL (IN) 2.50 (LB / FT) 3.35	TUBULAR STEEL Ø (IN) FOUNDATION	TUBULAR STEEL Ø (IN) 3.00 (LB / FT) 7.60	TUBULAR STEEL Ø (IN) 3.50 (LB / FT) 9.00	TUBULAR STEEL Ø (IN) 4.00 (LB / FT) 10.80	TUBULAR STEEL Ø (IN) 5.00 (LB / FT) 14.60	SIGN FRAME REQUIRED	REMARKS	SIGN DETAIL: DETAIL IN SHS	SIGN DETAIL: DETAIL ON SHEET NUMBER	SIGN DETAIL: DETAIL ON STD SHEET NUMBER
BETHEL VT 14							FY-FLUORESCENT YELLOW FYG-FLUORESCENT YELLOW GREEN																				"SHS"-STANDARD HIGHWAY SIGNS			
		A	M1-5A	24	24								1																
		A	M3-1	24	12			2.00								1		X								GREEN ON WHITE SHEETING	X		
		A	M1-5A	24	24			4.00																					E-136B
NB	0.838	A	S3-1	30	30								1		X																
		A	S3-1	30	30			6.25								1		X									X		
SB	0.820	F	VD-018	30	18								1		X																
		F	VD-018	30	18			3.75								1		X											E-128B
SB	0.800	F	S3-1	30	30		SCHOOL BUS STOP AHEAD 						1		X																
		F	W11-2	30	30	FYG		6.25								1		X									X		
		F	W16-9	24	12	FYG		2.00																			X		
SB	0.760	F	W2-1Mf	30	30		SIDE ROAD RIGHT						1		X															
		F	S3-1	30	30		SCHOOL BUS STOP AHEAD 						1																
		F	W2-2Ma R	30	30			6.25								1		X										6	
SB	0.696	G	VR-017	24	30								1	X													FACTORY HILL RD TH- 3			
		G	VR-017	24	30			5.00																					E-141
SIGN SUMMARY SHEET							SHEET TOTALS	35.50	0.00	0	0	0	7	0	0	5		75										
								SF	SF	EA	EA	EA	EA	EA	EA	EA		FT										
VERMONT AGENCY OF TRANSPORTATION							TOWN TOTALS	99.8	0.0	0.0	0.0	0.0	20	0.0	0.0	17		255.0										

PROJECT NAME: **Hartford-East Montpelier VT14**
PROJECT NUMBER: **STPG SIGN(21)**

FILE NAME: **Bethel.xls** PLOT DATE: **6/10/2009**
PROJECT MANAGER: **N. Avery** DRAWN BY: **T. Guazzoni**
DESIGNED BY: **D. Crossley** CHECKED BY: **S. Menard**
BETHEL SHEET 2 SHEET **62** OF **162**

DIRECTION	MILEPOINT	LOCATION CODE (SHEET 2)	SIGN CODE	WIDTH (IN)	HEIGHT (IN)	SHEETING REMARKS	SIGN LEGEND	NEW SIGNS "A"	NEW SIGNS "B"	EXISTING SIGNS RETAIN	EXISTING SIGNS SALVAGE FROM	EXISTING SIGNS SALVAGE TO	EXISTING SIGNS REMOVE	EXIST POST RETAIN	EXIST POST REMOVE	NUMBER OF NEW POSTS	SQUARE STEEL (IN) 1.75 (LB / FT) 1.88	SQUARE STEEL (IN) 2.00 (LB / FT) 2.42	SQUARE STEEL (IN) 2.50 (LB / FT) 3.35	TUBULAR STEEL Ø (IN) FOUNDATION	TUBULAR STEEL Ø (IN) 3.00 (LB / FT) 7.60	TUBULAR STEEL Ø (IN) 3.50 (LB / FT) 9.00	TUBULAR STEEL Ø (IN) 4.00 (LB / FT) 10.80	TUBULAR STEEL Ø (IN) 5.00 (LB / FT) 14.60	SIGN FRAME REQUIRED	REMARKS	SIGN DETAIL: DETAIL IN SHS	SIGN DETAIL: DETAIL ON SHEET NUMBER	SIGN DETAIL: DETAIL ON STD SHEET NUMBER
BETHEL VT 14							FY-FLUORESCENT YELLOW FYG-FLUORESCENT YELLOW GREEN																				"SHS"-STANDARD HIGHWAY SIGNS			
SB	0.688	H	R1-1	24	24				1		X														FACTORY HILL RD TH- 3			
		H	R1-1	30	30			6.25								1		X									X		
SB	0.680	F	M3-3	24	12				1		X																		
		F	M1-5	24	24				1																				
		F	M3-3	24	12			2.00								1		X							GREEN ON WHITE SHEETING	X		
		F	M1-5	24	24			4.00																				E-136B
SB	0.630	F	R2-1	24	30		SPEED LIMIT 50 		1						X														
		F	R2-1	24	30			5.00								1		X								X		
SB	0.395	F	VW-133L	30	30		HIDDEN DRIVES LEFT 		1						X														
SB	0.360	F	VW-133L	30	30			6.25								1									INSTALL 160' +/- SOUTH OF ORIGINAL SIGN LOCATION			E-154
SB	0.000	G	VD-024	60	7.5				1		X																	
							SHEET TOTALS	23.50	0.00	0	0	0	6	0	0	4		60										
								SF	SF	EA	EA	EA	EA	EA	EA	EA		FT										
							TOWN TOTALS	99.8	0.0	0.0	0.0	0.0	20	0.0	0.0	17		255.0										

SIGN SUMMARY SHEET

VERMONT AGENCY OF TRANSPORTATION

PROJECT NAME: **Hartford-East Montpelier VT14**
PROJECT NUMBER: **STPG SIGN(21)**

FILE NAME: **Bethel.xls**
PROJECT MANAGER: **N. Averv**
DESIGNED BY: **D. Crossley**
BETHEL SHEET 3

PLOT DATE: **6/10/2009**
DRAWN BY: **T. Guazzoni**
CHECKED BY: **S. Menard**
SHEET **63** OF **162**

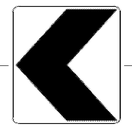
DIRECTION	MILEPOINT	LOCATION CODE (SHEET 2)	SIGN CODE	WIDTH (IN)	HEIGHT (IN)	SHEETING REMARKS	SIGN LEGEND FOR ALL POST LENGTHS AND INSTALLATION DATES SEE ORIGINAL RECORD PLANS	NEW SIGNS "A"	NEW SIGNS "B"	EXISTING SIGNS RETAIN	EXISTING SIGNS SALVAGE FROM	EXISTING SIGNS SALVAGE TO	EXISTING SIGNS REMOVE	EXIST POST RETAIN	EXIST POST REMOVE	NUMBER OF NEW POSTS	SQUARE STEEL (IN) (LB / FT) 1.75 / 1.88	SQUARE STEEL (IN) (LB / FT) 2.00 / 2.42	SQUARE STEEL (IN) (LB / FT) 2.50 / 3.35	TUBULAR STEEL Ø (IN) FOUNDATION	TUBULAR STEEL Ø (IN) (LB / FT) 3.00 / 7.60	TUBULAR STEEL Ø (IN) (LB / FT) 3.50 / 9.00	TUBULAR STEEL Ø (IN) (LB / FT) 4.00 / 10.80	TUBULAR STEEL Ø (IN) (LB / FT) 5.00 / 14.60	SIGN FRAME REQUIRED	REMARKS	SIGN DETAIL: DETAIL IN SHS	SIGN DETAIL: DETAIL ON SHEET NUMBER	SIGN DETAIL: DETAIL ON STD SHEET NUMBER
RANDOLPH VT 14							FY-FLUORESCENT YELLOW FYG-FLUORESCENT YELLOW GREEN																			"SHS"-STANDARD HIGHWAY SIGNS			
NB	0.000	C	VD-025	60	7.5								1		X													
		C	VD-024	60	7.5								1															
		C	VD-025	72	10		RANDOLPH / BETHEL / ORANGE CO / WINDSOR CO	0.84 5.00					1			2		X								2 MM PLAQUES @ 0.42 SF EA.		4	
		C	VD-024	72	10			5.00																				4	
NB	~~0.750~~ 0.075	C	VR-017	24	30		LEGAL LOAD LIMIT 24,000 POUNDS						1		X												CLAY WRIGHT RD TH-44			
		C	VR-017	24	30			5.00								1		X											E-141
NB	0.085	D	R1-1	30	30		STOP						1		X														
		D	R1-1	30	30			6.25								1		X										X	
NB	0.130	A	R2-1	24	30		SPEED LIMIT 50	5.00								1		X									INSTALL 250' +/- NORTH OF CLAY WRIGHT RD	X	
NB	0.880	A	W5-2	30	30		NARROW BRIDGE						1		X														
NB	0.920	A	W5-2	30	30		NARROW BRIDGE	6.25								1		X									INSTALL 200' +/- NORTH OF ORIGINAL SIGN LOCATION	X	
NB	0.990	B	OM-3L	12	36								1		X														
		B	OM-3L	12	36			3.00								1		X										X	
NB	1.050	A	OM-3R	12	36								1		X														
							SHEET TOTALS	~~35.50~~ 36.34 SF	0.00 SF	0 EA	0 EA	0 EA	~~7~~ 8 EA	0 EA	0 EA	7 EA	105 FT										
							TOWN TOTALS	771.4	0.0	19.0	5.0	5.0	155	0.0	0.0	130	1950.0												

SIGN SUMMARY SHEET

VERMONT AGENCY OF TRANSPORTATION

PROJECT NAME: **Hartford-East Montpelier VT14**
PROJECT NUMBER: **STPG SIGN(25)**

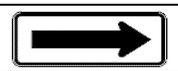
FILE NAME: **Randolph.xls** PLOT DATE: **6/18/2009**
PROJECT MANAGER: **N. Avery** DRAWN BY: **I. Shea**
DESIGNED BY: **D. Crossley** CHECKED BY: **S. Menard**
RANDOLPH SHEET 1 SHEET **64** OF **162**

DIRECTION	MILEPOINT	LOCATION CODE (SHEET 2)	SIGN CODE	WIDTH (IN)	HEIGHT (IN)	SHEETING REMARKS	SIGN LEGEND FOR ALL POST LENGTHS AND INSTALLATION DATES SEE ORIGINAL RECORD PLANS	NEW SIGNS "A"	NEW SIGNS "B"	EXISTING SIGNS RETAIN	EXISTING SIGNS SALVAGE FROM	EXISTING SIGNS SALVAGE TO	EXISTING SIGNS REMOVE	EXIST POST RETAIN	EXIST POST REMOVE	NUMBER OF NEW POSTS	SQUARE STEEL (IN) 1.75 (LB / FT) 1.88	SQUARE STEEL (IN) 2.00 (LB / FT) 2.42	SQUARE STEEL (IN) 2.50 (LB / FT) 3.35	TUBULAR STEEL Ø (IN) FOUNDATION	TUBULAR STEEL Ø (IN) 3.00 (LB / FT) 7.60	TUBULAR STEEL Ø (IN) 3.50 (LB / FT) 9.00	TUBULAR STEEL Ø (IN) 4.00 (LB / FT) 10.80	TUBULAR STEEL Ø (IN) 5.00 (LB / FT) 14.60	SIGN FRAME REQUIRED	REMARKS	SIGN DETAIL: DETAIL IN SHS	SIGN DETAIL: DETAIL ON SHEET NUMBER	SIGN DETAIL: DETAIL ON STD SHEET NUMBER
RANDOLPH VT 14							FY-FLUORESCENT YELLOW FYG-FLUORESCENT YELLOW GREEN																			"SHS"-STANDARD HIGHWAY SIGNS			
		A	OM-3R	12	36			3.00								1		X									X		
NB	1.280	A	VD-018	30	18								~~1~~ 2		X															
		A	VD-018	30	18			3.75								1		X											E-128B
NB	1.390	A	W1-2L	30	30		LEFT CURVE						1		X															
		A	W13-1	18	18		35 MPH PLAQUE						1																	
NB	1.450	A	W1-2L	30	30			6.25								1		X									INSTALL 300' +/- NORTH OF ORIGINAL SIGN LOCATION	X		
		A	W13-1	18	18			2.25																				X		
NB	1.480	A	W1-8L	18	24								1		X															
		A	W1-8L	24	30			5.00								1		X										X		
NB	1.480	B	W1-8R	18	24								1		X															
		B	W1-8R	24	30			5.00								1		X										X		
NB	1.490	A	W1-8L	18	24								1		X															
		A	W1-8L	24	30			5.00								1		X										X		
NB	1.490	B	W1-8R	18	24								1		X															
		B	W1-8R	24	30			5.00								1		X										X		
SIGN SUMMARY SHEET VERMONT AGENCY OF TRANSPORTATION							SHEET TOTALS	35.25 SF	0.00 SF	0 EA	0 EA	0 EA	~~8~~ 7 EA	0 EA	0 EA	7 EA	105 FT												
							TOWN TOTALS	771.4	0.0	19.0	5.0	5.0	155	0.0	0.0	130	1950.0											

PROJECT NAME: Hartford-East Montpelier VT14
PROJECT NUMBER: STPG SIGN(25)

FILE NAME: Randolph.xls
PROJECT MANAGER: N. Avery
DESIGNED BY: D. Crossley
RANDOLPH SHEET 2

PLOT DATE: 6/18/2009
DRAWN BY: I. Shea
CHECKED BY: S. Menard
SHEET 65 OF 162

DIRECTION	MILEPOINT	LOCATION CODE (SHEET 2)	SIGN CODE	WIDTH (IN)	HEIGHT (IN)	SHEETING REMARKS	SIGN LEGEND	NEW SIGNS "A"	NEW SIGNS "B"	EXISTING SIGNS RETAIN	EXISTING SIGNS SALVAGE FROM	EXISTING SIGNS SALVAGE TO	EXISTING SIGNS REMOVE	EXIST POST RETAIN	EXIST POST REMOVE	NUMBER OF NEW POSTS	SQUARE STEEL (IN) 1.75 (LB / FT) 1.88	SQUARE STEEL (IN) 2.00 (LB / FT) 2.42	SQUARE STEEL (IN) 2.50 (LB / FT) 3.35	TUBULAR STEEL Ø (IN) FOUNDATION	TUBULAR STEEL Ø (IN) 3.00 (LB / FT) 7.60	TUBULAR STEEL Ø (IN) 3.50 (LB / FT) 9.00	TUBULAR STEEL Ø (IN) 4.00 (LB / FT) 10.80	TUBULAR STEEL Ø (IN) 5.00 (LB / FT) 14.60	SIGN FRAME REQUIRED	REMARKS	SIGN DETAIL: DETAIL IN SHS	SIGN DETAIL: DETAIL ON SHEET NUMBER	SIGN DETAIL: DETAIL ON STD SHEET NUMBER
RANDOLPH VT 14							FY-FLUORESCENT YELLOW FYG-FLUORESCENT YELLOW GREEN																			"SHS"-STANDARD HIGHWAY SIGNS			
NB	1.495	A	W1-8L	18	24								1		X														
		A	W1-8L	24	30			5.00								1		X									X		
NB	1.495	B	W1-8R	18	24								1		X														
		B	W1-8R	24	30			5.00								1		X									X		
NB	1.920	A	W2-1Mg	30	30		LEFT CURVE MODIFIED 						1		X														
NB	2.030	A	W1-2Mk L	30	30			6.25								1		X								INSTALL 600'+/- NORTH OF ORIGINAL SIGN LOCATION		6	
NB	2.129	C	VR-017	24	24								1		X												DUGOUT ROAD TH-73			
		C	VR-017	24	30			5.00								1		X											E-141
NB	2.137	D	R1-1	24	24								1		X														
		D	R1-1	30	30			6.25								1		X									X		
NB	2.560	A	W1-2 L	30	30		LEFT CURVE						1		X														
		A	W13-1	18	18		40 MPH PLAQUE 						1																
NB	2.630	A	W1-2 L	30	30			6.25								1		X								INSTALL 350' +/- NORTH OF ORIGINAL SIGN LOCATION	X		
		A	W13-1	18	18			2.25																			X		
NB	2.660	A	W1-6L	48	24			8.00								2		X								INSTALL 160'+/- NORTH OF CURVE WARNING SIGN	X		
SIGN SUMMARY SHEET							SHEET TOTALS	44.00 SF	0.00 SF	0 EA	0 EA	0 EA	7 EA	0 EA	0 EA	8 EA	120 FT											
VERMONT AGENCY OF TRANSPORTATION							TOWN TOTALS	771.4	0.0	19.0	5.0	5.0	155	0.0	0.0	130	1950.0											

PROJECT NAME: **Hartford-East Montpelier VT14**
PROJECT NUMBER: **STPG SIGN(25)**

FILE NAME: **Randolph.xls** PLOT DATE: **6/18/2009**
PROJECT MANAGER: **N. Avery** DRAWN BY: **I. Shea**
DESIGNED BY: **D. Crossley** CHECKED BY: **S. Menard**
RANDOLPH SHEET 3 SHEET **66** OF **162**

DIRECTION	MILEPOINT	LOCATION CODE (SHEET 2)	SIGN CODE	WIDTH (IN)	HEIGHT (IN)	SHEETING REMARKS	SIGN LEGEND	NEW SIGNS "A"	NEW SIGNS "B"	EXISTING SIGNS RETAIN	EXISTING SIGNS SALVAGE FROM	EXISTING SIGNS SALVAGE TO	EXISTING SIGNS REMOVE	EXIST POST RETAIN	EXIST POST REMOVE	NUMBER OF NEW POSTS	SQUARE STEEL (IN) 1.75 (LB / FT) 1.88	SQUARE STEEL (IN) 2.00 (LB / FT) 2.42	SQUARE STEEL (IN) 2.50 (LB / FT) 3.35	TUBULAR STEEL Ø (IN) FOUNDATION	TUBULAR STEEL Ø (IN) 3.00 (LB / FT) 7.60	TUBULAR STEEL Ø (IN) 3.50 (LB / FT) 9.00	TUBULAR STEEL Ø (IN) 4.00 (LB / FT) 10.80	TUBULAR STEEL Ø (IN) 5.00 (LB / FT) 14.60	SIGN FRAME REQUIRED	REMARKS	SIGN DETAIL: DETAIL IN SHS	SIGN DETAIL: DETAIL ON SHEET NUMBER	SIGN DETAIL: DETAIL ON STD SHEET NUMBER
RANDOLPH VT 14							FY-FLUORESCENT YELLOW FYG-FLUORESCENT YELLOW GREEN																			"SHS"-STANDARD HIGHWAY SIGNS			
NB	2.670	B	W1-6L	48	24			8.00								2		X								INSTALL 50'+/- NORTH OF PREVIOUS SIGN	X		
NB	3.140	A	W2-2Ma R	30	30								1		X														
		A	W5-2	30	30								1																
		A	W2-2Ma R	30	30			6.25								2											6	
		A	W5-2	30	30			6.25										X									X	
NB	3.254	C	VR-017	24	24								1		X											HYDE RD TH-66			
		C	VR-017	24	30			5.00								1		X										E-141
NB	3.255	D	R1-1	24	24								1		X															
		D	R1-1	30	30			6.25								1		X									X	
NB	3.262	D	R1-1	24	24								1		X															
		D	R1-1	30	30			6.25								1		X									X	
NB	3.270	A	OM-3R	12	36								1		X															
		A	OM-3R	12	36			3.00								1		X									X	
NB	3.280	B	OM-3L	12	36								1		X															
		B	OM-3L	12	36			3.00								1		X									X	
SIGN SUMMARY SHEET							SHEET TOTALS	44.00	0.00	0	0	0	7	0	0	9		135									
								SF	SF	EA	EA	EA	EA	EA	EA	EA		FT									
VERMONT AGENCY OF TRANSPORTATION							TOWN TOTALS	771.4	0.0	19.0	5.0	5.0	155	0.0	0.0	130		1950.0									

PROJECT NAME: **Hartford-East Montpelier VT14**
PROJECT NUMBER: **STPG SIGN(25)**

FILE NAME: **Randolph.xls** PLOT DATE: **6/18/2009**
PROJECT MANAGER: **N. Avery** DRAWN BY: **I. Shea**
DESIGNED BY: **D. Crossley** CHECKED BY: **S. Menard**
RANDOLPH SHEET 4 SHEET **67** OF **162**

DIRECTION	MILEPOINT	LOCATION CODE (SHEET 2)	SIGN CODE	WIDTH (IN)	HEIGHT (IN)	SHEETING REMARKS	SIGN LEGEND FOR ALL POST LENGTHS AND INSTALLATION DATES SEE ORIGINAL RECORD PLANS	NEW SIGNS "A"	NEW SIGNS "B"	EXISTING SIGNS RETAIN	EXISTING SIGNS SALVAGE FROM	EXISTING SIGNS SALVAGE TO	EXISTING SIGNS REMOVE	EXIST POST RETAIN	EXIST POST REMOVE	NUMBER OF NEW POSTS	SQUARE STEEL (IN) 1.75 (LB / FT) 1.88	SQUARE STEEL (IN) 2.00 (LB / FT) 2.42	SQUARE STEEL (IN) 2.50 (LB / FT) 3.35	TUBULAR STEEL Ø (IN) FOUNDATION	TUBULAR STEEL Ø (IN) 3.00 (LB / FT) 7.60	TUBULAR STEEL Ø (IN) 3.50 (LB / FT) 9.00	TUBULAR STEEL Ø (IN) 4.00 (LB / FT) 10.80	TUBULAR STEEL Ø (IN) 5.00 (LB / FT) 14.60	SIGN FRAME REQUIRED	REMARKS	SIGN DETAIL DETAIL IN SHS	SIGN DETAIL DETAIL ON SHEET NUMBER	SIGN DETAIL DETAIL ON STD SHEET NUMBER
RANDOLPH VT 14							FY-FLUORESCENT YELLOW FYG-FLUORESCENT YELLOW GREEN																			"SHS"-STANDARD HIGHWAY SIGNS			
NB	3.320	A	W1-4R	30	30		RIGHT REVERSE CURVE						1		X														
NB	3.440	A	VW-060	30	30		HIDDEN DRIVES						1		X														
NB	3.460	A	W11-5	30	30		FARM MACHINERY SYMBOL	6.25				0 ~~1~~				1		X								INSTALL 100' +/- SOUTH OF ORIGINAL LOCATION			
		A	W7-3A	24	18		NEXT 1 MILE	3.00				0 ~~1~~														NO EXISTING			
NB	3.482	A	W11-5	30	30		FARM MACHINERY SYMBOL				0 ~~1~~				X														
		A	W7-3A	24	18		NEXT 1 MILE				0 ~~1~~																		
NB	3.500	A	VW-060	30	30			6.25								1		X								INSTALL 200'+/- NORTH OF REMOVED TRACTOR SIGN			E-154
NB	3.600	A	W2-2L	30	30								1		X														
		A	W2-2L	30	30			6.25								1		X										X	
NB	3.775	A	W1-4R	30	30		RIGHT REVERSE CURVE			1				X															
NB	3.974	A	W3-5	36	36		SPEED REDUCTION 40 MPH			1				X															
NB	4.055	A	R2-1	24	30								1		X															
		A	R2-1	30	36			7.50								1		X										6	
NB	4.190	A	VD-018	30	18								1		X															
		A	VD-018	30	18			3.75								1		X											E-128B
							SHEET TOTALS	~~33.00~~ ~~23.75~~ SF	0.00 SF	2 EA	0 ~~2~~ EA	0 ~~2~~ EA	5 EA	0 EA	0 EA	5 EA	75 FT										
							TOWN TOTALS	771.4	0.0	19.0	5.0	5.0	155	0.0	0.0	130	1950.0												

SIGN SUMMARY SHEET

VERMONT AGENCY OF TRANSPORTATION

PROJECT NAME: **Hartford-East Montpelier VT14**
PROJECT NUMBER: **STPG SIGN(25)**

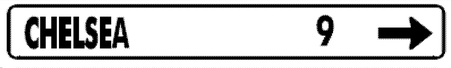
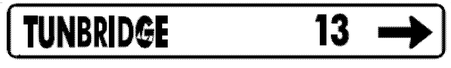
FILE NAME: **Randolph.xls**
PROJECT MANAGER: **N. Avery**
DESIGNED BY: **D. Crossley**
PLOT DATE: **6/18/2009**
DRAWN BY: **I. Shea**
CHECKED BY: **S. Menard**

DIRECTION	MILEPOINT	LOCATION CODE (SHEET 2)	SIGN CODE	WIDTH (IN)	HEIGHT (IN)	SHEETING REMARKS	SIGN LEGEND FOR ALL POST LENGTHS AND INSTALLATION DATES SEE ORIGINAL RECORD PLANS	NEW SIGNS "A"	NEW SIGNS "B"	EXISTING SIGNS RETAIN	EXISTING SIGNS SALVAGE FROM	EXISTING SIGNS SALVAGE TO	EXISTING SIGNS REMOVE	EXIST POST RETAIN	EXIST POST REMOVE	NUMBER OF NEW POSTS	SQUARE STEEL (IN) 1.75 (LB / FT) 1.88	SQUARE STEEL (IN) 2.00 (LB / FT) 2.42	SQUARE STEEL (IN) 2.50 (LB / FT) 3.35	TUBULAR STEEL Ø (IN) FOUNDATION	TUBULAR STEEL Ø (IN) 3.00 (LB / FT) 7.60	TUBULAR STEEL Ø (IN) 3.50 (LB / FT) 9.00	TUBULAR STEEL Ø (IN) 4.00 (LB / FT) 10.80	TUBULAR STEEL Ø (IN) 5.00 (LB / FT) 14.60	SIGN FRAME REQUIRED	REMARKS	SIGN DETAIL DETAIL IN SHS	SIGN DETAIL DETAIL ON SHEET NUMBER	SIGN DETAIL DETAIL ON STD SHEET NUMBER
RANDOLPH VT 14							FY-FLUORESCENT YELLOW FYG-FLUORESCENT YELLOW GREEN																			"SHS"-STANDARD HIGHWAY SIGNS			
NB	4.242	A	S1-1YG	30	30		SCHOOL SYMBOL			1				X															
		A	W16-9YG	24	12		AHEAD			1																			
NB	4.277	A	R2-1	30	36		SPEED LIMIT 35			1				X															
NB	4.310	A	W11-6H	30	30								1		X														
		A	W11-6H	30	30			6.25								1		X										E-153
NB	4.405	A	W2-2MR	30	30		MODIFIED RIGHT SIDE ROAD			1				X															
		A	W16-8A	24	18		TUNBRIDGE ROAD			1																			
NB	4.460	A	W5-2	30	30								1		X														
		A	W5-2	30	30			6.25								1		X									X	
NB	4.490	C	VR-017	24	24								1		X												TUNBRIDGE RD TH-9		
		C	VR-017	24	30			5.00								1		X										E-141
NB	4.495	D	R1-1	24	24								1		X														
		D	R1-1	30	30			6.25								1		X									X	
NB	4.500	D	R1-1	24	24							1	1		X												SALVAGED MM PLAQUE		
		D	R1-1	30	30			6.25								1		X									X	
SIGN SUMMARY SHEET							SHEET TOTALS	30.00 SF	0.00 SF	5 EA	0 EA	1 EA	5 EA	0 EA	0 EA	5 EA	75 FT											
VERMONT AGENCY OF TRANSPORTATION							TOWN TOTALS	771.4	0.0	19.0	5.0	5.0	155	0.0	0.0	130	1950.0											

PROJECT NAME: Hartford-East Montpelier VT14
PROJECT NUMBER: STPG SIGN(25)

FILE NAME: Randolph.xls
PROJECT MANAGER: N. Avery
DESIGNED BY: D. Crossley
RANDOLPH SHEET 6

PLOT DATE: 6/18/2009
DRAWN BY: I. Shea
CHECKED BY: S. Menard

DIRECTION	MILEPOINT	LOCATION CODE (SHEET 2)	SIGN CODE	WIDTH (IN)	HEIGHT (IN)	SHEETING REMARKS	SIGN LEGEND	NEW SIGNS "A"	NEW SIGNS "B"	EXISTING SIGNS RETAIN	EXISTING SIGNS SALVAGE FROM	EXISTING SIGNS SALVAGE TO	EXISTING SIGNS REMOVE	EXIST POST RETAIN	EXIST POST REMOVE	NUMBER OF NEW POSTS	SQUARE STEEL (IN) 1.75 (LB / FT) 1.88	SQUARE STEEL (IN) 2.00 (LB / FT) 2.42	SQUARE STEEL (IN) 2.50 (LB / FT) 3.35	TUBULAR STEEL Ø (IN) FOUNDATION	TUBULAR STEEL Ø (IN) 3.00 (LB / FT) 7.60	TUBULAR STEEL Ø (IN) 3.50 (LB / FT) 9.00	TUBULAR STEEL Ø (IN) 4.00 (LB / FT) 10.80	TUBULAR STEEL Ø (IN) 5.00 (LB / FT) 14.60	SIGN FRAME REQUIRED	REMARKS	SIGN DETAIL: DETAIL IN SHS	SIGN DETAIL: DETAIL ON SHEET NUMBER	SIGN DETAIL: DETAIL ON STD SHEET NUMBER
RANDOLPH VT 14							FY-FLUORESCENT YELLOW FYG-FLUORESCENT YELLOW GREEN																			"SHS"-STANDARD HIGHWAY SIGNS			
NB	4.573	A	D1-1A	72	12			6.00								2		X									5	
		A	D1-1A	72	12			6.00																	5	
NB	4.666	C	VR-017	24	24								1		X											CHELSEA MOUNTAIN RD TH-3			
		C	VR-017	24	30			5.00								1		X										E-141
NB	4.674	D	R1-1	24	24								1		X														
		D	R1-1	30	30			6.25								1		X								X		
NB	4.690	A	M3-1	24	12								1		X														
		A	M3-1	24	24								1															
		A	M3-1	24	12			2.00								1		X										
		A	M3-1	24	24			4.00																				
NB	4.750	A	R2-1	24	30		SPEED LIMIT 35			1				X														
NB	4.820	A	M2-1	21	15			2.19								1		X								GREEN ON WHITE SHEETING INSTALL 200'+/- SOUTH OF ORIGINAL LOCATION	X		
		A	M1-5	24	24			4.00																				E-136B
NB	4.860	A	M2-1	21	15		JCT						1		X													
		A	M1-5	24	24		VERMONT 66						1															
							SHEET TOTALS	35.44 SF	0.00 SF	1 EA	0 EA	0 EA	6 EA	0 EA	0 EA	6 EA		90 FT										
							TOWN TOTALS	771.4	0.0	19.0	5.0	5.0	155	0.0	0.0	130		1950.0										

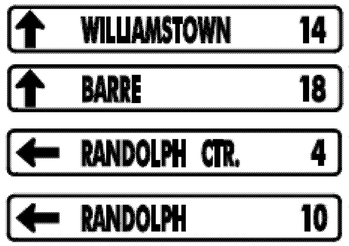
SIGN SUMMARY SHEET

VERMONT AGENCY OF TRANSPORTATION

PROJECT NAME: Hartford-East Montpelier VT14
PROJECT NUMBER: STPG SIGN(25)

FILE NAME: Randolph.xls
PROJECT MANAGER: N. Avery
DESIGNED BY: D. Crossley
RANDOLPH SHEET 7

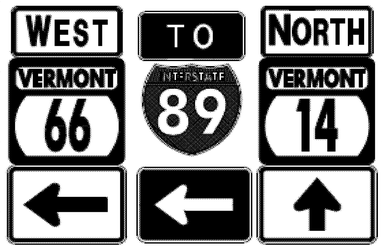
PLOT DATE: 6/18/2009
DRAWN BY: I. Shea
CHECKED BY: S. Menard

DIRECTION	MILEPOINT	LOCATION CODE (SHEET 2)	SIGN CODE	WIDTH (IN)	HEIGHT (IN)	SHEETING REMARKS	SIGN LEGEND	NEW SIGNS "A"	NEW SIGNS "B"	EXISTING SIGNS RETAIN	EXISTING SIGNS SALVAGE FROM	EXISTING SIGNS SALVAGE TO	EXISTING SIGNS REMOVE	EXIST POST RETAIN	EXIST POST REMOVE	NUMBER OF NEW POSTS	SQUARE STEEL (IN) 1.75 (LB / FT) 1.88	SQUARE STEEL (IN) 2.00 (LB / FT) 2.42	SQUARE STEEL (IN) 2.50 (LB / FT) 3.35	TUBULAR STEEL Ø (IN) FOUNDATION	TUBULAR STEEL Ø (IN) 3.00 (LB / FT) 7.60	TUBULAR STEEL Ø (IN) 3.50 (LB / FT) 9.00	TUBULAR STEEL Ø (IN) 4.00 (LB / FT) 10.80	TUBULAR STEEL Ø (IN) 5.00 (LB / FT) 14.60	SIGN FRAME REQUIRED	REMARKS	SIGN DETAIL: DETAIL IN SHS	SIGN DETAIL: DETAIL ON SHEET NUMBER	SIGN DETAIL: DETAIL ON STD SHEET NUMBER
RANDOLPH VT 14							FY-FLUORESCENT YELLOW FYG-FLUORESCENT YELLOW GREEN																			"SHS"-STANDARD HIGHWAY SIGNS			
NB	4.890	A	D1-1A	72	10								1		X														
		A	D1-1A	72	10								1																
		A	D1-1A	72	10								1																
		A	D1-1A	72	10								1																
		A	D1-1A	72	12			6.00								2			X							5	
		A	D1-1A	72	12			6.00																				5	
		A	D1-1A	72	12			6.00																				5	
		A	D1-1A	72	12			6.00																				5	
NB	4.920	A	M3-4	24	12								1	X															
		A	M1-5	24	24								1																
		A	M6-1 L	21	15								1																
		A	M4-5	24	12								1																
		A	M1-1	24	24								1																
		A	M6-1 L	21	15								1																
		A	M3-1	24	12								1																
SIGN SUMMARY SHEET							SHEET TOTALS	24.00 SF	0.00 SF	0 EA	0 EA	0 EA	11 EA	0 EA	0 EA	2 EA	30 FT											
VERMONT AGENCY OF TRANSPORTATION							TOWN TOTALS	771.4	0.0	19.0	5.0	5.0	155	0.0	0.0	130	1950.0											

PROJECT NAME: **Hartford-East Montpelier VT14**
PROJECT NUMBER: **STPG SIGN(25)**

FILE NAME: **Randolph.xls** PLOT DATE: **6/18/2009**
PROJECT MANAGER: **N. Avery** DRAWN BY: **I. Shea**
DESIGNED BY: **D. Crossley** CHECKED BY: **S. Menard**
RANDOLPH SHEET 8 SHEET **71** OF **162**

DIRECTION	MILEPOINT	LOCATION CODE (SHEET 2)	SIGN CODE	WIDTH (IN)	HEIGHT (IN)	SHEETING REMARKS	SIGN LEGEND	NEW SIGNS "A"	NEW SIGNS "B"	EXISTING SIGNS RETAIN	EXISTING SIGNS SALVAGE FROM	EXISTING SIGNS SALVAGE TO	EXISTING SIGNS REMOVE	EXIST POST RETAIN	EXIST POST REMOVE	NUMBER OF NEW POSTS	SQUARE STEEL (IN) 1.75 2.00 2.50 (LB / FT) 1.88 2.42 3.35	TUBULAR STEEL Ø (IN) FOUNDATION 3.00 3.50 4.00 5.00 (LB / FT) 7.60 9.00 10.80 14.60	SIGN FRAME REQUIRED	REMARKS	SIGN DETAIL: DETAIL IN SHS	SIGN DETAIL: DETAIL ON SHEET NUMBER	SIGN DETAIL: DETAIL ON STD SHEET NUMBER
RANDOLPH VT 14							FY-FLUORESCENT YELLOW FYG-FLUORESCENT YELLOW GREEN													"SHS"-STANDARD HIGHWAY SIGNS			
		A	M1-5	24	24								1										
		A	M6-3	21	15								1										
		A	M3-4	24	12			2.00											3A	GREEN ON WHITE SHEETING	X	7	
		A	M1-5	24	24			4.00															E-136B
		A	M6-1 L	21	15			2.19												GREEN ON WHITE SHEETING	X		
		A	M4-5	24	12			2.00												WHITE ON BLUE SHEETING	X		
		A	M1-1	24	24			4.00													X		
		A	M6-1 L	21	15			2.19												WHITE ON BLUE SHEETING	X		
		A	M3-1	24	12			2.00												GREEN ON WHITE SHEETING	X		
		A	M1-5	24	24			4.00															E-136B
		A	M6-3	21	15			2.19												GREEN ON WHITE SHEETING	X		
NB	4.925	C	M3-1	24	12								1	X									
		C	M1-5	24	24								1										
		C	M6-1 L	21	15								1										
		C	M3-3	24	12								1										
							SHEET TOTALS	24.57	0.00	0	0	0	6	0	0	0	0						
								SF	SF	EA	EA	EA	EA	EA	EA	EA	FT						
							TOWN TOTALS	771.4	0.0	19.0	5.0	5.0	155	0.0	0.0	130	1950.0						



SIGN SUMMARY SHEET

VERMONT AGENCY OF TRANSPORTATION

PROJECT NAME: Hartford-East Montpelier VT14
PROJECT NUMBER: STPG SIGN(25)

FILE NAME: Randolph.xls
PROJECT MANAGER: N. Avery
DESIGNED BY: D. Crossley
RANDOLPH SHEET 9

PLOT DATE: 6/18/2009
DRAWN BY: I. Shea
CHECKED BY: S. Menard
SHEET 72 OF 162

DIRECTION	MILEPOINT	LOCATION CODE (SHEET 2)	SIGN CODE	WIDTH (IN)	HEIGHT (IN)	SHEETING REMARKS	SIGN LEGEND FOR ALL POST LENGTHS AND INSTALLATION DATES SEE ORIGINAL RECORD PLANS	NEW SIGNS "A"	NEW SIGNS "B"	EXISTING SIGNS RETAIN	EXISTING SIGNS SALVAGE FROM	EXISTING SIGNS SALVAGE TO	EXISTING SIGNS REMOVE	EXIST POST RETAIN	EXIST POST REMOVE	NUMBER OF NEW POSTS	SQUARE STEEL (IN) 1.75 (LB / FT) 1.88	SQUARE STEEL (IN) 2.00 (LB / FT) 2.42	SQUARE STEEL (IN) 2.50 (LB / FT) 3.35	TUBULAR STEEL Ø (IN) FOUNDATION	TUBULAR STEEL Ø (IN) 3.00 (LB / FT) 7.60	TUBULAR STEEL Ø (IN) 3.50 (LB / FT) 9.00	TUBULAR STEEL Ø (IN) 4.00 (LB / FT) 10.80	TUBULAR STEEL Ø (IN) 5.00 (LB / FT) 14.60	SIGN FRAME REQUIRED	REMARKS	SIGN DETAIL: DETAIL IN SHS	SIGN DETAIL: DETAIL ON SHEET NUMBER	SIGN DETAIL: DETAIL ON STD SHEET NUMBER
RANDOLPH VT 14							FY-FLUORESCENT YELLOW FYG-FLUORESCENT YELLOW GREEN																			"SHS"-STANDARD HIGHWAY SIGNS			
		C	M1-5	24	24								1																
		C	M6-1 R	21	15								1																
		C	M3-1	24	12			2.00																#2	GREEN ON WHITE SHEETING	X	7	
		C	M1-5	24	24			4.00																				E-136B
		C	M6-1 L	21	15			2.19																			GREEN ON WHITE SHEETING	X	
		C	M3-3	24	12			2.00																			GREEN ON WHITE SHEETING	X	
		C	M1-5	24	24			4.00																				E-136B
		C	M6-1 R	21	15			2.19								2											GREEN ON WHITE SHEETING	X	
NB	4.970	A	M3-1	24	12								1	X																
		A	M1-5	24	24								1																
		A	M3-1	24	12			2.00																			GREEN ON WHITE SHEETING	X	
		A	M1-5	24	24			4.00								1												E-136B
NB	5.007	A	R2-1	24	30		SPEED LIMIT 35 MPH			1				X															
NB	5.166	A	R2-1	24	30		SPEED LIMIT 35 MPH			1				X															
NB	5.295	A	W5-2	30	30		NARROW BRIDGE						1		X														
							SHEET TOTALS	22.38 SF	0.00 SF	2 EA	0 EA	0 EA	5 EA	0 EA	0 EA	~~0~~ 3 EA	0 FT											
							TOWN TOTALS	771.4	0.0	19.0	5.0	5.0	155	0.0	0.0	130	1950.0											

SIGN SUMMARY SHEET

VERMONT AGENCY OF TRANSPORTATION

PROJECT NAME: Hartford-East Montpelier VT14
PROJECT NUMBER: STPG SIGN(25)

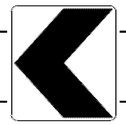
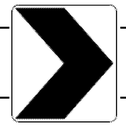
FILE NAME: Randolph.xls
PROJECT MANAGER: N. Avery
DESIGNED BY: D. Crossley
RANDOLPH SHEET 10

PLOT DATE: 6/18/2009
DRAWN BY: I. Shea
CHECKED BY: S. Menard
SHEET 73 OF 162

DIRECTION	MILEPOINT	LOCATION CODE (SHEET 2)	SIGN CODE	WIDTH (IN)	HEIGHT (IN)	SHEETING REMARKS	SIGN LEGEND FOR ALL POST LENGTHS AND INSTALLATION DATES SEE ORIGINAL RECORD PLANS	NEW SIGNS "A"	NEW SIGNS "B"	EXISTING SIGNS RETAIN	EXISTING SIGNS SALVAGE FROM	EXISTING SIGNS SALVAGE TO	EXISTING SIGNS REMOVE	EXIST POST RETAIN	EXIST POST REMOVE	NUMBER OF NEW POSTS	SQUARE STEEL (IN) 1.75 (LB / FT) 1.88	SQUARE STEEL (IN) 2.00 (LB / FT) 2.42	SQUARE STEEL (IN) 2.50 (LB / FT) 3.35	TUBULAR STEEL Ø (IN) FOUNDATION	TUBULAR STEEL Ø (IN) 3.00 (LB / FT) 7.60	TUBULAR STEEL Ø (IN) 3.50 (LB / FT) 9.00	TUBULAR STEEL Ø (IN) 4.00 (LB / FT) 10.80	TUBULAR STEEL Ø (IN) 5.00 (LB / FT) 14.60	SIGN FRAME REQUIRED	REMARKS	SIGN DETAIL DETAIL IN SHS	SIGN DETAIL DETAIL ON SHEET NUMBER	SIGN DETAIL DETAIL ON STD SHEET NUMBER
RANDOLPH VT 14							FY-FLUORESCENT YELLOW FYG-FLUORESCENT YELLOW GREEN																			"SHS"-STANDARD HIGHWAY SIGNS			
NB	5.346	A	R2-1	24	30		SPEED LIMIT 50 MPH			1				X															
NB	5.380	A	W5-2	30	30			6.25								1		X								INSTALL 150'+/- NORTH OF SPEED LIMIT 50	X		
NB	5.415	A	OM-3R	12	36		RIGHT OBJECT MARKER				1				X														
NB	5.410	A	OM-3R	12	36		RIGHT OBJECT MARKER					1				1		X											
NB	5.420	B	OM-3L	12	36		LEFT OBJECT MARKER				1	1			X	1		X											
NB	5.900	A	W11-6	30	30		SNOWMOBILE SYMBOL						1		X														
NB	6.290	A	W5-2	30	30			6.25								1		X								INSTALL 150' NORTH OF DRIVEWAY #1334	X		
NB	6.365	A	OM-3R	12	36								1		X														
		A	OM-3R	12	36			3.00								1		X									X		
NB	6.385	B	OM-3L	12	36			3.00					1			1		X								INSTALL AT NORTH END OF BRIDGE 38	X		
NB	6.670	A	W1-2R	30	30		RIGHT CURVE						1		X														
		A	W13-1	18	18		35 MPH PLAQUE						1																
NB	6.690	A	W1-2R	30	30			6.25								1		X								INSTALL 130' +/- NORTH OF ORIGINAL SIGN LOCATION	X		
		A	W13-1	18	18			2.25																			X		
NB	6.698	C	VR-017	24	24								~~1~~ 0		X														
SIGN SUMMARY SHEET							SHEET TOTALS	27.00 SF	0.00 SF	1 EA	2 EA	2 EA	5 EA	0 EA	0 EA	7 EA	105 FT											
VERMONT AGENCY OF TRANSPORTATION							TOWN TOTALS	771.4	0.0	19.0	5.0	5.0	155	0.0	0.0	130	1950.0											

PROJECT NAME: **Hartford-East Montpelier VT14**
PROJECT NUMBER: **STPG SIGN(25)**

FILE NAME: **Randolph.xls** PLOT DATE: **6/18/2009**
PROJECT MANAGER: **N. Avery** DRAWN BY: **I. Shea**
DESIGNED BY: **D. Crossley** CHECKED BY: **S. Menard**
RANDOLPH SHEET 11 SHEET **74** OF **162**

DIRECTION	MILEPOINT	LOCATION CODE (SHEET 2)	SIGN CODE	WIDTH (IN)	HEIGHT (IN)	SHEETING REMARKS	SIGN LEGEND	NEW SIGNS "A"	NEW SIGNS "B"	EXISTING SIGNS RETAIN	EXISTING SIGNS SALVAGE FROM	EXISTING SIGNS SALVAGE TO	EXISTING SIGNS REMOVE	EXIST POST RETAIN	EXIST POST REMOVE	NUMBER OF NEW POSTS	SQUARE STEEL (IN) 1.75 (LB / FT) 1.88	SQUARE STEEL (IN) 2.00 (LB / FT) 2.42	SQUARE STEEL (IN) 2.50 (LB / FT) 3.35	TUBULAR STEEL Ø (IN) FOUNDATION	TUBULAR STEEL Ø (IN) 3.00 (LB / FT) 7.60	TUBULAR STEEL Ø (IN) 3.50 (LB / FT) 9.00	TUBULAR STEEL Ø (IN) 4.00 (LB / FT) 10.80	TUBULAR STEEL Ø (IN) 5.00 (LB / FT) 14.60	SIGN FRAME REQUIRED	REMARKS	SIGN DETAIL: DETAIL IN SHS	SIGN DETAIL: DETAIL ON SHEET NUMBER	SIGN DETAIL: DETAIL ON STD SHEET NUMBER
RANDOLPH VT 14							FY-FLUORESCENT YELLOW FYG-FLUORESCENT YELLOW GREEN																			"SHS"-STANDARD HIGHWAY SIGNS			
		C	VR-017	24	30			5.00								1		X										E-141
NB	6.706	D	R1-1	24	24								1		X														
		D	R1-1	30	30			6.25								1		X									X	
NB	6.960	A	W1-8L	24	30			5.00								1		X									INSTALL AT CURVE APEX - FIRST CURVE PAST BRIDGE	X		
NB	6.961	B	W1-8R	24	30			5.00								1		X									INSTALL AT CURVE APEX - FIRST CURVE PAST BRIDGE	X		
NB	7.108	A	W5-2	30	30		NARROW BRIDGE						1		X														
		A	S3-1	30	30		SCHOOL BUS STOP AHEAD						1																
		A	W3-5	36	36			9.00								2		X									X	
NB	7.160	A	R2-5A	24	30		REDUCED SPEED AHEAD						1		X														
		A	W5-2	30	30			6.25								2		X									X	
		A	S3-1	30	30			6.25																			X	
NB	7.200	A	VD-018	30	18								1		X														
		A	VD-018	30	18			3.75								1		X										E-128B
NB	7.230	A	R2-1	24	30								1		X														
		A	R2-1	30	36			7.50								1		X										6	
							SHEET TOTALS	54.00 SF	0.00 SF	0 EA	0 EA	0 EA	6 EA	0 EA	0 EA	10 EA		150 FT										
							TOWN TOTALS	771.4	0.0	19.0	5.0	5.0	155	0.0	0.0	130		1950.0										

SIGN SUMMARY SHEET

VERMONT AGENCY OF TRANSPORTATION

PROJECT NAME: Hartford-East Montpelier VT14
PROJECT NUMBER: STPG SIGN(25)

FILE NAME: Randolph.xls
PROJECT MANAGER: N. Avery
DESIGNED BY: D. Crossley
RANDOLPH SHEET 12

PLOT DATE: 6/18/2009
DRAWN BY: I. Shea
CHECKED BY: S. Menard
SHEET 75 OF 162

DIRECTION	MILEPOINT	LOCATION CODE (SHEET 2)	SIGN CODE	WIDTH (IN)	HEIGHT (IN)	SHEETING REMARKS	SIGN LEGEND	NEW SIGNS "A"	NEW SIGNS "B"	EXISTING SIGNS RETAIN	EXISTING SIGNS SALVAGE FROM	EXISTING SIGNS SALVAGE TO	EXISTING SIGNS REMOVE	EXIST POST RETAIN	EXIST POST REMOVE	NUMBER OF NEW POSTS	SQUARE STEEL (IN) 1.75 (LB / FT) 1.88	SQUARE STEEL (IN) 2.00 (LB / FT) 2.42	SQUARE STEEL (IN) 2.50 (LB / FT) 3.35	TUBULAR STEEL Ø (IN) FOUNDATION	TUBULAR STEEL Ø (IN) 3.00 (LB / FT) 7.60	TUBULAR STEEL Ø (IN) 3.50 (LB / FT) 9.00	TUBULAR STEEL Ø (IN) 4.00 (LB / FT) 10.80	TUBULAR STEEL Ø (IN) 5.00 (LB / FT) 14.60	SIGN FRAME REQUIRED	REMARKS	SIGN DETAIL: DETAIL IN SHS	SIGN DETAIL: DETAIL ON SHEET NUMBER	SIGN DETAIL: DETAIL ON STD SHEET NUMBER
RANDOLPH VT 14							FY-FLUORESCENT YELLOW FYG-FLUORESCENT YELLOW GREEN																			"SHS"-STANDARD HIGHWAY SIGNS			
NB	7.245	A	OM-3R	12	36								1		X													
		A	OM-3R	12	36	FY		3.00								1		X									X	
NB	7.255	B	OM-3L	12	36								1		X													
		B	OM-3L	12	36	FY		3.00								1		X									X	
NB	7.558	A	VS3-4	30	30								1		X													
		A	VS3-4	30	30			6.25								1		X										5
NB	7.600	A	R2-1	24	30								1		X													
		A	R2-1	24	30			5.00								1		X									X	
SB	7.690	F	R2-5A	24	30		REDUCED SPEED AHEAD 						1		X													
SB	7.680	F	W3-5	36	36			9.00								2		X									X	
SB	7.640	F	VD-018	30	18								1		X													
		F	VD-018	30	18			3.75								1		X										E-128B
SB	7.620	F	R2-1	24	30								1		X													
		F	R2-1	30	36			7.50								1		X										6
SB	7.380	F	W5-2	30	30		NARROW BRIDGE						1		X													
							SHEET TOTALS	37.50	0.00	0	0	0	8	0	0	8		120										
								SF	SF	EA	EA	EA	EA	EA	EA	EA		FT										
							TOWN TOTALS	771.4	0.0	19.0	5.0	5.0	155	0.0	0.0	130		1950.0										

SIGN SUMMARY SHEET

VERMONT AGENCY OF TRANSPORTATION

PROJECT NAME: **Hartford-East Montpelier VT14**
PROJECT NUMBER: **STPG SIGN(25)**

FILE NAME: **Randolph.xls** PLOT DATE: **6/18/2009**
PROJECT MANAGER: **N. Avery** DRAWN BY: **I. Shea**
DESIGNED BY: **D. Crossley** CHECKED BY: **S. Menard**
RANDOLPH SHEET 13 SHEET **76** OF **162**

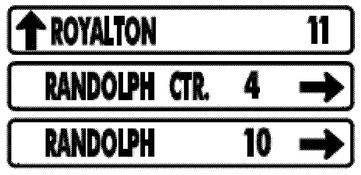
DIRECTION	MILEPOINT	LOCATION CODE (SHEET 2)	SIGN CODE	WIDTH (IN)	HEIGHT (IN)	SHEETING REMARKS	SIGN LEGEND	NEW SIGNS "A"	NEW SIGNS "B"	EXISTING SIGNS RETAIN	EXISTING SIGNS SALVAGE FROM	EXISTING SIGNS SALVAGE TO	EXISTING SIGNS REMOVE	EXIST POST RETAIN	EXIST POST REMOVE	NUMBER OF NEW POSTS	SQUARE STEEL (IN) 1.75 (LB / FT) 1.88	SQUARE STEEL (IN) 2.00 (LB / FT) 2.42	SQUARE STEEL (IN) 2.50 (LB / FT) 3.35	TUBULAR STEEL Ø (IN) FOUNDATION	TUBULAR STEEL Ø (IN) 3.00 (LB / FT) 7.60	TUBULAR STEEL Ø (IN) 3.50 (LB / FT) 9.00	TUBULAR STEEL Ø (IN) 4.00 (LB / FT) 10.80	TUBULAR STEEL Ø (IN) 5.00 (LB / FT) 14.60	SIGN FRAME REQUIRED	REMARKS	SIGN DETAIL: DETAIL IN SHS	SIGN DETAIL: DETAIL ON SHEET NUMBER	SIGN DETAIL: DETAIL ON STD SHEET NUMBER
RANDOLPH VT 14							FY-FLUORESCENT YELLOW FYG-FLUORESCENT YELLOW GREEN																			"SHS"-STANDARD HIGHWAY SIGNS			
SB	7.332	G	VR-017	24	24								1		X											NO. RANDOLPH RD TH-48			
		G	VR-017	24	30			5.00								1		X											E-141
SB	7.328	H	R1-1	30	30			6.25								1		X									INSTALL IN ISLAND	X		
SB	7.324	H	R1-1	24	24								1		X															
		H	R1-1	30	30			6.25								1		X										X	
SB	7.310	F	W5-2	30	30			6.25								1		X									INSTALL 100' +/- SOUTH OF NO. RANDOLPH RD	X		
SB	7.255	F	OM-3R	12	36								1		X															
		F	OM-3R	12	36			3.00								1		X										X	
SB	7.245	E	OM-3L	12	36								1		X															
		E	OM-3L	12	36			3.00								1		X										X	
SB	7.230	F	R2-1	24	30								1		X															
		F	R2-1	24	30			5.00								1		X										X	
SB	6.490	F	W5-2	30	30		NARROW BRIDGE						1		X															
		F	S3-1	30	30		SCHOOL BUS STOP AHEAD 						1																	
		F	S3-1	30	30			6.25								1		X										X	
SIGN SUMMARY SHEET							SHEET TOTALS	41.00 SF	0.00 SF	0 EA	0 EA	0 EA	7 EA	0 EA	0 EA	8 EA	120 FT											
VERMONT AGENCY OF TRANSPORTATION							TOWN TOTALS	771.4	0.0	19.0	5.0	5.0	155	0.0	0.0	130	1950.0											

PROJECT NAME: **Hartford-East Montpelier VT14**
PROJECT NUMBER: **STPG SIGN(25)**

FILE NAME: **Randolph.xls** PLOT DATE: **6/18/2009**
PROJECT MANAGER: **N. Avery** DRAWN BY: **I. Shea**
DESIGNED BY: **D. Crossley** CHECKED BY: **S. Menard**
RANDOLPH SHEET 14 SHEET **77** OF **162**

DIRECTION	MILEPOINT	LOCATION CODE (SHEET 2)	SIGN CODE	WIDTH (IN)	HEIGHT (IN)	SHEETING REMARKS	SIGN LEGEND	NEW SIGNS "A"	NEW SIGNS "B"	EXISTING SIGNS RETAIN	EXISTING SIGNS SALVAGE FROM	EXISTING SIGNS SALVAGE TO	EXISTING SIGNS REMOVE	EXIST POST RETAIN	EXIST POST REMOVE	NUMBER OF NEW POSTS	SQUARE STEEL (IN) 1.75 (LB / FT) 1.88	SQUARE STEEL (IN) 2.00 (LB / FT) 2.42	SQUARE STEEL (IN) 2.50 (LB / FT) 3.35	TUBULAR STEEL Ø (IN) FOUNDATION	TUBULAR STEEL Ø (IN) 3.00 (LB / FT) 7.60	TUBULAR STEEL Ø (IN) 3.50 (LB / FT) 9.00	TUBULAR STEEL Ø (IN) 4.00 (LB / FT) 10.80	TUBULAR STEEL Ø (IN) 5.00 (LB / FT) 14.60	SIGN FRAME REQUIRED	REMARKS	SIGN DETAIL: DETAIL IN SHS	SIGN DETAIL: DETAIL ON SHEET NUMBER	SIGN DETAIL: DETAIL ON STD SHEET NUMBER
RANDOLPH VT 14							FY-FLUORESCENT YELLOW FYG-FLUORESCENT YELLOW GREEN																			"SHS"-STANDARD HIGHWAY SIGNS			
SB	6.440	F	W5-2	30	30			6.25								1		X								INSTALL 250' +/- SOUTH OF ORIGINAL SIGN LOCATION	X		
SB	6.385	F	OM-3R	12	36								1		X														
		F	OM-3R	12	36			3.00								1		X										X	
SB	6.365	E	OM-3L	12	36								1		X														
		E	OM-3L	12	36			3.00								1		X										X	
SB	5.520	F	W5-2	30	30		NARROW BRIDGE 						1		X														
SB	5.500	F	W5-2	30	30			6.25								1		X									INSTALL 100' +/- SOUTH OF ORIGINAL LOCATION	X		
SB	5.471	F	W3-5	36	36		SPEED LIMIT 35 AHEAD			1				X															
SB	5.420	F	OM-3R	12	36		RIGHT OBJECT MARKER			1				X															
SB	5.410	E	OM-3L	12	36		LEFT OBJECT MARKER			1				X															
SB	5.346	F	R2-1	30	36		SPEED LIMIT 35			1				X															
SB	5.312	F	VW-054	30	30		HIDDEN DRIVES RIGHT				1				X														
SB	5.282	F	VW-054	30	30		HIDDEN DRIVES RIGHT					1				1		X									INSTALL SIGN 150'+/- SOUTH OF ORIGINAL LOCATION			
SB	5.166	F	R2-1	24	30		SPEED LIMIT 35			1				X															
SB	5.000	F	M2-1	21	15								1		X														
SIGN SUMMARY SHEET							SHEET TOTALS	18.50	0.00	5	1	1	4	0	0	5		75									
								SF	SF	EA	EA	EA	EA	EA	EA	EA		FT									
VERMONT AGENCY OF TRANSPORTATION							TOWN TOTALS	771.4	0.0	19.0	5.0	5.0	155	0.0	0.0	130		1950.0									

PROJECT NAME: **Hartford-East Montpelier VT14**
PROJECT NUMBER: **STPG SIGN(25)**
FILE NAME: **Randolph.xls** PLOT DATE: **6/18/2009**
PROJECT MANAGER: **N. Avery** DRAWN BY: **I. Shea**
DESIGNED BY: **D. Crossley** CHECKED BY: **S. Menard**
RANDOLPH SHEET 15 SHEET **78** OF **162**

DIRECTION	MILEPOINT	LOCATION CODE (SHEET 2)	SIGN CODE	WIDTH (IN)	HEIGHT (IN)	SHEETING REMARKS	SIGN LEGEND FOR ALL POST LENGTHS AND INSTALLATION DATES SEE ORIGINAL RECORD PLANS	NEW SIGNS "A"	NEW SIGNS "B"	EXISTING SIGNS RETAIN	EXISTING SIGNS SALVAGE FROM	EXISTING SIGNS SALVAGE TO	EXISTING SIGNS REMOVE	EXIST POST RETAIN	EXIST POST REMOVE	NUMBER OF NEW POSTS	SQUARE STEEL (IN) 1.75 (LB / FT) 1.88	SQUARE STEEL (IN) 2.00 (LB / FT) 2.42	SQUARE STEEL (IN) 2.50 (LB / FT) 3.35	TUBULAR STEEL Ø (IN) FOUNDATION	TUBULAR STEEL Ø (IN) 3.00 (LB / FT) 7.60	TUBULAR STEEL Ø (IN) 3.50 (LB / FT) 9.00	TUBULAR STEEL Ø (IN) 4.00 (LB / FT) 10.80	TUBULAR STEEL Ø (IN) 5.00 (LB / FT) 14.60	SIGN FRAME REQUIRED	REMARKS	SIGN DETAIL: DETAIL IN SHS	SIGN DETAIL: DETAIL ON SHEET NUMBER	SIGN DETAIL: DETAIL ON STD SHEET NUMBER
RANDOLPH VT 14							FY-FLUORESCENT YELLOW FYG-FLUORESCENT YELLOW GREEN																			"SHS"-STANDARD HIGHWAY SIGNS			
		F	M1-5	24	24								1		X													
		F	M2-1	21	15			2.19								1		X								GREEN ON WHITE SHEETING	X		
		F	M1-5	24	24			4.00																					E-136B
SB	4.970	F	D1-1A	72	10								1																
		F	D1-1A	72	10								1																
		F	D1-1A	72	10								1																
		F	D1-1A	72	12			6.00					1			2	X									5	
		F	D1-1A	72	12			6.00					1															5	
		F	D1-1A	72	12			6.00					1															5	
SB	4.930	F	M3-3	24	12								1	X															
		F	M1-5	24	24								1																
		F	M6-3	21	15								1																
		F	M3-4	24	12								1																
		F	M1-5	24	24								1																
		F	M6-1	21	15								1																
							SHEET TOTALS	24.19 SF	0.00 SF	0 EA	0 EA	0 EA	7 10 EA	0 EA	0 EA	3 EA	45 FT											
							TOWN TOTALS	771.4	0.0	19.0	5.0	5.0	155	0.0	0.0	130	1950.0											

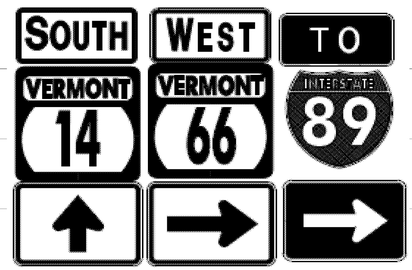
SIGN SUMMARY SHEET

VERMONT AGENCY OF TRANSPORTATION

PROJECT NAME: Hartford-East Montpelier VT14
PROJECT NUMBER: STPG SIGN(25)

FILE NAME: Randolph.xls
PROJECT MANAGER: N. Avery
DESIGNED BY: D. Crossley
RANDOLPH SHEET 16

PLOT DATE: 6/18/2009
DRAWN BY: I. Shea
CHECKED BY: S. Menard
SHEET 79 OF 162

DIRECTION	MILEPOINT	LOCATION CODE (SHEET 2)	SIGN CODE	WIDTH (IN)	HEIGHT (IN)	SHEETING REMARKS	SIGN LEGEND	NEW SIGNS "A"	NEW SIGNS "B"	EXISTING SIGNS RETAIN	EXISTING SIGNS SALVAGE FROM	EXISTING SIGNS SALVAGE TO	EXISTING SIGNS REMOVE	EXIST POST RETAIN	EXIST POST REMOVE	NUMBER OF NEW POSTS	SQUARE STEEL (IN) 1.75 (LB / FT) 1.88	SQUARE STEEL (IN) 2.00 (LB / FT) 2.42	SQUARE STEEL (IN) 2.50 (LB / FT) 3.35	TUBULAR STEEL Ø (IN) FOUNDATION	TUBULAR STEEL Ø (IN) 3.00 (LB / FT) 7.60	TUBULAR STEEL Ø (IN) 3.50 (LB / FT) 9.00	TUBULAR STEEL Ø (IN) 4.00 (LB / FT) 10.80	TUBULAR STEEL Ø (IN) 5.00 (LB / FT) 14.60	SIGN FRAME REQUIRED	REMARKS	SIGN DETAIL: DETAIL IN SHS	SIGN DETAIL: DETAIL ON SHEET NUMBER	SIGN DETAIL: DETAIL ON STD SHEET NUMBER
RANDOLPH VT 14							FY-FLUORESCENT YELLOW FYG-FLUORESCENT YELLOW GREEN																			"SHS"-STANDARD HIGHWAY SIGNS			
		F	M4-5	24	12								1																
		F	M1-1	24	24								1																
		F	M6-1	21	15								1																
		F	M3-3	24	12			2.00																		GREEN ON WHITE SHEETING	X		
		F	M1-5	24	24			4.00																					E-136B
		F	M6-3	21	15			2.19																		GREEN ON WHITE SHEETING	X		
		F	M3-4	24	12			2.00																		GREEN ON WHITE SHEETING	X		
		F	M1-5	24	24			4.00																			E-136B
		F	M6-1	21	15			2.19																		GREEN ON WHITE SHEETING	X		
		F	M4-5	24	12			2.00																		WHITE ON BLUE SHEETING	X		
		F	M1-1	24	24			4.00																			X		
		F	M6-1	21	15			2.19																		WHITE ON BLUE SHEETING	X		
SB	4.910	F	M3-3	24	12								1		X															
		F	M1-5	24	24								1																
		F	M3-3	24	12			2.00								1	X										X		
SIGN SUMMARY SHEET							SHEET TOTALS	26.57 SF	0.00 SF	0 EA	0 EA	0 EA	5 EA	0 EA	0 EA	1 EA	15 FT											
VERMONT AGENCY OF TRANSPORTATION							TOWN TOTALS	771.4	0.0	19.0	5.0	5.0	155	0.0	0.0	130	1950.0											

PROJECT NAME: **Hartford-East Montpelier VT14**
PROJECT NUMBER: **STPG SIGN(25)**

FILE NAME: **Randolph.xls** PLOT DATE: **6/18/2009**
PROJECT MANAGER: **N. Avery** DRAWN BY: **I. Shea**
DESIGNED BY: **D. Crossley** CHECKED BY: **S. Menard**
RANDOLPH SHEET 17 SHEET **80** OF **162**

DIRECTION	MILEPOINT	LOCATION CODE (SHEET 2)	SIGN CODE	WIDTH (IN)	HEIGHT (IN)	SHEETING REMARKS	SIGN LEGEND FOR ALL POST LENGTHS AND INSTALLATION DATES SEE ORIGINAL RECORD PLANS	NEW SIGNS "A"	NEW SIGNS "B"	EXISTING SIGNS RETAIN	EXISTING SIGNS SALVAGE FROM	EXISTING SIGNS SALVAGE TO	EXISTING SIGNS REMOVE	EXIST POST RETAIN	EXIST POST REMOVE	NUMBER OF NEW POSTS	SQUARE STEEL (IN) 1.75 (LB / FT) 1.88	SQUARE STEEL (IN) 2.00 (LB / FT) 2.42	SQUARE STEEL (IN) 2.50 (LB / FT) 3.35	TUBULAR STEEL Ø (IN) FOUNDATION	TUBULAR STEEL Ø (IN) 3.00 (LB / FT) 7.60	TUBULAR STEEL Ø (IN) 3.50 (LB / FT) 9.00	TUBULAR STEEL Ø (IN) 4.00 (LB / FT) 10.80	TUBULAR STEEL Ø (IN) 5.00 (LB / FT) 14.60	SIGN FRAME REQUIRED	REMARKS	SIGN DETAIL DETAIL IN SHS	SIGN DETAIL DETAIL ON SHEET NUMBER	SIGN DETAIL DETAIL ON STD SHEET NUMBER
RANDOLPH VT 14							FY-FLUORESCENT YELLOW FYG-FLUORESCENT YELLOW GREEN																			"SHS"-STANDARD HIGHWAY SIGNS			
		F	M1-5	24	24			4.00																					E-136B
SB	4.890	F	R2-1	30	36		SPEED LIMIT 35			1				X															
SB	4.740	F	D1-1A	54	7.5								1		X														
		F	D1-1A	54	7.5								1																
		F	D1-1A	72	12		CHELSEA 9	6.00								2		X										5	
		F	D1-1A	72	12		TUNBRIDGE 13	6.00																				5	
SB	4.690	F	W5-2	30	30		NARROW BRIDGE						1		X														
SB	4.640	F	M3-3	24	12								1		X														
		F	M1-5	24	24		SOUTH VERMONT 14						1																
		F	M3-3	24	12			2.00								1		X									GREEN ON WHITE SHEETING	X	
		F	M1-5	24	24			4.00																					E-136B
SB	4.620	F	W5-2	30	30		NARROW BRIDGE / SPEED LIMIT 35	6.25								1		X									INSTALL BETWEEN DRIVEWAYS	X	
SB	4.600	F	R2-1	24	30			5.00					1			1		X									INSTALL AT BEGINNING OF GUARDRAIL	X	
SB	4.590	F	OM-3R	12	36								1		X														
		F	OM-3R	12	36			3.00								1		X										X	
							SHEET TOTALS	36.25 SF	0.00 SF	1 EA	0 EA	0 EA	7 ~~6~~ EA	0 EA	0 EA	6 EA	90 FT											
							TOWN TOTALS	771.4	0.0	19.0	5.0	5.0	155	0.0	0.0	130	1950.0											

SIGN SUMMARY SHEET

VERMONT AGENCY OF TRANSPORTATION

PROJECT NAME: Hartford-East Montpelier VT14
PROJECT NUMBER: STPG SIGN(25)

FILE NAME: Randolph.xls
PROJECT MANAGER: N. Avery
DESIGNED BY: D. Crossley
PLOT DATE: 6/18/2009
DRAWN BY: I. Shea
CHECKED BY: S. Menard
RANDOLPH SHEET 18
SHEET 81 OF 162

DIRECTION	MILEPOINT	LOCATION CODE (SHEET 2)	SIGN CODE	WIDTH (IN)	HEIGHT (IN)	SHEETING REMARKS	SIGN LEGEND	NEW SIGNS "A"	NEW SIGNS "B"	EXISTING SIGNS RETAIN	EXISTING SIGNS SALVAGE FROM	EXISTING SIGNS SALVAGE TO	EXISTING SIGNS REMOVE	EXIST POST RETAIN	EXIST POST REMOVE	NUMBER OF NEW POSTS	SQUARE STEEL (IN) 1.75 (LB / FT) 1.88	SQUARE STEEL (IN) 2.00 (LB / FT) 2.42	SQUARE STEEL (IN) 2.50 (LB / FT) 3.35	TUBULAR STEEL Ø (IN) FOUNDATION	TUBULAR STEEL Ø (IN) 3.00 (LB / FT) 7.60	TUBULAR STEEL Ø (IN) 3.50 (LB / FT) 9.00	TUBULAR STEEL Ø (IN) 4.00 (LB / FT) 10.80	TUBULAR STEEL Ø (IN) 5.00 (LB / FT) 14.60	SIGN FRAME REQUIRED	REMARKS	SIGN DETAIL DETAIL IN SHS	SIGN DETAIL DETAIL ON SHEET NUMBER	SIGN DETAIL DETAIL ON STD SHEET NUMBER
RANDOLPH VT 14							FY-FLUORESCENT YELLOW FYG-FLUORESCENT YELLOW GREEN																			"SHS"-STANDARD HIGHWAY SIGNS			
SB	4.576	E	OM-3L	12	36								1		X													
		E	OM-3L	12	36			3.00								1		X									X	
SB	4.520	F	W11-6H	30	30								1		X													
		F	W11-6H	30	30			6.25								1		X										6
SB	4.462	F	S1-1YG	30	30		SCHOOL SYMBOL						1	X														
		F	W16-9YG	24	12		AHEAD						1															
SB	4.343	F	W11-5	30	30		FARM MACHINERY SYMBOL						1		X													
		F	W7-3A	24	18		NEXT 1 MILE						1															
SB	4.299	F	VR-017	24	30								1		X												EAST RANDOLPH COMMON (NORTH)		
		F	VR-017	24	30			5.00								1		X										E-141
SB	4.291	F	R1-1	30	30								1		X													
		F	R1-1	30	30			6.25								1		X									X	
SB	4.227	F	R2-1	24	30		STOP			1				X														
SB	4.238	F	VR-017	24	30								1		X												EAST RANDOLPH COMMON (SOUTH)		
		F	VR-017	24	30			5.00								1		X										E-141
SIGN SUMMARY SHEET							SHEET TOTALS	25.50	0.00	1	0	0	9	0	0	5		75									
								SF	SF	EA	EA	EA	EA	EA	EA	EA		FT									
VERMONT AGENCY OF TRANSPORTATION							TOWN TOTALS	771.4	0.0	19.0	5.0	5.0	155	0.0	0.0	130		1950.0									

PROJECT NAME: **Hartford-East Montpelier VT14**
PROJECT NUMBER: **STPG SIGN(25)**

FILE NAME: **Randolph.xls** PLOT DATE: **6/18/2009**
PROJECT MANAGER: **N. Avery** DRAWN BY: **I. Shea**
DESIGNED BY: **D. Crossley** CHECKED BY: **S. Menard**
RANDOLPH SHEET 19 SHEET **82** OF **162**

DIRECTION	MILEPOINT	LOCATION CODE (SHEET 2)	SIGN CODE	WIDTH (IN)	HEIGHT (IN)	SHEETING REMARKS	SIGN LEGEND	NEW SIGNS "A"	NEW SIGNS "B"	EXISTING SIGNS RETAIN	EXISTING SIGNS SALVAGE FROM	EXISTING SIGNS SALVAGE TO	EXISTING SIGNS REMOVE	EXIST POST RETAIN	EXIST POST REMOVE	NUMBER OF NEW POSTS	SQUARE STEEL (IN) 1.75 (LB / FT) 1.88	SQUARE STEEL (IN) 2.00 (LB / FT) 2.42	SQUARE STEEL (IN) 2.50 (LB / FT) 3.35	TUBULAR STEEL Ø (IN) FOUNDATION	TUBULAR STEEL Ø (IN) 3.00 (LB / FT) 7.60	TUBULAR STEEL Ø (IN) 3.50 (LB / FT) 9.00	TUBULAR STEEL Ø (IN) 4.00 (LB / FT) 10.80	TUBULAR STEEL Ø (IN) 5.00 (LB / FT) 14.60	SIGN FRAME REQUIRED	REMARKS	SIGN DETAIL: DETAIL IN SHS	SIGN DETAIL: DETAIL ON SHEET NUMBER	SIGN DETAIL: DETAIL ON STD SHEET NUMBER
RANDOLPH VT 14							FY-FLUORESCENT YELLOW FYG-FLUORESCENT YELLOW GREEN																				"SHS"-STANDARD HIGHWAY SIGNS			
SB	4.230	F	R1-1	30	30								1		X														
		F	R1-1	30	30			6.25								1		X									X		
SB	4.200	F	W2-2R	30	30		RIGHT SIDE ROAD						1		X														
SB	4.113	G	VR-017	24	24								1		X												BRALEY COVERED BRIDGE RD TH 64			
		G	VR-017	24	30			5.00								1		X											E-141
SB	4.105	H	R1-1	24	24								1		X												BRALEY COVERED BRIDGE RD TH 64			
		H	R1-1	30	30			6.25								1		X									X		
SB	4.055	F	R2-1	24	30		SPEED LIMIT 50			1				X															
SB	4.020	F	W1-4R	30	30		RIGHT REVERSE CURVE						1		X														
SB	3.980	F	VW-060	30	30		HIDDEN DRIVES 						1		X														
		F	W1-4R	30	30			6.25								2		X									X		
		F	VW-060	30	30			6.25																					E-154
SB	3.696	G	VR-017	24	24								1		X												PALMER RD TH-65			
		G	VR-017	24	30			5.00								1		X											E-141
SB	3.688	H	R1-1	24	24								1		X														
SIGN SUMMARY SHEET							SHEET TOTALS	35.00	0.00	1	0	0	8	0	0	6		90										
								SF	SF	EA	EA	EA	EA	EA	EA	EA		FT										
VERMONT AGENCY OF TRANSPORTATION							TOWN TOTALS	771.4	0.0	19.0	5.0	5.0	155	0.0	0.0	130		1950.0										

PROJECT NAME: **Hartford-East Montpelier VT14**
PROJECT NUMBER: **STPG SIGN(25)**

FILE NAME: **Randolph.xls** PLOT DATE: **6/18/2009**
PROJECT MANAGER: **N. Avery** DRAWN BY: **I. Shea**
DESIGNED BY: **D. Crossley** CHECKED BY: **S. Menard**
RANDOLPH SHEET 20 SHEET **83** OF **162**

DIRECTION	MILEPOINT	LOCATION CODE (SHEET 2)	SIGN CODE	WIDTH (IN)	HEIGHT (IN)	SHEETING REMARKS	SIGN LEGEND	NEW SIGNS "A"	NEW SIGNS "B"	EXISTING SIGNS RETAIN	EXISTING SIGNS SALVAGE FROM	EXISTING SIGNS SALVAGE TO	EXISTING SIGNS REMOVE	EXIST POST RETAIN	EXIST POST REMOVE	NUMBER OF NEW POSTS	SQUARE STEEL (IN) 1.75 (LB / FT) 1.88	SQUARE STEEL (IN) 2.00 (LB / FT) 2.42	SQUARE STEEL (IN) 2.50 (LB / FT) 3.35	TUBULAR STEEL Ø (IN) FOUNDATION	TUBULAR STEEL Ø (IN) 3.00 (LB / FT) 7.60	TUBULAR STEEL Ø (IN) 3.50 (LB / FT) 9.00	TUBULAR STEEL Ø (IN) 4.00 (LB / FT) 10.80	TUBULAR STEEL Ø (IN) 5.00 (LB / FT) 14.60	SIGN FRAME REQUIRED	REMARKS	SIGN DETAIL: DETAIL IN SHS	SIGN DETAIL: DETAIL ON SHEET NUMBER	SIGN DETAIL: DETAIL ON STD SHEET NUMBER
RANDOLPH VT 14							FY-FLUORESCENT YELLOW FYG-FLUORESCENT YELLOW GREEN																			"SHS"-STANDARD HIGHWAY SIGNS			
		H	R1-1	30	30			6.25								1		X									X		
SB	3.650	F	W1-4R	30	30		RIGHT REVERSE CURVE 						1		X														
SB	3.560	F	W1-4R	30	30			6.25								1		X								INSTALL 475' +/- SOUTH OF ORIGINAL LOCATION	X		
SB	3.380	F	W2-2mAL	30	30		SIDE ROAD LEFT						1		X														
		F	W5-2	30	30		NARROW BRIDGE 						1																
SB	3.330	F	W2-2MaL	30	30			6.25								2		X								INSTALL 250'+/- SOUTH OF ORIGINAL LOCATION		6	
		F	W5-2	30	30			6.25																			X		
SB	3.269	F	OM-3R	12	36								1		X														
		F	OM-3R	12	36			3.00								1		X									X		
SB	3.261	E	OM-3L	12	36								1		X														
		E	OM-3L	12	36			3.00								1		X									X		
SB	2.780	F	W1-2R	30	30		RIGHT CURVE						1		X														
		F	W13-1	18	18		40 MPH PLAQUE 						1																
SB	2.775	F	W1-2R	30	30			6.25								1		X								INSTALL 260'+/- SOUTH OF ORIGINAL LOCATION	X		
		F	W13-1	18	18			2.25																			X		
SIGN SUMMARY SHEET							SHEET TOTALS	39.50 SF	0.00 SF	0 EA	0 EA	0 EA	7 EA	0 EA	0 EA	7 EA	105 FT											
VERMONT AGENCY OF TRANSPORTATION							TOWN TOTALS	771.4	0.0	19.0	5.0	5.0	155	0.0	0.0	130	1950.0											

PROJECT NAME: **Hartford-East Montpelier VT14**
PROJECT NUMBER: **STPG SIGN(25)**
FILE NAME: **Randolph.xls** PLOT DATE: **6/18/2009**
PROJECT MANAGER: **N. Averv** DRAWN BY: **I. Shea**
DESIGNED BY: **D. Crossley** CHECKED BY: **S. Menard**
RANDOLPH SHEET 21 SHEET **84** OF **162**

DIRECTION	MILEPOINT	LOCATION CODE (SHEET 2)	SIGN CODE	WIDTH (IN)	HEIGHT (IN)	SHEETING REMARKS	SIGN LEGEND FOR ALL POST LENGTHS AND INSTALLATION DATES SEE ORIGINAL RECORD PLANS	NEW SIGNS "A"	NEW SIGNS "B"	EXISTING SIGNS RETAIN	EXISTING SIGNS SALVAGE FROM	EXISTING SIGNS SALVAGE TO	EXISTING SIGNS REMOVE	EXIST POST RETAIN	EXIST POST REMOVE	NUMBER OF NEW POSTS	SQUARE STEEL (IN) 1.75 (LB / FT) 1.88	SQUARE STEEL (IN) 2.00 (LB / FT) 2.42	SQUARE STEEL (IN) 2.50 (LB / FT) 3.35	TUBULAR STEEL Ø (IN) FOUNDATION	TUBULAR STEEL Ø (IN) 3.00 (LB / FT) 7.60	TUBULAR STEEL Ø (IN) 3.50 (LB / FT) 9.00	TUBULAR STEEL Ø (IN) 4.00 (LB / FT) 10.80	TUBULAR STEEL Ø (IN) 5.00 (LB / FT) 14.60	SIGN FRAME REQUIRED	REMARKS	SIGN DETAIL DETAIL IN SHS	SIGN DETAIL DETAIL ON SHEET NUMBER	SIGN DETAIL DETAIL ON STD SHEET NUMBER
RANDOLPH VT 14							FY-FLUORESCENT YELLOW FYG-FLUORESCENT YELLOW GREEN																			"SHS"-STANDARD HIGHWAY SIGNS			
SB	2.691	F	OM-3R	12	36			3.00								1		X								END OF STONE RET. WALL			
SB	2.137	F	W11-4	30	30		CATTLE SYMBOL						1		X														
		F	W16-2	24	18		700 FEET						1																
		F	W2-2MaR	30	30			6.25								1		X										6	
SB	2.081	G	VR-017	24	24		LEGAL LOAD LIMIT 24,000 POUNDS						0 ~~1~~		X											DAVIS RD TH-72			
		G	VR-017	24	30			5.00								1		X											E-141
SB	2.077	H	R1-1	24	24		STOP						0 ~~1~~		X											DAVIS RD TH-72			
		H	R1-1	30	30			6.25								1		X										X	
	2.070	F	W11-4	30	30		700 FEET	6.25								1		X								INSTALL 100'+/- SOUTH OF DAVIS RD		X	
		F	W16-2	24	18			3.00																				X	
SB	1.620	F	W1-2R	30	30		RIGHT CURVE						1		X														
		F	W13-1	18	18		35 MPH PLAQUE						1																
SB	1.580	F	VW-054R	30	30		HIDDEN DRIVE RIGHT						1		X														
		F	VD-018	30	18		SOUTH RANDOLPH E. BETHEL 2	3.75								1		X											E-128B
SB	1.550	F	VD-018	30	18		SOUTH RANDOLPH E. BETHEL 2						1		X														
		F	VW-054R	30	30		HIDDEN DRIVE RIGHT	6.25								1		X											E-154
SIGN SUMMARY SHEET							SHEET TOTALS	~~36.75~~ 39.75 SF	0.00 SF	0 EA	0 EA	0 EA	~~8~~ 6 EA	0 EA	0 EA	~~6~~ 7 EA	90 FT												
VERMONT AGENCY OF TRANSPORTATION							TOWN TOTALS	771.4	0.0	19.0	5.0	5.0	155	0.0	0.0	130	1950.0												

PROJECT NAME: Hartford-East Montpelier VT14
PROJECT NUMBER: STPG SIGN(25)

FILE NAME: Randolph.xls
PROJECT MANAGER: N. Avery
DESIGNED BY: D. Crossley
RANDOLPH SHEET 22

PLOT DATE: 6/18/2009
DRAWN BY: I. Shea
CHECKED BY: S. Menard
SHEET 85 OF 162

DIRECTION	MILEPOINT	LOCATION CODE (SHEET 2)	SIGN CODE	WIDTH (IN)	HEIGHT (IN)	SHEETING REMARKS	SIGN LEGEND FOR ALL POST LENGTHS AND INSTALLATION DATES SEE ORIGINAL RECORD PLANS	NEW SIGNS "A"	NEW SIGNS "B"	EXISTING SIGNS RETAIN	EXISTING SIGNS SALVAGE FROM	EXISTING SIGNS SALVAGE TO	EXISTING SIGNS REMOVE	EXIST POST RETAIN	EXIST POST REMOVE	NUMBER OF NEW POSTS	SQUARE STEEL (IN) 1.75 (LB / FT) 1.88	SQUARE STEEL (IN) 2.00 (LB / FT) 2.42	SQUARE STEEL (IN) 2.50 (LB / FT) 3.35	TUBULAR STEEL Ø (IN) FOUNDATION	TUBULAR STEEL Ø (IN) 3.00 (LB / FT) 7.60	TUBULAR STEEL Ø (IN) 3.50 (LB / FT) 9.00	TUBULAR STEEL Ø (IN) 4.00 (LB / FT) 10.80	TUBULAR STEEL Ø (IN) 5.00 (LB / FT) 14.60	SIGN FRAME REQUIRED	REMARKS	SIGN DETAIL: DETAIL IN SHS	SIGN DETAIL: DETAIL ON SHEET NUMBER	SIGN DETAIL: DETAIL ON STD SHEET NUMBER
RANDOLPH VT 14							FY-FLUORESCENT YELLOW FYG-FLUORESCENT YELLOW GREEN																			"SHS"-STANDARD HIGHWAY SIGNS			
SB	1.500	F	W1-2R	30	30			6.25								1		X								INSTALL 150' +/- SOUTH OF PREVIOUS SIGN	X		
		F	W13-1	18	18			2.25																				X		
SB	1.440	F	W2-2R	30	30		RIGHT SIDE ROAD						1		X															
SB	1.370	G	VR-017	24	24								1		X												SOUTH RANDOLPH RD TH-71			
		G	VR-017	24	30			5.00								1		X												E-141
SB	1.363	H	R1-1	30	30			6.25					1			1		X								INSTALL IN ISLAND	X		
SB	1.355	H	R1-1	24	24								1		X															
		H	R1-1	30	30			6.25								1		X										X		
SB	1.310	F	VW-054R	30	30		HIDDEN DRIVE RIGHT						1		X															
SB	1.280	F	M3-3	24	12		SOUTH						1		X															
		F	M1-5	24	24		VERMONT 14						1																	
		F	VW-054R	30	30			6.25								1											E-154
SB	1.120	F	W5-2	30	30		NARROW BRIDGE 						1		X															
SB	1.080	F	W5-2	30	30			6.25								1		X								INSTALL 200' SOUTH OF ORIGINAL SIGN LOCATION	X		
SB	0.998	F	OM-3R	12	36								1		X															
SIGN SUMMARY SHEET							SHEET TOTALS	38.50	0.00	0	0	0	9 8	0	0	6		90										
								SF	SF	EA	EA	EA	EA	EA	EA	EA		FT										
VERMONT AGENCY OF TRANSPORTATION							TOWN TOTALS	771.4	0.0	19.0	5.0	5.0	155	0.0	0.0	130		1950.0										

PROJECT NAME: Hartford-East Montpelier VT14
PROJECT NUMBER: STPG SIGN(25)

FILE NAME: Randolph.xls
PROJECT MANAGER: N. Avery
DESIGNED BY: D. Crossley
RANDOLPH SHEET 23

PLOT DATE: 6/18/2009
DRAWN BY: I. Shea
CHECKED BY: S. Menard
SHEET 86 OF 162

DIRECTION	MILEPOINT	LOCATION CODE (SHEET 2)	SIGN CODE	WIDTH (IN)	HEIGHT (IN)	SHEETING REMARKS	SIGN LEGEND	NEW SIGNS "A"	NEW SIGNS "B"	EXISTING SIGNS RETAIN	EXISTING SIGNS SALVAGE FROM	EXISTING SIGNS SALVAGE TO	EXISTING SIGNS REMOVE	EXIST POST RETAIN	EXIST POST REMOVE	NUMBER OF NEW POSTS	SQUARE STEEL (IN) 1.75 (LB / FT) 1.88	SQUARE STEEL (IN) 2.00 (LB / FT) 2.42	SQUARE STEEL (IN) 2.50 (LB / FT) 3.35	TUBULAR STEEL Ø (IN) FOUNDATION	TUBULAR STEEL Ø (IN) 3.00 (LB / FT) 7.60	TUBULAR STEEL Ø (IN) 3.50 (LB / FT) 9.00	TUBULAR STEEL Ø (IN) 4.00 (LB / FT) 10.80	TUBULAR STEEL Ø (IN) 5.00 (LB / FT) 14.60	SIGN FRAME REQUIRED	REMARKS	SIGN DETAIL DETAIL IN SHS	SIGN DETAIL DETAIL ON SHEET NUMBER	SIGN DETAIL DETAIL ON STD SHEET NUMBER
RANDOLPH VT 14							FY-FLUORESCENT YELLOW FYG-FLUORESCENT YELLOW GREEN																			"SHS"-STANDARD HIGHWAY SIGNS			
		F	OM-3R	12	36			3.00								1		X								X		
SB	0.990	E	OM-3L	12	36								1		X														
		E	OM-3L	12	36			3.00								1		X								X		
SB	0.340	H	R1-1	30	30			6.25								1		X								KINGSBURY RD TH-60	X		
SIGN SUMMARY SHEET							SHEET TOTALS	12.25	0.00	0	0	0	1	0	0	3		45										
								SF	SF	EA	EA	EA	EA	EA	EA	EA		FT										
VERMONT AGENCY OF TRANSPORTATION							TOWN TOTALS	771.4	0.0	19.0	5.0	5.0	155	0.0	0.0	130		1950.0										

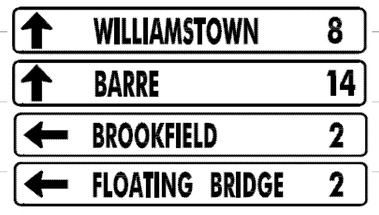
PROJECT NAME: **Hartford-East Montpelier VT14**
PROJECT NUMBER: **STPG SIGN(25)**

FILE NAME: **Randolph.xls** PLOT DATE: **6/18/2009**
PROJECT MANAGER: **N. Avery** DRAWN BY: **I. Shea**
DESIGNED BY: **D. Crossley** CHECKED BY: **S. Menard**
RANDOLPH SHEET 24 SHEET **87** OF **162**

DIRECTION	MILEPOINT	LOCATION CODE (SHEET 2)	SIGN CODE	WIDTH (IN)	HEIGHT (IN)	SHEETING REMARKS	SIGN LEGEND FOR ALL POST LENGTHS AND INSTALLATION DATES SEE ORIGINAL RECORD PLANS	NEW SIGNS "A"	NEW SIGNS "B"	EXISTING SIGNS RETAIN	EXISTING SIGNS SALVAGE FROM	EXISTING SIGNS SALVAGE TO	EXISTING SIGNS REMOVE	EXIST POST RETAIN	EXIST POST REMOVE	NUMBER OF NEW POSTS	SQUARE STEEL (IN) 1.75 (LB / FT) 1.88	SQUARE STEEL (IN) 2.00 (LB / FT) 2.42	SQUARE STEEL (IN) 2.50 (LB / FT) 3.35	TUBULAR STEEL Ø (IN) FOUNDATION	TUBULAR STEEL Ø (IN) 3.00 (LB / FT) 7.60	TUBULAR STEEL Ø (IN) 3.50 (LB / FT) 9.00	TUBULAR STEEL Ø (IN) 4.00 (LB / FT) 10.80	TUBULAR STEEL Ø (IN) 5.00 (LB / FT) 14.60	SIGN FRAME REQUIRED	REMARKS	SIGN DETAIL: DETAIL IN SHS	SIGN DETAIL: DETAIL ON SHEET NUMBER	SIGN DETAIL: DETAIL ON STD SHEET NUMBER
BROOKFIELD VT 14							FY-FLUORESCENT YELLOW FYG-FLUORESCENT YELLOW GREEN																			"SHS"-STANDARD HIGHWAY SIGNS			
NB	0.000	C	VD-024	72	10		BROOKFIELD / RANDOLPH	0.84 5.00								2 ~~1~~		X							2 MM PLAQUES @ 0.42 SF EA=0.84 SF		4	
NB	0.926	C	VR-017	24	30		LEGAL LOAD LIMIT 24,000 POUNDS	5.00								1		X							MONTGOMERY RD TH54			
NB	0.934	D	R1-1	30	30		STOP	6.25								1		X										
		A	W14-2	30	30		NO OUTLET						1		X													
NB	1.050	A	W11-5	30	30								1		X													
		A	W7-3A	24	18								1															
		A	W11-5	30	30		NEXT 4 MILES	6.25								1		X									X	
		A	W7-3A	24	18			3.00																			X	
NB	2.920	A	OM-1	18	18		OBJECT MARKER						~~2~~ 1		X										REMOVED MM PLAQUE			
NB	3.100	A	R2-5A	24	30		REDUCED SPEED AHEAD						1		X													
		A	VD-018	30	18		EAST BROOKFIELD WILLIAMSTOWN 8	3.75								1		X											E-128B
NB	3.230	A	R2-1	24	30								1		X													
		A	R2-1	30	36		SPEED LIMIT 45	7.50								1		X									6	
NB	3.310	A	VD-062A	72	16		BUSINESS SIGN			1				X														
NB	3.430	C	VR-017	24	24								1		X										EAST HILL RD TH-9			
SIGN SUMMARY SHEET							SHEET TOTALS	~~36.75~~ 37.59 SF	0.00 SF	1 EA	0 EA	0 EA	~~8~~ 7 EA	0 EA	0 EA	~~7~~ 6 EA	90 FT										
VERMONT AGENCY OF TRANSPORTATION							TOWN TOTALS	332.4	0.0	2.0	0.0	0.0	50	0.0	0.0	49	735.0										

PROJECT NAME: Hartford-East Montpelier VT14
PROJECT NUMBER: STPG SIGN(21)

FILE NAME: Brookfield.xls
PROJECT MANAGER: N. Avery
DESIGNED BY: D. Crossley
PLOT DATE: 6/10/2009
DRAWN BY: T. Guazzoni
CHECKED BY: S. Menard

DIRECTION	MILEPOINT	LOCATION CODE (SHEET 2)	SIGN CODE	WIDTH (IN)	HEIGHT (IN)	SHEETING REMARKS	SIGN LEGEND	NEW SIGNS "A"	NEW SIGNS "B"	EXISTING SIGNS RETAIN	EXISTING SIGNS SALVAGE FROM	EXISTING SIGNS SALVAGE TO	EXISTING SIGNS REMOVE	EXIST POST RETAIN	EXIST POST REMOVE	NUMBER OF NEW POSTS	SQUARE STEEL (IN) 1.75 (LB / FT) 1.88	SQUARE STEEL (IN) 2.00 (LB / FT) 2.42	SQUARE STEEL (IN) 2.50 (LB / FT) 3.35	TUBULAR STEEL Ø (IN) FOUNDATION	TUBULAR STEEL Ø (IN) 3.00 (LB / FT) 7.60	TUBULAR STEEL Ø (IN) 3.50 (LB / FT) 9.00	TUBULAR STEEL Ø (IN) 4.00 (LB / FT) 10.80	TUBULAR STEEL Ø (IN) 5.00 (LB / FT) 14.60	SIGN FRAME REQUIRED	REMARKS	SIGN DETAIL: DETAIL IN SHS	SIGN DETAIL: DETAIL ON SHEET NUMBER	SIGN DETAIL: DETAIL ON STD SHEET NUMBER
BROOKFIELD VT 14							FY-FLUORESCENT YELLOW FYG-FLUORESCENT YELLOW GREEN																			"SHS"-STANDARD HIGHWAY SIGNS			
		C	VR-017	24	30			5.00								1		X										E-141
NB	3.430	D	R1-1	24	24								1		X														
		D	R1-1	30	30			6.25								1		X									X		
NB	3.470	A	M2-1	21	15								1		X														
		A	M1-5	24	24								1																
		A	M2-1	21	15			2.19								1		X									GREEN ON WHITE SHEETING	X		
		A	M1-5	24	24			4.00																					E-136B
NB	3.560	A	D1-1A	72	12			6.00								2		X							INSTALL 15' SOUTH OF POLE W/U.G. POWER ACROSS FROM FIRE DEPT LANE		5	
		A	D1-1A	72	12			6.00																				5	
		A	D1-1A	72	12			6.00																				5	
		A	D1-1A	72	12			6.00																				5	
NB	3.640	A	M3-4	24	12								1		X														
		A	M1-6	24	24								1																
		A	M6-1	21	15								1																
		A	M3-1	24	12								1																
SIGN SUMMARY SHEET							SHEET TOTALS	41.44	0.00	0	0	0	7	0	0	5			75									
								SF	SF	EA	EA	EA	EA	EA	EA	EA			FT									
VERMONT AGENCY OF TRANSPORTATION							TOWN TOTALS	332.4	0.0	2.0	0.0	0.0	50	0.0	0.0	49			735.0									

PROJECT NAME: Hartford-East Montpelier VT14
PROJECT NUMBER: STPG SIGN(21)

FILE NAME: Brookfield.xls
PROJECT MANAGER: N. Averv
DESIGNED BY: D. Crossley
BROOKFIELD SHEET 2

PLOT DATE: 6/10/2009
DRAWN BY: T. Guazzoni
CHECKED BY: S. Menard
SHEET 89 OF 162

DIRECTION	MILEPOINT	LOCATION CODE (SHEET 2)	SIGN CODE	WIDTH (IN)	HEIGHT (IN)	SHEETING REMARKS	SIGN LEGEND	NEW SIGNS "A"	NEW SIGNS "B"	EXISTING SIGNS RETAIN	EXISTING SIGNS SALVAGE FROM	EXISTING SIGNS SALVAGE TO	EXISTING SIGNS REMOVE	EXIST POST RETAIN	EXIST POST REMOVE	NUMBER OF NEW POSTS	SQUARE STEEL (IN) 1.75 (LB / FT) 1.88	SQUARE STEEL (IN) 2.00 (LB / FT) 2.42	SQUARE STEEL (IN) 2.50 (LB / FT) 3.35	TUBULAR STEEL Ø (IN) FOUNDATION	TUBULAR STEEL Ø (IN) 3.00 (LB / FT) 7.60	TUBULAR STEEL Ø (IN) 3.50 (LB / FT) 9.00	TUBULAR STEEL Ø (IN) 4.00 (LB / FT) 10.80	TUBULAR STEEL Ø (IN) 5.00 (LB / FT) 14.60	SIGN FRAME REQUIRED	REMARKS	SIGN DETAIL DETAIL IN SHS	SIGN DETAIL DETAIL ON SHEET NUMBER	SIGN DETAIL DETAIL ON STD SHEET NUMBER
BROOKFIELD VT 14							FY-FLUORESCENT YELLOW FYG-FLUORESCENT YELLOW GREEN																			"SHS"-STANDARD HIGHWAY SIGNS			
		A	M1-6	24	24								1															
		A	M6-3	21	15								1															
		A	M3-4	24	12			2.00								2		X							2	GREEN ON WHITE SHEETING	X	7	
		A	M1-5	24	24			4.00																				E-136B
		A	M6-1	21	15			2.19																		GREEN ON WHITE SHEETING	X		
		A	M3-1	24	12			2.00																		GREEN ON WHITE SHEETING	X		
		A	M1-5	24	24			4.00																				E-136B
		A	M6-3	21	15			2.19																		GREEN ON WHITE SHEETING	X		
NB	3.650	C	W1-7	48	24								1		X													
		C	W1-7	48	24			8.00								2		X									X	
NB	3.677	A	M3-1	24	12								1		X													
		A	M1-5	24	24								1															
		A	M3-1	24	12			2.00								1		X								GREEN ON WHITE SHEETING			
		A	M1-5	24	24			4.00																				
NB	3.764	A	R2-1	24	30			5.00								1		X								INSTALL OPPOSITE SPEED LIMIT 45	X		
SIGN SUMMARY SHEET							SHEET TOTALS	35.38 SF	0.00 SF	0 EA	0 EA	0 EA	5 EA	0 EA	0 EA	6 EA		90 FT								
VERMONT AGENCY OF TRANSPORTATION							TOWN TOTALS	332.4	0.0	2.0	0.0	0.0	50	0.0	0.0	49		735.0								

PROJECT NAME: Hartford-East Montpelier VT14
PROJECT NUMBER: STPG SIGN(21)

FILE NAME: Brookfield.xls
PROJECT MANAGER: N. Averv
DESIGNED BY: D. Crossley
BROOKFIELD SHEET 3

PLOT DATE: 6/10/2009
DRAWN BY: T. Guazzoni
CHECKED BY: S. Menard

DIRECTION	MILEPOINT	LOCATION CODE (SHEET 2)	SIGN CODE	WIDTH (IN)	HEIGHT (IN)	SHEETING REMARKS	SIGN LEGEND	NEW SIGNS "A"	NEW SIGNS "B"	EXISTING SIGNS RETAIN	EXISTING SIGNS SALVAGE FROM	EXISTING SIGNS SALVAGE TO	EXISTING SIGNS REMOVE	EXIST POST RETAIN	EXIST POST REMOVE	NUMBER OF NEW POSTS	SQUARE STEEL (IN) 1.75 (LB / FT) 1.88	SQUARE STEEL (IN) 2.00 (LB / FT) 2.42	SQUARE STEEL (IN) 2.50 (LB / FT) 3.35	TUBULAR STEEL Ø (IN) FOUNDATION	TUBULAR STEEL Ø (IN) 3.00 (LB / FT) 7.60	TUBULAR STEEL Ø (IN) 3.50 (LB / FT) 9.00	TUBULAR STEEL Ø (IN) 4.00 (LB / FT) 10.80	TUBULAR STEEL Ø (IN) 5.00 (LB / FT) 14.60	SIGN FRAME REQUIRED	REMARKS	SIGN DETAIL: DETAIL IN SHS	SIGN DETAIL: DETAIL ON SHEET NUMBER	SIGN DETAIL: DETAIL ON STD SHEET NUMBER
BROOKFIELD VT 14							FY-FLUORESCENT YELLOW FYG-FLUORESCENT YELLOW GREEN																			"SHS"-STANDARD HIGHWAY SIGNS			
NB	3.800	A	W11-5	30	30			6.25								1		X								INSTALL OPPOSITE SB ALLIS STATE PARK SIGN	X		
		A	W7-3A	24	18			3.00																			X		
NB	5.019	C	VR-017	24	30								1		X												TAYLOR HILL RD TH-15			E-141
		C	VR-017	24	30			5.00								1		X											
NB	5.027	D	R1-1	30	30								1		X															
		D	R1-1	30	30			6.25								1		X									X		
NB	5.745	A	S3-1	30	30								1		X															
		A	VW-054R	30	30								1																
		A	S3-1	30	30			6.25									2		X							X		
		A	VW-054R	30	30			6.25																					E-154
NB	6.050	A	VW-347 H	30	30								1		X															
		A	VW-347 H	30	30			6.25								1		X										6	
NB	6.120	A	W1-5L	36	36			9.00									2		X								INSTALL 350'+/- NORTH OF PREVIOUS SIGN AT BEGINNING OF LEFT CURVE	X		
		A	W13-1	24	24			4.00																		INSTALL ON LEFT POST	X		
		A	W7-3A	24	18			3.00																		INSTALL ON RIGHT POST	X		
SIGN SUMMARY SHEET							SHEET TOTALS	55.25	0.00	0	0	0	5	0	0	8		120									
								SF	SF	EA	EA	EA	EA	EA	EA	EA		FT									
VERMONT AGENCY OF TRANSPORTATION							TOWN TOTALS	332.4	0.0	2.0	0.0	0.0	50	0.0	0.0	49		735.0									

PROJECT NAME: **Hartford-East Montpelier VT14**
PROJECT NUMBER: **STPG SIGN(21)**

FILE NAME: **Brookfield.xls** PLOT DATE: **6/10/2009**
PROJECT MANAGER: **N. Averv** DRAWN BY: **T. Guazzoni**
DESIGNED BY: **D. Crossley** CHECKED BY: **S. Menard**
BROOKFIELD SHEET 4 SHEET **91** OF **162**

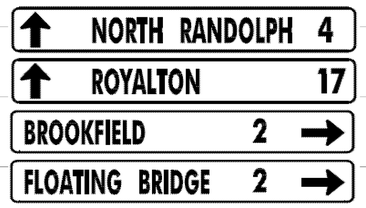
DIRECTION	MILEPOINT	LOCATION CODE (SHEET 2)	SIGN CODE	WIDTH (IN)	HEIGHT (IN)	SHEETING REMARKS	SIGN LEGEND FOR ALL POST LENGTHS AND INSTALLATION DATES SEE ORIGINAL RECORD PLANS	NEW SIGNS "A"	NEW SIGNS "B"	EXISTING SIGNS RETAIN	EXISTING SIGNS SALVAGE FROM	EXISTING SIGNS SALVAGE TO	EXISTING SIGNS REMOVE	EXIST POST RETAIN	EXIST POST REMOVE	NUMBER OF NEW POSTS	SQUARE STEEL (IN) 1.75 (LB / FT) 1.88	SQUARE STEEL (IN) 2.00 (LB / FT) 2.42	SQUARE STEEL (IN) 2.50 (LB / FT) 3.35	TUBULAR STEEL Ø (IN) FOUNDATION	TUBULAR STEEL Ø (IN) 3.00 (LB / FT) 7.60	TUBULAR STEEL Ø (IN) 3.50 (LB / FT) 9.00	TUBULAR STEEL Ø (IN) 4.00 (LB / FT) 10.80	TUBULAR STEEL Ø (IN) 5.00 (LB / FT) 14.60	SIGN FRAME REQUIRED	REMARKS	SIGN DETAIL DETAIL IN SHS	SIGN DETAIL DETAIL ON SHEET NUMBER	SIGN DETAIL DETAIL ON STD SHEET NUMBER
BROOKFIELD VT 14							FY-FLUORESCENT YELLOW FYG-FLUORESCENT YELLOW GREEN																			"SHS"-STANDARD HIGHWAY SIGNS			
NB	6.570	A	W1-2R	30	30		CURVE RIGHT						1		X														
		A	W13-1	24	24		35 MPH PLAQUE						1																
SB	5.940	F	VW-054L	30	30		HIDDEN DRIVE LEFT						1		X														
SB	5.930	F	VW-054L	30	30			6.25								1		X									INSTALL 100' +/- SOUTH OF ORIGINAL LOCATION			E-154
SB	4.395	G	VR-017	24	30		LEGAL LOAD LIMIT 24,000 POUNDS	5.00								1		X									TWIN POND RD TH-12			E-141
SB	4.380	H	R1-1	30	30		STOP	6.25								1		X										X		
SB	3.880	F	M2-1	21	15								1		X														
		F	M1-5	24	24		JCT						1																
		F	M2-1	21	15		VERMONT 65	2.19								1		X									GREEN ON WHITE SHEETING	X		
		F	M1-5	24	24			4.00																					E-136B
SB	3.870	F	W11-5	30	30			6.25	6.25							1		X									INSTALL 200' SOUTH OF ROUTE MARKER ASSEMBLY	X		
		F	W7-3A	24	18		NEXT 4 MILES	3.00																			NEW STOLEN	X		
SB	3.800	F	VD-062A	72	16		BUSINESS SIGN			1				X																
SB	3.780	F	VD-018	30	18		EAST BROOKFIELD NORTH RANDOLPH 4	3.75								1		X												E-128B
SB	3.764	F	R2-1	24	30								1		X														
							SHEET TOTALS	~~36.69~~ 42.94 SF	0.00 SF	1 EA	0 EA	0 EA	6 EA	0 EA	0 EA	6 EA	90 FT												
							TOWN TOTALS	332.4 SF	0.0 SF	2.0 EA	0.0 EA	0.0 EA	50 EA	0.0 EA	0.0 EA	49 EA	735.0 FT												

SIGN SUMMARY SHEET

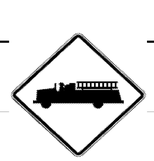
VERMONT AGENCY OF TRANSPORTATION

PROJECT NAME: Hartford-East Montpelier VT14
PROJECT NUMBER: STPG SIGN(21)

FILE NAME: Brookfield.xls
PROJECT MANAGER: N. Avery
DESIGNED BY: D. Crossley
PLOT DATE: 6/10/2009
DRAWN BY: T. Guazzoni
CHECKED BY: S. Menard
BROOKFIELD SHEET 5
SHEET 92 OF 162

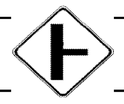
DIRECTION	MILEPOINT	LOCATION CODE (SHEET 2)	SIGN CODE	WIDTH (IN)	HEIGHT (IN)	SHEETING REMARKS	SIGN LEGEND	NEW SIGNS "A"	NEW SIGNS "B"	EXISTING SIGNS RETAIN	EXISTING SIGNS SALVAGE FROM	EXISTING SIGNS SALVAGE TO	EXISTING SIGNS REMOVE	EXIST POST RETAIN	EXIST POST REMOVE	NUMBER OF NEW POSTS	SQUARE STEEL (IN) 1.75 (LB / FT) 1.88	SQUARE STEEL (IN) 2.00 (LB / FT) 2.42	SQUARE STEEL (IN) 2.50 (LB / FT) 3.35	TUBULAR STEEL Ø (IN) FOUNDATION	TUBULAR STEEL Ø (IN) 3.00 (LB / FT) 7.60	TUBULAR STEEL Ø (IN) 3.50 (LB / FT) 9.00	TUBULAR STEEL Ø (IN) 4.00 (LB / FT) 10.80	TUBULAR STEEL Ø (IN) 5.00 (LB / FT) 14.60	SIGN FRAME REQUIRED	REMARKS	SIGN DETAIL: DETAIL IN SHS	SIGN DETAIL: DETAIL ON SHEET NUMBER	SIGN DETAIL: DETAIL ON STD SHEET NUMBER
BROOKFIELD VT 14							FY-FLUORESCENT YELLOW FYG-FLUORESCENT YELLOW GREEN																			"SHS"-STANDARD HIGHWAY SIGNS			
		F	R2-1	30	36			7.50								1		X									6
SB	3.722	F	D1-1A	72	10								1		X													
		F	D1-1A	72	10								1															
		F	D1-1A	72	10								1															
		F	D1-1G	72	10								1															
		F	D1-1A	72	12			6.00								2			X								5
		F	D1-1A	72	12			6.00																				5
		F	D1-1A	72	12			6.00																				5
		F	D1-1G	72	12			6.00																				5
SB	3.696	F	M3-3	24	12								1		X													
		F	M1-5	24	24								1															
		F	M6-3	21	15								1															
		F	M3-4	24	12								1															
		F	M1-5	24	24								1															
		F	M6-1	21	15								1															
SIGN SUMMARY SHEET							SHEET TOTALS	31.50	0.00	0	0	0	10	0	0	3			45								
VERMONT AGENCY OF TRANSPORTATION								SF	SF	EA	EA	EA	EA	EA	EA	EA			FT								
							TOWN TOTALS	332.4	0.0	2.0	0.0	0.0	50	0.0	0.0	49			735.0								

PROJECT NAME: **Hartford-East Montpelier VT14**
PROJECT NUMBER: **STPG SIGN(21)**
FILE NAME: **Brookfield.xls** PLOT DATE: **6/10/2009**
PROJECT MANAGER: **N. Averv** DRAWN BY: **T. Guazzoni**
DESIGNED BY: **D. Crossley** CHECKED BY: **S. Menard**
BROOKFIELD SHEET 6 SHEET **93** OF **162**

DIRECTION	MILEPOINT	LOCATION CODE (SHEET 2)	SIGN CODE	WIDTH (IN)	HEIGHT (IN)	SHEETING REMARKS	SIGN LEGEND	NEW SIGNS "A"	NEW SIGNS "B"	EXISTING SIGNS RETAIN	EXISTING SIGNS SALVAGE FROM	EXISTING SIGNS SALVAGE TO	EXISTING SIGNS REMOVE	EXIST POST RETAIN	EXIST POST REMOVE	NUMBER OF NEW POSTS	SQUARE STEEL (IN) 1.75 (LB / FT) 1.88	SQUARE STEEL (IN) 2.00 (LB / FT) 2.42	SQUARE STEEL (IN) 2.50 (LB / FT) 3.35	TUBULAR STEEL Ø (IN) FOUNDATION	TUBULAR STEEL Ø (IN) 3.00 (LB / FT) 7.60	TUBULAR STEEL Ø (IN) 3.50 (LB / FT) 9.00	TUBULAR STEEL Ø (IN) 4.00 (LB / FT) 10.80	TUBULAR STEEL Ø (IN) 5.00 (LB / FT) 14.60	SIGN FRAME REQUIRED	REMARKS	SIGN DETAIL: DETAIL IN SHS	SIGN DETAIL: DETAIL ON SHEET NUMBER	SIGN DETAIL: DETAIL ON STD SHEET NUMBER
BROOKFIELD VT 14							FY-FLUORESCENT YELLOW FYG-FLUORESCENT YELLOW GREEN																			"SHS"-STANDARD HIGHWAY SIGNS			
		F	M3-3	24	12			2.00								2		X							2	GREEN ON WHITE SHEETING	X		
		F	M1-5	24	24			4.00																					E-136B
		F	M6-3	21	15			2.19																			GREEN ON WHITE SHEETING	X		
		F	M3-4	24	12			2.00																			GREEN ON WHITE SHEETING	X		
		F	M1-5	24	24			4.00																					E-136B
		F	M6-1	21	15			2.19																			GREEN ON WHITE SHEETING	X		
SB	3.640	F	W11-8	30	30								1		X															
		F	W11-8	30	30			6.25								1		X								X		
SB	3.580	G	VR-017	24	30			5.00								1		X								FIRE DEPT LN TH-71			E-141
SB	3.573	G	VR-017	24	24		LEGAL LOAD LIMIT 24,000 LBS						1		X														
		H	R1-1	24	24								1																
		H	R1-1	30	30			6.25								1		X										X	
SB	3.567	H	R1-1	30	30			6.25								1		X										X	
SB	3.535	F	M3-3S	24	12								1		X														
		F	M1-5	24	24								1																
SIGN SUMMARY SHEET							SHEET TOTALS	40.13	0.00	0	0	0	5	0	0	6		90									
								SF	SF	EA	EA	EA	EA	EA	EA	EA		FT									
VERMONT AGENCY OF TRANSPORTATION							TOWN TOTALS	332.4	0.0	2.0	0.0	0.0	50	0.0	0.0	49		735.0									

PROJECT NAME: **Hartford-East Montpelier VT14**
PROJECT NUMBER: **STPG SIGN(21)**

FILE NAME: **Brookfield.xls** PLOT DATE: **6/10/2009**
PROJECT MANAGER: **N. Averv** DRAWN BY: **T. Guazzoni**
DESIGNED BY: **D. Crossley** CHECKED BY: **S. Menard**
BROOKFIELD SHEET 7 SHEET **94** OF **162**

DIRECTION	MILEPOINT	LOCATION CODE (SHEET 2)	SIGN CODE	WIDTH (IN)	HEIGHT (IN)	SHEETING REMARKS	SIGN LEGEND FOR ALL POST LENGTHS AND INSTALLATION DATES SEE ORIGINAL RECORD PLANS	NEW SIGNS "A"	NEW SIGNS "B"	EXISTING SIGNS RETAIN	EXISTING SIGNS SALVAGE FROM	EXISTING SIGNS SALVAGE TO	EXISTING SIGNS REMOVE	EXIST POST RETAIN	EXIST POST REMOVE	NUMBER OF NEW POSTS	SQUARE STEEL (IN) (LB / FT) 1.75 / 1.88	SQUARE STEEL (IN) (LB / FT) 2.00 / 2.42	SQUARE STEEL (IN) (LB / FT) 2.50 / 3.35	TUBULAR STEEL Ø (IN) FOUNDATION	TUBULAR STEEL Ø (IN) (LB / FT) 3.00 / 7.60	TUBULAR STEEL Ø (IN) (LB / FT) 3.50 / 9.00	TUBULAR STEEL Ø (IN) (LB / FT) 4.00 / 10.80	TUBULAR STEEL Ø (IN) (LB / FT) 5.00 / 14.60	SIGN FRAME REQUIRED	REMARKS	SIGN DETAIL: DETAIL IN SHS	SIGN DETAIL: DETAIL ON SHEET NUMBER	SIGN DETAIL: DETAIL ON STD SHEET NUMBER
BROOKFIELD VT 14							FY-FLUORESCENT YELLOW FYG-FLUORESCENT YELLOW GREEN																			"SHS"-STANDARD HIGHWAY SIGNS			
		F	M3-3S	24	12			2.00								1		X							GREEN ON WHITE SHEETING	X		
		F	M1-5	24	24			4.00																				E-136B
SB	3.490	F	W11-5	30	30			6.25								1		X									X	
		F	W7-3A	24	18			3.00																			X	
SB	3.230	F	R2-1	24	30								1		X													
		F	R2-1	24	30			5.00								1		X									X	
SB	2.916	G	VR-017	24	24								0 ~~1~~		~~X~~										OLD POST RD TH-33			
		G	VR-017	24	30			5.00								1		X										E-141
SB	2.908	H	R1-1	24	24								0 ~~1~~		~~X~~													
		H	R1-1	30	30			6.25								1		X									X	
SB	2.400	F	W2-2R	30	30		RIGHT SIDE ROAD 						1		X													
SB	2.370	F	W2-2MaR	30	30			6.25								1		X							INSTALL 150'+/- SOUTH OF ORIGINAL LOCATION		6	
SB	2.235	G	VR-017	24	30			5.00 5.00					1 1			3 ~~1~~		X							SIGN MISSING, NEW. POST DAMAGED, NEW. MCKEAGE RD TH-32			E-141
SB	2.231	H	R1-1	30	30			6.25								1		X							MCKEAGE RD TH-32 INSTALL IN ISLAND	X		
SB	2.227	H	R1-1	30	30			6.25								1		X							MCKEAGE RD TH-32	X		
SIGN SUMMARY SHEET							SHEET TOTALS	~~55.25~~ 60.25 SF	0.00 SF	0 EA	0 EA	0 EA	4 EA	0 EA	0 EA	~~9~~ 11 EA	135 FT											
VERMONT AGENCY OF TRANSPORTATION							TOWN TOTALS	332.4	0.0	2.0	0.0	0.0	50	0.0	0.0	49	735.0											

PROJECT NAME: **Hartford-East Montpelier VT14**
PROJECT NUMBER: **STPG SIGN(21)**

FILE NAME: **Brookfield.xls** PLOT DATE: **6/10/2009**
PROJECT MANAGER: **N. Averv** DRAWN BY: **T. Guazzoni**
DESIGNED BY: **D. Crossley** CHECKED BY: **S. Menard**
BROOKFIELD SHEET 8 SHEET **95** OF **162**

DIRECTION	MILEPOINT	LOCATION CODE (SHEET 2)	SIGN CODE	WIDTH (IN)	HEIGHT (IN)	SHEETING REMARKS	SIGN LEGEND FOR ALL POST LENGTHS AND INSTALLATION DATES SEE ORIGINAL RECORD PLANS	NEW SIGNS "A"	NEW SIGNS "B"	EXISTING SIGNS RETAIN	EXISTING SIGNS SALVAGE FROM	EXISTING SIGNS SALVAGE TO	EXISTING SIGNS REMOVE	EXIST POST RETAIN	EXIST POST REMOVE	NUMBER OF NEW POSTS	SQUARE STEEL (IN) 1.75 (LB / FT) 1.88	SQUARE STEEL (IN) 2.00 (LB / FT) 2.42	SQUARE STEEL (IN) 2.50 (LB / FT) 3.35	TUBULAR STEEL Ø (IN) FOUNDATION	TUBULAR STEEL Ø (IN) 3.00 (LB / FT) 7.60	TUBULAR STEEL Ø (IN) 3.50 (LB / FT) 9.00	TUBULAR STEEL Ø (IN) 4.00 (LB / FT) 10.80	TUBULAR STEEL Ø (IN) 5.00 (LB / FT) 14.60	SIGN FRAME REQUIRED	REMARKS	SIGN DETAIL: DETAIL IN SHS	SIGN DETAIL: DETAIL ON SHEET NUMBER	SIGN DETAIL: DETAIL ON STD SHEET NUMBER
BROOKFIELD VT 14							FY-FLUORESCENT YELLOW FYG-FLUORESCENT YELLOW GREEN																			"SHS"-STANDARD HIGHWAY SIGNS			
SB	0.000	G	VD-024	60	7.5		TOWN LINE SIGN						3 1		X											2 MM PLAQUES SEE NB, PAGE 88			

DIRECTION	MILEPOINT	LOCATION CODE (SHEET 2)	SIGN CODE	WIDTH (IN)	HEIGHT (IN)	SHEETING REMARKS	SIGN LEGEND	NEW SIGNS "A"	NEW SIGNS "B"	EXISTING SIGNS RETAIN	EXISTING SIGNS SALVAGE FROM	EXISTING SIGNS SALVAGE TO	EXISTING SIGNS REMOVE	EXIST POST RETAIN	EXIST POST REMOVE	NUMBER OF NEW POSTS	SQUARE STEEL (IN) 1.75 (LB / FT) 1.88	SQUARE STEEL (IN) 2.00 (LB / FT) 2.42	SQUARE STEEL (IN) 2.50 (LB / FT) 3.35	TUBULAR STEEL Ø (IN) FOUNDATION	TUBULAR STEEL Ø (IN) 3.00 (LB / FT) 7.60	TUBULAR STEEL Ø (IN) 3.50 (LB / FT) 9.00	TUBULAR STEEL Ø (IN) 4.00 (LB / FT) 10.80	TUBULAR STEEL Ø (IN) 5.00 (LB / FT) 14.60	SIGN FRAME REQUIRED	REMARKS	SIGN DETAIL: DETAIL IN SHS	SIGN DETAIL: DETAIL ON SHEET NUMBER	SIGN DETAIL: DETAIL ON STD SHEET NUMBER
WILLIAMSTOWN VT 14							FY-FLUORESCENT YELLOW FYG-FLUORESCENT YELLOW GREEN																			"SHS"-STANDARD HIGHWAY SIGNS			
NB	0.000	A	W1-5	30	30		WINDING RD						1		X														
		A	W13-1	18	18		35 MPH PLAQUE						1																
NB	0.000 TO 0.340	A		6	8		36 WHITE DELINEATORS	12.00								18	X									INSTALL BACK TO BACK AT 100' SPACING, STARTING ACROSS FROM TOWN LINE SIGN		5	
NB	0.785	A	W1-2R	30	30		CURVE RIGHT						1		X														
		A	W13-1	24	24		40 MPH PLAQUE						1																
NB	0.870	A	W1-2R	30	30	FY		6.25								1		X								INSTALL 450 FT +/- NORTH OF EXISTING (TO BE REMOVED)	X		
		A	W13-1	24	24	FY		4.00																			X		
NB	1.210	A	W1-2L	30	30	FY		6.25								1		X								INSTALL ACROSS FROM SB GUARDRAIL TERMINUS	X		
NB	1.445	A	W1-4R	30	30		REVERSE CURVE						1		X														
		A	W13-1	24	24		PLAQUE						1																
NB	1.520	A	W1-4R	30	30			6.25								1		X								INSTALL 80 FT +/- NORTH OF GRAVEL DRIVE	X		
		A	W13-1	24	24			4.00																			X		
NB	1.860	A	W11-2	30	30		PEDESTRIAN						1		X														
		A	W11-7	30	30			6.25								1		X									X		
NB	1.950	A	W11-7	30	30								1		X														
							SHEET TOTALS	45.00	0.00	0	0	0	8	0	0	22		330											
								SF	SF	EA	EA	EA	EA	EA	EA	EA		FT											
							TOWN TOTALS	501.1	0.0	67.0	0.0	0.0	94	0.0	0.0	109		1635.0											









SIGN SUMMARY SHEET

VERMONT AGENCY OF TRANSPORTATION

PROJECT NAME: Hartford-East Montpelier VT14
PROJECT NUMBER: SIGN STPG(21)

FILE NAME: Williamstown.xls
PROJECT MANAGER: N. Avery
DESIGNED BY: A. Gamble
WILLIAMSTOWN SHEET 1

PLOT DATE: 6/18/2009
DRAWN BY: T. Guazzoni
CHECKED BY: S. Menard

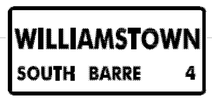
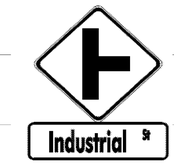
DIRECTION	MILEPOINT	LOCATION CODE (SHEET 2)	SIGN CODE	WIDTH (IN)	HEIGHT (IN)	SHEETING REMARKS	SIGN LEGEND	NEW SIGNS "A"	NEW SIGNS "B"	EXISTING SIGNS RETAIN	EXISTING SIGNS SALVAGE FROM	EXISTING SIGNS SALVAGE TO	EXISTING SIGNS REMOVE	EXIST POST RETAIN	EXIST POST REMOVE	NUMBER OF NEW POSTS	SQUARE STEEL (IN) 1.75 (LB / FT) 1.88	SQUARE STEEL (IN) 2.00 (LB / FT) 2.42	SQUARE STEEL (IN) 2.50 (LB / FT) 3.35	TUBULAR STEEL Ø (IN) FOUNDATION	TUBULAR STEEL Ø (IN) 3.00 (LB / FT) 7.60	TUBULAR STEEL Ø (IN) 3.50 (LB / FT) 9.00	TUBULAR STEEL Ø (IN) 4.00 (LB / FT) 10.80	TUBULAR STEEL Ø (IN) 5.00 (LB / FT) 14.60	SIGN FRAME REQUIRED	REMARKS	SIGN DETAIL: DETAIL IN SHS	SIGN DETAIL: DETAIL ON SHEET NUMBER	SIGN DETAIL: DETAIL ON STD SHEET NUMBER
WILLIAMSTOWN VT 14							FY-FLUORESCENT YELLOW FYG-FLUORESCENT YELLOW GREEN																			"SHS"-STANDARD HIGHWAY SIGNS			
		A	W11-2	30	30	FYG		6.25								1		X									X		
NB	2.195	A	VW-054	30	30		HIDDEN DRIVE RIGHT						1		X											REMOVE AND DO NOT REPLACE HIDDEN DRIVE SIGN			
		A	W11A-2	30	30								1																
		A	W16-2	24	18								1																	
		A	W11-2	30	30	FYG		6.25								1		X									X		
		A	W16-2	24	18	FYG		3.00																			X		
NB	3.365	C	VR-017	24	24								1		X															
		C	VR-017	24	30			5.00								1		X								TH-3, CHELSEA RD			E-141
NB	3.375	D	R1-1	24	24								1		X														
		D	R1-1	30	30			6.25								1		X								TH-3, CHELSEA RD	X		
NB	3.390	A	M3-1	24	12			2.00								1		X								INSTALL 25 FT +/- NORTH OF CHELSEA RD. GREEN ON WHITE	X		
		A	M1-5	24	24			4.00																					E-136B
NB	3.405	A	VW-054R	30	30		HIDDEN DRIVE RIGHT						1		X														
NB	3.425	A	W1-4R	30	30			6.25								2		X								INSTALL 100 FT +/- NORTH OF EXISTING HIDDEN DRIVE SIGN (TO BE REMOVED)	X		
		A	VW-054	30	30			6.25																					E-154
							SHEET TOTALS	45.25 SF	0.00 SF	0 EA	0 EA	0 EA	6 EA	0 EA	0 EA	7 EA		105 FT									
							TOWN TOTALS	501.1	0.0	67.0	0.0	0.0	94	0.0	0.0	109		1635.0									

SIGN SUMMARY SHEET

VERMONT AGENCY OF TRANSPORTATION

PROJECT NAME: **Hartford-East Montpelier VT14**
PROJECT NUMBER: **SIGN STPG(21)**

FILE NAME: **Williamstown.xls** PLOT DATE: **6/18/2009**
PROJECT MANAGER: **N. Averv** DRAWN BY: **T. Guazzoni**
DESIGNED BY: **A. Gamble** CHECKED BY: **S. Menard**
WILLIAMSTOWN SHEET 2 SHEET **98** OF **162**

DIRECTION	MILEPOINT	LOCATION CODE (SHEET 2)	SIGN CODE	WIDTH (IN)	HEIGHT (IN)	SHEETING REMARKS	SIGN LEGEND	NEW SIGNS "A"	NEW SIGNS "B"	EXISTING SIGNS RETAIN	EXISTING SIGNS SALVAGE FROM	EXISTING SIGNS SALVAGE TO	EXISTING SIGNS REMOVE	EXIST POST RETAIN	EXIST POST REMOVE	NUMBER OF NEW POSTS	SQUARE STEEL (IN) 1.75 (LB / FT) 1.88	SQUARE STEEL (IN) 2.00 (LB / FT) 2.42	SQUARE STEEL (IN) 2.50 (LB / FT) 3.35	TUBULAR STEEL Ø (IN) FOUNDATION	TUBULAR STEEL Ø (IN) 3.00 (LB / FT) 7.60	TUBULAR STEEL Ø (IN) 3.50 (LB / FT) 9.00	TUBULAR STEEL Ø (IN) 4.00 (LB / FT) 10.80	TUBULAR STEEL Ø (IN) 5.00 (LB / FT) 14.60	SIGN FRAME REQUIRED	REMARKS	SIGN DETAIL: DETAIL IN SHS	SIGN DETAIL: DETAIL ON SHEET NUMBER	SIGN DETAIL: DETAIL ON STD SHEET NUMBER
WILLIAMSTOWN VT 14							FY-FLUORESCENT YELLOW FYG-FLUORESCENT YELLOW GREEN																			"SHS"-STANDARD HIGHWAY SIGNS			
NB	3.640	A	R2-5A	24	30		REDUCED SPEED AHEAD 						1		X														
		A	W3-5	36	36			9.00								2		X									X		
NB	3.690	A	VD-018	30	18								1		X														
		A	VD-018	30	18			3.75								1		X											E-128B
NB	3.760	A	VW-202	30	30		TRUCKS ENTERING (TEXT) 						1		X														
		A	W2-2aL	30	30			6.25								1		X										6	
		A	W16-8	30	8			1.67																				7	
NB	3.800	A	R2-1	30	36			7.50								1		X									INSTALL 10 FT SOUTH OF UTILITY POLE		6	
NB	3.910	A	R2-1	24	30		SPEED LIMIT 40			1				X															
NB	3.980	A	W11-2	30	30		PEDESTRIAN			1				X															
		A	W16-4	24	18		NEXT 700 FT 						1																
		A	W16-4	24	18	FYG		3.00																				X	
NB	4.020	A	R2-5A	24	30		REDUCED SPEED AHEAD						1		X														
NB	4.066	C	VR-017	24	30		LEGAL LOAD LIMIT 24000 LBS			1				X													BUSINESS CTR RD TH-99			
	4.074	D	R1-1	30	30		STOP			1				X															
SIGN SUMMARY SHEET							SHEET TOTALS	31.17	0.00	4	0	0	5	0	0	5		75									
								SF	SF	EA	EA	EA	EA	EA	EA	EA		FT									
VERMONT AGENCY OF TRANSPORTATION							TOWN TOTALS	501.1	0.0	67.0	0.0	0.0	94	0.0	0.0	109		1635.0									

PROJECT NAME: **Hartford-East Montpelier VT14**
PROJECT NUMBER: **SIGN STPG(21)**

FILE NAME: **Williamstown.xls** PLOT DATE: **6/18/2009**
PROJECT MANAGER: **N. Averv** DRAWN BY: **T. Guazzoni**
DESIGNED BY: **A. Gamble** CHECKED BY: **S. Menard**
WILLIAMSTOWN SHEET 3 SHEET **99** OF **162**

DIRECTION	MILEPOINT	LOCATION CODE (SHEET 2)	SIGN CODE	WIDTH (IN)	HEIGHT (IN)	SHEETING REMARKS	SIGN LEGEND	NEW SIGNS "A"	NEW SIGNS "B"	EXISTING SIGNS RETAIN	EXISTING SIGNS SALVAGE FROM	EXISTING SIGNS SALVAGE TO	EXISTING SIGNS REMOVE	EXIST POST RETAIN	EXIST POST REMOVE	NUMBER OF NEW POSTS	SQUARE STEEL (IN) 1.75 (LB / FT) 1.88	SQUARE STEEL (IN) 2.00 (LB / FT) 2.42	SQUARE STEEL (IN) 2.50 (LB / FT) 3.35	TUBULAR STEEL Ø (IN) FOUNDATION	TUBULAR STEEL Ø (IN) 3.00 (LB / FT) 7.60	TUBULAR STEEL Ø (IN) 3.50 (LB / FT) 9.00	TUBULAR STEEL Ø (IN) 4.00 (LB / FT) 10.80	TUBULAR STEEL Ø (IN) 5.00 (LB / FT) 14.60	SIGN FRAME REQUIRED	REMARKS	SIGN DETAIL: DETAIL IN SHS	SIGN DETAIL: DETAIL ON SHEET NUMBER	SIGN DETAIL: DETAIL ON STD SHEET NUMBER
WILLIAMSTOWN VT 14							FY-FLUORESCENT YELLOW FYG-FLUORESCENT YELLOW GREEN																			"SHS"-STANDARD HIGHWAY SIGNS			
NB	4.150	A	R2-1	24	30								1		X														
		A	R2-1	30	36			7.50								1		X									6	
NB	4.190	A	W11A-2	30	30		PEDESTRIAN						1		X													
NB	4.310	A	W11-8	30	30								1		X													
		A	W11-8	30	30			6.25								1		X									X	
NB	4.370	A	R2-1	24	30								1		X														
		A	R2-1	24	30			5.00								1		X									X	
NB	4.400	A	M2-1	21	15								1		X													
		A	M1-5	24	24								1															
		A	M2-1	21	15			2.19								1		X								GREEN ON WHITE SHEETING	X	
		A	M1-5	24	24			4.00																				E-136B
NB	4.409	C	OM1-1	18	18								1		X													
		C	OM1-1	18	18			2.25								1		X									X	
NB	4.410	C	VR-017	24	24		LEGAL LOAD LIMIT 24000 LBS			1				X												TH-72, DEPOT ST		
NB	4.415	D	R1-1	24	24		STOP			1				X												TH-72, DEPOT ST		
SIGN SUMMARY SHEET							SHEET TOTALS	27.19	0.00	2	0	0	7	0	0	5		75									
								SF	SF	EA	EA	EA	EA	EA	EA	EA		FT									
VERMONT AGENCY OF TRANSPORTATION							TOWN TOTALS	501.1	0.0	67.0	0.0	0.0	94	0.0	0.0	109		1635.0									

PROJECT NAME: **Hartford-East Montpelier VT14**
PROJECT NUMBER: **SIGN STPG(21)**
FILE NAME: **Williamstown.xls** PLOT DATE: **6/18/2009**
PROJECT MANAGER: **N. Avery** DRAWN BY: **T. Guazzoni**
DESIGNED BY: **A. Gamble** CHECKED BY: **S. Menard**
WILLIAMSTOWN SHEET 4 SHEET **100** OF **162**

DIRECTION	MILEPOINT	LOCATION CODE (SHEET 2)	SIGN CODE	WIDTH (IN)	HEIGHT (IN)	SHEETING REMARKS	SIGN LEGEND FOR ALL POST LENGTHS AND INSTALLATION DATES SEE ORIGINAL RECORD PLANS	NEW SIGNS "A"	NEW SIGNS "B"	EXISTING SIGNS RETAIN	EXISTING SIGNS SALVAGE FROM	EXISTING SIGNS SALVAGE TO	EXISTING SIGNS REMOVE	EXIST POST RETAIN	EXIST POST REMOVE	NUMBER OF NEW POSTS	SQUARE STEEL (IN) 1.75 (LB / FT) 1.88	SQUARE STEEL (IN) 2.00 (LB / FT) 2.42	SQUARE STEEL (IN) 2.50 (LB / FT) 3.35	TUBULAR STEEL Ø (IN) FOUNDATION	TUBULAR STEEL Ø (IN) 3.00 (LB / FT) 7.60	TUBULAR STEEL Ø (IN) 3.50 (LB / FT) 9.00	TUBULAR STEEL Ø (IN) 4.00 (LB / FT) 10.80	TUBULAR STEEL Ø (IN) 5.00 (LB / FT) 14.60	SIGN FRAME REQUIRED	REMARKS	SIGN DETAIL DETAIL IN SHS	SIGN DETAIL DETAIL ON SHEET NUMBER	SIGN DETAIL DETAIL ON STD SHEET NUMBER
WILLIAMSTOWN VT 14							FY-FLUORESCENT YELLOW FYG-FLUORESCENT YELLOW GREEN																			"SHS"-STANDARD HIGHWAY SIGNS			
NB	4.440	C	VR-017	24	30		LEGAL LOAD LIMIT 24000 LBS	5.00					1		X	1		X								REMOVED EXISTING TH-71, BECKETT ST			
NB	4.445	D	R1-1	30	30		STOP	6.25					1		X	1		X								REMOVED EXISTING TH-71, BECKETT ST			
NB	4.470	A	D1-1A	72	10		UP ARROW BARRE 6			1				X												RETAIN - ASSEMBLY TO BE REPLACED BY WILLIAMSTOWN BRS0204(4)			
		A	M3-4S	24	12		WEST			1																			
		A	M1-5	24	24		VT 64			1																			
		A	M6-1I	21	15		LEFT ARROW			1																			
		A	M4-5I	24	12		TO			1																			
		A	M1-1	24	24		I-89			1																			
		A	M6-1S	21	15		LEFT ARROW			1																			
		A	M3-1S	24	12		NORTH			1																			
		A	M1-5	24	24		VT 14			1																			
		A	M6-3S	21	15		UP ARROW			1																			
NB	4.480	C	D1-1	72	10		<--- SOUTH BARRE			1				X												RETAIN - ASSEMBLY TO BE REPLACED BY WILLIAMSTOWN BRS0204(4)			
			D1-1	72	10		BROOKFIELD ---.			1																			
			M3-1	24	12		NORTH			1																			
SIGN SUMMARY SHEET							SHEET TOTALS	11.25	0.00	13	0	0	~~0~~ 2	0	0	2			30								
								SF	SF	EA	EA	EA	EA	EA	EA	EA			FT								
VERMONT AGENCY OF TRANSPORTATION							TOWN TOTALS	501.1	0.0	67.0	0.0	0.0	94	0.0	0.0	109			1635.0								

PROJECT NAME: **Hartford-East Montpelier VT14**
PROJECT NUMBER: **SIGN STPG(21)**

FILE NAME: **Williamstown.xls** PLOT DATE: **6/18/2009**
PROJECT MANAGER: **N. Averv** DRAWN BY: **T. Guazzoni**
DESIGNED BY: **A. Gamble** CHECKED BY: **S. Menard**
WILLIAMSTOWN SHEET 5 SHEET **101** OF **162**

DIRECTION	MILEPOINT	LOCATION CODE (SHEET 2)	SIGN CODE	WIDTH (IN)	HEIGHT (IN)	SHEETING REMARKS	SIGN LEGEND FOR ALL POST LENGTHS AND INSTALLATION DATES SEE ORIGINAL RECORD PLANS	NEW SIGNS "A"	NEW SIGNS "B"	EXISTING SIGNS RETAIN	EXISTING SIGNS SALVAGE FROM	EXISTING SIGNS SALVAGE TO	EXISTING SIGNS REMOVE	EXIST POST RETAIN	EXIST POST REMOVE	NUMBER OF NEW POSTS	SQUARE STEEL (IN) 1.75 (LB / FT) 1.88	SQUARE STEEL (IN) 2.00 (LB / FT) 2.42	SQUARE STEEL (IN) 2.50 (LB / FT) 3.35	TUBULAR STEEL Ø (IN) FOUNDATION	TUBULAR STEEL Ø (IN) 3.00 (LB / FT) 7.60	TUBULAR STEEL Ø (IN) 3.50 (LB / FT) 9.00	TUBULAR STEEL Ø (IN) 4.00 (LB / FT) 10.80	TUBULAR STEEL Ø (IN) 5.00 (LB / FT) 14.60	SIGN FRAME REQUIRED	REMARKS	SIGN DETAIL: DETAIL IN SHS	SIGN DETAIL: DETAIL ON SHEET NUMBER	SIGN DETAIL: DETAIL ON STD SHEET NUMBER
WILLIAMSTOWN VT 14							FY-FLUORESCENT YELLOW FYG-FLUORESCENT YELLOW GREEN																			"SHS"-STANDARD HIGHWAY SIGNS			
			M1-5	24	24		VERMONT 14			1																		
			M6-1 L	21	15		<---			1																		
			M3-3	24	12		SOUTH			1																		
			M1-5	24	24		VERMONT 14			1																		
			M6-1 R	21	15		--->																					
NB	4.490	A	W11-2	30	30		PEDESTRIAN						1		X													
NB	4.515	A	D1-1	54	7.5								1		X													
		A	D1-1A	72	12		GRANITEVILLE 4	6.00								2	X										6	
NB	4.540	C	VR-017	24	30		LEGAL LOAD LIMIT 24000 LBS			1				X													TH-1, MEADOW ST			
NB	4.550	C	R4-7	24	30								1		X													
		C	OM1-1	18	18								~~1~~ 0															
		C	R4-7	24	30			5.00								1	X										ISLAND ON MEADOW ST, PARALLEL TO VT 14	X		
		C	OM1-1	18	18			~~2.25~~ 2.25					1														PAINTBALL DAMAGE REDO	X		
NB	4.560	D	R1-1	30	30		STOP			1				X													TH-1, MEADOW ST			
NB	4.565	A	M3-1	24	12								1		X													
							SHEET TOTALS	~~13.25~~ 15.50 SF	0.00 SF	6 EA	0 EA	0 EA	5 EA	0 EA	0 EA	3 EA	45 FT												
							TOWN TOTALS	501.1	0.0	67.0	0.0	0.0	94	0.0	0.0	109	1635.0												

SIGN SUMMARY SHEET

VERMONT AGENCY OF TRANSPORTATION

PROJECT NAME: **Hartford-East Montpelier VT14**
PROJECT NUMBER: **SIGN STPG(21)**

FILE NAME: **Williamstown.xls** PLOT DATE: **6/18/2009**
PROJECT MANAGER: **N. Averv** DRAWN BY: **T. Guazzoni**
DESIGNED BY: **A. Gamble** CHECKED BY: **S. Menard**
WILLIAMSTOWN SHEET 6 SHEET **102** OF **162**

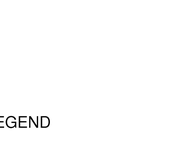
DIRECTION	MILEPOINT	LOCATION CODE (SHEET 2)	SIGN CODE	WIDTH (IN)	HEIGHT (IN)	SHEETING REMARKS	SIGN LEGEND	NEW SIGNS "A"	NEW SIGNS "B"	EXISTING SIGNS RETAIN	EXISTING SIGNS SALVAGE FROM	EXISTING SIGNS SALVAGE TO	EXISTING SIGNS REMOVE	EXIST POST RETAIN	EXIST POST REMOVE	NUMBER OF NEW POSTS	SQUARE STEEL (IN) 1.75 (LB / FT) 1.88	SQUARE STEEL (IN) 2.00 (LB / FT) 2.42	SQUARE STEEL (IN) 2.50 (LB / FT) 3.35	TUBULAR STEEL Ø (IN) FOUNDATION	TUBULAR STEEL Ø (IN) 3.00 (LB / FT) 7.60	TUBULAR STEEL Ø (IN) 3.50 (LB / FT) 9.00	TUBULAR STEEL Ø (IN) 4.00 (LB / FT) 10.80	TUBULAR STEEL Ø (IN) 5.00 (LB / FT) 14.60	SIGN FRAME REQUIRED	REMARKS	SIGN DETAIL: DETAIL IN SHS	SIGN DETAIL: DETAIL ON SHEET NUMBER	SIGN DETAIL: DETAIL ON STD SHEET NUMBER
WILLIAMSTOWN VT 14							FY-FLUORESCENT YELLOW FYG-FLUORESCENT YELLOW GREEN																			"SHS"-STANDARD HIGHWAY SIGNS			
		A	M1-5	24	24								1																
		A	M3-1	24	12			2.00								1		X								GREEN ON WHITE SHEETING	X		
		A	M1-5	24	24			4.00																					E-136B
NB	4.585	A	R2-1	24	30								1		X															
		A	R2-1	24	30			5.00								1		X										X	
NB	4.715	A	W1-3L	30	30		REVERSE TURN						1		X														
		A	W13-1	18	18		30 MPH PLAQUE 						1																
NB	4.780	A	W1-3L	30	30			6.25								1		X									INSTALL 20 FT +/- NORTH OF BREAK IN GUARDRAIL	X		
		A	W13-1	18	18			2.25																				X	
NB	4.790	C	VR-017	24	24		LEGAL LOAD LIMIT 24000 LBS			1				X													TH 25, CIRCLE ST			
NB	4.800	D	R1-1	24	24		STOP			1				X													TH 25, CIRCLE ST			
NB	4.900	A	R2-1	24	30								1		X															
		A	R2-1	24	30			5.00								1		X										X	
NB	5.380	C	VR-017	24	30		LEGAL LOAD LIMIT 24000 LBS			1				X													TH-12, BROCKWAY RD			
NB	5.390	D	R1-1	30	30		STOP			1				X													TH-12, BROCKWAY RD			
							SHEET TOTALS	24.50	0.00	4	0	0	5	0	0	4		60											
								SF	SF	EA	EA	EA	EA	EA	EA	EA		FT											
							TOWN TOTALS	501.1	0.0	67.0	0.0	0.0	94	0.0	0.0	109		1635.0											

SIGN SUMMARY SHEET

VERMONT AGENCY OF TRANSPORTATION

PROJECT NAME: **Hartford-East Montpelier VT14**
PROJECT NUMBER: **SIGN STPG(21)**

FILE NAME: **Williamstown.xls** PLOT DATE: **6/18/2009**
PROJECT MANAGER: **N. Avery** DRAWN BY: **T. Guazzoni**
DESIGNED BY: **A. Gamble** CHECKED BY: **S. Menard**
WILLIAMSTOWN SHEET 7 SHEET **103** OF **162**

DIRECTION	MILEPOINT	LOCATION CODE (SHEET 2)	SIGN CODE	WIDTH (IN)	HEIGHT (IN)	SHEETING REMARKS	SIGN LEGEND	NEW SIGNS "A"	NEW SIGNS "B"	EXISTING SIGNS RETAIN	EXISTING SIGNS SALVAGE FROM	EXISTING SIGNS SALVAGE TO	EXISTING SIGNS REMOVE	EXIST POST RETAIN	EXIST POST REMOVE	NUMBER OF NEW POSTS	SQUARE STEEL (IN) 1.75 (LB / FT) 1.88	SQUARE STEEL (IN) 2.00 (LB / FT) 2.42	SQUARE STEEL (IN) 2.50 (LB / FT) 3.35	TUBULAR STEEL Ø (IN) FOUNDATION	TUBULAR STEEL Ø (IN) 3.00 (LB / FT) 7.60	TUBULAR STEEL Ø (IN) 3.50 (LB / FT) 9.00	TUBULAR STEEL Ø (IN) 4.00 (LB / FT) 10.80	TUBULAR STEEL Ø (IN) 5.00 (LB / FT) 14.60	SIGN FRAME REQUIRED	REMARKS	SIGN DETAIL: DETAIL IN SHS	SIGN DETAIL: DETAIL ON SHEET NUMBER	SIGN DETAIL: DETAIL ON STD SHEET NUMBER
WILLIAMSTOWN VT 14							FY-FLUORESCENT YELLOW FYG-FLUORESCENT YELLOW GREEN																			"SHS"-STANDARD HIGHWAY SIGNS			
NB	5.650	C	VR-023B	30	30		$500 FINE/TRASH						1		X											GRAVEL PULLOUT			
NB	6.090	C	VR-017	24	30		LEGAL LOAD LIMIT 24000 LBS			1				X												TH-89, HULBERT RD			
NB	6.100	D	R1-1	30	30		STOP			1				X												TH-89, HULBERT RD			
NB	6.410	C	VR-017	24	30		LEGAL LOAD LIMIT 24000 LBS			1				X												TH-75, FARNHAM RD			
NB	6.420	D	R1-1	30	30		STOP			1				X												TH-75, FARNHAM RD			
NB	6.550	A	W11-10	30	30		TRUCK ENTERING SYMBOL			1				X												ASSEMBLY HAS SOLAR FLASHING BEACON ATTACHED			
		A	S4-4M	24	10		WHEN FLASHING (YELLOW BKGRND)			1																			
NB	6.670	A	R2-5A	24	30		REDUCED SPEED AHEAD 						1		X															
NB	6.695	A	W3-5	36	36			9.00								2		X								INSTALL 20 FT BEYOND PIKE DRIVEWAY, 10 FT SOUTH OF UTILITY POLE	X		
NB	6.725	A	W1-2MbR	30	30			6.25								2		X								INSTALL 200 FT +/- NORTH OF SPEED REDUCTION WARNING SIGN.		6	
		A	S3-1	30	30			6.25																			X		
NB	6.740	A	S3-1	30	30		SCHOOL BUS STOP AHEAD						1		X															
NB	6.750	A	W2-2R	30	30		SIDE ROAD RIGHT						1		X															
NB	6.805	A	R2-1	24	30								1		X															
		A	R2-1	24	30			5.00								1		X									X		
							SHEET TOTALS	26.50 SF	0.00 SF	6 EA	0 EA	0 EA	5 EA	0 EA	0 EA	5 EA		75 FT											
							TOWN TOTALS	501.1	0.0	67.0	0.0	0.0	94	0.0	0.0	109		1635.0											

SIGN SUMMARY SHEET

VERMONT AGENCY OF TRANSPORTATION

PROJECT NAME: **Hartford-East Montpelier VT14**
PROJECT NUMBER: **SIGN STPG(21)**

FILE NAME: **Williamstown.xls** PLOT DATE: **6/18/2009**
PROJECT MANAGER: **N. Avery** DRAWN BY: **T. Guazzoni**
DESIGNED BY: **A. Gamble** CHECKED BY: **S. Menard**
WILLIAMSTOWN SHEET 8 SHEET **104** OF **162**

DIRECTION	MILEPOINT	LOCATION CODE (SHEET 2)	SIGN CODE	WIDTH (IN)	HEIGHT (IN)	SHEETING REMARKS	SIGN LEGEND FOR ALL POST LENGTHS AND INSTALLATION DATES SEE ORIGINAL RECORD PLANS	NEW SIGNS "A"	NEW SIGNS "B"	EXISTING SIGNS RETAIN	EXISTING SIGNS SALVAGE FROM	EXISTING SIGNS SALVAGE TO	EXISTING SIGNS REMOVE	EXIST POST RETAIN	EXIST POST REMOVE	NUMBER OF NEW POSTS	SQUARE STEEL (IN) (LB / FT) 1.75 / 1.88	SQUARE STEEL (IN) (LB / FT) 2.00 / 2.42	SQUARE STEEL (IN) (LB / FT) 2.50 / 3.35	TUBULAR STEEL Ø (IN) FOUNDATION	TUBULAR STEEL Ø (IN) (LB / FT) 3.00 / 7.60	TUBULAR STEEL Ø (IN) (LB / FT) 3.50 / 9.00	TUBULAR STEEL Ø (IN) (LB / FT) 4.00 / 10.80	TUBULAR STEEL Ø (IN) (LB / FT) 5.00 / 14.60	SIGN FRAME REQUIRED	REMARKS	SIGN DETAIL: DETAIL IN SHS	SIGN DETAIL: DETAIL ON SHEET NUMBER	SIGN DETAIL: DETAIL ON STD SHEET NUMBER
WILLIAMSTOWN VT 14							FY-FLUORESCENT YELLOW FYG-FLUORESCENT YELLOW GREEN																			"SHS"-STANDARD HIGHWAY SIGNS			
SB	6.820	F	R2-1	24	30								1		X													
		F	R2-1	24	30			5.00								1		X									X	
SB	6.700	G	W1-7	36	18		DOUBLE ARROW			1				X												ACROSS FROM PIKE DRIVEWAY			
SB	5.795	G	VR-017	24	30		LEGAL LOAD LIMIT 24000 LBS			1				X												TH-8, FALLS BRIDGE RD			
SB	5.785	H	R1-1	30	30		STOP			1				X												TH-8, FALLS BRIDGE RD			
SB	5.730	F	VW-059	30	30		HIDDEN DRIVE 						1		X															
		F	VW-054	30	30			6.25								1		X										E-154
SB	5.350	F	VW-054	30	30		HIDDEN DRIVE LEFT						1		X													
SB	5.320	G	VR-017	24	30		LEGAL LOAD LIMIT 24000 LBS	5.00		1				X		1										MISSING SIGN & POST TH 104, SOUCY LANE			
SB	5.315	H	R1-1	30	30		STOP			1				X												TH 104, SOUCY LANE			
SB	5.310	F	VW-054	30	30			6.25								1		X								INSTALL 185' +/- SOUTH OF HIDDEN DRIVE LEFT SIGN TO BE REMOVED. BEHIND GUARD RAIL			E-154
SB	5.200	G	VR-017	24	30		LEGAL LOAD LIMIT 24000 LBS			1				X												TH-55, OLD TOWN RD			
SB	5.190	H	R1-1	30	30		STOP			1				X												TH-55, OLD TOWN RD			
SB	5.080	F	R2-5A	30	30		REDUCED SPEED AHEAD						1		X													
SB	5.040	F	W1-5R	30	30		WINDING RD						1		X													
							SHEET TOTALS	~~17.50~~ 22.50	0.00	7	0	0	5	0	0	~~3~~ 4	45										
								SF	SF	EA	EA	EA	EA	EA	EA	EA	FT										
							TOWN TOTALS	501.1	0.0	67.0	0.0	0.0	94	0.0	0.0	109	1635.0										

SIGN SUMMARY SHEET

VERMONT AGENCY OF TRANSPORTATION

PROJECT NAME: **Hartford-East Montpelier VT14**
PROJECT NUMBER: **SIGN STPG(21)**

FILE NAME: **Williamstown.xls**
PROJECT MANAGER: **N. Averv**
DESIGNED BY: **A. Gamble**
WILLIAMSTOWN SHEET 9

PLOT DATE: **6/18/2009**
DRAWN BY: **T. Guazzoni**
CHECKED BY: **S. Menard**
SHEET **105** OF **162**

DIRECTION	MILEPOINT	LOCATION CODE (SHEET 2)	SIGN CODE	WIDTH (IN)	HEIGHT (IN)	SHEETING REMARKS	SIGN LEGEND	NEW SIGNS "A"	NEW SIGNS "B"	EXISTING SIGNS RETAIN	EXISTING SIGNS SALVAGE FROM	EXISTING SIGNS SALVAGE TO	EXISTING SIGNS REMOVE	EXIST POST RETAIN	EXIST POST REMOVE	NUMBER OF NEW POSTS	SQUARE STEEL (IN) 1.75 (LB / FT) 1.88	SQUARE STEEL (IN) 2.00 (LB / FT) 2.42	SQUARE STEEL (IN) 2.50 (LB / FT) 3.35	TUBULAR STEEL Ø (IN) FOUNDATION	TUBULAR STEEL Ø (IN) 3.00 (LB / FT) 7.60	TUBULAR STEEL Ø (IN) 3.50 (LB / FT) 9.00	TUBULAR STEEL Ø (IN) 4.00 (LB / FT) 10.80	TUBULAR STEEL Ø (IN) 5.00 (LB / FT) 14.60	SIGN FRAME REQUIRED	REMARKS	SIGN DETAIL: DETAIL IN SHS	SIGN DETAIL: DETAIL ON SHEET NUMBER	SIGN DETAIL: DETAIL ON STD SHEET NUMBER
WILLIAMSTOWN VT 14							FY-FLUORESCENT YELLOW FYG-FLUORESCENT YELLOW GREEN																			"SHS"-STANDARD HIGHWAY SIGNS			
		F	W13-1	18	18		30 MPH PLAQUE 						1															
		F	W3-5	36	36			9.00								2		X									X		
SB	5.000	F	VD-018	30	18			3.75								1		X								INSTALL 200 FT +/- SOUTH OF SPEED REDUCTION WARNING SIGN			E-128B
SB	4.960	F	VW-054	30	30								1		X													
		F	W1-3L	30	30								1															
		F	W13-1	18	18								1															
		F	VW-054	30	30			6.25								2		X										E-154
		F	W1-3L	30	30			6.25																			X		
		F	W13-1	18	18			2.25																		INSTALL PLAQUE ON LEFT POST	X		
SB	4.920	F	R2-1	24	30								1		X															
		F	R2-1	30	36			7.50								1		X										6	
SB	4.810	F	R2-1	24	30								1		X															
		F	R2-1	24	30			5.00								1		X									X		
SB	4.760	F	W1-4R	30	30		REVERSE CURVE						1		X														
		F	W13-1	18	18		30 MPH PLAQUE						1																
							SHEET TOTALS	40.00 SF	0.00 SF	0 EA	0 EA	0 EA	8 EA	0 EA	0 EA	7 EA		105 FT										
							TOWN TOTALS	501.1	0.0	67.0	0.0	0.0	94	0.0	0.0	109		1635.0										

SIGN SUMMARY SHEET

VERMONT AGENCY OF TRANSPORTATION

PROJECT NAME: **Hartford-East Montpelier VT14**
PROJECT NUMBER: **SIGN STPG(21)**

FILE NAME: **Williamstown.xls** PLOT DATE: **6/18/2009**
PROJECT MANAGER: **N. Averv** DRAWN BY: **T. Guazzoni**
DESIGNED BY: **A. Gamble** CHECKED BY: **S. Menard**
WILLIAMSTOWN SHEET 10 SHEET **106** OF **162**

DIRECTION	MILEPOINT	LOCATION CODE (SHEET 2)	SIGN CODE	WIDTH (IN)	HEIGHT (IN)	SHEETING REMARKS	SIGN LEGEND	NEW SIGNS "A"	NEW SIGNS "B"	EXISTING SIGNS RETAIN	EXISTING SIGNS SALVAGE FROM	EXISTING SIGNS SALVAGE TO	EXISTING SIGNS REMOVE	EXIST POST RETAIN	EXIST POST REMOVE	NUMBER OF NEW POSTS	SQUARE STEEL (IN) 1.75 (LB / FT) 1.88	SQUARE STEEL (IN) 2.00 (LB / FT) 2.42	SQUARE STEEL (IN) 2.50 (LB / FT) 3.35	TUBULAR STEEL Ø (IN) FOUNDATION	TUBULAR STEEL Ø (IN) 3.00 (LB / FT) 7.60	TUBULAR STEEL Ø (IN) 3.50 (LB / FT) 9.00	TUBULAR STEEL Ø (IN) 4.00 (LB / FT) 10.80	TUBULAR STEEL Ø (IN) 5.00 (LB / FT) 14.60	SIGN FRAME REQUIRED	REMARKS	SIGN DETAIL: DETAIL IN SHS	SIGN DETAIL: DETAIL ON SHEET NUMBER	SIGN DETAIL: DETAIL ON STD SHEET NUMBER
WILLIAMSTOWN VT 14							FY-FLUORESCENT YELLOW FYG-FLUORESCENT YELLOW GREEN																			"SHS"-STANDARD HIGHWAY SIGNS			
SB	4.710	G	VR-017	24	30		LEGAL LOAD LIMIT 24,000 LBS			1				X												TH-78, ELM ST			
SB	4.705	H	R1-1	30	30		STOP			1				X												TH-78, ELM ST			
SB	4.700	A	W11-2	30	30		PEDESTRIAN 						1		X														
		A	W1-4R	30	30			6.25								1		X									X		
SB	4.610	F	M2-1	21	15		JCT						1		X														
		F	M1-5	24	24		VERMONT 64 						1																
SB	4.595	F	W11-2	30	30	FYG		6.25								1		X								INSTALL 75 FT +/- SOUTH OF JCT VT 64 (TO BE REMOVED)	X		
SB	4.590	F	D1-1	54	7.5		<--- GRANITEVILLE						1		X														
SB	4.570	G	VR-017	24	30		LEGAL LOAD LIMIT 24000			1				X												TH-24, CONSTRUCTION HILL RD			
SB	4.580	H	R1-1	30	30		STOP			1				X												TH-24, CONSTRUCTION HILL RD			
SB	4.575	F	M2-1	21	15		JCT VERMONT 64 	2.19								1		X								GREEN ON WHITE SHEETING. INSTALL 10' SOUTH OF CONSTRUCTION HILL RD	X		
		F	M1-5	24	24			4.00																				E-136B
SB	4.565	F	W11-8	30	30								1		X														
		F	W11-8	30	30			6.25								1		X									X		
SB	4.520	F	D1-1A	72	10		UP ARROW E BROOKFIELD 8			1				X												RETAIN - ASSEMBLY TO BE REPLACED BY WILLIAMSTOWN BRS0204(4)			
							SHEET TOTALS	24.94 SF	0.00 SF	5 EA	0 EA	0 EA	5 EA	0 EA	0 EA	4 EA			60 FT							
							TOWN TOTALS	501.1	0.0	67.0	0.0	0.0	94	0.0	0.0	109			1635.0							

SIGN SUMMARY SHEET

VERMONT AGENCY OF TRANSPORTATION

PROJECT NAME: **Hartford-East Montpelier VT14**
PROJECT NUMBER: **SIGN STPG(21)**

FILE NAME: **Williamstown.xls**
PROJECT MANAGER: **N. Avery**
DESIGNED BY: **A. Gamble**
WILLIAMSTOWN SHEET 11

PLOT DATE: **6/18/2009**
DRAWN BY: **T. Guazzoni**
CHECKED BY: **S. Menard**
SHEET **107** OF **162**

DIRECTION	MILEPOINT	LOCATION CODE (SHEET 2)	SIGN CODE	WIDTH (IN)	HEIGHT (IN)	SHEETING REMARKS	SIGN LEGEND	NEW SIGNS "A"	NEW SIGNS "B"	EXISTING SIGNS RETAIN	EXISTING SIGNS SALVAGE FROM	EXISTING SIGNS SALVAGE TO	EXISTING SIGNS REMOVE	EXIST POST RETAIN	EXIST POST REMOVE	NUMBER OF NEW POSTS	SQUARE STEEL (IN) 1.75 (LB / FT) 1.88	SQUARE STEEL (IN) 2.00 (LB / FT) 2.42	SQUARE STEEL (IN) 2.50 (LB / FT) 3.35	TUBULAR STEEL Ø (IN) FOUNDATION	TUBULAR STEEL Ø (IN) 3.00 (LB / FT) 7.60	TUBULAR STEEL Ø (IN) 3.50 (LB / FT) 9.00	TUBULAR STEEL Ø (IN) 4.00 (LB / FT) 10.80	TUBULAR STEEL Ø (IN) 5.00 (LB / FT) 14.60	SIGN FRAME REQUIRED	REMARKS	SIGN DETAIL: DETAIL IN SHS	SIGN DETAIL: DETAIL ON SHEET NUMBER	SIGN DETAIL: DETAIL ON STD SHEET NUMBER
WILLIAMSTOWN VT 14							FY-FLUORESCENT YELLOW FYG-FLUORESCENT YELLOW GREEN																			"SHS"-STANDARD HIGHWAY SIGNS			
		F	M3-3S	24	12		SOUTH			1																		
		F	M1-5	24	24		VT 14			1																		
		F	M6-3S	21	15		UP ARROW			1																		
		F	M4-5I	24	12		TO			1																		
		F	M1-1	24	24		I-89			1																		
		F	M6-1	21	15		RIGHT ARROW			1																		
		F	M3-4S	24	12		WEST			1																		
		F	M1-5	24	24		VT 64			1																		
		F	M6-1S	21	15		RIGHT ARROW			1																		
SB	4.510	F	VR-345	24	30		NO PARKING HERE TO CORNER 						1		X														
		F	R8-3A	24	24			4.00								1		X								X		
		F	R8-3cM	24	18			3.00																			5	
SB	4.470	F	R2-1	24	30								1		X														
		F	R2-1	24	30			5.00								1		X								X		
SB	4.450	F	M3-3	24	12								1		X													
							SHEET TOTALS	12.00 SF	0.00 SF	9 EA	0 EA	0 EA	3 EA	0 EA	0 EA	2 EA		30 FT										
							TOWN TOTALS	501.1	0.0	67.0	0.0	0.0	94	0.0	0.0	109		1635.0										

SIGN SUMMARY SHEET

VERMONT AGENCY OF TRANSPORTATION

PROJECT NAME: **Hartford-East Montpelier VT14**
PROJECT NUMBER: **SIGN STPG(21)**

FILE NAME: **Williamstown.xls** PLOT DATE: **6/18/2009**
PROJECT MANAGER: **N. Avery** DRAWN BY: **T. Guazzoni**
DESIGNED BY: **A. Gamble** CHECKED BY: **S. Menard**
WILLIAMSTOWN SHEET 12 SHEET **108** OF **162**

DIRECTION	MILEPOINT	LOCATION CODE (SHEET 2)	SIGN CODE	WIDTH (IN)	HEIGHT (IN)	SHEETING REMARKS	SIGN LEGEND	NEW SIGNS "A"	NEW SIGNS "B"	EXISTING SIGNS RETAIN	EXISTING SIGNS SALVAGE FROM	EXISTING SIGNS SALVAGE TO	EXISTING SIGNS REMOVE	EXIST POST RETAIN	EXIST POST REMOVE	NUMBER OF NEW POSTS	SQUARE STEEL (IN) 1.75 (LB / FT) 1.88	SQUARE STEEL (IN) 2.00 (LB / FT) 2.42	SQUARE STEEL (IN) 2.50 (LB / FT) 3.35	FOUNDATION	TUBULAR STEEL Ø (IN) 3.00 (LB / FT) 7.60	TUBULAR STEEL Ø (IN) 3.50 (LB / FT) 9.00	TUBULAR STEEL Ø (IN) 4.00 (LB / FT) 10.80	TUBULAR STEEL Ø (IN) 5.00 (LB / FT) 14.60	SIGN FRAME REQUIRED	REMARKS	SIGN DETAIL: DETAIL IN SHS	SIGN DETAIL: DETAIL ON SHEET NUMBER	SIGN DETAIL: DETAIL ON STD SHEET NUMBER
WILLIAMSTOWN VT 14							FY-FLUORESCENT YELLOW FYG-FLUORESCENT YELLOW GREEN																			"SHS"-STANDARD HIGHWAY SIGNS			
		F	M1-5	24	24								1															
		F	M3-3	24	12			2.00								1		X								GREEN ON WHITE SHEETING	X		
		F	M1-5	24	24			4.00																				E-136B
SB	4.430	G	VR-017	24	30		LEGAL LOAD LIMIT 24000 LBS			1				X												TH-73, GARDEN ST			
SB	4.420	H	R1-1	30	30		STOP			1				X												TH-73, GARDEN ST			
SB	4.420	F	R8-3A	24	24								1		X													
		F	VR-644P	24	12								1															
		F	R8-3A	24	24			4.00								1		X									X	
		F	VR-644P	24	12			2.00																		RED ON WHITE SHEETING		6
SB	4.400	F	R8-3A	24	24								1		X													
		F	M4-6	24	12								1															
		F	R8-3A	24	24			4.00								1		X									X	
		F	M4-6	24	12			2.00																		RED ON WHITE SHEETING	X		
SB	4.360	F	R2-1	24	30								1		X														
		F	R2-1	24	30			5.00								1		X									X	
SIGN SUMMARY SHEET							SHEET TOTALS	23.00	0.00	2	0	0	6	0	0	4		60									
								SF	SF	EA	EA	EA	EA	EA	EA	EA		FT									
VERMONT AGENCY OF TRANSPORTATION							TOWN TOTALS	501.1	0.0	67.0	0.0	0.0	94	0.0	0.0	109		1635.0									

PROJECT NAME: **Hartford-East Montpelier VT14**
PROJECT NUMBER: **SIGN STPG(21)**
FILE NAME: **Williamstown.xls** PLOT DATE: **6/18/2009**
PROJECT MANAGER: **N. Avery** DRAWN BY: **T. Guazzoni**
DESIGNED BY: **A. Gamble** CHECKED BY: **S. Menard**
WILLIAMSTOWN SHEET 13 SHEET **109** OF **162**

DIRECTION	MILEPOINT	LOCATION CODE (SHEET 2)	SIGN CODE	WIDTH (IN)	HEIGHT (IN)	SHEETING REMARKS	SIGN LEGEND	NEW SIGNS "A"	NEW SIGNS "B"	EXISTING SIGNS RETAIN	EXISTING SIGNS SALVAGE FROM	EXISTING SIGNS SALVAGE TO	EXISTING SIGNS REMOVE	EXIST POST RETAIN	EXIST POST REMOVE	NUMBER OF NEW POSTS	SQUARE STEEL (IN) 1.75 (LB / FT) 1.88	SQUARE STEEL (IN) 2.00 (LB / FT) 2.42	SQUARE STEEL (IN) 2.50 (LB / FT) 3.35	TUBULAR STEEL Ø (IN) FOUNDATION	TUBULAR STEEL Ø (IN) 3.00 (LB / FT) 7.60	TUBULAR STEEL Ø (IN) 3.50 (LB / FT) 9.00	TUBULAR STEEL Ø (IN) 4.00 (LB / FT) 10.80	TUBULAR STEEL Ø (IN) 5.00 (LB / FT) 14.60	SIGN FRAME REQUIRED	REMARKS	SIGN DETAIL DETAIL IN SHS	SIGN DETAIL DETAIL ON SHEET NUMBER	SIGN DETAIL DETAIL ON STD SHEET NUMBER
WILLIAMSTOWN VT 14							FY-FLUORESCENT YELLOW FYG-FLUORESCENT YELLOW GREEN																			"SHS"-STANDARD HIGHWAY SIGNS			
SB	4.305	G	VR-017	24	30		LEGAL LOAD LIMIT 24000			1				X												TH-39, PLEASANT ST			
SB	4.295	H	R1-1	30	30		STOP			1				X												TH-39, PLEASANT ST			
SB	4.240	F	W11-6H	30	30								1		X														
		F	W11-6H	30	30			6.25								1		X								INSTALL IN CLOSED POSITION			E-153
SB	4.195	G	VR-017	24	30		LEGAL LOAD LIMIT 24000			1				X												TH-40, SPIDER WEB FARM RD			
SB	4.190	H	R1-1	30	30		STOP			1				X												TH-40, SPIDER WEB FARM RD			
SB	4.150	F	R2-1	24	30								1		X															
		F	R2-1	24	30			5.00								1		X								INSTALL BEHIND SOUTH END OF GUARDRAIL		X	
SB	4.110	F	W11-2YG	30	30		PEDESTRIAN			1				X															
SB	4.110	F	W16-4YG	24	18		NEXT 700 FEET			1																			
SB	4.040	F	R2-1	24	30								1		X															
		F	R2-1	24	30			5.00								1		X										X	
SB	3.990	A	VW-202	30	30		TRUCKS ENTERING (TEXT)						1		X														
SB	3.915	G	VR-017	24	30		LEGAL LOAD LIMIT 24000 LBS			1				X												TH-100, INDUSTRY ST			
SB	3.910	H	R1-1	30	30		STOP			1				X												TH-100, INDUSTRY ST			
SIGN SUMMARY SHEET							SHEET TOTALS	16.25	0.00	8	0	0	4	0	0	3		45									
								SF	SF	EA	EA	EA	EA	EA	EA	EA		FT									
VERMONT AGENCY OF TRANSPORTATION							TOWN TOTALS	501.1	0.0	67.0	0.0	0.0	94	0.0	0.0	109		1635.0									

PROJECT NAME: **Hartford-East Montpelier VT14**
PROJECT NUMBER: **SIGN STPG(21)**

FILE NAME: **Williamstown.xls** PLOT DATE: **6/18/2009**
PROJECT MANAGER: **N. Averv** DRAWN BY: **T. Guazzoni**
DESIGNED BY: **A. Gamble** CHECKED BY: **S. Menard**
WILLIAMSTOWN SHEET 14 SHEET **110** OF **162**

DIRECTION	MILEPOINT	LOCATION CODE (SHEET 2)	SIGN CODE	WIDTH (IN)	HEIGHT (IN)	SHEETING REMARKS	SIGN LEGEND FOR ALL POST LENGTHS AND INSTALLATION DATES SEE ORIGINAL RECORD PLANS	NEW SIGNS "A"	NEW SIGNS "B"	EXISTING SIGNS RETAIN	EXISTING SIGNS SALVAGE FROM	EXISTING SIGNS SALVAGE TO	EXISTING SIGNS REMOVE	EXIST POST RETAIN	EXIST POST REMOVE	NUMBER OF NEW POSTS	SQUARE STEEL (IN) 1.75 (LB / FT) 1.88	SQUARE STEEL (IN) 2.00 (LB / FT) 2.42	SQUARE STEEL (IN) 2.50 (LB / FT) 3.35	TUBULAR STEEL Ø (IN) FOUNDATION	TUBULAR STEEL Ø (IN) 3.00 (LB / FT) 7.60	TUBULAR STEEL Ø (IN) 3.50 (LB / FT) 9.00	TUBULAR STEEL Ø (IN) 4.00 (LB / FT) 10.80	TUBULAR STEEL Ø (IN) 5.00 (LB / FT) 14.60	SIGN FRAME REQUIRED	REMARKS	SIGN DETAIL DETAIL IN SHS	SIGN DETAIL DETAIL ON SHEET NUMBER	SIGN DETAIL DETAIL ON STD SHEET NUMBER
WILLIAMSTOWN VT 14							FY-FLUORESCENT YELLOW FYG-FLUORESCENT YELLOW GREEN																			"SHS"-STANDARD HIGHWAY SIGNS			
SB	3.800	F	R2-1	24	30			5.00								1		X								INSTALL ACROSS FROM NB 40 MPH SIGN, BEHIND NORTH END OF GUARDRAIL	X		
SB	3.500	F	W2-2L	30	30		SIDE RD WARNING						1		X														
SB	2.920	F	VD-062B	72	16		BUSINESS SIGN			1				X															
SB	2.550	F	W11-2	30	30		PEDESTRIAN						1		X														
		F	VW-219P	24	18		SUMMER CAMP AREA						1																
SB	2.440	F	VW-060	30	30			6.25								1		X								INSTALL 200 FT +/- NORTH OF EXISTING			E-154
SB	2.400	F	VW-060	30	30		HIDDEN DRIVES						1		X														
SB		F	W11A-2	30	30								1																	
SB		F	W16-2	24	18								1																
		F	W11-2	30	30	FYG		~~9.00~~ 6.25								1		X										X	
		F	W16-2	24	18	FYG		3.00																				X	
SB	2.200	F	W11-7	30	30		EQUESTRIAN 						1		X															
		F	W11-7	30	30			6.25								1		X										X	
SB	2.140	F	W1-4R	30	30		REVERSE CURVE						1		X														
		F	W13-1	18	18		40 MPH PLAQUE						1																
							SHEET TOTALS	~~29.50~~ 26.75 SF	0.00 SF	1 EA	0 EA	0 EA	9 EA	0 EA	0 EA	4 EA		60 FT									
							TOWN TOTALS	501.1	0.0	67.0	0.0	0.0	94	0.0	0.0	109		1635.0											

SIGN SUMMARY SHEET

VERMONT AGENCY OF TRANSPORTATION

PROJECT NAME: **Hartford-East Montpelier VT14**
PROJECT NUMBER: **SIGN STPG(21)**

FILE NAME: **Williamstown.xls** PLOT DATE: **6/18/2009**
PROJECT MANAGER: **N. Avery** DRAWN BY: **T. Guazzoni**
DESIGNED BY: **A. Gamble** CHECKED BY: **S. Menard**
WILLIAMSTOWN SHEET 15 SHEET **111** OF **162**

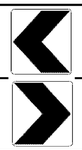
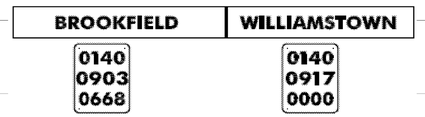
DIRECTION	MILEPOINT	LOCATION CODE (SHEET 2)	SIGN CODE	WIDTH (IN)	HEIGHT (IN)	SHEETING REMARKS	SIGN LEGEND FOR ALL POST LENGTHS AND INSTALLATION DATES SEE ORIGINAL RECORD PLANS	NEW SIGNS "A"	NEW SIGNS "B"	EXISTING SIGNS RETAIN	EXISTING SIGNS SALVAGE FROM	EXISTING SIGNS SALVAGE TO	EXISTING SIGNS REMOVE	EXIST POST RETAIN	EXIST POST REMOVE	NUMBER OF NEW POSTS	SQUARE STEEL (IN) 1.75 (LB / FT) 1.88	SQUARE STEEL (IN) 2.00 (LB / FT) 2.42	SQUARE STEEL (IN) 2.50 (LB / FT) 3.35	TUBULAR STEEL Ø (IN) FOUNDATION	TUBULAR STEEL Ø (IN) 3.00 (LB / FT) 7.60	TUBULAR STEEL Ø (IN) 3.50 (LB / FT) 9.00	TUBULAR STEEL Ø (IN) 4.00 (LB / FT) 10.80	TUBULAR STEEL Ø (IN) 5.00 (LB / FT) 14.60	SIGN FRAME REQUIRED	REMARKS	SIGN DETAIL: DETAIL IN SHS	SIGN DETAIL: DETAIL ON SHEET NUMBER	SIGN DETAIL: DETAIL ON STD SHEET NUMBER
WILLIAMSTOWN VT 14							FY-FLUORESCENT YELLOW FYG-FLUORESCENT YELLOW GREEN																			"SHS"-STANDARD HIGHWAY SIGNS			
SB	2.050	G	VR-017	24	24								1		X													
		G	VR-017	24	30			5.00								1		X								TH-93, TRIPP RD			E-141
SB	2.045	H	R1-1	24	24								1		X													
		H	R1-1	30	30			6.25								1		X						TH-93, TRIPP RD	X		
SB	1.990	F	W1-4R	30	30			6.25								1		X								INSTALL 300 FT +/- SOUTH OF TRIPP RD	X		
		F	W13-1	18	18			2.25																			X	
SB	1.890 TO 1.690	F		6	8		20 WHITE DELINEATORS	6.67								10	X									INSTALL B-B AT 100' SPACING, STARTING 500 FT SOUTH OF REV CURVE SIGN		5	
SB	1.270	F	S3-1	30	30								1		X													
		F	S3-1	30	30			6.25								1		X									X	
SB	1.180	F	W1-2L	30	30		CURVE LEFT						1		X													
		F	W13-1	18	18		40 MPH PLAQUE						1															
SB	1.155	G	VR-017	24	24								1		X													
		G	VR-017	24	30			5.00								1		X								TH-93, TRIPP RD			E-141
SB	1.150	H	R1-1	24	24								0 ~~1~~		~~X~~													
		H	R1-1	30	30			6.25								1		X								TH-93, TRIPP RD	X		
SIGN SUMMARY SHEET							SHEET TOTALS	43.92	0.00	0	0	0	~~6~~ 7	0	0	16		240									
								SF	SF	EA	EA	EA	EA	EA	EA	EA		FT									
VERMONT AGENCY OF TRANSPORTATION							TOWN TOTALS	501.1	0.0	67.0	0.0	0.0	94	0.0	0.0	109		1635.0									

PROJECT NAME: **Hartford-East Montpelier VT14**
PROJECT NUMBER: **SIGN STPG(21)**

FILE NAME: **Williamstown.xls** PLOT DATE: **6/18/2009**
PROJECT MANAGER: **N. Averv** DRAWN BY: **T. Guazzoni**
DESIGNED BY: **A. Gamble** CHECKED BY: **S. Menard**
WILLIAMSTOWN SHEET 16 SHEET **112** OF **162**

DIRECTION	MILEPOINT	LOCATION CODE (SHEET 2)	SIGN CODE	WIDTH (IN)	HEIGHT (IN)	SHEETING REMARKS	SIGN LEGEND	NEW SIGNS "A"	NEW SIGNS "B"	EXISTING SIGNS RETAIN	EXISTING SIGNS SALVAGE FROM	EXISTING SIGNS SALVAGE TO	EXISTING SIGNS REMOVE	EXIST POST RETAIN	EXIST POST REMOVE	NUMBER OF NEW POSTS	SQUARE STEEL (IN) 1.75 (LB / FT) 1.88	SQUARE STEEL (IN) 2.00 (LB / FT) 2.42	SQUARE STEEL (IN) 2.50 (LB / FT) 3.35	TUBULAR STEEL Ø (IN) FOUNDATION	TUBULAR STEEL Ø (IN) 3.00 (LB / FT) 7.60	TUBULAR STEEL Ø (IN) 3.50 (LB / FT) 9.00	TUBULAR STEEL Ø (IN) 4.00 (LB / FT) 10.80	TUBULAR STEEL Ø (IN) 5.00 (LB / FT) 14.60	SIGN FRAME REQUIRED	REMARKS	SIGN DETAIL: DETAIL IN SHS	SIGN DETAIL: DETAIL ON SHEET NUMBER	SIGN DETAIL: DETAIL ON STD SHEET NUMBER
WILLIAMSTOWN VT 14							FY-FLUORESCENT YELLOW FYG-FLUORESCENT YELLOW GREEN																			"SHS"-STANDARD HIGHWAY SIGNS			
SB	1.090	F	W1-2L	30	30	FY		6.25								1		X								INSTALL AT SOUTH END OF GRAVEL PULL-OFF	X		
		F	W13-1	18	18	FY		2.25																			X		
SB	0.620	F	W1-5L	30	30		WINDING RD						1		X														
		F	W13-1	18	18		40 MPH PLAQUE						1																
SB	0.540	F	W1-5L	30	30	FY		6.25								1		X								INSTALL ON SOUTH SIDE OF CULVERT BEHIND GUARDRAIL	X		
		F	W7-3A	24	18	FY		3.00																			X		
SB	0.490	F	W1-8	24	30	FY		5.00								1		X								INSTALL 300 FT +/- SOUTH OF CULVERT HEADWALL	X		
		E	W1-8	24	30	FY		5.00								1		X								INSTALL ON SEPARATE POST 5 FT SOUTH OF SB FACING SIGN	X		
SB	0.470	F	W1-6	60	48		LEFT ARROW						1		X														
SB	0.450	F	W1-8	24	30	FY		5.00								1		X								INSTALL 100 FT +/- SOUTH OF LEFT ARROW (TO BE REMOVED)	X		
		E	W1-8	24	30	FY		5.00								1		X								INSTALL ON SEPARATE POST 5 FT SOUTH OF SB FACING SIGN	X		
SB	0.410	F	W1-8	24	30	FY		5.00								1		X								INSTALL 50 FT +/- NORTH OF NB FACING RIGHT ARROW (TO BE REMOVED)	X		
		E	W1-8	24	30	FY		5.00								1		X								INSTALL ON SEPARATE POST 5 FT SOUTH OF SB FACING SIGN	X		
SB	0.400	E	W1-6	60	48		RIGHT ARROW (FACING NB)						1		X														
SB	0.380	F	W1-8	24	30	FY		5.00								1		X								INSTALL 100 FT +/- SOUTH OF NB FACING RIGHT ARROW (TO BE REMOVED)	X		
SIGN SUMMARY SHEET							SHEET TOTALS	52.75	0.00	0	0	0	4	0	0	9		135										
								SF	SF	EA	EA	EA	EA	EA	EA	EA		FT										
VERMONT AGENCY OF TRANSPORTATION							TOWN TOTALS	501.1	0.0	67.0	0.0	0.0	94	0.0	0.0	109		1635.0										

PROJECT NAME: **Hartford-East Montpelier VT14**
PROJECT NUMBER: **SIGN STPG(21)**
FILE NAME: **Williamstown.xls**
PROJECT MANAGER: **N. Averv**
DESIGNED BY: **A. Gamble**
WILLIAMSTOWN SHEET 17
PLOT DATE: **6/18/2009**
DRAWN BY: **T. Guazzoni**
CHECKED BY: **S. Menard**
SHEET **113** OF **162**

DIRECTION	MILEPOINT	LOCATION CODE (SHEET 2)	SIGN CODE	WIDTH (IN)	HEIGHT (IN)	SHEETING REMARKS	SIGN LEGEND FOR ALL POST LENGTHS AND INSTALLATION DATES SEE ORIGINAL RECORD PLANS	NEW SIGNS "A"	NEW SIGNS "B"	EXISTING SIGNS RETAIN	EXISTING SIGNS SALVAGE FROM	EXISTING SIGNS SALVAGE TO	EXISTING SIGNS REMOVE	EXIST POST RETAIN	EXIST POST REMOVE	NUMBER OF NEW POSTS	SQUARE STEEL (IN) 1.75 (LB / FT) 1.88	SQUARE STEEL (IN) 2.00 (LB / FT) 2.42	SQUARE STEEL (IN) 2.50 (LB / FT) 3.35	FOUNDATION	TUBULAR STEEL Ø (IN) 3.00 (LB / FT) 7.60	TUBULAR STEEL Ø (IN) 3.50 (LB / FT) 9.00	TUBULAR STEEL Ø (IN) 4.00 (LB / FT) 10.80	TUBULAR STEEL Ø (IN) 5.00 (LB / FT) 14.60	SIGN FRAME REQUIRED	REMARKS	SIGN DETAIL: DETAIL IN SHS	SIGN DETAIL: DETAIL ON SHEET NUMBER	SIGN DETAIL: DETAIL ON STD SHEET NUMBER
WILLIAMSTOWN VT 14							FY-FLUORESCENT YELLOW FYG-FLUORESCENT YELLOW GREEN																			"SHS"-STANDARD HIGHWAY SIGNS			
		E	W1-8	24	30	FY		5.00								1		X								INSTALL ON SEPARATE POST 5 FT SOUTH OF SB FACING SIGN	X		
SB	0.345	F	VW-347	30	30								1		X															
		F	VW-347	30	30			6.25								1		X								HINGED - INSTALL IN CLOSED POSITION		6	
SB	0.000	G	VD-024	60	7.5								~~2~~ 3		X												REMOVED MM PLAQUES			
		G	VD-024	72	10			5.00								2		X										4	
		G	VD-700	6	10			0.42																		BROOKFIELD MILE MARKER ~ INSTALL ON LEFT POST			E-138
		G	VD-700	6	10			0.42																		WILLIAMSTOWN MILE MARKER ~ INSTALL ON RIGHT POST			E-138

DIRECTION	MILEPOINT	LOCATION CODE (SHEET 2)	SIGN CODE	WIDTH (IN)	HEIGHT (IN)	SHEETING REMARKS	SIGN LEGEND	NEW SIGNS "A"	NEW SIGNS "B"	EXISTING SIGNS RETAIN	EXISTING SIGNS SALVAGE FROM	EXISTING SIGNS SALVAGE TO	EXISTING SIGNS REMOVE	EXIST POST RETAIN	EXIST POST REMOVE	NUMBER OF NEW POSTS	SQUARE STEEL (IN) 1.75 (LB / FT) 1.88	SQUARE STEEL (IN) 2.00 (LB / FT) 2.42	SQUARE STEEL (IN) 2.50 (LB / FT) 3.35	TUBULAR STEEL Ø (IN) FOUNDATION	TUBULAR STEEL Ø (IN) 3.00 (LB / FT) 7.60	TUBULAR STEEL Ø (IN) 3.50 (LB / FT) 9.00	TUBULAR STEEL Ø (IN) 4.00 (LB / FT) 10.80	TUBULAR STEEL Ø (IN) 5.00 (LB / FT) 14.60	SIGN FRAME REQUIRED	REMARKS	SIGN DETAIL: DETAIL IN SHS	SIGN DETAIL: DETAIL ON SHEET NUMBER	SIGN DETAIL: DETAIL ON STD SHEET NUMBER
BARRE TOWN VT 14							FY-FLUORESCENT YELLOW FYG-FLUORESCENT YELLOW GREEN																			"SHS"-STANDARD HIGHWAY SIGNS			
NB	0.000	C	VD-024	60	7.5								1		X														
		C	VD-025	60	7.5								1																
		C	VD-025	72	10			5.00								2		X										4	
		C	VD-024	72	10		BARRE TOWN | WILLIAMSTOWN WASHINGTON CO | ORANGE CO 0140 1202 0000 | 0140 0917 0683	5.00																				4	
		C	VD-700	6	10			0.42																			BARRE TOWN MILE MARKER ~ INSTALL ON LEFT POST			E-138
		C	VD-700	6	10			0.42																			WILLIAMSTOWN MILE MARKER ~ INSTALL ON RIGHT POST			E-138
NB	0.035	C	VR-017	24	24		LEGAL LOAD LIMIT 24000 LBS			1				X													TH-124, KINGS ROW			
NB	0.040	D	R1-1	24	24		STOP			1				X													TH-124, KINGS ROW			
NB	0.115	C	VR-017	24	24		LEGAL LOAD LIMIT 24000 LBS			1				X													TH-130, MORIN RD			
NB	0.120	D	R1-1	24	24		STOP			1				X													TH-130, MORIN RD			
NB	0.165	C	VR-017	24	24		LEGAL LOAD LIMIT 24000 LBS			1				X													TH-167, LEO AVE			
NB	0.170	D	R1-1	24	24		STOP			1				X													TH-167, LEO AVE			
NB	0.200	A	R2-1	24	30		SPEED LIMIT 40			1				X																
NB	0.800	C	VR-017	24	24		LEGAL LOAD LIMIT 24000 LBS			1				X													TH-104, JACKSON ST			
NB	0.805	D	R1-1	24	24		STOP			1				X													TH-104, JACKSON ST			
SIGN SUMMARY SHEET							SHEET TOTALS	10.84	0.00	9	0	0	2	0	0	2		30										
								SF	SF	EA	EA	EA	EA	EA	EA	EA		FT										
VERMONT AGENCY OF TRANSPORTATION							TOWN TOTALS	583.8	0.0	48.0	9.0	9.0	115	0.0	0.0	89		1335.0										

PROJECT NAME: **Hartford-East Montpelier VT14**
PROJECT NUMBER: **STPG SIGN(21)**

FILE NAME: **Barre Town.xls** PLOT DATE: **6/18/2009**
PROJECT MANAGER: **N. Averv** DRAWN BY: **T. Guazzoni**
DESIGNED BY: **A. Gamble** CHECKED BY: **S. Menard**
BARRE TOWN SHEET 1 SHEET **115** OF **162**

DIRECTION	MILEPOINT	LOCATION CODE (SHEET 2)	SIGN CODE	WIDTH (IN)	HEIGHT (IN)	SHEETING REMARKS	SIGN LEGEND	NEW SIGNS "A"	NEW SIGNS "B"	EXISTING SIGNS RETAIN	EXISTING SIGNS SALVAGE FROM	EXISTING SIGNS SALVAGE TO	EXISTING SIGNS REMOVE	EXIST POST RETAIN	EXIST POST REMOVE	NUMBER OF NEW POSTS	SQUARE STEEL (IN) 1.75 (LB / FT) 1.88	SQUARE STEEL (IN) 2.00 (LB / FT) 2.42	SQUARE STEEL (IN) 2.50 (LB / FT) 3.35	TUBULAR STEEL Ø (IN) FOUNDATION	TUBULAR STEEL Ø (IN) 3.00 (LB / FT) 7.60	TUBULAR STEEL Ø (IN) 3.50 (LB / FT) 9.00	TUBULAR STEEL Ø (IN) 4.00 (LB / FT) 10.80	TUBULAR STEEL Ø (IN) 5.00 (LB / FT) 14.60	SIGN FRAME REQUIRED	REMARKS	SIGN DETAIL: DETAIL IN SHS	SIGN DETAIL: DETAIL ON SHEET NUMBER	SIGN DETAIL: DETAIL ON STD SHEET NUMBER
BARRE TOWN VT 14							FY-FLUORESCENT YELLOW FYG-FLUORESCENT YELLOW GREEN																			"SHS"-STANDARD HIGHWAY SIGNS			
NB	0.875	C	VR-017	24	24		LEGAL LOAD LIMIT 24000 LBS			1				X												TH-60, HOLDEN RD			
NB	0.880	D	R1-1	24	24		STOP			1				X												TH-60, HOLDEN RD			
NB	1.020	A	R2-1	24	30								1		X														
		A	R2-1	24	30			5.00								1		X									X		
NB	1.270	A	R2-5A	24	30		REDUCED SPEED AHEAD 						1		X														
		A	W3-5	36	36			9.00								2		X									X		
NB	1.380	A	VD-062A	72	16		BUSINESS SIGN			1				X															
		A	VD-062A	72	16					1																			
NB	1.415	A	R2-1	30	36			7.50								1		X								INSTALL 80 FT SOUTH OF EXISTING, AT END OF GRASS ISLAND		6	
NB	1.450	A	R2-1	24	30		SPEED LIMIT 35						1		X														
NB	1.500	C	VR-017	24	30		LEGAL LOAD LIMIT 24000 LBS			1				X												TH-214, DON CAMP RD			
NB	1.505	D	R1-1	30	30		STOP			1				X												TH-214, DON CAMP RD			
NB	1.550	A	W3-3	36	36		SIGNAL AHEAD			1				X															
NB	1.560	A	VD-066	24	24		GAS/FOOD			1				X															
NB	1.585	A	M2-1	21	15								1		X														
							SHEET TOTALS	21.50 SF	0.00 SF	8 EA	0 EA	0 EA	4 EA	0 EA	0 EA	4 EA		60 FT											
							TOWN TOTALS	583.8	0.0	48.0	9.0	9.0	115	0.0	0.0	89		1335.0											

SIGN SUMMARY SHEET

VERMONT AGENCY OF TRANSPORTATION

PROJECT NAME: Hartford-East Montpelier VT14
PROJECT NUMBER: STPG SIGN(21)

FILE NAME: Barre Town.xls
PROJECT MANAGER: N. Averv
DESIGNED BY: A. Gamble
BARRE TOWN SHEET 2

PLOT DATE: 6/18/2009
DRAWN BY: T. Guazzoni
CHECKED BY: S. Menard
SHEET 116 OF 162

DIRECTION	MILEPOINT	LOCATION CODE (SHEET 2)	SIGN CODE	WIDTH (IN)	HEIGHT (IN)	SHEETING REMARKS	SIGN LEGEND	NEW SIGNS "A"	NEW SIGNS "B"	EXISTING SIGNS RETAIN	EXISTING SIGNS SALVAGE FROM	EXISTING SIGNS SALVAGE TO	EXISTING SIGNS REMOVE	EXIST POST RETAIN	EXIST POST REMOVE	NUMBER OF NEW POSTS	SQUARE STEEL (IN) 1.75 (LB / FT) 1.88	SQUARE STEEL (IN) 2.00 (LB / FT) 2.42	SQUARE STEEL (IN) 2.50 (LB / FT) 3.35	TUBULAR STEEL Ø (IN) FOUNDATION	TUBULAR STEEL Ø (IN) 3.00 (LB / FT) 7.60	TUBULAR STEEL Ø (IN) 3.50 (LB / FT) 9.00	TUBULAR STEEL Ø (IN) 4.00 (LB / FT) 10.80	TUBULAR STEEL Ø (IN) 5.00 (LB / FT) 14.60	SIGN FRAME REQUIRED	REMARKS	SIGN DETAIL: DETAIL IN SHS	SIGN DETAIL: DETAIL ON SHEET NUMBER	SIGN DETAIL: DETAIL ON STD SHEET NUMBER
BARRE TOWN VT 14							FY-FLUORESCENT YELLOW FYG-FLUORESCENT YELLOW GREEN																			"SHS"-STANDARD HIGHWAY SIGNS			
		A	M1-5A	24	24								1																
		A	M2-1	21	15		JCT VERMONT 63	2.19								1		X								GREEN ON WHITE SHEETING	X		
		A	M1-5	24	24			4.00																					E-136B
NB	1.635	A	VR-922L	36	30		LEFT ONLY/THRU-RIGHT			1				X															
NB	1.640	J	R4-7	24	30		KEEP RIGHT SYMBOL			1				X															
		J	OM1-1	12	12		YELLOW CLUSTER			1																			
		K	R3-4	24	24		NO U-TURN (FACING SB)			1																			
		K	OM1-1	12	12		YELLOW CLUSTER (FACING SB)			1																			
NB	1.655	A	D1-1A	54	7.5		UP ARROW BARRE 2						1	X															
		A	D1-1A	54	7.5		UP ARROW E MONTPELIER 5						1																
		A	D1-1A	54	7.5		GRANITEVILLE 3 RIGHT ARROW						1																
		A	M3-4	24	12		WEST						1																
		A	M1-5	24	24		VT 63						1																
		A	M6-1	21	15		LEFT ARROW						1																
		A	M4-5	24	12		TO						1																
							SHEET TOTALS	6.19	0.00	5	0	0	8	0	0	1		15											
								SF	SF	EA	EA	EA	EA	EA	EA	EA		FT											
							TOWN TOTALS	583.8	0.0	48.0	9.0	9.0	115	0.0	0.0	89		1335.0											

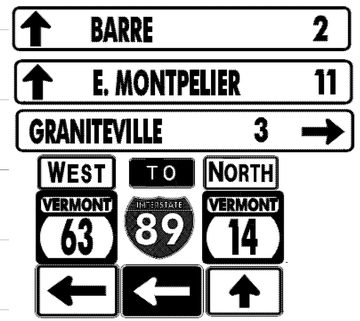
SIGN SUMMARY SHEET

VERMONT AGENCY OF TRANSPORTATION

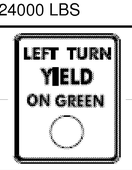
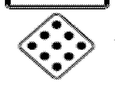
PROJECT NAME: Hartford-East Montpelier VT14
PROJECT NUMBER: STPG SIGN(21)

FILE NAME: Barre Town.xls
PROJECT MANAGER: N. Averv
DESIGNED BY: A. Gamble
BARRE TOWN SHEET 3

PLOT DATE: 6/18/2009
DRAWN BY: T. Guazzoni
CHECKED BY: S. Menard
SHEET 117 OF 162

DIRECTION	MILEPOINT	LOCATION CODE (SHEET 2)	SIGN CODE	WIDTH (IN)	HEIGHT (IN)	SHEETING REMARKS	SIGN LEGEND	NEW SIGNS "A"	NEW SIGNS "B"	EXISTING SIGNS RETAIN	EXISTING SIGNS SALVAGE FROM	EXISTING SIGNS SALVAGE TO	EXISTING SIGNS REMOVE	EXIST POST RETAIN	EXIST POST REMOVE	NUMBER OF NEW POSTS	SQUARE STEEL (IN) 1.75 (LB / FT) 1.88	SQUARE STEEL (IN) 2.00 (LB / FT) 2.42	SQUARE STEEL (IN) 2.50 (LB / FT) 3.35	TUBULAR STEEL Ø (IN) FOUNDATION	TUBULAR STEEL Ø (IN) 3.00 (LB / FT) 7.60	TUBULAR STEEL Ø (IN) 3.50 (LB / FT) 9.00	TUBULAR STEEL Ø (IN) 4.00 (LB / FT) 10.80	TUBULAR STEEL Ø (IN) 5.00 (LB / FT) 14.60	SIGN FRAME REQUIRED	REMARKS	SIGN DETAIL: DETAIL IN SHS	SIGN DETAIL: DETAIL ON SHEET NUMBER	SIGN DETAIL: DETAIL ON STD SHEET NUMBER
BARRE TOWN VT 14							FY-FLUORESCENT YELLOW FYG-FLUORESCENT YELLOW GREEN																			"SHS"-STANDARD HIGHWAY SIGNS			
		A	M1-1	24	24		I-89						1															
		A	M5-1	21	15		LEFT ARROW						1															
		A	M3-1	24	12		NORTH						1															
		A	M1-5	24	24		VT 14						1															
		A	M6-3	21	15		UP ARROW						1															
		A	D1-1A	72	12			6.00																INSTALL ON EXISTING POSTS		5	
		A	D1-1A	72	12			6.00																				5	
		A	D1-1A	72	12			6.00																				5	
		A	M3-4	24	12			2.00																		#3	GREEN ON WHITE SHEETING	X	7	
		A	M1-5	24	24			4.00																					E-136B
		A	M6-1L	21	15			2.19																			GREEN ON WHITE SHEETING	X		
		A	M4-5	24	12			2.00																			WHITE ON BLUE SHEETING	X		
		A	M1-1	24	24			4.00																				X		
		A	M6-1L	21	15			2.19																			WHITE ON BLUE SHEETING	X		
		A	M3-1	24	12			2.00																			GREEN ON WHITE SHEETING	X		
SIGN SUMMARY SHEET							SHEET TOTALS	36.38	0.00	0	0	0	5	0	0	0	0											
								SF	SF	EA	EA	EA	EA	EA	EA	EA	FT											
VERMONT AGENCY OF TRANSPORTATION							TOWN TOTALS	583.8	0.0	48.0	9.0	9.0	115	0.0	0.0	89	1335.0											

PROJECT NAME: **Hartford-East Montpelier VT14**
PROJECT NUMBER: **STPG SIGN(21)**
FILE NAME: **Barre Town.xls** PLOT DATE: **6/18/2009**
PROJECT MANAGER: **N. Averv** DRAWN BY: **T. Guazzoni**
DESIGNED BY: **A. Gamble** CHECKED BY: **S. Menard**
BARRE TOWN SHEET 4 SHEET **118** OF **162**

DIRECTION	MILEPOINT	LOCATION CODE (SHEET 2)	SIGN CODE	WIDTH (IN)	HEIGHT (IN)	SHEETING REMARKS	SIGN LEGEND FOR ALL POST LENGTHS AND INSTALLATION DATES SEE ORIGINAL RECORD PLANS	NEW SIGNS "A"	NEW SIGNS "B"	EXISTING SIGNS RETAIN	EXISTING SIGNS SALVAGE FROM	EXISTING SIGNS SALVAGE TO	EXISTING SIGNS REMOVE	EXIST POST RETAIN	EXIST POST REMOVE	NUMBER OF NEW POSTS	SQUARE STEEL (IN) (LB / FT) 1.75 / 1.88	SQUARE STEEL (IN) (LB / FT) 2.00 / 2.42	SQUARE STEEL (IN) (LB / FT) 2.50 / 3.35	TUBULAR STEEL Ø (IN) FOUNDATION	TUBULAR STEEL Ø (IN) (LB / FT) 3.00 / 7.60	TUBULAR STEEL Ø (IN) (LB / FT) 3.50 / 9.00	TUBULAR STEEL Ø (IN) (LB / FT) 4.00 / 10.80	TUBULAR STEEL Ø (IN) (LB / FT) 5.00 / 14.60	SIGN FRAME REQUIRED	REMARKS	SIGN DETAIL: DETAIL IN SHS	SIGN DETAIL: DETAIL ON SHEET NUMBER	SIGN DETAIL: DETAIL ON STD SHEET NUMBER
BARRE TOWN VT 14							FY-FLUORESCENT YELLOW FYG-FLUORESCENT YELLOW GREEN																			"SHS"-STANDARD HIGHWAY SIGNS			
		A	M1-5	24	24			4.00																				E-136B
		A	M6-3	21	15			2.19																		GREEN ON WHITE SHEETING	X		
NB	1.660	L	R6-1R	36	12		ONE WAY (FACING EAST IN MEDIAN)			1				X														
NB	1.670	K	R4-7	24	30		KEEP RIGHT SYMBOL (MEDIAN FACING SB)			1				X														
		K	OM1-1	12	12		YELLOW CLUSTER (MEDIAN FACING SB)			1																		
NB	1.680	C	VR-017	24	30		LEGAL LOAD LIMIT 24000 LBS			1				X												TH-4, MIDDLE RD			
NB	1.685	M	R10-12	24	30								1															
		M	R10-12	24	30			5.00																		INSTALL ON SPAN WIRE NEXT TO LEFT TURN SIGNAL	X		
NB	1.687	C	R4-7	24	30								2 ~~1~~		X											REMOVED MM PLAQUE			
		C	OM1-1	12	12								1															
		C	R4-7	24	30			5.00			4	4				1	X								INSTALL ON MIDDLE RD MEDIAN FACING EB (VT 63)	X		
		C	OM1-1	12	12			1.00								1									4 R&S DUE TO POST DAMAGE	X		
NB	1.705	A	M3-1	24	12		NORTH						1		X													
		A	M1-5	24	24		VT 14						1															
		A	M4-5	24	12		TO						1															
							SHEET TOTALS	17.19 SF	0.00 SF	4 EA	4 ~~0~~ EA	4 ~~0~~ EA	7 ~~6~~ EA	0 EA	0 EA	2 ~~1~~ EA	15 FT												
							TOWN TOTALS	583.8	0.0	48.0	9.0	9.0	115	0.0	0.0	89	1335.0												

SIGN SUMMARY SHEET

VERMONT AGENCY OF TRANSPORTATION

PROJECT NAME: **Hartford-East Montpelier VT14**
PROJECT NUMBER: **STPG SIGN(21)**

FILE NAME: **Barre Town.xls** PLOT DATE: **6/18/2009**
PROJECT MANAGER: **N. Averv** DRAWN BY: **T. Guazzoni**
DESIGNED BY: **A. Gamble** CHECKED BY: **S. Menard**
BARRE TOWN SHEET 5 SHEET **119** OF **162**

DIRECTION	MILEPOINT	LOCATION CODE (SHEET 2)	SIGN CODE	WIDTH (IN)	HEIGHT (IN)	SHEETING REMARKS	SIGN LEGEND FOR ALL POST LENGTHS AND INSTALLATION DATES SEE ORIGINAL RECORD PLANS	NEW SIGNS "A"	NEW SIGNS "B"	EXISTING SIGNS RETAIN	EXISTING SIGNS SALVAGE FROM	EXISTING SIGNS SALVAGE TO	EXISTING SIGNS REMOVE	EXIST POST RETAIN	EXIST POST REMOVE	NUMBER OF NEW POSTS	SQUARE STEEL (IN) 1.75 (LB / FT) 1.88	SQUARE STEEL (IN) 2.00 (LB / FT) 2.42	SQUARE STEEL (IN) 2.50 (LB / FT) 3.35	TUBULAR STEEL Ø (IN) FOUNDATION	TUBULAR STEEL Ø (IN) 3.00 (LB / FT) 7.60	TUBULAR STEEL Ø (IN) 3.50 (LB / FT) 9.00	TUBULAR STEEL Ø (IN) 4.00 (LB / FT) 10.80	TUBULAR STEEL Ø (IN) 5.00 (LB / FT) 14.60	SIGN FRAME REQUIRED	REMARKS	SIGN DETAIL: DETAIL IN SHS	SIGN DETAIL: DETAIL ON SHEET NUMBER	SIGN DETAIL: DETAIL ON STD SHEET NUMBER
BARRE TOWN VT 14							FY-FLUORESCENT YELLOW FYG-FLUORESCENT YELLOW GREEN																			"SHS"-STANDARD HIGHWAY SIGNS			
		A	M1-4	30	24		US 302						1															
		A	M3-1	24	12			2.00								1		X							#1A	GREEN ON WHITE SHEETING	X	7	
		A	M1-5	24	24			4.00																				E-136B
		A	M4-5	24	12			2.00																			X		
		A	M1-4	30	24			5.00																			X		
NB	1.760	A	D4-2	30	36								1		X														
		A	VD-365	30	6		1-800-685-RIDE						1														REMOVE AND DO NOT REPLACE PHONE NUMBER PLAQUE			
		A	D4-2	30	36			7.50								1		X									X		
NB	1.770	A	VD-062B	72	16		BUSINESS SIGN			1				X															
NB	1.785	A	R2-1	24	30			5.00								1		X								INSTALL 20 FT +/- SOUTH OF HANNAFORD DRIVEWAY	X		
NB	1.805	A	R8-3A	24	24								1		X														
		A	VR-644	24	12								1		X														
		A	R8-3A	24	24			4.00								1		X									X		
		A	M4-11	24	12			2.00																			X		
NB	1.820	C	VR-017	24	24						1		1		X														
							SHEET TOTALS	31.50	0.00	1	~~0~~ 1	0	6	0	0	4		60										
								SF	SF	EA	EA	EA	EA	EA	EA	EA		FT										
							TOWN TOTALS	583.8	0.0	48.0	9.0	9.0	115	0.0	0.0	89		1335.0										

SIGN SUMMARY SHEET

VERMONT AGENCY OF TRANSPORTATION

PROJECT NAME: **Hartford-East Montpelier VT14**
PROJECT NUMBER: **STPG SIGN(21)**

FILE NAME: **Barre Town.xls**
PROJECT MANAGER: **N. Avery**
DESIGNED BY: **A. Gamble**
BARRE TOWN SHEET 6

PLOT DATE: **6/18/2009**
DRAWN BY: **T. Guazzoni**
CHECKED BY: **S. Menard**

DIRECTION	MILEPOINT	LOCATION CODE (SHEET 2)	SIGN CODE	WIDTH (IN)	HEIGHT (IN)	SHEETING REMARKS	SIGN LEGEND FOR ALL POST LENGTHS AND INSTALLATION DATES SEE ORIGINAL RECORD PLANS	NEW SIGNS "A"	NEW SIGNS "B"	EXISTING SIGNS RETAIN	EXISTING SIGNS SALVAGE FROM	EXISTING SIGNS SALVAGE TO	EXISTING SIGNS REMOVE	EXIST POST RETAIN	EXIST POST REMOVE	NUMBER OF NEW POSTS	SQUARE STEEL (IN) 1.75 (LB / FT) 1.88	SQUARE STEEL (IN) 2.00 (LB / FT) 2.42	SQUARE STEEL (IN) 2.50 (LB / FT) 3.35	TUBULAR STEEL Ø (IN) FOUNDATION	TUBULAR STEEL Ø (IN) 3.00 (LB / FT) 7.60	TUBULAR STEEL Ø (IN) 3.50 (LB / FT) 9.00	TUBULAR STEEL Ø (IN) 4.00 (LB / FT) 10.80	TUBULAR STEEL Ø (IN) 5.00 (LB / FT) 14.60	SIGN FRAME REQUIRED	REMARKS	SIGN DETAIL: DETAIL IN SHS	SIGN DETAIL: DETAIL ON SHEET NUMBER	SIGN DETAIL: DETAIL ON STD SHEET NUMBER
BARRE TOWN VT 14							FY-FLUORESCENT YELLOW FYG-FLUORESCENT YELLOW GREEN																			"SHS"-STANDARD HIGHWAY SIGNS			
		C	VR-017	24	30		LEGAL LOAD LIMIT 24,000 POUNDS	5.00				1				1		X								TH-108, WILSON ST			E-141
NB	1.825	D	R1-1	24	24						1		1		X														
		D	R1-1	30	30		STOP	6.25				1				1		X								TH-108, WILSON ST	X		
NB	1.845	C	VR-017	24	24								1		X														
		C	N/A				TOWN PARKING REGULATION				1																			
		C	VR-017	24	30		LEGAL LOAD LIMIT 24,000 POUNDS	5.00								1		X								TH-109, SEAGER LN			E-141
		C	N/A									1														RE-INSTALL TOWN'S PARKING REGULATION SIGN BELOW LEGAL LOAD SIGN			
NB	1.850	D	R1-1	24	24								1		X														
		A	D-3				SEAGER LN				1																		
		A	D-3				SEAGER LN					1															RE-INSTALL TOWN'S STREET NAME SIGN ON TOP OF STOP SIGN			
		D	R1-1	30	30		STOP	6.25								1		X								TH-109, SEAGER LN	X		
NB	1.890	A	W2-1M	30	30		INTERSECTION			1				X															
NB	1.890	A	W16-2	24	18		500 FEET			1																			
NB	1.915	A	R8-3A	24	24								1		X														
		A	R8-3A	24	24			4.00								1		X									X		
							SHEET TOTALS	26.50 SF	0.00 SF	2 EA	~~3~~ 2 EA	~~4~~ 2 EA	4 EA	0 EA	0 EA	5 EA	75 FT											
							TOWN TOTALS	583.8	0.0	48.0	9.0	9.0	115	0.0	0.0	89	1335.0												

SIGN SUMMARY SHEET

VERMONT AGENCY OF TRANSPORTATION

PROJECT NAME: **Hartford-East Montpelier VT14**
PROJECT NUMBER: **STPG SIGN(21)**

FILE NAME: **Barre Town.xls**
PROJECT MANAGER: **N. Averv**
DESIGNED BY: **A. Gamble**
PLOT DATE: **6/18/2009**
DRAWN BY: **T. Guazzoni**
CHECKED BY: **S. Menard**

DIRECTION	MILEPOINT	LOCATION CODE (SHEET 2)	SIGN CODE	WIDTH (IN)	HEIGHT (IN)	SHEETING REMARKS	SIGN LEGEND FOR ALL POST LENGTHS AND INSTALLATION DATES SEE ORIGINAL RECORD PLANS	NEW SIGNS "A"	NEW SIGNS "B"	EXISTING SIGNS RETAIN	EXISTING SIGNS SALVAGE FROM	EXISTING SIGNS SALVAGE TO	EXISTING SIGNS REMOVE	EXIST POST RETAIN	EXIST POST REMOVE	NUMBER OF NEW POSTS	SQUARE STEEL (IN) 1.75 (LB / FT) 1.88	SQUARE STEEL (IN) 2.00 (LB / FT) 2.42	SQUARE STEEL (IN) 2.50 (LB / FT) 3.35	TUBULAR STEEL Ø (IN) FOUNDATION	TUBULAR STEEL Ø (IN) 3.00 (LB / FT) 7.60	TUBULAR STEEL Ø (IN) 3.50 (LB / FT) 9.00	TUBULAR STEEL Ø (IN) 4.00 (LB / FT) 10.80	TUBULAR STEEL Ø (IN) 5.00 (LB / FT) 14.60	SIGN FRAME REQUIRED	REMARKS	SIGN DETAIL: DETAIL IN SHS	SIGN DETAIL: DETAIL ON SHEET NUMBER	SIGN DETAIL: DETAIL ON STD SHEET NUMBER
BARRE TOWN VT 14							FY-FLUORESCENT YELLOW FYG-FLUORESCENT YELLOW GREEN																			"SHS"-STANDARD HIGHWAY SIGNS			
NB	1.945	A	D11-1	24	18								1		X													
		A	M7-1L	12	9								1															
		A	D11-1	24	18			3.00								1		X									X	
		A	M7-1L	12	9			0.75																			WHITE/GREEN	X	
NB	1.960	A	R8-3A	24	24			4.00								1		X									INSTALL 20 FT +/- SOUTH OF STIRLING HILL RD	X	
		A	M4-6	24	12			2.00																			RED ON WHITE SHEETING	X	
NB	1.970	C	VR-017	24	24							1	1		X												TH-53, STERLING HILL RD		
		C	N/A				TOWN PARKING REG				1																	
		C	W14-2				NO OUTLET				1																	
		C	VR-017	24	30			5.00								1		X											E-141
		C	N/A									1															RE-INSTALL TOWN'S PARKING REGULATION SIGN BELOW LEGAL LOAD		
		C	W14-2									1				1		X							INSTALL TOWN'S "NO OUTLET" SIGN ON NEW POST 20 - 50 FT EAST OF LEGAL LOAD SIGN		
NB	1.970	D	R1-1	24	24								1		X												TH-53, STERLING HILL RD		
		A	N/A				NO OUTLET						1														REMOVE AND DO NOT RE-INSTALL TOWN'S "NO OUTLET" SIGN		
		D	R1-1	30	30			6.25								1		X										X	
							SHEET TOTALS	21.00	0.00	0	2	3 ~~2~~	5	0	0	5	75												
								SF	SF	EA	EA	EA	EA	EA	EA	EA	FT												
							TOWN TOTALS	583.8	0.0	48.0	9.0	9.0	115	0.0	0.0	89	1335.0												

SIGN SUMMARY SHEET

VERMONT AGENCY OF TRANSPORTATION

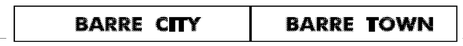
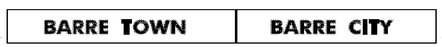
PROJECT NAME: **Hartford-East Montpelier VT14**
PROJECT NUMBER: **STPG SIGN(21)**

FILE NAME: **Barre Town.xls** PLOT DATE: **6/18/2009**
PROJECT MANAGER: **N. Averv** DRAWN BY: **T. Guazzoni**
DESIGNED BY: **A. Gamble** CHECKED BY: **S. Menard**
BARRE TOWN SHEET 8 SHEET **122** OF **162**

DIRECTION	MILEPOINT	LOCATION CODE (SHEET 2)	SIGN CODE	WIDTH (IN)	HEIGHT (IN)	SHEETING REMARKS	SIGN LEGEND FOR ALL POST LENGTHS AND INSTALLATION DATES SEE ORIGINAL RECORD PLANS	NEW SIGNS "A"	NEW SIGNS "B"	EXISTING SIGNS RETAIN	EXISTING SIGNS SALVAGE FROM	EXISTING SIGNS SALVAGE TO	EXISTING SIGNS REMOVE	EXIST POST RETAIN	EXIST POST REMOVE	NUMBER OF NEW POSTS	SQUARE STEEL (IN) 1.75 (LB / FT) 1.88	SQUARE STEEL (IN) 2.00 (LB / FT) 2.42	SQUARE STEEL (IN) 2.50 (LB / FT) 3.35	FOUNDATION	TUBULAR STEEL Ø (IN) 3.00 (LB / FT) 7.60	TUBULAR STEEL Ø (IN) 3.50 (LB / FT) 9.00	TUBULAR STEEL Ø (IN) 4.00 (LB / FT) 10.80	TUBULAR STEEL Ø (IN) 5.00 (LB / FT) 14.60	SIGN FRAME REQUIRED	REMARKS	SIGN DETAIL: DETAIL IN SHS	SIGN DETAIL: DETAIL ON SHEET NUMBER	SIGN DETAIL: DETAIL ON STD SHEET NUMBER
BARRE TOWN VT 14							FY-FLUORESCENT YELLOW FYG-FLUORESCENT YELLOW GREEN																			"SHS"-STANDARD HIGHWAY SIGNS			
NB	2.020	A	R2-1	24	30								1		X														
		A	R2-1	24	30			5.00								1		X									X		
NB	2.025	C	VR-017	24	24								0 ~~1~~		X														
		C	VR-017	24	24			5.00								1		X								TH-111, CHRISTIE ST			E-141
NB	2.030	D	R1-1	24	24						2		1		X														
		D	R1-1	30	30			6.25				2				1		X								TH-111, CHRISTIE ST	X		
NB	2.075	A	VD-062C	74.75	16		BUSINESS SIGN			1				X														
		A	VD-062B(	74.75	16		BUSINESS SIGN			1																		
NB	2.200	A	R2-5A	24	30		REDUCED SPEED AHEAD						1		X														
		A	W3-5	36	36			9.00								2		X								X		
NB	2.240	A	VD-018	30	18								1		X														
		A	VD-018	30	18			3.75								1		X											
NB	2.300	A	VR-038	24	18								1		X														
		A	R2-1	24	30								1																
		A	N/A				UNLESS OTHERWISE POSTED IN CITY LIMITS				1																		
SIGN SUMMARY SHEET							SHEET TOTALS	29.00	0.00	2	~~3~~ 1	~~2~~ 0	~~6~~ 7	0	0	6		90										
								SF	SF	EA	EA	EA	EA	EA	EA	EA		FT										
VERMONT AGENCY OF TRANSPORTATION							TOWN TOTALS	583.8	0.0	48.0	9.0	9.0	115	0.0	0.0	89		1335.0										

PROJECT NAME: **Hartford-East Montpelier VT14**
PROJECT NUMBER: **STPG SIGN(21)**

FILE NAME: **Barre Town.xls** PLOT DATE: **6/18/2009**
PROJECT MANAGER: **N. Averv** DRAWN BY: **T. Guazzoni**
DESIGNED BY: **A. Gamble** CHECKED BY: **S. Menard**
BARRE TOWN SHEET 9 SHEET **123** OF **162**

DIRECTION	MILEPOINT	LOCATION CODE (SHEET 2)	SIGN CODE	WIDTH (IN)	HEIGHT (IN)	SHEETING REMARKS	SIGN LEGEND FOR ALL POST LENGTHS AND INSTALLATION DATES SEE ORIGINAL RECORD PLANS	NEW SIGNS "A"	NEW SIGNS "B"	EXISTING SIGNS RETAIN	EXISTING SIGNS SALVAGE FROM	EXISTING SIGNS SALVAGE TO	EXISTING SIGNS REMOVE	EXIST POST RETAIN	EXIST POST REMOVE	NUMBER OF NEW POSTS	SQUARE STEEL (IN) 1.75 (LB / FT) 1.88	SQUARE STEEL (IN) 2.00 (LB / FT) 2.42	SQUARE STEEL (IN) 2.50 (LB / FT) 3.35	TUBULAR STEEL Ø (IN) FOUNDATION	TUBULAR STEEL Ø (IN) 3.00 (LB / FT) 7.60	TUBULAR STEEL Ø (IN) 3.50 (LB / FT) 9.00	TUBULAR STEEL Ø (IN) 4.00 (LB / FT) 10.80	TUBULAR STEEL Ø (IN) 5.00 (LB / FT) 14.60	SIGN FRAME REQUIRED	REMARKS	SIGN DETAIL DETAIL IN SHS	SIGN DETAIL DETAIL ON SHEET NUMBER	SIGN DETAIL DETAIL ON STD SHEET NUMBER
BARRE TOWN VT 14							FY-FLUORESCENT YELLOW FYG-FLUORESCENT YELLOW GREEN																			"SHS"-STANDARD HIGHWAY SIGNS			
		A	VR-038	24	18			3.00								1		X									E-141
		A	R2-1	30	36			7.50																		6	
		A	N/A				UNLESS OTHERWISE POSTED IN CITY LIMITS					1														RE-INSTALL TOWN'S "UNLESS OTHERWISE POSTED" PLAQUE BELOW SL 25			
NB	2.319	C	VD-025	60	7.5								1		X														
		C	VD-025	72	10			5.00								2		X								4	
		C	VD-700	6	10		 	0.42																	BARRE CITY MILE MARKER ~ INSTALL ON LEFT POST			E-138
		C	VD-700	6	10			0.42					1													NEW DAMAGED BARRE TOWN MILE MARKER ~ INSTALL ON RIGHT POST			E-138
		X																								2.1 MILES IN BARRE CITY, THEN BARRE TOWN RESUMES			
NB	2.321	C	VD-024	60	7.5								1		X														
		C	VD-025	72	10			5.00								2		X								4	
		C	VD-700	6	10		 	0.42																	BARRE T0WN MILE MARKER ~ INSTALL ON LEFT POST			E-138
		C	VD-700	6	10			0.42																		BARRE CITY MILE MARKER ~ INSTALL ON RIGHT POST			E-138
NB	2.325	A	VR-039	24	18								1		X															
		A	R2-1	24	30								1															
		A	VR-039	24	18			3.00								1		X											E-141
SIGN SUMMARY SHEET							SHEET TOTALS	25.60 ~~25.18~~ SF	0.00 SF	0 EA	0 EA	1 EA	5 ~~4~~ EA	0 EA	0 EA	6 EA	90 FT												
VERMONT AGENCY OF TRANSPORTATION							TOWN TOTALS	583.8	0.0	48.0	9.0	9.0	115	0.0	0.0	89	1335.0											

PROJECT NAME: Hartford-East Montpelier VT14
PROJECT NUMBER: STPG SIGN(21)

FILE NAME: Barre Town.xls
PROJECT MANAGER: N. Avery
DESIGNED BY: A. Gamble
BARRE TOWN SHEET 10

PLOT DATE: 6/18/2009
DRAWN BY: T. Guazzoni
CHECKED BY: S. Menard
SHEET 124 OF 162

DIRECTION	MILEPOINT	LOCATION CODE (SHEET 2)	SIGN CODE	WIDTH (IN)	HEIGHT (IN)	SHEETING REMARKS	SIGN LEGEND FOR ALL POST LENGTHS AND INSTALLATION DATES SEE ORIGINAL RECORD PLANS	NEW SIGNS "A"	NEW SIGNS "B"	EXISTING SIGNS RETAIN	EXISTING SIGNS SALVAGE FROM	EXISTING SIGNS SALVAGE TO	EXISTING SIGNS REMOVE	EXIST POST RETAIN	EXIST POST REMOVE	NUMBER OF NEW POSTS	SQUARE STEEL (IN) 1.75 (LB / FT) 1.88	SQUARE STEEL (IN) 2.00 (LB / FT) 2.42	SQUARE STEEL (IN) 2.50 (LB / FT) 3.35	TUBULAR STEEL Ø (IN) FOUNDATION	TUBULAR STEEL Ø (IN) 3.00 (LB / FT) 7.60	TUBULAR STEEL Ø (IN) 3.50 (LB / FT) 9.00	TUBULAR STEEL Ø (IN) 4.00 (LB / FT) 10.80	TUBULAR STEEL Ø (IN) 5.00 (LB / FT) 14.60	SIGN FRAME REQUIRED	REMARKS	SIGN DETAIL: DETAIL IN SHS	SIGN DETAIL: DETAIL ON SHEET NUMBER	SIGN DETAIL: DETAIL ON STD SHEET NUMBER
BARRE TOWN VT 14							FY-FLUORESCENT YELLOW FYG-FLUORESCENT YELLOW GREEN																			"SHS"-STANDARD HIGHWAY SIGNS			
		A	R2-1	24	30			5.00																			X		
NB	2.560	A	R2-1	24	30		SPEED LIMIT 40 						1		X														
		A	W1-2R	30	30			6.25								1		X									X		
NB	2.675	A	VD-062AI	72	16		BUSINESS SIGN			1				X															
		A	VD-062B	72	16		BUSINESS SIGN			1																			
NB	2.860	A	W1-4L	30	30		REVERSE CURVE LEFT 						1		X														
		A	W1-5L	30	30		NEXT 1/2 MILE 	6.25					1			1		X									X		
		A	W7-3A	24	18			3.00																			X		
NB	2.892	D	R1-1	30	30		STOP 	6.25								1		X									INSTALL GATEPOSTED STOP SIGN ON SOUTH SIDE OF PLAINFIELD BROOK RD	X		
NB	2.895	C	VR-017	24	24								1		X												TH-5, PLAINFIELD BROOK RD			
		C	N/A				TOWN PARKING REGULATION SIGN				1																		
		C	VR-017	24	30		LEGAL LOAD LIMIT 24,000 POUNDS 	5.00								1		X										E-141	
		C	N/A									1															RE-INSTALL TOWN'S PARKING REG SIGN BELOW LEGAL LOAD			
NB	2.905	D	R1-1	24	24		STOP 				1		1		X												TH-5, PLAINFIELD BROOK RD			
		D	R1-1	30	30			6.25				1				1		X									X		
SIGN SUMMARY SHEET							SHEET TOTALS	38.00 SF	0.00 SF	2 EA	~~2~~ 1 EA	~~2~~ 1 EA	~~5~~ 4 EA	0 EA	0 EA	5 EA	75 FT												
VERMONT AGENCY OF TRANSPORTATION							TOWN TOTALS	583.8 SF	0.0 SF	48.0 EA	9.0 EA	9.0 EA	115 EA	0.0 EA	0.0 EA	89 EA	1335.0 FT												

PROJECT NAME: **Hartford-East Montpelier VT14**
PROJECT NUMBER: **STPG SIGN(21)**

FILE NAME: **Barre Town.xls** PLOT DATE: **6/18/2009**
PROJECT MANAGER: **N. Averv** DRAWN BY: **T. Guazzoni**
DESIGNED BY: **A. Gamble** CHECKED BY: **S. Menard**
BARRE TOWN SHEET 11 SHEET **125** OF **162**

DIRECTION	MILEPOINT	LOCATION CODE (SHEET 2)	SIGN CODE	WIDTH (IN)	HEIGHT (IN)	SHEETING REMARKS	SIGN LEGEND FOR ALL POST LENGTHS AND INSTALLATION DATES SEE ORIGINAL RECORD PLANS	NEW SIGNS "A"	NEW SIGNS "B"	EXISTING SIGNS RETAIN	EXISTING SIGNS SALVAGE FROM	EXISTING SIGNS SALVAGE TO	EXISTING SIGNS REMOVE	EXIST POST RETAIN	EXIST POST REMOVE	NUMBER OF NEW POSTS	SQUARE STEEL (IN) 1.75 (LB / FT) 1.88	SQUARE STEEL (IN) 2.00 (LB / FT) 2.42	SQUARE STEEL (IN) 2.50 (LB / FT) 3.35	TUBULAR STEEL Ø (IN) FOUNDATION	TUBULAR STEEL Ø (IN) 3.00 (LB / FT) 7.60	TUBULAR STEEL Ø (IN) 3.50 (LB / FT) 9.00	TUBULAR STEEL Ø (IN) 4.00 (LB / FT) 10.80	TUBULAR STEEL Ø (IN) 5.00 (LB / FT) 14.60	SIGN FRAME REQUIRED	REMARKS	SIGN DETAIL: DETAIL IN SHS	SIGN DETAIL: DETAIL ON SHEET NUMBER	SIGN DETAIL: DETAIL ON STD SHEET NUMBER
BARRE TOWN VT 14							FY-FLUORESCENT YELLOW FYG-FLUORESCENT YELLOW GREEN																			"SHS"-STANDARD HIGHWAY SIGNS			
NB	2.950	A	W2-2L	30	30		INTERSECTION WARNING			1				X														
		A	W16-8A	30	8		PINE HILL RD			1																		
NB	3.175	A	R2-1	24	30		SPEED LIMIT 40						0 1		X													
		A	R2-1	24	30			5.00								1		X								X		
NB	3.230	A	W11-6H	30	30		SNOWMOBILE (HINGED)			1				X														
NB	3.340	A	W2-2MaR	30	30		Clark Rd	6.25								1		X									INSTALL 250 FT +/- NORTH OF AUTO DEALER DRIVEWAY		6	
		A	W16-8A	24	8			1.33																			CLARK RD		7	
NB	3.410	C	VR-017	24	24		LEGAL LOAD LIMIT 24,000 POUNDS						1		X														
		C	VR-017	24	30			5.00								1		X									TH-15, CLARK RD			E-141
NB	3.415	D	R1-1	24	24		STOP						1		X													
		D	R1-1	30	30			6.25								1		X									TH-15, CLARK RD		X	
NB	3.470	A	R2-1	24	30		SPEED LIMIT 50						1		X													
		A	R2-1	24	30			5.00								1		X								X		
NB	3.780	A	VW-060	30	30		HIDDEN DRIVES						1		X													
		A	W1-4R					6.25 6.25								1		X								X	NEW MISSING, STOLEN REDO		X	
							SHEET TOTALS	35.08 41.33	0.00	3	0	0	4 5	0	0	6	90									
								SF	SF	EA	EA	EA	EA	EA	EA	EA	FT									
							TOWN TOTALS	583.8	0.0	48.0	9.0	9.0	115	0.0	0.0	89	1335.0									

SIGN SUMMARY SHEET

VERMONT AGENCY OF TRANSPORTATION

PROJECT NAME: **Hartford-East Montpelier VT14**
PROJECT NUMBER: **STPG SIGN(21)**

FILE NAME: **Barre Town.xls** PLOT DATE: **6/18/2009**
PROJECT MANAGER: **N. Averv** DRAWN BY: **T. Guazzoni**
DESIGNED BY: **A. Gamble** CHECKED BY: **S. Menard**
BARRE TOWN SHEET 12 SHEET **126** OF **162**

DIRECTION	MILEPOINT	LOCATION CODE (SHEET 2)	SIGN CODE	WIDTH (IN)	HEIGHT (IN)	SHEETING REMARKS	SIGN LEGEND FOR ALL POST LENGTHS AND INSTALLATION DATES SEE ORIGINAL RECORD PLANS	NEW SIGNS "A"	NEW SIGNS "B"	EXISTING SIGNS RETAIN	EXISTING SIGNS SALVAGE FROM	EXISTING SIGNS SALVAGE TO	EXISTING SIGNS REMOVE	EXIST POST RETAIN	EXIST POST REMOVE	NUMBER OF NEW POSTS	SQUARE STEEL (IN) 1.75 (LB / FT) 1.88	SQUARE STEEL (IN) 2.00 (LB / FT) 2.42	SQUARE STEEL (IN) 2.50 (LB / FT) 3.35	TUBULAR STEEL Ø (IN) FOUNDATION	TUBULAR STEEL Ø (IN) 3.00 (LB / FT) 7.60	TUBULAR STEEL Ø (IN) 3.50 (LB / FT) 9.00	TUBULAR STEEL Ø (IN) 4.00 (LB / FT) 10.80	TUBULAR STEEL Ø (IN) 5.00 (LB / FT) 14.60	SIGN FRAME REQUIRED	REMARKS	SIGN DETAIL: DETAIL IN SHS	SIGN DETAIL: DETAIL ON SHEET NUMBER	SIGN DETAIL: DETAIL ON STD SHEET NUMBER
BARRE TOWN VT 14							FY-FLUORESCENT YELLOW FYG-FLUORESCENT YELLOW GREEN																			"SHS"-STANDARD HIGHWAY SIGNS			
			VW-060	30	30			6.25																					E-154
SB	3.825	G	VR-017	24	24						1		1		X														
		G	VR-017	24	30			5.00				1				1		X									TH-13, SUNBAY RD			E-141
SB	3.820	H	R1-1	24	24								1		X														
		H	R1-1	30	30			6.25								1		X									TH-13, SUNBAY RD	X		
SB	3.680	F	VW-168R	30	30		HIDDEN SIDE RD RIGHT 						1		X														
SB	3.640	F	W1-4L	30	30			6.25								1		X									INSTALL 200 FT +/- SOUTH OF EXISTING HIDDEN SIDE ROAD SIGN (TO BE REMOVED)	X		
		F	VW-054	30	30			6.25																					E-154
SB	3.600	F	R2-5A	24	30		REDUCED SPEED AHEAD						1		X														
SB	3.570	F	W3-5	36	36			9.00								2		X							INSTALL 150 FT +/- SOUTH OF EXISTING RSA (TO BE REMOVED)	X		
SB	3.470	F	R2-1	24	30								1		X														
		F	R2-1	30	36			7.50								1		X										6	
SB	3.450	F	W7-1	30	30								1		X														
		F	W7-1B	30	30			6.25								1		X										X		
SB	3.400	F	W11-6H	30	30		SNOWMOBILE (HINGED)			1				X																
							SHEET TOTALS	52.75	0.00	1	~~0~~ 1	~~0~~ 1	6	0	0	7		105										
								SF	SF	EA	EA	EA	EA	EA	EA	EA		FT										
							TOWN TOTALS	583.8	0.0	48.0	9.0	9.0	115	0.0	0.0	89		1335.0										

SIGN SUMMARY SHEET

VERMONT AGENCY OF TRANSPORTATION

PROJECT NAME: **Hartford-East Montpelier VT14**
PROJECT NUMBER: **STPG SIGN(21)**

FILE NAME: **Barre Town.xls**
PROJECT MANAGER: **N. Avery**
DESIGNED BY: **A. Gamble**
BARRE TOWN SHEET 13

PLOT DATE: **6/18/2009**
DRAWN BY: **T. Guazzoni**
CHECKED BY: **S. Menard**
SHEET **127** OF **162**

DIRECTION	MILEPOINT	LOCATION CODE (SHEET 2)	SIGN CODE	WIDTH (IN)	HEIGHT (IN)	SHEETING REMARKS	SIGN LEGEND FOR ALL POST LENGTHS AND INSTALLATION DATES SEE ORIGINAL RECORD PLANS	NEW SIGNS "A"	NEW SIGNS "B"	EXISTING SIGNS RETAIN	EXISTING SIGNS SALVAGE FROM	EXISTING SIGNS SALVAGE TO	EXISTING SIGNS REMOVE	EXIST POST RETAIN	EXIST POST REMOVE	NUMBER OF NEW POSTS	SQUARE STEEL (IN) 1.75 (LB / FT) 1.88	SQUARE STEEL (IN) 2.00 (LB / FT) 2.42	SQUARE STEEL (IN) 2.50 (LB / FT) 3.35	TUBULAR STEEL Ø (IN) FOUNDATION	TUBULAR STEEL Ø (IN) 3.00 (LB / FT) 7.60	TUBULAR STEEL Ø (IN) 3.50 (LB / FT) 9.00	TUBULAR STEEL Ø (IN) 4.00 (LB / FT) 10.80	TUBULAR STEEL Ø (IN) 5.00 (LB / FT) 14.60	SIGN FRAME REQUIRED	REMARKS	SIGN DETAIL DETAIL IN SHS	SIGN DETAIL DETAIL ON SHEET NUMBER	SIGN DETAIL DETAIL ON STD SHEET NUMBER
BARRE TOWN VT 14							FY-FLUORESCENT YELLOW FYG-FLUORESCENT YELLOW GREEN																			"SHS"-STANDARD HIGHWAY SIGNS			
SB	3.290	F	W1-5R	30	30			6.25								1		X							INSTALL BY NORTH CORNER OF PARKING LOT	X		
			W7-3A	24	18			3.00																			X		
SB	3.220	F	W1-4R	30	30		REVERSE CURVE						1		X														
SB	3.200	F	W2-2R	30	30		SIDE ROAD RIGHT						1		X														
		F	W16-8A	30	8		PINE HILL RD PLAQUE						1																
SB	3.120	F	R2-1	24	30								1		X														
		F	R2-1	24	30			5.00								1		X									X		
SB	3.090	F	W2-2MaR	30	30			6.25								1		X							INSTALL 10 FT NORTH OF UTILITY POLE		6	
		F	W16-8A	30	8			1.67																				7	
SB	3.025	G	VR-017	24	24						1		1		X														
		G	VR-017	24	30			5.00				1				1		X							TH-9, PINE HILL RD			E-141
SB	3.020	H	R1-1	24	24								1		X														
		H	R1-2	30	30			6.25								1		X							TH-9, PINE HILL RD	X		
SB	2.700	F	R2-1	24	30								1		X														
		F	R2-1	24	30			5.00								1		X								X		
							SHEET TOTALS	38.42	0.00	0	~~0~~ 1	~~0~~ 1	7	0	0	6	90											
								SF	SF	EA	EA	EA	EA	EA	EA	EA	FT											
							TOWN TOTALS	583.8	0.0	48.0	9.0	9.0	115	0.0	0.0	89	1335.0											

SIGN SUMMARY SHEET

VERMONT AGENCY OF TRANSPORTATION

PROJECT NAME: **Hartford-East Montpelier VT14**
PROJECT NUMBER: **STPG SIGN(21)**

FILE NAME: **Barre Town.xls**
PROJECT MANAGER: **N. Averv**
DESIGNED BY: **A. Gamble**
BARRE TOWN SHEET 14

PLOT DATE: **6/18/2009**
DRAWN BY: **T. Guazzoni**
CHECKED BY: **S. Menard**
SHEET **128** OF **162**

DIRECTION	MILEPOINT	LOCATION CODE (SHEET 2)	SIGN CODE	WIDTH (IN)	HEIGHT (IN)	SHEETING REMARKS	SIGN LEGEND	NEW SIGNS "A"	NEW SIGNS "B"	EXISTING SIGNS RETAIN	EXISTING SIGNS SALVAGE FROM	EXISTING SIGNS SALVAGE TO	EXISTING SIGNS REMOVE	EXIST POST RETAIN	EXIST POST REMOVE	NUMBER OF NEW POSTS	SQUARE STEEL (IN) 1.75 (LB / FT) 1.88	SQUARE STEEL (IN) 2.00 (LB / FT) 2.42	SQUARE STEEL (IN) 2.50 (LB / FT) 3.35	TUBULAR STEEL Ø (IN) FOUNDATION	TUBULAR STEEL Ø (IN) 3.00 (LB / FT) 7.60	TUBULAR STEEL Ø (IN) 3.50 (LB / FT) 9.00	TUBULAR STEEL Ø (IN) 4.00 (LB / FT) 10.80	TUBULAR STEEL Ø (IN) 5.00 (LB / FT) 14.60	SIGN FRAME REQUIRED	REMARKS	SIGN DETAIL: DETAIL IN SHS	SIGN DETAIL: DETAIL ON SHEET NUMBER	SIGN DETAIL: DETAIL ON STD SHEET NUMBER
BARRE TOWN VT 14							FY-FLUORESCENT YELLOW FYG-FLUORESCENT YELLOW GREEN																			"SHS"-STANDARD HIGHWAY SIGNS			
SB	2.490	F	VD-062B(	74.75	16		BUSINESS SIGN			1				X														
SB	2.490	F	VD-062C	74.75	16		BUSINESS SIGN			1																		
SB	2.430	F	R2-5A	24	30		REDUCED SPEED AHEAD 						1		X													
		F	W3-5	36	36			9.00								2		X								X		
SB	2.364	F	VD-062B	72	16		BUSINESS SIGN			1				X														
SB	2.321	F	VR-038	24	24		STATE HIGHWAY ENDS						1		X													
		F	R2-1	24	30		SPEED LIMIT 25						1															
		F	N/A				UNLESS OTHERWISE POSTED IN CITY LIMITS				1																	
		F	VR-038	24	18			3.00								1		X										E-141
		F	R2-1	30	36			7.50																		6		
		F	N/A									1													RE-INSTALL TOWN'S "UNLESS OTHERWISE POSTED" PLAQUE BELOW SL 25			
																										2.1 MILES IN BARRE CITY, THEN BARRE TOWN RESUMES			
SB	2.319	G	VD-024	60	7.5		STATE HIGHWAY BEGIN						1		X											NEW TL SIGN IS ON NB SIDE			
SB	2.319	F	VR-039	24	18		STATE HIGHWAY BEGINS						1		X													
		F	R2-1	24	30		SPEED LIMIT 35						1															
							SHEET TOTALS	19.50	0.00	3	1	1	6	0	0	3		45									
								SF	SF	EA	EA	EA	EA	EA	EA	EA		FT									
							TOWN TOTALS	583.8	0.0	48.0	9.0	9.0	115	0.0	0.0	89		1335.0									

SIGN SUMMARY SHEET

VERMONT AGENCY OF TRANSPORTATION

PROJECT NAME: **Hartford-East Montpelier VT14**
PROJECT NUMBER: **STPG SIGN(21)**
FILE NAME: **Barre Town.xls**
PROJECT MANAGER: **N. Avery**
DESIGNED BY: **A. Gamble**
BARRE TOWN SHEET 15
PLOT DATE: **6/18/2009**
DRAWN BY: **T. Guazzoni**
CHECKED BY: **S. Menard**
SHEET **129** OF **162**

DIRECTION	MILEPOINT	LOCATION CODE (SHEET 2)	SIGN CODE	WIDTH (IN)	HEIGHT (IN)	SHEETING REMARKS	SIGN LEGEND FOR ALL POST LENGTHS AND INSTALLATION DATES SEE ORIGINAL RECORD PLANS	NEW SIGNS "A"	NEW SIGNS "B"	EXISTING SIGNS RETAIN	EXISTING SIGNS SALVAGE FROM	EXISTING SIGNS SALVAGE TO	EXISTING SIGNS REMOVE	EXIST POST RETAIN	EXIST POST REMOVE	NUMBER OF NEW POSTS	SQUARE STEEL (IN) 1.75 (LB / FT) 1.88	SQUARE STEEL (IN) 2.00 (LB / FT) 2.42	SQUARE STEEL (IN) 2.50 (LB / FT) 3.35	TUBULAR STEEL Ø (IN) FOUNDATION	TUBULAR STEEL Ø (IN) 3.00 (LB / FT) 7.60	TUBULAR STEEL Ø (IN) 3.50 (LB / FT) 9.00	TUBULAR STEEL Ø (IN) 4.00 (LB / FT) 10.80	TUBULAR STEEL Ø (IN) 5.00 (LB / FT) 14.60	SIGN FRAME REQUIRED	REMARKS	SIGN DETAIL: DETAIL IN SHS	SIGN DETAIL: DETAIL ON SHEET NUMBER	SIGN DETAIL: DETAIL ON STD SHEET NUMBER
BARRE TOWN VT 14							FY-FLUORESCENT YELLOW FYG-FLUORESCENT YELLOW GREEN																			"SHS"-STANDARD HIGHWAY SIGNS			
		F	VR-039	24	18		STATE HIGHWAY BEGINS	3.00								1		X										E-141
		F	R2-1	24	30		SPEED LIMIT 35	5.00																			X	
SB	2.170	F	VD-018	30	18		SOUTH BARRE WILLIAMSTOWN 4						1		X													
		F	VD-018	30	18			3.75								1		X										E-128B
SB	2.120	F	W2-1	36	36								1	X												ASSEMBLY HAS FLASHING BEACONS. RETAIN POSTS AND BEACONS.			
		F	W16-2	24	18								1															
		F	W2-1Mb	36	36	FY	700 FEET	9.00																				6	
		F	W16-2	24	18	FY		3.00																			X	
SB	2.080	F	R2-1	24	30								1		X													
		F	R2-1	24	30		SPEED LIMIT 35	5.00								1		X									X	
SB	2.060	F	W11-2	30	30		PEDESTRIAN						1		X													
SB	2.050	F	W11-2	30	30	FYG		6.25								1		X									X	
SB	1.980	G	VR-017	24	24						1		1		X											TH-7, BRIDGE ST		
		G	N/A				TOWN PARKING REGULATION SIGN LEGAL LOAD LIMIT 24,000 POUNDS				1																	
		G	VR-017	24	30			5.00								1		X										E-141
SIGN SUMMARY SHEET							SHEET TOTALS	40.00 SF	0.00 SF	0 EA	2 1 EA	0 EA	6 EA	0 EA	0 EA	5 EA	75 FT											
VERMONT AGENCY OF TRANSPORTATION							TOWN TOTALS	583.8	0.0	48.0	9.0	9.0	115	0.0	0.0	89	1335.0											

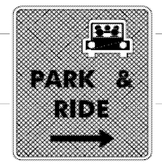
PROJECT NAME: Hartford-East Montpelier VT14
PROJECT NUMBER: STPG SIGN(21)

FILE NAME: Barre Town.xls
PROJECT MANAGER: N. Avery
DESIGNED BY: A. Gamble
BARRE TOWN SHEET 16

PLOT DATE: 6/18/2009
DRAWN BY: T. Guazzoni
CHECKED BY: S. Menard
SHEET 130 OF 162

DIRECTION	MILEPOINT	LOCATION CODE (SHEET 2)	SIGN CODE	WIDTH (IN)	HEIGHT (IN)	SHEETING REMARKS	SIGN LEGEND FOR ALL POST LENGTHS AND INSTALLATION DATES SEE ORIGINAL RECORD PLANS	NEW SIGNS "A"	NEW SIGNS "B"	EXISTING SIGNS RETAIN	EXISTING SIGNS SALVAGE FROM	EXISTING SIGNS SALVAGE TO	EXISTING SIGNS REMOVE	EXIST POST RETAIN	EXIST POST REMOVE	NUMBER OF NEW POSTS	SQUARE STEEL (IN) 1.75 (LB / FT) 1.88	SQUARE STEEL (IN) 2.00 (LB / FT) 2.42	SQUARE STEEL (IN) 2.50 (LB / FT) 3.35	TUBULAR STEEL Ø (IN) FOUNDATION	TUBULAR STEEL Ø (IN) 3.00 (LB / FT) 7.60	TUBULAR STEEL Ø (IN) 3.50 (LB / FT) 9.00	TUBULAR STEEL Ø (IN) 4.00 (LB / FT) 10.80	TUBULAR STEEL Ø (IN) 5.00 (LB / FT) 14.60	SIGN FRAME REQUIRED	REMARKS	SIGN DETAIL DETAIL IN SHS	SIGN DETAIL DETAIL ON SHEET NUMBER	SIGN DETAIL DETAIL ON STD SHEET NUMBER
BARRE TOWN VT 14							FY-FLUORESCENT YELLOW FYG-FLUORESCENT YELLOW GREEN																				"SHS"-STANDARD HIGHWAY SIGNS			
		G	N/A				TOWN PARKING REGULATION SIGN					2 ~~4~~														RE-INSTALL TOWN'S PARKING REG SIGN BELOW LEGAL LOAD			
SB	1.975	H	R1-1	24	24								1		X												TH-7, BRIDGE ST			
		H	R1-1	30	30			6.25								1		X										X		
SB	1.970	F	R8-3	24	30								1		X															
		F	R8-3A	24	24			4.00								1		X										X		
SB	1.945	F	R8-3	24	30								1		X															
		F	R8-3A	24	24			4.00								1		X										X		
SB	1.930	F	VD-062A	72	16		BUSINESS SIGN			1				X																
SB	1.930	F	VD-062A	72	16		BUSINESS SIGN			1																				
SB	1.875	F	R2-1	24	30								1		X															
		F	R2-1	24	30			5.00								1		X										X		
SB	1.865	G	VR-017	24	24								1		X												TH-110, STEVENS LANE			
		G	N/A				TOWN PARKING REGULATION SIGN 				1																			
		G	VR-017	24	30			5.00				1 ~~2~~	1 ~~2~~			1		X												E-141
		G	N/A				TOWN PARKING REGULATION SIGN					1														RE-INSTALL TOWN'S PARKING REG SIGN BELOW LEGAL LOAD			
SIGN SUMMARY SHEET							SHEET TOTALS	24.25 SF	0.00 SF	2 EA	1 EA	4 ~~2~~ EA	6 ~~5~~ EA	0 EA	0 EA	5 EA		75 FT											
VERMONT AGENCY OF TRANSPORTATION							TOWN TOTALS	583.8	0.0	48.0	9.0	9.0	115	0.0	0.0	89		1335.0											

PROJECT NAME: **Hartford-East Montpelier VT14**
PROJECT NUMBER: **STPG SIGN(21)**
FILE NAME: **Barre Town.xls**
PROJECT MANAGER: **N. Averv**
DESIGNED BY: **A. Gamble**
PLOT DATE: **6/18/2009**
DRAWN BY: **T. Guazzoni**
CHECKED BY: **S. Menard**
BARRE TOWN SHEET 17
SHEET **131** OF **162**

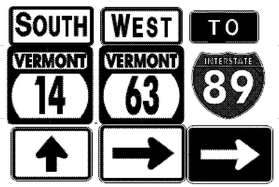
DIRECTION	MILEPOINT	LOCATION CODE (SHEET 2)	SIGN CODE	WIDTH (IN)	HEIGHT (IN)	SHEETING REMARKS	SIGN LEGEND	NEW SIGNS "A"	NEW SIGNS "B"	EXISTING SIGNS RETAIN	EXISTING SIGNS SALVAGE FROM	EXISTING SIGNS SALVAGE TO	EXISTING SIGNS REMOVE	EXIST POST RETAIN	EXIST POST REMOVE	NUMBER OF NEW POSTS	SQUARE STEEL (IN) 1.75 (LB / FT) 1.88	SQUARE STEEL (IN) 2.00 (LB / FT) 2.42	SQUARE STEEL (IN) 2.50 (LB / FT) 3.35	TUBULAR STEEL Ø (IN) FOUNDATION	TUBULAR STEEL Ø (IN) 3.00 (LB / FT) 7.60	TUBULAR STEEL Ø (IN) 3.50 (LB / FT) 9.00	TUBULAR STEEL Ø (IN) 4.00 (LB / FT) 10.80	TUBULAR STEEL Ø (IN) 5.00 (LB / FT) 14.60	SIGN FRAME REQUIRED	REMARKS	SIGN DETAIL: DETAIL IN SHS	SIGN DETAIL: DETAIL ON SHEET NUMBER	SIGN DETAIL: DETAIL ON STD SHEET NUMBER
BARRE TOWN VT 14							FY-FLUORESCENT YELLOW FYG-FLUORESCENT YELLOW GREEN																			"SHS"-STANDARD HIGHWAY SIGNS			
SB	1.860	H	R1-1	24	24								1		X													
		H	R1-1	30	30			6.25								1		X								X		
SB	1.830	F	VR-921L	30	30								1		X													
		F	VR-921L	30	30			6.25								1		X										E-145A
SB	1.800	F	W3-3	36	36								1		X													
		F	W3-3	36	36			9.00								2		X								X		
SB	1.795	F	M2-1	21	15		JCT						1		X													
		F	M1-5	24	24		VT 63						1															
SB	1.785	F	M2-1	21	15			2.19								1		X								GREEN ON WHITE SHEETING. INSTALL 5 FT NORTH OF PARK&RIDE LOT RAISED ISLAND	X		
		F	M1-5	24	24			4.00																				E-136B
SB	1.775	F	D4-2	30	36								1		X													
		F	VD-365	30	6		1-800-685-RIDE						1														REMOVE AND DO NOT REPLACE PHONE NUMBER PLAQUE			
		F	D4-2	30	36			7.50								1		X								X		
SB	1.755	H	R1-1	30	30								1		X													
		H	R1-1	30	30			6.25								1		X								PARK&RIDE EXIT	X		
SIGN SUMMARY SHEET							SHEET TOTALS	41.44	0.00	0	0	0	8	0	0	7		105									
								SF	SF	EA	EA	EA	EA	EA	EA	EA		FT									
VERMONT AGENCY OF TRANSPORTATION							TOWN TOTALS	583.8	0.0	48.0	9.0	9.0	115	0.0	0.0	89		1335.0									

PROJECT NAME: **Hartford-East Montpelier VT14**
PROJECT NUMBER: **STPG SIGN(21)**

FILE NAME: **Barre Town.xls** PLOT DATE: **6/18/2009**
PROJECT MANAGER: **N. Averv** DRAWN BY: **T. Guazzoni**
DESIGNED BY: **A. Gamble** CHECKED BY: **S. Menard**
BARRE TOWN SHEET 18 SHEET **132** OF **162**

DIRECTION	MILEPOINT	LOCATION CODE (SHEET 2)	SIGN CODE	WIDTH (IN)	HEIGHT (IN)	SHEETING REMARKS	SIGN LEGEND FOR ALL POST LENGTHS AND INSTALLATION DATES SEE ORIGINAL RECORD PLANS	NEW SIGNS "A"	NEW SIGNS "B"	EXISTING SIGNS RETAIN	EXISTING SIGNS SALVAGE FROM	EXISTING SIGNS SALVAGE TO	EXISTING SIGNS REMOVE	EXIST POST RETAIN	EXIST POST REMOVE	NUMBER OF NEW POSTS	SQUARE STEEL (IN) 1.75 (LB / FT) 1.88	SQUARE STEEL (IN) 2.00 (LB / FT) 2.42	SQUARE STEEL (IN) 2.50 (LB / FT) 3.35	TUBULAR STEEL Ø (IN) FOUNDATION	TUBULAR STEEL Ø (IN) 3.00 (LB / FT) 7.60	TUBULAR STEEL Ø (IN) 3.50 (LB / FT) 9.00	TUBULAR STEEL Ø (IN) 4.00 (LB / FT) 10.80	TUBULAR STEEL Ø (IN) 5.00 (LB / FT) 14.60	SIGN FRAME REQUIRED	REMARKS	SIGN DETAIL: DETAIL IN SHS	SIGN DETAIL: DETAIL ON SHEET NUMBER	SIGN DETAIL: DETAIL ON STD SHEET NUMBER
BARRE TOWN VT 14							FY-FLUORESCENT YELLOW FYG-FLUORESCENT YELLOW GREEN																			"SHS"-STANDARD HIGHWAY SIGNS			
SB	1.735	F	D1-1A	54	7.5								1		X														
		F	D1-1A	54	7.5								1																
		F	D1-1A	72	12			6.00								2		X									5	
		F	D1-1A	72	12			6.00																		5	
SB	1.715	F	VR922L	36	30								1		X														
		F	VR922L	36	30			7.50								1 ~~2~~		X									E-145A
SB	1.700	F	M3-3	24	12								1		X														
		F	M1-5	24	24								1																
		F	M6-3	21	15								1																
		F	M3-4	24	12								1																
		F	M1-5	24	24								1																
		F	M6-1	21	15								1																
		F	M4-5	24	12								1																
		F	M1-1	24	24								1																
		F	M6-1	21	15								1																
SIGN SUMMARY SHEET							SHEET TOTALS	19.50	0.00	0	0	0	12	0	0	3 ~~4~~	60										
								SF	SF	EA	EA	EA	EA	EA	EA	EA	FT										
VERMONT AGENCY OF TRANSPORTATION							TOWN TOTALS	583.8	0.0	48.0	9.0	9.0	115	0.0	0.0	89	1335.0										

PROJECT NAME: **Hartford-East Montpelier VT14**
PROJECT NUMBER: **STPG SIGN(21)**
FILE NAME: **Barre Town.xls** PLOT DATE: **6/18/2009**
PROJECT MANAGER: **N. Averv** DRAWN BY: **T. Guazzoni**
DESIGNED BY: **A. Gamble** CHECKED BY: **S. Menard**
BARRE TOWN SHEET 19 SHEET **133** OF **162**

DIRECTION	MILEPOINT	LOCATION CODE (SHEET 2)	SIGN CODE	WIDTH (IN)	HEIGHT (IN)	SHEETING REMARKS	SIGN LEGEND FOR ALL POST LENGTHS AND INSTALLATION DATES SEE ORIGINAL RECORD PLANS	NEW SIGNS "A"	NEW SIGNS "B"	EXISTING SIGNS RETAIN	EXISTING SIGNS SALVAGE FROM	EXISTING SIGNS SALVAGE TO	EXISTING SIGNS REMOVE	EXIST POST RETAIN	EXIST POST REMOVE	NUMBER OF NEW POSTS	SQUARE STEEL (IN) (LB / FT) 1.75 / 1.88	SQUARE STEEL (IN) (LB / FT) 2.00 / 2.42	SQUARE STEEL (IN) (LB / FT) 2.50 / 3.35	TUBULAR STEEL Ø (IN) FOUNDATION	TUBULAR STEEL Ø (IN) (LB / FT) 3.00 / 7.60	TUBULAR STEEL Ø (IN) (LB / FT) 3.50 / 9.00	TUBULAR STEEL Ø (IN) (LB / FT) 4.00 / 10.80	TUBULAR STEEL Ø (IN) (LB / FT) 5.00 / 14.60	SIGN FRAME REQUIRED	REMARKS	SIGN DETAIL: DETAIL IN SHS	SIGN DETAIL: DETAIL ON SHEET NUMBER	SIGN DETAIL: DETAIL ON STD SHEET NUMBER
BARRE TOWN VT 14							FY-FLUORESCENT YELLOW FYG-FLUORESCENT YELLOW GREEN																			"SHS"-STANDARD HIGHWAY SIGNS			
		F	M3-3	24	12			2.00								2		X							#3	GREEN ON WHITE SHEETING	X	7	
		F	M1-5	24	24			4.00																				E-136B
		F	M6-3	21	15			2.19																		GREEN ON WHITE SHEETING	X		
		F	M3-4	24	12			2.00																		GREEN ON WHITE SHEETING	X		
		F	M1-5	24	24			4.00																				E-136B
		F	M6-1	21	15			2.19																	GREEN ON WHITE SHEETING	X		
		F	M4-5	24	12			2.00																		WHITE ON BLUE SHEETING	X		
		F	M1-1	24	24			4.00																			X		
		F	M6-1	21	15			2.19																		WHITE ON BLUE SHEETING	X		
SB	1.690	N	R10-12	24	30								1		X															
		N	R10-12	24	30			5.00								0 ~~1~~		X								INSTALL ON SPAN WIRE NEXT TO LEFT TURN SIGNAL	X		
SB	1.635	F	R2-1	24	30								1		X															
		F	R2-1	24	30			5.00								1		X									X		
SB	1.560	G	VR-017	24	24		LEGAL LOAD LIMIT 24000 LBS			1				X												TH-59, SNOWBRIDGE RD (NORTH)			
SB	1.550	H	R1-1	24	24		STOP			1				X												TH-59, SNOWBRIDGE RD (NORTH)			
SIGN SUMMARY SHEET							SHEET TOTALS	34.57 SF	0.00 SF	2 EA	0 EA	0 EA	2 EA	0 EA	0 EA	3 ~~4~~ EA		60 FT										
VERMONT AGENCY OF TRANSPORTATION							TOWN TOTALS	583.8	0.0	48.0	9.0	9.0	115	0.0	0.0	89		1335.0										

PROJECT NAME: **Hartford-East Montpelier VT14**
PROJECT NUMBER: **STPG SIGN(21)**
FILE NAME: **Barre Town.xls**
PROJECT MANAGER: **N. Averv**
DESIGNED BY: **A. Gamble**
BARRE TOWN SHEET 20
PLOT DATE: **6/18/2009**
DRAWN BY: **T. Guazzoni**
CHECKED BY: **S. Menard**
SHEET **134** OF **162**

DIRECTION	MILEPOINT	LOCATION CODE (SHEET 2)	SIGN CODE	WIDTH (IN)	HEIGHT (IN)	SHEETING REMARKS	SIGN LEGEND	NEW SIGNS "A"	NEW SIGNS "B"	EXISTING SIGNS RETAIN	EXISTING SIGNS SALVAGE FROM	EXISTING SIGNS SALVAGE TO	EXISTING SIGNS REMOVE	EXIST POST RETAIN	EXIST POST REMOVE	NUMBER OF NEW POSTS	SQUARE STEEL (IN) 1.75 (LB / FT) 1.88	SQUARE STEEL (IN) 2.00 (LB / FT) 2.42	SQUARE STEEL (IN) 2.50 (LB / FT) 3.35	TUBULAR STEEL Ø (IN) FOUNDATION	TUBULAR STEEL Ø (IN) 3.00 (LB / FT) 7.60	TUBULAR STEEL Ø (IN) 3.50 (LB / FT) 9.00	TUBULAR STEEL Ø (IN) 4.00 (LB / FT) 10.80	TUBULAR STEEL Ø (IN) 5.00 (LB / FT) 14.60	SIGN FRAME REQUIRED	REMARKS	SIGN DETAIL DETAIL IN SHS	SIGN DETAIL DETAIL ON SHEET NUMBER	SIGN DETAIL DETAIL ON STD SHEET NUMBER
BARRE TOWN VT 14							FY-FLUORESCENT YELLOW FYG-FLUORESCENT YELLOW GREEN																			"SHS"-STANDARD HIGHWAY SIGNS			
SB	1.450	G	VR-017	24	24		LEGAL LOAD LIMIT 24000 LBS			1				X												TH-59, SNOWBRIDGE RD (SOUTH)			
SB	1.445	H	R1-1	24	24		STOP			1				X												TH-59, SNOWBRIDGE RD (SOUTH)			
SB	1.440	F	R2-1	24	30		SPEED LIMIT 40						1		X														
		F	R2-1	24	30			5.00								1		X									X		
SB	1.000	F	R2-1	24	30								1		X														
		F	R2-1	24	30		SPEED LIMIT 40	5.00								1		X									X		
SB	0.540	F	R2-1	24	30		SPEED LIMIT 40						1		X														
		F	R2-1	24	30			5.00								1		X									X		
SB	0.050	F	W11-10	30	30		TRUCK ENTERING SYMBOL			1				X												ASSEMBLY HAS SOLAR FLASHING BEACON ATTACHED			
		F	S4-4M	24	10		WHEN FLASHING (YELLOW BKGRND)			1																			
SIGN SUMMARY SHEET							SHEET TOTALS	15.00	0.00	4	0	0	3	0	0	3		45										
								SF	SF	EA	EA	EA	EA	EA	EA	EA		FT										
VERMONT AGENCY OF TRANSPORTATION							TOWN TOTALS	583.8	0.0	48.0	9.0	9.0	115	0.0	0.0	89		1335.0										

PROJECT NAME: **Hartford-East Montpelier VT14**
PROJECT NUMBER: **STPG SIGN(21)**

FILE NAME: **Barre Town.xls** PLOT DATE: **6/18/2009**
PROJECT MANAGER: **N. Averv** DRAWN BY: **T. Guazzoni**
DESIGNED BY: **A. Gamble** CHECKED BY: **S. Menard**
BARRE TOWN SHEET 21 SHEET **135** OF **162**

DIRECTION	MILEPOINT	LOCATION CODE (SHEET 2)	SIGN CODE	WIDTH (IN)	HEIGHT (IN)	SHEETING REMARKS	SIGN LEGEND FOR ALL POST LENGTHS AND INSTALLATION DATES SEE ORIGINAL RECORD PLANS	NEW SIGNS "A"	NEW SIGNS "B"	EXISTING SIGNS RETAIN	EXISTING SIGNS SALVAGE FROM	EXISTING SIGNS SALVAGE TO	EXISTING SIGNS REMOVE	EXIST POST RETAIN	EXIST POST REMOVE	NUMBER OF NEW POSTS	SQUARE STEEL (IN) 1.75 (LB / FT) 1.88	SQUARE STEEL (IN) 2.00 (LB / FT) 2.42	SQUARE STEEL (IN) 2.50 (LB / FT) 3.35	TUBULAR STEEL Ø (IN) FOUNDATION	TUBULAR STEEL Ø (IN) 3.00 (LB / FT) 7.60	TUBULAR STEEL Ø (IN) 3.50 (LB / FT) 9.00	TUBULAR STEEL Ø (IN) 4.00 (LB / FT) 10.80	TUBULAR STEEL Ø (IN) 5.00 (LB / FT) 14.60	SIGN FRAME REQUIRED	REMARKS	SIGN DETAIL DETAIL IN SHS	SIGN DETAIL DETAIL ON SHEET NUMBER	SIGN DETAIL DETAIL ON STD SHEET NUMBER
E MONTPELIER VT 14							FY-FLUORESCENT YELLOW FYG-FLUORESCENT YELLOW GREEN																			"SHS"-STANDARD HIGHWAY SIGNS			
NB	0.000	A	VD-024	72	10			5.00					1			2		X								INSTALL OPPOSITE EXISTING TOWN LINE SIGN		4	
		A	VD-700	6	10		EAST MONTPELIER 0140 1207 0000 / BARRE TOWN 0140 1202 0403	0.42																		EAST MONTPELIER MILE MARKER. INSTALL ON LEFT POST UNDER EAST MONTPELIER			E-138
		A	VD-700	6	10			0.42																		BARRE TOWN MILE MARKER. INSTALL ON RIGHT POST UNDER BARRE TOWN			E-138
NB	0.550	A	W11-6H	30	30								1		X														
		A	W11-6H	30	30		HINGED	6.25								1		X								INSTALL IN CLOSED POSITION			E-153
NB	0.705	A	M1-5A	24	24		ROUTE MARKER						1		X														
NB	0.930	A	VD-062A	72	16		BUSINESS SIGN			1				X															
		A	VD-062B	72	16					1																			
NB	0.970	A	W11-6H	30	30								1																
		A	W11-6H	30	30		HINGED	6.25								1		X								INSTALL IN CLOSED POSITION			E-153
NB	1.070	A	W1-4L	30	30		REVERSE CURVE W/SIDE RD						~~2~~ 1		X												REMOVED MM PLAQUE			
		A	W13-1	18	18		35 MPH PLAQUE						1																
		A	W1-4ML	30	30		East Hill Rd	6.25								1		X										6	
		A	W16-8	30	8			1.67																		EAST HILL RD		7	
NB	1.265	C	VR-017	24	30								1		X														
SIGN SUMMARY SHEET							SHEET TOTALS	26.26 SF	0.00 SF	2 EA	0 EA	0 EA	~~8~~ 5 EA	0 EA	0 EA	5 EA	75 FT											
VERMONT AGENCY OF TRANSPORTATION							TOWN TOTALS	803.2	0.0	27.0	3.0	3.0	149	0.0	0.0	132	1980.0											

PROJECT NAME: Hartford-East Montpelier VT14
PROJECT NUMBER: STPG SIGN(21)

FILE NAME: East Montpelier.xls
PROJECT MANAGER: N. Averv
DESIGNED BY: M. Miller
EAST MONTPELIER SHEET 1

PLOT DATE: 6/18/2009
DRAWN BY: T. Guazzoni
CHECKED BY: S. Menard
SHEET 136 OF 162

DIRECTION	MILEPOINT	LOCATION CODE (SHEET 2)	SIGN CODE	WIDTH (IN)	HEIGHT (IN)	SHEETING REMARKS	SIGN LEGEND	NEW SIGNS "A"	NEW SIGNS "B"	EXISTING SIGNS RETAIN	EXISTING SIGNS SALVAGE FROM	EXISTING SIGNS SALVAGE TO	EXISTING SIGNS REMOVE	EXIST POST RETAIN	EXIST POST REMOVE	NUMBER OF NEW POSTS	SQUARE STEEL (IN) 1.75 (LB / FT) 1.88	SQUARE STEEL (IN) 2.00 (LB / FT) 2.42	SQUARE STEEL (IN) 2.50 (LB / FT) 3.35	TUBULAR STEEL Ø (IN) FOUNDATION	TUBULAR STEEL Ø (IN) 3.00 (LB / FT) 7.60	TUBULAR STEEL Ø (IN) 3.50 (LB / FT) 9.00	TUBULAR STEEL Ø (IN) 4.00 (LB / FT) 10.80	TUBULAR STEEL Ø (IN) 5.00 (LB / FT) 14.60	SIGN FRAME REQUIRED	REMARKS	SIGN DETAIL: DETAIL IN SHS	SIGN DETAIL: DETAIL ON SHEET NUMBER	SIGN DETAIL: DETAIL ON STD SHEET NUMBER
E MONTPELIER VT 14							FY-FLUORESCENT YELLOW FYG-FLUORESCENT YELLOW GREEN																			"SHS"-STANDARD HIGHWAY SIGNS			
		C	VR-017	24	30			5.00								1		X							TH 52, EAST HILL RD			E-141
NB	1.275	D	R1-1	30	30								1		X													
		D	R1-1	30	30			6.25								1		X							TH 52, EAST HILL RD	X		
NB	1.460	A	W1-2L	30	30		LEFT CURVE W/SIDE RDS						1		X													
		A	W13-1	18	18		35 MPH PLAQUE						1															
NB	1.505	A	W1-10L	30	30			6.25								1		X							INSTALL 250 FT +/- NORTH OF EXISTING	X		
		A	W16-8	24	8			1.33																	FAIR RD		7	
NB	1.545	B	W1-8R	18	24								1		X													
		A	W1-8L	24	30	FY		5.00								1		X							INSTALL ON SEPARATE POSTS 5 FEET APART	X		
		B	W1-8R	24	30	FY		5.00								1		X								X		
NB	1.565	B	W1-8R	18	24								1		X													
		A	W1-8L	24	30	FY		5.00								1		X							INSTALL ON SEPARATE POSTS 5 FEET APART	X		
		B	W1-8R	24	30	FY		5.00								1		X								X		
NB	1.580	D	R1-1	24	24								1		X													
		D	R1-1	30	30			6.25								1		X							TH 51, FAIR RD	X		
SIGN SUMMARY SHEET							SHEET TOTALS	45.08 SF	0.00 SF	0 EA	0 EA	0 EA	6 EA	0 EA	0 EA	8 EA	120 FT										
VERMONT AGENCY OF TRANSPORTATION							TOWN TOTALS	803.2	0.0	27.0	3.0	3.0	149	0.0	0.0	132	1980.0										

PROJECT NAME: **Hartford-East Montpelier VT14**
PROJECT NUMBER: **STPG SIGN(21)**

FILE NAME: **East Montpelier.xls** PLOT DATE: **6/18/2009**
PROJECT MANAGER: **N. Avery** DRAWN BY: **T. Guazzoni**
DESIGNED BY: **M. Miller** CHECKED BY: **S. Menard**
EAST MONTPELIER SHEET 2 SHEET **137** OF **162**

DIRECTION	MILEPOINT	LOCATION CODE (SHEET 2)	SIGN CODE	WIDTH (IN)	HEIGHT (IN)	SHEETING REMARKS	SIGN LEGEND FOR ALL POST LENGTHS AND INSTALLATION DATES SEE ORIGINAL RECORD PLANS	NEW SIGNS "A"	NEW SIGNS "B"	EXISTING SIGNS RETAIN	EXISTING SIGNS SALVAGE FROM	EXISTING SIGNS SALVAGE TO	EXISTING SIGNS REMOVE	EXIST POST RETAIN	EXIST POST REMOVE	NUMBER OF NEW POSTS	SQUARE STEEL (IN) 1.75 (LB / FT) 1.88	SQUARE STEEL (IN) 2.00 (LB / FT) 2.42	SQUARE STEEL (IN) 2.50 (LB / FT) 3.35	TUBULAR STEEL Ø (IN) FOUNDATION	TUBULAR STEEL Ø (IN) 3.00 (LB / FT) 7.60	TUBULAR STEEL Ø (IN) 3.50 (LB / FT) 9.00	TUBULAR STEEL Ø (IN) 4.00 (LB / FT) 10.80	TUBULAR STEEL Ø (IN) 5.00 (LB / FT) 14.60	SIGN FRAME REQUIRED	REMARKS	SIGN DETAIL: DETAIL IN SHS	SIGN DETAIL: DETAIL ON SHEET NUMBER	SIGN DETAIL: DETAIL ON STD SHEET NUMBER
E MONTPELIER VT 14							FY-FLUORESCENT YELLOW FYG-FLUORESCENT YELLOW GREEN																				"SHS"-STANDARD HIGHWAY SIGNS			
NB	1.590	A	W1-8R	18	24								1		X												EXISTING ON SINGLE POST BACK TO BACK			
		B	W1-8R	18	24								1																
		A	W1-8L	24	30	FY		5.00								1		X									INSTALL ON SEPARATE POSTS 5 FEET APART	X		
		B	W1-8R	24	30	FY		5.00								1		X										X		
NB	1.595	A	W11-6H	30	30								1		X												EXISTING SIGN REMOVED			
		A	W11-6H	30	30		HINGED	6.25								1		X									INSTALL IN CLOSED POSITION			E-153
NB	1.600	C	VR-017	24	30						1	1	1		X											REMOVE & SALVAGED STREET SIGN TH 51, FAIR RD			
		C	VR-017	24	30			5.00								1		X									INSTALL 50 FT +/- DOWN TOWN HWY, BEYOND "Y"			E-141
NB	1.605	D	R1-1	24	24								~~1~~ 2		X												REMOVED MM PLAQUE			
		D	R1-1	30	30			6.25								1		X									TH 51, FAIR RD	X		
NB	1.610	A	W1-8R	18	24								1		X															
		B	W1-8R	18	24								1		X															
		A	W1-8L	24	30	FY		5.00								1		X									INSTALL ON SEPARATE POSTS 5 FEET APART	X		
		B	W1-8R	24	30	FY		5.00								1		X										X		
NB	1.630	A	W1-8R	18	24								1		X															
SIGN SUMMARY SHEET							SHEET TOTALS	37.50 SF	0.00 SF	0 EA	~~1~~ 0 EA	~~1~~ 0 EA	~~9~~ 7 EA	0 EA	0 EA	7 EA	105 FT												
VERMONT AGENCY OF TRANSPORTATION							TOWN TOTALS	803.2	0.0	27.0	3.0	3.0	149	0.0	0.0	132	1980.0											

PROJECT NAME: **Hartford-East Montpelier VT14**
PROJECT NUMBER: **STPG SIGN(21)**

FILE NAME: **East Montpelier.xls** PLOT DATE: **6/18/2009**
PROJECT MANAGER: **N. Averv** DRAWN BY: **T. Guazzoni**
DESIGNED BY: **M. Miller** CHECKED BY: **S. Menard**
EAST MONTPELIER SHEET 3 SHEET **138** OF **162**

DIRECTION	MILEPOINT	LOCATION CODE (SHEET 2)	SIGN CODE	WIDTH (IN)	HEIGHT (IN)	SHEETING REMARKS	SIGN LEGEND FOR ALL POST LENGTHS AND INSTALLATION DATES SEE ORIGINAL RECORD PLANS	NEW SIGNS "A"	NEW SIGNS "B"	EXISTING SIGNS RETAIN	EXISTING SIGNS SALVAGE FROM	EXISTING SIGNS SALVAGE TO	EXISTING SIGNS REMOVE	EXIST POST RETAIN	EXIST POST REMOVE	NUMBER OF NEW POSTS	SQUARE STEEL (IN) 1.75 (LB / FT) 1.88	SQUARE STEEL (IN) 2.00 (LB / FT) 2.42	SQUARE STEEL (IN) 2.50 (LB / FT) 3.35	TUBULAR STEEL Ø (IN) FOUNDATION	TUBULAR STEEL Ø (IN) 3.00 (LB / FT) 7.60	TUBULAR STEEL Ø (IN) 3.50 (LB / FT) 9.00	TUBULAR STEEL Ø (IN) 4.00 (LB / FT) 10.80	TUBULAR STEEL Ø (IN) 5.00 (LB / FT) 14.60	SIGN FRAME REQUIRED	REMARKS	SIGN DETAIL: DETAIL IN SHS	SIGN DETAIL: DETAIL ON SHEET NUMBER	SIGN DETAIL: DETAIL ON STD SHEET NUMBER
E MONTPELIER VT 14							FY-FLUORESCENT YELLOW FYG-FLUORESCENT YELLOW GREEN																			"SHS"-STANDARD HIGHWAY SIGNS			
		B	W1-8R	18	24								1		X														
		A	W1-8L	24	30	FY		5.00								1		X									INSTALL ON SEPARATE POSTS 5 FEET APART	X		
		B	W1-8R	24	30	FY		5.00								1		X										X		
NB	1.680	A	W3-5	36	36			9.00					1		X	2		X									EXISTING SIGN REMOVED INSTALL 50 FT +/- NORTH OF GRAVEL PULLOFF	X		
NB	1.800	A	R2-1	24	30								1		X															
		A	R2-1	30	36			7.50								1		X											6	
NB	1.960	A	R2-1	24	30		SPEED LIMIT 35			~~0~~ 1			1	~~X~~	X														
NB	2.010	A	W11-7	30	30								1		X															
		A	W11-7	30	30			6.25								1		X										X		
NB	2.035	C	VR-017	24	30						2		1		X											REMOVED MM PLAQUE REMOVED STREET SIGN			
		C	VR-017	24	30			~~6.25~~ 5.00								1		X									2 SIGNS SALVAGED FROM NB 2.035 TH-43, CARLTON BLVD			E-141
NB	2.040	D	R1-1	30	30							2	1		X															
		D	R1-1	30	30			6.25								1		X									TH-43, CARLTON BLVD	X		
NB	2.080	A	W1-2L	30	30		LEFT CURVE						1		X														
NB	2.135	A	W1-2L	30	30			6.25								1		X									INSTALL 300 FT +/- NORTH OF EXISTING	X		
SIGN SUMMARY SHEET							SHEET TOTALS	~~51.50~~ 50.25 SF	0.00 SF	~~1~~ 0 EA	~~0~~ 2 EA	~~0~~ 2 EA	~~6~~ 8 EA	0 EA	0 EA	9 EA		135 FT											
VERMONT AGENCY OF TRANSPORTATION							TOWN TOTALS	803.2	0.0	27.0	3.0	3.0	149	0.0	0.0	132		1980.0										

PROJECT NAME: **Hartford-East Montpelier VT14**
PROJECT NUMBER: **STPG SIGN(21)**

FILE NAME: **East Montpelier.xls** PLOT DATE: **6/18/2009**
PROJECT MANAGER: **N. Averv** DRAWN BY: **T. Guazzoni**
DESIGNED BY: **M. Miller** CHECKED BY: **S. Menard**
EAST MONTPELIER SHEET 4 SHEET **139** OF **162**

DIRECTION	MILEPOINT	LOCATION CODE (SHEET 2)	SIGN CODE	WIDTH (IN)	HEIGHT (IN)	SHEETING REMARKS	SIGN LEGEND FOR ALL POST LENGTHS AND INSTALLATION DATES SEE ORIGINAL RECORD PLANS	NEW SIGNS "A"	NEW SIGNS "B"	EXISTING SIGNS RETAIN	EXISTING SIGNS SALVAGE FROM	EXISTING SIGNS SALVAGE TO	EXISTING SIGNS REMOVE	EXIST POST RETAIN	EXIST POST REMOVE	NUMBER OF NEW POSTS	SQUARE STEEL (IN) 1.75 (LB / FT) 1.88	SQUARE STEEL (IN) 2.00 (LB / FT) 2.42	SQUARE STEEL (IN) 2.50 (LB / FT) 3.35	TUBULAR STEEL Ø (IN) FOUNDATION	TUBULAR STEEL Ø (IN) 3.00 (LB / FT) 7.60	TUBULAR STEEL Ø (IN) 3.50 (LB / FT) 9.00	TUBULAR STEEL Ø (IN) 4.00 (LB / FT) 10.80	TUBULAR STEEL Ø (IN) 5.00 (LB / FT) 14.60	SIGN FRAME REQUIRED	REMARKS	SIGN DETAIL: DETAIL IN SHS	SIGN DETAIL: DETAIL ON SHEET NUMBER	SIGN DETAIL: DETAIL ON STD SHEET NUMBER
E MONTPELIER VT 14							FY-FLUORESCENT YELLOW FYG-FLUORESCENT YELLOW GREEN																			"SHS"-STANDARD HIGHWAY SIGNS			
NB	2.150	A	R2-1	24	30		SPEED LIMIT 35				1				X											SIGN TO BE SALVAGED TO LOCATION ACROSS THE ROAD AT SB MP 2.01			
NB	2.180	C	VR-017	24	30								1		X														
		C	VR-017	24	30			5.00 ~~6.25~~								1		X								TH-7, PAULS SQ			E-141
NB	2.160	D	R1-1	30	30								1		X														
		D	R1-1	30	30			6.25							1		X								TH-7, PAULS SQ	X		
NB	2.200	A	W7-1	30	30		HILL SYMBOL 						1		X														
		A	W1-2L	30	30			6.25							1		X									X		
		A	W7-1B	30	30			6.25																			X		
NB	2.260	A	VD-062A	72	16		BUSINESS SIGN			1				X															
NB	2.265 TO 2.275	A		6	8		4 WHITE DELINEATORS	1.33								2	X									INSTALL BACK TO BACK EVENLY SPACED BETWEEN BUSINESS SIGN AND GUARDRAIL END		5	
NB	2.300	A	VD-018	30	18								1		X														
		A	VD-018	30	18			3.75								1		X											E-128A
NB	2.330	A	W3-1	30	30								1		X														
		A	W3-1	36	36			9.00								2		X									X		
NB	2.390	A	M2-1	21	15								1		X														
							SHEET TOTALS	~~39.08~~ 37.83 SF	0.00 SF	1 EA	1 EA	0 EA	6 EA	0 EA	0 EA	8 EA	120 FT												
							TOWN TOTALS	803.2	0.0	27.0	3.0	3.0	149	0.0	0.0	132	1980.0												

SIGN SUMMARY SHEET

VERMONT AGENCY OF TRANSPORTATION

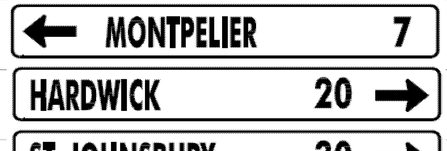
PROJECT NAME: Hartford-East Montpelier VT14
PROJECT NUMBER: STPG SIGN(21)

FILE NAME: East Montpelier.xls
PROJECT MANAGER: N. Avery
DESIGNED BY: M. Miller
EAST MONTPELIER SHEET 5

PLOT DATE: 6/18/2009
DRAWN BY: T. Guazzoni
CHECKED BY: S. Menard
SHEET 140 OF 162

DIRECTION	MILEPOINT	LOCATION CODE (SHEET 2)	SIGN CODE	WIDTH (IN)	HEIGHT (IN)	SHEETING REMARKS	SIGN LEGEND	NEW SIGNS "A"	NEW SIGNS "B"	EXISTING SIGNS RETAIN	EXISTING SIGNS SALVAGE FROM	EXISTING SIGNS SALVAGE TO	EXISTING SIGNS REMOVE	EXIST POST RETAIN	EXIST POST REMOVE	NUMBER OF NEW POSTS	SQUARE STEEL (IN) 1.75 (LB / FT) 1.88	SQUARE STEEL (IN) 2.00 (LB / FT) 2.42	SQUARE STEEL (IN) 2.50 (LB / FT) 3.35	TUBULAR STEEL Ø (IN) FOUNDATION	TUBULAR STEEL Ø (IN) 3.00 (LB / FT) 7.60	TUBULAR STEEL Ø (IN) 3.50 (LB / FT) 9.00	TUBULAR STEEL Ø (IN) 4.00 (LB / FT) 10.80	TUBULAR STEEL Ø (IN) 5.00 (LB / FT) 14.60	SIGN FRAME REQUIRED	REMARKS	SIGN DETAIL DETAIL IN SHS	SIGN DETAIL DETAIL ON SHEET NUMBER	SIGN DETAIL DETAIL ON STD SHEET NUMBER
E MONTPELIER VT 14							FY-FLUORESCENT YELLOW FYG-FLUORESCENT YELLOW GREEN																			"SHS"-STANDARD HIGHWAY SIGNS			
		A	M1-4	24	24								1		X														
		A	M2-1	21	15			2.19								1		X									X		
		A	M1-4	24	24			4.00																		X		
NB	2.400	A	D1-1A	72	10		LEFT ARROW MONTPELIER 7						1		X														
		A	D1-1A	72	10		HARDWICK 20 -->						1																
		A	D1-1A	72	10		ST JOHNSBURY 30 -->						1																
		A	M3-4	24	12		WEST						1																
		A	M1-4	24	24		US 2						1																
		A	M5-1L	21	15		LEFT ARROW, 90 DEGREE						1																
		A	M3-1	24	12		NORTH						1																
		A	M1-5A	24	24		VT 14						1																
		A	M5-1R	21	15		RIGHT ARROW, 90 DEGREE						1																
		A	M3-2	24	12		EAST						1																
		A	M1-4	24	24		US 2						1																
		A	M5-1R	21	15		RIGHT ARROW, 90 DEGREE						1																
SIGN SUMMARY SHEET							SHEET TOTALS	6.19	0.00	0	0	0	13	0	0	1			15									
								SF	SF	EA	EA	EA	EA	EA	EA	EA			FT									
VERMONT AGENCY OF TRANSPORTATION							TOWN TOTALS	803.2	0.0	27.0	3.0	3.0	149	0.0	0.0	132			1980.0									

PROJECT NAME: **Hartford-East Montpelier VT14**
PROJECT NUMBER: **STPG SIGN(21)**
FILE NAME: **East Montpelier.xls** PLOT DATE: **6/18/2009**
PROJECT MANAGER: **N. Avery** DRAWN BY: **T. Guazzoni**
DESIGNED BY: **M. Miller** CHECKED BY: **S. Menard**
EAST MONTPELIER SHEET 6 SHEET **141** OF **162**

DIRECTION	MILEPOINT	LOCATION CODE (SHEET 2)	SIGN CODE	WIDTH (IN)	HEIGHT (IN)	SHEETING REMARKS	SIGN LEGEND	NEW SIGNS "A"	NEW SIGNS "B"	EXISTING SIGNS RETAIN	EXISTING SIGNS SALVAGE FROM	EXISTING SIGNS SALVAGE TO	EXISTING SIGNS REMOVE	EXIST POST RETAIN	EXIST POST REMOVE	NUMBER OF NEW POSTS	SQUARE STEEL (IN) 1.75 (LB / FT) 1.88	SQUARE STEEL (IN) 2.00 (LB / FT) 2.42	SQUARE STEEL (IN) 2.50 (LB / FT) 3.35	TUBULAR STEEL Ø (IN) FOUNDATION	TUBULAR STEEL Ø (IN) 3.00 (LB / FT) 7.60	TUBULAR STEEL Ø (IN) 3.50 (LB / FT) 9.00	TUBULAR STEEL Ø (IN) 4.00 (LB / FT) 10.80	TUBULAR STEEL Ø (IN) 5.00 (LB / FT) 14.60	SIGN FRAME REQUIRED	REMARKS	SIGN DETAIL: DETAIL IN SHS	SIGN DETAIL: DETAIL ON SHEET NUMBER	SIGN DETAIL: DETAIL ON STD SHEET NUMBER
E MONTPELIER VT 14							FY-FLUORESCENT YELLOW FYG-FLUORESCENT YELLOW GREEN																			"SHS"-STANDARD HIGHWAY SIGNS			
		A	D1-1A	72	12			6.00								2			X								5	
		A	D1-1A	72	12			6.00																			5	
		A	D1-1A	72	12			6.00																			5	
		A	M3-4	24	12			2.00																	#3A		X	7
		A	M1-4	24	24			4.00																			X	
		A	M6-1	21	15			2.19																			X	
		A	M3-1	24	12			2.00																		GREEN ON WHITE SHEETING	X	
		A	M1-5	24	24			4.00																				E136-B
		A	M6-1	21	15			2.19																		GREEN ON WHITE SHEETING	X	
		A	M3-2	24	12			2.00																			X	
		A	M1-4	24	24			4.00																			X	
		A	M6-1	21	15			2.19																			X	
NB	2.475	A	R1-1	30	30								1		X													
		A	R1-1	36	36			9.00								2		X								X	
																										JCT US 2. VT 14 FOLLOWS US 2 FOR 0.2 MILES		
							SHEET TOTALS	51.57 SF	0.00 SF	0 EA	0 EA	0 EA	1 EA	0 EA	0 EA	4 EA	60 FT									
							TOWN TOTALS	803.2	0.0	27.0	3.0	3.0	149	0.0	0.0	132	1980.0									

SIGN SUMMARY SHEET

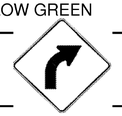
VERMONT AGENCY OF TRANSPORTATION

PROJECT NAME: **Hartford-East Montpelier VT14**
PROJECT NUMBER: **STPG SIGN(21)**
FILE NAME: **East Montpelier.xls** PLOT DATE: **6/18/2009**
PROJECT MANAGER: **N. Avery** DRAWN BY: **T. Guazzoni**
DESIGNED BY: **M. Miller** CHECKED BY: **S. Menard**
EAST MONTPELIER SHEET 7 SHEET **142** OF **162**

DIRECTION	MILEPOINT	LOCATION CODE (SHEET 2)	SIGN CODE	WIDTH (IN)	HEIGHT (IN)	SHEETING REMARKS	SIGN LEGEND FOR ALL POST LENGTHS AND INSTALLATION DATES SEE ORIGINAL RECORD PLANS	NEW SIGNS "A"	NEW SIGNS "B"	EXISTING SIGNS RETAIN	EXISTING SIGNS SALVAGE FROM	EXISTING SIGNS SALVAGE TO	EXISTING SIGNS REMOVE	EXIST POST RETAIN	EXIST POST REMOVE	NUMBER OF NEW POSTS	SQUARE STEEL (IN) 1.75 (LB / FT) 1.88	SQUARE STEEL (IN) 2.00 (LB / FT) 2.42	SQUARE STEEL (IN) 2.50 (LB / FT) 3.35	TUBULAR STEEL Ø (IN) FOUNDATION	TUBULAR STEEL Ø (IN) 3.00 (LB / FT) 7.60	TUBULAR STEEL Ø (IN) 3.50 (LB / FT) 9.00	TUBULAR STEEL Ø (IN) 4.00 (LB / FT) 10.80	TUBULAR STEEL Ø (IN) 5.00 (LB / FT) 14.60	SIGN FRAME REQUIRED	REMARKS	SIGN DETAIL DETAIL IN SHS	SIGN DETAIL DETAIL ON SHEET NUMBER	SIGN DETAIL DETAIL ON STD SHEET NUMBER
E MONTPELIER VT 14							FY-FLUORESCENT YELLOW FYG-FLUORESCENT YELLOW GREEN																			"SHS"-STANDARD HIGHWAY SIGNS			
NB	2.530	A	W11-8	30	30								1		X											VT 14 RESUMES			
		A	W11-2	30	30								1																
		A	W11-8	30	30	FY		6.25								2		X									X		
		A	W11-2	30	30	FY		6.25																			X		
NB	2.580	A	M3-1	24	12								1		X														
		A	M1-5A	24	24								1																
		A	M3-1	24	12			2.00								1		X								GREEN ON WHITE SHEETING	X		
		A	M1-5	24	24			4.00																					E-136B
NB	2.740	A	R2-1	24	30		SPEED LIMIT 40			1				X															
NB	2.780	A	W1-4L	30	30		LEFT REVERSE CURVE			1				X															
NB	2.940	A	W1-2R	30	30		RIGHT CURVE			1				X															
		A	W13-1	18	18		40 MPH PLAQUE			1																			
NB	2.990	A	R2-1	24	30		SPEED LIMIT 50			1				X															
NB	3.120	A	W11-3A	30	30		DEER CROSSING			1				X															
		A	W7-3A	24	18		NEXT 2 MILES			1																			
SIGN SUMMARY SHEET							SHEET TOTALS	18.50 SF	0.00 SF	7 EA	0 EA	0 EA	~~4~~ 2 EA	0 EA	0 EA	3 EA	45 FT											
VERMONT AGENCY OF TRANSPORTATION							TOWN TOTALS	803.2	0.0	27.0	3.0	3.0	149	0.0	0.0	132	1980.0											

PROJECT NAME: **Hartford-East Montpelier VT14**
PROJECT NUMBER: **STPG SIGN(21)**

FILE NAME: **East Montpelier.xls** PLOT DATE: **6/18/2009**
PROJECT MANAGER: **N. Avery** DRAWN BY: **T. Guazzoni**
DESIGNED BY: **M. Miller** CHECKED BY: **S. Menard**
EAST MONTPELIER SHEET 8 SHEET **143** OF **162**

DIRECTION	MILEPOINT	LOCATION CODE (SHEET 2)	SIGN CODE	WIDTH (IN)	HEIGHT (IN)	SHEETING REMARKS	SIGN LEGEND FOR ALL POST LENGTHS AND INSTALLATION DATES SEE ORIGINAL RECORD PLANS	NEW SIGNS "A"	NEW SIGNS "B"	EXISTING SIGNS RETAIN	EXISTING SIGNS SALVAGE FROM	EXISTING SIGNS SALVAGE TO	EXISTING SIGNS REMOVE	EXIST POST RETAIN	EXIST POST REMOVE	NUMBER OF NEW POSTS	SQUARE STEEL (IN) 1.75 (LB / FT) 1.88	SQUARE STEEL (IN) 2.00 (LB / FT) 2.42	SQUARE STEEL (IN) 2.50 (LB / FT) 3.35	TUBULAR STEEL Ø (IN) FOUNDATION	TUBULAR STEEL Ø (IN) 3.00 (LB / FT) 7.60	TUBULAR STEEL Ø (IN) 3.50 (LB / FT) 9.00	TUBULAR STEEL Ø (IN) 4.00 (LB / FT) 10.80	TUBULAR STEEL Ø (IN) 5.00 (LB / FT) 14.60	SIGN FRAME REQUIRED	REMARKS	SIGN DETAIL: DETAIL IN SHS	SIGN DETAIL: DETAIL ON SHEET NUMBER	SIGN DETAIL: DETAIL ON STD SHEET NUMBER
E MONTPELIER VT 14							FY-FLUORESCENT YELLOW FYG-FLUORESCENT YELLOW GREEN																				"SHS"-STANDARD HIGHWAY SIGNS			
NB	3.860	A	W1-2R	30	30			6.25								1		X								INSTALL 150 FT +/- SOUTH OF DRIVEWAY	X		
NB	3.920	A	W2-2R	30	30		RIGHT SIDE RD WARNING						1		X														
NB	3.980	A	W1-10L	30	30			6.25								1		X								INSTALL 250 FT +/- NORTH OF EXISTING SIDE RD WARNING (TO BE REMOVED)	X		
		A	W16-8	24	8			1.33																		DAGGETT RD		7	
NB	4.015	C	W14-2	30	30								~~1~~ 2		X														
		C	W14-2	30	30			6.25								1		X									X		
NB	4.018	C	VR-017	24	30								1		X														
		C	VR-017	24	30			5.00								1		X								TH-40, DAGGETT RD			E-141
NB	4.025	D	R1-1	30	30								1		X														
		D	R1-1	30	30			6.25								1		X								TH-40, DAGGETT RD	X		
NB	4.110	A	W11-6H	30	30								1		X														
		A	W11-6H	30	30		HINGED 	6.25								1		X								INSTALL IN CLOSED POSITION			E-153
NB	4.485	A	S1-1YG	36	36		SCHOOL AHEAD				1				X												SALVAGE TO 4.595 NB			
		A	W16-9YG	30	18		AHEAD				1																SALVAGE TO 4.595 NB			
NB	4.550	A	D1-1E	72	20		SCHOOL D-BOARD			1				X															
							SHEET TOTALS	37.58 SF	0.00 SF	1 EA	2 EA	0 EA	~~6~~ 5 EA	0 EA	0 EA	6 EA		90 FT											
							TOWN TOTALS	803.2	0.0	27.0	3.0	3.0	149	0.0	0.0	132		1980.0											

SIGN SUMMARY SHEET

VERMONT AGENCY OF TRANSPORTATION

PROJECT NAME: **Hartford-East Montpelier VT14**
PROJECT NUMBER: **STPG SIGN(21)**

FILE NAME: **East Montpelier.xls** PLOT DATE: **6/18/2009**
PROJECT MANAGER: **N. Averv** DRAWN BY: **T. Guazzoni**
DESIGNED BY: **M. Miller** CHECKED BY: **S. Menard**
EAST MONTPELIER SHEET 9 SHEET **144** OF **162**

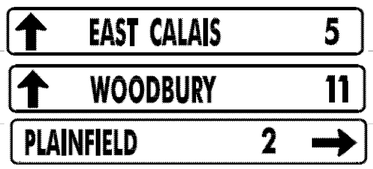
DIRECTION	MILEPOINT	LOCATION CODE (SHEET 2)	SIGN CODE	WIDTH (IN)	HEIGHT (IN)	SHEETING REMARKS	SIGN LEGEND FOR ALL POST LENGTHS AND INSTALLATION DATES SEE ORIGINAL RECORD PLANS	NEW SIGNS "A"	NEW SIGNS "B"	EXISTING SIGNS RETAIN	EXISTING SIGNS SALVAGE FROM	EXISTING SIGNS SALVAGE TO	EXISTING SIGNS REMOVE	EXIST POST RETAIN	EXIST POST REMOVE	NUMBER OF NEW POSTS	SQUARE STEEL (IN) 1.75 (LB / FT) 1.88	SQUARE STEEL (IN) 2.00 (LB / FT) 2.42	SQUARE STEEL (IN) 2.50 (LB / FT) 3.35	TUBULAR STEEL Ø (IN) FOUNDATION	TUBULAR STEEL Ø (IN) 3.00 (LB / FT) 7.60	TUBULAR STEEL Ø (IN) 3.50 (LB / FT) 9.00	TUBULAR STEEL Ø (IN) 4.00 (LB / FT) 10.80	TUBULAR STEEL Ø (IN) 5.00 (LB / FT) 14.60	SIGN FRAME REQUIRED	REMARKS	SIGN DETAIL: DETAIL IN SHS	SIGN DETAIL: DETAIL ON SHEET NUMBER	SIGN DETAIL: DETAIL ON STD SHEET NUMBER
E MONTPELIER VT 14							FY-FLUORESCENT YELLOW FYG-FLUORESCENT YELLOW GREEN																			"SHS"-STANDARD HIGHWAY SIGNS			
NB	4.595	A	S1-1YG	36	36		SCHOOL AHEAD					1				2		X								INSTALL 225' +/- NORTH OF SCHOOL D-BOARD AT FENCE CORNER			
		A	W16-9YG	30	18		AHEAD					1																	
NB	4.635	C	VR-017	24	30								1		X															
		C	VR-017	24	30			5.00								1		X								TH-30, COBURN RD			E-141
NB	4.645	D	R1-1	30	30						1		1		X															
		D	R1-1	30	30			6.25				1				1		X								TH-30, COBURN RD	X		
NB	4.870	A	W1-2L	30	30			6.25								1		X								INSTALL BEHIND NORTH END OF GUARDRAIL SECTION	X		
NB	5.090	A	W1-2L	30	30			6.25								1		X								INSTALL 150 FT +/- SOUTH OF DRIVEWAY	X		
NB	5.140	A	R2-5A	24	30		REDUCED SPEED AHEAD 						1		X															
		A	W3-5	36	36			9.00								2		X									X		
NB	5.180	A	W11-7	30	30								1		X															
		A	W11-7	30	30			6.25								1		X									X		
NB	5.245	A	VD-018	30	18			3.75								1		X								INSTALL 50 FT +/- SOUTH OF EXISTING, AWAY FROM LILACS			E-128A
NB	5.255	A	VD-018	30	18		VILLAGE SIGN						1		X															
NB	5.300	A	R2-1	24	30								1		X															
							SHEET TOTALS	42.75 SF	0.00 SF	0 EA	1 0 EA	3 2 EA	6 EA	0 EA	0 EA	10 EA		150 FT											
							TOWN TOTALS	803.2	0.0	27.0	3.0	3.0	149	0.0	0.0	132		1980.0										

SIGN SUMMARY SHEET

VERMONT AGENCY OF TRANSPORTATION

PROJECT NAME: **Hartford-East Montpelier VT14**
PROJECT NUMBER: **STPG SIGN(21)**

FILE NAME: **East Montpelier.xls** PLOT DATE: **6/18/2009**
PROJECT MANAGER: **N. Avery** DRAWN BY: **T. Guazzoni**
DESIGNED BY: **M. Miller** CHECKED BY: **S. Menard**
EAST MONTPELIER SHEET 10 SHEET **145** OF **162**

DIRECTION	MILEPOINT	LOCATION CODE (SHEET 2)	SIGN CODE	WIDTH (IN)	HEIGHT (IN)	SHEETING REMARKS	SIGN LEGEND FOR ALL POST LENGTHS AND INSTALLATION DATES SEE ORIGINAL RECORD PLANS	NEW SIGNS "A"	NEW SIGNS "B"	EXISTING SIGNS RETAIN	EXISTING SIGNS SALVAGE FROM	EXISTING SIGNS SALVAGE TO	EXISTING SIGNS REMOVE	EXIST POST RETAIN	EXIST POST REMOVE	NUMBER OF NEW POSTS	SQUARE STEEL (IN) (LB / FT) 1.75 / 1.88	SQUARE STEEL (IN) (LB / FT) 2.00 / 2.42	SQUARE STEEL (IN) (LB / FT) 2.50 / 3.35	TUBULAR STEEL Ø (IN) FOUNDATION	TUBULAR STEEL Ø (IN) (LB / FT) 3.00 / 7.60	TUBULAR STEEL Ø (IN) (LB / FT) 3.50 / 9.00	TUBULAR STEEL Ø (IN) (LB / FT) 4.00 / 10.80	TUBULAR STEEL Ø (IN) (LB / FT) 5.00 / 14.60	SIGN FRAME REQUIRED	REMARKS	SIGN DETAIL: DETAIL IN SHS	SIGN DETAIL: DETAIL ON SHEET NUMBER	SIGN DETAIL: DETAIL ON STD SHEET NUMBER
E MONTPELIER VT 14							FY-FLUORESCENT YELLOW FYG-FLUORESCENT YELLOW GREEN																			"SHS"-STANDARD HIGHWAY SIGNS			
		A	R2-1	24	30			5.00								1		X								X		
NB	5.360	A	M2-1	21	15								1		X														
		A	M1-5	30	24								1																
		A	M2-1	21	15			2.19								1		X								GREEN ON WHITE SHEETING	X		
		A	M1-5	30	24			5.00																				E-136B
NB	5.395	A	W11-2	30	30								1		X														
		A	W11-2	30	30	FYG		6.25								1		X									X		
NB	5.430	A	D1-1A	72	12								~~2~~ 1		X											REMOVED EXISTING MM PLAQUE			
		A	D1-1A	72	12								1																
		A	D1-1A	72	12								1																
		A	D1-1A	72	12			6.00								2		X									5	
		A	D1-1A	72	12			6.00																			5	
		A	D1-1A	72	12			6.00																			5	
NB	5.485	A	M3-1	24	12								1		X														
		A	M1-5	24	24								1																
SIGN SUMMARY SHEET							SHEET TOTALS	36.44 SF	0.00 SF	0 EA	0 EA	0 EA	~~9~~ 8 EA	0 EA	0 EA	5 EA	75 FT											
VERMONT AGENCY OF TRANSPORTATION							TOWN TOTALS	803.2	0.0	27.0	3.0	3.0	149	0.0	0.0	132	1980.0											

PROJECT NAME: Hartford-East Montpelier VT14
PROJECT NUMBER: STPG SIGN(21)

FILE NAME: East Montpelier.xls
PROJECT MANAGER: N. Avery
DESIGNED BY: M. Miller
EAST MONTPELIER SHEET 11

PLOT DATE: 6/18/2009
DRAWN BY: T. Guazzoni
CHECKED BY: S. Menard

DIRECTION	MILEPOINT	LOCATION CODE (SHEET 2)	SIGN CODE	WIDTH (IN)	HEIGHT (IN)	SHEETING REMARKS	SIGN LEGEND	NEW SIGNS "A"	NEW SIGNS "B"	EXISTING SIGNS RETAIN	EXISTING SIGNS SALVAGE FROM	EXISTING SIGNS SALVAGE TO	EXISTING SIGNS REMOVE	EXIST POST RETAIN	EXIST POST REMOVE	NUMBER OF NEW POSTS	SQUARE STEEL (IN) 1.75 (LB / FT) 1.88	SQUARE STEEL (IN) 2.00 (LB / FT) 2.42	SQUARE STEEL (IN) 2.50 (LB / FT) 3.35	TUBULAR STEEL Ø (IN) FOUNDATION	TUBULAR STEEL Ø (IN) 3.00 (LB / FT) 7.60	TUBULAR STEEL Ø (IN) 3.50 (LB / FT) 9.00	TUBULAR STEEL Ø (IN) 4.00 (LB / FT) 10.80	TUBULAR STEEL Ø (IN) 5.00 (LB / FT) 14.60	SIGN FRAME REQUIRED	REMARKS	SIGN DETAIL: DETAIL IN SHS	SIGN DETAIL: DETAIL ON SHEET NUMBER	SIGN DETAIL: DETAIL ON STD SHEET NUMBER
E MONTPELIER VT 14							FY-FLUORESCENT YELLOW FYG-FLUORESCENT YELLOW GREEN																			"SHS"-STANDARD HIGHWAY SIGNS			
		A	M6-3	21	15								1																
		A	M3-3	24	12								1																
		A	M1-5	24	24								1																
		A	M6-1	21	15								1																
		A	M3-1	24	12			2.00								2		X							#2A	GREEN ON WHITE SHEETING	X	7	
		A	M1-5	24	24			4.00																					E-136B
		A	M6-3	21	15			2.19																	GREEN ON WHITE SHEETING	X		
		A	M3-3	24	12			2.00																		GREEN ON WHITE SHEETING	X		
		A	M1-5	24	24			4.00																					E-136B
		A	M6-1	21	15			2.19																		GREEN ON WHITE SHEETING	X		
NB	5.570	A	M3-1	24	12								1		X														
		A	M1-5	24	24								1																
		A	M3-1	24	12			2.00								1		X								GREEN ON WHITE SHEETING	X		
		A	M1-5	24	24			4.00																					E-136B
NB	5.605	A	D1-1	72	12								1		X														
SIGN SUMMARY SHEET							SHEET TOTALS	22.38	0.00	0	0	0	7	0	0	3		45									
								SF	SF	EA	EA	EA	EA	EA	EA	EA		FT									
VERMONT AGENCY OF TRANSPORTATION							TOWN TOTALS	803.2	0.0	27.0	3.0	3.0	149	0.0	0.0	132		1980.0									

PROJECT NAME: **Hartford-East Montpelier VT14**
PROJECT NUMBER: **STPG SIGN(21)**
FILE NAME: **East Montpelier.xls** PLOT DATE: **6/18/2009**
PROJECT MANAGER: **N. Avery** DRAWN BY: **T. Guazzoni**
DESIGNED BY: **M. Miller** CHECKED BY: **S. Menard**
EAST MONTPELIER SHEET 12 SHEET **147** OF **162**

DIRECTION	MILEPOINT	LOCATION CODE (SHEET 2)	SIGN CODE	WIDTH (IN)	HEIGHT (IN)	SHEETING REMARKS	SIGN LEGEND	NEW SIGNS "A"	NEW SIGNS "B"	EXISTING SIGNS RETAIN	EXISTING SIGNS SALVAGE FROM	EXISTING SIGNS SALVAGE TO	EXISTING SIGNS REMOVE	EXIST POST RETAIN	EXIST POST REMOVE	NUMBER OF NEW POSTS	SQUARE STEEL (IN) 1.75 (LB / FT) 1.88	SQUARE STEEL (IN) 2.00 (LB / FT) 2.42	SQUARE STEEL (IN) 2.50 (LB / FT) 3.35	TUBULAR STEEL Ø (IN) FOUNDATION	TUBULAR STEEL Ø (IN) 3.00 (LB / FT) 7.60	TUBULAR STEEL Ø (IN) 3.50 (LB / FT) 9.00	TUBULAR STEEL Ø (IN) 4.00 (LB / FT) 10.80	TUBULAR STEEL Ø (IN) 5.00 (LB / FT) 14.60	SIGN FRAME REQUIRED	REMARKS	SIGN DETAIL: DETAIL IN SHS	SIGN DETAIL: DETAIL ON SHEET NUMBER	SIGN DETAIL: DETAIL ON STD SHEET NUMBER
E MONTPELIER VT 14							FY-FLUORESCENT YELLOW FYG-FLUORESCENT YELLOW GREEN																			"SHS"-STANDARD HIGHWAY SIGNS			
		A	D1-1	72	12								1															
		A	D2-1	72	12		EAST CALAIS 5 WOODBURY 11	6.00								2		X										5
		A	D2-1	72	12			6.00																				5
NB	5.640	A	R2-1	24	30		SPEED LIMIT 35						1		X													
		A	R2-1	24	30			5.00								1		X									X	
SB	5.820	A	R2-1	24	30		SPEED LIMIT 35						1		X													
		A	R2-1	30	36			7.50								1		X										6
SB	5.780	F	W11-2	30	30								1		X													
		F	W11-2	30	30	FYG		6.25								1		X									X	
SB	5.730	F	VD-018	30	18		NORTH MONTPELIER EAST MONTPELIER 3						1		X													
		F	VD-018	30	18			3.75								1		X										E-128A
SB	5.685	F	M2-1	21	15								1		X													
		F	M1-5	24	24								1															
		F	M2-1	21	15		JCT VERMONT 214	2.19								1		X									GREEN ON WHITE SHEETING	X	
		F	M1-5	30	24			5.00																				E-136B
SIGN SUMMARY SHEET							SHEET TOTALS	41.69 SF	0.00 SF	0 EA	0 EA	0 EA	7 EA	0 EA	0 EA	7 EA	105 FT										
VERMONT AGENCY OF TRANSPORTATION							TOWN TOTALS	803.2	0.0	27.0	3.0	3.0	149	0.0	0.0	132	1980.0										

PROJECT NAME: Hartford-East Montpelier VT14
PROJECT NUMBER: STPG SIGN(21)

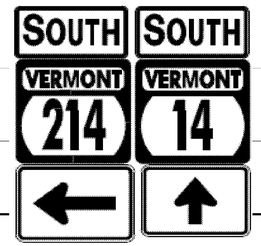
FILE NAME: East Montpelier.xls
PROJECT MANAGER: N. Avery
DESIGNED BY: M. Miller
EAST MONTPELIER SHEET 13

PLOT DATE: 6/18/2009
DRAWN BY: T. Guazzoni
CHECKED BY: S. Menard

DIRECTION	MILEPOINT	LOCATION CODE (SHEET 2)	SIGN CODE	WIDTH (IN)	HEIGHT (IN)	SHEETING REMARKS	SIGN LEGEND	NEW SIGNS "A"	NEW SIGNS "B"	EXISTING SIGNS RETAIN	EXISTING SIGNS SALVAGE FROM	EXISTING SIGNS SALVAGE TO	EXISTING SIGNS REMOVE	EXIST POST RETAIN	EXIST POST REMOVE	NUMBER OF NEW POSTS	SQUARE STEEL (IN) 1.75 2.00 2.50 (LB / FT) 1.88 2.42 3.35	TUBULAR STEEL Ø (IN) FOUNDATION 3.00 3.50 4.00 5.00 (LB / FT) 7.60 9.00 10.80 14.60	SIGN FRAME REQUIRED	REMARKS	SIGN DETAIL: DETAIL IN SHS	SIGN DETAIL: DETAIL ON SHEET NUMBER	SIGN DETAIL: DETAIL ON STD SHEET NUMBER
E MONTPELIER VT 14							FY-FLUORESCENT YELLOW FYG-FLUORESCENT YELLOW GREEN													"SHS"-STANDARD HIGHWAY SIGNS			
SB	5.630	F	D1-1A	72	12								1		X								
		F	D1-1A	72	12								1										
		F	D1-1A	72	12								1										
		F	D1-1A	72	12			6.00								2		X				5	
		F	D1-1A	72	12			6.00														5	
		F	D1-1A	72	12			6.00														5	
SB	5.575	F	M3-3	24	12								1		X								
		F	M1-5	24	24								1										
		F	M6-1	21	15								1										
		F	M3-3	24	12								1										
		F	M1-5	24	24								1										
		F	M6-1	21	15								1										
		F	M3-3	24	12			2.00								2		X		#2A	GREEN ON WHITE SHEETING	X	7	
		F	M1-5	30	24			5.00																E-136B
		F	M6-1	21	15			2.19													GREEN ON WHITE SHEETING	X		
SIGN SUMMARY SHEET							SHEET TOTALS	27.19	0.00	0	0	0	9	0	0	4	60						
								SF	SF	EA	EA	EA	EA	EA	EA	EA	FT						
VERMONT AGENCY OF TRANSPORTATION							TOWN TOTALS	803.2	0.0	27.0	3.0	3.0	149	0.0	0.0	132	1980.0						

PROJECT NAME: **Hartford-East Montpelier VT14**
PROJECT NUMBER: **STPG SIGN(21)**

FILE NAME: **East Montpelier.xls** PLOT DATE: **6/18/2009**
PROJECT MANAGER: **N. Averv** DRAWN BY: **T. Guazzoni**
DESIGNED BY: **M. Miller** CHECKED BY: **S. Menard**
EAST MONTPELIER SHEET 14 SHEET **149** OF **162**

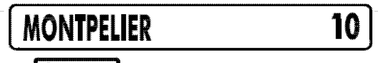
DIRECTION	MILEPOINT	LOCATION CODE (SHEET 2)	SIGN CODE	WIDTH (IN)	HEIGHT (IN)	SHEETING REMARKS	SIGN LEGEND FOR ALL POST LENGTHS AND INSTALLATION DATES SEE ORIGINAL RECORD PLANS	NEW SIGNS "A"	NEW SIGNS "B"	EXISTING SIGNS RETAIN	EXISTING SIGNS SALVAGE FROM	EXISTING SIGNS SALVAGE TO	EXISTING SIGNS REMOVE	EXIST POST RETAIN	EXIST POST REMOVE	NUMBER OF NEW POSTS	SQUARE STEEL (IN) 1.75 (LB / FT) 1.88	SQUARE STEEL (IN) 2.00 (LB / FT) 2.42	SQUARE STEEL (IN) 2.50 (LB / FT) 3.35	TUBULAR STEEL Ø (IN) FOUNDATION	TUBULAR STEEL Ø (IN) 3.00 (LB / FT) 7.60	TUBULAR STEEL Ø (IN) 3.50 (LB / FT) 9.00	TUBULAR STEEL Ø (IN) 4.00 (LB / FT) 10.80	TUBULAR STEEL Ø (IN) 5.00 (LB / FT) 14.60	SIGN FRAME REQUIRED	REMARKS	SIGN DETAIL: DETAIL IN SHS	SIGN DETAIL: DETAIL ON SHEET NUMBER	SIGN DETAIL: DETAIL ON STD SHEET NUMBER
E MONTPELIER VT 14							FY-FLUORESCENT YELLOW FYG-FLUORESCENT YELLOW GREEN																			"SHS"-STANDARD HIGHWAY SIGNS			
		F	M3-3	24	12			2.00																	GREEN ON WHITE SHEETING	X		
		F	M1-5	24	24			4.00																			E-136B
		F	M6-3	21	15			2.19																	GREEN ON WHITE SHEETING	X		
SB	5.560	G	W1-7	48	24								1		X												
		G	W1-7	48	24	FY		8.00								2	X									X	
SB	5.555	F	M3-3	24	12		SOUTH						1		X												
		F	M1-5	24	24		VT 14						1														
SB	5.510	F	D2-1	72	12		E MONTPELIER 3						1		X												
		F	D2-1	72	12		MONTPELIER 10						1														
SB	5.500	G	VR-017	24	30								1		X												
		G	VR-017	24	30			5.00								1	X								TH-11, FACTORY ST			E-141
SB	5.495	H	R1-1	30	30								~~1~~ 2		X												
		H	R1-1	30	30			6.25								1	X								TH-11, FACTORY ST	X		
SB	5.475	F	D2-1	72	12			6.00								2	X								INSTALL 100 FT +/- SOUTH OF FACTORY ST		5	
		F	D2-1	72	12			6.00																			5	
							SHEET TOTALS	39.44 SF	0.00 SF	0 EA	0 EA	0 EA	~~8~~ 7 EA	0 EA	0 EA	6 EA	90 FT											
							TOWN TOTALS	803.2	0.0	27.0	3.0	3.0	149	0.0	0.0	132	1980.0											

SIGN SUMMARY SHEET

VERMONT AGENCY OF TRANSPORTATION

PROJECT NAME: **Hartford-East Montpelier VT14**
PROJECT NUMBER: **STPG SIGN(21)**

FILE NAME: **East Montpelier.xls** PLOT DATE: **6/18/2009**
PROJECT MANAGER: **N. Avery** DRAWN BY: **T. Guazzoni**
DESIGNED BY: **M. Miller** CHECKED BY: **S. Menard**

DIRECTION	MILEPOINT	LOCATION CODE (SHEET 2)	SIGN CODE	WIDTH (IN)	HEIGHT (IN)	SHEETING REMARKS	SIGN LEGEND FOR ALL POST LENGTHS AND INSTALLATION DATES SEE ORIGINAL RECORD PLANS	NEW SIGNS "A"	NEW SIGNS "B"	EXISTING SIGNS RETAIN	EXISTING SIGNS SALVAGE FROM	EXISTING SIGNS SALVAGE TO	EXISTING SIGNS REMOVE	EXIST POST RETAIN	EXIST POST REMOVE	NUMBER OF NEW POSTS	SQUARE STEEL (IN) 1.75 (LB / FT) 1.88	SQUARE STEEL (IN) 2.00 (LB / FT) 2.42	SQUARE STEEL (IN) 2.50 (LB / FT) 3.35	TUBULAR STEEL Ø (IN) FOUNDATION	TUBULAR STEEL Ø (IN) 3.00 (LB / FT) 7.60	TUBULAR STEEL Ø (IN) 3.50 (LB / FT) 9.00	TUBULAR STEEL Ø (IN) 4.00 (LB / FT) 10.80	TUBULAR STEEL Ø (IN) 5.00 (LB / FT) 14.60	SIGN FRAME REQUIRED	REMARKS	SIGN DETAIL: DETAIL IN SHS	SIGN DETAIL: DETAIL ON SHEET NUMBER	SIGN DETAIL: DETAIL ON STD SHEET NUMBER
E MONTPELIER VT 14							FY-FLUORESCENT YELLOW FYG-FLUORESCENT YELLOW GREEN																			"SHS"-STANDARD HIGHWAY SIGNS			
		F	M3-3	24	12			2.00																	GREEN ON WHITE SHEETING. INSTALL ROUTE MARKERS ON LEFT POST BELOW D-BOARDS	X		
		F	M1-5	24	24			4.00																				E-136B
SB	5.320	F	R2-1	24	30								1		X													
		F	R2-1	24	30			5.00								1		X								X		
SB	5.060	F	W11-3A	30	30								1		X													
		F	W7-3A	24	18								1															
		F	W11-3A	30	30			6.25								1		X									6	
		F	W7-3A	24	18			3.00																		X		
SB	4.815	F	S1-1YG	36	36		SCHOOL AHEAD			1				X														
		F	W16-9YG	30	18		AHEAD			1																		
SB	4.771	F	D1-1E	72	20		SCHOOL D-BOARD			1				X														
SB	4.740	G	VR-017	24	30								1		X													
		G	VR-017	24	30			5.00								1		X									TH-26, HAMMETT HILL RD			E-141
SB	4.730	H	R1-1	30	30						1		1		X													
		H	R1-1	30	30			6.25				1				1		X									TH-26, HAMMETT HILL RD	X		
SIGN SUMMARY SHEET							SHEET TOTALS	31.50 SF	0.00 SF	3 EA	1 ~~0~~ EA	1 ~~0~~ EA	5 EA	0 EA	0 EA	4 EA	60 FT											
VERMONT AGENCY OF TRANSPORTATION							TOWN TOTALS	803.2	0.0	27.0	3.0	3.0	149	0.0	0.0	132	1980.0											

PROJECT NAME: **Hartford-East Montpelier VT14**
PROJECT NUMBER: **STPG SIGN(21)**

FILE NAME: **East Montpelier.xls** PLOT DATE: **6/18/2009**
PROJECT MANAGER: **N. Averv** DRAWN BY: **T. Guazzoni**
DESIGNED BY: **M. Miller** CHECKED BY: **S. Menard**

DIRECTION	MILEPOINT	LOCATION CODE (SHEET 2)	SIGN CODE	WIDTH (IN)	HEIGHT (IN)	SHEETING REMARKS	SIGN LEGEND FOR ALL POST LENGTHS AND INSTALLATION DATES SEE ORIGINAL RECORD PLANS	NEW SIGNS "A"	NEW SIGNS "B"	EXISTING SIGNS RETAIN	EXISTING SIGNS SALVAGE FROM	EXISTING SIGNS SALVAGE TO	EXISTING SIGNS REMOVE	EXIST POST RETAIN	EXIST POST REMOVE	NUMBER OF NEW POSTS	SQUARE STEEL (IN) 1.75 (LB / FT) 1.88	SQUARE STEEL (IN) 2.00 (LB / FT) 2.42	SQUARE STEEL (IN) 2.50 (LB / FT) 3.35	TUBULAR STEEL Ø (IN) FOUNDATION	TUBULAR STEEL Ø (IN) 3.00 (LB / FT) 7.60	TUBULAR STEEL Ø (IN) 3.50 (LB / FT) 9.00	TUBULAR STEEL Ø (IN) 4.00 (LB / FT) 10.80	TUBULAR STEEL Ø (IN) 5.00 (LB / FT) 14.60	SIGN FRAME REQUIRED	REMARKS	SIGN DETAIL: DETAIL IN SHS	SIGN DETAIL: DETAIL ON SHEET NUMBER	SIGN DETAIL: DETAIL ON STD SHEET NUMBER
E MONTPELIER VT 14							FY-FLUORESCENT YELLOW FYG-FLUORESCENT YELLOW GREEN																			"SHS"-STANDARD HIGHWAY SIGNS			
SB	4.360	F	W11-6H	30	30								1		X														
		F	W11-6H	30	30		HINGED	6.25								1		X								INSTALL IN CLOSED POSITION			E-153
SB	4.240	F	S3-1	30	30		SCHOOL BUS STOP AHEAD 						1		X														
SB	4.105	F	R1-10R	30	30			6.25								1		X								INSTALL 25 FT +/- SOUTH OF DRIVEWAY	X		
		F	W16-8	24	8		Daggett Rd	1.33																		DAGGETT RD		7	
SB	4.000	F	R2-1L	30	30			6.25								1		X								INSTALL 150 FT +/- SOUTH OF DAGGETT RD	X		
SB	3.360	F	S3-1	30	30		SCHOOL BUS STOP AHEAD			~~0~~ 1	1	1		~~X~~		1												
SB	3.150	F	W1-4L	30	30		REVERSE CURVE			1				X														
		F	W13-1	18	18		40 MPH PLAQUE			1																		
SB	3.070	F	W3-5	36	36		SPEED REDUCTION 40 MPH			1				X														
SB	3.060 TO 3.000	A	N/A	6	8		8 WHITE DELINEATORS	2.66								4	X									INSTALL BACK TO BACK AT 100' SPACING, START 50 FT SOUTH OF SPEED WARNING SIGN		5	
SB	2.990	F	R2-1	24	30								1		X														
		F	R2-1	30	36			7.50								1		X										6	
SB	2.950	F	S3-1	30	30		SCHOOL BUS STOP AHEAD			1				X														
		F	VW-060	30	30		HIDDEN DRIVES			1																		
SIGN SUMMARY SHEET							SHEET TOTALS	30.24	0.00	~~5~~ 6	~~1~~ 0	~~1~~ 0	3	0	0	~~9~~ 8		120										
								SF	SF	EA	EA	EA	EA	EA	EA	EA		FT										
VERMONT AGENCY OF TRANSPORTATION							TOWN TOTALS	803.2	0.0	27.0	3.0	3.0	149	0.0	0.0	132		1980.0										

PROJECT NAME: **Hartford-East Montpelier VT14**
PROJECT NUMBER: **STPG SIGN(21)**
FILE NAME: **East Montpelier.xls** PLOT DATE: **6/18/2009**
PROJECT MANAGER: **N. Avery** DRAWN BY: **T. Guazzoni**
DESIGNED BY: **M. Miller** CHECKED BY: **S. Menard**
EAST MONTPELIER SHEET 17 SHEET **152** OF **162**

DIRECTION	MILEPOINT	LOCATION CODE (SHEET 2)	SIGN CODE	WIDTH (IN)	HEIGHT (IN)	SHEETING REMARKS	SIGN LEGEND FOR ALL POST LENGTHS AND INSTALLATION DATES SEE ORIGINAL RECORD PLANS	NEW SIGNS "A"	NEW SIGNS "B"	EXISTING SIGNS RETAIN	EXISTING SIGNS SALVAGE FROM	EXISTING SIGNS SALVAGE TO	EXISTING SIGNS REMOVE	EXIST POST RETAIN	EXIST POST REMOVE	NUMBER OF NEW POSTS	SQUARE STEEL (IN) 1.75 (LB / FT) 1.88	SQUARE STEEL (IN) 2.00 (LB / FT) 2.42	SQUARE STEEL (IN) 2.50 (LB / FT) 3.35	TUBULAR STEEL Ø (IN) FOUNDATION	TUBULAR STEEL Ø (IN) 3.00 (LB / FT) 7.60	TUBULAR STEEL Ø (IN) 3.50 (LB / FT) 9.00	TUBULAR STEEL Ø (IN) 4.00 (LB / FT) 10.80	TUBULAR STEEL Ø (IN) 5.00 (LB / FT) 14.60	SIGN FRAME REQUIRED	REMARKS	SIGN DETAIL DETAIL IN SHS	SIGN DETAIL DETAIL ON SHEET NUMBER	SIGN DETAIL DETAIL ON STD SHEET NUMBER
E MONTPELIER VT 14							FY-FLUORESCENT YELLOW FYG-FLUORESCENT YELLOW GREEN																			"SHS"-STANDARD HIGHWAY SIGNS			
SB	2.820	F	VD-018	30	18		VILLAGE SIGN			1				X														
SB	2.740	F	R2-1	24	30						1		1		X														
		F	R2-1	30	36			7.50				1				1		X										6
SB	2.690	F	W11-2	30	30								1		X													
		F	W11-8	30	30								1															
		F	W11-2	30	30	FY		6.25								~~2~~ 1		X								X	
		F	W11-8	30	30	FY		6.25																				X	
SB	2.650	F	VD-062B	72	16		BUSINESS SIGN			1				X														
		F	VD-062A	72	16		BUSINESS SIGN			1																		
SB	2.610	F	W11-2	30	30		PEDESTRIAN SYMBOL						1		X													
SB	2.590	F	M2-1	21	15								1		X													
		F	M1-4	24	24								1															
		F	M2-1	21	15			2.19								1		X								X	
		F	M1-4	24	24			4.00																				X	
SB	2.585	G	VR-017	24	30								1		X													
							SHEET TOTALS	26.19 SF	0.00 SF	3 EA	~~0~~ 1 EA	~~0~~ 1 EA	7 EA	0 EA	0 EA	~~4~~ 3 EA	60 FT										
							TOWN TOTALS	803.2	0.0	27.0	3.0	3.0	149	0.0	0.0	132	1980.0										

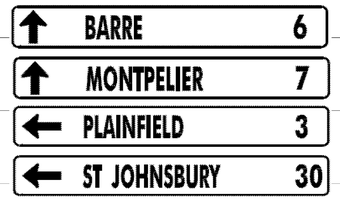
SIGN SUMMARY SHEET

VERMONT AGENCY OF TRANSPORTATION

PROJECT NAME: Hartford-East Montpelier VT14
PROJECT NUMBER: STPG SIGN(21)

FILE NAME: East Montpelier.xls
PROJECT MANAGER: N. Avery
DESIGNED BY: M. Miller
EAST MONTPELIER SHEET 18

PLOT DATE: 6/18/2009
DRAWN BY: T. Guazzoni
CHECKED BY: S. Menard
SHEET 153 OF 162

DIRECTION	MILEPOINT	LOCATION CODE (SHEET 2)	SIGN CODE	WIDTH (IN)	HEIGHT (IN)	SHEETING REMARKS	SIGN LEGEND FOR ALL POST LENGTHS AND INSTALLATION DATES SEE ORIGINAL RECORD PLANS	NEW SIGNS "A"	NEW SIGNS "B"	EXISTING SIGNS RETAIN	EXISTING SIGNS SALVAGE FROM	EXISTING SIGNS SALVAGE TO	EXISTING SIGNS REMOVE	EXIST POST RETAIN	EXIST POST REMOVE	NUMBER OF NEW POSTS	SQUARE STEEL (IN) 1.75 (LB / FT) 1.88	SQUARE STEEL (IN) 2.00 (LB / FT) 2.42	SQUARE STEEL (IN) 2.50 (LB / FT) 3.35	TUBULAR STEEL Ø (IN) FOUNDATION	TUBULAR STEEL Ø (IN) 3.00 (LB / FT) 7.60	TUBULAR STEEL Ø (IN) 3.50 (LB / FT) 9.00	TUBULAR STEEL Ø (IN) 4.00 (LB / FT) 10.80	TUBULAR STEEL Ø (IN) 5.00 (LB / FT) 14.60	SIGN FRAME REQUIRED	REMARKS	SIGN DETAIL: DETAIL IN SHS	SIGN DETAIL: DETAIL ON SHEET NUMBER	SIGN DETAIL: DETAIL ON STD SHEET NUMBER
E MONTPELIER VT 14							FY-FLUORESCENT YELLOW FYG-FLUORESCENT YELLOW GREEN																			"SHS"-STANDARD HIGHWAY SIGNS			
		G	VR-018	24	30			5.00								1		X							TH-39, KELTON RD			E-141
SB	2.575	H	R1-1	30	30						1		1		X													
		H	R1-1	30	30			6.25				1			1		X							TH-39, KELTON RD	X		
SB	2.565	F	D1-1A	72	12								1		X													
		F	D1-1A	72	12								1															
		F	D1-1A	72	12								1															
		F	D1-1A	72	12			6.00								2		X								5	
		F	D1-1A	72	12			6.00																		5	
		F	D1-1A	72	12			6.00																		5	
		F	D1-1A	72	12			6.00																		5	
SB	2.530	F	M3-2	24	12								1		X													
		F	M1-4	24	24								1															
		F	M6-1	21	15								1															
		F	M3-3	24	12								1															
							SHEET TOTALS	35.25 SF	0.00 SF	0 EA	1 ~~0~~ EA	1 ~~0~~ EA	9 EA	0 EA	0 EA	4 EA	60 FT											
							TOWN TOTALS	803.2	0.0	27.0	3.0	3.0	149	0.0	0.0	132	1980.0											

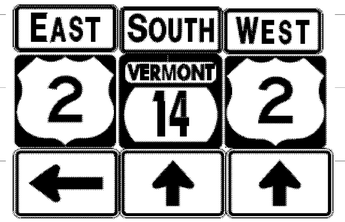
SIGN SUMMARY SHEET

VERMONT AGENCY OF TRANSPORTATION

PROJECT NAME: Hartford-East Montpelier VT14
PROJECT NUMBER: STPG SIGN(21)

FILE NAME: East Montpelier.xls
PROJECT MANAGER: N. Averv
DESIGNED BY: M. Miller
EAST MONTPELIER SHEET 19

PLOT DATE: 6/18/2009
DRAWN BY: T. Guazzoni
CHECKED BY: S. Menard
SHEET 154 OF 162

DIRECTION	MILEPOINT	LOCATION CODE (SHEET 2)	SIGN CODE	WIDTH (IN)	HEIGHT (IN)	SHEETING REMARKS	SIGN LEGEND FOR ALL POST LENGTHS AND INSTALLATION DATES SEE ORIGINAL RECORD PLANS	NEW SIGNS "A"	NEW SIGNS "B"	EXISTING SIGNS RETAIN	EXISTING SIGNS SALVAGE FROM	EXISTING SIGNS SALVAGE TO	EXISTING SIGNS REMOVE	EXIST POST RETAIN	EXIST POST REMOVE	NUMBER OF NEW POSTS	SQUARE STEEL (IN) (LB / FT) 1.75 / 1.88	SQUARE STEEL (IN) (LB / FT) 2.00 / 2.42	SQUARE STEEL (IN) (LB / FT) 2.50 / 3.35	TUBULAR STEEL Ø (IN) FOUNDATION	TUBULAR STEEL Ø (IN) (LB / FT) 3.00 / 7.60	TUBULAR STEEL Ø (IN) (LB / FT) 3.50 / 9.00	TUBULAR STEEL Ø (IN) (LB / FT) 4.00 / 10.80	TUBULAR STEEL Ø (IN) (LB / FT) 5.00 / 14.60	SIGN FRAME REQUIRED	REMARKS	SIGN DETAIL: DETAIL IN SHS	SIGN DETAIL: DETAIL ON SHEET NUMBER	SIGN DETAIL: DETAIL ON STD SHEET NUMBER
E MONTPELIER VT 14							FY-FLUORESCENT YELLOW FYG-FLUORESCENT YELLOW GREEN																			"SHS"-STANDARD HIGHWAY SIGNS			
		F	M1-5	24	24								1																
		F	M6-3	21	15								1																
		F	M3-4	24	12								1																
		F	M1-4	24	24								1																
		F	M6-3	21	15								1																
		F	M3-2	24	12			2.00								2			X						#3A		X	7	
		F	M1-4	24	24			4.00																			X		
		F	M6-1	21	15			2.19																			X		
		F	M3-3	24	12			2.00																	GREEN ON WHITE SHEETING		X	
		F	M1-5	24	24			4.00																					E-136B
		F	M6-3	21	15			2.19																			GREEN ON WHITE SHEETING	X	
		F	M3-4	24	12			2.00																			X		
		F	M1-4	24	24			4.00																			X		
		F	M6-3	21	15			2.19																			X		
SB	2.495	F	D1-2R	72	20								~~2~~ 1		X											REMOVED MM PLAQUE			
							SHEET TOTALS	24.57 SF	0.00 SF	0 EA	0 EA	0 EA	~~6~~ 7 EA	0 EA	0 EA	2 EA	30 FT									
							TOWN TOTALS	803.2	0.0	27.0	3.0	3.0	149	0.0	0.0	132	1980.0												

SIGN SUMMARY SHEET

VERMONT AGENCY OF TRANSPORTATION

PROJECT NAME: **Hartford-East Montpelier VT14**
PROJECT NUMBER: **STPG SIGN(21)**

FILE NAME: **East Montpelier.xls** PLOT DATE: **6/18/2009**
PROJECT MANAGER: **N. Averv** DRAWN BY: **T. Guazzoni**
DESIGNED BY: **M. Miller** CHECKED BY: **S. Menard**
EAST MONTPELIER SHEET 20 SHEET **155** OF **162**

DIRECTION	MILEPOINT	LOCATION CODE (SHEET 2)	SIGN CODE	WIDTH (IN)	HEIGHT (IN)	SHEETING REMARKS	SIGN LEGEND FOR ALL POST LENGTHS AND INSTALLATION DATES SEE ORIGINAL RECORD PLANS	NEW SIGNS "A"	NEW SIGNS "B"	EXISTING SIGNS RETAIN	EXISTING SIGNS SALVAGE FROM	EXISTING SIGNS SALVAGE TO	EXISTING SIGNS REMOVE	EXIST POST RETAIN	EXIST POST REMOVE	NUMBER OF NEW POSTS	SQUARE STEEL (IN) 1.75 (LB / FT) 1.88	SQUARE STEEL (IN) 2.00 (LB / FT) 2.42	SQUARE STEEL (IN) 2.50 (LB / FT) 3.35	TUBULAR STEEL Ø (IN) FOUNDATION	TUBULAR STEEL Ø (IN) 3.00 (LB / FT) 7.60	TUBULAR STEEL Ø (IN) 3.50 (LB / FT) 9.00	TUBULAR STEEL Ø (IN) 4.00 (LB / FT) 10.80	TUBULAR STEEL Ø (IN) 5.00 (LB / FT) 14.60	SIGN FRAME REQUIRED	REMARKS	SIGN DETAIL: DETAIL IN SHS	SIGN DETAIL: DETAIL ON SHEET NUMBER	SIGN DETAIL: DETAIL ON STD SHEET NUMBER
E MONTPELIER VT 14							FY-FLUORESCENT YELLOW FYG-FLUORESCENT YELLOW GREEN																			"SHS"-STANDARD HIGHWAY SIGNS			
		F	D1-2R	72	20			10.00								2		X									5	
SB	2.490	G	VR-017	24	30								1		X														
		G	VR-017	24	30			5.00								1		X									TH-25, QUAKER RD			E-141
SB	2.480	H	R1-1	30	30						1		1		X														
		H	R1-1	30	30			6.25				1				1		X									TH-25, QUAKER RD	X		
																											VT 14 FOLLOWS US 2 FOR 0.2 MILES			
SB	2.455	E	R1-1	30	30								1		X														
		E	R1-1	36	36			9.00								2		X									THIS STOP SIGN IS AT THE SOUTHERN INTERSECTION OF VT 14/US 2	X		
SB	2.450	F	OM-3R	12	36								1		X														
		F	OM-3R	12	36			3.00								1		X										X		
SB	2.420	E	OM-3L	12	36		LEFT OBJECT MARKER			1				X																
SB	2.415	F	R2-1	24	30								1		X														
		F	R2-1	24	30			5.00								1		X										X		
SB	2.395	F	M3-3	24	12						1		1		X												CROSS VT TRAIL (SALV.)			
		F	M1-5	24	24								1																	
							SHEET TOTALS	38.25	0.00	1	~~2~~ 0	~~1~~ 0	7	0	0	8		120											
								SF	SF	EA	EA	EA	EA	EA	EA	EA		FT											
							TOWN TOTALS	803.2	0.0	27.0	3.0	3.0	149	0.0	0.0	132		1980.0											

SIGN SUMMARY SHEET

VERMONT AGENCY OF TRANSPORTATION

PROJECT NAME: **Hartford-East Montpelier VT14**
PROJECT NUMBER: **STPG SIGN(21)**

FILE NAME: **East Montpelier.xls** PLOT DATE: **6/18/2009**
PROJECT MANAGER: **N. Avery** DRAWN BY: **T. Guazzoni**
DESIGNED BY: **M. Miller** CHECKED BY: **S. Menard**
EAST MONTPELIER SHEET 21 SHEET **156** OF **162**

DIRECTION	MILEPOINT	LOCATION CODE (SHEET 2)	SIGN CODE	WIDTH (IN)	HEIGHT (IN)	SHEETING REMARKS	SIGN LEGEND FOR ALL POST LENGTHS AND INSTALLATION DATES SEE ORIGINAL RECORD PLANS	NEW SIGNS "A"	NEW SIGNS "B"	EXISTING SIGNS RETAIN	EXISTING SIGNS SALVAGE FROM	EXISTING SIGNS SALVAGE TO	EXISTING SIGNS REMOVE	EXIST POST RETAIN	EXIST POST REMOVE	NUMBER OF NEW POSTS	SQUARE STEEL (IN) 1.75 (LB / FT) 1.88	SQUARE STEEL (IN) 2.00 (LB / FT) 2.42	SQUARE STEEL (IN) 2.50 (LB / FT) 3.35	TUBULAR STEEL Ø (IN) FOUNDATION	TUBULAR STEEL Ø (IN) 3.00 (LB / FT) 7.60	TUBULAR STEEL Ø (IN) 3.50 (LB / FT) 9.00	TUBULAR STEEL Ø (IN) 4.00 (LB / FT) 10.80	TUBULAR STEEL Ø (IN) 5.00 (LB / FT) 14.60	SIGN FRAME REQUIRED	REMARKS	SIGN DETAIL: DETAIL IN SHS	SIGN DETAIL: DETAIL ON SHEET NUMBER	SIGN DETAIL: DETAIL ON STD SHEET NUMBER
E MONTPELIER VT 14							FY-FLUORESCENT YELLOW FYG-FLUORESCENT YELLOW GREEN																			"SHS"-STANDARD HIGHWAY SIGNS			
		F	M3-3	24	12			2.00				1				1		X							GREEN ON WHITE SHEETING	X		
		F	M1-5	24	24			4.00																				E-136B
SB	2.320	F	VW-205	30	30								1		X														
		F	VW-205	30	30			6.25								~~2~~ 1		X										E-154
		F	W11-7	30	30			6.25																			X	
SB	2.310	F	W11-7	30	30		EQUESTRIAN						1		X													
		F	S3-1	30	30								1															
		F	W1-2R	30	30			6.25								~~2~~ 1	X							X	
		F	S3-1	30	30			6.25																			X	
SB	2.215	F	W1-2R	30	30		RIGHT CURVE						1		X													
SB	2.185	F	W1-2R	30	30			6.25								1	X									INSTALL 150 FT +/- SOUTH OF EXISTING	X	
SB	2.010	F	R2-1	24	30		SPEED LIMIT 35						1		X													
		F	R2-1	24	30		SPEED LIMIT 35					1				1	X									SIGN SALVAGED FROM NB MP 2.15		
SB	1.855	G	VR-017	24	30								1		X														
		G	VR-017	24	30			5.00								1	X									TH-60, LYLEHAVEN LANE		E-141
SIGN SUMMARY SHEET							SHEET TOTALS	42.25 SF	0.00 SF	0 EA	0 EA	~~2~~ 1 EA	6 EA	0 EA	0 EA	~~6~~ 8 EA	120 FT											
VERMONT AGENCY OF TRANSPORTATION							TOWN TOTALS	803.2	0.0	27.0	3.0	3.0	149	0.0	0.0	132	1980.0											

PROJECT NAME: **Hartford-East Montpelier VT14**
PROJECT NUMBER: **STPG SIGN(21)**

FILE NAME: **East Montpelier.xls** PLOT DATE: **6/18/2009**
PROJECT MANAGER: **N. Avery** DRAWN BY: **T. Guazzoni**
DESIGNED BY: **M. Miller** CHECKED BY: **S. Menard**
EAST MONTPELIER SHEET 22 SHEET **157** OF **162**

DIRECTION	MILEPOINT	LOCATION CODE (SHEET 2)	SIGN CODE	WIDTH (IN)	HEIGHT (IN)	SHEETING REMARKS	SIGN LEGEND FOR ALL POST LENGTHS AND INSTALLATION DATES SEE ORIGINAL RECORD PLANS	NEW SIGNS "A"	NEW SIGNS "B"	EXISTING SIGNS RETAIN	EXISTING SIGNS SALVAGE FROM	EXISTING SIGNS SALVAGE TO	EXISTING SIGNS REMOVE	EXIST POST RETAIN	EXIST POST REMOVE	NUMBER OF NEW POSTS	SQUARE STEEL (IN) 1.75 (LB / FT) 1.88	SQUARE STEEL (IN) 2.00 (LB / FT) 2.42	SQUARE STEEL (IN) 2.50 (LB / FT) 3.35	TUBULAR STEEL Ø (IN) FOUNDATION	TUBULAR STEEL Ø (IN) 3.00 (LB / FT) 7.60	TUBULAR STEEL Ø (IN) 3.50 (LB / FT) 9.00	TUBULAR STEEL Ø (IN) 4.00 (LB / FT) 10.80	TUBULAR STEEL Ø (IN) 5.00 (LB / FT) 14.60	SIGN FRAME REQUIRED	REMARKS	SIGN DETAIL: DETAIL IN SHS	SIGN DETAIL: DETAIL ON SHEET NUMBER	SIGN DETAIL: DETAIL ON STD SHEET NUMBER
E MONTPELIER VT 14							FY-FLUORESCENT YELLOW FYG-FLUORESCENT YELLOW GREEN																			"SHS"-STANDARD HIGHWAY SIGNS			
SB	1.845	H	R1-1	30	30						1		1		X													
		H	R1-1	30	30		STOP	6.25				1				1		X								TH-60, LYLEHAVEN LANE	X		
SB	1.800	F	R2-1	24	30						1		1		X													
		F	R2-1	24	30		SPEED LIMIT 50	5.00				1				1		X									X		
SB	1.740	F	W11-6	30	30								1		X													
		F	W11-6H	30	30		HINGED	6.25								1		X								INSTALL IN CLOSED POSITION			E-153
SB	1.690	F	W1-2MeR	30	30		RIGHT CURVE WITH WITH 2 SIDEROADS						1		X													
		F	W13-1	18	18		35 MPH PLAQUE						1															
		F	W1-10R	30	30			6.25								1		X									X		
		F	W16-8	24	8		Fair Rd	1.33																		FAIR RD		7	
SB	1.400	F	W1-4L	30	30		LEFT REVERSE CURVE						1		X													
		F	W13-1	18	18		35 MPH PLAQUE						1															
		F	W1-4MR	30	30			6.25								1		X									6		
		F	W16-8	30	8		East Hill Rd	1.67																		EAST HILL RD		7	
SB	1.305	F	VD-062B	72	16		BUSINESS SIGN			1				X														
							SHEET TOTALS	33.00	0.00	1	~~2~~ 0	~~2~~ 0	7	0	0	5			75									
								SF	SF	EA	EA	EA	EA	EA	EA	EA			FT									
							TOWN TOTALS	803.2	0.0	27.0	3.0	3.0	149	0.0	0.0	132			1980.0									

SIGN SUMMARY SHEET

VERMONT AGENCY OF TRANSPORTATION

PROJECT NAME: **Hartford-East Montpelier VT14**
PROJECT NUMBER: **STPG SIGN(21)**

FILE NAME: **East Montpelier.xls** PLOT DATE: **6/18/2009**
PROJECT MANAGER: **N. Averv** DRAWN BY: **T. Guazzoni**
DESIGNED BY: **M. Miller** CHECKED BY: **S. Menard**
EAST MONTPELIER SHEET 23 SHEET **158** OF **162**

DIRECTION	MILEPOINT	LOCATION CODE (SHEET 2)	SIGN CODE	WIDTH (IN)	HEIGHT (IN)	SHEETING REMARKS	SIGN LEGEND	NEW SIGNS "A"	NEW SIGNS "B"	EXISTING SIGNS RETAIN	EXISTING SIGNS SALVAGE FROM	EXISTING SIGNS SALVAGE TO	EXISTING SIGNS REMOVE	EXIST POST RETAIN	EXIST POST REMOVE	NUMBER OF NEW POSTS	SQUARE STEEL (IN) 1.75 (LB / FT) 1.88	SQUARE STEEL (IN) 2.00 (LB / FT) 2.42	SQUARE STEEL (IN) 2.50 (LB / FT) 3.35	TUBULAR STEEL Ø (IN) FOUNDATION	TUBULAR STEEL Ø (IN) 3.00 (LB / FT) 7.60	TUBULAR STEEL Ø (IN) 3.50 (LB / FT) 9.00	TUBULAR STEEL Ø (IN) 4.00 (LB / FT) 10.80	TUBULAR STEEL Ø (IN) 5.00 (LB / FT) 14.60	SIGN FRAME REQUIRED	REMARKS	SIGN DETAIL: DETAIL IN SHS	SIGN DETAIL: DETAIL ON SHEET NUMBER	SIGN DETAIL: DETAIL ON STD SHEET NUMBER
E MONTPELIER VT 14							FY-FLUORESCENT YELLOW FYG-FLUORESCENT YELLOW GREEN																			"SHS"-STANDARD HIGHWAY SIGNS			
		F	VD-062A	72	16		BUSINESS SIGN			1																		
SB	1.205	F	W11-6H	30	30								1		X													
		F	W11-6H	30	30		HINGED	6.25								1		X									INSTALL IN CLOSED POSITION			E-153
SB	0.910	F	VW-205	30	30								1		X													
		F	VW-205	30	30			6.25								1		X											E-154
SB	0.820	F	W11-6H	30	30								1		X													
		F	W11-6H	30	30		HINGED	6.25								1		X									INSTALL IN CLOSED POSITION			E-153
SB	0.000	G	VD-024	60	7.5		TOWN LINE SIGN						1		X												NEW TOWN LINE SIGN IN NB POSITION			
SIGN SUMMARY SHEET							SHEET TOTALS	18.75	0.00	1	0	0	4	0	0	3		45										
								SF	SF	EA	EA	EA	EA	EA	EA	EA		FT										
VERMONT AGENCY OF TRANSPORTATION							TOWN TOTALS	803.2	0.0	27.0	3.0	3.0	149	0.0	0.0	132		1980.0										

PROJECT NAME: Hartford-East Montpelier VT14
PROJECT NUMBER: STPG SIGN(21)
FILE NAME: East Montpelier.xls
PROJECT MANAGER: N. Avery
DESIGNED BY: M. Miller
EAST MONTPELIER SHEET 24
PLOT DATE: 6/18/2009
DRAWN BY: T. Guazzoni
CHECKED BY: S. Menard
SHEET 159 OF 162

TOWN TOTAL SIGN SUMMARY SHEET

VT ROUTE 14 **Hartford - East Montpelier STPG SIGN (21)**

Townname	County	Town Mileage	NEW SIGNS (SF)		EXISTING SIGNS (EA)				EXIST POST (EA)		NUMBER OF NEW POSTS (EA)				SQUARE STEEL (IN)			TUBULAR STEEL Ø (IN)				
											1.75"	2"	2.5"		1.75	2.00	2.50		3.00	3.50	4.00	5.00
											(LB / FT)				(LB / FT)				(LB / FT)			
			TYPE A	TYPE B	RETAIN	SALVAGE FROM	SALVAGE TO	REMOVE	RETAIN	REMOVE	1.88	2.42	3.35	TOTAL POSTS	1.88	2.42	3.35	FOUNDATION	7.60	9.00	10.80	14.60
Hartford	Windsor	7.856	130.20	0	41	13	9	26	0	0	0	26	0	26	0	390.00	0					
Sharon	Windsor	7.565	447.00	0	11	1	1	93	0	0	0	64	0	64	0	960.00	0					
Royalton	Windsor	9.121	973.50	0	62	9	9	190	0	0	0	152	0	152	0	2280.00	0					
Bethel	Windsor	0.89	99.80	0	0	0	0	20	0	0	0	17	0	17	0	255.00	0					
Randolph	Orange	7.734	771.40	0	19	5	5	155	0	0	0	128	2	130	0	1920.00	30					
Brookfield	Orange	6.677	332.40	0	2	0	0	50	0	0	0	45	4	49	0	675.00	60					
Williamstown	Orange	6.833	501.10	0	67	0	0	94	0	0	28	81	0	109	420	1215.00	0					
Barre (Town)	Washington	4.033	583.80	0	48	9	9	115	0	0	0	89	0	89	0	1335.00	0					
East Montpelier	Washington	5.821	803.20	0	27	3	3	149	0	0	6	120	6	132	90	1800.00	90					
		Sub-Total				40	36	892							510	10830	180					
Estimated Salvaged Street Name Signs to be erected onto new posts =							25															
Salvaged From signs to be added to Remove total =								40														
		TOTAL =	4642.4	0	277	40	61	932	0	0	34	722	12	768	510	10830	180	0	0	0	0	0

SEE ADDITIONAL PAGE, THIS SHEET, FOR ACTUAL TOWN TOTALS.

PROJECT NAME: HARTFORD - EAST MONTPELIER

PROJECT NUMBER: STPG SIGN (21)

FILE NAME: 09c024_TS.DGN
PROJECT LEADER: N. AVERY
DESIGNED BY: N. AVERY
TOWN TOTAL SIGN SUMMARY SHEET

PLOT DATE: 23-JUN-2009
DRAWN BY: N. AVERY
CHECKED BY: A. GAMBLE
SHEET 160 OF 162

ast Montpelier 911 SIGN (21)

Town Mileage		NEW SIGNS (SF)		EXISTING SIGNS (EA)				EXIST POST (EA)		NUMBER OF NEW POSTS (EA)				SQUARE STEEL (IN)			TUBU	
										1.75"	2"	2.5"		1.75	2.00	2.50		3.
										(LB / FT)				(LB / FT)				
		TYPE A	TYPE B	RETAIN	SALVAGE FROM	SALVAGE TO	REMOVE	RETAIN	REMOVE	1.88	2.42	3.35	TOTAL POSTS	1.88	2.42	3.35	FOUNDATION	7.
Hartford	7.856	193.99	0	42	11	11	30	0	0	0	29	0	29	0	433.75	0		
Sharon	7.565	460.06	0	11	1	1	98	0	0	0	66	0	66	0	884.42	0		
Royalton	9.121	1061.55	0	61	10	10	197	0	0	0	166	0	166	0	2204.42	0		
Bethel	0.89	98.75	0	0	0	0	22	0	0	0	17	0	17	0	242.75	0		
Randolph	7.734	784.49	0	19	4	4	160	0	0	0	134	2	136	0	1801.25	30.50		
Brookfield	6.677	344.48	0	2	0	0	53	0	0	0	52	2	54	0	707.50	30.00		
Williamstown	6.833	505.56	0	67	0	0	97	0	0	0	110	0	110	0	1393.50	0		
Barre	4.033	590.46	0	48	23	23	117	0	0	0	88	0	88	0	1211.75	0		
E. Montpelier	5.821	800.65	0	25	15	15	162	0	0	0	130	6	136	0	1729.67	96.00		
	Sub-Total				64	64	936								10,609.01	156.50		
Signs to be erected onto new posts =						25												
To Remove total =							64											
	TOTAL =	4839.99	0	275	64	64	1000	0	0	0	792	10	802	0	10,609.01	156.50	0	

PW 6-4-11 JHS 8-01-11