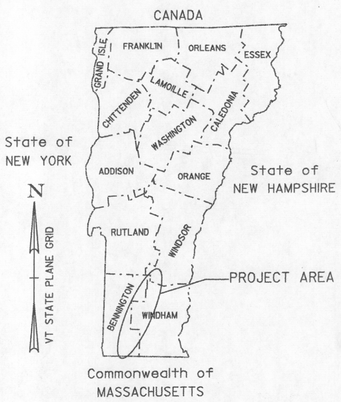
STATE OF VERMONT
AGENCY OF TRANSPORTATION

INDEX OF SHEETS
SEE SHEET 2

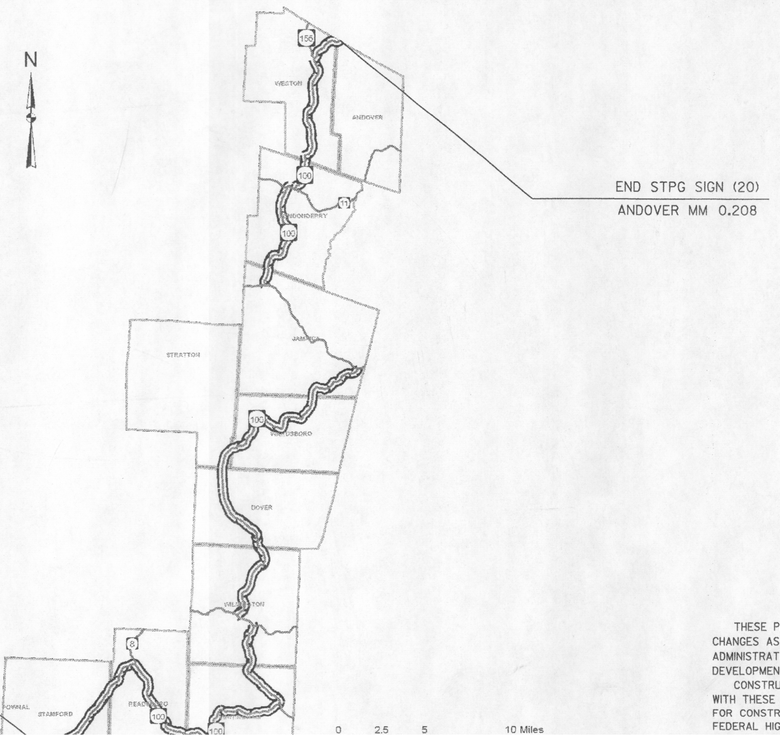


PROPOSED IMPROVEMENT

TOWNS OF STAMFORD – ANDOVER
COUNTIES OF BENNINGTON, WINDHAM AND WINDSOR
VERMONT ROUTE 100

BEGINNING AT THE VERMONT-MASSACHUSETTS STATE LINE ON VT ROUTE 100 IN THE TOWN OF STAMFORD AT MILE MARKER 0.000 AND EXTENDING NORTHERLY ALONG VT ROUTE 100 FOR A DISTANCE OF 66.945 MILES TO THE ANDOVER-LUDLOW TOWN LINE IN THE TOWN OF ANDOVER AT MILE MARKER 0.208; EXCLUDING CLASS 1SECTIONS WITHIN THE PROJECT CORRIDOR.
LENGTH OF ROADWAY = 66.945 MILES
LENGTH OF PROJECT = 66.416 MILES

WORK TO BE PERFORMED UNDER THIS PROJECT INCLUDES THE REMOVAL OF EXISTING SIGNS & POSTS AND THE INSTALLATION OF SIGNS & SIGN POSTS AND OTHER RELATED ITEMS.



END STPG SIGN (20)
ANDOVER MM 0.208

BEGIN STPG SIGN (20)
STAMFORD MM 0.000

CONVENTIONAL SYMBOLS

- COUNTY LINE
- TOWN LINE
- LIMITS OF ACCESS
- POINT OF ACCESS
- FENCE LINE
- STONE WALL
- TRAVELED WAY
- GUARD RAIL
- RAILROAD
- SURVEY LINE
- CULVERT
- POWER POLE
- TELEPHONE POLE
- TREES
- CONTROL OF ACCESS
- PROPERTY LINE

SURVEYED BY : N/A
SURVEYED DATE : N/A

RECORD PLANS

CONTRACTOR: F. R. LAFAYETTE, INC.- ESSEX JUNCTION, VT
RESIDENT ENGINEER: MARK HAUGHWOUT
CONSTRUCTION BEGAN: APRIL 7, 2010
CONSTRUCTION COMPLETE: JULY 27, 2011
RECORD PLANS BY: M. HAUGHWOUT & J. HYDE

I HEREBY CERTIFY THAT ALL THE CONSTUCTION REQUIRED BY THIS SET OF DRAWINGS HAS BEEN ACCOMPLISHED AS INDICATED HEREIN.

BY Mark W. Haughwout RESIDENT ENGINEER
DATE 1/31/13

NOTE: Any further information concerning final quantities, amounts or other details relative to this project may be found at Central Files in the electronic archives.

THESE PLANS ARE SUBJECT TO SUCH ENGINEERING CHANGES AS MAY BE REQUIRED BY THE FEDERAL HIGHWAY ADMINISTRATION OR THE DIRECTOR OF PROGRAM DEVELOPMENT.

CONSTRUCTION IS TO BE CARRIED ON IN ACCORDANCE WITH THESE PLANS AND THE STANDARD SPECIFICATIONS FOR CONSTRUCTION DATED 2006, AS APPROVED BY THE FEDERAL HIGHWAY ADMINISTRATION ON JUNE 15, 2006

for DIRECTOR OF PROGRAM DEVELOPMENT
APPROVED James V. Reed DATE 7-7-2011

PROJECT MANAGER : AMY GAMBLE

INDEX OF SHEETS

1	TITLE SHEET
2	GENERAL NOTES
3	QUANTITY SHEET
4	COUNTY/ TOWN LINE DESIGN
5-6	SIGN DETAILS
7	GUIDE SIGN ASSEMBLY
8	WARNING STREET NAME PLAQUES DETAIL
9-21	STAMFORD TRAFFIC SIGN SUMMARY SHEETS 1-13
22-36	READSBORO TRAFFIC SIGN SUMMARY SHEETS 1-15
37-70	WHITINGHAM TRAFFIC SIGN SUMMARY SHEETS 1-34
71-97	WILMINGTON TRAFFIC SIGN SUMMARY SHEETS 1-27
98-116	DOVER TRAFFIC SIGN SUMMARY SHEETS 1-19
117-118	STRATTON TRAFFIC SIGN SUMMARY SHEETS 1-2
119-136	WARDSBORO TRAFFIC SIGN SUMMARY SHEETS 1-18
137-149	JAMAICA TRAFFIC SIGN SUMMARY SHEETS 1-13
150-171	LONDONDERRY TRAFFIC SIGN SUMMARY SHEETS 1-22
172-194	WESTON TRAFFIC SIGN SUMMARY SHEETS 1-23
195	ANDOVER TRAFFIC SIGN SUMMARY SHEET 1
196	TOWN TOTAL SIGN SUMMARY SHEET
197-198	TRAFFIC CONTROL SHEETS

STANDARDS

E-120	STANDARD SIGN PLACEMENT EXPRESSWAY AND FREEWAY	08/08/1995
E-121	STANDARD SIGN PLACEMENT CONVENTIONAL ROAD	08/08/1995
E-123	GUIDE SIGN PLACEMENT	03/16/2004
E-127	ROUTE MARKINGS AT RURAL INTERSECTIONS	08/08/1995
E-128A	VILLAGE SIGNS A-M	08/08/1995
E-128B	VILLAGE SIGNS N-W	08/08/1995
E-132	GENERAL MOTORIST SERVICES SIGN DETAIL	08/18/1995
E-136B	STATE ROUTE MARKER SIGN DETAILS	08/08/1995
E-136C	STATE NUMBER TOWN HIGHWAY SIGN DETAILS	08/08/1995
E-138	MILEMARKER DETAILS STATE AND TOWN HIGHWAYS	05/30/2003
E-141	REGULATORY SIGN DETAILS	09/20/1995
E-144	REGULATORY SIGN DETAILS	03/29/1999
E-145A	REGULATORY SIGN DETAILS LANE USE CONTROL SIGNS	12/23/1994
E-145B	REGULATORY SIGN DETAILS LANE USE CONTROL SIGNS	12/23/1994
E-153	WARNING SIGN DETAILS	05/01/2004
E-154	WARNING SIGN DETAILS	05/01/2004
E-155	WARNING SIGN DETAILS	05/01/2004
E-164	SQUARE STEEL POSTS	06/08/2009

CLASS I SECTIONS OF HIGHWAY TO BE EXCLUDED FROM THIS PROJECT

TOWN	BEGIN MM	END MM	DISTANCE
READSBORO	6.547	7.076	0.529
		TOTAL CLASS I MILEAGE	0.529

GENERAL NOTES

1. ALL NEW SIGNS SHALL BE IN ACCORDANCE WITH THESE PLANS, THE LATEST EDITION OF THE 2003 MANUAL ON UNIFORM TRAFFIC CONTROL DEVICES, THE STANDARD HIGHWAY SIGN BOOK (SHS) PUBLISHED BY THE FEDERAL HIGHWAY ADMINISTRATION (FHWA), AND APPLICABLE VTRANS E-SERIES STANDARDS OR AS DIRECTED BY THE ENGINEER. SIGN LOCATIONS AS SHOWN ON THE PLANS ARE APROXIMATE. EXACT LOCATIONS TO BE DETERMINED BY THE ENGINEER IN THE FIELD.

2. ALL SIGNS WITHIN THE PROJECT LIMITS ARE TO BE REPLACED UNLESS OTHERWISE NOTED OR AS DIRECTED BY THE RESIDENT ENGINEER.

3. THE CONTRACTOR SHALL BE RESPONSIBLE FOR REPAIRING ANY DAMAGE TO PRIVATE OR PUBLIC PROPERTY CAUSED BY THE CONTRACTOR, AT THEIR EXPENSE.

4. ALL EXISTING MILE MARKER PLAQUES ATTACHED TO A DELINEATOR POST OR ATTACHED TO A RETAINED STAND ALONE SIGN POST ASSEMBLY SHALL BE RETAINED. IF AN EXISTING MILE MARKER PLAQUE IS ATTACHED TO A SIGN POST THAT IS TO BE REMOVED AND REPLACED IN THE SAME LOCATION, THE MILE MARKER PLAQUE SHALL BE REMOVED, SALVAGED AND INSTALLED TO THE NEW SIGN POST. IF AN EXISTING MILE MARKER PLAQUE IS ATTACHED TO A SIGN POST THAT IS TO BE RELOCATED TO A DIFFERENT LOCATION, THE MILE MARKER PLAQUE SHALL BE REMOVED, UNLESS OTHERWISE DIRECTED BY THE ENGINEER. PAYMENT FOR ANY OF THIS WORK SHALL BE INCIDENTAL TO ITEM 675.34 I SQUARE TUBE POST AND ANCHOR. PAYMENT FOR NEW MILE MARKERS AS SHOWN ON THESE PLANS SHALL BE PAID FOR AS ITEM 675.20 TRAFFIC SIGN, TYPE A.

5. SALVAGED SIGN TOTALS HAS BEEN ADDED TO THE TOTAL SIGN REMOVAL COLUMN ON THE TOWN TOTAL SIGN SUMMARY SHEET.

6. EXISTING STREET NAME SIGNS ATTACHED TO SIGN POSTS THAT ARE TO BE REPLACED, SHALL BE REMOVED AND INSTALLED ONTO NEW POST. ALL WORK AND MATERIALS NECESSARY TO REMOVE AND INSTALL THE STREET NAME PLAQUES SHALL BE PAID FOR UNDER ITEM 675.60 ERECTING SALVAGED SIGNS. AN ESTIMATED QUANTITY HAS BEEN ADDED TO ITEM 675.60 to PAY FOR THIS WORK.

7. ALL EXISTING STREET NAME PLAQUES INSTALLED ON STAND ALONE SIGN POSTS SHALL BE RETAINED WITHIN THE PROJECT LIMITS.

8. ALL SIGN PLACEMENT SHALL BE IN CONFORMANCE WITH STATE STANDARD E-120 STANDARD SIGN PLACEMENT CONVENTIOAL ROADS AND E-121 STANDARD SIGN PLACEMENT EXPRESSWAY AND FREEWAY.

9. ALL SIGN LETTERING, DIGITS, ARROWS, AND DESIGN OF SYMBOLS FOR SIGNS DETAILED REFERENCED IN THESE PLANS SHALL CONFORM WITH THE 'STANDARD ALPHABET FOR HIGHWAY SIGNS AND PAVEMENT MARKING' AS ADOPTED BY THE U.S. DEPARTMENT OF TRANSPORTATION AND THE FEDERAL HIGHWAY ADMINISTRATION (FHWA). UNLESS DETAILED WITHIN THESE PLANS.

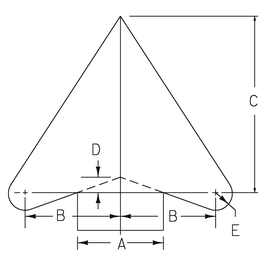
10. ALL COLORS SHALL CONFORM WITH THE STANDARD COLORS ADOPTED BY THE AMERICAN ASSOCIATION OF STATE HIGHWAY AND TRANSPORTATION OFFICIALS (AASHTO) AND APPROVED BY FHWA. UNLESS OTHERWISE NOTED.

11. WITHIN THE TRAFFIC SIGN SUMMARY SHEETS FY= FLUORESCENT YELLOW SHEETING (ASTM VII. VIII, OR IX) AND FYG = FLUORESCENT YELLOW-GREEN SHEETING (ASTM TYPE VII, VIII, OR IX).

12. SALVAGED SIGNS CALCULATED IN THE TRAFFIC SIGN SUMMARY SHEET HAVE BEEN INCLUDED INTO THE TOTAL FOR REMOVING SIGNS.

13. UNLESS OTHERWISE DETAILED ON THE PLANS, ALL SIGN BASE MATERIAL SHALL BE FLAT SHEET ALUMINUM WITH THE FOLLOWING MINIMUM THICKNESSES:

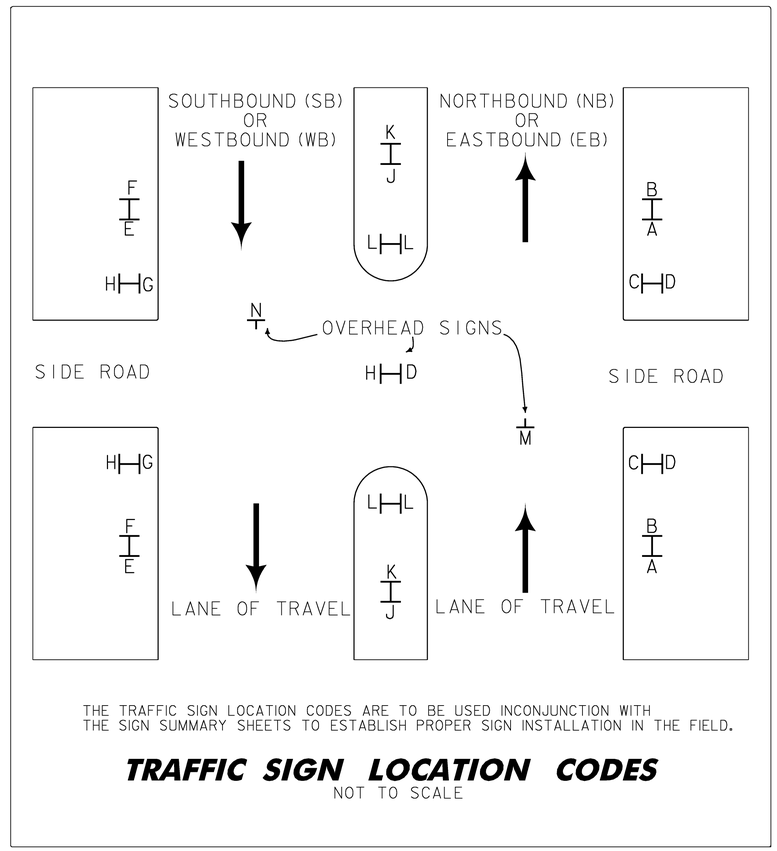
SIZES		24" X 10"		
		24" X 12"	36" X 12"	
		24" X 18"	36" X 15"	
		24" X 24"	36" X 18"	48" X 18"
		24" X 30"	36" X 24"	48" X 24"
	9" X 12"	30" X 15"	30" X 42"	48" X 30"
	12" X 12"	30" X 18"	36" X 36"	48" X 42"
	18" X 18"	30" X 30"	36" X 48"	48" X 48"
	21" X 15"	30" X 42"	36" X 54"	48" X 60"
THICKNESS	0.060"	0.080"	0.100"	0.125"



ARROW NOTES :

ARROW DIMENSIONS ARE BASED ON "A" DIMENSION. SEE BASE SIGN DETAIL FOR MORE INFORMATION. BASE SIGN DETAILS CAN BE FOUND ON SHEET 6 AND 7 OF THESE PROJECT PLANS.

DIMENSIONS (INCHES)				
A	B	C	D	E
2 5/8	3	5 1/4	3/8	1/2
3	3 1/2	6 1/8	7/16	9/16
3 1/8	1 5/8	6 3/8	1/2	5/8
3 1/4	3 3/4	6 5/8	1/2	5/8
3 5/16	13 13/16	6 11/16	1/2	11/16
3 1/2	4	7 1/8	9/16	11/16
3 3/4	4 5/16	7 5/8	9/16	3/4
4	4 5/8	8 1/8	5/8	13/16
4 3/8	5	8 7/8	11/16	7/8
4 1/2	5 3/16	9 1/8	11/16	7/8
4 3/4	5 7/16	9 5/8	3/4	1
5	5 3/4	10 1/8	3/4	1
5 1/4	6	10 5/8	13/16	1 1/16
6	6 7/8	12 3/16	15/16	1 3/16
6 1/2	7 1/2	13 3/16	1	1 5/16
7	8	14 3/16	1 1/16	1 3/8
8	9 3/16	16 1/4	1 1/4	1 5/8



THE TRAFFIC SIGN LOCATION CODES ARE TO BE USED INCONJUNCTION WITH THE SIGN SUMMARY SHEETS TO ESTABLISH PROPER SIGN INSTALLATION IN THE FIELD.

TRAFFIC SIGN LOCATION CODES

NOT TO SCALE

PROJECT NAME: STAMFORD - ANDOVER

PROJECT NUMBER: STPG SIGN (20)

FILE NAME: 09B022_TS.DGN
PROJECT LEADER: N. AVERY
DESIGNED BY: N. AVERY
GENREAL NOTES

PLOT DATE: 06-AUG-2009
DRAWN BY: N. AVERY
CHECKED BY: A. GAMBLE
SHEET 2 OF 198

STATE OF VERMONT
AGENCY OF TRANSPORTATION

QUANTITY SHEET 1

SUMMARY OF ESTIMATED QUANTITIES	TOTALS		DESCRIPTIONS				DETAILED SUMMARY OF QUANTITIES		
ROADWAY	GRAND TOTAL	FINAL	UNIT	ITEMS	ITEM NUMBER	ROUND	QUANTITIES	UNIT	ITEMS
1	1		CY	TRENCH EXCAVATION OF EARTH, EXPLORATORY (N.A.B.I.)	204.22				
56	56		HR	UNIFORMED TRAFFIC OFFICERS	630.10				
940	940		HR	FLAGGERS	630.15				
1	1		LS	MOBILIZATION/DEMOBILIZATION	635.11				
1	1		LS	TRAFFIC CONTROL	641.10				
5989.7	5989.7		SF	TRAFFIC SIGNS, TYPE A	675.20				
16095	16095		LF	SQUARE TUBE SIGN POST AND ANCHOR	675.341				
1195	1195		EACH	REMOVING SIGNS	675.50				
97	97		EACH	ERECTING SALVAGED SIGNS	675.60				

PROJECT NAME: STAMFORD - ANDOVER

PROJECT NUMBER: STPG SIGN (20)

FILE NAME: 09B022_TS.DGN
PROJECT LEADER: N. AVERY
DESIGNED BY: N. AVERY
GENREAL NOTES

PLOT DATE: 10-AUG-2009
DRAWN BY: N. AVERY
CHECKED BY: A. GAMBLE
SHEET 3 OF 198

TEXT	SERIES	DIMENSIONS
ADDISON	C	28.27
ALBANY	C	25.88
ALBURGH	C	29.99
ANDOVER	C	30.05
ARLINGTON	B	29.35
ATHENS	C	24.49
AVERILL	C	26.44
BAKERSFIELD	B	32.50
BARNARD	C	30.49
BARNET	C	24.83
BARRE CITY	B	32.50
BARRE TOWN	B	32.50
BARTON	C	25.38
BELVIDERE	C	32.50
BENNINGTON	B	32.50
BENSON	C	25.41
BERKSHIRE	B	29.04
BERLIN	C	22.50
BETHEL	C	23.80
BLOOMFIELD	B	32.13
BOLTON	C	24.39
BRADFORD	C	32.50
BRAINTREE	C	32.50
BRANDON	C	30.46
BRATTLEBORO	B	32.50
BRIDGEWATER	B	32.50
BRIDPORT	C	32.06
BRIGHTON	C	32.06
BRISTOL	C	27.24
BROOKFIELD	B	31.91
BROWNINGTON	B	31.22
BRUNSWICK	B	30.60
BURKE	C	20.93
BUELS GORE	B	32.50
BURLINGTON	B	32.50
CABOT	C	20.50
CALAIS	C	22.22
CAMBRIDGE	B	29.74
CANAAN	C	25.15
CASTLETON	B	29.32
CAVENDISH	C	32.50
CHARLESTON	B	32.50
CHARLOTTE	B	29.32
CHELSEA	C	28.84
CHESTER	C	28.46
CHITTENDEN	B	30.56
CLARENDON	B	30.32
COLCHESTER	B	32.50
CONCORD	C	30.42
CORINTH	C	27.27
CORNWALL	C	32.50
COVENTRY	C	32.50
CRAFTSBURY	B	32.50
DANBY	C	21.65
DANVILLE	C	31.16
DERBY	C	21.15
DORSET	C	24.55
DOVER	C	20.74
DUMMERSTON	B	32.50
DUXBURY	C	30.75
EDEN	C	15.85
ENOSBURG	C	32.50
EAST HAVEN	B	32.50
E. MONTPELIER	B (5")	32.50
ELMORE	C	25.46
ESSEX	C	20.38
FAIRFAX	C	27.05
FAIRFIELD	C	32.50
FAIR HAVEN	B	32.50
FAIRLEE	C	26.12
FAYSTON	C	28.85
FERDINAND	B	29.17
FERRISBURGH	B	32.50
FLETCHER	C	31.85
FRANKLIN	C	31.31

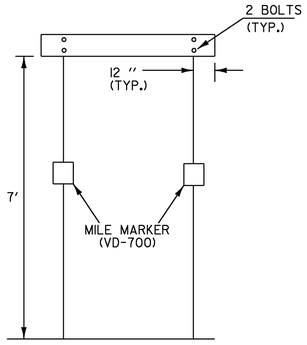
TEXT	SERIES	DIMENSIONS
GEORGIA	C	27.74
GLOVER	C	25.00
GOSHEN	C	25.16
GLASTENBURY	B (5")	31.32
GRAFTON	C	29.31
GRAND ISLE	B	32.50
GRANVILLE	C	32.50
GREENSBORO	B	32.50
GROTON	C	25.35
GUILDHALL	C	32.50
GUILFORD	C	31.78
HALIFAX	C	27.14
HANCOCK	C	29.96
HARDWICK	C	32.50
HARTFORD	C	32.50
HARTLAND	C	32.50
HIGHGATE	C	31.14
HINESBURG	B	29.23
HOLLAND	C	29.22
HUBBARDTON	B	31.42
HYDE PARK	B	32.50
IRA	C	10.15
IRASBURG	C	32.37
ISLE LA MOTTE	B (5")	32.50
JAMAICA	C	28.26
JAY	C	11.85
JERICHO	C	27.24
JOHNSON	C	30.39
KILLINGTON	B	30.16
KIRBY	C	18.99
LANDGROVE	B	30.33
LEICESTER	C	32.50
LEMINGTON	B	28.79
LONDONDERRY	B (5")	32.18
LOWELL	C	25.04
LUDLOW	C	26.10
LUNENBERG	B	30.01
LYNDON	C	24.96
MAIDSTONE	B	29.51
MANCHESTER	B	32.50
MARLBORO	C	32.50
MARSHFIELD	B	32.47
MENDON	C	26.02
MIDDLEBURY	B	32.50
MIDDLESEX	B	29.06
MIDDLETOWN SPR	B (5")	32.50
MILTON	C	22.63
MONTGOMERY	B	32.50
MONTPELIER	B	31.94
MORETOWN	C	32.50
MORGAN	C	26.52
MORRISTOWN	B	32.50
MOUNT HOLLY	B (5")	31.97
MOUNT TABOR	B	32.02
NEWARK	C	25.65
NEWBURY	C	30.87
NEWFANE	C	29.73
NEW HAVEN	B	32.50
NEWPORT CITY	B (5")	32.50
NEWPORT TOWN	B (5")	32.50
NORTH HERO	B	32.50
NORTHFIELD	B	31.57
NORTON	C	25.60
NORWICH	C	28.77
ORANGE	C	25.88
ORWELL	C	25.57
PANTON	C	25.38
PAWLET	C	24.59
PEACHAM	C	30.23
PERU	C	16.38
PITTSFIELD	C	32.50
PITTSFORD	C	32.50
PLAINFIELD	B	29.65
PLYMOUTH	C	32.50
POMFRET	C	29.42

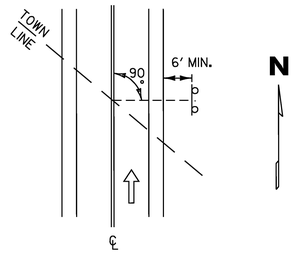
TEXT	SERIES	DIMENSIONS
POULTNEY	C	32.50
POWNAL	C	26.35
PROCTOR	C	29.31
PUTNEY	C	24.83
RANDOLPH	C	32.50
READING	C	27.47
READSBORO	B	31.09
RICHFORD	C	32.06
RICHMOND	C	32.50
RIPTON	C	22.97
ROCHESTER	B	29.54
ROCKINGHAM	B	32.50
ROXBURY	C	30.44
ROYALTON	C	32.50
RUPERT	C	24.94
RUTLAND CITY	B (5")	32.50
RUTLAND TOWN	B (5")	32.50
RYEGATE	C	28.47
ST. ALBANS CITY	B (5")	32.50
ST. ALBANS TOWN	B (5")	32.50
ST. GEORGE	B	32.50
ST. JOHNSBURY	B (5")	32.50
SALISBURY	C	32.50
SEARSBURG	B	30.93
SHAFTSBURY	B	32.50
SHARON	C	25.91
SHEFFIELD	C	32.50
SHELDON	C	29.42
SHOREHAM	C	32.50
SHREWSBURY	B	32.50
S. BURLINGTON	B (5")	32.50
SOUTH HERO	B	32.50
SPRINGFIELD	B	32.50
STAMFORD	C	32.50
STARKSBORO	B	32.50
STOCKBRIDGE	B	32.50
STOWE	C	21.30
STRAFFORD	B	30.42
STRATTON	C	32.06
SUDBURY	C	30.77
SUNDERLAND	B	32.50
SUTTON	C	24.21
SWANTON	C	30.22
THETFORD	C	32.50
TINMOUTH	C	32.14
TOPSHAM	C	30.53
TOWNSHEND	B	31.70
TROY	C	16.54
TUNBRIDGE	C	32.50
UNDERHILL	C	32.50
VERGENNES	B	30.03
VERNON	C	25.79
VERSHIRE	C	31.72
WAITSFIELD	B	30.44
WALDEN	C	25.46
WALLINGFORD	B	32.50
WALTHAM	C	29.91
WARDSBORO	B	32.29
WARREN	C	25.99
WARRENS GORE	B (5")	32.50
WASHINGTON	B	32.50
WATERBURY	B	31.40
WATERFORD	B	30.65
WATERVILLE	B	31.35
WEATHERSFIELD	B (5")	32.50
WELLS	C	20.83
WEST FAIRLEE	B (5")	32.50
WESTFIELD	C	32.50
WEST HAVEN	B	32.50
WESTFORD	C	32.50
WESTMINISTER	B	32.50
WESTMORE	C	32.50
WESTON	C	25.85

TEXT	SERIES	DIMENSIONS
WEST RUTLAND	B (5")	32.50
WEST WINDSOR	B (5")	32.50
WEYBRIDGE	C	32.50
WHEELOCK	C	32.50
WHITING	C	25.86
WHITINGHAM	B	32.50
WILLIAMSTOWN	B (5")	32.50
WILLISTON	C	32.50
WILMINGTON	B	32.16
WINDHAM	C	29.66
WINDSOR	C	28.77
WINHALL	C	28.24
WINOOSKI	C	30.81
WOLCOTT	C	29.38
WOODBURY	C	32.50
WOODFORD	C	32.50
WOODSTOCK	B	31.79
WORCESTER	B	30.76

NOTES:

1. WORD TO WORD SPACING FOR MULTIPLE TEXT TOWN NAMES IS ADJUSTABLE TO ACCOMMODATE DIMENSION REQUIREMENTS.
2. DIMENSIONS SHOWN ARE APPROXIMATE AND MAY BE ADJUSTED SLIGHTLY TO ACCOMMODATE VARIOUS MANUFACTURER'S LETTER WIDTHS.
3. ALL DIMENSIONS ARE IN INCHES UNLESS OTHERWISE NOTED

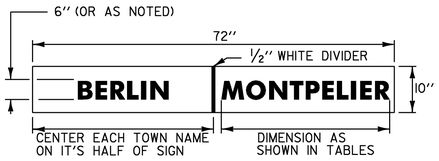




THE SIGN SHALL BE MOUNTED PARALLEL WITH THE ROADWAY, NORMALLY ON RIGHT SIDE TRAVELING WEST TO EAST OR SOUTH TO NORTH.

N

WHEN CROSSING COUNTY BOUNDARIES AN ADDITIONAL COUNTY LINE SIGN SHALL BE MOUNTED BELOW THE TOWN LINE SIGN MAINTAINING AN SEVEN FOOT CLEARANCE.



VD-024
VD-025 SIMILIAR

COUNTY NAMES

TEXT	SERIES	DIMENSIONS
ADDISON CO.	B	32.50
BENNINGTON CO.	B (5")	32.50
CALEDONIA CO.	B (5")	32.50
CHITTENDEN CO.	B (5")	32.50
ESSEX CO.	C	32.50
FRANKLIN CO.	B (5")	32.50
GRAND ISLE CO.	B (5")	32.50
LAMOILLE CO.	B (5")	32.50
ORANGE CO.	B	32.50
ORLEANS CO.	B	32.50
RUTLAND CO.	B	32.50
WASHINGTON CO.	B (5")	32.50
WINDHAM CO.	B	32.50
WINDSOR CO.	B	32.50

VD-025

TOWN/COUNTY LINE SIGN NOTES:

1. THE SIGN BASE MATERIAL SHALL BE HIGH DENSITY OVERLAID PLYWOOD 5/8 INCH THICK OR ALUMINUM SHEETING 0.125" MINIMUM THICKNESS. THE RETROREFLECTIVE MATERIAL SHALL BE SHEETING APPLIED TO THE ENTIRE BACKGROUND OF THE SIGN. THE LEGEND SHALL BE CUT-OUT RETROREFLECTIVE LEGEND. ALL RETROREFLECTIVE MATERIAL SHALL BE EQUAL TO OR EXCEEDING THE "THE AMERICAN SOCIETY OF TESTING AND MATERIALS" (ASTM 4956-01) TYPE III SHEETING.
2. SIGNS SHALL HAVE A MINIMUM ASTM TYPE III SHEETING WITH A WHITE LEGEND ON A GREEN BACKGROUND.
3. LEGEND SHALL CONFORM WITH THE STANDARD ALPHABETS FOR HIGHWAY SIGNS APPROVED BY THE NATIONAL JOINT COMMITTEE ON UNIFORM TRAFFIC CONTROL DEVICES.
4. ALL SIGNS SHALL BE IN ACCORDANCE WITH "THE MANUAL ON UNIFORM TRAFFIC CONTROL DEVICES" (2003 MUTCD) AND THE "STANDARD HIGHWAY SIGNS" BOOK (SHS) PUBLISHED BY THE FEDERAL HIGHWAY ADMINISTRATION (FHWA).

PROJECT NAME: STAMFORD - ANDOVER

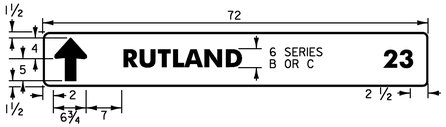
PROJECT NUMBER: STPG SIGN (20)

FILE NAME: 09b022_TS.DGN
PROJECT LEADER: N. AVERY
DESIGNED BY: N. AVERY
COUNTY/ TOWNLINE DESIGN

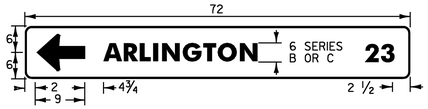
PLOT DATE: 06-AUG-2009
DRAWN BY: N. AVERY
CHECKED BY: A. GAMBLE
SHEET 4 OF 198



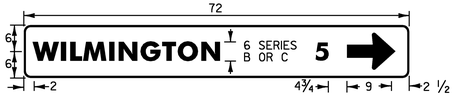
D1-1



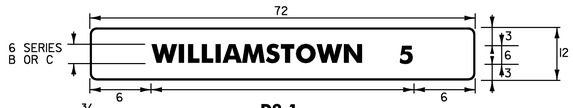
D1-1A



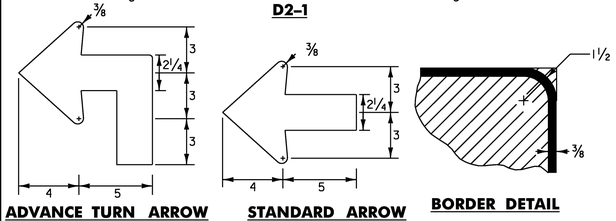
D1-1A



D1-1A

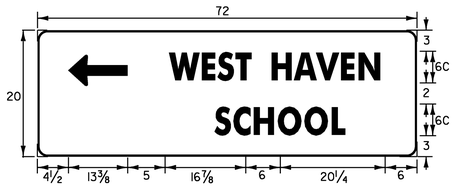


D2-1



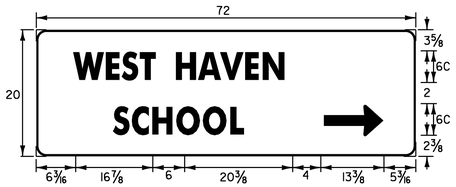
STANDARD DESTINATION SIGN NOTES
D1-1, D1-1A, D1-2, D2-1

1. ALL SIGNS SHALL BE IN ACCORDANCE WITH THE MUTCD AND THE "STANDARD HIGHWAY SIGNS" BOOK (SHS) PUBLISHED BY THE FEDERAL HIGHWAY ADMINISTRATION (FHWA).
2. THE SIGN BASE MATERIAL FOR STANDARD DESTINATION SIGNS SHALL BE HIGH DENSITY OVERLAYED PLYWOOD 5/8 INCH THICK OR FLAT SHEET ALUMINUM 1/8 INCH THICK.
3. THE DESTINATION SIGNS SHOWN ON THIS SHEET SHALL HAVE WHITE RETROREFLECTIVE ASTM TYPE III TEXT, ARROWS AND BORDERS ON A GREEN RETROREFLECTIVE ASTM TYPE III BACKGROUND. THE COLORS SHALL CONFORM WITH THE COLORS ADOPTED BY AASHTO AND APPROVED BY THE FHWA.
4. MULTIPLE ASSEMBLIES SHALL USE THE SAME SIZE THROUGHOUT. DO NOT MIX AND MATCH OLDER SIGN SIZES WITH NEW SIGN HEIGHTS AND WIDTHS.
5. ALL DIMENSIONS SHOWN IN INCHES UNLESS OTHERWISE NOTED.



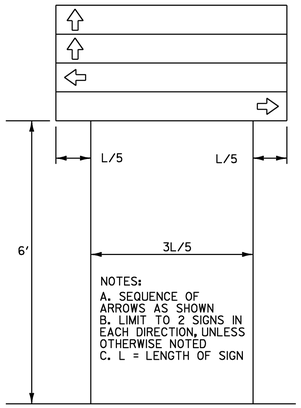
D1-2 (L)

LATERAL SPACING OF "SCHOOL" TEXT SHALL BE CENTERED TO TOP LINE TEXT.

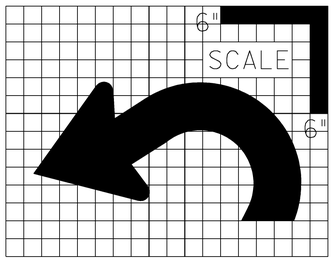


D1-2 (R)

LATERAL SPACING OF "SCHOOL" TEXT SHALL BE CENTERED TO TOP LINE TEXT.



DESTINATION ASSEMBLY





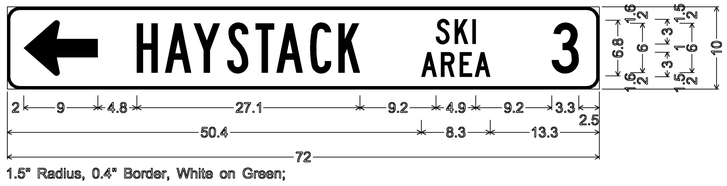
1.5" Radius, 0.4" Border, 0.4" Indent, Green on White;
"MAIN LOT" B:

VR-731



1.5" Radius, 0.4" Border, White on Green;
Standard Arrow Custom 9.0" X 6.8" 180"; "STRATTON MTN" B specified length;
"SKI" C; "AREA" C; "10" B specified length;

D1-1A



1.5" Radius, 0.4" Border, White on Green;
Standard Arrow Custom 9.0" X 6.8" 180"; "HAYSTACK" B; "SKI" C; "AREA" C; "3" C;

D1-1A



1.5" Radius, 0.4" Border, White on Green;
Standard Arrow Custom 9.0" X 6.8" 90"; "MOUNT SNOW" B 90% spacing; "SKI" C;
"AREA" C; "7" C;

D1-1A



1.5" Radius, 0.4" Border, White on Green;
Arrow Custom - 9.0" 135";
"GREENFIELD," B " " C "MA" B " " C "26" B specified length;

D1-1A



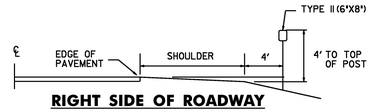
1.5" Radius, 0.4" Border, White on Green;
"GREENFIELD, MA" B; Standard Arrow Custom 14.9" X 6.8" 0";

D2-1

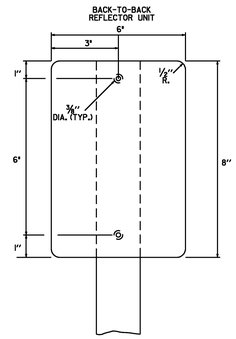


1.5" Radius, 0.4" Border, White on Green;
"LAKE WILLOUGHBY" B specified length; "9" B;
Standard Arrow Custom 9.0" X 6.0" 45";

D1-1A



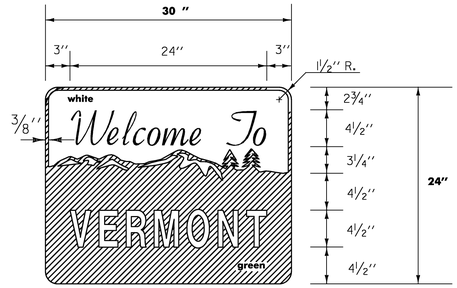
RIGHT SIDE OF ROADWAY



TYPE II (6"X8")

DELINEATORS WITH RETROREFLECTIVE SHEETING

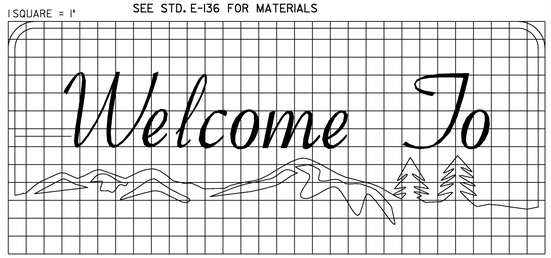
MATERIAL FOR RETROREFLECTIVE SHEETING FOR DELINEATORS SHALL BE A 0.063" ALUMINUM BACKING WITH A WHITE ASTM TYPE III OR TYPE IV.



VD-421

NOTE:
FOR THE WORDS "WELCOME TO" USE GERBER FONT MURRAY HILL BOLD OR EQUIVALENT. TEXT COLOR IS GREEN.
ALL OTHER TEXT USE GERBER FONT SOUVENIR DEMI BOLD OR EQUIVALENT. TEXT COLOR IS WHITE.
REFER TO STD. E-131 FOR COLORS.

MATERIALS:
SEE STD. E-136 FOR MATERIALS

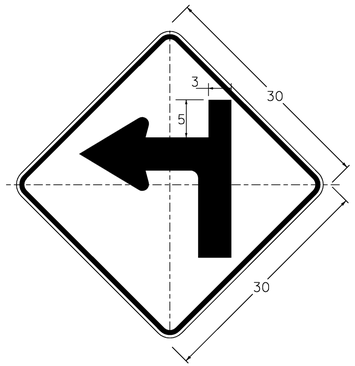


PROJECT NAME: STAMFORD - ANDOVER

PROJECT NUMBER: STPG SIGN (20)

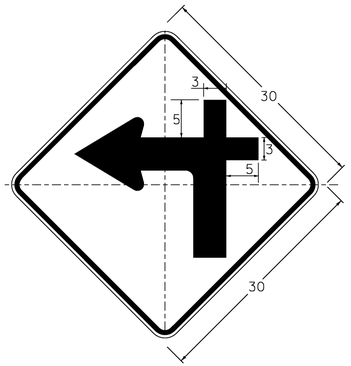
FILE NAME: 09B022_TS.DGN
PROJECT LEADER: N. AVERY
DESIGNED BY: N. AVERY
SIGN DESIGNS I

PLOT DATE: 06-AUG-2009
DRAWN BY: N. AVERY
CHECKED BY: A. GAMBLE
SHEET 5 OF 198



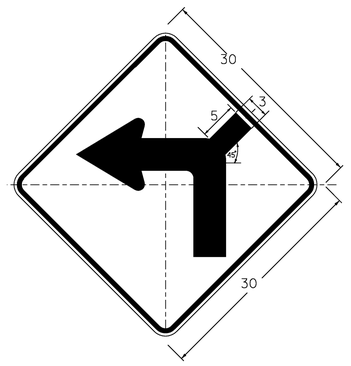
W1-1Mb L(R)

DIMENSIONS NOT SHOWN
FOR THIS DETAIL SHALL CONFORM
TO THE LATEST EDITION OF THE 2003 MUTCD
FOR SIGN DETAIL W1-1.
UNLESS OTHERWISE NOTED FOR THIS DETAIL



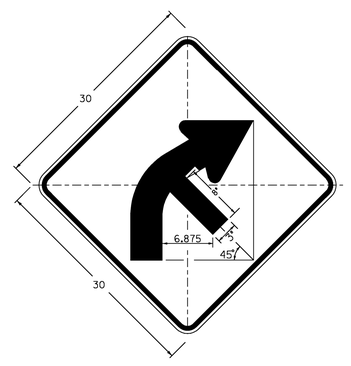
W1-1Mc L(R)

DIMENSIONS NOT SHOWN
FOR THIS DETAIL SHALL CONFORM
TO THE LATEST EDITION OF THE 2003 MUTCD
FOR SIGN DETAIL W1-1.
UNLESS OTHERWISE NOTED FOR THIS DETAIL



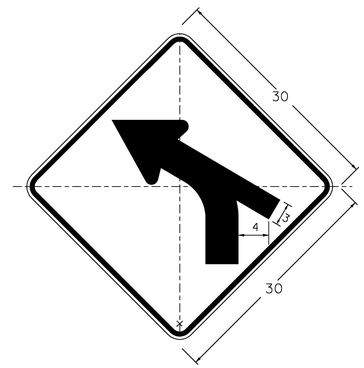
W1-1Md L(R)

DIMENSIONS NOT SHOWN
FOR THIS DETAIL SHALL CONFORM
TO THE LATEST EDITION OF THE 2003 MUTCD
FOR SIGN DETAIL W1-1.
UNLESS OTHERWISE NOTED FOR THIS DETAIL



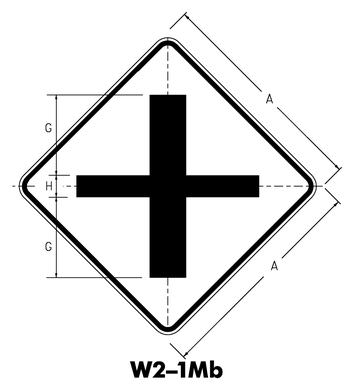
W1-2Mb R(L)

DIMENSIONS NOT SHOWN
FOR THIS DETAIL SHALL CONFORM
TO THE LATEST EDITION OF THE 2003 MUTCD
FOR SIGN DETAIL W1-2.
UNLESS OTHERWISE NOTED FOR THIS DETAIL



W1-2Mh L(R)

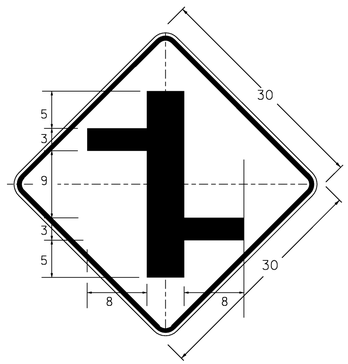
DIMENSIONS NOT SHOWN
FOR THIS DETAIL SHALL CONFORM
TO THE LATEST EDITION OF THE 2003 MUTCD
FOR SIGN DETAIL W1-2.
UNLESS OTHERWISE NOTED FOR THIS DETAIL



W2-1Mb

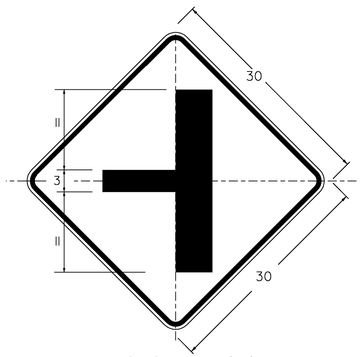
DIMENSIONS NOT SHOWN
FOR THIS DETAIL SHALL CONFORM
TO THE LATEST EDITION OF THE 2003 MUTCD
FOR SIGN DETAIL W2-1.
UNLESS OTHERWISE NOTED FOR THIS DETAIL

SIGN	DIMENSIONS (IN)		
	A	G	H
MIN & STD.	30	11	3
SPECIAL	36	13	4



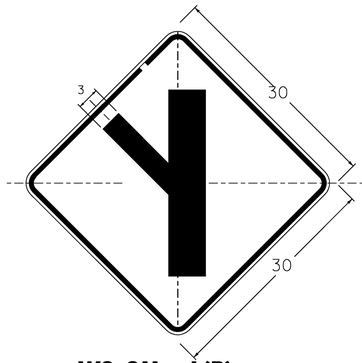
W2-1Md

DIMENSIONS NOT SHOWN
FOR THIS DETAIL SHALL CONFORM
TO THE LATEST EDITION OF THE 2003 MUTCD
FOR SIGN DETAIL W2-1.
UNLESS OTHERWISE NOTED FOR THIS DETAIL



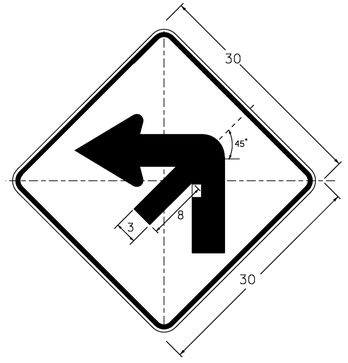
W2-2Ma L(R)

DIMENSIONS NOT SHOWN
FOR THIS DETAIL SHALL CONFORM
TO THE LATEST EDITION OF THE 2003 MUTCD
FOR SIGN DETAIL W2-2.
UNLESS OTHERWISE NOTED FOR THIS DETAIL



W2-3Ma L(R)

DIMENSIONS NOT SHOWN
FOR THIS DETAIL SHALL CONFORM
TO THE LATEST EDITION OF THE 2003 MUTCD
FOR SIGN DETAIL W2-3.
UNLESS OTHERWISE NOTED FOR THIS DETAIL



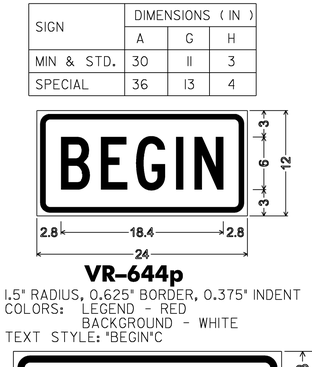
W1-1Mf L(R)

DIMENSIONS NOT SHOWN
FOR THIS DETAIL SHALL CONFORM
TO THE LATEST EDITION OF THE 2003 MUTCD
FOR SIGN DETAIL W1-1.
UNLESS OTHERWISE NOTED FOR THIS DETAIL



1.5" RADIUS, 0.625" BORDER, 0.375" INDENT
COLORS: LEGEND - BLACK
BACKGROUND - WHITE
TEXT STYLE: "SAFETY BELTS" B; "REQUIRED" C
SYMBOL: RG015 REFER TO 2004 SHS BOOK

VR-601

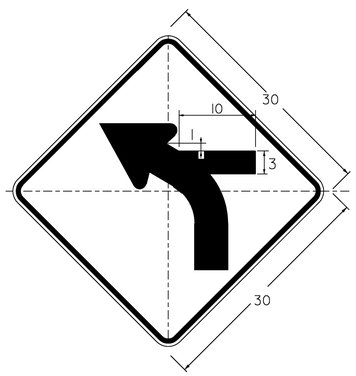


VR-644p

1.5" RADIUS, 0.625" BORDER, 0.375" INDENT
COLORS: LEGEND - RED
BACKGROUND - WHITE
TEXT STYLE: "BEGIN"C

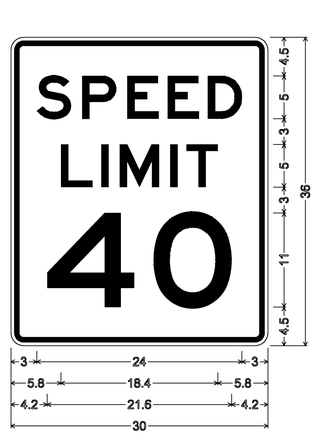
VR-208

1.5" RADIUS, 0.625" BORDER, 0.375" INDENT
COLORS: LEGEND - BLACK
BACKGROUND - WHITE
TEXT STYLE: "UNLESS" C;
"OTHERWISE"C - SPECIFIED LENGTH;
"POSTED" C



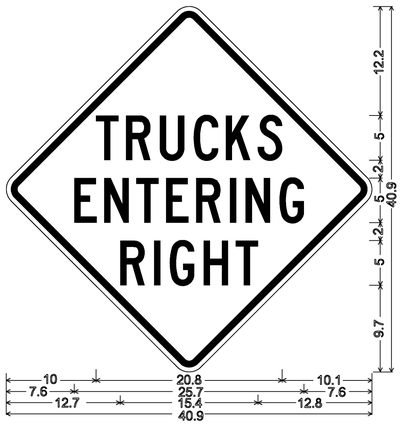
W1-2Md L

DIMENSIONS NOT SHOWN
FOR THIS DETAIL SHALL CONFORM
TO THE LATEST EDITION OF THE 2003 MUTCD
FOR SIGN DETAIL W1-2.
UNLESS OTHERWISE NOTED FOR THIS DETAIL



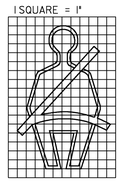
R2-1

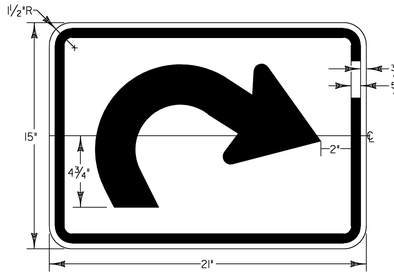
1.5" RADIUS, 0.625" BORDER, 0.375" INDENT
COLORS: LEGEND - BLACK
BACKGROUND - WHITE
TEXT STYLE: "SPEED" E; "LIMIT" E; "40" E



30" SQUARE SIGN FACE
1.875" RADIUS, 0.75" BORDER, 0.50" INDENT
COLORS: LEGEND - BLACK
BACKGROUND - YELLOW
TEXT STYLE: C

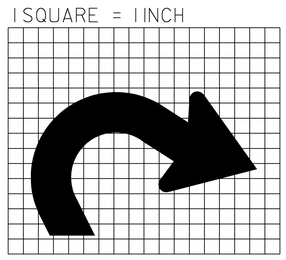
VW-081





VM-013 R(L)

COLORS: LEGEND - VARIES
BACKGROUND - VARIES
REFER TO TRAFFIC SIGN SUMMARY SHEET
FOR SIGN COLORS REQUIRED.



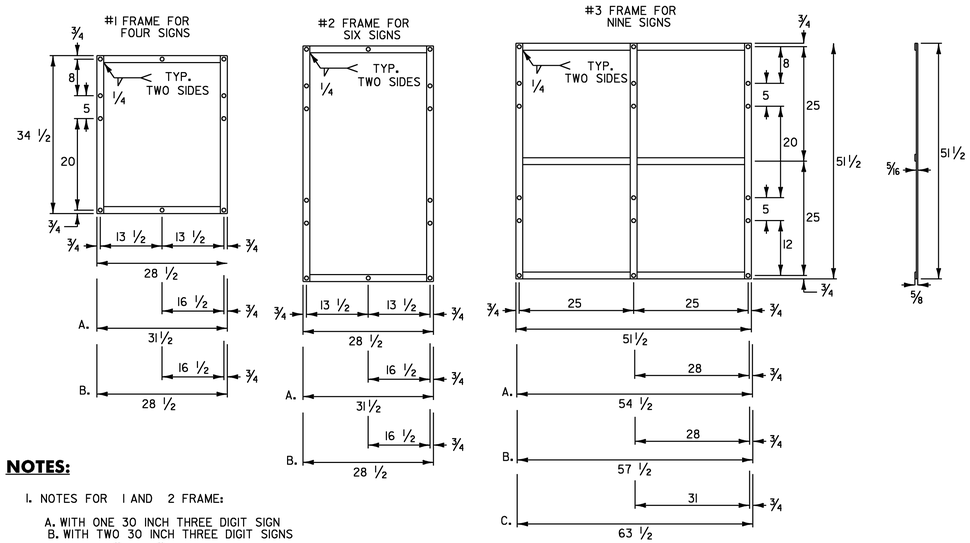
PROJECT NAME: STAMFORD - ANDOVER

PROJECT NUMBER: STPG SIGN (20)

FILE NAME: 09B022_TS.DGN
PROJECT LEADER: N. AVERY
DESIGNED BY: N. AVERY
SIGN DESIGNS 2

PLOT DATE: 06-AUG-2009
DRAWN BY: N. AVERY
CHECKED BY: A. GAMBLE
SHEET 6 OF 198

ROUTE MARKER ASSEMBLY FRAMES



NOTES:

1. NOTES FOR 1 AND 2 FRAME:

   A. WITH ONE 30 INCH THREE DIGIT SIGN
   B. WITH TWO 30 INCH THREE DIGIT SIGNS
      # #

2. NOTES FOR 3 FRAME:

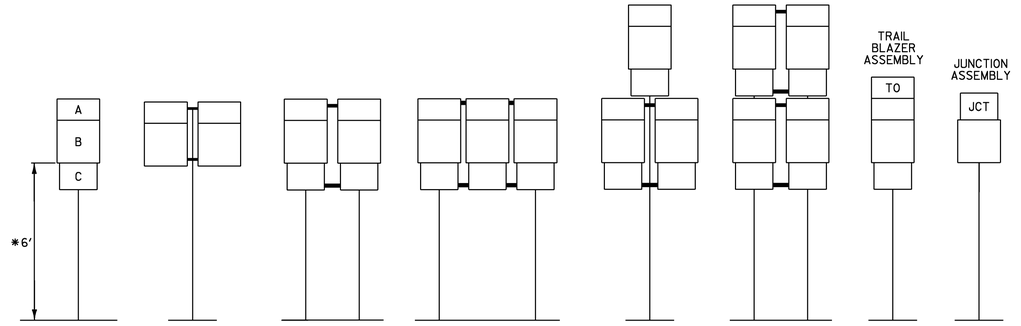
   A. WITH ONE 30 INCH THREE DIGIT SIGN IN AN OUTSIDE POSITION.
   B. WITH ONE 30 INCH THREE DIGIT SIGN IN THE CENTER POSITION OR TWO SUCH SIGNS IN THE OUTSIDE POSITIONS.
   C. WITH THREE 30 INCH THREE DIGIT SIGNS.

3. ALL HOLES SHALL BE 7/16 INCH DIAMETER. FOR OTHER SIGN COMBINATIONS THAN ABOVE, THE FRAME DIMENSIONS AND HOLE SPACING SHALL BE MODIFIED AS NECESSARY. THE FRAME SHALL BE PAINTED WITH ONE COAT OF PRIMER AND A SECOND COAT OF BLACK PAINT. THE PAINT SHALL BE OF THE TYPE USED ON EXTERIOR METAL SURFACES TO PREVENT METAL CORROSION.

4. STANDARD FRAMES SHALL BE 5/16 INCH x 1 1/2 INCH WELDED A-36 STEEL.

5. ALL DIMENSIONS SHOWN IN INCHES UNLESS OTHERWIS NOTED.

STANDARD MOUNTING OF ROUTE MARKER ASSEMBLIES



A - CARDINAL DIRECTION MARKER
B - ROUTE NUMBER
C - ADVANCE TURN ARROW OR DIRECTIONAL ARROW

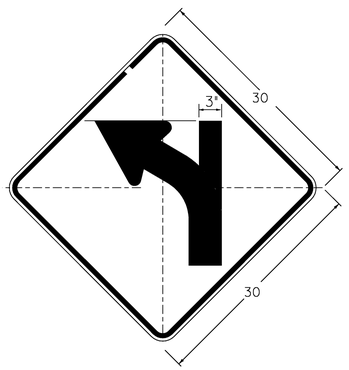
* WHERE PARKING OR PEDESTRIAN TRAFFIC WILL OCCUR IN THE IMMEDIATE VICINITY OF THESE SIGNS MINIMUM VERTICAL CLEARANCE SHALL BE INCREASED TO SEVEN FEET

INSTALLATION SEQUENCE:

IN MULTIPLE HORIZONTAL MOUNTINGS PLACE A ROUTE MARKER ASSEMBLY INDICATING A LEFT TURN ON THE LEFT SIDE OF THE ASSEMBLY; RIGHT TURN ON THE RIGHT SIDE. FOR VERTICALLY STACKED MOUNTINGS PLACE THE STRAIGHT THROUGH MOVE INDICATION ON TOP, THE LEFT OR RIGHT TURNS AS APPROPRIATE BENEATH.

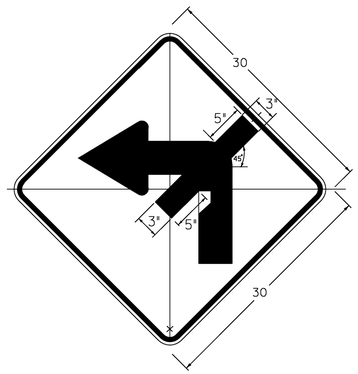
NOTES:

1. ALL DIMENSIONS SHOWN IN INCHES UNLESS OTHERWISE NOTED.
2. VERTICAL FRAME MEMBERS SHALL LINE UP WITH SIGN POST ON WHICH THEY ARE MOUNTED.



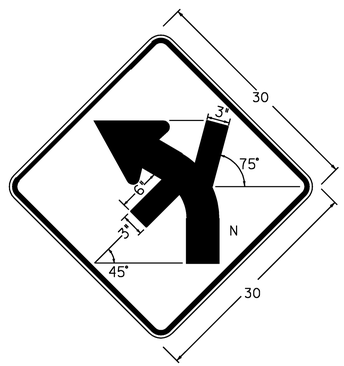
W1-2Mg L

DIMENSIONS NOT SHOWN FOR THIS DETAIL SHALL CONFORM TO THE LATEST EDITION OF THE 2003 MUTCD FOR SIGN DETAIL W1-2. UNLESS OTHERWISE NOTED FOR THIS DETAIL



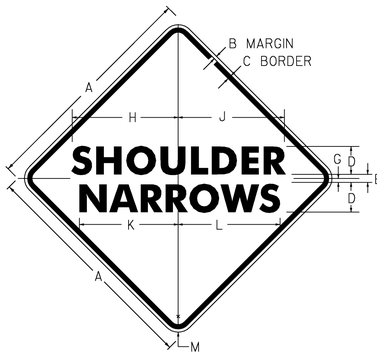
W1-1Me L(R)

DIMENSIONS NOT SHOWN FOR THIS DETAIL SHALL CONFORM TO THE LATEST EDITION OF THE 2003 MUTCD FOR SIGN DETAIL W1-1. UNLESS OTHERWISE NOTED FOR THIS DETAIL



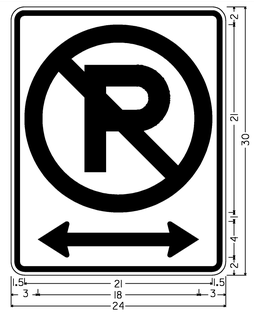
W1-2Mm L(R)

DIMENSIONS NOT SHOWN FOR THIS DETAIL SHALL CONFORM TO THE LATEST EDITION OF THE 2003 MUTCD FOR SIGN DETAIL W1-2. UNLESS OTHERWISE NOTED FOR THIS DETAIL



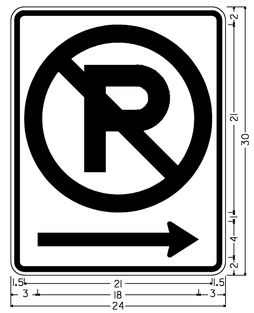
VW-619

COLORS: LEGEND - BLACK
BACKGROUND - YELLOW



VR-052

1.5" RADIUS, 0.625" BORDER, 0.375" INDENT
COLORS: TEXT & BORDER - BLACK
CIRCLE & DIAGONAL - RED
BACKGROUND - WHITE
REFER TO R8-3A



VR-052R (L)

1.5" RADIUS, 0.625" BORDER, 0.375" INDENT
COLORS: TEXT & BORDER - BLACK
CIRCLE & DIAGONAL - RED
BACKGROUND - WHITE
REFER TO R8-3A

SIGN	DIMENSIONS (INCHES)											
	A	B	C	D	E	F	G	H	J	K	L	M
MIN	30	1/2	3/4	4C	3	4C	I	11 5/16	11 5/16	10 5/16	10 5/16	1 7/8
STD.	36	5/8	7/8	5C	3	6D	I	13 13/16	13 1/16	17 5/8	18 1/4	2 1/4
EXPWY.	48	3/4	1 1/4	7D	3 1/2	7D	I	23 13/16	23 7/8	21 1/2	21 9/16	3

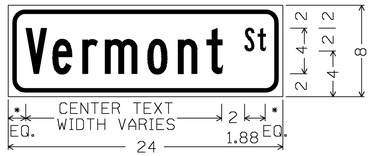
PROJECT NAME:	STAMFORD - ANDOVER
PROJECT NUMBER:	STPG SIGN (20)
FILE NAME: 09b022_TS.DGN	PLOT DATE: 06-AUG-2009
PROJECT LEADER: N. AVERY	DRAWN BY: N. AVERY
DESIGNED BY: N. AVERY	CHECKED BY: A. GAMBLE
GUIDE SIGN ASSEMBLY	SHEET 7 OF 198



1.5" RADIUS, 0.375" BORDER, 0.375" INDENT
COLORS: LEGEND - BLACK
BACKGROUND - YELLOW
TEXT STYLE: B

* LATERAL SPACING TO OUTSIDE OF PANEL SHALL BE A MINIMUM OF 1.5"

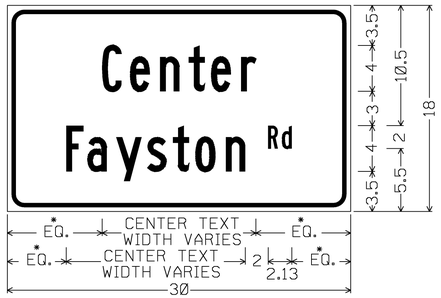
W16-8



1.5" RADIUS, 0.375" BORDER, 0.375" INDENT
COLORS: LEGEND - BLACK
BACKGROUND - YELLOW
TEXT STYLE: B

* LATERAL SPACING TO OUTSIDE OF PANEL SHALL BE A MINIMUM OF 1.5"

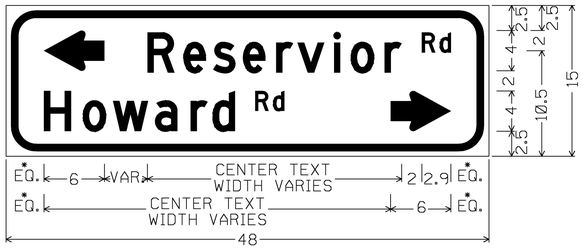
W16-8



1.5" RADIUS, 0.375" BORDER, 0.375" INDENT
COLORS: LEGEND - BLACK
BACKGROUND - YELLOW
TEXT STYLE: B

* LATERAL SPACING TO OUTSIDE OF PANEL SHALL BE A MINIMUM OF 1.5"

W16-8



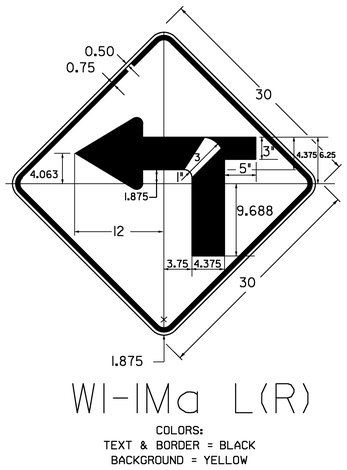
3" RADIUS, 0.75" BORDER, 0.50" INDENT
COLORS: LEGEND - BLACK
BACKGROUND - YELLOW
TEXT STYLE: D; STANDARD ARROW CUSTOM 6" WIDE X 4" HIGH

* LATERAL SPACING TO OUTSIDE OF PANEL SHALL BE A MINIMUM OF 3"

W16-8a

ADVANCE WARNING SIGN PLAQUE NOTES:

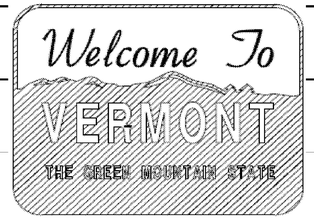
1. ALL ADVANCE STREET NAME PLAQUE SIGNS (W16-8 AND W16-8a) USED TO IDENTIFY THE NAME OF THE INTERSECTING STREETS SHALL HAVE INITIAL UPPER CASE LETTERS AND USED IN CONJUNCTION WITH LOWERCASE LETTERS (I.E. Main St, Foster Rd, East Ave, West Ln).



W1-1Ma L(R)

COLORS:
TEXT & BORDER = BLACK
BACKGROUND = YELLOW

PROJECT NAME: STAMFORD - ANDOVER	
PROJECT NUMBER: STPG SIGN (20)	
FILE NAME: 09b022_TS.DGN	PLOT DATE: 18-AUG-2009
PROJECT LEADER: N. AVERY	DRAWN BY: N. AVERY
DESIGNED BY: N. AVERY	CHECKED BY: A. GAMBLE
WARNING STREET NAME PLAQUES DETAIL	SHEET 8 OF 198

DIRECTION	MILEPOINT	LOCATION CODE (SHEET 2)	SIGN CODE	WIDTH (IN)	HEIGHT (IN)	SHEETING REMARKS	SIGN LEGEND	NEW SIGNS "A"	NEW SIGNS "B"	EXISTING SIGNS RETAIN	EXISTING SIGNS SALVAGE FROM	EXISTING SIGNS SALVAGE TO	EXISTING SIGNS REMOVE	EXIST POST RETAIN	EXIST POST REMOVE	NUMBER OF NEW POSTS	SQUARE STEEL (IN) (LB / FT) 1.75 / 1.88	SQUARE STEEL (IN) (LB / FT) 2.00 / 2.42	SQUARE STEEL (IN) (LB / FT) 2.50 / 3.35	TUBULAR STEEL Ø (IN) FOUNDATION	TUBULAR STEEL Ø (IN) (LB / FT) 3.00 / 7.60	TUBULAR STEEL Ø (IN) (LB / FT) 3.50 / 9.00	TUBULAR STEEL Ø (IN) (LB / FT) 4.00 / 10.80	TUBULAR STEEL Ø (IN) (LB / FT) 5.00 / 14.60	SIGN FRAME REQUIRED	REMARKS	SIGN DETAIL: DETAIL IN SHS	SIGN DETAIL: DETAIL ON SHEET NUMBER	SIGN DETAIL: DETAIL ON STD SHEET NUMBER
STAMFORD VT 100							FY-FLUORESCENT YELLOW FYG-FLUORESCENT YELLOW GREEN													ALL MILE MARKERS SHOWN WERE SALVAGED ONTO THE NEW POSTS.					"SHS"-STANDARD HIGHWAY SIGNS			
																				ALL STREET SIGNS SHOWN WERE SALVAGED ONTO THE NEW POSTS								
NB	0.016	A	VD-421A	60	48								1		X													
		A	VD-421A	30	24			5.00								1		X									5	
NB	0.043	A	R2-1	24	30								1		X													
		A	R2-1	24	30			5.00								1		X									X	
NB	0.043	A	M3-1S	24	12		NORTH						1		X													
		A	M1-5	30	24		VERMONT 100						1															
		A	M1-5A	24	24		VERMONT 8						1															
NB	0.081	A	M3-1	24	12			2.00								2		X						#1A	INSTALL ASSEMBLY 200 FEET NORTH OF EXISTING ASSEMBLY. GREEN ON WHITE SHEETING	X	7	
		A	M1-5	30	24			5.00																				E-136B
		A	M3-1	24	12			2.00																	GREEN ON WHITE SHEETING	X		
		A	M1-5	24	24			4.00																				E-136B
NB	0.125	A	VR-128	36	36								1		X													
		A	VR-601	30	36			7.50 ~~7.00~~								1		X									6	
NB	0.150	A	VR-654	24	24								1		X													
							SHEET TOTALS	~~30.50~~ ~~30.00~~ SF	0.00 SF	0 EA	0 EA	0 EA	7 EA	0 EA	0 EA	5 EA	75 FT											
							TOWN TOTALS	455.0	0.0	16.0	5.0	5.0	75	0.0	0.0	83	1245.0											

SIGN SUMMARY SHEET

VERMONT AGENCY OF TRANSPORTATION

PROJECT NAME: **Stamford-Andover VT100**
PROJECT NUMBER: **STPG SIGN(20)**

FILE NAME: **Stamford.xls**
PROJECT MANAGER: **N. Avery**
DESIGNED BY: **J. Kelly**
STAMFORD SHEET 1

PLOT DATE: **8/5/2009**
DRAWN BY: **T. Guazzoni**
CHECKED BY: **T. Guazzoni**
SHEET **9** OF **198**

DIRECTION	MILEPOINT	LOCATION CODE (SHEET 2)	SIGN CODE	WIDTH (IN)	HEIGHT (IN)	SHEETING REMARKS	SIGN LEGEND	NEW SIGNS "A"	NEW SIGNS "B"	EXISTING SIGNS RETAIN	EXISTING SIGNS SALVAGE FROM	EXISTING SIGNS SALVAGE TO	EXISTING SIGNS REMOVE	EXIST POST RETAIN	EXIST POST REMOVE	NUMBER OF NEW POSTS	SQUARE STEEL (IN) 1.75 (LB / FT) 1.88	SQUARE STEEL (IN) 2.00 (LB / FT) 2.42	SQUARE STEEL (IN) 2.50 (LB / FT) 3.35	FOUNDATION	TUBULAR STEEL Ø (IN) 3.00 (LB / FT) 7.60	TUBULAR STEEL Ø (IN) 3.50 (LB / FT) 9.00	TUBULAR STEEL Ø (IN) 4.00 (LB / FT) 10.80	TUBULAR STEEL Ø (IN) 5.00 (LB / FT) 14.60	SIGN FRAME REQUIRED	REMARKS	SIGN DETAIL: DETAIL IN SHS	SIGN DETAIL: DETAIL ON SHEET NUMBER	SIGN DETAIL: DETAIL ON STD SHEET NUMBER
STAMFORD VT 100							FY-FLUORESCENT YELLOW FYG-FLUORESCENT YELLOW GREEN																				"SHS"-STANDARD HIGHWAY SIGNS			
NB	0.150	A	VR-655	24	18		STRICTLY ENFORCED 						1																
		A	VR-654	24	24			4.00								1		X											E-143
NB	0.191	A	VR-048	24	30								1		X													
		A	VR-048	24	30			5.00								1		X											E-144
NB	0.220	A	R2-1	24	30								1		X														
		A	R2-1	24	30			5.00								1		X										X	
NB	0.260	A	W11-7	30	30		EQUESTRIAN SYMBOL						~~1~~		X												STUB ONLY REMOVED			
NB	0.260	A	W7-3A	30	30		NEXT 2 MILES						~~1~~																
NB	0.310	A	VD-018	30	18								1		X														
		A	VD-018	30	18			3.75								1		X											E-128A
NB	0.360	A	W1-4R	30	30		RIGHT REVERSE CURVE						1		X														
NB	0.360 ~~0.379~~	A	W1-4R	30	30			6.25								1		X		THIS SIGN WAS KEPT AT THE SAME LOCATION AT REQUEST OF AOT-DIST. #1						INSTALL ~~100~~ 0 FEET NORTH OF EXISTING			
NB	0.421	A	R2-1	24	30								1		X														
		A	R2-1	30	36			7.50								1		X										6	
NB	0.460	A	VD-062B	72	16		BUSINESS SIGN			1				X															
SIGN SUMMARY SHEET							SHEET TOTALS	31.50 SF	0.00 SF	1 EA	0 EA	0 EA	~~8~~ 6 EA	0 EA	0 EA	6 EA		90 FT										
VERMONT AGENCY OF TRANSPORTATION							TOWN TOTALS	455.0	0.0	16.0	5.0	5.0	75	0.0	0.0	83		1245.0										

PROJECT NAME: **Stamford-Andover VT100**
PROJECT NUMBER: **STPG SIGN(20)**
FILE NAME: **Stamford.xls**
PROJECT MANAGER: **N. Avery**
DESIGNED BY: **J. Kelly**
STAMFORD SHEET 2
PLOT DATE: **8/5/2009**
DRAWN BY: **T. Guazzoni**
CHECKED BY: **T. Guazzoni**
SHEET **10** OF **198**

DIRECTION	MILEPOINT	LOCATION CODE (SHEET 2)	SIGN CODE	WIDTH (IN)	HEIGHT (IN)	SHEETING REMARKS	SIGN LEGEND	NEW SIGNS "A"	NEW SIGNS "B"	EXISTING SIGNS RETAIN	EXISTING SIGNS SALVAGE FROM	EXISTING SIGNS SALVAGE TO	EXISTING SIGNS REMOVE	EXIST POST RETAIN	EXIST POST REMOVE	NUMBER OF NEW POSTS	SQUARE STEEL (IN) 1.75 (LB / FT) 1.88	SQUARE STEEL (IN) 2.00 (LB / FT) 2.42	SQUARE STEEL (IN) 2.50 (LB / FT) 3.35	TUBULAR STEEL Ø (IN) FOUNDATION	TUBULAR STEEL Ø (IN) 3.00 (LB / FT) 7.60	TUBULAR STEEL Ø (IN) 3.50 (LB / FT) 9.00	TUBULAR STEEL Ø (IN) 4.00 (LB / FT) 10.80	TUBULAR STEEL Ø (IN) 5.00 (LB / FT) 14.60	SIGN FRAME REQUIRED	REMARKS	SIGN DETAIL: DETAIL IN SHS	SIGN DETAIL: DETAIL ON SHEET NUMBER	SIGN DETAIL: DETAIL ON STD SHEET NUMBER
STAMFORD VT 100							FY-FLUORESCENT YELLOW FYG-FLUORESCENT YELLOW GREEN																			"SHS"-STANDARD HIGHWAY SIGNS			
NB	0.842	A	S1-1YG	30	30		SCHOOL PENTAGON			1				X															
		A	W16-9YG	24	12		AHEAD			1																			
NB	0.880	A	S4-3YG	24	8		SCHOOL			1				X															
		A	R2-1	24	30		SPEED LIMIT 30			1																			
		A	S4-4	24	10		WHEN FLASHING 			1																			
NB	~~0.900~~ 0.924	A	W11-8	30	30			6.25								1		X		THIS SIGN LOCATION WAS CHANGED AT THE REQUEST OF AOT-DIST. #1						INSTALL ~~325~~ 200 FEET SOUTH OF SOUTHERN SCHOOL CROSSWALK	X		
NB	0.963	A	S1-1YG	30	30		SCHOOL PENTAGON			1				X															
		A	W16-7YG	24	12		DOWN LH ARROW			1																			
NB	1.005	A	S1-1YG	30	30		SCHOOL PENTAGON			1				X															
		A	W16-7YG	24	12		DOWN LH ARROW 			1																			
NB	1.117	A	S5-2	24	30			5.00								1		X								INSTALL ACROSS FROM SCHOOL SPEED LIMIT 30 WHEN FLASHING	X		
NB	1.170	A	R2-1	24	30								1		X														
		A	R2-1	24	30			5.00								1		X									X		
NB	1.500	A	W1-2R	30	30		RIGHT CURVE						1		X														
NB	1.520	A	W1-2R	30	30			6.25								1		X								INSTALL 100 FEET NORTH OF EXISTING RIGHT CURVE SIGN	X		
							SHEET TOTALS	22.50 SF	0.00 SF	9 EA	0 EA	0 EA	2 EA	0 EA	0 EA	4 EA		60 FT							
							TOWN TOTALS	455.0	0.0	16.0	5.0	5.0	75	0.0	0.0	83		1245.0							

SIGN SUMMARY SHEET

VERMONT AGENCY OF TRANSPORTATION

PROJECT NAME: **Stamford-Andover VT100**
PROJECT NUMBER: **STPG SIGN(20)**

FILE NAME: **Stamford.xls** PLOT DATE: **8/5/2009**
PROJECT MANAGER: **N. Avery** DRAWN BY: **T. Guazzoni**
DESIGNED BY: **J. Kelly** CHECKED BY: **T. Guazzoni**
STAMFORD SHEET 4 SHEET **12** OF **198**

DIRECTION	MILEPOINT	LOCATION CODE (SHEET 2)	SIGN CODE	WIDTH (IN)	HEIGHT (IN)	SHEETING REMARKS	SIGN LEGEND	NEW SIGNS "A"	NEW SIGNS "B"	EXISTING SIGNS RETAIN	EXISTING SIGNS SALVAGE FROM	EXISTING SIGNS SALVAGE TO	EXISTING SIGNS REMOVE	EXIST POST RETAIN	EXIST POST REMOVE	NUMBER OF NEW POSTS	SQUARE STEEL (IN) 1.75 (LB / FT) 1.88	SQUARE STEEL (IN) 2.00 (LB / FT) 2.42	SQUARE STEEL (IN) 2.50 (LB / FT) 3.35	TUBULAR STEEL Ø (IN) FOUNDATION	TUBULAR STEEL Ø (IN) 3.00 (LB / FT) 7.60	TUBULAR STEEL Ø (IN) 3.50 (LB / FT) 9.00	TUBULAR STEEL Ø (IN) 4.00 (LB / FT) 10.80	TUBULAR STEEL Ø (IN) 5.00 (LB / FT) 14.60	SIGN FRAME REQUIRED	REMARKS	SIGN DETAIL: DETAIL IN SHS	SIGN DETAIL: DETAIL ON SHEET NUMBER	SIGN DETAIL: DETAIL ON STD SHEET NUMBER
STAMFORD VT 100							FY-FLUORESCENT YELLOW FYG-FLUORESCENT YELLOW GREEN																			"SHS"-STANDARD HIGHWAY SIGNS			
		A	W13-1	18	18			2.25																			X		
NB	1.560	C	VR-017	24	24		LEGAL LOAD LIMIT 24,000 POUNDS; SPEED LIMIT 25				I		2 ~~1~~		X					SPEED LIMIT 25 SIGN SALVAGED ONTO THE NEW POST								
		C	VR-017	24	30			5.00				I				1		X								TH-22, CLAYTON AVE			E-141
NB	1.565	D	R1-1	24	24		STOP; 1000 0214 0156						1		X														
		D	R1-1	30	30			6.25								1		X								TH-22, CLAYTON AVE	X		
NB	1.565	A	R2-1	24	30		SPEED LIMIT 45						1		X														
NB	1.678	A	R2-1	24	30			5.00								1		X								INSTALL 600 FEET NORTH OF EXISTING SPEED LIMIT 45 SIGN	X		
NB	1.824	C	VR-017	24	24		LEGAL LOAD LIMIT 24,000 POUNDS; CLOUGH RD				I	I	1		X					STREET SIGN SALVAGED ONTO THE NEW POST								
		C	VR-017	24	30			5.00								1		X								TH-1, CLOUGH RD			E-141
NB	1.832	D	R1-1	24	24		STOP; 1000 0214 0183						1		X														
		D	R1-1	30	30		SPEED LIMIT 50; UNLESS OTHERWISE POSTED	6.25								1		X								TH-1, CLOUGH RD	X		
NB	1.870	A	R2-1	24	30			5.00								1		X								INSTALL ACROSS FROM SB SPEED LIMIT 45	X		
		A	VR-208	24	24			4.00																				6	
NB	2.185	C	VR-017	24	30		LEGAL LOAD LIMIT 24,000 POUNDS	5.00								1		X								TH-25, CLOUGH RD			E-141
NB	2.200	D	R1-1	30	30								1		X														
							SHEET TOTALS	43.75	0.00	0	2 ~~0~~	2 ~~0~~	7 ~~6~~	0	0	7		105											
								SF	SF	EA	EA	EA	EA	EA	EA	EA		FT											
							TOWN TOTALS	455.0	0.0	16.0	5.0	5.0	75	0.0	0.0	83		1245.0											

SIGN SUMMARY SHEET

VERMONT AGENCY OF TRANSPORTATION

PROJECT NAME: **Stamford-Andover VT100**
PROJECT NUMBER: **STPG SIGN(20)**

FILE NAME: **Stamford.xls**
PROJECT MANAGER: **N. Avery**
DESIGNED BY: **J. Kelly**
STAMFORD SHEET 5

PLOT DATE: **8/5/2009**
DRAWN BY: **T. Guazzoni**
CHECKED BY: **T. Guazzoni**
SHEET **13** OF **198**

DIRECTION	MILEPOINT	LOCATION CODE (SHEET 2)	SIGN CODE	WIDTH (IN)	HEIGHT (IN)	SHEETING REMARKS	SIGN LEGEND	NEW SIGNS "A"	NEW SIGNS "B"	EXISTING SIGNS RETAIN	EXISTING SIGNS SALVAGE FROM	EXISTING SIGNS SALVAGE TO	EXISTING SIGNS REMOVE	EXIST POST RETAIN	EXIST POST REMOVE	NUMBER OF NEW POSTS	SQUARE STEEL (IN) 1.75 / 2.00 / 2.50 (LB / FT) 1.88	2.42	3.35	FOUNDATION	TUBULAR STEEL Ø (IN) 3.00 / 3.50 / 4.00 / 5.00 (LB / FT) 7.60	9.00	10.80	14.60	SIGN FRAME REQUIRED	REMARKS	SIGN DETAIL: DETAIL IN SHS	DETAIL ON SHEET NUMBER	DETAIL ON STD SHEET NUMBER
STAMFORD VT 100							FY-FLUORESCENT YELLOW FYG-FLUORESCENT YELLOW GREEN																			"SHS"-STANDARD HIGHWAY SIGNS			
NB	2.200	D	R1-1	30	30		1000 0214 0223 STOP	6.25								1		X								TH-25, CLOUGH RD	X		
NB	2.385	A	VW-054L	30	30		HIDDEN DRIVE LEFT	6.25								1		X								INSTALL ACROSS FROM DRIVE #2395			E-154
NB	2.550	A	R2-1	24	30		SPEED LIMIT 50						1		X														
		A	R2-1	24	30			5.00								1		X									X		
NB	3.085	C	VR-017	24	30		LEGAL LOAD LIMIT 24,000 POUNDS						1		X														
		C	VR-017	24	30			5.00								1		X								TH-26, ROBILLARD RD SOUTH			E-141
NB	3.090	D	R1-1	30	30		STOP						1		X														
		D	R1-1	30	30			6.25								1		X								TH-26, ROBILLARD RD SOUTH	X		
NB	3.382	C	VR-017	24	30		LEGAL LOAD LIMIT 24,000 POUNDS	5.00								1		X								TH-26, ROBILLARD RD NORTH			E-141
NB	3.390	D	R1-1	30	30		STOP						1		X														
		D	R1-1	30	30		1000 0214 0339	6.25								1		X								TH-26, ROBILLARD RD NORTH	X		
NB	3.739	C	VR-017	24	30		LEGAL LOAD LIMIT 24,000 POUNDS	5.00								1		X								TH-27, BROOKSIDE DR			E-141
NB	3.747	D	R1-1	30	30		STOP						1		X														
		D	R1-1	30	30		1000 0214 0374	6.25								1		X								TH-27, BROOKSIDE DR	X		
NB	4.921	C	VR-017	24	30								1		X														
							SHEET TOTALS	51.25	0.00	0	0	0	6	0	0	9		135											
								SF	SF	EA	EA	EA	EA	EA	EA	EA		FT											
							TOWN TOTALS	455.0	0.0	16.0	5.0	5.0	75	0.0	0.0	83		1245.0											

SIGN SUMMARY SHEET

VERMONT AGENCY OF TRANSPORTATION

PROJECT NAME: **Stamford-Andover VT100**
PROJECT NUMBER: **STPG SIGN(20)**

FILE NAME: **Stamford.xls**
PROJECT MANAGER: **N. Averv**
DESIGNED BY: **J. Kelly**
STAMFORD SHEET 6

PLOT DATE: **8/5/2009**
DRAWN BY: **T. Guazzoni**
CHECKED BY: **T. Guazzoni**
SHEET **14** OF **198**

DIRECTION	MILEPOINT	LOCATION CODE (SHEET 2)	SIGN CODE	WIDTH (IN)	HEIGHT (IN)	SHEETING REMARKS	SIGN LEGEND	NEW SIGNS "A"	NEW SIGNS "B"	EXISTING SIGNS RETAIN	EXISTING SIGNS SALVAGE FROM	EXISTING SIGNS SALVAGE TO	EXISTING SIGNS REMOVE	EXIST POST RETAIN	EXIST POST REMOVE	NUMBER OF NEW POSTS	SQUARE STEEL (IN) 1.75 (LB/FT) 1.88	SQUARE STEEL (IN) 2.00 (LB/FT) 2.42	SQUARE STEEL (IN) 2.50 (LB/FT) 3.35	FOUNDATION	TUBULAR STEEL Ø (IN) 3.00 (LB/FT) 7.60	TUBULAR STEEL Ø (IN) 3.50 (LB/FT) 9.00	TUBULAR STEEL Ø (IN) 4.00 (LB/FT) 10.80	TUBULAR STEEL Ø (IN) 5.00 (LB/FT) 14.60	SIGN FRAME REQUIRED	REMARKS	SIGN DETAIL: DETAIL IN SHS	SIGN DETAIL: DETAIL ON SHEET NUMBER	SIGN DETAIL: DETAIL ON STD SHEET NUMBER
STAMFORD VT 100							FY-FLUORESCENT YELLOW FYG-FLUORESCENT YELLOW GREEN																				"SHS"-STANDARD HIGHWAY SIGNS			
NB	4.921	C	VR-017	24	30		LEGAL LOAD LIMIT 24,000 POUNDS	5.00								1		X								TH-28, BUSHIKA RD SOUTH REINSTALL TOWN'S SPEED LIMIT 25 SIGN BELOW NEW LEGAL LOAD SIGN			E-141
		C	R2-1	24	30		SPEED LIMIT 25 (TOWN)				1	1																
NB	4.930	D	R1-1	30	30		STOP	6.25								1		X								TH-28, BUSHIKA RD SOUTH	X		
NB	5.098	C	VR-017	24	30		LEGAL LOAD LIMIT 24,000 POUNDS						1		X														
		C	VR-017	24	30			5.00								1		X								TH-28, BUSHIKA RD NORTH			E-141
NB	5.106	D	R1-1	30	30		STOP						1		X														
		D	R1-1	30	30			6.25								1		X								TH-28, BUSHIKA RD NORTH	X		
SB	5.289	G	VR-017	24	24		LEGAL LOAD LIMIT 24,000 POUNDS						1		X														
		G	VR-017	24	30			5.00								1		X								TH-3, SPORTSMEN RD			E-141
SB	5.281	H	R1-1	30	30		0140 1416 0529 STOP						1		X														
		H	R1-1	30	30			6.25								1		X								TH-3, SPORTSMEN RD	X		
SB	4.407	G	VR-017	24	30		LEGAL LOAD LIMIT 24,000 POUNDS	5.00					1			1		X								TH-4, COLLINS RD			E-141
SB	4.415	H	R1-1	30	30		0140 1416 0441 STOP						1		X														
		H	R1-1	30	30		HIDDEN DRIVE LEFT	6.25								1		X								TH-4, COLLINS RD	X		
SB	4.051	F	VW-054L	30	30			6.25								1		X								INSTALL AT BEGINNING OF SB PASSING ZONE (MARK ON PAVEMENT)			E-154
							SHEET TOTALS	51.25 SF	0.00 SF	0 EA	1 EA	1 EA	~~6~~ 5 EA	0 EA	0 EA	9 EA		135 FT								
							TOWN TOTALS	455.0	0.0	16.0	5.0	5.0	75	0.0	0.0	83		1245.0											

SIGN SUMMARY SHEET

VERMONT AGENCY OF TRANSPORTATION

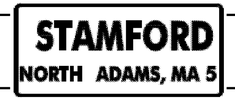
PROJECT NAME: **Stamford-Andover VT100**
PROJECT NUMBER: **STPG SIGN(20)**

FILE NAME: **Stamford.xls**
PROJECT MANAGER: **N. Avery**
DESIGNED BY: **J. Kelly**
STAMFORD SHEET 7

PLOT DATE: **8/5/2009**
DRAWN BY: **T. Guazzoni**
CHECKED BY: **T. Guazzoni**
SHEET **15** OF **198**

DIRECTION	MILEPOINT	LOCATION CODE (SHEET 2)	SIGN CODE	WIDTH (IN)	HEIGHT (IN)	SHEETING REMARKS	SIGN LEGEND	NEW SIGNS "A"	NEW SIGNS "B"	EXISTING SIGNS RETAIN	EXISTING SIGNS SALVAGE FROM	EXISTING SIGNS SALVAGE TO	EXISTING SIGNS REMOVE	EXIST POST RETAIN	EXIST POST REMOVE	NUMBER OF NEW POSTS	SQUARE STEEL (IN) 1.75 (LB / FT) 1.88	SQUARE STEEL (IN) 2.00 (LB / FT) 2.42	SQUARE STEEL (IN) 2.50 (LB / FT) 3.35	FOUNDATION	TUBULAR STEEL Ø (IN) 3.00 (LB / FT) 7.60	TUBULAR STEEL Ø (IN) 3.50 (LB / FT) 9.00	TUBULAR STEEL Ø (IN) 4.00 (LB / FT) 10.80	TUBULAR STEEL Ø (IN) 5.00 (LB / FT) 14.60	SIGN FRAME REQUIRED	REMARKS	SIGN DETAIL: DETAIL IN SHS	SIGN DETAIL: DETAIL ON SHEET NUMBER	SIGN DETAIL: DETAIL ON STD SHEET NUMBER
STAMFORD VT 100							FY-FLUORESCENT YELLOW FYG-FLUORESCENT YELLOW GREEN																			"SHS"-STANDARD HIGHWAY SIGNS			
SB	2.840	F	R2-1	24	30								1		X														
		F	R2-1	24	30			5.00								1		X									X		
SB	2.713	G	VR-017	24	30								1		X														
		G	VR-017	24	30			5.00								1		X								TH-29, LINCOLN RD			E-141
SB	2.705	H	R1-1	30	30		 1000 0214 0271						1		X														
		H	R1-1	30	30			6.25								1		X								TH-29, LINCOLN RD	X		
SB	2.590	H	R1-1	24	24		STOP						1		X											TH-7, LINCOLN RD			
SB	2.490	F	VW-054R	30	30								1		X														
		F	S3-1	30	30								1																
		F	VW-054R	30	30			6.25								2		X										E-154
		F	S3-1	30	30			6.25																			X		
SB	1.980	F	R2-5A	24	30		REDUCED SPEED AHEAD						1		X														
SB	1.870	F	R2-1	24	30								1		X														
		F	R2-1	30	36			7.50								1		X										6	
SB	1.827	F	W11-2	30	30		PEDESTRIAN						1		X														
SIGN SUMMARY SHEET							SHEET TOTALS	36.25	0.00	0	0	0	9	0	0	6		90										
								SF	SF	EA	EA	EA	EA	EA	EA	EA		FT										
VERMONT AGENCY OF TRANSPORTATION							TOWN TOTALS	455.0	0.0	16.0	5.0	5.0	75	0.0	0.0	83		1245.0										

PROJECT NAME: **Stamford-Andover VT100**
PROJECT NUMBER: **STPG SIGN(20)**
FILE NAME: **Stamford.xls**
PROJECT MANAGER: **N. Avery**
DESIGNED BY: **J. Kelly**
PLOT DATE: **8/5/2009**
DRAWN BY: **T. Guazzoni**
CHECKED BY: **T. Guazzoni**
STAMFORD SHEET 8
SHEET **16** OF **198**

DIRECTION	MILEPOINT	LOCATION CODE (SHEET 2)	SIGN CODE	WIDTH (IN)	HEIGHT (IN)	SHEETING REMARKS	SIGN LEGEND	NEW SIGNS "A"	NEW SIGNS "B"	EXISTING SIGNS RETAIN	EXISTING SIGNS SALVAGE FROM	EXISTING SIGNS SALVAGE TO	EXISTING SIGNS REMOVE	EXIST POST RETAIN	EXIST POST REMOVE	NUMBER OF NEW POSTS	SQUARE STEEL (IN) 1.75 (LB / FT) 1.88	SQUARE STEEL (IN) 2.00 (LB / FT) 2.42	SQUARE STEEL (IN) 2.50 (LB / FT) 3.35	FOUNDATION	TUBULAR STEEL Ø (IN) 3.00 (LB / FT) 7.60	TUBULAR STEEL Ø (IN) 3.50 (LB / FT) 9.00	TUBULAR STEEL Ø (IN) 4.00 (LB / FT) 10.80	TUBULAR STEEL Ø (IN) 5.00 (LB / FT) 14.60	SIGN FRAME REQUIRED	REMARKS	SIGN DETAIL: DETAIL IN SHS	SIGN DETAIL: DETAIL ON SHEET NUMBER	SIGN DETAIL: DETAIL ON STD SHEET NUMBER
STAMFORD VT 100							FY-FLUORESCENT YELLOW FYG-FLUORESCENT YELLOW GREEN																			"SHS"-STANDARD HIGHWAY SIGNS			
		F	W11-7	30	30		EQUESTRIAN						1															
		F	W7-3A	24	30		NEXT 2 MILES						1															
SB	1.776	G	VR-017	24	30								1		X													
		G	VR-017	24	30			5.00								1		X								TH-11, OLD COUNTY RD			E-141
SB	1.768	H	R1-1	30	30			6.25								1		X								TH-11, OLD COUNTY RD	X		
SB	1.756	F	N/A	30	30		EMPTY POST								X													
SB	1.708	F	W1-2L	30	30			6.25								1		X								INSTALL 250 FEET SOUTH OF EXISTING EMPTY POST LOCATION AND SOUTH OF MAILBOXES	X		
		F	W13-1	18	18			2.25																			X		
SB	1.505	F	R2-1	24	30								1		X													
		F	R2-1	24	30			5.00								1		X									X		
SB	1.270	F	R2-5A	24	30		REDUCED SPEED AHEAD 						1		X													
		F	W3-5	36	36			9.00								2		X									X		
	1.214	F	VD-018	30	18			3.75								1		X								INSTALL ON NORTH SIDE OF UTILITY POLE WITH TWO GUY WIRES			E-128A
SB	1.170	F	R2-1	24	30								1		X													
		F	R2-1	30	36			7.50								1		X										6	
							SHEET TOTALS	45.00 SF	0.00 SF	0 EA	0 EA	0 EA	6 7 EA	0 EA	0 EA	8 EA		120 FT										
							TOWN TOTALS	455.0	0.0	16.0	5.0	5.0	75	0.0	0.0	83		1245.0										

SIGN SUMMARY SHEET

VERMONT AGENCY OF TRANSPORTATION

PROJECT NAME: **Stamford-Andover VT100**
PROJECT NUMBER: **STPG SIGN(20)**

FILE NAME: **Stamford.xls**
PROJECT MANAGER: **N. Avery**
DESIGNED BY: **J. Kelly**
STAMFORD SHEET 9

PLOT DATE: **8/5/2009**
DRAWN BY: **T. Guazzoni**
CHECKED BY: **T. Guazzoni**
SHEET **17** OF **198**

DIRECTION	MILEPOINT	LOCATION CODE (SHEET 2)	SIGN CODE	WIDTH (IN)	HEIGHT (IN)	SHEETING REMARKS	SIGN LEGEND	NEW SIGNS "A"	NEW SIGNS "B"	EXISTING SIGNS RETAIN	EXISTING SIGNS SALVAGE FROM	EXISTING SIGNS SALVAGE TO	EXISTING SIGNS REMOVE	EXIST POST RETAIN	EXIST POST REMOVE	NUMBER OF NEW POSTS	SQUARE STEEL (IN) 1.75 (LB / FT) 1.88	SQUARE STEEL (IN) 2.00 (LB / FT) 2.42	SQUARE STEEL (IN) 2.50 (LB / FT) 3.35	FOUNDATION	TUBULAR STEEL Ø (IN) 3.00 (LB / FT) 7.60	TUBULAR STEEL Ø (IN) 3.50 (LB / FT) 9.00	TUBULAR STEEL Ø (IN) 4.00 (LB / FT) 10.80	TUBULAR STEEL Ø (IN) 5.00 (LB / FT) 14.60	SIGN FRAME REQUIRED	REMARKS	SIGN DETAIL: DETAIL IN SHS	SIGN DETAIL: DETAIL ON SHEET NUMBER	SIGN DETAIL: DETAIL ON STD SHEET NUMBER
STAMFORD VT 100							FY-FLUORESCENT YELLOW FYG-FLUORESCENT YELLOW GREEN																				"SHS"-STANDARD HIGHWAY SIGNS			
SB	1.155	F	S1-1YG	30	30		SCHOOL PENTAGON			1				X															
SB	1.155	F	W16-9YG	24	12		AHEAD			1																			
SB	1.117	F	S4-3YG	24	8		SCHOOL			~~1~~	~~1~~	~~1~~			~~X~~	~~1~~		~~X~~								RETAIN SIGNS AND FLASHING BEACON. REPLACE POST NO WORK WAS DONE AT THIS LOCATION DUE TO CONDUIT ON THE POST.			
SB	1.117	F	R2-1	24	30		SPEED LIMIT 30			~~1~~	~~1~~	~~1~~																	
SB	1.117	F	S4-4	24	10		WHEN FLASHING			~~1~~	~~1~~	~~1~~																	
SB	1.079	F	W11-8	30	30								1		X														
		F	W11-8	30	30			6.25								1		X								MAINTAIN 10' MIN FROM UTILITY POLE	X		
SB	1.077	G	VR-017	24	30		LEGAL LOAD LIMIT 24,000 POUNDS						1		X														
		G	VR-017	24	30			5.00								1		X								TH-12, MILL RD			E-141
SB	1.069	H	R1-1	30	30		 1000 0214 0107						1		X														
		H	R1-1	30	30			6.25								1		X								TH-12, MILL RD	X		
SB	1.020	G	VR-017	24	30		LEGAL LOAD LIMIT 24,000 POUNDS						1		X														
		G	VR-017	24	30			5.00								1		X								TH-20, STEBBINS RD			E-141
SB	1.016	H	R1-1	30	30								1		X														
		H	R1-1	30	30			6.25								1		X								TH-20, STEBBINS RD	X		
SIGN SUMMARY SHEET							SHEET TOTALS	28.75	0.00	~~5~~ 2	~~0~~ 3	~~0~~ 3	5	0	0	~~5~~ 6		90										
VERMONT AGENCY OF TRANSPORTATION								SF	SF	EA	EA	EA	EA	EA	EA	EA		FT										
							TOWN TOTALS	455.0	0.0	16.0	5.0	5.0	75	0.0	0.0	83		1245.0										

PROJECT NAME: **Stamford-Andover VT100**
PROJECT NUMBER: **STPG SIGN(20)**

FILE NAME: **Stamford.xls**
PROJECT MANAGER: **N. Avery**
DESIGNED BY: **J. Kelly**
STAMFORD SHEET 10

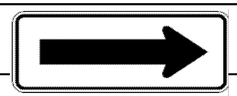
PLOT DATE: **8/5/2009**
DRAWN BY: **T. Guazzoni**
CHECKED BY: **T. Guazzoni**
SHEET **18** OF **198**

DIRECTION	MILEPOINT	LOCATION CODE (SHEET 2)	SIGN CODE	WIDTH (IN)	HEIGHT (IN)	SHEETING REMARKS	SIGN LEGEND	NEW SIGNS "A"	NEW SIGNS "B"	EXISTING SIGNS RETAIN	EXISTING SIGNS SALVAGE FROM	EXISTING SIGNS SALVAGE TO	EXISTING SIGNS REMOVE	EXIST POST RETAIN	EXIST POST REMOVE	NUMBER OF NEW POSTS	SQUARE STEEL (IN) 1.75 (LB / FT) 1.88	SQUARE STEEL (IN) 2.00 (LB / FT) 2.42	SQUARE STEEL (IN) 2.50 (LB / FT) 3.35	FOUNDATION	TUBULAR STEEL Ø (IN) 3.00 (LB / FT) 7.60	TUBULAR STEEL Ø (IN) 3.50 (LB / FT) 9.00	TUBULAR STEEL Ø (IN) 4.00 (LB / FT) 10.80	TUBULAR STEEL Ø (IN) 5.00 (LB / FT) 14.60	SIGN FRAME REQUIRED	REMARKS	SIGN DETAIL: DETAIL IN SHS	SIGN DETAIL: DETAIL ON SHEET NUMBER	SIGN DETAIL: DETAIL ON STD SHEET NUMBER
STAMFORD VT 100							FY-FLUORESCENT YELLOW FYG-FLUORESCENT YELLOW GREEN																				"SHS"-STANDARD HIGHWAY SIGNS			
SB	1.007	F	S1-1YG	30	30		SCHOOL PENTAGON			1				X															
SB	1.007	F	W16-7YG	24	12		DOWN LH ARROW			1																			
SB	0.965	F	S1-1YG	30	30		SCHOOL PENTAGON			1				X															
SB	0.965	F	W16-7YG	24	12		DOWN LH ARROW			1																			
SB	0.880	F	S5-2	24	30		END SCHOOL ZONE	5.00								1		X								INSTALL ACROSS ROAD FROM SCHOOL SPEED LIMIT 30 WHEN FLASHING	X		
SB	0.819	G	VR-017	24	30		LEGAL LOAD LIMIT 24,000 POUNDS						1		X											TH-2, JEPSON RD			
		G	VR-017	24	30			5.00								1		X											E-141
SB	0.811	H	R1-1	30	30		STOP						1		X											TH-2, JEPSON RD			
		H	R1-1	30	30			6.25								1		X								INSTALL SIGN CLOSER TO VT-100	X		
SB	0.795	F	W1-4L	30	30		LEFT REVERSE CURVE						1		X														
SB	0.780	F	W1-4~~L~~ R	30	30			6.25								1		X								INSTALL 80 FEET SOUTH OF EXISTING LOCATION	X		
SB	0.560	F	R2-1	24	30		SPEED LIMIT 35						1		X														
		F	R2-1	24	30			5.00								1		X									X		
SB	0.465	F	W1-6	48	24			8.00								2		X								INSTALL BETWEEN DRIVEWAY AND EXISTING LARGE ARROW	X		
SB	0.460	E	W1-6	48	24								1		X														
							SHEET TOTALS	35.50 SF	0.00 SF	4 EA	0 EA	0 EA	5 EA	0 EA	0 EA	7 EA		105 FT											
							TOWN TOTALS	455.0	0.0	16.0	5.0	5.0	75	0.0	0.0	83		1245.0										

SIGN SUMMARY SHEET

VERMONT AGENCY OF TRANSPORTATION

PROJECT NAME: **Stamford-Andover VT100**
PROJECT NUMBER: **STPG SIGN(20)**
FILE NAME: **Stamford.xls**
PROJECT MANAGER: **N. Avery**
DESIGNED BY: **J. Kelly**
DRAWN BY: **T. Guazzoni**
CHECKED BY: **T. Guazzoni**
PLOT DATE: **8/5/2009**
STAMFORD SHEET 11
SHEET **19** OF **198**

DIRECTION	MILEPOINT	LOCATION CODE (SHEET 2)	SIGN CODE	WIDTH (IN)	HEIGHT (IN)	SHEETING REMARKS	SIGN LEGEND	NEW SIGNS "A"	NEW SIGNS "B"	EXISTING SIGNS RETAIN	EXISTING SIGNS SALVAGE FROM	EXISTING SIGNS SALVAGE TO	EXISTING SIGNS REMOVE	EXIST POST RETAIN	EXIST POST REMOVE	NUMBER OF NEW POSTS	SQUARE STEEL (IN) 1.75 (LB / FT) 1.88	SQUARE STEEL (IN) 2.00 (LB / FT) 2.42	SQUARE STEEL (IN) 2.50 (LB / FT) 3.35	FOUNDATION	TUBULAR STEEL Ø (IN) 3.00 (LB / FT) 7.60	TUBULAR STEEL Ø (IN) 3.50 (LB / FT) 9.00	TUBULAR STEEL Ø (IN) 4.00 (LB / FT) 10.80	TUBULAR STEEL Ø (IN) 5.00 (LB / FT) 14.60	SIGN FRAME REQUIRED	REMARKS	SIGN DETAIL: DETAIL IN SHS	SIGN DETAIL: DETAIL ON SHEET NUMBER	SIGN DETAIL: DETAIL ON STD SHEET NUMBER
STAMFORD VT 100							FY-FLUORESCENT YELLOW FYG-FLUORESCENT YELLOW GREEN																			"SHS"-STANDARD HIGHWAY SIGNS			
		E	W1-6	48	24			8.00								2		X									X		
SB	0.420	F	R2-1	24	30								1		X														
		F	R2-1	24	30			5.00								1		X									X		
SB	0.244	F	R2-1	24	30								1		X														
		F	R2-1	24	30			5.00								1		X									X		
SB	0.060	F	M4-6S	24	12								1		X														
		F	M1-5	30	24								1																
		F	M1-5	24	24								1																
		F	M4-6	24	12			2.00								2		X							#1A	GREEN ON WHITE SHEETING	X	7	
		F	M1-5	30	24			5.00																				E-136B
		F	M4-6	24	12			2.00																		GREEN ON WHITE SHEETING	X		
		F	M1-5	24	24			4.00																				E-136B
SB	0.000	F	VR-038	24	18								1		X														
		F	VR-040	24	24		THROUGH WAY ENDS HERE						1																
		E	VR-039	24	18								1																
							SHEET TOTALS	31.00 SF	0.00 SF	0 EA	0 EA	0 EA	8 EA	0 EA	0 EA	6 EA		90 FT											
							TOWN TOTALS	455.0	0.0	16.0	5.0	5.0	75	0.0	0.0	83		1245.0											

SIGN SUMMARY SHEET

VERMONT AGENCY OF TRANSPORTATION

PROJECT NAME: **Stamford-Andover VT100**
PROJECT NUMBER: **STPG SIGN(20)**
FILE NAME: **Stamford.xls**
PROJECT MANAGER: **N. Avery**
DESIGNED BY: **J. Kelly**
STAMFORD SHEET 12
PLOT DATE: **8/5/2009**
DRAWN BY: **T. Guazzoni**
CHECKED BY: **T. Guazzoni**
SHEET **20** OF **198**

DIRECTION	MILEPOINT	LOCATION CODE (SHEET 2)	SIGN CODE	WIDTH (IN)	HEIGHT (IN)	SHEETING REMARKS	SIGN LEGEND	NEW SIGNS		EXISTING SIGNS				EXIST POST		NUMBER OF NEW POSTS	SQUARE STEEL (IN)			TUBULAR STEEL Ø (IN)				SIGN FRAME REQUIRED	REMARKS	SIGN DETAIL		
								"A"	"B"	RETAIN	SALVAGE FROM	SALVAGE TO	REMOVE	RETAIN	REMOVE		1.75 (LB / FT) 1.88	2.00 (LB / FT) 2.42	2.50 (LB / FT) 3.35	FOUNDATION	3.00 (LB / FT) 7.60	3.50 (LB / FT) 9.00	4.00 (LB / FT) 10.80	5.00 (LB / FT) 14.60			DETAIL IN SHS	DETAIL ON SHEET NUMBER	DETAIL ON STD SHEET NUMBER
STAMFORD VT 100							FY-FLUORESCENT YELLOW FYG-FLUORESCENT YELLOW GREEN																		"SHS"-STANDARD HIGHWAY SIGNS			
		E	VR-041	24	24		THROUGH WAY BEGINS HERE						1															
		F	VR-038	24	18		STATE HIGHWAY ENDS	3.00								1		X										E-141
		E	VR-039	24	18		STATE HIGHWAY BEGINS	3.00																				E-141

DIRECTION	MILEPOINT	LOCATION CODE (SHEET 2)	SIGN CODE	WIDTH (IN)	HEIGHT (IN)	SHEETING REMARKS	SIGN LEGEND	NEW SIGNS "A"	NEW SIGNS "B"	EXISTING SIGNS RETAIN	EXISTING SIGNS SALVAGE FROM	EXISTING SIGNS SALVAGE TO	EXISTING SIGNS REMOVE	EXIST POST RETAIN	EXIST POST REMOVE	NUMBER OF NEW POSTS	SQUARE STEEL (IN) 1.75 (LB / FT) 1.88	SQUARE STEEL (IN) 2.00 (LB / FT) 2.42	SQUARE STEEL (IN) 2.50 (LB / FT) 3.35	TUBULAR STEEL Ø (IN) FOUNDATION	TUBULAR STEEL Ø (IN) 3.00 (LB / FT) 7.60	TUBULAR STEEL Ø (IN) 3.50 (LB / FT) 9.00	TUBULAR STEEL Ø (IN) 4.00 (LB / FT) 10.80	TUBULAR STEEL Ø (IN) 5.00 (LB / FT) 14.60	SIGN FRAME REQUIRED	REMARKS	SIGN DETAIL: DETAIL IN SHS	SIGN DETAIL: DETAIL ON SHEET NUMBER	SIGN DETAIL: DETAIL ON STD SHEET NUMBER
READSBORO VT 100							FY-FLUORESCENT YELLOW FYG-FLUORESCENT YELLOW GREEN																				"SHS"-STANDARD HIGHWAY SIGNS			
NB	0.000	C	VD-024	72	10		READSBORO / STAMFORD; 1000 0209 0000; 1000 0214 0575	5.00			I	I				2		X		AT THE REQUEST OF AOT-DIST #1 THIS SIGN WAS REMOVED AND RE-INSTALLED FARTHER AWAY FROM THE DITCHLINE. TWO NEW POSTS INSTALLED.						INSTALL 125 FEET SOUTH OF EXISTING TOWN LINE SIGN		4	
		C	VD-700	6	10			0.42			I	I														INSTALL BELOW READSBORO			E-138
		C	VD-700	6	10			0.42			I	I														INSTALL BELOW STAMFORD			E-138
NB	0.024	C	VD-024	60	7.5		READSBORO/STAMFORD						1		X														
NB	0.044	A	N/A	N/A	N/A		NEIGHBORHOOD WATCH SIGN						1		X												REMOVE ILLEGAL SIGN. RETURN TO TOWN.			
NB	0.860	C	VM-607	24	30		43RD INF DIV			1				X															
NB	1.045	C	VR-017	24	30		LEGAL LOAD LIMIT 24,000 POUNDS	5.00								1		X									TH-50, RUE MADELINE RD			E-141
NB	1.053	D	R1-1	30	30								1		X												TH-50, RUE MADELINE RD			
		D	R1-1	30	30		STOP; 1000 0209 0103	6.25								1		X										X		
NB	1.829	A	VD-018	30	18		ADD E / HARTWELLVILLE / READSBORO 5						1		X														
		A	VD-018	30	18			3.75								1		X												E-128A
NB	1.944	A	W1-2R	30	30		RIGHT CURVE						1		X														
		A	W13-1	18	18		40 MPH PLAQUE						1																
NB	1.972	A	W1-10R	30	30			6.25								1		X									INSTALL 150 FEET NORTH OF EXISTING RIGHT CURVE SIGN	X		
		A	W13-1	18	18		40 M.P.H.	2.25																				X	
SIGN SUMMARY SHEET							SHEET TOTALS	29.34 SF	0.00 SF	1 EA	3 0 EA	3 0 EA	6 EA	0 EA	0 EA	6 EA		90 FT										
VERMONT AGENCY OF TRANSPORTATION							TOWN TOTALS	408.4	0.0	34.0	3.0	3.0	84	0.0	2.0	64		960.0										

PROJECT NAME: Stamford-Andover VT100
PROJECT NUMBER: STPG SIGN(20)

FILE NAME: Readsboro.xls
PROJECT MANAGER: N. Avery
DESIGNED BY: J. Kelly
READSBORO SHEET 1

PLOT DATE: 8/5/2009
DRAWN BY: T. Guazzoni
CHECKED BY: T. Guazzoni
SHEET 22 OF 198

DIRECTION	MILEPOINT	LOCATION CODE (SHEET 2)	SIGN CODE	WIDTH (IN)	HEIGHT (IN)	SHEETING REMARKS	SIGN LEGEND	NEW SIGNS "A"	NEW SIGNS "B"	EXISTING SIGNS RETAIN	EXISTING SIGNS SALVAGE FROM	EXISTING SIGNS SALVAGE TO	EXISTING SIGNS REMOVE	EXIST POST RETAIN	EXIST POST REMOVE	NUMBER OF NEW POSTS	SQUARE STEEL (IN) 1.75 (LB / FT) 1.88	SQUARE STEEL (IN) 2.00 (LB / FT) 2.42	SQUARE STEEL (IN) 2.50 (LB / FT) 3.35	FOUNDATION	TUBULAR STEEL Ø (IN) 3.00 (LB / FT) 7.60	TUBULAR STEEL Ø (IN) 3.50 (LB / FT) 9.00	TUBULAR STEEL Ø (IN) 4.00 (LB / FT) 10.80	TUBULAR STEEL Ø (IN) 5.00 (LB / FT) 14.60	SIGN FRAME REQUIRED	REMARKS	SIGN DETAIL: DETAIL IN SHS	SIGN DETAIL: DETAIL ON SHEET NUMBER	SIGN DETAIL: DETAIL ON STD SHEET NUMBER
READSBORO VT 100							FY-FLUORESCENT YELLOW FYG-FLUORESCENT YELLOW GREEN																			"SHS"-STANDARD HIGHWAY SIGNS			
NB	2.030	A	M2-1	21	15								1		X													
		A	M1-5	24	24								1														
		A	M2-1	21	15			2.19								1		X								GREEN ON WHITE SHEETING	X		
		A	M1-5	24	24			4.00																				E-136B
NB	2.069	A	M3-1	24	12								1															
		A	M1-5	24	24								1															
		A	M5-1L	21	15								1															
		A	M3-1	24	12								1															
		A	M1-5	24	24								1															
		A	M5-1L	21	15								1															
		A	M3-1	24	12			2.00								2		X						#2	GREEN ON WHITE SHEETING	X	7	
		A	M1-5	24	24			4.00																				E-136B
		A	M5-1L	21	15			2.19																			GREEN ON WHITE SHEETING	X		
		A	M4-5	24	12			2.00																			GREEN ON WHITE SHEETING	X		
		A	M1-5	24	24			4.00																				E-136B
							SHEET TOTALS	20.38	0.00	0	0	0	8	0	0	3			45								
								SF	SF	EA	EA	EA	EA	EA	EA	EA			FT								
							TOWN TOTALS	408.4	0.0	34.0	3.0	3.0	84	0.0	2.0	64			960.0								

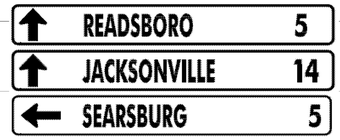
SIGN SUMMARY SHEET

VERMONT AGENCY OF TRANSPORTATION

PROJECT NAME: Stamford-Andover VT100
PROJECT NUMBER: STPG SIGN(20)

FILE NAME: Readsboro.xls
PROJECT MANAGER: N. Avery
DESIGNED BY: J. Kelly
READSBORO SHEET 2

PLOT DATE: 8/5/2009
DRAWN BY: T. Guazzoni
CHECKED BY: T. Guazzoni
SHEET 23 OF 198

DIRECTION	MILEPOINT	LOCATION CODE (SHEET 2)	SIGN CODE	WIDTH (IN)	HEIGHT (IN)	SHEETING REMARKS	SIGN LEGEND	NEW SIGNS "A"	NEW SIGNS "B"	EXISTING SIGNS RETAIN	EXISTING SIGNS SALVAGE FROM	EXISTING SIGNS SALVAGE TO	EXISTING SIGNS REMOVE	EXIST POST RETAIN	EXIST POST REMOVE	NUMBER OF NEW POSTS	SQUARE STEEL (IN) 1.75 (LB / FT) 1.88	SQUARE STEEL (IN) 2.00 (LB / FT) 2.42	SQUARE STEEL (IN) 2.50 (LB / FT) 3.35	TUBULAR STEEL Ø (IN) FOUNDATION	TUBULAR STEEL Ø (IN) 3.00 (LB / FT) 7.60	TUBULAR STEEL Ø (IN) 3.50 (LB / FT) 9.00	TUBULAR STEEL Ø (IN) 4.00 (LB / FT) 10.80	TUBULAR STEEL Ø (IN) 5.00 (LB / FT) 14.60	SIGN FRAME REQUIRED	REMARKS	SIGN DETAIL: DETAIL IN SHS	SIGN DETAIL: DETAIL ON SHEET NUMBER	SIGN DETAIL: DETAIL ON STD SHEET NUMBER
READSBORO VT 100							FY-FLUORESCENT YELLOW FYG-FLUORESCENT YELLOW GREEN																			"SHS"-STANDARD HIGHWAY SIGNS			
		A	M5-1L	21	15			2.19																		GREEN ON WHITE SHEETING	X		
NB	2.120	A	D1-1A	72	10								1		X													
		A	D1-1A	72	10								1															
		A	D1-1A	72	10								1															
		A	D1-1A	72	12			6.00								2		X								5	
		A	D1-1A	72	12			6.00																			5	
NB	2.179	A	M3-1S	24	12								1	X														
		A	M1-5	24	24								1															
		A	M5-1S	21	15								1															
		A	M4-5S	24	12								1															
		A	M1-5	24	24								1															
		A	M6-1S	21	15								1															
		A	M3-1S	24	12								1															
		A	M1-5	30	24								1															
							SHEET TOTALS	20.19 SF	0.00 SF	0 EA	0 EA	0 EA	11 EA	0 EA	0 EA	2 EA	30 FT											
							TOWN TOTALS	408.4	0.0	34.0	3.0	3.0	84	0.0	2.0	64	960.0											

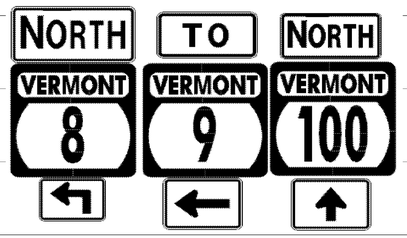
SIGN SUMMARY SHEET

VERMONT AGENCY OF TRANSPORTATION

PROJECT NAME: Stamford-Andover VT100
PROJECT NUMBER: STPG SIGN(20)

FILE NAME: Readsboro.xls
PROJECT MANAGER: N. Avery
DESIGNED BY: J. Kelly
READSBORO SHEET 3

PLOT DATE: 8/5/2009
DRAWN BY: T. Guazzoni
CHECKED BY: T. Guazzoni
SHEET 24 OF 198

DIRECTION	MILEPOINT	LOCATION CODE (SHEET 2)	SIGN CODE	WIDTH (IN)	HEIGHT (IN)	SHEETING REMARKS	SIGN LEGEND	NEW SIGNS "A"	NEW SIGNS "B"	EXISTING SIGNS RETAIN	EXISTING SIGNS SALVAGE FROM	EXISTING SIGNS SALVAGE TO	EXISTING SIGNS REMOVE	EXIST POST RETAIN	EXIST POST REMOVE	NUMBER OF NEW POSTS	SQUARE STEEL (IN) 1.75 (LB / FT) 1.88	SQUARE STEEL (IN) 2.00 (LB / FT) 2.42	SQUARE STEEL (IN) 2.50 (LB / FT) 3.35	FOUNDATION	TUBULAR STEEL Ø (IN) 3.00 (LB / FT) 7.60	TUBULAR STEEL Ø (IN) 3.50 (LB / FT) 9.00	TUBULAR STEEL Ø (IN) 4.00 (LB / FT) 10.80	TUBULAR STEEL Ø (IN) 5.00 (LB / FT) 14.60	SIGN FRAME REQUIRED	REMARKS	SIGN DETAIL: DETAIL IN SHS	SIGN DETAIL: DETAIL ON SHEET NUMBER	SIGN DETAIL: DETAIL ON STD SHEET NUMBER
READSBORO VT 100							FY-FLUORESCENT YELLOW FYG-FLUORESCENT YELLOW GREEN																			"SHS"-STANDARD HIGHWAY SIGNS			
NB	2.179	A	M6-3S	21	15				1																			
		A	M3-1	24	12			2.00																	#3A	INSTALL NEW SIGNS AND FRAME ON EXISTING POSTS. GREEN ON WHITE SHEETING	X	7	
		A	M1-5	24	24			4.00																				E-136B
		A	M5-1L	21	15			2.19																		GREEN ON WHITE SHEETING	X		
		A	M4-5	24	12			2.00																		GREEN ON WHITE SHEETING	X		
		A	M1-5	24	24			4.00																		E-136B
		A	M6-1L	21	15			2.19																		GREEN ON WHITE SHEETING	X		
		A	M3-1	24	12			2.00																		GREEN ON WHITE SHEETING	X		
		A	M1-5	30	24			5.00																				E-136B
		A	M6-3	21	15			2.19																		GREEN ON WHITE SHEETING	X		
NB	2.177	C	W1-7	48	24								1		X													
		C	W1-7	48	24			8.00								2	X										X	
NB	2.204	A	M3-1S	24	12		NORTH						~~1~~		X													
		A	M1-5	30	24		VERMONT 100						1															
NB	2.224	A	D2-1	72	12			6.00								2	X									INSTALL ASSEMBLY HALFWAY BETWEEN THE EXISTING ROUTE MARKER AND DESTINATION SIGNS		5	
							SHEET TOTALS	39.57 SF	0.00 SF	0 EA	0 EA	0 EA	~~3~~ 4 EA	0 EA	0 EA	4 EA	60 FT								
							TOWN TOTALS	408.4	0.0	34.0	3.0	3.0	84	0.0	2.0	64	960.0								

SIGN SUMMARY SHEET

VERMONT AGENCY OF TRANSPORTATION

PROJECT NAME: **Stamford-Andover VT100**
PROJECT NUMBER: **STPG SIGN(20)**

FILE NAME: **Readsboro.xls** PLOT DATE: **8/5/2009**
PROJECT MANAGER: **N. Averv** DRAWN BY: **T. Guazzoni**
DESIGNED BY: **J. Kelly** CHECKED BY: **T. Guazzoni**
READSBORO SHEET 4 SHEET **25** OF **198**

DIRECTION	MILEPOINT	LOCATION CODE (SHEET 2)	SIGN CODE	WIDTH (IN)	HEIGHT (IN)	SHEETING REMARKS	SIGN LEGEND	NEW SIGNS "A"	NEW SIGNS "B"	EXISTING SIGNS RETAIN	EXISTING SIGNS SALVAGE FROM	EXISTING SIGNS SALVAGE TO	EXISTING SIGNS REMOVE	EXIST POST RETAIN	EXIST POST REMOVE	NUMBER OF NEW POSTS	SQUARE STEEL (IN) 1.75 (LB / FT) 1.88	SQUARE STEEL (IN) 2.00 (LB / FT) 2.42	SQUARE STEEL (IN) 2.50 (LB / FT) 3.35	FOUNDATION	TUBULAR STEEL Ø (IN) 3.00 (LB / FT) 7.60	TUBULAR STEEL Ø (IN) 3.50 (LB / FT) 9.00	TUBULAR STEEL Ø (IN) 4.00 (LB / FT) 10.80	TUBULAR STEEL Ø (IN) 5.00 (LB / FT) 14.60	SIGN FRAME REQUIRED	REMARKS	SIGN DETAIL: DETAIL IN SHS	SIGN DETAIL: DETAIL ON SHEET NUMBER	SIGN DETAIL: DETAIL ON STD SHEET NUMBER
READSBORO VT 100							FY-FLUORESCENT YELLOW FYG-FLUORESCENT YELLOW GREEN																			"SHS"-STANDARD HIGHWAY SIGNS			
NB	2.224	A	D2-1	72	12		READSBORO 5	6.00																			5	
		A	M3-1	24	12		JACKSONVILLE 14	2.00																		GREEN ON WHITE SHEETING	X		
		A	M1-5	30	24		NORTH VERMONT 100	5.00																				E-136B
NB	2.244	A	D2-1	72	10		READSBORO 5						1		X													
		A	D2-1	72	10		JACKSONVILLE 14						1															
NB	4.020	A	N/A	N/A	N/A		~~EMPTY POST~~ READSBORO FALLS READSBORO 3								~~X~~											NO POST FOUND.		
		A	VD-018	30	18			3.75								1		X										E-128A
NB	4.260	D	R1-1	30	30		STOP						1		X											HOWE POND RD TH-4		
NB	4.930	C	VM-607	24	30		MEMORIAL HIGHWAY			1				X														
NB	5.002	A	OM-3R	12	36								1		X													
		A	OM-3R	12	36			3.00								1		X									X	
NB	5.032	B	OM-3L	12	36								1		X													
		B	OM-3L	12	36			3.00								1		X									X	
NB	5.757	A	W1-2L	30	30		LEFT CURVE						1		X													
		A	W13-1	18	18		35 MPH PLAQUE						1															
SIGN SUMMARY SHEET							SHEET TOTALS	22.75 SF	0.00 SF	1 EA	0 EA	0 EA	7 EA	0 EA	0 EA	3 EA		45 FT									
VERMONT AGENCY OF TRANSPORTATION							TOWN TOTALS	408.4	0.0	34.0	3.0	3.0	84	0.0	2.0	64		960.0									

PROJECT NAME: **Stamford-Andover VT100**
PROJECT NUMBER: **STPG SIGN(20)**
FILE NAME: **Readsboro.xls**
PROJECT MANAGER: **N. Avery**
DESIGNED BY: **J. Kelly**
READSBORO SHEET 5
PLOT DATE: **8/5/2009**
DRAWN BY: **T. Guazzoni**
CHECKED BY: **T. Guazzoni**
SHEET **26** OF **198**

DIRECTION	MILEPOINT	LOCATION CODE (SHEET 2)	SIGN CODE	WIDTH (IN)	HEIGHT (IN)	SHEETING REMARKS	SIGN LEGEND	NEW SIGNS "A"	NEW SIGNS "B"	EXISTING SIGNS RETAIN	EXISTING SIGNS SALVAGE FROM	EXISTING SIGNS SALVAGE TO	EXISTING SIGNS REMOVE	EXIST POST RETAIN	EXIST POST REMOVE	NUMBER OF NEW POSTS	SQUARE STEEL (IN) 1.75 (LB / FT) 1.88	SQUARE STEEL (IN) 2.00 (LB / FT) 2.42	SQUARE STEEL (IN) 2.50 (LB / FT) 3.35	FOUNDATION	TUBULAR STEEL Ø (IN) 3.00 (LB / FT) 7.60	TUBULAR STEEL Ø (IN) 3.50 (LB / FT) 9.00	TUBULAR STEEL Ø (IN) 4.00 (LB / FT) 10.80	TUBULAR STEEL Ø (IN) 5.00 (LB / FT) 14.60	SIGN FRAME REQUIRED	REMARKS	SIGN DETAIL: DETAIL IN SHS	SIGN DETAIL: DETAIL ON SHEET NUMBER	SIGN DETAIL: DETAIL ON STD SHEET NUMBER
READSBORO VT 100							FY-FLUORESCENT YELLOW FYG-FLUORESCENT YELLOW GREEN																				"SHS"-STANDARD HIGHWAY SIGNS			
NB	5.809	A	W1-2L	30	30	FY		6.25								1		X								INSTALL 275 FEET NORTH OF EXISTING SIGNS	X		
		A	W13-1	18	18	FY		2.25																			X		
NB	5.872	A	W1-6	48	24								1		X															
		A	OM1-1	18	18		9 BALL CLUSTER 						1																
		A	W1-6	48	24	FY		8.00								2		X									X		
NB	5.874	B	W1-6	48	24								1		~~X~~														
		B	OM1-1	18	18		9 BALL CLUSTER 						1																
		B	W1-6	48	24	FY		8.00								2		X								FACES SB TRAFFIC	X		
NB	5.905	A	W1-6	48	24	FY	 BR #23	8.00								2		X								BRIDGE PLAQUE SALVAGED TO NEW POST	X		
NB	5.907	B	W1-6	48	24								1		X												FACES SB TRAFFIC			
		B	W1-6	48	24	FY		8.00								2		X									X		
NB	6.210	A	W3-5	36	36		SPEED REDUCTION (40)			1				X															
NB	6.302	A	S3-1	30	30								1		X															
		A	S3-1	30	30		SCHOOL BUS STOP AHEAD	6.25								1		X									X		
NB	6.350	A	R2-1	24	30		SPEED LIMIT 40						1		X														
SIGN SUMMARY SHEET							SHEET TOTALS	46.75	0.00	1	0	0	7	0	0	10		150										
								SF	SF	EA	EA	EA	EA	EA	EA	EA		FT										
VERMONT AGENCY OF TRANSPORTATION							TOWN TOTALS	408.4	0.0	34.0	3.0	3.0	84	0.0	2.0	64		960.0										

PROJECT NAME: **Stamford-Andover VT100**
PROJECT NUMBER: **STPG SIGN(20)**

FILE NAME: **Readsboro.xls**
PROJECT MANAGER: **N. Avery**
DESIGNED BY: **J. Kelly**
READSBORO SHEET 6

PLOT DATE: **8/5/2009**
DRAWN BY: **T. Guazzoni**
CHECKED BY: **T. Guazzoni**
SHEET **27** OF **198**

DIRECTION	MILEPOINT	LOCATION CODE (SHEET 2)	SIGN CODE	WIDTH (IN)	HEIGHT (IN)	SHEETING REMARKS	SIGN LEGEND	NEW SIGNS "A"	NEW SIGNS "B"	EXISTING SIGNS RETAIN	EXISTING SIGNS SALVAGE FROM	EXISTING SIGNS SALVAGE TO	EXISTING SIGNS REMOVE	EXIST POST RETAIN	EXIST POST REMOVE	NUMBER OF NEW POSTS	SQUARE STEEL (IN) 1.75 (LB / FT) 1.88	SQUARE STEEL (IN) 2.00 (LB / FT) 2.42	SQUARE STEEL (IN) 2.50 (LB / FT) 3.35	FOUNDATION	TUBULAR STEEL Ø (IN) 3.00 (LB / FT) 7.60	TUBULAR STEEL Ø (IN) 3.50 (LB / FT) 9.00	TUBULAR STEEL Ø (IN) 4.00 (LB / FT) 10.80	TUBULAR STEEL Ø (IN) 5.00 (LB / FT) 14.60	SIGN FRAME REQUIRED	REMARKS	SIGN DETAIL: DETAIL IN SHS	SIGN DETAIL: DETAIL ON SHEET NUMBER	SIGN DETAIL: DETAIL ON STD SHEET NUMBER
READSBORO VT 100							FY-FLUORESCENT YELLOW FYG-FLUORESCENT YELLOW GREEN																				"SHS"-STANDARD HIGHWAY SIGNS			
NB	6.350	A	R2-1	30	36		SPEED LIMIT 40	7.50								1		X									6	
NB	6.440	A	W3-5	36	36		SPEED REDUCTION (25)			1				X														
NB	6.500	A	VD-018	30	18		VILLAGE SIGN			1				X														
NB	6.550	A	VR-038	24	12		STATE HIGHWAY ENDS			1				X														
		A	R2-1	30	36		SPEED LIMIT 25			1																		
							CLASS 1 PORTION OF HIGHWAY																						
NB	7.072	C	VR-017	24	30		LEGAL LOAD LIMIT 24,000 POUNDS	5.00								1		X									TUNNEL ST TH-2			E-141
NB	7.080	D	R1-1	30	30		TUNNEL ST / MAIN ST STOP			1	2	2		X												STREET SIGNS SALVAGED ONTO THE NEW POST.	TUNNEL ST TH-2		
NB	7.090	A	VR-039	24	12		STATE HIGHWAY BEGINS			1				X														
		B	VR--038	24	12		STATE HIGHWAY ENDS			1																		
NB	7.123	A	S1-1YG	30	30		SCHOOL PENTAGON			1				X														
		A	W16-7YG	24	12		DOWN LEFT HAND ARROW			1																		
NB	7.150	A	R2-1	24	30		SPEED LIMIT 40			1				X														
NB	7.221	C	VR-017	24	30		LEGAL LOAD LIMIT 24,000 POUNDS	5.00								1		X									TH-4, DEPOT ST			E-141
NB	7.226	D	R1-1	30	30		STOP				1	1			X	1		X									TH-4, DEPOT ST. RETAIN SIGN AND REPLACE POST			
							SHEET TOTALS	17.50	0.00	10	~~3~~ 1	~~3~~ 1	0	0	0	4		60											
								SF	SF	EA	EA	EA	EA	EA	EA	EA		FT											
							TOWN TOTALS	408.4	0.0	34.0	3.0	3.0	84	0.0	2.0	64		960.0											

SIGN SUMMARY SHEET

VERMONT AGENCY OF TRANSPORTATION

PROJECT NAME: **Stamford-Andover VT100**
PROJECT NUMBER: **STPG SIGN(20)**

FILE NAME: **Readsboro.xls**
PROJECT MANAGER: **N. Avery**
DESIGNED BY: **J. Kelly**
READSBORO SHEET 7

PLOT DATE: **8/5/2009**
DRAWN BY: **T. Guazzoni**
CHECKED BY: **T. Guazzoni**
SHEET **28** OF **198**

DIRECTION	MILEPOINT	LOCATION CODE (SHEET 2)	SIGN CODE	WIDTH (IN)	HEIGHT (IN)	SHEETING REMARKS	SIGN LEGEND	NEW SIGNS "A"	NEW SIGNS "B"	EXISTING SIGNS RETAIN	EXISTING SIGNS SALVAGE FROM	EXISTING SIGNS SALVAGE TO	EXISTING SIGNS REMOVE	EXIST POST RETAIN	EXIST POST REMOVE	NUMBER OF NEW POSTS	SQUARE STEEL (IN) 1.75 / 2.00 / 2.50 (LB / FT) 1.88 / 2.42 / 3.35	FOUNDATION	TUBULAR STEEL Ø (IN) 3.00 / 3.50 / 4.00 / 5.00 (LB / FT) 7.60 / 9.00 / 10.80 / 14.60	SIGN FRAME REQUIRED	REMARKS	SIGN DETAIL: DETAIL IN SHS	SIGN DETAIL: DETAIL ON SHEET NUMBER	SIGN DETAIL: DETAIL ON STD SHEET NUMBER
READSBORO VT 100							FY-FLUORESCENT YELLOW FYG-FLUORESCENT YELLOW GREEN														"SHS"-STANDARD HIGHWAY SIGNS			
NB	7.236	C	VR-017	24	30		LEGAL LOAD LIMIT 24,000 POUNDS	5.00								1	X				TH-46, JARVIS HILL			E-141
NB	7.244	D	R1-1	30	30		STOP / JARVIS HILL RD / VERMONT ROUTE 100			1	2	2		X					STREET SIGNS SALVAGED ONTO THE NEW POST.		TH-46, JARVIS HILL			
NB	7.270	A	M3-1	24	12		NORTH / VERMONT 100	2.00								1	X				INSTALL ACROSS FROM SOUTH BOUND VILLAGE SIGN. GREEN ON WHITE SHEETING	X		
		A	M1-5	30	24			5.00																E-136B
NB	7.350	A	R2-1	24	30		SPEED LIMIT 50			1				X										
NB	7.820	A	W3-5	36	36		SPEED REDUCTION (40)			1				X										
NB	7.900	A	R2-1	30	36		SPEED LIMIT 40			1				X										
SB	7.900	F	R2-1	24	30		SPEED LIMIT 50			1				X										
SB	7.450	F	W3-5	36	36		SPEED REDUCTION (40)			1				X										
SB	7.350	F	R2-1	30	36		SPEED LIMIT 40				1	1			1	1	X							
SB	7.310	F	W3-5	36	36		SPEED REDUCTION (25)			1				X										
SB	7.270	F	VD-018	30	18		VILLAGE SIGN				1	1			1	1	X							
SB	7.226	F	S1-1YG	30	30		SCHOOL PENTAGON			1				X										
		F	W16-9YG	24	12		AHEAD			1														
SB	7.150	F	R2-1	30	36		SPEED LIMIT 25			1				X										
							SHEET TOTALS	12.00	0.00	10	~~4~~ 2	~~4~~ 2	0	0	2	4	60							
								SF	SF	EA	EA	EA	EA	EA	EA	EA	FT							
							TOWN TOTALS	408.4	0.0	34.0	3.0	3.0	84	0.0	2.0	64	960.0							

SIGN SUMMARY SHEET

VERMONT AGENCY OF TRANSPORTATION

PROJECT NAME: **Stamford-Andover VT100**
PROJECT NUMBER: **STPG SIGN(20)**

FILE NAME: **Readsboro.xls**
PROJECT MANAGER: **N. Averv**
DESIGNED BY: **J. Kelly**
READSBORO SHEET 8

PLOT DATE: **8/5/2009**
DRAWN BY: **T. Guazzoni**
CHECKED BY: **T. Guazzoni**

DIRECTION	MILEPOINT	LOCATION CODE (SHEET 2)	SIGN CODE	WIDTH (IN)	HEIGHT (IN)	SHEETING REMARKS	SIGN LEGEND	NEW SIGNS "A"	NEW SIGNS "B"	EXISTING SIGNS RETAIN	EXISTING SIGNS SALVAGE FROM	EXISTING SIGNS SALVAGE TO	EXISTING SIGNS REMOVE	EXIST POST RETAIN	EXIST POST REMOVE	NUMBER OF NEW POSTS	SQUARE STEEL (IN) 1.75 (LB / FT) 1.88	SQUARE STEEL (IN) 2.00 (LB / FT) 2.42	SQUARE STEEL (IN) 2.50 (LB / FT) 3.35	FOUNDATION	TUBULAR STEEL Ø (IN) 3.00 (LB / FT) 7.60	TUBULAR STEEL Ø (IN) 3.50 (LB / FT) 9.00	TUBULAR STEEL Ø (IN) 4.00 (LB / FT) 10.80	TUBULAR STEEL Ø (IN) 5.00 (LB / FT) 14.60	SIGN FRAME REQUIRED	REMARKS	SIGN DETAIL: DETAIL IN SHS	SIGN DETAIL: DETAIL ON SHEET NUMBER	SIGN DETAIL: DETAIL ON STD SHEET NUMBER
READSBORO VT 100							FY-FLUORESCENT YELLOW FYG-FLUORESCENT YELLOW GREEN																				"SHS"-STANDARD HIGHWAY SIGNS			
SB	7.138	G	VR-017	24	30		NO PARKING BETWEEN SIGNS ← LEGAL LOAD LIMIT 24,000 POUNDS						1		X												PHELPS LANE TH-22, ~~SCHOOL RD~~ NEW POST WAS DAMAGED. ON 12-9-10 THIS SIGN WAS RE-INSTALLED.			
		G	VR-017	24	30			5.00			2	2				1		X											E-141
SB	7.130	H	R1-1	30	30		PHELPS LANE STOP				1	1	1		X												PHELPS LANE TH-22, ~~SCHOOL RD~~			
		H	R1-1	30	30			6.25								1		X										X	
SB	7.126	F	S1-1YG	30	30		SCHOOL PENTAGON			1				X															
		F	W16-7YG	24	12		LEFT HAND DOWN ARROW			1																			
SB	7.080	G	VR-017	24	30		LEGAL LOAD LIMIT 24,000 POUNDS SPEED LIMIT 25	5.00			1	1				1		X								SALVAGED 25 MPH SIGN ONTO NEW POST TH-23, EAST MAIN			E-141
SB	7.072	H	R1-1	30	30		GLEN AVE EAST MAIN ST				2	2	1		X												TH-23, EAST MAIN			
		H	R1-1	30	30		STOP	6.25								1		X										X	
							CLASS 1 PORTION OF HIGHWAY																							
SB	6.550	F	VR-039	24	12		STATE HIGHWAY BEGINS			1				X															
		F	R2-1	24	30		SPEED LIMIT 40			1																			
SB	6.529	F	S3-1	30	30		SCHOOL BUS STOP AHEAD						1		X														
		F	S3-1	30	30			6.25								1		X										X	
SB	6.350	F	R2-1	24	30		SPEED LIMIT 50			1				X															
							SHEET TOTALS	28.75 SF	0.00 SF	5 EA	6 ~~0~~ EA	6 ~~0~~ EA	4 EA	0 EA	0 EA	5 EA	75 FT											
							TOWN TOTALS	408.4	0.0	34.0	3.0	3.0	84	0.0	2.0	64	960.0											

SIGN SUMMARY SHEET

VERMONT AGENCY OF TRANSPORTATION

PROJECT NAME: **Stamford-Andover VT100**
PROJECT NUMBER: **STPG SIGN(20)**

FILE NAME: **Readsboro.xls**
PROJECT MANAGER: **N. Avery**
DESIGNED BY: **J. Kelly**
READSBORO SHEET 9

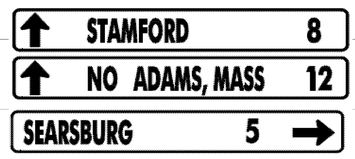
PLOT DATE: **8/5/2009**
DRAWN BY: **T. Guazzoni**
CHECKED BY: **T. Guazzoni**
SHEET **30** OF **198**

DIRECTION	MILEPOINT	LOCATION CODE (SHEET 2)	SIGN CODE	WIDTH (IN)	HEIGHT (IN)	SHEETING REMARKS	SIGN LEGEND	NEW SIGNS "A"	NEW SIGNS "B"	EXISTING SIGNS RETAIN	EXISTING SIGNS SALVAGE FROM	EXISTING SIGNS SALVAGE TO	EXISTING SIGNS REMOVE	EXIST POST RETAIN	EXIST POST REMOVE	NUMBER OF NEW POSTS	SQUARE STEEL (IN) (LB / FT) 1.75 1.88	SQUARE STEEL (IN) (LB / FT) 2.00 2.42	SQUARE STEEL (IN) (LB / FT) 2.50 3.35	TUBULAR STEEL Ø (IN) FOUNDATION	TUBULAR STEEL Ø (IN) (LB / FT) 3.00 7.60	TUBULAR STEEL Ø (IN) (LB / FT) 3.50 9.00	TUBULAR STEEL Ø (IN) (LB / FT) 4.00 10.80	TUBULAR STEEL Ø (IN) (LB / FT) 5.00 14.60	SIGN FRAME REQUIRED	REMARKS	SIGN DETAIL: DETAIL IN SHS	SIGN DETAIL: DETAIL ON SHEET NUMBER	SIGN DETAIL: DETAIL ON STD SHEET NUMBER
READSBORO VT 100							FY-FLUORESCENT YELLOW FYG-FLUORESCENT YELLOW GREEN																			"SHS"-STANDARD HIGHWAY SIGNS			
SB	6.144	F	W1-2R	30	30		RIGHT CURVE						1		X													
		F	W13-1	18	18		35 MPH PLAQUE						1															
SB	6.059	F	W1-2R	30	30	FY		6.25								1		X								INSTALL 450 FEET SOUTH OF EXISTING RIGHT CURVE	X		
		F	W13-1	18	18	FY		2.25																			X	
SB	5.039	F	OM-3R	12	36								1		X															
		F	OM-3R	12	36			3.00								1		X										X	
SB	5.004	E	OM-3L	12	36								1		X															
		E	OM-3L	12	36		1000 0209 0500	3.00								1		X										X	
SB	4.359	F	VD-018	30	18		READSBORO FALLS HEARTWELLVILLE 2						1		X															
		F	VD-018	30	18			3.75								1		X											E-128A
SB	3.710	F	S3-1	30	30		SCHOOL BUS STOP AHEAD						~~1~~		~~X~~												SIGN ALREADY REMOVED PRIOR TO PROJECT.			
		F	S3-1	30	30			6.25								1		X								INSTALL 500 FEET NORTH OF BAILEY HILL ROAD INTERSECTION	X		
SB	3.624	G	VR-017	24	30		LEGAL LOAD LIMIT 24,000 LBS			1				X												TH-29, BAILEY HILL RD			
SB	3.616	H	R1-1	30	30		STOP BAILEY HILL RD			1	~~1~~	~~1~~		X												TH-29, BAILEY HILL RD			
SB	2.338	F	W1-2L	30	30		LEFT CURVE						1		X															
SIGN SUMMARY SHEET							SHEET TOTALS	24.50	0.00	2	~~0~~ 1	~~0~~ 1	~~7~~ 6	0	0	5		75										
VERMONT AGENCY OF TRANSPORTATION								SF	SF	EA	EA	EA	EA	EA	EA	EA		FT										
							TOWN TOTALS	408.4	0.0	34.0	3.0	3.0	84	0.0	2.0	64		960.0										

PROJECT NAME: **Stamford-Andover VT100**
PROJECT NUMBER: **STPG SIGN(20)**

FILE NAME: **Readsboro.xls**
PROJECT MANAGER: **N. Avery**
DESIGNED BY: **J. Kelly**
READSBORO SHEET 10

PLOT DATE: **8/5/2009**
DRAWN BY: **T. Guazzoni**
CHECKED BY: **T. Guazzoni**
SHEET **31** OF **198**

DIRECTION	MILEPOINT	LOCATION CODE (SHEET 2)	SIGN CODE	WIDTH (IN)	HEIGHT (IN)	SHEETING REMARKS	SIGN LEGEND	NEW SIGNS "A"	NEW SIGNS "B"	EXISTING SIGNS RETAIN	EXISTING SIGNS SALVAGE FROM	EXISTING SIGNS SALVAGE TO	EXISTING SIGNS REMOVE	EXIST POST RETAIN	EXIST POST REMOVE	NUMBER OF NEW POSTS	SQUARE STEEL (IN) 1.75 (LB / FT) 1.88	SQUARE STEEL (IN) 2.00 (LB / FT) 2.42	SQUARE STEEL (IN) 2.50 (LB / FT) 3.35	TUBULAR STEEL Ø (IN) FOUNDATION	TUBULAR STEEL Ø (IN) 3.00 (LB / FT) 7.60	TUBULAR STEEL Ø (IN) 3.50 (LB / FT) 9.00	TUBULAR STEEL Ø (IN) 4.00 (LB / FT) 10.80	TUBULAR STEEL Ø (IN) 5.00 (LB / FT) 14.60	SIGN FRAME REQUIRED	REMARKS	SIGN DETAIL: DETAIL IN SHS	SIGN DETAIL: DETAIL ON SHEET NUMBER	SIGN DETAIL: DETAIL ON STD SHEET NUMBER
READSBORO VT 100							FY-FLUORESCENT YELLOW FYG-FLUORESCENT YELLOW GREEN																			"SHS"-STANDARD HIGHWAY SIGNS			
		F	W13-1	18	18		40 MPH PLAQUE						1															
		F	M2-1	21	15			2.19								1		X							GREEN ON WHITE SHEETING	X		
		F	M1-5	24	24			4.00																				E-136B
SB	2.294	F	M2-1S	21	15		JCT						1		X													
		F	M1-5	24	24		VT 8 						1														
		F	W1-10L	30	30			6.25								1		X									X	
		F	W13-1	18	18			2.25																			X	
SB	2.242	F	D1-1A	72	10								1															
		F	D1-1M	72	10								1															
		F	D1-1A	72	10								1															
		F	D1-1A	72	12			6.00								2		X									5	
		F	D1-1A	72	12			6.00																			5	
		F	D1-1A	72	12			6.00																			5	
SB	2.207	F	M3-3S	24	12								1	X														
		F	M1-5	30	24								1															
							SHEET TOTALS	32.69 SF	0.00 SF	0 EA	0 EA	0 EA	8 EA	0 EA	0 EA	4 EA	60 FT											
							TOWN TOTALS	408.4	0.0	34.0	3.0	3.0	84	0.0	2.0	64	960.0											

SIGN SUMMARY SHEET

VERMONT AGENCY OF TRANSPORTATION

PROJECT NAME: Stamford-Andover VT100
PROJECT NUMBER: STPG SIGN(20)

FILE NAME: Readsboro.xls
PROJECT MANAGER: N. Averv
DESIGNED BY: J. Kelly
READSBORO SHEET 11

PLOT DATE: 8/5/2009
DRAWN BY: T. Guazzoni
CHECKED BY: T. Guazzoni
SHEET 32 OF 198

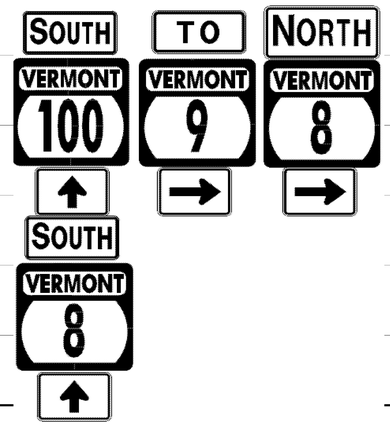
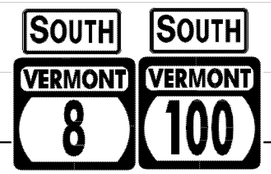
DIRECTION	MILEPOINT	LOCATION CODE (SHEET 2)	SIGN CODE	WIDTH (IN)	HEIGHT (IN)	SHEETING REMARKS	SIGN LEGEND	NEW SIGNS "A"	NEW SIGNS "B"	EXISTING SIGNS RETAIN	EXISTING SIGNS SALVAGE FROM	EXISTING SIGNS SALVAGE TO	EXISTING SIGNS REMOVE	EXIST POST RETAIN	EXIST POST REMOVE	NUMBER OF NEW POSTS	SQUARE STEEL (IN) 1.75 (LB / FT) 1.88	SQUARE STEEL (IN) 2.00 (LB / FT) 2.42	SQUARE STEEL (IN) 2.50 (LB / FT) 3.35	TUBULAR STEEL Ø (IN) FOUNDATION	TUBULAR STEEL Ø (IN) 3.00 (LB / FT) 7.60	TUBULAR STEEL Ø (IN) 3.50 (LB / FT) 9.00	TUBULAR STEEL Ø (IN) 4.00 (LB / FT) 10.80	TUBULAR STEEL Ø (IN) 5.00 (LB / FT) 14.60	SIGN FRAME REQUIRED	REMARKS	SIGN DETAIL: DETAIL IN SHS	SIGN DETAIL: DETAIL ON SHEET NUMBER	SIGN DETAIL: DETAIL ON STD SHEET NUMBER
READSBORO VT 100							FY-FLUORESCENT YELLOW FYG-FLUORESCENT YELLOW GREEN																			"SHS"-STANDARD HIGHWAY SIGNS			
		F	M6-3S	21	15								1																
		F	M3-3S	24	12								1																
		F	M1-5	24	24								1																
		F	M4-5S	24	12								1																
		F	M1-5	21	15								1																
		F	M6-1S	21	15								1																
		F	M3-1S	24	12								1																
		F	M1-5	24	24								1																
		F	M6-1S	21	15								1																
		F	M3-3	24	12			2.00																	#3A	GREEN ON WHITE SHEETING	X	7	
		F	M1-5	30	24			5.00																					E-136B
		F	M6-3	21	15			2.19																		GREEN ON WHITE SHEETING	X		
		F	M3-3	24	12			2.00																		GREEN ON WHITE SHEETING	X		
		F	M1-5	24	24			4.00																					E-136B
		F	M6-3	21	15			2.19																		GREEN ON WHITE SHEETING	X		
							SHEET TOTALS	17.38	0.00	0	0	0	9	0	0	0	0														
								SF	SF	EA	EA	EA	EA	EA	EA	EA	FT														
							TOWN TOTALS	408.4	0.0	34.0	3.0	3.0	84	0.0	2.0	64	960.0														

SIGN SUMMARY SHEET

VERMONT AGENCY OF TRANSPORTATION

PROJECT NAME: **Stamford-Andover VT100**
PROJECT NUMBER: **STPG SIGN(20)**

FILE NAME: **Readsboro.xls** PLOT DATE: **8/5/2009**
PROJECT MANAGER: **N. Avery** DRAWN BY: **T. Guazzoni**
DESIGNED BY: **J. Kelly** CHECKED BY: **T. Guazzoni**
READSBORO SHEET 12 SHEET **33** OF **198**

DIRECTION	MILEPOINT	LOCATION CODE (SHEET 2)	SIGN CODE	WIDTH (IN)	HEIGHT (IN)	SHEETING REMARKS	SIGN LEGEND	NEW SIGNS "A"	NEW SIGNS "B"	EXISTING SIGNS RETAIN	EXISTING SIGNS SALVAGE FROM	EXISTING SIGNS SALVAGE TO	EXISTING SIGNS REMOVE	EXIST POST RETAIN	EXIST POST REMOVE	NUMBER OF NEW POSTS	SQUARE STEEL (IN) 1.75 (LB / FT) 1.88	SQUARE STEEL (IN) 2.00 (LB / FT) 2.42	SQUARE STEEL (IN) 2.50 (LB / FT) 3.35	FOUNDATION	TUBULAR STEEL Ø (IN) 3.00 (LB / FT) 7.60	TUBULAR STEEL Ø (IN) 3.50 (LB / FT) 9.00	TUBULAR STEEL Ø (IN) 4.00 (LB / FT) 10.80	TUBULAR STEEL Ø (IN) 5.00 (LB / FT) 14.60	SIGN FRAME REQUIRED	REMARKS	SIGN DETAIL: DETAIL IN SHS	SIGN DETAIL: DETAIL ON SHEET NUMBER	SIGN DETAIL: DETAIL ON STD SHEET NUMBER
READSBORO VT 100							FY-FLUORESCENT YELLOW FYG-FLUORESCENT YELLOW GREEN																			"SHS"-STANDARD HIGHWAY SIGNS			
		F	M4-5	24	12			2.00																GREEN ON WHITE SHEETING	X		
		F	M1-5	21	15			4.00																				E-136B
		F	M6-1R	21	15			2.19																			GREEN ON WHITE SHEETING	X		
		F	M3-1	24	12			2.00																			GREEN ON WHITE SHEETING	X		
		F	M1-5	24	24			4.00																				E-136B
		F	M6-1R	21	15			2.19																			GREEN ON WHITE SHEETING	X		
		F	M6-1R	21	15			2.19																			GREEN ON WHITE SHEETING	X		
SB	2.153	F	M3-3	24	12							1		X															
		F	M1-5	24	24							1																	
		F	M3-3S	24	12							1																	
		F	M1-5	30	24							1																	
		F	M3-3	24	12			2.00								2		X							#1A	MAINTAIN 10 FEET CLEARANCE FROM UTILITY POLE. GREEN ON WHITE SHEETING	X	7	
		F	M1-5	24	24			4.00																				E-136B
		F	M3-3	24	12			2.00																GREEN ON WHITE SHEETING	X		
		F	M1-5	30	24			5.00																				E-136B
SB	2.112	F	D2-1	72	12		STAMFORD			1				X															
SIGN SUMMARY SHEET							SHEET TOTALS	29.38 SF	0.00 SF	1 EA	0 EA	0 EA	4 EA	0 EA	0 EA	2 EA	30 FT											
VERMONT AGENCY OF TRANSPORTATION							TOWN TOTALS	408.4	0.0	34.0	3.0	3.0	84	0.0	2.0	64	960.0											

PROJECT NAME: **Stamford-Andover VT100**
PROJECT NUMBER: **STPG SIGN(20)**

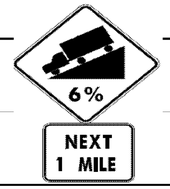
FILE NAME: **Readsboro.xls** PLOT DATE: **8/5/2009**
PROJECT MANAGER: **N. Avery** DRAWN BY: **T. Guazzoni**
DESIGNED BY: **J. Kelly** CHECKED BY: **T. Guazzoni**
READSBORO SHEET 13 SHEET **34** OF **198**

DIRECTION	MILEPOINT	LOCATION CODE (SHEET 2)	SIGN CODE	WIDTH (IN)	HEIGHT (IN)	SHEETING REMARKS	SIGN LEGEND	NEW SIGNS "A"	NEW SIGNS "B"	EXISTING SIGNS RETAIN	EXISTING SIGNS SALVAGE FROM	EXISTING SIGNS SALVAGE TO	EXISTING SIGNS REMOVE	EXIST POST RETAIN	EXIST POST REMOVE	NUMBER OF NEW POSTS	SQUARE STEEL (IN) 1.75 (LB / FT) 1.88	SQUARE STEEL (IN) 2.00 (LB / FT) 2.42	SQUARE STEEL (IN) 2.50 (LB / FT) 3.35	FOUNDATION	TUBULAR STEEL Ø (IN) 3.00 (LB / FT) 7.60	TUBULAR STEEL Ø (IN) 3.50 (LB / FT) 9.00	TUBULAR STEEL Ø (IN) 4.00 (LB / FT) 10.80	TUBULAR STEEL Ø (IN) 5.00 (LB / FT) 14.60	SIGN FRAME REQUIRED	REMARKS	SIGN DETAIL: DETAIL IN SHS	SIGN DETAIL: DETAIL ON SHEET NUMBER	SIGN DETAIL: DETAIL ON STD SHEET NUMBER
READSBORO VT 100							FY-FLUORESCENT YELLOW FYG-FLUORESCENT YELLOW GREEN																			"SHS"-STANDARD HIGHWAY SIGNS			
		F	D2-1	72	12		NO ADAMS MA			1																			
SB	2.073	F	VD-018	30	18		ADD "E" TO WORD 						~~1~~		~~X~~											OLD SIGN WAS MISSING			
		F	VD-018	30	18			3.75								1		X											E-128A
SB	2.068	E	W1-6	48	24								1		X														
		E	W1-6	48	24			8.00								2		X										X	
SB	2.054	G	VR-017	24	30								1		X											OLD COUNTY LANE TH-35, ~~HEARTWELLVILLE RD~~			
		G	VR-017	24	30			5.00								1		X											E-141
SB	2.054	H	R1-1	30	30		 1000 0209 0204						1		X											OLD COUNTY LANE TH-35, ~~HEARTWELLVILLE RD~~			
		H	R1-1	30	30			6.25								1		X										X	
SB	1.573	F	W1-2L	30	30								1		X														
		F	W1-2L	30	30			6.25								1		X										X	
SB	1.488	G	VR-017	24	30								1		X											TH-36, WILLIAMS RD (NORTH)			
		G	VR-017	24	30			5.00								1		X											E-141
SB	1.480	H	R1-1	30	30								1		X											TH-36, WILLIAMS RD (NORTH)			
		H	R1-1	30	30			6.25								1		X										X	
SIGN SUMMARY SHEET							SHEET TOTALS	40.50 SF	0.00 SF	1 EA	0 EA	0 EA	~~6~~ ~~7~~ EA	0 EA	0 EA	8 EA		120 FT										
VERMONT AGENCY OF TRANSPORTATION							TOWN TOTALS	408.4	0.0	34.0	3.0	3.0	84	0.0	2.0	64		960.0										

PROJECT NAME: **Stamford-Andover VT100**
PROJECT NUMBER: **STPG SIGN(20)**

FILE NAME: **Readsboro.xls**
PROJECT MANAGER: **N. Avery**
DESIGNED BY: **J. Kelly**
READSBORO SHEET 14

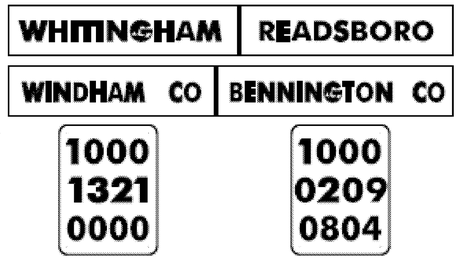
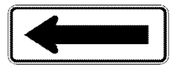
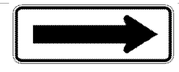
PLOT DATE: **8/5/2009**
DRAWN BY: **T. Guazzoni**
CHECKED BY: **T. Guazzoni**
SHEET **35** OF **198**

DIRECTION	MILEPOINT	LOCATION CODE (SHEET 2)	SIGN CODE	WIDTH (IN)	HEIGHT (IN)	SHEETING REMARKS	SIGN LEGEND	NEW SIGNS "A"	NEW SIGNS "B"	EXISTING SIGNS RETAIN	EXISTING SIGNS SALVAGE FROM	EXISTING SIGNS SALVAGE TO	EXISTING SIGNS REMOVE	EXIST POST RETAIN	EXIST POST REMOVE	NUMBER OF NEW POSTS	SQUARE STEEL (IN) 1.75 (LB / FT) 1.88	SQUARE STEEL (IN) 2.00 (LB / FT) 2.42	SQUARE STEEL (IN) 2.50 (LB / FT) 3.35	FOUNDATION	TUBULAR STEEL Ø (IN) 3.00 (LB / FT) 7.60	TUBULAR STEEL Ø (IN) 3.50 (LB / FT) 9.00	TUBULAR STEEL Ø (IN) 4.00 (LB / FT) 10.80	TUBULAR STEEL Ø (IN) 5.00 (LB / FT) 14.60	SIGN FRAME REQUIRED	REMARKS	SIGN DETAIL: DETAIL IN SHS	SIGN DETAIL: DETAIL ON SHEET NUMBER	SIGN DETAIL: DETAIL ON STD SHEET NUMBER
READSBORO VT 100							FY-FLUORESCENT YELLOW FYG-FLUORESCENT YELLOW GREEN																				"SHS"-STANDARD HIGHWAY SIGNS			
SB	1.386	G	VR-017	24	30								1		X												TH-36, WILLIAMS RD (SOUTH)			
		G	VR-017	24	30			5.00								1		X											E-141
SB	1.377	H	R1-1	30	30		 1000 0209 0136						1		X												TH-36, WILLIAMS RD (SOUTH)			
		H	R1-1	30	30			6.25								1		X										X		
SB	1.176	F	VW-054R	30	30		HIDDEN DRIVE RIGHT			1				X																
		F	S3-1	30	30		SCHOOL BUS STOP AHEAD 			1																			
SB	0.995	F	W7-1b	30	30			6.25								1		X									INSTALL 50 FEET SOUTH OF END OF GUARD RAIL	X		
		F	W7-3a	24	18			3.00																				X		
SB	0.737	F	W1-2R	30	30			6.25								1		X									INSTALL 300 FEET NORTH OF GUARD RAIL SECTION (ON INSIDE OF DOWNHILL CURVE)	X		
							SHEET TOTALS	26.75 SF	0.00 SF	2 EA	0 EA	0 EA	2 EA	0 EA	0 EA	4 EA		60 FT							
							TOWN TOTALS	408.4	0.0	34.0	3.0	3.0	84	0.0	2.0	64		960.0							

SIGN SUMMARY SHEET

VERMONT AGENCY OF TRANSPORTATION

PROJECT NAME: **Stamford-Andover VT100**
PROJECT NUMBER: **STPG SIGN(20)**
FILE NAME: **Readsboro.xls**
PROJECT MANAGER: **N. Avery**
DESIGNED BY: **J. Kelly**
READSBORO SHEET 15
PLOT DATE: **8/5/2009**
DRAWN BY: **T. Guazzoni**
CHECKED BY: **T. Guazzoni**
SHEET **36** OF **198**

DIRECTION	MILEPOINT	LOCATION CODE (SHEET 2)	SIGN CODE	WIDTH (IN)	HEIGHT (IN)	SHEETING REMARKS	SIGN LEGEND	NEW SIGNS "A"	NEW SIGNS "B"	EXISTING SIGNS RETAIN	EXISTING SIGNS SALVAGE FROM	EXISTING SIGNS SALVAGE TO	EXISTING SIGNS REMOVE	EXIST POST RETAIN	EXIST POST REMOVE	NUMBER OF NEW POSTS	SQUARE STEEL (IN) 1.75 (LB / FT) 1.88	SQUARE STEEL (IN) 2.00 (LB / FT) 2.42	SQUARE STEEL (IN) 2.50 (LB / FT) 3.35	FOUNDATION	TUBULAR STEEL Ø (IN) 3.00 (LB / FT) 7.60	TUBULAR STEEL Ø (IN) 3.50 (LB / FT) 9.00	TUBULAR STEEL Ø (IN) 4.00 (LB / FT) 10.80	TUBULAR STEEL Ø (IN) 5.00 (LB / FT) 14.60	SIGN FRAME REQUIRED	REMARKS	SIGN DETAIL: DETAIL IN SHS	SIGN DETAIL: DETAIL ON SHEET NUMBER	SIGN DETAIL: DETAIL ON STD SHEET NUMBER
WHITINGHAM VT 100							FY-FLUORESCENT YELLOW FYG-FLUORESCENT YELLOW GREEN																			"SHS"-STANDARD HIGHWAY SIGNS			
NB	0.000	C	VD-024	72	10			5.00								2		X							INSTALL NEW ASSEMBLY 200 FEET SOUTH OF EXISTING ASSEMBLY		4	
		C	VD-025	72	10			5.00																		WHITE MARK ON PAVEMENT AT LOCATION OF NEW SIGN		4	
		C	VD-700	6	10			0.42																		INSTALL BELOW WHITINGHAM			E-138
		C	VD-700	6	10			0.42																		INSTALL BELOW READSBORO			E-138
NB	0.038	C	VD-024	60	7.5		WHITINGHAM/READSBORO TOWN LINE						1		X														
		C	VD-025	60	7.5		WINDHAM CO/ BENNINGTON CO						1																
NB	0.173	A	W1-6	48	24								1		X														
		A	OM1-1	18	18		YELLOW CLUSTER						1																
		B	W1-6	48	24								1																
		B	OM1-1	18	18		YELLOW CLUSTER						1																
		A	W1-6	48	24	FY		8.00								2		X										X	
		B	W1-6	48	24	FY		8.00								2		X								FACES SB TRAFFIC		X	
NB	0.193	A	R2-1	24	30		SPEED LIMIT 40						1		X														
NB	0.223	A	N/A	18	24		TOWN SIGN 						1		X												ILLEGAL TOWN SIGN. RETURN TO TOWN			
NB	0.268	A	OM-3R	12	36			3.00					1			1		X									X	
SIGN SUMMARY SHEET							SHEET TOTALS	29.84 SF	0.00 SF	0 EA	0 EA	0 EA	~~8~~ 9 EA	0 EA	0 EA	7 EA		105 FT										
VERMONT AGENCY OF TRANSPORTATION							TOWN TOTALS	1058.3	0.0	40.0	13.0	13.0	220	0.0	0.0	193		2895.0										

PROJECT NAME: **Stamford-Andover VT100**
PROJECT NUMBER: **STPG SIGN(20)**

FILE NAME: **Whitingham.xls** PLOT DATE: **8/5/2009**
PROJECT MANAGER: **N. Avery** DRAWN BY: **I. Shea**
DESIGNED BY: **J. Kelly** CHECKED BY: **T. Guazzoni**
WHITINGHAM SHEET 1 SHEET **37** OF **198**

DIRECTION	MILEPOINT	LOCATION CODE (SHEET 2)	SIGN CODE	WIDTH (IN)	HEIGHT (IN)	SHEETING REMARKS	SIGN LEGEND	NEW SIGNS "A"	NEW SIGNS "B"	EXISTING SIGNS RETAIN	EXISTING SIGNS SALVAGE FROM	EXISTING SIGNS SALVAGE TO	EXISTING SIGNS REMOVE	EXIST POST RETAIN	EXIST POST REMOVE	NUMBER OF NEW POSTS	SQUARE STEEL (IN) 1.75 (LB / FT) 1.88	SQUARE STEEL (IN) 2.00 (LB / FT) 2.42	SQUARE STEEL (IN) 2.50 (LB / FT) 3.35	FOUNDATION	TUBULAR STEEL Ø (IN) 3.00 (LB / FT) 7.60	TUBULAR STEEL Ø (IN) 3.50 (LB / FT) 9.00	TUBULAR STEEL Ø (IN) 4.00 (LB / FT) 10.80	TUBULAR STEEL Ø (IN) 5.00 (LB / FT) 14.60	SIGN FRAME REQUIRED	REMARKS	SIGN DETAIL: DETAIL IN SHS	SIGN DETAIL: DETAIL ON SHEET NUMBER	SIGN DETAIL: DETAIL ON STD SHEET NUMBER
WHITINGHAM VT 100							FY-FLUORESCENT YELLOW FYG-FLUORESCENT YELLOW GREEN																			"SHS"-STANDARD HIGHWAY SIGNS			
NB	0.273	B	OM-3L	12	36			3.00								1		X									X	
NB	0.313	A	R2-1	24	30		SPEED LIMIT 40						1		X													
NB	0.408	A	R2-1	24	30			5.00								1		X								INSTALL 500 FEET NORTH OF EXISTING SPEED LIMIT 40 SIGN	X		
NB	0.600	A	W1-1R	30	30		RIGHT TURN						1		X													
		A	W13-1	18	18		30 MPH PLAQUE						1															
NB	0.648	A	W1-2R	30	30			6.25								1		X								INSTALL 250 FEET NORTH OF EXISTING RIGHT TURN SIGN	X		
		A	W13-1	18	18			2.25																			X	
NB	0.920	A	S3-1	30	30		SCHOOL BUS STOP AHEAD						1		X													
NB	0.970	A	R2-1	24	30								1		X													
		A	R2-1	24	30			5.00								1		X									X	
NB	1.098	A	W1-2L	30	30		LEFT CURVE						1		X													
		A	W13-1	18	18		35 MPH PLAQUE						1															
NB	1.114	A	W1-10L	30	30		LEFT CURVE W/RH SIDE ROAD						1		X													
NB	1.196	A	W1-10L	30	30			6.25								1		X								INSTALL ASSEMBLY 250 FEET SOUTH OF INTERSECTION AND SOUTH OF UTILITY POLE	X		
		A	W13-1	18	18			2.25																			X	
							SHEET TOTALS	30.00 SF	0.00 SF	0 EA	0 EA	0 EA	8 EA	0 EA	0 EA	5 EA		75 FT										
							TOWN TOTALS	1058.3	0.0	40.0	13.0	13.0	220	0.0	0.0	193		2895.0										

SIGN SUMMARY SHEET

VERMONT AGENCY OF TRANSPORTATION

PROJECT NAME: Stamford-Andover VT100
PROJECT NUMBER: STPG SIGN(20)

FILE NAME: Whitingham.xls
PROJECT MANAGER: N. Averv
DESIGNED BY: J. Kelly
WHITINGHAM SHEET 2

PLOT DATE: 8/5/2009
DRAWN BY: I. Shea
CHECKED BY: T. Guazzoni

DIRECTION	MILEPOINT	LOCATION CODE (SHEET 2)	SIGN CODE	WIDTH (IN)	HEIGHT (IN)	SHEETING REMARKS	SIGN LEGEND	NEW SIGNS "A"	NEW SIGNS "B"	EXISTING SIGNS RETAIN	EXISTING SIGNS SALVAGE FROM	EXISTING SIGNS SALVAGE TO	EXISTING SIGNS REMOVE	EXIST POST RETAIN	EXIST POST REMOVE	NUMBER OF NEW POSTS	SQUARE STEEL (IN) 1.75 (LB / FT) 1.88	SQUARE STEEL (IN) 2.00 (LB / FT) 2.42	SQUARE STEEL (IN) 2.50 (LB / FT) 3.35	FOUNDATION	TUBULAR STEEL Ø (IN) 3.00 (LB / FT) 7.60	TUBULAR STEEL Ø (IN) 3.50 (LB / FT) 9.00	TUBULAR STEEL Ø (IN) 4.00 (LB / FT) 10.80	TUBULAR STEEL Ø (IN) 5.00 (LB / FT) 14.60	SIGN FRAME REQUIRED	REMARKS	SIGN DETAIL: DETAIL IN SHS	SIGN DETAIL: DETAIL ON SHEET NUMBER	SIGN DETAIL: DETAIL ON STD SHEET NUMBER
WHITINGHAM VT 100							FY-FLUORESCENT YELLOW FYG-FLUORESCENT YELLOW GREEN																			"SHS"-STANDARD HIGHWAY SIGNS			
NB	1.235	B	W1-6	48	24			8.00								2		X								INSTALL ON SOUTH SIDE OF TH-38 FACING SOUTH BOUND TRAFFIC	X		
NB	1.237	C	VR-017	24	30								1		X											TH-38, MERRIFIELD RD			
		C	VR-017	24	30			5.00								1		X										E-141
NB	1.245	D	N/A				EMPTY POST   				I	I			X														
		D	R1-1	30	30			6.25								1		X								OLD POST WAS REMOVED PRIOR TO THE PROJECT TH-38, MERRIFIELD RD	X		
NB	1.250	A	W1-6	48	24								1		X														
		A	W1-6	48	24			8.00								2		X									X		
NB	1.250	B	W1-6	48	24		RIGHT ARROW						1		X														
NB	1.710	A	W1-2L	30	30		LEFT CURVE						1		X														
		A	W13-1	18	18		35 MPH PLAQUE						1																
NB	1.793	A	W1-1ML	30	30		LEFT TURN W/SIDE ROAD						1		X														
		A	W13-1	18	18		30 MPH PLAQUE						1																
NB	1.853	A	S3-1	30	30		SCHOOL BUS STOP AHEAD 	6.25					1		X												THE OLD SIGN WAS REMOVED AND A NEW SIGN WAS INSTALLED SINCE IT IS A SCHOOL BUS STOP.			
		A	W1-1MdL	30	30			6.25								1		X								THESE TWO SIGNS WERE MOVED TO ANOTHER LOCATION DUE TO THE VISIBILITY PROBLEMS WITH UTILITY POLES.		6	
NB	1.836	A	W13-1	18	18			2.25																			X		
							SHEET TOTALS	~~42.00~~ 35.75 SF	0.00 SF	0 EA	~~I~~ 0 EA	~~I~~ 0 EA	~~9~~ 8 EA	0 EA	0 EA	7 EA		105 FT											
							TOWN TOTALS	1058.3	0.0	40.0	13.0	13.0	220	0.0	0.0	193		2895.0											

SIGN SUMMARY SHEET

VERMONT AGENCY OF TRANSPORTATION

PROJECT NAME: **Stamford-Andover VT100**
PROJECT NUMBER: **STPG SIGN(20)**

FILE NAME: **Whitingham.xls**
PROJECT MANAGER: **N. Avery**
DESIGNED BY: **J. Kelly**
WHITINGHAM SHEET 3

PLOT DATE: **8/5/2009**
DRAWN BY: **I. Shea**
CHECKED BY: **T. Guazzoni**
SHEET **39** OF **198**

DIRECTION	MILEPOINT	LOCATION CODE (SHEET 2)	SIGN CODE	WIDTH (IN)	HEIGHT (IN)	SHEETING REMARKS	SIGN LEGEND	NEW SIGNS "A"	NEW SIGNS "B"	EXISTING SIGNS RETAIN	EXISTING SIGNS SALVAGE FROM	EXISTING SIGNS SALVAGE TO	EXISTING SIGNS REMOVE	EXIST POST RETAIN	EXIST POST REMOVE	NUMBER OF NEW POSTS	SQUARE STEEL (IN) 1.75 (LB / FT) 1.88	SQUARE STEEL (IN) 2.00 (LB / FT) 2.42	SQUARE STEEL (IN) 2.50 (LB / FT) 3.35	FOUNDATION	TUBULAR STEEL Ø (IN) 3.00 (LB / FT) 7.60	TUBULAR STEEL Ø (IN) 3.50 (LB / FT) 9.00	TUBULAR STEEL Ø (IN) 4.00 (LB / FT) 10.80	TUBULAR STEEL Ø (IN) 5.00 (LB / FT) 14.60	SIGN FRAME REQUIRED	REMARKS	SIGN DETAIL: DETAIL IN SHS	SIGN DETAIL: DETAIL ON SHEET NUMBER	SIGN DETAIL: DETAIL ON STD SHEET NUMBER
WHITINGHAM VT 100							FY-FLUORESCENT YELLOW FYG-FLUORESCENT YELLOW GREEN																			"SHS"-STANDARD HIGHWAY SIGNS			
NB	1.943	B	W1-6	48	24			8.00								2		X								INSTALL ON SOUTH SIDE OF TH-39 FACING SB TRAFFIC	X		
NB	1.945	C	VR-017	24	30			5.00					I			1		X								TH-39, SHIPPEE RD			E-141
NB	1.956	D	R1-1	30	30						I	I	1		X														
		D	R1-1	30	30			6.25								1		X								TH-39, SHIPPEE RD	X		
NB	1.958	A	W1-6	48	24			8.00					I			2		X								INSTALL ON NORTH SIDE OF TH-39 FACING NB TRAFFIC	X		
NB	1.958	B	W1-6	48	24								1		X														
		B	W1-6	48	24			8.00								2		X								FACES SB TRAFFIC	X		
NB	2.089	A	W1-2L	30	30		LEFT CURVE						1		X														
NB	2.108	A	W1-2L	30	30			6.25								1		X								INSTALL 100 FEET NORTH OF EXISTING LOCATION	X		
NB	2.178	A	W1-8	18	24		CHEVRON						1		X														
NB	2.185	B	W1-8	18	24		CHEVRON						1		X														
NB	2.213	B	W1-8	18	24		CHEVRON						1		X														
NB	2.219	A	W1-8	18	24		CHEVRON						1		X														
NB	2.14-2.22	A/B	N/A	6	8		WHITE DELINEATORS	3.33								5	X									INSTALL BACK TO BACK AT 100 FEET SPACING. START 50' NORTH OF BARN.		5	
NB	2.750	A	W7-1	30	30		HILL SYMBOL						1		X														
SIGN SUMMARY SHEET							SHEET TOTALS	44.83	0.00	0	I 0	I 0	I 10	0	0	14		210										
VERMONT AGENCY OF TRANSPORTATION								SF	SF	EA	EA	EA	EA	EA	EA	EA		FT										
							TOWN TOTALS	1058.3	0.0	40.0	13.0	13.0	220	0.0	0.0	193		2895.0										

PROJECT NAME: **Stamford-Andover VT100**
PROJECT NUMBER: **STPG SIGN(20)**

FILE NAME: **Whitingham.xls**
PROJECT MANAGER: **N. Avery**
DESIGNED BY: **J. Kelly**
WHITINGHAM SHEET 4

PLOT DATE: **8/5/2009**
DRAWN BY: **I. Shea**
CHECKED BY: **T. Guazzoni**
SHEET **40** OF **198**

DIRECTION	MILEPOINT	LOCATION CODE (SHEET 2)	SIGN CODE	WIDTH (IN)	HEIGHT (IN)	SHEETING REMARKS	SIGN LEGEND	NEW SIGNS "A"	NEW SIGNS "B"	EXISTING SIGNS RETAIN	EXISTING SIGNS SALVAGE FROM	EXISTING SIGNS SALVAGE TO	EXISTING SIGNS REMOVE	EXIST POST RETAIN	EXIST POST REMOVE	NUMBER OF NEW POSTS	SQUARE STEEL (IN) 1.75 (LB / FT) 1.88	SQUARE STEEL (IN) 2.00 (LB / FT) 2.42	SQUARE STEEL (IN) 2.50 (LB / FT) 3.35	FOUNDATION	TUBULAR STEEL Ø (IN) 3.00 (LB / FT) 7.60	TUBULAR STEEL Ø (IN) 3.50 (LB / FT) 9.00	TUBULAR STEEL Ø (IN) 4.00 (LB / FT) 10.80	TUBULAR STEEL Ø (IN) 5.00 (LB / FT) 14.60	SIGN FRAME REQUIRED	REMARKS	SIGN DETAIL: DETAIL IN SHS	SIGN DETAIL: DETAIL ON SHEET NUMBER	SIGN DETAIL: DETAIL ON STD SHEET NUMBER
WHITINGHAM VT 100							FY-FLUORESCENT YELLOW FYG-FLUORESCENT YELLOW GREEN																			"SHS"-STANDARD HIGHWAY SIGNS			
NB	2.788	A	S3-1	30	30		SCHOOL BUS STOP AHEAD			1			~~1~~	1	~~X~~											SIGN NOT REMOVED. SCHOOL BUS STOPS AT THIS LOCATION			
NB	~~2.870~~ 2.846	A	W1-10R	30	30			6.25								1		X								INSTALL ~~425~~ 307 FEET NORTH OF EXISTING SCHOOL BUS STOP AHEAD SIGN	X		
NB	3.365	A	W3-5	36	36		SPEED REDUCTION (40)			1				X														
NB	3.477	A	R2-1	24	30		SPEED LIMIT 40			1				X														
NB	3.634	A	W1-2R	30	30		RIGHT CURVE				1	1			X	1		X								RETAIN SIGN AND REPLACE POST.			
NB	3.767	A	W3-5	36	36		SPEED REDUCTION (30)			1				X														
NB	3.824	A	VD-018	30	18								1		X													
		A	VD-018	30	18			3.75								1		X										E-128A
		A	VD-701	6	8		BRIDGE 29				1	1														REINSTALL BRIDGE 29 PLAQUE BELOW NEW SIGN			
NB	3.861	A	R2-1	24	30		SPEED LIMIT 30			1				X														
NB	3.947	A	M3-1S	24	12								1		X													
		A	M1-5	30	24								1															
		A	M3-1	24	12			2.00								1		X							GREEN ON WHITE SHEETING	X		
		A	M1-5	30	24			5.00																				E-136B
NB	3.991	A	S3-1	30	30		SCHOOL BUS STOP AHEAD						1		X													
							SHEET TOTALS	17.00	0.00	4	2	2	~~4~~ 5	0	0	4		60									
								SF	SF	EA	EA	EA	EA	EA	EA	EA		FT									
							TOWN TOTALS	1058.3	0.0	40.0	13.0	13.0	220	0.0	0.0	193		2895.0									

SIGN SUMMARY SHEET

VERMONT AGENCY OF TRANSPORTATION

PROJECT NAME: **Stamford-Andover VT100**
PROJECT NUMBER: **STPG SIGN(20)**

FILE NAME: **Whitingham.xls**
PROJECT MANAGER: **N. Avery**
DESIGNED BY: **J. Kelly**
WHITINGHAM SHEET 5

PLOT DATE: **8/5/2009**
DRAWN BY: **I. Shea**
CHECKED BY: **T. Guazzoni**
SHEET **41** OF **198**

DIRECTION	MILEPOINT	LOCATION CODE (SHEET 2)	SIGN CODE	WIDTH (IN)	HEIGHT (IN)	SHEETING REMARKS	SIGN LEGEND	NEW SIGNS "A"	NEW SIGNS "B"	EXISTING SIGNS RETAIN	EXISTING SIGNS SALVAGE FROM	EXISTING SIGNS SALVAGE TO	EXISTING SIGNS REMOVE	EXIST POST RETAIN	EXIST POST REMOVE	NUMBER OF NEW POSTS	SQUARE STEEL (IN) 1.75 (LB / FT) 1.88	SQUARE STEEL (IN) 2.00 (LB / FT) 2.42	SQUARE STEEL (IN) 2.50 (LB / FT) 3.35	FOUNDATION	TUBULAR STEEL Ø (IN) 3.00 (LB / FT) 7.60	TUBULAR STEEL Ø (IN) 3.50 (LB / FT) 9.00	TUBULAR STEEL Ø (IN) 4.00 (LB / FT) 10.80	TUBULAR STEEL Ø (IN) 5.00 (LB / FT) 14.60	SIGN FRAME REQUIRED	REMARKS	SIGN DETAIL: DETAIL IN SHS	SIGN DETAIL: DETAIL ON SHEET NUMBER	SIGN DETAIL: DETAIL ON STD SHEET NUMBER
WHITINGHAM VT 100							FY-FLUORESCENT YELLOW FYG-FLUORESCENT YELLOW GREEN																			"SHS"-STANDARD HIGHWAY SIGNS			
		A	W1-3R	30	30								1															
		A	W13-1	18	18								1															
		A	S3-1	30	30			6.25								2		X								X	
		A	W1-3R	30	30			6.25																				X	
		A	W13-1	18	18			2.25																			X	
NB	4.009	A	W11-2YG	30	30		PEDESTRIAN			1				X															
		A	W16-4YG	24	18		NEXT 500 FEET			1																		
NB	4.078	C	VR-017	24	30			5.00					I			1		X								REMOVED OLD SIGN TH-33, STIMPSON HILL RD			E-141
NB	4.083	D	R1-1	30	30		  						1		X											SALVAGE DEAD END SIGN AND MILE MARKER ONTO NEW POST. ALSO STREET SIGN.			
		D	R1-1	30	30			6.25			2	2				1		X								TH-33, STIMPSON HILL RD	X		
NB	4.102	A	W1-8	18	24								1		X														
		A	W1-8	18	24	FY		3.00								1		X									X		
NB	4.102	B	W1-8	18	24								1		X														
		B	W1-8	18	24	FY		3.00								1		X								FACES SB TRAFFIC	X		
NB	4.116	A	W1-8	18	24								1		X														
SIGN SUMMARY SHEET							SHEET TOTALS	32.00	0.00	2	~~2~~ 0	~~2~~ 0	~~7~~ 6	0	0	6		90									
VERMONT AGENCY OF TRANSPORTATION								SF	SF	EA	EA	EA	EA	EA	EA	EA		FT									
							TOWN TOTALS	1058.3	0.0	40.0	13.0	13.0	220	0.0	0.0	193		2895.0									

PROJECT NAME: **Stamford-Andover VT100**
PROJECT NUMBER: **STPG SIGN(20)**

FILE NAME: **Whitingham.xls**
PROJECT MANAGER: **N. Avery**
DESIGNED BY: **J. Kelly**
WHITINGHAM SHEET 6

PLOT DATE: **8/5/2009**
DRAWN BY: **I. Shea**
CHECKED BY: **T. Guazzoni**
SHEET **42** OF **198**

DIRECTION	MILEPOINT	LOCATION CODE (SHEET 2)	SIGN CODE	WIDTH (IN)	HEIGHT (IN)	SHEETING REMARKS	SIGN LEGEND	NEW SIGNS "A"	NEW SIGNS "B"	EXISTING SIGNS RETAIN	EXISTING SIGNS SALVAGE FROM	EXISTING SIGNS SALVAGE TO	EXISTING SIGNS REMOVE	EXIST POST RETAIN	EXIST POST REMOVE	NUMBER OF NEW POSTS	SQUARE STEEL (IN) 1.75 (LB / FT) 1.88	SQUARE STEEL (IN) 2.00 (LB / FT) 2.42	SQUARE STEEL (IN) 2.50 (LB / FT) 3.35	FOUNDATION	TUBULAR STEEL Ø (IN) 3.00 (LB / FT) 7.60	TUBULAR STEEL Ø (IN) 3.50 (LB / FT) 9.00	TUBULAR STEEL Ø (IN) 4.00 (LB / FT) 10.80	TUBULAR STEEL Ø (IN) 5.00 (LB / FT) 14.60	SIGN FRAME REQUIRED	REMARKS	SIGN DETAIL: DETAIL IN SHS	SIGN DETAIL: DETAIL ON SHEET NUMBER	SIGN DETAIL: DETAIL ON STD SHEET NUMBER
WHITINGHAM VT 100							FY-FLUORESCENT YELLOW FYG-FLUORESCENT YELLOW																			"SHS"-STANDARD HIGHWAY SIGNS			
NB	4.116	A	W1-8	18	24	FY		3.00								1		X									X		
NB	4.116	B	W1-8	18	24								1		X											ON 5-9-11 THIS SIGN WAS FOUND ON THE GROUND. ON 7-2-11 CONTRACTOR RE-ERECTED THIS SIGN. 2 PAY ITEMS FOR THIS WORK. FACES SB TRAFFIC.			
		B	W1-8	18	24	FY		3.00			I	I	I			1		X									X		
NB	4.132	A	W1-8	18	24								1		X														
		A	W1-8	18	24	FY		3.00								1		X									X		
NB	4.132	B	W1-8	18	24								1		X														
		B	W1-8	18	24	FY		3.00								1		X									FACES SB TRAFFIC X		
NB	4.145	A	W1-8	18	24								1		X														
		A	W1-8	18	24	FY		3.00								1		X									X		
NB	4.145	B	W1-8	18	24								1		X														
		B	W1-8	18	24	FY		3.00								1		X									FACES SB TRAFFIC X		
NB	4.210	B	W1-3R	30	30	FY		6.25								1		X									INSTALL 125 FEET SOUTH OF EXISTING ASSEMBLY X		
		B	W13-1	18	18	FY		2.25																			GATE-POSTED ASSEMBLIES SHOULD BE INSTALLED AT SAME MILE POINT X		
NB	4.232	B	W1-3R	30	30		RIGHT REVERSE CURVE						1		X														
		B	W13-1	18	18		20 MPH PLAQUE						1																
							SHEET TOTALS	26.50 SF	0.00 SF	0 EA	~~0~~ I EA	~~0~~ I EA	~~7~~ 8 EA	0 EA	0 EA	7 EA		105 FT										
							TOWN TOTALS	1058.3	0.0	40.0	13.0	13.0	220	0.0	0.0	193		2895.0										

SIGN SUMMARY SHEET

VERMONT AGENCY OF TRANSPORTATION

PROJECT NAME: **Stamford-Andover VT100**
PROJECT NUMBER: **STPG SIGN(20)**

FILE NAME: **Whitingham.xls**
PROJECT MANAGER: **N. Avery**
DESIGNED BY: **J. Kelly**
WHITINGHAM SHEET 7

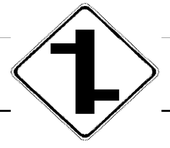
PLOT DATE: **8/5/2009**
DRAWN BY: **I. Shea**
CHECKED BY: **T. Guazzoni**
SHEET **43** OF **198**

DIRECTION	MILEPOINT	LOCATION CODE (SHEET 2)	SIGN CODE	WIDTH (IN)	HEIGHT (IN)	SHEETING REMARKS	SIGN LEGEND	NEW SIGNS "A"	NEW SIGNS "B"	EXISTING SIGNS RETAIN	EXISTING SIGNS SALVAGE FROM	EXISTING SIGNS SALVAGE TO	EXISTING SIGNS REMOVE	EXIST POST RETAIN	EXIST POST REMOVE	NUMBER OF NEW POSTS	SQUARE STEEL (IN) 1.75 (LB / FT) 1.88	SQUARE STEEL (IN) 2.00 (LB / FT) 2.42	SQUARE STEEL (IN) 2.50 (LB / FT) 3.35	FOUNDATION	TUBULAR STEEL Ø (IN) 3.00 (LB / FT) 7.60	TUBULAR STEEL Ø (IN) 3.50 (LB / FT) 9.00	TUBULAR STEEL Ø (IN) 4.00 (LB / FT) 10.80	TUBULAR STEEL Ø (IN) 5.00 (LB / FT) 14.60	SIGN FRAME REQUIRED	REMARKS	SIGN DETAIL: DETAIL IN SHS	SIGN DETAIL: DETAIL ON SHEET NUMBER	SIGN DETAIL: DETAIL ON STD SHEET NUMBER
WHITINGHAM VT 100							FY-FLUORESCENT YELLOW FYG-FLUORESCENT YELLOW GREEN																			"SHS"-STANDARD HIGHWAY SIGNS			
NB	4.270	A	OM-3R	12	36			3.00								1		X								INSTALL ON SOUTH SIDE OF LEDGE/CONCRETE OUTCROPPING	X		
NB	4.286	B	OM-3L	12	36		LEFT OBJECT MARKER						1		X														
NB	4.322	A	R2-1	24	30								1		X														
		A	R2-1	24	30			5.00								1		X									X		
NB	4.409	C	VR-017	24	30			5.00								1		X								TH-55, SADAWGA LAKE RD			E-141
NB	4.417	D	R1-1	30	30		BRIGHAM YOUNG MONUMENT →						1		X											TH-55, SADAWGA LAKE RD			
		D	R1-1	30	30		1000 1321 0441  SADAWGA LAKE RD	6.25			2	2				1		X							SALVAGED TWO STREET SIGNS ONTO NEW POSTS. ALSO MM.	X		
NB	4.600	A	R2-1	24	30								1		X														
		A	R2-1	24	30			5.00								1		X									X		
NB	4.757	A	W1-2R	30	30		RIGHT CURVE						1		X														
		A	W13-1	18	18		40 MPH PLAQUE 						1																
NB	4.780	A	W1-2R	30	30	FY		6.25								1		X								INSTALL 125 FEET NORTH OF EXISTING ASSEMBLY	X		
		A	W13-1	18	18	FY		2.25																			X		
NB	4.846	A	S3-1	30	30		SCHOOL BUS STOP AHEAD 						1		X														
NB	~~4.900~~ 4.906	A	W2-2MaR	30	30			6.25								2		X								INSTALL ~~285~~ 315 FEET NORTH OF EXISTING SCHOOL BUS STOP AHEAD		6		
SIGN SUMMARY SHEET							SHEET TOTALS	39.00 SF	0.00 SF	0 EA	~~2~~ 0 EA	~~2~~ 0 EA	7 EA	0 EA	0 EA	8 EA		120 FT										
VERMONT AGENCY OF TRANSPORTATION							TOWN TOTALS	1058.3	0.0	40.0	13.0	13.0	220	0.0	0.0	193		2895.0										

PROJECT NAME: **Stamford-Andover VT100**
PROJECT NUMBER: **STPG SIGN(20)**

FILE NAME: **Whitingham.xls**
PROJECT MANAGER: **N. Avery**
DESIGNED BY: **J. Kelly**
WHITINGHAM SHEET 8

PLOT DATE: **8/5/2009**
DRAWN BY: **I. Shea**
CHECKED BY: **T. Guazzoni**
SHEET **44** OF **198**

DIRECTION	MILEPOINT	LOCATION CODE (SHEET 2)	SIGN CODE	WIDTH (IN)	HEIGHT (IN)	SHEETING REMARKS	SIGN LEGEND	NEW SIGNS "A"	NEW SIGNS "B"	EXISTING SIGNS RETAIN	EXISTING SIGNS SALVAGE FROM	EXISTING SIGNS SALVAGE TO	EXISTING SIGNS REMOVE	EXIST POST RETAIN	EXIST POST REMOVE	NUMBER OF NEW POSTS	SQUARE STEEL (IN) 1.75 (LB / FT) 1.88	SQUARE STEEL (IN) 2.00 (LB / FT) 2.42	SQUARE STEEL (IN) 2.50 (LB / FT) 3.35	TUBULAR STEEL Ø (IN) FOUNDATION	TUBULAR STEEL Ø (IN) 3.00 (LB / FT) 7.60	TUBULAR STEEL Ø (IN) 3.50 (LB / FT) 9.00	TUBULAR STEEL Ø (IN) 4.00 (LB / FT) 10.80	TUBULAR STEEL Ø (IN) 5.00 (LB / FT) 14.60	SIGN FRAME REQUIRED	REMARKS	SIGN DETAIL: DETAIL IN SHS	SIGN DETAIL: DETAIL ON SHEET NUMBER	SIGN DETAIL: DETAIL ON STD SHEET NUMBER
WHITINGHAM VT 100							FY-FLUORESCENT YELLOW FYG-FLUORESCENT YELLOW GREEN																			"SHS"-STANDARD HIGHWAY SIGNS			
		A	S3-1	30	30			6.25																		X		
NB	4.976	C	VR-017	24	30								1		X														
		C	VR-017	24	30			5.00								1		X								PLUMB RD TH-59			E-141
NB	4.984	D	R1-1	30	30		 						1		X												SALVAGED STREET SIGN ONTO NEW POST. ALSO MM.			
		D	R1-1	30	30		1000 1321 0498	6.25								1		X								PLUMB RD TH-59	X		
NB	5.729	A	W2-1M	30	30		MODIFIED CROSSROADS 						1		X															
		A	W2-1Md	30	30			6.25								1		X										6
NB	5.788	A	W7-1	30	30		HILL SYMBOL						1		X															
		A	W1-4L	30	30		LEFT REVERSE CURVE						1																	
		A	W13-1	18	18		40 MPH PLAQUE 						1																	
		A	W7-1B	30	30			6.25								1		X									X		
		A	W7-3a	24	18			3.00																			X		
NB	5.792	C	VR-017	24	30								1		X															
		C	VR-017	24	30			5.00								1		X								TH-3, GOODNOW RD (SOUTH)			E-141
NB	5.802	D	R1-1	30	30								1		X															
							SHEET TOTALS	38.00	0.00	0	~~0~~	~~0~~	8	0	0	5		75											
								SF	SF	EA	EA	EA	EA	EA	EA	EA		FT											
							TOWN TOTALS	1058.3	0.0	40.0	13.0	13.0	220	0.0	0.0	193		2895.0											

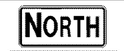
SIGN SUMMARY SHEET

VERMONT AGENCY OF TRANSPORTATION

PROJECT NAME: **Stamford-Andover VT100**
PROJECT NUMBER: **STPG SIGN(20)**

FILE NAME: **Whitingham.xls**
PROJECT MANAGER: **N. Avery**
DESIGNED BY: **J. Kelly**
WHITINGHAM SHEET 9

PLOT DATE: **8/5/2009**
DRAWN BY: **I. Shea**
CHECKED BY: **T. Guazzoni**
SHEET **45** OF **198**

DIRECTION	MILEPOINT	LOCATION CODE (SHEET 2)	SIGN CODE	WIDTH (IN)	HEIGHT (IN)	SHEETING REMARKS	SIGN LEGEND	NEW SIGNS "A"	NEW SIGNS "B"	EXISTING SIGNS RETAIN	EXISTING SIGNS SALVAGE FROM	EXISTING SIGNS SALVAGE TO	EXISTING SIGNS REMOVE	EXIST POST RETAIN	EXIST POST REMOVE	NUMBER OF NEW POSTS	SQUARE STEEL (IN) 1.75 (LB / FT) 1.88	SQUARE STEEL (IN) 2.00 (LB / FT) 2.42	SQUARE STEEL (IN) 2.50 (LB / FT) 3.35	TUBULAR STEEL Ø (IN) FOUNDATION	TUBULAR STEEL Ø (IN) 3.00 (LB / FT) 7.60	TUBULAR STEEL Ø (IN) 3.50 (LB / FT) 9.00	TUBULAR STEEL Ø (IN) 4.00 (LB / FT) 10.80	TUBULAR STEEL Ø (IN) 5.00 (LB / FT) 14.60	SIGN FRAME REQUIRED	REMARKS	SIGN DETAIL: DETAIL IN SHS	SIGN DETAIL: DETAIL ON SHEET NUMBER	SIGN DETAIL: DETAIL ON STD SHEET NUMBER
WHITINGHAM VT 100							FY-FLUORESCENT YELLOW FYG-FLUORESCENT YELLOW GREEN																			"SHS"-STANDARD HIGHWAY SIGNS			
NB	5.802	D	R1-1	30	30		 1000 1321 0580	6.25								1		X								SALVAGED MM ONTO NEW POST. TH-3, GOODNOW RD (SOUTH)	X		
NB	5.839	A	W1-4L	30	30			6.25								1		X								INSTALL MIDSPAN OF TH-3 LEGS	X		
NB	5.861	B	W1-6R	48	24			8.00								2		X								INSTALL NEXT TO LEGAL LOAD ASSEMBLY FACING SB TRAFFIC	X		
NB	5.861	C	VR-017	24	30								1		X														
		C	VR-017	24	30			5.00								1		X								TH-3, GOODNOW RD (NORTH)			E-141
		C	R2-1	24	30		TOWN'S SPEED LIMIT 30				1	1														INSTALL TOWN'S SPEED LIMIT 30 SIGN BELOW NEW LEGAL LOAD SIGN			
NB	5.877	D	R1-1	30	30								1		X											SALVAGED MM ONTO NEW POST.			
		D	R1-1	30	30		 1000 1321 0589	6.25								1		X								TH-3, GOODNOW RD (NORTH)	X		
NB	5.893	A	W1-8	18	24		CHEVRON						1		X														
		A	W1-6L	48	24			8.00								2		X									X		
NB	5.945	A	M3-1	24	12								1		X														
		A	M1-5A	24	24								1																
		A	M3-1	24	12			2.00								1		X								GREEN ON WHITE SHEETING	X		
		A	M1-5	30	24			5.00																				E-136B
NB	5.985	A	R2-1	24	30		SPEED LIMIT 50			~~1~~			~~1~~		X											SIGN NOT REMOVED PER R.E.			
							SHEET TOTALS	46.75	0.00	~~1~~ 0	1	1	~~6~~ 5	0	0	9		135											
								SF	SF	EA	EA	EA	EA	EA	EA	EA		FT										
							TOWN TOTALS	1058.3	0.0	40.0	13.0	13.0	220	0.0	0.0	193		2895.0										

SIGN SUMMARY SHEET

VERMONT AGENCY OF TRANSPORTATION

PROJECT NAME: **Stamford-Andover VT100**
PROJECT NUMBER: **STPG SIGN(20)**

FILE NAME: **Whitingham.xls**
PROJECT MANAGER: **N. Avery**
DESIGNED BY: **J. Kelly**
WHITINGHAM SHEET 10

PLOT DATE: **8/5/2009**
DRAWN BY: **I. Shea**
CHECKED BY: **T. Guazzoni**
SHEET **46** OF **198**

DIRECTION	MILEPOINT	LOCATION CODE (SHEET 2)	SIGN CODE	WIDTH (IN)	HEIGHT (IN)	SHEETING REMARKS	SIGN LEGEND	NEW SIGNS "A"	NEW SIGNS "B"	EXISTING SIGNS RETAIN	EXISTING SIGNS SALVAGE FROM	EXISTING SIGNS SALVAGE TO	EXISTING SIGNS REMOVE	EXIST POST RETAIN	EXIST POST REMOVE	NUMBER OF NEW POSTS	SQUARE STEEL (IN) 1.75 (LB / FT) 1.88	SQUARE STEEL (IN) 2.00 (LB / FT) 2.42	SQUARE STEEL (IN) 2.50 (LB / FT) 3.35	FOUNDATION	TUBULAR STEEL Ø (IN) 3.00 (LB / FT) 7.60	TUBULAR STEEL Ø (IN) 3.50 (LB / FT) 9.00	TUBULAR STEEL Ø (IN) 4.00 (LB / FT) 10.80	TUBULAR STEEL Ø (IN) 5.00 (LB / FT) 14.60	SIGN FRAME REQUIRED	REMARKS	SIGN DETAIL: DETAIL IN SHS	SIGN DETAIL: DETAIL ON SHEET NUMBER	SIGN DETAIL: DETAIL ON STD SHEET NUMBER
WHITINGHAM VT 100							FY-FLUORESCENT YELLOW FYG-FLUORESCENT YELLOW GREEN																			"SHS"-STANDARD HIGHWAY SIGNS			
NB	6.037	A	W1-4L	30	30		LEFT REVERSE CURVE						1		X														
NB	6.113	A	VW-054L	30	30		HIDDEN DRIVE LEFT						1		X														
NB	6.144	A	VW-054L	30	30			6.25								1		X							INSTALL 165 FEET NORTH OF EXISTING HIDDEN DRIVE LEFT SIGN LOCATION			E-154
NB	~~6.168~~ 6.182	A	W1-4L	30	30			6.25								1		X									125 INSTALL ~~200~~ FEET NORTH OF NEW HIDDEN DRIVE LEFT SIGN	X		
NB	6.269	A	W1-2R	30	30		RIGHT CURVE						1		X														
NB	6.291	A	S1-1YG	36	36		SCHOOL PENTAGON			1				X															
		A	W16-9YG	24	12		AHEAD			1																			
NB	6.381	C	VR-017	24	30								1		X														
		C	VR-017	24	30			5.00								1		X								TH-58, GINNY MORSE RD			E-141
		C	R2-1				SPEED LIMIT 30				1	1														REINSTALL TOWN'S SIGN BELOW NEW LEGAL LOAD SIGN			
NB	6.389	D	R1-1	30	30								1		X														
		D	R1-1	30	30			6.25								1		X								TH-58, GINNY MORSE RD	X		
NB	6.401	A	VW-202	30	30		TRUCKS ENTERING				1	1	1		X														
NB	6.429	A	VW-202	30	30			6.25								1		X							INSTALL 150 FEET NORTH OF EXISTING TRUCKS ENTERING SIGN ASSEMBLY			E-154
NB	6.535	A	OM-3R	12	36		RIGHT OBJECT MARKER						1		X														
SIGN SUMMARY SHEET							SHEET TOTALS	30.00 SF	0.00 SF	2 EA	~~2~~ 1 EA	~~2~~ 1 EA	7 EA	0 EA	0 EA	5 EA			75 FT									
VERMONT AGENCY OF TRANSPORTATION							TOWN TOTALS	1058.3	0.0	40.0	13.0	13.0	220	0.0	0.0	193			2895.0									

PROJECT NAME: **Stamford-Andover VT100**
PROJECT NUMBER: **STPG SIGN(20)**

FILE NAME: **Whitingham.xls** PLOT DATE: **8/5/2009**
PROJECT MANAGER: **N. Avery** DRAWN BY: **I. Shea**
DESIGNED BY: **J. Kelly** CHECKED BY: **T. Guazzoni**
WHITINGHAM SHEET 11 SHEET **47** OF **198**

DIRECTION	MILEPOINT	LOCATION CODE (SHEET 2)	SIGN CODE	WIDTH (IN)	HEIGHT (IN)	SHEETING REMARKS	SIGN LEGEND	NEW SIGNS "A"	NEW SIGNS "B"	EXISTING SIGNS RETAIN	EXISTING SIGNS SALVAGE FROM	EXISTING SIGNS SALVAGE TO	EXISTING SIGNS REMOVE	EXIST POST RETAIN	EXIST POST REMOVE	NUMBER OF NEW POSTS	SQUARE STEEL (IN) 1.75 (LB / FT) 1.88	SQUARE STEEL (IN) 2.00 (LB / FT) 2.42	SQUARE STEEL (IN) 2.50 (LB / FT) 3.35	FOUNDATION	TUBULAR STEEL Ø (IN) 3.00 (LB / FT) 7.60	TUBULAR STEEL Ø (IN) 3.50 (LB / FT) 9.00	TUBULAR STEEL Ø (IN) 4.00 (LB / FT) 10.80	TUBULAR STEEL Ø (IN) 5.00 (LB / FT) 14.60	SIGN FRAME REQUIRED	REMARKS	SIGN DETAIL: DETAIL IN SHS	SIGN DETAIL: DETAIL ON SHEET NUMBER	SIGN DETAIL: DETAIL ON STD SHEET NUMBER
WHITINGHAM VT 100							FY-FLUORESCENT YELLOW FYG-FLUORESCENT YELLOW GREEN																			"SHS"-STANDARD HIGHWAY SIGNS			
NB	6.540	B	OM-3L	12	36		LEFT OBJECT MARKER 						1		X														
NARROW BRIDGE SIGN SEE PAGE 70		A	W1-4R	30	30			6.25								1		X								INSTALL BEHIND RAIL BETWEEN BR #36 AND PARKING AREA	X		
NB	6.950	B	OM-3L	12	36		LEFT OBJECT MARKER			I			~~1~~		X											THIS SIGN WAS NOT REMOVED UNTIL LATE 2011, WHEN IT WAS REPLACED BY STATE FORCES.			
NB	6.955	A	VD-062B	72	16		BUSINESS SIGN			1				X															
NB	6.999	A	W3-5	36	36		SPEED REDUCTION (40)			1				X															
NB	7.060	A	W7-1B	36	36		HILL SYMBOL (11% GRADE)						1			X		2								INSTALL RELOCATED SIGNS 625 FEET SOUTH OF EXISTING AND SOUTH OF MOWED LAWN			
		A	W7-2B	24	18		TRUCKS USE LOWER GEAR						1													SALVAGE FROM MP 7.178			
		A	W7-3A	24	18		NEXT 1/2 MILE						1																
NB	7.111	C	VR-017	24	30								1		X														
		C	VR-017	24	30			5.00								1		X								TH-5, ALLARD RD			E-141
		C	R2-1				SPEED LIMIT 30					1	1													REINSTALL TOWN'S SPEED LIMIT SIGN BELOW NEW LEGAL LOAD SIGN			
NB	7.115	D	R1-1	30	30		 					I	I	1		X														
		D	R1-1	30	30		1000 1321 0711	6.25								1		X								TH-5, ALLARD RD	X		
NB	7.116	A	R2-1	30	36		SPEED LIMIT 40 			1				X															
NB	7.148	A	W1-5R	30	30	FY		6.25								1		X								INSTALL 170 FEET NORTH OF EXISTING SPEED LIMIT 40 SIGN AND BEHIND RAIL	X		
							SHEET TOTALS	23.75 SF	0.00 SF	~~4~~ 3 EA	~~2~~ 1 EA	~~5~~ 4 EA	~~3~~ 4 EA	0 EA	0 EA	4 EA		60 FT								
							TOWN TOTALS	1058.3	0.0	40.0	13.0	13.0	220	0.0	0.0	193		2895.0											

SIGN SUMMARY SHEET

VERMONT AGENCY OF TRANSPORTATION

PROJECT NAME: **Stamford-Andover VT100**
PROJECT NUMBER: **STPG SIGN(20)**

FILE NAME: **Whitingham.xls**
PROJECT MANAGER: **N. Avery**
DESIGNED BY: **J. Kelly**
WHITINGHAM SHEET 12

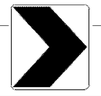
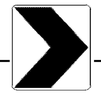
PLOT DATE: **8/5/2009**
DRAWN BY: **I. Shea**
CHECKED BY: **T. Guazzoni**
SHEET **48** OF **198**

DIRECTION	MILEPOINT	LOCATION CODE (SHEET 2)	SIGN CODE	WIDTH (IN)	HEIGHT (IN)	SHEETING REMARKS	SIGN LEGEND	NEW SIGNS "A"	NEW SIGNS "B"	EXISTING SIGNS RETAIN	EXISTING SIGNS SALVAGE FROM	EXISTING SIGNS SALVAGE TO	EXISTING SIGNS REMOVE	EXIST POST RETAIN	EXIST POST REMOVE	NUMBER OF NEW POSTS	SQUARE STEEL (IN) 1.75 (LB / FT) 1.88	SQUARE STEEL (IN) 2.00 (LB / FT) 2.42	SQUARE STEEL (IN) 2.50 (LB / FT) 3.35	FOUNDATION	TUBULAR STEEL Ø (IN) 3.00 (LB / FT) 7.60	TUBULAR STEEL Ø (IN) 3.50 (LB / FT) 9.00	TUBULAR STEEL Ø (IN) 4.00 (LB / FT) 10.80	TUBULAR STEEL Ø (IN) 5.00 (LB / FT) 14.60	SIGN FRAME REQUIRED	REMARKS	SIGN DETAIL: DETAIL IN SHS	SIGN DETAIL: DETAIL ON SHEET NUMBER	SIGN DETAIL: DETAIL ON STD SHEET NUMBER
WHITINGHAM			**VT 100**				FY-FLUORESCENT YELLOW FYG-FLUORESCENT YELLOW GREEN																			"SHS"-STANDARD HIGHWAY SIGNS			
		A	W7-3A	24	18	FY		3.00																			X		
NB	7.178	A	W7-1B	36	36		HILL SYMBOL (11% GRADE)				1				X											RELOCATE SIGNS 625 FEET SOUTH AND INSTALL ON NEW POSTS			
		A	W7-2B	24	18		TRUCKS USE LOWER GEAR				1															SALVAGE TO MP 7.060			
		A	W7-3A	24	18		NEXT 1/2 MILE				1																		
NB	7.249	A	W1-2R	30	30		RIGHT CURVE						1		X														
NB	7.288	A	W3-5	36	36		SPEED REDUCTION (30)			1				X															
NB	7.319	A	VW-054R	30	30		HIDDEN DRIVE RIGHT				1	1			X	1		X								REINSTALL SIGN ON NEW POST			
NB	7.353	A	VD-018	30	18								1		X														
		A	VD-018	30	18			3.75								1		X										E-128A
NB	7.408	A	R2-1	24	30		SPEED LIMIT 30						1		X														
		A	VR-020	24	30		NO PARKING ON TRAVELED LANE 						1															
NB	7.414	A	R2-1	30	36			7.50								1		X								INSTALL 30 FEET NORTH OF EXISTING SPEED LIMIT 30 SIGN ASSEMBLY.		6	
NB	7.448	A	VR-020	24	30		NO PARKING ON TRAVELED LANE						1		X														
NB	7.459	A	W1-8	18	24								1		X														
		A	W1-8	18	24	FY		3.00								1		X									X		
							SHEET TOTALS	17.25 SF	0.00 SF	1 EA	4 EA	1 EA	6 EA	0 EA	0 EA	4 EA		60 FT											
							TOWN TOTALS	1058.3	0.0	40.0	13.0	13.0	220	0.0	0.0	193		2895.0											

SIGN SUMMARY SHEET

VERMONT AGENCY OF TRANSPORTATION

PROJECT NAME: **Stamford-Andover VT100**
PROJECT NUMBER: **STPG SIGN(20)**
FILE NAME: **Whitingham.xls**
PROJECT MANAGER: **N. Avery**
DESIGNED BY: **J. Kelly**
WHITINGHAM SHEET 13
PLOT DATE: **8/5/2009**
DRAWN BY: **I. Shea**
CHECKED BY: **T. Guazzoni**
SHEET **49** OF **198**

DIRECTION	MILEPOINT	LOCATION CODE (SHEET 2)	SIGN CODE	WIDTH (IN)	HEIGHT (IN)	SHEETING REMARKS	SIGN LEGEND	NEW SIGNS "A"	NEW SIGNS "B"	EXISTING SIGNS RETAIN	EXISTING SIGNS SALVAGE FROM	EXISTING SIGNS SALVAGE TO	EXISTING SIGNS REMOVE	EXIST POST RETAIN	EXIST POST REMOVE	NUMBER OF NEW POSTS	SQUARE STEEL (IN) 1.75 (LB / FT) 1.88	SQUARE STEEL (IN) 2.00 (LB / FT) 2.42	SQUARE STEEL (IN) 2.50 (LB / FT) 3.35	TUBULAR STEEL Ø (IN) FOUNDATION	TUBULAR STEEL Ø (IN) 3.00 (LB / FT) 7.60	TUBULAR STEEL Ø (IN) 3.50 (LB / FT) 9.00	TUBULAR STEEL Ø (IN) 4.00 (LB / FT) 10.80	TUBULAR STEEL Ø (IN) 5.00 (LB / FT) 14.60	SIGN FRAME REQUIRED	REMARKS	SIGN DETAIL: DETAIL IN SHS	SIGN DETAIL: DETAIL ON SHEET NUMBER	SIGN DETAIL: DETAIL ON STD SHEET NUMBER
WHITINGHAM VT 100							FY-FLUORESCENT YELLOW FYG-FLUORESCENT YELLOW GREEN																			"SHS"-STANDARD HIGHWAY SIGNS			
NB	7.459	B	W1-8	18	24								1		X													
		B	W1-8	18	24	FY		3.00								1		X								FACES SB TRAFFIC	X	
NB	7.473	A	W1-8	18	24								1		X													
		A	W1-8	18	24	FY		3.00								1		X									X	
NB	7.473	B	W1-8	18	24								1		X													
		B	W1-8	18	24	FY		3.00								1		X								FACES SB TRAFFIC	X	
NB	7.493	A	W1-8	18	24								1		X													
		A	W1-8	18	24	FY		3.00								1		X									X	
NB	7.493	B	W1-8	18	24								1		X													
		B	W1-8	18	24	FY		3.00								1		X								FACES SB TRAFFIC	X	
NB	7.503	A	M2-1	21	15								1		X													
		A	M1-5A	30	24								1															
		A	M2-1	21	15		JCT VERMONT 112	2.19								1		X								GREEN ON WHITE SHEETING	X	
		A	M1-5	30	24			5.00																				E-136B
NB	7.519	A	D1-1M	72	10		UP ARROW WILMINGTON 7						1		X													
							SHEET TOTALS	22.19 SF	0.00 SF	0 EA	0 EA	0 EA	8 EA	0 EA	0 EA	6 EA		90 FT										
							TOWN TOTALS	1058.3	0.0	40.0	13.0	13.0	220	0.0	0.0	193		2895.0										

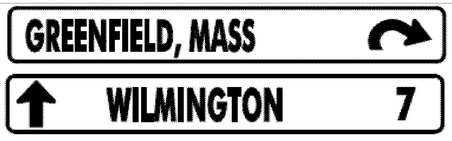
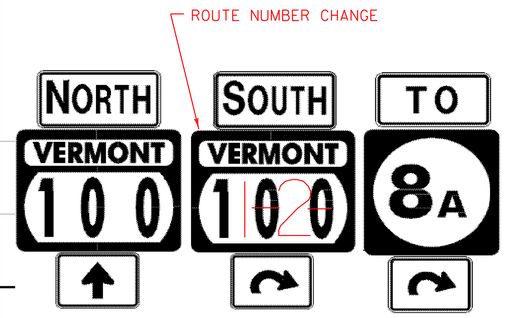
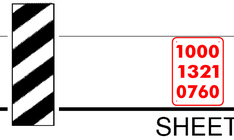
SIGN SUMMARY SHEET

VERMONT AGENCY OF TRANSPORTATION

PROJECT NAME: **Stamford-Andover VT100**
PROJECT NUMBER: **STPG SIGN(20)**

FILE NAME: **Whitingham.xls**
PROJECT MANAGER: **N. Avery**
DESIGNED BY: **J. Kelly**
WHITINGHAM SHEET 14

PLOT DATE: **8/5/2009**
DRAWN BY: **I. Shea**
CHECKED BY: **T. Guazzoni**
SHEET **50** OF **198**

DIRECTION	MILEPOINT	LOCATION CODE (SHEET 2)	SIGN CODE	WIDTH (IN)	HEIGHT (IN)	SHEETING REMARKS	SIGN LEGEND	NEW SIGNS "A"	NEW SIGNS "B"	EXISTING SIGNS RETAIN	EXISTING SIGNS SALVAGE FROM	EXISTING SIGNS SALVAGE TO	EXISTING SIGNS REMOVE	EXIST POST RETAIN	EXIST POST REMOVE	NUMBER OF NEW POSTS	SQUARE STEEL (IN) 1.75 (LB / FT) 1.88	SQUARE STEEL (IN) 2.00 (LB / FT) 2.42	SQUARE STEEL (IN) 2.50 (LB / FT) 3.35	TUBULAR STEEL Ø (IN) FOUNDATION	TUBULAR STEEL Ø (IN) 3.00 (LB / FT) 7.60	TUBULAR STEEL Ø (IN) 3.50 (LB / FT) 9.00	TUBULAR STEEL Ø (IN) 4.00 (LB / FT) 10.80	TUBULAR STEEL Ø (IN) 5.00 (LB / FT) 14.60	SIGN FRAME REQUIRED	REMARKS	SIGN DETAIL: DETAIL IN SHS	SIGN DETAIL: DETAIL ON SHEET NUMBER	SIGN DETAIL: DETAIL ON STD SHEET NUMBER
WHITINGHAM VT 100							FY-FLUORESCENT YELLOW FYG-FLUORESCENT YELLOW GREEN																			"SHS"-STANDARD HIGHWAY SIGNS			
		A	D1-1A	72	10		GREENFIELD MASS 26 MODIFIED RIGHT ARROW						1																
NB	7.553	A	VR-020	24	30		NO PARKING ON TRAVELED LANE						1		X														
		A	D2-1	72	12			6.00								2		X								5	
		A	D1-1A	72	12			6.00																				5	
NB	7.598	A	M3-1	24	12			2.00								2			X							#3B	INSTALL ON SOUTH SIDE OF UTILTY POLE AT BEGINNING OF RETAINING WALL. GREEN ON WHITE SHEETING	X	7	
		A	M1-5	30	24			5.00																					E-136B
		A	M6-3	21	15			2.19																			GREEN ON WHITE SHEETING	X		
		A	M3-3	24	12			2.00																			GREEN ON WHITE SHEETING	X		
		A	M1-5	30	24			5.00																					E-136B
		A	VM-013R	21	15			2.19																	GREEN ON WHITE SHEETING		6	
		A	M4-5	24	12			2.00																			BLACK ON WHITE SHEETING	X		
		A	M1-6	24	24			4.00																					E-136C
		A	VM-013R	21	15			2.19																			BLACK ON WHITE SHEETING		6	
NB	7.604	A	OM-3R	12	36								1		X														
		A	OM-3R	12	36			3.00								1		X								INSTALL AT EDGE OF PAVEMENT IN FRONT OF RETAINING WALL	X		
							SHEET TOTALS	41.57 SF	0.00 SF	0 EA	0 EA	0 EA	3 EA	0 EA	0 EA	5 EA		75 FT								
							TOWN TOTALS	1058.3	0.0	40.0	13.0	13.0	220	0.0	0.0	193		2895.0								

SIGN SUMMARY SHEET

VERMONT AGENCY OF TRANSPORTATION

PROJECT NAME: **Stamford-Andover VT100**
PROJECT NUMBER: **STPG SIGN(20)**

FILE NAME: **Whitingham.xls**
PROJECT MANAGER: **N. Avery**
DESIGNED BY: **J. Kelly**
WHITINGHAM SHEET 15

PLOT DATE: **8/5/2009**
DRAWN BY: **I. Shea**
CHECKED BY: **T. Guazzoni**
SHEET **51** OF **198**

DIRECTION	MILEPOINT	LOCATION CODE (SHEET 2)	SIGN CODE	WIDTH (IN)	HEIGHT (IN)	SHEETING REMARKS	SIGN LEGEND	NEW SIGNS "A"	NEW SIGNS "B"	EXISTING SIGNS RETAIN	EXISTING SIGNS SALVAGE FROM	EXISTING SIGNS SALVAGE TO	EXISTING SIGNS REMOVE	EXIST POST RETAIN	EXIST POST REMOVE	NUMBER OF NEW POSTS	SQUARE STEEL (IN) (LB / FT) 1.75 / 1.88	SQUARE STEEL (IN) (LB / FT) 2.00 / 2.42	SQUARE STEEL (IN) (LB / FT) 2.50 / 3.35	TUBULAR STEEL Ø (IN) FOUNDATION	TUBULAR STEEL Ø (IN) (LB / FT) 3.00 / 7.60	TUBULAR STEEL Ø (IN) (LB / FT) 3.50 / 9.00	TUBULAR STEEL Ø (IN) (LB / FT) 4.00 / 10.80	TUBULAR STEEL Ø (IN) (LB / FT) 5.00 / 14.60	SIGN FRAME REQUIRED	REMARKS	SIGN DETAIL: DETAIL IN SHS	SIGN DETAIL: DETAIL ON SHEET NUMBER	SIGN DETAIL: DETAIL ON STD SHEET NUMBER
WHITINGHAM VT 100							FY-FLUORESCENT YELLOW FYG-FLUORESCENT YELLOW GREEN																			"SHS"-STANDARD HIGHWAY SIGNS			
NB	7.685	A	M3-1	24	12								1		X													
		A	M1-5A	30	24								1															
		A	M6-1	21	15								1															
		A	M3-1	24	12			2.00								1		X							GREEN ON WHITE SHEETING	X		
		A	M1-5	30	24			5.00																				E-136B
2 NEW SIGNS SEE PAGE 70		A	M6-1L	21	15			2.19																			GREEN ON WHITE SHEETING	X		
NB	7.685	B	W1-6	48	24								1		X													
		B	W1-6	48	24			8.00								2		X							FACES SB TRAFFIC	X		
NB	7.686	C	VR-017	24	30								1		X															
		C	VR-017	24	30			5.00								1		X							GATES POND TH-41, ~~MILL HILL~~ RD			E-141
		C	R2-1	24	30		SPEED LIMIT 30 - TOWN SIGN				1	1													INSTALL TOWN'S SPEED LIMIT 30 SIGN BELOW NEW LEGAL LOAD			
NB	7.693	D	R1-1	30	30								1		X											GATES POND TH-41, ~~MILL HILL~~ RD			
		D	R1-1	30	30			6.25								1		X										
NB	7.719	A	R2-1	24	30		SPEED LIMIT 30			1				X														
		A	VR-020	24	30		NO PARKING ON TRAVELED LANE			1																		
SIGN SUMMARY SHEET							SHEET TOTALS	28.44 SF	0.00 SF	2 EA	1 EA	1 EA	6 EA	0 EA	0 EA	5 EA		75 FT									
VERMONT AGENCY OF TRANSPORTATION							TOWN TOTALS	1058.3	0.0	40.0	13.0	13.0	220	0.0	0.0	193		2895.0									

PROJECT NAME: **Stamford-Andover VT100**
PROJECT NUMBER: **STPG SIGN(20)**
FILE NAME: **Whitingham.xls**
PROJECT MANAGER: **N. Averv**
DESIGNED BY: **J. Kelly**
WHITINGHAM SHEET 16
PLOT DATE: **8/5/2009**
DRAWN BY: **I. Shea**
CHECKED BY: **T. Guazzoni**
SHEET **52** OF **198**

DIRECTION	MILEPOINT	LOCATION CODE (SHEET 2)	SIGN CODE	WIDTH (IN)	HEIGHT (IN)	SHEETING REMARKS	SIGN LEGEND	NEW SIGNS "A"	NEW SIGNS "B"	EXISTING SIGNS RETAIN	EXISTING SIGNS SALVAGE FROM	EXISTING SIGNS SALVAGE TO	EXISTING SIGNS REMOVE	EXIST POST RETAIN	EXIST POST REMOVE	NUMBER OF NEW POSTS	SQUARE STEEL (IN) (LB / FT) 1.75 / 1.88	SQUARE STEEL (IN) (LB / FT) 2.00 / 2.42	SQUARE STEEL (IN) (LB / FT) 2.50 / 3.35	TUBULAR STEEL Ø (IN) FOUNDATION	TUBULAR STEEL Ø (IN) (LB / FT) 3.00 / 7.60	TUBULAR STEEL Ø (IN) (LB / FT) 3.50 / 9.00	TUBULAR STEEL Ø (IN) (LB / FT) 4.00 / 10.80	TUBULAR STEEL Ø (IN) (LB / FT) 5.00 / 14.60	SIGN FRAME REQUIRED	REMARKS	SIGN DETAIL: DETAIL IN SHS	SIGN DETAIL: DETAIL ON SHEET NUMBER	SIGN DETAIL: DETAIL ON STD SHEET NUMBER
WHITINGHAM			**VT 100**				FY-FLUORESCENT YELLOW FYG-FLUORESCENT YELLOW GREEN																			"SHS"-STANDARD HIGHWAY SIGNS			
NB	7.751	A	W11-8	30	30								1		X													
		A	W11-8	30	30			6.25								1		X									X	
NB	7.832	A	M3-1S	24	12		NORTH			~~1~~				~~X~~	X												THE OLD POST WAS DAMAGED. SO IT WAS REPLACED. SIGNS WERE SALVAGED ONTO THE NEW POST. PAY FOR REMOVALS ALSO.			
		A	M1-5	30	24		VERMONT 100			~~1~~																		
NB	7.890	A	R2-1	24	30			5.00								1		X									INSTALL 130 FEET SOUTH OF EXISTING SPEED LIMIT 40, BEHIND BEGINNING OF RAIL	X		
NB	7.915	A	R2-1	24	30		SPEED LIMIT 40						1		X													
NB	7.933	A	D2-1	72	12			6.00								1		X									INSTALL 150 FEET SOUTH OF EXISTING DESTINATION BOARD		5	
NB	7.961	A	D2-1	72	10		WILMINGTON 7						1		X													
NB	8.065	A	W1-4L	30	30		LEFT REVERSE CURVE						1		X													
NB	8.151	A	R2-1	24	30		SPEED LIMIT 50						1		X													
NB	8.180	A	R2-1	24	30			5.00								1		X									INSTALL 180 FEET NORTH OF EXISTING SPEED LIMIT 50 SIGN	X		
NB	8.892	C	VR-017	24	30		 						1		X															
		C	VR-017	24	30			5.00			~~1~~	~~1~~				1		X									TH-21, BIRDVILLE RD			E-141
NB	8.898	D	R1-1	30	30		 						1		X															
		D	R1-1	30	30			6.25			~~1~~	~~1~~				1		X									TH-21, BIRDVILLE RD	X		
SIGN SUMMARY SHEET							SHEET TOTALS	33.50	0.00	~~0~~ 2	~~4~~ 0	~~4~~ 0	~~9~~ 7	0	0	6		90										
								SF	SF	EA	EA	EA	EA	EA	EA	EA		FT										
VERMONT AGENCY OF TRANSPORTATION							TOWN TOTALS	1058.3	0.0	40.0	13.0	13.0	220	0.0	0.0	193		2895.0										

PROJECT NAME: **Stamford-Andover VT100**
PROJECT NUMBER: **STPG SIGN(20)**

FILE NAME: **Whitingham.xls**
PROJECT MANAGER: **N. Avery**
DESIGNED BY: **J. Kelly**
WHITINGHAM SHEET 17

PLOT DATE: **8/5/2009**
DRAWN BY: **I. Shea**
CHECKED BY: **T. Guazzoni**
SHEET **53** OF **198**

DIRECTION	MILEPOINT	LOCATION CODE (SHEET 2)	SIGN CODE	WIDTH (IN)	HEIGHT (IN)	SHEETING REMARKS	SIGN LEGEND	NEW SIGNS "A"	NEW SIGNS "B"	EXISTING SIGNS RETAIN	EXISTING SIGNS SALVAGE FROM	EXISTING SIGNS SALVAGE TO	EXISTING SIGNS REMOVE	EXIST POST RETAIN	EXIST POST REMOVE	NUMBER OF NEW POSTS	SQUARE STEEL (IN) 1.75 (LB/FT) 1.88	SQUARE STEEL (IN) 2.00 (LB/FT) 2.42	SQUARE STEEL (IN) 2.50 (LB/FT) 3.35	TUBULAR STEEL Ø (IN) FOUNDATION	TUBULAR STEEL Ø (IN) 3.00 (LB/FT) 7.60	TUBULAR STEEL Ø (IN) 3.50 (LB/FT) 9.00	TUBULAR STEEL Ø (IN) 4.00 (LB/FT) 10.80	TUBULAR STEEL Ø (IN) 5.00 (LB/FT) 14.60	SIGN FRAME REQUIRED	REMARKS	SIGN DETAIL: DETAIL IN SHS	SIGN DETAIL: DETAIL ON SHEET NUMBER	SIGN DETAIL: DETAIL ON STD SHEET NUMBER
WHITINGHAM VT 100							FY-FLUORESCENT YELLOW FYG-FLUORESCENT YELLOW GREEN																			"SHS"-STANDARD HIGHWAY SIGNS			
NB	9.410	A	W2-2MaL	30	30			6.25								1		X								INSTALL 400 FEET SOUTH OF TH-3 INTERSECTION.		6	
NB	10.353	A	VW-054R	30	30		HIDDEN DRIVE RIGHT						1		X														
		A	S3-1	30	30		SCHOOL BUS STOP AHEAD						1																
NB	10.397	A	VW-054R	30	30			6.25			•					1		X		• SEE NOTE FOR TOWN LINE ON SHEET 7I					INSTALL DIRECTLY ACROSS FROM FULLER HILL ROAD, 235 FEET NORTH OF EXISTING			E-154
SB	10.570	F	W1-2L	30	30		LEFT CURVE						1		X														
		F	W13-1	18	18		40 MPH PLAQUE						1																
SB	10.505	F	W1-2MhL	30	30			6.25								1		X								INSTALL ACROSS FROM DRIVE, 350 FEET SOUTH OF EXISTING		6	
		F	W13-1	18	18		LEGAL LOAD LIMIT 24,000 POUNDS 40 M.P.H.	2.25																		X		
SB	10.400	G	VR-017	24	30			5.00								1		X								TH-18, FULLER HILL RD			E-141
SB	10.394	H	R1-1	24	24								1		X											TH-18, FULLER HILL RD			
		H	R1-1	30	30		STOP	6.25								1		X									X		
SB	9.580	F	W2-2R	30	30								1		X														
		F	W2-2MaR	30	30		LEGAL LOAD LIMIT 24,000 POUNDS SPEED ZONE AHEAD	6.25								1		X										6	
SB	9.496	G	VR-017	24	30			5.00								1		X								SPEED ZONE SIGN SALVAGED ONTO THE NEW POST. TH-3, WILMINGTON CROSS RD			E-141
SB	9.489	H	R1-1	30	30								1		X											TH-3, WILMINGTON CROSS RD			
							SHEET TOTALS	43.50 SF	0.00 SF	0 EA	2 0 EA	2 0 EA	9 7 EA	0 EA	0 EA	7 EA		105 FT								
							TOWN TOTALS	1058.3 SF	0.0 SF	40.0 EA	13.0 EA	13.0 EA	220 EA	0.0 EA	0.0 EA	193 EA		2895.0 FT								

SIGN SUMMARY SHEET

VERMONT AGENCY OF TRANSPORTATION

PROJECT NAME: **Stamford-Andover VT100**
PROJECT NUMBER: **STPG SIGN(20)**

FILE NAME: **Whitingham.xls**
PROJECT MANAGER: **N. Avery**
DESIGNED BY: **J. Kelly**
WHITINGHAM SHEET 18

PLOT DATE: **8/5/2009**
DRAWN BY: **I. Shea**
CHECKED BY: **T. Guazzoni**
SHEET **54** OF **198**

DIRECTION	MILEPOINT	LOCATION CODE (SHEET 2)	SIGN CODE	WIDTH (IN)	HEIGHT (IN)	SHEETING REMARKS	SIGN LEGEND	NEW SIGNS "A"	NEW SIGNS "B"	EXISTING SIGNS RETAIN	EXISTING SIGNS SALVAGE FROM	EXISTING SIGNS SALVAGE TO	EXISTING SIGNS REMOVE	EXIST POST RETAIN	EXIST POST REMOVE	NUMBER OF NEW POSTS	SQUARE STEEL (IN) 1.75 (LB / FT) 1.88	SQUARE STEEL (IN) 2.00 (LB / FT) 2.42	SQUARE STEEL (IN) 2.50 (LB / FT) 3.35	TUBULAR STEEL Ø (IN) FOUNDATION	TUBULAR STEEL Ø (IN) 3.00 (LB / FT) 7.60	TUBULAR STEEL Ø (IN) 3.50 (LB / FT) 9.00	TUBULAR STEEL Ø (IN) 4.00 (LB / FT) 10.80	TUBULAR STEEL Ø (IN) 5.00 (LB / FT) 14.60	SIGN FRAME REQUIRED	REMARKS	SIGN DETAIL: DETAIL IN SHS	SIGN DETAIL: DETAIL ON SHEET NUMBER	SIGN DETAIL: DETAIL ON STD SHEET NUMBER
WHITINGHAM VT 100							FY-FLUORESCENT YELLOW FYG-FLUORESCENT YELLOW GREEN																			"SHS"-STANDARD HIGHWAY SIGNS			
SB	9.489	H	R1-1	30	30		 1000 1321 0949	6.25							X	1		X									X		
SB	9.374	F	N/A				EMPTY POST								X														
SB	9.005	F	W2-1M	30	30								1		X														
		F	W2-1Mb	30	30			6.25								1		X										6	
SB	8.898	G	VR-017	24	30								1		X											TH-31, FOWLER RD			
		G	VR-017	24	30			5.00								1		X											E-141
SB	8.892	H	R1-1	30	30		FOWLER RD						1		X											TH-31, FOWLER RD			
		H	R1-1	30	30			6.25								1		X									X		
SB	8.460	F	W1-4L	30	30		LEFT REVERSE CURVE						1		X														
SB	8.393	F	W1-4L	30	30			6.25								1		X									INSTALL 200 FEET SOUTH OF EXISTING REVERSE CURVE SIGN	X		
		F	W13-1	18	18			2.25																			MAINTAIN 10 FEET TO UTILITY POLE	X		
SB	8.350	F	W1-8	24	30		CHEVRON			1				X															
SB	8.330	F	W1-8	24	30		CHEVRON			1				X															
SB	8.305	F	W3-5	36	36		SPEED REDUCTION (40) 			1				X															
SB	8.180	F	R2-1	30	36			7.50								1		X									INSTALL ACROSS FROM NEW NB SPEED LIMIT 50		6	
							SHEET TOTALS	39.75 SF	0.00 SF	3 EA	~~0~~ EA	~~0~~ EA	4 EA	0 EA	0 EA	6 EA		90 FT								
							TOWN TOTALS	1058.3	0.0	40.0	13.0	13.0	220	0.0	0.0	193		2895.0											

SIGN SUMMARY SHEET

VERMONT AGENCY OF TRANSPORTATION

PROJECT NAME: **Stamford-Andover VT100**
PROJECT NUMBER: **STPG SIGN(20)**

FILE NAME: **Whitingham.xls**
PROJECT MANAGER: **N. Avery**
DESIGNED BY: **J. Kelly**
WHITINGHAM SHEET 19

PLOT DATE: **8/5/2009**
DRAWN BY: **I. Shea**
CHECKED BY: **T. Guazzoni**
SHEET **55** OF **198**

DIRECTION	MILEPOINT	LOCATION CODE (SHEET 2)	SIGN CODE	WIDTH (IN)	HEIGHT (IN)	SHEETING REMARKS	SIGN LEGEND	NEW SIGNS "A"	NEW SIGNS "B"	EXISTING SIGNS RETAIN	EXISTING SIGNS SALVAGE FROM	EXISTING SIGNS SALVAGE TO	EXISTING SIGNS REMOVE	EXIST POST RETAIN	EXIST POST REMOVE	NUMBER OF NEW POSTS	SQUARE STEEL (IN) (LB / FT) 1.75 1.88	SQUARE STEEL (IN) (LB / FT) 2.00 2.42	SQUARE STEEL (IN) (LB / FT) 2.50 3.35	FOUNDATION	TUBULAR STEEL Ø (IN) (LB / FT) 3.00 7.60	TUBULAR STEEL Ø (IN) (LB / FT) 3.50 9.00	TUBULAR STEEL Ø (IN) (LB / FT) 4.00 10.80	TUBULAR STEEL Ø (IN) (LB / FT) 5.00 14.60	SIGN FRAME REQUIRED	REMARKS	SIGN DETAIL: DETAIL IN SHS	SIGN DETAIL: DETAIL ON SHEET NUMBER	SIGN DETAIL: DETAIL ON STD SHEET NUMBER
WHITINGHAM VT 100							FY-FLUORESCENT YELLOW FYG-FLUORESCENT YELLOW GREEN																			"SHS"-STANDARD HIGHWAY SIGNS			
SB	8.150	F	R2-1	24	30		SPEED LIMIT 40						1		X														
SB	8.040	F	VD-062B	72	16		BUSINESS SIGN			1																			
		F	VD-062B	72	16		BUSINESS SIGN			1				X															
SB	8.000	F	W3-5	36	36		SPEED REDUCTION (30)			1				X															
SB	7.980	F	VD-018	30	18								1		X														
		F	VD-018	30	18			3.75								1		X										E-128A
SB	7.960	F	W11-8	30	30								1		X														
		F	W11-8	30	30			6.25								1		X									X	
SB	7.910	F	R2-1	24	30		SPEED LIMIT 30						1		X														
		F	W11-2YG	30	30		PEDESTRIAN					1				1		X								RELOCATE FROM M.P. 7.88 AND INSTALL ON NEW POST			
		F	W7-3AFY	24	18		NEXT 1/4 MILE					1																	
SB	7.890	F	R2-1	30	36			7.50								1		X								INSTALL 100+ FEET SOUTH AND ACROSS FROM NEW NB SPEED LIMIT 40 SIGN		6	
SB	7.880	F	W11-2YG	30	30		PEDESTRIAN				1															RELOCATED TO MP 7.91 AND INSTALL ON NEW POST			
		F	W7-3AFY	24	18		NEXT 1/4 MILE				1																		
SB	7.810	F	D4-2	30	36		PARK & RIDE SYMBOL			1				X															
							SHEET TOTALS	17.50 SF	0.00 SF	4 EA	2 EA	2 EA	4 EA	0 EA	0 EA	4 EA		60 FT											
							TOWN TOTALS	1058.3	0.0	40.0	13.0	13.0	220	0.0	0.0	193		2895.0											

SIGN SUMMARY SHEET

VERMONT AGENCY OF TRANSPORTATION

PROJECT NAME: **Stamford-Andover VT100**
PROJECT NUMBER: **STPG SIGN(20)**

FILE NAME: **Whitingham.xls**
PROJECT MANAGER: **N. Avery**
DESIGNED BY: **J. Kelly**
WHITINGHAM SHEET 20

PLOT DATE: **8/5/2009**
DRAWN BY: **I. Shea**
CHECKED BY: **T. Guazzoni**

DIRECTION	MILEPOINT	LOCATION CODE (SHEET 2)	SIGN CODE	WIDTH (IN)	HEIGHT (IN)	SHEETING REMARKS	SIGN LEGEND	NEW SIGNS "A"	NEW SIGNS "B"	EXISTING SIGNS RETAIN	EXISTING SIGNS SALVAGE FROM	EXISTING SIGNS SALVAGE TO	EXISTING SIGNS REMOVE	EXIST POST RETAIN	EXIST POST REMOVE	NUMBER OF NEW POSTS	SQUARE STEEL (IN) 1.75 (LB / FT) 1.88	SQUARE STEEL (IN) 2.00 (LB / FT) 2.42	SQUARE STEEL (IN) 2.50 (LB / FT) 3.35	TUBULAR STEEL Ø (IN) FOUNDATION	TUBULAR STEEL Ø (IN) 3.00 (LB / FT) 7.60	TUBULAR STEEL Ø (IN) 3.50 (LB / FT) 9.00	TUBULAR STEEL Ø (IN) 4.00 (LB / FT) 10.80	TUBULAR STEEL Ø (IN) 5.00 (LB / FT) 14.60	SIGN FRAME REQUIRED	REMARKS	SIGN DETAIL: DETAIL IN SHS	SIGN DETAIL: DETAIL ON SHEET NUMBER	SIGN DETAIL: DETAIL ON STD SHEET NUMBER
WHITINGHAM VT 100							FY-FLUORESCENT YELLOW FYG-FLUORESCENT YELLOW GREEN																			"SHS"-STANDARD HIGHWAY SIGNS			
		F	VD-365	30	6		PARK & RIDE PHONE NUMBER						1																
SB	7.770	F	M2-1S	21	15								1		X														
		F	M1-5	30	24								1																
		F	M2-1	21	15			2.19								1			X						GREEN ON WHITE SHEETING	X		
		F	M1-5	30	24			5.00																				E-136B
		E	D4-2	30	36		PARK & RIDE SYMBOL				1	1															REINSTALL PARK AND RIDE SIGNS ON BACK SIDE OF JCT VERMONT 112			
		E	VD-365	30	6		PARK & RIDE PHONE NUMBER						1																
SB	7.740	F	W1-1R	30	30								1		X														
		F	W13-1	18	18								1		X														
		F	W1-1R	30	30			6.25								1		X							X	
		F	W13-1	18	18			2.25																			X	
SB	7.648	F	D1-1A	72	10								1		X														
		F	D1-1A	72	10								1																
		F	D1-1M	72	10								1																
		F	N/A				~~BRIGHAM YOUNG DESTINATION BOARD~~						~~1~~ 9														SIGN ALREADY REMOVED PRIOR TO PROJECT. ~~ILLEGAL TOWN SIGN. RETURN TO TOWN~~			
							SHEET TOTALS	15.69 SF	0.00 SF	0 EA	1 EA	1 EA	~~10~~ EA	0 EA	0 EA	2 EA	30 FT											
							TOWN TOTALS	1058.3	0.0	40.0	13.0	13.0	220	0.0	0.0	193	2895.0											

SIGN SUMMARY SHEET

VERMONT AGENCY OF TRANSPORTATION

PROJECT NAME: **Stamford-Andover VT100**
PROJECT NUMBER: **STPG SIGN(20)**

FILE NAME: **Whitingham.xls**
PROJECT MANAGER: **N. Avery**
DESIGNED BY: **J. Kelly**
WHITINGHAM SHEET 21

PLOT DATE: **8/5/2009**
DRAWN BY: **I. Shea**
CHECKED BY: **T. Guazzoni**
SHEET **57** OF **198**

DIRECTION	MILEPOINT	LOCATION CODE (SHEET 2)	SIGN CODE	WIDTH (IN)	HEIGHT (IN)	SHEETING REMARKS	SIGN LEGEND	NEW SIGNS "A"	NEW SIGNS "B"	EXISTING SIGNS RETAIN	EXISTING SIGNS SALVAGE FROM	EXISTING SIGNS SALVAGE TO	EXISTING SIGNS REMOVE	EXIST POST RETAIN	EXIST POST REMOVE	NUMBER OF NEW POSTS	SQUARE STEEL (IN) 1.75 (LB / FT) 1.88	SQUARE STEEL (IN) 2.00 (LB / FT) 2.42	SQUARE STEEL (IN) 2.50 (LB / FT) 3.35	TUBULAR STEEL Ø (IN) FOUNDATION	TUBULAR STEEL Ø (IN) 3.00 (LB / FT) 7.60	TUBULAR STEEL Ø (IN) 3.50 (LB / FT) 9.00	TUBULAR STEEL Ø (IN) 4.00 (LB / FT) 10.80	TUBULAR STEEL Ø (IN) 5.00 (LB / FT) 14.60	SIGN FRAME REQUIRED	REMARKS	SIGN DETAIL: DETAIL IN SHS	SIGN DETAIL: DETAIL ON SHEET NUMBER	SIGN DETAIL: DETAIL ON STD SHEET NUMBER
WHITINGHAM VT 100							FY-FLUORESCENT YELLOW FYG-FLUORESCENT YELLOW GREEN																			"SHS"-STANDARD HIGHWAY SIGNS			
		F	D1-1A	72	12			6.00								2		X									5	
		F	D1-1A	72	12			6.00																			5	
		F	D1-1A	72	12			6.00																			5	
SB	7.648	E	M3-1	24	12		NORTH						1		X													
		E	M1-5	24	24		VT 100						1															
		E	M6-3	21	15		UP ARROW						1															
		E	M4-5	24	12		TO						1															
		E	M1-5	24	24		VT 8A						1															
		E	VM-013	21	15		MODIFIED RIGHT ARROW						1															
		E	M3-3	24	12		SOUTH						1															
		E	M1-5	24	24		VT 112						1															
		E	VM-013	21	15		MODIFIED RIGHT ARROW						1															
SB	7.628	F	M3-3	24	12								1		X													
		F	M1-5	24	24								1															
		F	M3-3	24	12			2.00								1		X								GREEN ON WHITE SHEETING	X	
							SHEET TOTALS	20.00 SF	0.00 SF	0 EA	0 EA	0 EA	11 EA	0 EA	0 EA	3 EA		45 FT								
							TOWN TOTALS	1058.3	0.0	40.0	13.0	13.0	220	0.0	0.0	193		2895.0								

SIGN SUMMARY SHEET

VERMONT AGENCY OF TRANSPORTATION

PROJECT NAME: Stamford-Andover VT100
PROJECT NUMBER: STPG SIGN(20)

FILE NAME: Whitingham.xls
PROJECT MANAGER: N. Avery
DESIGNED BY: J. Kelly
WHITINGHAM SHEET 22

PLOT DATE: 8/5/2009
DRAWN BY: I. Shea
CHECKED BY: T. Guazzoni
SHEET 58 OF 198

DIRECTION	MILEPOINT	LOCATION CODE (SHEET 2)	SIGN CODE	WIDTH (IN)	HEIGHT (IN)	SHEETING REMARKS	SIGN LEGEND	NEW SIGNS "A"	NEW SIGNS "B"	EXISTING SIGNS RETAIN	EXISTING SIGNS SALVAGE FROM	EXISTING SIGNS SALVAGE TO	EXISTING SIGNS REMOVE	EXIST POST RETAIN	EXIST POST REMOVE	NUMBER OF NEW POSTS	SQUARE STEEL (IN) 1.75 (LB / FT) 1.88	SQUARE STEEL (IN) 2.00 (LB / FT) 2.42	SQUARE STEEL (IN) 2.50 (LB / FT) 3.35	TUBULAR STEEL Ø (IN) FOUNDATION	TUBULAR STEEL Ø (IN) 3.00 (LB / FT) 7.60	TUBULAR STEEL Ø (IN) 3.50 (LB / FT) 9.00	TUBULAR STEEL Ø (IN) 4.00 (LB / FT) 10.80	TUBULAR STEEL Ø (IN) 5.00 (LB / FT) 14.60	SIGN FRAME REQUIRED	REMARKS	SIGN DETAIL: DETAIL IN SHS	SIGN DETAIL: DETAIL ON SHEET NUMBER	SIGN DETAIL: DETAIL ON STD SHEET NUMBER
WHITINGHAM VT 100							FY-FLUORESCENT YELLOW FYG-FLUORESCENT YELLOW GREEN																			"SHS"-STANDARD HIGHWAY SIGNS			
SB	7.410	H	R1-1	30	30		1000 1321 0741 STOP ACADEMY RD DEAD END						1		X														
		H	R1-1	30	30			6.25								1		X								TH-42, ACADEMY RD	X		
SB	7.405	F	R2-1	24	30		SPEED LIMIT 40						1		X														
		F	R2-1	24	30			5.00								1		X									X		
SB	7.383	F	W1-8	18	24								1		X														
		F	W1-8	18	24	FY		3.00								1		X									X		
SB	7.383	E	W1-8	18	24								1		X														
		E	W1-8	18	24	FY		3.00								1		X									X		
SB	7.368	F	W1-8	18	24		CHEVRON						1		X														
SB	7.368	E	W1-8	18	24		CHEVRON						1		X														
SB	7.358	F	W1-8	18	24								1		X														
		F	W1-8	18	24	FY		3.00								1		X									X		
SB	7.358	E	W1-8	18	24								1		X														
		E	W1-8	18	24	FY		3.00					–			1		X									X		
SB	7.333	F	W1-8	18	24			3.00								1		X								INSTALL BOTH SIGNS SOUTH OF DRIVE	X		
SIGN SUMMARY SHEET							SHEET TOTALS	26.25 SF	0.00 SF	0 EA	0 EA	0 EA	8 EA	0 EA	0 EA	7 EA		105 FT										
VERMONT AGENCY OF TRANSPORTATION							TOWN TOTALS	1058.3	0.0	40.0	13.0	13.0	220	0.0	0.0	193		2895.0										

PROJECT NAME: **Stamford-Andover VT100**
PROJECT NUMBER: **STPG SIGN(20)**

FILE NAME: **Whitingham.xls**
PROJECT MANAGER: **N. Avery**
DESIGNED BY: **J. Kelly**
WHITINGHAM SHEET 24

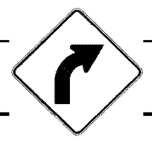
PLOT DATE: **8/5/2009**
DRAWN BY: **I. Shea**
CHECKED BY: **T. Guazzoni**
SHEET **60** OF **198**






DIRECTION	MILEPOINT	LOCATION CODE (SHEET 2)	SIGN CODE	WIDTH (IN)	HEIGHT (IN)	SHEETING REMARKS	SIGN LEGEND	NEW SIGNS "A"	NEW SIGNS "B"	EXISTING SIGNS RETAIN	EXISTING SIGNS SALVAGE FROM	EXISTING SIGNS SALVAGE TO	EXISTING SIGNS REMOVE	EXIST POST RETAIN	EXIST POST REMOVE	NUMBER OF NEW POSTS	SQUARE STEEL (IN) 1.75 (LB / FT) 1.88	SQUARE STEEL (IN) 2.00 (LB / FT) 2.42	SQUARE STEEL (IN) 2.50 (LB / FT) 3.35	TUBULAR STEEL Ø (IN) FOUNDATION	TUBULAR STEEL Ø (IN) 3.00 (LB / FT) 7.60	TUBULAR STEEL Ø (IN) 3.50 (LB / FT) 9.00	TUBULAR STEEL Ø (IN) 4.00 (LB / FT) 10.80	TUBULAR STEEL Ø (IN) 5.00 (LB / FT) 14.60	SIGN FRAME REQUIRED	REMARKS	SIGN DETAIL: DETAIL IN SHS	SIGN DETAIL: DETAIL ON SHEET NUMBER	SIGN DETAIL: DETAIL ON STD SHEET NUMBER
WHITINGHAM VT 100							FY-FLUORESCENT YELLOW FYG-FLUORESCENT YELLOW GREEN																			"SHS"-STANDARD HIGHWAY SIGNS			
SB	7.333	E	W1-8	18	24	FY		3.00								1		X									X		
SB	7.128	F	R2-1	24	30		SPEED LIMIT 50						1		X														
SB	7.103	F	R2-1	24	30			5.00								1		X								INSTALL ~~125~~ 150 FEET SOUTH OF EXISTING SPEED LIMIT 50 SIGN	X		
SB	7.098	F	W1-5L	30	30		LEFT WINDING ROAD						1		X														
SB	7.065	F	W1-4R	30	30			6.25								1		X								INSTALL 200 FEET SOUTH OF EXISTING WINDING ROAD SIGN	X		
SB	6.964	F	OM-3R	12	36		OBJECT MARKER (RIGHT)			~~1~~			~~1~~		X											THESE SIGNS WERE NOT REMOVED BY THE CONTRACTOR. A NEW NARROW BRIDGE SIGN WAS INSTALLED BY STATE FORCES IN LATE 2011.			
SB	6.955	E	OM-3L	12	36		OBJECT MARKER (LEFT)			~~1~~			~~1~~		X														
SB	6.774	F	VW-202	30	30		TRUCKS ENTERING						1		X														
SB	6.645	F	VW-202	30	30			6.25								1		X								INSTALL 200 FEET NORTH OF EXISTING SCHOOL SIGN ASSEMBLY			E-154
SB	6.607	F	S1-1YG	36	36		SCHOOL PENTAGON			1				X															
		F	W16-9YG	24	12		AHEAD			1																			
SB	6.542	F	OM-3R	12	36		RIGHT OBJECT MARKER						1		X														
SB	6.538	F	OM-3L	12	36		LEFT OBJECT MARKER						1		X														
SB	6.525	F	W11-6(H)	30	30			6.25								1		X								INSTALL HINGED SIGN IN CLOSED POSITION, 90 FEET SOUTH OF BRIDGE #36			E-153
SB	6.355	F	W1-2R	30	30			6.25								1		X								INSTALL 200 FEET NORTH OF BEGINNING OF GUARD RAIL	X		
							SHEET TOTALS	33.00 SF	0.00 SF	~~4~~ 2 EA	0 EA	0 EA	~~5~~ 7 EA	0 EA	0 EA	6 EA		90 FT								
							TOWN TOTALS	1058.3 SF	0.0 SF	40.0 EA	13.0 EA	13.0 EA	220 EA	0.0 EA	0.0 EA	193 EA		2895.0 FT								

SIGN SUMMARY SHEET

VERMONT AGENCY OF TRANSPORTATION

PROJECT NAME: **Stamford-Andover VT100**
PROJECT NUMBER: **STPG SIGN(20)**

FILE NAME: **Whitingham.xls**
PROJECT MANAGER: **N. Avery**
DESIGNED BY: **J. Kelly**
WHITINGHAM SHEET 25

PLOT DATE: **8/5/2009**
DRAWN BY: **I. Shea**
CHECKED BY: **T. Guazzoni**
SHEET **61** OF **198**

DIRECTION	MILEPOINT	LOCATION CODE (SHEET 2)	SIGN CODE	WIDTH (IN)	HEIGHT (IN)	SHEETING REMARKS	SIGN LEGEND	NEW SIGNS "A"	NEW SIGNS "B"	EXISTING SIGNS RETAIN	EXISTING SIGNS SALVAGE FROM	EXISTING SIGNS SALVAGE TO	EXISTING SIGNS REMOVE	EXIST POST RETAIN	EXIST POST REMOVE	NUMBER OF NEW POSTS	SQUARE STEEL (IN) 1.75 (LB / FT) 1.88	SQUARE STEEL (IN) 2.00 (LB / FT) 2.42	SQUARE STEEL (IN) 2.50 (LB / FT) 3.35	TUBULAR STEEL Ø (IN) FOUNDATION	TUBULAR STEEL Ø (IN) 3.00 (LB / FT) 7.60	TUBULAR STEEL Ø (IN) 3.50 (LB / FT) 9.00	TUBULAR STEEL Ø (IN) 4.00 (LB / FT) 10.80	TUBULAR STEEL Ø (IN) 5.00 (LB / FT) 14.60	SIGN FRAME REQUIRED	REMARKS	SIGN DETAIL: DETAIL IN SHS	SIGN DETAIL: DETAIL ON SHEET NUMBER	SIGN DETAIL: DETAIL ON STD SHEET NUMBER
WHITINGHAM VT 100							FY-FLUORESCENT YELLOW FYG-FLUORESCENT YELLOW GREEN																			"SHS"-STANDARD HIGHWAY SIGNS			
SB	6.133	F	W1-4L	30	30		LEFT REVERSE CURVE						1		X														
		F	W13-1	18	18		40 MPH PLAQUE						1																
SB	6.068	F	W1-4L	30	30			6.25								1		X									INSTALL 350 FEET SOUTH OF EXISTING SIGN LOCATION	X		
		F	W13-1	18	18			2.25																				X		
SB	6.018	F	W2-1M	30	30		CROSSROAD MODIFIED 						1		X																
SB	5.970	F	W1-2MmR	30	30			6.25								1		X									INSTALL 250 FEET SOUTH OF EXISTING CROSSROADS SIGN		7	
SB	5.883	G	VR-017	24	30								1		X													TH-3, WILMINGTON CROSS RD			
		G	VR-017	24	30			5.00								1		X									INSTALL CLOSER TO VT-100			E-141
SB	5.875	H	R1-1	30	30		 						1		X															
		H	R1-1	30	30			6.25								1		X									TH-3, WILMINGTON CROSS RD	X		
SB	5.786	F	M3-3	24	12								1		X															
		F	M1-5A	24	24								1																	
		F	M3-3	24	12			2.00								1		X									GREEN ON WHITE SHEETING	X		
		F	M1-5	30	24			5.00																						E-136B
SB	5.140	F	S3-1	30	30		SCHOOL BUS STOP AHEAD						1		X															
							SHEET TOTALS	33.00	0.00	0	0	0	8	0	0	5		75											
								SF	SF	EA	EA	EA	EA	EA	EA	EA		FT											
							TOWN TOTALS	1058.3	0.0	40.0	13.0	13.0	220	0.0	0.0	193		2895.0											

SIGN SUMMARY SHEET

VERMONT AGENCY OF TRANSPORTATION

PROJECT NAME: **Stamford-Andover VT100**
PROJECT NUMBER: **STPG SIGN(20)**

FILE NAME: **Whitingham.xls**
PROJECT MANAGER: **N. Avery**
DESIGNED BY: **J. Kelly**
WHITINGHAM SHEET 26

PLOT DATE: **8/5/2009**
DRAWN BY: **I. Shea**
CHECKED BY: **T. Guazzoni**
SHEET **62** OF **198**

DIRECTION	MILEPOINT	LOCATION CODE (SHEET 2)	SIGN CODE	WIDTH (IN)	HEIGHT (IN)	SHEETING REMARKS	SIGN LEGEND	NEW SIGNS "A"	NEW SIGNS "B"	EXISTING SIGNS RETAIN	EXISTING SIGNS SALVAGE FROM	EXISTING SIGNS SALVAGE TO	EXISTING SIGNS REMOVE	EXIST POST RETAIN	EXIST POST REMOVE	NUMBER OF NEW POSTS	SQUARE STEEL (IN) 1.75 (LB / FT) 1.88	SQUARE STEEL (IN) 2.00 (LB / FT) 2.42	SQUARE STEEL (IN) 2.50 (LB / FT) 3.35	TUBULAR STEEL Ø (IN) FOUNDATION	TUBULAR STEEL Ø (IN) 3.00 (LB / FT) 7.60	TUBULAR STEEL Ø (IN) 3.50 (LB / FT) 9.00	TUBULAR STEEL Ø (IN) 4.00 (LB / FT) 10.80	TUBULAR STEEL Ø (IN) 5.00 (LB / FT) 14.60	SIGN FRAME REQUIRED	REMARKS	SIGN DETAIL: DETAIL IN SHS	SIGN DETAIL: DETAIL ON SHEET NUMBER	SIGN DETAIL: DETAIL ON STD SHEET NUMBER
WHITINGHAM VT 100							FY-FLUORESCENT YELLOW FYG-FLUORESCENT YELLOW GREEN																			"SHS"-STANDARD HIGHWAY SIGNS			
SB	5.102	F	W1-2L	30	30		LEFT CURVE						1		X														
		F	W13-1	18	18		40 MPH PLAQUE						1																
SB	5.090	G	VR-017	24	30								1		X														
		G	VR-017	24	30			5.00								1		X								TH-15, CORSE RD			E-141
SB	5.084	H	R1-1	30	30		 						1		X												SALVAGED STREET SIGN AND MM ONTO NEW POST.			
		H	R1-1	30	30		1000 1321 0509	6.25								1		X								TH-15, CORSE RD	X		
SB	~~5.065~~ 5.056	F	W1-2MbL	30	30			6.25								2		X								INSTALL 400 FEET NORTH OF TH-~~15~~ 59, PLUMB RD.		6	
		F	S3-1	30	30			6.25																				
SB	4.740	F	W3-5	36	36		SPEED REDUCTION (40)			1				X														
SB	4.675	F	VD-062B	72	16		BUSINESS SIGN			1				X														
SB	4.640	F	VW-054R	30	30								1		X														
		F	VW-054R	30	30			6.25								1		X										E-154
SB	4.600	F	R2-1	24	30								1		X														
		F	R2-1	30	36			7.50								1		X									6	
SB	4.549	F	W2-1	30	30								1		X														
							SHEET TOTALS	37.50 SF	0.00 SF	2 EA	~~0~~ EA	~~0~~ EA	7 EA	0 EA	0 EA	6 EA		90 FT											
							TOWN TOTALS	1058.3	0.0	40.0	13.0	13.0	220	0.0	0.0	193		2895.0										

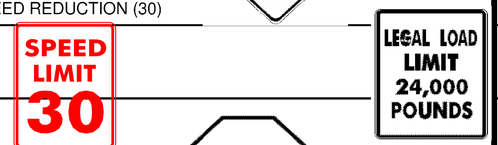
SIGN SUMMARY SHEET

VERMONT AGENCY OF TRANSPORTATION

PROJECT NAME: Stamford-Andover VT100
PROJECT NUMBER: STPG SIGN(20)

FILE NAME: Whitingham.xls
PROJECT MANAGER: N. Avery
DESIGNED BY: J. Kelly
WHITINGHAM SHEET 27

PLOT DATE: 8/5/2009
DRAWN BY: I. Shea
CHECKED BY: T. Guazzoni
SHEET 63 OF 198

DIRECTION	MILEPOINT	LOCATION CODE (SHEET 2)	SIGN CODE	WIDTH (IN)	HEIGHT (IN)	SHEETING REMARKS	SIGN LEGEND	NEW SIGNS "A"	NEW SIGNS "B"	EXISTING SIGNS RETAIN	EXISTING SIGNS SALVAGE FROM	EXISTING SIGNS SALVAGE TO	EXISTING SIGNS REMOVE	EXIST POST RETAIN	EXIST POST REMOVE	NUMBER OF NEW POSTS	SQUARE STEEL (IN) 1.75 (LB / FT) 1.88	SQUARE STEEL (IN) 2.00 (LB / FT) 2.42	SQUARE STEEL (IN) 2.50 (LB / FT) 3.35	TUBULAR STEEL Ø (IN) FOUNDATION	TUBULAR STEEL Ø (IN) 3.00 (LB / FT) 7.60	TUBULAR STEEL Ø (IN) 3.50 (LB / FT) 9.00	TUBULAR STEEL Ø (IN) 4.00 (LB / FT) 10.80	TUBULAR STEEL Ø (IN) 5.00 (LB / FT) 14.60	SIGN FRAME REQUIRED	REMARKS	SIGN DETAIL: DETAIL IN SHS	SIGN DETAIL: DETAIL ON SHEET NUMBER	SIGN DETAIL: DETAIL ON STD SHEET NUMBER
WHITINGHAM VT 100							FY-FLUORESCENT YELLOW FYG-FLUORESCENT YELLOW GREEN																			"SHS"-STANDARD HIGHWAY SIGNS			
		F	W2-1Mb	30	30			6.25								1		X										6	
SB	4.432	F	W3-5	36	36		SPEED REDUCTION (30)			1				X															
SB	4.415	G	VR-017	24	30			5.00								1		X									SALVAGED SPEED LIMIT 30MPH. RE-INSTALLED UNDER LL24 TH-17, MAPLE DR			E-141
SB	4.411	H	R1-1	30	30								1		X												SALVAGED STREET SIGN ONTO NEW POST.			
		H	R1-1	30	30			6.25								1		X									TH-17, MAPLE DR	X		
SB	4.385	F	VD-018	30	18								1		X														
		F	VD-018	30	18			3.75								1		X									INSTALL APPROX 20 FEET NORTH OF EXISTING AND 10 FEET AWAY FROM POLE			E-128A
SB	4.360	F	VW-054L	30	30								1		X														
		F	W1-2L	30	30								1		X														
		F	W1-2L	30	30			6.25								2		X									INSTALL LEFT CURVE SIGN ON TOP	X		
		F	VW-054L	30	30			6.25																					E-154
SB	4.320	F	R2-1	24	30								1		X															
		F	R2-1	30	36			7.50								1		X									SHOULD BE INSTALLED DIRECTLY ACROSS FROM NB SPEED LIMIT 40 SIGN		6	
SB	4.281	E	OM-3L	12	36		VERTICAL OBJECT MARKER (LEFT)						1		X														
SB	4.231	F	S3-1	30	30		SCHOOL BUS STOP AHEAD						1		X														
							SHEET TOTALS	41.25	0.00	1	~~2~~ 0	~~2~~ 0	7	0	0	7		105											
								SF	SF	EA	EA	EA	EA	EA	EA	EA		FT										
							TOWN TOTALS	1058.3	0.0	40.0	13.0	13.0	220	0.0	0.0	193		2895.0										

SIGN SUMMARY SHEET

VERMONT AGENCY OF TRANSPORTATION

PROJECT NAME: **Stamford-Andover VT100**
PROJECT NUMBER: **STPG SIGN(20)**

FILE NAME: **Whitingham.xls**
PROJECT MANAGER: **N. Avery**
DESIGNED BY: **J. Kelly**
WHITINGHAM SHEET 28

PLOT DATE: **8/5/2009**
DRAWN BY: **I. Shea**
CHECKED BY: **T. Guazzoni**
SHEET **64** OF **198**

DIRECTION	MILEPOINT	LOCATION CODE (SHEET 2)	SIGN CODE	WIDTH (IN)	HEIGHT (IN)	SHEETING REMARKS	SIGN LEGEND	NEW SIGNS "A"	NEW SIGNS "B"	EXISTING SIGNS RETAIN	EXISTING SIGNS SALVAGE FROM	EXISTING SIGNS SALVAGE TO	EXISTING SIGNS REMOVE	EXIST POST RETAIN	EXIST POST REMOVE	NUMBER OF NEW POSTS	SQUARE STEEL (IN) 1.75 (LB / FT) 1.88	SQUARE STEEL (IN) 2.00 (LB / FT) 2.42	SQUARE STEEL (IN) 2.50 (LB / FT) 3.35	TUBULAR STEEL Ø (IN) FOUNDATION	TUBULAR STEEL Ø (IN) 3.00 (LB / FT) 7.60	TUBULAR STEEL Ø (IN) 3.50 (LB / FT) 9.00	TUBULAR STEEL Ø (IN) 4.00 (LB / FT) 10.80	TUBULAR STEEL Ø (IN) 5.00 (LB / FT) 14.60	SIGN FRAME REQUIRED	REMARKS	SIGN DETAIL: DETAIL IN SHS	SIGN DETAIL: DETAIL ON SHEET NUMBER	SIGN DETAIL: DETAIL ON STD SHEET NUMBER
WHITINGHAM VT 100							FY-FLUORESCENT YELLOW FYG-FLUORESCENT YELLOW GREEN																			"SHS"-STANDARD HIGHWAY SIGNS			
		F	W1-3R	30	30		RIGHT REVERSE CURVE						1																
		F	W13-1	18	18		20 MPH PLAQUE						1																
SB	4.210	F	S3-1	30	30	FY		6.25								2		X								85 INSTALL ASSEMBLY ~~110~~ FEET SOUTH OF EXISTING AND ACROSS FROM "B" ASSEMBLY	X		
		F	W1-3R	30	30	FY		6.25																		GATE-POSTED ASSEMBLIES SHOULD BE AT SAME MILE POINT	X		
		F	W13-1	18	18	FY		2.25																			X		
SB	4.168	F	W11-2YG	30	30		PEDESTRIAN SYMBOL			1				X															
		F	W16-4YG	24	18		NEXT 500 FEET			1																			
SB	4.044	G	VR-017	24	30								1		X														
		G	VR-017	24	30			5.00								1		X								TH-17, SCHOOL ST			E-141
		~~G~~	~~N/A~~				~~TOWN SIGN - SLOW CHILDREN~~						~~1~~													REMOVE ILLEGAL SIGN. RETURN TO TOWN - SIGN MISSING			
SB	4.038	H	R1-1	30	30		 						1		X												SALVAGED STREET SIGN AND MM ONTO NEW POST			
		H	R1-1	30	30		 	6.25								1		X								TH-17, SCHOOL ST	X		
SB	3.991	G	VR-017	24	30			5.00								1		X								TH-11, BROOK ST			E-141
		~~G~~	~~N/A~~				~~SLOW CHILDREN~~						1													~~REMOVE ILLEGAL SIGN. RETURN TO TOWN~~ SALVAGED SPEED LIMIT SIGN ONTO NEW POST			
SB	3.986	H	R1-1	30	30								1		X														
SIGN SUMMARY SHEET							SHEET TOTALS	31.00 SF	0.00 SF	2 EA	~~2~~ 0 EA	~~2~~ 0 EA	7 EA	0 EA	0 EA	5 EA		75 FT										
VERMONT AGENCY OF TRANSPORTATION							TOWN TOTALS	1058.3	0.0	40.0	13.0	13.0	220	0.0	0.0	193		2895.0									

PROJECT NAME: Stamford-Andover VT100
PROJECT NUMBER: STPG SIGN(20)

FILE NAME: Whitingham.xls
PROJECT MANAGER: N. Avery
DESIGNED BY: J. Kelly
WHITINGHAM SHEET 29

PLOT DATE: 8/5/2009
DRAWN BY: I. Shea
CHECKED BY: T. Guazzoni
SHEET 65 OF 198

DIRECTION	MILEPOINT	LOCATION CODE (SHEET 2)	SIGN CODE	WIDTH (IN)	HEIGHT (IN)	SHEETING REMARKS	SIGN LEGEND	NEW SIGNS "A"	NEW SIGNS "B"	EXISTING SIGNS RETAIN	EXISTING SIGNS SALVAGE FROM	EXISTING SIGNS SALVAGE TO	EXISTING SIGNS REMOVE	EXIST POST RETAIN	EXIST POST REMOVE	NUMBER OF NEW POSTS	SQUARE STEEL (IN) (LB / FT) 1.75 / 1.88	SQUARE STEEL (IN) (LB / FT) 2.00 / 2.42	SQUARE STEEL (IN) (LB / FT) 2.50 / 3.35	TUBULAR STEEL Ø (IN) FOUNDATION	TUBULAR STEEL Ø (IN) (LB / FT) 3.00 / 7.60	TUBULAR STEEL Ø (IN) (LB / FT) 3.50 / 9.00	TUBULAR STEEL Ø (IN) (LB / FT) 4.00 / 10.80	TUBULAR STEEL Ø (IN) (LB / FT) 5.00 / 14.60	SIGN FRAME REQUIRED	REMARKS	SIGN DETAIL: DETAIL IN SHS	SIGN DETAIL: DETAIL ON SHEET NUMBER	SIGN DETAIL: DETAIL ON STD SHEET NUMBER
WHITINGHAM VT 100							FY-FLUORESCENT YELLOW FYG-FLUORESCENT YELLOW GREEN																			"SHS"-STANDARD HIGHWAY SIGNS			
SB	3.986	H	R1-1	30	30		1000 1321 0399 STOP	6.25								1		X								TH-11, BROOK ST	X		
SB	3.984	F	R2-1	24	30		SPEED LIMIT 30						1		X														
SB	3.900	F	W1-10L	30	30			6.25								1		X								INSTALL 200 FEET NORTH OF EXISTING SPEED LIMIT 40 SIGN	X		
SB	3.861	F	R2-1	24	30		SPEED LIMIT 40			1				X															
SB	3.822	G	VR-017	24	30		LEGAL LOAD LIMIT 24,000 POUNDS						1		X														
		G	VR-017	24	30			5.00								1		X								TH-12, BRICKHOUSE RD			E-141
SB	3.817	H	R1-1	30	30		STOP						1		X														
		H	R1-1	30	30		1000 1321 0382	6.25								1		X								TH-12, BRICKHOUSE RD	X		
SB	3.811	F	VR-020	24	30		NO PARKING ON TRAVELED LANES			1				X															
SB	3.786	F	M3-3S	24	12		SOUTH			1				X															
		F	M1-5	30	24		VERMONT 100			1																			
SB	3.771	F	VR-020	24	30		NO PARKING ON TRAVELED LANES			1				X															
SB	3.732	F	R2-1	24	30		SPEED LIMIT 40			1				X															
SB	3.480	G	VM-607	24	30		43RD INF DIV MEMORIAL HIGHWAY			1				X															
SB	3.477	F	R2-1	24	30		SPEED LIMIT 50			1				X															
							SHEET TOTALS	23.75	0.00	8	~~0~~	~~0~~	3	0	0	4		60										
								SF	SF	EA	EA	EA	EA	EA	EA	EA		FT										
							TOWN TOTALS	1058.3	0.0	40.0	13.0	13.0	220	0.0	0.0	193		2895.0										

SIGN SUMMARY SHEET

VERMONT AGENCY OF TRANSPORTATION

PROJECT NAME: Stamford-Andover VT100
PROJECT NUMBER: STPG SIGN(20)

FILE NAME: Whitingham.xls
PROJECT MANAGER: N. Avery
DESIGNED BY: J. Kelly
WHITINGHAM SHEET 30

PLOT DATE: 8/5/2009
DRAWN BY: I. Shea
CHECKED BY: T. Guazzoni
SHEET 66 OF 198

DIRECTION	MILEPOINT	LOCATION CODE (SHEET 2)	SIGN CODE	WIDTH (IN)	HEIGHT (IN)	SHEETING REMARKS	SIGN LEGEND	NEW SIGNS "A"	NEW SIGNS "B"	EXISTING SIGNS RETAIN	EXISTING SIGNS SALVAGE FROM	EXISTING SIGNS SALVAGE TO	EXISTING SIGNS REMOVE	EXIST POST RETAIN	EXIST POST REMOVE	NUMBER OF NEW POSTS	SQUARE STEEL (IN) 1.75 (LB / FT) 1.88	SQUARE STEEL (IN) 2.00 (LB / FT) 2.42	SQUARE STEEL (IN) 2.50 (LB / FT) 3.35	TUBULAR STEEL Ø (IN) FOUNDATION	TUBULAR STEEL Ø (IN) 3.00 (LB / FT) 7.60	TUBULAR STEEL Ø (IN) 3.50 (LB / FT) 9.00	TUBULAR STEEL Ø (IN) 4.00 (LB / FT) 10.80	TUBULAR STEEL Ø (IN) 5.00 (LB / FT) 14.60	SIGN FRAME REQUIRED	REMARKS	SIGN DETAIL: DETAIL IN SHS	SIGN DETAIL: DETAIL ON SHEET NUMBER	SIGN DETAIL: DETAIL ON STD SHEET NUMBER
WHITINGHAM VT 100							FY-FLUORESCENT YELLOW FYG-FLUORESCENT YELLOW GREEN																			"SHS"-STANDARD HIGHWAY SIGNS			
SB	3.063	G	VR-017	24	30								1		X														
		G	VR-017	24	30			5.00								1		X								TH-56, DAM RD			E-141
SB	3.058	H	R1-1	30	30								1		X														
		H	R1-1	30	30			6.25							1		X								TH-56, DAM RD	X		
SB	2.932	G	VR-017	24	30			5.00								1		X								TH-32, PIKE RD			
SB	2.927	H	R1-1	30	30								1		X														
		H	R1-1	30	30			6.25								1		X								TH-32, PIKE RD	X		
SB	2.575	F	N/A				EMPTY POST								X											AT THE REQUEST OF AOT-DIST #1, THIS SIGN WAS REMOVED AND RE-INTALLED FARTHER AWAY FROM THE DITCHLINE.			
		F	W1-4L	30	30			6.25				I	I			1		X									X		
SB	2.309	F	W1-4R	30	30		RIGHT REVERSE CURVE						1		X														
SB	2.275	F	VW-054R	30	30		HIDDEN DRIVE RIGHT						1		X														
		F	W1-4R	30	30			6.25								1		X									X		
		F	W13-1	18	18			2.25																			X		
SB	2.237	F	VW-054R	30	30			6.25								1		X								INSTALL 200 FEET SOUTH OF EXISTING HIDDEN DRIVE RIGHT SIGN			E-154
SB	~~2.130~~ 2.211	F	S3-1	30	30		SCHOOL BUS STOP AHEAD	6.25					1		X											SCHOOL BUS STOPS AT THIS LOCATION. OLD SIGN REMOVED, NEW SIGN INSTALLED.			
							SHEET TOTALS	~~43.50~~ 49.75	0.00	0	~~0~~	~~0~~	6	0	0	7		105								
								SF	SF	EA	EA	EA	EA	EA	EA	EA		FT										
							TOWN TOTALS	1058.3	0.0	40.0	13.0	13.0	220	0.0	0.0	193		2895.0										

SIGN SUMMARY SHEET

VERMONT AGENCY OF TRANSPORTATION

PROJECT NAME: **Stamford-Andover VT100**
PROJECT NUMBER: **STPG SIGN(20)**

FILE NAME: **Whitingham.xls**
PROJECT MANAGER: **N. Avery**
DESIGNED BY: **J. Kelly**
WHITINGHAM SHEET 31

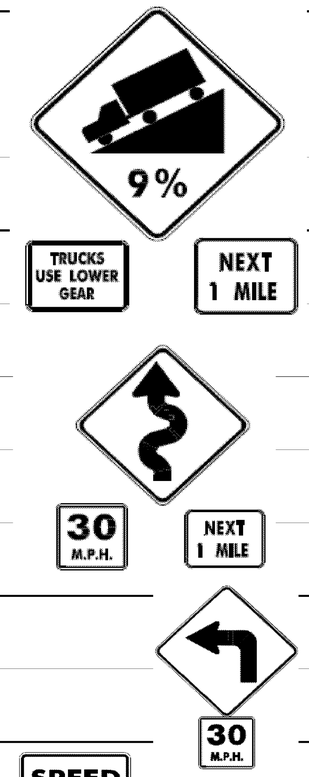
PLOT DATE: **8/5/2009**
DRAWN BY: **I. Shea**
CHECKED BY: **T. Guazzoni**
SHEET **67** OF **198**

DIRECTION	MILEPOINT	LOCATION CODE (SHEET 2)	SIGN CODE	WIDTH (IN)	HEIGHT (IN)	SHEETING REMARKS	SIGN LEGEND	NEW SIGNS "A"	NEW SIGNS "B"	EXISTING SIGNS RETAIN	EXISTING SIGNS SALVAGE FROM	EXISTING SIGNS SALVAGE TO	EXISTING SIGNS REMOVE	EXIST POST RETAIN	EXIST POST REMOVE	NUMBER OF NEW POSTS	SQUARE STEEL (IN) 1.75 (LB / FT) 1.88	SQUARE STEEL (IN) 2.00 (LB / FT) 2.42	SQUARE STEEL (IN) 2.50 (LB / FT) 3.35	TUBULAR STEEL Ø (IN) FOUNDATION	TUBULAR STEEL Ø (IN) 3.00 (LB / FT) 7.60	TUBULAR STEEL Ø (IN) 3.50 (LB / FT) 9.00	TUBULAR STEEL Ø (IN) 4.00 (LB / FT) 10.80	TUBULAR STEEL Ø (IN) 5.00 (LB / FT) 14.60	SIGN FRAME REQUIRED	REMARKS	SIGN DETAIL: DETAIL IN SHS	SIGN DETAIL: DETAIL ON SHEET NUMBER	SIGN DETAIL: DETAIL ON STD SHEET NUMBER
WHITINGHAM VT 100							FY-FLUORESCENT YELLOW FYG-FLUORESCENT YELLOW GREEN																			"SHS"-STANDARD HIGHWAY SIGNS			
SB	2.085	F	W1-1MR	30	30		RIGHT TURN WITH LEFT SIDE ROAD						1		X														
		F	W13-1	18	18		30 MPH PLAQUE						1																
SB	2.028	F	W1-1MbR	30	30			6.25								1		X									INSTALL 300 FEET SOUTH OF EXISTING RIGHT TURN ASSEMBLY		6	
			W13-1	18	18			2.25																				X	
SB	1.635	~~F~~	~~N/A~~				~~EMPTY POST~~								X											MISSING			
SB	1.400	F	W1-2R	30	30		RIGHT CURVE						1		X														
		F	W13-1	18	18		35 MPH PLAQUE						1																
SB	1.353	F	W1-10R	30	30			6.25								1		X									INSTALL 250 FEET SOUTH OF EXISTING RH CURVE ASSEMBLY	X		
		F	W13-1	18	18			2.25																				X	
SB	1.027	F	W3-5	36	36			9.00								2		X									INSTALL 300 FEET NORTH OF SPEED LIMIT 40 ASSEMBLY	X		
SB	0.970	F	R2-1	24	30								1		X														
		F	R2-1	30	36			7.50								1		X											6
SB	0.900	F	W7-1	30	30		TRUCK HILL SYMBOL						1		X														
		F	W1-5L	30	30		WINDING ROAD LEFT						1																
		F	W7-2B	24	18								1																
SIGN SUMMARY SHEET							SHEET TOTALS	33.50	0.00	0	0	0	8	0	0	5		75									
								SF	SF	EA	EA	EA	EA	EA	EA	EA		FT									
VERMONT AGENCY OF TRANSPORTATION							TOWN TOTALS	1058.3	0.0	40.0	13.0	13.0	220	0.0	0.0	193		2895.0									

PROJECT NAME: **Stamford-Andover VT100**
PROJECT NUMBER: **STPG SIGN(20)**

FILE NAME: **Whitingham.xls** PLOT DATE: **8/5/2009**
PROJECT MANAGER: **N. Avery** DRAWN BY: **I. Shea**
DESIGNED BY: **J. Kelly** CHECKED BY: **T. Guazzoni**
WHITINGHAM SHEET 32 SHEET **68** OF **198**

DIRECTION	MILEPOINT	LOCATION CODE (SHEET 2)	SIGN CODE	WIDTH (IN)	HEIGHT (IN)	SHEETING REMARKS	SIGN LEGEND	NEW SIGNS "A"	NEW SIGNS "B"	EXISTING SIGNS RETAIN	EXISTING SIGNS SALVAGE FROM	EXISTING SIGNS SALVAGE TO	EXISTING SIGNS REMOVE	EXIST POST RETAIN	EXIST POST REMOVE	NUMBER OF NEW POSTS	SQUARE STEEL (IN) 1.75 (LB / FT) 1.88	SQUARE STEEL (IN) 2.00 (LB / FT) 2.42	SQUARE STEEL (IN) 2.50 (LB / FT) 3.35	FOUNDATION	TUBULAR STEEL Ø (IN) 3.00 (LB / FT) 7.60	TUBULAR STEEL Ø (IN) 3.50 (LB / FT) 9.00	TUBULAR STEEL Ø (IN) 4.00 (LB / FT) 10.80	TUBULAR STEEL Ø (IN) 5.00 (LB / FT) 14.60	SIGN FRAME REQUIRED	REMARKS	SIGN DETAIL: DETAIL IN SHS	SIGN DETAIL: DETAIL ON SHEET NUMBER	SIGN DETAIL: DETAIL ON STD SHEET NUMBER
WHITINGHAM VT 100							FY-FLUORESCENT YELLOW FYG-FLUORESCENT YELLOW GREEN																			"SHS"-STANDARD HIGHWAY SIGNS			
		F	W7-1B	30	30			6.25								2		X									X	
		F	W7-2B	24	18			3.00																		INSTALL ON LEFT HAND POST	X	
		F	W7-3a	24	18			3.00																		INSTALL ON RIGHT HAND POST	X	
SB	0.860	F	W1-1L	30	30		LEFT TURN						1		X													
		F	W13-1	18	18		30 MPH PLAQUE						1															
		F	W1-5L	30	30			6.25								2		X									X	
		F	W13-1	18	18			2.25																		INSTALL ON LEFT HAND POST		
		F	W7-3a	24	18			3.00																		INSTALL ON RIGHT HAND POST	X	
SB	0.788	F	W1-1L	30	30			6.25								1										INSTALL 100 FEET NORTH OF DRIVE ON CORNER	X	
		F	W13-1	18	18			2.25																			X	
SB	0.683	F	R2-1	24	30								1		X													
		F	R2-1	24	30			5.00								1		X									X	
SB	0.268	F	OM-3R	12	36								1		X													
		F	OM-3R	12	36			3.00								1		X									X	
SB	0.264	E	OM-3L	12	36								1		X													
							SHEET TOTALS	40.25	0.00	0	0	0	~~5~~ 6	0	0	~~6~~ 7		90										
								SF	SF	EA	EA	EA	EA	EA	EA	EA		FT										
							TOWN TOTALS	1058.3	0.0	40.0	13.0	13.0	220	0.0	0.0	193		2895.0										



SIGN SUMMARY SHEET

VERMONT AGENCY OF TRANSPORTATION

PROJECT NAME: **Stamford-Andover VT100**
PROJECT NUMBER: **STPG SIGN(20)**

FILE NAME: **Whitingham.xls**
PROJECT MANAGER: **N. Avery**
DESIGNED BY: **J. Kelly**
WHITINGHAM SHEET 33

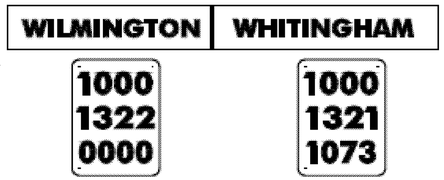
PLOT DATE: **8/5/2009**
DRAWN BY: **I. Shea**
CHECKED BY: **T. Guazzoni**
SHEET **69** OF **198**

DIRECTION	MILEPOINT	LOCATION CODE (SHEET 2)	SIGN CODE	WIDTH (IN)	HEIGHT (IN)	SHEETING REMARKS	SIGN LEGEND	NEW SIGNS "A"	NEW SIGNS "B"	EXISTING SIGNS RETAIN	EXISTING SIGNS SALVAGE FROM	EXISTING SIGNS SALVAGE TO	EXISTING SIGNS REMOVE	EXIST POST RETAIN	EXIST POST REMOVE	NUMBER OF NEW POSTS	SQUARE STEEL (IN) 1.75 (LB / FT) 1.88	SQUARE STEEL (IN) 2.00 (LB / FT) 2.42	SQUARE STEEL (IN) 2.50 (LB / FT) 3.35	FOUNDATION	TUBULAR STEEL Ø (IN) 3.00 (LB / FT) 7.60	TUBULAR STEEL Ø (IN) 3.50 (LB / FT) 9.00	TUBULAR STEEL Ø (IN) 4.00 (LB / FT) 10.80	TUBULAR STEEL Ø (IN) 5.00 (LB / FT) 14.60	SIGN FRAME REQUIRED	REMARKS	SIGN DETAIL: DETAIL IN SHS	SIGN DETAIL: DETAIL ON SHEET NUMBER	SIGN DETAIL: DETAIL ON STD SHEET NUMBER
WHITINGHAM VT 100							FY-FLUORESCENT YELLOW FYG-FLUORESCENT YELLOW GREEN																			"SHS"-STANDARD HIGHWAY SIGNS			
SB	0.264	E	OM-3L	12	36			3.00								1		X									X		
NB	0.191	A	W5-2	30	30			6.25						1												NEW SIGNS INSTALLED BY THE CONTRACTOR PER RECOMMENDATION OF M. MILLER, TRAFFIC OPS.			
SB	0.358	A	W5-2	30	30			6.25						1															
NB	6.868	A	W5-2	36	36			——						2												THESE TWO LARGER NEW SIGNS WERE INSTALLED IN LATE 2011. THEY WERE INSTALLED BY STATE FORCES AS PART OF A WORK ORDER SUBMITTED BY TRAFFIC OPS.			
SB	7.026	A	W5-2	36	36			——						2															
NB	7.650	A	W1-1MBL	30	30			6.25					1		1											THESE TWO NEW SIGNS WERE MISTAKENLY OMITTED FROM THE PROJECT PLANS.			
		A	W13-1	18	18			2.25					1															
SIGN SUMMARY SHEET							SHEET TOTALS	24.00 ~~3.00~~ SF	0.00 SF	0 EA	0 EA	0 EA	2 ~~0~~ EA	0 EA	0 EA	1 EA		15 FT											
VERMONT AGENCY OF TRANSPORTATION							TOWN TOTALS	1058.3	0.0	40.0 EA	13.0 EA	13.0 EA	220 EA	0.0 EA	0.0 EA	193 EA		2895.0 FT										

PROJECT NAME: **Stamford-Andover VT100**
PROJECT NUMBER: **STPG SIGN(20)**

FILE NAME: **Whitingham.xls**
PROJECT MANAGER: **N. Avery**
DESIGNED BY: **J. Kelly**
WHITINGHAM SHEET 34

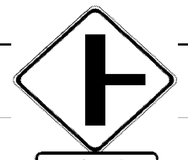
PLOT DATE: **8/5/2009**
DRAWN BY: **I. Shea**
CHECKED BY: **T. Guazzoni**
SHEET **70** OF **198**

DIRECTION	MILEPOINT	LOCATION CODE (SHEET 2)	SIGN CODE	WIDTH (IN)	HEIGHT (IN)	SHEETING REMARKS	SIGN LEGEND	NEW SIGNS "A"	NEW SIGNS "B"	EXISTING SIGNS RETAIN	EXISTING SIGNS SALVAGE FROM	EXISTING SIGNS SALVAGE TO	EXISTING SIGNS REMOVE	EXIST POST RETAIN	EXIST POST REMOVE	NUMBER OF NEW POSTS	SQUARE STEEL (IN) 1.75 (LB / FT) 1.88	SQUARE STEEL (IN) 2.00 (LB / FT) 2.42	SQUARE STEEL (IN) 2.50 (LB / FT) 3.35	TUBULAR STEEL Ø (IN) FOUNDATION	TUBULAR STEEL Ø (IN) 3.00 (LB / FT) 7.60	TUBULAR STEEL Ø (IN) 3.50 (LB / FT) 9.00	TUBULAR STEEL Ø (IN) 4.00 (LB / FT) 10.80	TUBULAR STEEL Ø (IN) 5.00 (LB / FT) 14.60	SIGN FRAME REQUIRED	REMARKS	SIGN DETAIL: DETAIL IN SHS	SIGN DETAIL: DETAIL ON SHEET NUMBER	SIGN DETAIL: DETAIL ON STD SHEET NUMBER
WILMINGTON VT 100							FY-FLUORESCENT YELLOW FYG-FLUORESCENT YELLOW GREEN																			"SHS"-STANDARD HIGHWAY SIGNS			
NB	0.000	C	VD-024	60	7.5										X						AT THE REQUEST OF AOT-DIST. #1 THIS SET OF SIGNS WAS MOVED OUT OF THE DITCHLINE.					TOWN LINE SIGN IS MISSING. EMPTY POST IS 171 FT ± SOUTH OF THE JCT WITH HEBARD RD (TH-39).			
		C	VD-024	72	10			5.00		|	|	|			2		X								INSTALL IN SAME POSITION AS EMPTY POST REMOVAL, IN "C" POSITION.		4	
		C	VD-700	6	10			0.42		|	|	|													WILMINGTON MILE MARKER. INSTALL ON LEFT POST UNDER WILMINGTON.			E-138
		C	VD-700	6	10			0.42		|	|	|													WHITINGHAM MILE MARKER. INSTALL ON RIGHT POST UNDER WHITINGHAM..			E-138
NB	0.032	C	VR-017	24	30			5.00								1		X								HEBARD HILL RD (TH-39)			E-141
NB	0.040	D	R1-1	24	24								1		X															
		D	R1-1	30	30			6.25								1		X								HEBARD HILL RD (TH-39)	X		
NB	0.345	A	W1-2L	30	30			~~•6.25~~ 6.25					~~•1~~			1		X			• SEE NOTE ON SHEET #76					INSTALL BEHIND GUARD RAIL, 315 FT ± SOUTH OF THE GRAVEL ROAD TO BE REOPENED (SEE NEXT 2 ENTRIES)	X		
NB	0.394	C	VR-017	24	30			5.00								1		X								RADER RD (TH-70). **THIS CLASS III ROAD TO BE REOPENED** ~~(EDGELINE AND CENTERLINE MAY STILL BE CLOSED)~~ HAS BEEN			E-141
NB	0.400	D	R1-1	30	30			6.25								1		X								RADER RD (TH-70); GRAVEL ROAD w/ A GUARDRAIL BREAK, JUST BEYOND LEFT CURVE BEGIN / ON SLIGHT UPHILL	X		
NB	0.638	C	VR-017	24	30			5.00								1		X								(TH-36)			E-141
NB	0.644	D	R1-1	30	30			6.25								1		X								(TH-36)	X		
NB	0.941	C	VR-017	24	24								1		X													RADER ROAD (TH-69), SOUTHERLY APPROACH.			
		C	VR-017	24	30			5.00								1		X								INSTALL AT A POINT ON TH-69 JUST BEYOND THE CONVERGANCE OF THE TWO APPROACHES.			E-141
NB	0.949	D	R1-1	24	24								1		X											RADER ROAD (TH-69), SOUTHERLY APPROACH.			
SIGN SUMMARY SHEET							SHEET TOTALS	~~57.09~~ ~~50.84~~ SF	0.00 SF	0 EA	~~3~~ ~~0~~ EA	~~3~~ ~~0~~ EA	~~7~~ ~~3~~ EA	0 EA	0 EA	10 EA		150 FT										
VERMONT AGENCY OF TRANSPORTATION							TOWN TOTALS	825.4	0.0	64.0	15.0	15.0	145	0.0	0.0	145		2175.0									

PROJECT NAME: **Stamford-Andover VT100**
PROJECT NUMBER: **STPG SIGN(20)**

FILE NAME: **Wilminaton.xls**
PROJECT MANAGER: **N. Averv**
DESIGNED BY: **M. Miller**
WILMINGTON SHEET 1

PLOT DATE: **8/6/2009**
DRAWN BY: **T. Guazzoni**
CHECKED BY: **T. Guazzoni**
SHEET **71** OF **198**

DIRECTION	MILEPOINT	LOCATION CODE (SHEET 2)	SIGN CODE	WIDTH (IN)	HEIGHT (IN)	SHEETING REMARKS	SIGN LEGEND	NEW SIGNS "A"	NEW SIGNS "B"	EXISTING SIGNS RETAIN	EXISTING SIGNS SALVAGE FROM	EXISTING SIGNS SALVAGE TO	EXISTING SIGNS REMOVE	EXIST POST RETAIN	EXIST POST REMOVE	NUMBER OF NEW POSTS	SQUARE STEEL (IN) 1.75 (LB / FT) 1.88	SQUARE STEEL (IN) 2.00 (LB / FT) 2.42	SQUARE STEEL (IN) 2.50 (LB / FT) 3.35	TUBULAR STEEL Ø (IN) FOUNDATION	TUBULAR STEEL Ø (IN) 3.00 (LB / FT) 7.60	TUBULAR STEEL Ø (IN) 3.50 (LB / FT) 9.00	TUBULAR STEEL Ø (IN) 4.00 (LB / FT) 10.80	TUBULAR STEEL Ø (IN) 5.00 (LB / FT) 14.60	SIGN FRAME REQUIRED	REMARKS	SIGN DETAIL: DETAIL IN SHS	SIGN DETAIL: DETAIL ON SHEET NUMBER	SIGN DETAIL: DETAIL ON STD SHEET NUMBER
WILMINGTON VT 100							FY-FLUORESCENT YELLOW FYG-FLUORESCENT YELLOW GREEN																			"SHS"-STANDARD HIGHWAY SIGNS			
NB	0.949	D	R1-1	30	30			6.25								1		X									X		
NB	0.984	D	R1-1	24	24		STOP (INSTALLED BACK-TO-BACKWITH THE LEGAL LOAD LIMIT SIGN)						1		X												RADER ROAD (TH-69), NORTHERLY APPROACH.			
		C	VR-017	24	24		LEGAL LOAD LIMIT 24,000 LBS 						1													INSTALLED BACK-TO-BACK WITH THE STOP SIGN			
		D	R1-1	30	30			6.25								1		X									X		
NB	1.366	A	W2-2R	30	30		SIDE ROAD RIGHT (SYMBOL) 						1		X															
NB	1.396	A	W2-2MaR	30	30			6.25								1		X								INSTALL 160 FT ± NORTH OF PREVIOUS LOCATION.		6	
		A	W16-8	24	8			1.33																				8	
NB	1.480	C	VR-017	24	24								1		X											DIX ROAD (TH-35)			
		C	N/A	18	24		DEAD END ROAD 				1																		
		C	VR-017	24	30			5.00								1		X											E-141
		C	N/A	18	24		DEAD END ROAD					1														INSTALL THE TOWN SIGN UNDER THE NEW LEGAL LOAD LIMIT SIGN.			
NB	1.488	D	R1-1	24	24								1		X												DIX ROAD (TH-35)			
		D	R1-1	30	30			6.25								1		X									X		
NB	1.540	A	VD-062AS	72	16		BUSINESS SIGN 			1				X															
NB	1.772	A	W1-4R	30	30	FY		6.25								1		X								INSTALL 25 FT ± IN ADVANCE OF EXISTING ASSEMBLY (TO BE REMOVED). BEHIND RAIL.		X		
							SHEET TOTALS	37.58 SF	0.00 SF	1 EA	1 EA	1 EA	5 EA	0 EA	0 EA	6 EA		90 FT									
							TOWN TOTALS	825.4	0.0	64.0	15.0	15.0	145	0.0	0.0	145		2175.0									

SIGN SUMMARY SHEET

VERMONT AGENCY OF TRANSPORTATION

PROJECT NAME: **Stamford-Andover VT100**
PROJECT NUMBER: **STPG SIGN(20)**

FILE NAME: **Wilmington.xls**
PROJECT MANAGER: **N. Averv**
DESIGNED BY: **M. Miller**
WILMINGTON SHEET 2

PLOT DATE: **8/6/2009**
DRAWN BY: **T. Guazzoni**
CHECKED BY: **T. Guazzoni**
SHEET **72** OF **198**

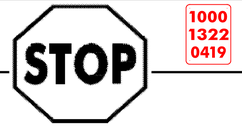
DIRECTION	MILEPOINT	LOCATION CODE (SHEET 2)	SIGN CODE	WIDTH (IN)	HEIGHT (IN)	SHEETING REMARKS	SIGN LEGEND	NEW SIGNS "A"	NEW SIGNS "B"	EXISTING SIGNS RETAIN	EXISTING SIGNS SALVAGE FROM	EXISTING SIGNS SALVAGE TO	EXISTING SIGNS REMOVE	EXIST POST RETAIN	EXIST POST REMOVE	NUMBER OF NEW POSTS	SQUARE STEEL (IN) 1.75 (LB / FT) 1.88	SQUARE STEEL (IN) 2.00 (LB / FT) 2.42	SQUARE STEEL (IN) 2.50 (LB / FT) 3.35	TUBULAR STEEL Ø (IN) FOUNDATION	TUBULAR STEEL Ø (IN) 3.00 (LB / FT) 7.60	TUBULAR STEEL Ø (IN) 3.50 (LB / FT) 9.00	TUBULAR STEEL Ø (IN) 4.00 (LB / FT) 10.80	TUBULAR STEEL Ø (IN) 5.00 (LB / FT) 14.60	SIGN FRAME REQUIRED	REMARKS	SIGN DETAIL: DETAIL IN SHS	SIGN DETAIL: DETAIL ON SHEET NUMBER	SIGN DETAIL: DETAIL ON STD SHEET NUMBER
WILMINGTON VT 100							FY-FLUORESCENT YELLOW FYG-FLUORESCENT YELLOW GREEN																			"SHS"-STANDARD HIGHWAY SIGNS			
		A	W13-1	24	24	FY		4.00																		NOTE UPSIZED ADVISORY SPEED PLAQUE.	X		
NB	1.777	A	W1-4R	30	30		REVERSE CURVE RIGHT						1		X													
		A	W13-1	18	18		35 MPH (PLAQUE)						1															
NB	1.980	A	VW-168L	30	30		HIDDEN SIDE ROAD LEFT (TEXT)						1		X													
NB	2.000	A	VW-054L	30	30			6.25								1		X							INSTALL 100 FT ± NORTH OF THE HIDDEN SIDE ROAD SIGN THAT WAS JUST REMOVED.			E-154
NB	2.155	A	VD-062BC	74.75	16		TRAVEL INFO SYMBOLS			1				X														
		A	VD-062C	74.75	16		TRAVEL INFO			1																		
NB	2.180	A	VW-544	36	36								1		X													
		A	VW-544	36	36			9.00								2		X									E-154
NB	2.275	A	W11-2	30	30		PEDESTRIAN SYMBOL			1				X														
		A	W16-9P	24	12	FYG		2.00																	ADD THE "AHEAD" PLAQUE UNDER THE PED SIGN	X		
NB	2.310	A	W3-1	36	36		STOP AHEAD			1				X														
NB	2.348	A	M2-1	21	15		JCT			1				X														
		A	M1-5	24	24		VERMONT ROUTE 9			1				X														
NB	2.391	A	D1-1A	72	12		<--- WILMINGTON 1			1				X														
							SHEET TOTALS	21.25 SF	0.00 SF	7 EA	0 EA	0 EA	4 EA	0 EA	0 EA	3 EA	45 FT											
							TOWN TOTALS	825.4	0.0	64.0	15.0	15.0	145	0.0	0.0	145	2175.0											

SIGN SUMMARY SHEET

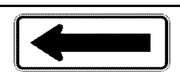
VERMONT AGENCY OF TRANSPORTATION

PROJECT NAME: **Stamford-Andover VT100**
PROJECT NUMBER: **STPG SIGN(20)**

FILE NAME: **Wilmington.xls** PLOT DATE: **8/6/2009**
PROJECT MANAGER: **N. Avery** DRAWN BY: **T. Guazzoni**
DESIGNED BY: **M. Miller** CHECKED BY: **T. Guazzoni**
WILMINGTON SHEET 3 SHEET **73** OF **198**

DIRECTION	MILEPOINT	LOCATION CODE (SHEET 2)	SIGN CODE	WIDTH (IN)	HEIGHT (IN)	SHEETING REMARKS	SIGN LEGEND	NEW SIGNS "A"	NEW SIGNS "B"	EXISTING SIGNS RETAIN	EXISTING SIGNS SALVAGE FROM	EXISTING SIGNS SALVAGE TO	EXISTING SIGNS REMOVE	EXIST POST RETAIN	EXIST POST REMOVE	NUMBER OF NEW POSTS	SQUARE STEEL (IN) 1.75 (LB / FT) 1.88	SQUARE STEEL (IN) 2.00 (LB / FT) 2.42	SQUARE STEEL (IN) 2.50 (LB / FT) 3.35	TUBULAR STEEL Ø (IN) FOUNDATION	TUBULAR STEEL Ø (IN) 3.00 (LB / FT) 7.60	TUBULAR STEEL Ø (IN) 3.50 (LB / FT) 9.00	TUBULAR STEEL Ø (IN) 4.00 (LB / FT) 10.80	TUBULAR STEEL Ø (IN) 5.00 (LB / FT) 14.60	SIGN FRAME REQUIRED	REMARKS	SIGN DETAIL: DETAIL IN SHS	SIGN DETAIL: DETAIL ON SHEET NUMBER	SIGN DETAIL: DETAIL ON STD SHEET NUMBER
WILMINGTON VT 100							FY-FLUORESCENT YELLOW FYG-FLUORESCENT YELLOW GREEN																			"SHS"-STANDARD HIGHWAY SIGNS			
		A	D1-1A	72	12		<--- BENNINGTON 22			1				X														
		A	D1-1A	72	12		MARLBORO 8 --->			1				X														
		A	D1-1A	72	12		BRATTLEBORO 18 --->			1				X														
NB	2.424	A	M3-4	24	12		WEST			1				X														
		A	M1-5	24	24		VERMONT ROUTE 9			1				X														
		A	M6-1	21	15		<--- LEFT			1				X														
		A	M3-1	24	12		NORTH			1				X														
		A	M1-5	30	24		VERMONT ROUTE 100			1				X														
		A	M6-1	21	15		<--- LEFT			1				X														
		A	M3-2	24	12		EAST			1				X														
		A	M1-5	24	24		VERMONT ROUTE 9			1				X														
		A	M6-1	21	15		RIGHT --->			1				X														
NB	2.464	A	R1-1	36	36		 1000 1322 0419	9.00								2		X									INSTALL THE NEW UPSIZED STOP ON 2 POSTS, 25 FT ± IN ADVANCE OF THE EXISTING SIGN	X		
NB	2.469	A	R1-1	30	30		STOP						1		X														
			BECOMES VT ROUTE 9																										
SIGN SUMMARY SHEET							SHEET TOTALS	9.00 SF	0.00 SF	12 EA	0 EA	0 EA	1 EA	0 EA	0 EA	2 EA		30 FT									
VERMONT AGENCY OF TRANSPORTATION							TOWN TOTALS	825.4	0.0	64.0	15.0	15.0	145	0.0	0.0	145		2175.0									

PROJECT NAME: **Stamford-Andover VT100**
PROJECT NUMBER: **STPG SIGN(20)**
FILE NAME: **Wilminaton.xls**
PROJECT MANAGER: **N. Averv**
DESIGNED BY: **M. Miller**
PLOT DATE: **8/6/2009**
DRAWN BY: **T. Guazzoni**
CHECKED BY: **T. Guazzoni**
WILMINGTON SHEET 4
SHEET **74** OF **198**

DIRECTION	MILEPOINT	LOCATION CODE (SHEET 2)	SIGN CODE	WIDTH (IN)	HEIGHT (IN)	SHEETING REMARKS	SIGN LEGEND	NEW SIGNS		EXISTING SIGNS				EXIST POST		NUMBER OF NEW POSTS	SQUARE STEEL (IN)			TUBULAR STEEL Ø (IN)				SIGN FRAME REQUIRED	REMARKS	SIGN DETAIL		
								"A"	"B"	RETAIN	SALVAGE FROM	SALVAGE TO	REMOVE	RETAIN	REMOVE		1.75 (LB / FT)	2.00 (LB / FT)	2.50 (LB / FT)	FOUNDATION	3.00 (LB / FT)	4.00 (LB / FT)	5.00 (LB / FT)			DETAIL IN SHS	DETAIL ON SHEET NUMBER	DETAIL ON STD SHEET NUMBER
																	1.88	2.42	3.35		7.60	9.00	10.80	14.60					
WILMINGTON VT 100							FY-FLUORESCENT YELLOW FYG-FLUORESCENT YELLOW GREEN																		"SHS"-STANDARD HIGHWAY SIGNS			
SB	2.469	E	R1-1	30	30		STOP			1				X											RETAIN THE "GATEPOSTED" LEFT-SIDE 30" STOP SIGN FOR NB VT-100.			
SB	2.429	F	M3-3	24	12		SOUTH			1				X														
		F	M1-5	30	24		VERMONT ROUTE 100			1																		
SB	2.392	F	R2-1	24	30		SPEED LIMIT 50			1				X														
SB	2.354	F	D2-1	72	12		JACKSONVILLE 6			1				X														
		F	D2-1	72	12		WHITINGHAM 9			1																		
SB	2.319	F	W11-1	30	30	FYG	BICYCLE SYMBOL			1				X														
		F	W16-1	24	30	FYG	SHARE THE ROAD (TEXT)			1																		
SB	2.210	F	VW-168R	30	30		HIDDEN SIDE ROAD RIGHT						1		X													
SB	2.160	F	VW-054R	30	30			•6.25 6.25								1		X			•SEE NOTE ON NEXT SHEET			INSTALL 260 FT ± SOUTH OF EXISTING HIDDEN SIDE ROAD SIGN BEHIND GUARD RAIL.			E-154
SB	1.925	F	W1-6	48	24			8.00								2		X								INSTALL 175 FT IN ADVANCE OF EXISTING (NORTH OF) THE LARGE ARROW/CLUSTER FACING NB TRAFFIC, AT M.P. 1.890.	X		
SB	1.923	E	W1-6	48	24			8.00								2		X								INSTALL FACING NB TRAFFIC, 5 FT ± SOUTH OF THE SB FACING ARROW. MAINTAIN 10 FT MIN TO POLE.	X		
SB	1.892	F	W1-6	48	24			8.00								2		X								INSTALL FACING SB TRAFFIC, 10 FT NORTH OF THE NB FACING ARROW (WHICH WILL BE REPLACED).	X		
SB	1.890	E	W1-6	48	24								1															
		E	OM1-1	18	18		OBJECT MARKER						1		X															
							SHEET TOTALS	~~36.50~~ 30.25	0.00	8	0	0	3	0	0	7			105									
								SF	SF	EA	EA	EA	EA	EA	EA	EA			FT									
							TOWN TOTALS	825.4	0.0	64.0	15.0	15.0	145	0.0	0.0	145			2175.0									

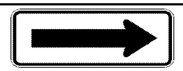
SIGN SUMMARY SHEET

VERMONT AGENCY OF TRANSPORTATION

PROJECT NAME: **Stamford-Andover VT100**
PROJECT NUMBER: **STPG SIGN(20)**

FILE NAME: **Wilminaton.xls**
PROJECT MANAGER: **N. Averv**
DESIGNED BY: **M. Miller**
WILMINGTON SHEET 5

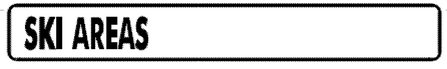
PLOT DATE: **8/6/2009**
DRAWN BY: **T. Guazzoni**
CHECKED BY: **T. Guazzoni**
SHEET **75** OF **198**

DIRECTION	MILEPOINT	LOCATION CODE (SHEET 2)	SIGN CODE	WIDTH (IN)	HEIGHT (IN)	SHEETING REMARKS	SIGN LEGEND	NEW SIGNS "A"	NEW SIGNS "B"	EXISTING SIGNS RETAIN	EXISTING SIGNS SALVAGE FROM	EXISTING SIGNS SALVAGE TO	EXISTING SIGNS REMOVE	EXIST POST RETAIN	EXIST POST REMOVE	NUMBER OF NEW POSTS	SQUARE STEEL (IN) 1.75 (LB / FT) 1.88	SQUARE STEEL (IN) 2.00 (LB / FT) 2.42	SQUARE STEEL (IN) 2.50 (LB / FT) 3.35	TUBULAR STEEL Ø (IN) FOUNDATION	TUBULAR STEEL Ø (IN) 3.00 (LB / FT) 7.60	TUBULAR STEEL Ø (IN) 3.50 (LB / FT) 9.00	TUBULAR STEEL Ø (IN) 4.00 (LB / FT) 10.80	TUBULAR STEEL Ø (IN) 5.00 (LB / FT) 14.60	SIGN FRAME REQUIRED	REMARKS	SIGN DETAIL: DETAIL IN SHS	SIGN DETAIL: DETAIL ON SHEET NUMBER	SIGN DETAIL: DETAIL ON STD SHEET NUMBER
WILMINGTON VT 100							FY-FLUORESCENT YELLOW FYG-FLUORESCENT YELLOW GREEN																			"SHS"-STANDARD HIGHWAY SIGNS			
		E	W1-6	48	24			8.00								2		X									X		
SB	1.615	F	W2-2	30	30		HIDDEN SIDE ROAD LEFT SYMBOL						1		X														
SB	1.570	F	W2-2Ma	30	30			•6.25 6.25					I			1		X		• SEE NOTE BELOW						INSTALL 235 FT ± SOUTH OF THE EXISTING SIGN, JUST BEYOND THE END OF GUARDRAIL.		6	
		F	W16-8	24	8			1.33																				8	
SB	1.270	G	VR-017	24	24		LEGAL LOAD LIMIT 24,000 LBS						1		X												BOYD HILL RD (TH-34)			
		H	R1-1	24	24		STOP (ON BACK)						1																
		G	VR-017	24	30			5.00					I			1		X										E-141
SB	1.257	H	R1-1	30	30			6.25								1		X									INSTALL ON RIGHT SIDE OF TH-34 AT JCT w/ VT-100.	X		
SB	0.705	F	N/A				REMOVE EMPTY POST								X														
SB	0.560	F	S3-1	30	30		SCHOOL BUS STOP AHEAD						1		X												•DURING THE SUMMER OF 2010, IT WAS DISCOVERED THAT THESE FOUR NEW SIGNS WERE VANDALIZED (GUN SHOTS). THEY REMOVED AND REPLACED AS PART OF THIS CONTRACT.			
		F	W1-2R	30	30		CURVE RIGHT						1																
		F	W1-2Mh R	30	30			•6.25 6.25					I			1		X										6	
SB	0.040	G	VR-017	24	24								1		X												GREEN ROAD (TH-38)			
		G	VR-017	24	30			5.00								1		X										E-141
SB	0.032	H	R1-1	24	24								1		X												GREEN ROAD (TH-38)			
SIGN SUMMARY SHEET							SHEET TOTALS	~~50.58~~ ~~38.00~~ SF	0.00 SF	0 EA	0 EA	0 EA	~~10~~ ~~7~~ EA	0 EA	0 EA	7 EA	105 FT												
VERMONT AGENCY OF TRANSPORTATION							TOWN TOTALS	825.4	0.0	64.0	15.0	15.0	145	0.0	0.0	145	2175.0											

PROJECT NAME: **Stamford-Andover VT100**
PROJECT NUMBER: **STPG SIGN(20)**

FILE NAME: **Wilmington.xls**
PROJECT MANAGER: **N. Averv**
DESIGNED BY: **M. Miller**
WILMINGTON SHEET 6

PLOT DATE: **8/6/2009**
DRAWN BY: **T. Guazzoni**
CHECKED BY: **T. Guazzoni**
SHEET **76** OF **198**

DIRECTION	MILEPOINT	LOCATION CODE (SHEET 2)	SIGN CODE	WIDTH (IN)	HEIGHT (IN)	SHEETING REMARKS	SIGN LEGEND	NEW SIGNS "A"	NEW SIGNS "B"	EXISTING SIGNS RETAIN	EXISTING SIGNS SALVAGE FROM	EXISTING SIGNS SALVAGE TO	EXISTING SIGNS REMOVE	EXIST POST RETAIN	EXIST POST REMOVE	NUMBER OF NEW POSTS	SQUARE STEEL (IN) 1.75 (LB / FT) 1.88	SQUARE STEEL (IN) 2.00 (LB / FT) 2.42	SQUARE STEEL (IN) 2.50 (LB / FT) 3.35	TUBULAR STEEL Ø (IN) FOUNDATION	TUBULAR STEEL Ø (IN) 3.00 (LB / FT) 7.60	TUBULAR STEEL Ø (IN) 3.50 (LB / FT) 9.00	TUBULAR STEEL Ø (IN) 4.00 (LB / FT) 10.80	TUBULAR STEEL Ø (IN) 5.00 (LB / FT) 14.60	SIGN FRAME REQUIRED	REMARKS	SIGN DETAIL: DETAIL IN SHS	SIGN DETAIL: DETAIL ON SHEET NUMBER	SIGN DETAIL: DETAIL ON STD SHEET NUMBER
WILMINGTON VT 100							FY-FLUORESCENT YELLOW FYG-FLUORESCENT YELLOW GREEN																			"SHS"-STANDARD HIGHWAY SIGNS			
SB	0.032	H	R1-1	30	30			6.25			I	I				3 ~~1~~		X			AT THE REQUEST OF THE TOWN, THIS SIGN WAS RELOCATED FARTHER FROM THE INTERSECTION.					INSTALL AS CLOSE TO ACTUAL STOPPING POINT AS POSSIBLE.	X		
			VT ROUTE 100 RESUMES AT BREAK IN CENTERLINE OF VT ROUTE 9																										
NB	2.556	C	VR-017	24	30								1		X												LISLE HILL ROAD (TH-61)			
		C	VR-017	24	30			5.00								1		X											E-141
NB	2.564	D	R1-1	30	30								1		X												LISLE HILL ROAD (TH-61)			
		D	R1-1	30	30			6.25								1		X										X		
NB	2.585	A	M3-1	24	12								1		X															
		A	M1-5	30	24								1																	
		A	M3-1	24	12			2.00								1		X								GREEN ON WHITE SHEETING	X		
		A	M1-5	30	24			5.00																					E-136B
NB	2.600	A	R2-1	24	30								1		X															
		A	R2-1	24	30			5.00								1		X										X		
NB	2.650	A	D1-1S	72	10								1		X															
		A	D2-1	72	10								1																	
		A	D2-1	72	12			6.00								2		X										5	
SIGN SUMMARY SHEET							SHEET TOTALS	35.50	0.00	0	~~1~~	~~0~~	~~9~~ ~~7~~	0	0	7		105											
VERMONT AGENCY OF TRANSPORTATION								SF	SF	EA	EA	EA	EA	EA	EA	EA		FT										
							TOWN TOTALS	825.4	0.0	64.0	15.0	15.0	145	0.0	0.0	145		2175.0											

PROJECT NAME: **Stamford-Andover VT100**
PROJECT NUMBER: **STPG SIGN(20)**
FILE NAME: **Wilminaton.xls**
PROJECT MANAGER: **N. Averv**
DESIGNED BY: **M. Miller**
WILMINGTON SHEET 7
PLOT DATE: **8/6/2009**
DRAWN BY: **T. Guazzoni**
CHECKED BY: **T. Guazzoni**
SHEET **77** OF **198**

DIRECTION	MILEPOINT	LOCATION CODE (SHEET 2)	SIGN CODE	WIDTH (IN)	HEIGHT (IN)	SHEETING REMARKS	SIGN LEGEND	NEW SIGNS "A"	NEW SIGNS "B"	EXISTING SIGNS RETAIN	EXISTING SIGNS SALVAGE FROM	EXISTING SIGNS SALVAGE TO	EXISTING SIGNS REMOVE	EXIST POST RETAIN	EXIST POST REMOVE	NUMBER OF NEW POSTS	SQUARE STEEL (IN) 1.75 (LB / FT) 1.88	SQUARE STEEL (IN) 2.00 (LB / FT) 2.42	SQUARE STEEL (IN) 2.50 (LB / FT) 3.35	TUBULAR STEEL Ø (IN) FOUNDATION	TUBULAR STEEL Ø (IN) 3.00 (LB / FT) 7.60	TUBULAR STEEL Ø (IN) 3.50 (LB / FT) 9.00	TUBULAR STEEL Ø (IN) 4.00 (LB / FT) 10.80	TUBULAR STEEL Ø (IN) 5.00 (LB / FT) 14.60	SIGN FRAME REQUIRED	REMARKS	SIGN DETAIL: DETAIL IN SHS	SIGN DETAIL: DETAIL ON SHEET NUMBER	SIGN DETAIL: DETAIL ON STD SHEET NUMBER
WILMINGTON VT 100							FY-FLUORESCENT YELLOW FYG-FLUORESCENT YELLOW GREEN																			"SHS"-STANDARD HIGHWAY SIGNS			
		A	D2-1	72	12			6.00																				5	
NB	2.715	A	W1-3R	30	30		RIGHT REVERSE TURN SYMBOL						1		X														
NB	2.758	A	R2-1	24	30		SPEED LIMIT 25			1				X															
NB	2.780	A	VW-054R	30	30		HIDDEN DRIVE RIGHT 						1		X														
NB	2.785	A	W1-3R	30	30			6.25								1		X									INSTALL 25 FT ± NORTH OF HIDDEN DRIVE RIGHT SIGN JUST-REMOVED.	X	
NB	2.830	A	OM-3R	12	36			3.00								1											INSTALL 250 FT ± NORTH OF HIDDEN DRIVE RIGHT SIGN JUST-REMOVED.	X	
NB	2.832	A	N/A				EMPTY POST								X														
NB	2.903	A	R2-1	24	30		SPEED LIMIT 25			1				X															
NB	2.987	C	VR-017	24	30								1		X												STOWE HILL RD (TH-21)			
		C	VR-017	24	30			5.00								1		X											E-141
NB	2.995	D	R1-1	30	30								1		X												STOWE HILL RD (TH-21)			
		D	R1-1	30	30			6.25								1		X										X	
NB	3.080	A	R2-1	24	30								1		X														
		A	R2-1	24	30			5.00								1		X										X	
NB	3.233	C	VR-017	24	30		LEGAL LOAD LIMIT 24,000 LBS			1				X													ADAMS DR (TH-22)			
SIGN SUMMARY SHEET							SHEET TOTALS	31.50	0.00	3	0	0	5	0	0	~~4~~ 5		60									
								SF	SF	EA	EA	EA	EA	EA	EA	EA		FT									
VERMONT AGENCY OF TRANSPORTATION							TOWN TOTALS	825.4	0.0	64.0	15.0	15.0	145	0.0	0.0	145		2175.0									

PROJECT NAME: **Stamford-Andover VT100**
PROJECT NUMBER: **STPG SIGN(20)**

FILE NAME: **Wilmington.xls**
PROJECT MANAGER: **N. Averv**
DESIGNED BY: **M. Miller**
WILMINGTON SHEET 8

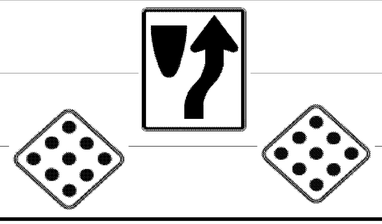
PLOT DATE: **8/6/2009**
DRAWN BY: **T. Guazzoni**
CHECKED BY: **T. Guazzoni**
SHEET **78** OF **198**

DIRECTION	MILEPOINT	LOCATION CODE (SHEET 2)	SIGN CODE	WIDTH (IN)	HEIGHT (IN)	SHEETING REMARKS	SIGN LEGEND	NEW SIGNS "A"	NEW SIGNS "B"	EXISTING SIGNS RETAIN	EXISTING SIGNS SALVAGE FROM	EXISTING SIGNS SALVAGE TO	EXISTING SIGNS REMOVE	EXIST POST RETAIN	EXIST POST REMOVE	NUMBER OF NEW POSTS	SQUARE STEEL (IN) 1.75 (LB / FT) 1.88	SQUARE STEEL (IN) 2.00 (LB / FT) 2.42	SQUARE STEEL (IN) 2.50 (LB / FT) 3.35	TUBULAR STEEL Ø (IN) FOUNDATION	TUBULAR STEEL Ø (IN) 3.00 (LB / FT) 7.60	TUBULAR STEEL Ø (IN) 3.50 (LB / FT) 9.00	TUBULAR STEEL Ø (IN) 4.00 (LB / FT) 10.80	TUBULAR STEEL Ø (IN) 5.00 (LB / FT) 14.60	SIGN FRAME REQUIRED	REMARKS	SIGN DETAIL: DETAIL IN SHS	SIGN DETAIL: DETAIL ON SHEET NUMBER	SIGN DETAIL: DETAIL ON STD SHEET NUMBER
WILMINGTON VT 100							FY-FLUORESCENT YELLOW FYG-FLUORESCENT YELLOW GREEN																				"SHS"-STANDARD HIGHWAY SIGNS			
NB	3.241	D	R1-1	30	30								1														ADAMS DR (TH-22)			
		D	R1-1	30	30			6.25								1		X									X		
NB	3.467	A	R2-1	24	30		SPEED LIMIT 40			1				X															
NB	3.507	A	VW-133R	30	30		HIDDEN DRIVES RIGHT				1				X												340			
NB	3.565	A	VW-133R	30	30		HIDDEN DRIVES RIGHT					1				1		X									SALVAGE THE SIGN TO A NEW POSITION ~~300~~ FT ± AHEAD OF PREVIOUS LOCATION.			
NB	3.815	A	S3-1	30	30								1		X															
		A	S3-1	30	30			6.25								1		X									X		
NB	3.858	A	R2-1	24	30		SPEED LIMIT 40			1				X															
NB	3.950	A	W1-2R	30	30		RIGHT CURVE				1	1			X	1		X											
		A	W13-1	18	18		35 MPH PLAQUE				1	1																	
NB	3.978	D	R1-1	30	30			6.25								1		X			HAPPY HAVEN ROAD - PRIVATE					JUST SOUTH OF WOFFENDED ROAD ON ~~LEFT~~. RIGHT	X		
NB	4.085	A	S1-1YG	36	36		PENTAGONAL SCHOOL SYMBOL			1				X															
		A	W16-9YG	36	20		AHEAD (PLAQUE)			1																			
NB	4.212	A	W1-2L	30	30		LEFT CURVE						1		X														
		A	R2-1	24	30		SPEED LIMIT 40					1				1		X									SALVAGED FROM M.P. 4.275			
SIGN SUMMARY SHEET							SHEET TOTALS	18.75 SF	0.00 SF	4 EA	3 EA	4 EA	3 ~~2~~ EA	0 EA	0 EA	6 EA		90 FT											
VERMONT AGENCY OF TRANSPORTATION							TOWN TOTALS	825.4	0.0	64.0	15.0	15.0	145	0.0	0.0	145		2175.0											

PROJECT NAME: **Stamford-Andover VT100**
PROJECT NUMBER: **STPG SIGN(20)**

FILE NAME: **Wilminaton.xls**
PROJECT MANAGER: **N. Averv**
DESIGNED BY: **M. Miller**
WILMINGTON SHEET 9

PLOT DATE: **8/6/2009**
DRAWN BY: **T. Guazzoni**
CHECKED BY: **T. Guazzoni**
SHEET **79** OF **198**

DIRECTION	MILEPOINT	LOCATION CODE (SHEET 2)	SIGN CODE	WIDTH (IN)	HEIGHT (IN)	SHEETING REMARKS	SIGN LEGEND	NEW SIGNS "A"	NEW SIGNS "B"	EXISTING SIGNS RETAIN	EXISTING SIGNS SALVAGE FROM	EXISTING SIGNS SALVAGE TO	EXISTING SIGNS REMOVE	EXIST POST RETAIN	EXIST POST REMOVE	NUMBER OF NEW POSTS	SQUARE STEEL (IN) 1.75 (LB / FT) 1.88	SQUARE STEEL (IN) 2.00 (LB / FT) 2.42	SQUARE STEEL (IN) 2.50 (LB / FT) 3.35	FOUNDATION	TUBULAR STEEL Ø (IN) 3.00 (LB / FT) 7.60	TUBULAR STEEL Ø (IN) 3.50 (LB / FT) 9.00	TUBULAR STEEL Ø (IN) 4.00 (LB / FT) 10.80	TUBULAR STEEL Ø (IN) 5.00 (LB / FT) 14.60	SIGN FRAME REQUIRED	REMARKS	SIGN DETAIL: DETAIL IN SHS	SIGN DETAIL: DETAIL ON SHEET NUMBER	SIGN DETAIL: DETAIL ON STD SHEET NUMBER
WILMINGTON VT 100							FY-FLUORESCENT YELLOW FYG-FLUORESCENT YELLOW GREEN																				"SHS"-STANDARD HIGHWAY SIGNS			
NB	4.275	A	R2-1	24	30		SPEED LIMIT 40				1			X												SALVAGE TO M.P. 4.212			
		A	W1-2L	30	30			6.25								1		X									X		
NB	4.380	A	VD-062AS	72	16		BUSINESS SIGN			1				X															
NB	4.501	A	R2-1	24	30		SPEED LIMIT 50			1				X															
NB	4.709	A	VD-062AS	72	16		BUSINESS SIGN			1				X															
		A	VD-062AS	72	16		BUSINESS SIGN			1																			
		A	VD-062AS	72	16		BUSINESS SIGN			1																			
NB	4.826	A	D1-1S	72	10								1		X														
		A	D1-1S	72	10								1																
		A	D1-1	72	12			6.00								2		X								BEHIND RAIL		5	
		A	D1-1	72	12			6.00																			5	
NB	4.860	J	R4-7	24	30								1		X														
		J	OM1-1	18	18								1																
		K	OM1-1	18	18								1														IN THE FALL OF 2010, THIS ISLAND WAS REMOVED BY AOT-DIST. #1. THESE NEW SIGNS WERE REMOVED BY AOT CREWS.			
		J	R4-7	24	30			5.00								1		X								INSTALL AT 7 FT VERTICAL CLEARANCE	X		E-121
							SHEET TOTALS	23.25 SF	0.00 SF	5 EA	1 EA	0 EA	5 EA	0 EA	0 EA	4 EA		60 FT									
							TOWN TOTALS	825.4	0.0	64.0	15.0	15.0	145	0.0	0.0	145		2175.0											

SIGN SUMMARY SHEET

VERMONT AGENCY OF TRANSPORTATION

PROJECT NAME: **Stamford-Andover VT100**
PROJECT NUMBER: **STPG SIGN(20)**

FILE NAME: **Wilmington.xls**
PROJECT MANAGER: **N. Avery**
DESIGNED BY: **M. Miller**
WILMINGTON SHEET 10

PLOT DATE: **8/6/2009**
DRAWN BY: **T. Guazzoni**
CHECKED BY: **T. Guazzoni**
SHEET **80** OF **198**

DIRECTION	MILEPOINT	LOCATION CODE (SHEET 2)	SIGN CODE	WIDTH (IN)	HEIGHT (IN)	SHEETING REMARKS	SIGN LEGEND	NEW SIGNS "A"	NEW SIGNS "B"	EXISTING SIGNS RETAIN	EXISTING SIGNS SALVAGE FROM	EXISTING SIGNS SALVAGE TO	EXISTING SIGNS REMOVE	EXIST POST RETAIN	EXIST POST REMOVE	NUMBER OF NEW POSTS	SQUARE STEEL (IN) 1.75 (LB / FT) 1.88	SQUARE STEEL (IN) 2.00 (LB / FT) 2.42	SQUARE STEEL (IN) 2.50 (LB / FT) 3.35	FOUNDATION	TUBULAR STEEL Ø (IN) 3.00 (LB / FT) 7.60	TUBULAR STEEL Ø (IN) 3.50 (LB / FT) 9.00	TUBULAR STEEL Ø (IN) 4.00 (LB / FT) 10.80	TUBULAR STEEL Ø (IN) 5.00 (LB / FT) 14.60	SIGN FRAME REQUIRED	REMARKS	SIGN DETAIL: DETAIL IN SHS	SIGN DETAIL: DETAIL ON SHEET NUMBER	SIGN DETAIL: DETAIL ON STD SHEET NUMBER
WILMINGTON VT 100							FY-FLUORESCENT YELLOW FYG-FLUORESCENT YELLOW GREEN																			"SHS"-STANDARD HIGHWAY SIGNS			
		J	OM1-1	18	18			2.25																		YELLOW ON YELLOW; INSTALL AT 4 FT VERTICAL CLEARANCE	X		
		K	OM1-1	18	18			2.25																		INSTALL BACK-TO-BACK WITH THE NB FACING YELLOW CLUSTER	X		
NB	4.921	A	VR-921L	30	30			6.25								1		X								INSTALL 35 FT IN ADVANCE OF EXISTING SIGN (TO BE REMOVED); ASSEMBLY BEHIND RAIL.			E-145A
NB	4.928	A	VR-921L	30	30		LEFT "ONLY" I THRU UP (SYMBOL)						1		X													
NB	4.985	C	M3-1	24	12								1		X													
		C	M1-5	30	24								1															
		C	M6-1	21	15								1															
		C	M3-3	24	12								1															
		C	M1-5	30	24								1															
		C	M6-1	21	15								1															
		C	M3-1	24	12		NORTH VERMONT 100 / SOUTH VERMONT 100	2.00								1		X							#2B	BEHIND GUARD RAIL. GREEN ON WHITE SHEETING.	X	7	
		C	M1-5	30	24			5.00																				E-136B
		C	M6-1L	21	15			2.19																		GREEN ON WHITE SHEETING	X		
		C	M3-3	24	12			2.00																		GREEN ON WHITE SHEETING	X		
		C	M1-5	30	24			5.00																				E-136B
							SHEET TOTALS	26.94 SF	0.00 SF	0 EA	0 EA	0 EA	7 EA	0 EA	0 EA	2 EA		30 FT								
							TOWN TOTALS	825.4	0.0	64.0	15.0	15.0	145	0.0	0.0	145		2175.0								

SIGN SUMMARY SHEET

VERMONT AGENCY OF TRANSPORTATION

PROJECT NAME: Stamford-Andover VT100
PROJECT NUMBER: STPG SIGN(20)

FILE NAME: Wilmington.xls
PROJECT MANAGER: N. Avery
DESIGNED BY: M. Miller
WILMINGTON SHEET 11

PLOT DATE: 8/6/2009
DRAWN BY: T. Guazzoni
CHECKED BY: T. Guazzoni
SHEET 81 OF 198

DIRECTION	MILEPOINT	LOCATION CODE (SHEET 2)	SIGN CODE	WIDTH (IN)	HEIGHT (IN)	SHEETING REMARKS	SIGN LEGEND	NEW SIGNS "A"	NEW SIGNS "B"	EXISTING SIGNS RETAIN	EXISTING SIGNS SALVAGE FROM	EXISTING SIGNS SALVAGE TO	EXISTING SIGNS REMOVE	EXIST POST RETAIN	EXIST POST REMOVE	NUMBER OF NEW POSTS	SQUARE STEEL (IN) 1.75 (LB / FT) 1.88	SQUARE STEEL (IN) 2.00 (LB / FT) 2.42	SQUARE STEEL (IN) 2.50 (LB / FT) 3.35	TUBULAR STEEL Ø (IN) FOUNDATION	TUBULAR STEEL Ø (IN) 3.00 (LB / FT) 7.60	TUBULAR STEEL Ø (IN) 3.50 (LB / FT) 9.00	TUBULAR STEEL Ø (IN) 4.00 (LB / FT) 10.80	TUBULAR STEEL Ø (IN) 5.00 (LB / FT) 14.60	SIGN FRAME REQUIRED	REMARKS	SIGN DETAIL: DETAIL IN SHS	SIGN DETAIL: DETAIL ON SHEET NUMBER	SIGN DETAIL: DETAIL ON STD SHEET NUMBER
WILMINGTON VT 100							FY-FLUORESCENT YELLOW FYG-FLUORESCENT YELLOW GREEN																			"SHS"-STANDARD HIGHWAY SIGNS			
		C	M6-1R	21	15			2.19																		GREEN ON WHITE SHEETING	X		
NB	4.990	J	R4-7	24	30								1		X													
		J	OM1-1	18	18								1															
		K	OM1-1	18	18								1															
		J	R4-7	24	30			5.00								1										INSTALL AT 7 FT VERTICAL CLEARANCE.	X		E-121
		J	OM1-1	18	18			2.25																		YELLOW ON YELLOW; INSTALL AT 4 FT VERTICAL CLEARANCE	X		
		K	OM1-1	18	18			2.25																		BACK TO BACK WITH THE OTHER YELLOW CLUSTER	X		
NB	5.004	A	M3-1	24	12								1		X													
		A	M1-5	30	24								1															
		A	M3-1	24	12			2.00																		GREEN ON WHITE SHEETING. INSTALL 100 FT BEYOND INTERSECTION w/ COLDBROOK RD (TH 1) ON LEFT.	X		
		A	M1-5	30	24			5.00								1												E-136B
NB	5.040	A	R2-1	24	30			5.00								1		X								INSTALL 190' NORTH OF ROUTE MARKER	X		
NB	5.220	A	W11-7	30	30		EQUESTRIAN SYMBOL						1		X													
		A	W16-4	24	18		NEXT 1000 FT (PLAQUE)						1															
NB	5.370	A	W1-2R	30	30		CURVE RIGHT						1		X													
							SHEET TOTALS	23.69 SF	0.00 SF	0 EA	0 EA	0 EA	8 EA	0 EA	0 EA	3/2 EA		30 FT										
							TOWN TOTALS	825.4	0.0	64.0	15.0	15.0	145	0.0	0.0	145		2175.0										

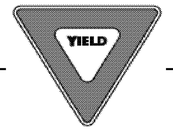
SIGN SUMMARY SHEET

VERMONT AGENCY OF TRANSPORTATION

PROJECT NAME: **Stamford-Andover VT100**
PROJECT NUMBER: **STPG SIGN(20)**

FILE NAME: **Wilmington.xls**
PROJECT MANAGER: **N. Averv**
DESIGNED BY: **M. Miller**
WILMINGTON SHEET 12

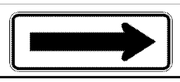
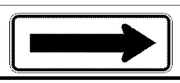
PLOT DATE: **8/6/2009**
DRAWN BY: **T. Guazzoni**
CHECKED BY: **T. Guazzoni**
SHEET **82** OF **198**

DIRECTION	MILEPOINT	LOCATION CODE (SHEET 2)	SIGN CODE	WIDTH (IN)	HEIGHT (IN)	SHEETING REMARKS	SIGN LEGEND	NEW SIGNS "A"	NEW SIGNS "B"	EXISTING SIGNS RETAIN	EXISTING SIGNS SALVAGE FROM	EXISTING SIGNS SALVAGE TO	EXISTING SIGNS REMOVE	EXIST POST RETAIN	EXIST POST REMOVE	NUMBER OF NEW POSTS	SQUARE STEEL (IN) (LB / FT) 1.75 / 1.88	SQUARE STEEL (IN) (LB / FT) 2.00 / 2.42	SQUARE STEEL (IN) (LB / FT) 2.50 / 3.35	TUBULAR STEEL Ø (IN) FOUNDATION (LB / FT) 3.00 / 7.60	TUBULAR STEEL Ø (IN) FOUNDATION (LB / FT) 3.50 / 9.00	TUBULAR STEEL Ø (IN) FOUNDATION (LB / FT) 4.00 / 10.80	TUBULAR STEEL Ø (IN) FOUNDATION (LB / FT) 5.00 / 14.60	SIGN FRAME REQUIRED	REMARKS	SIGN DETAIL: DETAIL IN SHS	SIGN DETAIL: DETAIL ON SHEET NUMBER	SIGN DETAIL: DETAIL ON STD SHEET NUMBER
WILMINGTON VT 100							FY-FLUORESCENT YELLOW FYG-FLUORESCENT YELLOW GREEN																		"SHS"-STANDARD HIGHWAY SIGNS			
		A	W13-1	18	18		35-MPH (PLAQUE)						1														
NB	5.395	A	W1-2R	30	30			6.25								1		X							INSTALL 130 FT ± NORTH OF EXISTING SIGN; MAINTAIN 10 FT MIN TO POLE. .	X		
NB	5.500	A	VD-062AS	72	16		BUSINESS			1				X											ADAMS FARM - THIS BUSINESS HAS CLOSED AND THE SIGN WAS REMOVED BY AOT CREWS.			
NB	5.560	A	W2-1M	36	36		CROSSROAD SYMBOL			1				X														
		A	W16-8A	48	18		HIGLEY HILL RD / HASKELL HILL RD (PLAQUE)			1																		
NB	5.630	C	VR-017	24	30								1		X											HIGLEY HILL RD (TH-3); SOUTHERLY LEG OF TH-3			
		C	VR-017	24	30			5.00								1		X							INSTALL AT A POINT JUST BEYOND THE CONVERGANCE OF THE TWO APPROACHES.			E-141
NB	5.636	D	R1-1	30	30								1		X											SOUTHERLY LEG OF TH-3			
		D	R1-1	30	30			6.25								1		X							INSTALL IN THE SMALL TRIANGULAR "ISLAND" FOR THE SB APPROACH OF TH-3.	X		
NB	5.637	C	R1-2	36	36								1		X											NORTHERLY LEG OF TH-3 FACES EB TRAFFIC ON TH-3. THE NORTHERLY LEG YIELDS; INSTALLED IN THE SMALL TRIANGULAR ISLAND.			
		C	R1-2	36	36			3.89								1		X								X		
NB	5.640	D	R1-1	30	30								1		X											NORTHERLY LEG OF TH-3			
		D	R1-1	30	30			6.25								1		X								X		
NB	6.025	A	W1-4R	30	30		RIGHT REVERSE CURVE						1		X													
		A	W13-1	18	18		30 MPH PLAQUE						1															
SIGN SUMMARY SHEET							SHEET TOTALS	27.64	0.00	3	0	0	7	0	0	5		75								
								SF	SF	EA	EA	EA	EA	EA	EA	EA		FT								
VERMONT AGENCY OF TRANSPORTATION							TOWN TOTALS	825.4	0.0	64.0	15.0	15.0	145	0.0	0.0	145		2175.0								

PROJECT NAME: **Stamford-Andover VT100**
PROJECT NUMBER: **STPG SIGN(20)**

FILE NAME: **Wilminaton.xls**
PROJECT MANAGER: **N. Averv**
DESIGNED BY: **M. Miller**
WILMINGTON SHEET 13

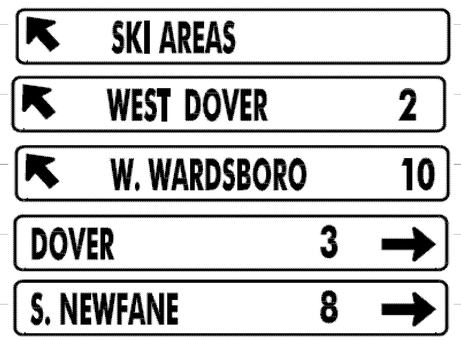
PLOT DATE: **8/6/2009**
DRAWN BY: **T. Guazzoni**
CHECKED BY: **T. Guazzoni**
SHEET **83** OF **198**

DIRECTION	MILEPOINT	LOCATION CODE (SHEET 2)	SIGN CODE	WIDTH (IN)	HEIGHT (IN)	SHEETING REMARKS	SIGN LEGEND	NEW SIGNS "A"	NEW SIGNS "B"	EXISTING SIGNS RETAIN	EXISTING SIGNS SALVAGE FROM	EXISTING SIGNS SALVAGE TO	EXISTING SIGNS REMOVE	EXIST POST RETAIN	EXIST POST REMOVE	NUMBER OF NEW POSTS	SQUARE STEEL (IN) 1.75 / 2.00 / 2.50 (LB / FT) 1.88	SQUARE STEEL (IN) 2.00 (LB / FT) 2.42	SQUARE STEEL (IN) 2.50 (LB / FT) 3.35	FOUNDATION	TUBULAR STEEL Ø (IN) 3.00 (LB / FT) 7.60	TUBULAR STEEL Ø (IN) 3.50 (LB / FT) 9.00	TUBULAR STEEL Ø (IN) 4.00 (LB / FT) 10.80	TUBULAR STEEL Ø (IN) 5.00 (LB / FT) 14.60	SIGN FRAME REQUIRED	REMARKS	SIGN DETAIL: DETAIL IN SHS	SIGN DETAIL: DETAIL ON SHEET NUMBER	SIGN DETAIL: DETAIL ON STD SHEET NUMBER
WILMINGTON VT 100							FY-FLUORESCENT YELLOW FYG-FLUORESCENT YELLOW GREEN																			"SHS"-STANDARD HIGHWAY SIGNS			
NB	6.050	A	W11-7	30	30								1		X														
		A	W11-7P	24	18		XING PLAQUE 						~~1~~																
		A	W11-7	30	30			6.25								1		X									X		
NB	6.120	A	VD-062AS	72	16		BUSINESS SIGN			1				X															
		A	VD-062AS	72	16		BUSINESS SIGN			1																			
NB	6.155	A	W1-2L	30	30			6.25								1		X									INSTALL 200 FT ± NORTH OF THE BUSINESS SIGN ASSEMBLY; MAINTAIN 10 FT MIN TO UTILITY POLE.	X		
		A	W13-1	18	18			2.25																			X		
NB	6.200	A	W1-6	48	24								1		X														
		A	W1-6	48	24			8.00								2		X									X		
NB	6.215	A	W1-6	48	24								1		X														
		A	W1-6	48	24			8.00								2		X									X		
NB	6.225	B	W1-6	48	24								1		X														
		B	W1-6	48	24			8.00								2		X									X		
NB	6.240	B	W1-6	48	24								1		X														
		B	W1-6	48	24			8.00								2		X									X		
SIGN SUMMARY SHEET							SHEET TOTALS	46.75	0.00	2	0	0	~~7~~ 6	0	0	10		150										
VERMONT AGENCY OF TRANSPORTATION								SF	SF	EA	EA	EA	EA	EA	EA	EA		FT										
							TOWN TOTALS	825.4	0.0	64.0	15.0	15.0	145	0.0	0.0	145		2175.0											

PROJECT NAME: **Stamford-Andover VT100**
PROJECT NUMBER: **STPG SIGN(20)**

FILE NAME: **Wilmington.xls**
PROJECT MANAGER: **N. Avery**
DESIGNED BY: **M. Miller**
WILMINGTON SHEET 14

PLOT DATE: **8/6/2009**
DRAWN BY: **T. Guazzoni**
CHECKED BY: **T. Guazzoni**
SHEET **84** OF **198**

DIRECTION	MILEPOINT	LOCATION CODE (SHEET 2)	SIGN CODE	WIDTH (IN)	HEIGHT (IN)	SHEETING REMARKS	SIGN LEGEND	NEW SIGNS "A"	NEW SIGNS "B"	EXISTING SIGNS RETAIN	EXISTING SIGNS SALVAGE FROM	EXISTING SIGNS SALVAGE TO	EXISTING SIGNS REMOVE	EXIST POST RETAIN	EXIST POST REMOVE	NUMBER OF NEW POSTS	SQUARE STEEL (IN) 1.75 (LB / FT) 1.88	SQUARE STEEL (IN) 2.00 (LB / FT) 2.42	SQUARE STEEL (IN) 2.50 (LB / FT) 3.35	TUBULAR STEEL Ø (IN) FOUNDATION	TUBULAR STEEL Ø (IN) 3.00 (LB / FT) 7.60	TUBULAR STEEL Ø (IN) 3.50 (LB / FT) 9.00	TUBULAR STEEL Ø (IN) 4.00 (LB / FT) 10.80	TUBULAR STEEL Ø (IN) 5.00 (LB / FT) 14.60	SIGN FRAME REQUIRED	REMARKS	SIGN DETAIL: DETAIL IN SHS	SIGN DETAIL: DETAIL ON SHEET NUMBER	SIGN DETAIL: DETAIL ON STD SHEET NUMBER
WILMINGTON VT 100							FY-FLUORESCENT YELLOW FYG-FLUORESCENT YELLOW GREEN																			"SHS"-STANDARD HIGHWAY SIGNS			
NB	6.293	A	VD-062AS	72	16		BUSINESS SIGN			1				X														
		A	VD-062B	72	16		BUSINESS SIGN			1																		
NB	6.375	A	W1-10L	30	30		LEFT CURVE w/ MINOR SIDE ROAD RIGHT			1				X														
		A	W16-8A	24	18		E. DOVER RD (PLAQUE)			1																		
NB	6.395	A	D1-1S	72	10								1		X													
		A	D1-1A	72	10								1															
		A	D1-1A	72	10								1															
		A	D1-1A	72	10								1															
		A	D1-1A	72	10								1															
		A	D1-1	72	12			6.00								2			X							5	
		A	D1-1A	72	12			6.00																			5	
		A	D1-1A	72	12			6.00																			5	
		A	D1-1A	72	12			6.00																			5	
		A	D1-1A	72	12			6.00																			5	
NB	6.440	C	VR-017	24	30								1		X												EAST DOVER RD (TH-2) SOUTHERLY APPROACH TO TH-2		
							SHEET TOTALS	30.00 SF	0.00 SF	4 EA	0 EA	0 EA	6 EA	0 EA	0 EA	2 EA	30 FT									
							TOWN TOTALS	825.4	0.0	64.0	15.0	15.0	145	0.0	0.0	145	2175.0									

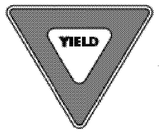
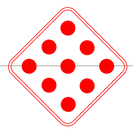
SIGN SUMMARY SHEET

VERMONT AGENCY OF TRANSPORTATION

PROJECT NAME: Stamford-Andover VT100
PROJECT NUMBER: STPG SIGN(20)

FILE NAME: Wilmington.xls
PROJECT MANAGER: N. Avery
DESIGNED BY: M. Miller
WILMINGTON SHEET 15

PLOT DATE: 8/6/2009
DRAWN BY: T. Guazzoni
CHECKED BY: T. Guazzoni
SHEET 85 OF 198

DIRECTION	MILEPOINT	LOCATION CODE (SHEET 2)	SIGN CODE	WIDTH (IN)	HEIGHT (IN)	SHEETING REMARKS	SIGN LEGEND	NEW SIGNS "A"	NEW SIGNS "B"	EXISTING SIGNS RETAIN	EXISTING SIGNS SALVAGE FROM	EXISTING SIGNS SALVAGE TO	EXISTING SIGNS REMOVE	EXIST POST RETAIN	EXIST POST REMOVE	NUMBER OF NEW POSTS	SQUARE STEEL (IN) 1.75 (LB / FT) 1.88	SQUARE STEEL (IN) 2.00 (LB / FT) 2.42	SQUARE STEEL (IN) 2.50 (LB / FT) 3.35	TUBULAR STEEL Ø (IN) FOUNDATION	TUBULAR STEEL Ø (IN) 3.00 (LB / FT) 7.60	TUBULAR STEEL Ø (IN) 3.50 (LB / FT) 9.00	TUBULAR STEEL Ø (IN) 4.00 (LB / FT) 10.80	TUBULAR STEEL Ø (IN) 5.00 (LB / FT) 14.60	SIGN FRAME REQUIRED	REMARKS	SIGN DETAIL: DETAIL IN SHS	SIGN DETAIL: DETAIL ON SHEET NUMBER	SIGN DETAIL: DETAIL ON STD SHEET NUMBER
WILMINGTON VT 100							FY-FLUORESCENT YELLOW FYG-FLUORESCENT YELLOW GREEN																			"SHS"-STANDARD HIGHWAY SIGNS			
		C	VR-017	24	30			5.00								1		X								INSTALL AT A POINT JUST BEYOND THE CONVERGANCE OF THE TWO APPROACHES TO TH-2.			E-141
NB	6.448	D	R1-1	30	30								1		X											SOUTHERLY APPROACH TO TH-2			
		D	R1-1	30	30			6.25								1		X								INSTALL IN THE SMALL TRIANGULAR ISLAND FOR THE SOUTHERLY APPROACH	X		
NB	6.449	C	R1-2	36	36		 						1		X						AN OBJECT MARKER WAS INSTALLED BACK-TO-BACK WITH THIS SIGN. THIS IS A SALVAGED SIGN FROM ANOTHER LOCATION AS PER M. MILLLER, TRAFFIC OPS.						FACES EB TH-2 TRAFFIC AT THE NORTHERLY APPROACH			
		C	R1-2	36	36			3.89								1		X								INSTALL IN THE SMALL TRIANGULAR ISLAND FOR THE NORTHERLY APPROACH	X		
NB	6.457	D	R1-1	30	30								1		X											NORTHERLY APPROACH TO TH-2			
		D	R1-1	30	30			6.25								1		X									X		
NB	6.510	A	M3-1	24	12								1		X														
		A	M1-5	30	24								1																
		A	M3-1	24	12			2.00								1		X							GREEN ON WHITE SHEETING	X		
		A	M1-5	30	24			5.00																				E-136B
NB	7.130	A	W1-4L	30	30		REVERSE CURVE LEFT						1		X														
		A	W13-1	18	18		40-MPH (PLAQUE) 						1																
NB	7.215	A	W1-4L	30	30			6.25								1		X									X		
		A	W13-1	18	18			2.25																			X		
SIGN SUMMARY SHEET							SHEET TOTALS	36.89	0.00	0	0	0	7	0	0	6		90										
								SF	SF	EA	EA	EA	EA	EA	EA	EA		FT										
VERMONT AGENCY OF TRANSPORTATION							TOWN TOTALS	825.4	0.0	64.0	15.0	15.0	145	0.0	0.0	145		2175.0										

PROJECT NAME: **Stamford-Andover VT100**
PROJECT NUMBER: **STPG SIGN(20)**
FILE NAME: **Wilmington.xls**
PROJECT MANAGER: **N. Avery**
DESIGNED BY: **M. Miller**
WILMINGTON SHEET 16
PLOT DATE: **8/6/2009**
DRAWN BY: **T. Guazzoni**
CHECKED BY: **T. Guazzoni**
SHEET **86** OF **198**

DIRECTION	MILEPOINT	LOCATION CODE (SHEET 2)	SIGN CODE	WIDTH (IN)	HEIGHT (IN)	SHEETING REMARKS	SIGN LEGEND	NEW SIGNS "A"	NEW SIGNS "B"	EXISTING SIGNS RETAIN	EXISTING SIGNS SALVAGE FROM	EXISTING SIGNS SALVAGE TO	EXISTING SIGNS REMOVE	EXIST POST RETAIN	EXIST POST REMOVE	NUMBER OF NEW POSTS	SQUARE STEEL (IN) 1.75 (LB / FT) 1.88	SQUARE STEEL (IN) 2.00 (LB / FT) 2.42	SQUARE STEEL (IN) 2.50 (LB / FT) 3.35	TUBULAR STEEL Ø (IN) FOUNDATION	TUBULAR STEEL Ø (IN) 3.00 (LB / FT) 7.60	TUBULAR STEEL Ø (IN) 3.50 (LB / FT) 9.00	TUBULAR STEEL Ø (IN) 4.00 (LB / FT) 10.80	TUBULAR STEEL Ø (IN) 5.00 (LB / FT) 14.60	SIGN FRAME REQUIRED	REMARKS	SIGN DETAIL: DETAIL IN SHS	SIGN DETAIL: DETAIL ON SHEET NUMBER	SIGN DETAIL: DETAIL ON STD SHEET NUMBER
WILMINGTON VT 100							FY-FLUORESCENT YELLOW FYG-FLUORESCENT YELLOW GREEN																			"SHS"-STANDARD HIGHWAY SIGNS			
SB	7.040	F	W2-3MR	30	30								1		X														
		F	W16-8A	24	18								1																
		F	W2-3MaL	30	30	FY		6.25								1		X								INSTALL SIGN AS SHOWN		6	
		F	W16-8	30	18	FY		~~3.75~~ 3.00																				8	
SB	6.972	G	VR-017	24	30								1		X												GALLUP PITCH RD (TH-50)			
		G	VR-017	24	30			5.00								1		X											E-141
SB	6.964	H	R1-1	30	30								1		X												GALLUP PITCH RD (TH-50)			
		H	R1-1	30	30			6.25								1		X								INSTALL AS CLOSE TO STOPPING POINT AS POSSIBLE	X		
SB	6.690	F	VD-062AS	72	16		BUSINESS SIGN			1				X															
SB	6.634	F	W1-2R	30	30		CURVE RIGHT			1				X															
SB	6.410	F	M3-3	24	12								1		X														
		F	M1-5	30	24								1																
		F	M3-3	24	12			2.00								1		X								GREEN ON WHITE SHEETING	X		
		F	M1-5	30	24			5.00																					E-136B
SB	6.330	F	W1-4R	30	30		REVERSE TURN RIGHT						1		X														
							SHEET TOTALS	~~28.25~~ ~~27.50~~	0.00	2	0	0	7	0	0	4		60										
								SF	SF	EA	EA	EA	EA	EA	EA	EA		FT										
							TOWN TOTALS	825.4	0.0	64.0	15.0	15.0	145	0.0	0.0	145		2175.0										

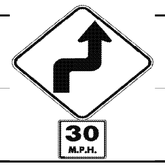
SIGN SUMMARY SHEET

VERMONT AGENCY OF TRANSPORTATION

PROJECT NAME: **Stamford-Andover VT100**
PROJECT NUMBER: **STPG SIGN(20)**

FILE NAME: **Wilmington.xls**
PROJECT MANAGER: **N. Avery**
DESIGNED BY: **M. Miller**
WILMINGTON SHEET 17

PLOT DATE: **8/6/2009**
DRAWN BY: **T. Guazzoni**
CHECKED BY: **T. Guazzoni**
SHEET **87** OF **198**

DIRECTION	MILEPOINT	LOCATION CODE (SHEET 2)	SIGN CODE	WIDTH (IN)	HEIGHT (IN)	SHEETING REMARKS	SIGN LEGEND	NEW SIGNS "A"	NEW SIGNS "B"	EXISTING SIGNS RETAIN	EXISTING SIGNS SALVAGE FROM	EXISTING SIGNS SALVAGE TO	EXISTING SIGNS REMOVE	EXIST POST RETAIN	EXIST POST REMOVE	NUMBER OF NEW POSTS	SQUARE STEEL (IN) 1.75 (LB / FT) 1.88	SQUARE STEEL (IN) 2.00 (LB / FT) 2.42	SQUARE STEEL (IN) 2.50 (LB / FT) 3.35	TUBULAR STEEL Ø (IN) FOUNDATION	TUBULAR STEEL Ø (IN) 3.00 (LB / FT) 7.60	TUBULAR STEEL Ø (IN) 3.50 (LB / FT) 9.00	TUBULAR STEEL Ø (IN) 4.00 (LB / FT) 10.80	TUBULAR STEEL Ø (IN) 5.00 (LB / FT) 14.60	SIGN FRAME REQUIRED	REMARKS	SIGN DETAIL: DETAIL IN SHS	SIGN DETAIL: DETAIL ON SHEET NUMBER	SIGN DETAIL: DETAIL ON STD SHEET NUMBER
WILMINGTON VT 100							FY-FLUORESCENT YELLOW FYG-FLUORESCENT YELLOW GREEN																				"SHS"-STANDARD HIGHWAY SIGNS			
		F	W13-1	18	18		30-MPH (PLAQUE)						1																
SB	6.320	F	W1-3R	30	30			6.25								1		X								INSTALL TO A NEW POSITION 50 FT ± SOUTH OF PREVIOUS LOCATION.	X		
		F	W13-1	18	18			2.25																				X		
SB	6.275	F	W11-7	30	30								1		X															
		F	W11-7P	24	18		XING PLAQUE 						1																	
		F	W11-7	30	30			6.25								1		X										X		
SB	5.870	G	VR-017	24	30								1		X													OLD ARK RD (TH-14)			
		G	VR-017	24	30			5.00								1		X												E-141
SB	5.862	H	R1-1	30	30								1		X													OLD ARK RD (TH-14)			
		H	R1-1	30	30			6.25								1		X										X		
SB	5.720	F	VD-062AS	72	16		BUSINESS SIGN 				~~1~~		1		X												SIGN REMOVED - BUSINESS IS ~~SALVAGE TO M.P. 5.695.~~ CLOSED			
		F	W2-1Mb	36	36	FY		9.00								2		X											6	
		F	W16-8a	48	15	FY		5.00																					8	
SB	5.695	F	VD-062AS	72	16		BUSINESS SIGN					~~1~~				2		X									BUSINESS IS CLOSED ~~SALVAGED FROM M.P. 5.720. INSTALL 130 SOUTH OF EXISTING LOCATION~~			
SB	5.640	G	VR-017	24	30								1		X												HASKELL HILL RD (TH-80)			
SIGN SUMMARY SHEET							SHEET TOTALS	40.00	0.00	0	0 ~~1~~	0 ~~1~~	7 ~~6~~	0	0	8		120											
VERMONT AGENCY OF TRANSPORTATION								SF	SF	EA	EA	EA	EA	EA	EA	EA		FT										
							TOWN TOTALS	825.4	0.0	64.0	15.0	15.0	145	0.0	0.0	145		2175.0												

PROJECT NAME: **Stamford-Andover VT100**
PROJECT NUMBER: **STPG SIGN(20)**

FILE NAME: **Wilmington.xls**
PROJECT MANAGER: **N. Averv**
DESIGNED BY: **M. Miller**
WILMINGTON SHEET 18

PLOT DATE: **8/6/2009**
DRAWN BY: **T. Guazzoni**
CHECKED BY: **T. Guazzoni**
SHEET **88** OF **198**

DIRECTION	MILEPOINT	LOCATION CODE (SHEET 2)	SIGN CODE	WIDTH (IN)	HEIGHT (IN)	SHEETING REMARKS	SIGN LEGEND	NEW SIGNS "A"	NEW SIGNS "B"	EXISTING SIGNS RETAIN	EXISTING SIGNS SALVAGE FROM	EXISTING SIGNS SALVAGE TO	EXISTING SIGNS REMOVE	EXIST POST RETAIN	EXIST POST REMOVE	NUMBER OF NEW POSTS	SQUARE STEEL (IN) 1.75 (LB / FT) 1.88	SQUARE STEEL (IN) 2.00 (LB / FT) 2.42	SQUARE STEEL (IN) 2.50 (LB / FT) 3.35	TUBULAR STEEL Ø (IN) FOUNDATION	TUBULAR STEEL Ø (IN) 3.00 (LB / FT) 7.60	TUBULAR STEEL Ø (IN) 3.50 (LB / FT) 9.00	TUBULAR STEEL Ø (IN) 4.00 (LB / FT) 10.80	TUBULAR STEEL Ø (IN) 5.00 (LB / FT) 14.60	SIGN FRAME REQUIRED	REMARKS	SIGN DETAIL: DETAIL IN SHS	SIGN DETAIL: DETAIL ON SHEET NUMBER	SIGN DETAIL: DETAIL ON STD SHEET NUMBER
WILMINGTON VT 100							FY-FLUORESCENT YELLOW FYG-FLUORESCENT YELLOW GREEN																			"SHS"-STANDARD HIGHWAY SIGNS			
		G	VR-017	24	30			5.00								1		X										E-141
SB	5.632	H	R1-1	30	30								1		X											HASKELL HILL RD (TH-80)			
		H	R1-1	30	30			6.25								1		X									X		
SB	5.560	F	W1-2L	30	30		CURVE LEFT						1		X														
		F	W13-1	18	18		35 MPH						1																
SB	5.508	F	W11-7	30	30		EQUESTRIAN SYMBOL						1		X														
		F	W16-4	24	18		NEXT 1000 FT (PLAQUE)						1																
		F	W1-2L	30	30			6.25								1		X									X		
		F	W13-1	18	18			2.25																			X		
SB	5.425	F	VW-619	30	30		 1000 1322 0540						1		X														
		F	VW-619	30	30			6.25								1		X									SALVAGED MM ONTO NEW POST.		7	
SB	5.185	F	VD-062B	72	16		BUSINESS SIGN			1				X															
		F	VD-062AS	72	16		BUSINESS SIGN			1																			
SB	5.045	K	R4-7	24	30								1		X														
		K	OM1-1	18	18								1																
							SHEET TOTALS	26.00	0.00	2	0	0	8	0	0	4		60										
								SF	SF	EA	EA	EA	EA	EA	EA	EA		FT										
							TOWN TOTALS	825.4	0.0	64.0	15.0	15.0	145	0.0	0.0	145		2175.0										

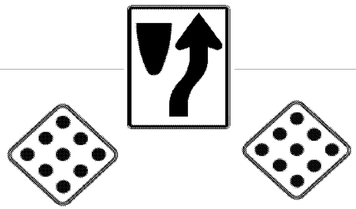
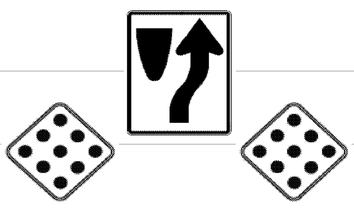
SIGN SUMMARY SHEET

VERMONT AGENCY OF TRANSPORTATION

PROJECT NAME: **Stamford-Andover VT100**
PROJECT NUMBER: **STPG SIGN(20)**

FILE NAME: **Wilmington.xls**
PROJECT MANAGER: **N. Avery**
DESIGNED BY: **M. Miller**
WILMINGTON SHEET 19

PLOT DATE: **8/6/2009**
DRAWN BY: **T. Guazzoni**
CHECKED BY: **T. Guazzoni**
SHEET **89** OF **198**

DIRECTION	MILEPOINT	LOCATION CODE (SHEET 2)	SIGN CODE	WIDTH (IN)	HEIGHT (IN)	SHEETING REMARKS	SIGN LEGEND	NEW SIGNS "A"	NEW SIGNS "B"	EXISTING SIGNS RETAIN	EXISTING SIGNS SALVAGE FROM	EXISTING SIGNS SALVAGE TO	EXISTING SIGNS REMOVE	EXIST POST RETAIN	EXIST POST REMOVE	NUMBER OF NEW POSTS	SQUARE STEEL (IN) 1.75 (LB / FT) 1.88	SQUARE STEEL (IN) 2.00 (LB / FT) 2.42	SQUARE STEEL (IN) 2.50 (LB / FT) 3.35	TUBULAR STEEL Ø (IN) FOUNDATION	TUBULAR STEEL Ø (IN) 3.00 (LB / FT) 7.60	TUBULAR STEEL Ø (IN) 3.50 (LB / FT) 9.00	TUBULAR STEEL Ø (IN) 4.00 (LB / FT) 10.80	TUBULAR STEEL Ø (IN) 5.00 (LB / FT) 14.60	SIGN FRAME REQUIRED	REMARKS	SIGN DETAIL: DETAIL IN SHS	SIGN DETAIL: DETAIL ON SHEET NUMBER	SIGN DETAIL: DETAIL ON STD SHEET NUMBER
WILMINGTON VT 100							FY-FLUORESCENT YELLOW FYG-FLUORESCENT YELLOW GREEN																				"SHS"-STANDARD HIGHWAY SIGNS			
		J	OM1-1	18	18								1																
		K	R4-7	~~24~~ 24 ~~34~~	30			5.00								1		X									INSTALLED IN THE RAISED MEDIAN	X		
		K	OM1-1	18	18			2.25																			INSTALL THE TWO OBJECT MARKERS BACK TO BACK.	X		
		J	OM1-1	18	18			2.25																			PROVIDE 4 FT OF CLEARANCE TO THE BOTTOM OF THE OBJECT MARKERS.	X		
SB	5.043	F	D1-1S	72	10								1		X														
		F	D1-1	72	12			6.00								2		X										6	
SB	4.984	G	VR-017	24	30			5.00								1		X									COLDBROOK RD (TH-1)			E-141
SB	4.980	H	R1-1	30	30		STOP						1		X												COLDBROOK RD (TH-1).			
		G	R4-7	24	30		"BULLNOSE" SYMBOL						~~1~~ 2														ANOTHER SET OF SIGNS WERE REMOVED AT THE WEST END OF THIS ISLAND ON THE T.H. THREE NEW SIGNS WERE INSTALLED. LATER THE POST WAS REPLACED SEE SHEET #97.			
		H	OM1-1	18	18		OBJECT MARKER						~~1~~ 2																
		G	OM1-1	18	18		OBJECT MARKER						~~1~~ 2																
		G	R4-7	24	30			~~5.00~~ 5.00																				X		
		G	OM1-1	18	18			~~2.25~~ 2.25																			INSTALL OBJECT MARKERS BACK-TO-BACK.	X		
		H	OM1-1	18	18			~~2.25~~ 2.25																			PROVIDE 4 FT CLEARANCE TO OBJECT MARKERS.	X		
SB	4.976	H	R1-1	30	30								1		X												COLDBROOK RD (TH-1)			
							SHEET TOTALS	~~39.50~~ ~~30.00~~	0.00	0	0	0	~~10~~ ~~7~~	0	0	4		60											
								SF	SF	EA	EA	EA	EA	EA	EA	EA		FT											
							TOWN TOTALS	825.4	0.0	64.0	15.0	15.0	145	0.0	0.0	145		2175.0											

SIGN SUMMARY SHEET

VERMONT AGENCY OF TRANSPORTATION

PROJECT NAME: **Stamford-Andover VT100**
PROJECT NUMBER: **STPG SIGN(20)**

FILE NAME: **Wilmington.xls**
PROJECT MANAGER: **N. Averv**
DESIGNED BY: **M. Miller**
WILMINGTON SHEET 20

PLOT DATE: **8/6/2009**
DRAWN BY: **T. Guazzoni**
CHECKED BY: **T. Guazzoni**
SHEET **90** OF **198**

DIRECTION	MILEPOINT	LOCATION CODE (SHEET 2)	SIGN CODE	WIDTH (IN)	HEIGHT (IN)	SHEETING REMARKS	SIGN LEGEND	NEW SIGNS "A"	NEW SIGNS "B"	EXISTING SIGNS RETAIN	EXISTING SIGNS SALVAGE FROM	EXISTING SIGNS SALVAGE TO	EXISTING SIGNS REMOVE	EXIST POST RETAIN	EXIST POST REMOVE	NUMBER OF NEW POSTS	SQUARE STEEL (IN) 1.75 (LB/FT) 1.88	SQUARE STEEL (IN) 2.00 (LB/FT) 2.42	SQUARE STEEL (IN) 2.50 (LB/FT) 3.35	TUBULAR STEEL Ø (IN) FOUNDATION	TUBULAR STEEL Ø (IN) 3.00 (LB/FT) 7.60	TUBULAR STEEL Ø (IN) 3.50 (LB/FT) 9.00	TUBULAR STEEL Ø (IN) 4.00 (LB/FT) 10.80	TUBULAR STEEL Ø (IN) 5.00 (LB/FT) 14.60	SIGN FRAME REQUIRED	REMARKS	SIGN DETAIL: DETAIL IN SHS	SIGN DETAIL: DETAIL ON SHEET NUMBER	SIGN DETAIL: DETAIL ON STD SHEET NUMBER
WILMINGTON VT 100							FY-FLUORESCENT YELLOW FYG-FLUORESCENT YELLOW GREEN																			"SHS"-STANDARD HIGHWAY SIGNS			
		H	R1-1	36	36			9.00			I	I				2		X		SALVAGED STREET SIGN ONTO NEW POST.					INSTALL THE UPSIZED STOP SIGN ON TWO NEW POSTS.	X		
SB	4.975	K	R4-7	24	38								1		X											SEE NOTE FOR NB MM 4.860 - PAGE 80			
		K	OM1-1	18	18								1																
		J	OM1-1	18	18								1																
		K	R4-7	24	~~38~~ 30			5.00								1		X							INSTALLED IN THE RAISED MEDIAN ACROSS FROM ± THE TH-1 RIGHT-SIDE STOP SIGN.	X		
		K	OM1-1	18	18			2.25																	INSTALL OBJECT MARKERS BACK-TO-BACK.	X		
		J	OM1-1	18	18			2.25																	PROVIDE 4 FT CLEARANCE TO OBJECT MARKERS.	X		
SB	4.930	F	M3-3	24	12			2.00					I			1		X							GREEN ON WHITE SHEETING. INSTALL 250 FT SOUTH OF JCT w/ COLDBROOK RD (TH-1)	X		
		F	M1-5	30	24			5.00					I																E-136B
SB	4.618	F	W3-5	36	36		SPEED REDUCTION 40 MPH AHEAD (SYMBOL)			1				X															
SB	4.522	F	R2-1	24	30		SPEED LIMIT 40 						1		X														
		F	R2-1	30	36			7.50								1		X										6	
SB	4.480	F	W1-2R	30	30								1		X															
		F	W1-2R	30	30			6.25								1		X										X	
SB	4.400	F	S1-1YG	36	36		PENTAGONAL SCHOOL SYMBOL			1				X															
							SHEET TOTALS	39.25 SF	0.00 SF	2 EA	~~0~~ EA	~~0~~ EA	~~7~~ 5 EA	0 EA	0 EA	6 EA		90 FT										
							TOWN TOTALS	825.4	0.0	64.0	15.0	15.0	145	0.0	0.0	145		2175.0										

SIGN SUMMARY SHEET

VERMONT AGENCY OF TRANSPORTATION

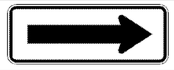
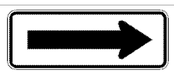
PROJECT NAME: **Stamford-Andover VT100**
PROJECT NUMBER: **STPG SIGN(20)**

FILE NAME: **Wilminaton.xls**
PROJECT MANAGER: **N. Averv**
DESIGNED BY: **M. Miller**
WILMINGTON SHEET 21

PLOT DATE: **8/6/2009**
DRAWN BY: **T. Guazzoni**
CHECKED BY: **T. Guazzoni**
SHEET **91** OF **198**

DIRECTION	MILEPOINT	LOCATION CODE (SHEET 2)	SIGN CODE	WIDTH (IN)	HEIGHT (IN)	SHEETING REMARKS	SIGN LEGEND	NEW SIGNS "A"	NEW SIGNS "B"	EXISTING SIGNS RETAIN	EXISTING SIGNS SALVAGE FROM	EXISTING SIGNS SALVAGE TO	EXISTING SIGNS REMOVE	EXIST POST RETAIN	EXIST POST REMOVE	NUMBER OF NEW POSTS	SQUARE STEEL (IN) 1.75 (LB / FT) 1.88	SQUARE STEEL (IN) 2.00 (LB / FT) 2.42	SQUARE STEEL (IN) 2.50 (LB / FT) 3.35	TUBULAR STEEL Ø (IN) FOUNDATION	TUBULAR STEEL Ø (IN) 3.00 (LB / FT) 7.60	TUBULAR STEEL Ø (IN) 3.50 (LB / FT) 9.00	TUBULAR STEEL Ø (IN) 4.00 (LB / FT) 10.80	TUBULAR STEEL Ø (IN) 5.00 (LB / FT) 14.60	SIGN FRAME REQUIRED	REMARKS	SIGN DETAIL: DETAIL IN SHS	SIGN DETAIL: DETAIL ON SHEET NUMBER	SIGN DETAIL: DETAIL ON STD SHEET NUMBER
WILMINGTON VT 100							FY-FLUORESCENT YELLOW FYG-FLUORESCENT YELLOW GREEN																			"SHS"-STANDARD HIGHWAY SIGNS			
		F	W16-9YG	36	20		AHEAD (PLAQUE)			1																			
SB	4.351	F	R2-1	24	30		SPEED LIMIT 40			1				X															
SB	4.236	H	R1-1	30	30		STOP			1				X													SCHOOL DRIVEWAY ~ PRIVATE STOP SIGN.			
SB	4.232	F	R8-3A	24	24								1		X														
		F	VR-644P	24	12		BEGIN						1																
		F	R8-3A	24	24			4.00								1		X								X		
		F	M4-11	24	12			2.00																			RED ON WHITE SHEETING			E-140
SB	4.215	F	W1-2L	30	30								1		X														
		F	W13-1	18	18								1																
		F	W1-2L	30	30			6.25								1		X								X		
		F	W13-1	18	18			2.25																		X		
SB	4.180	F	R8-3A	24	24								1		X														
		F	R8-3A	24	24			4.00								1		X								X		
SB	4.152	F	R8-3A	24	24								1		X														
		F	M4-6P	24	12								1																
SIGN SUMMARY SHEET							SHEET TOTALS	18.50	0.00	3	0	0	7	0	0	3	45											
								SF	SF	EA	EA	EA	EA	EA	EA	EA	FT											
VERMONT AGENCY OF TRANSPORTATION							TOWN TOTALS	825.4	0.0	64.0	15.0	15.0	145	0.0	0.0	145	2175.0											

PROJECT NAME: **Stamford-Andover VT100**
PROJECT NUMBER: **STPG SIGN(20)**
FILE NAME: **Wilmington.xls** PLOT DATE: **8/6/2009**
PROJECT MANAGER: **N. Avery** DRAWN BY: **T. Guazzoni**
DESIGNED BY: **M. Miller** CHECKED BY: **T. Guazzoni**
WILMINGTON SHEET 22 SHEET **92** OF **198**

DIRECTION	MILEPOINT	LOCATION CODE (SHEET 2)	SIGN CODE	WIDTH (IN)	HEIGHT (IN)	SHEETING REMARKS	SIGN LEGEND	NEW SIGNS "A"	NEW SIGNS "B"	EXISTING SIGNS RETAIN	EXISTING SIGNS SALVAGE FROM	EXISTING SIGNS SALVAGE TO	EXISTING SIGNS REMOVE	EXIST POST RETAIN	EXIST POST REMOVE	NUMBER OF NEW POSTS	SQUARE STEEL (IN) 1.75 (LB / FT) 1.88	SQUARE STEEL (IN) 2.00 (LB / FT) 2.42	SQUARE STEEL (IN) 2.50 (LB / FT) 3.35	TUBULAR STEEL Ø (IN) FOUNDATION	TUBULAR STEEL Ø (IN) 3.00 (LB / FT) 7.60	TUBULAR STEEL Ø (IN) 3.50 (LB / FT) 9.00	TUBULAR STEEL Ø (IN) 4.00 (LB / FT) 10.80	TUBULAR STEEL Ø (IN) 5.00 (LB / FT) 14.60	SIGN FRAME REQUIRED	REMARKS	SIGN DETAIL: DETAIL IN SHS	SIGN DETAIL: DETAIL ON SHEET NUMBER	SIGN DETAIL: DETAIL ON STD SHEET NUMBER
WILMINGTON VT 100							FY-FLUORESCENT YELLOW FYG-FLUORESCENT YELLOW GREEN																			"SHS"-STANDARD HIGHWAY SIGNS			
		F	R8-3A	24	24			4.00								1		X									X		
		F	M4-6P	24	12			2.00																		RED ON WHITE SHEETING	X		
SB	4.115	F	W1-6	48	24								1		X														
		F	W1-6	48	24			8.00								2		X									X		
SB	4.108	E	W1-6	48	24								1		X														
		E	W1-6	48	24			8.00								2		X								PROVIDE 10 FT MINIMUM DISTANCE TO UTILITY POLE	X		
SB	4.093	F	S3-1	30	30	SCHOOL BUS STOP AHEAD				I			~~1~~	I	~~X~~											SCHOOL BUS STOPS HERE.			
SB	4.075	F	W1-6	48	24			8.00								2		X								INSTALL MIDWAY ± BETWEEN THE OTHER TWO SETS OF LARGE ARROWS			
SB	4.074	E	W1-6	48	24			8.00								2		X								IN SB LANE FACING NB TRAFFIC. INSTALL 5 FT ± FROM SB FACING ARROW.			
SB	4.035	F	W1-6	48	24								1		X														
		F	W1-6	48	24			8.00								2		X											
SB	4.034	E	W1-6	48	24								1		X														
		E	W1-6	48	24			8.00								2		X											
SB	3.993	G	VR-017	24	30								1		X											WOFFENDEN RD (TH-24)			
		G	VR-017	24	30			5.00								1		X											E-141
SIGN SUMMARY SHEET							SHEET TOTALS	59.00	0.00	~~0~~ I	0	0	~~6~~ 5	~~0~~ I	0	14		210										
VERMONT AGENCY OF TRANSPORTATION								SF	SF	EA	EA	EA	EA	EA	EA	EA		FT										
							TOWN TOTALS	825.4	0.0	64.0	15.0	15.0	145	0.0	0.0	145		2175.0											

PROJECT NAME: **Stamford-Andover VT100**
PROJECT NUMBER: **STPG SIGN(20)**

FILE NAME: **Wilmington.xls**
PROJECT MANAGER: **N. Averv**
DESIGNED BY: **M. Miller**
WILMINGTON SHEET 23

PLOT DATE: **8/6/2009**
DRAWN BY: **T. Guazzoni**
CHECKED BY: **T. Guazzoni**

E-141

DIRECTION	MILEPOINT	LOCATION CODE (SHEET 2)	SIGN CODE	WIDTH (IN)	HEIGHT (IN)	SHEETING REMARKS	SIGN LEGEND	NEW SIGNS "A"	NEW SIGNS "B"	EXISTING SIGNS RETAIN	EXISTING SIGNS SALVAGE FROM	EXISTING SIGNS SALVAGE TO	EXISTING SIGNS REMOVE	EXIST POST RETAIN	EXIST POST REMOVE	NUMBER OF NEW POSTS	SQUARE STEEL (IN) 1.75 (LB / FT) 1.88	SQUARE STEEL (IN) 2.00 (LB / FT) 2.42	SQUARE STEEL (IN) 2.50 (LB / FT) 3.35	FOUNDATION	TUBULAR STEEL Ø (IN) 3.00 (LB / FT) 7.60	TUBULAR STEEL Ø (IN) 3.50 (LB / FT) 9.00	TUBULAR STEEL Ø (IN) 4.00 (LB / FT) 10.80	TUBULAR STEEL Ø (IN) 5.00 (LB / FT) 14.60	SIGN FRAME REQUIRED	REMARKS	SIGN DETAIL: DETAIL IN SHS	SIGN DETAIL: DETAIL ON SHEET NUMBER	SIGN DETAIL: DETAIL ON STD SHEET NUMBER
WILMINGTON VT 100							FY-FLUORESCENT YELLOW FYG-FLUORESCENT YELLOW GREEN																			"SHS"-STANDARD HIGHWAY SIGNS			
SB	4.001	H	R1-1	30	30								1		X														
		H	R1-1	30	30			6.25								1		X									X	
SB	3.952	F	R2-1	24	30		SPEED LIMIT 40			1				X														
SB	3.460	F	R2-1	24	30								1		X														
		F	R2-1	24	30			5.00								1		X									X	
SB	3.345	F	VD-062C	74.75	16		TRAVEL INFO SYMBOLS			1				X														
		F	VD-062BC	74.75	16		TRAVEL INFO TEXT			1																		
SB	3.215	F	W3-5	36	36		SPEED REDUCTION 25 MPH AHEAD			1				X														
SB	3.125	F	VD-062B	72	16		BUSINESS SIGN			1				X														
		F	VD-062B	72	16		BUSINESS SIGN			1																		
SB	3.090	F	R2-1	24	30								1		X														
		F	R2-1	30	36			7.50								1		X									6	
SB	2.970	F	R2-1	24	30			5.00								1		X									INSTALL BEHIND RAIL 130 FT ± NORTH OF RIGHT REVERSE TURN SIGN AHEAD, WHICH WILL BE REMOVED.	X		
SB	2.945	F	W1-3R	30	30		RIGHT REVERSE TURN 						1		X														
SB	2.935	F	W1-3R	30	30			6.25								1		X									INSTALL 50 FT SOUTH OF (BEYOND) THE PREVIOUS POSITION OF THIS SIGN.	X		
							SHEET TOTALS	30.00 SF	0.00 SF	6 EA	0 EA	0 EA	4 EA	0 EA	0 EA	5 EA		75 FT									
							TOWN TOTALS	825.4	0.0	64.0	15.0	15.0	145	0.0	0.0	145		2175.0									

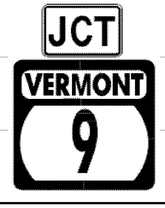
SIGN SUMMARY SHEET

VERMONT AGENCY OF TRANSPORTATION

PROJECT NAME: **Stamford-Andover VT100**
PROJECT NUMBER: **STPG SIGN(20)**

FILE NAME: **Wilmington.xls**
PROJECT MANAGER: **N. Avery**
DESIGNED BY: **M. Miller**
WILMINGTON SHEET 24

PLOT DATE: **8/6/2009**
DRAWN BY: **T. Guazzoni**
CHECKED BY: **T. Guazzoni**
SHEET **94** OF **198**

DIRECTION	MILEPOINT	LOCATION CODE (SHEET 2)	SIGN CODE	WIDTH (IN)	HEIGHT (IN)	SHEETING REMARKS	SIGN LEGEND	NEW SIGNS "A"	NEW SIGNS "B"	EXISTING SIGNS RETAIN	EXISTING SIGNS SALVAGE FROM	EXISTING SIGNS SALVAGE TO	EXISTING SIGNS REMOVE	EXIST POST RETAIN	EXIST POST REMOVE	NUMBER OF NEW POSTS	SQUARE STEEL (IN) 1.75 (LB / FT) 1.88	SQUARE STEEL (IN) 2.00 (LB / FT) 2.42	SQUARE STEEL (IN) 2.50 (LB / FT) 3.35	TUBULAR STEEL Ø (IN) FOUNDATION	TUBULAR STEEL Ø (IN) 3.00 (LB / FT) 7.60	TUBULAR STEEL Ø (IN) 3.50 (LB / FT) 9.00	TUBULAR STEEL Ø (IN) 4.00 (LB / FT) 10.80	TUBULAR STEEL Ø (IN) 5.00 (LB / FT) 14.60	SIGN FRAME REQUIRED	REMARKS	SIGN DETAIL: DETAIL IN SHS	SIGN DETAIL: DETAIL ON SHEET NUMBER	SIGN DETAIL: DETAIL ON STD SHEET NUMBER
WILMINGTON VT 100							FY-FLUORESCENT YELLOW FYG-FLUORESCENT YELLOW GREEN																			"SHS"-STANDARD HIGHWAY SIGNS			
SB	2.890	F	R2-1	24	30		SPEED LIMIT 25						1		X														
SB	2.885	F	N/A				EMPTY POST								X														
SB	2.845	F	W1-6	48	24								1		X														
		F	W1-6	48	24			8.00								2		X									X		
SB	2.844	E	W1-6	48	24								1		X														
		E	W1-6	48	24			8.00								2		X									X		
SB	2.836	F	W1-6	48	24								1		X												SALVAGED ONTO NEW POST.		
		F	W1-6	48	24			8.00								2		X									X		
SB	2.835	E	W1-6	48	24								1		X														
		E	W1-6	48	24			8.00								2		X									X		
SB	2.785	F	M2-1	21	15								1		X														
		F	M1-5	24	24								1																
		F	M2-1	21	15			2.19								1		X									GREEN ON WHITE SHEETING	X		
		F	M1-5	24	24			4.00																					E-136B
SB	2.725	F	D1-1A	72	10								1		X														
							SHEET TOTALS	38.19 SF	0.00 SF	0 EA	0 EA	0 EA	8 EA	0 EA	0 EA	9 EA		135 FT											
							TOWN TOTALS	825.4	0.0	64.0	15.0	15.0	145	0.0	0.0	145		2175.0											

SIGN SUMMARY SHEET

VERMONT AGENCY OF TRANSPORTATION

PROJECT NAME: **Stamford-Andover VT100**
PROJECT NUMBER: **STPG SIGN(20)**

FILE NAME: **Wilmington.xls**
PROJECT MANAGER: **N. Averv**
DESIGNED BY: **M. Miller**
WILMINGTON SHEET 25

PLOT DATE: **8/6/2009**
DRAWN BY: **T. Guazzoni**
CHECKED BY: **T. Guazzoni**
SHEET **95** OF **198**

DIRECTION	MILEPOINT	LOCATION CODE (SHEET 2)	SIGN CODE	WIDTH (IN)	HEIGHT (IN)	SHEETING REMARKS	SIGN LEGEND	NEW SIGNS "A"	NEW SIGNS "B"	EXISTING SIGNS RETAIN	EXISTING SIGNS SALVAGE FROM	EXISTING SIGNS SALVAGE TO	EXISTING SIGNS REMOVE	EXIST POST RETAIN	EXIST POST REMOVE	NUMBER OF NEW POSTS	SQUARE STEEL (IN) 1.75 (LB / FT) 1.88	SQUARE STEEL (IN) 2.00 (LB / FT) 2.42	SQUARE STEEL (IN) 2.50 (LB / FT) 3.35	TUBULAR STEEL Ø (IN) FOUNDATION	TUBULAR STEEL Ø (IN) 3.00 (LB / FT) 7.60	TUBULAR STEEL Ø (IN) 3.50 (LB / FT) 9.00	TUBULAR STEEL Ø (IN) 4.00 (LB / FT) 10.80	TUBULAR STEEL Ø (IN) 5.00 (LB / FT) 14.60	SIGN FRAME REQUIRED	REMARKS	SIGN DETAIL: DETAIL IN SHS	SIGN DETAIL: DETAIL ON SHEET NUMBER	SIGN DETAIL: DETAIL ON STD SHEET NUMBER
WILMINGTON VT 100							FY-FLUORESCENT YELLOW FYG-FLUORESCENT YELLOW GREEN																				"SHS"-STANDARD HIGHWAY SIGNS			
		F	D1-1A	72	10								1																
		F	D1-1A	72	10								1																
		F	D1-1A	72	10								1																
		F	D1-1A	72	12		MARLBORO 11	6.00								2			X									5	
		F	D1-1A	72	12		BRATTLEBORO 19	6.00																				5	
		F	D1-1A	72	12		SEARSBURG 7	6.00																				5	
		F	D1-1A	72	12		BENNINGTON 21	6.00																				5	
SB	2.720	F	W1-3R	30	30		RIGHT REVERSE TURN						1		X														
SB	2.630	F	VR-020	24	30		NO PARKING ON TRAVELED LANE						I														OLD SIGN WAS REMOVED.		
		F	VR-020	24	30			5.00								1		X											E-146
SB	2.570	F	M3-2	24	12		EAST				1	1		~~X~~	X	2			X								RETAIN FRAME		
		F	M1-5	24	24		VERMONT 9				1	1														AS PER J. KELLY, TRAFFIC OPS, THE OLD TUBULAR POSTS WERE REMOVED AND NEW SQUARE STEEL POSTS WERE INSTALLED.			
		F	M6-1	21	15		<--- LEFT				1	1																	
		F	M3-3	24	12		SOUTH				1	1																	
		F	M1-5	30	24		VERMONT 100				1	1																	
							SHEET TOTALS	29.00 SF	0.00 SF	0 EA	5 EA	5 EA	4 EA	0 EA	0 EA	~~4~~ 5 EA		75 FT										
							TOWN TOTALS	825.4	0.0	64.0	15.0	15.0	145	0.0	0.0	145		2175.0										

SIGN SUMMARY SHEET

VERMONT AGENCY OF TRANSPORTATION

PROJECT NAME: Stamford-Andover VT100
PROJECT NUMBER: STPG SIGN(20)

FILE NAME: Wilminaton.xls
PROJECT MANAGER: N. Averv
DESIGNED BY: M. Miller
WILMINGTON SHEET 26

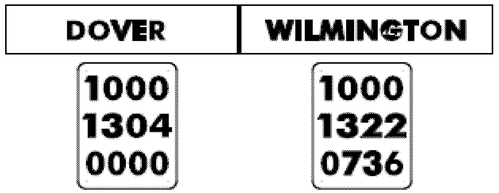
PLOT DATE: 8/6/2009
DRAWN BY: T. Guazzoni
CHECKED BY: T. Guazzoni
SHEET 96 OF 198

DIRECTION	MILEPOINT	LOCATION CODE (SHEET 2)	SIGN CODE	WIDTH (IN)	HEIGHT (IN)	SHEETING REMARKS	SIGN LEGEND	NEW SIGNS "A"	NEW SIGNS "B"	EXISTING SIGNS RETAIN	EXISTING SIGNS SALVAGE FROM	EXISTING SIGNS SALVAGE TO	EXISTING SIGNS REMOVE	EXIST POST RETAIN	EXIST POST REMOVE	NUMBER OF NEW POSTS	SQUARE STEEL (IN) 1.75 (LB / FT) 1.88	SQUARE STEEL (IN) 2.00 (LB / FT) 2.42	SQUARE STEEL (IN) 2.50 (LB / FT) 3.35	TUBULAR STEEL Ø (IN) FOUNDATION	TUBULAR STEEL Ø (IN) 3.00 (LB / FT) 7.60	TUBULAR STEEL Ø (IN) 3.50 (LB / FT) 9.00	TUBULAR STEEL Ø (IN) 4.00 (LB / FT) 10.80	TUBULAR STEEL Ø (IN) 5.00 (LB / FT) 14.60	SIGN FRAME REQUIRED	REMARKS	SIGN DETAIL: DETAIL IN SHS	SIGN DETAIL: DETAIL ON SHEET NUMBER	SIGN DETAIL: DETAIL ON STD SHEET NUMBER
WILMINGTON VT 100							FY-FLUORESCENT YELLOW FYG-FLUORESCENT YELLOW GREEN																			"SHS"-STANDARD HIGHWAY SIGNS			
SB	2.570	F	M6-1	21	15		<--- LEFT				1	1																	
		F	M3-4	24	12		WEST				1	1																	
		F	M1-5	24	24		VERMONT 9				1	1																	
		F	M6-1	21	15		RIGHT --->				1	1																	
SB	4.975	H	R4-7	24	30						1	1	1													THIS ASSEMBLY IS ON THE WEST END OF THE ISLAND ON T/H/ #1			
		G	OMI-1	18	18						1	1	1																
		G	OMI-1	18	18						1	1	1													POST WAS REMOVED AND REPLACED. SIGNS WERE SALVAGED. SEE SHEET #90			
SIGN SUMMARY SHEET							SHEET TOTALS	0.00 SF	0.00 SF	0 EA	~~7~~ 4 EA	~~7~~ 4 EA	~~3~~ 0 EA	0 EA	0 EA	0 EA									0 FT				
VERMONT AGENCY OF TRANSPORTATION							TOWN TOTALS	825.4	0.0	64.0	15.0	15.0	145	0.0	0.0	145									2175.0				

PROJECT NAME: **Stamford-Andover VT100**
PROJECT NUMBER: **STPG SIGN(20)**

FILE NAME: **Wilminaton.xls**
PROJECT MANAGER: **N. Averv**
DESIGNED BY: **M. Miller**
WILMINGTON SHEET 27

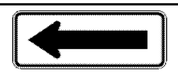
PLOT DATE: **8/6/2009**
DRAWN BY: **T. Guazzoni**
CHECKED BY: **T. Guazzoni**
SHEET **97** OF **198**

DIRECTION	MILEPOINT	LOCATION CODE (SHEET 2)	SIGN CODE	WIDTH (IN)	HEIGHT (IN)	SHEETING REMARKS	SIGN LEGEND	NEW SIGNS "A"	NEW SIGNS "B"	EXISTING SIGNS RETAIN	EXISTING SIGNS SALVAGE FROM	EXISTING SIGNS SALVAGE TO	EXISTING SIGNS REMOVE	EXIST POST RETAIN	EXIST POST REMOVE	NUMBER OF NEW POSTS	SQUARE STEEL (IN) 1.75 (LB/FT) 1.88	SQUARE STEEL (IN) 2.00 (LB/FT) 2.42	SQUARE STEEL (IN) 2.50 (LB/FT) 3.35	FOUNDATION	TUBULAR STEEL Ø (IN) 3.00 (LB/FT) 7.60	TUBULAR STEEL Ø (IN) 3.50 (LB/FT) 9.00	TUBULAR STEEL Ø (IN) 4.00 (LB/FT) 10.80	TUBULAR STEEL Ø (IN) 5.00 (LB/FT) 14.60	SIGN FRAME REQUIRED	REMARKS	SIGN DETAIL: DETAIL IN SHS	SIGN DETAIL: DETAIL ON SHEET NUMBER	SIGN DETAIL: DETAIL ON STD SHEET NUMBER
DOVER VT 100							FY-FLUORESCENT YELLOW FYG-FLUORESCENT YELLOW GREEN																				"SHS"-STANDARD HIGHWAY SIGNS			
NB	0.000	C	VD-024	72	10			5.00 ~~6.00~~								2		X								INSTALL BEHIND RAIL DIRECTLY ACROSS FROM THE REMOVED SOUTHBOUND SIGN.		4	
		C	VD-700	6	10			0.42																		DOVER MILE MARKER. INSTALL ON THE LEFT SIDE POST UNDER DOVER.			E-138
		C	VD-700	6	10			0.42																		WILMINGTON MILE MARKER. INSTALL ON THE RIGHT SIDE POST UNDER WILMINGTON.			E-138
NB	0.270	A	R2-5A	24	30		REDUCED SPEED AHEAD 						1		X															
		A	W3-5	36	36			9.00								2		X									X		
NB	0.360	A	W1-2L	30	30		CURVE LEFT						1		X															
NB	0.400	A	R2-1	24	30								1		X															
		A	R4-1	24	30								1																	
		A	R2-1	24	30			5.00								1		X								SPEED LIMIT SIGN ON TOP.	X		
		A	R4-1	24	30			5.00																		SALVAGED MM ONTO NEW POST.	X		
NB	0.450	A	W1-3L	30	30								1		X															
		A	W13-1	18	18								1																	
		A	W1-3L	30	30			6.25								1		X									X		
		A	W13-1	18	18			2.25																			X		
NB	0.510	A	W1-6	48	24								1		X															
SIGN SUMMARY SHEET							SHEET TOTALS	33.34 34.34	0.00	0	0	0	7	0	0	6		90										
								SF	SF	EA	EA	EA	EA	EA	EA	EA		FT										
VERMONT AGENCY OF TRANSPORTATION							TOWN TOTALS	648.1	0.0	30.0	3.0	1.0	116	0.0	0.0	112		1680.0										

PROJECT NAME: **Stamford-Andover VT100**
PROJECT NUMBER: **STPG SIGN(20)**

FILE NAME: **Dover.xls**
PROJECT MANAGER: **N. Avery**
DESIGNED BY: **M. Miller**
DOVER SHEET 1

PLOT DATE: **8/6/2009**
DRAWN BY: **I. Shea**
CHECKED BY: **T. Guazzoni**
SHEET **98** OF **198**

DIRECTION	MILEPOINT	LOCATION CODE (SHEET 2)	SIGN CODE	WIDTH (IN)	HEIGHT (IN)	SHEETING REMARKS	SIGN LEGEND	NEW SIGNS "A"	NEW SIGNS "B"	EXISTING SIGNS RETAIN	EXISTING SIGNS SALVAGE FROM	EXISTING SIGNS SALVAGE TO	EXISTING SIGNS REMOVE	EXIST POST RETAIN	EXIST POST REMOVE	NUMBER OF NEW POSTS	SQUARE STEEL (IN) 1.75 (LB / FT) 1.88	SQUARE STEEL (IN) 2.00 (LB / FT) 2.42	SQUARE STEEL (IN) 2.50 (LB / FT) 3.35	TUBULAR STEEL Ø (IN) FOUNDATION	TUBULAR STEEL Ø (IN) 3.00 (LB / FT) 7.60	TUBULAR STEEL Ø (IN) 3.50 (LB / FT) 9.00	TUBULAR STEEL Ø (IN) 4.00 (LB / FT) 10.80	TUBULAR STEEL Ø (IN) 5.00 (LB / FT) 14.60	SIGN FRAME REQUIRED	REMARKS	SIGN DETAIL: DETAIL IN SHS	SIGN DETAIL: DETAIL ON SHEET NUMBER	SIGN DETAIL: DETAIL ON STD SHEET NUMBER
DOVER VT 100							FY-FLUORESCENT YELLOW FYG-FLUORESCENT YELLOW GREEN																				"SHS"-STANDARD HIGHWAY SIGNS			
				48	24			8.00								2		X									X		
NB	0.520	A	S3-1	30	30								1		X														
		A	VW-133L	30	30								1																
		A	S3-1	30	30			6.25								2		X								INSTALL IN TOP POSITION.	X		
		A	VW-054L	30	30			6.25																					E-154
NB	0.525	B	W1-6	48	24								1		X														
		B	W1-6	48	24	FY		8.00								2		X								FACES SB TRAFFIC.	X		
NB	0.590	A	R2-1	24	30								1		X														
		A	R4-1	24	30								1																
		A	R2-1	24	30		 1000 1304 0060	5.00								1		X							SPEED LIMIT SIGN IN TOP POSITION	X		
		A	R4-1	24	30			5.00																	SALVAGED MM ONTO NEW POST.	X		
NB	0.810	A	W2-3MR	30	30		SIDE ROAD RIGHT (DOWN 45º) SYMBOL 						1		X														
		A	W1-2Mh L	30	30			6.25								1		X										6
		A	W16-8	30	8		1000 1304 0080	1.67																	SALVAGED MM ONTO NEW POST.			8
NB	0.830	A	R2-1	24	30		SPEED LIMIT 35						1		X														
							SHEET TOTALS	46.42 SF	0.00 SF	0 EA	0 EA	0 EA	7 EA	0 EA	0 EA	8 EA			120 FT										
							TOWN TOTALS	648.1	0.0	30.0	3.0	1.0	116	0.0	0.0	112			1680.0										

SIGN SUMMARY SHEET

VERMONT AGENCY OF TRANSPORTATION

PROJECT NAME: Stamford-Andover VT100
PROJECT NUMBER: STPG SIGN(20)

FILE NAME: Dover.xls
PROJECT MANAGER: N. Averv
DESIGNED BY: M. Miller
DOVER SHEET 2

PLOT DATE: 8/6/2009
DRAWN BY: I. Shea
CHECKED BY: T. Guazzoni
SHEET 99 OF 198

DIRECTION	MILEPOINT	LOCATION CODE (SHEET 2)	SIGN CODE	WIDTH (IN)	HEIGHT (IN)	SHEETING REMARKS	SIGN LEGEND	NEW SIGNS "A"	NEW SIGNS "B"	EXISTING SIGNS RETAIN	EXISTING SIGNS SALVAGE FROM	EXISTING SIGNS SALVAGE TO	EXISTING SIGNS REMOVE	EXIST POST RETAIN	EXIST POST REMOVE	NUMBER OF NEW POSTS	SQUARE STEEL (IN) 1.75 (LB / FT) 1.88	SQUARE STEEL (IN) 2.00 (LB / FT) 2.42	SQUARE STEEL (IN) 2.50 (LB / FT) 3.35	TUBULAR STEEL Ø (IN) FOUNDATION	TUBULAR STEEL Ø (IN) 3.00 (LB / FT) 7.60	TUBULAR STEEL Ø (IN) 3.50 (LB / FT) 9.00	TUBULAR STEEL Ø (IN) 4.00 (LB / FT) 10.80	TUBULAR STEEL Ø (IN) 5.00 (LB / FT) 14.60	SIGN FRAME REQUIRED	REMARKS	SIGN DETAIL: DETAIL IN SHS	SIGN DETAIL: DETAIL ON SHEET NUMBER	SIGN DETAIL: DETAIL ON STD SHEET NUMBER
DOVER VT 100							FY-FLUORESCENT YELLOW FYG-FLUORESCENT YELLOW GREEN																				"SHS"-STANDARD HIGHWAY SIGNS			
NB	0.850	A	VD-062AS	72	16		BUSINESS SIGN			1				X														
		A	VD-062AS	72	16		BUSINESS SIGN			1																		
NB	0.890	C	VR-017	24	30								1		X												DORR FITCH RD (TH-4)			
		C	VR-017	24	30			5.00								1		X										E-141
NB	0.900	D	R1-1	30	30								1		X												DORR FITCH RD (TH-4)			
		D	R1-1	30	30			6.25							1		X								SALVAGED STREED SIGN AND MM ONTO NEW POST.	X		
NB	0.925	A	R2-1	24	30								1		X															
		A	R2-1	24	30			5.00								1		X									X	
NB	0.983	C	VR-017	24	30								1		X												PARSONAGE RD (TH-35)			
		C	VR-017	24	30			5.00								1		X										E-141
NB	0.991	D	R1-1	30	30								1		X												PARSONAGE RD (TH-35)			
		D	R1-1	30	30			6.25							1		X								SALVAGED STREED SIGN AND MM ONTO NEW POST.	X		
NB	1.096	C	VR-017	24	30								1		X												VALLEY VIEW RD (TH-15)			
		C	VR-017	24	30			5.00								1		X										E-141
NB	1.104	D	R1-1	30	30								1		X												VALLEY VIEW RD (TH-15)			
SIGN SUMMARY SHEET							SHEET TOTALS	32.50	0.00	2	0	0	7	0	0	6		90										
								SF	SF	EA	EA	EA	EA	EA	EA	EA		FT										
VERMONT AGENCY OF TRANSPORTATION							TOWN TOTALS	648.1	0.0	30.0	3.0	1.0	116	0.0	0.0	112		1680.0										

PROJECT NAME: **Stamford-Andover VT100**
PROJECT NUMBER: **STPG SIGN(20)**

FILE NAME: **Dover.xls**
PROJECT MANAGER: **N. Averv**
DESIGNED BY: **M. Miller**
DOVER SHEET 3

PLOT DATE: **8/6/2009**
DRAWN BY: **I. Shea**
CHECKED BY: **T. Guazzoni**
SHEET **100** OF **198**

DIRECTION	MILEPOINT	LOCATION CODE (SHEET 2)	SIGN CODE	WIDTH (IN)	HEIGHT (IN)	SHEETING REMARKS	SIGN LEGEND	NEW SIGNS "A"	NEW SIGNS "B"	EXISTING SIGNS RETAIN	EXISTING SIGNS SALVAGE FROM	EXISTING SIGNS SALVAGE TO	EXISTING SIGNS REMOVE	EXIST POST RETAIN	EXIST POST REMOVE	NUMBER OF NEW POSTS	SQUARE STEEL (IN) 1.75 (LB/FT) 1.88	SQUARE STEEL (IN) 2.00 (LB/FT) 2.42	SQUARE STEEL (IN) 2.50 (LB/FT) 3.35	TUBULAR STEEL Ø (IN) FOUNDATION	TUBULAR STEEL Ø (IN) 3.00 (LB/FT) 7.60	TUBULAR STEEL Ø (IN) 3.50 (LB/FT) 9.00	TUBULAR STEEL Ø (IN) 4.00 (LB/FT) 10.80	TUBULAR STEEL Ø (IN) 5.00 (LB/FT) 14.60	SIGN FRAME REQUIRED	REMARKS	SIGN DETAIL: DETAIL IN SHS	SIGN DETAIL: DETAIL ON SHEET NUMBER	SIGN DETAIL: DETAIL ON STD SHEET NUMBER
DOVER VT 100							FY-FLUORESCENT YELLOW FYG-FLUORESCENT YELLOW GREEN																			"SHS"-STANDARD HIGHWAY SIGNS			
		D	R1-1	30	30		VALLEY VIEW RD STOP 1000 1304 0110	6.25			I	I				1		X		SALVAGED STREET SIGN AND MM ONTO NEW POST.					INSTALL IN POSITION OF BUS STOP SIGN.	X		
		D	N/A				BUS STOP SIGN				~~I~~															SEE NB I.106 BELOW. ~~SALVAGE SIGN TO M.P. 1.106~~			
NB	1.106	A	N/A				BUS STOP SIGN					~~I~~				1		X								NO WORK WAS DONE. ~~SALVAGED SIGN FROM M.P. 1.104~~			
NB	1.200	A	R2-1	24	30								1		X													
		B	W14-3	48	36								1															
		A	R2-1	24	30		SPEED LIMIT 40 NO PASSING ZONE	5.00								1		X									X	
		B	W14-3	40	30			3.86																		INSTALL ON BACK	X	
NB	~~1.235~~ I.314	A	M3-1	24	12		NORTH VERMONT 100	2.00								1		X		THIS SIGN WAS MOVED FOR BETTER VISIBILITY					GREEN ON WHITE SHEETING.	X	
		A	M1-5	30	24			5.00																		INSTALL ~~200~~ 600 FT ± NORTH OF SPEED LIMIT 40. MAINTAIN 10 FT MIN TO UTILITY POLE.		E-136B
NB	1.410	A	R2-1	24	30		SPEED LIMIT 40 1000 1304 0140						1		X											SALVAGED MM ONTO NEW POST.		
		A	R2-1	24	30			5.00								1		X									X	
NB	1.500	A	VD-062AS	72	16		BUSINESS SIGN			1				X														
		A	VD-062AS	72	16		BUSINESS SIGN			1																		
NB	1.581	C	VR-017	24	30		LEGAL LOAD LIMIT 24,000 POUNDS						1		X												WINDY HILL RD (TH-14)		
		C	VR-017	24	30			5.00								1		X										E-141
							SHEET TOTALS	32.11	0.00	2	1	1	4	0	0	6		90										
								SF	SF	EA	EA	EA	EA	EA	EA	EA		FT										
							TOWN TOTALS	648.1	0.0	30.0	3.0	1.0	116	0.0	0.0	112		1680.0										

SIGN SUMMARY SHEET

VERMONT AGENCY OF TRANSPORTATION

PROJECT NAME: **Stamford-Andover VT100**
PROJECT NUMBER: **STPG SIGN(20)**

FILE NAME: **Dover.xls**
PROJECT MANAGER: **N. Averv**
DESIGNED BY: **M. Miller**
DOVER SHEET 4

PLOT DATE: **8/6/2009**
DRAWN BY: **I. Shea**
CHECKED BY: **T. Guazzoni**
SHEET **101** OF **198**

DIRECTION	MILEPOINT	LOCATION CODE (SHEET 2)	SIGN CODE	WIDTH (IN)	HEIGHT (IN)	SHEETING REMARKS	SIGN LEGEND	NEW SIGNS "A"	NEW SIGNS "B"	EXISTING SIGNS RETAIN	EXISTING SIGNS SALVAGE FROM	EXISTING SIGNS SALVAGE TO	EXISTING SIGNS REMOVE	EXIST POST RETAIN	EXIST POST REMOVE	NUMBER OF NEW POSTS	SQUARE STEEL (IN) 1.75 (LB / FT) 1.88	SQUARE STEEL (IN) 2.00 (LB / FT) 2.42	SQUARE STEEL (IN) 2.50 (LB / FT) 3.35	TUBULAR STEEL Ø (IN) FOUNDATION	TUBULAR STEEL Ø (IN) 3.00 (LB / FT) 7.60	TUBULAR STEEL Ø (IN) 3.50 (LB / FT) 9.00	TUBULAR STEEL Ø (IN) 4.00 (LB / FT) 10.80	TUBULAR STEEL Ø (IN) 5.00 (LB / FT) 14.60	SIGN FRAME REQUIRED	REMARKS	SIGN DETAIL: DETAIL IN SHS	SIGN DETAIL: DETAIL ON SHEET NUMBER	SIGN DETAIL: DETAIL ON STD SHEET NUMBER
DOVER VT 100							FY-FLUORESCENT YELLOW FYG-FLUORESCENT YELLOW GREEN																				"SHS"-STANDARD HIGHWAY SIGNS			
NB	1.589	D	R1-1	30	30								1		X											WINDY HILL RD (TH-14)			
		D	R1-1	30	30			6.25								1		X								X		
NB	1.600	A	R2-1	24	30		SPEED LIMIT 40 						1		X															
NB	1.640	A	R2-1	24	30			5.00								1		X								INSTALL 200 FT ± AHEAD, NORTH OF EXISTING LOCATION. MAINTAIN 10 FT MIN TO UTILITY POLE.	X		
NB	1.930	A	R2-1	24	30								1		X															
		A	R2-1	24	30			5.00								1		X									X		
NB	2.070	A	VD-062B	72	16		BUSINESS SIGN			1				X				X											
NB	2.145	A	M3-1	24	12								1		X			X											
		A	M1-5	30	24								1																
		A	M6-2	21	15								1																
		A	M3-1	24	12			2.00								1		X								GREEN ON WHITE SHEETING	X		
		A	M1-5	30	24			5.00																		ASSEMBLY IS BEHIND RAIL			E-136B
		A	M6-2L	21	15			2.19																		GREEN ON WHITE SHEETING	X		
NB	2.170	C	VR-017	24	30								1		X												BLUE BROOK RD (TH-8)			
		C	VR-017	24	30			5.00								1		X								SOUTHERLY APPROACH TO TH-8			E-141
							SHEET TOTALS	30.44	0.00	1	0	0	7	0	0	5		75										
								SF	SF	EA	EA	EA	EA	EA	EA	EA		FT										
							TOWN TOTALS	648.1	0.0	30.0	3.0	1.0	116	0.0	0.0	112		1680.0										

SIGN SUMMARY SHEET

VERMONT AGENCY OF TRANSPORTATION

PROJECT NAME: **Stamford-Andover VT100**
PROJECT NUMBER: **STPG SIGN(20)**

FILE NAME: **Dover.xls**
PROJECT MANAGER: **N. Avery**
DESIGNED BY: **M. Miller**
DOVER SHEET 5

PLOT DATE: **8/6/2009**
DRAWN BY: **I. Shea**
CHECKED BY: **T. Guazzoni**
SHEET **102** OF **198**

DIRECTION	MILEPOINT	LOCATION CODE (SHEET 2)	SIGN CODE	WIDTH (IN)	HEIGHT (IN)	SHEETING REMARKS	SIGN LEGEND	NEW SIGNS "A"	NEW SIGNS "B"	EXISTING SIGNS RETAIN	EXISTING SIGNS SALVAGE FROM	EXISTING SIGNS SALVAGE TO	EXISTING SIGNS REMOVE	EXIST POST RETAIN	EXIST POST REMOVE	NUMBER OF NEW POSTS	SQUARE STEEL (IN) 1.75 (LB / FT) 1.88	SQUARE STEEL (IN) 2.00 (LB / FT) 2.42	SQUARE STEEL (IN) 2.50 (LB / FT) 3.35	TUBULAR STEEL Ø (IN) FOUNDATION	TUBULAR STEEL Ø (IN) 3.00 (LB / FT) 7.60	TUBULAR STEEL Ø (IN) 3.50 (LB / FT) 9.00	TUBULAR STEEL Ø (IN) 4.00 (LB / FT) 10.80	TUBULAR STEEL Ø (IN) 5.00 (LB / FT) 14.60	SIGN FRAME REQUIRED	REMARKS	SIGN DETAIL: DETAIL IN SHS	SIGN DETAIL: DETAIL ON SHEET NUMBER	SIGN DETAIL: DETAIL ON STD SHEET NUMBER
DOVER VT 100							FY-FLUORESCENT YELLOW FYG-FLUORESCENT YELLOW GREEN																				"SHS"-STANDARD HIGHWAY SIGNS			
NB	2.180	D	R1-1	30	30								1		X														
		D	R1-1	30	30			6.25								1		X									SOUTHERLY APPROACH TO BLUE BROOK RD (TH-8)	X		
NB	2.210	A	R2-1	24	30		SPEED LIMIT 40						1		X														
NB	2.212	C	VR-017	24	30								1		X													BLUE BROOK RD (TH-8)			
		C	VR-017	24	30			5.00								1		X									NORTHERLY APPROACH TO TH-8			E-141
NB	2.220	D	R1-1	30	30								1		X														
		D	R1-1	30	30		 	6.25								1		X		SALVAGED MM ONTO NEW POST					NORTHERLY APPROACH TO BLUE BROOK RD (TH-8)	X		
NB	2.295	A	R2-1	24	30			5.00								1		X									INSTALL BETWEEN THE TWO DRIVES IN THE GRASSY SECTION, JUST SOUTH OF THE DOVER POLICE DEPT.	X		
NB	2.715	A	VD-062B	72	16		BUSINESS SIGN			1				X															
		A	VD-062AL	72	16		BUSINESS SIGN			1																			
		A	VD-062AS	72	16		BUSINESS SIGN			1																			
NB	2.810	A	M3-1	24	12								1		X														
		A	M1-5	30	24								1																
		A	M6-2	21	15								1																
		A	M3-1	24	12			2.00								1		X									GREEN ON WHITE SHEETING	X		
SIGN SUMMARY SHEET							SHEET TOTALS	24.50	0.00	3	0	0	7	0	0	5		75										
								SF	SF	EA	EA	EA	EA	EA	EA	EA		FT										
VERMONT AGENCY OF TRANSPORTATION							TOWN TOTALS	648.1	0.0	30.0	3.0	1.0	116	0.0	0.0	112		1680.0										

PROJECT NAME: **Stamford-Andover VT100**
PROJECT NUMBER: **STPG SIGN(20)**

FILE NAME: **Dover.xls** PLOT DATE: **8/6/2009**
PROJECT MANAGER: **N. Averv** DRAWN BY: **I. Shea**
DESIGNED BY: **M. Miller** CHECKED BY: **T. Guazzoni**
DOVER SHEET 6 SHEET **103** OF **198**

DIRECTION	MILEPOINT	LOCATION CODE (SHEET 2)	SIGN CODE	WIDTH (IN)	HEIGHT (IN)	SHEETING REMARKS	SIGN LEGEND	NEW SIGNS "A"	NEW SIGNS "B"	EXISTING SIGNS RETAIN	EXISTING SIGNS SALVAGE FROM	EXISTING SIGNS SALVAGE TO	EXISTING SIGNS REMOVE	EXIST POST RETAIN	EXIST POST REMOVE	NUMBER OF NEW POSTS	SQUARE STEEL (IN) 1.75 (LB / FT) 1.88	SQUARE STEEL (IN) 2.00 (LB / FT) 2.42	SQUARE STEEL (IN) 2.50 (LB / FT) 3.35	TUBULAR STEEL Ø (IN) FOUNDATION	TUBULAR STEEL Ø (IN) 3.00 (LB / FT) 7.60	TUBULAR STEEL Ø (IN) 3.50 (LB / FT) 9.00	TUBULAR STEEL Ø (IN) 4.00 (LB / FT) 10.80	TUBULAR STEEL Ø (IN) 5.00 (LB / FT) 14.60	SIGN FRAME REQUIRED	REMARKS	SIGN DETAIL: DETAIL IN SHS	SIGN DETAIL: DETAIL ON SHEET NUMBER	SIGN DETAIL: DETAIL ON STD SHEET NUMBER
DOVER VT 100							FY-FLUORESCENT YELLOW FYG-FLUORESCENT YELLOW GREEN																			"SHS"-STANDARD HIGHWAY SIGNS			
		A	M1-5	30	24			5.00																			
		A	M6-2R	21	15			2.19																		GREEN ON WHITE SHEETING	X		E-136B
NB	2.890	A	R2-1	24	30								1		X														
		A	R2-1	24	30			5.00								1		X									X		
NB	3.006	C	VR-017	24	30								1		X						SALVAGED MM ONTO NEW POST.					MOUNTAINVIEW LOOP (SOUTH) (TH-45)			
		C	VR-017	24	30		1000 1304 0301	5.00								1		X											E-141
NB	3.014	D	R1-1	30	30								1		X											MOUNTAINVIEW LOOP (SOUTH) (TH-45)			
		D	R1-1	30	30			6.25								1		X									X		
NB	3.069	C	VR-017	24	30		LEGAL LOAD LIMIT 24,000 LBS			1				X											MOUNTAINVIEW LOOP (NORTH) (TH-45)			
NB	3.077	D	R1-1	30	30								1		X											MOUNTAINVIEW LOOP (NORTH) (TH-45)			
		D	R1-1	30	30			6.25								1		X									X		
NB	3.290	A	VD-062AS	72	16		BUSINESS SIGN			1				X															
NB	3.320	A	VD-062B	72	16		BUSINESS SIGN			1				X															
		A	VD-062AL	72	16		BUSINESS SIGN			1																			
		A	VD-062B	72	16		BUSINESS SIGN			1																			
							SHEET TOTALS	29.69	0.00	5	0	0	4	0	0	4		60										
								SF	SF	EA	EA	EA	EA	EA	EA	EA		FT										
							TOWN TOTALS	648.1	0.0	30.0	3.0	1.0	116	0.0	0.0	112		1680.0										

SIGN SUMMARY SHEET

VERMONT AGENCY OF TRANSPORTATION

PROJECT NAME: **Stamford-Andover VT100**
PROJECT NUMBER: **STPG SIGN(20)**

FILE NAME: **Dover.xls**
PROJECT MANAGER: **N. Averv**
DESIGNED BY: **M. Miller**
DOVER SHEET 7

PLOT DATE: **8/6/2009**
DRAWN BY: **I. Shea**
CHECKED BY: **T. Guazzoni**
SHEET **104** OF **198**

DIRECTION	MILEPOINT	LOCATION CODE (SHEET 2)	SIGN CODE	WIDTH (IN)	HEIGHT (IN)	SHEETING REMARKS	SIGN LEGEND	NEW SIGNS "A"	NEW SIGNS "B"	EXISTING SIGNS RETAIN	EXISTING SIGNS SALVAGE FROM	EXISTING SIGNS SALVAGE TO	EXISTING SIGNS REMOVE	EXIST POST RETAIN	EXIST POST REMOVE	NUMBER OF NEW POSTS	SQUARE STEEL (IN) 1.75 (LB / FT) 1.88	SQUARE STEEL (IN) 2.00 (LB / FT) 2.42	SQUARE STEEL (IN) 2.50 (LB / FT) 3.35	TUBULAR STEEL Ø (IN) FOUNDATION	TUBULAR STEEL Ø (IN) 3.00 (LB / FT) 7.60	TUBULAR STEEL Ø (IN) 3.50 (LB / FT) 9.00	TUBULAR STEEL Ø (IN) 4.00 (LB / FT) 10.80	TUBULAR STEEL Ø (IN) 5.00 (LB / FT) 14.60	SIGN FRAME REQUIRED	REMARKS	SIGN DETAIL: DETAIL IN SHS	SIGN DETAIL: DETAIL ON SHEET NUMBER	SIGN DETAIL: DETAIL ON STD SHEET NUMBER
DOVER VT 100							FY-FLUORESCENT YELLOW FYG-FLUORESCENT YELLOW GREEN																			"SHS"-STANDARD HIGHWAY SIGNS			
NB	3.360	A	VD-062AS	72	16		BUSINESS SIGN			1				X														
		A	VD-062AS	72	16		BUSINESS SIGN			1																		
NB	3.400	A	VD-062AL	72	16		BUSINESS SIGN			1				X														
		A	VD-062AS	72	16		BUSINESS SIGN			1																		
NB	3.440	A	D4-1	30	24								1		X													
		A	VR-731	30	15								1															
		A	D4-1	30	24			5.00								1	X							X		
		A	VR-731	24	8			1.33																		GREEN ON WHITE SHEETING		5
NB	3.480	A	VW-205	30	30		WATCH FOR TURNING VEHICLES						1		X													
NB	3.605	C	M3-1	24	12		NORTH						1		X													
		C	M1-5	30	24		VT 100						1															
		C	M6-1	21	15		LEFT						1															
		C	M3-3	24	12		SOUTH						1															
		C	M1-5	30	24		VT 100						1															
		C	M6-1	21	15		RIGHT						1															
							SHEET TOTALS	6.33 SF	0.00 SF	4 EA	0 EA	0 EA	9 EA	0 EA	0 EA	1 EA	15 FT												
							TOWN TOTALS	648.1	0.0	32.0	1.0	1.0	116	0.0	0.0	112	1680.0												

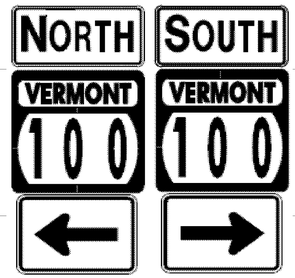
SIGN SUMMARY SHEET

VERMONT AGENCY OF TRANSPORTATION

PROJECT NAME: **Stamford-Andover VT100**
PROJECT NUMBER: **STPG SIGN(20)**

FILE NAME: **Dover.xls**
PROJECT MANAGER: **N. Avery**
DESIGNED BY: **M. Miller**
DOVER SHEET 8

PLOT DATE: **8/10/2009**
DRAWN BY: **I. Shea**
CHECKED BY: **T. Guazzoni**

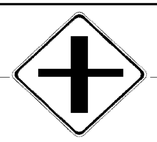
DIRECTION	MILEPOINT	LOCATION CODE (SHEET 2)	SIGN CODE	WIDTH (IN)	HEIGHT (IN)	SHEETING REMARKS	SIGN LEGEND	NEW SIGNS "A"	NEW SIGNS "B"	EXISTING SIGNS RETAIN	EXISTING SIGNS SALVAGE FROM	EXISTING SIGNS SALVAGE TO	EXISTING SIGNS REMOVE	EXIST POST RETAIN	EXIST POST REMOVE	NUMBER OF NEW POSTS	SQUARE STEEL (IN) 1.75 (LB / FT) 1.88	SQUARE STEEL (IN) 2.00 (LB / FT) 2.42	SQUARE STEEL (IN) 2.50 (LB / FT) 3.35	TUBULAR STEEL Ø (IN) FOUNDATION	TUBULAR STEEL Ø (IN) 3.00 (LB / FT) 7.60	TUBULAR STEEL Ø (IN) 3.50 (LB / FT) 9.00	TUBULAR STEEL Ø (IN) 4.00 (LB / FT) 10.80	TUBULAR STEEL Ø (IN) 5.00 (LB / FT) 14.60	SIGN FRAME REQUIRED	REMARKS	SIGN DETAIL: DETAIL IN SHS	SIGN DETAIL: DETAIL ON SHEET NUMBER	SIGN DETAIL: DETAIL ON STD SHEET NUMBER
DOVER VT 100							FY-FLUORESCENT YELLOW FYG-FLUORESCENT YELLOW GREEN																			"SHS"-STANDARD HIGHWAY SIGNS			
NB	3.610	C	M3-1	24	12			2.00								2		X							#2B	GREEN ON WHITE SHEETING; INSTALL ASSEMBLY 25 FT +/- NORTH OF PREVIOUS POSITION	X	7	
		C	M1-5	30	24			5.00																				E-136B
		C	M6-1L	21	15			2.19																			GREEN ON WHITE SHEETING	X		
		C	M3-3	24	12			2.00																			GREEN ON WHITE SHEETING	X		
		C	M1-5	30	24			5.00																						E-136B
		C	M6-1R	21	15			2.19																			GREEN ON WHITE SHEETING	X		
NB	3.640	A	M3-1S	24	12								1		X															
		A	M1-5	24	24								1																	
		A	M3-1	24	12			2.00								1		X									GREEN ON WHITE SHEETING	X		
		A	M1-5	30	24			5.00																						E-136B
NB	3.960	A	D1-1S	72	10								1		X															
		A	D1-1	72	12			6.00								2		X											5	
NB	4.035	A	VD-062B	72	16		BUSINESS SIGN			1				X																
NB	4.060	A	N/A				~~TWO EMPTY POSTS~~								X												MISSING			
NB	4.150	A	M3-1	24	12								1		X															
SIGN SUMMARY SHEET							SHEET TOTALS	31.38 SF	0.00 SF	1 EA	0 EA	0 EA	4 EA	0 EA	0 EA	5 EA		75 FT									
VERMONT AGENCY OF TRANSPORTATION							TOWN TOTALS	648.1	0.0	30.0	3.0	1.0	116	0.0	0.0	112		1680.0									

PROJECT NAME: **Stamford-Andover VT100**
PROJECT NUMBER: **STPG SIGN(20)**
FILE NAME: **Dover.xls** PLOT DATE: **8/6/2009**
PROJECT MANAGER: **N. Averv** DRAWN BY: **I. Shea**
DESIGNED BY: **M. Miller** CHECKED BY: **T. Guazzoni**
DOVER SHEET 9 SHEET **106** OF **198**

DIRECTION	MILEPOINT	LOCATION CODE (SHEET 2)	SIGN CODE	WIDTH (IN)	HEIGHT (IN)	SHEETING REMARKS	SIGN LEGEND	NEW SIGNS "A"	NEW SIGNS "B"	EXISTING SIGNS RETAIN	EXISTING SIGNS SALVAGE FROM	EXISTING SIGNS SALVAGE TO	EXISTING SIGNS REMOVE	EXIST POST RETAIN	EXIST POST REMOVE	NUMBER OF NEW POSTS	SQUARE STEEL (IN) 1.75 (LB / FT) 1.88	SQUARE STEEL (IN) 2.00 (LB / FT) 2.42	SQUARE STEEL (IN) 2.50 (LB / FT) 3.35	TUBULAR STEEL Ø (IN) FOUNDATION	TUBULAR STEEL Ø (IN) 3.00 (LB / FT) 7.60	TUBULAR STEEL Ø (IN) 3.50 (LB / FT) 9.00	TUBULAR STEEL Ø (IN) 4.00 (LB / FT) 10.80	TUBULAR STEEL Ø (IN) 5.00 (LB / FT) 14.60	SIGN FRAME REQUIRED	REMARKS	SIGN DETAIL: DETAIL IN SHS	SIGN DETAIL: DETAIL ON SHEET NUMBER	SIGN DETAIL: DETAIL ON STD SHEET NUMBER
DOVER VT 100							FY-FLUORESCENT YELLOW FYG-FLUORESCENT YELLOW GREEN																				"SHS"-STANDARD HIGHWAY SIGNS			
		A	M1-5	24	24								1																
		A	M3-1	24	12		NORTH / VERMONT 100	2.00								1		X									GREEN ON WHITE SHEETING	X		
		A	M1-5	30	24		SPEED LIMIT 50	5.00																					E-136B
NB	4.190	A	R2-1	24	30			5.00								1		X									INSTALL 240 FT ± NORTH OF THE ROUTE MARKER ASSEMBLY	X		
NB	4.821	C	VR-017	24	30		NO PARKING / LEGAL LOAD LIMIT 24,000 POUNDS				I	I	1		X												AHMEEK RD (TH-13)			
		C	VR-017	24	30			5.00					I			1		X												E-141
NB	4.829	D	R1-1	30	30		STOP						1		X												AHMEEK RD (TH-13)			
		D	R1-1	30	30			6.25								1		X										X		
NB	5.270	A	W11-6H	30	30		SNOWMOBILE SYMBOL				I		~~1~~		X												SNOWMOBILES USE THE CROSSING. NO WORK WAS DONE.			
NB	5.300	C	VR-017	24	30		LEGAL LOAD LIMIT 24,000 POUNDS / NO PARKING					I	I	1		X											BLUE BROOK RD (TH-8)			
		C	VR-017	24	30			5.00						I			1		X											E-141
NB	5.308	D	R1-1	30	30		STOP / BLUE BROOK RD					I	I	1		X											BLUE BROOK RD (TH-8)			
		D	R1-1	30	30		~~1000 1304 0530~~	6.25								1		X									STREET SIGN AND MMSALVAGED ONTO NEW POST.	X		
NB	5.453	C	VR-017	24	30		LEGAL LOAD LIMIT 24,000 POUNDS						1		X												DUNCAN RD (TH-33)			
		C	VR-017	24	30			5.00								1		X												E-141
SIGN SUMMARY SHEET							SHEET TOTALS	39.50	0.00	~~1~~ 0	~~3~~ 0	~~3~~ 0	~~8~~ 7	0	0	7		105											
								SF	SF	EA	EA	EA	EA	EA	EA	EA		FT											
VERMONT AGENCY OF TRANSPORTATION							TOWN TOTALS	648.1	0.0	30.0	3.0	1.0	116	0.0	0.0	112		1680.0											

PROJECT NAME: **Stamford-Andover VT100**
PROJECT NUMBER: **STPG SIGN(20)**

FILE NAME: **Dover.xls** PLOT DATE: **8/6/2009**
PROJECT MANAGER: **N. Averv** DRAWN BY: **I. Shea**
DESIGNED BY: **M. Miller** CHECKED BY: **T. Guazzoni**
DOVER SHEET 10 SHEET **107** OF **198**

DIRECTION	MILEPOINT	LOCATION CODE (SHEET 2)	SIGN CODE	WIDTH (IN)	HEIGHT (IN)	SHEETING REMARKS	SIGN LEGEND	NEW SIGNS "A"	NEW SIGNS "B"	EXISTING SIGNS RETAIN	EXISTING SIGNS SALVAGE FROM	EXISTING SIGNS SALVAGE TO	EXISTING SIGNS REMOVE	EXIST POST RETAIN	EXIST POST REMOVE	NUMBER OF NEW POSTS	SQUARE STEEL (IN) (LB / FT) 1.75 / 1.88	SQUARE STEEL (IN) (LB / FT) 2.00 / 2.42	SQUARE STEEL (IN) (LB / FT) 2.50 / 3.35	TUBULAR STEEL Ø (IN) FOUNDATION	TUBULAR STEEL Ø (IN) (LB / FT) 3.00 / 7.60	TUBULAR STEEL Ø (IN) (LB / FT) 3.50 / 9.00	TUBULAR STEEL Ø (IN) (LB / FT) 4.00 / 10.80	TUBULAR STEEL Ø (IN) (LB / FT) 5.00 / 14.60	SIGN FRAME REQUIRED	REMARKS	SIGN DETAIL: DETAIL IN SHS	SIGN DETAIL: DETAIL ON SHEET NUMBER	SIGN DETAIL: DETAIL ON STD SHEET NUMBER
DOVER VT 100							FY-FLUORESCENT YELLOW FYG-FLUORESCENT YELLOW GREEN																			"SHS"-STANDARD HIGHWAY SIGNS			
NB	5.461	D	R1-1	30	30								1		X											DUNCAN RD (TH-33)			
		D	R1-1	30	30			6.25								1		X								X		
SB	5.470	F	W11-6H	30	30		SNOWMOBILE SYMBOL 			I			~~1~~		~~X~~											SNOWMOBILES USE THIS CROSSING. NO WORK WAS DONE.			
SB	4.570	F	W2-2Ma R	30	30			6.25								1		X								INSTALL 500 FT ± IN ADVANCE OF TH-50.		6	
SB	4.474	G	VR-017	24	30								1		X											UPPER HIGHLANDS LOOP (TH-50)			
		G	VR-017	24	30			5.00								1		X										E-141
SB	4.466	H	R1-1	30	30		 UPPER HIGHLANDS LOOP 1000 1304 0447				I	I	1		X											UPPER HIGHLANDS LOOP (TH-50)			
		H	R1-1	30	30			6.25								1		X									X		
SB	4.390	G	VR-017	24	30								1		X											LOWER HIGHLANDS RD (TH-53)			
		G	VR-017	24	30			5.00					I			1		X										E-141
SB	4.380	H	R1-1	30	30		 LOWER HIGHLANDS RD 1000 1304 0439				I	I	1		X											LOWER HIGHLANDS RD (TH-53)			
		H	R1-1	30	30			6.25								1		X									X		
SB	4.360	F	VD-062AS	72	16		BUSINESS SIGN			1				X															
SB	4.240	F	W2-1M	30	30								1		X														
		F	W2-1Mb	30	30			6.25								1		X										6	
SIGN SUMMARY SHEET							SHEET TOTALS	41.25 SF	0.00 SF	~~2~~ 1 EA	~~2~~ 0 EA	~~2~~ 0 EA	7 EA	0 EA	0 EA	7 EA		105 FT											
VERMONT AGENCY OF TRANSPORTATION							TOWN TOTALS	648.1	0.0	30.0	3.0	1.0	116	0.0	0.0	112		1680.0										

PROJECT NAME: **Stamford-Andover VT100**
PROJECT NUMBER: **STPG SIGN(20)**

FILE NAME: **Dover.xls**
PROJECT MANAGER: **N. Averv**
DESIGNED BY: **M. Miller**
DOVER SHEET 11

PLOT DATE: **8/6/2009**
DRAWN BY: **I. Shea**
CHECKED BY: **T. Guazzoni**
SHEET **108** OF **198**

DIRECTION	MILEPOINT	LOCATION CODE (SHEET 2)	SIGN CODE	WIDTH (IN)	HEIGHT (IN)	SHEETING REMARKS	SIGN LEGEND	NEW SIGNS "A"	NEW SIGNS "B"	EXISTING SIGNS RETAIN	EXISTING SIGNS SALVAGE FROM	EXISTING SIGNS SALVAGE TO	EXISTING SIGNS REMOVE	EXIST POST RETAIN	EXIST POST REMOVE	NUMBER OF NEW POSTS	SQUARE STEEL (IN) 1.75 (LB / FT) 1.88	SQUARE STEEL (IN) 2.00 (LB / FT) 2.42	SQUARE STEEL (IN) 2.50 (LB / FT) 3.35	TUBULAR STEEL Ø (IN) FOUNDATION	TUBULAR STEEL Ø (IN) 3.00 (LB / FT) 7.60	TUBULAR STEEL Ø (IN) 3.50 (LB / FT) 9.00	TUBULAR STEEL Ø (IN) 4.00 (LB / FT) 10.80	TUBULAR STEEL Ø (IN) 5.00 (LB / FT) 14.60	SIGN FRAME REQUIRED	REMARKS	SIGN DETAIL: DETAIL IN SHS	SIGN DETAIL: DETAIL ON SHEET NUMBER	SIGN DETAIL: DETAIL ON STD SHEET NUMBER
DOVER VT 100							FY-FLUORESCENT YELLOW FYG-FLUORESCENT YELLOW GREEN																			"SHS"-STANDARD HIGHWAY SIGNS			
SB	4.202	F	D1-1	72	12		MOUNT SNOW SKI AREA →	6.00								2		X								INSTALL 200 FT ± SOUTH OF THE CROSSROAD WARNING SIGN		5	
SB	4.130	G	VR-017	24	30		LEGAL LOAD LIMIT 24,000 POUNDS						1		X											MOUNT SNOW NORTH ACCESS ROAD			
		G	VR-017	24	30			5.00								1		X										E-141
SB	4.120	H	R1-1	30	30		STOP 1000 1304 0413						1													MOUNT SNOW NORTH ACCESS ROAD			
		H	R1-1	30	30			6.25								1		X								INSTALL AS CLOSE TO STOPPING POINT AS POSSIBLE	X		
SB	4.103	F	M3-3	24	12								1		X														
		F	M1-5	30	24								1																
		F	M3-3	24	12		SOUTH VERMONT 100	2.00								1/2		X								GREEN ON WHITE SHEETING	X		
		F	M1-5	30	24		SPEED LIMIT 50	5.00																				E-136B
SB	4.046	F	R2-1	24	30			5.00								1		X								INSTALL 300 FT SOUTH OF THE ROUTE MARKER ASSEMBLY	X		
SB	3.940	F	VD-062AL	72	16		BUSINESS SIGN			1				X															
		F	VD-062B	72	16		BUSINESS SIGN			1																			
		F	VD-062AS	72	16		BUSINESS SIGN			1																			
SB	3.720	F	W2-2Ma R	30	30		⊢	6.25								1		X								INSTALL 25 FEET IN NORTH OF THE EXISTING SIGN.		6	
SB	3.715	F	W2-2R	30	30		SIDE ROAD RIGHT SYMBOL						1		X														
							SHEET TOTALS	35.50 SF	0.00 SF	3 EA	0 EA	0 EA	5/4 EA	0 EA	0 EA	7/8 EA		120 FT										
							TOWN TOTALS	648.1	0.0	30.0	3.0	1.0	116	0.0	0.0	112		1680.0										

SIGN SUMMARY SHEET

VERMONT AGENCY OF TRANSPORTATION

PROJECT NAME: **Stamford-Andover VT100**
PROJECT NUMBER: **STPG SIGN(20)**

FILE NAME: **Dover.xls**
PROJECT MANAGER: **N. Averv**
DESIGNED BY: **M. Miller**
DOVER SHEET 12

PLOT DATE: **8/6/2009**
DRAWN BY: **I. Shea**
CHECKED BY: **T. Guazzoni**
SHEET **109** OF **198**

DIRECTION	MILEPOINT	LOCATION CODE (SHEET 2)	SIGN CODE	WIDTH (IN)	HEIGHT (IN)	SHEETING REMARKS	SIGN LEGEND	NEW SIGNS "A"	NEW SIGNS "B"	EXISTING SIGNS RETAIN	EXISTING SIGNS SALVAGE FROM	EXISTING SIGNS SALVAGE TO	EXISTING SIGNS REMOVE	EXIST POST RETAIN	EXIST POST REMOVE	NUMBER OF NEW POSTS	SQUARE STEEL (IN) 1.75 (LB / FT) 1.88	SQUARE STEEL (IN) 2.00 (LB / FT) 2.42	SQUARE STEEL (IN) 2.50 (LB / FT) 3.35	TUBULAR STEEL Ø (IN) FOUNDATION	TUBULAR STEEL Ø (IN) 3.00 (LB / FT) 7.60	TUBULAR STEEL Ø (IN) 3.50 (LB / FT) 9.00	TUBULAR STEEL Ø (IN) 4.00 (LB / FT) 10.80	TUBULAR STEEL Ø (IN) 5.00 (LB / FT) 14.60	SIGN FRAME REQUIRED	REMARKS	SIGN DETAIL: DETAIL IN SHS	SIGN DETAIL: DETAIL ON SHEET NUMBER	SIGN DETAIL: DETAIL ON STD SHEET NUMBER
DOVER VT 100							FY-FLUORESCENT YELLOW FYG-FLUORESCENT YELLOW GREEN																			"SHS"-STANDARD HIGHWAY SIGNS			
SB	3.620	G	VR-017	24	30		LEGAL LOAD LIMIT 24,000 POUNDS						1		X											SOUTH ACCESS ROAD (TH-3)			
		G	VR-017	24	30			5.00								1		X										E-141
SB	3.610	H	R1-1	30	30		STOP						1		X											SOUTH ACCESS ROAD (TH-3)			
		H	R1-1	30	30			6.25								1		X								INSTALL CLOSER TO ACTUAL STOPPING POINT.	X		
SB	3.555	F	M3-3	24	12								1		X														
		F	M1-5	24	24								1																
		F	M3-3	24	12		SOUTH VERMONT 100	2.00								1		X								GREEN ON WHITE SHEETING	X		
		F	M1-5	30	24			5.00																				E-136B
SB	3.155	F	VD-062AS	72	16		BUSINESS SIGN			1				X															
SB	3.025	F	R2-5A	24	30		REDUCED SPEED AHEAD SPEED LIMIT 40						1		X														
		F	W3-5	36	36			9.00								2		X									X		
SB	2.965	F	W1-10L	30	30		CURVE LEFT w/ SIDE ROAD RIGHT						1		X														
SB	2.948	F	W1-2Mh L	30	30		Tannery Rd	6.25								1		X								INSTALL 90 FT± SOUTH OF EXISTING SIGN LOCATION.		6	
		F	W16-8	24	8			1.33																				8
SB	2.915	F	VD-062AS	72	16		BUSINESS SIGN			1				X															
							SHEET TOTALS	34.83	0.00	2	0	0	6	0	0	6		90										
								SF	SF	EA	EA	EA	EA	EA	EA	EA		FT										
							TOWN TOTALS	648.1	0.0	30.0	3.0	1.0	116	0.0	0.0	112		1680.0										

SIGN SUMMARY SHEET

VERMONT AGENCY OF TRANSPORTATION

PROJECT NAME: Stamford-Andover VT100
PROJECT NUMBER: STPG SIGN(20)

FILE NAME: Dover.xls
PROJECT MANAGER: N. Avery
DESIGNED BY: M. Miller
DOVER SHEET 13

PLOT DATE: 8/6/2009
DRAWN BY: I. Shea
CHECKED BY: T. Guazzoni

DIRECTION	MILEPOINT	LOCATION CODE (SHEET 2)	SIGN CODE	WIDTH (IN)	HEIGHT (IN)	SHEETING REMARKS	SIGN LEGEND	NEW SIGNS "A"	NEW SIGNS "B"	EXISTING SIGNS RETAIN	EXISTING SIGNS SALVAGE FROM	EXISTING SIGNS SALVAGE TO	EXISTING SIGNS REMOVE	EXIST POST RETAIN	EXIST POST REMOVE	NUMBER OF NEW POSTS	SQUARE STEEL (IN) 1.75 (LB / FT) 1.88	SQUARE STEEL (IN) 2.00 (LB / FT) 2.42	SQUARE STEEL (IN) 2.50 (LB / FT) 3.35	TUBULAR STEEL Ø (IN) FOUNDATION	TUBULAR STEEL Ø (IN) 3.00 (LB / FT) 7.60	TUBULAR STEEL Ø (IN) 3.50 (LB / FT) 9.00	TUBULAR STEEL Ø (IN) 4.00 (LB / FT) 10.80	TUBULAR STEEL Ø (IN) 5.00 (LB / FT) 14.60	SIGN FRAME REQUIRED	REMARKS	SIGN DETAIL: DETAIL IN SHS	SIGN DETAIL: DETAIL ON SHEET NUMBER	SIGN DETAIL: DETAIL ON STD SHEET NUMBER
DOVER VT 100							FY-FLUORESCENT YELLOW FYG-FLUORESCENT YELLOW GREEN																			"SHS"-STANDARD HIGHWAY SIGNS			
		F	VD-062B	72	16		BUSINESS SIGN			1																		
SB	2.890	F	R2-1	30	36			7.50								1		X								INSTALL 25 FT± IN NORTH OF EXISTING SIGN (TO BE REMOVED)	X		
SB	2.885	F	R2-1	24	30		SPEED LIMIT 40						1		X													
SB	2.850	G	VR-017	24	24								1		X												TANNERY RD (TH-3)			
		G	VR-017	24	30			5.00								1		X										E-141
SB	2.830	H	R1-1	30	30								1		X												TANNERY RD (TH-3)			
		H	R1-1	30	30			6.25								1		X								**INSTALL CLOSER TO ACTUAL STOPPING POINT**	X		
SB	2.770	F	S3-1	30	30		SCHOOL BUS STOP AHEAD 						1		X														
		F	R2-1	24	30			5.00								1		X									X	
SB	2.635	F	R2-1	24	30		SPEED LIMIT 40						1		X													
SB	2.595	F	VW-205	30	30								~~1~~ 2		X												SNOWMOBILE SYMBOL SIGN REMOVED - SEE NEXT SHEET.			
		F	VW-205	36	36			9.00								2		X										E-154
SB	2.510	F	W11-8	30	30		FIRE ENGINE SYMBOL						1		X													
		F	W1-2Md L	30	30			6.25								1		X									6	
		F	W16-8	24	8			1.33																			8	
SIGN SUMMARY SHEET							SHEET TOTALS	40.33	0.00	1	0	0	~~8~~ 7	0	0	7		105									
								SF	SF	EA	EA	EA	EA	EA	EA	EA		FT									
VERMONT AGENCY OF TRANSPORTATION							TOWN TOTALS	648.1	0.0	30.0	3.0	1.0	116	0.0	0.0	112		1680.0									

PROJECT NAME: **Stamford-Andover VT100**
PROJECT NUMBER: **STPG SIGN(20)**

FILE NAME: **Dover.xls**
PROJECT MANAGER: **N. Averv**
DESIGNED BY: **M. Miller**
DOVER SHEET 14

PLOT DATE: **8/6/2009**
DRAWN BY: **I. Shea**
CHECKED BY: **T. Guazzoni**
SHEET **111** OF **198**

DIRECTION	MILEPOINT	LOCATION CODE (SHEET 2)	SIGN CODE	WIDTH (IN)	HEIGHT (IN)	SHEETING REMARKS	SIGN LEGEND	NEW SIGNS "A"	NEW SIGNS "B"	EXISTING SIGNS RETAIN	EXISTING SIGNS SALVAGE FROM	EXISTING SIGNS SALVAGE TO	EXISTING SIGNS REMOVE	EXIST POST RETAIN	EXIST POST REMOVE	NUMBER OF NEW POSTS	SQUARE STEEL (IN) 1.75 (LB / FT) 1.88	SQUARE STEEL (IN) 2.00 (LB / FT) 2.42	SQUARE STEEL (IN) 2.50 (LB / FT) 3.35	TUBULAR STEEL Ø (IN) FOUNDATION	TUBULAR STEEL Ø (IN) 3.00 (LB / FT) 7.60	TUBULAR STEEL Ø (IN) 3.50 (LB / FT) 9.00	TUBULAR STEEL Ø (IN) 4.00 (LB / FT) 10.80	TUBULAR STEEL Ø (IN) 5.00 (LB / FT) 14.60	SIGN FRAME REQUIRED	REMARKS	SIGN DETAIL: DETAIL IN SHS	SIGN DETAIL: DETAIL ON SHEET NUMBER	SIGN DETAIL: DETAIL ON STD SHEET NUMBER
DOVER VT 100							FY-FLUORESCENT YELLOW FYG-FLUORESCENT YELLOW GREEN																			"SHS"-STANDARD HIGHWAY SIGNS			
SB	2.482	F	W11-8	30	30			6.25								1		X		SNOWMOBILES SIGN ATTACHED TO LONGER, NEW POST. SEE SHEET #116					INSTALL 150 FT ± SOUTH OF THE ORIGINAL LOCATION.	X		
SB	2.430	G	VR-017	30 ~~24~~	30								1		X											STUGGER RD, NORTH (TH-66)			
		G	VR-017	30 ~~24~~	30			6.25 ~~5.00~~								1		X										E-141
SB	2.422	H	R1-1	24 ~~30~~	30								1		X											STUGGER RD, NORTH (TH-66)			
		H	R1-1	24 ~~30~~	30			5.00 ~~6.25~~								1		X									X		
SB	2.330	G	VR-017	24	30								1		X											STUGGER RD, SOUTH (TH-66)			
		G	VR-017	24	30			6.25 ~~5.00~~								1		X										E-141
SB	2.322	H	R1-1	30	30								1		X											STUGGER RD, SOUTH (TH-66)			
		H	R1-1	30	30			6.25								1		X									X		
SB	2.215	F	R2-1	24	30		SPEED LIMIT 40 						1		X														
SB	2.150	F	R2-1	24	30			5.00								1		X								340 FT ± SOUTH OF ORIGINAL LOCATION	X		
SB	1.940	F	R2-1	24	30		SPEED LIMIT 40						1		X														
SB	1.880	F	VD-062AS	72	16		BUSINESS SIGN			1				X															
		F	VD-062AS	72	16		BUSINESS SIGN			1																			
SB	1.789	G	VR-017	24	30		LEGAL LOAD LIMIT 24,000 LBS			1				X												COUNTRY CLUB RD (TH-9)			
							SHEET TOTALS	33.75 SF	0.00 SF	3 EA	0 EA	0 EA	6 EA	0 EA	0 EA	6 EA		90 FT							
							TOWN TOTALS	648.1	0.0	30.0	3.0	1.0	116	0.0	0.0	112		1680.0							

SIGN SUMMARY SHEET

VERMONT AGENCY OF TRANSPORTATION

PROJECT NAME: **Stamford-Andover VT100**
PROJECT NUMBER: **STPG SIGN(20)**

FILE NAME: **Dover.xls**
PROJECT MANAGER: **N. Averv**
DESIGNED BY: **M. Miller**
DOVER SHEET 15

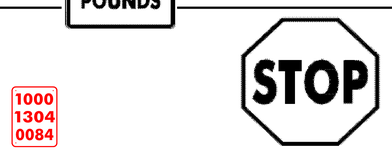
PLOT DATE: **8/6/2009**
DRAWN BY: **I. Shea**
CHECKED BY: **T. Guazzoni**
SHEET **112** OF **198**

DIRECTION	MILEPOINT	LOCATION CODE (SHEET 2)	SIGN CODE	WIDTH (IN)	HEIGHT (IN)	SHEETING REMARKS	SIGN LEGEND	NEW SIGNS "A"	NEW SIGNS "B"	EXISTING SIGNS RETAIN	EXISTING SIGNS SALVAGE FROM	EXISTING SIGNS SALVAGE TO	EXISTING SIGNS REMOVE	EXIST POST RETAIN	EXIST POST REMOVE	NUMBER OF NEW POSTS	SQUARE STEEL (IN) 1.75 (LB / FT) 1.88	SQUARE STEEL (IN) 2.00 (LB / FT) 2.42	SQUARE STEEL (IN) 2.50 (LB / FT) 3.35	TUBULAR STEEL Ø (IN) FOUNDATION	TUBULAR STEEL Ø (IN) 3.00 (LB / FT) 7.60	TUBULAR STEEL Ø (IN) 3.50 (LB / FT) 9.00	TUBULAR STEEL Ø (IN) 4.00 (LB / FT) 10.80	TUBULAR STEEL Ø (IN) 5.00 (LB / FT) 14.60	SIGN FRAME REQUIRED	REMARKS	SIGN DETAIL: DETAIL IN SHS	SIGN DETAIL: DETAIL ON SHEET NUMBER	SIGN DETAIL: DETAIL ON STD SHEET NUMBER
DOVER VT 100							FY-FLUORESCENT YELLOW FYG-FLUORESCENT YELLOW GREEN																			"SHS"-STANDARD HIGHWAY SIGNS			
SB	1.781	H	R1-1	30	30								1		X												COUNTRY CLUB RD (TH-9)			
		H	R1-1	30	30			6.25								1		X									X		
SB	1.762	F	R2-1	24	30			5.00								1		X									INSTALL 100 FT ± SOUTH OF THE JCT w/ COUNTRY CLUB RD	X		
SB	1.685	F	VD-062AS	72	16		BUSINESS SIGN			1				X															
SB	1.420	F	R2-1	24	30		SPEED LIMIT 40						1		X															
SB	1.340	F	VD-018	30	18								1		X															
		F	VD-018	30	18			3.75								1		X											E-128B
SB	1.300	F	VD-062B	72	16		BUSINESS SIGN			1				X															
		F	VD-062AS	72	16		BUSINESS SIGN			1																			
		F	VD-062AS	72	16		BUSINESS SIGN			1																			
SB	1.200	F	R2-1	24	30								1		X															
		F	R2-1	24	30			5.00								1		X									INSTALL ON TOP	X		
		F	R4-1	24	30			5.00																		INSTALL ON BOTTOM	X		
SB	1.108	G	VR-017	24	24								1		X												CROSSTOWN RD (TH-9)			
		G	VR-017	24	30			5.00								1		X											E-141
							SHEET TOTALS	30.00 SF	0.00 SF	4 EA	0 EA	0 EA	5 EA	0 EA	0 EA	5 EA		75 FT										
							TOWN TOTALS	648.1	0.0	30.0	3.0	1.0	116	0.0	0.0	112		1680.0										

SIGN SUMMARY SHEET

VERMONT AGENCY OF TRANSPORTATION

PROJECT NAME: **Stamford-Andover VT100**
PROJECT NUMBER: **STPG SIGN(20)**
FILE NAME: **Dover.xls**
PROJECT MANAGER: **N. Avery**
DESIGNED BY: **M. Miller**
DOVER SHEET 16
PLOT DATE: **8/6/2009**
DRAWN BY: **I. Shea**
CHECKED BY: **T. Guazzoni**
SHEET **113** OF **198**

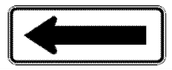
DIRECTION	MILEPOINT	LOCATION CODE (SHEET 2)	SIGN CODE	WIDTH (IN)	HEIGHT (IN)	SHEETING REMARKS	SIGN LEGEND	NEW SIGNS "A"	NEW SIGNS "B"	EXISTING SIGNS RETAIN	EXISTING SIGNS SALVAGE FROM	EXISTING SIGNS SALVAGE TO	EXISTING SIGNS REMOVE	EXIST POST RETAIN	EXIST POST REMOVE	NUMBER OF NEW POSTS	SQUARE STEEL (IN) 1.75 (LB / FT) 1.88	SQUARE STEEL (IN) 2.00 (LB / FT) 2.42	SQUARE STEEL (IN) 2.50 (LB / FT) 3.35	TUBULAR STEEL Ø (IN) FOUNDATION	TUBULAR STEEL Ø (IN) 3.00 (LB / FT) 7.60	TUBULAR STEEL Ø (IN) 3.50 (LB / FT) 9.00	TUBULAR STEEL Ø (IN) 4.00 (LB / FT) 10.80	TUBULAR STEEL Ø (IN) 5.00 (LB / FT) 14.60	SIGN FRAME REQUIRED	REMARKS	SIGN DETAIL: DETAIL IN SHS	SIGN DETAIL: DETAIL ON SHEET NUMBER	SIGN DETAIL: DETAIL ON STD SHEET NUMBER
DOVER VT 100							FY-FLUORESCENT YELLOW FYG-FLUORESCENT YELLOW GREEN																				"SHS"-STANDARD HIGHWAY SIGNS			
SB	1.104	H	R1-1	30	30								1		X												CROSSTOWN RD (TH-9)			
		H	R1-1	30	30			6.25								1		X									X		
SB	1.095	F	R4-1	24	30		DO NOT PASS						1		X														
		F	M3-3	24	12			2.00								1		X								GREEN ON WHITE SHEETING	X		
		F	M1-5	30	24			5.00																		MAINTAIN 10 FT MIN TO UTILITY POLE			E-136B
SB	1.033	F	R2-1	24	30			5.00								1		X								INSTALL 10 FT MIN NORTH OF EXISTING UTILITY POLE. THIS SIGN ON TOP.	X		
		F	R4-1	24	30			5.00																			X		
SB	1.031	F	R2-1	24	30		SPEED LIMIT 35						1		X														
SB	0.843	G	VR-017	24	30			5.00								1		X								BOGLE RD (TH-38)			E-141
SB	0.835	H	R1-1	30	30								1		X												BOGLE RD (TH-38)			
		H	R1-1	30	30			6.25								1		X									X		
SB	0.825	F	R2-1	24	30								1		X														
		F	R4-1	24	30								1																
		F	R2-1	24	30			5.00								1		X									X		
		F	R4-1	24	30			5.00																			X		
SIGN SUMMARY SHEET							SHEET TOTALS	44.50	0.00	0	0	0	6	0	0	6		90										
VERMONT AGENCY OF TRANSPORTATION								SF	SF	EA	EA	EA	EA	EA	EA	EA		FT										
							TOWN TOTALS	648.1	0.0	30.0	3.0	1.0	116	0.0	0.0	112		1680.0										

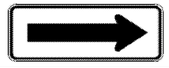
PROJECT NAME: **Stamford-Andover VT100**
PROJECT NUMBER: **STPG SIGN(20)**
FILE NAME: **Dover.xls**
PROJECT MANAGER: **N. Averv**
DESIGNED BY: **M. Miller**
DOVER SHEET 17
PLOT DATE: **8/6/2009**
DRAWN BY: **I. Shea**
CHECKED BY: **T. Guazzoni**
SHEET **114** OF **198**

DIRECTION	MILEPOINT	LOCATION CODE (SHEET 2)	SIGN CODE	WIDTH (IN)	HEIGHT (IN)	SHEETING REMARKS	SIGN LEGEND	NEW SIGNS "A"	NEW SIGNS "B"	EXISTING SIGNS RETAIN	EXISTING SIGNS SALVAGE FROM	EXISTING SIGNS SALVAGE TO	EXISTING SIGNS REMOVE	EXIST POST RETAIN	EXIST POST REMOVE	NUMBER OF NEW POSTS	SQUARE STEEL (IN) 1.75 (LB / FT) 1.88	SQUARE STEEL (IN) 2.00 (LB / FT) 2.42	SQUARE STEEL (IN) 2.50 (LB / FT) 3.35	TUBULAR STEEL Ø (IN) FOUNDATION	TUBULAR STEEL Ø (IN) 3.00 (LB / FT) 7.60	TUBULAR STEEL Ø (IN) 3.50 (LB / FT) 9.00	TUBULAR STEEL Ø (IN) 4.00 (LB / FT) 10.80	TUBULAR STEEL Ø (IN) 5.00 (LB / FT) 14.60	SIGN FRAME REQUIRED	REMARKS	SIGN DETAIL: DETAIL IN SHS	SIGN DETAIL: DETAIL ON SHEET NUMBER	SIGN DETAIL: DETAIL ON STD SHEET NUMBER
DOVER VT 100							FY-FLUORESCENT YELLOW FYG-FLUORESCENT YELLOW GREEN																			"SHS"-STANDARD HIGHWAY SIGNS			
SB	0.755	F	W1-3L	30	30		REVERSE TURN LEFT						1		X														
		F	W13-1	18	18		30 MPH (PLAQUE)						1																
		F	W1-3L	30	30	FY		6.25								1		X										X	
		F	W13-1	18	18	FY		2.25																				X	
SB	0.720	F	S3-1	30	30			6.25								1		X									INSTALL 190 FT± SOUTH OF REVERSE TURN WARNING SIGN.	X	
SB	0.650	F	W1-6	48	24								1		X												290 FT ± SOUTH OF SCHOOL BUS STOP AHEAD SIGN		
		F	W1-6	48	24	FY		8.00								2		X										X	
SB	0.645	E	W1-6	48	24								1		X														
		E	W1-6	48	24	FY		8.00								2		X									INSTALL 25 FT ± SOUTH OF EXISTING NB-FACING ARROW	X	
SB	0.635	F	W1-6	48	24								1		X														
		F	W1-6	48	24	FY		8.00								2		X										X	
SB	0.630	E	W1-6	48	24								1		X														
		E	W1-6	48	24	FY		8.00								2		X									INSTALL 25 FT ± SOUTH OF EXISTING NB-FACING ARROW	X	
SB	0.410	F	R2-1	24	30								1		X														
		F	VR-417	30	30								1																
							SHEET TOTALS	46.75 SF	0.00 SF	0 EA	0 EA	0 EA	9 8 EA	0 EA	0 EA	10 EA		150 FT										
							TOWN TOTALS	648.1	0.0	30.0	3.0	1.0	116	0.0	0.0	112		1680.0										

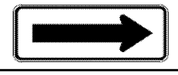












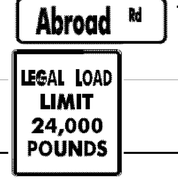
SIGN SUMMARY SHEET

VERMONT AGENCY OF TRANSPORTATION

PROJECT NAME: **Stamford-Andover VT100**
PROJECT NUMBER: **STPG SIGN(20)**

FILE NAME: **Dover.xls**
PROJECT MANAGER: **N. Averv**
DESIGNED BY: **M. Miller**
DOVER SHEET 18

PLOT DATE: **8/6/2009**
DRAWN BY: **I. Shea**
CHECKED BY: **T. Guazzoni**
SHEET **115** OF **198**

DIRECTION	MILEPOINT	LOCATION CODE (SHEET 2)	SIGN CODE	WIDTH (IN)	HEIGHT (IN)	SHEETING REMARKS	SIGN LEGEND	NEW SIGNS "A"	NEW SIGNS "B"	EXISTING SIGNS RETAIN	EXISTING SIGNS SALVAGE FROM	EXISTING SIGNS SALVAGE TO	EXISTING SIGNS REMOVE	EXIST POST RETAIN	EXIST POST REMOVE	NUMBER OF NEW POSTS	SQUARE STEEL (IN) (LB / FT) 1.75 / 1.88	SQUARE STEEL (IN) (LB / FT) 2.00 / 2.42	SQUARE STEEL (IN) (LB / FT) 2.50 / 3.35	TUBULAR STEEL Ø (IN) FOUNDATION	TUBULAR STEEL Ø (IN) (LB / FT) 3.00 / 7.60	TUBULAR STEEL Ø (IN) (LB / FT) 3.50 / 9.00	TUBULAR STEEL Ø (IN) (LB / FT) 4.00 / 10.80	TUBULAR STEEL Ø (IN) (LB / FT) 5.00 / 14.60	SIGN FRAME REQUIRED	REMARKS	SIGN DETAIL: DETAIL IN SHS	SIGN DETAIL: DETAIL ON SHEET NUMBER	SIGN DETAIL: DETAIL ON STD SHEET NUMBER
DOVER VT 100							FY-FLUORESCENT YELLOW FYG-FLUORESCENT YELLOW GREEN																			"SHS"-STANDARD HIGHWAY SIGNS			
		E	W14-3	48	36								1														
		F	R2-1	24	30			5.00								1		X									X		
		F	VR-417	30	30			6.25																					E-141
		E	W14-3	40	30	FY		3.86																		PENNANT INSTALLED ON BACK OF SPEED LIMIT 50 SIGN	X		
SB	0.~~260~~ 0.245	F	W2-3Ma L	30	30			6.25								1		X									INSTALL ~~80~~ 160 FT ± NORTH OF THE CONCRETE BLOCK RETAINING WALL. INSTALL SIGN AS SHOWN		6	
		F	W16-8	24	8			1.33																			X		
SB	0.145	G	VR-017	24	30								1		X										ABROAD RD (TH-11)			
		G	VR-017	24	30			5.00								1		X											E-141
SB	0.135	H	R1-1	30	30								1		X										ABROAD RD (TH-11)			
		H	R1-1	30	30			6.25								1		X									X		
SB	0.000	G	VD-024	60	7.5		WILMINGTON I DOVER						1		X														
SB	2.482	A	W11-6	30	30			6.25			I	I	I		X	I										NEW FOLDING SNOWMOBILE SIGN WAS INSTALLED. FIRE ENGINE SIGN WAS SALVAGED ONTO POST.			
							SHEET TOTALS	40.19 33.94 SF	0.00 SF	0 EA	I ~~0~~ EA	I ~~0~~ EA	5 ~~4~~ EA	0 EA	0 EA	4 EA		60 FT							
							TOWN TOTALS	648.1	0.0	30.0	3.0	1.0	116	0.0	0.0	112		1680.0										

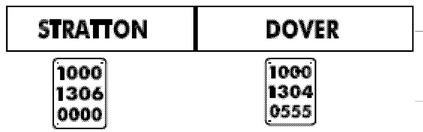
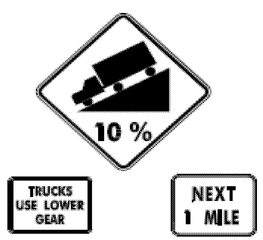
SIGN SUMMARY SHEET

VERMONT AGENCY OF TRANSPORTATION

PROJECT NAME: **Stamford-Andover VT100**
PROJECT NUMBER: **STPG SIGN(20)**

FILE NAME: **Dover.xls**
PROJECT MANAGER: **N. Averv**
DESIGNED BY: **M. Miller**
DOVER SHEET 19

PLOT DATE: **8/6/2009**
DRAWN BY: **I. Shea**
CHECKED BY: **T. Guazzoni**
SHEET **116** OF **198**

DIRECTION	MILEPOINT	LOCATION CODE (SHEET 2)	SIGN CODE	WIDTH (IN)	HEIGHT (IN)	SHEETING REMARKS	SIGN LEGEND	NEW SIGNS "A"	NEW SIGNS "B"	EXISTING SIGNS RETAIN	EXISTING SIGNS SALVAGE FROM	EXISTING SIGNS SALVAGE TO	EXISTING SIGNS REMOVE	EXIST POST RETAIN	EXIST POST REMOVE	NUMBER OF NEW POSTS	SQUARE STEEL (IN) 1.75 (LB / FT) 1.88	SQUARE STEEL (IN) 2.00 (LB / FT) 2.42	SQUARE STEEL (IN) 2.50 (LB / FT) 3.35	FOUNDATION	TUBULAR STEEL Ø (IN) 3.00 (LB / FT) 7.60	TUBULAR STEEL Ø (IN) 3.50 (LB / FT) 9.00	TUBULAR STEEL Ø (IN) 4.00 (LB / FT) 10.80	TUBULAR STEEL Ø (IN) 5.00 (LB / FT) 14.60	SIGN FRAME REQUIRED	REMARKS	SIGN DETAIL: DETAIL IN SHS	SIGN DETAIL: DETAIL ON SHEET NUMBER	SIGN DETAIL: DETAIL ON STD SHEET NUMBER
STRATTON VT 100							FY-FLUORESCENT YELLOW FYG-FLUORESCENT YELLOW GREEN																			"SHS"-STANDARD HIGHWAY SIGNS			
NB	0.000	C	VD-024	60	7.5								1		X													
		C	VD-024	72	10			5.00								2		X										4	
		C	VD-700	6	10			0.42																			INSTALL "0000" BELOW STRATTON			E-138
		C	VD-700	6	10			0.42																			INSTALL "0555" BELOW DOVER			E-138
NB	0.335	A	W1-4L	30	30		LEFT REVERSE CURVE				1				X														
		A	W13-1	18	18		40 MPH PLAQUE				1																		
NB	0.415	A	W1-4L	30	30		LEFT REVERSE CURVE					1				1		X									INSTALL BETWEEN DRIVES, 425 FEET NORTH OF EXISTING ASSEMBLY			
		A	W13-1	18	18		40 MPH PLAQUE					1																	
NB	0.460	C	VM-607	24	30		43RD INFANTRY DIV.						1		X														
		C	VR-023B	24	30		$500 FINE FOR THROWING TRASH						1																
NB	0.500	A	W7-1b	30	30								1		X														
		A	W7-2b	24	18								1																
		A	W7-1b	36	36			9.00								2		X										X	
		A	W7-2b	24	18			3.00																			INSTALL ON LH POST	X	
		A	W7-3a	24	18			3.00																			INSTALL ON RH POST	X	
							SHEET TOTALS	20.84 SF	0.00 SF	0 EA	2 EA	2 EA	5 EA	0 EA	0 EA	5 EA	75 FT										
							TOWN TOTALS	53.1	0.0	0.0	3.0	3.0	12	0.0	0.0	10	150.0										

SIGN SUMMARY SHEET

VERMONT AGENCY OF TRANSPORTATION

PROJECT NAME: **Stamford-Andover VT100**
PROJECT NUMBER: **STPG SIGN(20)**
FILE NAME: **Stratton.xls**
PROJECT MANAGER: **N. Avery**
DESIGNED BY: **J. Kelly**
STRATTON SHEET 1
PLOT DATE: **8/6/2009**
DRAWN BY: **T. Guazzoni**
CHECKED BY: **T. Guazzoni**
SHEET **117** OF **198**

DIRECTION	MILEPOINT	LOCATION CODE (SHEET 2)	SIGN CODE	WIDTH (IN)	HEIGHT (IN)	SHEETING REMARKS	SIGN LEGEND	NEW SIGNS "A"	NEW SIGNS "B"	EXISTING SIGNS RETAIN	EXISTING SIGNS SALVAGE FROM	EXISTING SIGNS SALVAGE TO	EXISTING SIGNS REMOVE	EXIST POST RETAIN	EXIST POST REMOVE	NUMBER OF NEW POSTS	SQUARE STEEL (IN) 1.75 (LB / FT) 1.88	SQUARE STEEL (IN) 2.00 (LB / FT) 2.42	SQUARE STEEL (IN) 2.50 (LB / FT) 3.35	TUBULAR STEEL Ø (IN) FOUNDATION	TUBULAR STEEL Ø (IN) 3.00 (LB / FT) 7.60	TUBULAR STEEL Ø (IN) 3.50 (LB / FT) 9.00	TUBULAR STEEL Ø (IN) 4.00 (LB / FT) 10.80	TUBULAR STEEL Ø (IN) 5.00 (LB / FT) 14.60	SIGN FRAME REQUIRED	REMARKS	SIGN DETAIL: DETAIL IN SHS	SIGN DETAIL: DETAIL ON SHEET NUMBER	SIGN DETAIL: DETAIL ON STD SHEET NUMBER
STRATTON VT 100							FY-FLUORESCENT YELLOW FYG-FLUORESCENT YELLOW GREEN																			"SHS"-STANDARD HIGHWAY SIGNS			
NB	0.620	A	VW-054	30	30								1		X														
		A	VW-054L	30	30			6.25								1		X										E-154
SB	1.064	G	R2-1				SPEED LIMIT 25 (TOWN)				1	1														REINSTALL SIGN BELOW NEW LEGAL LOAD SIGN			
		G	VR-017	24	30								1		X						STREET SIGN AND MM SALVAGED ONTO NEW POST.						TH-20, PENNY AVE			
		G	VR-017	24	30			5.00								1		X										E-141
SB	1.060	H	R1-1	30	30		 				I	I	1		X												TH-20, PENNY AVE			
		H	R1-1	30	30			6.25								1		X									X	
SB	0.600	F	W1-4L	30	30		LEFT REVERSE CURVE						1		X														
		F	W13-1	18	18		40 MPH PLAQUE						1																
SB	0.549	F	W7-1	30	30		HILL SYMBOL						1		X														
		F	W7-2b	24	18		TRUCKS USE LOWER GEAR 						1																
		F	W1-4L	30	30			6.25								1		X									X	
		F	W13-1	18	18			2.25																			X	
SB	0.511	F	W7-1	30	30		 	6.25								1		X									X	
NB	1.325	A	VW-054R	30	30			6.25								I										NEW SIGN INSTALLED PER REQUEST OF M. MILLER, TRAFFIC OPS. SEE EMAIL DATED 5-7-10			
SIGN SUMMARY SHEET							SHEET TOTALS	38.50 ~~32.25~~ SF	0.00 SF	0 EA	1 EA	1 EA	7 EA	0 EA	0 EA	6 ~~5~~ EA		75 FT										
VERMONT AGENCY OF TRANSPORTATION							TOWN TOTALS	53.1	0.0	0.0	3.0	3.0	12	0.0	0.0	10		150.0										

PROJECT NAME: **Stamford-Andover VT100**
PROJECT NUMBER: **STPG SIGN(20)**

FILE NAME: **Stratton.xls**
PROJECT MANAGER: **N. Averv**
DESIGNED BY: **J. Kelly**
STRATTON SHEET 2

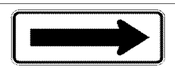
PLOT DATE: **8/6/2009**
DRAWN BY: **T. Guazzoni**
CHECKED BY: **T. Guazzoni**
SHEET **118** OF **198**

DIRECTION	MILEPOINT	LOCATION CODE (SHEET 2)	SIGN CODE	WIDTH (IN)	HEIGHT (IN)	SHEETING REMARKS	SIGN LEGEND	NEW SIGNS "A"	NEW SIGNS "B"	EXISTING SIGNS RETAIN	EXISTING SIGNS SALVAGE FROM	EXISTING SIGNS SALVAGE TO	EXISTING SIGNS REMOVE	EXIST POST RETAIN	EXIST POST REMOVE	NUMBER OF NEW POSTS	SQUARE STEEL (IN) 1.75 (LB / FT) 1.88	SQUARE STEEL (IN) 2.00 (LB / FT) 2.42	SQUARE STEEL (IN) 2.50 (LB / FT) 3.35	FOUNDATION	TUBULAR STEEL Ø (IN) 3.00 (LB / FT) 7.60	TUBULAR STEEL Ø (IN) 3.50 (LB / FT) 9.00	TUBULAR STEEL Ø (IN) 4.00 (LB / FT) 10.80	TUBULAR STEEL Ø (IN) 5.00 (LB / FT) 14.60	SIGN FRAME REQUIRED	REMARKS	SIGN DETAIL: DETAIL IN SHS	SIGN DETAIL: DETAIL ON SHEET NUMBER	SIGN DETAIL: DETAIL ON STD SHEET NUMBER
WARDSBORO VT 100							FY-FLUORESCENT YELLOW FYG-FLUORESCENT YELLOW GREEN																			"SHS"-STANDARD HIGHWAY SIGNS			
NB	0.000	C	VD-024	60	7.5								1		X														
		C	VD-024	72	10		WARDSBORO / STRATTON 1000 1319 0000 / 1000 1316 0134	5.00								2		X								INSTALL THE NEW SIGN ON 2 POSTS IN THE SAME POSITION AS THE PREVIOUS SIGN.			
		C	VD-700	6	10			0.42																		WARDSBORO MILE MARKER PLAQUE; INSTALL UNDER WARDSBORO			E-138
		C	VD-700	6	10			0.42																		STRATTON MILE MARKER PLAQUE; INSTALL UNDER STRATTON			E-138
NB	0.565	A	W7-1B	30	30		HILL SYMBOL 11%						1		X														
		A	W7-3A	24	18		NEXT 1 MILE						1																
NB	0.617	A	W7-1B	30	30		11% / NEXT 1 MILE	6.25								1		X								INSTALL 275 FEET NORTH OF EXISTING LOCATION	X		
		A	W7-3A	24	18			3.00																			X		
NB	0.695	A	VW-054	30	30		HIDDEN DRIVE RIGHT						1		X														
NB	0.735	A	W1-2L	30	30		LEFT CURVE						1		X														
		A	W13-1	18	18		35 MPH PLAQUE						1																
NB	0.825	A	W1-2L	30	30	FY	35 M.P.H.	6.25								1		X								INSTALL 475 FEET NORTH OF EXISTING LEFT CURVE ASSEMBLY	X		
		A	W13-1	18	18	FY		2.25																			X		
NB	0.860	A	W1-6	48	24								1		X														
		A	W1-6	48	24	FY		8.00								2		X									X		
							SHEET TOTALS	31.59 SF	0.00 SF	0 EA	0 EA	0 EA	7 EA	0 EA	0 EA	6 EA		90 FT											
							TOWN TOTALS	633.3	0.0	24.0	12.0	12.0	108	0.0	0.0	129		1935.0											

SIGN SUMMARY SHEET

VERMONT AGENCY OF TRANSPORTATION

PROJECT NAME: Stamford-Andover VT100
PROJECT NUMBER: STPG SIGN(20)
FILE NAME: Wardsboro.xls
PROJECT MANAGER: N. Avery
DESIGNED BY: J. Kelly
WARDSBORO SHEET 1
PLOT DATE: 8/6/2009
DRAWN BY: T. Guazzoni
CHECKED BY: T. Guazzoni
SHEET 119 OF 198

DIRECTION	MILEPOINT	LOCATION CODE (SHEET 2)	SIGN CODE	WIDTH (IN)	HEIGHT (IN)	SHEETING REMARKS	SIGN LEGEND	NEW SIGNS "A"	NEW SIGNS "B"	EXISTING SIGNS RETAIN	EXISTING SIGNS SALVAGE FROM	EXISTING SIGNS SALVAGE TO	EXISTING SIGNS REMOVE	EXIST POST RETAIN	EXIST POST REMOVE	NUMBER OF NEW POSTS	SQUARE STEEL (IN) 1.75 (LB / FT) 1.88	SQUARE STEEL (IN) 2.00 (LB / FT) 2.42	SQUARE STEEL (IN) 2.50 (LB / FT) 3.35	TUBULAR STEEL Ø (IN) FOUNDATION	TUBULAR STEEL Ø (IN) 3.00 (LB / FT) 7.60	TUBULAR STEEL Ø (IN) 3.50 (LB / FT) 9.00	TUBULAR STEEL Ø (IN) 4.00 (LB / FT) 10.80	TUBULAR STEEL Ø (IN) 5.00 (LB / FT) 14.60	SIGN FRAME REQUIRED	REMARKS	SIGN DETAIL: DETAIL IN SHS	SIGN DETAIL: DETAIL ON SHEET NUMBER	SIGN DETAIL: DETAIL ON STD SHEET NUMBER
WARDSBORO VT 100							FY-FLUORESCENT YELLOW FYG-FLUORESCENT YELLOW GREEN																			"SHS"-STANDARD HIGHWAY SIGNS			
NB	0.861	B	W1-6	48	24								1		X														
		B	W1-6	48	24	~~FY~~		8.00								2		X								FACES SB TRAFFIC	X		
NB	0.900	A	W1-6	48	24								1		X														
		A	W1-6	48	24	FY		8.00								2		X									X		
NB	0.901	B	W1-6	48	24								1		X														
		B	W1-6	48	24	~~FY~~		8.00								2		X								FACES SB TRAFFIC	X		
NB	0.928	C	VR-017	24	30		LEGAL LOAD LIMIT 24,000 LBS						1		X												TH-30, UPPER PODUNK RD		
		C	n/a	18	24		CHILDREN AT PLAY 						1														REMOVE THE NON-COMPLIANT TOWN-INSTALLED SIGN. RETURN TO TOWN		
		C	VR-017	24	30			5.00								1		X										E-141
NB	0.933	D	R1-1	30	30		STOP 			1				X												TH-30, UPPER PODUNK RD		
NB	1.479	A	VW-133	30	30		HIDDEN DRIVE LEFT						1		X														
NB	1.526	A	VW-054L	30	30			6.25								1		X								INSTALL 250 FEET NORTH OF EXISTING HIDDEN DRIVE LEFT		E-154
NB	1.720	A	W1-2L	30	30		LEGAL CURVE 						1		X														
		A	W13-1	18	18		35 MPH PLAQUE 						1																
NB	1.777	A	W1-2L	30	30	FY		6.25								1		X								INSTALL 300 FEET NORTH OF EXISTING LEFT CURVE ASSEMBLY	X		
							SHEET TOTALS	41.50 SF	0.00 SF	1 EA	0 EA	0 EA	8 EA	0 EA	0 EA	9 EA		135 FT							
							TOWN TOTALS	633.3	0.0	24.0	12.0	12.0	108	0.0	0.0	129		1935.0							

SIGN SUMMARY SHEET

VERMONT AGENCY OF TRANSPORTATION

PROJECT NAME: **Stamford-Andover VT100**
PROJECT NUMBER: **STPG SIGN(20)**

FILE NAME: **Wardsboro.xls**
PROJECT MANAGER: **N. Avery**
DESIGNED BY: **J. Kelly**
WARDSBORO SHEET 2

PLOT DATE: **8/6/2009**
DRAWN BY: **T. Guazzoni**
CHECKED BY: **T. Guazzoni**
SHEET **120** OF **198**

DIRECTION	MILEPOINT	LOCATION CODE (SHEET 2)	SIGN CODE	WIDTH (IN)	HEIGHT (IN)	SHEETING REMARKS	SIGN LEGEND	NEW SIGNS "A"	NEW SIGNS "B"	EXISTING SIGNS RETAIN	EXISTING SIGNS SALVAGE FROM	EXISTING SIGNS SALVAGE TO	EXISTING SIGNS REMOVE	EXIST POST RETAIN	EXIST POST REMOVE	NUMBER OF NEW POSTS	SQUARE STEEL (IN) 1.75 (LB / FT) 1.88	SQUARE STEEL (IN) 2.00 (LB / FT) 2.42	SQUARE STEEL (IN) 2.50 (LB / FT) 3.35	TUBULAR STEEL Ø (IN) FOUNDATION	TUBULAR STEEL Ø (IN) 3.00 (LB / FT) 7.60	TUBULAR STEEL Ø (IN) 3.50 (LB / FT) 9.00	TUBULAR STEEL Ø (IN) 4.00 (LB / FT) 10.80	TUBULAR STEEL Ø (IN) 5.00 (LB / FT) 14.60	SIGN FRAME REQUIRED	REMARKS	SIGN DETAIL: DETAIL IN SHS	SIGN DETAIL: DETAIL ON SHEET NUMBER	SIGN DETAIL: DETAIL ON STD SHEET NUMBER
WARDSBORO VT 100							FY-FLUORESCENT YELLOW FYG-FLUORESCENT YELLOW GREEN																			"SHS"-STANDARD HIGHWAY SIGNS			
		A	W13-1	18	18	FY		2.25																			X		
NB	1.830	A	W1-6L	48	24	FY		8.00								2		X								INSTALL SOUTH SIDE OF UTILITY POLE	X		
NB	1.840	B	W1-6R	48	24	FY		8.00								2		X								INSTALL NORTH SIDE OF UTILITY POLE FACES SB TRAFFIC	X		
NB	1.970	A	W3-5	36	36		SPEED REDUCTION (30)				1	1			X	2		X											
NB	2.020	A	W1-10R	30	30		RIGHT CURVE WITH SIDEROAD LEFT						1		X															
		A	VD-018	30	18			3.75								1		X										E-128A
NB	2.060	A	VD-018	30	18		WEST WARDSBORO WARDSBORO 4						1		X															
		A	W1-10R	30	30			6.25								1		X									X		
NB	2.100	A	D1-1A	72	10								1		X															
		A	D1-1S	72	10								1																	
		A	D1-1A	72	12			6.00								2		X										5	
		A	D1-1	72	12			6.00																				5	
NB	2.156	A	R2-1	30	36		SPEED LIMIT 30					1				1		X								SALVAGE FROM M.P. 2.158.			
NB	2.158	A	R2-1	30	36		SPEED LIMIT 30				1				X											SIGN IS BLOCKING ENTRANCE TO THE GARAGE, SALVAGE TO M.P. 2.156.			
NB	2.186	A	W1-3L	36	36		LEFT REVERSE TURN			1				X															
							SHEET TOTALS	40.25	0.00	1	2	2	4	0	0	11		165											
								SF	SF	EA	EA	EA	EA	EA	EA	EA		FT											
							TOWN TOTALS	633.3	0.0	24.0	12.0	12.0	108	0.0	0.0	129		1935.0											

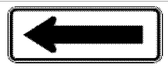
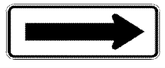
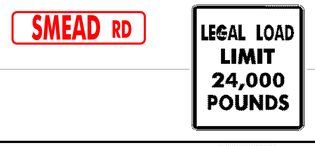
SIGN SUMMARY SHEET

VERMONT AGENCY OF TRANSPORTATION

PROJECT NAME: Stamford-Andover VT100
PROJECT NUMBER: STPG SIGN(20)

FILE NAME: Wardsboro.xls
PROJECT MANAGER: N. Avery
DESIGNED BY: J. Kelly
WARDSBORO SHEET 3

PLOT DATE: 8/6/2009
DRAWN BY: T. Guazzoni
CHECKED BY: T. Guazzoni
SHEET 121 OF 198

DIRECTION	MILEPOINT	LOCATION CODE (SHEET 2)	SIGN CODE	WIDTH (IN)	HEIGHT (IN)	SHEETING REMARKS	SIGN LEGEND	NEW SIGNS "A"	NEW SIGNS "B"	EXISTING SIGNS RETAIN	EXISTING SIGNS SALVAGE FROM	EXISTING SIGNS SALVAGE TO	EXISTING SIGNS REMOVE	EXIST POST RETAIN	EXIST POST REMOVE	NUMBER OF NEW POSTS	SQUARE STEEL (IN) 1.75 (LB / FT) 1.88	SQUARE STEEL (IN) 2.00 (LB / FT) 2.42	SQUARE STEEL (IN) 2.50 (LB / FT) 3.35	TUBULAR STEEL Ø (IN) FOUNDATION	TUBULAR STEEL Ø (IN) 3.00 (LB / FT) 7.60	TUBULAR STEEL Ø (IN) 3.50 (LB / FT) 9.00	TUBULAR STEEL Ø (IN) 4.00 (LB / FT) 10.80	TUBULAR STEEL Ø (IN) 5.00 (LB / FT) 14.60	SIGN FRAME REQUIRED	REMARKS	SIGN DETAIL: DETAIL IN SHS	SIGN DETAIL: DETAIL ON SHEET NUMBER	SIGN DETAIL: DETAIL ON STD SHEET NUMBER
WARDSBORO VT 100							FY-FLUORESCENT YELLOW FYG-FLUORESCENT YELLOW GREEN																			"SHS"-STANDARD HIGHWAY SIGNS			
		A	W13-1	24	24		20 MPH PLAQUE			1																		
NB	2.240	A	W1-6	48	24								1		X													
		A	W1-6	48	24	FY		8.00								2		X									X	
NB	2.260	A	W5-2	30	30								1		X													
		A	W5-2	36	36			9.00								~~1~~ 2		X									X	
NB	2.285	A	M3-1S	24	12		NORTH						1		X													
		A	M1-5	30	24		VERMONT 100						1															
		A	M6-1	21	15		<--- LEFT ARROW						1															
NB	2.295	B	W1-6	48	24								1		X													
		B	W1-6	48	24	FY		8.00								2		X								FACES SB TRAFFIC	X	
NB	2.297	C	VR-017	24	30								1		X												TH-6, SMEAD RD		
		C	VR-017	24	30			5.00								1		X								STREET SIGN SALVAGED ONTO NEW POST		E-141
NB	2.302	D	R1-1	30	30								1		X												TH-6, SMEAD RD		
		D	R1-1	30	30			6.25								1		X									X	
NB	2.306	A	W1-6	60	30								1		X													
							SHEET TOTALS	36.25 SF	0.00 SF	1 EA	~~0~~ EA	~~0~~ EA	9 EA	0 EA	0 EA	~~7~~ 8 EA			105 FT									
							TOWN TOTALS	633.3	0.0	24.0	12.0	12.0	108	0.0	0.0	129			1935.0									

SIGN SUMMARY SHEET

VERMONT AGENCY OF TRANSPORTATION

PROJECT NAME: **Stamford-Andover VT100**
PROJECT NUMBER: **STPG SIGN(20)**

FILE NAME: **Wardsboro.xls**
PROJECT MANAGER: **N. Averv**
DESIGNED BY: **J. Kelly**
WARDSBORO SHEET 4

PLOT DATE: **8/6/2009**
DRAWN BY: **T. Guazzoni**
CHECKED BY: **T. Guazzoni**
SHEET **122** OF **198**

DIRECTION	MILEPOINT	LOCATION CODE (SHEET 2)	SIGN CODE	WIDTH (IN)	HEIGHT (IN)	SHEETING REMARKS	SIGN LEGEND	NEW SIGNS "A"	NEW SIGNS "B"	EXISTING SIGNS RETAIN	EXISTING SIGNS SALVAGE FROM	EXISTING SIGNS SALVAGE TO	EXISTING SIGNS REMOVE	EXIST POST RETAIN	EXIST POST REMOVE	NUMBER OF NEW POSTS	SQUARE STEEL (IN) 1.75 (LB / FT) 1.88	SQUARE STEEL (IN) 2.00 (LB / FT) 2.42	SQUARE STEEL (IN) 2.50 (LB / FT) 3.35	TUBULAR STEEL Ø (IN) FOUNDATION	TUBULAR STEEL Ø (IN) 3.00 (LB / FT) 7.60	TUBULAR STEEL Ø (IN) 3.50 (LB / FT) 9.00	TUBULAR STEEL Ø (IN) 4.00 (LB / FT) 10.80	TUBULAR STEEL Ø (IN) 5.00 (LB / FT) 14.60	SIGN FRAME REQUIRED	REMARKS	SIGN DETAIL: DETAIL IN SHS	SIGN DETAIL: DETAIL ON SHEET NUMBER	SIGN DETAIL: DETAIL ON STD SHEET NUMBER
WARDSBORO VT 100							FY-FLUORESCENT YELLOW FYG-FLUORESCENT YELLOW GREEN																			"SHS"-STANDARD HIGHWAY SIGNS			
		A	W1-6	60	30	FY		12.50								2		X									X		
NB	2.310	A	OM-3R	12	36								1		X														
		A	OM-3R	12	36			3.00								1		X									X		
NB	2.325	B	OM-3L	12	36								1		X														
		B	OM-3L	12	36			3.00								1		X									X		
NB	2.390	A	R2-1	24	30								1		X														
		A	R2-1	24	30			5.00								1		X									X		
NB	2.555	A	R2-1	24	30								1		X														
		A	R2-1	24	30			5.00								1		X									X		
NB	~~2.765~~ 2.785	A	R2-1	24	30								1		X													MOVED 100' N. OF ORGINAL LOCATION FOR BETTER VISIBILITY.			
		A	R2-1	24	30			5.00								1		X									X		
NB	2.800	A	M3-3	24	12			2.00								1		X									GREEN ON WHITE SHEETING. INSTALL 50 FT +/- SOUTH OF END OF GUARD RAIL	X		
		A	M1-5	30	24			5.00																					E-136B
NB	3.802	C	VR-017	24	30								1		X													TH-6, LOWER PODUNK RD			
		C	VR-017	24	30			5.00								1		X											E-141
							SHEET TOTALS	45.50 SF	0.00 SF	0 EA	0 EA	0 EA	6 EA	0 EA	0 EA	9 EA		135 FT											
							TOWN TOTALS	633.3	0.0	24.0	12.0	12.0	108	0.0	0.0	129		1935.0											

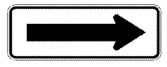
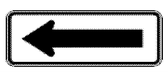
SIGN SUMMARY SHEET

VERMONT AGENCY OF TRANSPORTATION

PROJECT NAME: **Stamford-Andover VT100**
PROJECT NUMBER: **STPG SIGN(20)**

FILE NAME: **Wardsboro.xls**
PROJECT MANAGER: **N. Averv**
DESIGNED BY: **J. Kelly**
WARDSBORO SHEET 5

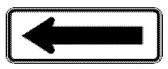
PLOT DATE: **8/6/2009**
DRAWN BY: **T. Guazzoni**
CHECKED BY: **T. Guazzoni**
SHEET **123** OF **198**

DIRECTION	MILEPOINT	LOCATION CODE (SHEET 2)	SIGN CODE	WIDTH (IN)	HEIGHT (IN)	SHEETING REMARKS	SIGN LEGEND	NEW SIGNS "A"	NEW SIGNS "B"	EXISTING SIGNS RETAIN	EXISTING SIGNS SALVAGE FROM	EXISTING SIGNS SALVAGE TO	EXISTING SIGNS REMOVE	EXIST POST RETAIN	EXIST POST REMOVE	NUMBER OF NEW POSTS	SQUARE STEEL (IN) 1.75 (LB / FT) 1.88	SQUARE STEEL (IN) 2.00 (LB / FT) 2.42	SQUARE STEEL (IN) 2.50 (LB / FT) 3.35	TUBULAR STEEL Ø (IN) FOUNDATION	TUBULAR STEEL Ø (IN) 3.00 (LB / FT) 7.60	TUBULAR STEEL Ø (IN) 3.50 (LB / FT) 9.00	TUBULAR STEEL Ø (IN) 4.00 (LB / FT) 10.80	TUBULAR STEEL Ø (IN) 5.00 (LB / FT) 14.60	SIGN FRAME REQUIRED	REMARKS	SIGN DETAIL: DETAIL IN SHS	SIGN DETAIL: DETAIL ON SHEET NUMBER	SIGN DETAIL: DETAIL ON STD SHEET NUMBER
WARDSBORO VT 100							FY-FLUORESCENT YELLOW FYG-FLUORESCENT YELLOW GREEN																			"SHS"-STANDARD HIGHWAY SIGNS			
NB	3.807	D	R1-1	30	30		 1000 1319 0383						1		X											TH-6, LOWER PODUNK RD			
		D	R1-1	30	30			6.25								1		X								MM SALVAGED ONTO NEW POST	X		
NB	4.095 ~~4.055~~	A	W1-2L	30	30								1		X														
		A	W13-1	18	18								1															
		A	W1-2L	30	30	FY		6.25								1		X								THIS WAS MOVED 225' NORTH FOR BETTER VISIBILITY	X		
		A	W13-1	18	18	FY		2.25																			X		
NB	4.140	A	W1-6	48	24								1		X														
		A	W1-6	48	24	FY		8.00								2		X									X		
NB	4.141	B	W1-6	48	24	FY		8.00								2		X								FACES SB TRAFFIC	X		
NB	4.190	A	W1-6	48	24								1		X														
		A	W1-6	48	24	FY		8.00								2		X									X		
NB	4.191	B	W1-6	48	24								1		X														
		B	W1-6	48	24			8.00								2		X								FACES SB TRAFFIC	X		
NB	4.207	A	W1-6	48	24	FY		8.00								2		X									X		
NB	4.208	B	W1-6	48	24								1		X														
SIGN SUMMARY SHEET							SHEET TOTALS	54.75 SF	0.00 SF	0 EA	0 EA	0 EA	7 EA	0 EA	0 EA	12 EA		180 FT									
VERMONT AGENCY OF TRANSPORTATION							TOWN TOTALS	633.3	0.0	24.0	12.0	12.0	108	0.0	0.0	129		1935.0									

PROJECT NAME: **Stamford-Andover VT100**
PROJECT NUMBER: **STPG SIGN(20)**

FILE NAME: **Wardsboro.xls**
PROJECT MANAGER: **N. Averv**
DESIGNED BY: **J. Kelly**
WARDSBORO SHEET 6

PLOT DATE: **8/6/2009**
DRAWN BY: **T. Guazzoni**
CHECKED BY: **T. Guazzoni**
SHEET **124** OF **198**

DIRECTION	MILEPOINT	LOCATION CODE (SHEET 2)	SIGN CODE	WIDTH (IN)	HEIGHT (IN)	SHEETING REMARKS	SIGN LEGEND	NEW SIGNS "A"	NEW SIGNS "B"	EXISTING SIGNS RETAIN	EXISTING SIGNS SALVAGE FROM	EXISTING SIGNS SALVAGE TO	EXISTING SIGNS REMOVE	EXIST POST RETAIN	EXIST POST REMOVE	NUMBER OF NEW POSTS	SQUARE STEEL (IN) 1.75 (LB/FT) 1.88	SQUARE STEEL (IN) 2.00 (LB/FT) 2.42	SQUARE STEEL (IN) 2.50 (LB/FT) 3.35	FOUNDATION	TUBULAR STEEL Ø (IN) 3.00 (LB/FT) 7.60	TUBULAR STEEL Ø (IN) 3.50 (LB/FT) 9.00	TUBULAR STEEL Ø (IN) 4.00 (LB/FT) 10.80	TUBULAR STEEL Ø (IN) 5.00 (LB/FT) 14.60	SIGN FRAME REQUIRED	REMARKS	SIGN DETAIL: DETAIL IN SHS	SIGN DETAIL: DETAIL ON SHEET NUMBER	SIGN DETAIL: DETAIL ON STD SHEET NUMBER
WARDSBORO VT 100							FY-FLUORESCENT YELLOW FYG-FLUORESCENT YELLOW GREEN																			"SHS"-STANDARD HIGHWAY SIGNS			
		B	W1-6	48	24	FY		8.00								2		X								FACES SB TRAFFIC	X		
NB	5.187	C	VR-017	24	30								1		X												TH-26, GILFEATHER RD			
		C	VR-017	24	30			5.00								1		X											E-141
NB	5.192	D	R1-1	30	30		 GILFEATHER RD						1		X												STREET SIGN + MM SALVAGED ONTO NEW POST. TH-26, GILFEATHER RD			
		D	R1-1	30	30		1000 1319 0520	6.25								1		X										X		
NB	5.710	A	W1-2L	30	30		LEFT CURVE						1		X															
		A	W13-1	18	18		35 MPH PLAQUE						1														I75'			
NB	5.748	A	W1-2L	30	30			6.25								1		X								INSTALL ~~200~~ FEET NORTH OF EXISTING LEFT CURVE ASSEMBLY	X		
		A	W13-1	18	18			2.25																			X		
NB	5.785	A	W1-6	48	24		1000 1319 0580 						1		X															
		A	W1-6	48	24			8.00								2		X								MM SALVAGED ONTO NEW POST	X		
NB	5.815	A	W1-6	48	24								1		X															
		A	W1-6	48	24			8.00								2		X										X		
NB	5.816	B	W1-6	48	24			8.00								2		X								FACES SB TRAFFIC	X		
NB	5.850	B	W1-6	48	24								1		X															
							SHEET TOTALS	51.75	0.00	0	0	0	7	0	0	11		165											
								SF	SF	EA	EA	EA	EA	EA	EA	EA		FT											
							TOWN TOTALS	633.3	0.0	24.0	12.0	12.0	108	0.0	0.0	129		1935.0											

SIGN SUMMARY SHEET

VERMONT AGENCY OF TRANSPORTATION

PROJECT NAME: **Stamford-Andover VT100**
PROJECT NUMBER: **STPG SIGN(20)**

FILE NAME: **Wardsboro.xls**
PROJECT MANAGER: **N. Avery**
DESIGNED BY: **J. Kelly**
WARDSBORO SHEET 7

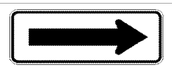
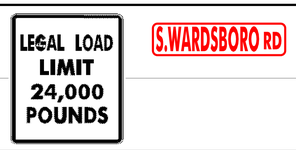
PLOT DATE: **8/6/2009**
DRAWN BY: **T. Guazzoni**
CHECKED BY: **T. Guazzoni**
SHEET **125** OF **198**

DIRECTION	MILEPOINT	LOCATION CODE (SHEET 2)	SIGN CODE	WIDTH (IN)	HEIGHT (IN)	SHEETING REMARKS	SIGN LEGEND	NEW SIGNS "A"	NEW SIGNS "B"	EXISTING SIGNS RETAIN	EXISTING SIGNS SALVAGE FROM	EXISTING SIGNS SALVAGE TO	EXISTING SIGNS REMOVE	EXIST POST RETAIN	EXIST POST REMOVE	NUMBER OF NEW POSTS	SQUARE STEEL (IN) 1.75 (LB / FT) 1.88	SQUARE STEEL (IN) 2.00 (LB / FT) 2.42	SQUARE STEEL (IN) 2.50 (LB / FT) 3.35	FOUNDATION	TUBULAR STEEL Ø (IN) 3.00 (LB / FT) 7.60	TUBULAR STEEL Ø (IN) 3.50 (LB / FT) 9.00	TUBULAR STEEL Ø (IN) 4.00 (LB / FT) 10.80	TUBULAR STEEL Ø (IN) 5.00 (LB / FT) 14.60	SIGN FRAME REQUIRED	REMARKS	SIGN DETAIL: DETAIL IN SHS	SIGN DETAIL: DETAIL ON SHEET NUMBER	SIGN DETAIL: DETAIL ON STD SHEET NUMBER
WARDSBORO VT 100							FY-FLUORESCENT YELLOW FYG-FLUORESCENT YELLOW GREEN																			"SHS"-STANDARD HIGHWAY SIGNS			
		B	W1-6	48	24			8.00								2		X								FACES SB TRAFFIC	X		
NB	5.930	B	W1-6	48	24			8.00								2		X			FACES SB TRAFFIC					INSTALL ACROSS FROM DRIVEWAY	X		
NB	6.045	A	R2-5A	24	30		REDUCED SPEED AHEAD 						1		X															
NB	6.092	A	W3-5	36	36			9.00								2		X								INSTALL 250 FEET NORTH OF EXISTING REDUCED SPEED AHEAD SIGN	X		
NB	6.105	A	VD-018	30	18		WARDSBORO E JAMAICA 5						1		X															
NB	6.133	A	VD-018	30	18			3.75								1		X								INSTALL 150 FEET NORTH OF EXISTING VILLAGE SIGN			E-128A
NB	6.190	A	R2-1	24	30								1		X												MM SALVAGED ONTO NEW POST			
		A	R2-1	30	36		1000 1319 0620	7.50								1		X											6	
NB	6.320	A	VD-062B	72	16		BUSINESS SIGN			1				X																
		A	VD-062B	72	16		BUSINESS SIGN			1																				
NB	6.360	A	VD-062B	72	16		BUSINESS SIGN			1				X																
		A	VD-062B	72	16		BUSINESS SIGN			1																				
NB	6.395	A	R2-1	24	30								1		X																
		A	R2-1	24	30		1000 1319 0640	5.00								1		X									MM SALVAGED ONTO NEW POST	X		
NB	6.520	A	R2-1	24	30		SPEED LIMIT 35						1		X															
SIGN SUMMARY SHEET							SHEET TOTALS	41.25	0.00	4	0	0	5	0	0	9		135										
								SF	SF	EA	EA	EA	EA	EA	EA	EA		FT										
VERMONT AGENCY OF TRANSPORTATION							TOWN TOTALS	633.3	0.0	24.0	12.0	12.0	108	0.0	0.0	129		1935.0										

PROJECT NAME: **Stamford-Andover VT100**
PROJECT NUMBER: **STPG SIGN(20)**

FILE NAME: **Wardsboro.xls**
PROJECT MANAGER: **N. Avery**
DESIGNED BY: **J. Kelly**
WARDSBORO SHEET 8

PLOT DATE: **8/6/2009**
DRAWN BY: **T. Guazzoni**
CHECKED BY: **T. Guazzoni**
SHEET **126** OF **198**

DIRECTION	MILEPOINT	LOCATION CODE (SHEET 2)	SIGN CODE	WIDTH (IN)	HEIGHT (IN)	SHEETING REMARKS	SIGN LEGEND	NEW SIGNS "A"	NEW SIGNS "B"	EXISTING SIGNS RETAIN	EXISTING SIGNS SALVAGE FROM	EXISTING SIGNS SALVAGE TO	EXISTING SIGNS REMOVE	EXIST POST RETAIN	EXIST POST REMOVE	NUMBER OF NEW POSTS	SQUARE STEEL (IN) 1.75 (LB / FT) 1.88	SQUARE STEEL (IN) 2.00 (LB / FT) 2.42	SQUARE STEEL (IN) 2.50 (LB / FT) 3.35	TUBULAR STEEL Ø (IN) FOUNDATION	TUBULAR STEEL Ø (IN) 3.00 (LB / FT) 7.60	TUBULAR STEEL Ø (IN) 3.50 (LB / FT) 9.00	TUBULAR STEEL Ø (IN) 4.00 (LB / FT) 10.80	TUBULAR STEEL Ø (IN) 5.00 (LB / FT) 14.60	SIGN FRAME REQUIRED	REMARKS	SIGN DETAIL: DETAIL IN SHS	SIGN DETAIL: DETAIL ON SHEET NUMBER	SIGN DETAIL: DETAIL ON STD SHEET NUMBER
WARDSBORO VT 100							FY-FLUORESCENT YELLOW FYG-FLUORESCENT YELLOW GREEN																			"SHS"-STANDARD HIGHWAY SIGNS			
NB	6.535	A	W1-1MbL	30	30								1		X														
		A	W13-1	18	18								1																
		A	W1-1MbL	30	30	FY		6.25								1		X										6	
		A	W13-1	18	18	FY		2.25																				X	
NB	6.560	A	M1-5	30	24		VERMONT 100						1		X														
		A	M6-1	21	15		<---LEFT						1																
		A	M3-1	24	12			2.00								1		X							GREEN ON WHITE SHEETING	X		
		A	M1-5	30	24			5.00																					E-136B
		A	M6-1L	21	15			2.19																			GREEN ON WHITE SHEETING	X		
NB	6.575	A	W1-6	48	24		<=== LARGE ARROW LEFT						1		X														
NB	6.576	B	W1-6	48	24								1		X														
		B	W1-6	48	24	FY		8.00								2		X										X	
NB	6.577	C	VR-017	24	30								1		X											TH-2, S. WARDSBORO RD			
		C	VR-017	24	30			5.00								1		X									SALVAGED STREET SIGN AND MM ONTO NEW POST			E-141
NB	6.582	D	R1-1	30	30		STOP 			1				X													TH-2, S. WARDSBORO RD			
							SHEET TOTALS	30.69	0.00	1	0	0	7	0	0	5		75										
								SF	SF	EA	EA	EA	EA	EA	EA	EA		FT										
							TOWN TOTALS	633.3	0.0	24.0	12.0	12.0	108	0.0	0.0	129		1935.0										

SIGN SUMMARY SHEET

VERMONT AGENCY OF TRANSPORTATION

PROJECT NAME: **Stamford-Andover VT100**
PROJECT NUMBER: **STPG SIGN(20)**

FILE NAME: **Wardsboro.xls**
PROJECT MANAGER: **N. Averv**
DESIGNED BY: **J. Kelly**
WARDSBORO SHEET 9

PLOT DATE: **8/6/2009**
DRAWN BY: **T. Guazzoni**
CHECKED BY: **T. Guazzoni**
SHEET **127** OF **198**

DIRECTION	MILEPOINT	LOCATION CODE (SHEET 2)	SIGN CODE	WIDTH (IN)	HEIGHT (IN)	SHEETING REMARKS	SIGN LEGEND	NEW SIGNS "A"	NEW SIGNS "B"	EXISTING SIGNS RETAIN	EXISTING SIGNS SALVAGE FROM	EXISTING SIGNS SALVAGE TO	EXISTING SIGNS REMOVE	EXIST POST RETAIN	EXIST POST REMOVE	NUMBER OF NEW POSTS	SQUARE STEEL (IN) (LB / FT) 1.75 / 1.88	SQUARE STEEL (IN) (LB / FT) 2.00 / 2.42	SQUARE STEEL (IN) (LB / FT) 2.50 / 3.35	TUBULAR STEEL Ø (IN) FOUNDATION	TUBULAR STEEL Ø (IN) (LB / FT) 3.00 / 7.60	TUBULAR STEEL Ø (IN) (LB / FT) 3.50 / 9.00	TUBULAR STEEL Ø (IN) (LB / FT) 4.00 / 10.80	TUBULAR STEEL Ø (IN) (LB / FT) 5.00 / 14.60	SIGN FRAME REQUIRED	REMARKS	SIGN DETAIL: DETAIL IN SHS	SIGN DETAIL: DETAIL ON SHEET NUMBER	SIGN DETAIL: DETAIL ON STD SHEET NUMBER
WARDSBORO VT 100							FY-FLUORESCENT YELLOW FYG-FLUORESCENT YELLOW GREEN																			"SHS"-STANDARD HIGHWAY SIGNS			
NB	6.584	C	W1-6	48	24	~~FY~~		8.00								2		X								ARROW FACES NB TRAFFIC, BUT **INSTALL PARALLEL TO VT-100**; BEHIND RAIL 10 FT± NORTH OF STOP SIGN.	X		
NB	6.596	A	M3-1	24	12		NORTH			1				X														
		A	M1-5	30	24		VERMONT 100			1																		
NB	6.675	A	R2-1	24	30								1		X														
		A	R2-1	24	30			5.00								1		X									X	
NB	6.880	A	R2-1	24	30		SPEED LIMIT 40			1				X														
NB	6.960	A	S1-1YG	36	36		SCHOOL PENTAGON			1				X														
		A	W16-9YG	24	10		AHEAD			1																		
NB	7.093	A	D1-2L	72	20		<--- WARDSBORO ELEMENTARY SCHOOL			1				X														
		B	D1-2R	72	20		WARDSBORO ELEMENTARY SCHOOL --->			1																		
NB	7.280	A	R2-1	24	30		SPEED LIMIT 50			1				X														
SB	7.280	F	R2-1	24	30		SPEED LIMIT 40			1				X														
SB	7.215	F	S1-1YG	36	36		SCHOOL PENTAGON			1				X														
		F	W16-9YG	24	10		AHEAD			1																		
SB	7.095	G	VR-017	24	30								2 ~~1~~		X												SALVAGED SEAT BELT SIGN ONTO NEW POST TH-45, SCHOOL ~~DR~~RD			
							SHEET TOTALS	13.00	0.00	11	~~0~~	~~0~~	3 ~~2~~	0	0	3		45											
								SF	SF	EA	EA	EA	EA	EA	EA	EA		FT										
							TOWN TOTALS	633.3	0.0	24.0	12.0	12.0	108	0.0	0.0	129		1935.0										

SIGN SUMMARY SHEET

VERMONT AGENCY OF TRANSPORTATION

PROJECT NAME: **Stamford-Andover VT100**
PROJECT NUMBER: **STPG SIGN(20)**

FILE NAME: **Wardsboro.xls**
PROJECT MANAGER: **N. Averv**
DESIGNED BY: **J. Kelly**
WARDSBORO SHEET 10

PLOT DATE: **8/6/2009**
DRAWN BY: **T. Guazzoni**
CHECKED BY: **T. Guazzoni**
SHEET **128** OF **198**

DIRECTION	MILEPOINT	LOCATION CODE (SHEET 2)	SIGN CODE	WIDTH (IN)	HEIGHT (IN)	SHEETING REMARKS	SIGN LEGEND	NEW SIGNS "A"	NEW SIGNS "B"	EXISTING SIGNS RETAIN	EXISTING SIGNS SALVAGE FROM	EXISTING SIGNS SALVAGE TO	EXISTING SIGNS REMOVE	EXIST POST RETAIN	EXIST POST REMOVE	NUMBER OF NEW POSTS	SQUARE STEEL (IN) 1.75 (LB / FT) 1.88	SQUARE STEEL (IN) 2.00 (LB / FT) 2.42	SQUARE STEEL (IN) 2.50 (LB / FT) 3.35	TUBULAR STEEL Ø (IN) FOUNDATION	TUBULAR STEEL Ø (IN) 3.00 (LB / FT) 7.60	TUBULAR STEEL Ø (IN) 3.50 (LB / FT) 9.00	TUBULAR STEEL Ø (IN) 4.00 (LB / FT) 10.80	TUBULAR STEEL Ø (IN) 5.00 (LB / FT) 14.60	SIGN FRAME REQUIRED	REMARKS	SIGN DETAIL: DETAIL IN SHS	SIGN DETAIL: DETAIL ON SHEET NUMBER	SIGN DETAIL: DETAIL ON STD SHEET NUMBER
WARDSBORO VT 100							FY-FLUORESCENT YELLOW FYG-FLUORESCENT YELLOW GREEN																				"SHS"-STANDARD HIGHWAY SIGNS			
SB	7.095	G	VR-017	24	30		SEAT BELT • LEGAL LOAD LIMIT 24,000 POUNDS	5.00			I	I	I			1		X								• SEE BELOW FOR STOP SIGN NOTE			E-141
SB	7.090	H	R1-1	30	30		SCHOOL RD				I	I	2 ~~1~~		X											SALVAGED SEAT BELT SIGN ONTO NEW POST TH-45, SCHOOL DR			
		H	R1-1	30	30		SEAT BELT STOP	6.25								1		X									X		
SB	7.000	F	VD-062B	72	16		BUSINESS SIGN			1				X															
SB	6.960	F	VD-062B	72	16		BUSINESS SIGN			1				X															
		F	VD-062B	72	16		BUSINESS SIGN			1																			
SB	6.940	F	VD-018	30	18								1		X														
		F	VD-018	30	18		WARDSBORO W. WARDSBORO 4	3.75								1		X											E-128A
SB	6.880	F	R2-1	30	36		SPEED LIMIT 35			1				X															
SB	6.650	F	W1-1MaR	30	30		MODIFIED RIGHT TURN						1		X														
		F	W13-1	18	18		20 MPH PLAQUE						1																
SB	6.608	F	M1-5	30	24		VERMONT 100						1		X														
		F	M6-1	21	15		RIGHT --->						1																
		F	W1-1MaR	30	30	FY		6.25								1		X										8	
		F	W13-1	18	18	FY	20 M.P.H.	2.25																				X	
SIGN SUMMARY SHEET							SHEET TOTALS	23.50	0.00	4	2 ~~0~~	2 ~~0~~	8 ~~6~~	0	0	4		60										
VERMONT AGENCY OF TRANSPORTATION								SF	SF	EA	EA	EA	EA	EA	EA	EA		FT										
							TOWN TOTALS	633.3	0.0	24.0	12.0	12.0	108	0.0	0.0	129		1935.0											

PROJECT NAME: **Stamford-Andover VT100**
PROJECT NUMBER: **STPG SIGN(20)**

FILE NAME: **Wardsboro.xls** PLOT DATE: **8/6/2009**
PROJECT MANAGER: **N. Avery** DRAWN BY: **T. Guazzoni**
DESIGNED BY: **J. Kelly** CHECKED BY: **T. Guazzoni**
WARDSBORO SHEET 11 SHEET **129** OF **198**

DIRECTION	MILEPOINT	LOCATION CODE (SHEET 2)	SIGN CODE	WIDTH (IN)	HEIGHT (IN)	SHEETING REMARKS	SIGN LEGEND	NEW SIGNS "A"	NEW SIGNS "B"	EXISTING SIGNS RETAIN	EXISTING SIGNS SALVAGE FROM	EXISTING SIGNS SALVAGE TO	EXISTING SIGNS REMOVE	EXIST POST RETAIN	EXIST POST REMOVE	NUMBER OF NEW POSTS	SQUARE STEEL (IN) 1.75 (LB / FT) 1.88	SQUARE STEEL (IN) 2.00 (LB / FT) 2.42	SQUARE STEEL (IN) 2.50 (LB / FT) 3.35	TUBULAR STEEL Ø (IN) FOUNDATION	TUBULAR STEEL Ø (IN) 3.00 (LB / FT) 7.60	TUBULAR STEEL Ø (IN) 3.50 (LB / FT) 9.00	TUBULAR STEEL Ø (IN) 4.00 (LB / FT) 10.80	TUBULAR STEEL Ø (IN) 5.00 (LB / FT) 14.60	SIGN FRAME REQUIRED	REMARKS	SIGN DETAIL: DETAIL IN SHS	SIGN DETAIL: DETAIL ON SHEET NUMBER	SIGN DETAIL: DETAIL ON STD SHEET NUMBER
WARDSBORO VT 100							FY-FLUORESCENT YELLOW FYG-FLUORESCENT YELLOW GREEN																				"SHS"-STANDARD HIGHWAY SIGNS			
SB	6.534	F	R2-1	24	30		SPEED LIMIT 35						1		X														
SB	6.527	G	VR-017	24	30		LEGAL LOAD LIMIT 24,000 LBS						1		X												TH-5, MAIN ST			
		G	R2-1	24	30		SPEED LIMIT 25 (TOWN INSTALLED)				1	1	I														INSTALL UNDER NEW LEGAL LOAD LIMIT 24,000 LBS			
		H	R1-1	30	30		LEGAL LOAD LIMIT 24,000 POUNDS						1																
		G	VR-017	24	30			5.00								1		X								INSTALL LEGAL LOAD LIMIT AND STOP SIGNS BACK-TO-BACK			E-141
		H	R1-1	30	30		STOP	6.25					I														X		
SB	6.522	H	R1-1	30	30		STOP						1		X												TH-5, MAIN ST			
		H	R1-1	30	30		MAIN ST	6.25								1		X								SALAVGED STREET SIGN ONTO NEW POST	X		
SB	6.510	G	VR-017	24	30		LEGAL LOAD LIMIT 24,000 POUNDS	5.00								1		X								TH-14, FORNUTO RD			E-141
SB	6.500	H	R1-1	30	30		STOP						1		X														
		H	R1-1	30	30			6.25								1		X								TH-14, FORNUTO RD	X		
SB	~~6.462~~ 6.442	F	M3-3	24	12		SOUTH VERMONT 100	2.00								1		X								GREEN ON WHITE SHEETING.	X		
		F	M1-5	30	24			5.00																		INSTALL ASSEMBLY ~~200~~ 300 FT± SOUTH OF FORNUTO RD, JUST SOUTH OF THE DRIVEWAY			E-136B
SB	6.400	F	R2-1	24	30		SPEED LIMIT 35						1		X														
		F	R2-1	24	30			5.00								1		X									X		
							SHEET TOTALS	40.75	0.00	0	1	1	~~8~~ 6	0	0	6		90											
								SF	SF	EA	EA	EA	EA	EA	EA	EA		FT											
							TOWN TOTALS	633.3	0.0	24.0	12.0	12.0	108	0.0	0.0	129		1935.0											

SIGN SUMMARY SHEET

VERMONT AGENCY OF TRANSPORTATION

PROJECT NAME: **Stamford-Andover VT100**
PROJECT NUMBER: **STPG SIGN(20)**

FILE NAME: **Wardsboro.xls**
PROJECT MANAGER: **N. Avery**
DESIGNED BY: **J. Kelly**
WARDSBORO SHEET 12

PLOT DATE: **8/6/2009**
DRAWN BY: **T. Guazzoni**
CHECKED BY: **T. Guazzoni**
SHEET **130** OF **198**

DIRECTION	MILEPOINT	LOCATION CODE (SHEET 2)	SIGN CODE	WIDTH (IN)	HEIGHT (IN)	SHEETING REMARKS	SIGN LEGEND	NEW SIGNS "A"	NEW SIGNS "B"	EXISTING SIGNS RETAIN	EXISTING SIGNS SALVAGE FROM	EXISTING SIGNS SALVAGE TO	EXISTING SIGNS REMOVE	EXIST POST RETAIN	EXIST POST REMOVE	NUMBER OF NEW POSTS	SQUARE STEEL (IN) (LB / FT) 1.75 / 1.88	SQUARE STEEL (IN) (LB / FT) 2.00 / 2.42	SQUARE STEEL (IN) (LB / FT) 2.50 / 3.35	TUBULAR STEEL Ø (IN) FOUNDATION	TUBULAR STEEL Ø (IN) (LB / FT) 3.00 / 7.60	TUBULAR STEEL Ø (IN) (LB / FT) 3.50 / 9.00	TUBULAR STEEL Ø (IN) (LB / FT) 4.00 / 10.80	TUBULAR STEEL Ø (IN) (LB / FT) 5.00 / 14.60	SIGN FRAME REQUIRED	REMARKS	SIGN DETAIL: DETAIL IN SHS	SIGN DETAIL: DETAIL ON SHEET NUMBER	SIGN DETAIL: DETAIL ON STD SHEET NUMBER
WARDSBORO VT 100							FY-FLUORESCENT YELLOW FYG-FLUORESCENT YELLOW GREEN																			"SHS"-STANDARD HIGHWAY SIGNS			
SB	6.190	F	R2-1	24	30								1		X													
		F	R2-1	24	30			5.00								1		X									X	
SB	5.990	F	W1-2R	30	30		CURVE RIGHT						1		X													
		F	W13-1	18	18		35 MPH (PLAQUE) 						1															
SB	5.970	F	W1-2R	30	30			6.25								1		X								INSTALL 100 FEET SOUTH OF EXISTING RIGHT CURVE ASSEMBLY	X		
		F	W13-1	18	18			2.25																			X	
SB	5.193	G	VR-017	24	30								1		X												TH-16, BILLS RD (NORTH)			
		G	VR-017	24	30			5.00								1		X										E-141
SB	5.188	H	R1-1	30	30		 BILLS RD						1		X												TH-16, BILLS RD (NORTH)			
		H	R1-1	30	30			6.25								1		X								SALAVGED STREET SIGN ONTO NEW POST	X		
SB	4.838	G	VR-017	24	30		LEGAL LOAD LIMIT 24,000 LBS						1		X												TH-16, BILLS RD (SOUTH)			
		G	R2-1	24	30		SPEED LIMIT 25 (TOWN) 																				INSTALL UNDER NEW LEGAL LOAD LIMIT 24,000 LBS SIGN			
		G	VR-017	24	30			5.00								1		X										E-141
SB	4.832	H	R1-1	30	30		 1000 1319 0483						1		X												TH-16, BILLS RD (SOUTH)			
		H	R1-1	30	30			6.25								1		X									X	
							SHEET TOTALS	36.00	0.00	0	1	1	~~7~~ 8	0	0	6		90										
								SF	SF	EA	EA	EA	EA	EA	EA	EA		FT										
							TOWN TOTALS	633.3	0.0	24.0	12.0	12.0	108	0.0	0.0	129		1935.0										

SIGN SUMMARY SHEET

VERMONT AGENCY OF TRANSPORTATION

PROJECT NAME: **Stamford-Andover VT100**
PROJECT NUMBER: **STPG SIGN(20)**

FILE NAME: **Wardsboro.xls**
PROJECT MANAGER: **N. Avery**
DESIGNED BY: **J. Kelly**
WARDSBORO SHEET 13

PLOT DATE: **8/6/2009**
DRAWN BY: **T. Guazzoni**
CHECKED BY: **T. Guazzoni**
SHEET **131** OF **198**

DIRECTION	MILEPOINT	LOCATION CODE (SHEET 2)	SIGN CODE	WIDTH (IN)	HEIGHT (IN)	SHEETING REMARKS	SIGN LEGEND	NEW SIGNS "A"	NEW SIGNS "B"	EXISTING SIGNS RETAIN	EXISTING SIGNS SALVAGE FROM	EXISTING SIGNS SALVAGE TO	EXISTING SIGNS REMOVE	EXIST POST RETAIN	EXIST POST REMOVE	NUMBER OF NEW POSTS	SQUARE STEEL (IN) 1.75 (LB / FT) 1.88	SQUARE STEEL (IN) 2.00 (LB / FT) 2.42	SQUARE STEEL (IN) 2.50 (LB / FT) 3.35	TUBULAR STEEL Ø (IN) FOUNDATION	TUBULAR STEEL Ø (IN) 3.00 (LB / FT) 7.60	TUBULAR STEEL Ø (IN) 3.50 (LB / FT) 9.00	TUBULAR STEEL Ø (IN) 4.00 (LB / FT) 10.80	TUBULAR STEEL Ø (IN) 5.00 (LB / FT) 14.60	SIGN FRAME REQUIRED	REMARKS	SIGN DETAIL: DETAIL IN SHS	SIGN DETAIL: DETAIL ON SHEET NUMBER	SIGN DETAIL: DETAIL ON STD SHEET NUMBER
WARDSBORO VT 100							FY-FLUORESCENT YELLOW FYG-FLUORESCENT YELLOW GREEN																				"SHS"-STANDARD HIGHWAY SIGNS			
SB	4.305	F	W1-2R	30	30		RIGHT CURVE						1		X														
		F	W13-1	18	18		35 MPH PLAQUE						1																
SB	4.258	F	W1-2R	30	30	FY		6.25								1		X									INSTALL 250 FEET SOUTH OF EXISTING RIGHT CURVE ASSEMBLY	X		
		F	W13-1	18	18	FY	1000 1319 0440	2.25																				X		
SB	3.248	G	VR-017	24	30		LEGAL LOAD LIMIT 24,000 LBS						1		X															
		G	R2-1	24	30		 SPEED LIMIT 35 (TOWN)				1	1													INSTALL UNDER NEW LEGAL LOAD LIMIT 24,000 LBS SIGN			
		G	VR-017	24	30			5.00								1		X									TH-11, FITTS RD			E-141
SB	3.242	H	R1-1	30	30								1		X															
		H	R1-1	30	30			6.25								1		X									TH-11, FITTS RD	X		
SB	2.887	F	W3-5	36	36		SPEED REDUCTION (30)			1				X															
SB	2.820 ~~2.830~~	F	VD-018	30	18								1		X														
		F	VD-018	30	18			3.75								1		X									SIGN MOVED 75' SOUTH FOR BETTER VISIBILITY			E-128A
SB	2.766	F	R2-1	30	36		SPEED LIMIT 30				1				X												SALVAGE TO MP 2.730, 185+/- FEET SOUTH			
SB	2.763	G	VR-017	24	30		LEGAL LOAD LIMIT 24,000 LBS						1		X															
		G	R2-1	24	30		SPEED LIMIT 35 (TOWN INSTALLED)				1	1	I														INSTALL UNDER NEW LEGAL LOAD LIMIT 24,000 LBS SIGN			
							SHEET TOTALS	23.50	0.00	1	3	2	~~6~~ 8	0	0	4		60											
								SF	SF	EA	EA	EA	EA	EA	EA	EA		FT											
							TOWN TOTALS	633.3	0.0	24.0	12.0	12.0	108	0.0	0.0	129		1935.0											

SIGN SUMMARY SHEET

VERMONT AGENCY OF TRANSPORTATION

PROJECT NAME: **Stamford-Andover VT100**
PROJECT NUMBER: **STPG SIGN(20)**

FILE NAME: **Wardsboro.xls**
PROJECT MANAGER: **N. Avery**
DESIGNED BY: **J. Kelly**
WARDSBORO SHEET 14

PLOT DATE: **8/6/2009**
DRAWN BY: **T. Guazzoni**
CHECKED BY: **T. Guazzoni**
SHEET **132** OF **198**

DIRECTION	MILEPOINT	LOCATION CODE (SHEET 2)	SIGN CODE	WIDTH (IN)	HEIGHT (IN)	SHEETING REMARKS	SIGN LEGEND	NEW SIGNS "A"	NEW SIGNS "B"	EXISTING SIGNS RETAIN	EXISTING SIGNS SALVAGE FROM	EXISTING SIGNS SALVAGE TO	EXISTING SIGNS REMOVE	EXIST POST RETAIN	EXIST POST REMOVE	NUMBER OF NEW POSTS	SQUARE STEEL (IN) 1.75 (LB/FT) 1.88	SQUARE STEEL (IN) 2.00 (LB/FT) 2.42	SQUARE STEEL (IN) 2.50 (LB/FT) 3.35	TUBULAR STEEL Ø (IN) FOUNDATION	TUBULAR STEEL Ø (IN) 3.00 (LB/FT) 7.60	TUBULAR STEEL Ø (IN) 3.50 (LB/FT) 9.00	TUBULAR STEEL Ø (IN) 4.00 (LB/FT) 10.80	TUBULAR STEEL Ø (IN) 5.00 (LB/FT) 14.60	SIGN FRAME REQUIRED	REMARKS	SIGN DETAIL: DETAIL IN SHS	SIGN DETAIL: DETAIL ON SHEET NUMBER	SIGN DETAIL: DETAIL ON STD SHEET NUMBER
WARDSBORO VT 100							FY-FLUORESCENT YELLOW FYG-FLUORESCENT YELLOW GREEN																			"SHS"-STANDARD HIGHWAY SIGNS			
		G	VR-017	24	30		LEGAL LOAD LIMIT 24,000 POUNDS	5.00								1		X								TH-10, SHELDON HILL RD			E-141
SB	2.758	H	R1-1	30	30		STOP SHELDON HILL RD						1		X														
		H	R1-1	30	30			6.25			I	I				1		X								TH-10, SHELDON HILL RD	X		
SB	2.730	F	R2-1	30	36		SPEED LIMIT 30					1	I			1		X								SALVAGED SIGN FROM M.P. 2.766			
SB	2.555	F	R2-1	24	30		SPEED LIMIT 30						1		X														
		F	R2-1	24	30			5.00								1		X									X		
SB	2.411	F	W1-3L	36	36		LEFT REVERSE TURN				1		I		X											SALVAGE TO M.P. 2.403			
		F	W13-1	24	24		20 MPH PLAQUE				1		I													SALVAGE TO M.P. 2.403			
SB	2.403	F	W5-2	30	30		NARROW BRIDGE						1		X														
		F	W1-3L	36	36		1000 1319 0240 LEFT REVERSE TURN					1				2		X								SALVAGED FROM M.P. 2.411			
		F	W13-1	24	24		20 MPH PLAQUE					1														SALVAGED FROM M.P. 2.411			
SB	2.345	F	W5-2	36	36		NARROW BRIDGE	9.00								~~1~~		X								INSTALL 275 FT± SOUTH OF THE RELOCATED REVERSE TURN ASSEMBLY.	X		
SB	2.343	E	W1-6	48	24								1		X														
		E	W1-6	48	24	FY		8.00								2		X									X		
SB	2.338	G	VR-017	24	30								1		X											TH-7, NEWELL RD			
							SHEET TOTALS	33.25	0.00	0	~~3~~ 2	~~4~~ 3	~~8~~ 5	0	0	~~10~~ 9		135									
								SF	SF	EA	EA	EA	EA	EA	EA	EA		FT									
							TOWN TOTALS	633.3	0.0	24.0	12.0	12.0	108	0.0	0.0	129		1935.0									

SIGN SUMMARY SHEET

VERMONT AGENCY OF TRANSPORTATION

PROJECT NAME: **Stamford-Andover VT100**
PROJECT NUMBER: **STPG SIGN(20)**

FILE NAME: **Wardsboro.xls**
PROJECT MANAGER: **N. Averv**
DESIGNED BY: **J. Kelly**
WARDSBORO SHEET 15

PLOT DATE: **8/6/2009**
DRAWN BY: **T. Guazzoni**
CHECKED BY: **T. Guazzoni**
SHEET **133** OF **198**

DIRECTION	MILEPOINT	LOCATION CODE (SHEET 2)	SIGN CODE	WIDTH (IN)	HEIGHT (IN)	SHEETING REMARKS	SIGN LEGEND	NEW SIGNS "A"	NEW SIGNS "B"	EXISTING SIGNS RETAIN	EXISTING SIGNS SALVAGE FROM	EXISTING SIGNS SALVAGE TO	EXISTING SIGNS REMOVE	EXIST POST RETAIN	EXIST POST REMOVE	NUMBER OF NEW POSTS	SQUARE STEEL (IN) 1.75 (LB / FT) 1.88	SQUARE STEEL (IN) 2.00 (LB / FT) 2.42	SQUARE STEEL (IN) 2.50 (LB / FT) 3.35	TUBULAR STEEL Ø (IN) FOUNDATION	TUBULAR STEEL Ø (IN) 3.00 (LB / FT) 7.60	TUBULAR STEEL Ø (IN) 3.50 (LB / FT) 9.00	TUBULAR STEEL Ø (IN) 4.00 (LB / FT) 10.80	TUBULAR STEEL Ø (IN) 5.00 (LB / FT) 14.60	SIGN FRAME REQUIRED	REMARKS	SIGN DETAIL: DETAIL IN SHS	SIGN DETAIL: DETAIL ON SHEET NUMBER	SIGN DETAIL: DETAIL ON STD SHEET NUMBER
WARDSBORO VT 100							FY-FLUORESCENT YELLOW FYG-FLUORESCENT YELLOW GREEN																			"SHS"-STANDARD HIGHWAY SIGNS			
		G	VR-017	24	30			5.00								1		X										E-141
SB	2.334	H	R1-1	30	30		STOP				1	1	I		X	1		X								TH-7, NEWELL RD			
SB	2.333	F	W1-6	60	30								1		X														
		F	W1-6	60	30	FY		12.50								2		X									X		
SB	2.323	F	OM-3R	12	36								1		X														
		F	OM-3R	12	36			3.00								1		X									X		
SB	2.313	E	OM-3L	12	36								1		X														
		E	OM-3L	12	36			3.00								1		X									X		
SB	2.280	F	R2-1	24	30								1		X														
		F	R2-1	24	30			5.00								1		X									X		
SB	2.278	G	VR-017	24	30								1		X														
		H	R1-1	30	30		LEGAL LOAD LIMIT 24,000 POUNDS 1000 1319 0228						1													TH-46, CROSS RD			
		G	VR-017	24	30			5.00								1		X											E-141
SB	2.273	H	R1-1	30	30			6.25								1		X									X		
SB	2.228	F	D1-1A	72	10								1		X														
							SHEET TOTALS	39.75	0.00	0	1	1	7	0	0	9		135										
								SF	SF	EA	EA	EA	EA	EA	EA	EA		FT										
							TOWN TOTALS	633.3	0.0	24.0	12.0	12.0	108	0.0	0.0	129		1935.0										

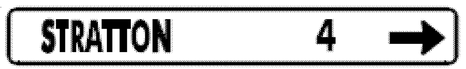
SIGN SUMMARY SHEET

VERMONT AGENCY OF TRANSPORTATION

PROJECT NAME: **Stamford-Andover VT100**
PROJECT NUMBER: **STPG SIGN(20)**

FILE NAME: **Wardsboro.xls**
PROJECT MANAGER: **N. Avery**
DESIGNED BY: **J. Kelly**
WARDSBORO SHEET 16

PLOT DATE: **8/6/2009**
DRAWN BY: **T. Guazzoni**
CHECKED BY: **T. Guazzoni**
SHEET **134** OF **198**

DIRECTION	MILEPOINT	LOCATION CODE (SHEET 2)	SIGN CODE	WIDTH (IN)	HEIGHT (IN)	SHEETING REMARKS	SIGN LEGEND	NEW SIGNS "A"	NEW SIGNS "B"	EXISTING SIGNS RETAIN	EXISTING SIGNS SALVAGE FROM	EXISTING SIGNS SALVAGE TO	EXISTING SIGNS REMOVE	EXIST POST RETAIN	EXIST POST REMOVE	NUMBER OF NEW POSTS	SQUARE STEEL (IN) 1.75 (LB / FT) 1.88	SQUARE STEEL (IN) 2.00 (LB / FT) 2.42	SQUARE STEEL (IN) 2.50 (LB / FT) 3.35	TUBULAR STEEL Ø (IN) FOUNDATION	TUBULAR STEEL Ø (IN) 3.00 (LB / FT) 7.60	TUBULAR STEEL Ø (IN) 3.50 (LB / FT) 9.00	TUBULAR STEEL Ø (IN) 4.00 (LB / FT) 10.80	TUBULAR STEEL Ø (IN) 5.00 (LB / FT) 14.60	SIGN FRAME REQUIRED	REMARKS	SIGN DETAIL: DETAIL IN SHS	SIGN DETAIL: DETAIL ON SHEET NUMBER	SIGN DETAIL: DETAIL ON STD SHEET NUMBER
WARDSBORO VT 100							FY-FLUORESCENT YELLOW FYG-FLUORESCENT YELLOW GREEN																			"SHS"-STANDARD HIGHWAY SIGNS			
		F	D1-1A	72	10								1															
		F	D1-1A	72	12			6.00								2		X										5
		F	D1-1A	72	12			6.00																			5
SB	2.143	G	VR-017	24	30								1		X													
		G	VR-017	24	30			5.00								1		X								TH-1, STRATTON-ARLINGTON RD		E-141
SB	2.138	H	R1-1	30	30								1		X													
		H	R1-1	30	30			6.25			|	|				1		X								TH-1, STRATTON-ARLINGTON RD	X	
SB	2.115	F	M3-3S	24	12		SOUTH						1		X													
		F	M1-5	30	24		 VERMONT 100						1															
		F	R2-1	24	30			5.00								1		X									X	
SB	2.077	F	M3-3	24	12			2.00								1		X								INSTALL 200 FT± SOUTH OF THE NEW SPEED LIMIT SIGN. GREEN ON WHITE SHEETING	X	
		F	M1-5	30	24			5.00																				E-136B
SB	2.040	F	R2-1	24	30		SPEED LIMIT 50						1		X													
SB	1.900	F	W1-2R	30	30		RIGHT CURVE				1		|		X													
		F	W13-1	18	18		35 MPH PLAQUE				1		|															
							SHEET TOTALS	35.25 SF	0.00 SF	0 EA	~~2~~ 3 EA	~~0~~ | EA	~~6~~ 8 EA	0 EA	0 EA	6 EA		90 FT							
							TOWN TOTALS	633.3	0.0	24.0	12.0	12.0	108	0.0	0.0	129		1935.0										

SIGN SUMMARY SHEET

VERMONT AGENCY OF TRANSPORTATION

PROJECT NAME: **Stamford-Andover VT100**
PROJECT NUMBER: **STPG SIGN(20)**

FILE NAME: **Wardsboro.xls**
PROJECT MANAGER: **N. Avery**
DESIGNED BY: **J. Kelly**
WARDSBORO SHEET 17

PLOT DATE: **8/6/2009**
DRAWN BY: **T. Guazzoni**
CHECKED BY: **T. Guazzoni**
SHEET **135** OF **198**

DIRECTION	MILEPOINT	LOCATION CODE (SHEET 2)	SIGN CODE	WIDTH (IN)	HEIGHT (IN)	SHEETING REMARKS	SIGN LEGEND	NEW SIGNS "A"	NEW SIGNS "B"	EXISTING SIGNS RETAIN	EXISTING SIGNS SALVAGE FROM	EXISTING SIGNS SALVAGE TO	EXISTING SIGNS REMOVE	EXIST POST RETAIN	EXIST POST REMOVE	NUMBER OF NEW POSTS	SQUARE STEEL (IN) 1.75 (LB / FT) 1.88	SQUARE STEEL (IN) 2.00 (LB / FT) 2.42	SQUARE STEEL (IN) 2.50 (LB / FT) 3.35	TUBULAR STEEL Ø (IN) FOUNDATION	TUBULAR STEEL Ø (IN) 3.00 (LB / FT) 7.60	TUBULAR STEEL Ø (IN) 3.50 (LB / FT) 9.00	TUBULAR STEEL Ø (IN) 4.00 (LB / FT) 10.80	TUBULAR STEEL Ø (IN) 5.00 (LB / FT) 14.60	SIGN FRAME REQUIRED	REMARKS	SIGN DETAIL: DETAIL IN SHS	SIGN DETAIL: DETAIL ON SHEET NUMBER	SIGN DETAIL: DETAIL ON STD SHEET NUMBER
WARDSBORO VT 100							FY-FLUORESCENT YELLOW FYG-FLUORESCENT YELLOW GREEN																			"SHS"-STANDARD HIGHWAY SIGNS			
SB	1.872	F	W1-2R	30	30		RIGHT CURVE					1				1		X								INSTALL 150 FT± SOUTH OF PREVIOUS POSITION	X		
		F	W13-1	18	18		35 MPH PLAQUE					1															X		
SB	0.990	F	W1-2R	30	30		RIGHT CURVE						1		X														
		F	W13-1	18	18		35 MPH PLAQUE						1																
	0.933	F	W1-2R	30	30	~~FY~~		6.25								1		X								INSTALL 300 FT± SOUTH OF PREVIOUS POSITION	X		
		F	W13-1	18	18	~~FY~~		2.25																			X		
SB	0.760	F	VW-060	30	30		HIDDEN DRIVES						1		X														
SB	0.700	F	VW-054R	30	30			6.25								1		X								INSTALL 315 FT± SOUTH OF PREVIOUS HIDDEN DRIVES SIGN			E-154
							SHEET TOTALS	14.75	0.00	0	0	2	3	0	0	3		45									
								SF	SF	EA	EA	EA	EA	EA	EA	EA		FT									
							TOWN TOTALS	633.3	0.0	24.0	12.0	12.0	108	0.0	0.0	129		1935.0									





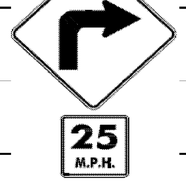
SIGN SUMMARY SHEET

VERMONT AGENCY OF TRANSPORTATION

PROJECT NAME: **Stamford-Andover VT100**
PROJECT NUMBER: **STPG SIGN(20)**

FILE NAME: **Wardsboro.xls**
PROJECT MANAGER: **N. Avery**
DESIGNED BY: **J. Kelly**
WARDSBORO SHEET 18

PLOT DATE: **8/6/2009**
DRAWN BY: **T. Guazzoni**
CHECKED BY: **T. Guazzoni**
SHEET **136** OF **198**

DIRECTION	MILEPOINT	LOCATION CODE (SHEET 2)	SIGN CODE	WIDTH (IN)	HEIGHT (IN)	SHEETING REMARKS	SIGN LEGEND	NEW SIGNS "A"	NEW SIGNS "B"	EXISTING SIGNS RETAIN	EXISTING SIGNS SALVAGE FROM	EXISTING SIGNS SALVAGE TO	EXISTING SIGNS REMOVE	EXIST POST RETAIN	EXIST POST REMOVE	NUMBER OF NEW POSTS	SQUARE STEEL (IN) 1.75 (LB / FT) 1.88	SQUARE STEEL (IN) 2.00 (LB / FT) 2.42	SQUARE STEEL (IN) 2.50 (LB / FT) 3.35	TUBULAR STEEL Ø (IN) FOUNDATION	TUBULAR STEEL Ø (IN) 3.00 (LB / FT) 7.60	TUBULAR STEEL Ø (IN) 3.50 (LB / FT) 9.00	TUBULAR STEEL Ø (IN) 4.00 (LB / FT) 10.80	TUBULAR STEEL Ø (IN) 5.00 (LB / FT) 14.60	SIGN FRAME REQUIRED	REMARKS	SIGN DETAIL: DETAIL IN SHS	SIGN DETAIL: DETAIL ON SHEET NUMBER	SIGN DETAIL: DETAIL ON STD SHEET NUMBER
JAMAICA VT 100							FY-FLUORESCENT YELLOW FYG-FLUORESCENT YELLOW GREEN																				"SHS"-STANDARD HIGHWAY SIGNS			
NB	0.000	C	VD-024	60	7.5		JAMAICA I WARDSBORO						1		X											INSTALL THE NEW SIGN ON TWO POSTS AT THE SAME LOCATION AS THE REMOVAL		4	
		C	VD-024	72	10		JAMAICA | WARDSBORO	5.00								2		X											
		C	VD-700	6	10		1000-1309-0000				1	1														JAMAICA MILE MARKER. INSTALL ON THE LEFT-SIDE POST UNDER JAMAICA.			
		C	VD-700	6	10		1000-1319-0737				1	1														WARDSBORO MILE MARKER. INSTALL ON THE RIGHT-SIDE POST UNDER WARDSBORO.			
RETAIN SIGN AT NB 0.300 SEE PAGE 149																													
NB	0.475	A	W1-1R	30	30		RIGHT TURN SYMBOL						1		X															
		A	W13-1	18	18		25 MPH (PLAQUE)						1																	
NB	0.509	A	W1-1R	30	30	FY		6.25								1		X								INSTALL 180 FT ± NORTH OF PREVIOUS POSITION, 10 FT MIN NORTH OF POLE.	X		
		A	W13-1	18	18	FY		2.25																			X		
NB	~~1.022~~ 1.036	A	W1-4L	30	30		REVERSE CURVE LEFT						1		X											MOVED 75' NORTH OF PREVIOUS LOCATION			
		A	W1-3L	30	30	FY		6.25								1		X									X		
		A	W13-1	18	18	FY		2.25																			X		
NB	1.073	A	S3-1	30	30		SCHOOL BUS STOP AHEAD			1				X															
NB	1.270	A	W1-2L	30	30		CURVE LEFT						1		X															
NB	~~1.310~~ 1.298	A	W1-2L	30	30	FY		6.25								1		X								INSTALL ~~210~~ 150 FT ± NORTH OF PREVIOUS POSITON.	X		
NB	1.746	A	W1-2R	30	30								1		X														
							SHEET TOTALS	28.25	0.00	1	2	2	6	0	0	5		75											
								SF	SF	EA	EA	EA	EA	EA	EA	EA		FT											
							TOWN TOTALS	391.9	0.0	33.0	4.0	4.0	69	0.0	0.0	66		990.0											

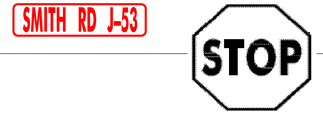
SIGN SUMMARY SHEET

VERMONT AGENCY OF TRANSPORTATION

PROJECT NAME: **Stamford-Andover VT100**
PROJECT NUMBER: **STPG SIGN(20)**

FILE NAME: **Jamaica.xls**
PROJECT MANAGER: **N. Averv**
DESIGNED BY: **M. Miller**
JAMAICA SHEET 1

PLOT DATE: **8/6/2009**
DRAWN BY: **T. Guazzoni**
CHECKED BY: **T. Guazzoni**
SHEET **137** OF **198**

DIRECTION	MILEPOINT	LOCATION CODE (SHEET 2)	SIGN CODE	WIDTH (IN)	HEIGHT (IN)	SHEETING REMARKS	SIGN LEGEND	NEW SIGNS "A"	NEW SIGNS "B"	EXISTING SIGNS RETAIN	EXISTING SIGNS SALVAGE FROM	EXISTING SIGNS SALVAGE TO	EXISTING SIGNS REMOVE	EXIST POST RETAIN	EXIST POST REMOVE	NUMBER OF NEW POSTS	SQUARE STEEL (IN) 1.75 (LB / FT) 1.88	SQUARE STEEL (IN) 2.00 (LB / FT) 2.42	SQUARE STEEL (IN) 2.50 (LB / FT) 3.35	TUBULAR STEEL Ø (IN) FOUNDATION	TUBULAR STEEL Ø (IN) 3.00 (LB / FT) 7.60	TUBULAR STEEL Ø (IN) 3.50 (LB / FT) 9.00	TUBULAR STEEL Ø (IN) 4.00 (LB / FT) 10.80	TUBULAR STEEL Ø (IN) 5.00 (LB / FT) 14.60	SIGN FRAME REQUIRED	REMARKS	SIGN DETAIL: DETAIL IN SHS	SIGN DETAIL: DETAIL ON SHEET NUMBER	SIGN DETAIL: DETAIL ON STD SHEET NUMBER
JAMAICA VT 100							FY-FLUORESCENT YELLOW FYG-FLUORESCENT YELLOW GREEN																				"SHS"-STANDARD HIGHWAY SIGNS			
NB	I.746	A	W13-1	18	18								1																
		A	W1-2R	30	30	FY		6.25								1		X										X	
		A	W13-1	18	18	FY		2.25																				X	
NB	2.244	C	VR-017	24	30			5.00								1		X								SMITH 53 CLAYTON RD (TH-55)			
NB	2.252	D	R1-1	30	30								1		X															
		D	R1-1	30	30			6.25								1		X										X	
NB	2.255	A	OM-3R	12	36			3.00					I		X	1		X									INSTALL w/ 4 FT OF VERTICAL CLEARANCE TO THE BOTTOM OF THE SIGN	X	
NB	2.288	B	OM-3L	12	36								1		X												BEHIND RAIL; BR #78; SIGN AND POST MAY BE MISSING		
		B	OM-3L	12	36			3.00								1		X									IN NB LANE FACING SB TRAFFIC	X	
NB	2.491	C	VR-017	24	30			5.00					I			1		X									OLD ROUTE 8 (TH-56)		E-141
NB	2.499	D	R1-1	30	30								1		X												OLD ROUTE 8 (TH-56)		
		D	R1-1	30	30		1000 1309 0253	6.25								1		X										X	
NB	2.953	A	W1-7B	30	30	FY		6.25								1		X									INSTALL 135 FT± NORTH OF GUARDRAIL END, 500 FT± SOUTH OF EXISTING HILL SYMBOL.	X	
		A	W16-4	30	24	FY	NEXT 2000 FEET	5.00																			SPAN PLAQUE ACROSS BOTH POSTS.	X	
NB	2.993	A	N/A				~~(EMPTY POST)~~								~~X~~												POST PREVIOUSLY REMOVED		
							SHEET TOTALS	48.25	0.00	0	0	0	~~4~~ 6	0	0	8		120										
								SF	SF	EA	EA	EA	EA	EA	EA	EA		FT										
							TOWN TOTALS	391.9	0.0	33.0	4.0	4.0	69	0.0	0.0	66		990.0										

SIGN SUMMARY SHEET

VERMONT AGENCY OF TRANSPORTATION

PROJECT NAME: **Stamford-Andover VT100**
PROJECT NUMBER: **STPG SIGN(20)**

FILE NAME: **Jamaica.xls**
PROJECT MANAGER: **N. Averv**
DESIGNED BY: **M. Miller**
JAMAICA SHEET 2

PLOT DATE: **8/6/2009**
DRAWN BY: **T. Guazzoni**
CHECKED BY: **T. Guazzoni**
SHEET **138** OF **198**

DIRECTION	MILEPOINT	LOCATION CODE (SHEET 2)	SIGN CODE	WIDTH (IN)	HEIGHT (IN)	SHEETING REMARKS	SIGN LEGEND	NEW SIGNS "A"	NEW SIGNS "B"	EXISTING SIGNS RETAIN	EXISTING SIGNS SALVAGE FROM	EXISTING SIGNS SALVAGE TO	EXISTING SIGNS REMOVE	EXIST POST RETAIN	EXIST POST REMOVE	NUMBER OF NEW POSTS	SQUARE STEEL (IN) 1.75 (LB / FT) 1.88	SQUARE STEEL (IN) 2.00 (LB / FT) 2.42	SQUARE STEEL (IN) 2.50 (LB / FT) 3.35	FOUNDATION	TUBULAR STEEL Ø (IN) 3.00 (LB / FT) 7.60	TUBULAR STEEL Ø (IN) 3.50 (LB / FT) 9.00	TUBULAR STEEL Ø (IN) 4.00 (LB / FT) 10.80	TUBULAR STEEL Ø (IN) 5.00 (LB / FT) 14.60	SIGN FRAME REQUIRED	REMARKS	SIGN DETAIL: DETAIL IN SHS	SIGN DETAIL: DETAIL ON SHEET NUMBER	SIGN DETAIL: DETAIL ON STD SHEET NUMBER
JAMAICA VT 100							FY-FLUORESCENT YELLOW FYG-FLUORESCENT YELLOW GREEN																			"SHS"-STANDARD HIGHWAY SIGNS			
NB	3.057	A	W7-1B	30	30		HILL SYMBOL w/ 6% GRADE						1		X														
~~NB~~	~~3.104~~	~~A~~	~~N/A~~				~~(TWO POSTS w/ DUAL FLASHING BEACONS)~~							~~X~~												PREVIOUSLY REMOVED WHEN BRIDGE WORK WAS COMPLETE.			
NB	3.140	A	W3-5	36	36			9.00								2		X								100 SOUTH 10 FT ± NORTH OF THE "REDUCED SPEED AHEAD" TO BE REMOVED	X		THIS SIGN WAS MOVED FOR BETTER VISIBILITY AND AWAY FROM DRIVE.
NB	3.138	A	R2-5A	24	30		REDUCED SPEED AHEAD						1		X														
NB	3.220	A	S3-1	30	30		SCHOOL BUS STOP AHEAD					~~1~~	1		X											INSTALLED ON TOP FROM SHEET # 182 - WESTON NB MM 7.010			
		A	W2-3Ma L	30	30			6.25								~~1~~ 2		X								INSTALL AS SHOWN		6	
		A	W16-8	30	8			1.67																		ADDITIONAL SIGN RESULTED IN 2 POSTS		6	
NB	3.225	A	VD-062B	72	16		BUSINESS SIGN			1				X															
NB	3.265	A	R2-1	24	30								1		X														
		A	R2-1	30	36			7.50								1		X										6	
NB	3.329	C	VR-017	24	30		LEGAL LOAD LIMIT 24,000 LBS			1				X													OLD ROUTE 8 (TH-56).			
NB	3.337	D	R1-1	30	30		STOP OLD ROUTE 8 J-56			~~1~~ 2				X													OLD ROUTE 8 (TH-56).			
NB	3.387	C	VR-017	24	30		LEGAL LOAD LIMIT 24,000 LBS			1				X													EATON RD (TH-43).			
NB	3.395	D	R1-1	30	30		STOP EATON RD J-43 1000 1309 0340			~~1~~ 2				X													EATON RD (TH-43).			
NB	3.463	A	M2-1	21	15		JCT			1				X															
							SHEET TOTALS	24.42 SF	0.00 SF	~~8~~ 6 EA	~~1~~ 0 EA	~~1~~ 0 EA	4 EA	0 EA	0 EA	~~5~~ 4 EA		60 FT											
							TOWN TOTALS	391.9	0.0	33.0	4.0	4.0	69	0.0	0.0	66		990.0											

SIGN SUMMARY SHEET

VERMONT AGENCY OF TRANSPORTATION

PROJECT NAME: Stamford-Andover VT100
PROJECT NUMBER: STPG SIGN(20)

FILE NAME: Jamaica.xls
PROJECT MANAGER: N. Averv
DESIGNED BY: M. Miller
JAMAICA SHEET 3

PLOT DATE: 8/6/2009
DRAWN BY: T. Guazzoni
CHECKED BY: T. Guazzoni
SHEET 139 OF 198

DIRECTION	MILEPOINT	LOCATION CODE (SHEET 2)	SIGN CODE	WIDTH (IN)	HEIGHT (IN)	SHEETING REMARKS	SIGN LEGEND	NEW SIGNS "A"	NEW SIGNS "B"	EXISTING SIGNS RETAIN	EXISTING SIGNS SALVAGE FROM	EXISTING SIGNS SALVAGE TO	EXISTING SIGNS REMOVE	EXIST POST RETAIN	EXIST POST REMOVE	NUMBER OF NEW POSTS	SQUARE STEEL (IN) 1.75 (LB / FT) 1.88	SQUARE STEEL (IN) 2.00 (LB / FT) 2.42	SQUARE STEEL (IN) 2.50 (LB / FT) 3.35	TUBULAR STEEL Ø (IN) FOUNDATION	TUBULAR STEEL Ø (IN) 3.00 (LB / FT) 7.60	TUBULAR STEEL Ø (IN) 3.50 (LB / FT) 9.00	TUBULAR STEEL Ø (IN) 4.00 (LB / FT) 10.80	TUBULAR STEEL Ø (IN) 5.00 (LB / FT) 14.60	SIGN FRAME REQUIRED	REMARKS	SIGN DETAIL: DETAIL IN SHS	SIGN DETAIL: DETAIL ON SHEET NUMBER	SIGN DETAIL: DETAIL ON STD SHEET NUMBER
JAMAICA VT 100							FY-FLUORESCENT YELLOW FYG-FLUORESCENT YELLOW GREEN																			"SHS"-STANDARD HIGHWAY SIGNS			
		A	M1-5	24	24		VERMONT 30			1																			
NB	3.482	A	W3-1	36	36		STOP AHEAD SYMBOL			1				X															
NB	3.503	A	D1-1A	72	10		<--- JAMAICA 3			1				X															
		A	D1-1	72	10		<--- STRATTON MTN SKI AREA 10			1																			
		A	D1-1A	72	10		TOWNSEND 6 --->			1																			
		A	D1-1A	72	10		BRATTLEBORO 23 --->			1																			
NB	3.538	A	M3-1S	24	12		NORTH			1				X															
		A	M1-5	24	24		VERMONT 30			1																			
		A	M6-1S	21	15		<--- LEFT			1																			
		A	M3-1S	24	12		NORTH			1																			
		A	M1-5	30	24		VERMONT 100			1																			
		A	M6-1S	21	15		<--- LEFT			1																			
		A	M3-3S	24	12		SOUTH			1																			
		A	M1-5	24	24		VERMONT 30			1																			
		A	M6-1S	21	15		RIGHT --->			1																			
							SHEET TOTALS	0.00	0.00	15	0	0	0	0	0	0	0												
								SF	SF	EA	EA	EA	EA	EA	EA	EA	FT												
							TOWN TOTALS	391.9	0.0	33.0	4.0	4.0	69	0.0	0.0	66	990.0												

SIGN SUMMARY SHEET

VERMONT AGENCY OF TRANSPORTATION

PROJECT NAME: **Stamford-Andover VT100**
PROJECT NUMBER: **STPG SIGN(20)**
FILE NAME: **Jamaica.xls**
PROJECT MANAGER: **N. Avery**
DESIGNED BY: **M. Miller**
JAMAICA SHEET 4
PLOT DATE: **8/6/2009**
DRAWN BY: **T. Guazzoni**
CHECKED BY: **T. Guazzoni**
SHEET **140** OF **198**

DIRECTION	MILEPOINT	LOCATION CODE (SHEET 2)	SIGN CODE	WIDTH (IN)	HEIGHT (IN)	SHEETING REMARKS	SIGN LEGEND	NEW SIGNS "A"	NEW SIGNS "B"	EXISTING SIGNS RETAIN	EXISTING SIGNS SALVAGE FROM	EXISTING SIGNS SALVAGE TO	EXISTING SIGNS REMOVE	EXIST POST RETAIN	EXIST POST REMOVE	NUMBER OF NEW POSTS	SQUARE STEEL (IN) (LB / FT) 1.75 / 1.88	SQUARE STEEL (IN) (LB / FT) 2.00 / 2.42	SQUARE STEEL (IN) (LB / FT) 2.50 / 3.35	TUBULAR STEEL Ø (IN) FOUNDATION	TUBULAR STEEL Ø (IN) (LB / FT) 3.00 / 7.60	TUBULAR STEEL Ø (IN) (LB / FT) 3.50 / 9.00	TUBULAR STEEL Ø (IN) (LB / FT) 4.00 / 10.80	TUBULAR STEEL Ø (IN) (LB / FT) 5.00 / 14.60	SIGN FRAME REQUIRED	REMARKS	SIGN DETAIL: DETAIL IN SHS	SIGN DETAIL: DETAIL ON SHEET NUMBER	SIGN DETAIL: DETAIL ON STD SHEET NUMBER
JAMAICA VT 100							FY-FLUORESCENT YELLOW FYG-FLUORESCENT YELLOW GREEN																			"SHS"-STANDARD HIGHWAY SIGNS			
NB	3.570	A	R1-1	30	30		0300 1309 0068 STOP 1000 1309 0360						1		X													
		A	R1-1	36	36			9.00								2		X								SALVAGE 2 MM ONTO NEW POSTS BACK-TO-BACK	X		
							VT 100 TURNS TO VT 30 FOR 8.146 MILES BEFORE RESUMING																					
SB	3.565	F	M3-3	24	12		SOUTH			1				X														
		F	M1-5	30	24		VERMONT 100			1																		
SB	3.545	F	R2-1	24	30		SPEED LIMIT 40						1		X													
		F	R2-1	24	30			5.00								1		X									X	
SB	3.520	F	D2-1	72	10		WARDSBORO 5			1				X														
		F	D2-1	72	10		WILMINGTON 24			1																		
SB	3.480	F	W2-1	30	30		CROSSROAD SYMBOL			1				X													RETAIN THE PRIMARY SIGN AND POST			
		F	W13-1	18	18		25 MPH (PLAQUE)						1															
SB	3.407	G	VR-017	24	30		LEGAL LOAD LIMIT 24,000 LBS			1				X													RIVER RD (TH-41)			
SB	3.399	H	R1-1	30	30		RIVER RD J-41 STOP 1000 1309 0340			1				X													RIVER RD (TH-41)			
SB	3.275	F	R2-1	24	30		SPEED LIMIT 50			1				X														
SB	2.520	F	W1-2L	30	30		–	6.25								1		X									INSTALL 30 FT ± NORTH OF THE UTILITY POLE; POLE IS JUST NORTH OF THE JCT w/ TH-56 (@ MP 2.495) ON LEFT.	X		
							SHEET TOTALS	20.25 SF	0.00 SF	8 EA	0 EA	0 EA	3 EA	0 EA	0 EA	4 EA		60 FT							
							TOWN TOTALS	391.9	0.0	33.0	4.0	4.0	69	0.0	0.0	66		990.0							

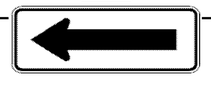
SIGN SUMMARY SHEET

VERMONT AGENCY OF TRANSPORTATION

PROJECT NAME: **Stamford-Andover VT100**
PROJECT NUMBER: **STPG SIGN(20)**

FILE NAME: **Jamaica.xls**
PROJECT MANAGER: **N. Averv**
DESIGNED BY: **M. Miller**
JAMAICA SHEET 5

PLOT DATE: **8/6/2009**
DRAWN BY: **T. Guazzoni**
CHECKED BY: **T. Guazzoni**
SHEET **141** OF **198**

DIRECTION	MILEPOINT	LOCATION CODE (SHEET 2)	SIGN CODE	WIDTH (IN)	HEIGHT (IN)	SHEETING REMARKS	SIGN LEGEND	NEW SIGNS "A"	NEW SIGNS "B"	EXISTING SIGNS RETAIN	EXISTING SIGNS SALVAGE FROM	EXISTING SIGNS SALVAGE TO	EXISTING SIGNS REMOVE	EXIST POST RETAIN	EXIST POST REMOVE	NUMBER OF NEW POSTS	SQUARE STEEL (IN) (LB / FT) 1.75 / 1.88	SQUARE STEEL (IN) (LB / FT) 2.00 / 2.42	SQUARE STEEL (IN) (LB / FT) 2.50 / 3.35	TUBULAR STEEL Ø (IN) FOUNDATION	TUBULAR STEEL Ø (IN) (LB / FT) 3.00 / 7.60	TUBULAR STEEL Ø (IN) (LB / FT) 3.50 / 9.00	TUBULAR STEEL Ø (IN) (LB / FT) 4.00 / 10.80	TUBULAR STEEL Ø (IN) (LB / FT) 5.00 / 14.60	SIGN FRAME REQUIRED	REMARKS	SIGN DETAIL: DETAIL IN SHS	SIGN DETAIL: DETAIL ON SHEET NUMBER	SIGN DETAIL: DETAIL ON STD SHEET NUMBER
JAMAICA VT 100							FY-FLUORESCENT YELLOW FYG-FLUORESCENT YELLOW GREEN																			"SHS"-STANDARD HIGHWAY SIGNS			
SB	2.334	G	VR-017	24	30								1		X											HENDERSON RD J-42B ~~(TH-42)~~			
		G	VR-017	24	30			5.00								1		X										E-141
SB	2.326	H	R1-1	30	30								1		X											HENDERSON RD J-42B ~~(TH-42)~~ SALVAGE STREET SIGN ONTO NEW POST			
		H	R1-1	30	30			6.25								1		X									X	
SB	2.305	F	VW-054	30	30		HIDDEN DRIVE RIGHT						1		X													
SB	2.285	F	OM-3R	12	36								1		X													
		F	OM-3R	12	36			3.00								1		X									X	
SB	2.250	E	OM-3L	12	36								1		X													
		E	OM-3L	12	36			3.00								1		X									X	
SB	2.230	F	VW-054R	30	30	FY		6.25								1		X								INSTALL 10 FT IN ADVANCE OF POLE, 100 FT ± BEYOND THE OBJECT MARKER JUST REPLACED.			E-154
SB	1.940	F	W1-2L	30	30		CURVE LEFT						1		X													
		F	W13-1	18	18		35 MPH (PLAQUE)						1															
SB	1.900	F	W1-2L	30	30	FY		6.25								1		X								INSTALL 210 FT ± SOUTH OF PREVIOUS POSITION.			
		F	W13-1	18	18	FY		2.25																			X	
SB	1.835	F	W1-6	48	24	FY		8.00								2		X								INSTALL 80 FT ± NORTH OF THE EXISTING LEFT ARROW AT M.P. 1.820.	X		
							SHEET TOTALS	40.00 SF	0.00 SF	0 EA	0 EA	0 EA	7 EA	0 EA	0 EA	8 EA		120 FT							
							TOWN TOTALS	391.9	0.0	33.0	4.0	4.0	69	0.0	0.0	66		990.0							

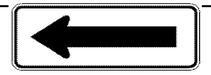
SIGN SUMMARY SHEET

VERMONT AGENCY OF TRANSPORTATION

PROJECT NAME: **Stamford-Andover VT100**
PROJECT NUMBER: **STPG SIGN(20)**

FILE NAME: **Jamaica.xls**
PROJECT MANAGER: **N. Averv**
DESIGNED BY: **M. Miller**
JAMAICA SHEET 6

PLOT DATE: **8/6/2009**
DRAWN BY: **T. Guazzoni**
CHECKED BY: **T. Guazzoni**
SHEET **142** OF **198**

DIRECTION	MILEPOINT	LOCATION CODE (SHEET 2)	SIGN CODE	WIDTH (IN)	HEIGHT (IN)	SHEETING REMARKS	SIGN LEGEND	NEW SIGNS "A"	NEW SIGNS "B"	EXISTING SIGNS RETAIN	EXISTING SIGNS SALVAGE FROM	EXISTING SIGNS SALVAGE TO	EXISTING SIGNS REMOVE	EXIST POST RETAIN	EXIST POST REMOVE	NUMBER OF NEW POSTS	SQUARE STEEL (IN) 1.75 (LB/FT) 1.88	SQUARE STEEL (IN) 2.00 (LB/FT) 2.42	SQUARE STEEL (IN) 2.50 (LB/FT) 3.35	TUBULAR STEEL Ø (IN) FOUNDATION	TUBULAR STEEL Ø (IN) 3.00 (LB/FT) 7.60	TUBULAR STEEL Ø (IN) 3.50 (LB/FT) 9.00	TUBULAR STEEL Ø (IN) 4.00 (LB/FT) 10.80	TUBULAR STEEL Ø (IN) 5.00 (LB/FT) 14.60	SIGN FRAME REQUIRED	REMARKS	SIGN DETAIL: DETAIL IN SHS	SIGN DETAIL: DETAIL ON SHEET NUMBER	SIGN DETAIL: DETAIL ON STD SHEET NUMBER
JAMAICA VT 100							FY-FLUORESCENT YELLOW FYG-FLUORESCENT YELLOW GREEN																			"SHS"-STANDARD HIGHWAY SIGNS			
SB	1.834	E	W1-6	48	24	FY		8.00								2		X								INSTALL 5 FT ± SOUTH OF THE SB-FACING ARROW. THIS ARROW FACES NB TRAFFIC, IN THE SB LANE. FY SHEETING.	X		
SB	1.820	F	W1-6	48	24		<=== LARGE ARROW						1		X														
SB	1.801	F	W1-6	48	24	FY	1000 1309 0180 	8.00								2		X			SALVAGE MM ONTO NEW POST						INSTALL 5 FT ± NORTH OF THE EXISTING RIGHT ARROW AT M.P. 1.800.	X		
SB	1.800	E	W1-6	48	24						I		1		X														
		E	W1-6	48	24	FY		8.00								2		X									FACES NB TRAFFIC	X		
SB	1.382	F	W1-2R	30	30								1		X														
		F	W1-2R	30	30	FY		6.25								1		X									ASSURE 10 FT MIN TO UTILITY POLE.	X		
SB	1.233	F	W1-4L	30	30		LEFT REVERSE CURVE 						1		X														
		F	W1-3L	30	30	FY		6.25								1		X										X		
		F	W13-1	18	18	FY		2.25																				X		
NEW SIGN SEE SHEET I49																													
SB	0.727	F	W1-1~~R~~L	30	30		LEFT TURN						1		X														
		F	W13-1	18	18		25 MPH (PLAQUE) 						1																
SB	0.680	F	W1-1~~R~~L	30	30	FY		6.25								1		X									INSTALL 250 FT ± SOUTH OF PREVIOUS POSITION.	X		
		F	W13-1	18	18	FY		2.25																				X		
SB	0.604	F	W1-6	48	24								1		X														
SIGN SUMMARY SHEET							SHEET TOTALS	47.25	0.00	0	0	0	7	0	0	9		135										
VERMONT AGENCY OF TRANSPORTATION								SF	SF	EA	EA	EA	EA	EA	EA	EA		FT										
							TOWN TOTALS	391.9	0.0	33.0	4.0	4.0	69	0.0	0.0	66		990.0										

PROJECT NAME: **Stamford-Andover VT100**
PROJECT NUMBER: **STPG SIGN(20)**
FILE NAME: **Jamaica.xls**
PROJECT MANAGER: **N. Avery**
DESIGNED BY: **M. Miller**
JAMAICA SHEET 7
PLOT DATE: **8/6/2009**
DRAWN BY: **T. Guazzoni**
CHECKED BY: **T. Guazzoni**
SHEET **143** OF **198**

DIRECTION	MILEPOINT	LOCATION CODE (SHEET 2)	SIGN CODE	WIDTH (IN)	HEIGHT (IN)	SHEETING REMARKS	SIGN LEGEND	NEW SIGNS "A"	NEW SIGNS "B"	EXISTING SIGNS RETAIN	EXISTING SIGNS SALVAGE FROM	EXISTING SIGNS SALVAGE TO	EXISTING SIGNS REMOVE	EXIST POST RETAIN	EXIST POST REMOVE	NUMBER OF NEW POSTS	SQUARE STEEL (IN) 1.75 (LB / FT) 1.88	SQUARE STEEL (IN) 2.00 (LB / FT) 2.42	SQUARE STEEL (IN) 2.50 (LB / FT) 3.35	TUBULAR STEEL Ø (IN) FOUNDATION	TUBULAR STEEL Ø (IN) 3.00 (LB / FT) 7.60	TUBULAR STEEL Ø (IN) 3.50 (LB / FT) 9.00	TUBULAR STEEL Ø (IN) 4.00 (LB / FT) 10.80	TUBULAR STEEL Ø (IN) 5.00 (LB / FT) 14.60	SIGN FRAME REQUIRED	REMARKS	SIGN DETAIL: DETAIL IN SHS	SIGN DETAIL: DETAIL ON SHEET NUMBER	SIGN DETAIL: DETAIL ON STD SHEET NUMBER
JAMAICA VT 100							FY-FLUORESCENT YELLOW FYG-FLUORESCENT YELLOW GREEN																			"SHS"-STANDARD HIGHWAY SIGNS			
		F	W1-6	48	24	FY		8.00								2		X									X		
SB	0.603	E	W1-6	48	24						MISSING		~~1~~		X														
		E	W1-6	48	24	FY		8.00								2		X									X		
SB	0.587	F	W1-6	48	24								1		X														
		F	W1-6	48	24	FY		8.00																			X		
SB	0.586	E	W1-6	48	24								1		X														
		E	W1-6	48	24	FY		8.00								2		X									X		
SB	0.325	F	VW-060	30	30																								
		F	VW-060	30	30	FY		6.25								1		X										E-154
SB	0.032	F	W3-5	36	36		SPEED REDUCTION 40 MPH AHEAD			1				X															
			VT 100 RESUMES																										
NB	3.600	B	R1-1	30	30		STOP 1000 1309 0360						1		X														
NB	3.630	A	M3-1S	24	12								1		X															
		A	M1-5	30	24								1																
		A	M3-1	24	12			2.00								1		X									GREEN ON WHITE SHEETING	X		
SIGN SUMMARY SHEET							SHEET TOTALS	40.25 SF	0.00 SF	1 EA	0 EA	0 EA	6 EA	0 EA	0 EA	8 EA		120 FT										
VERMONT AGENCY OF TRANSPORTATION							TOWN TOTALS	391.9	0.0	33.0	4.0	4.0	69	0.0	0.0	66		990.0										

PROJECT NAME: **Stamford-Andover VT100**
PROJECT NUMBER: **STPG SIGN(20)**

FILE NAME: **Jamaica.xls**
PROJECT MANAGER: **N. Averv**
DESIGNED BY: **M. Miller**
JAMAICA SHEET 8

PLOT DATE: **8/6/2009**
DRAWN BY: **T. Guazzoni**
CHECKED BY: **T. Guazzoni**
SHEET **144** OF **198**

DIRECTION	MILEPOINT	LOCATION CODE (SHEET 2)	SIGN CODE	WIDTH (IN)	HEIGHT (IN)	SHEETING REMARKS	SIGN LEGEND	NEW SIGNS "A"	NEW SIGNS "B"	EXISTING SIGNS RETAIN	EXISTING SIGNS SALVAGE FROM	EXISTING SIGNS SALVAGE TO	EXISTING SIGNS REMOVE	EXIST POST RETAIN	EXIST POST REMOVE	NUMBER OF NEW POSTS	SQUARE STEEL (IN) 1.75 (LB / FT) 1.88	SQUARE STEEL (IN) 2.00 (LB / FT) 2.42	SQUARE STEEL (IN) 2.50 (LB / FT) 3.35	TUBULAR STEEL Ø (IN) FOUNDATION	TUBULAR STEEL Ø (IN) 3.00 (LB / FT) 7.60	TUBULAR STEEL Ø (IN) 3.50 (LB / FT) 9.00	TUBULAR STEEL Ø (IN) 4.00 (LB / FT) 10.80	TUBULAR STEEL Ø (IN) 5.00 (LB / FT) 14.60	SIGN FRAME REQUIRED	REMARKS	SIGN DETAIL: DETAIL IN SHS	SIGN DETAIL: DETAIL ON SHEET NUMBER	SIGN DETAIL: DETAIL ON STD SHEET NUMBER
JAMAICA VT 100							FY-FLUORESCENT YELLOW FYG-FLUORESCENT YELLOW GREEN																			"SHS"-STANDARD HIGHWAY SIGNS			
		A	M1-5	30	24			5.00																					E-136B
NB	3.663	A	W1-4R	30	30		REVERSE CURVE RIGHT						1		X														
NB	3.687	A	VD-062B	72	16		BUSINESS SIGN			1				X															
NB	3.735	A	S3-1	30	30								1		X														
		A	S3-1	30	30			6.25								1		X										X	
NB	3.813	A	VS3-4A	30	30		SCHOOL BUS TURN AROUND AHEAD				~~1~~	~~1~~			~~X~~	~~1~~		~~X~~									SIGN PREVIOUSLY MOVED TO MM NB IN JAMAICA 2.140 RT.			
NB	3.935	A	R2-1	24	30			5.00								1		X									INSTALL BEHIND RAIL 25 FT ± IN ADVANCE OF THE EXISTING SIGN, TO BE REMOVED.	X		
NB	3.940	A	R2-1	24	30		SPEED LIMIT 50						1		X														
NB	4.300	A	W1-2L	30	30		CURVE LEFT						1		X														
NB	4.345	A	VW-054	30	30		HIDDEN DRIVE LEFT 						1		X														
		A	W1-2L	30	30			6.25								1		X										X	
NB	4.375	A	VW-054	30	30	FY		6.25								1		X									INSTALL 160 FT ± NORTH OF THE PREVIOUS LOCATION.			E-154
NB	4.490	A	W11-7	30	30		EQUESTRIAN SYMBOL						1		X														
SB	4.255	F	W1-4R	30	30		REVERSE CURVE RIGHT w/ MINOR SIDE RD RIGHT						1		X														
		F	W13-1	18	18		45 MPH (PLAQUE) 1000 1309 0423						1																
							SHEET TOTALS	28.75	0.00	1	~~0~~ 1	~~0~~ 1	8	0	0	5		75										
								SF	SF	EA	EA	EA	EA	EA	EA	EA		FT										
							TOWN TOTALS	391.9	0.0	33.0	4.0	4.0	69	0.0	0.0	66		990.0										

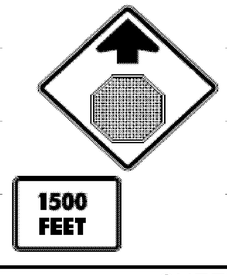
SIGN SUMMARY SHEET

VERMONT AGENCY OF TRANSPORTATION

PROJECT NAME: **Stamford-Andover VT100**
PROJECT NUMBER: **STPG SIGN(20)**

FILE NAME: **Jamaica.xls**
PROJECT MANAGER: **N. Averv**
DESIGNED BY: **M. Miller**
JAMAICA SHEET 9

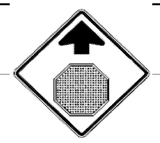
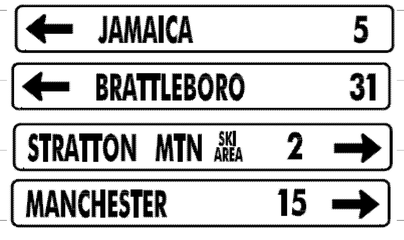
PLOT DATE: **8/6/2009**
DRAWN BY: **T. Guazzoni**
CHECKED BY: **T. Guazzoni**
SHEET **145** OF **198**

DIRECTION	MILEPOINT	LOCATION CODE (SHEET 2)	SIGN CODE	WIDTH (IN)	HEIGHT (IN)	SHEETING REMARKS	SIGN LEGEND	NEW SIGNS "A"	NEW SIGNS "B"	EXISTING SIGNS RETAIN	EXISTING SIGNS SALVAGE FROM	EXISTING SIGNS SALVAGE TO	EXISTING SIGNS REMOVE	EXIST POST RETAIN	EXIST POST REMOVE	NUMBER OF NEW POSTS	SQUARE STEEL (IN) 1.75 (LB / FT) 1.88	SQUARE STEEL (IN) 2.00 (LB / FT) 2.42	SQUARE STEEL (IN) 2.50 (LB / FT) 3.35	FOUNDATION	TUBULAR STEEL Ø (IN) 3.00 (LB / FT) 7.60	TUBULAR STEEL Ø (IN) 3.50 (LB / FT) 9.00	TUBULAR STEEL Ø (IN) 4.00 (LB / FT) 10.80	TUBULAR STEEL Ø (IN) 5.00 (LB / FT) 14.60	SIGN FRAME REQUIRED	REMARKS	SIGN DETAIL: DETAIL IN SHS	SIGN DETAIL: DETAIL ON SHEET NUMBER	SIGN DETAIL: DETAIL ON STD SHEET NUMBER
JAMAICA VT 100							FY-FLUORESCENT YELLOW FYG-FLUORESCENT YELLOW GREEN																				"SHS"-STANDARD HIGHWAY SIGNS			
SB	4.072	F	S3-1	30	30								1		X														
		F	S3-1	30	30			6.25								1		X									X		
SB	4.007	F	VS3-4A	30	30		SCHOOL BUS TURN AROUND AHEAD				~~1~~	~~1~~			~~X~~	~~1~~		~~X~~								NO WORK DONE - SIGN PREVIOUSLY MOVED TO MM SB IN JAMAICA 2.330 RT			
SB	3.896	G	VR-017	24	30								1		X													MILL BROOK RD (TH-62)			
		G	VR-017	24	30			5.00								1		X											E-141
SB	3.890	H	R1-1	30	30								1		X													MILL BROOK RD (TH-62)			
		H	R1-1	30	30			6.25								1		X									X		
SB	3.888	G	VR-017	24	30								1		X													COLEMAN HILLS RD (TH-6)			
		G	VR-017	24	30			5.00								1		X											E-141
SB	3.882	H	R1-1	30	30								1		X													COLEMAN HILLS RD (TH-6)			
		H	R1-1	30	30			6.25								1		X									X		
SB	3.880	F	W3-1	36	36								1		X																
		F	W16-2	24	18								1																	
		F	W3-1	36	36			9.00								2		X									X		
		F	W16-2	24	18			3.00																			INSTALL PLAQUE ON LEFT-SIDE POST	X		
SIGN SUMMARY SHEET							SHEET TOTALS	40.75	0.00	0	~~0~~ 1	~~0~~ 1	7	0	0	~~7~~ 8		120										
VERMONT AGENCY OF TRANSPORTATION								SF	SF	EA	EA	EA	EA	EA	EA	EA		FT										
							TOWN TOTALS	391.9	0.0	33.0	4.0	4.0	69	0.0	0.0	66		990.0										

PROJECT NAME: **Stamford-Andover VT100**
PROJECT NUMBER: **STPG SIGN(20)**

FILE NAME: **Jamaica.xls**
PROJECT MANAGER: **N. Averv**
DESIGNED BY: **M. Miller**
JAMAICA SHEET 10

PLOT DATE: **8/6/2009**
DRAWN BY: **T. Guazzoni**
CHECKED BY: **T. Guazzoni**
SHEET **146** OF **198**

DIRECTION	MILEPOINT	LOCATION CODE (SHEET 2)	SIGN CODE	WIDTH (IN)	HEIGHT (IN)	SHEETING REMARKS	SIGN LEGEND	NEW SIGNS "A"	NEW SIGNS "B"	EXISTING SIGNS RETAIN	EXISTING SIGNS SALVAGE FROM	EXISTING SIGNS SALVAGE TO	EXISTING SIGNS REMOVE	EXIST POST RETAIN	EXIST POST REMOVE	NUMBER OF NEW POSTS	SQUARE STEEL (IN) 1.75 (LB / FT) 1.88	SQUARE STEEL (IN) 2.00 (LB / FT) 2.42	SQUARE STEEL (IN) 2.50 (LB / FT) 3.35	FOUNDATION	TUBULAR STEEL Ø (IN) 3.00 (LB / FT) 7.60	TUBULAR STEEL Ø (IN) 3.50 (LB / FT) 9.00	TUBULAR STEEL Ø (IN) 4.00 (LB / FT) 10.80	TUBULAR STEEL Ø (IN) 5.00 (LB / FT) 14.60	SIGN FRAME REQUIRED	REMARKS	SIGN DETAIL: DETAIL IN SHS	SIGN DETAIL: DETAIL ON SHEET NUMBER	SIGN DETAIL: DETAIL ON STD SHEET NUMBER
JAMAICA VT 100							FY-FLUORESCENT YELLOW FYG-FLUORESCENT YELLOW GREEN																			"SHS"-STANDARD HIGHWAY SIGNS			
SB	3.845	F	VD-062B	72	16		BUSINESS SIGN			1				X														
SB	3.770	F	W3-1	36	36								1		X													
		F	W3-1	36	36			9.00								2		X									X	
SB	3.732	F	M2-1	21	15								1		X													
		F	M1-5	24	24								1															
		F	M2-1	21	15			2.19								1		X								GREEN ON WHITE SHEETING	X		
		F	M1-5	24	24			4.00																				E-136B
SB	3.695	F	D1-1A	72	10								1		X													
		F	D1-1A	72	10								1															
		F	D1-1S	72	10								1															
		F	D1-1A	72	10								1															
		F	D1-1A	72	12			6.00								2			X								5	
		F	D1-1A	72	12			6.00																			5	
		F	D1-1	72	12			6.00																			5	
		F	D1-1A	72	12			6.00																			5	

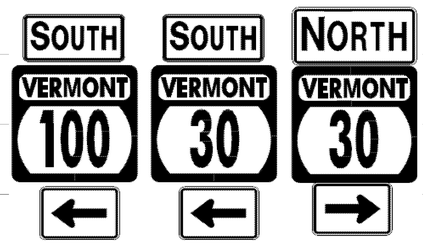
SIGN SUMMARY SHEET

VERMONT AGENCY OF TRANSPORTATION

	NEW SIGNS "A"	NEW SIGNS "B"	EXISTING SIGNS RETAIN	EXISTING SIGNS SALVAGE FROM	EXISTING SIGNS SALVAGE TO	EXISTING SIGNS REMOVE	EXIST POST RETAIN	EXIST POST REMOVE	NUMBER OF NEW POSTS	SQUARE STEEL (IN)	TUBULAR STEEL Ø (IN)
SHEET TOTALS	39.19	0.00	1	0	0	7	0	0	5	75	
	SF	SF	EA	EA	EA	EA	EA	EA	EA	FT	
TOWN TOTALS	391.9	0.0	33.0	4.0	4.0	69	0.0	0.0	66	990.0	

PROJECT NAME: **Stamford-Andover VT100**
PROJECT NUMBER: **STPG SIGN(20)**

FILE NAME: **Jamaica.xls** PLOT DATE: **8/6/2009**
PROJECT MANAGER: **N. Averv** DRAWN BY: **T. Guazzoni**
DESIGNED BY: **M. Miller** CHECKED BY: **T. Guazzoni**
JAMAICA SHEET 11 SHEET **147** OF **198**

DIRECTION	MILEPOINT	LOCATION CODE (SHEET 2)	SIGN CODE	WIDTH (IN)	HEIGHT (IN)	SHEETING REMARKS	SIGN LEGEND	NEW SIGNS "A"	NEW SIGNS "B"	EXISTING SIGNS RETAIN	EXISTING SIGNS SALVAGE FROM	EXISTING SIGNS SALVAGE TO	EXISTING SIGNS REMOVE	EXIST POST RETAIN	EXIST POST REMOVE	NUMBER OF NEW POSTS	SQUARE STEEL (IN) 1.75 (LB / FT) 1.88	SQUARE STEEL (IN) 2.00 (LB / FT) 2.42	SQUARE STEEL (IN) 2.50 (LB / FT) 3.35	TUBULAR STEEL Ø (IN) FOUNDATION	TUBULAR STEEL Ø (IN) 3.00 (LB / FT) 7.60	TUBULAR STEEL Ø (IN) 3.50 (LB / FT) 9.00	TUBULAR STEEL Ø (IN) 4.00 (LB / FT) 10.80	TUBULAR STEEL Ø (IN) 5.00 (LB / FT) 14.60	SIGN FRAME REQUIRED	REMARKS	SIGN DETAIL: DETAIL IN SHS	SIGN DETAIL: DETAIL ON SHEET NUMBER	SIGN DETAIL: DETAIL ON STD SHEET NUMBER
JAMAICA VT 100							FY-FLUORESCENT YELLOW FYG-FLUORESCENT YELLOW GREEN																			"SHS"-STANDARD HIGHWAY SIGNS			
SB	3.645	F	M3-3S	24	12								1	X														
		F	M1-5	30	24								1															
		F	M6-1	21	15								1															
		F	M3-3S	24	12								1															
		F	M1-5	24	24								1															
		F	M6-1S	21	15								1															
		F	M3-1S	24	12								1															
		F	M1-5	24	24								1															
		F	M6-1S	21	15								1															
		F	M3-3	24	12			2.00																	#3A	GREEN ON WHITE SHEETING	X	7	
		F	M1-5	30	24			5.00																		INSTALL THE NEW SIGNS ON A NEW SIGN FRAME; RETAIN THE EXISTING TUBULAR POSTS.			E-136B
		F	M6-1L	21	15			2.19																	GREEN ON WHITE SHEETING	X		
		F	M3-3	24	12			2.00																		GREEN ON WHITE SHEETING	X		
		F	M1-5	24	24			4.00																					E-136B
		F	M6-1L	21	15			2.19																		GREEN ON WHITE SHEETING	X		
							SHEET TOTALS	17.38 SF	0.00 SF	0 EA	0 EA	0 EA	9 EA	0 EA	0 EA	0 EA	0 FT								
							TOWN TOTALS	391.9	0.0	33.0	4.0	4.0	69	0.0	0.0	66	990.0								

SIGN SUMMARY SHEET

VERMONT AGENCY OF TRANSPORTATION

PROJECT NAME: **Stamford-Andover VT100**
PROJECT NUMBER: **STPG SIGN(20)**

FILE NAME: **Jamaica.xls**
PROJECT MANAGER: **N. Avery**
DESIGNED BY: **M. Miller**
JAMAICA SHEET 12

PLOT DATE: **8/6/2009**
DRAWN BY: **T. Guazzoni**
CHECKED BY: **T. Guazzoni**
SHEET **148** OF **198**

DIRECTION	MILEPOINT	LOCATION CODE (SHEET 2)	SIGN CODE	WIDTH (IN)	HEIGHT (IN)	SHEETING REMARKS	SIGN LEGEND	NEW SIGNS "A"	NEW SIGNS "B"	EXISTING SIGNS RETAIN	EXISTING SIGNS SALVAGE FROM	EXISTING SIGNS SALVAGE TO	EXISTING SIGNS REMOVE	EXIST POST RETAIN	EXIST POST REMOVE	NUMBER OF NEW POSTS	SQUARE STEEL (IN) 1.75 (LB / FT) 1.88	SQUARE STEEL (IN) 2.00 (LB / FT) 2.42	SQUARE STEEL (IN) 2.50 (LB / FT) 3.35	TUBULAR STEEL Ø (IN) FOUNDATION	TUBULAR STEEL Ø (IN) 3.00 (LB / FT) 7.60	TUBULAR STEEL Ø (IN) 3.50 (LB / FT) 9.00	TUBULAR STEEL Ø (IN) 4.00 (LB / FT) 10.80	TUBULAR STEEL Ø (IN) 5.00 (LB / FT) 14.60	SIGN FRAME REQUIRED	REMARKS	SIGN DETAIL: DETAIL IN SHS	SIGN DETAIL: DETAIL ON SHEET NUMBER	SIGN DETAIL: DETAIL ON STD SHEET NUMBER
JAMAICA VT 100							FY-FLUORESCENT YELLOW FYG-FLUORESCENT YELLOW GREEN																			"SHS"-STANDARD HIGHWAY SIGNS			
		F	M3-1	24	12			2.00																		GREEN ON WHITE SHEETING	X		
		F	M1-5	24	24			4.00																					E-136B
		F	M6-1R	21	15			2.19																		GREEN ON WHITE SHEETING	X		
SB	3.600	F	R1-1	30	30								1		X														
		F	R1-1	36	36			9.00								2		X									X		
SB	1.182	F	W1-6	48	24			8.00								2		X								NEW SIGN ADDED TO PLANS PER REQUEST OF M. MILLER, TRAFFIC OPS.			
NB	0.300	F	W-619	36	36					X				X												SIGN RETAINED			

DIRECTION	MILEPOINT	LOCATION CODE (SHEET 2)	SIGN CODE	WIDTH (IN)	HEIGHT (IN)	SHEETING REMARKS	SIGN LEGEND	NEW SIGNS "A"	NEW SIGNS "B"	EXISTING SIGNS RETAIN	EXISTING SIGNS SALVAGE FROM	EXISTING SIGNS SALVAGE TO	EXISTING SIGNS REMOVE	EXIST POST RETAIN	EXIST POST REMOVE	NUMBER OF NEW POSTS	SQUARE STEEL (IN) 1.75 (LB / FT) 1.88	SQUARE STEEL (IN) 2.00 (LB / FT) 2.42	SQUARE STEEL (IN) 2.50 (LB / FT) 3.35	TUBULAR STEEL Ø (IN) FOUNDATION	TUBULAR STEEL Ø (IN) 3.00 (LB / FT) 7.60	TUBULAR STEEL Ø (IN) 3.50 (LB / FT) 9.00	TUBULAR STEEL Ø (IN) 4.00 (LB / FT) 10.80	TUBULAR STEEL Ø (IN) 5.00 (LB / FT) 14.60	SIGN FRAME REQUIRED	REMARKS	SIGN DETAIL: DETAIL IN SHS	SIGN DETAIL: DETAIL ON SHEET NUMBER	SIGN DETAIL: DETAIL ON STD SHEET NUMBER
LONDONDERRY VT 100							FY-FLUORESCENT YELLOW FYG-FLUORESCENT YELLOW GREEN																			"SHS"-STANDARD HIGHWAY SIGNS			
NB	0.477	A	W7-1	30	30		HILL SYMBOL 						1		X													
		A	W7-1b	30	30			6.25								1		X								X		
NB	0.812	A	W1-10R	30	30		RIGHT CURVE WITH LH SIDE ROAD						1		X													
		A	W16-8	24	12		SPRING HILL RD						1															
NB	0.900	A	W1-10R	30	30			6.25								1		X							INSTALL 450 FEET NORTH OF EXISTING ASSEMBLY.	X		
		A	W16-8	30	8			1.67																			8	
NB	1.010	A	W1-2L	30	30		LEFT CURVE						1		X													
NB	1.130	A	W1-2L	30	30			6.25								1		X							INSTALL 625 FEET NORTH OF EXISTING LEFT CURVE SIGN	X		
NB	1.320	A	VD-062AS	72	16		BUSINESS SIGN			1				X											WINHALL BROOK CG			
NB	1.392	C	VR-017	24	30								1		X											TH-46, WINHALL STATION RD			
		C	VR-017	24	30			5.00								1		X										E-141
NB	1.397	D	R1-1	30	30		 						1		X											TH-46, WINHALL STATION RD			
		D	R1-1	30	30			6.25								1		X								X		
NB	1.730	A	W2-1L	30	30		LEFT/RIGHT SEPARATED SIDE ROADS						1		X													
SIGN SUMMARY SHEET							SHEET TOTALS	31.67 SF	0.00 SF	1 EA	0 EA	0 EA	7 EA	0 EA	0 EA	5 EA		75 FT									
VERMONT AGENCY OF TRANSPORTATION							TOWN TOTALS	729.7	0.0	22.0	4.0	4.0	151	0.0	0.0	118		1770.0									

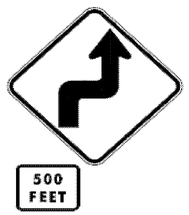
PROJECT NAME: **Stamford-Andover VT100**
PROJECT NUMBER: **STPG SIGN(20)**

FILE NAME: **Londonderrv.xls** PLOT DATE: **8/6/2009**
PROJECT MANAGER: **N. Averv** DRAWN BY: **T. Guazzoni**
DESIGNED BY: **J. Kelly** CHECKED BY: **T. Guazzoni**
LONDONDERRY SHEET 1 SHEET **150** OF **198**

DIRECTION	MILEPOINT	LOCATION CODE (SHEET 2)	SIGN CODE	WIDTH (IN)	HEIGHT (IN)	SHEETING REMARKS	SIGN LEGEND	NEW SIGNS "A"	NEW SIGNS "B"	EXISTING SIGNS RETAIN	EXISTING SIGNS SALVAGE FROM	EXISTING SIGNS SALVAGE TO	EXISTING SIGNS REMOVE	EXIST POST RETAIN	EXIST POST REMOVE	NUMBER OF NEW POSTS	SQUARE STEEL (IN) 1.75 (LB / FT) 1.88	SQUARE STEEL (IN) 2.00 (LB / FT) 2.42	SQUARE STEEL (IN) 2.50 (LB / FT) 3.35	TUBULAR STEEL Ø (IN) FOUNDATION	TUBULAR STEEL Ø (IN) 3.00 (LB / FT) 7.60	TUBULAR STEEL Ø (IN) 3.50 (LB / FT) 9.00	TUBULAR STEEL Ø (IN) 4.00 (LB / FT) 10.80	TUBULAR STEEL Ø (IN) 5.00 (LB / FT) 14.60	SIGN FRAME REQUIRED	REMARKS	SIGN DETAIL: DETAIL IN SHS	SIGN DETAIL: DETAIL ON SHEET NUMBER	SIGN DETAIL: DETAIL ON STD SHEET NUMBER
LONDONDERRY VT 100							FY-FLUORESCENT YELLOW FYG-FLUORESCENT YELLOW GREEN																			"SHS"-STANDARD HIGHWAY SIGNS			
NB	1.750	A	W2-2MaL	30	30			6.25								1		X								INSTALL 400 FEET SOUTH OF INTERSECTION		6	
		A	W16-8	30	8			1.67																				8	
NB	2.070	A	W7-1	30	30								1		X														
		A	W7-1b	30	30			6.25								1		X									X	
NB	2.155	A	VD-062AS	72	16		BUSINESS SIGN			1				X														
		A	VD-062B	72	16		BUSINESS SIGN			1																		
		A	VD-062AS	72	16		BUSINESS SIGN			1																		
NB	2.454	C	VR-017	24	30								1		X												TH-49, WINDY RISE LANE EAST			
		C	VR-017	24	30			5.00								1		X										E-141
NB	2.459	D	R1-1	30	30		 1000 1310 0247						1		X												TH-49, WINDY RISE LANE EAST			
		D	R1-1	30	30			6.25								1		X									X	
NB	2.657	A	W1-3R	48	48		RIGHT REVERSE TURN						1		X														
		A	W16-2	24	18		1400 FEET						1																
NB	2.690	A	W3-5	36	36		SPEED REDUCTION (30) SIGN RETAINED			1				X												SEE SEPARATE ENVELOPE FOR SIGN CHANGES IN THIS TOWN			
NB	2.755	A	VD-018	30	18								1		X														
SIGN SUMMARY SHEET							SHEET TOTALS	25.42	0.00	4	0	0	6	0	0	4		60										
								SF	SF	EA	EA	EA	EA	EA	EA	EA		FT										
VERMONT AGENCY OF TRANSPORTATION							TOWN TOTALS	729.7	0.0	22.0	4.0	4.0	151	0.0	0.0	118		1770.0										

PROJECT NAME: **Stamford-Andover VT100**
PROJECT NUMBER: **STPG SIGN(20)**

FILE NAME: **Londonderrv.xls** PLOT DATE: **8/6/2009**
PROJECT MANAGER: **N. Averv** DRAWN BY: **T. Guazzoni**
DESIGNED BY: **J. Kelly** CHECKED BY: **T. Guazzoni**
LONDONDERRY SHEET 2 SHEET **151** OF **198**

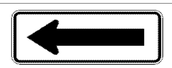
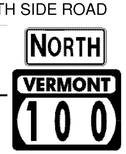
DIRECTION	MILEPOINT	LOCATION CODE (SHEET 2)	SIGN CODE	WIDTH (IN)	HEIGHT (IN)	SHEETING REMARKS	SIGN LEGEND	NEW SIGNS "A"	NEW SIGNS "B"	EXISTING SIGNS RETAIN	EXISTING SIGNS SALVAGE FROM	EXISTING SIGNS SALVAGE TO	EXISTING SIGNS REMOVE	EXIST POST RETAIN	EXIST POST REMOVE	NUMBER OF NEW POSTS	SQUARE STEEL (IN) 1.75 (LB / FT) 1.88	SQUARE STEEL (IN) 2.00 (LB / FT) 2.42	SQUARE STEEL (IN) 2.50 (LB / FT) 3.35	TUBULAR STEEL Ø (IN) FOUNDATION	TUBULAR STEEL Ø (IN) 3.00 (LB / FT) 7.60	TUBULAR STEEL Ø (IN) 3.50 (LB / FT) 9.00	TUBULAR STEEL Ø (IN) 4.00 (LB / FT) 10.80	TUBULAR STEEL Ø (IN) 5.00 (LB / FT) 14.60	SIGN FRAME REQUIRED	REMARKS	SIGN DETAIL: DETAIL IN SHS	SIGN DETAIL: DETAIL ON SHEET NUMBER	SIGN DETAIL: DETAIL ON STD SHEET NUMBER
LONDONDERRY VT 100							FY-FLUORESCENT YELLOW FYG-FLUORESCENT YELLOW GREEN																			"SHS"-STANDARD HIGHWAY SIGNS			
		A	VD-018	30	18			3.75								1		X									E-128A
NB	2.795	A	W1-3R	48	48								1		X													
		A	W13-1	24	24		20 MPH PLAQUE 						1															
		A	W1-3R	36	36	FY		9.00								2		X									X	
		A	W16-2	24	18	FY		3.00																			INSTALL ON LEFT POST	X	
NB	~~2.846~~ 2.890	A	R2-1	~~24~~ 30	~~30~~ 36		SPEED LIMIT 30 																			SIGN ALREADY INSTALLED. SEE SIGN CHANGE NOTE ON SHEET #151			
~~NB~~	~~2.875~~	~~A~~	~~R2-1~~	~~30~~	~~36~~			~~7.50~~								~~1~~		~~X~~							SEE NOTE ABOVE		~~INSTALL150 FEET NORTH OF EXISTING SPEED LIMIT 30 SIGN, NORTH OF TH-27.~~		6
NB	2.910	A	W1-3R	30	30	FY		6.25								1		X									INSTALL 80 FEET SOUTH OF END OF GUARDRAIL.	X	
		A	W13-1	18	18	FY		2.25																				X	
		C	VR-017	24	30		LEGAL LOAD LIMIT 24,000 POUNDS	5.00					I			1		X									TH-48, W RIVER ST			E-141
NB	2.952	D	R1-1	30	30								1		X												TH-48, W RIVER ST			
		D	R1-1	30	30		1000 1310 0294	6.25								1		X										X	
NB	2.953	A	D1-1A	72	10		<--- LONDONDERRY 3						1		X														
NB	2.983	A	M3-1S	24	12								1		X														
		A	M1-5	30	24								1																
SIGN SUMMARY SHEET							SHEET TOTALS	~~43.00~~ 35.50 SF	0.00 SF	0 EA	0 EA	0 EA	~~6~~ 7 EA	0 EA	0 EA	7 EA		105 FT											
VERMONT AGENCY OF TRANSPORTATION							TOWN TOTALS	729.7	0.0	22.0	4.0	4.0	151	0.0	0.0	118		1770.0										

PROJECT NAME: **Stamford-Andover VT100**
PROJECT NUMBER: **STPG SIGN(20)**

FILE NAME: **Londonderrv.xls** PLOT DATE: **8/6/2009**
PROJECT MANAGER: **N. Averv** DRAWN BY: **T. Guazzoni**
DESIGNED BY: **J. Kelly** CHECKED BY: **T. Guazzoni**
LONDONDERRY SHEET 3 SHEET **152** OF **198**

DIRECTION	MILEPOINT	LOCATION CODE (SHEET 2)	SIGN CODE	WIDTH (IN)	HEIGHT (IN)	SHEETING REMARKS	SIGN LEGEND	NEW SIGNS "A"	NEW SIGNS "B"	EXISTING SIGNS RETAIN	EXISTING SIGNS SALVAGE FROM	EXISTING SIGNS SALVAGE TO	EXISTING SIGNS REMOVE	EXIST POST RETAIN	EXIST POST REMOVE	NUMBER OF NEW POSTS	SQUARE STEEL (IN) 1.75 (LB / FT) 1.88	SQUARE STEEL (IN) 2.00 (LB / FT) 2.42	SQUARE STEEL (IN) 2.50 (LB / FT) 3.35	TUBULAR STEEL Ø (IN) FOUNDATION	TUBULAR STEEL Ø (IN) 3.00 (LB / FT) 7.60	TUBULAR STEEL Ø (IN) 3.50 (LB / FT) 9.00	TUBULAR STEEL Ø (IN) 4.00 (LB / FT) 10.80	TUBULAR STEEL Ø (IN) 5.00 (LB / FT) 14.60	SIGN FRAME REQUIRED	REMARKS	SIGN DETAIL: DETAIL IN SHS	SIGN DETAIL: DETAIL ON SHEET NUMBER	SIGN DETAIL: DETAIL ON STD SHEET NUMBER
LONDONDERRY VT 100							FY-FLUORESCENT YELLOW FYG-FLUORESCENT YELLOW GREEN																			"SHS"-STANDARD HIGHWAY SIGNS			
		A	M6-1S	21	15								1															
		A	M3-1	24	12			2.00								1		X								GREEN ON WHITE SHEETING	X		
		A	M1-5	30	24			5.00																				E-136B
		A	M6-1L	21	15			2.19																		GREEN ON WHITE SHEETING	X		
		B	M3-3S	24	12		NORTH 1000 1310 0298						1															
		B	M1-5	30	24		VERMONT 100						1															
		B	M6-3S	21	15		LEFT ARROW						1															
NB	2.983	C	W1-6	48	24	FY		8.00								2		X								INSTALL AT END OF BRIDGE RAIL	X		
NB	2.994	C	VR-017	24	30								1		X											TH-2, MAIN ST			
		C	VR-017	24	30			5.00								1		X								INSTALL 20+ FEET FROM VT-100			E-141
NB	2.996	D	R1-1	30	30								1		X											TH-2, MAIN ST			
		D	R1-1	30	30			6.25								1		X									X		
NB	2.999	C	VR-017	24	30								1		X											TH-5, MIDDLETOWN RD			
		C	VR-017	24	30			5.00								1		X											E-141
		C					NO THRU TRUCKS						1													REMOVE TOWN SIGN. RETURN TO TOWN			
SIGN SUMMARY SHEET							SHEET TOTALS	33.44 SF	0.00 SF	0 EA	0 EA	0 EA	8 EA	0 EA	0 EA	6 EA		90 FT										
VERMONT AGENCY OF TRANSPORTATION							TOWN TOTALS	729.7	0.0	22.0	4.0	4.0	151	0.0	0.0	118		1770.0										

PROJECT NAME: **Stamford-Andover VT100**
PROJECT NUMBER: **STPG SIGN(20)**
FILE NAME: **Londonderrv.xls**
PROJECT MANAGER: **N. Averv**
DESIGNED BY: **J. Kelly**
LONDONDERRY SHEET 4
PLOT DATE: **8/6/2009**
DRAWN BY: **T. Guazzoni**
CHECKED BY: **T. Guazzoni**
SHEET **153** OF **198**

DIRECTION	MILEPOINT	LOCATION CODE (SHEET 2)	SIGN CODE	WIDTH (IN)	HEIGHT (IN)	SHEETING REMARKS	SIGN LEGEND	NEW SIGNS "A"	NEW SIGNS "B"	EXISTING SIGNS RETAIN	EXISTING SIGNS SALVAGE FROM	EXISTING SIGNS SALVAGE TO	EXISTING SIGNS REMOVE	EXIST POST RETAIN	EXIST POST REMOVE	NUMBER OF NEW POSTS	SQUARE STEEL (IN) 1.75 (LB / FT) 1.88	SQUARE STEEL (IN) 2.00 (LB / FT) 2.42	SQUARE STEEL (IN) 2.50 (LB / FT) 3.35	TUBULAR STEEL Ø (IN) FOUNDATION	TUBULAR STEEL Ø (IN) 3.00 (LB / FT) 7.60	TUBULAR STEEL Ø (IN) 3.50 (LB / FT) 9.00	TUBULAR STEEL Ø (IN) 4.00 (LB / FT) 10.80	TUBULAR STEEL Ø (IN) 5.00 (LB / FT) 14.60	SIGN FRAME REQUIRED	REMARKS	SIGN DETAIL: DETAIL IN SHS	SIGN DETAIL: DETAIL ON SHEET NUMBER	SIGN DETAIL: DETAIL ON STD SHEET NUMBER
LONDONDERRY VT 100							FY-FLUORESCENT YELLOW FYG-FLUORESCENT YELLOW GREEN																			"SHS"-STANDARD HIGHWAY SIGNS			
NB	3.010	D	R1-1	30	30								1		X														
		D	R1-1	30	30			6.25								1		X								TH-5, MIDDLETOWN RD	X	
NB	3.007	A	M3-3S	24	12		SOUTH						1		X													
		A	M1-5	30	24		VERMONT 100						1															
		A	M6-1S	21	15		<--- LEFT						1															
		A	M3-1S	24	12		NORTH						1															
		A	M1-5	30	24		VERMONT 100						1															
		A	M6-3S	21	15		^UP ARROW						1															
		A	M3-1S	24	12		NORTH						1															
		A	M1-5	24	24		VERMONT 100						1															
		A	M6-1S	21	15		<--- LEFT						1															
		A	W1-6	48	24	FY		8.00								2		X								X		
NB	3.012	A	W1-3R	30	30		RIGHT REVERSE TURN WITH SIDE ROAD						1		X													
		A	W13-1	18	18		20 MPH PLAQUE 						1															
NB	3.017	A	M3-1	24	12			2.00								1		X								INSTALL 25 FEET NORTH OF EXISTING REVERSE TURN ASSEMBLY. GREEN ON WHITE SHEETING	X	
							SHEET TOTALS	16.25 SF	0.00 SF	0 EA	0 EA	0 EA	12 EA	0 EA	0 EA	4 EA		60 FT								
							TOWN TOTALS	729.7	0.0	22.0	4.0	4.0	151	0.0	0.0	118		1770.0								

SIGN SUMMARY SHEET

VERMONT AGENCY OF TRANSPORTATION

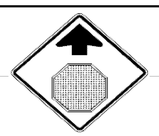
PROJECT NAME: **Stamford-Andover VT100**
PROJECT NUMBER: **STPG SIGN(20)**
FILE NAME: **Londonderrv.xls**
PROJECT MANAGER: **N. Averv**
DESIGNED BY: **J. Kelly**
LONDONDERRY SHEET 5
PLOT DATE: **8/6/2009**
DRAWN BY: **T. Guazzoni**
CHECKED BY: **T. Guazzoni**
SHEET **154** OF **198**

DIRECTION	MILEPOINT	LOCATION CODE (SHEET 2)	SIGN CODE	WIDTH (IN)	HEIGHT (IN)	SHEETING REMARKS	SIGN LEGEND	NEW SIGNS "A"	NEW SIGNS "B"	EXISTING SIGNS RETAIN	EXISTING SIGNS SALVAGE FROM	EXISTING SIGNS SALVAGE TO	EXISTING SIGNS REMOVE	EXIST POST RETAIN	EXIST POST REMOVE	NUMBER OF NEW POSTS	SQUARE STEEL (IN) 1.75 (LB / FT) 1.88	SQUARE STEEL (IN) 2.00 (LB / FT) 2.42	SQUARE STEEL (IN) 2.50 (LB / FT) 3.35	TUBULAR STEEL Ø (IN) FOUNDATION	TUBULAR STEEL Ø (IN) 3.00 (LB / FT) 7.60	TUBULAR STEEL Ø (IN) 3.50 (LB / FT) 9.00	TUBULAR STEEL Ø (IN) 4.00 (LB / FT) 10.80	TUBULAR STEEL Ø (IN) 5.00 (LB / FT) 14.60	SIGN FRAME REQUIRED	REMARKS	SIGN DETAIL: DETAIL IN SHS	SIGN DETAIL: DETAIL ON SHEET NUMBER	SIGN DETAIL: DETAIL ON STD SHEET NUMBER
LONDONDERRY VT 100							FY-FLUORESCENT YELLOW FYG-FLUORESCENT YELLOW GREEN																			"SHS"-STANDARD HIGHWAY SIGNS			
		A	M1-5	30	24			5.00																				E-136B
NB	3.080	C	VR-017	24	24								1		X											TH-55, CRESCENT ST			
		C	VR-017	24	30			5.00								1		X										E-141
NB	3.084	D	R1-1	30	30		 1000 1310 0307						1		X											TH-55, CRESCENT ST			
		D	R1-1	30	30			6.25								1		X									X		
NB	3.177	A	R2-1	24	30								1		X														
		A	R2-1	24	30			5.00								1		X								MAINTAIN 10+ FEET FROM UTILITY POLE	X		
NB	3.217	A	W1-6	48	24								1		X													
		A	W1-6	48	24	FY	 1000 1304 0320	8.00								2		X									X		
NB	3.217	B	W1-6	48	24								1		X													
		B	W1-6	48	24	FY	 40 ~~50~~	8.00								2		X								FACES SB TRAFFIC	X		
NB	3.282	A	R2-1	24	30			5.00		I						1		X		SEE SIGN CHANGE NOTE ON SHEET #151						~~INSTALL 350 FEET NORTH OF BACK TO BACK LARGE ARROWS~~	X		
NB	3.460 ~~3.402~~	A	R2-1	24	30		SPEED LIMIT 50			I			~~1~~		X													
NB	3.427	A	VW-060	30	30		HIDDEN DRIVES						1		X													
NB	3.502	A	S3-1	30	30								1		X													
SIGN SUMMARY SHEET							SHEET TOTALS	~~42.25~~ 37.25	0.00	0	0	0	~~8~~ 7	0	0	8		120									
VERMONT AGENCY OF TRANSPORTATION								SF	SF	EA	EA	EA	EA	EA	EA	EA		FT									
							TOWN TOTALS	729.7	0.0	22.0	4.0	4.0	151	0.0	0.0	118		1770.0									

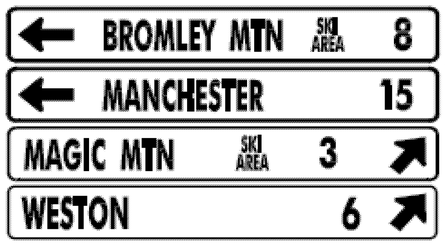
PROJECT NAME: Stamford-Andover VT100
PROJECT NUMBER: STPG SIGN(20)

FILE NAME: Londonderrv.xls
PROJECT MANAGER: N. Averv
DESIGNED BY: J. Kelly
LONDONDERRY SHEET 6

PLOT DATE: 8/6/2009
DRAWN BY: T. Guazzoni
CHECKED BY: T. Guazzoni
SHEET 155 OF 198

DIRECTION	MILEPOINT	LOCATION CODE (SHEET 2)	SIGN CODE	WIDTH (IN)	HEIGHT (IN)	SHEETING REMARKS	SIGN LEGEND	NEW SIGNS "A"	NEW SIGNS "B"	EXISTING SIGNS RETAIN	EXISTING SIGNS SALVAGE FROM	EXISTING SIGNS SALVAGE TO	EXISTING SIGNS REMOVE	EXIST POST RETAIN	EXIST POST REMOVE	NUMBER OF NEW POSTS	SQUARE STEEL (IN) 1.75 (LB / FT) 1.88	SQUARE STEEL (IN) 2.00 (LB / FT) 2.42	SQUARE STEEL (IN) 2.50 (LB / FT) 3.35	FOUNDATION	TUBULAR STEEL Ø (IN) 3.00 (LB / FT) 7.60	TUBULAR STEEL Ø (IN) 3.50 (LB / FT) 9.00	TUBULAR STEEL Ø (IN) 4.00 (LB / FT) 10.80	TUBULAR STEEL Ø (IN) 5.00 (LB / FT) 14.60	SIGN FRAME REQUIRED	REMARKS	SIGN DETAIL: DETAIL IN SHS	SIGN DETAIL: DETAIL ON SHEET NUMBER	SIGN DETAIL: DETAIL ON STD SHEET NUMBER
LONDONDERRY VT 100							FY-FLUORESCENT YELLOW FYG-FLUORESCENT YELLOW GREEN																			"SHS"-STANDARD HIGHWAY SIGNS			
		A	VW-054R	30	30			6.25								2		X								INSTALL HIDDEN DRIVES RIGHT SIGN AT TOP			E-154
		A	S3-1	30	30			6.25																			X		
NB	3.712	A	W1-4L	30	30		LEFT REVERSE CURV\E						1		X														
		A	W13-1	18	18		35 MPH PLAQUE 						1															
NB	3.778	A	W1-4L	30	30		LEFT REVERSE CURV\E	6.25								1		X								INSTALL 350 FEET NORTH OF EXISTING LEFT REVERSE CURVE ASSEMBLY	X		
		A	W13-1	18	18		35 MPH PLAQUE	2.25																			X		
NB	3.827	A	W1-6	48	24		<=== LEFT			1				X															
NB	3.827	B	W1-6	48	24		RIGHT ===>			1				X															
NB	3.882	A	VW-054R	30	30		HIDDEN DRIVE RIGHT				1				X														
NB	3.892	A	VW-054R	30	30		HIDDEN DRIVE RIGHT					1				1		X								INSTALL SIGN ON NEW POST 50 FEET NORTH OF EXISTING LOCATION			
NB	5.432	A	VD-062C	72	16		BUSINESS SIGN			1				X															
		A	VD-062BC	72	16		BUSINESS SIGN			1																			
NB	5.619	A	W3-1	36	36								1		X														
		A	W3-1	36	36			9.00								2		X									X		
NB	5.690	A	M2-1S	21	15								1		X														
SIGN SUMMARY SHEET							SHEET TOTALS	30.00 SF	0.00 SF	4 EA	1 EA	1 EA	4 EA	0 EA	0 EA	6 EA		90 FT										
VERMONT AGENCY OF TRANSPORTATION							TOWN TOTALS	729.7	0.0	22.0	4.0	4.0	151	0.0	0.0	118		1770.0										

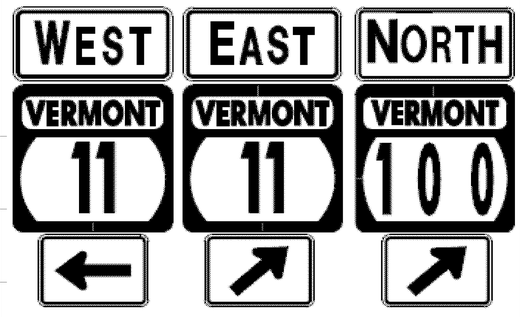
PROJECT NAME: **Stamford-Andover VT100**
PROJECT NUMBER: **STPG SIGN(20)**
FILE NAME: **Londonderrv.xls** PLOT DATE: **8/6/2009**
PROJECT MANAGER: **N. Averv** DRAWN BY: **T. Guazzoni**
DESIGNED BY: **J. Kelly** CHECKED BY: **T. Guazzoni**
LONDONDERRY SHEET 7 SHEET **156** OF **198**

DIRECTION	MILEPOINT	LOCATION CODE (SHEET 2)	SIGN CODE	WIDTH (IN)	HEIGHT (IN)	SHEETING REMARKS	SIGN LEGEND	NEW SIGNS "A"	NEW SIGNS "B"	EXISTING SIGNS RETAIN	EXISTING SIGNS SALVAGE FROM	EXISTING SIGNS SALVAGE TO	EXISTING SIGNS REMOVE	EXIST POST RETAIN	EXIST POST REMOVE	NUMBER OF NEW POSTS	SQUARE STEEL (IN) 1.75 (LB / FT) 1.88	SQUARE STEEL (IN) 2.00 (LB / FT) 2.42	SQUARE STEEL (IN) 2.50 (LB / FT) 3.35	FOUNDATION	TUBULAR STEEL Ø (IN) 3.00 (LB / FT) 7.60	TUBULAR STEEL Ø (IN) 3.50 (LB / FT) 9.00	TUBULAR STEEL Ø (IN) 4.00 (LB / FT) 10.80	TUBULAR STEEL Ø (IN) 5.00 (LB / FT) 14.60	SIGN FRAME REQUIRED	REMARKS	SIGN DETAIL: DETAIL IN SHS	SIGN DETAIL: DETAIL ON SHEET NUMBER	SIGN DETAIL: DETAIL ON STD SHEET NUMBER
LONDONDERRY VT 100							FY-FLUORESCENT YELLOW FYG-FLUORESCENT YELLOW GREEN																			"SHS"-STANDARD HIGHWAY SIGNS			
		A	M1-5	24	24								1															
		A	M2-1	21	15			2.19								1		X								GREEN ON WHITE SHEETING	X		
		A	M1-5	24	24			4.00																					E-136B
NB	5.722	A	D1-1G	72	10								1	X															
		A	D1-1A	72	10								1																
		A	D1-1A	72	10								1																
		A	D1-1S	72	10								1																
		A	D1-1A	72	12			6.00																		5	
		A	D1-1A	72	12			6.00																				5	
		A	D1-1A	72	12			6.00																				5	
		A	D1-1A	72	12			6.00																				5	
NB	5.768	A	M3-4S	24	12								1	X															
		A	M1-5	24	24								1																
		A	M5-1S	21	15								1																
		A	M3-2S	24	12								1																
							SHEET TOTALS	30.19 SF	0.00 SF	0 EA	0 EA	0 EA	9 EA	0 EA	0 EA	1 EA	15 FT												
							TOWN TOTALS	729.7	0.0	22.0	4.0	4.0	151	0.0	0.0	118	1770.0												

SIGN SUMMARY SHEET

VERMONT AGENCY OF TRANSPORTATION

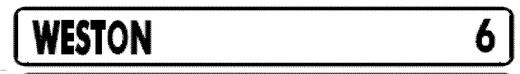
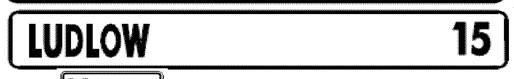
PROJECT NAME: Stamford-Andover VT100
PROJECT NUMBER: STPG SIGN(20)
FILE NAME: Londonderrv.xls
PROJECT MANAGER: N. Averv
DESIGNED BY: J. Kelly
LONDONDERRY SHEET 8
PLOT DATE: 8/6/2009
DRAWN BY: T. Guazzoni
CHECKED BY: T. Guazzoni
SHEET 157 OF 198

DIRECTION	MILEPOINT	LOCATION CODE (SHEET 2)	SIGN CODE	WIDTH (IN)	HEIGHT (IN)	SHEETING REMARKS	SIGN LEGEND	NEW SIGNS "A"	NEW SIGNS "B"	EXISTING SIGNS RETAIN	EXISTING SIGNS SALVAGE FROM	EXISTING SIGNS SALVAGE TO	EXISTING SIGNS REMOVE	EXIST POST RETAIN	EXIST POST REMOVE	NUMBER OF NEW POSTS	SQUARE STEEL (IN) 1.75 (LB / FT) 1.88	SQUARE STEEL (IN) 2.00 (LB / FT) 2.42	SQUARE STEEL (IN) 2.50 (LB / FT) 3.35	TUBULAR STEEL Ø (IN) FOUNDATION	TUBULAR STEEL Ø (IN) 3.00 (LB / FT) 7.60	TUBULAR STEEL Ø (IN) 3.50 (LB / FT) 9.00	TUBULAR STEEL Ø (IN) 4.00 (LB / FT) 10.80	TUBULAR STEEL Ø (IN) 5.00 (LB / FT) 14.60	SIGN FRAME REQUIRED	REMARKS	SIGN DETAIL: DETAIL IN SHS	SIGN DETAIL: DETAIL ON SHEET NUMBER	SIGN DETAIL: DETAIL ON STD SHEET NUMBER
LONDONDERRY VT 100							FY-FLUORESCENT YELLOW FYG-FLUORESCENT YELLOW GREEN																			"SHS"-STANDARD HIGHWAY SIGNS			
		A	M1-5	24	24								1															
		A	M5-1S	21	15								1															
		A	M3-1S	24	12								1															
		A	M1-5	30	24								1															
		A	M5-1S	21	15								1															
		A	M3-4	24	12			2.00																	#3A	GREEN ON WHITE SHEETING	X	7	
		A	M1-5	24	24			4.00																				E-136B
		A	M6-1L	21	15			2.19																		GREEN ON WHITE SHEETING	X		
		A	M3-2	24	12			2.00																		GREEN ON WHITE SHEETING	X		
		A	M1-5	24	24			4.00																		E-136B
		A	M6-2R	21	15			2.19																		GREEN ON WHITE SHEETING	X		
		A	M3-1	24	12			2.00																		GREEN ON WHITE SHEETING	X		
		A	M1-5	30	24			5.00																				E-136B
		A	M6-2R	21	15			2.19																		GREEN ON WHITE SHEETING	X		
NB	5.795	A	R1-1	36	36		STOP 1000 1310 0581			1				X														
							SHEET TOTALS	25.57 SF	0.00 SF	1 EA	0 EA	0 EA	5 EA	0 EA	0 EA	0 EA			0 FT									
							TOWN TOTALS	729.7	0.0	22.0	4.0	4.0	151	0.0	0.0	118			1770.0									

SIGN SUMMARY SHEET

VERMONT AGENCY OF TRANSPORTATION

PROJECT NAME: **Stamford-Andover VT100**
PROJECT NUMBER: **STPG SIGN(20)**
FILE NAME: **Londonderrv.xls**
PROJECT MANAGER: **N. Averv**
DESIGNED BY: **J. Kelly**
LONDONDERRY SHEET 9
PLOT DATE: **8/6/2009**
DRAWN BY: **T. Guazzoni**
CHECKED BY: **T. Guazzoni**
SHEET **158** OF **198**

DIRECTION	MILEPOINT	LOCATION CODE (SHEET 2)	SIGN CODE	WIDTH (IN)	HEIGHT (IN)	SHEETING REMARKS	SIGN LEGEND	NEW SIGNS "A"	NEW SIGNS "B"	EXISTING SIGNS RETAIN	EXISTING SIGNS SALVAGE FROM	EXISTING SIGNS SALVAGE TO	EXISTING SIGNS REMOVE	EXIST POST RETAIN	EXIST POST REMOVE	NUMBER OF NEW POSTS	SQUARE STEEL (IN) (LB / FT) 1.75 / 1.88	SQUARE STEEL (IN) (LB / FT) 2.00 / 2.42	SQUARE STEEL (IN) (LB / FT) 2.50 / 3.35	TUBULAR STEEL Ø (IN) FOUNDATION	TUBULAR STEEL Ø (IN) (LB / FT) 3.00 / 7.60	TUBULAR STEEL Ø (IN) (LB / FT) 3.50 / 9.00	TUBULAR STEEL Ø (IN) (LB / FT) 4.00 / 10.80	TUBULAR STEEL Ø (IN) (LB / FT) 5.00 / 14.60	SIGN FRAME REQUIRED	REMARKS	SIGN DETAIL: DETAIL IN SHS	SIGN DETAIL: DETAIL ON SHEET NUMBER	SIGN DETAIL: DETAIL ON STD SHEET NUMBER
LONDONDERRY VT 100							FY-FLUORESCENT YELLOW FYG-FLUORESCENT YELLOW GREEN																			"SHS"-STANDARD HIGHWAY SIGNS			
NB	5.842	A	VR-041	24	24		THROUGH WAY BEGINS HERE						1		X													
		A	R2-1	24	30								1															
		B	VR-040	24	24		THROUGH WAY ENDS HERE 						1															
		A	R2-1	24	30			5.00								1		X									X	
NB	5.859	C	VR-017	24	24								1		X												TH-14, POND ST			
		C	VR-017	24	30			5.00								1		X										E-141
NB	5.863	D	R1-1	30	30		 						1		X												TH-14, POND ST			
		D	R1-1	30	30			6.25								1		X									X	
NB	5.871	A	M3-1	24	12								1		X													
		A	M1-5A	24	24								1															
		A	D2-1	72	12			6.00								2		X									5	
		A	D2-1	72	12			6.00																			5	
		A	M3-1	24	12			2.00																		GREEN ON WHITE SHEETING	X		
		A	M1-5	30	24			5.00																		INSTALL ON LEFT POST			E-136B
NB	5.911	A	S3-1	30	30								1		X													
							SHEET TOTALS	35.25	0.00	0	0	0	8	0	0	5		75										
								SF	SF	EA	EA	EA	EA	EA	EA	EA		FT										
							TOWN TOTALS	729.7	0.0	22.0	4.0	4.0	151	0.0	0.0	118		1770.0										

SIGN SUMMARY SHEET

VERMONT AGENCY OF TRANSPORTATION

PROJECT NAME: **Stamford-Andover VT100**
PROJECT NUMBER: **STPG SIGN(20)**

FILE NAME: **Londonderrv.xls**
PROJECT MANAGER: **N. Averv**
DESIGNED BY: **J. Kelly**
LONDONDERRY SHEET 10

PLOT DATE: **8/6/2009**
DRAWN BY: **T. Guazzoni**
CHECKED BY: **T. Guazzoni**
SHEET **159** OF **198**

DIRECTION	MILEPOINT	LOCATION CODE (SHEET 2)	SIGN CODE	WIDTH (IN)	HEIGHT (IN)	SHEETING REMARKS	SIGN LEGEND	NEW SIGNS "A"	NEW SIGNS "B"	EXISTING SIGNS RETAIN	EXISTING SIGNS SALVAGE FROM	EXISTING SIGNS SALVAGE TO	EXISTING SIGNS REMOVE	EXIST POST RETAIN	EXIST POST REMOVE	NUMBER OF NEW POSTS	SQUARE STEEL (IN) 1.75 (LB / FT) 1.88	SQUARE STEEL (IN) 2.00 (LB / FT) 2.42	SQUARE STEEL (IN) 2.50 (LB / FT) 3.35	TUBULAR STEEL Ø (IN) FOUNDATION	TUBULAR STEEL Ø (IN) 3.00 (LB / FT) 7.60	TUBULAR STEEL Ø (IN) 3.50 (LB / FT) 9.00	TUBULAR STEEL Ø (IN) 4.00 (LB / FT) 10.80	TUBULAR STEEL Ø (IN) 5.00 (LB / FT) 14.60	SIGN FRAME REQUIRED	REMARKS	SIGN DETAIL: DETAIL IN SHS	SIGN DETAIL: DETAIL ON SHEET NUMBER	SIGN DETAIL: DETAIL ON STD SHEET NUMBER
LONDONDERRY VT 100							FY-FLUORESCENT YELLOW FYG-FLUORESCENT YELLOW GREEN																				"SHS"-STANDARD HIGHWAY SIGNS			
		A	S3-1	30	30			6.25								1		X									X		
NB	5.985	A	W1-4ML	30	30		MODIFIED LEFT REVERSE CURVE						1		X															
		A	W13-1	18	18		40 MPH PLAQUE						1																	
NB	~~5.965~~ 6.273	A	R2-1	24	30								1		X																
		A	R2-1	24	30			5.00								1		X								NEW MM CHANGE. SEE SIGN CHANGE NOTE ON SHEET #151.	X		
NB	6.000	A	VW-544	30	30		EMERGENCY VEHICLES 						1		X																
NB	6.040	A	VW-544	30	30			6.25								1		X								INSTALL 200 FEET NORTH OF EXISTING EMERGENCY VEHICLES ASSEMBLY			E-154
NB	6.642	C	VR-017	24	30								~~1~~ 2		X												TH-15, COBBLE RIDGE RD			
		C	VR-017	24	30			5.00								1		X								NO PARKING SIGN WAS REMOVED AND GIVEN TO THE TOWN. ILLEGAL SIGN.			E-141
NB	6.647	D	R1-1	30	30		 1000 1310 0665						1		X												TH-15, COBBLE RIDGE RD			
		D	R1-1	30	30			6.25								1		X									X		
NB	7.470	A	W1-4R	30	30								1		X															
		A	W1-4R	30	30			6.25								1		X									X		
NB	7.520	A	VW-081R	30	30								1		X																
		A	VW-081R	30	30			6.25								1		X										6	
							SHEET TOTALS	41.25 SF	0.00 SF	0 EA	0 EA	0 EA	~~0~~ 9 EA	0 EA	0 EA	7 EA		105 FT										
							TOWN TOTALS	729.7	0.0	22.0	4.0	4.0	151	0.0	0.0	118		1770.0										

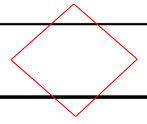
SIGN SUMMARY SHEET

VERMONT AGENCY OF TRANSPORTATION

PROJECT NAME: **Stamford-Andover VT100**
PROJECT NUMBER: **STPG SIGN(20)**

FILE NAME: **Londonderrv.xls**
PROJECT MANAGER: **N. Averv**
DESIGNED BY: **J. Kelly**
LONDONDERRY SHEET 11

PLOT DATE: **8/6/2009**
DRAWN BY: **T. Guazzoni**
CHECKED BY: **T. Guazzoni**
SHEET **160** OF **198**

DIRECTION	MILEPOINT	LOCATION CODE (SHEET 2)	SIGN CODE	WIDTH (IN)	HEIGHT (IN)	SHEETING REMARKS	SIGN LEGEND	NEW SIGNS "A"	NEW SIGNS "B"	EXISTING SIGNS RETAIN	EXISTING SIGNS SALVAGE FROM	EXISTING SIGNS SALVAGE TO	EXISTING SIGNS REMOVE	EXIST POST RETAIN	EXIST POST REMOVE	NUMBER OF NEW POSTS	SQUARE STEEL (IN) 1.75 (LB / FT) 1.88	SQUARE STEEL (IN) 2.00 (LB / FT) 2.42	SQUARE STEEL (IN) 2.50 (LB / FT) 3.35	TUBULAR STEEL Ø (IN) FOUNDATION	TUBULAR STEEL Ø (IN) 3.00 (LB / FT) 7.60	TUBULAR STEEL Ø (IN) 3.50 (LB / FT) 9.00	TUBULAR STEEL Ø (IN) 4.00 (LB / FT) 10.80	TUBULAR STEEL Ø (IN) 5.00 (LB / FT) 14.60	SIGN FRAME REQUIRED	REMARKS	SIGN DETAIL: DETAIL IN SHS	SIGN DETAIL: DETAIL ON SHEET NUMBER	SIGN DETAIL: DETAIL ON STD SHEET NUMBER
LONDONDERRY VT 100							FY-FLUORESCENT YELLOW FYG-FLUORESCENT YELLOW GREEN																			"SHS"-STANDARD HIGHWAY SIGNS			
SB	7.220	F	VW-205	36	36		 1000 1310 0720						1		X														
		F	VW-205	36	36			9.00								2		X											E-154
SB	6.810	F	VW-054	30	30		HIDDEN DRIVE RIGHT						1		X														
SB	6.765	F	S3-1	30	30		SCHOOL BUS STOP AHEAD 						1		X														
		F	VW-054R	30	30			6.25								2		X									INSTALL HIDDEN DRIVE RIGHT SIGN ABOVE THE SCHOOL BUS STOP AHEAD SIGN			E-154
		F	S3-1	30	30			6.25																				X	
SB	6.593	G	VR-017	24	30								1		X													TH-67, EVERGREEN LANE			
		G	VR-017	24	30			5.00								1		X											E-141
SB	6.588	H	R1-1	30	30		 1000 1310 0659						1		X													TH-67, EVERGREEN LANE			
		H	R1-1	30	30			6.25								1		X										X	
SB	6.550	F	VW-054	30	30		HIDDEN DRIVES RIGHT						1		X														
SB	6.480	F	VW-054R	30	30			6.25									1		X							INSTALL 375 FEET NORTH OF EXISTING SIGN AND NEXT TO MASON'S SIGN.			E-154
SB	6.335	F	VW-544	30	30		EMERGENCY VEHICLES						1		X														
SB	6.259	F	VW-544	30	30			6.25									1		X							INSTALL 400 FEET SOUTH OF EXISTING EMERGENCY VEHICLES ASSEMBLY			E-154
SB	6.190	F	VD-062BC	72	16		~~BUSINESS SIGN~~ 			1				X																
SIGN SUMMARY SHEET							SHEET TOTALS	45.25 SF	0.00 SF	1 EA	0 EA	0 EA	7 EA	0 EA	0 EA	8 EA		120 FT										
VERMONT AGENCY OF TRANSPORTATION							TOWN TOTALS	729.7	0.0	22.0	4.0	4.0	151	0.0	0.0	118		1770.0										

PROJECT NAME: **Stamford-Andover VT100**
PROJECT NUMBER: **STPG SIGN(20)**

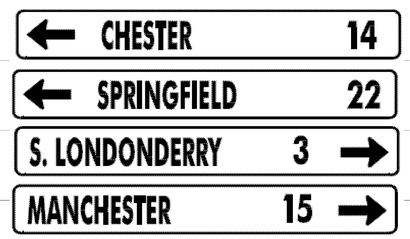
FILE NAME: **Londonderrv.xls** PLOT DATE: **8/6/2009**
PROJECT MANAGER: **N. Averv** DRAWN BY: **T. Guazzoni**
DESIGNED BY: **J. Kelly** CHECKED BY: **T. Guazzoni**
LONDONDERRY SHEET 12 SHEET **161** OF **198**

DIRECTION	MILEPOINT	LOCATION CODE (SHEET 2)	SIGN CODE	WIDTH (IN)	HEIGHT (IN)	SHEETING REMARKS	SIGN LEGEND	NEW SIGNS "A"	NEW SIGNS "B"	EXISTING SIGNS RETAIN	EXISTING SIGNS SALVAGE FROM	EXISTING SIGNS SALVAGE TO	EXISTING SIGNS REMOVE	EXIST POST RETAIN	EXIST POST REMOVE	NUMBER OF NEW POSTS	SQUARE STEEL (IN) 1.75 (LB / FT) 1.88	SQUARE STEEL (IN) 2.00 (LB / FT) 2.42	SQUARE STEEL (IN) 2.50 (LB / FT) 3.35	TUBULAR STEEL Ø (IN) FOUNDATION	TUBULAR STEEL Ø (IN) 3.00 (LB / FT) 7.60	TUBULAR STEEL Ø (IN) 3.50 (LB / FT) 9.00	TUBULAR STEEL Ø (IN) 4.00 (LB / FT) 10.80	TUBULAR STEEL Ø (IN) 5.00 (LB / FT) 14.60	SIGN FRAME REQUIRED	REMARKS	SIGN DETAIL: DETAIL IN SHS	SIGN DETAIL: DETAIL ON SHEET NUMBER	SIGN DETAIL: DETAIL ON STD SHEET NUMBER
LONDONDERRY VT 100							FY-FLUORESCENT YELLOW FYG-FLUORESCENT YELLOW GREEN																			"SHS"-STANDARD HIGHWAY SIGNS			
		F	VD-062C	72	16		BUSINESS SIGN			1																			
SB	6.150	F	W1-10L	30	30		LEFT CURVE WITH RH SIDE ROAD						1		X														
		F	W13-1	18	18		40 MPH PLAQUE						1																
SB	6.115	F	S3-1	30	30								1		X														
		F	W1-10L	30	30			6.25								2		X									X	
		F	S3-1	30	30			6.25																			INSTALL SCHOOL BUS STOP AHEAD SIGN BELOW LEFT CURVE SIGN	X	
SB	6.080	F	~~W3-5~~ R2-1	~~36~~ 30	36		SPEED ~~REDUCTION~~ LIMIT (30)			1				X													SPEED LIMIT SIGN CHANGE. SEE SHEET #151		
SB	6.039	F	W1-6	48	24		LEFT LARGE ARROW			1				X															
SB	5.998	G	VR-017	24	30								1		X												TH-63, WILLIAMS ST		
		G	VR-017	24	30			5.00								1		X											E-141
SB	5.993	H	R1-1	30	30								1		X												TH-63, WILLIAMS ST		
		H	R1-1	30	30		1000 1310 0600	6.25								1		X										X	
SB	5.975	F	W3-1	36	36		STOP AHEAD			1				X															
SB	5.965	F	R2-1	24	30					I			~~1~~	X	~~X~~												SPEED LIMIT SIGN CHANGE. SEE SHEET #151.		
		F	R2-1	24 30	30 36			~~7.50~~								~~1~~		~~X~~										6	
SIGN SUMMARY SHEET							SHEET TOTALS	~~31.25~~ 23.75 SF	0.00 SF	4 EA	0 EA	0 EA	~~6~~ 5 EA	0 EA	0 EA	5 EA		75 FT											
VERMONT AGENCY OF TRANSPORTATION							TOWN TOTALS	729.7	0.0	22.0	4.0	4.0	151	0.0	0.0	118		1770.0										

PROJECT NAME: Stamford-Andover VT100
PROJECT NUMBER: STPG SIGN(20)

FILE NAME: Londonderry.xls
PROJECT MANAGER: N. Avery
DESIGNED BY: J. Kelly
LONDONDERRY SHEET 13

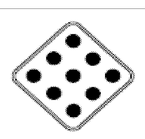
PLOT DATE: 8/6/2009
DRAWN BY: T. Guazzoni
CHECKED BY: T. Guazzoni
SHEET 162 OF 198

DIRECTION	MILEPOINT	LOCATION CODE (SHEET 2)	SIGN CODE	WIDTH (IN)	HEIGHT (IN)	SHEETING REMARKS	SIGN LEGEND	NEW SIGNS "A"	NEW SIGNS "B"	EXISTING SIGNS RETAIN	EXISTING SIGNS SALVAGE FROM	EXISTING SIGNS SALVAGE TO	EXISTING SIGNS REMOVE	EXIST POST RETAIN	EXIST POST REMOVE	NUMBER OF NEW POSTS	SQUARE STEEL (IN) (LB / FT) 1.75 1.88	SQUARE STEEL (IN) (LB / FT) 2.00 2.42	SQUARE STEEL (IN) (LB / FT) 2.50 3.35	FOUNDATION	TUBULAR STEEL Ø (IN) (LB / FT) 3.00 7.60	TUBULAR STEEL Ø (IN) (LB / FT) 3.50 9.00	TUBULAR STEEL Ø (IN) (LB / FT) 4.00 10.80	TUBULAR STEEL Ø (IN) (LB / FT) 5.00 14.60	SIGN FRAME REQUIRED	REMARKS	SIGN DETAIL: DETAIL IN SHS	SIGN DETAIL: DETAIL ON SHEET NUMBER	SIGN DETAIL: DETAIL ON STD SHEET NUMBER
LONDONDERRY VT 100							FY-FLUORESCENT YELLOW FYG-FLUORESCENT YELLOW GREEN																			"SHS"-STANDARD HIGHWAY SIGNS			
SB	5.926	F	M2-1S	21	15								1		X													
		F	M1-5	24	24								1															
		F	M2-1	21	15			2.19								1		X							GREEN ON WHITE SHEETING	X		
		F	M1-5	24	24			4.00																				E-136B
SB	5.870	F	D1-1A	72	10								1		X													
		F	D1-1A	72	10								1															
		F	D1-1A	72	10								1															
		F	D1-1A	72	10								1															
		F	D1-1A	72	12			6.00								2			X						5	
		F	D1-1A	72	12			6.00																			5	
		F	D1-1A	72	12			6.00																			5	
		F	D1-1A	72	12			6.00																			5	
SB	5.844	G	VR-017	24	30								1		X												TH-54, HIGH ST			
		G	VR-017	24	30			5.00								1		X										E-141
SB	5.840	H	R1-1	24	24								1		X												TH-54, HIGH ST			
							SHEET TOTALS	35.19 SF	0.00 SF	0 EA	0 EA	0 EA	8 EA	0 EA	0 EA	4 EA		60 FT										
							TOWN TOTALS	729.7	0.0	22.0	4.0	4.0	151	0.0	0.0	118		1770.0										

SIGN SUMMARY SHEET

VERMONT AGENCY OF TRANSPORTATION

PROJECT NAME: Stamford-Andover VT100
PROJECT NUMBER: STPG SIGN(20)
FILE NAME: Londonderrv.xls
PROJECT MANAGER: N. Averv
DESIGNED BY: J. Kelly
LONDONDERRY SHEET 14
PLOT DATE: 8/6/2009
DRAWN BY: T. Guazzoni
CHECKED BY: T. Guazzoni
SHEET 163 OF 198

DIRECTION	MILEPOINT	LOCATION CODE (SHEET 2)	SIGN CODE	WIDTH (IN)	HEIGHT (IN)	SHEETING REMARKS	SIGN LEGEND	NEW SIGNS "A"	NEW SIGNS "B"	EXISTING SIGNS RETAIN	EXISTING SIGNS SALVAGE FROM	EXISTING SIGNS SALVAGE TO	EXISTING SIGNS REMOVE	EXIST POST RETAIN	EXIST POST REMOVE	NUMBER OF NEW POSTS	SQUARE STEEL (IN) 1.75 (LB / FT) 1.88	SQUARE STEEL (IN) 2.00 (LB / FT) 2.42	SQUARE STEEL (IN) 2.50 (LB / FT) 3.35	TUBULAR STEEL Ø (IN) FOUNDATION	TUBULAR STEEL Ø (IN) 3.00 (LB / FT) 7.60	TUBULAR STEEL Ø (IN) 3.50 (LB / FT) 9.00	TUBULAR STEEL Ø (IN) 4.00 (LB / FT) 10.80	TUBULAR STEEL Ø (IN) 5.00 (LB / FT) 14.60	SIGN FRAME REQUIRED	REMARKS	SIGN DETAIL: DETAIL IN SHS	SIGN DETAIL: DETAIL ON SHEET NUMBER	SIGN DETAIL: DETAIL ON STD SHEET NUMBER
LONDONDERRY VT 100							FY-FLUORESCENT YELLOW FYG-FLUORESCENT YELLOW GREEN																			"SHS"-STANDARD HIGHWAY SIGNS			
		H	R1-1	30	30			6.25								1		X									X		
SB	5.820	F	R1-1	30	30					I			1	X	X											REPLACED IN 2009 ON RT. II PROJECT.			
		F	R1-1	36	36		1000 1310 0584 	0.00 ~~9.00~~								2		X								X		
SB	5.794	F	OM1-1	18	18								1		X														
		E	R1-1	30	30								1																
		F	OM1-1	18	18		 	2.25								1		X								INSTALL SIGNS BACK TO BACK AS EXISTING	X		
		E	R1-1	30	30			6.25																			X		
SB	5.784	H	R1-1	30	30								1		X														
		G	OM1-1	18	18								1																
		H	R1-1	30	30		 	6.25								1		X								INSTALL SIGNS BACK TO BACK AS EXISTING	X		
		G	OM1-1	18	18			2.25																		GATE POSTED WITH MM 5.779 BELOW	X		
SB	5.779	H	R1-1	30	30								1		X															
		H	R1-1	30	30			6.25								1		X									X		
SB	5.768	F	M3-3S	24	12		SOUTH						1		X														
		F	M1-5	30	24		VERMONT 100						1																
SIGN SUMMARY SHEET							SHEET TOTALS	~~38.50~~ 29.50	0.00	0	0	0	~~8~~ 7	0	0	6		90										
VERMONT AGENCY OF TRANSPORTATION								SF	SF	EA	EA	EA	EA	EA	EA	EA		FT										
							TOWN TOTALS	729.7	0.0	22.0	4.0	4.0	151	0.0	0.0	118		1770.0											

PROJECT NAME: **Stamford-Andover VT100**
PROJECT NUMBER: **STPG SIGN(20)**

FILE NAME: **Londonderry.xls**
PROJECT MANAGER: **N. Avery**
DESIGNED BY: **J. Kelly**
LONDONDERRY SHEET 15

PLOT DATE: **8/6/2009**
DRAWN BY: **T. Guazzoni**
CHECKED BY: **T. Guazzoni**
SHEET **164** OF **198**

DIRECTION	MILEPOINT	LOCATION CODE (SHEET 2)	SIGN CODE	WIDTH (IN)	HEIGHT (IN)	SHEETING REMARKS	SIGN LEGEND	NEW SIGNS "A"	NEW SIGNS "B"	EXISTING SIGNS RETAIN	EXISTING SIGNS SALVAGE FROM	EXISTING SIGNS SALVAGE TO	EXISTING SIGNS REMOVE	EXIST POST RETAIN	EXIST POST REMOVE	NUMBER OF NEW POSTS	SQUARE STEEL (IN) 1.75 (LB / FT) 1.88	SQUARE STEEL (IN) 2.00 (LB / FT) 2.42	SQUARE STEEL (IN) 2.50 (LB / FT) 3.35	TUBULAR STEEL Ø (IN) FOUNDATION	TUBULAR STEEL Ø (IN) 3.00 (LB / FT) 7.60	TUBULAR STEEL Ø (IN) 3.50 (LB / FT) 9.00	TUBULAR STEEL Ø (IN) 4.00 (LB / FT) 10.80	TUBULAR STEEL Ø (IN) 5.00 (LB / FT) 14.60	SIGN FRAME REQUIRED	REMARKS	SIGN DETAIL: DETAIL IN SHS	SIGN DETAIL: DETAIL ON SHEET NUMBER	SIGN DETAIL: DETAIL ON STD SHEET NUMBER
LONDONDERRY VT 100							FY-FLUORESCENT YELLOW FYG-FLUORESCENT YELLOW GREEN																			"SHS"-STANDARD HIGHWAY SIGNS			
SB	5.750	F	D2-1	72	12		S. LONDONDERRY 3	6.00								2		X							INSTALL ASSEMBLY 100 FEET SOUTH OF EXISTING ROUTE MARKER ASSEMBLY		5	
		F	D2-1	72	12		RAWSONVILLE 7	6.00																			5	
		F	D2-1	72	12		STRATTON MTN SKI AREA 11	6.00																			5	
		F	M3-3	24	12		SOUTH VERMONT 100	2.00																	GREEN ON WHITE SHEETING. INSTALL ON LH POST	X		
		F	M1-5	30	24			5.00																	INSTALL ON LH POST			E-136B
SB	5.624	F	VD-062AL	72	16		BUSINESS SIGN			1				X														
SB	5.564	F	R2-1	24	30		SPEED LIMIT 50						1		X													
		F	R2-1	24	30		SPEED LIMIT 50	5.00								1		X									X	
SB	5.240	F	VW-133R	30	30		HIDDEN DRIVES RIGHT			1				X														
		F	W16-2	24	18		600 FEET			1																		
SB	4.783	F	VW-054R	30	30		HIDDEN DRIVE RIGHT			1				X														
SB	4.049	F	W1-4L	30	30		LEFT REVERSE CURVE				1				X													
		F	W13-1	18	18		35 MPH PLAQUE				1																	
SB	3.973	F	W1-4L	30	30		LEFT REVERSE CURVE					1				1		X									REINSTALL SIGNS 400 FEET SOUTH OF EXISTING LEFT REVERSE CURVE ASSEMBLY			
		F	W13-1	18	18		35 MPH PLAQUE					1																
							SHEET TOTALS	30.00 SF	0.00 SF	4 EA	2 EA	2 EA	1 EA	0 EA	0 EA	4 EA		60 FT										
							TOWN TOTALS	729.7	0.0	22.0	4.0	4.0	151	0.0	0.0	118		1770.0										

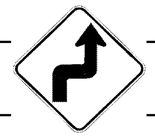
SIGN SUMMARY SHEET

VERMONT AGENCY OF TRANSPORTATION

PROJECT NAME: Stamford-Andover VT100
PROJECT NUMBER: STPG SIGN(20)

FILE NAME: Londonderrv.xls
PROJECT MANAGER: N. Averv
DESIGNED BY: J. Kelly
LONDONDERRY SHEET 16

PLOT DATE: 8/6/2009
DRAWN BY: T. Guazzoni
CHECKED BY: T. Guazzoni
SHEET 165 OF 198

DIRECTION	MILEPOINT	LOCATION CODE (SHEET 2)	SIGN CODE	WIDTH (IN)	HEIGHT (IN)	SHEETING REMARKS	SIGN LEGEND	NEW SIGNS "A"	NEW SIGNS "B"	EXISTING SIGNS RETAIN	EXISTING SIGNS SALVAGE FROM	EXISTING SIGNS SALVAGE TO	EXISTING SIGNS REMOVE	EXIST POST RETAIN	EXIST POST REMOVE	NUMBER OF NEW POSTS	SQUARE STEEL (IN) 1.75 (LB / FT) 1.88	SQUARE STEEL (IN) 2.00 (LB / FT) 2.42	SQUARE STEEL (IN) 2.50 (LB / FT) 3.35	TUBULAR STEEL Ø (IN) FOUNDATION	TUBULAR STEEL Ø (IN) 3.00 (LB / FT) 7.60	TUBULAR STEEL Ø (IN) 3.50 (LB / FT) 9.00	TUBULAR STEEL Ø (IN) 4.00 (LB / FT) 10.80	TUBULAR STEEL Ø (IN) 5.00 (LB / FT) 14.60	SIGN FRAME REQUIRED	REMARKS	SIGN DETAIL: DETAIL IN SHS	SIGN DETAIL: DETAIL ON SHEET NUMBER	SIGN DETAIL: DETAIL ON STD SHEET NUMBER
LONDONDERRY VT 100							FY-FLUORESCENT YELLOW FYG-FLUORESCENT YELLOW GREEN																				"SHS"-STANDARD HIGHWAY SIGNS			
SB	3.809	F	S3-1	30	30		SCHOOL BUS STOP AHEAD						1		X														
SB	3.674	F	VW-054L	30	30								1		X														
		F	VW-054L	30	30			6.25								1		X										E-154
SB	3.574	F	W3-5	36	36		SPEED REDUCTION (30)			1	~~1~~																		
SB	3.423	F	W3-5	36	36		SPEED REDUCTION (30)			1			~~1~~			~~2~~		~~X~~		SEE SHEET # 151 FOR SIGN CHANGE NOTE.						~~INSTALL SIGN 800 FEET SOUTH OF EXISTING LOCATION~~			
SB	3.414	F	VD-018	30	18		SOUTH LONDONDERRY RAWSONVILLE 4						1		X														
SB	3.404	F	R2-1	24	30		SPEED LIMIT 30						1		X														
SB	~~3.362~~ 3.414	F	VD-018	30	18		1000 1318 0340 SOUTH LONDONDERRY RAWSONVILLE 5	3.75								1		X		SAME LOCATION AS OLD SIGN						~~INSTALL 200 FEET NORTH OF BUSINESS SIGN ASSEMBLY~~			E-128A
SB	3.350	F	W1-3R	30	30		RIGHT REVERSE TURN						1		X														
SB	3.324	F	VD-062AS	72	16		BUSINESS SIGN			1				X															
		F	VD-062AS	72	16		BUSINESS SIGN			1																			
SB	3.282	F	R2-1	30	36			~~7.50~~								1		X		IN GOOD CONDITION - REPLACED 10/09						INSTALL 225 FEET SOUTH OF BUSINESS SIGN AND ACROSS FROM SPEED LIMIT 50 SIGN		6	
SB	3.244	F	W1-3R	30	30	FY		6.25								1		X									INSTALL 200 FEET SOUTH OF NEW SPEED LIMIT 30 SIGN	X		
SB	3.154	F	W1-1L	30	30		LEFT TURN WITH LH SIDE ROAD						1		X														
		F	W13-1	18	18		20 MPH PLAQUE						1																
							SHEET TOTALS	~~16.25~~ ~~23.75~~ SF	0.00 SF	2 EA	0 ~~1~~ EA	0 ~~1~~ EA	7 EA	0 EA	0 EA	6 EA		90 FT									
							TOWN TOTALS	729.7 SF	0.0 SF	22.0 EA	4.0 EA	4.0 EA	151 EA	0.0 EA	0.0 EA	118 EA		1770.0 FT									

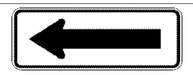
SIGN SUMMARY SHEET

VERMONT AGENCY OF TRANSPORTATION

PROJECT NAME: **Stamford-Andover VT100**
PROJECT NUMBER: **STPG SIGN(20)**

FILE NAME: **Londonderrv.xls**
PROJECT MANAGER: **N. Averv**
DESIGNED BY: **J. Kelly**
LONDONDERRY SHEET 17

PLOT DATE: **8/6/2009**
DRAWN BY: **T. Guazzoni**
CHECKED BY: **T. Guazzoni**
SHEET **166** OF **198**

DIRECTION	MILEPOINT	LOCATION CODE (SHEET 2)	SIGN CODE	WIDTH (IN)	HEIGHT (IN)	SHEETING REMARKS	SIGN LEGEND	NEW SIGNS "A"	NEW SIGNS "B"	EXISTING SIGNS RETAIN	EXISTING SIGNS SALVAGE FROM	EXISTING SIGNS SALVAGE TO	EXISTING SIGNS REMOVE	EXIST POST RETAIN	EXIST POST REMOVE	NUMBER OF NEW POSTS	SQUARE STEEL (IN) 1.75 (LB / FT) 1.88	SQUARE STEEL (IN) 2.00 (LB / FT) 2.42	SQUARE STEEL (IN) 2.50 (LB / FT) 3.35	TUBULAR STEEL Ø (IN) FOUNDATION	TUBULAR STEEL Ø (IN) 3.00 (LB / FT) 7.60	TUBULAR STEEL Ø (IN) 3.50 (LB / FT) 9.00	TUBULAR STEEL Ø (IN) 4.00 (LB / FT) 10.80	TUBULAR STEEL Ø (IN) 5.00 (LB / FT) 14.60	SIGN FRAME REQUIRED	REMARKS	SIGN DETAIL: DETAIL IN SHS	SIGN DETAIL: DETAIL ON SHEET NUMBER	SIGN DETAIL: DETAIL ON STD SHEET NUMBER
LONDONDERRY VT 100							FY-FLUORESCENT YELLOW FYG-FLUORESCENT YELLOW GREEN																			"SHS"-STANDARD HIGHWAY SIGNS			
SB	3.144	F	W1-1fM L	30	30	FY		6.25								1		X								INSTALL 50 FEET SOUTH OF EXISTING LEFT TURN ASSEMBLY		6	
		F	W13-1	18	18	FY		2.25																			X	
SB	3.119	E	W1-6	48	24								1		X														
		E	W1-6	48	24	FY		8.00								2		X								FACES NB TRAFFIC	X	
SB	3.104	F	W1-6	48	24								1		X														
		F	W1-6	48	24	FY		8.00								2		X									X	
SB	3.084	E	W1-6	48	24								1		X														
		E	W1-6	48	24	FY		8.00								2		X								FACES NB TRAFFIC	X	
SB	3.067	F	W1-1McR	36	36		MODIFIED RIGHT TURN						1		X														
		F	W13-1	24	24		20 MPH PLAQUE						1																
SB	3.037	F	R2-1	24	30		SPEED LIMIT 30						1		X														
		F	W1-1McR	36	36	FY		9.00								2		X										X	
		F	W13-1	24	24	FY		4.00																		INSTALL ON LH POST	X	
SB	3.012	F	M3-3S	24	12		SOUTH						1		X														
		F	M1-5	24	24		VERMONT						1																
							SHEET TOTALS	45.50 SF	0.00 SF	0 EA	0 EA	0 EA	8 EA	0 EA	0 EA	9 EA		135 FT										
							TOWN TOTALS	729.7	0.0	22.0	4.0	4.0	151	0.0	0.0	118		1770.0										

SIGN SUMMARY SHEET

VERMONT AGENCY OF TRANSPORTATION

PROJECT NAME: **Stamford-Andover VT100**
PROJECT NUMBER: **STPG SIGN(20)**

FILE NAME: **Londonderrv.xls**
PROJECT MANAGER: **N. Averv**
DESIGNED BY: **J. Kelly**
LONDONDERRY SHEET 18

PLOT DATE: **8/6/2009**
DRAWN BY: **T. Guazzoni**
CHECKED BY: **T. Guazzoni**
SHEET **167** OF **198**

DIRECTION	MILEPOINT	LOCATION CODE (SHEET 2)	SIGN CODE	WIDTH (IN)	HEIGHT (IN)	SHEETING REMARKS	SIGN LEGEND	NEW SIGNS "A"	NEW SIGNS "B"	EXISTING SIGNS RETAIN	EXISTING SIGNS SALVAGE FROM	EXISTING SIGNS SALVAGE TO	EXISTING SIGNS REMOVE	EXIST POST RETAIN	EXIST POST REMOVE	NUMBER OF NEW POSTS	SQUARE STEEL (IN) 1.75 (LB/FT) 1.88	SQUARE STEEL (IN) 2.00 (LB/FT) 2.42	SQUARE STEEL (IN) 2.50 (LB/FT) 3.35	TUBULAR STEEL Ø (IN) FOUNDATION	TUBULAR STEEL Ø (IN) 3.00 (LB/FT) 7.60	TUBULAR STEEL Ø (IN) 3.50 (LB/FT) 9.00	TUBULAR STEEL Ø (IN) 4.00 (LB/FT) 10.80	TUBULAR STEEL Ø (IN) 5.00 (LB/FT) 14.60	SIGN FRAME REQUIRED	REMARKS	SIGN DETAIL: DETAIL IN SHS	SIGN DETAIL: DETAIL ON SHEET NUMBER	SIGN DETAIL: DETAIL ON STD SHEET NUMBER
LONDONDERRY VT 100							FY-FLUORESCENT YELLOW FYG-FLUORESCENT YELLOW GREEN																			"SHS"-STANDARD HIGHWAY SIGNS			
	SB 3.012	F	M6-1S	21	15		RIGHT ===>						1															
		F	M3-3	24	12			2.00								1		X							GREEN ON WHITE SHEETING	X		
		F	M1-5	~~24~~ 30	24			5.00																				E-136B
		F	M6-1R	21	15			2.19																			GREEN ON WHITE SHEETING	X		
SB	2.951	E	W1-6	48	24								1		X															
		E	W1-6	48	24	FY		8.00								2		X							FACES NB TRAFFIC	X		
SB	2.950	G	VR-017	24	30								1		X												TH-6, WINHALL HOLLOW RD			
		G	VR-017	24	30			5.00								1		X										E-141
		G	VR-660	24	30		NO PARKING ON TRAVEL LANE						1															
SB	2.946	H	R1-1	30	30								1		X												TH-6, WINHALL HOLLOW RD			
		H	R1-1	30	30			6.25								1		X										X		
SB	2.933	F	M3-3	24	12			2.00								1		X							INSTALL NEW ASSEMBLY BEHIND LARGE ARROW. GREEN ON WHITE SHEETING	X		
		F	M1-5	30	24			5.00																				E-136B
SB	2.933	E	W1-6	48	24								1		X															
		E	W1-6	48	24	FY		8.00								2		X							FACES NB TRAFFIC	X		
							SHEET TOTALS	43.44 SF	0.00 SF	0 EA	0 EA	0 EA	6 EA	0 EA	0 EA	8 EA		120 FT									
							TOWN TOTALS	729.7	0.0	22.0	4.0	4.0	151	0.0	0.0	118		1770.0									

SIGN SUMMARY SHEET

VERMONT AGENCY OF TRANSPORTATION

PROJECT NAME: **Stamford-Andover VT100**
PROJECT NUMBER: **STPG SIGN(20)**

FILE NAME: **Londonderry.xls**
PROJECT MANAGER: **N. Avery**
DESIGNED BY: **J. Kelly**
LONDONDERRY SHEET 19

PLOT DATE: **8/6/2009**
DRAWN BY: **T. Guazzoni**
CHECKED BY: **T. Guazzoni**
SHEET **168** OF **198**

DIRECTION	MILEPOINT	LOCATION CODE (SHEET 2)	SIGN CODE	WIDTH (IN)	HEIGHT (IN)	SHEETING REMARKS	SIGN LEGEND	NEW SIGNS "A"	NEW SIGNS "B"	EXISTING SIGNS RETAIN	EXISTING SIGNS SALVAGE FROM	EXISTING SIGNS SALVAGE TO	EXISTING SIGNS REMOVE	EXIST POST RETAIN	EXIST POST REMOVE	NUMBER OF NEW POSTS	SQUARE STEEL (IN) 1.75 (LB / FT) 1.88	SQUARE STEEL (IN) 2.00 (LB / FT) 2.42	SQUARE STEEL (IN) 2.50 (LB / FT) 3.35	TUBULAR STEEL Ø (IN) FOUNDATION	TUBULAR STEEL Ø (IN) 3.00 (LB / FT) 7.60	TUBULAR STEEL Ø (IN) 3.50 (LB / FT) 9.00	TUBULAR STEEL Ø (IN) 4.00 (LB / FT) 10.80	TUBULAR STEEL Ø (IN) 5.00 (LB / FT) 14.60	SIGN FRAME REQUIRED	REMARKS	SIGN DETAIL: DETAIL IN SHS	SIGN DETAIL: DETAIL ON SHEET NUMBER	SIGN DETAIL: DETAIL ON STD SHEET NUMBER
LONDONDERRY VT 100							FY-FLUORESCENT YELLOW FYG-FLUORESCENT YELLOW GREEN																			"SHS"-STANDARD HIGHWAY SIGNS			
SB	2.873	G	VR-017	24	30								1		X											TH-27, MELENDY HILL RD			
		G	VR-017	24	30			5.00								1		X										E-141
SB	2.868	H	R1-1	30	30								1		X											TH-27, MELENDY HILL RD SEE NOTE FOR SIGN CHANGES ON SHEET #151			
		H	R1-1	30	30			6.25								1		X									X		
SB	2.863	F	R2-1	24	30		 40						~~1~~		~~X~~														
		F	R2-1	24	30			~~5.00~~								~~1~~		~~X~~									X		
SB	2.813	F	M3-3	24	12		SOUTH						1		X											MM. STILL THERE			
		F	M1-5A	24	24		VERMONT 100 1000 1310 0280						1																
SB	2.494	G	VR-017	24	30								1		X											TH-49, WINDY RISE LANE WEST			
		G	VR-017	24	30			5.00								1		X										E-141
SB	2.490	H	R1-1	30	30								1		X											TH-49, WINDY RISE LANE WEST			
		H	R1-1	30	30			6.25								1		X									X		
SB	1.821	G	VR-017	24	30								1		X											TH-45, GLEBE VIEW LANE			
		G	VR-017	24	30			5.00								1		X										E-141
		G					WATCH FOR CHILDREN						~~1~~													~~REMOVE TOWN'S ILLEGAL SIGN. RETURN TO TOWN~~ MISSING			
SIGN SUMMARY SHEET							SHEET TOTALS	~~27.50~~ ~~32.50~~	0.00	0	0	0	~~7~~ ~~9~~	0	0	~~5~~ ~~6~~			90									
VERMONT AGENCY OF TRANSPORTATION								SF	SF	EA	EA	EA	EA	EA	EA	EA			FT									
							TOWN TOTALS	729.7	0.0	22.0	4.0	4.0	151	0.0	0.0	118			1770.0									

PROJECT NAME: **Stamford-Andover VT100**
PROJECT NUMBER: **STPG SIGN(20)**

FILE NAME: **Londonderrv.xls** PLOT DATE: **8/6/2009**
PROJECT MANAGER: **N. Averv** DRAWN BY: **T. Guazzoni**
DESIGNED BY: **J. Kelly** CHECKED BY: **T. Guazzoni**
LONDONDERRY SHEET 20 SHEET **169** OF **198**

DIRECTION	MILEPOINT	LOCATION CODE (SHEET 2)	SIGN CODE	WIDTH (IN)	HEIGHT (IN)	SHEETING REMARKS	SIGN LEGEND	NEW SIGNS "A"	NEW SIGNS "B"	EXISTING SIGNS RETAIN	EXISTING SIGNS SALVAGE FROM	EXISTING SIGNS SALVAGE TO	EXISTING SIGNS REMOVE	EXIST POST RETAIN	EXIST POST REMOVE	NUMBER OF NEW POSTS	SQUARE STEEL (IN) 1.75 (LB / FT) 1.88	SQUARE STEEL (IN) 2.00 (LB / FT) 2.42	SQUARE STEEL (IN) 2.50 (LB / FT) 3.35	TUBULAR STEEL Ø (IN) FOUNDATION	TUBULAR STEEL Ø (IN) 3.00 (LB / FT) 7.60	TUBULAR STEEL Ø (IN) 3.50 (LB / FT) 9.00	TUBULAR STEEL Ø (IN) 4.00 (LB / FT) 10.80	TUBULAR STEEL Ø (IN) 5.00 (LB / FT) 14.60	SIGN FRAME REQUIRED	REMARKS	SIGN DETAIL: DETAIL IN SHS	SIGN DETAIL: DETAIL ON SHEET NUMBER	SIGN DETAIL: DETAIL ON STD SHEET NUMBER
LONDONDERRY VT 100							FY-FLUORESCENT YELLOW FYG-FLUORESCENT YELLOW GREEN																				"SHS"-STANDARD HIGHWAY SIGNS			
SB	1.815	H	R1-1	30	30				1				X													TH-45, GLEBE VIEW LANE			
		H	R1-1	30	30			6.25								1		X									X		
SB	1.628	F	W1-10R	30	30		RIGHT CURVE WITH LEFT SIDE ROAD						1		X														
SB	1.610	F	VD-062AS	72	16		BUSINESS SIGN			1				X															
SB	1.505	F	W1-10R	30	30			6.25								1		X									INSTALL 650 FEET SOUTH OF EXISTING RIGHT CURVE ASSEMBLY	X		
SB	1.128	F	W1-10L	30	30		LEFT CURVE WITH RH SIDE ROAD						1		X														
		F	W16-8	24	12		SPRING HILL RD						1																
SB	1.050	F	W1-10L	30	30			6.25								1		X									INSTALL 300 FEET NORTH OF THE SPRING HILL RD INTERSECTION	X		
		F	W16-8	30	8			1.67																				8	
SB	0.988	G	VR-017	24	30								1		X													TH-41, SPRING HILL RD			
		G	VR-017	24	30			5.00								1		X											E-141
SB	0.984	H	R1-1	30	30								1		X													TH-41, SPRING HILL RD			
		H	R1-1	30	30			6.25								1		X										X		
SB	0.180	F	W11-7	30	30		EQUESTRIAN						1		X														
SB	0.054	F	W7-1	30	30								1		X														
							SHEET TOTALS	31.67	0.00	1	0	0	8	0	0	5		75											
								SF	SF	EA	EA	EA	EA	EA	EA	EA		FT											
							TOWN TOTALS	729.7	0.0	22.0	4.0	4.0	151	0.0	0.0	118		1770.0											

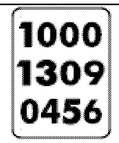
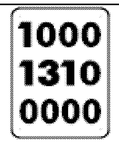
SIGN SUMMARY SHEET

VERMONT AGENCY OF TRANSPORTATION

PROJECT NAME: **Stamford-Andover VT100**
PROJECT NUMBER: **STPG SIGN(20)**

FILE NAME: **Londonderrv.xls**
PROJECT MANAGER: **N. Averv**
DESIGNED BY: **J. Kelly**
LONDONDERRY SHEET 21

PLOT DATE: **8/6/2009**
DRAWN BY: **T. Guazzoni**
CHECKED BY: **T. Guazzoni**
SHEET **170** OF **198**

DIRECTION	MILEPOINT	LOCATION CODE (SHEET 2)	SIGN CODE	WIDTH (IN)	HEIGHT (IN)	SHEETING REMARKS	SIGN LEGEND	NEW SIGNS "A"	NEW SIGNS "B"	EXISTING SIGNS RETAIN	EXISTING SIGNS SALVAGE FROM	EXISTING SIGNS SALVAGE TO	EXISTING SIGNS REMOVE	EXIST POST RETAIN	EXIST POST REMOVE	NUMBER OF NEW POSTS	SQUARE STEEL (IN) 1.75 (LB / FT) 1.88	SQUARE STEEL (IN) 2.00 (LB / FT) 2.42	SQUARE STEEL (IN) 2.50 (LB / FT) 3.35	TUBULAR STEEL Ø (IN) FOUNDATION	TUBULAR STEEL Ø (IN) 3.00 (LB / FT) 7.60	TUBULAR STEEL Ø (IN) 3.50 (LB / FT) 9.00	TUBULAR STEEL Ø (IN) 4.00 (LB / FT) 10.80	TUBULAR STEEL Ø (IN) 5.00 (LB / FT) 14.60	SIGN FRAME REQUIRED	REMARKS	SIGN DETAIL: DETAIL IN SHS	SIGN DETAIL: DETAIL ON SHEET NUMBER	SIGN DETAIL: DETAIL ON STD SHEET NUMBER
LONDONDERRY VT 100							FY-FLUORESCENT YELLOW FYG-FLUORESCENT YELLOW GREEN																			"SHS"-STANDARD HIGHWAY SIGNS			
		F	W7-1b	30	30			6.25								1		X								X		
SB	0.010	F	VW-133R	30	30								1		X														
		F	VW-054R	30	30			6.25								1		X										E-154
SB	0.000	G	VR-024	60	7.5								1		X														
		G	VR-024	72	10			5.00								2		X										4
		G	VR-700	6	10			0.42																			INSTALL BELOW JAMAICA			E-138
		G	VR-700	6	10			0.42																			INSTALL BELOW LONDONDERRY			E-138
NB	5.700	D	RI-1	30	30						I	I				I		X								THIS SIGN WAS REMOVED AND SALVAGED TO THE PLAZA ENTRANCE (SOUTH) PER REQUEST OF M. MILLER, TRAFFIC OPS.			
										(SEE SHEET #159)																		
NB	5.850	D	RI-1	30	30						I	I	I			I		X								THIS SIGN WAS REMOVED AND SALVAGED ONTO A NEW POST AT THE PLAZA ENTRANCE (NORTH) PER REQUEST OF M. MILLER, TRAFFIC OPS.			
NB	5.800	G	RI-1	30	30						I	I	I			I		X								THIS SIGN WAS REMOVED AND SALVAGED ONTO A NEW POST DUE TO THE OLD POST BEING FOUND DAMAGED. THIS LOCATION IS FOR MOTORISTS TRAVELING FROM VT. RT. 100 NORTH TO VT. RT. 11 WEST. REQUEST OF M. MILLER, TRAFFIC OPS.			
							SHEET TOTALS	18.34	0.00	0	2 0	3 0	5 2	0	0	7 4		60											
								SF	SF	EA	EA	EA	EA	EA	EA	EA		FT											
							TOWN TOTALS	729.7	0.0	22.0	4.0	4.0	151	0.0	0.0	118		1770.0											

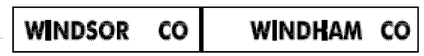
SIGN SUMMARY SHEET

VERMONT AGENCY OF TRANSPORTATION

PROJECT NAME: Stamford-Andover VT100
PROJECT NUMBER: STPG SIGN(20)

FILE NAME: Londonderrv.xls
PROJECT MANAGER: N. Averv
DESIGNED BY: J. Kelly
LONDONDERRY SHEET 22

PLOT DATE: 8/6/2009
DRAWN BY: T. Guazzoni
CHECKED BY: T. Guazzoni
SHEET 171 OF 198

DIRECTION	MILEPOINT	LOCATION CODE (SHEET 2)	SIGN CODE	WIDTH (IN)	HEIGHT (IN)	SHEETING REMARKS	SIGN LEGEND	NEW SIGNS "A"	NEW SIGNS "B"	EXISTING SIGNS RETAIN	EXISTING SIGNS SALVAGE FROM	EXISTING SIGNS SALVAGE TO	EXISTING SIGNS REMOVE	EXIST POST RETAIN	EXIST POST REMOVE	NUMBER OF NEW POSTS	SQUARE STEEL (IN) (LB / FT) 1.75 / 1.88	SQUARE STEEL (IN) (LB / FT) 2.00 / 2.42	SQUARE STEEL (IN) (LB / FT) 2.50 / 3.35	TUBULAR STEEL Ø (IN) FOUNDATION	TUBULAR STEEL Ø (IN) (LB / FT) 3.00 / 7.60	TUBULAR STEEL Ø (IN) (LB / FT) 3.50 / 9.00	TUBULAR STEEL Ø (IN) (LB / FT) 4.00 / 10.80	TUBULAR STEEL Ø (IN) (LB / FT) 5.00 / 14.60	SIGN FRAME REQUIRED	REMARKS	SIGN DETAIL: DETAIL IN SHS	SIGN DETAIL: DETAIL ON SHEET NUMBER	SIGN DETAIL: DETAIL ON STD SHEET NUMBER
WESTON VT 100							FY-FLUORESCENT YELLOW FYG-FLUORESCENT YELLOW GREEN																			"SHS"-STANDARD HIGHWAY SIGNS			
NB	0.000	C	VD-024	60	7.5								1		X													
		C	VD-025	60	7.5								1															
		C	VD-024	72	10			5.00								2		X									4	
		C	VD-025	72	10			5.00																			4	
		C	VD-700	6	10			0.42																		INSTALL BELOW WESTON			E-138
		C	VD-700	6	10			0.42																		INSTALL BELOW LONDONDERRY			E-138
NB	0.195	A	W1-1MR	30	30		RIGHT TURN WITH ANGLED CROSSROADS						1		X													
		A	W13-1	18	18		30 MPH PLAQUE						1															
NB	0.240	A	VW-202	30	30								1		X													
		A	VW-202	30	30			6.25								1		X										E-154
NB	0.278	A	W1-1MeR	30	30	FY		6.25								1		X								INSTALL 200 FEET NORTH OF TRUCKS ENTERING ASSEMBLY		7	
		A	W13-1	18	18	FY		2.25																			X	
NB	0.320	C	VR-017	24	24								1		X											TH-48, LONGLEY LOOP			
		C	VR-017	24	30			5.00								1		X										E-141
NB	0.360	D	R1-1	30	30								1		X											TH-48, LONGLEY LOOP			
							SHEET TOTALS	30.59 SF	0.00 SF	0 EA	0 EA	0 EA	7 EA	0 EA	0 EA	5 EA	75 FT											
							TOWN TOTALS	774.4	0.0	26.0	12.0	12.0	139	0.0	0.0	140	2100.0													

SIGN SUMMARY SHEET

VERMONT AGENCY OF TRANSPORTATION

PROJECT NAME: **Stamford-Andover VT100**
PROJECT NUMBER: **STPG SIGN(20)**

FILE NAME: **Weston.xls**
PROJECT MANAGER: **N. Avery**
DESIGNED BY: **J. Kelly**
WESTON SHEET 1

PLOT DATE: **8/6/2009**
DRAWN BY: **T. Guazzoni**
CHECKED BY: **T. Guazzoni**
SHEET **172** OF **198**

DIRECTION	MILEPOINT	LOCATION CODE (SHEET 2)	SIGN CODE	WIDTH (IN)	HEIGHT (IN)	SHEETING REMARKS	SIGN LEGEND	NEW SIGNS "A"	NEW SIGNS "B"	EXISTING SIGNS RETAIN	EXISTING SIGNS SALVAGE FROM	EXISTING SIGNS SALVAGE TO	EXISTING SIGNS REMOVE	EXIST POST RETAIN	EXIST POST REMOVE	NUMBER OF NEW POSTS	SQUARE STEEL (IN) 1.75 (LB / FT) 1.88	SQUARE STEEL (IN) 2.00 (LB / FT) 2.42	SQUARE STEEL (IN) 2.50 (LB / FT) 3.35	TUBULAR STEEL Ø (IN) FOUNDATION	TUBULAR STEEL Ø (IN) 3.00 (LB / FT) 7.60	TUBULAR STEEL Ø (IN) 3.50 (LB / FT) 9.00	TUBULAR STEEL Ø (IN) 4.00 (LB / FT) 10.80	TUBULAR STEEL Ø (IN) 5.00 (LB / FT) 14.60	SIGN FRAME REQUIRED	REMARKS	SIGN DETAIL: DETAIL IN SHS	SIGN DETAIL: DETAIL ON SHEET NUMBER	SIGN DETAIL: DETAIL ON STD SHEET NUMBER
WESTON VT 100							FY-FLUORESCENT YELLOW FYG-FLUORESCENT YELLOW GREEN																			"SHS"-STANDARD HIGHWAY SIGNS			
		D	R1-1	30	30		LONGLEY LOOP STOP 1000 1421 0034	6.25			|	|				1		X									X		
NB	0.415	C	VR-017	24	30		LEGAL LOAD LIMIT 24,000 POUNDS	5.00								1		X								TH-48, LONGLEY LOOP			E-141
NB	0.420	D	R1-1	30	30		STOP						1		X											TH-48, LONGLEY LOOP			
		D	R1-1	30	30			6.25								1		X									X		
NB	0.430	C	VR-017	24	24		LEGAL LOAD LIMIT 24,000 POUNDS						1		X											TH-48, LONGLEY LOOP			
		C	VR-017	24	30			5.00								1		X											E-141
NB	0.440	D	R1-1	30	30		LONGLEY LOOP STOP				|	|	1		X											TH-48, LONGLEY LOOP			
		D	R1-1	30	30			6.25								1		X									X		
NB	0.647	C	VR-017	24	24		LEGAL LOAD LIMIT 24,000 POUNDS						1		X											TH-36, BOYNTON RD			
		C	VR-017	24	30			5.00								1		X											E-141
NB	0.653	D	R1-1	24	24		STOP						1		X											TH-36, BOYNTON RD			
		D	R1-1	30	30		1000 1421 0065	6.25								1		X									X		
NB	1.510	A	VD-062B	72	16		BUSINESS SIGN			1				X															
NB	1.863	C	VR-017	24	30		DALE RD LEGAL LOAD LIMIT 24,000 POUNDS					|	|	1		X											TH-33, DALE RD			
		C	VR-017	24	30			5.00								1		X											E-141
SIGN SUMMARY SHEET							SHEET TOTALS	45.00	0.00	1	~~3~~ 0	~~3~~ 0	6	0	0	8		120										
VERMONT AGENCY OF TRANSPORTATION								SF	SF	EA	EA	EA	EA	EA	EA	EA		FT									
							TOWN TOTALS	774.4	0.0	26.0	12.0	12.0	139	0.0	0.0	140		2100.0										

PROJECT NAME: **Stamford-Andover VT100**
PROJECT NUMBER: **STPG SIGN(20)**

FILE NAME: **Weston.xls**
PROJECT MANAGER: **N. Avery**
DESIGNED BY: **J. Kelly**
WESTON SHEET 2

PLOT DATE: **8/6/2009**
DRAWN BY: **T. Guazzoni**
CHECKED BY: **T. Guazzoni**
SHEET **173** OF **198**

DIRECTION	MILEPOINT	LOCATION CODE (SHEET 2)	SIGN CODE	WIDTH (IN)	HEIGHT (IN)	SHEETING REMARKS	SIGN LEGEND	NEW SIGNS "A"	NEW SIGNS "B"	EXISTING SIGNS RETAIN	EXISTING SIGNS SALVAGE FROM	EXISTING SIGNS SALVAGE TO	EXISTING SIGNS REMOVE	EXIST POST RETAIN	EXIST POST REMOVE	NUMBER OF NEW POSTS	SQUARE STEEL (IN) 1.75 (LB / FT) 1.88	SQUARE STEEL (IN) 2.00 (LB / FT) 2.42	SQUARE STEEL (IN) 2.50 (LB / FT) 3.35	TUBULAR STEEL Ø (IN) FOUNDATION	TUBULAR STEEL Ø (IN) 3.00 (LB / FT) 7.60	TUBULAR STEEL Ø (IN) 3.50 (LB / FT) 9.00	TUBULAR STEEL Ø (IN) 4.00 (LB / FT) 10.80	TUBULAR STEEL Ø (IN) 5.00 (LB / FT) 14.60	SIGN FRAME REQUIRED	REMARKS	SIGN DETAIL: DETAIL IN SHS	SIGN DETAIL: DETAIL ON SHEET NUMBER	SIGN DETAIL: DETAIL ON STD SHEET NUMBER
WESTON VT 100							FY-FLUORESCENT YELLOW FYG-FLUORESCENT YELLOW GREEN																			"SHS"-STANDARD HIGHWAY SIGNS			
NB	1.873	D	R1-1	30	30				1					X												TH-33, DALE RD			
		D	R1-1	30	30			6.25								1		X									X		
NB	2.155	A	W1-2MgL	30	30		MODIFIED LEFT CURVE 						1		X														
NB	2.278	A	W1-2MgL	30	30			6.25								1		X								INSTALL 650 FEET NORTH OF EXISTING LEFT CURVE ASSEMBLY		7	
NB	2.360	D	R1-1	30	30			6.25								1		X								INSTALL AT EXISTING LEGAL LOAD LIMIT LOCATION	X		
NB	2.360	C	VR-017	24	30								~~1~~		~~X~~												TH-44, FOSTER RD			
		C	VR-017	24	30			5.00								1		X									INSTALL 50' BEYOND EXISTING LOCATION ON TH-44			E-141
NB	2.363	D	R1-1	30	30								1		X												TH-44, FOSTER RD			
		D	R1-1	30	30			6.25								1		X										X		
NB	2.365	A	M3-1S	24	12		NORTH			1				X															
		A	M1-5	30	24		VERMONT 100			1																			
		A	M6-2S	21	15		UP LH ARROW			1																			
NB	2.445	A	VD-062AS	72	16		BUSINESS SIGN			1				X															
NB	2.530	A	W3-5	36	36		SPEED REDUCTION (40)			1				X															
NB	2.662	A	R2-1	24	30		SPEED LIMIT 40						1		X														
							SHEET TOTALS	30.00	0.00	5	0	0	5	0	0	5		75										
								SF	SF	EA	EA	EA	EA	EA	EA	EA		FT										
							TOWN TOTALS	774.4	0.0	26.0	12.0	12.0	139	0.0	0.0	140		2100.0										

SIGN SUMMARY SHEET

VERMONT AGENCY OF TRANSPORTATION

PROJECT NAME: **Stamford-Andover VT100**
PROJECT NUMBER: **STPG SIGN(20)**

FILE NAME: **Weston.xls**
PROJECT MANAGER: **N. Avery**
DESIGNED BY: **J. Kelly**
WESTON SHEET 3

PLOT DATE: **8/6/2009**
DRAWN BY: **T. Guazzoni**
CHECKED BY: **T. Guazzoni**
SHEET **174** OF **198**

DIRECTION	MILEPOINT	LOCATION CODE (SHEET 2)	SIGN CODE	WIDTH (IN)	HEIGHT (IN)	SHEETING REMARKS	SIGN LEGEND	NEW SIGNS "A"	NEW SIGNS "B"	EXISTING SIGNS RETAIN	EXISTING SIGNS SALVAGE FROM	EXISTING SIGNS SALVAGE TO	EXISTING SIGNS REMOVE	EXIST POST RETAIN	EXIST POST REMOVE	NUMBER OF NEW POSTS	SQUARE STEEL (IN) 1.75 (LB / FT) 1.88	SQUARE STEEL (IN) 2.00 (LB / FT) 2.42	SQUARE STEEL (IN) 2.50 (LB / FT) 3.35	TUBULAR STEEL Ø (IN) FOUNDATION	TUBULAR STEEL Ø (IN) 3.00 (LB / FT) 7.60	TUBULAR STEEL Ø (IN) 3.50 (LB / FT) 9.00	TUBULAR STEEL Ø (IN) 4.00 (LB / FT) 10.80	TUBULAR STEEL Ø (IN) 5.00 (LB / FT) 14.60	SIGN FRAME REQUIRED	REMARKS	SIGN DETAIL: DETAIL IN SHS	SIGN DETAIL: DETAIL ON SHEET NUMBER	SIGN DETAIL: DETAIL ON STD SHEET NUMBER
WESTON VT 100							FY-FLUORESCENT YELLOW FYG-FLUORESCENT YELLOW GREEN																				"SHS"-STANDARD HIGHWAY SIGNS			
NB	2.668	A	R2-1	30	36		SPEED LIMIT 40	7.50								1		X								INSTALL 30 FEET NORTH OF EXISTING SPEED LIMIT 40 SIGN		6	
NB	2.736	C	VR-017	24	30		PIPER HILL RD						1		X											TH-44, PIPER HILL RD			
		C	VR-017	24	30		LEGAL LOAD LIMIT 24,000 POUNDS	5.00								1		X											E-141
NB	2.741	D	R1-1	30	30								1		X											TH-44, PIPER HILL RD			
		D	R1-1	30	30		1000 1421 0274 STOP	6.25								1		X										X	
NB	2.767	A	W3-5	36	36		SPEED REDUCTION (30)			1				X															
NB	2.810	A	VD-018	30	18		WESTON LUDLOW 11						1		X														
		A	VD-018	30	18			3.75								1		X											E-128A
NB	2.850	A	R2-1	24	30		SPEED LIMIT 30						1		X														
NB	2.895	A	R2-1	30	36			7.50								1		X								INSTALL 240 FEET NORTH OF EXISTING AND SOUTH OF UTILITY POLE		6	
NB	2.942	A	W11-2	30	30		PEDESTRIAN			1				X															
		A	W16-9	24	12		AHEAD			1																			
NB	3.010	A	R2-1	24	30		SPEED LIMIT 30						1		X														
		A	R2-1	24	30			5.00								1		X										X	
NB	3.052	A	W11-2	30	30		PEDESTRIAN			1				X															
							SHEET TOTALS	35.00	0.00	4	0	0	5	0	0	6		90											
								SF	SF	EA	EA	EA	EA	EA	EA	EA		FT											
							TOWN TOTALS	774.4	0.0	26.0	12.0	12.0	139	0.0	0.0	140		2100.0											

SIGN SUMMARY SHEET

VERMONT AGENCY OF TRANSPORTATION

PROJECT NAME: **Stamford-Andover VT100**
PROJECT NUMBER: **STPG SIGN(20)**

FILE NAME: **Weston.xls**
PROJECT MANAGER: **N. Avery**
DESIGNED BY: **J. Kelly**
WESTON SHEET 4

PLOT DATE: **8/6/2009**
DRAWN BY: **T. Guazzoni**
CHECKED BY: **T. Guazzoni**
SHEET **175** OF **198**

DIRECTION	MILEPOINT	LOCATION CODE (SHEET 2)	SIGN CODE	WIDTH (IN)	HEIGHT (IN)	SHEETING REMARKS	SIGN LEGEND	NEW SIGNS "A"	NEW SIGNS "B"	EXISTING SIGNS RETAIN	EXISTING SIGNS SALVAGE FROM	EXISTING SIGNS SALVAGE TO	EXISTING SIGNS REMOVE	EXIST POST RETAIN	EXIST POST REMOVE	NUMBER OF NEW POSTS	SQUARE STEEL (IN) 1.75 (LB / FT) 1.88	SQUARE STEEL (IN) 2.00 (LB / FT) 2.42	SQUARE STEEL (IN) 2.50 (LB / FT) 3.35	TUBULAR STEEL Ø (IN) FOUNDATION	TUBULAR STEEL Ø (IN) 3.00 (LB / FT) 7.60	TUBULAR STEEL Ø (IN) 3.50 (LB / FT) 9.00	TUBULAR STEEL Ø (IN) 4.00 (LB / FT) 10.80	TUBULAR STEEL Ø (IN) 5.00 (LB / FT) 14.60	SIGN FRAME REQUIRED	REMARKS	SIGN DETAIL: DETAIL IN SHS	SIGN DETAIL: DETAIL ON SHEET NUMBER	SIGN DETAIL: DETAIL ON STD SHEET NUMBER
WESTON VT 100							FY-FLUORESCENT YELLOW FYG-FLUORESCENT YELLOW GREEN																				"SHS"-STANDARD HIGHWAY SIGNS			
NB	3.052	A	W16-4	24	18		NEXT 1000 FEET			1																			
NB	3.060	C	VR-052L	24	30		NO PARKING (LEFT ARROW)			~~1~~	1	1	1	~~X~~	X												OLD POST WAS REPLACED			
NB	3.075	C	VR-052	24	30		NO PARKING (DOUBLE ARROW)				1	1			X	1		X									RETAIN SIGN, INSTALL ON NEW POST			
NB	3.120	C	VR-052R	12	18		NO PARKING (RIGHT ARROW)				1																RELOCATE SIGN 35 FEET NORTH			
NB	3.127	C	VR-052R	12	18		NO PARKING (RIGHT ARROW)					1				1		X									INSTALL 35 FEET NORTH OF EXISTING			
NB	3.155	A	W1-1R	30	30		RIGHT TURN						1		X															
		A	W13-1	18	18		25 MPH PLAQUE						1																	
		C	VR-052L	24	30			5.00								1		X									INSTALL 50 FEET SOUTH OF EXISTING		7	
NB	3.165	C	VR-052L	24	30		NO PARKING (LEFT ARROW)						1		X															
NB	3.187	C	VR-017	24	24								1		X													TH-39, MARKHAM LANE			
		C	VR-017	24	30			5.00								1		X												E-141
NB	3.193	D	R1-1	30	30								1		X												TH-39, MARKHAM LANE			
		D	R1-1	30	30		1000 1421 0319 	6.25								1		X										X		
NB	~~3.210~~ 3.216	C	VR-052	12	18		NO PARKING (DOUBLE ARROW)			~~1~~	~~1~~	~~1~~	~~1~~	~~X~~	X												THIS SIGN WAS RELOCATED TO NB MM 3.216 RT. WHERE NEW HIDDEN DRIVE RIGHT WAS INSTALLED. SEE SHEET #194			
NB	3.259	A	R2-1	24	30								1		X															
							SHEET TOTALS	16.25	0.00	3	~~4~~ 2	~~4~~ 2	~~8~~ 6	0	0	5		75											
								SF	SF	EA	EA	EA	EA	EA	EA	EA		FT											
							TOWN TOTALS	774.4	0.0	26.0	12.0	12.0	139	0.0	0.0	140		2100.0											

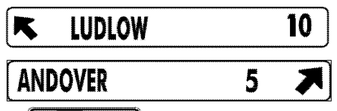
SIGN SUMMARY SHEET

VERMONT AGENCY OF TRANSPORTATION

PROJECT NAME: **Stamford-Andover VT100**
PROJECT NUMBER: **STPG SIGN(20)**

FILE NAME: **Weston.xls**
PROJECT MANAGER: **N. Avery**
DESIGNED BY: **J. Kelly**
WESTON SHEET 5

PLOT DATE: **8/6/2009**
DRAWN BY: **T. Guazzoni**
CHECKED BY: **T. Guazzoni**
SHEET **176** OF **198**

DIRECTION	MILEPOINT	LOCATION CODE (SHEET 2)	SIGN CODE	WIDTH (IN)	HEIGHT (IN)	SHEETING REMARKS	SIGN LEGEND	NEW SIGNS "A"	NEW SIGNS "B"	EXISTING SIGNS RETAIN	EXISTING SIGNS SALVAGE FROM	EXISTING SIGNS SALVAGE TO	EXISTING SIGNS REMOVE	EXIST POST RETAIN	EXIST POST REMOVE	NUMBER OF NEW POSTS	SQUARE STEEL (IN) 1.75 (LB / FT) 1.88	SQUARE STEEL (IN) 2.00 (LB / FT) 2.42	SQUARE STEEL (IN) 2.50 (LB / FT) 3.35	TUBULAR STEEL Ø (IN) FOUNDATION	TUBULAR STEEL Ø (IN) 3.00 (LB / FT) 7.60	TUBULAR STEEL Ø (IN) 3.50 (LB / FT) 9.00	TUBULAR STEEL Ø (IN) 4.00 (LB / FT) 10.80	TUBULAR STEEL Ø (IN) 5.00 (LB / FT) 14.60	SIGN FRAME REQUIRED	REMARKS	SIGN DETAIL: DETAIL IN SHS	SIGN DETAIL: DETAIL ON SHEET NUMBER	SIGN DETAIL: DETAIL ON STD SHEET NUMBER
WESTON VT 100							FY-FLUORESCENT YELLOW FYG-FLUORESCENT YELLOW GREEN																			"SHS"-STANDARD HIGHWAY SIGNS			
		A	R8-3A	24	24		NO PARKING SYMBOL 		1																			
		A	R2-1	24	30			5.00								1		X							INSTALL SIGN ON TOP	X		
		C	VR-052	24	30			5.00																				7	
NB	3.360	A	D1-1A	54	7.5		ANDOVER 5 ---> 						1		X														
		A	W1-10L	30	30			6.25								1		X										X	
NB	3.363	C	VR-052L	24	30		DOUBLE NO PARKING (~~LEFT~~ ARROW) 						1		X														
		C	VR-052	24	30			5.00								1		X										7	
NB	3.405	C	VR-052R	24	30		NO PARKING RIGHT ARROW 1000 1421 0000						1		X														
RETAINED SIGN. SEE SHEET # 194																													
NB	3.405	A	M3-1S	24	12								1		X														
		A	M1-5	30	24								1																
		A	M6-2S	21	15								1																
		A	D1-1A	72	12			6.00								2		X										5	
		A	D1-1A	72	12			6.00																				5	
		A	M3-1	24	12			2.00																			GREEN ON WHITE SHEETING	X		
		A	M1-5	30	24			5.00																					E-136B
							SHEET TOTALS	40.25 SF	0.00 SF	0 EA	0 EA	0 EA	7 EA	0 EA	0 EA	5 EA			75 FT									
							TOWN TOTALS	774.4	0.0	26.0	12.0	12.0	139	0.0	0.0	140			2100.0									

SIGN SUMMARY SHEET

VERMONT AGENCY OF TRANSPORTATION

PROJECT NAME: **Stamford-Andover VT100**
PROJECT NUMBER: **STPG SIGN(20)**

FILE NAME: **Weston.xls**
PROJECT MANAGER: **N. Averv**
DESIGNED BY: **J. Kelly**
WESTON SHEET 6

PLOT DATE: **8/6/2009**
DRAWN BY: **T. Guazzoni**
CHECKED BY: **T. Guazzoni**
SHEET **177** OF **198**

DIRECTION	MILEPOINT	LOCATION CODE (SHEET 2)	SIGN CODE	WIDTH (IN)	HEIGHT (IN)	SHEETING REMARKS	SIGN LEGEND	NEW SIGNS "A"	NEW SIGNS "B"	EXISTING SIGNS RETAIN	EXISTING SIGNS SALVAGE FROM	EXISTING SIGNS SALVAGE TO	EXISTING SIGNS REMOVE	EXIST POST RETAIN	EXIST POST REMOVE	NUMBER OF NEW POSTS	SQUARE STEEL (IN) 1.75 (LB / FT) 1.88	SQUARE STEEL (IN) 2.00 (LB / FT) 2.42	SQUARE STEEL (IN) 2.50 (LB / FT) 3.35	TUBULAR STEEL Ø (IN) FOUNDATION	TUBULAR STEEL Ø (IN) 3.00 (LB / FT) 7.60	TUBULAR STEEL Ø (IN) 3.50 (LB / FT) 9.00	TUBULAR STEEL Ø (IN) 4.00 (LB / FT) 10.80	TUBULAR STEEL Ø (IN) 5.00 (LB / FT) 14.60	SIGN FRAME REQUIRED	REMARKS	SIGN DETAIL: DETAIL IN SHS	SIGN DETAIL: DETAIL ON SHEET NUMBER	SIGN DETAIL: DETAIL ON STD SHEET NUMBER
WESTON VT 100							FY-FLUORESCENT YELLOW FYG-FLUORESCENT YELLOW GREEN																			"SHS"-STANDARD HIGHWAY SIGNS			
		A	M6-2L	21	15			2.19																		GREEN ON WHITE SHEETING	X		
NB	3.405	C	VR-052R	24	30			5.00								1		X								INSTALL PARALLEL TO ROADWAY BESIDE ROUTE MARKER ASSEMBLY		7	
NB	3.435	C	VR-017	24	24								1		X											TH-1, CHESTER MOUNTAIN RD			
		C	VR-017	24	30			5.00								1		X											E-141
NB	3.435	D	R1-1	30	30								1		X											TH-1, CHESTER MOUNTAIN RD			
		D	R1-1	30	30			6.25								1		X									X		
NB	3.465	A	R2-1	24	30								1		X														
		A	R2-1	24	30			5.00								1		X									X		
NB	3.517	A	M3-1S	24	12		NORTH			1				X															
		A	M1-5	30	24		VERMONT 100			1																			
NB	3.670	A	R2-1	24	30								1		X														
		A	R2-1	24	30			5.00								1		X									X		
NB	3.973	C	VR-017	24	24								1		X											TH-20, BURTON RD			
		C	VR-017	24	30			5.00								1		X											E-141
NB	3.979	D	R1-1	30	30								1		X											TH-20, BURTON RD			
							SHEET TOTALS	33.44	0.00	2	~~0~~	~~0~~	6	0	0	6		90										
								SF	SF	EA	EA	EA	EA	EA	EA	EA		FT										
							TOWN TOTALS	774.4	0.0	26.0	12.0	12.0	139	0.0	0.0	140		2100.0										

SIGN SUMMARY SHEET

VERMONT AGENCY OF TRANSPORTATION

PROJECT NAME: **Stamford-Andover VT100**
PROJECT NUMBER: **STPG SIGN(20)**

FILE NAME: **Weston.xls**
PROJECT MANAGER: **N. Avery**
DESIGNED BY: **J. Kelly**
WESTON SHEET 7

PLOT DATE: **8/6/2009**
DRAWN BY: **T. Guazzoni**
CHECKED BY: **T. Guazzoni**
SHEET **178** OF **198**

DIRECTION	MILEPOINT	LOCATION CODE (SHEET 2)	SIGN CODE	WIDTH (IN)	HEIGHT (IN)	SHEETING REMARKS	SIGN LEGEND	NEW SIGNS "A"	NEW SIGNS "B"	EXISTING SIGNS RETAIN	EXISTING SIGNS SALVAGE FROM	EXISTING SIGNS SALVAGE TO	EXISTING SIGNS REMOVE	EXIST POST RETAIN	EXIST POST REMOVE	NUMBER OF NEW POSTS	SQUARE STEEL (IN) (LB / FT) 1.75 / 1.88	SQUARE STEEL (IN) (LB / FT) 2.00 / 2.42	SQUARE STEEL (IN) (LB / FT) 2.50 / 3.35	TUBULAR STEEL Ø (IN) FOUNDATION	TUBULAR STEEL Ø (IN) (LB / FT) 3.00 / 7.60	TUBULAR STEEL Ø (IN) (LB / FT) 3.50 / 9.00	TUBULAR STEEL Ø (IN) (LB / FT) 4.00 / 10.80	TUBULAR STEEL Ø (IN) (LB / FT) 5.00 / 14.60	SIGN FRAME REQUIRED	REMARKS	SIGN DETAIL: DETAIL IN SHS	SIGN DETAIL: DETAIL ON SHEET NUMBER	SIGN DETAIL: DETAIL ON STD SHEET NUMBER
WESTON VT 100							FY-FLUORESCENT YELLOW FYG-FLUORESCENT YELLOW GREEN																			"SHS"-STANDARD HIGHWAY SIGNS			
		D	R1-1	30	30		BURTON RD / STOP	6.25			|	|				1		X								X		
NB	4.552	C	VR-017	24	30		LEGAL LOAD LIMIT 24,000 POUNDS						1		X											TH-56, MAPLE HILL RD			
		C	VR-017	24	30			5.00								1		X										E-141
NB	4.558	D	R1-1	30	30								1		X											TH-56, MAPLE HILL RD			
		D	R1-1	30	30		1000 1421 0456 / STOP	6.25								1		X									X		
NB	5.005	A	VD-062B	72	16		BUSINESS SIGN			1				X															
		A	VD-062AS	72	16		BUSINESS SIGN			1																			
NB	5.225	A	R2-1	24	30		SPEED LIMIT 50						1		X														
NB	5.300	A	R2-1	24	30		SPEED LIMIT 50	5.00								1		X								INSTALL 400 FEET NORTH OF EXISTING SPEED LIMIT 50 SIGN	X		
NB	5.472	C	VR-017	24	30		LEGAL LOAD LIMIT 24,000 POUNDS						1		X											TH-15, FELTON RD			
		C	VR-017	24	30			5.00								1		X										E-141
NB	5.478	D	R1-1	30	30								1		X											TH-15, FELTON RD			
		D	R1-1	30	30		1000 1421 0546 / STOP	6.25								1		X									X		
NB	5.975	C	VR-017	24	30		LEGAL LOAD LIMIT 16,000 POUNDS						1		X											TH-14, KILE RD			
		C	VR-017	24	30			5.00								1		X										E-141
SIGN SUMMARY SHEET							SHEET TOTALS	38.75	0.00	2	0	0	6	0	0	7		105										
								SF	SF	EA	EA	EA	EA	EA	EA	EA		FT										
VERMONT AGENCY OF TRANSPORTATION							TOWN TOTALS	774.4	0.0	26.0	12.0	12.0	139	0.0	0.0	140		2100.0										

PROJECT NAME: Stamford-Andover VT100
PROJECT NUMBER: STPG SIGN(20)

FILE NAME: Weston.xls
PROJECT MANAGER: N. Averv
DESIGNED BY: J. Kelly
WESTON SHEET 8

PLOT DATE: 8/6/2009
DRAWN BY: T. Guazzoni
CHECKED BY: T. Guazzoni
SHEET 179 OF 198

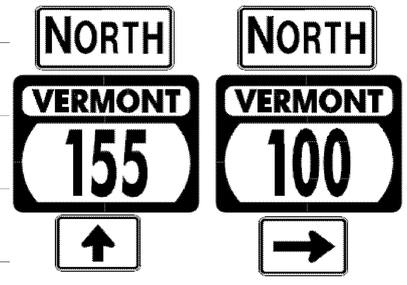
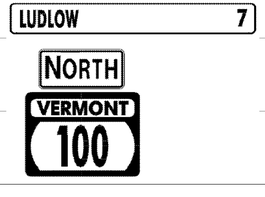
DIRECTION	MILEPOINT	LOCATION CODE (SHEET 2)	SIGN CODE	WIDTH (IN)	HEIGHT (IN)	SHEETING REMARKS	SIGN LEGEND	NEW SIGNS "A"	NEW SIGNS "B"	EXISTING SIGNS RETAIN	EXISTING SIGNS SALVAGE FROM	EXISTING SIGNS SALVAGE TO	EXISTING SIGNS REMOVE	EXIST POST RETAIN	EXIST POST REMOVE	NUMBER OF NEW POSTS	SQUARE STEEL (IN) 1.75 (LB / FT) 1.88	SQUARE STEEL (IN) 2.00 (LB / FT) 2.42	SQUARE STEEL (IN) 2.50 (LB / FT) 3.35	FOUNDATION	TUBULAR STEEL Ø (IN) 3.00 (LB / FT) 7.60	TUBULAR STEEL Ø (IN) 3.50 (LB / FT) 9.00	TUBULAR STEEL Ø (IN) 4.00 (LB / FT) 10.80	TUBULAR STEEL Ø (IN) 5.00 (LB / FT) 14.60	SIGN FRAME REQUIRED	REMARKS	SIGN DETAIL: DETAIL IN SHS	SIGN DETAIL: DETAIL ON SHEET NUMBER	SIGN DETAIL: DETAIL ON STD SHEET NUMBER
WESTON VT 100							FY-FLUORESCENT YELLOW FYG-FLUORESCENT YELLOW GREEN																				"SHS"-STANDARD HIGHWAY SIGNS			
NB	5.981	D	R1-1	30	30		1000 1421 0598						1		X											TH-14, KILE RD			
		D	R1-1	30	30			6.25								1		X									X		
NB	6.420	A	M2-1	21	15			2.19								1		X								INSTALL 200 FEET SOUTH OF EXISTING JCT VT-155 ASSEMBLY. GREEN ON WHITE SHEETING	X		
		A	M1-5	30	24			5.00																					E-136B
NB	6.460	A	M2-1	21	15		JCT						1		X														
		A	M1-5	30	24		VERMONT 155						1																
		A	W1-1MbR	36	36	FY		9.00								2		X										6	
		A	W13-1	24	24	FY	25 M.P.H.	4.00																		INSTALL ON LEFT POST	X		
NB	6.505	A	D1-1A	72	10								1		X														
		A	D1-1A	72	10								1																
		A	D1-1A	72	12		E WALLINGFORD 11	6.00								2		X										5	
		A	D1-1A	72	12		LUDLOW 7	6.00																				5	
NB	6.540	A	M3-1S	24	12								1		X														
		A	M1-5	30	24								1																
		A	M6-3S	21	15								1																
							SHEET TOTALS	38.44	0.00	0	0	0	8	0	0	6		90											
								SF	SF	EA	EA	EA	EA	EA	EA	EA		FT											
							TOWN TOTALS	774.4	0.0	26.0	12.0	12.0	139	0.0	0.0	140		2100.0											

SIGN SUMMARY SHEET

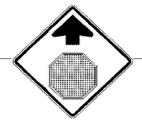
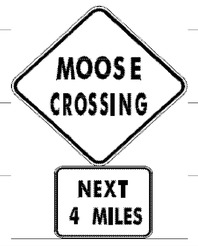
VERMONT AGENCY OF TRANSPORTATION

PROJECT NAME: **Stamford-Andover VT100**
PROJECT NUMBER: **STPG SIGN(20)**

FILE NAME: **Weston.xls** PLOT DATE: **8/6/2009**
PROJECT MANAGER: **N. Averv** DRAWN BY: **T. Guazzoni**
DESIGNED BY: **J. Kelly** CHECKED BY: **T. Guazzoni**
WESTON SHEET 9 SHEET **180** OF **198**

DIRECTION	MILEPOINT	LOCATION CODE (SHEET 2)	SIGN CODE	WIDTH (IN)	HEIGHT (IN)	SHEETING REMARKS	SIGN LEGEND	NEW SIGNS "A"	NEW SIGNS "B"	EXISTING SIGNS RETAIN	EXISTING SIGNS SALVAGE FROM	EXISTING SIGNS SALVAGE TO	EXISTING SIGNS REMOVE	EXIST POST RETAIN	EXIST POST REMOVE	NUMBER OF NEW POSTS	SQUARE STEEL (IN) 1.75 (LB / FT) 1.88	SQUARE STEEL (IN) 2.00 (LB / FT) 2.42	SQUARE STEEL (IN) 2.50 (LB / FT) 3.35	TUBULAR STEEL Ø (IN) FOUNDATION	TUBULAR STEEL Ø (IN) 3.00 (LB / FT) 7.60	TUBULAR STEEL Ø (IN) 3.50 (LB / FT) 9.00	TUBULAR STEEL Ø (IN) 4.00 (LB / FT) 10.80	TUBULAR STEEL Ø (IN) 5.00 (LB / FT) 14.60	SIGN FRAME REQUIRED	REMARKS	SIGN DETAIL: DETAIL IN SHS	SIGN DETAIL: DETAIL ON SHEET NUMBER	SIGN DETAIL: DETAIL ON STD SHEET NUMBER
WESTON VT 100							FY-FLUORESCENT YELLOW FYG-FLUORESCENT YELLOW GREEN																			"SHS"-STANDARD HIGHWAY SIGNS			
		A	M3-1S	24	12								1																
		A	M1-5	30	24								1																
		A	M6-1S	21	15								1																
		A	M3-1	24	12			2.00								2		X							#2B	GREEN ON WHITE SHEETING	X	7	
		A	M1-5	30	24			5.00																		E-136B
		A	M6-3	21	15			2.19																		GREEN ON WHITE SHEETING	X		
		A	M3-1	24	12			2.00																		GREEN ON WHITE SHEETING	X		
		A	M1-5	30	24			5.00																					E-136B
		A	M6-1R	21	15			2.19																		GREEN ON WHITE SHEETING	X		
NB	6.565	B	R1-1	30	30								1		X															
		B	R1-1	36	36			9.00								2		X									X		
NB	6.585	A	M3-1S	24	12								1		X															
		A	M1-5	30	24								1																
		A	D2-1	72	12			6.00								2		X									5		
		A	M3-1	24	12			2.00																		INSTALL ON LEFT POST. GREEN ON WHITE SHEETING	X		
SIGN SUMMARY SHEET							SHEET TOTALS	35.38 SF	0.00 SF	0 EA	0 EA	0 EA	6 EA	0 EA	0 EA	6 EA		90 FT										
VERMONT AGENCY OF TRANSPORTATION							TOWN TOTALS	774.4	0.0	26.0	12.0	12.0	139	0.0	0.0	140		2100.0										

PROJECT NAME: **Stamford-Andover VT100**
PROJECT NUMBER: **STPG SIGN(20)**
FILE NAME: **Weston.xls**
PROJECT MANAGER: **N. Avery**
DESIGNED BY: **J. Kelly**
WESTON SHEET 10
PLOT DATE: **8/6/2009**
DRAWN BY: **T. Guazzoni**
CHECKED BY: **T. Guazzoni**
SHEET **181** OF **198**

DIRECTION	MILEPOINT	LOCATION CODE (SHEET 2)	SIGN CODE	WIDTH (IN)	HEIGHT (IN)	SHEETING REMARKS	SIGN LEGEND	NEW SIGNS "A"	NEW SIGNS "B"	EXISTING SIGNS RETAIN	EXISTING SIGNS SALVAGE FROM	EXISTING SIGNS SALVAGE TO	EXISTING SIGNS REMOVE	EXIST POST RETAIN	EXIST POST REMOVE	NUMBER OF NEW POSTS	SQUARE STEEL (IN) 1.75 (LB / FT) 1.88	SQUARE STEEL (IN) 2.00 (LB / FT) 2.42	SQUARE STEEL (IN) 2.50 (LB / FT) 3.35	FOUNDATION	TUBULAR STEEL Ø (IN) 3.00 (LB / FT) 7.60	TUBULAR STEEL Ø (IN) 3.50 (LB / FT) 9.00	TUBULAR STEEL Ø (IN) 4.00 (LB / FT) 10.80	TUBULAR STEEL Ø (IN) 5.00 (LB / FT) 14.60	SIGN FRAME REQUIRED	REMARKS	SIGN DETAIL: DETAIL IN SHS	SIGN DETAIL: DETAIL ON SHEET NUMBER	SIGN DETAIL: DETAIL ON STD SHEET NUMBER
WESTON VT 100							FY-FLUORESCENT YELLOW FYG-FLUORESCENT YELLOW GREEN																				"SHS"-STANDARD HIGHWAY SIGNS			
		A	M1-5	30	24			5.00																			INSTALL ON LEFT POST			E-136B
NB	6.630	A	D2-1	72	10		LUDLOW 7						1		X														
NB	6.720	A	R2-1	24	30								1		X															
		A	R2-1	24	30			5.00								1		X										X		
NB	6.760	B	W3-1	36	36								1		X													MM. FACES SB TRAFFIC (BACK-TO-BACK) WITH W3-1.			
		B	W3-1	36	36			9.00								2		X									INSTALL BETWEEN PAVEMENT STENCILS AND ACROSS FROM SB ASSEMBLY	X		
NB	6.910	A	VW-000	30	30								1		X															
		A	W7-3A	24	18								1																
		A	VW-000	30	30			6.25								1		X											E-153
		A	W7-3A	24	18			3.00																				X	
NB	7.010	A	S3-1	30	30								1		X															
		A	W2-2MaR	30	30			6.25																INSTALL ABOVE SCHOOL BUS STOP AHEAD SIGN		6	
		A	S3-1	30	30		NOT INSTALLED HERE, SEE SHEET # 139.	~~6.25~~																			THIS SALVAGED SIGN WAS INSTALLED AT JAMAICA NB MM. 3.220	X		
NB	7.101	C	VR-017	24	30								1		X													TH-42, CIDER MILL RD			
		C	VR-017	24	30			5.00								1		X												E-141
							SHEET TOTALS	~~39.50~~ ~~45.75~~	0.00	0	0	0	7	0	0	7		105											
								SF	SF	EA	EA	EA	EA	EA	EA	EA		FT										
							TOWN TOTALS	774.4	0.0	26.0	12.0	12.0	139	0.0	0.0	140		2100.0										

SIGN SUMMARY SHEET

VERMONT AGENCY OF TRANSPORTATION

PROJECT NAME: **Stamford-Andover VT100**
PROJECT NUMBER: **STPG SIGN(20)**

FILE NAME: **Weston.xls**
PROJECT MANAGER: **N. Avery**
DESIGNED BY: **J. Kelly**
WESTON SHEET 11

PLOT DATE: **8/6/2009**
DRAWN BY: **T. Guazzoni**
CHECKED BY: **T. Guazzoni**
SHEET **182** OF **198**

DIRECTION	MILEPOINT	LOCATION CODE (SHEET 2)	SIGN CODE	WIDTH (IN)	HEIGHT (IN)	SHEETING REMARKS	SIGN LEGEND	NEW SIGNS "A"	NEW SIGNS "B"	EXISTING SIGNS RETAIN	EXISTING SIGNS SALVAGE FROM	EXISTING SIGNS SALVAGE TO	EXISTING SIGNS REMOVE	EXIST POST RETAIN	EXIST POST REMOVE	NUMBER OF NEW POSTS	SQUARE STEEL (IN) 1.75 (LB / FT) 1.88	SQUARE STEEL (IN) 2.00 (LB / FT) 2.42	SQUARE STEEL (IN) 2.50 (LB / FT) 3.35	FOUNDATION	TUBULAR STEEL Ø (IN) 3.00 (LB / FT) 7.60	TUBULAR STEEL Ø (IN) 3.50 (LB / FT) 9.00	TUBULAR STEEL Ø (IN) 4.00 (LB / FT) 10.80	TUBULAR STEEL Ø (IN) 5.00 (LB / FT) 14.60	SIGN FRAME REQUIRED	REMARKS	SIGN DETAIL: DETAIL IN SHS	SIGN DETAIL: DETAIL ON SHEET NUMBER	SIGN DETAIL: DETAIL ON STD SHEET NUMBER
WESTON VT 100							FY-FLUORESCENT YELLOW FYG-FLUORESCENT YELLOW GREEN																				"SHS"-STANDARD HIGHWAY SIGNS			
NB	7.106	D	R1-1	30	30		1000 1421 0713 STOP		1					X												TH-42, CIDER MILL RD			
		D	R1-1	30	30			6.25								1		X									X		
SB	7.957	G	VR-017	24	30		SLAWSON RD 1000 1421 0799 LEGAL LOAD LIMIT 24,000 POUNDS						1	X													TH-54, SLAWSON RD			
		G	VR-017	24	30			5.00								1		X											E-141
SB	7.951	H	R1-1	30	30		STOP						1	X													TH-54, SLAWSON RD			
		H	R1-1	30	30			6.25								1		X										X	
SB	7.897	F	W7-1b	30	30		9% TRUCKS USE LOWER GEAR NEXT 1/2 MILE	6.25								2		X									INSTALL 300 FEET SOUTH OF TH-54, SLAWSON RD	X		
		F	W7-2A	24	18			3.00																			INSTALL ON LEFT POST	X		
		F	W7-3A	24	18			3.00																			INSTALL ON RIGHT POST	X		
SB	7.610	F	W7-1	30	30		HILL SYMBOL						1	X																
		F	W7-2A	24	18		TRUCKS USE LOWER GEAR						1																	
SB	6.760	F	W3-1	36	36								1	X																
		F	W3-1	36	36			9.00								2		X										X	
SB	6.715	F	M2-1S	21	15								1																	
		F	M1-5	30	24								1																	
							SHEET TOTALS	38.75	0.00	0	~~0~~	~~0~~	8	0	0	7		105											
								SF	SF	EA	EA	EA	EA	EA	EA	EA		FT											
							TOWN TOTALS	774.4	0.0	26.0	12.0	12.0	139	0.0	0.0	140		2100.0											

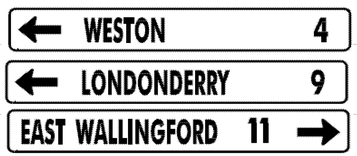
SIGN SUMMARY SHEET

VERMONT AGENCY OF TRANSPORTATION

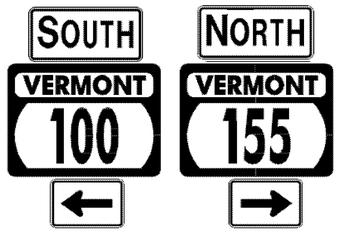
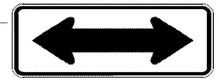
PROJECT NAME: **Stamford-Andover VT100**
PROJECT NUMBER: **STPG SIGN(20)**

FILE NAME: **Weston.xls**
PROJECT MANAGER: **N. Avery**
DESIGNED BY: **J. Kelly**
WESTON SHEET 12

PLOT DATE: **8/6/2009**
DRAWN BY: **T. Guazzoni**
CHECKED BY: **T. Guazzoni**
SHEET **183** OF **198**

DIRECTION	MILEPOINT	LOCATION CODE (SHEET 2)	SIGN CODE	WIDTH (IN)	HEIGHT (IN)	SHEETING REMARKS	SIGN LEGEND	NEW SIGNS "A"	NEW SIGNS "B"	EXISTING SIGNS RETAIN	EXISTING SIGNS SALVAGE FROM	EXISTING SIGNS SALVAGE TO	EXISTING SIGNS REMOVE	EXIST POST RETAIN	EXIST POST REMOVE	NUMBER OF NEW POSTS	SQUARE STEEL (IN) (LB / FT) 1.75 1.88	SQUARE STEEL (IN) (LB / FT) 2.00 2.42	SQUARE STEEL (IN) (LB / FT) 2.50 3.35	TUBULAR STEEL Ø (IN) FOUNDATION	TUBULAR STEEL Ø (IN) (LB / FT) 3.00 7.60	TUBULAR STEEL Ø (IN) (LB / FT) 3.50 9.00	TUBULAR STEEL Ø (IN) (LB / FT) 4.00 10.80	TUBULAR STEEL Ø (IN) (LB / FT) 5.00 14.60	SIGN FRAME REQUIRED	REMARKS	SIGN DETAIL: DETAIL IN SHS	SIGN DETAIL: DETAIL ON SHEET NUMBER	SIGN DETAIL: DETAIL ON STD SHEET NUMBER
WESTON VT 100							FY-FLUORESCENT YELLOW FYG-FLUORESCENT YELLOW GREEN																			"SHS"-STANDARD HIGHWAY SIGNS			
		F	M2-1	21	15			2.19								1		X							GREEN ON WHITE SHEETING	X		
		F	M1-5	30	24			5.00																				E-136B
SB	6.675	F	D1-1A	72	10								1		X													
		F	D1-1A	72	10								1															
		F	D1-1A	72	10								1															
		F	D1-1A	72	12			6.00								2		X									5
		F	D1-1A	72	12			6.00																				5
		F	D1-1A	72	12			6.00																				5
SB	6.600	F	M3-3S	24	12								1		X													
		F	M1-5	30	24								1															
		F	M6-1S	21	15								1															
		F	M3-1S	24	12								1															
		F	M1-5	30	24								1															
		F	M6-1S	21	15								1															
		F	M3-3	24	12			2.00								2		X							#2B	GREEN ON WHITE SHEETING	X	7	
SIGN SUMMARY SHEET							SHEET TOTALS	27.19 SF	0.00 SF	0 EA	0 EA	0 EA	9 EA	0 EA	0 EA	5 EA	75 FT											
VERMONT AGENCY OF TRANSPORTATION							TOWN TOTALS	774.4	0.0	26.0	12.0	12.0	139	0.0	0.0	140	2100.0											

PROJECT NAME: **Stamford-Andover VT100**
PROJECT NUMBER: **STPG SIGN(20)**
FILE NAME: **Weston.xls** PLOT DATE: **8/6/2009**
PROJECT MANAGER: **N. Avery** DRAWN BY: **T. Guazzoni**
DESIGNED BY: **J. Kelly** CHECKED BY: **T. Guazzoni**
WESTON SHEET 13 SHEET **184** OF **198**

DIRECTION	MILEPOINT	LOCATION CODE (SHEET 2)	SIGN CODE	WIDTH (IN)	HEIGHT (IN)	SHEETING REMARKS	SIGN LEGEND	NEW SIGNS "A"	NEW SIGNS "B"	EXISTING SIGNS RETAIN	EXISTING SIGNS SALVAGE FROM	EXISTING SIGNS SALVAGE TO	EXISTING SIGNS REMOVE	EXIST POST RETAIN	EXIST POST REMOVE	NUMBER OF NEW POSTS	SQUARE STEEL (IN) 1.75 (LB / FT) 1.88	SQUARE STEEL (IN) 2.00 (LB / FT) 2.42	SQUARE STEEL (IN) 2.50 (LB / FT) 3.35	TUBULAR STEEL Ø (IN) FOUNDATION	TUBULAR STEEL Ø (IN) 3.00 (LB / FT) 7.60	TUBULAR STEEL Ø (IN) 3.50 (LB / FT) 9.00	TUBULAR STEEL Ø (IN) 4.00 (LB / FT) 10.80	TUBULAR STEEL Ø (IN) 5.00 (LB / FT) 14.60	SIGN FRAME REQUIRED	REMARKS	SIGN DETAIL: DETAIL IN SHS	SIGN DETAIL: DETAIL ON SHEET NUMBER	SIGN DETAIL: DETAIL ON STD SHEET NUMBER
WESTON VT 100							FY-FLUORESCENT YELLOW FYG-FLUORESCENT YELLOW GREEN																			"SHS"-STANDARD HIGHWAY SIGNS			
		F	M1-5	30	24			5.00																			E-136B
		F	M6-1L	21	15			2.19																		GREEN ON WHITE SHEETING	X		
		F	M3-1	24	12			2.00																		GREEN ON WHITE SHEETING	X		
		F	M1-5	30	24			5.00																					E-136B
		F	M6-1R	21	15			2.19																		GREEN ON WHITE SHEETING	X		
SB	6.565	F	R1-1	30	30								1		X											VT-155 INTERSECTION			
		F	R1-1	36	36			9.00								2		X								X		
SB	6.550	G	W1-7	48	24								1		X															
		G	W1-7	48	24	FY		8.00								2		X								X		
SB	6.520	F	M3-3S	24	12								1		X															
		F	M1-5	30	24								1																
		F	M3-3	24	12			2.00								1		X								GREEN ON WHITE SHEETING	X		
		F	M1-5	30	24			5.00																					E-136B
SB	6.495	F	R2-1	24	30								1		X															
		F	R2-1	24	30			5.00								1		X									X		
SIGN SUMMARY SHEET							SHEET TOTALS	45.38	0.00	0	0	0	5	0	0	6		90									
								SF	SF	EA	EA	EA	EA	EA	EA	EA		FT									
VERMONT AGENCY OF TRANSPORTATION							TOWN TOTALS	774.4	0.0	26.0	12.0	12.0	139	0.0	0.0	140		2100.0									

PROJECT NAME: **Stamford-Andover VT100**
PROJECT NUMBER: **STPG SIGN(20)**

FILE NAME: **Weston.xls**
PROJECT MANAGER: **N. Averv**
DESIGNED BY: **J. Kelly**
WESTON SHEET 14

PLOT DATE: **8/6/2009**
DRAWN BY: **T. Guazzoni**
CHECKED BY: **T. Guazzoni**
SHEET **185** OF **198**

DIRECTION	MILEPOINT	LOCATION CODE (SHEET 2)	SIGN CODE	WIDTH (IN)	HEIGHT (IN)	SHEETING REMARKS	SIGN LEGEND	NEW SIGNS "A"	NEW SIGNS "B"	EXISTING SIGNS RETAIN	EXISTING SIGNS SALVAGE FROM	EXISTING SIGNS SALVAGE TO	EXISTING SIGNS REMOVE	EXIST POST RETAIN	EXIST POST REMOVE	NUMBER OF NEW POSTS	SQUARE STEEL (IN) (LB / FT) 1.75 / 1.88	SQUARE STEEL (IN) (LB / FT) 2.00 / 2.42	SQUARE STEEL (IN) (LB / FT) 2.50 / 3.35	TUBULAR STEEL Ø (IN) FOUNDATION	TUBULAR STEEL Ø (IN) (LB / FT) 3.00 / 7.60	TUBULAR STEEL Ø (IN) (LB / FT) 3.50 / 9.00	TUBULAR STEEL Ø (IN) (LB / FT) 4.00 / 10.80	TUBULAR STEEL Ø (IN) (LB / FT) 5.00 / 14.60	SIGN FRAME REQUIRED	REMARKS	SIGN DETAIL: DETAIL IN SHS	SIGN DETAIL: DETAIL ON SHEET NUMBER	SIGN DETAIL: DETAIL ON STD SHEET NUMBER
WESTON VT 100							FY-FLUORESCENT YELLOW FYG-FLUORESCENT YELLOW GREEN																			"SHS"-STANDARD HIGHWAY SIGNS			
SB	6.455	F	D2-1	72	10								1		X													
		F	D2-1	72	10								1															
		F	D2-1	72	12		WESTON 4	6.00								2		X									5	
		F	D2-1	72	12		LONDONDERRY 9	6.00																			5	
SB	5.920	F	VR-017	24	30								1		X											TH-55, STEVENS LOOP (NORTH)			
		F	VR-017	24	30		LEGAL LOAD LIMIT 24,000 POUNDS	5.00								1		X										E-141
SB	5.915	F	R1-1	30	30								1		X											TH-55, STEVENS LOOP (NORTH)			
		F	R1-1	30	30		1000 1421 0594 STOP	6.25								1		X									X	
SB	5.750	F	VR-017	24	30								1		X											TH-55, STEVENS LOOP (SOUTH)			
		F	VR-017	24	30		LEGAL LOAD LIMIT 24,000 POUNDS	5.00								1		X										E-141
SB	5.740	F	R1-1	30	30								1		X											TH-55, STEVENS LOOP (SOUTH)			
		F	R1-1	30	30		1000 1421 0574 STOP	6.25								1		X									X	
SB	5.288	F	VW-054R	30	30		HIDDEN DRIVE RIGHT			1				X														
SB	5.110	F	VD-062B	72	16		BUSINESS SIGN			1				X														
SB	5.080	F	R2-1	24	30		SPEED LIMIT 50						1		X													
							SHEET TOTALS	34.50	0.00	2	0	0	7	0	0	6		90									
								SF	SF	EA	EA	EA	EA	EA	EA	EA		FT									
							TOWN TOTALS	774.4	0.0	26.0	12.0	12.0	139	0.0	0.0	140		2100.0									

SIGN SUMMARY SHEET

VERMONT AGENCY OF TRANSPORTATION

PROJECT NAME: **Stamford-Andover VT100**
PROJECT NUMBER: **STPG SIGN(20)**

FILE NAME: **Weston.xls**
PROJECT MANAGER: **N. Avery**
DESIGNED BY: **J. Kelly**
WESTON SHEET 15

PLOT DATE: **8/6/2009**
DRAWN BY: **T. Guazzoni**
CHECKED BY: **T. Guazzoni**
SHEET **186** OF **198**

DIRECTION	MILEPOINT	LOCATION CODE (SHEET 2)	SIGN CODE	WIDTH (IN)	HEIGHT (IN)	SHEETING REMARKS	SIGN LEGEND	NEW SIGNS "A"	NEW SIGNS "B"	EXISTING SIGNS RETAIN	EXISTING SIGNS SALVAGE FROM	EXISTING SIGNS SALVAGE TO	EXISTING SIGNS REMOVE	EXIST POST RETAIN	EXIST POST REMOVE	NUMBER OF NEW POSTS	SQUARE STEEL (IN) 1.75 (LB / FT) 1.88	SQUARE STEEL (IN) 2.00 (LB / FT) 2.42	SQUARE STEEL (IN) 2.50 (LB / FT) 3.35	TUBULAR STEEL Ø (IN) FOUNDATION	TUBULAR STEEL Ø (IN) 3.00 (LB / FT) 7.60	TUBULAR STEEL Ø (IN) 3.50 (LB / FT) 9.00	TUBULAR STEEL Ø (IN) 4.00 (LB / FT) 10.80	TUBULAR STEEL Ø (IN) 5.00 (LB / FT) 14.60	SIGN FRAME REQUIRED	REMARKS	SIGN DETAIL: DETAIL IN SHS	SIGN DETAIL: DETAIL ON SHEET NUMBER	SIGN DETAIL: DETAIL ON STD SHEET NUMBER
WESTON VT 100							FY-FLUORESCENT YELLOW FYG-FLUORESCENT YELLOW GREEN																			"SHS"-STANDARD HIGHWAY SIGNS			
SB	5.038	G	VR-017	24	24								1		X											TH-22, GREENDALE RD			
		G	VR-017	24	30			5.00								1		X											E-141
SB	5.032	H	R1-1	30	30								1		X											TH-22, GREENDALE RD			
		H	R1-1	30	30			6.25								1		X										X		
SB	5.020	F	R2-1	24	30			5.00								1		X									INSTALL 80 FEET SOUTH OF INTERSECTION	X		
SB	3.836	F	W3-5	36	36		SPEED REDUCTION (40)					1				2		X									RELOCATED 50 FEET NORTH OF EXISTING			
SB	3.827	F	W3-5	36	36		SPEED REDUCTION (40)				1																		
SB	3.715	F	VD-018	30	18								1		X															
		F	VD-018	30	18			3.75								1		X											E-128A
SB	3.670	F	R2-1	24	30								1		X															
		F	R2-1	30	36			7.50								1		X										6	
SB	3.620	F	VD-062AS	72	16		BUSINESS SIGN			1				X															
SB	3.560	F	W3-5	36	36		SPEED REDUCTION (30)			1				X															
SB	3.522	F	W11-2YG	30	30		PEDESTRIAN			1				X															
		F	W16-9YG	24	12		AHEAD			1																			
							SHEET TOTALS	27.50	0.00	4	1	1	4	0	0	7		105											
								SF	SF	EA	EA	EA	EA	EA	EA	EA		FT											
							TOWN TOTALS	774.4	0.0	26.0	12.0	12.0	139	0.0	0.0	140		2100.0											

SIGN SUMMARY SHEET

VERMONT AGENCY OF TRANSPORTATION

PROJECT NAME: **Stamford-Andover VT100**
PROJECT NUMBER: **STPG SIGN(20)**

FILE NAME: **Weston.xls**
PROJECT MANAGER: **N. Avery**
DESIGNED BY: **J. Kelly**
WESTON SHEET 16

PLOT DATE: **8/6/2009**
DRAWN BY: **T. Guazzoni**
CHECKED BY: **T. Guazzoni**
SHEET **187** OF **198**

DIRECTION	MILEPOINT	LOCATION CODE (SHEET 2)	SIGN CODE	WIDTH (IN)	HEIGHT (IN)	SHEETING REMARKS	SIGN LEGEND	NEW SIGNS "A"	NEW SIGNS "B"	EXISTING SIGNS RETAIN	EXISTING SIGNS SALVAGE FROM	EXISTING SIGNS SALVAGE TO	EXISTING SIGNS REMOVE	EXIST POST RETAIN	EXIST POST REMOVE	NUMBER OF NEW POSTS	SQUARE STEEL (IN) 1.75 (LB / FT) 1.88	SQUARE STEEL (IN) 2.00 (LB / FT) 2.42	SQUARE STEEL (IN) 2.50 (LB / FT) 3.35	TUBULAR STEEL Ø (IN) FOUNDATION	TUBULAR STEEL Ø (IN) 3.00 (LB / FT) 7.60	TUBULAR STEEL Ø (IN) 3.50 (LB / FT) 9.00	TUBULAR STEEL Ø (IN) 4.00 (LB / FT) 10.80	TUBULAR STEEL Ø (IN) 5.00 (LB / FT) 14.60	SIGN FRAME REQUIRED	REMARKS	SIGN DETAIL: DETAIL IN SHS	SIGN DETAIL: DETAIL ON SHEET NUMBER	SIGN DETAIL: DETAIL ON STD SHEET NUMBER
WESTON VT 100							FY-FLUORESCENT YELLOW FYG-FLUORESCENT YELLOW GREEN																				"SHS"-STANDARD HIGHWAY SIGNS			
SB	3.467	F	R2-1	24	30				1				X		1		X											
		F	R2-1	30	36			7.50								1		X										6
SB	3.467	F	D1-1A	54	7.5				1				X		1		X											
		F	D1-1A	72	~~10~~ 12			6.00								2		X										5
SB	3.380	F	R2-1	24	30				1				X		1		X											
		F	R2-1	~~24~~ 30	~~30~~ 36			~~5.00~~ 7.50								1		X								NOTE: LARGER SIZE	X	
SB	3.345	G	VR-052L	24	30			5.00								1		X								INSTALL 50 FEET NORTH OF EXISTING AND SET BACK FROM ROADWAY		7	
SB	3.335	F	W1-1L	30	30		LEFT TURN					1		X														
		F	W13-1	18	18		25 MPH PLAQUE					1																
		G	VR-052L	12	18		NO PARKING (LEFT ARROW)					1																
		F	W11-2YG	30	30		PEDESTRIAN				1					1		X								SALVAGED FROM M.P. 3.298		
		F	W16-4YG	24	18		NEXT 1000 FEET				1																	
SB	3.298	F	W11-2YG	30	30		PEDESTRIAN				1			X												THIS ASSEMBLY WAS REMOVED AGAIN AND REINSTALLED ON 4/26/11 WITH THE HIDDEN DRIVE LEFT SIGN BEING ADDED PER REQUEST OF M. MILLER, TRAFFIC OPS. SEE SHEET # 194			
		F	W16-4YG	24	18		NEXT 1000 FEET				1																	
		F	W1-1L	30	30			6.25								1		X									X	
							SHEET TOTALS	~~29.75~~ 32.25 SF	0.00 SF	0 EA	2 EA	2 EA	6 EA	0 EA	0 EA	7 EA		105 FT										
							TOWN TOTALS	774.4	0.0	26.0	12.0	12.0	139	0.0	0.0	140		2100.0										

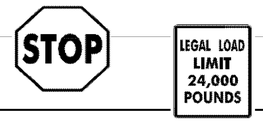
SIGN SUMMARY SHEET

VERMONT AGENCY OF TRANSPORTATION

PROJECT NAME: **Stamford-Andover VT100**
PROJECT NUMBER: **STPG SIGN(20)**

FILE NAME: **Weston.xls**
PROJECT MANAGER: **N. Averv**
DESIGNED BY: **J. Kelly**
WESTON SHEET 17

PLOT DATE: **8/6/2009**
DRAWN BY: **T. Guazzoni**
CHECKED BY: **T. Guazzoni**
SHEET **188** OF **198**

DIRECTION	MILEPOINT	LOCATION CODE (SHEET 2)	SIGN CODE	WIDTH (IN)	HEIGHT (IN)	SHEETING REMARKS	SIGN LEGEND	NEW SIGNS "A"	NEW SIGNS "B"	EXISTING SIGNS RETAIN	EXISTING SIGNS SALVAGE FROM	EXISTING SIGNS SALVAGE TO	EXISTING SIGNS REMOVE	EXIST POST RETAIN	EXIST POST REMOVE	NUMBER OF NEW POSTS	SQUARE STEEL (IN) 1.75 (LB / FT) 1.88	SQUARE STEEL (IN) 2.00 (LB / FT) 2.42	SQUARE STEEL (IN) 2.50 (LB / FT) 3.35	TUBULAR STEEL Ø (IN) FOUNDATION	TUBULAR STEEL Ø (IN) 3.00 (LB / FT) 7.60	TUBULAR STEEL Ø (IN) 3.50 (LB / FT) 9.00	TUBULAR STEEL Ø (IN) 4.00 (LB / FT) 10.80	TUBULAR STEEL Ø (IN) 5.00 (LB / FT) 14.60	SIGN FRAME REQUIRED	REMARKS	SIGN DETAIL: DETAIL IN SHS	SIGN DETAIL: DETAIL ON SHEET NUMBER	SIGN DETAIL: DETAIL ON STD SHEET NUMBER
WESTON VT 100							FY-FLUORESCENT YELLOW FYG-FLUORESCENT YELLOW GREEN																				"SHS"-STANDARD HIGHWAY SIGNS			
		F	W13-1	18	18			2.25																			X		
SB	3.260	G	VR-052	24	30							1		X																
		G	VR-052	24	30			5.00								1		X										7	
SB	3.244	F	W1-8	18	24		CHEVRON			1				X															
NEW SIGN. SEE SHEET # 194																													
SB	3.210	H	R1-1	30	30								1		X												TH-8, PARK ST			
		H	R1-1	30	30			6.25								1		X									(INTERSECTION ISLAND)	X		
		G	VR-017	24	30			5.00																			INSTALL ON BACK SIDE OF STOP SIGN IN ISLAND			
SB	3.210	F	W1-8	18	24		CHEVRON				1	1			X	1		X									RETAIN SIGN AND INSTALL ON NEW POST.			
SB	3.200	H	R1-1	30	30								1		X												TH-8, PARK ST			
		H	R1-1	30	30			6.25								1		X										X		
SB	3.195	F	R2-1	24	30		SPEED LIMIT 30			~~1~~			1	~~X~~	X												THIS SIGN WAS REMOVED. APPROVED BY M. MILLER ON 6/17/10			
SB	3.170	G	VR-052R	12	18		NO PARKING (RIGHT ARROW)				1				X												RELOCATE SOUTH TO INTERSECTION ISLAND AT M.P. 3.155			
		G	VR-052	24	30			5.00								1		X										7		
SB	3.160	G	VR-017	24	30								1		X												TH-2, LAWRENCE HILL RD			
		G	VR-017	24	30			5.00								1		X												E-141
SIGN SUMMARY SHEET							SHEET TOTALS	34.75 SF	0.00 SF	1 2 EA	2 EA	1 EA	5 4 EA	0 EA	0 EA	6 EA		90 FT											
VERMONT AGENCY OF TRANSPORTATION							TOWN TOTALS	774.4	0.0	26.0	12.0	12.0	139	0.0	0.0	140		2100.0											

PROJECT NAME: **Stamford-Andover VT100**
PROJECT NUMBER: **STPG SIGN(20)**

FILE NAME: **Weston.xls**
PROJECT MANAGER: **N. Avery**
DESIGNED BY: **J. Kelly**
WESTON SHEET 18

PLOT DATE: **8/6/2009**
DRAWN BY: **T. Guazzoni**
CHECKED BY: **T. Guazzoni**
SHEET **189** OF **198**

DIRECTION	MILEPOINT	LOCATION CODE (SHEET 2)	SIGN CODE	WIDTH (IN)	HEIGHT (IN)	SHEETING REMARKS	SIGN LEGEND	NEW SIGNS "A"	NEW SIGNS "B"	EXISTING SIGNS RETAIN	EXISTING SIGNS SALVAGE FROM	EXISTING SIGNS SALVAGE TO	EXISTING SIGNS REMOVE	EXIST POST RETAIN	EXIST POST REMOVE	NUMBER OF NEW POSTS	SQUARE STEEL (IN) 1.75 (LB / FT) 1.88	SQUARE STEEL (IN) 2.00 (LB / FT) 2.42	SQUARE STEEL (IN) 2.50 (LB / FT) 3.35	FOUNDATION	TUBULAR STEEL Ø (IN) 3.00 (LB / FT) 7.60	TUBULAR STEEL Ø (IN) 3.50 (LB / FT) 9.00	TUBULAR STEEL Ø (IN) 4.00 (LB / FT) 10.80	TUBULAR STEEL Ø (IN) 5.00 (LB / FT) 14.60	SIGN FRAME REQUIRED	REMARKS	SIGN DETAIL: DETAIL IN SHS	SIGN DETAIL: DETAIL ON SHEET NUMBER	SIGN DETAIL: DETAIL ON STD SHEET NUMBER
WESTON VT 100							FY-FLUORESCENT YELLOW FYG-FLUORESCENT YELLOW GREEN																				"SHS"-STANDARD HIGHWAY SIGNS			
SB	3.155	H	R1-1	30	30		1000 1421 0315 STOP						1		X												TH-2, LAWRENCE HILL RD			
		H	R1-1	30	30			6.25								1		X									INTERSECTION ISLAND	X		
SB	3.155	F	D1-1	54	7.5		LANDGROVE --->						1		X															
		F	D1-1G	54	7.5		HAPGOOD POND --->						1																	
		E	D1-1	54	7.5		<--- LANDGROVE						1																	
		E	D1-1G	54	7.5		<--- HAPGOOD POND						1																	
SB	3.155	G	VR-052R	24	30		NO PARKING (RIGHT ARROW)				1	~~1~~															NEW STOP INSTALL ON ~~EXISTING~~ ~~DESTINATION~~ SIGN POST - SEE SB MM 3.150			
SB	3.150	D	R1-1	30	30							1	1		X												SALVAGED NO PARKING (RIGHT ARROW) TO HERE.			
		D	R1-1	30	30		STOP	6.25								1		X										X		
SB	3.110	F	M3-3S	24	12		SOUTH				1	1			X	1		X									RETAIN ROUTE MARKER SIGNS AND REPLACE POST			
		F	M1-5	30	24		VERMONT100				1	1																		
		C	VR-660	12	18		NO PARKING ON TRAVEL WAY						1																	
SB	3.030	F	R2-1	24	30		SPEED LIMIT 30						1		X															
		F	R2-1	24	30			5.00								1		X										X		
SB	3.020	G	VR-052L	24	30								1		X															
SIGN SUMMARY SHEET							SHEET TOTALS	17.50	0.00	0	~~3~~ 2	3	9	0	0	4		60										
								SF	SF	EA	EA	EA	EA	EA	EA	EA		FT										
VERMONT AGENCY OF TRANSPORTATION							TOWN TOTALS	774.4	0.0	26.0	12.0	12.0	139	0.0	0.0	140		2100.0										

PROJECT NAME: **Stamford-Andover VT100**
PROJECT NUMBER: **STPG SIGN(20)**

FILE NAME: **Weston.xls**
PROJECT MANAGER: **N. Averv**
DESIGNED BY: **J. Kelly**
WESTON SHEET 19

PLOT DATE: **8/6/2009**
DRAWN BY: **T. Guazzoni**
CHECKED BY: **T. Guazzoni**
SHEET **190** OF **198**

DIRECTION	MILEPOINT	LOCATION CODE (SHEET 2)	SIGN CODE	WIDTH (IN)	HEIGHT (IN)	SHEETING REMARKS	SIGN LEGEND	NEW SIGNS "A"	NEW SIGNS "B"	EXISTING SIGNS RETAIN	EXISTING SIGNS SALVAGE FROM	EXISTING SIGNS SALVAGE TO	EXISTING SIGNS REMOVE	EXIST POST RETAIN	EXIST POST REMOVE	NUMBER OF NEW POSTS	SQUARE STEEL (IN) 1.75 (LB / FT) 1.88	SQUARE STEEL (IN) 2.00 (LB / FT) 2.42	SQUARE STEEL (IN) 2.50 (LB / FT) 3.35	TUBULAR STEEL Ø (IN) FOUNDATION	TUBULAR STEEL Ø (IN) 3.00 (LB / FT) 7.60	TUBULAR STEEL Ø (IN) 3.50 (LB / FT) 9.00	TUBULAR STEEL Ø (IN) 4.00 (LB / FT) 10.80	TUBULAR STEEL Ø (IN) 5.00 (LB / FT) 14.60	SIGN FRAME REQUIRED	REMARKS	SIGN DETAIL: DETAIL IN SHS	SIGN DETAIL: DETAIL ON SHEET NUMBER	SIGN DETAIL: DETAIL ON STD SHEET NUMBER
WESTON VT 100							FY-FLUORESCENT YELLOW FYG-FLUORESCENT YELLOW GREEN																				"SHS"-STANDARD HIGHWAY SIGNS			
		G	VR-052L	24	30			5.00								1		X									150 FEET SOUTH		7	
SB	2.995	G	VR-052R	24	30		NO PARKING (RIGHT ARROW)				1				X											RELOCATE SIGN ~~80 FEET NORTH AND IN LINE WITH WESTON INN SIGN.~~ REMOVE MM			
SB	2.967 ~~2.980~~	G	VR-052R	24	30		NO PARKING (RIGHT ARROW)					1				1		X											
SB	2.954	G	VR-017	24	24								1		X												TH-40, MILL LANE			
		G	VR-017	24	30			5.00								1		X											E-141
SB	2.948	H	R1-1	30	30								1		X												TH-40, MILL LANE			
		H	R1-1	30	30		1000 1421 0295	6.25								1		X										X	
SB	2.900	F	R2-1	24	30			5.00								1		X									INSTALL 250 FEET NORTH OF EXISTING AT EDGE OF PAVED SHOULDER	X		
SB	2.850	F	R2-1	24	30		SPEED LIMIT 40						1		X														
SB	2.730	F	M3-3S	24	12		SOUTH				1	1			X	1		X											
SB	2.730	F	M1-5	30	24		VERMONT 100				1	1																	
SB	2.668	F	R2-1	24	30			5.00								1		X									INSTALL 40 FEET NORTH OF EXISTING SPEED LIMIT 50 SIGN AND ACROSS FROM NB SL 40	X		
SB	2.660	F	R2-1	24	30		SPEED LIMIT 50						1		X														
SB	2.205	F	VD-062B	72	16		BUSINESS SIGN			1				X															
SB	1.170	F	W1-2R	30	30								1		X														
							SHEET TOTALS	26.25	0.00	1	~~4~~ 3	~~4~~ 3	5	0	0	7		105											
								SF	SF	EA	EA	EA	EA	EA	EA	EA		FT										
							TOWN TOTALS	774.4	0.0	26.0	12.0	12.0	139	0.0	0.0	140		2100.0										

SIGN SUMMARY SHEET

VERMONT AGENCY OF TRANSPORTATION

PROJECT NAME: **Stamford-Andover VT100**
PROJECT NUMBER: **STPG SIGN(20)**

FILE NAME: **Weston.xls** PLOT DATE: **8/6/2009**
PROJECT MANAGER: **N. Averv** DRAWN BY: **T. Guazzoni**
DESIGNED BY: **J. Kelly** CHECKED BY: **T. Guazzoni**
WESTON SHEET 20 SHEET **191** OF **198**

DIRECTION	MILEPOINT	LOCATION CODE (SHEET 2)	SIGN CODE	WIDTH (IN)	HEIGHT (IN)	SHEETING REMARKS	SIGN LEGEND	NEW SIGNS "A"	NEW SIGNS "B"	EXISTING SIGNS RETAIN	EXISTING SIGNS SALVAGE FROM	EXISTING SIGNS SALVAGE TO	EXISTING SIGNS REMOVE	EXIST POST RETAIN	EXIST POST REMOVE	NUMBER OF NEW POSTS	SQUARE STEEL (IN) 1.75 (LB / FT) 1.88	SQUARE STEEL (IN) 2.00 (LB / FT) 2.42	SQUARE STEEL (IN) 2.50 (LB / FT) 3.35	FOUNDATION	TUBULAR STEEL Ø (IN) 3.00 (LB / FT) 7.60	TUBULAR STEEL Ø (IN) 3.50 (LB / FT) 9.00	TUBULAR STEEL Ø (IN) 4.00 (LB / FT) 10.80	TUBULAR STEEL Ø (IN) 5.00 (LB / FT) 14.60	SIGN FRAME REQUIRED	REMARKS	SIGN DETAIL: DETAIL IN SHS	SIGN DETAIL: DETAIL ON SHEET NUMBER	SIGN DETAIL: DETAIL ON STD SHEET NUMBER
WESTON VT 100							FY-FLUORESCENT YELLOW FYG-FLUORESCENT YELLOW GREEN																			"SHS"-STANDARD HIGHWAY SIGNS			
		F	W13-1	18	18								1																
		F	W1-2R	30	30			6.25								1		X									X		
		F	W13-1	18	18			2.25																			X		
SB	1.035	F	VW-054R	30	30		HIDDEN DRIVE RIGHT						1		X														
SB	0.997	F	VW-054R	30	30			6.25								1		X								INSTALL 200 FEET SOUTH OF EXISTING HIDDEN DRIVE RIGHT SIGN AT M.P. 1.035			E-154
SB	0.935	F	VW-054R	30	30		HIDDEN DRIVE RIGHT						1		X														
SB	0.827	F	W1-2R	30	30		RIGHT CURVE						1		X														
SB	0.750	F	W1-10R	30	30			6.25								1		X								INSTALL 400 FEET SOUTH OF EXISTING RIGHT CURVE SIGN	X		
SB	0.625	F	VW-054R	30	30		HIDDEN DRIVE RIGHT						1		X														
SB	0.565	F	VW-054R	30	30			6.25								1		X								INSTALL AT SOUTH ABUTMENT OF BRIDGE #92			E-154
SB	0.537	F	VW-081L	30	30		TRUCKS ENTERING						1		X														
SB	0.500	F	VW-081L	30	30			6.25								1		X								INSTALL BETWEEN YELLOW HOUSE AND WHITE HOUSE (200 FEET SOUTH OF EXISTING LOCATION)			E-154
SB	0.460	F	W1-1ML	30	30		LEFT TURN WITH CROSSROADS						1		X														
		F	W13-1	18	18		30 MPH PLAQUE						1																
SB	0.435	F	S3-1	30	30		SCHOOL BUS STOP AHEAD						1		X														
							SHEET TOTALS	33.50	0.00	0	0	0	9	0	0	5		75											
								SF	SF	EA	EA	EA	EA	EA	EA	EA		FT											
							TOWN TOTALS	774.4	0.0	26.0	12.0	12.0	139	0.0	0.0	140		2100.0											

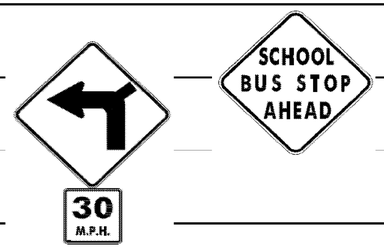
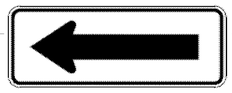
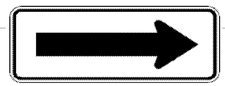
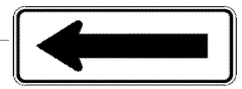
SIGN SUMMARY SHEET

VERMONT AGENCY OF TRANSPORTATION

PROJECT NAME: **Stamford-Andover VT100**
PROJECT NUMBER: **STPG SIGN(20)**

FILE NAME: **Weston.xls**
PROJECT MANAGER: **N. Avery**
DESIGNED BY: **J. Kelly**
WESTON SHEET 21

PLOT DATE: **8/6/2009**
DRAWN BY: **T. Guazzoni**
CHECKED BY: **T. Guazzoni**
SHEET **192** OF **198**

DIRECTION	MILEPOINT	LOCATION CODE (SHEET 2)	SIGN CODE	WIDTH (IN)	HEIGHT (IN)	SHEETING REMARKS	SIGN LEGEND	NEW SIGNS "A"	NEW SIGNS "B"	EXISTING SIGNS RETAIN	EXISTING SIGNS SALVAGE FROM	EXISTING SIGNS SALVAGE TO	EXISTING SIGNS REMOVE	EXIST POST RETAIN	EXIST POST REMOVE	NUMBER OF NEW POSTS	SQUARE STEEL (IN) 1.75 (LB / FT) 1.88	SQUARE STEEL (IN) 2.00 (LB / FT) 2.42	SQUARE STEEL (IN) 2.50 (LB / FT) 3.35	TUBULAR STEEL Ø (IN) FOUNDATION	TUBULAR STEEL Ø (IN) 3.00 (LB / FT) 7.60	TUBULAR STEEL Ø (IN) 3.50 (LB / FT) 9.00	TUBULAR STEEL Ø (IN) 4.00 (LB / FT) 10.80	TUBULAR STEEL Ø (IN) 5.00 (LB / FT) 14.60	SIGN FRAME REQUIRED	REMARKS	SIGN DETAIL: DETAIL IN SHS	SIGN DETAIL: DETAIL ON SHEET NUMBER	SIGN DETAIL: DETAIL ON STD SHEET NUMBER
WESTON VT 100							FY-FLUORESCENT YELLOW FYG-FLUORESCENT YELLOW GREEN																			"SHS"-STANDARD HIGHWAY SIGNS			
		F	S3-1	30	30			6.25								1		X									X		
SB	0.397	F	W1-1MdL	30	30	FY		6.25								1		X									INSTALL 200 FEET SOUTH OF SCHOOL BUS STOP AHEAD SIGN		6	
		F	W13-1	18	18	FY		2.25																			X		
SB	0.370	F	W1-6	48	24								I		X														
		F	W1-6	48	24	FY		8.00								2		X									X		
SB	0.355	E	W1-6	48	24								I		X														
		E	W1-6	48	24	FY		8.00								2		X									X		
SB	0.343	G	VR-017	24	30								1		X												TH-34, JOHNSON HILL RD			
		G	VR-017	24	30			5.00								1		X											E-141
SB	0.337	H	R1-1	30	30								1		X												TH-34, JOHNSON HILL RD			
		H	R1-1	30	30			6.25								1		X									X		
SB	0.345	E	W1-6	48	24								I		X														
		E	W1-6	48	24	FY		8.00								2		X									X		
SB	0.335	F	W1-6	48	24								I		X														
		F	W1-6	48	24	FY		8.00								2		X									X		
SIGN SUMMARY SHEET							SHEET TOTALS	58.00	0.00	0	0	0	6 ~~2~~	0	0	12		180										
VERMONT AGENCY OF TRANSPORTATION								SF	SF	EA	EA	EA	EA	EA	EA	EA		FT										
							TOWN TOTALS	774.4	0.0	26.0	12.0	12.0	139	0.0	0.0	140		2100.0											

PROJECT NAME: **Stamford-Andover VT100**
PROJECT NUMBER: **STPG SIGN(20)**

FILE NAME: **Weston.xls**
PROJECT MANAGER: **N. Averv**
DESIGNED BY: **J. Kelly**
WESTON SHEET 22

PLOT DATE: **8/6/2009**
DRAWN BY: **T. Guazzoni**
CHECKED BY: **T. Guazzoni**
SHEET **193** OF **198**

DIRECTION	MILEPOINT	LOCATION CODE (SHEET 2)	SIGN CODE	WIDTH (IN)	HEIGHT (IN)	SHEETING REMARKS	SIGN LEGEND	NEW SIGNS "A"	NEW SIGNS "B"	EXISTING SIGNS RETAIN	EXISTING SIGNS SALVAGE FROM	EXISTING SIGNS SALVAGE TO	EXISTING SIGNS REMOVE	EXIST POST RETAIN	EXIST POST REMOVE	NUMBER OF NEW POSTS	SQUARE STEEL (IN) 1.75 (LB / FT) 1.88	SQUARE STEEL (IN) 2.00 (LB / FT) 2.42	SQUARE STEEL (IN) 2.50 (LB / FT) 3.35	TUBULAR STEEL Ø (IN) FOUNDATION	TUBULAR STEEL Ø (IN) 3.00 (LB / FT) 7.60	TUBULAR STEEL Ø (IN) 3.50 (LB / FT) 9.00	TUBULAR STEEL Ø (IN) 4.00 (LB / FT) 10.80	TUBULAR STEEL Ø (IN) 5.00 (LB / FT) 14.60	SIGN FRAME REQUIRED	REMARKS	SIGN DETAIL: DETAIL IN SHS	SIGN DETAIL: DETAIL ON SHEET NUMBER	SIGN DETAIL: DETAIL ON STD SHEET NUMBER
WESTON VT 100							FY-FLUORESCENT YELLOW FYG-FLUORESCENT YELLOW GREEN																				"SHS"-STANDARD HIGHWAY SIGNS			
SB	0.145	F	VW-060	30	30		HIDDEN DRIVES						1		X														
SB	0.100	F	VW-202	30	30								1		X														
		F	VW-060	30	30		TRUCKS ENTERING	6.25								2		X									INSTALL HIDDEN DRIVES ABOVE TRUCKS ENTERING SIGN			E-154
		F	VW-202	30	30			6.25																					E-154
NB	3.216	A	VW-054	30	30		HIDDEN DRIVE RIGHT	6.25								1											THIS NEW SIGN WAS ADDED TO THE PROJECT PER REQUEST OF M. MILLER, TRAFFIC OPS.			
		C	VR-052	12	18																						PAID ON SHEET #176. INSTALLED UNDER SIGN ABOVE			
NB	3.384	A	W11-8	30	30					1					X												SIGN RETAINED			
SB	3.298	F	VW-054	30	30		HIDDEN DRIVE LEFT	6.25																			THIS SIGN WAS ADDED ON 4/26/11. SEE NOTE ON SHEET #188.			
		F	W1-1L	30	30						1	1	1																
		F	W13-1	18	18		25 M.P.H.				1	1	1		X	1													
SB	3.220	G	VR-052	12	18			1.50							X												THIS NEW SIGN WAS INSTALLED ON 7/27/11 AS PER REQUEST OF M. MILLER, TRAFFIC OPS.			
							SHEET TOTALS	26.50 ~~12.50~~ SF	0.00 SF	~~1~~ ~~0~~ EA	~~2~~ ~~0~~ EA	~~2~~ ~~0~~ EA	~~4~~ ~~2~~ EA	0 EA	0 EA	~~4~~ ~~2~~ EA	30 FT												
							TOWN TOTALS	774.4	0.0	26.0	12.0	12.0	139	0.0	0.0	140	2100.0												

SIGN SUMMARY SHEET

VERMONT AGENCY OF TRANSPORTATION

PROJECT NAME: Stamford-Andover VT100
PROJECT NUMBER: STPG SIGN(20)

FILE NAME: Weston.xls
PROJECT MANAGER: N. Averv
DESIGNED BY: J. Kelly
WESTON SHEET 23

PLOT DATE: 8/6/2009
DRAWN BY: T. Guazzoni
CHECKED BY: T. Guazzoni
SHEET 194 OF 198

* Kease Expedite *

Requested by: Vermont Traffic Committee Action
Re: Sept. 3, 2009 Meeting

Vermont Agency of Transportation
TRAFFIC SHOP WORKORDER

W.O. No.: 09-173
W.O. Date: 10/9/09
Page 1 of 4

on: "Route 100"
Route: VT. 100 Street Address Range: From: #2294 Route 100 To: #3650 Route 100
Town(s): Londonderry (South Londonderry) C/T: 1310 T.I.: T.C.

ID No.	Dir.	M.P.	L C	Sign Code	Color	Sign Size	Action	Legend of New Sign	Legend of Existing Sign	Installation Information	New Posts Installed Type	Quan	Lngth	Anch
										See Sketch: Install				
										10 Ft ± in advance of the				
	NB	7.305±	A	W3-5	B/Y	36"	New	ROAD LIKELY TO ICE		Below Rail Section,				
										Access From Drive # 2317.				
										See Sketch: 40 Ft ±				
	NB	2.445±	A	R2-1	B/W	30x36"	New	SL 40 (30x36")		South of Pole # ~~40~~ 39				
										Net: T/40/5/13111/2,				
										Install the upsized				
										SL-40. Then Access				
										From This Sign,				
	SB	2.445±	F	R2-1	B/W	24x30"	New	SL 50		Install the New				
										SL-50 for SB.				

828-5571
Prepared by M. Miner Date 10/12/09
Reviewed by DEL Date 10/14/09
Approved by A. Gaudette Date 10/16/09
Traffic Operations Engineer

Copy Of W.O. Sent To:
✓ District No. 2
___ Requesting Party
___ Planning (HAL # _____)
✓ Other Nhec Highways R.E.
Scanned - Aurora Sign Shop (20)

Digsafe No._____
Date_____ Time_____
Elec._____ COPY
Gas_____ TV_____
Other_____

Date Completed _____
Leader_____ Hrs_____
FOR YOUR INFORMATION
Helper_____ Hrs_____
Vehicle_____ Hrs_____

* PLEASE EXPEDITE *

Vermont Agency of Transportation
TRAFFIC SHOP WORKORDER

W.O. No.: 09-473
W.O. Date: 10/19/09

Route: VT. 100 Street Address Range: SEE P. 1 Town(s): LANDGROVE (SOUTH LANDGROVE) C/T: 1310 T.I.: T.C.

ID No.	Dir.	M.P.	L C	Sign Code	Color	Sign Size	Action	Legend of New Sign	Legend of Existing Sign	Installation Information	New Posts Installed Type	Quan	Lngth	Anch
										150 FT ± NORTH OF THE				
										℄ INTERSECTION W/ DRIVE				
	NB	2.552	A	R2-1	B/W	24x30"	NEW	SL 40		#2540 INSTALL THIS				
										SIGN BEHIND RAIL.				
										SEE SKETCH.				
										REMOVE THIS SIGN				
9830	NB	2.857	A	R2-1	B/W	24x30"	REMOVE		SL 30	AND POST.				
										REMOVE THE SIGN &				
9831	SB	2.857	F	R2-1	B/W	24x30"	REMOVE		SL 50	THE EXISTING POST				
	↓	↓	↓					SL 40		LOCATE & INSTALL				
				R2-1	B/W	24x30"	NEW			THE NEW SIGN HERE.				
										40 FEET ± SOUTH OF				
										POLE # VZ26/51/5,				
	NB	2.890	A	R2-1	B/W	30x36"	NEW	SL 30		INSTALL THIS NEW				
								(30x36")		UPSIZED SIGN BEHIND RAIL				

* PLEASE EXPEDITE *

Vermont Agency of Transportation

TRAFFIC SHOP WORKORDER

W.O. No.: 09-473
W.O. Date: 10/19/09
Page 3 of 4

Route: VT-100 Street Address Range: See P. 1 Town(s): Londonderry (South Londonderry) DT: 1310 T.I.: T.C.

ID No.	Dir.	M.P.	L C	Sign Code	Color	Sign Size	Action	Legend of New Sign	Legend of Existing Sign	Installation Information	New Posts Installed Type	Quan	Lngth	Anch
										See Sketch: 75 Ft ±				
	NB	3.283±	A	R2-1	B/W	24x30"	New	SL 40		North of Pole #8/0,				
										Install This New				
										SL-40; Then, Across				
	SB	3.283±	F	R2-1	B/W	30x36"	New	SL 30 (30x36")		The Road For SB Traffic				
										Install The New Upsized				
										SL-30.				
										Remove The Existing				
9875	SB	3.356	F	W1-3R	B/Y	30"	Remove			Curve Warning Sign				
										And Post; Install				
										Same Position on 2				
										New Posts, Install				
										The Salvaged Speed				
(116336)				W3-5	B on Y	36"	Install Salvage To		SL 50	Reduction Sign From				
										Further Ahead (at				
										SB 3.563)				

* PLEASE EXPEDITE *

Vermont Agency of Transportation

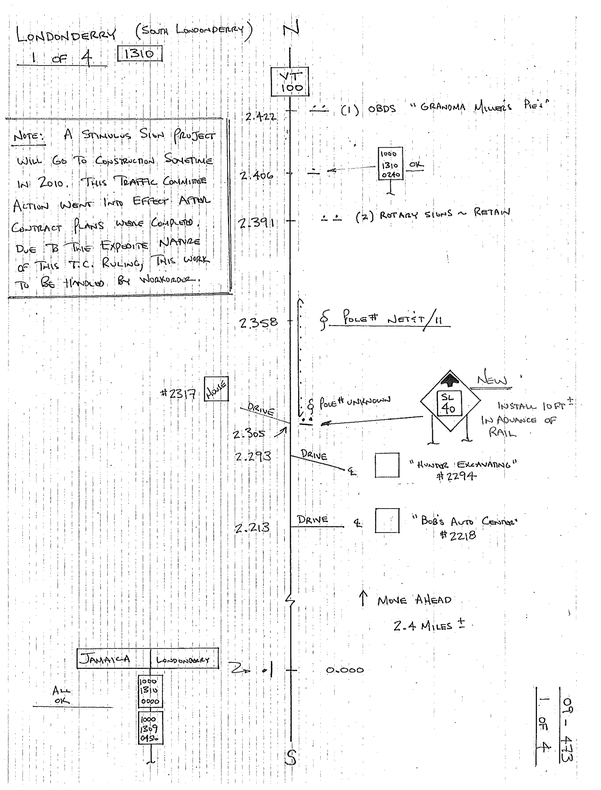
TRAFFIC SHOP WORKORDER

W.O. No.: 09-173
W.O. Date: 10/19/09
Page 4 of 4

Route: VT. 100 Street Address Range: SEE P. 1 Town(s): LONDONDERRY (SOUTH LONDONDERRY) C/T: 1310 T.I.: T.C.

ID No.	Dir.	M.P.	L C	Sign Code	Color	Sign Size	Action	Legend of New Sign	Legend of Existing Sign	Installation Information	New Posts Installed Type	Quan	Lngth	Anch
										REMOVE THE SIGN				
9877	NB	3.394	A	R2-1	B/W	24x30"	REMOVE		SL 50	AND POST.				
										SAME AS ABOVE				
9876	SB	3.394	F	R2-1	B/W	24x30"	REMOVE		SL 30					
										SEE SKETCH: 15 FEET ±				
	NB	3.460 ±	A	R2-1	B/W	24x30"	NEW	SL 50		SOUTH OF AND ACROSS				
										FROM POLE #16 INSTALL				
										THIS NEW SIGN; THEN,				
	SB	3.460 ±	F	R2-1	B/W	30x36"	NEW	SL 40 (30x36")		ACROSS THE ROAD,				
										INSTALL THE NEW				
										SL-40 FOR SB.				
116330	SB	3.563	F	W3-5	B/Y	36"	REMOVE/ SALVAGE FROM		SL 30	SALVAGE THE EXISTING				
	↓	↓	↓							SIGN TO SB 3.356;				
				W3-5	B/Y	36"	NEW	SL 40		INSTALL THE NEW SIGN				
										HOLE ~ EXISTING POSTS SALVAGEABLE?				

END W.O.


LONDONDERRY (SOUTH LONDONDERRY)
1 OF 4
1310
N
VIT 100
2.422
(1) OBDS "GRANDMA MILLER'S PIES"
1000 1310 0240 OK
2.406
2.391
(2) ROTARY SIGNS ~ RETAIN
2.358
POLE# NEW1T/11
#2317 NEW
DRIVE
POLE# UNKNOWN
SL 40
NEW
2.305
2.293
DRIVE
"HUNTER EXCAVATING" #2294
2.213
DRIVE
"BOB'S AUTO CENTER" #2218
MOVE AHEAD
2.4 MILES ±
JAMAICA
LONDONDERRY
0.000
S
ALL OK
1000 1310 0000
1000 1349 0030
1 OF 4

3 of 4

LONDONDERRY (Scale housewares)
1310
3 of 4
N
VT 100
3.31+
δ Inlet it/12/81
(2-) 6685
15'+
Blade
3.293
δ floor # Metrit/11/82
3.288
Blade (Phase) ε
Lev (30x36")
SL 30
3.283 +
Lev
SL 40
73'+
3.269
δ floor # 8/0
H
3.252
Blade # 3272
G
3.142
Partial
SL 30
Cafeteria Ent (TH-55)
N/Hopper Twin. Rd (TH-5)
Thompson Brake Rd (TH-2)
Winthrop Housing (TH-6)
West River Dr (TH-48)
G

Londonderry (South Londonderry)

4 CF 4 | 1310

Remove/Salvage Ezam

SL 36

SL 40

New

Retain

Salvage Rds Sng Ahead

3.49r

Retain

Relocate Existing Posts

Pole #16

3.4u3

New (30x36")

SL 40

16'6"

New

SL 50

3.4u3

Drive #3452

3.42g

Retain

Hidden Drives Alert

3.41

Retain

Remove Pavement

3.403

Remove

SL 36

3.394

Remove

SL 50

Install/Salvage to (From 09 3.353)

SL 36

3.35r

Remove

Remove Post 2

New Posts

3.32r

Drive #332r

4

N

S

Pro. w.o. —