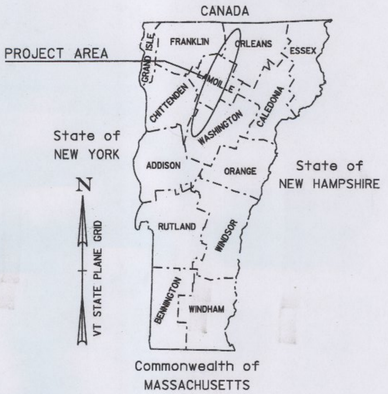
STATE OF VERMONT
AGENCY OF TRANSPORTATION

INDEX OF SHEETS
SEE SHEET 2



PROPOSED IMPROVEMENT

TOWNS OF MORETOWN – NEWPORT
COUNTIES OF WASHINGTON, LAMOILLE AND ORLEANS
VERMONT ROUTE 100

BEGINNING AT THE WAITSFIELD-MORETOWN TOWN LINE ON VT ROUTE 100 IN THE TOWN OF MORETOWN AT MILE MARKER 0.000 AND EXTENDING NORTHERLY ALONG VT ROUTE 100 FOR A DISTANCE OF 62.359 MILES TO THE END OF VT ROUTE 100 AT THE INTERSECTION OF VT ROUTE 100, VT ROUTE 105 AND VT ROUTE 14 IN THE TOWN OF NEWPORT AT MILE MARKER 4.211. EXLUDING CLASS I SECTIONS WITHIN THE PROJECT CORRIDOR.

LENGTH OF ROADWAY = 61.132 MILES
LENGTH OF PROJECT = 58.753 MILES

WORK TO BE PERFORMED UNDER THIS PROJECT INCLUDES THE REMOVAL OF EXISTING SIGNS & POSTS AND THE INSTALLATION OF SIGNS & SIGN POSTS AND OTHER RELATED ITEMS.

RECORD PLANS

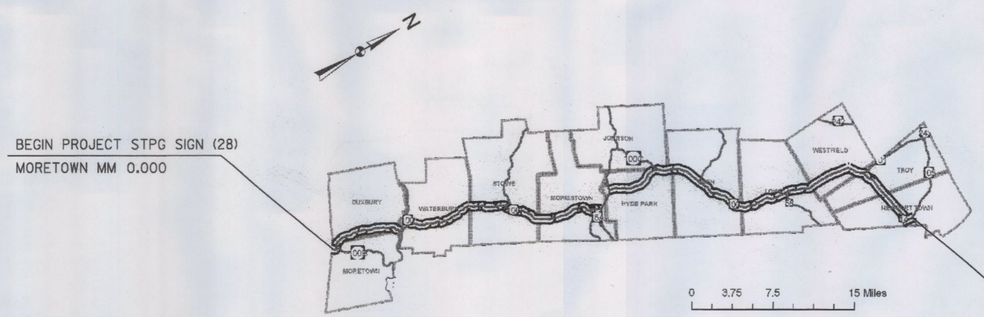
CONTRACTOR: F. R. LAFAYETTE, INC.- ESSEX JUNCTION, VT
RESIDENT ENGINEER: JEFF COTA
CONSTRUCTION BEGAN: APRIL 12, 2010
CONSTRUCTION COMPLETE: JULY 5, 2010
RECORD PLANS BY: JEFF COTA & SANDRA SCHMITT

I HEREBY CERTIFY THAT ALL THE CONSTRUCTION REQUIRED BY THIS SET OF DRAWINGS HAS BEEN ACCOMPLISHED AS INDICATED HEREIN.

BY _____ RESIDENT ENGINEER

DATE 10/30/13

NOTE: Any further information concerning final quantities, amounts or other details relative to this project may be found at Central Files in the electronic archives.



CONVENTIONAL SYMBOLS

COUNTY LINE
TOWN LINE
LIMITS OF ACCESS
POINT OF ACCESS
FENCE LINE
STONE WALL
TRAVELED WAY
GUARD RAIL
RAILROAD
SURVEY LINE
CULVERT
POWER POLE
TELEPHONE POLE
TREES
CONTROL OF ACCESS
PROPERTY LINE
R.O.W. TAKING LINE
SLOPE RIGHTS
TOP OF CUT
TOE OF SLOPE

SURVEYED BY : N/A
SURVEYED DATE : N/A

DATUM
VERTICAL N/A
HORIZONTAL N/A

THESE PLANS ARE SUBJECT TO SUCH ENGINEERING CHANGES AS MAY BE REQUIRED BY THE FEDERAL HIGHWAY ADMINISTRATION OR THE DIRECTOR OF PROGRAM DEVELOPMENT.

CONSTRUCTION IS TO BE CARRIED ON IN ACCORDANCE WITH THESE PLANS AND THE STANDARD SPECIFICATIONS FOR CONSTRUCTION DATED 2006, AS APPROVED BY THE FEDERAL HIGHWAY ADMINISTRATION ON JUNE 15, 2006 FOR USE ON THIS PROJECT, INCLUDING ALL SUBSEQUENT REVISIONS AND SUCH REVISED SPECIFICATIONS AND SPECIAL PROVISIONS AS ARE INCORPORATED IN THESE PLANS.

DIRECTOR OF PROGRAM DEVELOPMENT
APPROVED _____ DATE 10/2/09

PROJECT MANAGER : AMY GAMBLE

PROJECT NAME : MORETOWN - NEWPORT TOWN
PROJECT NUMBER : STPG SIGN (28)

SHEET 1 OF 166 SHEETS

INDEX OF SHEETS

1	TITLE SHEET
2	GENERAL NOTES
3	QUANTITY SHEET
4	COUNTY/ TOWN LINE DESIGN
5-6	SIGN DETAILS
7	GUIDE SIGN ASSEMBLY
8	WARNING STREET NAME PLAQUE DETAIL
9-18	MORETOWN TRAFFIC SIGN SUMMARY SHEETS 1-10
19-32	DUXBURY TRAFFIC SIGN SUMMARY SHEETS 1-14
33-55	WATERBURY TRAFFIC SIGN SUMMARY SHEETS 1-23
56-75	STOWE TRAFFIC SIGN SUMMARY SHEETS 1-20
76-90	MORRISTOWN TRAFFIC SIGN SUMMARY SHEETS 1-15
91-103	HYDE PARK TRAFFIC SIGN SUMMARY SHEETS 1-13
104-118	EDEN TRAFFIC SIGN SUMMARY SHEETS 1-15
119-133	LOWELL TRAFFIC SIGN SUMMARY SHEETS 1-15
134-138	WESTFIELD TRAFFIC SIGN SUMMARY SHEETS 1-5
139-148	TROY TRAFFIC SIGN SUMMARY SHEETS 1-10
149-163	NEWPORT TOWN TRAFFIC SIGN SUMMARY SHEETS 1-15
164	TOWN TOTAL SIGN SUMMARY SHEET
165-166	TRAFFIC CONTROL SHEETS

STANDARDS

E-120	STANDARD SIGN PLACEMENT EXPRESSWAY AND FREEWAY	08/08/1995
E-121	STANDARD SIGN PLACEMENT CONVENTIONAL ROAD	08/08/1995
E-123	GUIDE SIGN PLACEMENT	03/16/2004
E-127	ROUTE MARKINGS AT RURAL INTERSECTIONS	08/08/1995
E-128A	VILLAGE SIGNS A-M	08/08/1995
E-128B	VILLAGE SIGNS N-W	08/08/1995
E-132	GENERAL MOTORIST SERVICES SIGN DETAIL	08/18/1995
E-136B	STATE ROUTE MARKER SIGN DETAILS	08/08/1995
E-136C	STATE NUMBER TOWN HIGHWAY SIGN DETAILS	08/08/1995
E-138	MILEMARKER DETAILS STATE AND TOWN HIGHWAYS	05/30/2003
E-141	REGULATORY SIGN DETAILS	09/20/1995
E-144	REGULATORY SIGN DETAILS	03/29/1999
E-145A	REGULATORY SIGN DETAILS LANE USE CONTROL SIGNS	12/23/1994
E-145B	REGULATORY SIGN DETAILS LANE USE CONTROL SIGNS	12/23/1994
E-153	WARNING SIGN DETAILS	05/01/2004
E-154	WARNING SIGN DETAILS	05/01/2004
E-164	SQUARE STEEL POSTS	06/08/2009

CLASS I SECTIONS OF HIGHWAY TO BE EXCLUDED FROM THIS PROJECT

TOWN	BEGIN MM	END MM	DISTANCE
STOWE	2.945	3.987	1.042
MORRISTOWN	4.851	6.188	1.337
		TOTAL CLASS I MILEAGE	2.379

GENERAL NOTES

1. ALL NEW SIGNS SHALL BE IN ACCORDANCE WITH THESE PLANS, THE LATEST EDITION OF THE 2003 MANUAL ON UNIFORM TRAFFIC CONTROL DEVICES, THE STANDARD HIGHWAY SIGN BOOK (SHS) PUBLISHED BY THE FEDERAL HIGHWAY ADMINISTRATION (FHWA), AND APPLICABLE VTRANS E-SERIES STANDARDS OR AS DIRECTED BY THE ENGINEER. SIGN LOCATIONS AS SHOWN ON THE PLANS ARE APROXIMATE. EXACT LOCATIONS TO BE DETERMINED BY THE ENGINEER IN THE FIELD.

2. ALL SIGNS WITHIN THE PROJECT LIMITS ARE TO BE REPLACED UNLESS OTHERWISE NOTED OR AS DIRECTED BY THE RESIDENT ENGINEER.

3. THE CONTRACTOR SHALL BE RESPONSIBLE FOR REPAIRING ANY DAMAGE TO PRIVATE OR PUBLIC PROPERTY CAUSED BY THE CONTRACTOR, AT THEIR EXPENSE.

4. ALL EXISTING MILE MARKER PLAQUES ATTACHED TO A DELINEATOR POST OR ATTACHED TO A RETAINED STAND ALONE SIGN POST ASSEMBLY SHALL BE RETAINED. IF AN EXISTING MILE MARKER PLAQUE IS ATTACHED TO A SIGN POST THAT IS TO BE REMOVED AND REPLACED IN THE SAME LOCATION, THE MILE MARKER PLAQUE SHALL BE REMOVED, SALVAGED AND INSTALLED TO THE NEW SIGN POST. IF AN EXISTING MILE MARKER PLAQUE IS ATTACHED TO A SIGN POST THAT IS TO BE RELOCATED TO A DIFFERENT LOCATION, THE MILE MARKER PLAQUE SHALL BE REMOVED, UNLESS OTHERWISE DIRECTED BY THE ENGINEER. PAYMENT FOR ANY OF THIS WORK SHALL BE INCIDENTAL TO ITEM 675.341 SQUARE TUBE POST AND ANCHOR. PAYMENT FOR NEW MILE MARKERS AS SHOWN ON THESE PLANS SHALL BE PAID FOR AS ITEM 675.20 TRAFFIC SIGN, TYPE A.

5. SALVAGED SIGN TOTALS HAS BEEN ADDED TO THE TOTAL SIGN REMOVAL COLUMN ON THE TOWN TOTAL SIGN SUMMARY SHEET.

6. EXISTING STREET NAME SIGNS ATTACHED TO SIGN POSTS THAT ARE TO BE REPLACED, SHALL BE REMOVED AND INSTALLED ONTO NEW POST. ALL WORK AND MATERIALS NECESSARY TO REMOVE AND INSTALL THE STREET NAME PLAQUES SHALL BE PAID UNDER ITEM 675.60 ERECTING SALVAGED SIGNS. AN ESTIMATED QUANTITY HAS BEEN ADDED TO PAY ITEM 675.60 TO PAY FOR THIS WORK.

7. ALL EXISTING STREET NAME PLAQUES INSTALLED ON STAND ALONE SIGN POSTS SHALL BE RETAINED WITHIN THE PROJECT LIMITS.

8. ALL SIGN PLACEMENT SHALL BE IN CONFORMANCE WITH STATE STANDARD E-120 STANDARD SIGN PLACEMENT CONVENTIOAL ROADS AND E-121 STANDARD SIGN PLACEMENT EXPRESSWAY AND FREEWAY.

9. ALL SIGN LETTERING, DIGITS, ARROWS, AND DESIGN OF SYMBOLS FOR SIGNS DETAILED REFERENCED IN THESE PLANS SHALL CONFORM WITH THE "STANDARD ALPHABET FOR HIGHWAY SIGNS AND PAVEMENT MARKING" AS ADOPTED BY THE U.S. DEPARTMENT OF TRANSPORTATION AND THE FEDERAL HIGHWAY ADMINISTRATION (FHWA). UNLESS DETAILED WITHIN THESE PLANS.


10. ALL COLORS SHALL CONFORM WITH THE STANDARD COLORS ADOPTED BY THE AMERICAN ASSOCIATION OF STATE HIGHWAY AND TRANSPORTATION OFFICIALS (AASHTO) AND APPROVED BY FHWA. UNLESS OTHERWISE NOTED.

11. WITHIN THE TRAFFIC SIGN SUMMARY SHEETS FY= FLUORESCENT YELLOW SHEETING (ASTM VII. VIII, OR IX) AND FYG = FLUORESCENT YELLOW-GREEN SHEETING (ASTM TYPE VII, VIII, OR IX).

12. SALVAGED SIGNS CALCULATED IN THE TRAFFIC SIGN SUMMARY SHEET HAVE BEEN INCLUDED INTO THE TOTAL FOR REMOVING SIGNS.

13. UNLESS OTHERWISE DETAILED ON THE PLANS, ALL SIGN BASE MATERIAL SHALL BE FLAT SHEET ALUMINUM WITH THE FOLLOWING MINIMUM THICKNESSES:


SIZES		24" X 10"		
		24" X 12"	36" X 12"	
		24" X 18"	36" X 15"	
		24" X 24"	36" X 18"	48" X 18"
		24" X 30"	36" X 24"	48" X 24"
	9" X 12"	30" X 15"	30" X 42"	48" X 30"
	12" X 12"	30" X 18"	36" X 36"	48" X 42"
	18" X 18"	30" X 30"	36" X 48"	48" X 48"
	21" X 15"	30" X 42"	36" X 54"	48" X 60"
THICKNESS	0.060"	0.080"	0.100"	0.125"

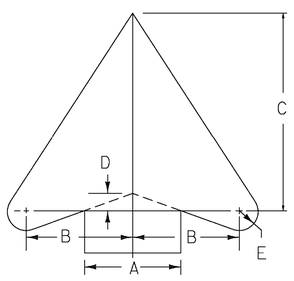

ARROW NOTES :

ARROW DIMENSIONS ARE BASED ON "A" DIMENSION. SEE BASE SIGN DETAIL FOR MORE INFORMATION. BASE SIGN DETAILS CAN BE FOUND ON SHEET 6 AND 7 OF THESE PROJECT PLANS.

DIMENSIONS (INCHES)				
A	B	C	D	E
2 5/8	3	5 1/4	3/8	1/2
3	3 1/2	6 1/8	7/16	9/16
3 1/8	1 5/8	6 3/8	1/2	5/8
3 1/4	3 3/4	6 5/8	1/2	5/8
3 5/16	13 13/16	6 11/16	1/2	11/16
3 1/2	4	7 1/8	9/16	11/16
3 3/4	4 5/16	7 5/8	9/16	3/4
4	4 5/8	8 1/8	5/8	13/16
4 3/8	5	8 7/8	11/16	7/8
4 1/2	5 3/16	9 1/8	11/16	7/8
4 3/4	5 7/16	9 5/8	3/4	1
5	5 3/4	10 1/8	3/4	1
5 1/4	6	10 5/8	13/16	1 1/16
6	6 7/8	12 3/16	15/16	1 3/16
6 1/2	7 1/2	13 3/16	1	1 5/16
7	8	14 3/16	1 1/16	1 3/8
8	9 3/16	16 1/4	1 1/4	1 5/8

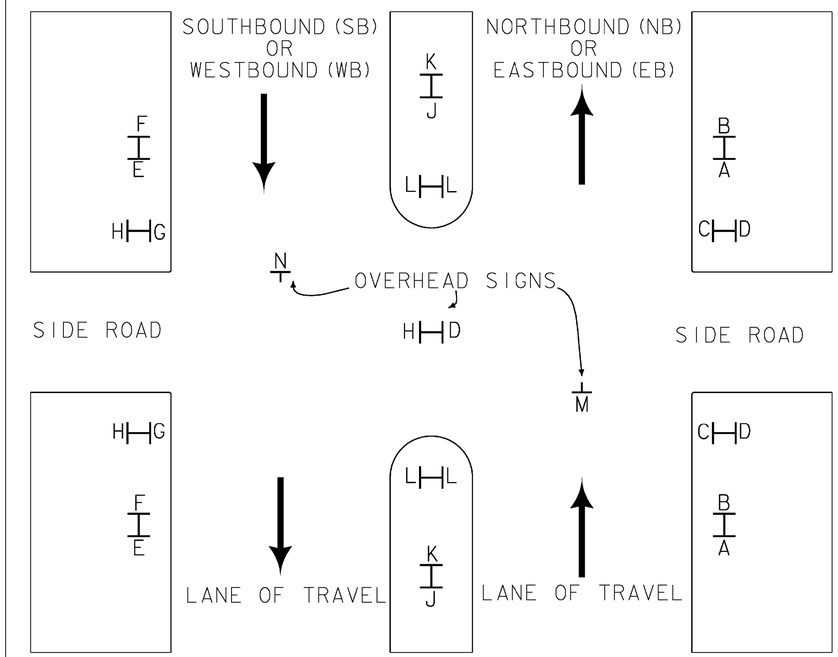

THE TRAFFIC SIGN LOCATION CODES ARE TO BE USED INCONJUNCTION WITH THE SIGN SUMMARY SHEETS TO ESTABLISH PROPER SIGN INSTALLATION IN THE FIELD.

TRAFFIC SIGN LOCATION CODES

NOT TO SCALE

PROJECT NAME: MORETOWN - NEWPORT TOWN

PROJECT NUMBER: STPG SIGN (28)

FILE NAME: 09B060_TS.DGN
PROJECT LEADER: N. AVERY
DESIGNED BY: N. AVERY
GENERAL NOTES

PLOT DATE: 30-SEP-2009
DRAWN BY: N. AVERY
CHECKED BY: A. GAMBLE
SHEET 2 OF 166

STATE OF VERMONT
AGENCY OF TRANSPORTATION

QUANTITY SHEET 1

SUMMARY OF ESTIMATED QUANTITIES	TOTALS		DESCRIPTIONS				DETAILED SUMMARY OF QUANTITIES		
ROADWAY	GRAND TOTAL	FINAL	UNIT	ITEMS	ITEM NUMBER	ROUND	QUANTITIES	UNIT	ITEMS
1	1		CY	TRENCH EXCAVATION OF EARTH, EXPLORATORY (N.A.B.I.)	204.22				
50	50		HR	UNIFORMED TRAFFIC OFFICERS	630.10				
876	876		HR	FLAGGERS	630.15				
1	1		LS	MOBILIZATION/DEMOBILIZATION	635.11				
1	1		LS	TRAFFIC CONTROL	641.10				
4214.6	4214.6		SF	TRAFFIC SIGNS, TYPE A	675.20				
10335	10335		LF	SQUARE TUBE SIGN POST AND ANCHOR	675.341				
853	853		EACH	REMOVING SIGNS	675.50				
34	34		EACH	ERECTING SALVAGED SIGNS	675.60				

PROJECT NAME: MORETOWN - NEWPORT TOWN

PROJECT NUMBER: STPG SIGN (28)

FILE NAME: 09B060_TS.DGN
PROJECT LEADER: N. AVERY
DESIGNED BY: N. AVERY
QUANTITY SHEET


PLOT DATE: 30-SEP-2009
DRAWN BY: N. AVERY
CHECKED BY: A. GAMBLE
SHEET 3 OF 166


TEXT	SERIES	DIMENSIONS
ADDISON	C	28.27
ALBANY	C	25.88
ALBURGH	C	29.99
ANDOVER	C	30.05
ARLINGTON	B	29.35
ATHENS	C	24.49
AVERILL	C	26.44
BAKERSFIELD	B	32.50
BARNARD	C	30.49
BARNET	C	24.83
BARRE CITY	B	32.50
BARRE TOWN	B	32.50
BARTON	C	25.38
BELVIDERE	C	32.50
BENNINGTON	B	32.50
BENSON	C	25.41
BERKSHIRE	B	29.04
BERLIN	C	22.50
BETHEL	C	23.80
BLOOMFIELD	B	32.13
BOLTON	C	24.39
BRADFORD	C	32.50
BRAINTREE	C	32.50
BRANDON	C	30.46
BRATTLEBORO	B	32.50
BRIDGEWATER	B	32.50
BRIDPORT	C	32.06
BRIGHTON	C	32.06
BRISTOL	C	27.24
BROOKFIELD	B	31.91
BROWNINGTON	B	31.22
BRUNSWICK	B	30.60
BURKE	C	20.93
BUELS GORE	B	32.50
BURLINGTON	B	32.50
CABOT	C	20.50
CALAIS	C	22.22
CAMBRIDGE	B	29.74
CANAAN	C	25.15
CASTLETON	B	29.32
CAVENDISH	C	32.50
CHARLESTON	B	32.50
CHARLOTTE	B	29.32
CHELSEA	C	28.84
CHESTER	C	28.46
CHITTENDEN	B	30.56
CLARENDON	B	30.32
COLCHESTER	B	32.50
CONCORD	C	30.42
CORINTH	C	27.27
CORNWALL	C	32.50
COVENTRY	C	32.50
CRAFTSBURY	B	32.50
DANBY	C	21.65
DANVILLE	C	31.16
DERBY	C	21.15
DORSET	C	24.55
DOVER	C	20.74
DUMMERSTON	B	32.50
DUXBURY	C	30.75
EDEN	C	15.85
ENOSBURG	C	32.50
EAST HAVEN	B	32.50
E. MONTPELIER	B (5″)	32.50
ELMORE	C	25.46
ESSEX	C	20.38
FAIRFAX	C	27.05
FAIRFIELD	C	32.50
FAIR HAVEN	B	32.50
FAIRLEE	C	26.12
FAYSTON	C	28.85
FERDINAND	B	29.17
FERRISBURGH	B	32.50
FLETCHER	C	31.85
FRANKLIN	C	31.31

TEXT	SERIES	DIMENSIONS
GEORGIA	C	27.74
GLOVER	C	25.00
GOSHEN	C	25.16
GLASTENBURY	B (5″)	31.32
GRAFTON	C	29.31
GRAND ISLE	B	32.50
GRANVILLE	C	32.50
GREENSBORO	B	32.50
GROTON	C	25.35
GUILDHALL	C	32.50
GUILFORD	C	31.78
HALIFAX	C	27.14
HANCOCK	C	29.96
HARDWICK	C	32.50
HARTFORD	C	32.50
HARTLAND	C	32.50
HIGHGATE	C	31.14
HINESBURG	B	29.23
HOLLAND	C	29.22
HUBBARDTON	B	31.42
HYDE PARK	B	32.50
IRA	C	10.15
IRASBURG	C	32.37
ISLE LA MOTTE	B (5″)	32.50
JAMAICA	C	28.26
JAY	C	11.85
JERICHO	C	27.24
JOHNSON	C	30.39
KILLINGTON	B	30.16
KIRBY	C	18.99
LANDGROVE	B	30.33
LEICESTER	C	32.50
LEMINGTON	B	28.79
LONDONDERRY	B (5″)	32.18
LOWELL	C	25.04
LUDLOW	C	26.10
LUNENBERG	B	30.01
LYNDON	C	24.96
MAIDSTONE	B	29.51
MANCHESTER	B	32.50
MARLBORO	C	32.50
MARSHFIELD	B	32.47
MENDON	C	26.02
MIDDLEBURY	B	32.50
MIDDLESEX	B	29.06
MIDDLETOWN SPR	B (5″)	32.50
MILTON	C	22.63
MONTGOMERY	B	32.50
MONTPELIER	B	31.94
MORETOWN	C	32.50
MORGAN	C	26.52
MORRISTOWN	B	32.50
MOUNT HOLLY	B (5″)	31.97
MOUNT TABOR	B	32.02
NEWARK	C	25.65
NEWBURY	C	30.87
NEWFANE	C	29.73
NEW HAVEN	B	32.50
NEWPORT CITY	B (5″)	32.50
NEWPORT TOWN	B (5″)	32.50
NORTH HERO	B	32.50
NORTHFIELD	B	31.57
NORTON	C	25.60
NORWICH	C	28.77
ORANGE	C	25.88
ORWELL	C	25.57
PANTON	C	25.38
PAWLET	C	24.59
PEACHAM	C	30.23
PERU	C	16.38
PITTSFIELD	C	32.50
PITTSFORD	C	32.50
PLAINFIELD	B	29.65
PLYMOUTH	C	32.50
POMFRET	C	29.42

TEXT	SERIES	DIMENSIONS
POULTNEY	C	32.50
POWNAL	C	26.35
PROCTOR	C	29.31
PUTNEY	C	24.83
RANDOLPH	C	32.50
READING	C	27.47
READSBORO	B	31.09
RICHFORD	C	32.06
RICHMOND	C	32.50
RIPTON	C	22.97
ROCHESTER	B	29.54
ROCKINGHAM	B	32.50
ROXBURY	C	30.44
ROYALTON	C	32.50
RUPERT	C	24.94
RUTLAND CITY	B (5″)	32.50
RUTLAND TOWN	B (5″)	32.50
RYEGATE	C	28.47
ST. ALBANS CITY	B (5″)	32.50
ST. ALBANS TOWN	B (5″)	32.50
ST. GEORGE	B	32.50
ST. JOHNSBURY	B (5″)	32.50
SALISBURY	C	32.50
SEARSBURG	B	30.93
SHAFTSBURY	B	32.50
SHARON	C	25.91
SHEFFIELD	C	32.50
SHELDON	C	29.42
SHOREHAM	C	32.50
SHREWSBURY	B	32.50
S. BURLINGTON	B (5″)	32.50
SOUTH HERO	B	32.50
SPRINGFIELD	B	32.50
STAMFORD	C	32.50
STARKSBORO	B	32.50
STOCKBRIDGE	B	32.50
STOWE	C	21.30
STRAFFORD	B	30.42
STRATTON	C	32.06
SUDBURY	C	30.77
SUNDERLAND	B	32.50
SUTTON	C	24.21
SWANTON	C	30.22
THETFORD	C	32.50
TINMOUTH	C	32.14
TOPSHAM	C	30.53
TOWNSHEND	B	31.70
TROY	C	16.54
TUNBRIDGE	C	32.50
UNDERHILL	C	32.50
VERGENNES	B	30.03
VERNON	C	25.79
VERSHIRE	C	31.72
WAITSFIELD	B	30.44
WALDEN	C	25.46
WALLINGFORD	B	32.50
WALTHAM	C	29.91
WARDSBORO	B	32.29
WARREN	C	25.99
WARRENS GORE	B (5″)	32.50
WASHINGTON	B	32.50
WATERBURY	B	31.40
WATERFORD	B	30.65
WATERVILLE	B	31.35
WEATHERSFIELD	B (5″)	32.50
WELLS	C	20.83
WEST FAIRLEE	B (5″)	32.50
WESTFIELD	C	32.50
WEST HAVEN	B	32.50
WESTFORD	C	32.50
WESTMINISTER	B	32.50
WESTMORE	C	32.50
WESTON	C	25.85

TEXT	SERIES	DIMENSIONS
WEST RUTLAND	B (5″)	32.50
WEST WINDSOR	B (5″)	32.50
WEYBRIDGE	C	32.50
WHEELOCK	C	32.50
WHITING	C	25.86
WHITINGHAM	B	32.50
WILLIAMSTOWN	B (5″)	32.50
WILLISTON	C	32.50
WILMINGTON	B	32.16
WINDHAM	C	29.66
WINDSOR	C	28.77
WINHALL	C	28.24
WINOOSKI	C	30.81
WOLCOTT	C	29.38
WOODBURY	C	32.50
WOODFORD	C	32.50
WOODSTOCK	B	31.79
WORCESTER	B	30.76

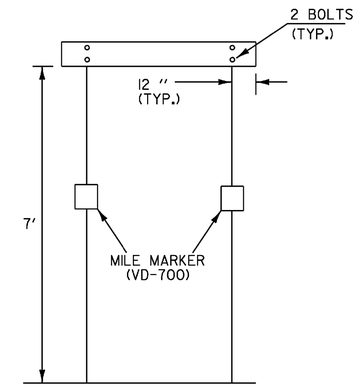


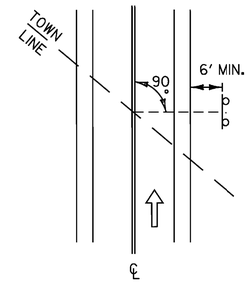

THE SIGN SHALL BE MOUNTED PARALLEL WITH THE ROADWAY, NORMALLY ON RIGHT SIDE TRAVELING WEST TO EAST OR SOUTH TO NORTH.

NOTES:

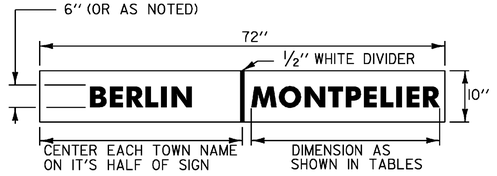1. WORD TO WORD SPACING FOR MULTIPLE TEXT TOWN NAMES IS ADJUSTABLE TO ACCOMMODATE DIMENSION REQUIREMENTS.
2. DIMENSIONS SHOWN ARE APPROXIMATE AND MAY BE ADJUSTED SLIGHTLY TO ACCOMMODATE VARIOUS MANUFACTURER'S LETTER WIDTHS.
3. ALL DIMENSIONS ARE IN INCHES UNLESS OTHERWISE NOTED



VD-024
VD-025 SIMILIAR

WHEN CROSSING COUNTY BOUNDARIES AN ADDITIONAL COUNTY LINE SIGN SHALL BE MOUNTED BELOW THE TOWN LINE SIGN MAINTAINING AN SEVEN FOOT CLEARANCE.

COUNTY NAMES

TEXT	SERIES	DIMENSIONS
ADDISON CO.	B	32.50
BENNINGTON CO.	B (5″)	32.50
CALEDONIA CO.	B (5″)	32.50
CHITTENDEN CO.	B (5″)	32.50
ESSEX CO.	C	32.50
FRANKLIN CO.	B (5″)	32.50
GRAND ISLE CO.	B (5″)	32.50
LAMOILLE CO.	B (5″)	32.50
ORANGE CO.	B	32.50
ORLEANS CO.	B	32.50
RUTLAND CO.	B	32.50
WASHINGTON CO.	B (5″)	32.50
WINDHAM CO.	B	32.50
WINDSOR CO.	B	32.50

VD-025

TOWN/COUNTY LINE SIGN NOTES:

1. THE SIGN BASE MATERIAL SHALL BE HIGH DENSITY OVERLAID PLYWOOD ⅝ INCH THICK OR ALUMINUM SHEETING 0.125″ MINIMUM THICKNESS. THE RETROREFLECTIVE MATERIAL SHALL BE SHEETING APPLIED TO THE ENTIRE BACKGROUND OF THE SIGN. THE LEGEND SHALL BE CUT-OUT RETROREFLECTIVE LEGEND. ALL RETROREFLECTIVE MATERIAL SHALL BE EQUAL TO OR EXCEEDING THE ″THE AMERICAN SOCIETY OF TESTING AND MATERIALS″ (ASTM 4956-01) TYPE III SHEETING.
2. SIGNS SHALL HAVE A MINIMUM ASTM TYP III SHEETING WITH A WHITE LEGEND ON A GREEN BACKGROUND.
3. LEGEND SHALL CONFORM WITH THE STANDARD ALPHABETS FOR HIGHWAY SIGNS APPROVED BY THE NATIONAL JOINT COMMITTEE ON UNIFORM TRAFFIC CONTROL DEVICES.
4. ALL SIGNS SHALL BE IN ACCORDANCE WITH ″THE MANUAL ON UNIFORM TRAFFIC CONTROL DEVICES″ (2003 MUTCD) AND THE ″STANDARD HIGHWAY SIGNS″ BOOK (SHS) PUBLISHED BY THE FEDERAL HIGHWAY ADMINISTRATION (FHWA).

PROJECT NAME: MORETOWN - NEWPORT TOWN

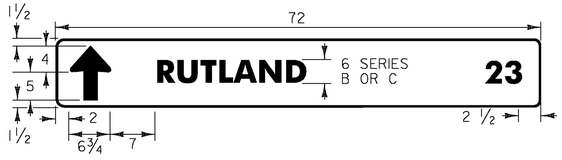
PROJECT NUMBER: STPG SIGN (28)

FILE NAME: 09B060_TS.DGN
PROJECT LEADER: N. AVERY
DESIGNED BY: N. AVERY
COUNTY / TOWN LINE DESIGN


PLOT DATE: 30-SEP-2009
DRAWN BY: N. AVERY
CHECKED BY: A. GAMBLE
SHEET 4 OF 166




D1-1




D1-1A

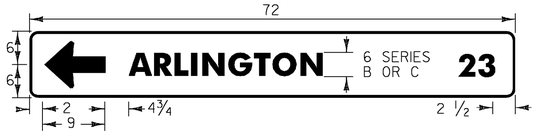


D1-1A

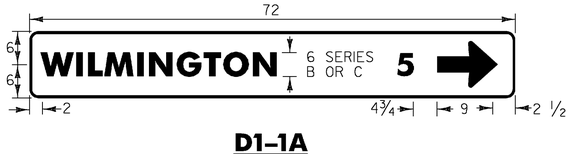


D1-1A

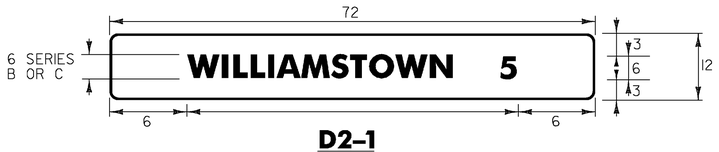


D2-1

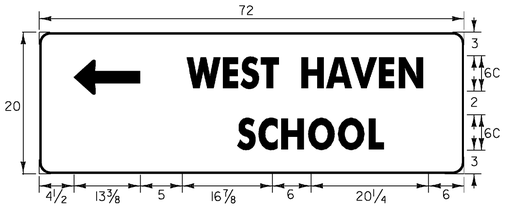


D1-2 (L)

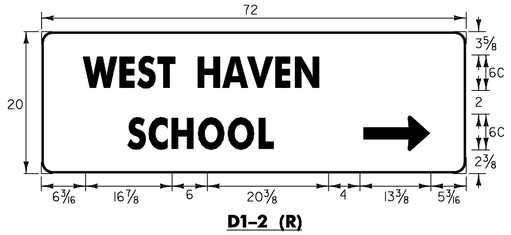


D1-2 (R)

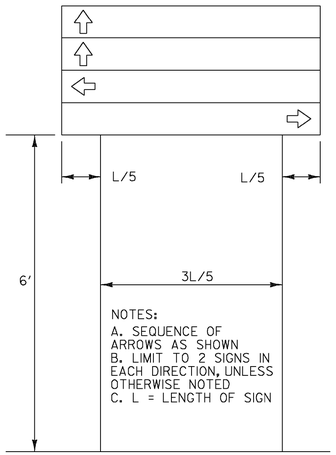

DESTINATION ASSEMBLY

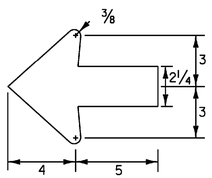

STANDARD ARROW

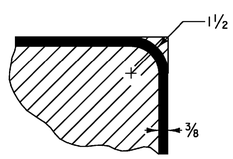


BORDER DETAIL

STANDARD DESTINATION SIGN NOTES
D1-1, D1-1A, D1-2, D2-1

1. ALL SIGNS SHALL BE IN ACCORDANCE WITH THE MUTCD AND THE "STANDARD HIGHWAY SIGNS" BOOK (SHS) PUBLISHED BY THE FEDERAL HIGHWAY ADMINISTRATION (FHWA).
2. THE SIGN BASE MATERIAL FOR STANDARD DESTINATION SIGNS SHALL BE HIGH DENSITY OVERLAYED PLYWOOD 5/8 INCH THICK OR FLAT SHEET ALUMINUM 1/8 INCH THICK.
3. THE DESTINATION SIGNS SHOWN ON THIS SHEET SHALL HAVE WHITE RETROREFLECTIVE ASTM TYPE III TEXT, ARROWS AND BORDERS ON A GREEN RETROREFLECTIVE ASTM TYPE III BACKGROUND. THE COLORS SHALL CONFORM WITH THE COLORS ADOPTED BY AASHTO AND APPROVED BY THE FHWA.
4. MULTIPLE ASSEMBLIES SHALL USE THE SAME SIZE THROUGHOUT. DO NOT MIX AND MATCH OLDER SIGN SIZES WITH NEW SIGN HEIGHTS AND WIDTHS.
5. ALL DIMENSIONS SHOWN IN INCHES UNLESS OTHERWISE NOTED.



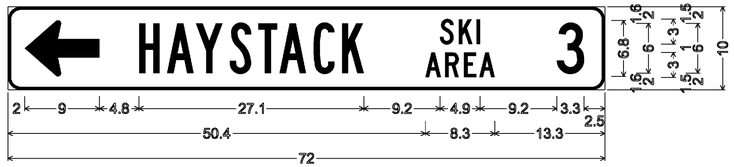1.5" Radius, 0.4" Border, White on Green;
Standard Arrow Custom 9.0" X 6.8" 180"; "STRATTON MTN" B specified length;
"SKI" C; "AREA" C; "10" B specified length;




1.5" Radius, 0.4" Border, White on Green;
Standard Arrow Custom 9.0" X 6.8" 180"; "HAYSTACK" B; "SKI" C; "AREA" C; "3" C;

D1-1A




1.5" Radius, 0.4" Border, White on Green;
Standard Arrow Custom 9.0" X 6.8" 90"; "MOUNT SNOW" B 90% spacing; "SKI" C;
"AREA" C; "7" C;

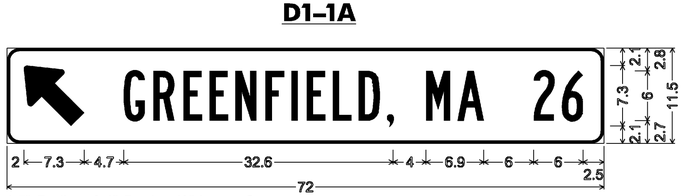D1-1A




1.5" Radius, 0.4" Border, White on Green;
Arrow Custom - 9.0" 135";
"GREENFIELD," B " " C "MA" B " " C "26" B specified length;

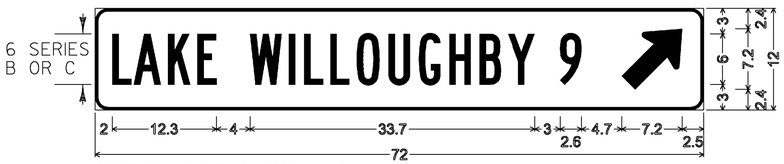D1-1A




1.5" Radius, 0.4" Border, White on Green;
"LAKE WILLOUGHBY" B specified length; "9" B;
Standard Arrow Custom 9.0" X 6.0" 45";

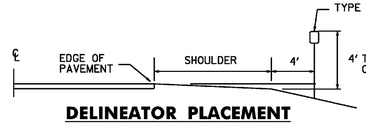D1-1A



DELINEATOR PLACEMENT

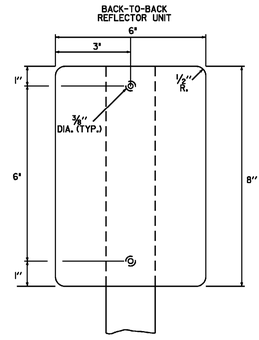


TYPE II (6"X8")

DELINEATORS WITH RETROREFLECTIVE SHEETING


MATERIAL FOR RETROREFLECTIVE SHEETING FOR DELINEATORS SHALL BE A 0.063" ALUMINUM BACKING WITH A WHITE ASTM TYPE III OR TYPE IV.

PROJECT NAME: MORETOWN - NEWPORT TOWN	
PROJECT NUMBER: STPG SIGN (28)	
FILE NAME: 09B060_TS.DGN	PLOT DATE: 30-SEP-2009
PROJECT LEADER: N. AVERY	DRAWN BY: N. AVERY
DESIGNED BY: N. AVERY	CHECKED BY: A. GAMBLE
SIGN DETAILS I	SHEET 5 OF 166

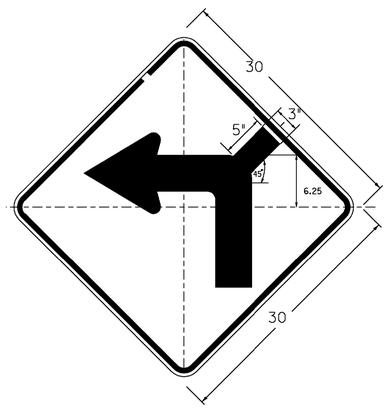


W1-1Md L(R)

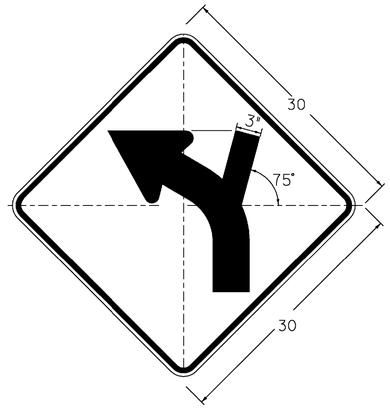DIMENSIONS NOT SHOWN
FOR THIS DETAIL SHALL CONFORM
TO THE LATEST EDITION OF THE 2003 MUTCD
FOR SIGN DETAIL W1-1.
UNLESS OTHERWISE NOTED FOR THIS DETAIL




W1-2Mi L(R)

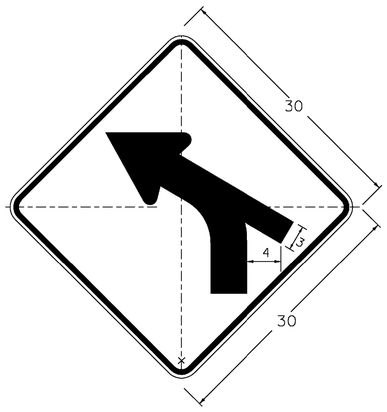DIMENSIONS NOT SHOWN
FOR THIS DETAIL SHALL CONFORM
TO THE LATEST EDITION OF THE 2003 MUTCD
FOR SIGN DETAIL W1-2.
UNLESS OTHERWISE NOTED FOR THIS DETAIL




W1-2Mh L(R)

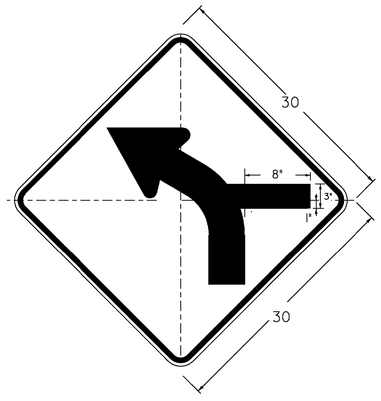DIMENSIONS NOT SHOWN
FOR THIS DETAIL SHALL CONFORM
TO THE LATEST EDITION OF THE 2003 MUTCD
FOR SIGN DETAIL W1-2.
UNLESS OTHERWISE NOTED FOR THIS DETAIL




W1-2Mc L

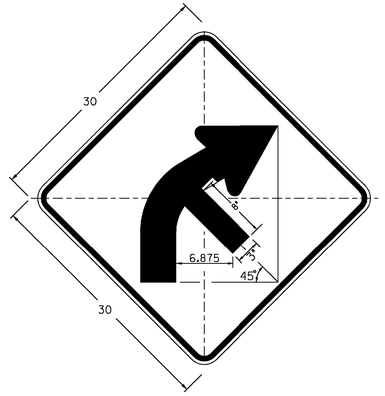DIMENSIONS NOT SHOWN
FOR THIS DETAIL SHALL CONFORM
TO THE LATEST EDITION OF THE 2003 MUTCD
FOR SIGN DETAIL W1-2.
UNLESS OTHERWISE NOTED FOR THIS DETAIL




W1-2Mb R(L)

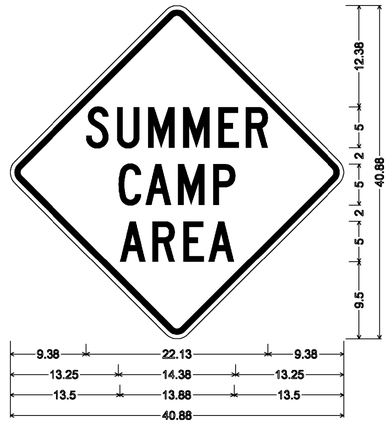DIMENSIONS NOT SHOWN
FOR THIS DETAIL SHALL CONFORM
TO THE LATEST EDITION OF THE 2003 MUTCD
FOR SIGN DETAIL W1-2.
UNLESS OTHERWISE NOTED FOR THIS DETAIL




1.875" RADIUS, 0.75" BORDER, 0.5" INDENT
COLORS: LEGEND - BLACK
BACKGROUND - YELLOW
TEXT STYLE: "SUMMER" C; "CAMP" C; "AHEAD" C

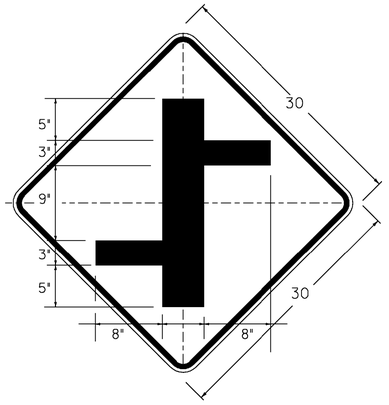VW-219




W2-1Me

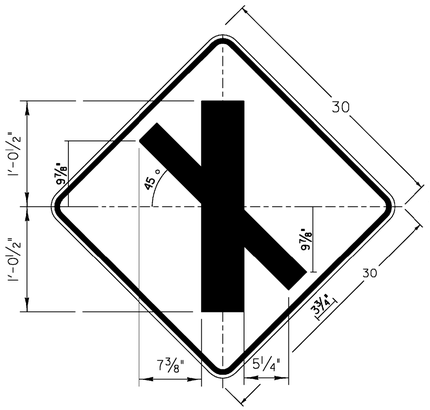DIMENSIONS NOT SHOWN
FOR THIS DETAIL SHALL CONFORM
TO THE LATEST EDITION OF THE 2003 MUTCD
FOR SIGN DETAIL W2-1.
UNLESS OTHERWISE NOTED FOR THIS DETAIL




W2-1Mh

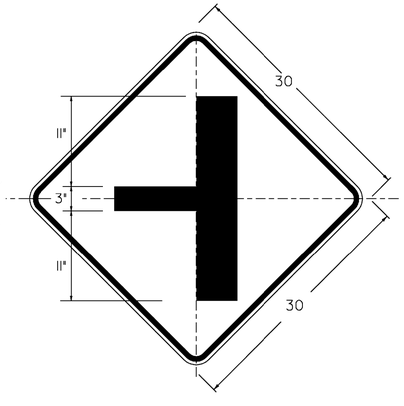DIMENSIONS NOT SHOWN
FOR THIS DETAIL SHALL CONFORM
TO THE LATEST EDITION OF THE 2003 MUTCD
FOR SIGN DETAIL W2-1.
UNLESS OTHERWISE NOTED FOR THIS DETAIL




W2-2Ma L(R)

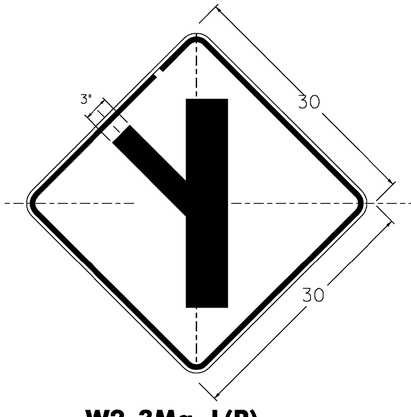DIMENSIONS NOT SHOWN
FOR THIS DETAIL SHALL CONFORM
TO THE LATEST EDITION OF THE 2003 MUTCD
FOR SIGN DETAIL W2-2.
UNLESS OTHERWISE NOTED FOR THIS DETAIL




W2-3Ma L(R)

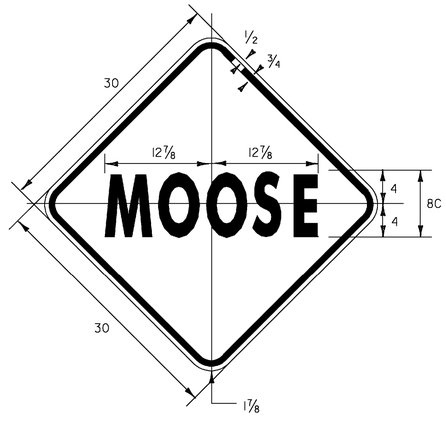DIMENSIONS NOT SHOWN
FOR THIS DETAIL SHALL CONFORM
TO THE LATEST EDITION OF THE 2003 MUTCD
FOR SIGN DETAIL W2-3.
UNLESS OTHERWISE NOTED FOR THIS DETAIL




VW-001

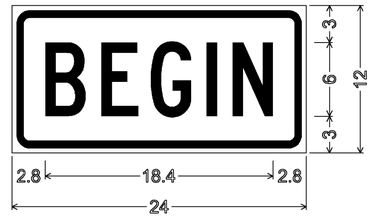COLORS: LEGEND - BLACK
BACKGROUND - YELLOW




1.5" RADIUS, 0.625" BORDER, 0.375" INDENT
COLORS: LEGEND - RED
BACKGROUND - WHITE
TEXT STYLE: "BEGIN" C

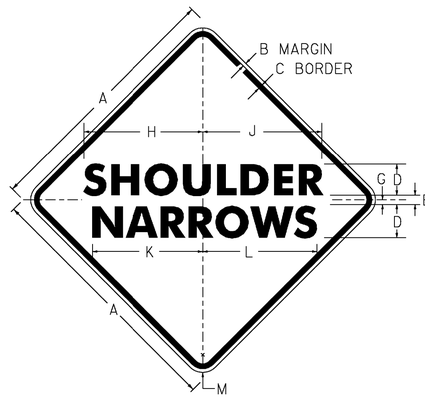VR-644p




VW-619

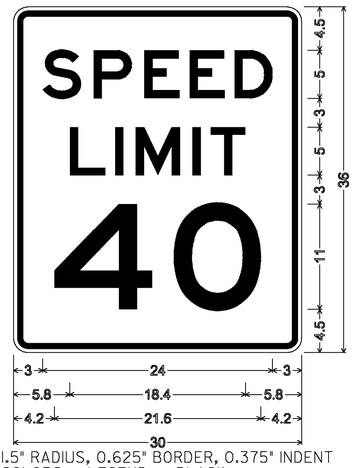COLORS: LEGEND - BLACK
BACKGROUND - YELLOW



1.5" RADIUS, 0.625" BORDER, 0.375" INDENT
COLORS: LEGEND - BLACK
BACKGROUND - WHITE
TEXT STYLE: "SPEED" E; "LIMIT" E; "40" E

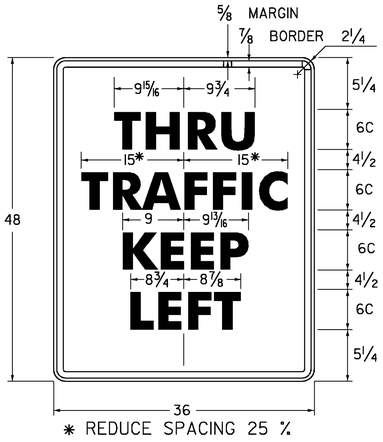
R2-1



* REDUCE SPACING 25 %

COLORS: LEGEND - BLACK
BACKGROUND - WHITE

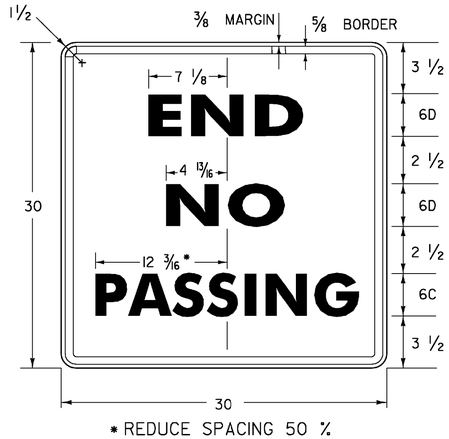VR-118L



* REDUCE SPACING 50 %

COLORS: LEGEND - BLACK
BACKGROUND - WHITE

VR-417



* REDUCE SPACING 40%
** REDUCE SPACING 60%

COLORS: LEGEND - BLACK
BACKGROUND - WHITE

VR-023b

SIGN	DIMENSIONS (INCHES)											
	A	B	C	D	E	F	G	H	J	K	L	M
MIN & STD.	36	⅝	⅞	5C	3	6D	I	13 11/16	13 1/16	17 5/8	18 1/4	2¼
EXPWY.	48	¾	1¼	7D	3½	7D	I	23 13/16	23 7/8	21½	21 9/16	3

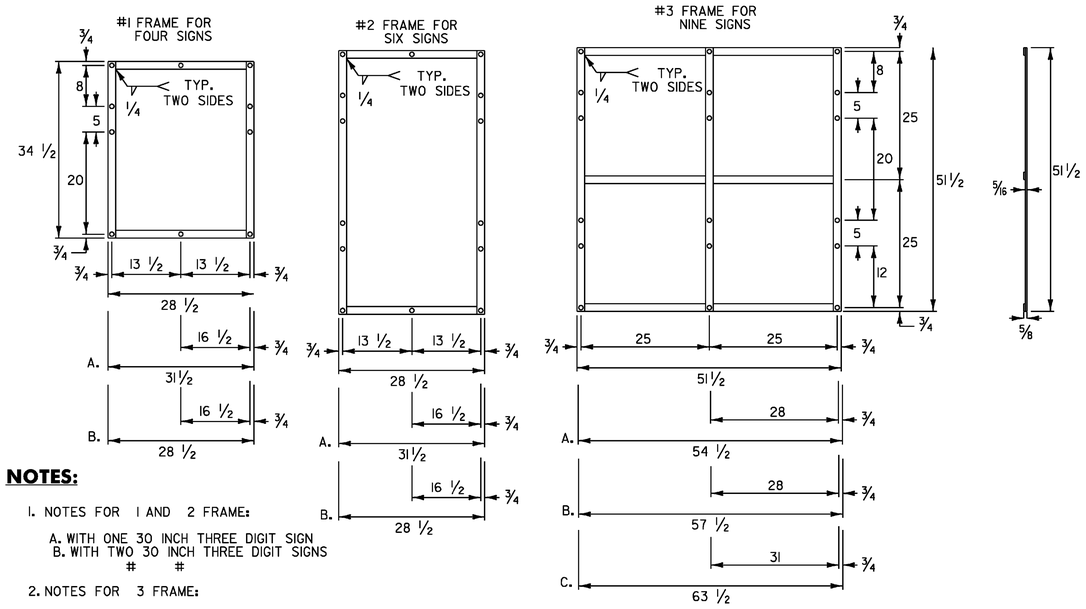
PROJECT NAME: MORETOWN - NEWPORT TOWN

PROJECT NUMBER: STPG SIGN (28)

FILE NAME: 09B060_TS.DGN
PROJECT LEADER: N. AVERY
DESIGNED BY: N. AVERY
SIGN DETAILS 2

PLOT DATE: 30-SEP-2009
DRAWN BY: N. AVERY
CHECKED BY: A. GAMBLE
SHEET 6 OF 166


ROUTE MARKER ASSEMBLY FRAMES



NOTES:

1. NOTES FOR 1 AND 2 FRAME:
   - A. WITH ONE 30 INCH THREE DIGIT SIGN
   - B. WITH TWO 30 INCH THREE DIGIT SIGNS (# #)
2. NOTES FOR 3 FRAME:
   - A. WITH ONE 30 INCH THREE DIGIT SIGN IN AN OUTSIDE POSITION.
   - B. WITH ONE#30 INCH THREE DIGIT SIGN IN THE CENTER POSITION OR TWO SUCH SIGNS IN THE OUTSIDE POSITIONS.
   - C. WITH THREE 30 INCH THREE DIGIT SIGNS.
3. ALL HOLES SHALL BE 7/16 INCH DIAMETER. FOR OTHER SIGN COMBINATIONS. THAN ABOVE, THE FRAME DIMENSIONS AND HOLE SPACING SHALL BE MODIFIED AS NECESSARY. THE FRAME SHALL BE PAINTED WITH ONE COAT OF PRIMER AND A SECOND COAT OF BLACK PAINT. THE PAINT SHALL BE OF THE TYPE USED ON EXTERIOR METAL SURFACES TO PREVENT METAL CORROSION.
4. STANDARD FRAMES SHALL BE 5/16 INCH x 1 1/2 INCH WELDED A-36 STEEL.
5. ALL DIMENSIONS SHOWN IN INCHES UNLESS OTHERWISE NOTED.

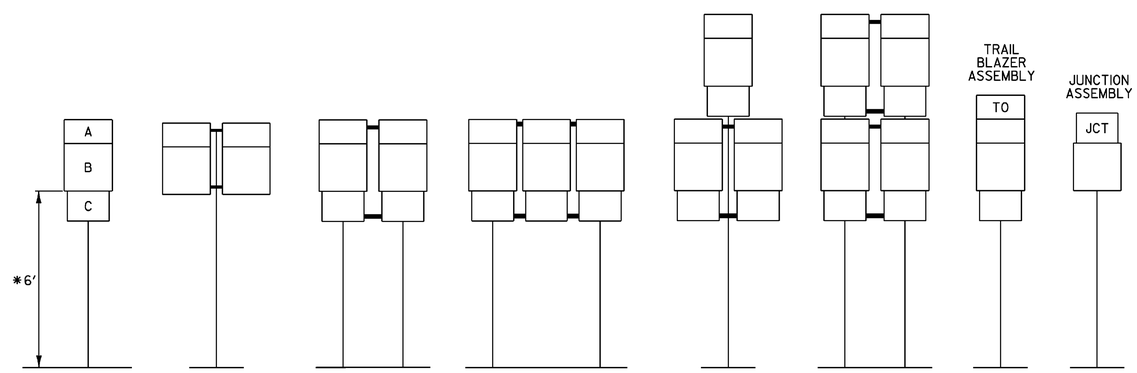STANDARD MOUNTING OF ROUTE MARKER ASSEMBLIES



A - CARDINAL DIRECTION MARKER
B - ROUTE NUMBER
C - ADVANCE TURN ARROW OR DIRECTIONAL ARROW

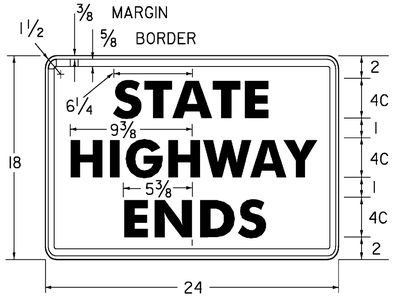
* WHERE PARKING OR PEDESTRIAN TRAFFIC WILL OCCUR IN THE IMMEDIATE VICINITY OF THESE SIGNS MINIMUM VERTICAL CLEARANCE SHALL BE INCREASED TO SEVEN FEET

INSTALLATION SEQUENCE:

IN MULTIPLE HORIZONTAL MOUNTINGS PLACE A ROUTE MARKER ASSEMBLY INDICATING A LEFT TURN ON THE LEFT SIDE OF THE ASSEMBLY; RIGHT TURN ON THE RIGHT SIDE. FOR VERTICALLY STACKED MOUNTINGS PLACE THE STRAIGHT THROUGH MOVE INDICATION ON TOP, THE LEFT OR RIGHT TURNS AS APPROPRIATE BENEATH.


NOTES:

1. ALL DIMENSIONS SHOWN IN INCHES UNLESS OTHERWISE NOTED.
2. VERTICAL FRAME MEMBERS SHALL LINE UP WITH SIGN POST ON WHICH THEY ARE MOUNTED.




COLORS: LEGEND - BLACK
BACKGROUND - WHITE

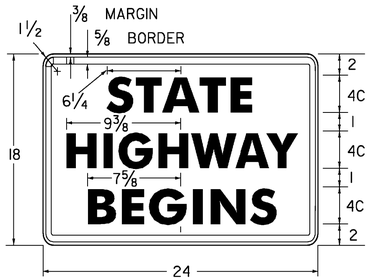VR-038




COLORS: LEGEND - BLACK
BACKGROUND - WHITE

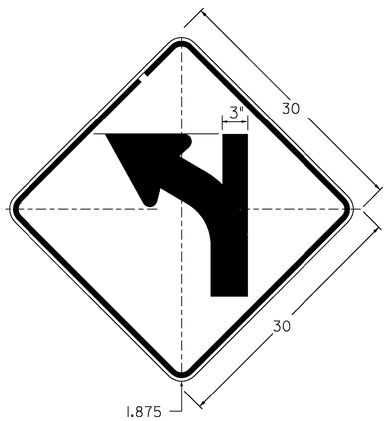VR-039




W1-2Mg L(R)

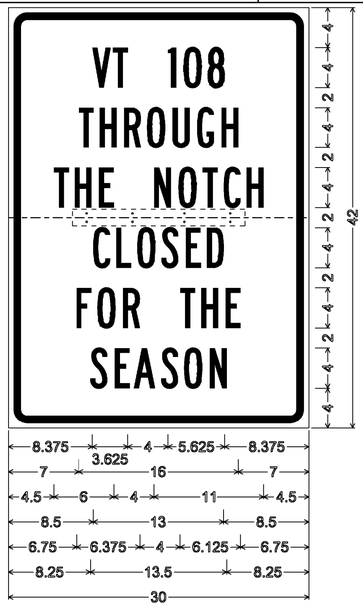DIMENSIONS NOT SHOWN FOR THIS DETAIL SHALL CONFORM TO THE LATEST EDITION OF THE 2003 MUTCD FOR SIGN DETAIL W1-2. UNLESS OTHERWISE NOTED FOR THIS DETAIL




1.875" RADIUS, 0.75" BORDER, 0.50" INDENT
COLORS: LEGEND - BLACK
BACKGROUND - WHITE
TEXT STYLE: "VT 108" B; "THROUGH" B; "THE NOTCH" B; "CLOSED" B; "FOR THE" B; "SEASON" B

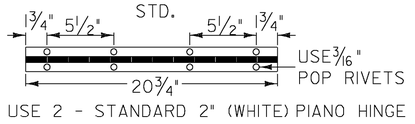VR-474H



USE 2 - STANDARD 2" (WHITE) PIANO HINGE

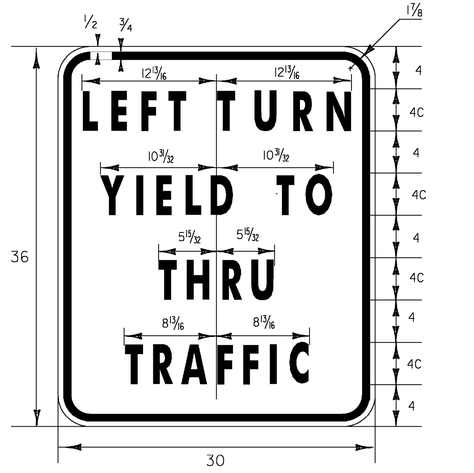

COLORS: LEGEND - BLACK
BACKGROUND - WHITE

VR-615


PROJECT NAME: MORETOWN - NEWPORT TOWN	
PROJECT NUMBER: STPG SIGN (28)	
FILE NAME: 09B060_TS.DGN	PLOT DATE: 30-SEP-2009
PROJECT LEADER: N. AVERY	DRAWN BY: N. AVERY
DESIGNED BY: N. AVERY	CHECKED BY: A. GAMBLE
GUIDE SIGN ASSEMBLY	SHEET 7 OF 166



I.5" RADIUS, 0.375" BORDER, 0.375" INDENT
COLORS: LEGEND - BLACK
BACKGROUND - YELLOW
TEXT STYLE: B

* LATERAL SPACING TO OUTSIDE OF PANEL SHALL BE A MINIMUM OF I.5"

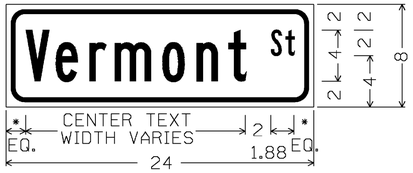
W16-8



I.5" RADIUS, 0.375" BORDER, 0.375" INDENT
COLORS: LEGEND - BLACK
BACKGROUND - YELLOW
TEXT STYLE: B

* LATERAL SPACING TO OUTSIDE OF PANEL SHALL BE A MINIMUM OF I.5"

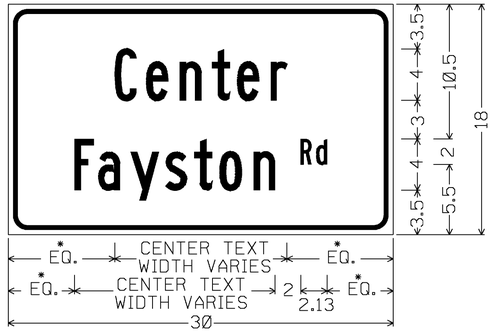
W16-8



I.5" RADIUS, 0.375" BORDER, 0.375" INDENT
COLORS: LEGEND - BLACK
BACKGROUND - YELLOW
TEXT STYLE: B

* LATERAL SPACING TO OUTSIDE OF PANEL SHALL BE A MINIMUM OF I.5"

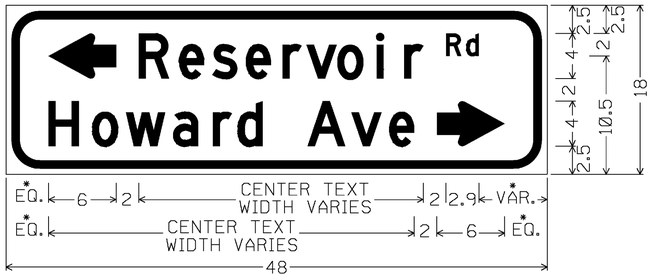W16-8




3" RADIUS, 0.75" BORDER, 0.50" INDENT
COLORS: LEGEND - BLACK
BACKGROUND - YELLOW
TEXT STYLE: DSTANDARD ARROW CUSTOM 6" WIDE X 4" HIGH

* LATERAL SPACING TO OUTSIDE OF PANEL SHALL BE A MINIMUM OF 3"

W16-8a


ADVANCE STREET NAME WARNING SIGN PLAQUE NOTES:

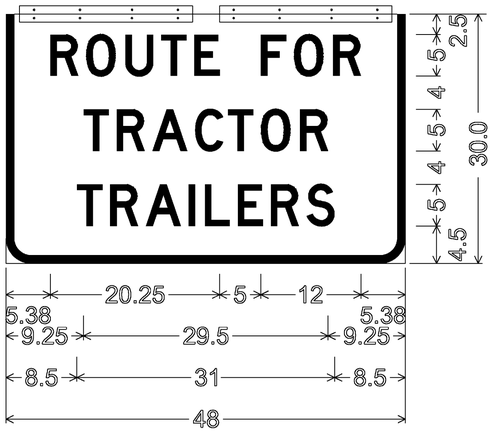1. ALL ADVANCE STREET NAME PLAQUE SIGNS (W16-8 AND W16-8a) USED TO IDENTIFY THE NAME OF THE INTERSECTING STREETS SHALL HAVE INITIAL UPPER CASE LETTERS AND USED IN CONJUNCTION WITH LOWERCASE LETTERS (I.E. Main St, Foster Rd, East Ave, West Ln).




3.00" Radius, 1.00" Border, Black on White;
"ROUTE FOR" D; "TRACTOR" D;
"TRAILERS" D;

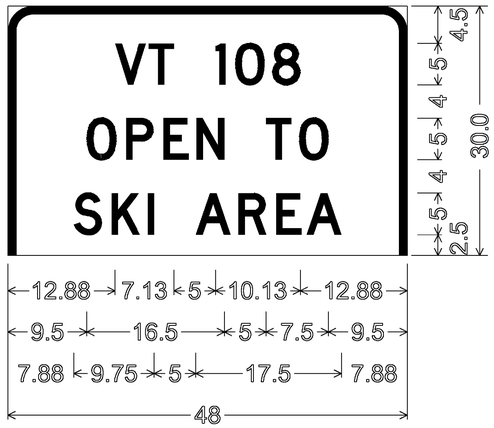
SIDE A




3.00" Radius, 1.00" Border, Black on White;
"VT 108" D; "OPEN TO" D;
"SKI AREA" D;

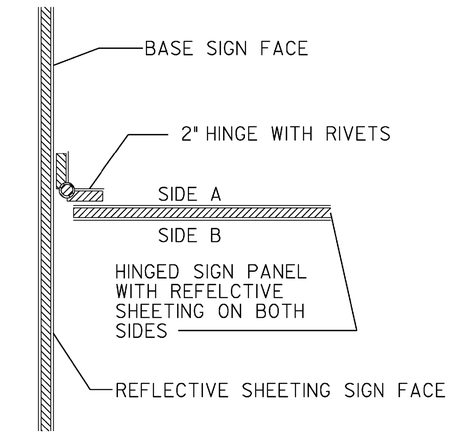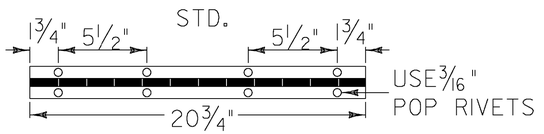SIDE B






USE 2 - STANDARD 2" (WHITE) PIANO HINGE

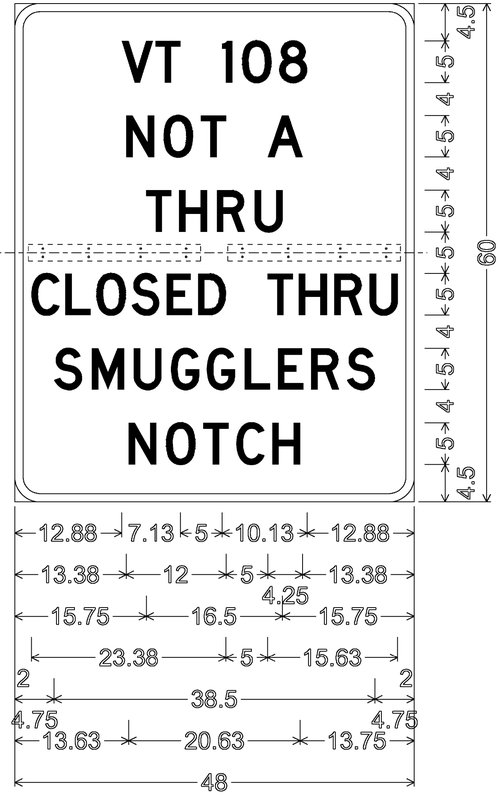

3.00" Radius, 1.00" Border, Black on White;
"VT 108" D; "NOT A" D;
"THRU" D;
"CLOSED THRU" D specified length;
"SMUGGLERS" D; "NOTCH" D;

VR-493 H
BASE SIGN


PROJECT NAME: MORETOWN - NEWPORT TOWN	
PROJECT NUMBER: STPG SIGN (28)	
FILE NAME: 09b060_TS.DGN	PLOT DATE: 30-SEP-2009
PROJECT LEADER: N. AVERY	DRAWN BY: N. AVERY
DESIGNED BY: N. AVERY	CHECKED BY: A. GAMBLE
WARNING STREET NAME PLAQUE DETAIL	SHEET 8 OF 166

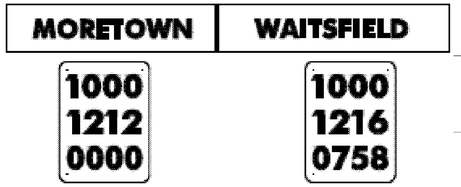DIRECTION	MILEPOINT	LOCATION CODE (SHEET 2)	SIGN CODE	WIDTH (IN)	HEIGHT (IN)	SHEETING REMARKS	SIGN LEGEND	NEW SIGNS "A"	NEW SIGNS "B"	EXISTING SIGNS RETAIN	EXISTING SIGNS SALVAGE FROM	EXISTING SIGNS SALVAGE TO	EXISTING SIGNS REMOVE	EXIST POST RETAIN	EXIST POST REMOVE	NUMBER OF NEW POSTS	SQUARE STEEL (IN) 1.75 (LB / FT) 1.88	SQUARE STEEL (IN) 2.00 (LB / FT) 2.42	SQUARE STEEL (IN) 2.50 (LB / FT) 3.35	TUBULAR STEEL Ø (IN) FOUNDATION	TUBULAR STEEL Ø (IN) 3.00 (LB / FT) 7.60	TUBULAR STEEL Ø (IN) 3.50 (LB / FT) 9.00	TUBULAR STEEL Ø (IN) 4.00 (LB / FT) 10.80	TUBULAR STEEL Ø (IN) 5.00 (LB / FT) 14.60	SIGN FRAME REQUIRED	REMARKS	SIGN DETAIL: DETAIL IN SHS	SIGN DETAIL: DETAIL ON SHEET NUMBER	SIGN DETAIL: DETAIL ON STD SHEET NUMBER
MORETOWN VT 100							FY-FLUORESCENT YELLOW FYG-FLUORESCENT YELLOW GREEN																			"SHS"-STANDARD HIGHWAY SIGNS			
NB	0.000	C	VD-024	60	7.5								I		X													
		C	VD-024	72	10			5.00								2		X									4
		C	VD-700	6	10			0.42																				
		C	VD-700	6	10			0.42																				
NB	0.187	A	VD-062B	72	16		BUSINESS SIGN			1				X														
		A	VD-062Al	72	16		BUSINESS SIGN			1																		
NB	0.230	A	M2-1S	21	15		JCT						1		X													
		A	M1-5	30	24		VT 100B						1															
NB	0.310	A	W2-2L	36	36		LEFT SIDE ROAD						1		X													
		A	W13-1	24	24		40 MPH PLAQUE						1															
		A	M2-1S	21	15			2.19								1		X						GREEN ON WHITE SHEETING	X	
		A	M1-5	30	24			5.00																				E-136B
NB	0.350	A	M3-1S	24	12		NORTH						1		X													
		A	M1-5	30	24		VERMONT 100						1															
		A	M5-1S	21	15		<--- LEFT (90 DEG)						1															
SIGN SUMMARY SHEET							SHEET TOTALS	13.03	0.00	2	0	0	7	0	0	3		45								
								SF	SF	EA	EA	EA	EA	EA	EA	EA		FT								
VERMONT AGENCY OF TRANSPORTATION							TOWN TOTALS	228.6	0.0	22.0	0.0	0.0	60	0.0	0.0	27		405.0								


PROJECT NAME: **Mortown-Newport Town VT100**
PROJECT NUMBER: **STPG SIGN(28)**

FILE NAME: **Moretown.xls** PLOT DATE: **9/16/2009**
PROJECT MANAGER: **N. Avery** DRAWN BY: **I. Shea**
DESIGNED BY: **D. Crossley** CHECKED BY: **J. Kelly**
MORETOWN SHEET 1 SHEET **9** OF **166**

DIRECTION	MILEPOINT	LOCATION CODE (SHEET 2)	SIGN CODE	WIDTH (IN)	HEIGHT (IN)	SHEETING REMARKS	SIGN LEGEND	NEW SIGNS "A"	NEW SIGNS "B"	EXISTING SIGNS RETAIN	EXISTING SIGNS SALVAGE FROM	EXISTING SIGNS SALVAGE TO	EXISTING SIGNS REMOVE	EXIST POST RETAIN	EXIST POST REMOVE	NUMBER OF NEW POSTS	SQUARE STEEL (IN) 1.75 (LB / FT) 1.88	SQUARE STEEL (IN) 2.00 (LB / FT) 2.42	SQUARE STEEL (IN) 2.50 (LB / FT) 3.35	TUBULAR STEEL Ø (IN) FOUNDATION	TUBULAR STEEL Ø (IN) 3.00 (LB / FT) 7.60	TUBULAR STEEL Ø (IN) 3.50 (LB / FT) 9.00	TUBULAR STEEL Ø (IN) 4.00 (LB / FT) 10.80	TUBULAR STEEL Ø (IN) 5.00 (LB / FT) 14.60	SIGN FRAME REQUIRED	REMARKS	SIGN DETAIL: DETAIL IN SHS	SIGN DETAIL: DETAIL ON SHEET NUMBER	SIGN DETAIL: DETAIL ON STD SHEET NUMBER
MORETOWN		**VT 100**					FY-FLUORESCENT YELLOW FYG-FLUORESCENT YELLOW GREEN																			"SHS"-STANDARD HIGHWAY SIGNS			
		A	M3-1S	24	12		NORTH						1															
		A	M1-5	30	24		VERMONT 100B						1															
		A	M6-3S	21	15		^UP ARROW						1															
		A	W2-2L	36	36		ELIMINATED	~~9.00~~			28.0		4			2		~~X~~		2				X			X	
	TYPE B ROUTE DIRECTIONAL SIGN ADDED PER C.O. #1	A	W16-8	36	12		ELIMINATED	~~3.00~~																			8	
NB	0.390	A	D2-1	72	10		^ MORETOWN 1						1		X													
		A	D2-1	72	10		^ MIDDLESEX 8						1															
		A	D1-1A	72	10		<--- WATERBURY 8						1															
		A	D1-1A	72	10		<--- STOWE 18						1															
	0.120	A	W3-5	36	36			9.00								2		X									X	
NB	0.410	A	R2-5A	24	30		REDUCED SPEED AHEAD						2 ~~1~~		X													
		A	D1-1A	72	12		MORETOWN 1	6.00								2			X								5	
		A	D1-1A	72	12		MIDDLESEX 8	6.00																			5	
		A	D1-1A	72	12		WATERBURY 8	6.00																			5	
		A	D1-1A	72	12		STOWE 18	6.00																			5	
							SHEET TOTALS	45.00 SF	0.00 SF	0 EA	0 EA	0 EA	8 EA	0 EA	0 EA	6 EA		90 FT										
							TOWN TOTALS	228.6	0.0	22.0	0.0	0.0	60	0.0	0.0	27		405.0										

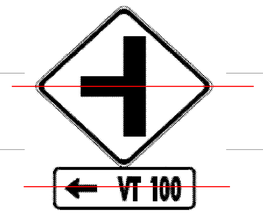



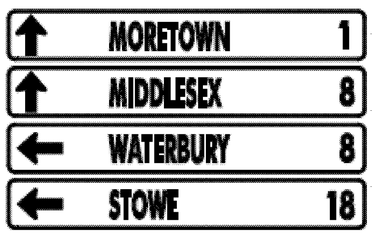

SIGN SUMMARY SHEET

VERMONT AGENCY OF TRANSPORTATION

PROJECT NAME: Mortown-Newport Town VT100
PROJECT NUMBER: STPG SIGN(28)

FILE NAME: Moretown.xls
PROJECT MANAGER: N. Avery
DESIGNED BY: D. Crossley
MORETOWN SHEET 2

PLOT DATE: 9/16/2009
DRAWN BY: I. Shea
CHECKED BY: J. Kelly


DIRECTION	MILEPOINT	LOCATION CODE (SHEET 2)	SIGN CODE	WIDTH (IN)	HEIGHT (IN)	SHEETING REMARKS	SIGN LEGEND	NEW SIGNS		EXISTING SIGNS				EXIST POST		NUMBER OF NEW POSTS	SQUARE STEEL (IN)			TUBULAR STEEL Ø (IN)					SIGN FRAME REQUIRED	REMARKS	SIGN DETAIL		
								"A"	"B"	RETAIN	SALVAGE FROM	SALVAGE TO	REMOVE	RETAIN	REMOVE		1.75 (LB / FT)	2.00 (LB / FT)	2.50 (LB / FT)	FOUNDATION	3.00 (LB / FT)	3.50 (LB / FT)	4.00 (LB / FT)	5.00 (LB / FT)			DETAIL IN SHS	DETAIL ON SHEET NUMBER	DETAIL ON STD SHEET NUMBER
																	1.88	2.42	3.35		7.60	9.00	10.80	14.60					
MORETOWN VT 100							FY-FLUORESCENT YELLOW FYG-FLUORESCENT YELLOW GREEN																			"SHS"-STANDARD HIGHWAY SIGNS			
NB	0.440	A	M3-1	24	12		NORTH						1	X															
		A	M1-5A	24	24		ROUTE 100						1																
		A	M6-1	21	15		<--- LEFT						1																
		A	M4-5	24	12		TO						1																
		A	M3-1	24	12		NORTH						1																
		A	M1-1	24	24		INTERSTATE 89						1																
		A	M6-1	21	15		<--- LEFT						1																
		A	M3-1	24	12		NORTH						1																
		A	M1-5A	24	24		ROUTE 100B						1																
		A	M6-3	21	15		^UP ARROW						1																
		A	M4-5	24	12		TO						1																
		A	M3-3	24	12		SOUTH						1																
		A	M1-1	24	24		INTERSTATE 89						1																
		A	M6-3	21	15		^UP ARROW						1																
		A	M3-1	24	12			2.00																	3B	GREEN ON WHITE SHEETING INSTALL SIGNS ON EXISTING ROUND POSTS	X	7	
							SHEET TOTALS	2.00	0.00	0	0	0	14	0	0	0	0											
								SF	SF	EA	EA	EA	EA	EA	EA	EA	FT											
							TOWN TOTALS	228.6	0.0	22.0	0.0	0.0	60	0.0	0.0	27	405.0											

SIGN SUMMARY SHEET

VERMONT AGENCY OF TRANSPORTATION

PROJECT NAME: **Mortown-Newport Town VT100**
PROJECT NUMBER: **STPG SIGN(28)**

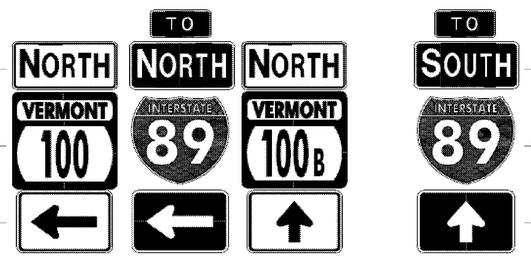FILE NAME: **Moretown.xls** PLOT DATE: **9/16/2009**
PROJECT MANAGER: **N. Avery** DRAWN BY: **I. Shea**
DESIGNED BY: **D. Crossley** CHECKED BY: **J. Kelly**
MORETOWN SHEET 3 SHEET **11** OF **166**

DIRECTION	MILEPOINT	LOCATION CODE (SHEET 2)	SIGN CODE	WIDTH (IN)	HEIGHT (IN)	SHEETING REMARKS	SIGN LEGEND	NEW SIGNS "A"	NEW SIGNS "B"	EXISTING SIGNS RETAIN	EXISTING SIGNS SALVAGE FROM	EXISTING SIGNS SALVAGE TO	EXISTING SIGNS REMOVE	EXIST POST RETAIN	EXIST POST REMOVE	NUMBER OF NEW POSTS	SQUARE STEEL (IN) 1.75 (LB / FT) 1.88	SQUARE STEEL (IN) 2.00 (LB / FT) 2.42	SQUARE STEEL (IN) 2.50 (LB / FT) 3.35	TUBULAR STEEL Ø (IN) FOUNDATION	TUBULAR STEEL Ø (IN) 3.00 (LB / FT) 7.60	TUBULAR STEEL Ø (IN) 3.50 (LB / FT) 9.00	TUBULAR STEEL Ø (IN) 4.00 (LB / FT) 10.80	TUBULAR STEEL Ø (IN) 5.00 (LB / FT) 14.60	SIGN FRAME REQUIRED	REMARKS	SIGN DETAIL: DETAIL IN SHS	SIGN DETAIL: DETAIL ON SHEET NUMBER	SIGN DETAIL: DETAIL ON STD SHEET NUMBER
MORETOWN VT 100							FY-FLUORESCENT YELLOW FYG-FLUORESCENT YELLOW GREEN																			"SHS"-STANDARD HIGHWAY SIGNS			
		A	M1-5	30	24			5.00																				E-136B
		A	M6-1L	21	15			2.19																		GREEN ON WHITE SHEETING	X		
		A	M4-5	24	12			2.00																		WHITE ON BLUE SHEETING	X		
		A	M3-1	24	12			2.00																		WHITE ON BLUE SHEETING	X		
		A	M1-1	24	24			4.00																			X		
		A	M6-1L	21	15			2.19																		WHITE ON BLUE SHEETING	X		
		A	M3-1	24	12			2.00																		GREEN ON WHITE SHEETING	X		
		A	M1-5	30	24			5.00																				E-136B
		A	M6-3	21	15			2.19																		GREEN ON WHITE SHEETING	X		
		A	M4-5	24	12			2.00								3 ~~1~~		X						WHITE ON BLUE SHEETING. INSTALL BESIDE ASSEMBLY AS SHOWN.	X		
		A	M3-3	24	12			2.00																		WHITE ON BLUE SHEETING	X		
		A	M1-1	24	24			4.00																			X		
		A	M6-1L	21	15			2.19																		WHITE ON BLUE SHEETING	X		
NB	0.450	C	W1-7	48	24								1		X														
		C	W1-7	48	24			8.00								2		X											
							SHEET TOTALS	44.76 SF	0.00 SF	0 EA	0 EA	0 EA	1 EA	0 EA	0 EA	3 EA		45 FT										
							TOWN TOTALS	228.6	0.0	22.0	0.0	0.0	60	0.0	0.0	27		405.0										

SIGN SUMMARY SHEET

VERMONT AGENCY OF TRANSPORTATION

PROJECT NAME: **Mortown-Newport Town VT100**
PROJECT NUMBER: **STPG SIGN(28)**

FILE NAME: **Moretown.xls** PLOT DATE: **9/16/2009**
PROJECT MANAGER: **N. Avery** DRAWN BY: **I. Shea**
DESIGNED BY: **D. Crossley** CHECKED BY: **J. Kelly**
MORETOWN SHEET 4 SHEET **12** OF **166**

DIRECTION	MILEPOINT	LOCATION CODE (SHEET 2)	SIGN CODE	WIDTH (IN)	HEIGHT (IN)	SHEETING REMARKS	SIGN LEGEND	NEW SIGNS "A"	NEW SIGNS "B"	EXISTING SIGNS RETAIN	EXISTING SIGNS SALVAGE FROM	EXISTING SIGNS SALVAGE TO	EXISTING SIGNS REMOVE	EXIST POST RETAIN	EXIST POST REMOVE	NUMBER OF NEW POSTS	SQUARE STEEL (IN) 1.75 (LB / FT) 1.88	SQUARE STEEL (IN) 2.00 (LB / FT) 2.42	SQUARE STEEL (IN) 2.50 (LB / FT) 3.35	TUBULAR STEEL Ø (IN) FOUNDATION	TUBULAR STEEL Ø (IN) 3.00 (LB / FT) 7.60	TUBULAR STEEL Ø (IN) 3.50 (LB / FT) 9.00	TUBULAR STEEL Ø (IN) 4.00 (LB / FT) 10.80	TUBULAR STEEL Ø (IN) 5.00 (LB / FT) 14.60	SIGN FRAME REQUIRED	REMARKS	SIGN DETAIL: DETAIL IN SHS	SIGN DETAIL: DETAIL ON SHEET NUMBER	SIGN DETAIL: DETAIL ON STD SHEET NUMBER
MORETOWN VT 100							FY-FLUORESCENT YELLOW FYG-FLUORESCENT YELLOW GREEN																			"SHS"-STANDARD HIGHWAY SIGNS			
NB	0.466	B	R1-1	30	30		STOP			1				X														
NB	0.510	A	M3-1	24	12			2.00								1		X							GREEN ON WHITE SHEETING INSTALL 150'+/- SOUTH OF EXISTING 40 MPH SPEED LIMIT	X		
		A	M1-5	24	30			5.00																				E-136B
NB	0.530	A	R2-1	24	30								2 ~~1~~		X														
		A	R2-1	30	36			7.50								1		X									6	
NB	0.610	B	W3-1	36	36		STOP AHEAD						1		X													
NB	0.650	A	W11-3A	30	30		DEER CROSSING 						1		X													
		A	W11-3	30	30			6.25								1		X									X	
NB	0.840	A	R2-1	24	30								1		X													
		A	R2-1	24	30			5.00								1		X									X	
NB	0.980	A	W11-7	30	30		EQUESTRIAN SYMBOL						1		X													
NB	1.059	A	W1-4MR	30	30		MODIFIED RIGHT REVERSE CURVE						1		X													
		A	W13-1	18	18		30 MPH PLAQUE 						1															
		A	W11-7	30	30			6.25								1		X									X	
							MORETOWN ENDS AT MILEPOINT 1.15 RESUMES AFTER GOING THROUGH DUXBURY																					
							SHEET TOTALS	32.00 SF	0.00 SF	1 EA	0 EA	0 EA	7 EA	0 EA	0 EA	5 EA	75 FT										
							TOWN TOTALS	228.6	0.0	22.0	0.0	0.0	60	0.0	0.0	27	405.0										

SIGN SUMMARY SHEET

VERMONT AGENCY OF TRANSPORTATION

PROJECT NAME: **Mortown-Newport Town VT100**
PROJECT NUMBER: **STPG SIGN(28)**

FILE NAME: **Moretown.xls** PLOT DATE: **9/16/2009**
PROJECT MANAGER: **N. Avery** DRAWN BY: **I. Shea**
DESIGNED BY: **D. Crossley** CHECKED BY: **J. Kelly**
MORETOWN SHEET 5

DIRECTION	MILEPOINT	LOCATION CODE (SHEET 2)	SIGN CODE	WIDTH (IN)	HEIGHT (IN)	SHEETING REMARKS	SIGN LEGEND	NEW SIGNS		EXISTING SIGNS				EXIST POST		NUMBER OF NEW POSTS	SQUARE STEEL (IN)			TUBULAR STEEL Ø (IN)					SIGN FRAME REQUIRED	REMARKS	SIGN DETAIL		
								"A"	"B"	RETAIN	SALVAGE FROM	SALVAGE TO	REMOVE	RETAIN	REMOVE		1.75 (LB / FT)	2.00 (LB / FT)	2.50 (LB / FT)	FOUNDATION	3.00 (LB / FT)	3.50 (LB / FT)	4.00 (LB / FT)	5.00 (LB / FT)			DETAIL IN SHS	DETAIL ON SHEET NUMBER	DETAIL ON STD SHEET NUMBER
																	1.88	2.42	3.35		7.60	9.00	10.80	14.60					
MORETOWN VT 100							FY-FLUORESCENT YELLOW FYG-FLUORESCENT YELLOW GREEN																			"SHS"-STANDARD HIGHWAY SIGNS			
NB	1.220	A	R10-7	24	30		DO NOT BLOCK INTERSECTION			1				X															
NB	1.223	C	VR-017	24	30		LEGAL LOAD LIMIT 24000			1				X												COBB HILL RD TH 6			
NB	1.231	D	R1-1	30	30		STOP			1				X												COBB HILL RD TH 6			
NB	1.208	A	M3-4	24	12		WEST			1				X															
		A	M1-4	24	24		US2			1																			
		A	M3-1S	24	12		NORTH			1																			
		A	M1-5	30	24		VERMONT 100			1																			
		A	M6-1S	21	15		LEFT			1																			
		A	M3-2	24	12		EAST			1																			
		A	M1-4	24	24		US 2			1																			
		A	M6-1	21	15		RIGHT			1																			
		A	M4-5I	24	12		TO			1																			
		A	M1-1	24	24		I-89			1																			
		A	M6-1I	21	15		LEFT			1																			
SIGN SUMMARY SHEET							SHEET TOTALS	0.00	0.00	15	0	0	0	0	0	0	0												
								SF	SF	EA	EA	EA	EA	EA	EA	EA	FT												
VERMONT AGENCY OF TRANSPORTATION							TOWN TOTALS	228.6	0.0	22.0	0.0	0.0	60	0.0	0.0	27	405.0												


PROJECT NAME: **Mortown-Newport Town VT100**
PROJECT NUMBER: **STPG SIGN(28)**

FILE NAME: **Moretown.xls** PLOT DATE: **9/16/2009**
PROJECT MANAGER: **N. Avery** DRAWN BY: **I. Shea**
DESIGNED BY: **D. Crossley** CHECKED BY: **J. Kelly**
MORETOWN SHEET 6 SHEET **14** OF **166**

DIRECTION	MILEPOINT	LOCATION CODE (SHEET 2)	SIGN CODE	WIDTH (IN)	HEIGHT (IN)	SHEETING REMARKS	SIGN LEGEND	NEW SIGNS "A"	NEW SIGNS "B"	EXISTING SIGNS RETAIN	EXISTING SIGNS SALVAGE FROM	EXISTING SIGNS SALVAGE TO	EXISTING SIGNS REMOVE	EXIST POST RETAIN	EXIST POST REMOVE	NUMBER OF NEW POSTS	SQUARE STEEL (IN) 1.75 (LB / FT) 1.88	SQUARE STEEL (IN) 2.00 (LB / FT) 2.42	SQUARE STEEL (IN) 2.50 (LB / FT) 3.35	TUBULAR STEEL Ø (IN) FOUNDATION	TUBULAR STEEL Ø (IN) 3.00 (LB / FT) 7.60	TUBULAR STEEL Ø (IN) 3.50 (LB / FT) 9.00	TUBULAR STEEL Ø (IN) 4.00 (LB / FT) 10.80	TUBULAR STEEL Ø (IN) 5.00 (LB / FT) 14.60	SIGN FRAME REQUIRED	REMARKS	SIGN DETAIL: DETAIL IN SHS	SIGN DETAIL: DETAIL ON SHEET NUMBER	SIGN DETAIL: DETAIL ON STD SHEET NUMBER
MORETOWN VT 100							FY-FLUORESCENT YELLOW FYG-FLUORESCENT YELLOW GREEN																			"SHS"-STANDARD HIGHWAY SIGNS			
SB	1.211	F	M3-3S	24	12								1		X														
		F	M1-5	30	24								1																
		F	M3-3	24	12			2.00								1		X							GREEN ON WHITE SHEETING	X		
		F	M1-5	30	24			5.00																					E-136B
SB	1.180	F	R2-1	24	30		SPEED LIMIT 35			1				X															
SB	1.158	F	W1-4L	30	30		LEFT REVERSE CURVE						1		X														
			MORETOWN ENDS AT MILEPOINT 1.15 RESUMES AFTER GOING THROUGH DUXBURY																										
SB	0.950	F	W11-3A	30	30		DEER CROSSING 						1		X														
		F	W11-3	30	30			6.25								1		X										X	
SB	0.880	F	R2-1	24	30								1		X														
		F	R2-1	24	30			5.00								1		X										X	
SB	0.640	F	VD-062A	72	16		BUSINESS SIGN			1				X															
SB	0.610	F	W3-1	30	30		STOP AHEAD			1				X															
SB	0.560	F	M2-1	21	15								1		X														
		F	M1-5A	24	24								1																
SIGN SUMMARY SHEET							SHEET TOTALS	18.25	0.00	3	0	0	7	0	0	3		45									
								SF	SF	EA	EA	EA	EA	EA	EA	EA		FT									
VERMONT AGENCY OF TRANSPORTATION							TOWN TOTALS	228.6	0.0	22.0	0.0	0.0	60	0.0	0.0	27		405.0									

PROJECT NAME: **Mortown-Newport Town VT100**
PROJECT NUMBER: **STPG SIGN(28)**

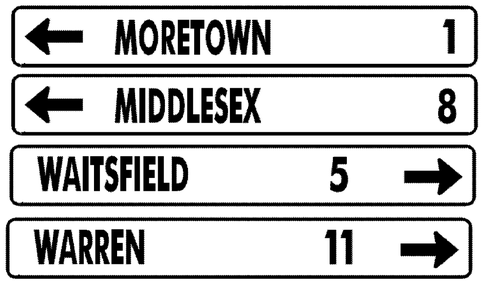FILE NAME: **Moretown.xls** PLOT DATE: **9/16/2009**
PROJECT MANAGER: **N. Avery** DRAWN BY: **I. Shea**
DESIGNED BY: **D. Crossley** CHECKED BY: **J. Kelly**
MORETOWN SHEET 7 SHEET **15** OF **166**


DIRECTION	MILEPOINT	LOCATION CODE (SHEET 2)	SIGN CODE	WIDTH (IN)	HEIGHT (IN)	SHEETING REMARKS	SIGN LEGEND	NEW SIGNS "A"	NEW SIGNS "B"	EXISTING SIGNS RETAIN	EXISTING SIGNS SALVAGE FROM	EXISTING SIGNS SALVAGE TO	EXISTING SIGNS REMOVE	EXIST POST RETAIN	EXIST POST REMOVE	NUMBER OF NEW POSTS	SQUARE STEEL (IN) 1.75 (LB / FT) 1.88	SQUARE STEEL (IN) 2.00 (LB / FT) 2.42	SQUARE STEEL (IN) 2.50 (LB / FT) 3.35	TUBULAR STEEL Ø (IN) FOUNDATION	TUBULAR STEEL Ø (IN) 3.00 (LB / FT) 7.60	TUBULAR STEEL Ø (IN) 3.50 (LB / FT) 9.00	TUBULAR STEEL Ø (IN) 4.00 (LB / FT) 10.80	TUBULAR STEEL Ø (IN) 5.00 (LB / FT) 14.60	SIGN FRAME REQUIRED	REMARKS	SIGN DETAIL: DETAIL IN SHS	SIGN DETAIL: DETAIL ON SHEET NUMBER	SIGN DETAIL: DETAIL ON STD SHEET NUMBER
MORETOWN VT 100							FY-FLUORESCENT YELLOW FYG-FLUORESCENT YELLOW GREEN																			"SHS"-STANDARD HIGHWAY SIGNS			
		F	M2-1	21	15			2.19								1		X							GREEN ON WHITE SHEETING	X		
		F	M1-5	30	24			5.00																					E-136B
SB	0.530	F	D2-1	72	10								1		X														
		F	D2-1	72	10								1																
		F	D2-1	72	10								1																
		F	D2-1	72	10								1																
		F	D1-1A	72	12			6.00								2			X								5
		F	D1-1A	72	12			6.00																					5
		F	D1-1A	72	12			6.00																					5
		F	D1-1A	72	12			6.00																					5
SB	0.490	F	M3-1	24	12								1	~~X~~		2			X									
		F	M1-5	30	24								1																
		F	M6-1	21	15								1																
		F	M3-3	24	12								1																
		F	M1-5	30	24								1																
							SHEET TOTALS	31.19	0.00	0	0	0	9	0	0	3		45										
								SF	SF	EA	EA	EA	EA	EA	EA	EA		FT										
							TOWN TOTALS	228.6	0.0	22.0	0.0	0.0	60	0.0	0.0	27		405.0										

SIGN SUMMARY SHEET

VERMONT AGENCY OF TRANSPORTATION

PROJECT NAME: Mortown-Newport Town VT100
PROJECT NUMBER: STPG SIGN(28)

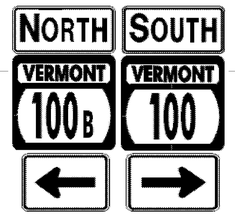FILE NAME: Moretown.xls
PROJECT MANAGER: N. Avery
DESIGNED BY: D. Crossley
PLOT DATE: 9/16/2009
DRAWN BY: I. Shea
CHECKED BY: J. Kelly
MORETOWN SHEET 8

DIRECTION	MILEPOINT	LOCATION CODE (SHEET 2)	SIGN CODE	WIDTH (IN)	HEIGHT (IN)	SHEETING REMARKS	SIGN LEGEND	NEW SIGNS "A"	NEW SIGNS "B"	EXISTING SIGNS RETAIN	EXISTING SIGNS SALVAGE FROM	EXISTING SIGNS SALVAGE TO	EXISTING SIGNS REMOVE	EXIST POST RETAIN	EXIST POST REMOVE	NUMBER OF NEW POSTS	SQUARE STEEL (IN) 1.75 (LB / FT) 1.88	SQUARE STEEL (IN) 2.00 (LB / FT) 2.42	SQUARE STEEL (IN) 2.50 (LB / FT) 3.35	TUBULAR STEEL Ø (IN) FOUNDATION	TUBULAR STEEL Ø (IN) 3.00 (LB / FT) 7.60	TUBULAR STEEL Ø (IN) 3.50 (LB / FT) 9.00	TUBULAR STEEL Ø (IN) 4.00 (LB / FT) 10.80	TUBULAR STEEL Ø (IN) 5.00 (LB / FT) 14.60	SIGN FRAME REQUIRED	REMARKS	SIGN DETAIL: DETAIL IN SHS	SIGN DETAIL: DETAIL ON SHEET NUMBER	SIGN DETAIL: DETAIL ON STD SHEET NUMBER
MORETOWN VT 100							FY-FLUORESCENT YELLOW FYG-FLUORESCENT YELLOW GREEN																			"SHS"-STANDARD HIGHWAY SIGNS			
		F	M6-1	21	15								1															
		F	M3-1	24	12			2.00																	1B	GREEN ON WHITE SHEETING	X		
		F	M1-5	30	24			5.00																				E-136B
		F	M6-1L	21	15			2.19																		GREEN ON WHITE SHEETING	X		
		F	M3-3	24	12			2.00																	GREEN ON WHITE SHEETING	X		
		F	M1-5	30	24			5.00																				E-136B
		F	M6-1R	21	15			2.19																		GREEN ON WHITE SHEETING	X		
SB	0.460	F	R1-1	30	30		STOP			1				X														
SB	0.440	F	M3-3	24	12								1		X													
		F	M1-5	24	24								1															
		F	M3-3	24	12			2.00								1		X							GREEN ON WHITE SHEETING	X		
		F	M1-5	30	24			5.00																				E-136B
SB	0.400	F	D1-1A	72	10								1		X													
		F	D1-1A	72	10								1															
		F	D2-1	72	12			6.00								2		X										5
SIGN SUMMARY SHEET							SHEET TOTALS	31.38	0.00	1	0	0	5	0	0	3		45									
								SF	SF	EA	EA	EA	EA	EA	EA	EA		FT									
VERMONT AGENCY OF TRANSPORTATION							TOWN TOTALS	228.6	0.0	22.0	0.0	0.0	60	0.0	0.0	27		405.0									

PROJECT NAME: **Mortown-Newport Town VT100**
PROJECT NUMBER: **STPG SIGN(28)**
FILE NAME: **Moretown.xls**
PROJECT MANAGER: **N. Avery**
DESIGNED BY: **D. Crossley**
MORETOWN SHEET 9
PLOT DATE: **9/16/2009**
DRAWN BY: **I. Shea**
CHECKED BY: **J. Kelly**
SHEET **17** OF **166**

DIRECTION	MILEPOINT	LOCATION CODE (SHEET 2)	SIGN CODE	WIDTH (IN)	HEIGHT (IN)	SHEETING REMARKS	SIGN LEGEND	NEW SIGNS "A"	NEW SIGNS "B"	EXISTING SIGNS RETAIN	EXISTING SIGNS SALVAGE FROM	EXISTING SIGNS SALVAGE TO	EXISTING SIGNS REMOVE	EXIST POST RETAIN	EXIST POST REMOVE	NUMBER OF NEW POSTS	SQUARE STEEL (IN) 1.75 (LB/FT) 1.88	SQUARE STEEL (IN) 2.00 (LB/FT) 2.42	SQUARE STEEL (IN) 2.50 (LB/FT) 3.35	TUBULAR STEEL Ø (IN) FOUNDATION	TUBULAR STEEL Ø (IN) 3.00 (LB/FT) 7.60	TUBULAR STEEL Ø (IN) 3.50 (LB/FT) 9.00	TUBULAR STEEL Ø (IN) 4.00 (LB/FT) 10.80	TUBULAR STEEL Ø (IN) 5.00 (LB/FT) 14.60	SIGN FRAME REQUIRED	REMARKS	SIGN DETAIL: DETAIL IN SHS	SIGN DETAIL: DETAIL ON SHEET NUMBER	SIGN DETAIL: DETAIL ON STD SHEET NUMBER
MORETOWN VT 100							FY-FLUORESCENT YELLOW FYG-FLUORESCENT YELLOW GREEN																			"SHS"-STANDARD HIGHWAY SIGNS			
		F	D2-1	72	12		WAITSFIELD 5 WARREN 11	6.00																				5
SB	0.360	F	R2-1	24	30								1		X													
		F	R2-1	24	30		SPEED LIMIT 50	5.00								1		X									X	
SB	0.080	F	W11-6H	30	30		HINGED SNOWMOBILE SYMBOL						1		X													

DIRECTION	MILEPOINT	LOCATION CODE (SHEET 2)	SIGN CODE	WIDTH (IN)	HEIGHT (IN)	SHEETING REMARKS	SIGN LEGEND	NEW SIGNS "A"	NEW SIGNS "B"	EXISTING SIGNS RETAIN	EXISTING SIGNS SALVAGE FROM	EXISTING SIGNS SALVAGE TO	EXISTING SIGNS REMOVE	EXIST POST RETAIN	EXIST POST REMOVE	NUMBER OF NEW POSTS	SQUARE STEEL (IN) 1.75 (LB / FT) 1.88	SQUARE STEEL (IN) 2.00 (LB / FT) 2.42	SQUARE STEEL (IN) 2.50 (LB / FT) 3.35	TUBULAR STEEL Ø (IN) FOUNDATION	TUBULAR STEEL Ø (IN) 3.00 (LB / FT) 7.60	TUBULAR STEEL Ø (IN) 3.50 (LB / FT) 9.00	TUBULAR STEEL Ø (IN) 4.00 (LB / FT) 10.80	TUBULAR STEEL Ø (IN) 5.00 (LB / FT) 14.60	SIGN FRAME REQUIRED	REMARKS	SIGN DETAIL: DETAIL IN SHS	SIGN DETAIL: DETAIL ON SHEET NUMBER	SIGN DETAIL: DETAIL ON STD SHEET NUMBER
DUXBURY VT 100							FY-FLUORESCENT YELLOW FYG-FLUORESCENT YELLOW GREEN																			"SHS"-STANDARD HIGHWAY SIGNS			
NB	0.000	C	VD-024	60	7.5								1		X														
		C	VD-024	72	10		DUXBURY / MORETOWN	5.00								2		X											4
		C	VD-700	6	10		1000 1206 0000 / 1000 1212 0115	0.42																				
		C	VD-700	6	10			0.42																				
NB	0.010	A	S3-1	30	30		SCHOOL BUS STOP AHEAD						1		X														
		A	W1-4R	30	30		30 M.P.H.	6.25								1		X										X
		A	W13-1	18	18		SCHOOL BUS STOP AHEAD	~~2.25~~		I				I														X
NB	0.050	A	S3-1	30	30			6.25								1		X									INSTALL 200' +/- NORTH OF ORIGINAL SIGN LOCATION		X	
NB	0.218	C	VR-017	24	30		LEGAL LOAD LIMIT 24,000 LBS			1				X													DELONG RD TH 15			
NB	0.224	D	R1-1	30	30		STOP			1				X													DELONG RD TH 15			
NB	0.320	A	S1-1	36	36	FYG	SCHOOL			1				X																
		A	W16-9	36	24	FYG	AHEAD			1																				
NB	0.360	A	S4-3	24	8	FYG	SCHOOL			1				X																
		A	R2-1	24	30		SPEED LIMIT 35			1																				
		A	S4-2	24	10		WHEN CHILDREN ARE PRESENT			1																				
SIGN SUMMARY SHEET							SHEET TOTALS	20.59	0.00	7	0	0	2	0	0	4		60										
								SF	SF	EA	EA	EA	EA	EA	EA	EA		FT										
VERMONT AGENCY OF TRANSPORTATION							TOWN TOTALS	345.2	0.0	68.0	1.0	1.0	65	0.0	0.0	62		930.0										

PROJECT NAME: **Moretown-Newport Town VT100**
PROJECT NUMBER: **STPG SIGN(28)**
FILE NAME: **Duxburv.xls** PLOT DATE: **9/16/2009**
PROJECT MANAGER: **N. Averv** DRAWN BY: **I. Shea**
DESIGNED BY: **D. Crossley** CHECKED BY: **J. Kelly**
DUXBURY SHEET 1 SHEET **19** OF **166**

DIRECTION	MILEPOINT	LOCATION CODE (SHEET 2)	SIGN CODE	WIDTH (IN)	HEIGHT (IN)	SHEETING REMARKS	SIGN LEGEND	NEW SIGNS "A"	NEW SIGNS "B"	EXISTING SIGNS RETAIN	EXISTING SIGNS SALVAGE FROM	EXISTING SIGNS SALVAGE TO	EXISTING SIGNS REMOVE	EXIST POST RETAIN	EXIST POST REMOVE	NUMBER OF NEW POSTS	SQUARE STEEL (IN) 1.75 (LB/FT) 1.88	SQUARE STEEL (IN) 2.00 (LB/FT) 2.42	SQUARE STEEL (IN) 2.50 (LB/FT) 3.35	TUBULAR STEEL Ø (IN) FOUNDATION	TUBULAR STEEL Ø (IN) 3.00 (LB/FT) 7.60	TUBULAR STEEL Ø (IN) 3.50 (LB/FT) 9.00	TUBULAR STEEL Ø (IN) 4.00 (LB/FT) 10.80	TUBULAR STEEL Ø (IN) 5.00 (LB/FT) 14.60	SIGN FRAME REQUIRED	REMARKS	SIGN DETAIL: DETAIL IN SHS	SIGN DETAIL: DETAIL ON SHEET NUMBER	SIGN DETAIL: DETAIL ON STD SHEET NUMBER
DUXBURY VT 100							FY-FLUORESCENT YELLOW FYG-FLUORESCENT YELLOW GREEN																			"SHS"-STANDARD HIGHWAY SIGNS			
NB	0.432	A	D1-1E	72	20								1		X													
		A	D1-2R	72	20		HARWOOD UNION HIGH SCHOOL →	10.00								2		X										5
		A	S4-3	24	8	FYG	SCHOOL			1					X													
		A	R2-1	24	30		SPEED LIMIT 35						1															
		A	S4-2	24	10		WHEN CHILDREN ARE PRESENT			1																		
		A	R2-1	24	30		SPEED LIMIT 35	5.00																			X	
NB	0.500	A	S1-1	36	36	FYG	SCHOOL			1				X														
		A	W16-7	30	18	FYG	DIAGONAL ARROW			1																		
NB	0.510	D	R1-1	30	30		STOP			1				X														
NB	0.527	A	S4-3YG	24	8		SCHOOL			1					X													
		A	R2-1	24	30								1															
		A	S4-2	24	10		SPEED LIMIT 35						1															
		A	R2-1	24	30			5.00								1		X									X	
		A	S4-2	24	10		WHEN CHILDREN ARE PRESENT	1.67																			X	
NB	0.570	A	W11-3	30	30		DEER CROSSING						1		X													
							SHEET TOTALS	21.67	0.00	6	0	0	5	0	0	3		45										
								SF	SF	EA	EA	EA	EA	EA	EA	EA		FT										
							TOWN TOTALS	345.2	0.0	68.0	1.0	1.0	65	0.0	0.0	62		930.0										

SIGN SUMMARY SHEET

VERMONT AGENCY OF TRANSPORTATION

PROJECT NAME: **Moretown-Newport Town VT100**
PROJECT NUMBER: **STPG SIGN(28)**

FILE NAME: **Duxburv.xls** PLOT DATE: **9/16/2009**
PROJECT MANAGER: **N. Averv** DRAWN BY: **I. Shea**
DESIGNED BY: **D. Crossley** CHECKED BY: **J. Kelly**
DUXBURY SHEET 2 SHEET **20** OF **166**

DIRECTION	MILEPOINT	LOCATION CODE (SHEET 2)	SIGN CODE	WIDTH (IN)	HEIGHT (IN)	SHEETING REMARKS	SIGN LEGEND	NEW SIGNS "A"	NEW SIGNS "B"	EXISTING SIGNS RETAIN	EXISTING SIGNS SALVAGE FROM	EXISTING SIGNS SALVAGE TO	EXISTING SIGNS REMOVE	EXIST POST RETAIN	EXIST POST REMOVE	NUMBER OF NEW POSTS	SQUARE STEEL (IN) 1.75 (LB / FT) 1.88	SQUARE STEEL (IN) 2.00 (LB / FT) 2.42	SQUARE STEEL (IN) 2.50 (LB / FT) 3.35	TUBULAR STEEL Ø (IN) FOUNDATION	TUBULAR STEEL Ø (IN) 3.00 (LB / FT) 7.60	TUBULAR STEEL Ø (IN) 3.50 (LB / FT) 9.00	TUBULAR STEEL Ø (IN) 4.00 (LB / FT) 10.80	TUBULAR STEEL Ø (IN) 5.00 (LB / FT) 14.60	SIGN FRAME REQUIRED	REMARKS	SIGN DETAIL: DETAIL IN SHS	SIGN DETAIL: DETAIL ON SHEET NUMBER	SIGN DETAIL: DETAIL ON STD SHEET NUMBER
DUXBURY VT 100							FY-FLUORESCENT YELLOW FYG-FLUORESCENT YELLOW GREEN																			"SHS"-STANDARD HIGHWAY SIGNS			
		A	W11-3	30	30			6.25								1		X										
NB	0.620	A	R2-1	24	30			5.00								1		X								INSTALL OPPOSITE SCHOOL 35 MPH SIGN	X		
NB	0.810	A	R2-1	24	30		SPEED LIMIT 50			1				X														
NB	0.895	A	VW-000	30	30		MOOSE CROSSING			1				X														
		A	W7-3A	24	18		NEXT 4 MILES			1																		
NB	2.581	C	VR-017	24	24		LEGAL LOAD LIMIT 24,000 LBS			1				X												WILDER RD TH-29			
NB	2.588	D	R1-1	24	24		STOP			1				X												WILDER RD TH-29			
NB	2.765	A	S3-1	30	30								1		X														
		A	S3-1	30	30			6.25								1		X									X	
NB	3.150	A	S3-1	30	30								1		X														
		A	S3-1	30	30			6.25								1		X									X	
NB	3.258	C	VR-017	24	24		LEGAL LOAD LIMIT 24,000 LBS			1				X												STEVENS BROOK RD TH-27			
NB	3.260	D	R1-1	24	24		STOP			1				X												STEVENS BROOK RD TH-27			
NB	4.390	A	VW-054L	30	30		HIDDEN DRIVE LEFT						1		X														
NB	4.817	C	VR-017	24	24		LEGAL LOAD LIMIT 24,000 LBS			1				X												ATWOOD RD TH-25			
							SHEET TOTALS	23.75	0.00	8	0	0	3	0	0	4	60											
								SF	SF	EA	EA	EA	EA	EA	EA	EA	FT											
							TOWN TOTALS	345.2	0.0	68.0	1.0	1.0	65	0.0	0.0	62	930.0											

SIGN SUMMARY SHEET

VERMONT AGENCY OF TRANSPORTATION

PROJECT NAME: **Moretown-Newport Town VT100**
PROJECT NUMBER: **STPG SIGN(28)**

FILE NAME: **Duxburv.xls** PLOT DATE: **9/16/2009**
PROJECT MANAGER: **N. Averv** DRAWN BY: **I. Shea**
DESIGNED BY: **D. Crossley** CHECKED BY: **J. Kelly**

DIRECTION	MILEPOINT	LOCATION CODE (SHEET 2)	SIGN CODE	WIDTH (IN)	HEIGHT (IN)	SHEETING REMARKS	SIGN LEGEND	NEW SIGNS "A"	NEW SIGNS "B"	EXISTING SIGNS RETAIN	EXISTING SIGNS SALVAGE FROM	EXISTING SIGNS SALVAGE TO	EXISTING SIGNS REMOVE	EXIST POST RETAIN	EXIST POST REMOVE	NUMBER OF NEW POSTS	SQUARE STEEL (IN) 1.75 (LB / FT) 1.88	SQUARE STEEL (IN) 2.00 (LB / FT) 2.42	SQUARE STEEL (IN) 2.50 (LB / FT) 3.35	TUBULAR STEEL Ø (IN) FOUNDATION	TUBULAR STEEL Ø (IN) 3.00 (LB / FT) 7.60	TUBULAR STEEL Ø (IN) 3.50 (LB / FT) 9.00	TUBULAR STEEL Ø (IN) 4.00 (LB / FT) 10.80	TUBULAR STEEL Ø (IN) 5.00 (LB / FT) 14.60	SIGN FRAME REQUIRED	REMARKS	SIGN DETAIL: DETAIL IN SHS	SIGN DETAIL: DETAIL ON SHEET NUMBER	SIGN DETAIL: DETAIL ON STD SHEET NUMBER
DUXBURY VT 100							FY-FLUORESCENT YELLOW FYG-FLUORESCENT YELLOW GREEN																			"SHS"-STANDARD HIGHWAY SIGNS			
NB	4.815	D	R1-1	24	24		STOP			1				X												ATWOOD RD TH-25			
NB	5.060	C	VM-607	24	30		43RD INF DIV MEMORIAL HIGHWAY			1				X															
NB	5.060	C	VR-278	24	30		PROHIBITED DUMPING GARBAGE …						1		X														
NB	5.085	A	W3-5	36	36		SPEED REDUCTION 40 MPH			1				X															
NB	5.200	A	VW-054R	30	30								1		X														
		A	VW-054R	30	30			6.25								1		X									X	
NB	5.232	A	R2-1	24	30								1		X														
		A	R2-1	30	36			7.50								1		X										6
NB	5.390	A	R2-1	24	30								1		X														
		A	R2-1	24	30			5.00								1		X									X	
NB	5.510	A	S1-1	36	36								1		X														
		A	W16-9	36	20								1																
		A	S1-1	36	36	F-Y-G		9.00								2		X									X	
		A	W16-9	36	20	F-Y-G		5.00																			X	
NB	5.549	A	S4-3YG	24	8		SCHOOL			1					X	1			X							REPLACE POST ONLY RETAIN EXISTING FLASHING BEACON			
							SHEET TOTALS	32.75	0.00	4	0	0	6	0	0	6		90									
								SF	SF	EA	EA	EA	EA	EA	EA	EA		FT									
							TOWN TOTALS	345.2	0.0	68.0	1.0	1.0	65	0.0	0.0	62		930.0									

SIGN SUMMARY SHEET

VERMONT AGENCY OF TRANSPORTATION

PROJECT NAME: **Moretown-Newport Town VT100**
PROJECT NUMBER: **STPG SIGN(28)**

FILE NAME: **Duxburv.xls** PLOT DATE: **9/16/2009**
PROJECT MANAGER: **N. Averv** DRAWN BY: **I. Shea**
DESIGNED BY: **D. Crossley** CHECKED BY: **J. Kelly**
DUXBURY SHEET 4 SHEET **22** OF **166**



DIRECTION	MILEPOINT	LOCATION CODE (SHEET 2)	SIGN CODE	WIDTH (IN)	HEIGHT (IN)	SHEETING REMARKS	SIGN LEGEND	NEW SIGNS "A"	NEW SIGNS "B"	EXISTING SIGNS RETAIN	EXISTING SIGNS SALVAGE FROM	EXISTING SIGNS SALVAGE TO	EXISTING SIGNS REMOVE	EXIST POST RETAIN	EXIST POST REMOVE	NUMBER OF NEW POSTS	SQUARE STEEL (IN) (LB / FT) 1.75 / 1.88	SQUARE STEEL (IN) (LB / FT) 2.00 / 2.42	SQUARE STEEL (IN) (LB / FT) 2.50 / 3.35	TUBULAR STEEL Ø (IN) FOUNDATION	TUBULAR STEEL Ø (IN) (LB / FT) 3.00 / 7.60	TUBULAR STEEL Ø (IN) (LB / FT) 3.50 / 9.00	TUBULAR STEEL Ø (IN) (LB / FT) 4.00 / 10.80	TUBULAR STEEL Ø (IN) (LB / FT) 5.00 / 14.60	SIGN FRAME REQUIRED	REMARKS	SIGN DETAIL: DETAIL IN SHS	SIGN DETAIL: DETAIL ON SHEET NUMBER	SIGN DETAIL: DETAIL ON STD SHEET NUMBER
DUXBURY VT 100							FY-FLUORESCENT YELLOW FYG-FLUORESCENT YELLOW GREEN																			"SHS"-STANDARD HIGHWAY SIGNS			
		A	S4-4	24	10		WHEN FLASHING			1																		
		A	R2-1	24	30		SPEED LIMIT 35			1																		
NB	5.610	A	D1-1E	72	10								1		X													
		A	D1-2 R	72	20		CROSSETT BROOK MIDDLE SCHOOL →	10.00								2		X									5	
NB	5.670	D	R1-1	30	30		STOP			1				X														
NB	5.719	A	R2-1	24	30		SPEED LIMIT 40						1		X													
		A	R2-1	24	30			5.00								1		X									X	
NB	5.760	A	W1-4L	30	30		LEFT REVERSE CURVE						1		X													
NB	5.820	A	W1-4L	30	30			6.25								1		X									INSTALL 300'+/- NORTH OF ORIGINAL SIGN LOCATION	X	
NB	5.871	A	W1-8	18	24								1		X													
		A	W1-8	18	24			3.00								1		X									X	
NB	5.896	A	W1-8	18	24								1		X													
		A	W1-8	18	24			3.00								1		X									X	
NB	5.916	A	W1-8	18	24								1		X													
		A	W1-8	18	24			3.00								1		X									X	
SIGN SUMMARY SHEET							SHEET TOTALS	30.25	0.00	3	0	0	6	0	0	7		105									
								SF	SF	EA	EA	EA	EA	EA	EA	EA		FT									
VERMONT AGENCY OF TRANSPORTATION							TOWN TOTALS	345.2	0.0	68.0	1.0	1.0	65	0.0	0.0	62		930.0									

PROJECT NAME: **Moretown-Newport Town VT100**
PROJECT NUMBER: **STPG SIGN(28)**
FILE NAME: **Duxburv.xls**
PROJECT MANAGER: **N. Averv**
DESIGNED BY: **D. Crossley**
DUXBURY SHEET 5
PLOT DATE: **9/16/2009**
DRAWN BY: **I. Shea**
CHECKED BY: **J. Kelly**
SHEET **23** OF **166**

DIRECTION	MILEPOINT	LOCATION CODE (SHEET 2)	SIGN CODE	WIDTH (IN)	HEIGHT (IN)	SHEETING REMARKS	SIGN LEGEND	NEW SIGNS "A"	NEW SIGNS "B"	EXISTING SIGNS RETAIN	EXISTING SIGNS SALVAGE FROM	EXISTING SIGNS SALVAGE TO	EXISTING SIGNS REMOVE	EXIST POST RETAIN	EXIST POST REMOVE	NUMBER OF NEW POSTS	SQUARE STEEL (IN) 1.75 (LB / FT) 1.88	SQUARE STEEL (IN) 2.00 (LB / FT) 2.42	SQUARE STEEL (IN) 2.50 (LB / FT) 3.35	TUBULAR STEEL Ø (IN) FOUNDATION	TUBULAR STEEL Ø (IN) 3.00 (LB / FT) 7.60	TUBULAR STEEL Ø (IN) 3.50 (LB / FT) 9.00	TUBULAR STEEL Ø (IN) 4.00 (LB / FT) 10.80	TUBULAR STEEL Ø (IN) 5.00 (LB / FT) 14.60	SIGN FRAME REQUIRED	REMARKS	SIGN DETAIL: DETAIL IN SHS	SIGN DETAIL: DETAIL ON SHEET NUMBER	SIGN DETAIL: DETAIL ON STD SHEET NUMBER
DUXBURY VT 100							FY-FLUORESCENT YELLOW FYG-FLUORESCENT YELLOW GREEN																			"SHS"-STANDARD HIGHWAY SIGNS			
NB	5.947	A	W1-8	18	24								1		X														
		A	W1-8	18	24			3.00								1		X									X		
NB	5.981	A	R2-1	24	30								1		X														
		A	R2-1	24	30			5.00								1		X									X		
NB	6.140	A	R2-1	24	30								1		X														
		A	R2-1	30	36			7.50								1		X									X		
NB	6.170	A	W3-1	36	36		STOP AHEAD			1				X															
NB	6.213	A	M2-1	21	15								1		X														
		A	M1-4	24	24								1																
		A	M2-1	21	15			2.19								1		X							BLACK ON WHITE SHEETING	X		
		A	M1-4	24	24			4.00																			X		
NB	6.220	A	D1-1A	72	10								1		X														
		A	D1-1A	72	10								1																
		A	D1-1A	72	10								1																
		A	D1-1A	72	10								1																
SIGN SUMMARY SHEET							SHEET TOTALS	21.69	0.00	1	0	0	9	0	0	4		60										
								SF	SF	EA	EA	EA	EA	EA	EA	EA		FT										
VERMONT AGENCY OF TRANSPORTATION							TOWN TOTALS	345.2	0.0	68.0	1.0	1.0	65	0.0	0.0	62		930.0										





PROJECT NAME: **Moretown-Newport Town VT100**
PROJECT NUMBER: **STPG SIGN(28)**

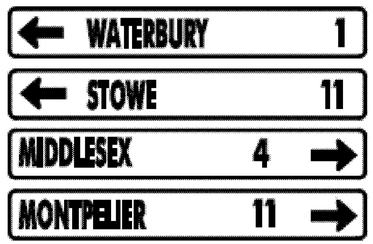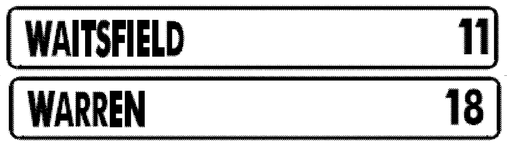FILE NAME: **Duxburv.xls** PLOT DATE: **9/16/2009**
PROJECT MANAGER: **N. Avery** DRAWN BY: **I. Shea**
DESIGNED BY: **D. Crossley** CHECKED BY: **J. Kelly**
DUXBURY SHEET 6 SHEET **24** OF **166**

DIRECTION	MILEPOINT	LOCATION CODE (SHEET 2)	SIGN CODE	WIDTH (IN)	HEIGHT (IN)	SHEETING REMARKS	SIGN LEGEND	NEW SIGNS "A"	NEW SIGNS "B"	EXISTING SIGNS RETAIN	EXISTING SIGNS SALVAGE FROM	EXISTING SIGNS SALVAGE TO	EXISTING SIGNS REMOVE	EXIST POST RETAIN	EXIST POST REMOVE	NUMBER OF NEW POSTS	SQUARE STEEL (IN) 1.75 (LB / FT) 1.88	SQUARE STEEL (IN) 2.00 (LB / FT) 2.42	SQUARE STEEL (IN) 2.50 (LB / FT) 3.35	TUBULAR STEEL Ø (IN) FOUNDATION	TUBULAR STEEL Ø (IN) 3.00 (LB / FT) 7.60	TUBULAR STEEL Ø (IN) 3.50 (LB / FT) 9.00	TUBULAR STEEL Ø (IN) 4.00 (LB / FT) 10.80	TUBULAR STEEL Ø (IN) 5.00 (LB / FT) 14.60	SIGN FRAME REQUIRED	REMARKS	SIGN DETAIL: DETAIL IN SHS	SIGN DETAIL: DETAIL ON SHEET NUMBER	SIGN DETAIL: DETAIL ON STD SHEET NUMBER
DUXBURY VT 100							FY-FLUORESCENT YELLOW FYG-FLUORESCENT YELLOW GREEN																			"SHS"-STANDARD HIGHWAY SIGNS			
		A	D1-1A	72	12			6.00								2			X								5
		A	D1-1A	72	12			6.00																				5
		A	D1-1A	72	12			6.00																				5
		A	D1-1A	72	12			6.00																				5
SB	6.210	F	W1-4L	30	30			6.25								1		X								INSTALL JUST SOUTH OF BRIDGE 194	X		
SB	6.190	F	D2-1	72	10								1		X													
		F	D2-1	72	10								1															
		F	D2-1	72	12			6.00								2		X									5	
		F	D2-1	72	12			6.00																			5	
SB	6.161	G	VR-017	24	24								1		X												RIVER ROAD TH-1			
SB	6.140	G	VR-017	24	30			5.00								1		X										E-141
SB	6.154	H	R1-1	30	30								2 1		X												RIVER ROAD TH-1			
SB	6.144	H	R1-1	30	30			6.25								1		X									X	
SB	6.140	F	R2-1	24	30								1		X															
		F	R2-1	24	30			5.00								1		X									X	
SIGN SUMMARY SHEET							SHEET TOTALS	58.50	0.00	0	0	0	5	0	0	8		120									
								SF	SF	EA	EA	EA	EA	EA	EA	EA		FT									
VERMONT AGENCY OF TRANSPORTATION							TOWN TOTALS	345.2	0.0	68.0	1.0	1.0	65	0.0	0.0	62		930.0									

PROJECT NAME: **Moretown-Newport Town VT100**
PROJECT NUMBER: **STPG SIGN(28)**

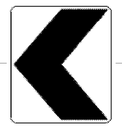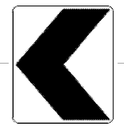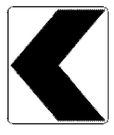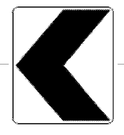FILE NAME: **Duxburv.xls** PLOT DATE: **9/16/2009**
PROJECT MANAGER: **N. Avery** DRAWN BY: **I. Shea**
DESIGNED BY: **D. Crossley** CHECKED BY: **J. Kelly**
DUXBURY SHEET 7 SHEET **25** OF **166**

DIRECTION	MILEPOINT	LOCATION CODE (SHEET 2)	SIGN CODE	WIDTH (IN)	HEIGHT (IN)	SHEETING REMARKS	SIGN LEGEND	NEW SIGNS "A"	NEW SIGNS "B"	EXISTING SIGNS RETAIN	EXISTING SIGNS SALVAGE FROM	EXISTING SIGNS SALVAGE TO	EXISTING SIGNS REMOVE	EXIST POST RETAIN	EXIST POST REMOVE	NUMBER OF NEW POSTS	SQUARE STEEL (IN) 1.75 (LB / FT) 1.88	SQUARE STEEL (IN) 2.00 (LB / FT) 2.42	SQUARE STEEL (IN) 2.50 (LB / FT) 3.35	TUBULAR STEEL Ø (IN) FOUNDATION	TUBULAR STEEL Ø (IN) 3.00 (LB / FT) 7.60	TUBULAR STEEL Ø (IN) 3.50 (LB / FT) 9.00	TUBULAR STEEL Ø (IN) 4.00 (LB / FT) 10.80	TUBULAR STEEL Ø (IN) 5.00 (LB / FT) 14.60	SIGN FRAME REQUIRED	REMARKS	SIGN DETAIL: DETAIL IN SHS	SIGN DETAIL: DETAIL ON SHEET NUMBER	SIGN DETAIL: DETAIL ON STD SHEET NUMBER
DUXBURY VT 100							FY-FLUORESCENT YELLOW FYG-FLUORESCENT YELLOW GREEN																			"SHS"-STANDARD HIGHWAY SIGNS			
SB	6.131	F	W1-8	18	24								1		X													
		F	W1-8	18	24			3.00								1		X									X	
SB	6.113	F	W1-8	18	24								1		X													
		F	W1-8	18	24			3.00								1		X									X	
SB	6.094	F	W1-8	18	24								1		X													
		F	W1-8	18	24			3.00								1		X									X	
SB	6.076	F	W1-8	18	24								1		X													
		F	W1-8	18	24			3.00								1		X									X	
SB	6.062	F	W1-8	18	24								1		X													
		F	W1-8	18	24			3.00								1		X									X	
SB	5.973	F	R2-1	24	30								1		X													
		F	R2-1	24	30			5.00								1		X									X	
SB	5.760	F	S1-1	36	36								1		X													
		F	W16-9	24	10								1															
		F	S1-1	36	36	FYG		9.00								2		X									X	
SIGN SUMMARY SHEET							SHEET TOTALS	29.00	0.00	0	0	0	8	0	0	8		120									
								SF	SF	EA	EA	EA	EA	EA	EA	EA		FT									
VERMONT AGENCY OF TRANSPORTATION							TOWN TOTALS	345.2	0.0	68.0	1.0	1.0	65	0.0	0.0	62		930.0									


PROJECT NAME: **Moretown-Newport Town VT100**
PROJECT NUMBER: **STPG SIGN(28)**

FILE NAME: **Duxburv.xls** PLOT DATE: **9/16/2009**
PROJECT MANAGER: **N. Averv** DRAWN BY: **I. Shea**
DESIGNED BY: **D. Crosslev** CHECKED BY: **J. Kelly**
DUXBURY SHEET 8 SHEET **26** OF **166**

DIRECTION	MILEPOINT	LOCATION CODE (SHEET 2)	SIGN CODE	WIDTH (IN)	HEIGHT (IN)	SHEETING REMARKS	SIGN LEGEND	NEW SIGNS "A"	NEW SIGNS "B"	EXISTING SIGNS RETAIN	EXISTING SIGNS SALVAGE FROM	EXISTING SIGNS SALVAGE TO	EXISTING SIGNS REMOVE	EXIST POST RETAIN	EXIST POST REMOVE	NUMBER OF NEW POSTS	SQUARE STEEL (IN) 1.75 (LB / FT) 1.88	SQUARE STEEL (IN) 2.00 (LB / FT) 2.42	SQUARE STEEL (IN) 2.50 (LB / FT) 3.35	TUBULAR STEEL Ø (IN) FOUNDATION	TUBULAR STEEL Ø (IN) 3.00 (LB / FT) 7.60	TUBULAR STEEL Ø (IN) 3.50 (LB / FT) 9.00	TUBULAR STEEL Ø (IN) 4.00 (LB / FT) 10.80	TUBULAR STEEL Ø (IN) 5.00 (LB / FT) 14.60	SIGN FRAME REQUIRED	REMARKS	SIGN DETAIL: DETAIL IN SHS	SIGN DETAIL: DETAIL ON SHEET NUMBER	SIGN DETAIL: DETAIL ON STD SHEET NUMBER
DUXBURY VT 100							FY-FLUORESCENT YELLOW FYG-FLUORESCENT YELLOW GREEN																			"SHS"-STANDARD HIGHWAY SIGNS			
		F	W16-9	36	24	FYG		5.00																			X		
SB	5.719	F	S4-3YG	24	8		SCHOOL			1				X															
		F	R2-1	24	30		SPEED LIMIT 35			1																			
		F	S4-4	24	10		WHEN FLASHING			1																			
SB	5.690	F	D1-1E	72	20		<--- CROSSETT BROOK MIDDLE SCHOOL			1				X															
SB	5.669	G	VR-017	24	24		LEGAL LOAD LIMIT 24,000 LBS			1				~~X~~		1		X									MAIN ST TH-41			
SB	5.658	H	R1-1	30	30		STOP			1				X													MAIN ST TH-41			
SB	5.594	F	VW-619	24 30	24 30		TO DUXBURY / SHOULDER NARROWS	4.00					1		X															
		F	VW-619	36	36			7.50								1		X											6	
SB	5.560	F	R2-1	24	30		SPEED LIMIT 40			1				X															
SB	5.508	G	VR-017	24	24		LEGAL LOAD LIMIT 24,000 LBS				1	1			X	1		X									CROSSETT HILL RD TH-4(NORTH) MOVE SIGN CLOSER TO RT 100			
SB	5.496	H	R1-1	24	24		STOP			1				X													CROSSETT HILL RD TH-4(NORTH)			
SB	5.390	F	R2-1	24	30		SPEED LIMIT 40						1		X															
		F	R2-1	24	30			5.00								1		X										X		
SB	5.232	F	R2-1	24	30								1		X															
SIGN SUMMARY SHEET							SHEET TOTALS	17.50	0.00	8	1	1	3	0	0	3		45										
								SF	SF	EA	EA	EA	EA	EA	EA	EA		FT										
VERMONT AGENCY OF TRANSPORTATION							TOWN TOTALS	345.2	0.0	68.0	1.0	1.0	65	0.0	0.0	62		930.0										

PROJECT NAME: **Moretown-Newport Town VT100**
PROJECT NUMBER: **STPG SIGN(28)**

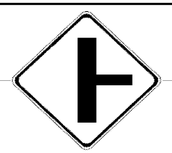FILE NAME: **Duxburv.xls** PLOT DATE: **9/16/2009**
PROJECT MANAGER: **N. Avery** DRAWN BY: **I. Shea**
DESIGNED BY: **D. Crossley** CHECKED BY: **J. Kelly**
DUXBURY SHEET 9 SHEET **27** OF **166**

DIRECTION	MILEPOINT	LOCATION CODE (SHEET 2)	SIGN CODE	WIDTH (IN)	HEIGHT (IN)	SHEETING REMARKS	SIGN LEGEND	NEW SIGNS "A"	NEW SIGNS "B"	EXISTING SIGNS RETAIN	EXISTING SIGNS SALVAGE FROM	EXISTING SIGNS SALVAGE TO	EXISTING SIGNS REMOVE	EXIST POST RETAIN	EXIST POST REMOVE	NUMBER OF NEW POSTS	SQUARE STEEL (IN) 1.75 (LB / FT) 1.88	SQUARE STEEL (IN) 2.00 (LB / FT) 2.42	SQUARE STEEL (IN) 2.50 (LB / FT) 3.35	TUBULAR STEEL Ø (IN) FOUNDATION	TUBULAR STEEL Ø (IN) 3.00 (LB / FT) 7.60	TUBULAR STEEL Ø (IN) 3.50 (LB / FT) 9.00	TUBULAR STEEL Ø (IN) 4.00 (LB / FT) 10.80	TUBULAR STEEL Ø (IN) 5.00 (LB / FT) 14.60	SIGN FRAME REQUIRED	REMARKS	SIGN DETAIL: DETAIL IN SHS	SIGN DETAIL: DETAIL ON SHEET NUMBER	SIGN DETAIL: DETAIL ON STD SHEET NUMBER
DUXBURY VT 100							FY-FLUORESCENT YELLOW FYG-FLUORESCENT YELLOW GREEN																			"SHS"-STANDARD HIGHWAY SIGNS			
		F	R2-1	24	30			5.00								1		X								X		
SB	5.091	F	VD-062B	72	16		BUSINESS SIGN			1				X														
SB	4.648	G	VR-017	24	24		LEGAL LOAD LIMIT 24,000 LBS			1				X													GROUT RD TH-23			
SB	4.641	H	R1-1	24	24		STOP			1				X													GROUT RD TH-23			
SB	4.584	F	VW-000	30	30		MOOSE CROSSING			1				X																
		F	W7-3A	24	18		NEXT 4 MILES			1																				
SB	4.320	F	W2-2R	30	30		RIGHT SIDE ROAD						1		X															
SB	4.266	F	S3-1	30	30		SCHOOL BUS STOP AHEAD 						1		X															
		F	W2-2MaR	30	30			6.25								1		X											6	
SB	4.192	C	R6-1 L	36	12		ONE WAY			1				X																
		D	R6-1 L	36	12		ONE WAY			1																				
SB	4.180	C	R6-1 L	36	12		ONE WAY			1				X																
		D	R6-1 L	36	12		ONE WAY			1																				
SB	4.170	G	VR-017	24	30		LEGAL LOAD LIMIT 24,000 LBS			1				X													CROSSETT HILL RD TH-4(NORTH)			
SB	4.130	H	R1-1	30	30		STOP			1				X													CROSSETT HILL RD TH-4(SOUTH)			
							SHEET TOTALS	11.25	0.00	11	0	0	2	0	0	2		30											
								SF	SF	EA	EA	EA	EA	EA	EA	EA		FT											
							TOWN TOTALS	345.2	0.0	68.0	1.0	1.0	65	0.0	0.0	62		930.0											

SIGN SUMMARY SHEET

VERMONT AGENCY OF TRANSPORTATION

PROJECT NAME: **Moretown-Newport Town VT100**
PROJECT NUMBER: **STPG SIGN(28)**

FILE NAME: **Duxburv.xls** PLOT DATE: **9/16/2009**
PROJECT MANAGER: **N. Averv** DRAWN BY: **I. Shea**
DESIGNED BY: **D. Crosslev** CHECKED BY: **J. Kelly**
DUXBURY SHEET 10 SHEET **28** OF **166**

DIRECTION	MILEPOINT	LOCATION CODE (SHEET 2)	SIGN CODE	WIDTH (IN)	HEIGHT (IN)	SHEETING REMARKS	SIGN LEGEND	NEW SIGNS "A"	NEW SIGNS "B"	EXISTING SIGNS RETAIN	EXISTING SIGNS SALVAGE FROM	EXISTING SIGNS SALVAGE TO	EXISTING SIGNS REMOVE	EXIST POST RETAIN	EXIST POST REMOVE	NUMBER OF NEW POSTS	SQUARE STEEL (IN) 1.75 (LB / FT) 1.88	SQUARE STEEL (IN) 2.00 (LB / FT) 2.42	SQUARE STEEL (IN) 2.50 (LB / FT) 3.35	TUBULAR STEEL Ø (IN) FOUNDATION	TUBULAR STEEL Ø (IN) 3.00 (LB / FT) 7.60	TUBULAR STEEL Ø (IN) 3.50 (LB / FT) 9.00	TUBULAR STEEL Ø (IN) 4.00 (LB / FT) 10.80	TUBULAR STEEL Ø (IN) 5.00 (LB / FT) 14.60	SIGN FRAME REQUIRED	REMARKS	SIGN DETAIL: DETAIL IN SHS	SIGN DETAIL: DETAIL ON SHEET NUMBER	SIGN DETAIL: DETAIL ON STD SHEET NUMBER
DUXBURY VT 100							FY-FLUORESCENT YELLOW FYG-FLUORESCENT YELLOW GREEN																			"SHS"-STANDARD HIGHWAY SIGNS			
SB	3.895	F	VW-054L	30	30		HIDDEN DRIVE LEFT						1		X													
SB	3.835	F	VW-054L	30	30			6.25								1		X							INSTALL 300' SOUTH OF ORIGINAL SIGN LOCATION			E-154
SB	2.855	F	W11-6 H	30	30		SNOWMOBILE SYMBOL HINGED			1				X														
SB	2.726	G	VR-017	24	30		LEGAL LOAD LIMIT 24,000 LBS			1				X												RYAN RD TH-26			
SB	2.715	H	R1-1	30	30		STOP			1				X												RYAN RD TH-26			
SB	1.948	G	VR-017	24	30		LEGAL LOAD LIMIT 24,000 LBS			1				X												TURNER HILL RD TH-31 (NORTH) REMOVE SLOW CHILDREN SIGN			
SB	1.942	H	R1-1	30	30		STOP			1				X												TURNER HILL RD TH-31 (NORTH)			
SB	1.750	F	S3-1	30	30								1		X															
		F	S3-1	30	30			6.25								1		X									X	
SB	1.410	F	S3-1	30	30								1		X															
		F	S3-1	30	30			6.25								1		X									X	
SB	0.940	F	W11-3	30	30			6.25								1		X								INSTALL 250' +/- NORTH OF SPEED REDUCTION 40 MPH SIGN	X	
SB	0.905	F	W3-5	36	36		SPEED REDUCTION 40 MPH			1				X														
SB	0.858	G	VR-017	24	24		LEGAL LOAD LIMIT 24,000 LBS			1				X												TURNER HILL RD TH-31 (SOUTH)			
SB	0.846	H	R1-1	30	30		STOP			1				X												TURNER HILL RD TH-31 (SOUTH)			
							SHEET TOTALS	25.00	0.00	8	0	0	3	0	0	4		60									
								SF	SF	EA	EA	EA	EA	EA	EA	EA		FT									
							TOWN TOTALS	345.2	0.0	68.0	1.0	1.0	65	0.0	0.0	62		930.0									

SIGN SUMMARY SHEET

VERMONT AGENCY OF TRANSPORTATION

PROJECT NAME: **Moretown-Newport Town VT100**
PROJECT NUMBER: **STPG SIGN(28)**

FILE NAME: **Duxburv.xls** PLOT DATE: **9/16/2009**
PROJECT MANAGER: **N. Avery** DRAWN BY: **I. Shea**
DESIGNED BY: **D. Crossley** CHECKED BY: **J. Kelly**
DUXBURY SHEET 11 SHEET **29** OF **166**

DIRECTION	MILEPOINT	LOCATION CODE (SHEET 2)	SIGN CODE	WIDTH (IN)	HEIGHT (IN)	SHEETING REMARKS	SIGN LEGEND	NEW SIGNS "A"	NEW SIGNS "B"	EXISTING SIGNS RETAIN	EXISTING SIGNS SALVAGE FROM	EXISTING SIGNS SALVAGE TO	EXISTING SIGNS REMOVE	EXIST POST RETAIN	EXIST POST REMOVE	NUMBER OF NEW POSTS	SQUARE STEEL (IN) 1.75 (LB / FT) 1.88	SQUARE STEEL (IN) 2.00 (LB / FT) 2.42	SQUARE STEEL (IN) 2.50 (LB / FT) 3.35	TUBULAR STEEL Ø (IN) FOUNDATION	TUBULAR STEEL Ø (IN) 3.00 (LB / FT) 7.60	TUBULAR STEEL Ø (IN) 3.50 (LB / FT) 9.00	TUBULAR STEEL Ø (IN) 4.00 (LB / FT) 10.80	TUBULAR STEEL Ø (IN) 5.00 (LB / FT) 14.60	SIGN FRAME REQUIRED	REMARKS	SIGN DETAIL: DETAIL IN SHS	SIGN DETAIL: DETAIL ON SHEET NUMBER	SIGN DETAIL: DETAIL ON STD SHEET NUMBER
DUXBURY VT 100							FY-FLUORESCENT YELLOW FYG-FLUORESCENT YELLOW GREEN																			"SHS"-STANDARD HIGHWAY SIGNS			
SB	0.806	F	R2-1	24	30								1		X													
		F	R2-1	30	36			7.50								~~2~~ 1		X									6
SB	0.720	G	VR-017	24	30		LEGAL LOAD LIMIT 24,000 LBS			1				X													
SB	0.711	H	R1-1	30	30		STOP			1				X													
SB	0.678	F	S1-1	36	36	FYG	SCHOOL			1				X													
		F	W16-9	36	20	FYG	AHEAD			1																	
SB	0.609	F	S4-3	24	8								1		X												
		F	R2-1	24	30								1														
		F	S4-2	24	10								1													
		F	S4-3	24	8	FYG		1.33								1		X								X	
		F	R2-1	24	30			5.00																		X	
		F	S4-2	24	10			1.67																		X	
SB	0.501	F	S1-1YG	36	36		SCHOOL			1				X													
		F	W16-7YG	30	18		DIAGONAL ARROW			1																	
SB	0.480	F	D1-2 L	72	20								1		X												
							SHEET TOTALS	15.50	0.00	6	0	0	5	0	0	3		45									
								SF	SF	EA	EA	EA	EA	EA	EA	EA		FT									
							TOWN TOTALS	345.2	0.0	68.0	1.0	1.0	65	0.0	0.0	62		930.0									

SIGN SUMMARY SHEET

VERMONT AGENCY OF TRANSPORTATION

PROJECT NAME: **Moretown-Newport Town VT100**
PROJECT NUMBER: **STPG SIGN(28)**

FILE NAME: **Duxburv.xls** PLOT DATE: **9/16/2009**
PROJECT MANAGER: **N. Averv** DRAWN BY: **I. Shea**
DESIGNED BY: **D. Crosslev** CHECKED BY: **J. Kelly**
DUXBURY SHEET 12 SHEET **30** OF **166**

DIRECTION	MILEPOINT	LOCATION CODE (SHEET 2)	SIGN CODE	WIDTH (IN)	HEIGHT (IN)	SHEETING REMARKS	SIGN LEGEND	NEW SIGNS "A"	NEW SIGNS "B"	EXISTING SIGNS RETAIN	EXISTING SIGNS SALVAGE FROM	EXISTING SIGNS SALVAGE TO	EXISTING SIGNS REMOVE	EXIST POST RETAIN	EXIST POST REMOVE	NUMBER OF NEW POSTS	SQUARE STEEL (IN) 1.75 (LB / FT) 1.88	SQUARE STEEL (IN) 2.00 (LB / FT) 2.42	SQUARE STEEL (IN) 2.50 (LB / FT) 3.35	TUBULAR STEEL Ø (IN) FOUNDATION	TUBULAR STEEL Ø (IN) 3.00 (LB / FT) 7.60	TUBULAR STEEL Ø (IN) 3.50 (LB / FT) 9.00	TUBULAR STEEL Ø (IN) 4.00 (LB / FT) 10.80	TUBULAR STEEL Ø (IN) 5.00 (LB / FT) 14.60	SIGN FRAME REQUIRED	REMARKS	SIGN DETAIL: DETAIL IN SHS	SIGN DETAIL: DETAIL ON SHEET NUMBER	SIGN DETAIL: DETAIL ON STD SHEET NUMBER
DUXBURY VT 100							FY-FLUORESCENT YELLOW FYG-FLUORESCENT YELLOW GREEN																			"SHS"-STANDARD HIGHWAY SIGNS			
		F	D1-2 L	72	20		HARWOOD UNION ← HIGH SCHOOL	10.00								2		X									5
SB	0.430	F	W2-2R	30	30		RIGHT SIDE ROAD						1		X													
SB	0.420	G	VR-017	24	30		LEGAL LOAD LIMIT 24,000 LBS			1				X												DOWSVILLE RD TH-35			
SB	0.407	H	R1-1	30	30		STOP			1				X												DOWSVILLE RD TH-35			
SB	0.395	F	S4-3	24	8								1		X													
		F	R2-1	24	30		SCHOOL						1															
		F	S4-2	24	10		SPEED LIMIT 35						1															
		F	S4-3	24	8	FYG	WHEN CHILDREN ARE PRESENT	1.33								1		X									X	
		F	R2-1	24	30			5.00																			X	
		F	S4-2	24	10			1.67																			X	
SB	0.357	F	R2-1	24	30		SPEED LIMIT 40						1		X													
		F	R2-1	24	30			5.00								1		X									X	
SB	0.306	G	VR-017	24	30		LEGAL LOAD LIMIT 24,000 LBS			1				X												CLARK RD TH-42			
SB	0.298	H	R1-1	30	30		STOP			1				X												CLARK RD TH-42			
SB	0.217	F	W1-4MR	30	30		MODIFIED RIGHT REVERSE CURVE						1		X													
							SHEET TOTALS	23.00	0.00	4	0	0	6	0	0	4		60									
								SF	SF	EA	EA	EA	EA	EA	EA	EA		FT									
							TOWN TOTALS	345.2	0.0	68.0	1.0	1.0	65	0.0	0.0	62		930.0									

SIGN SUMMARY SHEET

VERMONT AGENCY OF TRANSPORTATION


PROJECT NAME: Moretown-Newport Town VT100
PROJECT NUMBER: STPG SIGN(28)

FILE NAME: Duxburv.xls
PROJECT MANAGER: N. Averv
DESIGNED BY: D. Crossley
PLOT DATE: 9/16/2009
DRAWN BY: I. Shea
CHECKED BY: J. Kelly

DIRECTION	MILEPOINT	LOCATION CODE (SHEET 2)	SIGN CODE	WIDTH (IN)	HEIGHT (IN)	SHEETING REMARKS	SIGN LEGEND	NEW SIGNS "A"	NEW SIGNS "B"	EXISTING SIGNS RETAIN	EXISTING SIGNS SALVAGE FROM	EXISTING SIGNS SALVAGE TO	EXISTING SIGNS REMOVE	EXIST POST RETAIN	EXIST POST REMOVE	NUMBER OF NEW POSTS	SQUARE STEEL (IN) (LB / FT) 1.75 / 1.88	SQUARE STEEL (IN) (LB / FT) 2.00 / 2.42	SQUARE STEEL (IN) (LB / FT) 2.50 / 3.35	TUBULAR STEEL Ø (IN) FOUNDATION	TUBULAR STEEL Ø (IN) (LB / FT) 3.00 / 7.60	TUBULAR STEEL Ø (IN) (LB / FT) 3.50 / 9.00	TUBULAR STEEL Ø (IN) (LB / FT) 4.00 / 10.80	TUBULAR STEEL Ø (IN) (LB / FT) 5.00 / 14.60	SIGN FRAME REQUIRED	REMARKS	SIGN DETAIL: DETAIL IN SHS	SIGN DETAIL: DETAIL ON SHEET NUMBER	SIGN DETAIL: DETAIL ON STD SHEET NUMBER
DUXBURY VT 100							FY-FLUORESCENT YELLOW FYG-FLUORESCENT YELLOW GREEN																			"SHS"-STANDARD HIGHWAY SIGNS			
		F	W13-1	18	18		30 MPH PLAQUE 						1															
		F	W11-7	30	30			6.25								1		X									X	
SB	0.170	F	W11-7	30	30		EQUESTRIAN 						1		X													
		F	W1-4R	30	30			6.25								1		X										
		F	W13-1	18	18			2.25																			X	
SB	0.137	G	VR-017	24	24		LEGAL LOAD LIMIT 24,000 LBS			1				X												WARD HILL RD TH-35			
SB	0.127	H	R1-1	30	30		STOP			1				X												WARD HILL RD TH-35			
SIGN SUMMARY SHEET							SHEET TOTALS	14.75	0.00	2	0	0	2	0	0	2	30											
								SF	SF	EA	EA	EA	EA	EA	EA	EA	FT											
VERMONT AGENCY OF TRANSPORTATION							TOWN TOTALS	345.2	0.0	68.0	1.0	1.0	65	0.0	0.0	62	930.0											

PROJECT NAME: **Moretown-Newport Town VT100**
PROJECT NUMBER: **STPG SIGN(28)**

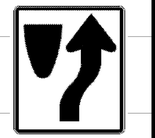FILE NAME: **Duxburv.xls** PLOT DATE: **9/16/2009**
PROJECT MANAGER: **N. Averv** DRAWN BY: **I. Shea**
DESIGNED BY: **D. Crossley** CHECKED BY: **J. Kelly**
DUXBURY SHEET 14 SHEET **32** OF **166**

DIRECTION	MILEPOINT	LOCATION CODE (SHEET 2)	SIGN CODE	WIDTH (IN)	HEIGHT (IN)	SHEETING REMARKS	SIGN LEGEND	NEW SIGNS "A"	NEW SIGNS "B"	EXISTING SIGNS RETAIN	EXISTING SIGNS SALVAGE FROM	EXISTING SIGNS SALVAGE TO	EXISTING SIGNS REMOVE	EXIST POST RETAIN	EXIST POST REMOVE	NUMBER OF NEW POSTS	SQUARE STEEL (IN) (LB / FT) 1.75 / 1.88	SQUARE STEEL (IN) (LB / FT) 2.00 / 2.42	SQUARE STEEL (IN) (LB / FT) 2.50 / 3.35	TUBULAR STEEL Ø (IN) FOUNDATION	TUBULAR STEEL Ø (IN) (LB / FT) 3.00 / 7.60	TUBULAR STEEL Ø (IN) (LB / FT) 3.50 / 9.00	TUBULAR STEEL Ø (IN) (LB / FT) 4.00 / 10.80	TUBULAR STEEL Ø (IN) (LB / FT) 5.00 / 14.60	SIGN FRAME REQUIRED	REMARKS	SIGN DETAIL: DETAIL IN SHS	SIGN DETAIL: DETAIL ON SHEET NUMBER	SIGN DETAIL: DETAIL ON STD SHEET NUMBER
WATERBURY VT 100							FY-FLUORESCENT YELLOW FYG-FLUORESCENT YELLOW GREEN																			"SHS"-STANDARD HIGHWAY SIGNS			
NB	0.011	K	R1-1	30	30								1		X													
		J	R4-7	24	30								1															
		J	OM1-1	18	18								1															
		K	R1-1	30	30			6.25								~~1~~		~~X~~								X	
		J	R4-7	24	30			5.00																		X	
		J	OM1-1	18	18			2.25																		X	
NB	0.067	A	VR-041	24	24		THROUGH WAY BEGINS HERE						1		X													
NB	0.078	A	VR-118L	30	48								1		X													
		A	VR-118L	30	48			10.00								2		X									6	
			SIGNS FROM MP 0.79 - MP 0.659 TO BE REPLACED IN STOWE STREET PART OF INTERSTATE SIGN PROJECT																									
NB	0.660	C	VR-017	24	24								1		X											STOWE ST TH -2			
		C	VR-017	24	30			5.00								1		X										E-141
NB	0.665	M	R10-12	24	30								1													ON SPAN WIRE			
		M	R10-12	24	30			5.00																		ON SPAN WIRE	X		
NB	0.680	A	M3-1	24	12								1		X													
							SHEET TOTALS	33.50 SF	0.00 SF	0 EA	0 EA	0 EA	8 EA	0 EA	0 EA	4 EA	60 FT												
							TOWN TOTALS	622.8	0.0	89.0	5.0	5.0	115	2.0	0.0	105	1575.0												

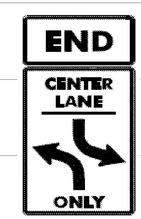
SIGN SUMMARY SHEET

VERMONT AGENCY OF TRANSPORTATION

PROJECT NAME: **Moretown-Newport Town VT100**
PROJECT NUMBER: **STPG SIGN(28)**

FILE NAME: **Waterburv.xls**
PROJECT MANAGER: **N. Averv**
DESIGNED BY: **D. Crossley**
WATERBURY SHEET 1

PLOT DATE: **9/17/2009**
DRAWN BY: **I. Shea**
CHECKED BY: **N. Avery**
SHEET **33** OF **166**

DIRECTION	MILEPOINT	LOCATION CODE (SHEET 2)	SIGN CODE	WIDTH (IN)	HEIGHT (IN)	SHEETING REMARKS	SIGN LEGEND	NEW SIGNS "A"	NEW SIGNS "B"	EXISTING SIGNS RETAIN	EXISTING SIGNS SALVAGE FROM	EXISTING SIGNS SALVAGE TO	EXISTING SIGNS REMOVE	EXIST POST RETAIN	EXIST POST REMOVE	NUMBER OF NEW POSTS	SQUARE STEEL (IN) 1.75 (LB / FT) 1.88	SQUARE STEEL (IN) 2.00 (LB / FT) 2.42	SQUARE STEEL (IN) 2.50 (LB / FT) 3.35	TUBULAR STEEL Ø (IN) FOUNDATION	TUBULAR STEEL Ø (IN) 3.00 (LB / FT) 7.60	TUBULAR STEEL Ø (IN) 3.50 (LB / FT) 9.00	TUBULAR STEEL Ø (IN) 4.00 (LB / FT) 10.80	TUBULAR STEEL Ø (IN) 5.00 (LB / FT) 14.60	SIGN FRAME REQUIRED	REMARKS	SIGN DETAIL: DETAIL IN SHS	SIGN DETAIL: DETAIL ON SHEET NUMBER	SIGN DETAIL: DETAIL ON STD SHEET NUMBER
WATERBURY VT 100							FY-FLUORESCENT YELLOW FYG-FLUORESCENT YELLOW GREEN																			"SHS"-STANDARD HIGHWAY SIGNS			
		A	M1-5	30	24								1															
		A	M3-1	24	12			2.00								1		X							GREEN ON WHITE SHEETING	X		
		A	M1-5	30	24			5.00																				E-136B
NB	0.714	A	VR-644	24	12								1		X													
		A	R3-9B	24	36								1															
		A	VR-644p	24	12			2.00								1		X								BLACK ON WHITE SHEETING		6	
		A	R3-9B	24	36			6.00																			X		
NB	0.720	A	VD-062C	74.75	16		TRAVEL INFORMATION			1				X														
		A	VD-062BC	74.75	16		TRAVEL INFORMATION			1																		
NB	0.759	A	R2-1	24	30								1		X													
		A	R2-1	24	30			5.00								1		X									X		
NB	0.770	A	M4-6	24	12								1		X													
		A	R3-9B	24	36								1															
		A	M4-6	24	12			2.00								1		X								BLACK ON WHITE SHEETING	X		
		A	R3-9B	24	36			6.00																			X		
							SHEET TOTALS	28.00	0.00	2	0	0	6	0	0	4		60										
								SF	SF	EA	EA	EA	EA	EA	EA	EA		FT										
							TOWN TOTALS	622.8	0.0	89.0	5.0	5.0	115	2.0	0.0	105		1575.0										

SIGN SUMMARY SHEET

VERMONT AGENCY OF TRANSPORTATION

PROJECT NAME: **Moretown-Newport Town VT100**
PROJECT NUMBER: **STPG SIGN(28)**

FILE NAME: **Waterburv.xls**
PROJECT MANAGER: **N. Avery**
DESIGNED BY: **D. Crossley**
WATERBURY SHEET 2

PLOT DATE: **9/17/2009**
DRAWN BY: **I. Shea**
CHECKED BY: **N. Avery**
SHEET **34** OF **166**

DIRECTION	MILEPOINT	LOCATION CODE (SHEET 2)	SIGN CODE	WIDTH (IN)	HEIGHT (IN)	SHEETING REMARKS	SIGN LEGEND	NEW SIGNS "A"	NEW SIGNS "B"	EXISTING SIGNS RETAIN	EXISTING SIGNS SALVAGE FROM	EXISTING SIGNS SALVAGE TO	EXISTING SIGNS REMOVE	EXIST POST RETAIN	EXIST POST REMOVE	NUMBER OF NEW POSTS	SQUARE STEEL (IN) (LB / FT) 1.75	2.00	2.50	TUBULAR STEEL Ø (IN) FOUNDATION	(LB / FT) 3.00	3.50	4.00	5.00	SIGN FRAME REQUIRED	REMARKS	SIGN DETAIL DETAIL IN SHS	DETAIL ON SHEET NUMBER	DETAIL ON STD SHEET NUMBER
																	1.88	2.42	3.35		7.60	9.00	10.80	14.60					
WATERBURY VT 100							FY-FLUORESCENT YELLOW FYG-FLUORESCENT YELLOW GREEN																			"SHS"-STANDARD HIGHWAY SIGNS			
NB	0.790	A	VR-921	30	30								1		X														
		A	VR-921	30	30			6.25								1		X										E-145A
NB	0.820	C	R4-7	24	30		RIGHT BULL NOSE			1				X														
		C	OM1-1	18	18		YELLOW CLUSTER			1																		
NB	0.900	A	VD-062B	72	16		BUSINESS SIGN			1				X														
		A	VD-062AS	72	16		BUSINESS SIGN			1																		
NB	0.930	A	S3-1	30	30		SCHOOL BUS STOP AHEAD			1				X														
NB	0.980	A	R2-1	24	30								1		X														
		A	R2-1	24	30			5.00								1		X									X	
NB	1.022	C	VR-017	24	24								1		X												MILL ST TH-20		
		C	VR-017	24	30			5.00								1		X										E-141
NB	1.028	D	R1-1	24	24								1		X												MILL ST TH-20		
		D	R1-1	30	30			6.25								1		X									X	
NB	1.128	C	VR-017	24	24								1		X												LAUREL LN TH-21		
		C	VR-017	24	30			5.00								1		X										E-141
							SHEET TOTALS	27.50	0.00	5	0	0	5	0	0	5		75										
								SF	SF	EA	EA	EA	EA	EA	EA	EA		FT										
							TOWN TOTALS	622.8	0.0	89.0	5.0	5.0	115	2.0	0.0	105		1575.0										

SIGN SUMMARY SHEET

VERMONT AGENCY OF TRANSPORTATION

PROJECT NAME: **Moretown-Newport Town VT100**
PROJECT NUMBER: **STPG SIGN(28)**

FILE NAME: **Waterburv.xls** PLOT DATE: **9/17/2009**
PROJECT MANAGER: **N. Avery** DRAWN BY: **I. Shea**
DESIGNED BY: **D. Crossley** CHECKED BY: **N. Avery**
WATERBURY SHEET 3 SHEET **35** OF **166**

DIRECTION	MILEPOINT	LOCATION CODE (SHEET 2)	SIGN CODE	WIDTH (IN)	HEIGHT (IN)	SHEETING REMARKS	SIGN LEGEND	NEW SIGNS "A"	NEW SIGNS "B"	EXISTING SIGNS RETAIN	EXISTING SIGNS SALVAGE FROM	EXISTING SIGNS SALVAGE TO	EXISTING SIGNS REMOVE	EXIST POST RETAIN	EXIST POST REMOVE	NUMBER OF NEW POSTS	SQUARE STEEL (IN) (LB / FT) 1.75 / 1.88	SQUARE STEEL (IN) (LB / FT) 2.00 / 2.42	SQUARE STEEL (IN) (LB / FT) 2.50 / 3.35	TUBULAR STEEL Ø (IN) FOUNDATION	TUBULAR STEEL Ø (IN) (LB / FT) 3.00 / 7.60	TUBULAR STEEL Ø (IN) (LB / FT) 3.50 / 9.00	TUBULAR STEEL Ø (IN) (LB / FT) 4.00 / 10.80	TUBULAR STEEL Ø (IN) (LB / FT) 5.00 / 14.60	SIGN FRAME REQUIRED	REMARKS	SIGN DETAIL: DETAIL IN SHS	SIGN DETAIL: DETAIL ON SHEET NUMBER	SIGN DETAIL: DETAIL ON STD SHEET NUMBER
WATERBURY VT 100							FY-FLUORESCENT YELLOW FYG-FLUORESCENT YELLOW GREEN																			"SHS"-STANDARD HIGHWAY SIGNS			
NB	1.133	D	R1-1	24	24								~~1~~		X											LAUREL LN TH-21			
		D	R1-1	30	30			~~6.25~~								1		X									X		
NB	1.180	A	R2-1	24	30								1		X															
		A	R2-1	24	30			5.00								1		X									X		
NB	1.258	A	VR-921 L	30	30								1		X															
		A	VR-921 L	30	30			6.25								1		X											E-145A
NB	1.358	A	M3-1S	24	12								1		X														
		A	M1-5	30	24								1																
		A	M3-1	24	12			2.00								1		X							GREEN ON WHITE SHEETING	X		
		A	M1-5	30	24			5.00																				E-136B
NB	1.420	A	R2-1	24	30								1		X															
		A	R2-1	24	30			5.00								1		X									X		
NB	1.540	A	VD-062AS	72	16		BUSINESS SIGN			1				X															
		A	VD-062AS	72	16		BUSINESS SIGN			1																			
		A	VD-062B	72	16		BUSINESS SIGN			1																			
SIGN SUMMARY SHEET							SHEET TOTALS	29.50	0.00	3	0	0	6	0	0	5		75									
								SF	SF	EA	EA	EA	EA	EA	EA	EA		FT									
VERMONT AGENCY OF TRANSPORTATION							TOWN TOTALS	622.8	0.0	89.0	5.0	5.0	115	2.0	0.0	105		1575.0									

PROJECT NAME: **Moretown-Newport Town VT100**
PROJECT NUMBER: **STPG SIGN(28)**


FILE NAME: **Waterburv.xls** PLOT DATE: **9/17/2009**
PROJECT MANAGER: **N. Avery** DRAWN BY: **I. Shea**
DESIGNED BY: **D. Crosslev** CHECKED BY: **N. Avery**
WATERBURY SHEET 4 SHEET **36** OF **166**

DIRECTION	MILEPOINT	LOCATION CODE (SHEET 2)	SIGN CODE	WIDTH (IN)	HEIGHT (IN)	SHEETING REMARKS	SIGN LEGEND	NEW SIGNS "A"	NEW SIGNS "B"	EXISTING SIGNS RETAIN	EXISTING SIGNS SALVAGE FROM	EXISTING SIGNS SALVAGE TO	EXISTING SIGNS REMOVE	EXIST POST RETAIN	EXIST POST REMOVE	NUMBER OF NEW POSTS	SQUARE STEEL (IN) (LB / FT) 1.75 / 1.88	SQUARE STEEL (IN) (LB / FT) 2.00 / 2.42	SQUARE STEEL (IN) (LB / FT) 2.50 / 3.35	TUBULAR STEEL Ø (IN) FOUNDATION	TUBULAR STEEL Ø (IN) (LB / FT) 3.00 / 7.60	TUBULAR STEEL Ø (IN) (LB / FT) 3.50 / 9.00	TUBULAR STEEL Ø (IN) (LB / FT) 4.00 / 10.80	TUBULAR STEEL Ø (IN) (LB / FT) 5.00 / 14.60	SIGN FRAME REQUIRED	REMARKS	SIGN DETAIL: DETAIL IN SHS	SIGN DETAIL: DETAIL ON SHEET NUMBER	SIGN DETAIL: DETAIL ON STD SHEET NUMBER
WATERBURY VT 100							FY-FLUORESCENT YELLOW FYG-FLUORESCENT YELLOW GREEN																			"SHS"-STANDARD HIGHWAY SIGNS			
NB	1.575	A	VD-062AS	72	16		BUSINESS SIGN			1				X														
		A	VD-062B	72	16		BUSINESS SIGN			1																		
NB	1.606	A	R2-1	24	30								1		X													
		A	R2-1	24	30			5.00								1		X								
NB	1.636	C	VR-017	24	24			5.00					I		X	1		X								GUPTIL RD TH-1			E-141
NB	1.644	D	R1-1	24	24								1		X												GUPTIL RD TH-1			
		D	R1-1	30	30			6.25								1		X									X		
NB	1.750	A	R2-1	24	30								1		X													
		A	R2-1	24	30			5.00								1		X										
NB	2.050	A	VD-062B	72	16		BUSINESS SIGN			1				X														
		A	VD-062B	72	16		BUSINESS SIGN			1																		
NB	2.360	C	VR-017	24	24								1		X												STOWEBURY RD TH-51			
		C	VR-017	24	30			5.00								1		X										E-141
NB	2.360	D	R1-1	24	24								1		X												STOWEBURY RD TH-51			
		D	R1-1	30	30			6.25								1		X									X		
SIGN SUMMARY SHEET							SHEET TOTALS	32.50	0.00	4	0	0	5	0	0	6		90									
								SF	SF	EA	EA	EA	EA	EA	EA	EA		FT									
VERMONT AGENCY OF TRANSPORTATION							TOWN TOTALS	622.8	0.0	89.0	5.0	5.0	115	2.0	0.0	105		1575.0									

PROJECT NAME: **Moretown-Newport Town VT100**
PROJECT NUMBER: **STPG SIGN(28)**
FILE NAME: **Waterburv.xls**
PROJECT MANAGER: **N. Avery**
DESIGNED BY: **D. Crossley**
WATERBURY SHEET 5
PLOT DATE: **9/17/2009**
DRAWN BY: **I. Shea**
CHECKED BY: **N. Avery**
SHEET **37** OF **166**

DIRECTION	MILEPOINT	LOCATION CODE (SHEET 2)	SIGN CODE	WIDTH (IN)	HEIGHT (IN)	SHEETING REMARKS	SIGN LEGEND	NEW SIGNS "A"	NEW SIGNS "B"	EXISTING SIGNS RETAIN	EXISTING SIGNS SALVAGE FROM	EXISTING SIGNS SALVAGE TO	EXISTING SIGNS REMOVE	EXIST POST RETAIN	EXIST POST REMOVE	NUMBER OF NEW POSTS	SQUARE STEEL (IN) 1.75 (LB / FT) 1.88	SQUARE STEEL (IN) 2.00 (LB / FT) 2.42	SQUARE STEEL (IN) 2.50 (LB / FT) 3.35	TUBULAR STEEL Ø (IN) FOUNDATION	TUBULAR STEEL Ø (IN) 3.00 (LB / FT) 7.60	TUBULAR STEEL Ø (IN) 3.50 (LB / FT) 9.00	TUBULAR STEEL Ø (IN) 4.00 (LB / FT) 10.80	TUBULAR STEEL Ø (IN) 5.00 (LB / FT) 14.60	SIGN FRAME REQUIRED	REMARKS	SIGN DETAIL: DETAIL IN SHS	SIGN DETAIL: DETAIL ON SHEET NUMBER	SIGN DETAIL: DETAIL ON STD SHEET NUMBER
WATERBURY VT 100							FY-FLUORESCENT YELLOW FYG-FLUORESCENT YELLOW GREEN																			"SHS"-STANDARD HIGHWAY SIGNS			
NB	2.477	A	W3-5	36	36								1		X													
		A	W3-5	36	36			9.00								2		X									X	
NB	2.515	A	VD-062B	72	16		BUSINESS SIGN			1				X														
		A	VD-062B	72	16		BUSINESS SIGN			1																		
NB	2.562	A	R2-1	24	30		SPEED LIMIT 40 						1		X													
		A	R2-1	30	36		END NO PASSING	7.50								~~2~~ 1		X								REPLACE SPEED LIMIT SIGN ONLY		6	
	NEW 2.581			30	30			6.25																				
		A	R4-1	24	30		DO NOT PASS				1	1																
NB	2.640	C	VR-017	24	24								1		X												EAST WIND RD TH-41			
		C	VR-017	24	30			5.00								1		X										E-141
NB	2.650	D	R1-1	24	24								1		X												EAST WIND RD TH-41			
		D	R1-1	30	30			6.25								1		X									X	
NB	2.756	C	VR-017	24	24								1		X												MCNEIL RD TH-16			
		C	VR-017	24	30			5.00								1		X										E-141
NB	2.764	D	R1-1	24	24								1		X												MCNEIL RD TH-16			
		D	R1-1	30	30			6.25								1		X									X	
SIGN SUMMARY SHEET							SHEET TOTALS	39.00	0.00	2	1	1	6	0	0	8		120										
								SF	SF	EA	EA	EA	EA	EA	EA	EA		FT										
VERMONT AGENCY OF TRANSPORTATION							TOWN TOTALS	622.8	0.0	89.0	5.0	5.0	115	2.0	0.0	105		1575.0										

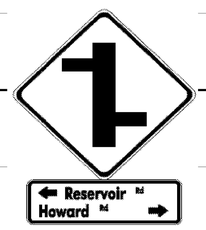PROJECT NAME: **Moretown-Newport Town VT100**
PROJECT NUMBER: **STPG SIGN(28)**
FILE NAME: **Waterburv.xls**
PROJECT MANAGER: **N. Avery**
DESIGNED BY: **D. Crossley**
WATERBURY SHEET 6
PLOT DATE: **9/17/2009**
DRAWN BY: **I. Shea**
CHECKED BY: **N. Avery**
SHEET **38** OF **166**

DIRECTION	MILEPOINT	LOCATION CODE (SHEET 2)	SIGN CODE	WIDTH (IN)	HEIGHT (IN)	SHEETING REMARKS	SIGN LEGEND	NEW SIGNS "A"	NEW SIGNS "B"	EXISTING SIGNS RETAIN	EXISTING SIGNS SALVAGE FROM	EXISTING SIGNS SALVAGE TO	EXISTING SIGNS REMOVE	EXIST POST RETAIN	EXIST POST REMOVE	NUMBER OF NEW POSTS	SQUARE STEEL (IN) 1.75 (LB / FT) 1.88	SQUARE STEEL (IN) 2.00 (LB / FT) 2.42	SQUARE STEEL (IN) 2.50 (LB / FT) 3.35	TUBULAR STEEL Ø (IN) FOUNDATION	TUBULAR STEEL Ø (IN) 3.00 (LB / FT) 7.60	TUBULAR STEEL Ø (IN) 3.50 (LB / FT) 9.00	TUBULAR STEEL Ø (IN) 4.00 (LB / FT) 10.80	TUBULAR STEEL Ø (IN) 5.00 (LB / FT) 14.60	SIGN FRAME REQUIRED	REMARKS	SIGN DETAIL: DETAIL IN SHS	SIGN DETAIL: DETAIL ON SHEET NUMBER	SIGN DETAIL: DETAIL ON STD SHEET NUMBER
WATERBURY VT 100							FY-FLUORESCENT YELLOW FYG-FLUORESCENT YELLOW GREEN																			"SHS"-STANDARD HIGHWAY SIGNS			
NB	2.858	A	R2-1	24	30		SPEED LIMIT 40			1				X														
	NEW			30	30		END NO PASSING	6.25																				
		B	W14-3	48	36		NO PASSING ZONE			1																		
NB	3.088	A	VD-018	30	18					1				X														
		A	VD-018	30	18			3.75								1		X										E-128B
NB	3.120	A	VD-062BRN	72	16		BUSINESS SIGN			1				X														
		A	VD-062B	72	16		BUSINESS SIGN			1																		
		A	VD-062B	72	16		BUSINESS SIGN			1																		
NB	3.138	A	R2-1	24	30								1		X													
		A	R2-1	24	30			5.00								1		X									X	
NB	3.160	A	W2-1M f	36	36		MODIFIED CROSSROAD						1		X													
		A	W16-8A	48	15		<--- RESERVOIR RD HOWARD RD --->						1															
NB	3.210	A	W2-1M f	36	36			9.00								2		X								INSTALL 260' +/- NORTH OF ORIGINAL SIGN LOCATION		6	
			W16-8A	48	15			5.00																				8	
NB	3.324	C	VR-017	24	24									1	X													HOWARD AVE TH-1			
		C	VR-017	24	30			5.00								1		X											E-141
							SHEET TOTALS	27.75 SF	0.00 SF	6 EA	0 EA	0 EA	3 EA	1 EA	0 EA	5 EA		75 FT										
							TOWN TOTALS	622.8	0.0	89.0	5.0	5.0	115	2.0	0.0	105		1575.0										

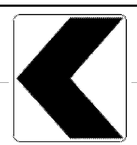
SIGN SUMMARY SHEET

VERMONT AGENCY OF TRANSPORTATION

PROJECT NAME: **Moretown-Newport Town VT100**
PROJECT NUMBER: **STPG SIGN(28)**


FILE NAME: **Waterburv.xls**
PROJECT MANAGER: **N. Averv**
DESIGNED BY: **D. Crossley**
WATERBURY SHEET 7

PLOT DATE: **9/17/2009**
DRAWN BY: **I. Shea**
CHECKED BY: **N. Avery**

DIRECTION	MILEPOINT	LOCATION CODE (SHEET 2)	SIGN CODE	WIDTH (IN)	HEIGHT (IN)	SHEETING REMARKS	SIGN LEGEND	NEW SIGNS "A"	NEW SIGNS "B"	EXISTING SIGNS RETAIN	EXISTING SIGNS SALVAGE FROM	EXISTING SIGNS SALVAGE TO	EXISTING SIGNS REMOVE	EXIST POST RETAIN	EXIST POST REMOVE	NUMBER OF NEW POSTS	SQUARE STEEL (IN) (LB / FT) 1.75 / 1.88	SQUARE STEEL (IN) (LB / FT) 2.00 / 2.42	SQUARE STEEL (IN) (LB / FT) 2.50 / 3.35	TUBULAR STEEL Ø (IN) FOUNDATION	TUBULAR STEEL Ø (IN) (LB / FT) 3.00 / 7.60	TUBULAR STEEL Ø (IN) (LB / FT) 3.50 / 9.00	TUBULAR STEEL Ø (IN) (LB / FT) 4.00 / 10.80	TUBULAR STEEL Ø (IN) (LB / FT) 5.00 / 14.60	SIGN FRAME REQUIRED	REMARKS	SIGN DETAIL: DETAIL IN SHS	SIGN DETAIL: DETAIL ON SHEET NUMBER	SIGN DETAIL: DETAIL ON STD SHEET NUMBER
WATERBURY VT 100							FY-FLUORESCENT YELLOW FYG-FLUORESCENT YELLOW GREEN																			"SHS"-STANDARD HIGHWAY SIGNS			
NB	3.332	D	R1-1	24	24									1	X											HOWARD AVE TH-1			
		D	R1-1	30	30			6.25								1		X									X		
NB	3.320	A	W3-5	36	36		SPEED REDUCTION SPEED LIMIT 35			1				X															
NB	3.360	A	VD-062B	72	16		BUSINESS SIGN							X															
		A	VD-062B	72	16		BUSINESS SIGN																						
NB	3.400	A	W1-1L	30	30								1		X														
		A	W16-8A	24	8								1																
		A	W1-2 McL	30	30			6.25								1		X										6	
		A	W16-8A	30	8			1.33																				8	
NB	3.430	A	R2-1	24	30		SPEED LIMIT 35			1				X															
NB	3.477	A	VW-205	36	36		WATCH FOR TURNING VEHICLES			1				X															
NB	3.504	B	W1-8	18	24		CHEVRON			1				X															
NB	3.524	A	W1-8	18	24	FY		3.00								1		X										X	
		B	W1-8	18	24		CHEVRON			1																			
NB	3.550	C	VR-017	24	24								1		X												HOLLOW DR TH-38			
SIGN SUMMARY SHEET							SHEET TOTALS	16.83	0.00	5	0	0	3	1	0	3		45									
								SF	SF	EA	EA	EA	EA	EA	EA	EA		FT									
VERMONT AGENCY OF TRANSPORTATION							TOWN TOTALS	622.8	0.0	89.0	5.0	5.0	115	2.0	0.0	105		1575.0									

PROJECT NAME: **Moretown-Newport Town VT100**
PROJECT NUMBER: **STPG SIGN(28)**

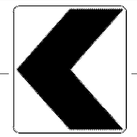FILE NAME: **Waterburv.xls** PLOT DATE: **9/17/2009**
PROJECT MANAGER: **N. Avery** DRAWN BY: **I. Shea**
DESIGNED BY: **D. Crossley** CHECKED BY: **N. Avery**
WATERBURY SHEET 8 SHEET **40** OF **166**

DIRECTION	MILEPOINT	LOCATION CODE (SHEET 2)	SIGN CODE	WIDTH (IN)	HEIGHT (IN)	SHEETING REMARKS	SIGN LEGEND	NEW SIGNS "A"	NEW SIGNS "B"	EXISTING SIGNS RETAIN	EXISTING SIGNS SALVAGE FROM	EXISTING SIGNS SALVAGE TO	EXISTING SIGNS REMOVE	EXIST POST RETAIN	EXIST POST REMOVE	NUMBER OF NEW POSTS	SQUARE STEEL (IN) (LB / FT) 1.75 / 1.88	SQUARE STEEL (IN) (LB / FT) 2.00 / 2.42	SQUARE STEEL (IN) (LB / FT) 2.50 / 3.35	TUBULAR STEEL Ø (IN) FOUNDATION	TUBULAR STEEL Ø (IN) (LB / FT) 3.00 / 7.60	TUBULAR STEEL Ø (IN) (LB / FT) 3.50 / 9.00	TUBULAR STEEL Ø (IN) (LB / FT) 4.00 / 10.80	TUBULAR STEEL Ø (IN) (LB / FT) 5.00 / 14.60	SIGN FRAME REQUIRED	REMARKS	SIGN DETAIL: DETAIL IN SHS	SIGN DETAIL: DETAIL ON SHEET NUMBER	SIGN DETAIL: DETAIL ON STD SHEET NUMBER
WATERBURY VT 100							FY-FLUORESCENT YELLOW FYG-FLUORESCENT YELLOW GREEN																			"SHS"-STANDARD HIGHWAY SIGNS			
		C	VR-017	24	30			5.00								1		X									E-141
NB	3.552	A	W1-8	18	24	FY		3.00					I		X	1		X								X	
		B	W1-8	18	24		CHEVRON			1																	
NB	3.552	D	R1-1	30	30								1		X											HOLLOW DR TH-38 ISLAND			
		D	R1-1	30	30			6.25								1		X								X	
NB	3.558	D	R1-1	30	30								1		X											HOLLOW DR TH-38			
		D	R1-1	30	30			6.25								1		X								X	
NB	3.598	A	R2-1	24	30		SPEED LIMIT 35			1				X													
NB	3.825	A	R2-1	24	30								1	X													
		A	R2-1	24	30			5.00								1		X								X	
NB	4.072	A	W2-2L	30	30		LEFT SIDE ROAD			1				X													
		A	W16-8A	30	8		GREG HILL RD			1																	
NB	4.108	A	VD-062B	72	16		BUSINESS SIGN			1																	
		A	VD-062B	72	16		BUSINESS SIGN			1				X													
NB	4.150	A	W11-3	30	30		DEER CROSSING						1		X												
							SHEET TOTALS	25.50	0.00	6	0	0	4	0	0	5		75									
								SF	SF	EA	EA	EA	EA	EA	EA	EA		FT									
							TOWN TOTALS	622.8	0.0	89.0	5.0	5.0	115	2.0	0.0	105		1575.0									

SIGN SUMMARY SHEET

VERMONT AGENCY OF TRANSPORTATION

PROJECT NAME: **Moretown-Newport Town VT100**
PROJECT NUMBER: **STPG SIGN(28)**

FILE NAME: **Waterburv.xls**
PROJECT MANAGER: **N. Averv**
DESIGNED BY: **D. Crossley**
WATERBURY SHEET 9

PLOT DATE: **9/17/2009**
DRAWN BY: **I. Shea**
CHECKED BY: **N. Avery**
SHEET **41** OF **166**

DIRECTION	MILEPOINT	LOCATION CODE (SHEET 2)	SIGN CODE	WIDTH (IN)	HEIGHT (IN)	SHEETING REMARKS	SIGN LEGEND	NEW SIGNS "A"	NEW SIGNS "B"	EXISTING SIGNS RETAIN	EXISTING SIGNS SALVAGE FROM	EXISTING SIGNS SALVAGE TO	EXISTING SIGNS REMOVE	EXIST POST RETAIN	EXIST POST REMOVE	NUMBER OF NEW POSTS	SQUARE STEEL (IN) 1.75 (LB / FT) 1.88	SQUARE STEEL (IN) 2.00 (LB / FT) 2.42	SQUARE STEEL (IN) 2.50 (LB / FT) 3.35	TUBULAR STEEL Ø (IN) FOUNDATION	TUBULAR STEEL Ø (IN) 3.00 (LB / FT) 7.60	TUBULAR STEEL Ø (IN) 3.50 (LB / FT) 9.00	TUBULAR STEEL Ø (IN) 4.00 (LB / FT) 10.80	TUBULAR STEEL Ø (IN) 5.00 (LB / FT) 14.60	SIGN FRAME REQUIRED	REMARKS	SIGN DETAIL: DETAIL IN SHS	SIGN DETAIL: DETAIL ON SHEET NUMBER	SIGN DETAIL: DETAIL ON STD SHEET NUMBER
WATERBURY VT 100							FY-FLUORESCENT YELLOW FYG-FLUORESCENT YELLOW GREEN																			"SHS"-STANDARD HIGHWAY SIGNS			
		A	W11-3	30	30			6.25								1		X									X		
NB	4.440	C	VR-017	24	24								1		X											GUILD HILL RD TH 5			
		C	VR-017	24	30			5.00								1		X											E-141
NB	4.440	D	R1-1	24	24								1		X											GUILD HILL RD TH 5			
		D	R1-1	30	30			6.25								1		X									X		
NB	5.158	D	R1-1	24	24								1		X											BEAVER POND RD TH-14			
		D	R1-1	30	30			6.25								1		X									X		
NB	5.160	C	VR-017	24	30								1		X											BEAVER POND RD TH-14			
		C	VR-017	24	30			5.00								1		X											E-141
NB	5.170	D	R1-1	30	30								1		X											BEAVER POND RD TH-14			
		D	R1-1	30	30			6.25								1		X									X		
NB	5.280	A	R8-3A	24	24		NO PARKING SYMBOL						1		X														
NB	5.300	C	VM-607	24	30		43RD INF DIV			1				X															
NB	5.365	A	VW-000	30	30		MOOSE CROSSING			1				X															
		A	W7-3A	24	18		NEXT 1 MILE			1																			
							SHEET TOTALS	35.00	0.00	3	0	0	6	0	0	6		90											
								SF	SF	EA	EA	EA	EA	EA	EA	EA		FT											
							TOWN TOTALS	622.8	0.0	89.0	5.0	5.0	115	2.0	0.0	105		1575.0											

SIGN SUMMARY SHEET

VERMONT AGENCY OF TRANSPORTATION

PROJECT NAME: **Moretown-Newport Town VT100**
PROJECT NUMBER: **STPG SIGN(28)**

FILE NAME: **Waterburv.xls**
PROJECT MANAGER: **N. Avery**
DESIGNED BY: **D. Crossley**
WATERBURY SHEET 10

PLOT DATE: **9/17/2009**
DRAWN BY: **I. Shea**
CHECKED BY: **N. Avery**
SHEET **42** OF **166**

DIRECTION	MILEPOINT	LOCATION CODE (SHEET 2)	SIGN CODE	WIDTH (IN)	HEIGHT (IN)	SHEETING REMARKS	SIGN LEGEND	NEW SIGNS "A"	NEW SIGNS "B"	EXISTING SIGNS RETAIN	EXISTING SIGNS SALVAGE FROM	EXISTING SIGNS SALVAGE TO	EXISTING SIGNS REMOVE	EXIST POST RETAIN	EXIST POST REMOVE	NUMBER OF NEW POSTS	SQUARE STEEL (IN) 1.75 (LB / FT) 1.88	SQUARE STEEL (IN) 2.00 (LB / FT) 2.42	SQUARE STEEL (IN) 2.50 (LB / FT) 3.35	TUBULAR STEEL Ø (IN) FOUNDATION	TUBULAR STEEL Ø (IN) 3.00 (LB / FT) 7.60	TUBULAR STEEL Ø (IN) 3.50 (LB / FT) 9.00	TUBULAR STEEL Ø (IN) 4.00 (LB / FT) 10.80	TUBULAR STEEL Ø (IN) 5.00 (LB / FT) 14.60	SIGN FRAME REQUIRED	REMARKS	SIGN DETAIL: DETAIL IN SHS	SIGN DETAIL: DETAIL ON SHEET NUMBER	SIGN DETAIL: DETAIL ON STD SHEET NUMBER
WATERBURY VT 100							FY-FLUORESCENT YELLOW FYG-FLUORESCENT YELLOW GREEN																			"SHS"-STANDARD HIGHWAY SIGNS			
NB	5.560	A	W2-2MR	30	30		RIGHT SIDE ROAD			1				X														
		A	W16-8A	24	18		SPRUCE HAVEN RD			1																		
NB	5.606	A	S3-1	30	30		SCHOOL BUS STOP AHEAD			1				X														
NB	5.664	C	VR-017	24	24								1		X												SPRUCE HAVEN RD TH- 46			
		C	VR-017	24	30			5.00								1		X											E-141
NB	5.652	D	R1-1	24	24								1		X												SPRUCE HAVEN RD TH- 46			
		D	R1-1	30	30			6.25							1		X										X		
NB	6.055	C	VR-017	24	30			5.00								1		X									RUBY RAYMOND RD TH-13			E-141
NB	6.062	D	R1-1	24	24								1		X												RUBY RAYMOND RD TH-13			
		D	R1-1	30	30			6.25								1		X										X	
NB	6.269	C	VR-017	24	24								1		X												RUSSEL S RD TH-54			
		C	VR-017	24	30			5.00								1		X											E-141
NB	6.277	D	R1-1	24	24								1		X												RUSSEL S RD TH-54			
		D	R1-1	30	30			6.25								1		X										X	
NB	6.285	A	W7-1	30	30								1		X														
							SHEET TOTALS	33.75	0.00	3	0	0	6	0	0	6		90											
								SF	SF	EA	EA	EA	EA	EA	EA	EA		FT											
							TOWN TOTALS	622.8	0.0	89.0	5.0	5.0	115	2.0	0.0	105		1575.0											

SIGN SUMMARY SHEET

VERMONT AGENCY OF TRANSPORTATION

PROJECT NAME: **Moretown-Newport Town VT100**
PROJECT NUMBER: **STPG SIGN(28)**

FILE NAME: **Waterburv.xls** PLOT DATE: **9/17/2009**
PROJECT MANAGER: **N. Avery** DRAWN BY: **I. Shea**
DESIGNED BY: **D. Crosslev** CHECKED BY: **N. Avery**
WATERBURY SHEET 11 SHEET **43** OF **166**

DIRECTION	MILEPOINT	LOCATION CODE (SHEET 2)	SIGN CODE	WIDTH (IN)	HEIGHT (IN)	SHEETING REMARKS	SIGN LEGEND	NEW SIGNS "A"	NEW SIGNS "B"	EXISTING SIGNS RETAIN	EXISTING SIGNS SALVAGE FROM	EXISTING SIGNS SALVAGE TO	EXISTING SIGNS REMOVE	EXIST POST RETAIN	EXIST POST REMOVE	NUMBER OF NEW POSTS	SQUARE STEEL (IN) 1.75 (LB / FT) 1.88	SQUARE STEEL (IN) 2.00 (LB / FT) 2.42	SQUARE STEEL (IN) 2.50 (LB / FT) 3.35	TUBULAR STEEL Ø (IN) FOUNDATION	TUBULAR STEEL Ø (IN) 3.00 (LB / FT) 7.60	TUBULAR STEEL Ø (IN) 3.50 (LB / FT) 9.00	TUBULAR STEEL Ø (IN) 4.00 (LB / FT) 10.80	TUBULAR STEEL Ø (IN) 5.00 (LB / FT) 14.60	SIGN FRAME REQUIRED	REMARKS	SIGN DETAIL: DETAIL IN SHS	SIGN DETAIL: DETAIL ON SHEET NUMBER	SIGN DETAIL: DETAIL ON STD SHEET NUMBER
WATERBURY VT 100							FY-FLUORESCENT YELLOW FYG-FLUORESCENT YELLOW GREEN																			"SHS"-STANDARD HIGHWAY SIGNS			
		A	W7-1b	30	30			6.25								1		X								X		
NB	6.390	A	VW-205	30	30		WATCH FOR TURNING VEHICLES			1				X														
SB	6.574	G	VR-017	24	24								1		X											GREGG HILL RD TH 11			
		G	VR-017	24	30			5.00								1		X										E-141
SB	6.573	H	R1-1	30	30								1		X											GREGG HILL RD TH 11			
		H	R1-1	30	30			6.25								1		X									X	
SB	6.550	H	R1-1	24	24								1		X											GREGG HILL RD TH 11			
		H	R1-1	30	30			6.25								1		X									X	
SB	6.394	F	VW-000	30	30		MOOSE CROSSING			1				X														
		F	W7-3A	24	18		NEXT 1 MILE			1																		
SB	6.155	F	W2-2ML	30	30		LEFT SIDE ROAD			1				X														
		F	W16-8A	24	18		RUBY RAYMOND RD			1																		
SB	5.845	F	VW-133R	30	30		HIDDEN DRIVES RIGHT				1	1			X	2		X									REPLACE POSTS			
		F	S3-1	30	30		SCHOOL BUS STOP AHEAD				1	1																	
SB	5.772	F	W2-2ML	30	30		MODIFIED LEFT SIDE ROAD			1					X												REPLACE POST			
							SHEET TOTALS	23.75	0.00	6	2	2	3	0	0	6		90										
								SF	SF	EA	EA	EA	EA	EA	EA	EA		FT										
							TOWN TOTALS	622.8	0.0	89.0	5.0	5.0	115	2.0	0.0	105		1575.0										

SIGN SUMMARY SHEET

VERMONT AGENCY OF TRANSPORTATION

PROJECT NAME: **Moretown-Newport Town VT100**
PROJECT NUMBER: **STPG SIGN(28)**

FILE NAME: **Waterburv.xls** PLOT DATE: **9/17/2009**
PROJECT MANAGER: **N. Avery** DRAWN BY: **I. Shea**
DESIGNED BY: **D. Crosslev** CHECKED BY: **N. Avery**
WATERBURY SHEET 12 SHEET **44** OF **166**

DIRECTION	MILEPOINT	LOCATION CODE (SHEET 2)	SIGN CODE	WIDTH (IN)	HEIGHT (IN)	SHEETING REMARKS	SIGN LEGEND	NEW SIGNS "A"	NEW SIGNS "B"	EXISTING SIGNS RETAIN	EXISTING SIGNS SALVAGE FROM	EXISTING SIGNS SALVAGE TO	EXISTING SIGNS REMOVE	EXIST POST RETAIN	EXIST POST REMOVE	NUMBER OF NEW POSTS	SQUARE STEEL (IN) 1.75 (LB / FT) 1.88	SQUARE STEEL (IN) 2.00 (LB / FT) 2.42	SQUARE STEEL (IN) 2.50 (LB / FT) 3.35	TUBULAR STEEL Ø (IN) FOUNDATION	TUBULAR STEEL Ø (IN) 3.00 (LB / FT) 7.60	TUBULAR STEEL Ø (IN) 3.50 (LB / FT) 9.00	TUBULAR STEEL Ø (IN) 4.00 (LB / FT) 10.80	TUBULAR STEEL Ø (IN) 5.00 (LB / FT) 14.60	SIGN FRAME REQUIRED	REMARKS	SIGN DETAIL DETAIL IN SHS	SIGN DETAIL DETAIL ON SHEET NUMBER	SIGN DETAIL DETAIL ON STD SHEET NUMBER
WATERBURY VT 100							FY-FLUORESCENT YELLOW FYG-FLUORESCENT YELLOW GREEN																			"SHS"-STANDARD HIGHWAY SIGNS			
		F	W16-8A	24	18		SPRUCE HAVEN RD			1						1		X										
SB	5.283	F	W11-3	30	30		DEER CROSSING TEXT 						1		X													
		F	W11-3	30	30			6.25								1		X									X	
SB	4.900	F	VW-205	30	30		WATCH FOR TURNING VEHICLES						1		X													
SB	4.844	F	VD-062AS	72	16		BUSINESS SIGN			1				X														
		F	VD-062AS	72	16		BUSINESS SIGN			1																		
		F	VD-062B	72	16		BUSINESS SIGN			1																		
SB	4.600	F	W2-2L	30	30		LEFT SIDE ROAD						1		X													
SB	4.540	F	W2-2MaL	30	30			6.25								1		X									INSTALL 300' +/- SOUTH OF ORIGINAL SIGN LOCATION		6	
			W16-8	30	8			1.67																				6
SB	4.386	F	VD-062B	72	16		BUSINESS SIGN			1				X														
		F	VD-062B	72	16		BUSINESS SIGN			1																		
SB	4.266	E	VR-072	24	30		THINK NO DRINK			1				X														
		F	VR-072	24	30		THINK NO DRINK			1																		
SB	4.188	G	VR-017	24	24								1		X												GREGG HILL RD TH-11		
							SHEET TOTALS	14.17	0.00	8	0	0	4	0	0	3		45										
								SF	SF	EA	EA	EA	EA	EA	EA	EA		FT										
							TOWN TOTALS	622.8	0.0	89.0	5.0	5.0	115	2.0	0.0	105		1575.0										

SIGN SUMMARY SHEET

VERMONT AGENCY OF TRANSPORTATION

PROJECT NAME: **Moretown-Newport Town VT100**
PROJECT NUMBER: **STPG SIGN(28)**

FILE NAME: **Waterburv.xls**
PROJECT MANAGER: **N. Avery**
DESIGNED BY: **D. Crossley**
WATERBURY SHEET 13

PLOT DATE: **9/17/2009**
DRAWN BY: **I. Shea**
CHECKED BY: **N. Avery**
SHEET **45** OF **166**

DIRECTION	MILEPOINT	LOCATION CODE (SHEET 2)	SIGN CODE	WIDTH (IN)	HEIGHT (IN)	SHEETING REMARKS	SIGN LEGEND	NEW SIGNS "A"	NEW SIGNS "B"	EXISTING SIGNS RETAIN	EXISTING SIGNS SALVAGE FROM	EXISTING SIGNS SALVAGE TO	EXISTING SIGNS REMOVE	EXIST POST RETAIN	EXIST POST REMOVE	NUMBER OF NEW POSTS	SQUARE STEEL (IN) 1.75 (LB/FT) 1.88	SQUARE STEEL (IN) 2.00 (LB/FT) 2.42	SQUARE STEEL (IN) 2.50 (LB/FT) 3.35	TUBULAR STEEL Ø (IN) FOUNDATION	TUBULAR STEEL Ø (IN) 3.00 (LB/FT) 7.60	TUBULAR STEEL Ø (IN) 3.50 (LB/FT) 9.00	TUBULAR STEEL Ø (IN) 4.00 (LB/FT) 10.80	TUBULAR STEEL Ø (IN) 5.00 (LB/FT) 14.60	SIGN FRAME REQUIRED	REMARKS	SIGN DETAIL: DETAIL IN SHS	SIGN DETAIL: DETAIL ON SHEET NUMBER	SIGN DETAIL: DETAIL ON STD SHEET NUMBER
WATERBURY VT 100							FY-FLUORESCENT YELLOW FYG-FLUORESCENT YELLOW GREEN																			"SHS"-STANDARD HIGHWAY SIGNS			
		G	VR-017	24	30			5.00								1		X									E-141
SB	4.180	H	R1-1	24	24								1		X											GREGG HILL RD TH-11			
		H	R1-1	30	30			6.25								1		X								X		
SB	3.945	F	W3-5	36	36		SPEED REDUCTION SPEED LIMIT 35			1				X														
SB	3.905	F	VD-018	30	18		WATERBURY CENTER WATERBURY 2			1				X														
SB	3.883	F	VW-054R	30	30		HIDDEN DRIVE RIGHT						1		X													
SB	3.856	F	R2-1	24	30								1		X													
		F	R2-1	30	36			7.50								1		X									6	
SB	3.811	F	VW-205	36	36		WATCH FOR TURNING VEHICLES			1				X														
SB	3.708	F	W1-10R	30	30		MODIFIED RIGHT CURVE			1				X														
		F	W16-8A	24	8		HOLLOW RD			1																		
SB	3.684	F	S3-1	30	30		SCHOOL BUS STOP AHEAD			1				X														
SB	3.676	G	VR-017	24	24								1		X											SUNSET DR TH-39			
		G	VR-017	24	30			5.00								1		X										E-141
SB	3.670	H	R1-1	24	24								1		X											SUNSET DR TH-39		
							SHEET TOTALS	23.75	0.00	6	0	0	5	0	0	4		60										
								SF	SF	EA	EA	EA	EA	EA	EA	EA		FT										
							TOWN TOTALS	622.8	0.0	89.0	5.0	5.0	115	2.0	0.0	105		1575.0										

SIGN SUMMARY SHEET

VERMONT AGENCY OF TRANSPORTATION

PROJECT NAME: **Moretown-Newport Town VT100**
PROJECT NUMBER: **STPG SIGN(28)**

FILE NAME: **Waterburv.xls** PLOT DATE: **9/17/2009**
PROJECT MANAGER: **N. Avery** DRAWN BY: **I. Shea**
DESIGNED BY: **D. Crosslev** CHECKED BY: **N. Avery**
WATERBURY SHEET 14 SHEET **46** OF **166**

DIRECTION	MILEPOINT	LOCATION CODE (SHEET 2)	SIGN CODE	WIDTH (IN)	HEIGHT (IN)	SHEETING REMARKS	SIGN LEGEND	NEW SIGNS "A"	NEW SIGNS "B"	EXISTING SIGNS RETAIN	EXISTING SIGNS SALVAGE FROM	EXISTING SIGNS SALVAGE TO	EXISTING SIGNS REMOVE	EXIST POST RETAIN	EXIST POST REMOVE	NUMBER OF NEW POSTS	SQUARE STEEL (IN) (LB / FT) 1.75 / 1.88	SQUARE STEEL (IN) (LB / FT) 2.00 / 2.42	SQUARE STEEL (IN) (LB / FT) 2.50 / 3.35	TUBULAR STEEL Ø (IN) FOUNDATION	TUBULAR STEEL Ø (IN) (LB / FT) 3.00 / 7.60	TUBULAR STEEL Ø (IN) (LB / FT) 3.50 / 9.00	TUBULAR STEEL Ø (IN) (LB / FT) 4.00 / 10.80	TUBULAR STEEL Ø (IN) (LB / FT) 5.00 / 14.60	SIGN FRAME REQUIRED	REMARKS	SIGN DETAIL: DETAIL IN SHS	SIGN DETAIL: DETAIL ON SHEET NUMBER	SIGN DETAIL: DETAIL ON STD SHEET NUMBER
WATERBURY VT 100							FY-FLUORESCENT YELLOW FYG-FLUORESCENT YELLOW GREEN																			"SHS"-STANDARD HIGHWAY SIGNS			
		H	R1-1	30	30			6.25								1		X								X		
SB	3.540	F	R2-1	24	30		SPEED LIMIT 35			1				X														
SB	3.475	G	VR-017	24	24		LEGAL LOAD LIMIT 24,000 LBS						1		X												LAKE VIEW TER. TH-73			
		H	R1-1	24	24		STOP						1		X														
		G	VR-017	24	30			~~5.00~~								1		X										E-141
SB	3.468	H	R1-1	24	24								1		X												LAKE VIEW TER. TH-73			
		H	R1-1	30	30			6.25								1		X								INSTALL NEW SIGN 10' BACK FROM EXISTING SIGN LOCATION	X		
SB	3.456	F	W1-10 L	36	36		MODIFIED CROSSROAD			1				X														
		F	W16-8A	48	15		<--- RESERVOIR RD HOWARD AVE ===>			1																		
SB	3.436	F	R2-1	24	30			5.00					I		X	1		X										
SB	3.414	F	VD-062B	72	16		BUSINESS SIGN			1				X														
		F	VD-062AL	72	16		BUSINESS SIGN			1																		
		F	VD-062B	72	16		BUSINESS SIGN			1																		
SB	3.335	G	VR-017	24	24								1		X												RESERVOIR RD TH-17			
		G	VR-017	24	30			5.00								1		X										E-141
SIGN SUMMARY SHEET							SHEET TOTALS	27.50	0.00	6	0	0	4	0	0	5		75										
								SF	SF	EA	EA	EA	EA	EA	EA	EA		FT										
VERMONT AGENCY OF TRANSPORTATION							TOWN TOTALS	622.8	0.0	89.0	5.0	5.0	115	2.0	0.0	105		1575.0										

PROJECT NAME: **Moretown-Newport Town VT100**
PROJECT NUMBER: **STPG SIGN(28)**

FILE NAME: **Waterburv.xls**
PROJECT MANAGER: **N. Avery**
DESIGNED BY: **D. Crossley**
WATERBURY SHEET 15

PLOT DATE: **9/17/2009**
DRAWN BY: **I. Shea**
CHECKED BY: **N. Avery**
SHEET **47** OF **166**

DIRECTION	MILEPOINT	LOCATION CODE (SHEET 2)	SIGN CODE	WIDTH (IN)	HEIGHT (IN)	SHEETING REMARKS	SIGN LEGEND	NEW SIGNS "A"	NEW SIGNS "B"	EXISTING SIGNS RETAIN	EXISTING SIGNS SALVAGE FROM	EXISTING SIGNS SALVAGE TO	EXISTING SIGNS REMOVE	EXIST POST RETAIN	EXIST POST REMOVE	NUMBER OF NEW POSTS	SQUARE STEEL (IN) 1.75 (LB / FT) 1.88	SQUARE STEEL (IN) 2.00 (LB / FT) 2.42	SQUARE STEEL (IN) 2.50 (LB / FT) 3.35	TUBULAR STEEL Ø (IN) FOUNDATION	TUBULAR STEEL Ø (IN) 3.00 (LB / FT) 7.60	TUBULAR STEEL Ø (IN) 3.50 (LB / FT) 9.00	TUBULAR STEEL Ø (IN) 4.00 (LB / FT) 10.80	TUBULAR STEEL Ø (IN) 5.00 (LB / FT) 14.60	SIGN FRAME REQUIRED	REMARKS	SIGN DETAIL: DETAIL IN SHS	SIGN DETAIL: DETAIL ON SHEET NUMBER	SIGN DETAIL: DETAIL ON STD SHEET NUMBER
WATERBURY VT 100							FY-FLUORESCENT YELLOW FYG-FLUORESCENT YELLOW GREEN																			"SHS"-STANDARD HIGHWAY SIGNS			
SB	3.344	H	R1-1	24	24								1		X											RESERVOIR RD TH-17			
		H	R1-1	30	30			6.25								1		X									X		
SB	3.266	F	M4-5I	24	12		TO			1				X															
		F	M1-1	24	24		INTERSTATE 89			1																			
		F	M6-3I	21	15		^UP ARROW			1																			
SB	3.199	F	S3-1	30	30		SCHOOL BUS STOP AHEAD			1				X															
SB	3.161	F	R2-1	24	30		SPEED LIMIT 40			1				X															
SB	3.118	F	VW-054L	30	30		HIDDEN DRIVE LEFT						1		X														
SB	3.098	F	VW-054L	30	30			6.25								1		X									INSTALL 100 ' +/- SOUTH OF ORIGINAL SIGN LOCATION			E-154
SB	2.915	F	VD-062B	72	16		BUSINESS SIGN			1				X															
		F	VD-062B	72	16		BUSINESS SIGN			1																			
SB	2.876	F	R4-1	24	30		DO NOT PASS			1				X															
SB	2.581	F	R2-1	24	30		SPEED LIMIT 50				1	1			X	2		X											
		E	W14-3	48	36		NO PASSING ZONE				1	1																	
SB	2.326	F	VW-054R	30	30		HIDDEN DRIVE RIGHT						1		X														
							SHEET TOTALS	12.50	0.00	8	2	2	3	0	0	4		60										
								SF	SF	EA	EA	EA	EA	EA	EA	EA		FT										
							TOWN TOTALS	622.8	0.0	89.0	5.0	5.0	115	2.0	0.0	105		1575.0										

SIGN SUMMARY SHEET

VERMONT AGENCY OF TRANSPORTATION

PROJECT NAME: **Moretown-Newport Town VT100**
PROJECT NUMBER: **STPG SIGN(28)**

FILE NAME: **Waterburv.xls** PLOT DATE: **9/17/2009**
PROJECT MANAGER: **N. Avery** DRAWN BY: **I. Shea**
DESIGNED BY: **D. Crosslev** CHECKED BY: **N. Avery**
WATERBURY SHEET 16

DIRECTION	MILEPOINT	LOCATION CODE (SHEET 2)	SIGN CODE	WIDTH (IN)	HEIGHT (IN)	SHEETING REMARKS	SIGN LEGEND	NEW SIGNS "A"	NEW SIGNS "B"	EXISTING SIGNS RETAIN	EXISTING SIGNS SALVAGE FROM	EXISTING SIGNS SALVAGE TO	EXISTING SIGNS REMOVE	EXIST POST RETAIN	EXIST POST REMOVE	NUMBER OF NEW POSTS	SQUARE STEEL (IN) 1.75 (LB / FT) 1.88	SQUARE STEEL (IN) 2.00 (LB / FT) 2.42	SQUARE STEEL (IN) 2.50 (LB / FT) 3.35	TUBULAR STEEL Ø (IN) FOUNDATION	TUBULAR STEEL Ø (IN) 3.00 (LB / FT) 7.60	TUBULAR STEEL Ø (IN) 3.50 (LB / FT) 9.00	TUBULAR STEEL Ø (IN) 4.00 (LB / FT) 10.80	TUBULAR STEEL Ø (IN) 5.00 (LB / FT) 14.60	SIGN FRAME REQUIRED	REMARKS	SIGN DETAIL: DETAIL IN SHS	SIGN DETAIL: DETAIL ON SHEET NUMBER	SIGN DETAIL: DETAIL ON STD SHEET NUMBER
WATERBURY VT 100							FY-FLUORESCENT YELLOW FYG-FLUORESCENT YELLOW GREEN																			"SHS"-STANDARD HIGHWAY SIGNS			
SB	2.223	F	VW-205	36	36		WATCH FOR TURNING VEHICLES	9.00					1		X	2													
		F	W13-1	18	18		40 MPH PLAQUE						1																
SB	2.143	F	VW-205	36	36			9.00								2		X								INSTALL 400' +/- SOUTH OF ORIGINAL SIGN LOCATION			E-154
		F	W13-1	24	24			4.00																			X		
SB	1.949	F	W3-5	36	36		SPEED REDUCTION SPEED LIMIT 40	9.00					1		X	2		X									X		
SB	1.906	F	VD-062AS	72	16		BUSINESS SIGN			1				X															
		F	VD-062B	72	16		BUSINESS SIGN			1																			
SB	1.812	F	VD-062B	72	16		BUSINESS SIGN			1				X															
		F	VD-062AS	72	16		BUSINESS SIGN			1																			
SB	1.775	F	R2-1	24	30		SPEED LIMIT 40						1		X														
		F	R2-1	30	36			7.50								1		X											6
SB	1.736	F	VD-062C	74.75	16		BUSINESS SIGN			1				X															
		F	VD-062BC	74.75	16		BUSINESS SIGN			1																			
SB	1.612	F	R2-1	24	30								1		X														
SIGN SUMMARY SHEET							SHEET TOTALS	29.50	0.00	7	0	0	4	0	0	5		75									
								SF	SF	EA	EA	EA	EA	EA	EA	EA		FT									
VERMONT AGENCY OF TRANSPORTATION							TOWN TOTALS	622.8	0.0	89.0	5.0	5.0	115	2.0	0.0	105		1575.0									

PROJECT NAME: **Moretown-Newport Town VT100**
PROJECT NUMBER: **STPG SIGN(28)**

FILE NAME: **Waterburv.xls** PLOT DATE: **9/17/2009**
PROJECT MANAGER: **N. Avery** DRAWN BY: **I. Shea**
DESIGNED BY: **D. Crosslev** CHECKED BY: **N. Avery**
WATERBURY SHEET 17 SHEET **49** OF **166**

DIRECTION	MILEPOINT	LOCATION CODE (SHEET 2)	SIGN CODE	WIDTH (IN)	HEIGHT (IN)	SHEETING REMARKS	SIGN LEGEND	NEW SIGNS "A"	NEW SIGNS "B"	EXISTING SIGNS RETAIN	EXISTING SIGNS SALVAGE FROM	EXISTING SIGNS SALVAGE TO	EXISTING SIGNS REMOVE	EXIST POST RETAIN	EXIST POST REMOVE	NUMBER OF NEW POSTS	SQUARE STEEL (IN) 1.75 (LB / FT) 1.88	SQUARE STEEL (IN) 2.00 (LB / FT) 2.42	SQUARE STEEL (IN) 2.50 (LB / FT) 3.35	TUBULAR STEEL Ø (IN) FOUNDATION	TUBULAR STEEL Ø (IN) 3.00 (LB / FT) 7.60	TUBULAR STEEL Ø (IN) 3.50 (LB / FT) 9.00	TUBULAR STEEL Ø (IN) 4.00 (LB / FT) 10.80	TUBULAR STEEL Ø (IN) 5.00 (LB / FT) 14.60	SIGN FRAME REQUIRED	REMARKS	SIGN DETAIL: DETAIL IN SHS	SIGN DETAIL: DETAIL ON SHEET NUMBER	SIGN DETAIL: DETAIL ON STD SHEET NUMBER
WATERBURY VT 100							FY-FLUORESCENT YELLOW FYG-FLUORESCENT YELLOW GREEN																			"SHS"-STANDARD HIGHWAY SIGNS			
		F	R2-1	24	30			5.00								1		X								X		
SB	1.526	F	VW-054R	30	30								1		X														
		F	VW-054R	30	30			6.25								1		X										E-154
SB	1.425	F	R2-1	24	30								1		X														
		F	R2-1	24	30			5.00								1		X								X		
SB	1.374	F	VD-062AS	72	16		BUSINESS SIGN			1				X														
		F	VD-062B	72	16		BUSINESS SIGN			1																		
SB	1.269	F	VW-205	36	36								1		X														
		F	S3-1	30	30								1															
		F	VW-205	36	36			9.00								2			X						INSTALL SIGNS ON SAME SIGN POSTS			E-154
		F	S3-1	36	36			9.00																			X	
SB	1.248	F	R2-1	24	30								1		X														
		F	R2-1	30	36			7.50								1		X							INSTALL ACROSS FROM NORTHBOUND SPEED LIMIT 40		6	
SB	1.143	G	VR-017	24	30		LEGAL LOAD LIMIT 24,000 LBS			1				X											CROSSROAD TH-15			
SB	1.135	H	R1-1	24	24								1		X										CROSSROAD TH-15			
							SHEET TOTALS	41.75 SF	0.00 SF	3 EA	0 EA	0 EA	6 EA	0 EA	0 EA	6 EA		90 FT											
							TOWN TOTALS	622.8	0.0	89.0	5.0	5.0	115	2.0	0.0	105		1575.0										

SIGN SUMMARY SHEET

VERMONT AGENCY OF TRANSPORTATION

PROJECT NAME: **Moretown-Newport Town VT100**
PROJECT NUMBER: **STPG SIGN(28)**

FILE NAME: **Waterburv.xls**
PROJECT MANAGER: **N. Avery**
DESIGNED BY: **D. Crossley**
WATERBURY SHEET 18

PLOT DATE: **9/17/2009**
DRAWN BY: **I. Shea**
CHECKED BY: **N. Avery**
SHEET **50** OF **166**

DIRECTION	MILEPOINT	LOCATION CODE (SHEET 2)	SIGN CODE	WIDTH (IN)	HEIGHT (IN)	SHEETING REMARKS	SIGN LEGEND	NEW SIGNS "A"	NEW SIGNS "B"	EXISTING SIGNS RETAIN	EXISTING SIGNS SALVAGE FROM	EXISTING SIGNS SALVAGE TO	EXISTING SIGNS REMOVE	EXIST POST RETAIN	EXIST POST REMOVE	NUMBER OF NEW POSTS	SQUARE STEEL (IN) 1.75 (LB / FT) 1.88	SQUARE STEEL (IN) 2.00 (LB / FT) 2.42	SQUARE STEEL (IN) 2.50 (LB / FT) 3.35	TUBULAR STEEL Ø (IN) FOUNDATION	TUBULAR STEEL Ø (IN) 3.00 (LB / FT) 7.60	TUBULAR STEEL Ø (IN) 3.50 (LB / FT) 9.00	TUBULAR STEEL Ø (IN) 4.00 (LB / FT) 10.80	TUBULAR STEEL Ø (IN) 5.00 (LB / FT) 14.60	SIGN FRAME REQUIRED	REMARKS	SIGN DETAIL: DETAIL IN SHS	SIGN DETAIL: DETAIL ON SHEET NUMBER	SIGN DETAIL: DETAIL ON STD SHEET NUMBER
WATERBURY VT 100							FY-FLUORESCENT YELLOW FYG-FLUORESCENT YELLOW GREEN																			"SHS"-STANDARD HIGHWAY SIGNS			
		H	R1-1	30	30			6.25								1		X								X		
SB	1.113	F	R2-1	24	30								1		X														
		F	R2-1	24	30			5.00								1		X								X		
SB	0.980	F	VD-062B	72	16		BUSINESS SIGN			1				X															
		F	VD-062B	72	16		BUSINESS SIGN			1																			
		F	VD-062AS	72	16		BUSINESS SIGN			1																			
SB	0.943	F	W3-3	36	36		SIGNAL AHEAD			1				X															
SB	0.914	F	R2-1	24	30								1		X														
		F	R2-1	24	30			5.00								1		X								X		
SB	0.887	F	VR-921L	30	30								1		X														
		F	VR-921L	30	30			6.25								1		X										E-145A
SB	0.847	N	R10-12	24	30								1																
		N	R10-12	24	30			5.00																			INSTALL ON SIGNAL LIGHT CANTILEVER	X		
SB	0.824	F	VR-644	24	12								1		X														
		F	R3-9B	24	36								1																
							SHEET TOTALS	27.50	0.00	4	0	0	6	0	0	4		60										
								SF	SF	EA	EA	EA	EA	EA	EA	EA		FT										
							TOWN TOTALS	622.8	0.0	89.0	5.0	5.0	115	2.0	0.0	105		1575.0										

SIGN SUMMARY SHEET

VERMONT AGENCY OF TRANSPORTATION

PROJECT NAME: **Moretown-Newport Town VT100**
PROJECT NUMBER: **STPG SIGN(28)**


FILE NAME: **Waterburv.xls** PLOT DATE: **9/17/2009**
PROJECT MANAGER: **N. Avery** DRAWN BY: **I. Shea**
DESIGNED BY: **D. Crosslev** CHECKED BY: **N. Avery**
WATERBURY SHEET 19 SHEET **51** OF **166**

DIRECTION	MILEPOINT	LOCATION CODE (SHEET 2)	SIGN CODE	WIDTH (IN)	HEIGHT (IN)	SHEETING REMARKS	SIGN LEGEND	NEW SIGNS "A"	NEW SIGNS "B"	EXISTING SIGNS RETAIN	EXISTING SIGNS SALVAGE FROM	EXISTING SIGNS SALVAGE TO	EXISTING SIGNS REMOVE	EXIST POST RETAIN	EXIST POST REMOVE	NUMBER OF NEW POSTS	SQUARE STEEL (IN) 1.75 (LB / FT) 1.88	SQUARE STEEL (IN) 2.00 (LB / FT) 2.42	SQUARE STEEL (IN) 2.50 (LB / FT) 3.35	TUBULAR STEEL Ø (IN) FOUNDATION	TUBULAR STEEL Ø (IN) 3.00 (LB / FT) 7.60	TUBULAR STEEL Ø (IN) 3.50 (LB / FT) 9.00	TUBULAR STEEL Ø (IN) 4.00 (LB / FT) 10.80	TUBULAR STEEL Ø (IN) 5.00 (LB / FT) 14.60	SIGN FRAME REQUIRED	REMARKS	SIGN DETAIL: DETAIL IN SHS	SIGN DETAIL: DETAIL ON SHEET NUMBER	SIGN DETAIL: DETAIL ON STD SHEET NUMBER
WATERBURY VT 100							FY-FLUORESCENT YELLOW FYG-FLUORESCENT YELLOW GREEN																			"SHS"-STANDARD HIGHWAY SIGNS			
		F	VR-644	24	12			2.00								1		X								BLACK ON WHITE SHEETING		6	
		F	R3-9B	24	36			6.00																				X		
SB	0.744	F	M4-6	24	12								1		X															
		F	R3-9B	24	36								1																
		F	M4-6	24	12			2.00								1		X								BLACK ON WHITE SHEETING	X		
		F	R3-9B	24	36			6.00																			X		
SB	0.740												I		X														
SB	0.729	F	VR-922MR	36	30								1		X														
		F	D4-2	30	36								1																
		F	VR-922R	36	30			7.50								2		X										E-145A
		F	D4-2	24	30			5.00																		LEFT ARROW. INSTALL ON LEFT POST	X		
SB	0.710	G	VR-017	24	30								1		X												BLUSH HILL RD TH-2			
		G	VR-017	24	30			5.00								1		X										E-141
SB	0.696	N	R10-12	30	30								1																
		N	R10-12	30	30			6.25																		INSTALL ON SPAN WIRE	X		
			SIGNS FROM MP 0.697 TO SB MP 0.130 PART OF INTERSTATE SIGN PROJECT																										
							SHEET TOTALS	39.75 SF	0.00 SF	0 EA	0 EA	0 EA	6 EA	0 EA	0 EA	5 EA	75 FT												
							TOWN TOTALS	622.8	0.0	89.0	5.0	5.0	115	2.0	0.0	105	1575.0												

SIGN SUMMARY SHEET


VERMONT AGENCY OF TRANSPORTATION

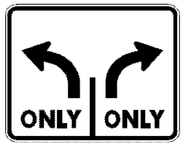PROJECT NAME: **Moretown-Newport Town VT100**
PROJECT NUMBER: **STPG SIGN(28)**
FILE NAME: **Waterburv.xls**
PROJECT MANAGER: **N. Avery**
DESIGNED BY: **D. Crossley**
WATERBURY SHEET 20
PLOT DATE: **9/17/2009**
DRAWN BY: **I. Shea**
CHECKED BY: **N. Avery**
SHEET **52** OF **166**

DIRECTION	MILEPOINT	LOCATION CODE (SHEET 2)	SIGN CODE	WIDTH (IN)	HEIGHT (IN)	SHEETING REMARKS	SIGN LEGEND	NEW SIGNS "A"	NEW SIGNS "B"	EXISTING SIGNS RETAIN	EXISTING SIGNS SALVAGE FROM	EXISTING SIGNS SALVAGE TO	EXISTING SIGNS REMOVE	EXIST POST RETAIN	EXIST POST REMOVE	NUMBER OF NEW POSTS	SQUARE STEEL (IN) 1.75 (LB/FT) 1.88	SQUARE STEEL (IN) 2.00 (LB/FT) 2.42	SQUARE STEEL (IN) 2.50 (LB/FT) 3.35	TUBULAR STEEL Ø (IN) FOUNDATION	TUBULAR STEEL Ø (IN) 3.00 (LB/FT) 7.60	TUBULAR STEEL Ø (IN) 3.50 (LB/FT) 9.00	TUBULAR STEEL Ø (IN) 4.00 (LB/FT) 10.80	TUBULAR STEEL Ø (IN) 5.00 (LB/FT) 14.60	SIGN FRAME REQUIRED	REMARKS	SIGN DETAIL: DETAIL IN SHS	SIGN DETAIL: DETAIL ON SHEET NUMBER	SIGN DETAIL: DETAIL ON STD SHEET NUMBER
WATERBURY VT 100							FY-FLUORESCENT YELLOW FYG-FLUORESCENT YELLOW GREEN																			"SHS"-STANDARD HIGHWAY SIGNS			
SB	0.134	F	W12-2	30	30								1		X													
		F	W16-5	24	12								1														
		F	W12-2	30	30			6.25								1		X								X		
		F	W16-5	24	12			2.00																		X		
SB	0.111	F	VD-062BC	72	16		BUSINESS SIGN			1				X														
		F	VD-062C	72	16		BUSINESS SIGN			1																		
SB	0.069	F	VR-925	36	30								1		X													
		F	VR-925	36	30			7.50								2		X										E-145A
SB	0.062	F	M3-2	24	12								1		X													
		F	M1-4	24	24								1															
		F	M6-1S	21	15								1															
		F	M3-3S	24	12								1															
		F	M1-5	30	24								1															
		F	M6-1	21	15								1															
		F	M3-4	24	12								1															
SIGN SUMMARY SHEET							SHEET TOTALS	15.75	0.00	2	0	0	10	0	0	3	45										
								SF	SF	EA	EA	EA	EA	EA	EA	EA	FT										
VERMONT AGENCY OF TRANSPORTATION							TOWN TOTALS	622.8	0.0	89.0	5.0	5.0	115	2.0	0.0	105	1575.0										

PROJECT NAME: **Moretown-Newport Town VT100**
PROJECT NUMBER: **STPG SIGN(28)**

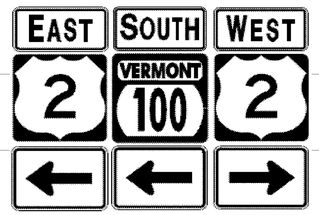FILE NAME: **Waterburv.xls** PLOT DATE: **9/17/2009**
PROJECT MANAGER: **N. Avery** DRAWN BY: **I. Shea**
DESIGNED BY: **D. Crossley** CHECKED BY: **N. Avery**
WATERBURY SHEET 21 SHEET **53** OF **166**

DIRECTION	MILEPOINT	LOCATION CODE (SHEET 2)	SIGN CODE	WIDTH (IN)	HEIGHT (IN)	SHEETING REMARKS	SIGN LEGEND	NEW SIGNS "A"	NEW SIGNS "B"	EXISTING SIGNS RETAIN	EXISTING SIGNS SALVAGE FROM	EXISTING SIGNS SALVAGE TO	EXISTING SIGNS REMOVE	EXIST POST RETAIN	EXIST POST REMOVE	NUMBER OF NEW POSTS	SQUARE STEEL (IN) 1.75 (LB / FT) 1.88	SQUARE STEEL (IN) 2.00 (LB / FT) 2.42	SQUARE STEEL (IN) 2.50 (LB / FT) 3.35	TUBULAR STEEL Ø (IN) FOUNDATION	TUBULAR STEEL Ø (IN) 3.00 (LB / FT) 7.60	TUBULAR STEEL Ø (IN) 3.50 (LB / FT) 9.00	TUBULAR STEEL Ø (IN) 4.00 (LB / FT) 10.80	TUBULAR STEEL Ø (IN) 5.00 (LB / FT) 14.60	SIGN FRAME REQUIRED	REMARKS	SIGN DETAIL: DETAIL IN SHS	SIGN DETAIL: DETAIL ON SHEET NUMBER	SIGN DETAIL: DETAIL ON STD SHEET NUMBER
WATERBURY VT 100							FY-FLUORESCENT YELLOW FYG-FLUORESCENT YELLOW GREEN																			"SHS"-STANDARD HIGHWAY SIGNS			
		F	M1-4	24	24								1															
		F	M6-1	21	15								1															
		F	M3-2	24	12			2.00								2			X						3B		X	
		F	M1-4	24	24			4.00																			X	
		F	M6-1L	21	15			2.19																			X	
		F	M3-3	24	12			2.00																		GREEN ON WHITE SHEETING	X		
		F	M1-5	30	24			5.00																				E-136B
		F	M6-1L	21	15			2.19																		GREEN ON WHITE SHEETING	X		
		F	M3-4	24	12			2.00																			X	
		F	M1-4	24	24			4.00																			X	
		F	M6-1R	21	15			2.19																			X	
SB	0.035	F	VR-040	24	24		THROUGH WAY ENDS HERE						1		X													
		F	N/A				TOWN PARKING ORDNANCE						1													RETURN SIGN TO TOWN			
SB	0.006	F	R1-1	30	30								1		X													
		E	R5-1	30	30								1															
							SHEET TOTALS	25.57 SF	0.00 SF	0 EA	0 EA	0 EA	6 EA	0 EA	0 EA	2 EA			30 FT									
							TOWN TOTALS	622.8	0.0	89.0	5.0	5.0	115	2.0	0.0	105			1575.0									

SIGN SUMMARY SHEET

VERMONT AGENCY OF TRANSPORTATION


PROJECT NAME: **Moretown-Newport Town VT100**
PROJECT NUMBER: **STPG SIGN(28)**

FILE NAME: **Waterburv.xls** PLOT DATE: **9/17/2009**
PROJECT MANAGER: **N. Avery** DRAWN BY: **I. Shea**
DESIGNED BY: **D. Crosslev** CHECKED BY: **N. Avery**
WATERBURY SHEET 22 SHEET **54** OF **166**

DIRECTION	MILEPOINT	LOCATION CODE (SHEET 2)	SIGN CODE	WIDTH (IN)	HEIGHT (IN)	SHEETING REMARKS	SIGN LEGEND	NEW SIGNS "A"	NEW SIGNS "B"	EXISTING SIGNS RETAIN	EXISTING SIGNS SALVAGE FROM	EXISTING SIGNS SALVAGE TO	EXISTING SIGNS REMOVE	EXIST POST RETAIN	EXIST POST REMOVE	NUMBER OF NEW POSTS	SQUARE STEEL (IN) 1.75 (LB / FT) 1.88	SQUARE STEEL (IN) 2.00 (LB / FT) 2.42	SQUARE STEEL (IN) 2.50 (LB / FT) 3.35	TUBULAR STEEL Ø (IN) FOUNDATION	TUBULAR STEEL Ø (IN) 3.00 (LB / FT) 7.60	TUBULAR STEEL Ø (IN) 3.50 (LB / FT) 9.00	TUBULAR STEEL Ø (IN) 4.00 (LB / FT) 10.80	TUBULAR STEEL Ø (IN) 5.00 (LB / FT) 14.60	SIGN FRAME REQUIRED	REMARKS	SIGN DETAIL: DETAIL IN SHS	SIGN DETAIL: DETAIL ON SHEET NUMBER	SIGN DETAIL: DETAIL ON STD SHEET NUMBER
WATERBURY VT 100							FY-FLUORESCENT YELLOW FYG-FLUORESCENT YELLOW GREEN																			"SHS"-STANDARD HIGHWAY SIGNS			
		F	R1-1	30	30			6.25								1		X								INSTALL SIGNS BACK TO BACK	X		
		E	R5-1	30	30			6.25																			X		
SIGN SUMMARY SHEET							SHEET TOTALS	12.50	0.00	0	0	0	0	0	0	1		15										
								SF	SF	EA	EA	EA	EA	EA	EA	EA		FT										
VERMONT AGENCY OF TRANSPORTATION							TOWN TOTALS	622.8	0.0	89.0	5.0	5.0	115	2.0	0.0	105		1575.0										

PROJECT NAME: **Moretown-Newport Town VT100**
PROJECT NUMBER: **STPG SIGN(28)**

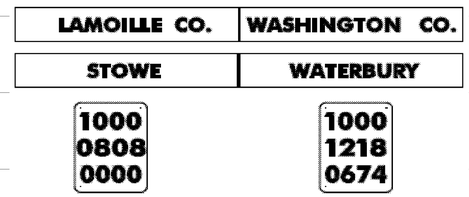FILE NAME: **Waterburv.xls** PLOT DATE: **9/17/2009**
PROJECT MANAGER: **N. Avery** DRAWN BY: **I. Shea**
DESIGNED BY: **D. Crosslev** CHECKED BY: **N. Avery**
WATERBURY SHEET 23 SHEET **55** OF **166**

DIRECTION	MILEPOINT	LOCATION CODE (SHEET 2)	SIGN CODE	WIDTH (IN)	HEIGHT (IN)	SHEETING REMARKS	SIGN LEGEND	NEW SIGNS "A"	NEW SIGNS "B"	EXISTING SIGNS RETAIN	EXISTING SIGNS SALVAGE FROM	EXISTING SIGNS SALVAGE TO	EXISTING SIGNS REMOVE	EXIST POST RETAIN	EXIST POST REMOVE	NUMBER OF NEW POSTS	SQUARE STEEL (IN) 1.75 (LB / FT) 1.88	SQUARE STEEL (IN) 2.00 (LB / FT) 2.42	SQUARE STEEL (IN) 2.50 (LB / FT) 3.35	TUBULAR STEEL Ø (IN) FOUNDATION	TUBULAR STEEL Ø (IN) 3.00 (LB / FT) 7.60	TUBULAR STEEL Ø (IN) 3.50 (LB / FT) 9.00	TUBULAR STEEL Ø (IN) 4.00 (LB / FT) 10.80	TUBULAR STEEL Ø (IN) 5.00 (LB / FT) 14.60	SIGN FRAME REQUIRED	REMARKS	SIGN DETAIL: DETAIL IN SHS	SIGN DETAIL: DETAIL ON SHEET NUMBER	SIGN DETAIL: DETAIL ON STD SHEET NUMBER
STOWE VT 100							FY-FLUORESCENT YELLOW FYG-FLUORESCENT YELLOW GREEN																			"SHS"-STANDARD HIGHWAY SIGNS			
NB	0.000	C	VD-024	60	7.5								1		X													
		C	VD-025	60	7.5								1															
		C	VD-025	72	12			6.00								2		X								4	
		C	VD-024	72	12			6.00																				4	
		C	VD-700	6	10			0.42																					E-138
		C	VD-700	6	10			0.42																					E-138
NB	0.220	A	VD-062B	72	16		BUSINESS SIGN			1				X														
		A	VD-062AL	72	16		BUSINESS SIGN			1																		
		A	VD-062AL	72	16		BUSINESS SIGN			1																		
NB	0.420	A	VD-062B	72	16		BUSINESS SIGN			1				X														
		A	VD-062AL	72	16		BUSINESS SIGN			1																		
		A	VD-062AL	72	16		BUSINESS SIGN			1																		
NB	0.510	A	VD-062B	72	16		BUSINESS SIGN			1				X														
		A	VD-062AL	72	16		BUSINESS SIGN			1																		
NB	0.720	A	VD-062B	72	16		BUSINESS SIGN			1				X														
							SHEET TOTALS	12.84	0.00	9	0	0	2	0	0	2	30											
								SF	SF	EA	EA	EA	EA	EA	EA	EA	FT											
							TOWN TOTALS	582.8	0.0	65.0	6.0	6.0	105	0.0	0.0	103	1545.0											

SIGN SUMMARY SHEET

VERMONT AGENCY OF TRANSPORTATION

PROJECT NAME: **Moretown-Newport Town VT100**
PROJECT NUMBER: **STPG SIGN(28)**

FILE NAME: **Stowe.xls** PLOT DATE: **9/29/2009**
PROJECT MANAGER: **N. Avery** DRAWN BY: **I. Shea**
DESIGNED BY: **D. Crossley** CHECKED BY: **N. Avery**
STOWE SHEET 1 SHEET **56** OF **166**

DIRECTION	MILEPOINT	LOCATION CODE (SHEET 2)	SIGN CODE	WIDTH (IN)	HEIGHT (IN)	SHEETING REMARKS	SIGN LEGEND	NEW SIGNS "A"	NEW SIGNS "B"	EXISTING SIGNS RETAIN	EXISTING SIGNS SALVAGE FROM	EXISTING SIGNS SALVAGE TO	EXISTING SIGNS REMOVE	EXIST POST RETAIN	EXIST POST REMOVE	NUMBER OF NEW POSTS	SQUARE STEEL (IN) 1.75 (LB / FT) 1.88	SQUARE STEEL (IN) 2.00 (LB / FT) 2.42	SQUARE STEEL (IN) 2.50 (LB / FT) 3.35	TUBULAR STEEL Ø (IN) FOUNDATION	TUBULAR STEEL Ø (IN) 3.00 (LB / FT) 7.60	TUBULAR STEEL Ø (IN) 3.50 (LB / FT) 9.00	TUBULAR STEEL Ø (IN) 4.00 (LB / FT) 10.80	TUBULAR STEEL Ø (IN) 5.00 (LB / FT) 14.60	SIGN FRAME REQUIRED	REMARKS	SIGN DETAIL: DETAIL IN SHS	SIGN DETAIL: DETAIL ON SHEET NUMBER	SIGN DETAIL: DETAIL ON STD SHEET NUMBER
STOWE VT 100							FY-FLUORESCENT YELLOW FYG-FLUORESCENT YELLOW GREEN																			"SHS"-STANDARD HIGHWAY SIGNS			
		A	VD-062AL	72	16		BUSINESS SIGN			1																		
		A	VD-062AL	72	16		BUSINESS SIGN			1																		
NB	0.822	A	D1-1A	72	10								1		X													
		A	D1-1	72	10								1															
		A	VR-474H	30	42		VT 108 THROUGH THE NOTCH - HINGED- CLOSED FOR THE SEASON				1	1														REINSTALL ON LEFT POST			
		A	D1-1A	72	12			6.00								2		X								5	
		A	D1-1	72	12			6.00																				5	
NB	0.885	A	M3-1S	24	12								1		X													
		A	M1-5	30	24								1															
		A	M3-1	24	12			2.00								1		X							GREEN ON WHITE SHEETING	X		
		A	M1-5	30	24			5.00																				E-136B
NB	1.063	A	VD-062C	74.75	16		TRAVEL INFORMATION			1				X														
		A	VD-062BC	74.75	16		TRAVEL INFORMATION			1																		
NB	1.133	A	W3-5	36	36		SPEED REDUCTION SPEED LIMIT 40			1				X														
NB	1.192	A	R2-1	24	30								1		X													
							SHEET TOTALS	19.00	0.00	5	1	1	5	0	0	3		45										
								SF	SF	EA	EA	EA	EA	EA	EA	EA		FT										
							TOWN TOTALS	582.8	0.0	65.0	6.0	6.0	105	0.0	0.0	103		1545.0										

SIGN SUMMARY SHEET

VERMONT AGENCY OF TRANSPORTATION

PROJECT NAME: **Moretown-Newport Town VT100**
PROJECT NUMBER: **STPG SIGN(28)**

FILE NAME: **Stowe.xls**
PROJECT MANAGER: **N. Avery**
DESIGNED BY: **D. Crossley**
STOWE SHEET 2

PLOT DATE: **9/29/2009**
DRAWN BY: **I. Shea**
CHECKED BY: **N. Avery**

DIRECTION	MILEPOINT	LOCATION CODE (SHEET 2)	SIGN CODE	WIDTH (IN)	HEIGHT (IN)	SHEETING REMARKS	SIGN LEGEND	NEW SIGNS "A"	NEW SIGNS "B"	EXISTING SIGNS RETAIN	EXISTING SIGNS SALVAGE FROM	EXISTING SIGNS SALVAGE TO	EXISTING SIGNS REMOVE	EXIST POST RETAIN	EXIST POST REMOVE	NUMBER OF NEW POSTS	SQUARE STEEL (IN) 1.75 (LB / FT) 1.88	SQUARE STEEL (IN) 2.00 (LB / FT) 2.42	SQUARE STEEL (IN) 2.50 (LB / FT) 3.35	TUBULAR STEEL Ø (IN) FOUNDATION	TUBULAR STEEL Ø (IN) 3.00 (LB / FT) 7.60	TUBULAR STEEL Ø (IN) 3.50 (LB / FT) 9.00	TUBULAR STEEL Ø (IN) 4.00 (LB / FT) 10.80	TUBULAR STEEL Ø (IN) 5.00 (LB / FT) 14.60	SIGN FRAME REQUIRED	REMARKS	SIGN DETAIL: DETAIL IN SHS	SIGN DETAIL: DETAIL ON SHEET NUMBER	SIGN DETAIL: DETAIL ON STD SHEET NUMBER
STOWE VT 100							FY-FLUORESCENT YELLOW FYG-FLUORESCENT YELLOW GREEN																			"SHS"-STANDARD HIGHWAY SIGNS			
		A	R2-1	30	36			7.50								1		X									6
NB	1.243	A	VW-205	30	30		WATCH FOR TURNING VEHICLES			1				X														
NB	1.264	C	VR-017	24	24								1		X											SKY ACRES DR TH-91			
		C	VR-017	24	30			5.00								1		X										E-141
NB	1.270	D	R1-1	24	24								1		X											SKY ACRES DR TH-91			
		D	R1-1	30	30			6.25								1		X								X		
NB	1.342	A	W11-1	30	30		BICYCLE SYMBOL			1				X														
		A	W16-1	18	24		SHARE THE ROAD			1																		
NB	1.444	A	R2-1	24	30		SPEED LIMIT 40			1				X														
NB	1.470	A	W1-10L	30	30			6.25								1		X								INSTALL 140' +/- NORTH OF RETAINED SPEED LIMIT 40 SIGN	X		
		A	W16-8A	30	8			1.67																				8
NB	1.505	A	W1-6	48	24		<=== LEFT LARGE ARROW			1				X														
NB	1.520	F	OM-3R	12	36			3.00								1		X									X	
NB	1.525	F	OM-3L	12	36								1		X													
		E	OM-3L	12	36			3.00								1		X									X	
SIGN SUMMARY SHEET							SHEET TOTALS	32.67 SF	0.00 SF	5 EA	0 EA	0 EA	3 EA	0 EA	0 EA	6 EA		90 FT								
VERMONT AGENCY OF TRANSPORTATION							TOWN TOTALS	582.8	0.0	65.0	6.0	6.0	105	0.0	0.0	103		1545.0								

PROJECT NAME: **Moretown-Newport Town VT100**
PROJECT NUMBER: **STPG SIGN(28)**

FILE NAME: **Stowe.xls** PLOT DATE: **9/29/2009**
PROJECT MANAGER: **N. Avery** DRAWN BY: **I. Shea**
DESIGNED BY: **D. Crossley** CHECKED BY: **N. Avery**
STOWE SHEET 3 SHEET **58** OF **166**

DIRECTION	MILEPOINT	LOCATION CODE (SHEET 2)	SIGN CODE	WIDTH (IN)	HEIGHT (IN)	SHEETING REMARKS	SIGN LEGEND	NEW SIGNS "A"	NEW SIGNS "B"	EXISTING SIGNS RETAIN	EXISTING SIGNS SALVAGE FROM	EXISTING SIGNS SALVAGE TO	EXISTING SIGNS REMOVE	EXIST POST RETAIN	EXIST POST REMOVE	NUMBER OF NEW POSTS	SQUARE STEEL (IN) 1.75 (LB / FT) 1.88	SQUARE STEEL (IN) 2.00 (LB / FT) 2.42	SQUARE STEEL (IN) 2.50 (LB / FT) 3.35	TUBULAR STEEL Ø (IN) FOUNDATION	TUBULAR STEEL Ø (IN) 3.00 (LB / FT) 7.60	TUBULAR STEEL Ø (IN) 3.50 (LB / FT) 9.00	TUBULAR STEEL Ø (IN) 4.00 (LB / FT) 10.80	TUBULAR STEEL Ø (IN) 5.00 (LB / FT) 14.60	SIGN FRAME REQUIRED	REMARKS	SIGN DETAIL: DETAIL IN SHS	SIGN DETAIL: DETAIL ON SHEET NUMBER	SIGN DETAIL: DETAIL ON STD SHEET NUMBER
STOWE VT 100							FY-FLUORESCENT YELLOW FYG-FLUORESCENT YELLOW GREEN																			"SHS"-STANDARD HIGHWAY SIGNS			
NB	1.532	B	W1-6	48	24		RIGHT ===> LARGE ARROW			1				X														
NB	1.544	C	VR-017	24	30								1		X											GOLD BROOK RD TH-7			
		C	VR-017	24	30			5.00								1		X											E-141
NB	1.552	D	R1-1	24	24								1		X											GOLD BROOK RD TH-7			
		D	R1-1	30	30			6.25								1		X									X		
NB	1.646	A	W1-2R	30	30		RIGHT CURVE			1				X															
NB	1.794	A	R2-1	24	30								1		X														
		A	R2-1	24	30			5.00								1		X									X		
NB	1.933	A	W11-1	30	30		BICYCLE SYMBOL			1				X															
		A	W16-1	18	24		SHARE THE ROAD			1																			
NB	1.989	A	R2-1	24	30								1		X														
		A	R2-1	24	30			5.00								1		X									X		
NB	2.067	A	W11-6	30	30								1		X														
		A	W11-6	30	30			6.25								1		X									X		
NB	2.117	A	W3-5	36	36		SPEED REDUCTION SPEED LIMIT 30			1				X															
SIGN SUMMARY SHEET							SHEET TOTALS	27.50	0.00	5	0	0	5	0	0	5		75									
								SF	SF	EA	EA	EA	EA	EA	EA	EA		FT									
VERMONT AGENCY OF TRANSPORTATION							TOWN TOTALS	582.8	0.0	65.0	6.0	6.0	105	0.0	0.0	103		1545.0									

PROJECT NAME: **Moretown-Newport Town VT100**
PROJECT NUMBER: **STPG SIGN(28)**
FILE NAME: **Stowe.xls** PLOT DATE: **9/29/2009**
PROJECT MANAGER: **N. Avery** DRAWN BY: **I. Shea**
DESIGNED BY: **D. Crossley** CHECKED BY: **N. Avery**
STOWE SHEET 4 SHEET **59** OF **166**

DIRECTION	MILEPOINT	LOCATION CODE (SHEET 2)	SIGN CODE	WIDTH (IN)	HEIGHT (IN)	SHEETING REMARKS	SIGN LEGEND	NEW SIGNS "A"	NEW SIGNS "B"	EXISTING SIGNS RETAIN	EXISTING SIGNS SALVAGE FROM	EXISTING SIGNS SALVAGE TO	EXISTING SIGNS REMOVE	EXIST POST RETAIN	EXIST POST REMOVE	NUMBER OF NEW POSTS	SQUARE STEEL (IN) (LB / FT) 1.75 / 1.88	SQUARE STEEL (IN) (LB / FT) 2.00 / 2.42	SQUARE STEEL (IN) (LB / FT) 2.50 / 3.35	TUBULAR STEEL Ø (IN) FOUNDATION	TUBULAR STEEL Ø (IN) (LB / FT) 3.00 / 7.60	TUBULAR STEEL Ø (IN) (LB / FT) 3.50 / 9.00	TUBULAR STEEL Ø (IN) (LB / FT) 4.00 / 10.80	TUBULAR STEEL Ø (IN) (LB / FT) 5.00 / 14.60	SIGN FRAME REQUIRED	REMARKS	SIGN DETAIL: DETAIL IN SHS	SIGN DETAIL: DETAIL ON SHEET NUMBER	SIGN DETAIL: DETAIL ON STD SHEET NUMBER
STOWE VT 100							FY-FLUORESCENT YELLOW FYG-FLUORESCENT YELLOW GREEN																			"SHS"-STANDARD HIGHWAY SIGNS			
NB	2.180	A	VD-018	30	18								1		X													
		A	VD-018	30	18			3.75								1		X										E-128A
NB	2.274	A	R2-1	24	30		SPEED LIMIT 30						1		X													
		A	R4-1	24	30		DO NOT PASS 						1															
		A	R2-1	30	36			7.50								1		X										6
NB	2.350	A	R4-1	24	30			5.00								1		X								INSTALL 80' +/- SOUTH THE 4 BUSINESS SIGNS	X	
NB	2.365	A	VD-062B	72	16		BUSINESS SIGN			1				X														
		A	VD-062B	72	16		BUSINESS SIGN			1																		
		A	VD-062B	72	16		BUSINESS SIGN			1																		
		A	VD-062B	72	16		BUSINESS SIGN			1																		
NB	2.373	C	R5-1	30	30		DO NOT ENTER						1		X												SIGN IN R.O.W. RETURN TO BUSINESS		
NB	2.382	B	R5-1	30	30		DO NOT ENTER						1		X												SIGN IN R.O.W. RETURN TO BUSINESS		
NB	2.431	C	VR-017	24	24								1		X												SYLVAN PARK RD TH-62 (SOUTH)		E-141
		C	VR-017	24	30			5.00								1		X										
NB	2.439	D	R1-1	24	24								1		X												SYLVAN PARK RD TH-62 (SOUTH)	X	
							SHEET TOTALS	21.25 SF	0.00 SF	4 EA	0 EA	0 EA	7 EA	0 EA	0 EA	4 EA		60 FT								
							TOWN TOTALS	582.8	0.0	65.0	6.0	6.0	105	0.0	0.0	103		1545.0								

SIGN SUMMARY SHEET

VERMONT AGENCY OF TRANSPORTATION

PROJECT NAME: **Moretown-Newport Town VT100**
PROJECT NUMBER: **STPG SIGN(28)**

FILE NAME: **Stowe.xls** PLOT DATE: **9/29/2009**
PROJECT MANAGER: **N. Avery** DRAWN BY: **I. Shea**
DESIGNED BY: **D. Crossley** CHECKED BY: **N. Avery**
STOWE SHEET 5 SHEET **60** OF **166**

DIRECTION	MILEPOINT	LOCATION CODE (SHEET 2)	SIGN CODE	WIDTH (IN)	HEIGHT (IN)	SHEETING REMARKS	SIGN LEGEND	NEW SIGNS "A"	NEW SIGNS "B"	EXISTING SIGNS RETAIN	EXISTING SIGNS SALVAGE FROM	EXISTING SIGNS SALVAGE TO	EXISTING SIGNS REMOVE	EXIST POST RETAIN	EXIST POST REMOVE	NUMBER OF NEW POSTS	SQUARE STEEL (IN) 1.75 (LB / FT) 1.88	SQUARE STEEL (IN) 2.00 (LB / FT) 2.42	SQUARE STEEL (IN) 2.50 (LB / FT) 3.35	TUBULAR STEEL Ø (IN) FOUNDATION	TUBULAR STEEL Ø (IN) 3.00 (LB / FT) 7.60	TUBULAR STEEL Ø (IN) 3.50 (LB / FT) 9.00	TUBULAR STEEL Ø (IN) 4.00 (LB / FT) 10.80	TUBULAR STEEL Ø (IN) 5.00 (LB / FT) 14.60	SIGN FRAME REQUIRED	REMARKS	SIGN DETAIL: DETAIL IN SHS	SIGN DETAIL: DETAIL ON SHEET NUMBER	SIGN DETAIL: DETAIL ON STD SHEET NUMBER
STOWE VT 100							FY-FLUORESCENT YELLOW FYG-FLUORESCENT YELLOW GREEN																			"SHS"-STANDARD HIGHWAY SIGNS			
		D	R1-1	30	30			6.25								1		X										
NB	2.508	A	R2-1	24	30		SPEED LIMIT 30			1					X														
		A	R4-1	24	30								2 ~~1~~															
		A	R4-1	24	30			5.00								1		X								X		
NB	2.533	C	VR-017	24	24								1		X											SYLVAN PARK RD TH-62 (NORTH)			
		C	VR-017	24	30			5.00								1		X										E-141
NB	2.540	D	R1-1	24	24								1		X											SYLVAN PARK RD TH-62 (NORTH)			
		D	R1-1	30	30			7.50								1		X								X		
NB	2.668	A	R2-1	24	30		SPEED LIMIT 30				1	1			X	1		X										
		A	R4-1	24	30			6.25																	INSTALL UNDER SPEED LIMIT 30 SIGN	X		
NB	2.726	C	VR-017	24	24								1		X											THOMAS LANE TH-87			
		C	VR-017	24	24			5.00								1		X										E-141
NB	2.733	D	R1-1	24	24								1		X											THOMAS LANE TH-87			
		D	R1-1	24	24			6.25								1		X								X		
NB	2.791	C	VR-017	24	24								1		X											CLIFF STREETH-60 (SOUTH)			
							SHEET TOTALS	41.25 SF	0.00 SF	1 EA	1 EA	1 EA	6 EA	0 EA	0 EA	7 EA	105 FT										
							TOWN TOTALS	582.8	0.0	65.0	6.0	6.0	105	0.0	0.0	103	1545.0											

SIGN SUMMARY SHEET

VERMONT AGENCY OF TRANSPORTATION

PROJECT NAME: **Moretown-Newport Town VT100**
PROJECT NUMBER: **STPG SIGN(28)**

FILE NAME: **Stowe.xls** PLOT DATE: **9/29/2009**
PROJECT MANAGER: **N. Avery** DRAWN BY: **I. Shea**
DESIGNED BY: **D. Crossley** CHECKED BY: **N. Avery**
STOWE SHEET 6 SHEET **61** OF **166**

DIRECTION	MILEPOINT	LOCATION CODE (SHEET 2)	SIGN CODE	WIDTH (IN)	HEIGHT (IN)	SHEETING REMARKS	SIGN LEGEND	NEW SIGNS "A"	NEW SIGNS "B"	EXISTING SIGNS RETAIN	EXISTING SIGNS SALVAGE FROM	EXISTING SIGNS SALVAGE TO	EXISTING SIGNS REMOVE	EXIST POST RETAIN	EXIST POST REMOVE	NUMBER OF NEW POSTS	SQUARE STEEL (IN) 1.75 (LB/FT) 1.88	SQUARE STEEL (IN) 2.00 (LB/FT) 2.42	SQUARE STEEL (IN) 2.50 (LB/FT) 3.35	TUBULAR STEEL Ø (IN) FOUNDATION	TUBULAR STEEL Ø (IN) 3.00 (LB/FT) 7.60	TUBULAR STEEL Ø (IN) 3.50 (LB/FT) 9.00	TUBULAR STEEL Ø (IN) 4.00 (LB/FT) 10.80	TUBULAR STEEL Ø (IN) 5.00 (LB/FT) 14.60	SIGN FRAME REQUIRED	REMARKS	SIGN DETAIL: DETAIL IN SHS	SIGN DETAIL: DETAIL ON SHEET NUMBER	SIGN DETAIL: DETAIL ON STD SHEET NUMBER
STOWE VT 100							FY-FLUORESCENT YELLOW FYG-FLUORESCENT YELLOW GREEN																			"SHS"-STANDARD HIGHWAY SIGNS			
		C	VR-017	24	30			6.25								1		X									E-141
NB	2.794	A	VR-417	30	30			6.25								1		X								INSTALL 5' NORTH OF STOP SIGN		6	
		B	W14-3	36	24			5.00																			X		
NB	2.795	D	R1-1	24	24								1		X											CLIFF STREETH-60 (SOUTH)			
		D	R1-1	30	30			5.00								1		X									X		
NB	2.843	A	S3-1	30	30		SCHOOL BUS STOP AHEAD			1				X															
NB	2.863	A	VD-018	30	18								1		X															
		A	VD-018	30	18			3.75								1		X											E-128B
NB	2.938	A	R2-1	24	30								1		X														
		B	VR-038	24	18		STATE HIGHWAY ENDS 				1	1													INSTALL ABOVE NEW SPEED LIMIT 25 SIGN			
		A	R2-1	30	36			7.50								1		X										6	
	TOWN OF STOWE CLASS 1																												
NB	3.979	A	R2-1	24	30		SPEED LIMIT 40						1		X														
		A	VR-041	24	24		THROUGH WAY BEGINS HERE						1																
		B	VR-038	24	18		STATE HIGHWAY ENDS						1																
							SHEET TOTALS	33.75	0.00	1	1	1	6	0	0	5		75										
								SF	SF	EA	EA	EA	EA	EA	EA	EA		FT										
							TOWN TOTALS	582.8	0.0	65.0	6.0	6.0	105	0.0	0.0	103		1545.0										

SIGN SUMMARY SHEET

VERMONT AGENCY OF TRANSPORTATION

PROJECT NAME: **Moretown-Newport Town VT100**
PROJECT NUMBER: **STPG SIGN(28)**

FILE NAME: **Stowe.xls** PLOT DATE: **9/29/2009**
PROJECT MANAGER: **N. Avery** DRAWN BY: **I. Shea**
DESIGNED BY: **D. Crossley** CHECKED BY: **N. Avery**
STOWE SHEET 7 SHEET **62** OF **166**

DIRECTION	MILEPOINT	LOCATION CODE (SHEET 2)	SIGN CODE	WIDTH (IN)	HEIGHT (IN)	SHEETING REMARKS	SIGN LEGEND	NEW SIGNS "A"	NEW SIGNS "B"	EXISTING SIGNS RETAIN	EXISTING SIGNS SALVAGE FROM	EXISTING SIGNS SALVAGE TO	EXISTING SIGNS REMOVE	EXIST POST RETAIN	EXIST POST REMOVE	NUMBER OF NEW POSTS	SQUARE STEEL (IN) 1.75 (LB / FT) 1.88	SQUARE STEEL (IN) 2.00 (LB / FT) 2.42	SQUARE STEEL (IN) 2.50 (LB / FT) 3.35	TUBULAR STEEL Ø (IN) FOUNDATION	TUBULAR STEEL Ø (IN) 3.00 (LB / FT) 7.60	TUBULAR STEEL Ø (IN) 3.50 (LB / FT) 9.00	TUBULAR STEEL Ø (IN) 4.00 (LB / FT) 10.80	TUBULAR STEEL Ø (IN) 5.00 (LB / FT) 14.60	SIGN FRAME REQUIRED	REMARKS	SIGN DETAIL: DETAIL IN SHS	SIGN DETAIL: DETAIL ON SHEET NUMBER	SIGN DETAIL: DETAIL ON STD SHEET NUMBER
STOWE VT 100							FY-FLUORESCENT YELLOW FYG-FLUORESCENT YELLOW GREEN																			"SHS"-STANDARD HIGHWAY SIGNS			
		A	VR-039	24	18			3.00																			7
		A	R2-1	24	30			5.00								1		X								X	
NB	4.136	A	W11-7	30	30		SIGN MISSING						~~1~~		~~X~~													
NB	4.288	C	VR-017	24	30								1		X												BRUSH HILL RD TH-16		
		C	VR-017	24	30			5.00								1		X										E-141
NB	4.298	D	R1-1	30	30								1		X												BRUSH HILL RD TH-16		
		D	R1-1	30	30			6.25								1		X									X	
NB	4.302	A	R2-1	24	30								1		X														
		A	R2-1	24	30			5.00								1		X									X	
NB	4.605	A	R2-1	24	30								1		X														
		A	R2-1	24	30			5.00								1		X									X	
NB	4.838	A	VD-062B	72	16		BUSINESS SIGN			1				X														
		A	VD-062B	72	16		BUSINESS SIGN			1																		
		A	VD-062B	72	16		BUSINESS SIGN			1																		
							SHEET TOTALS	29.25	0.00	3	0	0	5	0	0	5		75										
								SF	SF	EA	EA	EA	EA	EA	EA	EA		FT										
							TOWN TOTALS	582.8	0.0	65.0	6.0	6.0	105	0.0	0.0	103		1545.0										

SIGN SUMMARY SHEET


VERMONT AGENCY OF TRANSPORTATION

PROJECT NAME: **Moretown-Newport Town VT100**
PROJECT NUMBER: **STPG SIGN(28)**

FILE NAME: **Stowe.xls** PLOT DATE: **9/29/2009**
PROJECT MANAGER: **N. Avery** DRAWN BY: **I. Shea**
DESIGNED BY: **D. Crossley** CHECKED BY: **N. Avery**
STOWE SHEET 8 SHEET **63** OF **166**

DIRECTION	MILEPOINT	LOCATION CODE (SHEET 2)	SIGN CODE	WIDTH (IN)	HEIGHT (IN)	SHEETING REMARKS	SIGN LEGEND	NEW SIGNS "A"	NEW SIGNS "B"	EXISTING SIGNS RETAIN	EXISTING SIGNS SALVAGE FROM	EXISTING SIGNS SALVAGE TO	EXISTING SIGNS REMOVE	EXIST POST RETAIN	EXIST POST REMOVE	NUMBER OF NEW POSTS	SQUARE STEEL (IN) 1.75 (LB / FT) 1.88	SQUARE STEEL (IN) 2.00 (LB / FT) 2.42	SQUARE STEEL (IN) 2.50 (LB / FT) 3.35	TUBULAR STEEL Ø (IN) FOUNDATION	TUBULAR STEEL Ø (IN) 3.00 (LB / FT) 7.60	TUBULAR STEEL Ø (IN) 3.50 (LB / FT) 9.00	TUBULAR STEEL Ø (IN) 4.00 (LB / FT) 10.80	TUBULAR STEEL Ø (IN) 5.00 (LB / FT) 14.60	SIGN FRAME REQUIRED	REMARKS	SIGN DETAIL: DETAIL IN SHS	SIGN DETAIL: DETAIL ON SHEET NUMBER	SIGN DETAIL: DETAIL ON STD SHEET NUMBER
STOWE VT 100							FY-FLUORESCENT YELLOW FYG-FLUORESCENT YELLOW GREEN																			"SHS"-STANDARD HIGHWAY SIGNS			
NB	4.920	A	W1-10R	30	30		MODIFIED RIGHT CURVE						1		X														
		A	VD-062B	72	16		BUSINESS SIGN					1				2		X								SALVAGE FROM NB 4.96			
		A	VD-062B	72	16		BUSINESS SIGN					1																	
		A	VD-062B	72	16		BUSINESS SIGN					1																	
NB	4.960	A	VD-062B	72	16		BUSINESS SIGN				1				X														
		A	VD-062B	72	16		BUSINESS SIGN				1																		
		A	VD-062B	72	16		BUSINESS SIGN				1																		
		A	W1-10 R	30	30	FY		6.25								1		X									X		
		A	W16-8	30	18	FY		3.75																				8	
NB	5.005	A	VR-615	30	36		LEFT TURN YIELD TO THRU TRAFFIC						1		X														
		A	VR-615	30	36			7.50								1		X										7	
NB	5.208	A	R2-1	24	30		SPEED LIMIT 40						1		X														
		A	R2-1	24	30			5.00								1		X									X		
NB	5.499	A	W2-2R	30	30		RIGHT SIDE ROAD						1		X														
NB	5.520	A	W2-2MaR	30	30			6.25								1		X									INSTALL 100' +/- NOTTH OF ORIGINAL SIGN LOCATION		6	
							SHEET TOTALS	28.75 SF	0.00 SF	0 EA	3 EA	3 EA	4 EA	0 EA	0 EA	6 EA		90 FT								
							TOWN TOTALS	582.8	0.0	65.0	6.0	6.0	105	0.0	0.0	103		1545.0											



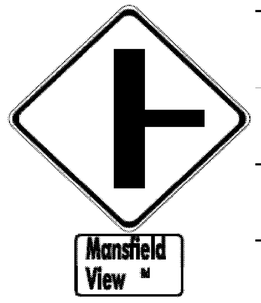

SIGN SUMMARY SHEET

VERMONT AGENCY OF TRANSPORTATION

PROJECT NAME: Moretown-Newport Town VT100
PROJECT NUMBER: STPG SIGN(28)

FILE NAME: Stowe.xls
PROJECT MANAGER: N. Avery
DESIGNED BY: D. Crosslev
STOWE SHEET 9

PLOT DATE: 9/29/2009
DRAWN BY: I. Shea
CHECKED BY: N. Avery

DIRECTION	MILEPOINT	LOCATION CODE (SHEET 2)	SIGN CODE	WIDTH (IN)	HEIGHT (IN)	SHEETING REMARKS	SIGN LEGEND	NEW SIGNS "A"	NEW SIGNS "B"	EXISTING SIGNS RETAIN	EXISTING SIGNS SALVAGE FROM	EXISTING SIGNS SALVAGE TO	EXISTING SIGNS REMOVE	EXIST POST RETAIN	EXIST POST REMOVE	NUMBER OF NEW POSTS	SQUARE STEEL (IN) 1.75 (LB / FT) 1.88	SQUARE STEEL (IN) 2.00 (LB / FT) 2.42	SQUARE STEEL (IN) 2.50 (LB / FT) 3.35	TUBULAR STEEL Ø (IN) FOUNDATION	TUBULAR STEEL Ø (IN) 3.00 (LB / FT) 7.60	TUBULAR STEEL Ø (IN) 3.50 (LB / FT) 9.00	TUBULAR STEEL Ø (IN) 4.00 (LB / FT) 10.80	TUBULAR STEEL Ø (IN) 5.00 (LB / FT) 14.60	SIGN FRAME REQUIRED	REMARKS	SIGN DETAIL: DETAIL IN SHS	SIGN DETAIL: DETAIL ON SHEET NUMBER	SIGN DETAIL: DETAIL ON STD SHEET NUMBER
STOWE VT 100							FY-FLUORESCENT YELLOW FYG-FLUORESCENT YELLOW GREEN																			"SHS"-STANDARD HIGHWAY SIGNS			
		A	W16-8	30	18			3.75																				8	
NB	5.593	C	VR-017	24	30								1		X											MANSFIELD VIEW RD. TH-24			
		C	VR-017	24	30			5.00								1		X										E-141
NB	5.603	D	R1-1	30	30								1		X											MANSFIELD VIEW RD. TH-24			
		D	R1-1	30	30			6.25								1		X									X		
NB	5.632	A	R2-1	24	30								1		X														
		A	R2-1	24	30			5.00								1		X									X		
NB	6.269	A	W1-10L	30	30		MODIFIED LEFT CURVE			1				X															
		A	W16-8A	30	18		RANDOLPH RD			1																			
NB	6.374	C	VR-017	24	30								1		X											RANDOLPH RD TH-2			
		C	VR-017	24	30			6.25								1		X										E-141
NB	6.375	A	W1-6	48	24		<=== LEFT LARGE ARROW			1				X															
NB	6.376	D	R1-1	30	30								1		X											RANDOLPH RD TH-2			
		D	R1-1	30	30			5.00								1		X									X		
NB	6.471	A	M3-1S	24	12		NORTH			1				X															
							SHEET TOTALS	31.25	0.00	4	0	0	5	0	0	5		75										
								SF	SF	EA	EA	EA	EA	EA	EA	EA		FT										
							TOWN TOTALS	582.8	0.0	65.0	6.0	6.0	105	0.0	0.0	103		1545.0										

SIGN SUMMARY SHEET

VERMONT AGENCY OF TRANSPORTATION

PROJECT NAME: Moretown-Newport Town VT100
PROJECT NUMBER: STPG SIGN(28)

FILE NAME: Stowe.xls
PROJECT MANAGER: N. Avery
DESIGNED BY: D. Crossley
STOWE SHEET 10

PLOT DATE: 9/29/2009
DRAWN BY: I. Shea
CHECKED BY: N. Avery

DIRECTION	MILEPOINT	LOCATION CODE (SHEET 2)	SIGN CODE	WIDTH (IN)	HEIGHT (IN)	SHEETING REMARKS	SIGN LEGEND	NEW SIGNS "A"	NEW SIGNS "B"	EXISTING SIGNS RETAIN	EXISTING SIGNS SALVAGE FROM	EXISTING SIGNS SALVAGE TO	EXISTING SIGNS REMOVE	EXIST POST RETAIN	EXIST POST REMOVE	NUMBER OF NEW POSTS	SQUARE STEEL (IN) 1.75 (LB / FT) 1.88	SQUARE STEEL (IN) 2.00 (LB / FT) 2.42	SQUARE STEEL (IN) 2.50 (LB / FT) 3.35	TUBULAR STEEL Ø (IN) FOUNDATION	TUBULAR STEEL Ø (IN) 3.00 (LB / FT) 7.60	TUBULAR STEEL Ø (IN) 3.50 (LB / FT) 9.00	TUBULAR STEEL Ø (IN) 4.00 (LB / FT) 10.80	TUBULAR STEEL Ø (IN) 5.00 (LB / FT) 14.60	SIGN FRAME REQUIRED	REMARKS	SIGN DETAIL: DETAIL IN SHS	SIGN DETAIL: DETAIL ON SHEET NUMBER	SIGN DETAIL: DETAIL ON STD SHEET NUMBER
STOWE VT 100							FY-FLUORESCENT YELLOW FYG-FLUORESCENT YELLOW GREEN																			"SHS"-STANDARD HIGHWAY SIGNS			
		A	M1-5	30	24		VERMONT 100			1																		
NB	6.549	C	VR-017	24	30								1		X											TINKER LN TH-13			
		C	VR-017	24	30			5.00								1		X										E-141
NB	6.552	B	W1-6	48	24		RIGHT ===> LARGE ARROW			1				X														
NB	6.561	D	R1-1	30	30								1		X											TINKER LN TH-13			
		D	R1-1	30	30			6.25								1		X									X	
SB	6.671	F	W1-10R	30	30		MODIFIED RIGHT CURVE			1				X														
		F	W16-8A	30	18		TINKER LANE			1																		
SB	6.470	F	M3-3S	24	12		SOUTH			1				X														
		F	M1-5	30	24		VERMONT 100			1																		
SB	5.906	G	VM-607	24	30		43RD INF DIV MEMORIAL HIGHWAY			1				X														
SB	5.904	G	VR-023B	24	30								1		X														
		G	VR-023B	24	30			5.00								1		X										6
SB	5.786	F	R2-5A	24	30		REDUCED SPEED AHEAD 						1		X														
		F	W3-5	36	36			9.00								2		X									X	
SIGN SUMMARY SHEET							SHEET TOTALS	25.25	0.00	7	0	0	4	0	0	5		75								
								SF	SF	EA	EA	EA	EA	EA	EA	EA		FT								
VERMONT AGENCY OF TRANSPORTATION							TOWN TOTALS	582.8	0.0	65.0	6.0	6.0	105	0.0	0.0	103		1545.0								

PROJECT NAME: **Moretown-Newport Town VT100**
PROJECT NUMBER: **STPG SIGN(28)**

FILE NAME: **Stowe.xls**
PROJECT MANAGER: **N. Avery**
DESIGNED BY: **D. Crossley**
STOWE SHEET 11

PLOT DATE: **9/29/2009**
DRAWN BY: **I. Shea**
CHECKED BY: **N. Avery**
SHEET **66** OF **166**

DIRECTION	MILEPOINT	LOCATION CODE (SHEET 2)	SIGN CODE	WIDTH (IN)	HEIGHT (IN)	SHEETING REMARKS	SIGN LEGEND	NEW SIGNS "A"	NEW SIGNS "B"	EXISTING SIGNS RETAIN	EXISTING SIGNS SALVAGE FROM	EXISTING SIGNS SALVAGE TO	EXISTING SIGNS REMOVE	EXIST POST RETAIN	EXIST POST REMOVE	NUMBER OF NEW POSTS	SQUARE STEEL (IN) (LB / FT) 1.75 / 1.88	SQUARE STEEL (IN) (LB / FT) 2.00 / 2.42	SQUARE STEEL (IN) (LB / FT) 2.50 / 3.35	TUBULAR STEEL Ø (IN) FOUNDATION	TUBULAR STEEL Ø (IN) (LB / FT) 3.00 / 7.60	TUBULAR STEEL Ø (IN) (LB / FT) 3.50 / 9.00	TUBULAR STEEL Ø (IN) (LB / FT) 4.00 / 10.80	TUBULAR STEEL Ø (IN) (LB / FT) 5.00 / 14.60	SIGN FRAME REQUIRED	REMARKS	SIGN DETAIL: DETAIL IN SHS	SIGN DETAIL: DETAIL ON SHEET NUMBER	SIGN DETAIL: DETAIL ON STD SHEET NUMBER
STOWE VT 100							FY-FLUORESCENT YELLOW FYG-FLUORESCENT YELLOW GREEN																			"SHS"-STANDARD HIGHWAY SIGNS			
SB	5.634	F	R2-1	24	30								1		X														
		F	R2-1	30	36			7.50								1		X										6
SB	5.280	F	R2-1	24	30								1		X														
		F	R2-1	24	30			5.00								1		X										
SB	5.155	F	W1-10L	30	30								1		X														
		F	W1-10L	30	30			6.25								1		X									X	
		F	W16-8A	30	18			3.75																				8
SB	5.084	F	W1-6	48	24								1		X													
		F	W1-6	48	24			8.00								2		X									X	
SB	5.064	G	VR-017	24	30								1		X												STAGE COACH RD TH-4		
		G	VR-017	24	30			5.00								1		X										E-141
SB	5.055	H	R1-1	30	30								1		X												STAGE COACH RD TH-4		
		H	R1-1	30	30			6.25								1		X									X	
SB	5.043	F	W1-6	48	24			8.00					I		X	2		X									X	
SB	5.042	E	W1-6	48	24								1		X													
							SHEET TOTALS	49.75 SF	0.00 SF	0 EA	0 EA	0 EA	7 EA	0 EA	0 EA	9 EA	135 FT												
							TOWN TOTALS	582.8	0.0	65.0	6.0	6.0	105	0.0	0.0	103	1545.0												

SIGN SUMMARY SHEET

VERMONT AGENCY OF TRANSPORTATION

PROJECT NAME: Moretown-Newport Town VT100
PROJECT NUMBER: STPG SIGN(28)

FILE NAME: Stowe.xls
PROJECT MANAGER: N. Avery
DESIGNED BY: D. Crossley
STOWE SHEET 12

PLOT DATE: 9/29/2009
DRAWN BY: I. Shea
CHECKED BY: N. Avery
SHEET 67 OF 166

DIRECTION	MILEPOINT	LOCATION CODE (SHEET 2)	SIGN CODE	WIDTH (IN)	HEIGHT (IN)	SHEETING REMARKS	SIGN LEGEND	NEW SIGNS "A"	NEW SIGNS "B"	EXISTING SIGNS RETAIN	EXISTING SIGNS SALVAGE FROM	EXISTING SIGNS SALVAGE TO	EXISTING SIGNS REMOVE	EXIST POST RETAIN	EXIST POST REMOVE	NUMBER OF NEW POSTS	SQUARE STEEL (IN) 1.75 (LB / FT) 1.88	SQUARE STEEL (IN) 2.00 (LB / FT) 2.42	SQUARE STEEL (IN) 2.50 (LB / FT) 3.35	TUBULAR STEEL Ø (IN) FOUNDATION	TUBULAR STEEL Ø (IN) 3.00 (LB / FT) 7.60	TUBULAR STEEL Ø (IN) 3.50 (LB / FT) 9.00	TUBULAR STEEL Ø (IN) 4.00 (LB / FT) 10.80	TUBULAR STEEL Ø (IN) 5.00 (LB / FT) 14.60	SIGN FRAME REQUIRED	REMARKS	SIGN DETAIL: DETAIL IN SHS	SIGN DETAIL: DETAIL ON SHEET NUMBER	SIGN DETAIL: DETAIL ON STD SHEET NUMBER
STOWE VT 100							FY-FLUORESCENT YELLOW FYG-FLUORESCENT YELLOW GREEN																			"SHS"-STANDARD HIGHWAY SIGNS			
		E	W1-6	48	24			8.00								2		X									X		
SB	5.034	H	R1-1	24	24								1		X												STAGE COACH RD TH-4			
		H	R1-1	36	36			9.00								2		X									X		
SB	4.872	F	R2-1	24	30								1		X															
		F	R2-1	24	30			5.00								1		X									X		
SB	4.630	F	R2-1	24	30								1		X															
		F	R2-1	24	30			5.00								1		X									X		
SB	4.310	F	R2-1	24	30								1		X															
		F	R2-1	24	30			5.00								1		X									X		
SB	4.281	F	VW-205	30	30		WATCH FOR TURNING VEHICLES			1				X															
SB	4.224	F	VW-054R	30	30		HIDDEN DRIVE RIGHT						1		X															
		F	W2-2MaR	30	30	FY		6.25								1		X										6	
		F	W16-8A	30	8	FY		1.67																				8	
SB	4.194	F	M4-1AS	24	12								1		X															
		F	M4-5S	24	12								1																	
							SHEET TOTALS	39.92	0.00	1	0	0	7	0	0	8		120											
								SF	SF	EA	EA	EA	EA	EA	EA	EA		FT											
							TOWN TOTALS	582.8	0.0	65.0	6.0	6.0	105	0.0	0.0	103		1545.0											

SIGN SUMMARY SHEET

VERMONT AGENCY OF TRANSPORTATION

PROJECT NAME: Moretown-Newport Town VT100
PROJECT NUMBER: STPG SIGN(28)

FILE NAME: Stowe.xls
PROJECT MANAGER: N. Avery
DESIGNED BY: D. Crossley
STOWE SHEET 13

PLOT DATE: 9/29/2009
DRAWN BY: I. Shea
CHECKED BY: N. Avery
SHEET 68 OF 166

DIRECTION	MILEPOINT	LOCATION CODE (SHEET 2)	SIGN CODE	WIDTH (IN)	HEIGHT (IN)	SHEETING REMARKS	SIGN LEGEND	NEW SIGNS "A"	NEW SIGNS "B"	EXISTING SIGNS RETAIN	EXISTING SIGNS SALVAGE FROM	EXISTING SIGNS SALVAGE TO	EXISTING SIGNS REMOVE	EXIST POST RETAIN	EXIST POST REMOVE	NUMBER OF NEW POSTS	SQUARE STEEL (IN) 1.75 (LB / FT) 1.88	SQUARE STEEL (IN) 2.00 (LB / FT) 2.42	SQUARE STEEL (IN) 2.50 (LB / FT) 3.35	TUBULAR STEEL Ø (IN) FOUNDATION	TUBULAR STEEL Ø (IN) 3.00 (LB / FT) 7.60	TUBULAR STEEL Ø (IN) 3.50 (LB / FT) 9.00	TUBULAR STEEL Ø (IN) 4.00 (LB / FT) 10.80	TUBULAR STEEL Ø (IN) 5.00 (LB / FT) 14.60	SIGN FRAME REQUIRED	REMARKS	SIGN DETAIL: DETAIL IN SHS	SIGN DETAIL: DETAIL ON SHEET NUMBER	SIGN DETAIL: DETAIL ON STD SHEET NUMBER
STOWE VT 100							FY-FLUORESCENT YELLOW FYG-FLUORESCENT YELLOW GREEN																			"SHS"-STANDARD HIGHWAY SIGNS			
		F	M3-1S	24	12								1																
		F	M1-5	30	24								1																
		F	M6-1S	21	15								1																
		F	VR-474H	30	42								1		X														
		F	M4-1A	24	12		ALT / TO / NORTH	2.00								1			X							GREEN ON WHITE SHEETING	X		
		F	M4-5	24	12			2.00																		GREEN ON WHITE SHEETING	X		
		F	M3-1	24	12		VERMONT 108 →	2.00																		GREEN ON WHITE SHEETING	X		
		F	M1-5	30	24		VT 108 THROUGH THE NOTCH CLOSED FOR THE SEASON	5.00																					E-136B
		F	M6-1R	21	15			2.19																		GREEN ON WHITE SHEETING	X		
		F	VR-474H	30	42			8.75								1			X							INSTALL NEXT TO ROUTE MARKER ASSEMBLY ON SEPARATE POST		7	
SB	4.161	G	VR-017	24	30		LEGAL LOAD LIMIT 24,000 POUNDS						1		X											WEST HILL RD. TH-8			
		G	VR-017	24	30			5.00								1		X											E-141
SB	4.153	H	R1-1	30	30		STOP						1		X											WEST HILL RD. TH-8			
		H	R1-1	30	30			6.25								1		X									X		
SB	4.113	F	W3-5	36	36		SPEED REDUCTION SPEED LIMIT 25			1				X															
							SHEET TOTALS	33.19 SF	0.00 SF	1 EA	0 EA	0 EA	6 EA	0 EA	0 EA	4 EA		60 FT											
							TOWN TOTALS	582.8	0.0	65.0	6.0	6.0	105	0.0	0.0	103		1545.0											

SIGN SUMMARY SHEET

VERMONT AGENCY OF TRANSPORTATION

PROJECT NAME: **Moretown-Newport Town VT100**
PROJECT NUMBER: **STPG SIGN(28)**

FILE NAME: **Stowe.xls** PLOT DATE: **9/29/2009**
PROJECT MANAGER: **N. Avery** DRAWN BY: **I. Shea**
DESIGNED BY: **D. Crossley** CHECKED BY: **N. Avery**
STOWE SHEET 14 SHEET **69** OF **166**

DIRECTION	MILEPOINT	LOCATION CODE (SHEET 2)	SIGN CODE	WIDTH (IN)	HEIGHT (IN)	SHEETING REMARKS	SIGN LEGEND	NEW SIGNS "A"	NEW SIGNS "B"	EXISTING SIGNS RETAIN	EXISTING SIGNS SALVAGE FROM	EXISTING SIGNS SALVAGE TO	EXISTING SIGNS REMOVE	EXIST POST RETAIN	EXIST POST REMOVE	NUMBER OF NEW POSTS	SQUARE STEEL (IN) 1.75 (LB / FT) 1.88	SQUARE STEEL (IN) 2.00 (LB / FT) 2.42	SQUARE STEEL (IN) 2.50 (LB / FT) 3.35	TUBULAR STEEL Ø (IN) FOUNDATION	TUBULAR STEEL Ø (IN) 3.00 (LB / FT) 7.60	TUBULAR STEEL Ø (IN) 3.50 (LB / FT) 9.00	TUBULAR STEEL Ø (IN) 4.00 (LB / FT) 10.80	TUBULAR STEEL Ø (IN) 5.00 (LB / FT) 14.60	SIGN FRAME REQUIRED	REMARKS	SIGN DETAIL: DETAIL IN SHS	SIGN DETAIL: DETAIL ON SHEET NUMBER	SIGN DETAIL: DETAIL ON STD SHEET NUMBER
STOWE VT 100							FY-FLUORESCENT YELLOW FYG-FLUORESCENT YELLOW GREEN																			"SHS"-STANDARD HIGHWAY SIGNS			
SB	4.038	F	VD-062C	74.75	16		TRAVEL INFORMATION			1				X														
		F	VD-062BC	74.75	16		TRAVEL INFORMATION			1																		
SB	4.018	A	VD-018	30	18								1		X													
		A	VD-018	30	18			3.75								1		X										E-128B
SB	3.980	F	R2-1	24	30								1		X													
		F	VR-038	24	18								1															
		F	R4-1	24	30		DO NOT PASS						1															
		F	VR-038	24	18			3.00								1		X								7	
		F	R2-1	30	36			7.50																				6
		BEGIN CLASS 1																										
SB	2.941	F	R2-1	24	30								1		X													
		F	VR-039	24	18								1															
		F	VR-039	24	18			3.00								1		X								7	
		F	R2-1	24	30			5.00																			X	
SB	2.900	F	W1-8	18	24								1		X													
							SHEET TOTALS	22.25	0.00	2	0	0	7	0	0	3		45									
								SF	SF	EA	EA	EA	EA	EA	EA	EA		FT									
							TOWN TOTALS	582.8	0.0	65.0	6.0	6.0	105	0.0	0.0	103		1545.0									

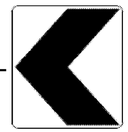
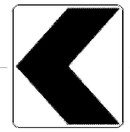
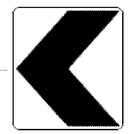
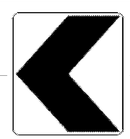
SIGN SUMMARY SHEET

VERMONT AGENCY OF TRANSPORTATION


PROJECT NAME: Moretown-Newport Town VT100
PROJECT NUMBER: STPG SIGN(28)

FILE NAME: Stowe.xls
PROJECT MANAGER: N. Avery
DESIGNED BY: D. Crossley
STOWE SHEET 15

PLOT DATE: 9/29/2009
DRAWN BY: I. Shea
CHECKED BY: N. Avery
SHEET 70 OF 166

DIRECTION	MILEPOINT	LOCATION CODE (SHEET 2)	SIGN CODE	WIDTH (IN)	HEIGHT (IN)	SHEETING REMARKS	SIGN LEGEND	NEW SIGNS "A"	NEW SIGNS "B"	EXISTING SIGNS RETAIN	EXISTING SIGNS SALVAGE FROM	EXISTING SIGNS SALVAGE TO	EXISTING SIGNS REMOVE	EXIST POST RETAIN	EXIST POST REMOVE	NUMBER OF NEW POSTS	SQUARE STEEL (IN) 1.75 (LB / FT) 1.88	SQUARE STEEL (IN) 2.00 (LB / FT) 2.42	SQUARE STEEL (IN) 2.50 (LB / FT) 3.35	TUBULAR STEEL Ø (IN) FOUNDATION	TUBULAR STEEL Ø (IN) 3.00 (LB / FT) 7.60	TUBULAR STEEL Ø (IN) 3.50 (LB / FT) 9.00	TUBULAR STEEL Ø (IN) 4.00 (LB / FT) 10.80	TUBULAR STEEL Ø (IN) 5.00 (LB / FT) 14.60	SIGN FRAME REQUIRED	REMARKS	SIGN DETAIL: DETAIL IN SHS	SIGN DETAIL: DETAIL ON SHEET NUMBER	SIGN DETAIL: DETAIL ON STD SHEET NUMBER
STOWE VT 100							FY-FLUORESCENT YELLOW FYG-FLUORESCENT YELLOW GREEN																			"SHS"-STANDARD HIGHWAY SIGNS			
		F	W1-8	18	24			3.00								1		X									X		
SB	2.899	E	W1-8	18	24								1																
		E	W1-8	18	24			3.00								1		X									X		
SB	2.890	F	W1-8	18	24								1		X														
		F	W1-8	18	24			3.00								1		X									X		
SB	2.889	E	W1-8	18	24								1		X														
		E	W1-8	18	24			3.00								1		X									X		
SB	2.880	F	S3-1	30	30		SCHOOL BUS STOP AHEAD			1				X														
SB	2.870	F	W1-8	18	24								1		X														
		F	W1-8	18	24			3.00								1		X									X		
SB	2.869	E	W1-8	18	24								1		X														
		E	W1-8	18	24			3.00								1		X									X		
SB	2.860	F	W1-8	18	24								1		X														
		F	W1-8	18	24			3.00								1		X									X		
SB	2.859	E	W1-8	18	24								1		X														
SIGN SUMMARY SHEET							SHEET TOTALS	21.00	0.00	1	0	0	7	0	0	7		105									
								SF	SF	EA	EA	EA	EA	EA	EA	EA		FT									
VERMONT AGENCY OF TRANSPORTATION							TOWN TOTALS	582.8	0.0	65.0	6.0	6.0	105	0.0	0.0	103		1545.0									

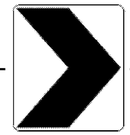PROJECT NAME: Moretown-Newport Town VT100
PROJECT NUMBER: STPG SIGN(28)
FILE NAME: Stowe.xls
PROJECT MANAGER: N. Avery
DESIGNED BY: D. Crossley
STOWE SHEET 16
PLOT DATE: 9/29/2009
DRAWN BY: I. Shea
CHECKED BY: N. Avery
SHEET 71 OF 166

DIRECTION	MILEPOINT	LOCATION CODE (SHEET 2)	SIGN CODE	WIDTH (IN)	HEIGHT (IN)	SHEETING REMARKS	SIGN LEGEND	NEW SIGNS "A"	NEW SIGNS "B"	EXISTING SIGNS RETAIN	EXISTING SIGNS SALVAGE FROM	EXISTING SIGNS SALVAGE TO	EXISTING SIGNS REMOVE	EXIST POST RETAIN	EXIST POST REMOVE	NUMBER OF NEW POSTS	SQUARE STEEL (IN) 1.75 (LB/FT) 1.88	SQUARE STEEL (IN) 2.00 (LB/FT) 2.42	SQUARE STEEL (IN) 2.50 (LB/FT) 3.35	TUBULAR STEEL Ø (IN) FOUNDATION	TUBULAR STEEL Ø (IN) 3.00 (LB/FT) 7.60	TUBULAR STEEL Ø (IN) 3.50 (LB/FT) 9.00	TUBULAR STEEL Ø (IN) 4.00 (LB/FT) 10.80	TUBULAR STEEL Ø (IN) 5.00 (LB/FT) 14.60	SIGN FRAME REQUIRED	REMARKS	SIGN DETAIL: DETAIL IN SHS	SIGN DETAIL: DETAIL ON SHEET NUMBER	SIGN DETAIL: DETAIL ON STD SHEET NUMBER
STOWE VT 100							FY-FLUORESCENT YELLOW FYG-FLUORESCENT YELLOW GREEN																			"SHS"-STANDARD HIGHWAY SIGNS			
		E	W1-8	18	24			3.00								1		X									X		
SB	2.850	F	VD-018	30	18								1		X														
			VD-018	30	18			3.75								1		X										E-128A
SB	2.792	F	R2-1	24	30		SPEED LIMIT 30			1				X															
		F	R4-1	24	30								1		X														
		F	R4-1	24	30			5.00								1		X									X		
SB	2.754	G	VR-017	24	30								1		X											RIVER RD TH- 95			
		G	VR-017	24	30			5.00								1		X										E-141
SB	2.752	H	R1-1	24	24								1		X											RIVER RD TH- 95 ISLAND			
		H	R1-1	30	30			6.25								1		X									X		
SB	2.740	H	R1-1	24	24								1		X											RIVER RD TH- 95			
		H	R1-1	30	30			6.25								1		X									X		
SB	2.490	F	R2-1	24	30								1		X														
		F	R2-1	24	30			5.00								1		X									X		
		F	R4-1	24	30			5.00																			X		
SIGN SUMMARY SHEET							SHEET TOTALS	39.25	0.00	1	0	0	6	0	0	7		105									
								SF	SF	EA	EA	EA	EA	EA	EA	EA		FT									
VERMONT AGENCY OF TRANSPORTATION							TOWN TOTALS	582.8	0.0	65.0	6.0	6.0	105	0.0	0.0	103		1545.0									


PROJECT NAME: **Moretown-Newport Town VT100**
PROJECT NUMBER: **STPG SIGN(28)**

FILE NAME: **Stowe.xls** PLOT DATE: **9/29/2009**
PROJECT MANAGER: **N. Avery** DRAWN BY: **I. Shea**
DESIGNED BY: **D. Crossley** CHECKED BY: **N. Avery**
STOWE SHEET 17 SHEET **72** OF **166**

DIRECTION	MILEPOINT	LOCATION CODE (SHEET 2)	SIGN CODE	WIDTH (IN)	HEIGHT (IN)	SHEETING REMARKS	SIGN LEGEND	NEW SIGNS "A"	NEW SIGNS "B"	EXISTING SIGNS RETAIN	EXISTING SIGNS SALVAGE FROM	EXISTING SIGNS SALVAGE TO	EXISTING SIGNS REMOVE	EXIST POST RETAIN	EXIST POST REMOVE	NUMBER OF NEW POSTS	SQUARE STEEL (IN) 1.75 (LB / FT) 1.88	SQUARE STEEL (IN) 2.00 (LB / FT) 2.42	SQUARE STEEL (IN) 2.50 (LB / FT) 3.35	TUBULAR STEEL Ø (IN) FOUNDATION	TUBULAR STEEL Ø (IN) 3.00 (LB / FT) 7.60	TUBULAR STEEL Ø (IN) 3.50 (LB / FT) 9.00	TUBULAR STEEL Ø (IN) 4.00 (LB / FT) 10.80	TUBULAR STEEL Ø (IN) 5.00 (LB / FT) 14.60	SIGN FRAME REQUIRED	REMARKS	SIGN DETAIL: DETAIL IN SHS	SIGN DETAIL: DETAIL ON SHEET NUMBER	SIGN DETAIL: DETAIL ON STD SHEET NUMBER
STOWE VT 100							FY-FLUORESCENT YELLOW FYG-FLUORESCENT YELLOW GREEN																			"SHS"-STANDARD HIGHWAY SIGNS			
SB	2.440	F	W11-1	30	30		BICYCLE SYMBOL			1				X														
		F	W16-1	18	24		SHARE THE ROAD			1																		
SB	2.350	F	VR-417	30	30			6.25								1		X									X	
		E	W14-3	36	24			6.00																			X	
SB	2.330	F	W11-6 H	30	30								1		X														
		F	W11-6H	30	30			6.25								1		X										E-153
SB	2.280	F	R2-1	24	30								1		X														
		E	W14-3	48	36		NO PASSING ZONE 						1															
		F	R2-1	24	30			5.00								1		X									X	
SB	2.020	F	R2-1	24	30								1		X														
		F	R2-1	24	30			5.00								1		X									X	
SB	1.796	F	R2-1	24	30		 MISSING						~~1~~		~~X~~														
		F	R2-1	24	30		DUPLICATE, DO NOT PLACE	~~5.00~~								~~1~~		~~X~~									X	
SB	1.720	F	W11-1	30	30		BICYCLE SYMBOL			1				X														
		F	W16-1	18	24		SHARE THE ROAD			1																		
SIGN SUMMARY SHEET							SHEET TOTALS	33.50	0.00	4	0	0	5	0	0	5		75									
								SF	SF	EA	EA	EA	EA	EA	EA	EA		FT									
VERMONT AGENCY OF TRANSPORTATION							TOWN TOTALS	582.8	0.0	65.0	6.0	6.0	105	0.0	0.0	103		1545.0									

PROJECT NAME: **Moretown-Newport Town VT100**
PROJECT NUMBER: **STPG SIGN(28)**

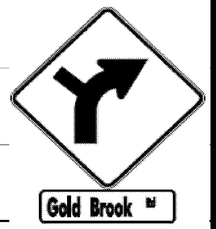FILE NAME: **Stowe.xls** PLOT DATE: **9/29/2009**
PROJECT MANAGER: **N. Avery** DRAWN BY: **I. Shea**
DESIGNED BY: **D. Crossley** CHECKED BY: **N. Avery**
STOWE SHEET 18 SHEET **73** OF **166**

DIRECTION	MILEPOINT	LOCATION CODE (SHEET 2)	SIGN CODE	WIDTH (IN)	HEIGHT (IN)	SHEETING REMARKS	SIGN LEGEND	NEW SIGNS "A"	NEW SIGNS "B"	EXISTING SIGNS RETAIN	EXISTING SIGNS SALVAGE FROM	EXISTING SIGNS SALVAGE TO	EXISTING SIGNS REMOVE	EXIST POST RETAIN	EXIST POST REMOVE	NUMBER OF NEW POSTS	SQUARE STEEL (IN) 1.75 (LB / FT) 1.88	SQUARE STEEL (IN) 2.00 (LB / FT) 2.42	SQUARE STEEL (IN) 2.50 (LB / FT) 3.35	TUBULAR STEEL Ø (IN) FOUNDATION	TUBULAR STEEL Ø (IN) 3.00 (LB / FT) 7.60	TUBULAR STEEL Ø (IN) 3.50 (LB / FT) 9.00	TUBULAR STEEL Ø (IN) 4.00 (LB / FT) 10.80	TUBULAR STEEL Ø (IN) 5.00 (LB / FT) 14.60	SIGN FRAME REQUIRED	REMARKS	SIGN DETAIL: DETAIL IN SHS	SIGN DETAIL: DETAIL ON SHEET NUMBER	SIGN DETAIL: DETAIL ON STD SHEET NUMBER
STOWE VT 100							FY-FLUORESCENT YELLOW FYG-FLUORESCENT YELLOW GREEN																			"SHS"-STANDARD HIGHWAY SIGNS			
SB	1.620	F	VW-205	30	30		WATCH FOR TURNING VEHICLES 						1		X													
		F	W1-10 R	30	30			6.25								1		X								X		
		F	W16-8	30	8			1.67																				8	
SB	1.470	F	R2-1	24	30								1		X													
		F	R2-1	24	30			5.00								1		X								X		
SB	1.370	F	S3-1	30	30		SCHOOL BUS STOP			1				X														
SB	1.200	F	R2-1	24	30								1		X													
		F	R2-1	24	30			5.00								1		X								X		
SB	1.140	A	VD-062B	72	16		BUSINESS SIGN			1				X														
		A	VD-062B	72	16		BUSINESS SIGN			1																		
		A	VD-062B	72	16		BUSINESS SIGN			1																		
SB	0.983	F	W2-2R	30	30		RIGHT SIDE ROAD			1				X														
		F	W16-8A	30	10		MOSCOW RD			1																		
SB	0.940	A	VD-062B	72	16		BUSINESS SIGN			1				X														
		A	VD-062B	72	16		BUSINESS SIGN			1																		
SIGN SUMMARY SHEET							SHEET TOTALS	17.92	0.00	8	0	0	3	0	0	3		45									
								SF	SF	EA	EA	EA	EA	EA	EA	EA		FT									
VERMONT AGENCY OF TRANSPORTATION							TOWN TOTALS	582.8	0.0	65.0	6.0	6.0	105	0.0	0.0	103		1545.0									

PROJECT NAME: **Moretown-Newport Town VT100**
PROJECT NUMBER: **STPG SIGN(28)**

FILE NAME: **Stowe.xls** PLOT DATE: **9/29/2009**
PROJECT MANAGER: **N. Avery** DRAWN BY: **I. Shea**
DESIGNED BY: **D. Crossley** CHECKED BY: **N. Avery**
STOWE SHEET 19 SHEET **74** OF **166**

DIRECTION	MILEPOINT	LOCATION CODE (SHEET 2)	SIGN CODE	WIDTH (IN)	HEIGHT (IN)	SHEETING REMARKS	SIGN LEGEND	NEW SIGNS "A"	NEW SIGNS "B"	EXISTING SIGNS RETAIN	EXISTING SIGNS SALVAGE FROM	EXISTING SIGNS SALVAGE TO	EXISTING SIGNS REMOVE	EXIST POST RETAIN	EXIST POST REMOVE	NUMBER OF NEW POSTS	SQUARE STEEL (IN) 1.75 (LB / FT) 1.88	SQUARE STEEL (IN) 2.00 (LB / FT) 2.42	SQUARE STEEL (IN) 2.50 (LB / FT) 3.35	TUBULAR STEEL Ø (IN) FOUNDATION	TUBULAR STEEL Ø (IN) 3.00 (LB / FT) 7.60	TUBULAR STEEL Ø (IN) 3.50 (LB / FT) 9.00	TUBULAR STEEL Ø (IN) 4.00 (LB / FT) 10.80	TUBULAR STEEL Ø (IN) 5.00 (LB / FT) 14.60	SIGN FRAME REQUIRED	REMARKS	SIGN DETAIL DETAIL IN SHS	SIGN DETAIL DETAIL ON SHEET NUMBER	SIGN DETAIL DETAIL ON STD SHEET NUMBER
STOWE VT 100							FY-FLUORESCENT YELLOW FYG-FLUORESCENT YELLOW GREEN																			"SHS"-STANDARD HIGHWAY SIGNS			
		A	VD-062B	72	16		BUSINESS SIGN			1																		
SB	0.861	G	VR-017	24	24								1		X											MOSCOW RD TH-1			
		G	VR-017	24	30			5.00								1		X										E-141
SB	0.849	H	R1-1	24	24								1		X											MOSCOW RD TH-1			
		H	R1-1	30	30			6.25								1		X									X	
SB	0.800	F	R2-1	24	30								1		X														
		F	R2-1	24	30			5.00								1		X									X	
SB	0.770	F	M3-3S	24	12								1		X													
		F	M1-5	30	24								1															
		F	M3-3	24	12			2.00								1		X							GREEN ON WHITE SHEETING	X		
		F	M1-5	30	24			5.00																				E-136B
SB	0.166	G	VR-017	24	30		LEGAL LOAD LIMIT 24,000 LBS			1				X											BLACK BEAR RUN TH-111			
SB	0.156	H	R1-1	30	30		STOP			1				X											BLACK BEAR RUN TH-111			
							SHEET TOTALS	23.25 SF	0.00 SF	3 EA	0 EA	0 EA	5 EA	0 EA	0 EA	4 EA		60 FT										
							TOWN TOTALS	582.8	0.0	65.0	6.0	6.0	105	0.0	0.0	103		1545.0										

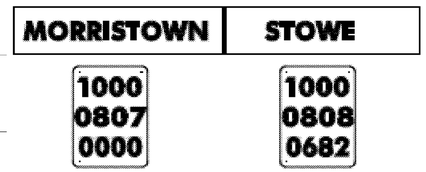
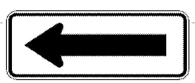
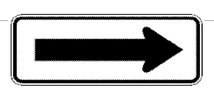
SIGN SUMMARY SHEET

VERMONT AGENCY OF TRANSPORTATION

PROJECT NAME: **Moretown-Newport Town VT100**
PROJECT NUMBER: **STPG SIGN(28)**

FILE NAME: **Stowe.xls**
PROJECT MANAGER: **N. Avery**
DESIGNED BY: **D. Crossley**
STOWE SHEET 20

PLOT DATE: **9/29/2009**
DRAWN BY: **I. Shea**
CHECKED BY: **N. Avery**

DIRECTION	MILEPOINT	LOCATION CODE (SHEET 2)	SIGN CODE	WIDTH (IN)	HEIGHT (IN)	SHEETING REMARKS	SIGN LEGEND	NEW SIGNS "A"	NEW SIGNS "B"	EXISTING SIGNS RETAIN	EXISTING SIGNS SALVAGE FROM	EXISTING SIGNS SALVAGE TO	EXISTING SIGNS REMOVE	EXIST POST RETAIN	EXIST POST REMOVE	NUMBER OF NEW POSTS	SQUARE STEEL (IN) 1.75 (LB / FT) 1.88	SQUARE STEEL (IN) 2.00 (LB / FT) 2.42	SQUARE STEEL (IN) 2.50 (LB / FT) 3.35	TUBULAR STEEL Ø (IN) FOUNDATION	TUBULAR STEEL Ø (IN) 3.00 (LB / FT) 7.60	TUBULAR STEEL Ø (IN) 3.50 (LB / FT) 9.00	TUBULAR STEEL Ø (IN) 4.00 (LB / FT) 10.80	TUBULAR STEEL Ø (IN) 5.00 (LB / FT) 14.60	SIGN FRAME REQUIRED	REMARKS	SIGN DETAIL: DETAIL IN SHS	SIGN DETAIL: DETAIL ON SHEET NUMBER	SIGN DETAIL: DETAIL ON STD SHEET NUMBER
MORRISTOWN VT 100							FY-FLUORESCENT YELLOW FYG-FLUORESCENT YELLOW GREEN																			"SHS"-STANDARD HIGHWAY SIGNS			
NB	0.000	C	VD-024	72	10			5.00								2		X								INSTALL OPPOSITE EXISTING SB TOWNLINE SIGN		4	
		C	VD-700	6	10			0.42																					
		C	VD-700	6	10			0.42																					
NB	0.370	A	R2-1	24	30								1		X														
		A	R2-1	24	30			5.00								1		X									X		
NB	0.910	A	W1-2L	30	30		LEFT CURVE						1		X														
		A	W13-1	24	24		40 MPH PLAQUE						1																
NB	0.980	B	W1-8	18	24		CHEVRON 						1		X														
		A	W1-2L	30	30			6.25								1		X									X		
		A	W13-1	24	24			4.00																			X		
NB	1.000	A	W1-8	18	24		CHEVRON						1		X														
		B	W1-8	18	24		CHEVRON 						1																
		A	W1-6	48	24			8.00								2		X									X		
NB	1.020	A	W1-8	18	24		CHEVRON 						1		X														
		B	W1-6	48	24			8.00								2		X									X		
SIGN SUMMARY SHEET							SHEET TOTALS	37.09	0.00	0	0	0	7	0	0	8		120									
								SF	SF	EA	EA	EA	EA	EA	EA	EA		FT									
VERMONT AGENCY OF TRANSPORTATION							TOWN TOTALS	369.7	0.0	77.0	5.0	5.0	65	0.0	0.0	68		1020.0									

PROJECT NAME: Moretown-Newport Town VT100
PROJECT NUMBER: STPG SIGN(28)

FILE NAME: Morristown.xls
PROJECT MANAGER: N. Avery
DESIGNED BY: D. Crossley
MORRISTOWN SHEET 1

PLOT DATE: 9/29/2009
DRAWN BY: I. Shea
CHECKED BY: J. Kelly

DIRECTION	MILEPOINT	LOCATION CODE (SHEET 2)	SIGN CODE	WIDTH (IN)	HEIGHT (IN)	SHEETING REMARKS	SIGN LEGEND	NEW SIGNS "A"	NEW SIGNS "B"	EXISTING SIGNS RETAIN	EXISTING SIGNS SALVAGE FROM	EXISTING SIGNS SALVAGE TO	EXISTING SIGNS REMOVE	EXIST POST RETAIN	EXIST POST REMOVE	NUMBER OF NEW POSTS	SQUARE STEEL (IN) (LB / FT) 1.75 / 1.88	SQUARE STEEL (IN) (LB / FT) 2.00 / 2.42	SQUARE STEEL (IN) (LB / FT) 2.50 / 3.35	TUBULAR STEEL Ø (IN) FOUNDATION	TUBULAR STEEL Ø (IN) (LB / FT) 3.00 / 7.60	TUBULAR STEEL Ø (IN) (LB / FT) 3.50 / 9.00	TUBULAR STEEL Ø (IN) (LB / FT) 4.00 / 10.80	TUBULAR STEEL Ø (IN) (LB / FT) 5.00 / 14.60	SIGN FRAME REQUIRED	REMARKS	SIGN DETAIL: DETAIL IN SHS	SIGN DETAIL: DETAIL ON SHEET NUMBER	SIGN DETAIL: DETAIL ON STD SHEET NUMBER
MORRISTOWN VT 100							FY-FLUORESCENT YELLOW FYG-FLUORESCENT YELLOW GREEN																			"SHS"-STANDARD HIGHWAY SIGNS			
NB	1.075	C	VR-017	24	30								1		X											JOE'S POND RD TH-100			
		C	VR-017	24	30			5.00								1		X										E-141
NB	1.083	D	R1-1	30	30								1		X											JOE'S POND RD TH-100			
		D	R1-1	30	30			6.25								1		X									X	
NB	1.399	D	R1-1	30	30								1		X											TAMARACK HILL RD TH-86			
		D	R1-1	30	30			6.25								1		X									X	
NB	1.407	C	VR-017	24	30								1		X											TAMARACK HILL RD TH-86			
		C	VR-017	24	30			5.00								1		X										E-141
NB	1.560	A	VD-062B	72	16		BUSINESS SIGN			1				X														
		A	VD-062B	72	16		BUSINESS SIGN			1																		
NB	1.602	A	W11-7	30	30		EQUESTRIAN			1				X														
NB	1.645	A	W2-2MR	30	30		RIGHT SIDE ROAD			1				X														
		A	W16-8A	30	8			1.67																		X	
NB	1.694	C	VR-017	24	30								1		X											STANCLIFF RD TH-72			
		C	VR-017	24	30			5.00								1		X										E-141
SIGN SUMMARY SHEET							SHEET TOTALS	29.17	0.00	4	0	0	5	0	0	5		75										
								SF	SF	EA	EA	EA	EA	EA	EA	EA		FT										
VERMONT AGENCY OF TRANSPORTATION							TOWN TOTALS	369.7	0.0	77.0	5.0	5.0	65	0.0	0.0	68		1020.0										


PROJECT NAME: **Moretown-Newport Town VT100**
PROJECT NUMBER: **STPG SIGN(28)**

FILE NAME: **Morristown.xls** PLOT DATE: **9/29/2009**
PROJECT MANAGER: **N. Avery** DRAWN BY: **I. Shea**
DESIGNED BY: **D. Crossley** CHECKED BY: **J. Kelly**
MORRISTOWN SHEET 2 SHEET **77** OF **166**

DIRECTION	MILEPOINT	LOCATION CODE (SHEET 2)	SIGN CODE	WIDTH (IN)	HEIGHT (IN)	SHEETING REMARKS	SIGN LEGEND	NEW SIGNS "A"	NEW SIGNS "B"	EXISTING SIGNS RETAIN	EXISTING SIGNS SALVAGE FROM	EXISTING SIGNS SALVAGE TO	EXISTING SIGNS REMOVE	EXIST POST RETAIN	EXIST POST REMOVE	NUMBER OF NEW POSTS	SQUARE STEEL (IN) (LB / FT) 1.75 / 1.88	SQUARE STEEL (IN) (LB / FT) 2.00 / 2.42	SQUARE STEEL (IN) (LB / FT) 2.50 / 3.35	TUBULAR STEEL Ø (IN) FOUNDATION	TUBULAR STEEL Ø (IN) (LB / FT) 3.00 / 7.60	TUBULAR STEEL Ø (IN) (LB / FT) 3.50 / 9.00	TUBULAR STEEL Ø (IN) (LB / FT) 4.00 / 10.80	TUBULAR STEEL Ø (IN) (LB / FT) 5.00 / 14.60	SIGN FRAME REQUIRED	REMARKS	SIGN DETAIL: DETAIL IN SHS	SIGN DETAIL: DETAIL ON SHEET NUMBER	SIGN DETAIL: DETAIL ON STD SHEET NUMBER
MORRISTOWN VT 100							FY-FLUORESCENT YELLOW FYG-FLUORESCENT YELLOW GREEN																			"SHS"-STANDARD HIGHWAY SIGNS			
NB	1.688	D	R1-1	30	30								1		X											STANCLIFF RD TH-72			
		D	R1-1	30	30			6.25								1		X								X		
NB	1.840	C	VR-017	24	30								1		X											BROOK N PINE RD TH-113			
		C	VR-017	24	30			5.00								1		X										E-141
NB	1.834	D	R1-1	30	30								1		X											BROOK N PINE RD TH-113			
		D	R1-1	30	30			6.25								1		X								X		
NB	2.200	A	VD-062B	72	16		BUSINESS SIGN			1				X														
NB	2.231	C	VR-017	24	30								1		X											GOELTZ RD TH-56			
		C	VR-017	24	30			5.00								1		X										E-141
NB	2.239	D	R1-1	30	30								1		X											GOELTZ RD TH-56			
		D	R1-1	30	30			6.25								1		X								X		
NB	2.396	A	W2-2ML	30	30		LEFT SIDE ROAD			1				X														
		A	VW-054R	30	30		HIDDEN DRIVE RIGHT			1																		
NB	2.430	A	S3-1	30	30		SCHOOL BUS STOP AHEAD			1				X														
NB	3.010	A	D1-1M	72	10								1		X													
SIGN SUMMARY SHEET							SHEET TOTALS	28.75	0.00	4	0	0	6	0	0	5	75										
								SF	SF	EA	EA	EA	EA	EA	EA	EA	FT										
VERMONT AGENCY OF TRANSPORTATION							TOWN TOTALS	369.7	0.0	77.0	5.0	5.0	65	0.0	0.0	68	1020.0										

PROJECT NAME: **Moretown-Newport Town VT100**
PROJECT NUMBER: **STPG SIGN(28)**

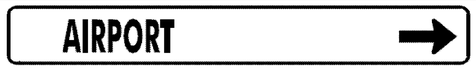FILE NAME: **Morristown.xls** PLOT DATE: **9/29/2009**
PROJECT MANAGER: **N. Avery** DRAWN BY: **I. Shea**
DESIGNED BY: **D. Crosslev** CHECKED BY: **J. Kelly**
MORRISTOWN SHEET 3 SHEET **78** OF **166**

DIRECTION	MILEPOINT	LOCATION CODE (SHEET 2)	SIGN CODE	WIDTH (IN)	HEIGHT (IN)	SHEETING REMARKS	SIGN LEGEND	NEW SIGNS "A"	NEW SIGNS "B"	EXISTING SIGNS RETAIN	EXISTING SIGNS SALVAGE FROM	EXISTING SIGNS SALVAGE TO	EXISTING SIGNS REMOVE	EXIST POST RETAIN	EXIST POST REMOVE	NUMBER OF NEW POSTS	SQUARE STEEL (IN) 1.75 (LB / FT) 1.88	SQUARE STEEL (IN) 2.00 (LB / FT) 2.42	SQUARE STEEL (IN) 2.50 (LB / FT) 3.35	TUBULAR STEEL Ø (IN) FOUNDATION	TUBULAR STEEL Ø (IN) 3.00 (LB / FT) 7.60	TUBULAR STEEL Ø (IN) 3.50 (LB / FT) 9.00	TUBULAR STEEL Ø (IN) 4.00 (LB / FT) 10.80	TUBULAR STEEL Ø (IN) 5.00 (LB / FT) 14.60	SIGN FRAME REQUIRED	REMARKS	SIGN DETAIL: DETAIL IN SHS	SIGN DETAIL: DETAIL ON SHEET NUMBER	SIGN DETAIL: DETAIL ON STD SHEET NUMBER
MORRISTOWN VT 100							FY-FLUORESCENT YELLOW FYG-FLUORESCENT YELLOW GREEN																			"SHS"-STANDARD HIGHWAY SIGNS			
		A	D1-1	72	12			6.00								2		X									5
NB	3.044	A	D4-2	30	36		PARK & RIDE			1				X														
		A	VD-365	30	6		1-800-685-RIDE						1															
NB	3.051	D	R1-1	24	24								1		X											DRIVE TO AIRPORT			
		D	R1-1	30	30			6.25								1		X									X	
NB	3.880	A	S3-1	30	30								1		X														
		A	S3-1	30	30			6.25								1		X									X	
NB	4.000	A	W11-5	30	30								1		X													
		A	W11-5	30	30			6.25								1		X									X	
NB	4.096	C	VR-017	24	30		LEGAL LOAD LIMIT 24,000 LBS			1				X											OAK RIDGE ESTATE RD. TH-118			
NB	4.104	D	R1-1	30	30		STOP			1				X											OAK RIDGE ESTATE RD. TH-118			
NB	4.126	A	W3-5	36	36		SPEED REDUCTION SPEED LIMIT 40			1				X														
NB	4.161	A	VW-205	30	30		WATCH FOR TURNING VEHICLES						1		X													
		A	VD-062B	72	16		BUSINESS SIGN					1				2		X										
		A	VD-062B	72	16		BUSINESS SIGN					1																
SIGN SUMMARY SHEET							SHEET TOTALS	24.75	0.00	4	0	2	5	0	0	7		105								
								SF	SF	EA	EA	EA	EA	EA	EA	EA		FT								
VERMONT AGENCY OF TRANSPORTATION							TOWN TOTALS	369.7	0.0	77.0	5.0	5.0	65	0.0	0.0	68		1020.0								

PROJECT NAME: **Moretown-Newport Town VT100**
PROJECT NUMBER: **STPG SIGN(28)**

FILE NAME: **Morristown.xls**
PROJECT MANAGER: **N. Avery**
DESIGNED BY: **D. Crossley**
MORRISTOWN SHEET 4

PLOT DATE: **9/29/2009**
DRAWN BY: **I. Shea**
CHECKED BY: **J. Kelly**
SHEET **79** OF **166**

DIRECTION	MILEPOINT	LOCATION CODE (SHEET 2)	SIGN CODE	WIDTH (IN)	HEIGHT (IN)	SHEETING REMARKS	SIGN LEGEND	NEW SIGNS "A"	NEW SIGNS "B"	EXISTING SIGNS RETAIN	EXISTING SIGNS SALVAGE FROM	EXISTING SIGNS SALVAGE TO	EXISTING SIGNS REMOVE	EXIST POST RETAIN	EXIST POST REMOVE	NUMBER OF NEW POSTS	SQUARE STEEL (IN) 1.75 (LB / FT) 1.88	SQUARE STEEL (IN) 2.00 (LB / FT) 2.42	SQUARE STEEL (IN) 2.50 (LB / FT) 3.35	TUBULAR STEEL Ø (IN) FOUNDATION	TUBULAR STEEL Ø (IN) 3.00 (LB / FT) 7.60	TUBULAR STEEL Ø (IN) 3.50 (LB / FT) 9.00	TUBULAR STEEL Ø (IN) 4.00 (LB / FT) 10.80	TUBULAR STEEL Ø (IN) 5.00 (LB / FT) 14.60	SIGN FRAME REQUIRED	REMARKS	SIGN DETAIL: DETAIL IN SHS	SIGN DETAIL: DETAIL ON SHEET NUMBER	SIGN DETAIL: DETAIL ON STD SHEET NUMBER
MORRISTOWN VT 100							FY-FLUORESCENT YELLOW FYG-FLUORESCENT YELLOW GREEN																			"SHS"-STANDARD HIGHWAY SIGNS			
		A	VD-062AL	72	16		BUSINESS SIGN				1																	
NB	4.210	A	VD-062B	72	16		BUSINESS SIGN				1				X													
		A	VD-062B	72	16		BUSINESS SIGN				1																	
		A	VD-062AL	72	16		BUSINESS SIGN				1																	
		A	W2-3MaL	30	30			6.25								1		X								6	
		A	W16-8A	30	18			3.75																				8	
NB	4.240	A	R2-1	24	30								1		X													
		A	R2-1	30	36			7.50								1		X									6	
NB	4.361	C	VR-017	24	30										X											LAGUE RD TH-91		
		C	VR-017	24	30			5.00								1		X										E-141
NB	4.369	D	R1-1	30	30								1		X											LAGUE RD TH-91		
		D	R1-1	30	30			6.25								1		X									X	
NB	4.410	A	R2-1	24	30		SPEED LIMIT 40 						1		X													
NB	4.425	A	R2-1	24	30			5.00								1		X								INSTALL 80' NORTH OF EXISTING	X	
NB	4.460	A	VD-062B	72	16		BUSINESS SIGN				1				X													
SIGN SUMMARY SHEET							SHEET TOTALS	33.75 SF	0.00 SF	1 EA	3 EA	1 EA	3 EA	0 EA	0 EA	5 EA	75 FT											
VERMONT AGENCY OF TRANSPORTATION							TOWN TOTALS	369.7	0.0	77.0	5.0	5.0	65	0.0	0.0	68	1020.0											

PROJECT NAME: **Moretown-Newport Town VT100**
PROJECT NUMBER: **STPG SIGN(28)**

FILE NAME: **Morristown.xls** PLOT DATE: **9/29/2009**
PROJECT MANAGER: **N. Avery** DRAWN BY: **I. Shea**
DESIGNED BY: **D. Crossley** CHECKED BY: **J. Kelly**
MORRISTOWN SHEET 5 SHEET **80** OF **166**

DIRECTION	MILEPOINT	LOCATION CODE (SHEET 2)	SIGN CODE	WIDTH (IN)	HEIGHT (IN)	SHEETING REMARKS	SIGN LEGEND	NEW SIGNS "A"	NEW SIGNS "B"	EXISTING SIGNS RETAIN	EXISTING SIGNS SALVAGE FROM	EXISTING SIGNS SALVAGE TO	EXISTING SIGNS REMOVE	EXIST POST RETAIN	EXIST POST REMOVE	NUMBER OF NEW POSTS	SQUARE STEEL (IN) 1.75 (LB / FT) 1.88	SQUARE STEEL (IN) 2.00 (LB / FT) 2.42	SQUARE STEEL (IN) 2.50 (LB / FT) 3.35	TUBULAR STEEL Ø (IN) FOUNDATION	TUBULAR STEEL Ø (IN) 3.00 (LB / FT) 7.60	TUBULAR STEEL Ø (IN) 3.50 (LB / FT) 9.00	TUBULAR STEEL Ø (IN) 4.00 (LB / FT) 10.80	TUBULAR STEEL Ø (IN) 5.00 (LB / FT) 14.60	SIGN FRAME REQUIRED	REMARKS	SIGN DETAIL: DETAIL IN SHS	SIGN DETAIL: DETAIL ON SHEET NUMBER	SIGN DETAIL: DETAIL ON STD SHEET NUMBER
MORRISTOWN VT 100							FY-FLUORESCENT YELLOW FYG-FLUORESCENT YELLOW GREEN																			"SHS"-STANDARD HIGHWAY SIGNS			
		A	VD-062B	72	16		BUSINESS SIGN			1																		
		A	VD-062B	72	16		BUSINESS SIGN			1																		
NB	4.524	A	S1-1YG	36	36		SCHOOL SYMBOL			1				X														
		A	W16-9YG	30	18		AHEAD			1																		
NB	4.556	A	R2-1	30	36		SPEED LIMIT 35			1				X														
NB	4.640	A	D1-1E	72	20								1		X													
		A	D1-1	72	20			10.00								2		X									5	
NB	4.670	A	W11-9	30	30								1		X													
		A	W11-9	30	30			6.25								1		X									X	
NB	4.785	A	W3-5	36	36			9.00								2		X										
NB	4.850	A	R2-1	24	30								1		X													
		A	VR-038	24	18								1														
		A	R2-1	30	36			3.00								1		X									6	
		A	VR-038	24	18			7.50																			6	
			CLASS 1 PORTION OF HIGHWAY																									
							SHEET TOTALS	35.75	0.00	5	0	0	4	0	0	6		90									
								SF	SF	EA	EA	EA	EA	EA	EA	EA		FT									
							TOWN TOTALS	369.7	0.0	77.0	5.0	5.0	65	0.0	0.0	68		1020.0									

SIGN SUMMARY SHEET

VERMONT AGENCY OF TRANSPORTATION

PROJECT NAME: Moretown-Newport Town VT100
PROJECT NUMBER: STPG SIGN(28)

FILE NAME: Morristown.xls
PROJECT MANAGER: N. Avery
DESIGNED BY: D. Crossley
MORRISTOWN SHEET 6

PLOT DATE: 9/29/2009
DRAWN BY: I. Shea
CHECKED BY: J. Kelly

DIRECTION	MILEPOINT	LOCATION CODE (SHEET 2)	SIGN CODE	WIDTH (IN)	HEIGHT (IN)	SHEETING REMARKS	SIGN LEGEND	NEW SIGNS		EXISTING SIGNS				EXIST POST		NUMBER OF NEW POSTS	SQUARE STEEL (IN)			TUBULAR STEEL Ø (IN)					SIGN FRAME REQUIRED	REMARKS	SIGN DETAIL		
								"A"	"B"	RETAIN	SALVAGE FROM	SALVAGE TO	REMOVE	RETAIN	REMOVE		1.75	2.00	2.50	FOUNDATION	3.00	3.50	4.00	5.00			DETAIL IN SHS	DETAIL ON SHEET NUMBER	DETAIL ON STD SHEET NUMBER
																	(LB / FT)				(LB / FT)								
																	1.88	2.42	3.35		7.60	9.00	10.80	14.60					
MORRISTOWN VT 100							FY-FLUORESCENT YELLOW FYG-FLUORESCENT YELLOW GREEN																			"SHS"-STANDARD HIGHWAY SIGNS			
NB	6.170	A	VD-062B	72	16		BUSINESS SIGN			1				X															
		A	VD-062AS	72	16		BUSINESS SIGN			1																			
		A	VD-062AL	72	16		BUSINESS SIGN			1																			
NB	6.188	A	VR-039	24	18		STATE HIGHWAY BEGINS				1	1				1		X											
		A	R2-1	24	30		SPEED LIMIT 40				1	1																	
NB	6.302	A	VR-932	48	30		LEFT "ONLY"/THRU/RIGHT "ONLY"			1				X															
NB	6.376	C	VR-017	24	30		LEGAL LOAD LIMIT 24,000 LBS			1				X												NORTHGATE AVE. TH-101			
NB	6.384	D	R1-1	30	30		STOP			1				X												NORTHGATE AVE. TH-101			
NB	6.465	A	M2-1S	21	15		JCT			1				X															
		A	M1-5	24	24		VERMONT 15			1																			
NB	6.495	A	VR-921MR	30	30		THRU/MODIFIED RIGHT "ONLY"			1				X															
NB	6.532	A	D1-1A	72	12		<--- JOHNSON 7			1				X															
		A	D1-1A	72	12		<--- JEFFERSONVILLE 16			1																			
		A	D1-1A	72	12		WOLCOTT 8 --->			1																			
		A	D1-1A	72	12		HARDWICK 13 --->			1																			
							SHEET TOTALS	0.00	0.00	13	2	2	0	0	0	1	15												
								SF	SF	EA	EA	EA	EA	EA	EA	EA	FT												
							TOWN TOTALS	369.7	0.0	77.0	5.0	5.0	65	0.0	0.0	68	1020.0												

SIGN SUMMARY SHEET

VERMONT AGENCY OF TRANSPORTATION

PROJECT NAME: **Moretown-Newport Town VT100**
PROJECT NUMBER: **STPG SIGN(28)**

FILE NAME: **Morristown.xls** PLOT DATE: **9/29/2009**
PROJECT MANAGER: **N. Avery** DRAWN BY: **I. Shea**
DESIGNED BY: **D. Crossley** CHECKED BY: **J. Kelly**
MORRISTOWN SHEET 7 SHEET **82** OF **166**

DIRECTION	MILEPOINT	LOCATION CODE (SHEET 2)	SIGN CODE	WIDTH (IN)	HEIGHT (IN)	SHEETING REMARKS	SIGN LEGEND	NEW SIGNS "A"	NEW SIGNS "B"	EXISTING SIGNS RETAIN	EXISTING SIGNS SALVAGE FROM	EXISTING SIGNS SALVAGE TO	EXISTING SIGNS REMOVE	EXIST POST RETAIN	EXIST POST REMOVE	NUMBER OF NEW POSTS	SQUARE STEEL (IN) 1.75 (LB / FT) 1.88	SQUARE STEEL (IN) 2.00 (LB / FT) 2.42	SQUARE STEEL (IN) 2.50 (LB / FT) 3.35	TUBULAR STEEL Ø (IN) FOUNDATION	TUBULAR STEEL Ø (IN) 3.00 (LB / FT) 7.60	TUBULAR STEEL Ø (IN) 3.50 (LB / FT) 9.00	TUBULAR STEEL Ø (IN) 4.00 (LB / FT) 10.80	TUBULAR STEEL Ø (IN) 5.00 (LB / FT) 14.60	SIGN FRAME REQUIRED	REMARKS	SIGN DETAIL: DETAIL IN SHS	SIGN DETAIL: DETAIL ON SHEET NUMBER	SIGN DETAIL: DETAIL ON STD SHEET NUMBER
MORRISTOWN VT 100							FY-FLUORESCENT YELLOW FYG-FLUORESCENT YELLOW GREEN																			"SHS"-STANDARD HIGHWAY SIGNS			
NB	6.568	A	VR-922L	36	30		LEFT "ONLY"/THRU & RIGHT			1				X															
NB	6.582	J	R4-7	24	30		RIGHT BULLNOSE			1				X															
		J	OM1-1	18	18		YELLOW CLUSTER			1																			
		K	OM1-1	18	18		YELLOW CLUSTER			1																			
NB	6.589	A	M3-4S	24	12		WEST			1				X															
		A	M1-5	24	24		VERMONT 15			1																			
		A	M4-5S	21	15		TO			1																			
		A	M3-1S	24	12		NORTH			1																			
		A	M1-5	30	24		VERMONT 100			1																			
		A	M6-1S	21	15		<--- LEFT			1																			
		A	M3-2S	24	12		EAST			1																			
		A	M1-5	24	24		VERMONT 15			1																			
		A	M6-1S	21	15		RIGHT --->			1																			
SB	6.592	K	R4-7	24	30		RIGHT BULLNOSE			1				X															
		J	OM1-1	18	18		YELLOW CLUSTER			1																			
							SHEET TOTALS	0.00	0.00	15	0	0	0	0	0	0	0												
								SF	SF	EA	EA	EA	EA	EA	EA	EA	FT												
							TOWN TOTALS	369.7	0.0	77.0	5.0	5.0	65	0.0	0.0	68	1020.0												

SIGN SUMMARY SHEET

VERMONT AGENCY OF TRANSPORTATION

PROJECT NAME: **Moretown-Newport Town VT100**
PROJECT NUMBER: **STPG SIGN(28)**

FILE NAME: **Morristown.xls**
PROJECT MANAGER: **N. Averv**
DESIGNED BY: **D. Crosslev**
MORRISTOWN SHEET 8

PLOT DATE: **9/29/2009**
DRAWN BY: **I. Shea**
CHECKED BY: **J. Kelly**

DIRECTION	MILEPOINT	LOCATION CODE (SHEET 2)	SIGN CODE	WIDTH (IN)	HEIGHT (IN)	SHEETING REMARKS	SIGN LEGEND	NEW SIGNS "A"	NEW SIGNS "B"	EXISTING SIGNS RETAIN	EXISTING SIGNS SALVAGE FROM	EXISTING SIGNS SALVAGE TO	EXISTING SIGNS REMOVE	EXIST POST RETAIN	EXIST POST REMOVE	NUMBER OF NEW POSTS	SQUARE STEEL (IN) 1.75 (LB / FT) 1.88	SQUARE STEEL (IN) 2.00 (LB / FT) 2.42	SQUARE STEEL (IN) 2.50 (LB / FT) 3.35	TUBULAR STEEL Ø (IN) FOUNDATION	TUBULAR STEEL Ø (IN) 3.00 (LB / FT) 7.60	TUBULAR STEEL Ø (IN) 3.50 (LB / FT) 9.00	TUBULAR STEEL Ø (IN) 4.00 (LB / FT) 10.80	TUBULAR STEEL Ø (IN) 5.00 (LB / FT) 14.60	SIGN FRAME REQUIRED	REMARKS	SIGN DETAIL: DETAIL IN SHS	SIGN DETAIL: DETAIL ON SHEET NUMBER	SIGN DETAIL: DETAIL ON STD SHEET NUMBER
MORRISTOWN VT 100							FY-FLUORESCENT YELLOW FYG-FLUORESCENT YELLOW GREEN																			"SHS"-STANDARD HIGHWAY SIGNS			
		K	OM1-1	18	18		YELLOW CLUSTER			1																		
SB	6.564	F	R3-7 L	30	30		LEFT LANE MUST TURN LEFT			1				X														
SB	6.554	F	M3-3S	24	12		SOUTH			1				X														
		F	M1-5	30	24		VERMONT 100			1																		
SB	6.523	F	D2-1	72	12		MORRISVILLE 1			1				X														
		F	D2-1	72	12		STOWE 10			1																		
		F	D9-2	24	24		HOSPITAL SYMBOL			1																	X	
SB	6.500	F	R2-1	24	30		SPEED LIMIT 40	5.00								1		X								INSTALL 125' +/- SOUTH OF PREVIOUS SIGN	X	
SB	6.470	G	VR-017	24	30		LEGAL LOAD LIMIT 24,000 LBS			1				X												GOODELL AVE. TH-84		
SB	6.462	H	R1-1	30	30		STOP			1				X												GOODELL AVE. TH-84		
SB	6.418	G	VR-017	24	24		LEGAL LOAD LIMIT 24,000 POUNDS						1		X											STRAFFORD AVE. TH-83		
		G	VR-017	24	30			5.00								1		X										E-141
SB	6.411	H	R1-1	24	24		STOP						1		X											STRAFFORD AVE. TH-83		
		H	R1-1	30	30			6.25								1		X									X	
SB	6.367	F	VR-932	48	30		LEFT "ONLY"/THRU/RIGHT "ONLY"			1				X														
							SHEET TOTALS	16.25	0.00	10	0	0	2	0	0	3		45										
								SF	SF	EA	EA	EA	EA	EA	EA	EA		FT										
							TOWN TOTALS	369.7	0.0	77.0	5.0	5.0	65	0.0	0.0	68		1020.0										

SIGN SUMMARY SHEET

VERMONT AGENCY OF TRANSPORTATION

PROJECT NAME: **Moretown-Newport Town VT100**
PROJECT NUMBER: **STPG SIGN(28)**

FILE NAME: **Morristown.xls** PLOT DATE: **9/29/2009**
PROJECT MANAGER: **N. Averv** DRAWN BY: **I. Shea**
DESIGNED BY: **D. Crosslev** CHECKED BY: **J. Kelly**
MORRISTOWN SHEET 9 SHEET **84** OF **166**

DIRECTION	MILEPOINT	LOCATION CODE (SHEET 2)	SIGN CODE	WIDTH (IN)	HEIGHT (IN)	SHEETING REMARKS	SIGN LEGEND	NEW SIGNS "A"	NEW SIGNS "B"	EXISTING SIGNS RETAIN	EXISTING SIGNS SALVAGE FROM	EXISTING SIGNS SALVAGE TO	EXISTING SIGNS REMOVE	EXIST POST RETAIN	EXIST POST REMOVE	NUMBER OF NEW POSTS	SQUARE STEEL (IN) 1.75 (LB / FT) 1.88	SQUARE STEEL (IN) 2.00 (LB / FT) 2.42	SQUARE STEEL (IN) 2.50 (LB / FT) 3.35	TUBULAR STEEL Ø (IN) FOUNDATION	TUBULAR STEEL Ø (IN) 3.00 (LB / FT) 7.60	TUBULAR STEEL Ø (IN) 3.50 (LB / FT) 9.00	TUBULAR STEEL Ø (IN) 4.00 (LB / FT) 10.80	TUBULAR STEEL Ø (IN) 5.00 (LB / FT) 14.60	SIGN FRAME REQUIRED	REMARKS	SIGN DETAIL: DETAIL IN SHS	SIGN DETAIL: DETAIL ON SHEET NUMBER	SIGN DETAIL: DETAIL ON STD SHEET NUMBER
MORRISTOWN VT 100							FY-FLUORESCENT YELLOW FYG-FLUORESCENT YELLOW GREEN																			"SHS"-STANDARD HIGHWAY SIGNS			
SB	6.277	F	VD-062B	72	16		BUSINESS SIGN			1	I	I			X	2												
		F	VD-062B	72	16		BUSINESS SIGN			1	I	I																
		F	VD-062B	72	16		BUSINESS SIGN			1																		
SB	6.252	G	VR-017	24	30		LEGAL LOAD LIMIT 24,000 LBS			1				X												PROFESSIONAL WAY (TH-82)			
SB	6.246	H	R1-1	30	30		STOP			1				X												PROFESSIONAL WAY (TH-82)			
SB	6.245	F	W3-5	36	36		SPEED REDUCTION SPEED LIMIT 25			1				X														
SB	6.194	F	VR-038	24	18		STATE HIGHWAY ENDS			1	I	I		X		I												
		F	R2-1	24	30								1		X													
		F	R2-1	30	36			7.50								1	X										6	
VILLAGE OF MORRISTOWN																												
SB	4.872	F	VR-039	24	18								1		X													
		F	R2-1	24	30								1														
		F	VR-039	24	18			3.00								1	X								6	
		F	R2-1	24	30			5.00																			X	
SB	4.790	F	R2-1	24	30		SPEED LIMIT 35			1				X														
SIGN SUMMARY SHEET							SHEET TOTALS	15.50 SF	0.00 SF	8 EA	0 EA	0 EA	3 EA	0 EA	0 EA	2 EA	30 FT											
VERMONT AGENCY OF TRANSPORTATION							TOWN TOTALS	369.7	0.0	77.0	5.0	5.0	65	0.0	0.0	68	1020.0											

PROJECT NAME: **Moretown-Newport Town VT100**
PROJECT NUMBER: **STPG SIGN(28)**

FILE NAME: **Morristown.xls** PLOT DATE: **9/29/2009**
PROJECT MANAGER: **N. Avery** DRAWN BY: **I. Shea**
DESIGNED BY: **D. Crossley** CHECKED BY: **J. Kelly**
MORRISTOWN SHEET 10

DIRECTION	MILEPOINT	LOCATION CODE (SHEET 2)	SIGN CODE	WIDTH (IN)	HEIGHT (IN)	SHEETING REMARKS	SIGN LEGEND	NEW SIGNS "A"	NEW SIGNS "B"	EXISTING SIGNS RETAIN	EXISTING SIGNS SALVAGE FROM	EXISTING SIGNS SALVAGE TO	EXISTING SIGNS REMOVE	EXIST POST RETAIN	EXIST POST REMOVE	NUMBER OF NEW POSTS	SQUARE STEEL (IN) 1.75 (LB / FT) 1.88	SQUARE STEEL (IN) 2.00 (LB / FT) 2.42	SQUARE STEEL (IN) 2.50 (LB / FT) 3.35	TUBULAR STEEL Ø (IN) FOUNDATION	TUBULAR STEEL Ø (IN) 3.00 (LB / FT) 7.60	TUBULAR STEEL Ø (IN) 3.50 (LB / FT) 9.00	TUBULAR STEEL Ø (IN) 4.00 (LB / FT) 10.80	TUBULAR STEEL Ø (IN) 5.00 (LB / FT) 14.60	SIGN FRAME REQUIRED	REMARKS	SIGN DETAIL: DETAIL IN SHS	SIGN DETAIL: DETAIL ON SHEET NUMBER	SIGN DETAIL: DETAIL ON STD SHEET NUMBER
MORRISTOWN VT 100							FY-FLUORESCENT YELLOW FYG-FLUORESCENT YELLOW GREEN																			"SHS"-STANDARD HIGHWAY SIGNS			
SB	4.771	F	S1-1YG	36	36		SCHOOL			1				X														
		F	W16-9YG	30	18		AHEAD			1																		
SB	4.724	F	D1-1 E	72	20								1		X													
		F	D1-1	72	20			10.00								2		X										5
SB	4.666	F	W1-2L	30	30		LEFT CURVE						1		X													
		F	M3-3	24	12			2.00								1		X							GREEN ON WHITE SHEETING	X		
		F	M1-5	30	24			5.00																				E-136B
SB	4.617	F	M3-3S	24	12		SOUTH						1		X													
		F	M1-5	30	24		VT 100 						1															
		F	W1-2L	30	30			6.25								1		X									X	
SB	4.600	F	VD-062B	72	16		BUSINESS SIGN			1				X														
		F	VD-062AL	72	16		BUSINESS SIGN			1																		
		F	VD-062B	72	16		BUSINESS SIGN			1																		
SB	4.544	F	R2-1	24	30								1		X													
		F	R2-1	24	30			5.00								1		X										
SIGN SUMMARY SHEET							SHEET TOTALS	28.25	0.00	5	0	0	5	0	0	5		75								
								SF	SF	EA	EA	EA	EA	EA	EA	EA		FT								
VERMONT AGENCY OF TRANSPORTATION							TOWN TOTALS	369.7	0.0	77.0	5.0	5.0	65	0.0	0.0	68		1020.0								

PROJECT NAME: **Moretown-Newport Town VT100**
PROJECT NUMBER: **STPG SIGN(28)**
FILE NAME: **Morristown.xls**
PROJECT MANAGER: **N. Avery**
DESIGNED BY: **D. Crossley**
MORRISTOWN SHEET 11
PLOT DATE: **9/29/2009**
DRAWN BY: **I. Shea**
CHECKED BY: **J. Kelly**
SHEET **86** OF **166**

DIRECTION	MILEPOINT	LOCATION CODE (SHEET 2)	SIGN CODE	WIDTH (IN)	HEIGHT (IN)	SHEETING REMARKS	SIGN LEGEND	NEW SIGNS "A"	NEW SIGNS "B"	EXISTING SIGNS RETAIN	EXISTING SIGNS SALVAGE FROM	EXISTING SIGNS SALVAGE TO	EXISTING SIGNS REMOVE	EXIST POST RETAIN	EXIST POST REMOVE	NUMBER OF NEW POSTS	SQUARE STEEL (IN) (LB / FT) 1.75 / 1.88	SQUARE STEEL (IN) (LB / FT) 2.00 / 2.42	SQUARE STEEL (IN) (LB / FT) 2.50 / 3.35	TUBULAR STEEL Ø (IN) FOUNDATION	TUBULAR STEEL Ø (IN) (LB / FT) 3.00 / 7.60	TUBULAR STEEL Ø (IN) (LB / FT) 3.50 / 9.00	TUBULAR STEEL Ø (IN) (LB / FT) 4.00 / 10.80	TUBULAR STEEL Ø (IN) (LB / FT) 5.00 / 14.60	SIGN FRAME REQUIRED	REMARKS	SIGN DETAIL: DETAIL IN SHS	SIGN DETAIL: DETAIL ON SHEET NUMBER	SIGN DETAIL: DETAIL ON STD SHEET NUMBER
MORRISTOWN VT 100							FY-FLUORESCENT YELLOW FYG-FLUORESCENT YELLOW GREEN																			"SHS"-STANDARD HIGHWAY SIGNS			
SB	4.406	G	VR-017	24	30								1		X											MORRISTOWN CORNERS RD TH-2			
		G	VR-017	24	30			5.00								1		X										E-141
SB	4.398	H	R1-1	30	30								1		X											MORRISTOWN CORNERS RD TH-2			
		H	R1-1	30	30			6.25								1		X								X		
SB	4.374	F	R2-1	24	30		SPEED LIMIT 40 			1				X														
SB	4.340	G	VR-017	24	30			5.00								1		X								MILLER BRIDGE RD TH-42			E-141
SB	4.334	H	R1-1	30	30								1		X											MILLER BRIDGE RD TH-42			
		H	R1-1	30	30			6.25								1		X								X		
SB	4.242	F	R2-1	24	30		SPEED LIMIT 50			1				X														
SB	3.912	F	VW-054R	30	30		HIDDEN DRIVE RIGHT						1		X													
SB	3.492	F	W2-2MR	30	30		RIGHT SIDE ROAD			1				X														
SB	3.411	G	VR-017	24	30								1		X											COCHRAN RD TH-54			
		G	VR-017	24	30			5.00								1		X										E-141
SB	3.401	H	R1-1	30	30								1		X											COCHRAN RD TH-54			
		H	R1-1	30	30			6.25								1		X								X		
SIGN SUMMARY SHEET							SHEET TOTALS	33.75	0.00	3	0	0	6	0	0	6		90								
								SF	SF	EA	EA	EA	EA	EA	EA	EA		FT								
VERMONT AGENCY OF TRANSPORTATION							TOWN TOTALS	369.7	0.0	77.0	5.0	5.0	65	0.0	0.0	68		1020.0								

PROJECT NAME: **Moretown-Newport Town VT100**
PROJECT NUMBER: **STPG SIGN(28)**
FILE NAME: **Morristown.xls**
PROJECT MANAGER: **N. Avery**
DESIGNED BY: **D. Crossley**
MORRISTOWN SHEET 12
PLOT DATE: **9/29/2009**
DRAWN BY: **I. Shea**
CHECKED BY: **J. Kelly**
SHEET **87** OF **166**

DIRECTION	MILEPOINT	LOCATION CODE (SHEET 2)	SIGN CODE	WIDTH (IN)	HEIGHT (IN)	SHEETING REMARKS	SIGN LEGEND	NEW SIGNS "A"	NEW SIGNS "B"	EXISTING SIGNS RETAIN	EXISTING SIGNS SALVAGE FROM	EXISTING SIGNS SALVAGE TO	EXISTING SIGNS REMOVE	EXIST POST RETAIN	EXIST POST REMOVE	NUMBER OF NEW POSTS	SQUARE STEEL (IN) 1.75 (LB / FT) 1.88	SQUARE STEEL (IN) 2.00 (LB / FT) 2.42	SQUARE STEEL (IN) 2.50 (LB / FT) 3.35	TUBULAR STEEL Ø (IN) FOUNDATION	TUBULAR STEEL Ø (IN) 3.00 (LB / FT) 7.60	TUBULAR STEEL Ø (IN) 3.50 (LB / FT) 9.00	TUBULAR STEEL Ø (IN) 4.00 (LB / FT) 10.80	TUBULAR STEEL Ø (IN) 5.00 (LB / FT) 14.60	SIGN FRAME REQUIRED	REMARKS	SIGN DETAIL: DETAIL IN SHS	SIGN DETAIL: DETAIL ON SHEET NUMBER	SIGN DETAIL: DETAIL ON STD SHEET NUMBER
MORRISTOWN VT 100							FY-FLUORESCENT YELLOW FYG-FLUORESCENT YELLOW GREEN																			"SHS"-STANDARD HIGHWAY SIGNS			
SB	3.363	F	R2-1	24	30								1		X														
		F	R2-1	24	30			5.00								1		X									X	
SB	3.148	F	D1-1M	72	10								1		X														
		F	D1-1	72	12			6.00								2		X										5
SB	3.072	F	D4-2	30	36								1		X														
		F	D4-2	30	36			7.50								1		X									X	
SB	2.655	F	W2-2MR	30	30		RIGHT SIDE ROAD						1		X														
		F	VW-054L	30	30		HIDDEN DRIVE LEFT						1																
SB	2.620	F	S3-1	30	30		SCHOOL BUS STOP AHEAD						1		X														
SB	2.532	G	VR-017	30	30								1		X												PLANE VIEW RD TH-92		
		G	VR-017	24	30			5.00								1		X										E-141
SB	2.524	H	R1-1	30	30								1		X												PLANE VIEW RD TH-92		
		H	R1-1	30	30			6.25								1		X									X	
SB	2.286	F	VD-062B	72	16		BUSINESS SIGN			1				X														
SB	2.244	G	VR-017	24	30								1		X												GOLF COURSE RD TH-55		
							SHEET TOTALS	29.75 SF	0.00 SF	1 EA	0 EA	0 EA	9 EA	0 EA	0 EA	6 EA		90 FT									
							TOWN TOTALS	369.7	0.0	77.0	5.0	5.0	65	0.0	0.0	68		1020.0										

SIGN SUMMARY SHEET

VERMONT AGENCY OF TRANSPORTATION

PROJECT NAME: **Moretown-Newport Town VT100**
PROJECT NUMBER: **STPG SIGN(28)**

FILE NAME: **Morristown.xls** PLOT DATE: **9/29/2009**
PROJECT MANAGER: **N. Averv** DRAWN BY: **I. Shea**
DESIGNED BY: **D. Crosslev** CHECKED BY: **J. Kelly**
MORRISTOWN SHEET 13 SHEET **88** OF **166**

DIRECTION	MILEPOINT	LOCATION CODE (SHEET 2)	SIGN CODE	WIDTH (IN)	HEIGHT (IN)	SHEETING REMARKS	SIGN LEGEND	NEW SIGNS "A"	NEW SIGNS "B"	EXISTING SIGNS RETAIN	EXISTING SIGNS SALVAGE FROM	EXISTING SIGNS SALVAGE TO	EXISTING SIGNS REMOVE	EXIST POST RETAIN	EXIST POST REMOVE	NUMBER OF NEW POSTS	SQUARE STEEL (IN) 1.75 (LB / FT) 1.88	SQUARE STEEL (IN) 2.00 (LB / FT) 2.42	SQUARE STEEL (IN) 2.50 (LB / FT) 3.35	TUBULAR STEEL Ø (IN) FOUNDATION	TUBULAR STEEL Ø (IN) 3.00 (LB / FT) 7.60	TUBULAR STEEL Ø (IN) 3.50 (LB / FT) 9.00	TUBULAR STEEL Ø (IN) 4.00 (LB / FT) 10.80	TUBULAR STEEL Ø (IN) 5.00 (LB / FT) 14.60	SIGN FRAME REQUIRED	REMARKS	SIGN DETAIL: DETAIL IN SHS	SIGN DETAIL: DETAIL ON SHEET NUMBER	SIGN DETAIL: DETAIL ON STD SHEET NUMBER
MORRISTOWN VT 100							FY-FLUORESCENT YELLOW FYG-FLUORESCENT YELLOW GREEN																			"SHS"-STANDARD HIGHWAY SIGNS			
		G	VR-017	24	30			5.00								1		X										E-141
SB	2.238	H	R1-1	30	30								1		X											GOLF COURSE RD TH-55			
		H	R1-1	30	30			6.25								1		X									X		
SB	1.957	F	VD-062B	72	16		BUSINESS SIGN			1				X															
SB	1.780	F	W11-7	30	30		EQUESTRIAN			1				X															
SB	1.760	F	W2-2ML	30	30		MODIFIED LEFT SIDE ROAD			1				X															
			W16-8A	30	8			1.67																				8	
SB	1.529	G	VR-017	24	30								1		X											RYDER BROOK RD TH-115			
		G	VR-017	24	30			5.00								1		X											E-141
SB	1.523	H	R1-1	30	30								1		X											RYDER BROOK RD TH-115			
		H	R1-1	30	30			6.25								1		X									X		
SB	1.183	F	W1-2R	30	30		RIGHT CURVE MODIFIED						1		X														
		F	W13-1	18	18		40 MPH PLAQUE						1																
SB	1.122	F	VW-054R	30	30		HIDDEN DRIVE RIGHT 						1		X														
SB	1.085	F	VW-054R	30	30			6.25								1		X									INSTALL 200 +/- SOUTH OF ORIGINAL SIGN LOCATION			E-154
							SHEET TOTALS	30.42	0.00	3	0	0	6	0	0	5		75										
								SF	SF	EA	EA	EA	EA	EA	EA	EA		FT										
							TOWN TOTALS	369.7	0.0	77.0	5.0	5.0	65	0.0	0.0	68		1020.0										

SIGN SUMMARY SHEET

VERMONT AGENCY OF TRANSPORTATION



PROJECT NAME: **Moretown-Newport Town VT100**
PROJECT NUMBER: **STPG SIGN(28)**

FILE NAME: **Morristown.xls**
PROJECT MANAGER: **N. Avery**
DESIGNED BY: **D. Crossley**
MORRISTOWN SHEET 14

PLOT DATE: **9/29/2009**
DRAWN BY: **I. Shea**
CHECKED BY: **J. Kelly**

DIRECTION	MILEPOINT	LOCATION CODE (SHEET 2)	SIGN CODE	WIDTH (IN)	HEIGHT (IN)	SHEETING REMARKS	SIGN LEGEND	NEW SIGNS "A"	NEW SIGNS "B"	EXISTING SIGNS RETAIN	EXISTING SIGNS SALVAGE FROM	EXISTING SIGNS SALVAGE TO	EXISTING SIGNS REMOVE	EXIST POST RETAIN	EXIST POST REMOVE	NUMBER OF NEW POSTS	SQUARE STEEL (IN) 1.75 (LB / FT) 1.88	SQUARE STEEL (IN) 2.00 (LB / FT) 2.42	SQUARE STEEL (IN) 2.50 (LB / FT) 3.35	TUBULAR STEEL Ø (IN) FOUNDATION	TUBULAR STEEL Ø (IN) 3.00 (LB / FT) 7.60	TUBULAR STEEL Ø (IN) 3.50 (LB / FT) 9.00	TUBULAR STEEL Ø (IN) 4.00 (LB / FT) 10.80	TUBULAR STEEL Ø (IN) 5.00 (LB / FT) 14.60	SIGN FRAME REQUIRED	REMARKS	SIGN DETAIL: DETAIL IN SHS	SIGN DETAIL: DETAIL ON SHEET NUMBER	SIGN DETAIL: DETAIL ON STD SHEET NUMBER
MORRISTOWN VT 100							FY-FLUORESCENT YELLOW FYG-FLUORESCENT YELLOW GREEN																			"SHS"-STANDARD HIGHWAY SIGNS			
SB	1.057	F	W1-2R	30	30			6.25								1		X								INSTALL 150' +/- SOUTH OF NEW HIDDEN DRIVE RIGHT SIGN	X		
		F	W13-1	24	24			4.00																			X		
SB	0.760	G	VR-017	24	30								1		X												VANASSE RD TH-87			
		G	VR-017	24	30			5.00								1		X											E-141
SB	0.754	H	R1-1	30	30		STOP			1				X												VANASSE RD TH-87			
SB	0.634	G	VR-017	24	30								1		X												LAWRENCE RD TH-71			
		G	VR-017	24	30			5.00								1		X											E-141
SB	0.627	H	R1-1	30	30								1		X												LAWRENCE RD TH-71			
		H	R1-1	30	30			6.25								1		X										X	
SB	0.000	G	VD-024	60	7.5		STOWE/MORRISTOWN						1		X														
SIGN SUMMARY SHEET							SHEET TOTALS	26.50 SF	0.00 SF	1 EA	0 EA	0 EA	4 EA	0 EA	0 EA	4 EA		60 FT									
VERMONT AGENCY OF TRANSPORTATION							TOWN TOTALS	369.7	0.0	77.0	5.0	5.0	65	0.0	0.0	68		1020.0									

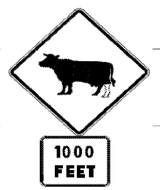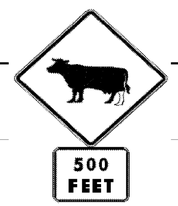PROJECT NAME: **Moretown-Newport Town VT100**
PROJECT NUMBER: **STPG SIGN(28)**
FILE NAME: **Morristown.xls**
PROJECT MANAGER: **N. Avery**
DESIGNED BY: **D. Crossley**
MORRISTOWN SHEET 15
PLOT DATE: **9/29/2009**
DRAWN BY: **I. Shea**
CHECKED BY: **J. Kelly**
SHEET **90** OF **166**

DIRECTION	MILEPOINT	LOCATION CODE (SHEET 2)	SIGN CODE	WIDTH (IN)	HEIGHT (IN)	SHEETING REMARKS	SIGN LEGEND	NEW SIGNS "A"	NEW SIGNS "B"	EXISTING SIGNS RETAIN	EXISTING SIGNS SALVAGE FROM	EXISTING SIGNS SALVAGE TO	EXISTING SIGNS REMOVE	EXIST POST RETAIN	EXIST POST REMOVE	NUMBER OF NEW POSTS	SQUARE STEEL (IN) 1.75 (LB / FT) 1.88	SQUARE STEEL (IN) 2.00 (LB / FT) 2.42	SQUARE STEEL (IN) 2.50 (LB / FT) 3.35	TUBULAR STEEL Ø (IN) FOUNDATION	TUBULAR STEEL Ø (IN) 3.00 (LB / FT) 7.60	TUBULAR STEEL Ø (IN) 3.50 (LB / FT) 9.00	TUBULAR STEEL Ø (IN) 4.00 (LB / FT) 10.80	TUBULAR STEEL Ø (IN) 5.00 (LB / FT) 14.60	SIGN FRAME REQUIRED	REMARKS	SIGN DETAIL: DETAIL IN SHS	SIGN DETAIL: DETAIL ON SHEET NUMBER	SIGN DETAIL: DETAIL ON STD SHEET NUMBER
HYDE PARK VT 100							FY-FLUORESCENT YELLOW FYG-FLUORESCENT YELLOW GREEN																			"SHS"-STANDARD HIGHWAY SIGNS			
NB	0.017	B	R1-1	36	36		STOP			1				X														
NB	0.062	A	M3-1S	24	12		NORTH			1				X														
		A	M1-5	30	24		VERMONT 100			1																		
NB	0.098	A	D2-1	72	10								1		X													
		A	D2-1	72	10								1															
		A	D2-1	72	12			6.00								2		X							5	
		A	D2-1	72	12			6.00																			5	
NB	0.140	A	R2-1	24	30		SPEED LIMIT 50			1				X														
NB	0.234	B	W3-1	36	36		STOP AHEAD			1				X														
NB	0.810	A	W11-4	30	30								1		X													
		A	W16-2	24	18								1															
		A	W11-4	30	30	FY		6.25								1		X							X	
		A	W16-2	24	18	FY		3.00																			X	
NB	0.897	A	W11-4	30	30	FY		6.25								1		X								INSTALL 500 ' +/- NORTH OF PREVIOUS CATTLE SIGN	X	
		A	W16-2	24	18	FY		3.00																			X	
							SHEET TOTALS	30.50 SF	0.00 SF	5 EA	0 EA	0 EA	4 EA	0 EA	0 EA	4 EA		60 FT										
							TOWN TOTALS	287.3	0.0	80.0	0.0	0.0	54	0.0	0.0	42		630.0										

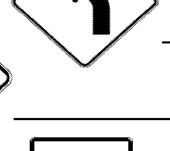
SIGN SUMMARY SHEET

VERMONT AGENCY OF TRANSPORTATION

PROJECT NAME: Moretown-Newport Town VT100
PROJECT NUMBER: STPG SIGN(28)

FILE NAME: Hyde Park.xls
PROJECT MANAGER: N. Avery
DESIGNED BY: D. Crossley
HYDE PARK SHEET 1

PLOT DATE: 9/29/2009
DRAWN BY: I. Shea
CHECKED BY: J. Kelly

DIRECTION	MILEPOINT	LOCATION CODE (SHEET 2)	SIGN CODE	WIDTH (IN)	HEIGHT (IN)	SHEETING REMARKS	SIGN LEGEND	NEW SIGNS "A"	NEW SIGNS "B"	EXISTING SIGNS RETAIN	EXISTING SIGNS SALVAGE FROM	EXISTING SIGNS SALVAGE TO	EXISTING SIGNS REMOVE	EXIST POST RETAIN	EXIST POST REMOVE	NUMBER OF NEW POSTS	SQUARE STEEL (IN) (LB / FT) 1.75 / 1.88	SQUARE STEEL (IN) (LB / FT) 2.00 / 2.42	SQUARE STEEL (IN) (LB / FT) 2.50 / 3.35	TUBULAR STEEL Ø (IN) FOUNDATION	TUBULAR STEEL Ø (IN) (LB / FT) 3.00 / 7.60	TUBULAR STEEL Ø (IN) (LB / FT) 3.50 / 9.00	TUBULAR STEEL Ø (IN) (LB / FT) 4.00 / 10.80	TUBULAR STEEL Ø (IN) (LB / FT) 5.00 / 14.60	SIGN FRAME REQUIRED	REMARKS	SIGN DETAIL: DETAIL IN SHS	SIGN DETAIL: DETAIL ON SHEET NUMBER	SIGN DETAIL: DETAIL ON STD SHEET NUMBER
HYDE PARK VT 100							FY-FLUORESCENT YELLOW FYG-FLUORESCENT YELLOW GREEN																			"SHS"-STANDARD HIGHWAY SIGNS			
NB	1.660	A	VW-202	30	30		TRUCKS ENTERING						1		X													
NB	1.750	A	VW-202	30	30			6.25								1		X							INSTALL 475' +/- NORTH OF ORIGINAL SIGN LOCATION			E-154
NB	2.590	A	VD-062B	72	16		BUSINESS SIGN			1				X														
NB	2.730	C	VR-017	24	30								1		X											LONGMORE HILL RD TH-31			
		C	VR-017	24	30			5.00								1		X										E-141
NB	2.738	D	R1-1	30	30								1		X											LONGMORE HILL RD TH-31			
		D	R1-1	30	30			6.25								1		X									X	
NB	2.860	A	W1-2L	30	30		LEFT CURVE						1		X													
NB	2.890	A	VW-054L	30	30		HIDDEN DRIVE LEFT						1		X													
NB	2.920	A	W1-2L	30	30			6.25								1		X							INSTALL 150' +/- NORTH OF REMOVED HIDDEN DRIVE LEFT SIGN	X		
NB	2.950	A	VW-054L	30	30			6.25								1		X									INSTALL 150' +/- NORTH OF NEW LEFT CURVE SIGN			E-154
NB	3.756	C	VR-017	24	30								1		X											FLEURY RD TH-25			
		C	VR-017	24	30			5.00								1		X										E-141
NB	3.750	D	R1-1	30	30								1		X											FLEURY RD TH-25			
		D	R1-1	30	30			6.25								1		X									X	
							SHEET TOTALS	41.25 SF	0.00 SF	1 EA	0 EA	0 EA	7 EA	0 EA	0 EA	7 EA		105 FT										
							TOWN TOTALS	287.3	0.0	80.0	0.0	0.0	54	0.0	0.0	42		630.0										

SIGN SUMMARY SHEET

VERMONT AGENCY OF TRANSPORTATION

PROJECT NAME: **Moretown-Newport Town VT100**
PROJECT NUMBER: **STPG SIGN(28)**

FILE NAME: **Hyde Park.xls**
PROJECT MANAGER: **N. Avery**
DESIGNED BY: **D. Crossley**
HYDE PARK SHEET 2

PLOT DATE: **9/29/2009**
DRAWN BY: **I. Shea**
CHECKED BY: **J. Kelly**
SHEET **92** OF **166**

DIRECTION	MILEPOINT	LOCATION CODE (SHEET 2)	SIGN CODE	WIDTH (IN)	HEIGHT (IN)	SHEETING REMARKS	SIGN LEGEND	NEW SIGNS "A"	NEW SIGNS "B"	EXISTING SIGNS RETAIN	EXISTING SIGNS SALVAGE FROM	EXISTING SIGNS SALVAGE TO	EXISTING SIGNS REMOVE	EXIST POST RETAIN	EXIST POST REMOVE	NUMBER OF NEW POSTS	SQUARE STEEL (IN) 1.75 (LB / FT) 1.88	SQUARE STEEL (IN) 2.00 (LB / FT) 2.42	SQUARE STEEL (IN) 2.50 (LB / FT) 3.35	TUBULAR STEEL Ø (IN) FOUNDATION	TUBULAR STEEL Ø (IN) 3.00 (LB / FT) 7.60	TUBULAR STEEL Ø (IN) 3.50 (LB / FT) 9.00	TUBULAR STEEL Ø (IN) 4.00 (LB / FT) 10.80	TUBULAR STEEL Ø (IN) 5.00 (LB / FT) 14.60	SIGN FRAME REQUIRED	REMARKS	SIGN DETAIL: DETAIL IN SHS	SIGN DETAIL: DETAIL ON SHEET NUMBER	SIGN DETAIL: DETAIL ON STD SHEET NUMBER
HYDE PARK VT 100							FY-FLUORESCENT YELLOW FYG-FLUORESCENT YELLOW GREEN																			"SHS"-STANDARD HIGHWAY SIGNS			
NB	3.875	A	W2-2MaL	30	30		LEFT SIDE ROAD			1				X														
		A	W16-8	24	8		WHITAKER RD			1				X														
NB	4.747	A	VD-018	30	18		N. HYDE PARK EDEN 4						1		X													
		A	VD-018	30	18			3.75								1		X										E-128B
NB	4.783	A	W3-5	36	36		SPEED REDUCTION SPEED LIMIT 40			1				X														
NB	4.822	A	W2-2MaL	30	30		LEFT SIDE ROAD			1				X														
		A	W16-8	24	8		WILSON RD			1																		
NB	4.861	A	R2-1	30	36		SPEED LIMIT 40			1				X														
NB	4.894	A	M2-1S	21	15		JCT			1				X														
		A	M1-5	30	24		ROUTE 100C			1																		
NB	4.933	A	W11-2YG	30	30		PEDESTRIAN			1				X														
		A	W11-2PBYG	24	18		BLIND PERSON			1																		
NB	4.970	A	W1-1MaR	30	30		MODIFIED RIGHT TURN						1		X													
		A	W13-1	18	18		30 MPH PLAQUE						1															
NB	5.020	A	VW-054R	30	30		HIDDEN DRIVE RIGHT						1		X													
							SHEET TOTALS	3.75	0.00	10	0	0	4	0	0	1		15										
								SF	SF	EA	EA	EA	EA	EA	EA	EA		FT										
							TOWN TOTALS	287.3	0.0	80.0	0.0	0.0	54	0.0	0.0	42		630.0										

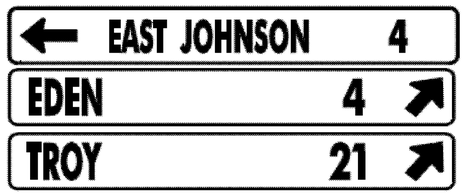
SIGN SUMMARY SHEET

VERMONT AGENCY OF TRANSPORTATION

PROJECT NAME: **Moretown-Newport Town VT100**
PROJECT NUMBER: **STPG SIGN(28)**

FILE NAME: **Hyde Park.xls**
PROJECT MANAGER: **N. Avery**
DESIGNED BY: **D. Crossley**
HYDE PARK SHEET 3

PLOT DATE: **9/29/2009**
DRAWN BY: **I. Shea**
CHECKED BY: **J. Kelly**

DIRECTION	MILEPOINT	LOCATION CODE (SHEET 2)	SIGN CODE	WIDTH (IN)	HEIGHT (IN)	SHEETING REMARKS	SIGN LEGEND	NEW SIGNS "A"	NEW SIGNS "B"	EXISTING SIGNS RETAIN	EXISTING SIGNS SALVAGE FROM	EXISTING SIGNS SALVAGE TO	EXISTING SIGNS REMOVE	EXIST POST RETAIN	EXIST POST REMOVE	NUMBER OF NEW POSTS	SQUARE STEEL (IN) (LB / FT) 1.75 / 1.88	SQUARE STEEL (IN) (LB / FT) 2.00 / 2.42	SQUARE STEEL (IN) (LB / FT) 2.50 / 3.35	TUBULAR STEEL Ø (IN) FOUNDATION	TUBULAR STEEL Ø (IN) (LB / FT) 3.00 / 7.60	TUBULAR STEEL Ø (IN) (LB / FT) 3.50 / 9.00	TUBULAR STEEL Ø (IN) (LB / FT) 4.00 / 10.80	TUBULAR STEEL Ø (IN) (LB / FT) 5.00 / 14.60	SIGN FRAME REQUIRED	REMARKS	SIGN DETAIL: DETAIL IN SHS	SIGN DETAIL: DETAIL ON SHEET NUMBER	SIGN DETAIL: DETAIL ON STD SHEET NUMBER
HYDE PARK VT 100							FY-FLUORESCENT YELLOW FYG-FLUORESCENT YELLOW GREEN																			"SHS"-STANDARD HIGHWAY SIGNS			
NB	5.040	A	W1-10 R	30	30			6.25								1		X							INSTALL 100' +/- NORTH OF REMOVED HIDDEN DRIVE RIGHT SIGN	X		
			W13-1	24	24			4.00																			X		
NB	5.067	A	D1-1A	72	10								1		X														
		A	D1-1A	72	10								1																
		A	D1-1	72	10								1																
		A	D1-1	72	12			6.00								2		X								5	
		A	D1-1	72	12			6.00																				5	
		A	D1-1	72	12			6.00																				5	
NB	5.086	A	R2-1	30	36		SPEED LIMIT 35			1				X															
NB	5.120	A	M3-3S	24	12		SOUTH			1				X															
		A	M1-5	30	24		VERMONT 100C			1																			
		A	M6-1S	21	15		<--- LEFT			1																			
		A	M3-1S	24	12		NORTH			1																			
		A	M1-5	30	24		VERMONT 100			1																			
		A	M6-2S	21	15		RIGHT ---> (45 DEG)			1																			
							SHEET TOTALS	28.25	0.00	7	0	0	3	0	0	3		45										
								SF	SF	EA	EA	EA	EA	EA	EA	EA		FT										
							TOWN TOTALS	287.3	0.0	80.0	0.0	0.0	54	0.0	0.0	42		630.0										

SIGN SUMMARY SHEET

VERMONT AGENCY OF TRANSPORTATION

PROJECT NAME: **Moretown-Newport Town VT100**
PROJECT NUMBER: **STPG SIGN(28)**

FILE NAME: **Hyde Park.xls** PLOT DATE: **9/29/2009**
PROJECT MANAGER: **N. Avery** DRAWN BY: **I. Shea**
DESIGNED BY: **D. Crossley** CHECKED BY: **J. Kelly**
HYDE PARK SHEET 4 SHEET **94** OF **166**

DIRECTION	MILEPOINT	LOCATION CODE (SHEET 2)	SIGN CODE	WIDTH (IN)	HEIGHT (IN)	SHEETING REMARKS	SIGN LEGEND	NEW SIGNS "A"	NEW SIGNS "B"	EXISTING SIGNS RETAIN	EXISTING SIGNS SALVAGE FROM	EXISTING SIGNS SALVAGE TO	EXISTING SIGNS REMOVE	EXIST POST RETAIN	EXIST POST REMOVE	NUMBER OF NEW POSTS	SQUARE STEEL (IN) 1.75 (LB / FT) 1.88	SQUARE STEEL (IN) 2.00 (LB / FT) 2.42	SQUARE STEEL (IN) 2.50 (LB / FT) 3.35	TUBULAR STEEL Ø (IN) FOUNDATION	TUBULAR STEEL Ø (IN) 3.00 (LB / FT) 7.60	TUBULAR STEEL Ø (IN) 3.50 (LB / FT) 9.00	TUBULAR STEEL Ø (IN) 4.00 (LB / FT) 10.80	TUBULAR STEEL Ø (IN) 5.00 (LB / FT) 14.60	SIGN FRAME REQUIRED	REMARKS	SIGN DETAIL: DETAIL IN SHS	SIGN DETAIL: DETAIL ON SHEET NUMBER	SIGN DETAIL: DETAIL ON STD SHEET NUMBER
HYDE PARK VT 100							FY-FLUORESCENT YELLOW FYG-FLUORESCENT YELLOW GREEN																			"SHS"-STANDARD HIGHWAY SIGNS			
NB	5.139	C	W1-7	48	24		<===> DOUBLE ARROW	8.00		~~1~~				~~X~~		2		X										
NB	5.177	A	M3-1S	24	12		NORTH			1				X														
		A	M1-5	30	24		VERMONT 100			1																		
NB	5.196	A	D2-1	72	10								1		X													
		A	D2-1	72	10								1															
		A	D2-1	72	12		EDEN 4	6.00								2		X										5
		A	D2-1	72	12		TROY 21	6.00																				5
NB	5.232	A	R2-1	24	30		SPEED LIMIT 35			1				X														
NB	5.330	A	VD-062B	72	16		BUSINESS SIGNS			1				X														
		A	VD-062B	72	16		BUSINESS SIGNS			1																		
NB	5.551	C	VR-017	24	30		LEGAL LOAD LIMIT 24,000 POUNDS						2 ~~1~~		X												FERRY ST TH-3		
		C	VR-017	24	30			5.00								1		X											E-141
		D	R1-1	30	30		STOP	6.25								1		X									FERRY ST TH-3	X	
NB	5.605	A	R2-1	24	30		SPEED LIMIT 35			1				X														
NB	5.789	A	R2-1	24	30		SPEED LIMIT 50			1				X														
							SHEET TOTALS	23.25 SF	0.00 SF	8 EA	0 EA	0 EA	3 EA	0 EA	0 EA	4 EA		60 FT										
							TOWN TOTALS	287.3	0.0	80.0	0.0	0.0	54	0.0	0.0	42		630.0										

SIGN SUMMARY SHEET

VERMONT AGENCY OF TRANSPORTATION

PROJECT NAME: Moretown-Newport Town VT100
PROJECT NUMBER: STPG SIGN(28)


FILE NAME: Hyde Park.xls
PROJECT MANAGER: N. Avery
DESIGNED BY: D. Crossley
HYDE PARK SHEET 5

PLOT DATE: 9/29/2009
DRAWN BY: I. Shea
CHECKED BY: J. Kelly

DIRECTION	MILEPOINT	LOCATION CODE (SHEET 2)	SIGN CODE	WIDTH (IN)	HEIGHT (IN)	SHEETING REMARKS	SIGN LEGEND	NEW SIGNS		EXISTING SIGNS				EXIST POST		NUMBER OF NEW POSTS	SQUARE STEEL (IN)			TUBULAR STEEL Ø (IN)					SIGN FRAME REQUIRED	REMARKS	SIGN DETAIL		
								"A"	"B"	RETAIN	SALVAGE FROM	SALVAGE TO	REMOVE	RETAIN	REMOVE		1.75 (LB / FT) 1.88	2.00 (LB / FT) 2.42	2.50 (LB / FT) 3.35	FOUNDATION	3.00 (LB / FT) 7.60	3.50 (LB / FT) 9.00	4.00 (LB / FT) 10.80	5.00 (LB / FT) 14.60			DETAIL IN SHS	DETAIL ON SHEET NUMBER	DETAIL ON STD SHEET NUMBER
HYDE PARK VT 100							FY-FLUORESCENT YELLOW FYG-FLUORESCENT YELLOW GREEN																		"SHS"-STANDARD HIGHWAY SIGNS			
SB	5.956	F	VD-062B	72	16		BUSINESS SIGN			1				X														
		F	VD-062B	72	16		BUSINESS SIGN			1																		
SB	5.899	F	W3-5	36	36		SPEED REDUCTION SPEED LIMIT 35			1				X														
SB	5.844	E	VD-018	30	18								1		X													
		E	VD-018	30	18			3.75								1		X										
SB	5.790	F	R2-1	30	36		SPEED LIMIT 35			1				X														
SB	5.758	G	VR-017	24	30								1		X											MUDGET HILL RD TH-77			
		G	VR-017	24	30			5.00								1		X										E-141
SB	5.750	H	R1-1	30	30		STOP			1				X														
SB	5.680	F	R2-1	24	30		SPEED LIMIT 35			1				X														
SB	5.605	F	W11-2YG	30	30		PEDESTRIAN			1				X														
		F	W11-2PBYG	24	18		BLIND PERSON			1																		
SB	5.408	F	R2-1	24	30		SPEED LIMIT 35			1				X														
SB	5.274	F	W1-10L	30	30		MODIFIED LEFT CURVE						1		X													
		F	W13-1	18	18		30 MPH PLAQUE						1															
SIGN SUMMARY SHEET							SHEET TOTALS	8.75	0.00	9	0	0	4	0	0	2	30										
								SF	SF	EA	EA	EA	EA	EA	EA	EA	FT										
VERMONT AGENCY OF TRANSPORTATION							TOWN TOTALS	287.3	0.0	80.0	0.0	0.0	54	0.0	0.0	42	630.0										

PROJECT NAME: **Moretown-Newport Town VT100**
PROJECT NUMBER: **STPG SIGN(28)**

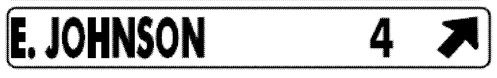FILE NAME: **Hyde Park.xls** PLOT DATE: **9/29/2009**
PROJECT MANAGER: **N. Avery** DRAWN BY: **I. Shea**
DESIGNED BY: **D. Crossley** CHECKED BY: **J. Kelly**
HYDE PARK SHEET 6 SHEET **96** OF **166**

DIRECTION	MILEPOINT	LOCATION CODE (SHEET 2)	SIGN CODE	WIDTH (IN)	HEIGHT (IN)	SHEETING REMARKS	SIGN LEGEND	NEW SIGNS "A"	NEW SIGNS "B"	EXISTING SIGNS RETAIN	EXISTING SIGNS SALVAGE FROM	EXISTING SIGNS SALVAGE TO	EXISTING SIGNS REMOVE	EXIST POST RETAIN	EXIST POST REMOVE	NUMBER OF NEW POSTS	SQUARE STEEL (IN) 1.75 (LB / FT) 1.88	SQUARE STEEL (IN) 2.00 (LB / FT) 2.42	SQUARE STEEL (IN) 2.50 (LB / FT) 3.35	TUBULAR STEEL Ø (IN) FOUNDATION	TUBULAR STEEL Ø (IN) 3.00 (LB / FT) 7.60	TUBULAR STEEL Ø (IN) 3.50 (LB / FT) 9.00	TUBULAR STEEL Ø (IN) 4.00 (LB / FT) 10.80	TUBULAR STEEL Ø (IN) 5.00 (LB / FT) 14.60	SIGN FRAME REQUIRED	REMARKS	SIGN DETAIL: DETAIL IN SHS	SIGN DETAIL: DETAIL ON SHEET NUMBER	SIGN DETAIL: DETAIL ON STD SHEET NUMBER
HYDE PARK		**VT 100**					FY-FLUORESCENT YELLOW FYG-FLUORESCENT YELLOW GREEN																			"SHS"-STANDARD HIGHWAY SIGNS			
SB	5.234	F	M2-1S	21	15		JCT			1				X														
		F	M1-5	30	24		VERMONT 100C			1																		
SB	5.205	F	D1-1A	72	10								1		X													
		F	D1-1A	72	10								1															
		F	D1-1A	72	10								1															
		F	D1-1A	72	12			6.00								2		X								5	
		F	D1-1A	72	12			6.00																		5	
		F	D1-1A	72	12			6.00																		5	
SB	5.143	F	M3-3S	24	12		SOUTH			1				X														
		F	M1-5	30	24		VERMONT 100			1																		
		F	M6-2 L	21	15		<--- LEFT (45 DEG)			1																		
		F	M4-5S	24	12		TO			1																		
		F	M3-2S	24	12		EAST			1																		
		F	M1-5	24	24		VERMONT 15			1																		
		F	M6-2S	21	15		<--- LEFT (45 DEG)			1																		
							SHEET TOTALS	18.00	0.00	9	0	0	3	0	0	2		30										
								SF	SF	EA	EA	EA	EA	EA	EA	EA		FT										
							TOWN TOTALS	287.3	0.0	80.0	0.0	0.0	54	0.0	0.0	42		630.0										

SIGN SUMMARY SHEET

VERMONT AGENCY OF TRANSPORTATION

PROJECT NAME: **Moretown-Newport Town VT100**
PROJECT NUMBER: **STPG SIGN(28)**

FILE NAME: **Hyde Park.xls** PLOT DATE: **9/29/2009**
PROJECT MANAGER: **N. Averv** DRAWN BY: **I. Shea**
DESIGNED BY: **D. Crosslev** CHECKED BY: **J. Kelly**
HYDE PARK SHEET 7 SHEET **97** OF **166**

DIRECTION	MILEPOINT	LOCATION CODE (SHEET 2)	SIGN CODE	WIDTH (IN)	HEIGHT (IN)	SHEETING REMARKS	SIGN LEGEND	NEW SIGNS "A"	NEW SIGNS "B"	EXISTING SIGNS RETAIN	EXISTING SIGNS SALVAGE FROM	EXISTING SIGNS SALVAGE TO	EXISTING SIGNS REMOVE	EXIST POST RETAIN	EXIST POST REMOVE	NUMBER OF NEW POSTS	SQUARE STEEL (IN) 1.75 (LB / FT) 1.88	SQUARE STEEL (IN) 2.00 (LB / FT) 2.42	SQUARE STEEL (IN) 2.50 (LB / FT) 3.35	TUBULAR STEEL Ø (IN) FOUNDATION	TUBULAR STEEL Ø (IN) 3.00 (LB / FT) 7.60	TUBULAR STEEL Ø (IN) 3.50 (LB / FT) 9.00	TUBULAR STEEL Ø (IN) 4.00 (LB / FT) 10.80	TUBULAR STEEL Ø (IN) 5.00 (LB / FT) 14.60	SIGN FRAME REQUIRED	REMARKS	SIGN DETAIL: DETAIL IN SHS	SIGN DETAIL: DETAIL ON SHEET NUMBER	SIGN DETAIL: DETAIL ON STD SHEET NUMBER
HYDE PARK VT 100							FY-FLUORESCENT YELLOW FYG-FLUORESCENT YELLOW GREEN																			"SHS"-STANDARD HIGHWAY SIGNS			
		F	M3-3S	24	12		SOUTH			1																		
		F	M1-5	30	24		VERMONT 100C			1																		
		F	M6-2	21	15		RIGHT ---> (45 DEG)			1																		
		F	M4-5S	24	12		TO			1																		
		F	M3-4S	24	12		WEST			1																		
		F	M1-5	24	24		VERMONT 15			1																		
		F	M6-2S	21	15		RIGHT ---> (45 DEG)			1																		
SB	5.114	F	D1-1A	72	12		HYDE PARK 5			1				X														
		F	D1-1A	72	12		MORRISVILLE 8			1																		
		F	M3-3S	24	12		SOUTH			1																		
		F	M1-5	30	24		VERMONT 100			1																		
SB	5.094	F	R2-1	24	30		SPEED LIMIT 40			1				X														
SB	4.913	G	VR-017	24	30		LEGAL LOAD LIMIT 24,000 POUNDS						1		X												WILSON RD TH-6			
		G	VR-017	24	30			5.00								1		X											E-141
SB	4.905	H	R1-1	30	30		STOP	6.25		~~1~~				~~X~~	X	1										WILSON RD TH--6	X		
							SHEET TOTALS	5.00 SF	0.00 SF	13 EA	0 EA	0 EA	1 EA	0 EA	0 EA	1 EA			15 FT									
							TOWN TOTALS	287.3	0.0	80.0	0.0	0.0	54	0.0	0.0	42			630.0									

SIGN SUMMARY SHEET

VERMONT AGENCY OF TRANSPORTATION

PROJECT NAME: **Moretown-Newport Town VT100**
PROJECT NUMBER: **STPG SIGN(28)**

FILE NAME: **Hyde Park.xls**
PROJECT MANAGER: **N. Avery**
DESIGNED BY: **D. Crossley**
HYDE PARK SHEET 8

PLOT DATE: **9/29/2009**
DRAWN BY: **I. Shea**
CHECKED BY: **J. Kelly**

DIRECTION	MILEPOINT	LOCATION CODE (SHEET 2)	SIGN CODE	WIDTH (IN)	HEIGHT (IN)	SHEETING REMARKS	SIGN LEGEND	NEW SIGNS "A"	NEW SIGNS "B"	EXISTING SIGNS RETAIN	EXISTING SIGNS SALVAGE FROM	EXISTING SIGNS SALVAGE TO	EXISTING SIGNS REMOVE	EXIST POST RETAIN	EXIST POST REMOVE	NUMBER OF NEW POSTS	SQUARE STEEL (IN) 1.75 (LB / FT) 1.88	SQUARE STEEL (IN) 2.00 (LB / FT) 2.42	SQUARE STEEL (IN) 2.50 (LB / FT) 3.35	TUBULAR STEEL Ø (IN) FOUNDATION	TUBULAR STEEL Ø (IN) 3.00 (LB / FT) 7.60	TUBULAR STEEL Ø (IN) 3.50 (LB / FT) 9.00	TUBULAR STEEL Ø (IN) 4.00 (LB / FT) 10.80	TUBULAR STEEL Ø (IN) 5.00 (LB / FT) 14.60	SIGN FRAME REQUIRED	REMARKS	SIGN DETAIL: DETAIL IN SHS	SIGN DETAIL: DETAIL ON SHEET NUMBER	SIGN DETAIL: DETAIL ON STD SHEET NUMBER
HYDE PARK VT 100							FY-FLUORESCENT YELLOW FYG-FLUORESCENT YELLOW GREEN																			"SHS"-STANDARD HIGHWAY SIGNS			
SB	4.861	F	R2-1	24	30		SPEED LIMIT 50			1				X															
SB	4.370	G	VR-017	24	30								1		X											EBENEZER RD TH-89			
		G	VR-017	24	30			5.00								1		X											E-141
SB	4.361	H	R1-1	30	30		STOP			1				X													EBENEZER RD TH-89			
SB	3.967	G	VR-017	24	30								1		X											WHITAKER RD TH-6			
		G	VR-017	24	30			5.00								1		X											E-141
SB	3.959	H	R1-1	30	30								1		X											WHITAKER RD TH-6			
		H	R1-1	30	30			6.25								1		X										X	
SB	3.158	F	W1-2R	30	30		RIGHT CURVE 						1		X														
SB	3.078	F	W1-2R	30	30			6.25								1		X									INSTALL 400' +/- SOUTH OF ORIGINAL SIGN LOCATION	X		
SB	2.645	G	VR-017	24	30								1		X											WILL GRIMES RD TH-36			
		G	VR-017	24	30			5.00								1		X											E-141
SB	2.630	H	R1-1	24	24								1		X											WILL GRIMES RD TH-36			
		H	R1-1	30	30			6.25								1		X										X	
SB	2.177	G	VR-017	24	30								1		X												MANNING RD TH-37			
							SHEET TOTALS	33.75 SF	0.00 SF	2 EA	0 EA	0 EA	7 EA	0 EA	0 EA	6 EA		90 FT									
							TOWN TOTALS	287.3	0.0	80.0	0.0	0.0	54	0.0	0.0	42		630.0											

SIGN SUMMARY SHEET

VERMONT AGENCY OF TRANSPORTATION

PROJECT NAME: **Moretown-Newport Town VT100**
PROJECT NUMBER: **STPG SIGN(28)**

FILE NAME: **Hyde Park.xls** PLOT DATE: **9/29/2009**
PROJECT MANAGER: **N. Avery** DRAWN BY: **I. Shea**
DESIGNED BY: **D. Crossley** CHECKED BY: **J. Kelly**
HYDE PARK SHEET 9 SHEET **99** OF **166**

DIRECTION	MILEPOINT	LOCATION CODE (SHEET 2)	SIGN CODE	WIDTH (IN)	HEIGHT (IN)	SHEETING REMARKS	SIGN LEGEND	NEW SIGNS "A"	NEW SIGNS "B"	EXISTING SIGNS RETAIN	EXISTING SIGNS SALVAGE FROM	EXISTING SIGNS SALVAGE TO	EXISTING SIGNS REMOVE	EXIST POST RETAIN	EXIST POST REMOVE	NUMBER OF NEW POSTS	SQUARE STEEL (IN) 1.75 (LB/FT) 1.88	SQUARE STEEL (IN) 2.00 (LB/FT) 2.42	SQUARE STEEL (IN) 2.50 (LB/FT) 3.35	TUBULAR STEEL Ø (IN) FOUNDATION	TUBULAR STEEL Ø (IN) 3.00 (LB/FT) 7.60	TUBULAR STEEL Ø (IN) 3.50 (LB/FT) 9.00	TUBULAR STEEL Ø (IN) 4.00 (LB/FT) 10.80	TUBULAR STEEL Ø (IN) 5.00 (LB/FT) 14.60	SIGN FRAME REQUIRED	REMARKS	SIGN DETAIL: DETAIL IN SHS	SIGN DETAIL: DETAIL ON SHEET NUMBER	SIGN DETAIL: DETAIL ON STD SHEET NUMBER
HYDE PARK VT 100							FY-FLUORESCENT YELLOW FYG-FLUORESCENT YELLOW GREEN																			"SHS"-STANDARD HIGHWAY SIGNS			
		H	R1-1	24	24								1															
		G	VR-017	24	30			5.00								1		X										E-141
SB	2.170	H	R1-1	30	30								1		X											MANNING RD TH-37			
		H	R1-1	30	30			6.25								1		X									X		
SB	2.040	F	VW-202	30	30		TRUCKS ENTERING 						1		X															
SB	1.974	F	VW-202	30	30			6.25								1		X									INSTALL 350' +/- SOUTH OF ORIGINAL SIGN LOCATION			E-154
SB	1.557	F	W2-2RM	30	30		RIGHT SIDE ROAD (MOD.)						1		X														
SB	1.514	F	W11-6	30	30		SNOWMOBILE 						1		X														
SB	1.484	F	W2-2MaR	30	30			6.25								1		X									INSTALL 150' +/- SOUTH OF REMOVED SNOWMOBILE SIGN		6	
SB	1.397	G	VR-017	24	30								1		X											WEBSTER RD TH-38			
		G	VR-017	24	30			5.00								1		X											E-141
SB	1.390	H	R1-1	30	30								1		X											WEBSTER RD TH-38			
		H	R1-1	30	30			6.25								1		X										X	
SB	1.181	F	W11-4	30	30								1		X														
		F	W16-2	24	18								1																
SIGN SUMMARY SHEET							SHEET TOTALS	35.00	0.00	0	0	0	9	0	0	6		90									
								SF	SF	EA	EA	EA	EA	EA	EA	EA		FT									
VERMONT AGENCY OF TRANSPORTATION							TOWN TOTALS	287.3	0.0	80.0	0.0	0.0	54	0.0	0.0	42		630.0									

PROJECT NAME: **Moretown-Newport Town VT100**
PROJECT NUMBER: **STPG SIGN(28)**


FILE NAME: **Hyde Park.xls**
PROJECT MANAGER: **N. Avery**
DESIGNED BY: **D. Crossley**
HYDE PARK SHEET 10

PLOT DATE: **9/29/2009**
DRAWN BY: **I. Shea**
CHECKED BY: **J. Kelly**
SHEET **100** OF **166**

DIRECTION	MILEPOINT	LOCATION CODE (SHEET 2)	SIGN CODE	WIDTH (IN)	HEIGHT (IN)	SHEETING REMARKS	SIGN LEGEND	NEW SIGNS "A"	NEW SIGNS "B"	EXISTING SIGNS RETAIN	EXISTING SIGNS SALVAGE FROM	EXISTING SIGNS SALVAGE TO	EXISTING SIGNS REMOVE	EXIST POST RETAIN	EXIST POST REMOVE	NUMBER OF NEW POSTS	SQUARE STEEL (IN) 1.75 (LB / FT) 1.88	SQUARE STEEL (IN) 2.00 (LB / FT) 2.42	SQUARE STEEL (IN) 2.50 (LB / FT) 3.35	TUBULAR STEEL Ø (IN) FOUNDATION	TUBULAR STEEL Ø (IN) 3.00 (LB / FT) 7.60	TUBULAR STEEL Ø (IN) 3.50 (LB / FT) 9.00	TUBULAR STEEL Ø (IN) 4.00 (LB / FT) 10.80	TUBULAR STEEL Ø (IN) 5.00 (LB / FT) 14.60	SIGN FRAME REQUIRED	REMARKS	SIGN DETAIL: DETAIL IN SHS	SIGN DETAIL: DETAIL ON SHEET NUMBER	SIGN DETAIL: DETAIL ON STD SHEET NUMBER
HYDE PARK VT 100							FY-FLUORESCENT YELLOW FYG-FLUORESCENT YELLOW GREEN																			"SHS"-STANDARD HIGHWAY SIGNS			
		F	W11-4	30	30	FY		6.25								1		X									X		
		F	W16-2	24	18	FY		3.00																		X		
SB	1.087	F	W11-4	30	30								1		X														
		F	W16-2	24	18								1																
		F	W11-4	30	30	FY		6.25								1		X									X		
		F	W16-2	24	18	FY		3.00																		X		
SB	0.317	F	VD-062B	72	16		BUSINESS SIGN			1				X															
SB	0.276	F	W2-2MR	30	30		MODIFIED RIGHT SIDE ROAD			1				X															
SB	0.241	F	W3-1	36	36		STOP AHEAD SYMBOL			1				X															
SB	0.213	F	VD-018	30	18		HYDE PARK MORRISVILLE 2			1				X															
SB	0.157	F	M2-1S	21	15		JCT			1				X															
		F	M1-5	24	24		VERMONT 15			1																			
SB	0.145	G	VR-017	24	30								1		X												BATTLE HILL RD TH-6		
		G	VR-017	24	30			5.00								1		X											E-141
SB	0.132	H	R1-1	30	30								1		X											BATTLE HILL RD TH-6			
SIGN SUMMARY SHEET							SHEET TOTALS	23.50	0.00	6	0	0	4	0	0	3		45									
								SF	SF	EA	EA	EA	EA	EA	EA	EA		FT									
VERMONT AGENCY OF TRANSPORTATION							TOWN TOTALS	287.3	0.0	80.0	0.0	0.0	54	0.0	0.0	42		630.0									

PROJECT NAME: **Moretown-Newport Town VT100**
PROJECT NUMBER: **STPG SIGN(28)**

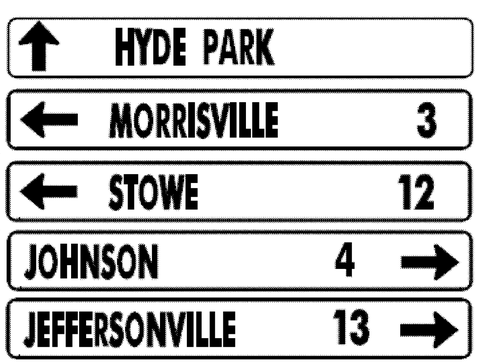FILE NAME: **Hyde Park.xls** PLOT DATE: **9/29/2009**
PROJECT MANAGER: **N. Avery** DRAWN BY: **I. Shea**
DESIGNED BY: **D. Crossley** CHECKED BY: **J. Kelly**
HYDE PARK SHEET 11 SHEET **101** OF **166**



DIRECTION	MILEPOINT	LOCATION CODE (SHEET 2)	SIGN CODE	WIDTH (IN)	HEIGHT (IN)	SHEETING REMARKS	SIGN LEGEND	NEW SIGNS "A"	NEW SIGNS "B"	EXISTING SIGNS RETAIN	EXISTING SIGNS SALVAGE FROM	EXISTING SIGNS SALVAGE TO	EXISTING SIGNS REMOVE	EXIST POST RETAIN	EXIST POST REMOVE	NUMBER OF NEW POSTS	SQUARE STEEL (IN) (LB / FT) 1.75 / 1.88	SQUARE STEEL (IN) (LB / FT) 2.00 / 2.42	SQUARE STEEL (IN) (LB / FT) 2.50 / 3.35	TUBULAR STEEL Ø (IN) FOUNDATION	TUBULAR STEEL Ø (IN) (LB / FT) 3.00 / 7.60	TUBULAR STEEL Ø (IN) (LB / FT) 3.50 / 9.00	TUBULAR STEEL Ø (IN) (LB / FT) 4.00 / 10.80	TUBULAR STEEL Ø (IN) (LB / FT) 5.00 / 14.60	SIGN FRAME REQUIRED	REMARKS	SIGN DETAIL: DETAIL IN SHS	SIGN DETAIL: DETAIL ON SHEET NUMBER	SIGN DETAIL: DETAIL ON STD SHEET NUMBER
HYDE PARK VT 100							FY-FLUORESCENT YELLOW FYG-FLUORESCENT YELLOW GREEN																			"SHS"-STANDARD HIGHWAY SIGNS			
		H	R1-1	30	30			6.25								1		X								X		
SB	0.105	F	D1-1	72	10								1		X													
		F	D1-1A	72	10								1															
		F	D1-1A	72	10								1															
		F	D1-1A	72	10								1															
		F	D1-1	72	12			6.00								2			X								5	
		F	D1-1A	72	12			6.00																			5	
		F	D1-1A	72	12			6.00																			5	
		F	D1-1A	72	12			6.00																			5	
		F	D1-1A	72	12			6.00																			5	
SB	0.050	F	M3-2S	24	12		EAST			1				X														
		F	M1-5	24	24		VERMONT 15			1																		
		F	M6-1S	21	15		<--- LEFT			1																		
		F	M3-3S	24	12		SOUTH			1																		
SIGN SUMMARY SHEET							SHEET TOTALS	36.25	0.00	4	0	0	5	0	0	3	45										
								SF	SF	EA	EA	EA	EA	EA	EA	EA	FT										
VERMONT AGENCY OF TRANSPORTATION							TOWN TOTALS	287.3	0.0	80.0	0.0	0.0	54	0.0	0.0	42	630.0										

PROJECT NAME: **Moretown-Newport Town VT100**
PROJECT NUMBER: **STPG SIGN(28)**
FILE NAME: **Hyde Park.xls**
PROJECT MANAGER: **N. Averv**
DESIGNED BY: **D. Crossley**
HYDE PARK SHEET 12
PLOT DATE: **9/29/2009**
DRAWN BY: **I. Shea**
CHECKED BY: **J. Kelly**
SHEET **102** OF **166**

DIRECTION	MILEPOINT	LOCATION CODE (SHEET 2)	SIGN CODE	WIDTH (IN)	HEIGHT (IN)	SHEETING REMARKS	SIGN LEGEND	NEW SIGNS		EXISTING SIGNS				EXIST POST		NUMBER OF NEW POSTS	SQUARE STEEL (IN)			TUBULAR STEEL Ø (IN)				SIGN FRAME REQUIRED	REMARKS	SIGN DETAIL		
								"A"	"B"	RETAIN	SALVAGE FROM	SALVAGE TO	REMOVE	RETAIN	REMOVE		1.75	2.00	2.50	FOUNDATION	3.00	3.50	4.00	5.00			DETAIL IN SHS	DETAIL ON SHEET NUMBER	DETAIL ON STD SHEET NUMBER
																	(LB / FT)				(LB / FT)							
																	1.88	2.42	3.35		7.60	9.00	10.80	14.60					
HYDE PARK VT 100							FY-FLUORESCENT YELLOW FYG-FLUORESCENT YELLOW GREEN																			"SHS"-STANDARD HIGHWAY SIGNS			
		F	M1-5	30	24		VERMONT 100			1																		
		F	M6-1S	21	15		<--- LEFT			1																		
		F	M3-4S	24	12		WEST			1																		
		F	M1-5	24	24		VERMONT 15			1																		
		F	M6-1S	21	15		RIGHT --->			1																		
SB	0.017	E	R1-1	36	36		STOP			1				X														
SIGN SUMMARY SHEET							SHEET TOTALS	0.00	0.00	6	0	0	0	0	0	0	0											
								SF	SF	EA	EA	EA	EA	EA	EA	EA	FT											
VERMONT AGENCY OF TRANSPORTATION							TOWN TOTALS	287.3	0.0	80.0	0.0	0.0	54	0.0	0.0	42	630.0											

PROJECT NAME: **Moretown-Newport Town VT100**
PROJECT NUMBER: **STPG SIGN(28)**

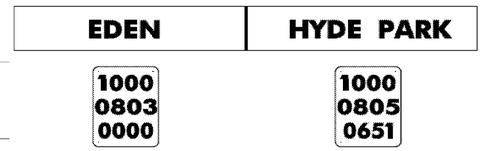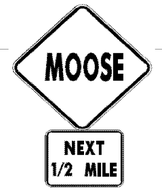FILE NAME: **Hyde Park.xls** PLOT DATE: **9/29/2009**
PROJECT MANAGER: **N. Avery** DRAWN BY: **I. Shea**
DESIGNED BY: **D. Crossley** CHECKED BY: **J. Kelly**
HYDE PARK SHEET 13 SHEET **103** OF **166**

DIRECTION	MILEPOINT	LOCATION CODE (SHEET 2)	SIGN CODE	WIDTH (IN)	HEIGHT (IN)	SHEETING REMARKS	SIGN LEGEND	NEW SIGNS "A"	NEW SIGNS "B"	EXISTING SIGNS RETAIN	EXISTING SIGNS SALVAGE FROM	EXISTING SIGNS SALVAGE TO	EXISTING SIGNS REMOVE	EXIST POST RETAIN	EXIST POST REMOVE	NUMBER OF NEW POSTS	SQUARE STEEL (IN) 1.75 (LB / FT) 1.88	SQUARE STEEL (IN) 2.00 (LB / FT) 2.42	SQUARE STEEL (IN) 2.50 (LB / FT) 3.35	TUBULAR STEEL Ø (IN) FOUNDATION	TUBULAR STEEL Ø (IN) 3.00 (LB / FT) 7.60	TUBULAR STEEL Ø (IN) 3.50 (LB / FT) 9.00	TUBULAR STEEL Ø (IN) 4.00 (LB / FT) 10.80	TUBULAR STEEL Ø (IN) 5.00 (LB / FT) 14.60	SIGN FRAME REQUIRED	REMARKS	SIGN DETAIL: DETAIL IN SHS	SIGN DETAIL: DETAIL ON SHEET NUMBER	SIGN DETAIL: DETAIL ON STD SHEET NUMBER
EDEN VT 100							FY-FLUORESCENT YELLOW FYG-FLUORESCENT YELLOW GREEN																			"SHS"-STANDARD HIGHWAY SIGNS			
NB	0.000	C	VD-024	72	12			5.00								2		X							INSTALL OPPOSITE EXISTING TOWNLINE SIGN		4	
		C	VD-700	6	10			~~0.42~~																				
		C	VD-700	6	10			0.42																				
NB	0.190	A	VW-001A	30	30		MOOSE SYMBOL						1		X													
		A	W7-3A	24	18								1															
		A	VW-001A	30	30			6.25								1		X									6	
		A	W7-3A	24	18			3.00																			X	
NB	0.210	C	VM-607	24	30		43RD INF DIV MEMORIAL HIGHWAY			1				X														
NB	1.785	A	S1-1YG	36	36		SCHOOL			1				X														
		A	W16-9YG	36	20		AHEAD			1																		
NB	1.872	A	D1-1E	72	12		<--- EDEN CENTRAL SCHOOL			1				X														
NB	2.090	C	VR-017	24	30								1		X												BLAKEVILLE RD TH-17 (SOUTH)			
		C	VR-017	24	30			5.00								1		X										E-141
NB	2.100	D	R1-1	24	24								1		X												BLAKEVILLE RD TH-17 (SOUTH)			
		D	R1-1	30	30			6.25								1		X									X	
							SHEET TOTALS	26.34 SF	0.00 SF	4 EA	0 EA	0 EA	4 EA	0 EA	0 EA	5 EA		75 FT										
							TOWN TOTALS	462.5	0.0	40.0	2.0	2.0	86	0.0	0.0	77		1155.0										

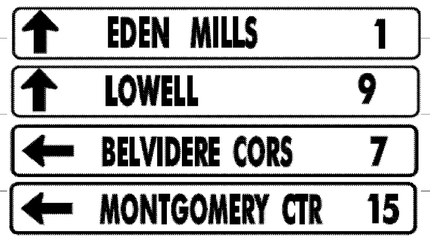
SIGN SUMMARY SHEET

VERMONT AGENCY OF TRANSPORTATION

PROJECT NAME: **Moretown-Newport Town VT100**
PROJECT NUMBER: **STPG SIGN(28)**



FILE NAME: **Eden.xls**
PROJECT MANAGER: **N. Averv**
DESIGNED BY: **D. Crossley**
EDEN SHEET 1

PLOT DATE: **9/30/2009**
DRAWN BY: **I. Shea**
CHECKED BY: **J. Kelly**
SHEET **104** OF **166**

DIRECTION	MILEPOINT	LOCATION CODE (SHEET 2)	SIGN CODE	WIDTH (IN)	HEIGHT (IN)	SHEETING REMARKS	SIGN LEGEND	NEW SIGNS "A"	NEW SIGNS "B"	EXISTING SIGNS RETAIN	EXISTING SIGNS SALVAGE FROM	EXISTING SIGNS SALVAGE TO	EXISTING SIGNS REMOVE	EXIST POST RETAIN	EXIST POST REMOVE	NUMBER OF NEW POSTS	SQUARE STEEL (IN) (LB / FT) 1.75 / 1.88	SQUARE STEEL (IN) (LB / FT) 2.00 / 2.42	SQUARE STEEL (IN) (LB / FT) 2.50 / 3.35	TUBULAR STEEL Ø (IN) FOUNDATION	TUBULAR STEEL Ø (IN) (LB / FT) 3.00 / 7.60	TUBULAR STEEL Ø (IN) (LB / FT) 3.50 / 9.00	TUBULAR STEEL Ø (IN) (LB / FT) 4.00 / 10.80	TUBULAR STEEL Ø (IN) (LB / FT) 5.00 / 14.60	SIGN FRAME REQUIRED	REMARKS	SIGN DETAIL: DETAIL IN SHS	SIGN DETAIL: DETAIL ON SHEET NUMBER	SIGN DETAIL: DETAIL ON STD SHEET NUMBER
EDEN VT 100							FY-FLUORESCENT YELLOW FYG-FLUORESCENT YELLOW GREEN																			"SHS"-STANDARD HIGHWAY SIGNS			
NB	2.770	A	M2-1S	21	15								1		X													
		A	M1-5	30	24								1															
		A	M2-1	21	15			2.19								1		X							GREEN ON WHITE SHEETING	X		
		A	M1-5	30	24			5.00																				E-136B
NB	2.820	A	D1-1A	72	10								1		X													
		A	D1-1A	72	10								1															
		A	D1-1A	72	10								1															
		A	D1-1A	72	12			6.00								2			X							5
		A	D1-1A	72	12			6.00																				5
		A	D1-1A	72	12			6.00																				5
		A	D1-1A	72	12			6.00																				5
NB	2.870	A	M3-1S	24	12								1		X													
		A	M1-5	30	24								1															
		A	M6-1S	21	15								1															
SIGN SUMMARY SHEET							SHEET TOTALS	31.19	0.00	0	0	0	9	0	0	3		45									
								SF	SF	EA	EA	EA	EA	EA	EA	EA		FT									
VERMONT AGENCY OF TRANSPORTATION							TOWN TOTALS	462.5	0.0	40.0	2.0	2.0	86	0.0	0.0	77		1155.0									

PROJECT NAME: **Moretown-Newport Town VT100**
PROJECT NUMBER: **STPG SIGN(28)**

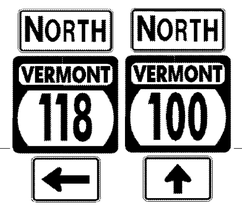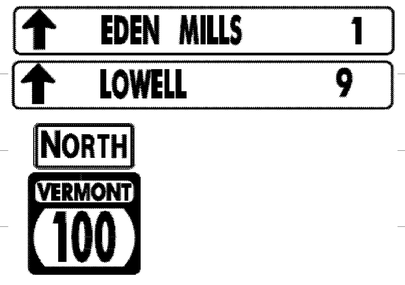FILE NAME: **Eden.xls** PLOT DATE: **9/30/2009**
PROJECT MANAGER: **N. Avery** DRAWN BY: **I. Shea**
DESIGNED BY: **D. Crossley** CHECKED BY: **J. Kelly**
EDEN SHEET 2 SHEET **105** OF **166**

DIRECTION	MILEPOINT	LOCATION CODE (SHEET 2)	SIGN CODE	WIDTH (IN)	HEIGHT (IN)	SHEETING REMARKS	SIGN LEGEND	NEW SIGNS "A"	NEW SIGNS "B"	EXISTING SIGNS RETAIN	EXISTING SIGNS SALVAGE FROM	EXISTING SIGNS SALVAGE TO	EXISTING SIGNS REMOVE	EXIST POST RETAIN	EXIST POST REMOVE	NUMBER OF NEW POSTS	SQUARE STEEL (IN) 1.75 (LB / FT) 1.88	SQUARE STEEL (IN) 2.00 (LB / FT) 2.42	SQUARE STEEL (IN) 2.50 (LB / FT) 3.35	TUBULAR STEEL Ø (IN) FOUNDATION	TUBULAR STEEL Ø (IN) 3.00 (LB / FT) 7.60	TUBULAR STEEL Ø (IN) 3.50 (LB / FT) 9.00	TUBULAR STEEL Ø (IN) 4.00 (LB / FT) 10.80	TUBULAR STEEL Ø (IN) 5.00 (LB / FT) 14.60	SIGN FRAME REQUIRED	REMARKS	SIGN DETAIL: DETAIL IN SHS	SIGN DETAIL: DETAIL ON SHEET NUMBER	SIGN DETAIL: DETAIL ON STD SHEET NUMBER
EDEN VT 100							FY-FLUORESCENT YELLOW FYG-FLUORESCENT YELLOW GREEN																			"SHS"-STANDARD HIGHWAY SIGNS			
		A	M3-1S	24	12								1																
		A	M1-5	30	24								1																
		A	M6-3S	21	15								1																
		A	M3-1	24	12			2.00								2		X							2B	GREEN ON WHITE SHEETING	X	7	
		A	M1-5	30	24			5.00																				E-136B
		A	M6-1L	21	15			2.19																GREEN ON WHITE SHEETING	X		
		A	M3-1	24	12			2.00																				
		A	M1-5	30	24			5.00																				E-136B
		A	M6-3	21	15			2.19																		GREEN ON WHITE SHEETING	X		
NB	2.950	A	M3-1S	24	12								1		X													
		A	M1-5	30	24								1															
		A	D1-1A	72	12			6.00									2		X									5	
		A	D1-1A	72	12			6.00																			5	
		A	M3-1	24	12			2.00																		GREEN ON WHITE SHEETING	X		
		A	M1-5	30	24			5.00																				E-136B
							SHEET TOTALS	37.38	0.00	0	0	0	5	0	0	4		60									
								SF	SF	EA	EA	EA	EA	EA	EA	EA		FT									
							TOWN TOTALS	462.5	0.0	40.0	2.0	2.0	86	0.0	0.0	77		1155.0									

SIGN SUMMARY SHEET

VERMONT AGENCY OF TRANSPORTATION

PROJECT NAME: **Moretown-Newport Town VT100**
PROJECT NUMBER: **STPG SIGN(28)**

FILE NAME: **Eden.xls**
PROJECT MANAGER: **N. Averv**
DESIGNED BY: **D. Crosslev**
EDEN SHEET 3

PLOT DATE: **9/30/2009**
DRAWN BY: **I. Shea**
CHECKED BY: **J. Kelly**
SHEET **106** OF **166**


DIRECTION	MILEPOINT	LOCATION CODE (SHEET 2)	SIGN CODE	WIDTH (IN)	HEIGHT (IN)	SHEETING REMARKS	SIGN LEGEND	NEW SIGNS "A"	NEW SIGNS "B"	EXISTING SIGNS RETAIN	EXISTING SIGNS SALVAGE FROM	EXISTING SIGNS SALVAGE TO	EXISTING SIGNS REMOVE	EXIST POST RETAIN	EXIST POST REMOVE	NUMBER OF NEW POSTS	SQUARE STEEL (IN) 1.75 (LB / FT) 1.88	SQUARE STEEL (IN) 2.00 (LB / FT) 2.42	SQUARE STEEL (IN) 2.50 (LB / FT) 3.35	TUBULAR STEEL Ø (IN) FOUNDATION	TUBULAR STEEL Ø (IN) 3.00 (LB / FT) 7.60	TUBULAR STEEL Ø (IN) 3.50 (LB / FT) 9.00	TUBULAR STEEL Ø (IN) 4.00 (LB / FT) 10.80	TUBULAR STEEL Ø (IN) 5.00 (LB / FT) 14.60	SIGN FRAME REQUIRED	REMARKS	SIGN DETAIL DETAIL IN SHS	SIGN DETAIL DETAIL ON SHEET NUMBER	SIGN DETAIL DETAIL ON STD SHEET NUMBER
EDEN VT 100							FY-FLUORESCENT YELLOW FYG-FLUORESCENT YELLOW GREEN																			"SHS"-STANDARD HIGHWAY SIGNS			
NB	2.950	C	VR-017	24	30								1		X											PARSONAGE RD TH-18			
		C	VR-017	24	30			5.00								1		X										E-141
NB	2.960	D	R1-1	30	30								1		X											PARSONAGE RD TH-18			
		D	R1-1	30	30			6.25								1		X									X	
NB	2.980	A	R2-1	24	30								1		X														
		A	R2-1	24	30			5.00								1		X									X	
NB	3.510	C	VR-017	24	24								1		X											BLAKEVILLE RD TH-17 (NORTH)			
		C	VR-017	24	30			5.00								1		X										E-141
NB	3.520	D	R1-1	24	24								3 ~~1~~		X											BLAKEVILLE RD TH-17 (NORTH)			
		D	R1-1	30	30			6.25								1		X									X	
NB	3.615	A	W3-5	36	36		SPEED REDUCTION SPEED LIMIT 40			1				X														
NB	3.650	A	VD-018	30	18		EDEN MILLS LOWELL 8			1				X														
NB	3.690	A	W1-4R	30	30		RIGHT REVERSE CURVE						1		X													
NB	3.715	A	R2-1	24	30								1		X														
		A	R2-1	30	36			7.50								1		X										6
							SHEET TOTALS	35.00	0.00	2	0	0	7	0	0	6		90										
								SF	SF	EA	EA	EA	EA	EA	EA	EA		FT										
							TOWN TOTALS	462.5	0.0	40.0	2.0	2.0	86	0.0	0.0	77		1155.0										

SIGN SUMMARY SHEET

VERMONT AGENCY OF TRANSPORTATION

PROJECT NAME: **Moretown-Newport Town VT100**
PROJECT NUMBER: **STPG SIGN(28)**

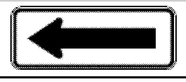FILE NAME: **Eden.xls** PLOT DATE: **9/30/2009**
PROJECT MANAGER: **N. Avery** DRAWN BY: **I. Shea**
DESIGNED BY: **D. Crossley** CHECKED BY: **J. Kelly**
EDEN SHEET 4 SHEET **107** OF **166**

DIRECTION	MILEPOINT	LOCATION CODE (SHEET 2)	SIGN CODE	WIDTH (IN)	HEIGHT (IN)	SHEETING REMARKS	SIGN LEGEND	NEW SIGNS "A"	NEW SIGNS "B"	EXISTING SIGNS RETAIN	EXISTING SIGNS SALVAGE FROM	EXISTING SIGNS SALVAGE TO	EXISTING SIGNS REMOVE	EXIST POST RETAIN	EXIST POST REMOVE	NUMBER OF NEW POSTS	SQUARE STEEL (IN) 1.75 (LB / FT) 1.88	SQUARE STEEL (IN) 2.00 (LB / FT) 2.42	SQUARE STEEL (IN) 2.50 (LB / FT) 3.35	TUBULAR STEEL Ø (IN) FOUNDATION	TUBULAR STEEL Ø (IN) 3.00 (LB / FT) 7.60	TUBULAR STEEL Ø (IN) 3.50 (LB / FT) 9.00	TUBULAR STEEL Ø (IN) 4.00 (LB / FT) 10.80	TUBULAR STEEL Ø (IN) 5.00 (LB / FT) 14.60	SIGN FRAME REQUIRED	REMARKS	SIGN DETAIL: DETAIL IN SHS	SIGN DETAIL: DETAIL ON SHEET NUMBER	SIGN DETAIL: DETAIL ON STD SHEET NUMBER
EDEN VT 100							FY-FLUORESCENT YELLOW FYG-FLUORESCENT YELLOW GREEN																			"SHS"-STANDARD HIGHWAY SIGNS			
NB	3.770	A	W1-2 R	30	30			6.25								1		X								INSTALL OPPOSITE BEGINNING OF SB GUARD RAIL	X		
NB	3.920	A	R2-1	24	30								1		X													
		A	R2-1	30	36			7.50								1		X										6
NB	3.950	A	W1-1L	30	30		LEFT TURN						1		X													
		A	W13-1	18	18		30 MPH PLAQUE						1															
NB	3.970	A	W1-1L	30	30			6.25								1		X								INSTALL 100' +/- NORTH OF ORIGINAL SIGN LOCATION	X		
		A	W13-1	24	24			4.00																			X	
NB	4.014	C	VR-017	24	30								1		X													EARLE LN TH-40			
		C	VR-017	24	30			5.00								1		X											E-141
NB	4.014	D	R1-1	30	30								1		X													EARLE LN TH-40			
		D	R1-1	30	30			6.25								1		X										X	
NB	4.017	A	W1-6	48	24								1		X													
		A	W1-6	48	24			8.00								2		X										X	
NB	4.020	B	W1-6	48	24								1		X													
		B	W1-6	48	24			8.00								2		X										X	
							SHEET TOTALS	51.25 SF	0.00 SF	0 EA	0 EA	0 EA	7 EA	0 EA	0 EA	9 EA		135 FT										
							TOWN TOTALS	462.5	0.0	40.0	2.0	2.0	86	0.0	0.0	77		1155.0										

SIGN SUMMARY SHEET

VERMONT AGENCY OF TRANSPORTATION

PROJECT NAME: **Moretown-Newport Town VT100**
PROJECT NUMBER: **STPG SIGN(28)**

FILE NAME: **Eden.xls**
PROJECT MANAGER: **N. Averv**
DESIGNED BY: **D. Crossley**
EDEN SHEET 5

PLOT DATE: **9/30/2009**
DRAWN BY: **I. Shea**
CHECKED BY: **J. Kelly**
SHEET **108** OF **166**

DIRECTION	MILEPOINT	LOCATION CODE (SHEET 2)	SIGN CODE	WIDTH (IN)	HEIGHT (IN)	SHEETING REMARKS	SIGN LEGEND	NEW SIGNS "A"	NEW SIGNS "B"	EXISTING SIGNS RETAIN	EXISTING SIGNS SALVAGE FROM	EXISTING SIGNS SALVAGE TO	EXISTING SIGNS REMOVE	EXIST POST RETAIN	EXIST POST REMOVE	NUMBER OF NEW POSTS	SQUARE STEEL (IN) (LB / FT) 1.75 / 1.88	SQUARE STEEL (IN) (LB / FT) 2.00 / 2.42	SQUARE STEEL (IN) (LB / FT) 2.50 / 3.35	TUBULAR STEEL Ø (IN) FOUNDATION	TUBULAR STEEL Ø (IN) (LB / FT) 3.00 / 7.60	TUBULAR STEEL Ø (IN) (LB / FT) 3.50 / 9.00	TUBULAR STEEL Ø (IN) (LB / FT) 4.00 / 10.80	TUBULAR STEEL Ø (IN) (LB / FT) 5.00 / 14.60	SIGN FRAME REQUIRED	REMARKS	SIGN DETAIL: DETAIL IN SHS	SIGN DETAIL: DETAIL ON SHEET NUMBER	SIGN DETAIL: DETAIL ON STD SHEET NUMBER
EDEN VT 100							FY-FLUORESCENT YELLOW FYG-FLUORESCENT YELLOW GREEN																			"SHS"-STANDARD HIGHWAY SIGNS			
NB	4.030	A	W11-6H	30	30								1		X													
		A	W11-6H	30	30			6.25								1		X										E-152
NB	4.120	A	W1-1MR	30	30								1		X													
		A	W13-1	18	18								1															
		A	W1-1MdR	30	30			6.25								1		X										6	
		A	W13-1	24	24			4.00																			X	
NB	4.180	A	M3-1S	24	12		NORTH						1		X													
		A	M1-5	30	24		VERMONT 100						1															
NB	4.210	A	M3-1	24	12			2.00								1		X							GREEN ON WHITE SHEETING	X		
		A	M1-5	30	24			5.00																	INSTALL SIGN 150' +/- NORTH OF ORIGINAL SIGN LOCATION			E-136B
NB	4.260	A	VD-062B	72	16		BUSINESS SIGN			1				X														
NB	4.290	A	W1-6	48	24								1		X													
		A	W1-6	48	24			8.00								2		X								X		
NB	4.320	C	VR-017	24	30		LEGAL LOAD LIMIT 24,000 POUNDS	5.00								1		X							EAST HILL RD TH-2			E-141
NB	4.300	D	R1-1	30	30								1		X										EAST HILL RD TH-2			
							SHEET TOTALS	36.50 SF	0.00 SF	1 EA	0 EA	0 EA	7 EA	0 EA	0 EA	6 EA		90 FT										
							TOWN TOTALS	462.5	0.0	40.0	2.0	2.0	86	0.0	0.0	77		1155.0										

SIGN SUMMARY SHEET

VERMONT AGENCY OF TRANSPORTATION

PROJECT NAME: Moretown-Newport Town VT100
PROJECT NUMBER: STPG SIGN(28)


FILE NAME: Eden.xls
PROJECT MANAGER: N. Averv
DESIGNED BY: D. Crosslev
EDEN SHEET 6

PLOT DATE: 9/30/2009
DRAWN BY: I. Shea
CHECKED BY: J. Kelly
SHEET 109 OF 166

DIRECTION	MILEPOINT	LOCATION CODE (SHEET 2)	SIGN CODE	WIDTH (IN)	HEIGHT (IN)	SHEETING REMARKS	SIGN LEGEND	NEW SIGNS "A"	NEW SIGNS "B"	EXISTING SIGNS RETAIN	EXISTING SIGNS SALVAGE FROM	EXISTING SIGNS SALVAGE TO	EXISTING SIGNS REMOVE	EXIST POST RETAIN	EXIST POST REMOVE	NUMBER OF NEW POSTS	SQUARE STEEL (IN) 1.75 (LB/FT) 1.88	SQUARE STEEL (IN) 2.00 (LB/FT) 2.42	SQUARE STEEL (IN) 2.50 (LB/FT) 3.35	TUBULAR STEEL Ø (IN) FOUNDATION	TUBULAR STEEL Ø (IN) 3.00 (LB/FT) 7.60	TUBULAR STEEL Ø (IN) 3.50 (LB/FT) 9.00	TUBULAR STEEL Ø (IN) 4.00 (LB/FT) 10.80	TUBULAR STEEL Ø (IN) 5.00 (LB/FT) 14.60	SIGN FRAME REQUIRED	REMARKS	SIGN DETAIL: DETAIL IN SHS	SIGN DETAIL: DETAIL ON SHEET NUMBER	SIGN DETAIL: DETAIL ON STD SHEET NUMBER
EDEN VT 100							FY-FLUORESCENT YELLOW FYG-FLUORESCENT YELLOW GREEN																			"SHS"-STANDARD HIGHWAY SIGNS			
		D	R1-1	30	30			6.25								1		X								X		
NB	4.350	A	R2-1	24	30								1		X														
		A	R2-1	24	30			5.00								1		X								X		
NB	4.530	C	VR-017	24	30		LEGAL LOAD LIMIT 24,000 LBS			1				X												LAKESHORE RD TH-30 CLASS 4			
NB	4.540	D	R1-1	30	30		STOP			1				X												LAKESHORE RD TH-30 CLASS 4			
NB	4.575	A	R2-1	24	30		SPEED LIMIT 40			1				X															
NB	4.683	C	VR-017	24	30		LEGAL LOAD LIMIT 24,000 LBS			1				X												BARROWS LN TH-41			
NB	4.683	D	R1-1	30	30		STOP			1				X												BARROWS LN TH-41			
NB	4.795	A	W11-2YG	30	30		PEDESTRIAN			1				X															
		A	W16-4YG	30	24		NEXT 2000 FEET			1																			
NB	5.230	A	R2-1	24	30		SPEED LIMIT 50			1				X															
NB	5.565	A	VW-202	30	30		TRUCKS ENTERING			1				X															
NB	5.914	A	R2-1	24	30		SPEED LIMIT 50			1				X															
NB	6.118	C	VR-017	24	30		LEGAL LOAD LIMIT 16,000 LBS			1				X												BOY SCOUT CAMP RD TH-32			
NB	6.126	D	R1-1	30	30		STOP			1				X												BOY SCOUT CAMP RD TH-32			
SIGN SUMMARY SHEET							SHEET TOTALS	11.25	0.00	12	0	0	1	0	0	2		30										
								SF	SF	EA	EA	EA	EA	EA	EA	EA		FT										
VERMONT AGENCY OF TRANSPORTATION							TOWN TOTALS	462.5	0.0	40.0	2.0	2.0	86	0.0	0.0	77		1155.0										

PROJECT NAME: **Moretown-Newport Town VT100**
PROJECT NUMBER: **STPG SIGN(28)**

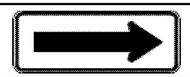FILE NAME: **Eden.xls** PLOT DATE: **9/30/2009**
PROJECT MANAGER: **N. Averv** DRAWN BY: **I. Shea**
DESIGNED BY: **D. Crosslev** CHECKED BY: **J. Kelly**
EDEN SHEET 7 SHEET **110** OF **166**

DIRECTION	MILEPOINT	LOCATION CODE (SHEET 2)	SIGN CODE	WIDTH (IN)	HEIGHT (IN)	SHEETING REMARKS	SIGN LEGEND	NEW SIGNS "A"	NEW SIGNS "B"	EXISTING SIGNS RETAIN	EXISTING SIGNS SALVAGE FROM	EXISTING SIGNS SALVAGE TO	EXISTING SIGNS REMOVE	EXIST POST RETAIN	EXIST POST REMOVE	NUMBER OF NEW POSTS	SQUARE STEEL (IN) 1.75 (LB / FT) 1.88	SQUARE STEEL (IN) 2.00 (LB / FT) 2.42	SQUARE STEEL (IN) 2.50 (LB / FT) 3.35	TUBULAR STEEL Ø (IN) FOUNDATION	TUBULAR STEEL Ø (IN) 3.00 (LB / FT) 7.60	TUBULAR STEEL Ø (IN) 3.50 (LB / FT) 9.00	TUBULAR STEEL Ø (IN) 4.00 (LB / FT) 10.80	TUBULAR STEEL Ø (IN) 5.00 (LB / FT) 14.60	SIGN FRAME REQUIRED	REMARKS	SIGN DETAIL: DETAIL IN SHS	SIGN DETAIL: DETAIL ON SHEET NUMBER	SIGN DETAIL: DETAIL ON STD SHEET NUMBER
EDEN VT 100							FY-FLUORESCENT YELLOW FYG-FLUORESCENT YELLOW GREEN																			"SHS"-STANDARD HIGHWAY SIGNS			
NB	6.805	A	W1-4R	30	30		RIGHT REVERSE CURVE			1				X														
NB	7.003	A	W1-6	48	24		<=== LEFT			1				X														
NB	7.003	B	W1-6	48	24		RIGHT ===>			1				X														
NB	7.030	A	W1-6	48	24		<=== LEFT			1					X	2		X										
NB	7.030	B	W1-6	48	24		RIGHT ===>			1				X		2		X										
NB	~~7.190~~ 7.292	B	W1-6	48	24			8.00								2		X									INSTALL SOUTH OF WOODS ROAD	X		
SB	7.292	F	W1-4R	30	30		RIGHT REVERSE CURVE 						1		X														
		F	W1-2 R	30	30			6.25								1		X										X		
SB	5.336	F	W3-5	36	36								1		X														
		F	W3-5	36	36			9.00								2		X										X		
SB	5.254	F	R2-1	24	30								1		X														
		F	R2-1	30	36			7.50								1		X											6	
SB	5.197	F	W11-2	30	30	FYG	PEDESTRIAN			1				X														
		F	W16-4	30	24	FYG	NEXT 2000 FEET			1																		
SB	5.154	F	VW-060	30	30		HIDDEN DRIVES			1				X														
							SHEET TOTALS	30.75	0.00	8	0	0	3	0	0	8		120										
								SF	SF	EA	EA	EA	EA	EA	EA	EA		FT										
							TOWN TOTALS	462.5	0.0	40.0	2.0	2.0	86	0.0	0.0	77		1155.0										

SIGN SUMMARY SHEET

VERMONT AGENCY OF TRANSPORTATION

PROJECT NAME: **Moretown-Newport Town VT100**
PROJECT NUMBER: **STPG SIGN(28)**

FILE NAME: **Eden.xls** PLOT DATE: **9/30/2009**
PROJECT MANAGER: **N. Averv** DRAWN BY: **I. Shea**
DESIGNED BY: **D. Crosslev** CHECKED BY: **J. Kelly**
EDEN SHEET 8 SHEET **111** OF **166**

DIRECTION	MILEPOINT	LOCATION CODE (SHEET 2)	SIGN CODE	WIDTH (IN)	HEIGHT (IN)	SHEETING REMARKS	SIGN LEGEND	NEW SIGNS "A"	NEW SIGNS "B"	EXISTING SIGNS RETAIN	EXISTING SIGNS SALVAGE FROM	EXISTING SIGNS SALVAGE TO	EXISTING SIGNS REMOVE	EXIST POST RETAIN	EXIST POST REMOVE	NUMBER OF NEW POSTS	SQUARE STEEL (IN) 1.75 (LB / FT) 1.88	SQUARE STEEL (IN) 2.00 (LB / FT) 2.42	SQUARE STEEL (IN) 2.50 (LB / FT) 3.35	TUBULAR STEEL Ø (IN) FOUNDATION	TUBULAR STEEL Ø (IN) 3.00 (LB / FT) 7.60	TUBULAR STEEL Ø (IN) 3.50 (LB / FT) 9.00	TUBULAR STEEL Ø (IN) 4.00 (LB / FT) 10.80	TUBULAR STEEL Ø (IN) 5.00 (LB / FT) 14.60	SIGN FRAME REQUIRED	REMARKS	SIGN DETAIL: DETAIL IN SHS	SIGN DETAIL: DETAIL ON SHEET NUMBER	SIGN DETAIL: DETAIL ON STD SHEET NUMBER
EDEN VT 100							FY-FLUORESCENT YELLOW FYG-FLUORESCENT YELLOW GREEN																			"SHS"-STANDARD HIGHWAY SIGNS			
SB	4.906	F	R2-1	24	30		SPEED LIMIT 40			1				X														
SB	4.800	F	VW-060	30	30		HIDDEN DRIVES			1				X														
SB	4.714	G	VR-017	24	30		LEGAL LOAD LIMIT 24,000 LBS			1				X												CAMP RD TH-27			
SB	4.708	H	R1-1	30	30		STOP			1				X												CAMP RD TH-27			
SB	4.470	F	W3-5	36	36		SPEED REDUCTION SPEED LIMIT 35						1		X														
SB	4.437	F	W2-3ML	30	30		MODIFIED LEFT ANGLE SIDE ROAD			1				X															
		F	W16-8A	30	8		EAST HILL RD			1																			
SB	4.375	F	R2-1	24	30		SPEED LIMIT 35						1		X														
SB	4.350	F	R2-1	30	36			7.50								1		X						INSTALL ACROSS FROM NORTHBOUND SPEED LIMIT 40		6	
SB	4.341	F	VD-018	30	18		EDEN MILLS EDEN 1			1				X														
SB	4.300	F	W1-1MdL	30	30		MODIFIED LEFT TURN				1				X														
		F	W13-1	18	18		30 MPH PLAQUE				1																		
SB	4.257	F	M3-3S	24	12		SOUTH						1		X														
		F	M1-5	30	24		VERMONT 100						1																
		F	W1-1MdL	30	30		MODIFIED LEFT TURN					1				1		X								SALVAGED FROM SB MP 4.30			
							SHEET TOTALS	7.50	0.00	7	2	1	4	0	0	2		30										
								SF	SF	EA	EA	EA	EA	EA	EA	EA		FT										
							TOWN TOTALS	462.5	0.0	40.0	2.0	2.0	86	0.0	0.0	77		1155.0										

SIGN SUMMARY SHEET

VERMONT AGENCY OF TRANSPORTATION

PROJECT NAME: **Moretown-Newport Town VT100**
PROJECT NUMBER: **STPG SIGN(28)**

FILE NAME: **Eden.xls**
PROJECT MANAGER: **N. Averv**
DESIGNED BY: **D. Crossley**
EDEN SHEET 9

PLOT DATE: **9/30/2009**
DRAWN BY: **I. Shea**
CHECKED BY: **J. Kelly**
SHEET **112** OF **166**

DIRECTION	MILEPOINT	LOCATION CODE (SHEET 2)	SIGN CODE	WIDTH (IN)	HEIGHT (IN)	SHEETING REMARKS	SIGN LEGEND	NEW SIGNS "A"	NEW SIGNS "B"	EXISTING SIGNS RETAIN	EXISTING SIGNS SALVAGE FROM	EXISTING SIGNS SALVAGE TO	EXISTING SIGNS REMOVE	EXIST POST RETAIN	EXIST POST REMOVE	NUMBER OF NEW POSTS	SQUARE STEEL (IN) 1.75 (LB/FT) 1.88	SQUARE STEEL (IN) 2.00 (LB/FT) 2.42	SQUARE STEEL (IN) 2.50 (LB/FT) 3.35	TUBULAR STEEL Ø (IN) FOUNDATION	TUBULAR STEEL Ø (IN) 3.00 (LB/FT) 7.60	TUBULAR STEEL Ø (IN) 3.50 (LB/FT) 9.00	TUBULAR STEEL Ø (IN) 4.00 (LB/FT) 10.80	TUBULAR STEEL Ø (IN) 5.00 (LB/FT) 14.60	SIGN FRAME REQUIRED	REMARKS	SIGN DETAIL: DETAIL IN SHS	SIGN DETAIL: DETAIL ON SHEET NUMBER	SIGN DETAIL: DETAIL ON STD SHEET NUMBER
EDEN VT 100							FY-FLUORESCENT YELLOW FYG-FLUORESCENT YELLOW GREEN																			"SHS"-STANDARD HIGHWAY SIGNS			
		F	W13-1	18	18		30 MPH PLAQUE					1														SALVAGED FROM SB MP 4.30			
SB	4.210	G	VR-017	24	24								1		X											NORTH RD TH-1			
		G	VR-017	24	30			5.00								1		X											E-141
SB	4.215	F	W1-6	48	24		<=== LEFT LARGE ARROW			1				X															
		H	R1-1	30	30		STOP			1				X													NORTH RD TH-1 ISLAND		
		E	W1-6	48	24		RIGHT ===> LARGE ARROW			1				X															
SB	4.209	H	R1-1	24	24								1		X											NORTH RD TH-1			
		H	R1-1	30	30			6.25								1		X										X	
SB	4.102	F	S3-1	30	30								1		X															
		F	S3-1	30	30			6.25								1		X										X	
SB	3.945	F	R2-1	24	30		SPEED LIMIT 40						1		X														
SB	3.920	F	R2-1	24	30			5.00									1		X							INSTALL ACROSS FROM NORTHBOUND SPEED LIMIT 35	X		
SB	3.927	G	VR-017	24	30			5.00								1		X							WHITNEY LN TH -25			E-141
SB	3.917	H	R1-1	24	24								1		X											WHITNEY LN TH -25			
		H	R1-1	30	30			6.25								1		X										X	
							SHEET TOTALS	33.75	0.00	3	0	1	5	0	0	6		90											
								SF	SF	EA	EA	EA	EA	EA	EA	EA		FT											
							TOWN TOTALS	462.5	0.0	40.0	2.0	2.0	86	0.0	0.0	77		1155.0											

SIGN SUMMARY SHEET

VERMONT AGENCY OF TRANSPORTATION

PROJECT NAME: **Moretown-Newport Town VT100**
PROJECT NUMBER: **STPG SIGN(28)**

FILE NAME: **Eden.xls** PLOT DATE: **9/30/2009**
PROJECT MANAGER: **N. Avery** DRAWN BY: **I. Shea**
DESIGNED BY: **D. Crossley** CHECKED BY: **J. Kelly**
EDEN SHEET 10 SHEET **113** OF **166**

DIRECTION	MILEPOINT	LOCATION CODE (SHEET 2)	SIGN CODE	WIDTH (IN)	HEIGHT (IN)	SHEETING REMARKS	SIGN LEGEND	NEW SIGNS "A"	NEW SIGNS "B"	EXISTING SIGNS RETAIN	EXISTING SIGNS SALVAGE FROM	EXISTING SIGNS SALVAGE TO	EXISTING SIGNS REMOVE	EXIST POST RETAIN	EXIST POST REMOVE	NUMBER OF NEW POSTS	SQUARE STEEL (IN) (LB / FT) 1.75 / 1.88	SQUARE STEEL (IN) (LB / FT) 2.00 / 2.42	SQUARE STEEL (IN) (LB / FT) 2.50 / 3.35	TUBULAR STEEL Ø (IN) FOUNDATION	TUBULAR STEEL Ø (IN) (LB / FT) 3.00 / 7.60	TUBULAR STEEL Ø (IN) (LB / FT) 3.50 / 9.00	TUBULAR STEEL Ø (IN) (LB / FT) 4.00 / 10.80	TUBULAR STEEL Ø (IN) (LB / FT) 5.00 / 14.60	SIGN FRAME REQUIRED	REMARKS	SIGN DETAIL: DETAIL IN SHS	SIGN DETAIL: DETAIL ON SHEET NUMBER	SIGN DETAIL: DETAIL ON STD SHEET NUMBER
EDEN VT 100							FY-FLUORESCENT YELLOW FYG-FLUORESCENT YELLOW GREEN																			"SHS"-STANDARD HIGHWAY SIGNS			
SB	3.907	A	W1-8L	18	24			3.00								1		X								INSTALL 50'+/- SOUTH OF WHITNEY LANE TH	X		
		B	W1-8R	18	24			3.00								1		X								INSTALL 51 '+/- SOUTH OF WHITNEY LANE TH	X		
SB	3.867	A	W1-8L	18	24			3.00								1		X								INSTALL 200' +/- SOUTH OF PREVIOUS CHEVRON	X		
		B	W1-8R	18	24			3.00								1		X									X		
SB	3.730	F	R2-1	24	30								1		X															
SB	3.720	F	R2-1	24	30			5.00								1		X								INSTALL ACROSS FROM NORTHBOUND SPEED LIMIT 40			
SB	3.707	G	N/A	24	30		NO DUMPING						1		X													
SB	3.320	G	VR-017	24	30								1		X												OLD SCHOOLHOUSE RD TH-44			
		G	VR-017	24	30			5.00								1		X											E-141
SB	3.309	H	R1-1	30	30								1		X												OLD SCHOOLHOUSE RD TH-44			
		H	R1-1	30	30			6.25								1		X									X		
SB	3.051	F	M2-1S	21	15								1		X														
		F	M1-5	30	24								1																
		F	M2-1	21	15			2.19								1		X								GREEN ON WHITE SHEETING	X		
		F	M1-5	30	24			5.00																					E-136B
							SHEET TOTALS	35.44 SF	0.00 SF	0 EA	0 EA	0 EA	6 EA	0 EA	0 EA	8 EA		120 FT									
							TOWN TOTALS	462.5	0.0	40.0	2.0	2.0	86	0.0	0.0	77		1155.0									

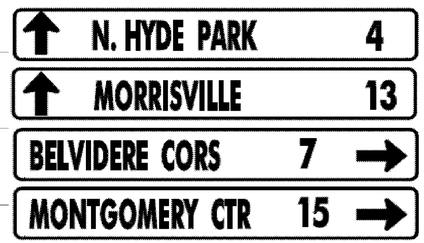
SIGN SUMMARY SHEET

VERMONT AGENCY OF TRANSPORTATION

PROJECT NAME: **Moretown-Newport Town VT100**
PROJECT NUMBER: **STPG SIGN(28)**

FILE NAME: **Eden.xls**
PROJECT MANAGER: **N. Averv**
DESIGNED BY: **D. Crossley**
EDEN SHEET 11

PLOT DATE: **9/30/2009**
DRAWN BY: **I. Shea**
CHECKED BY: **J. Kelly**


DIRECTION	MILEPOINT	LOCATION CODE (SHEET 2)	SIGN CODE	WIDTH (IN)	HEIGHT (IN)	SHEETING REMARKS	SIGN LEGEND	NEW SIGNS "A"	NEW SIGNS "B"	EXISTING SIGNS RETAIN	EXISTING SIGNS SALVAGE FROM	EXISTING SIGNS SALVAGE TO	EXISTING SIGNS REMOVE	EXIST POST RETAIN	EXIST POST REMOVE	NUMBER OF NEW POSTS	SQUARE STEEL (IN) (LB / FT) 1.75 / 1.88	SQUARE STEEL (IN) (LB / FT) 2.00 / 2.42	SQUARE STEEL (IN) (LB / FT) 2.50 / 3.35	TUBULAR STEEL Ø (IN) FOUNDATION	TUBULAR STEEL Ø (IN) (LB / FT) 3.00 / 7.60	TUBULAR STEEL Ø (IN) (LB / FT) 3.50 / 9.00	TUBULAR STEEL Ø (IN) (LB / FT) 4.00 / 10.80	TUBULAR STEEL Ø (IN) (LB / FT) 5.00 / 14.60	SIGN FRAME REQUIRED	REMARKS	SIGN DETAIL: DETAIL IN SHS	SIGN DETAIL: DETAIL ON SHEET NUMBER	SIGN DETAIL: DETAIL ON STD SHEET NUMBER
EDEN VT 100							FY-FLUORESCENT YELLOW FYG-FLUORESCENT YELLOW GREEN																			"SHS"-STANDARD HIGHWAY SIGNS			
SB	2.995	G	VR-017	24	30								1		X											SHOVER RD TH-21			
		G	VR-017	24	30			5.00								1		X										E-141
SB	2.985	H	R1-1	30	30								1		X											SHOVER RD TH-21			
		H	R1-1	30	30			6.25								1		X									X	
SB	2.969	F	D1-1A	72	10								1		X													
		F	D1-1A	72	10								1															
		F	D1-1A	72	10								1															
		F	D1-1A	72	12			6.00								2			X							5
		F	D1-1A	72	12			6.00																				5
		F	D1-1A	72	12			6.00																				5
		F	D1-1A	72	12			6.00																				5
SB	2.945	F	M3-3S	24	12								1		X													
		F	M1-5	30	24								1															
		F	M6-3S	21	15								1															
							SHEET TOTALS	35.25	0.00	0	0	0	9	0	0	4		60										
								SF	SF	EA	EA	EA	EA	EA	EA	EA		FT										
							TOWN TOTALS	462.5	0.0	40.0	2.0	2.0	86	0.0	0.0	77		1155.0										

SIGN SUMMARY SHEET

VERMONT AGENCY OF TRANSPORTATION

PROJECT NAME: **Moretown-Newport Town VT100**
PROJECT NUMBER: **STPG SIGN(28)**

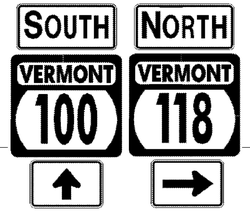FILE NAME: **Eden.xls** PLOT DATE: **9/30/2009**
PROJECT MANAGER: **N. Avery** DRAWN BY: **I. Shea**
DESIGNED BY: **D. Crossley** CHECKED BY: **J. Kelly**
EDEN SHEET 12 SHEET **115** OF **166**


DIRECTION	MILEPOINT	LOCATION CODE (SHEET 2)	SIGN CODE	WIDTH (IN)	HEIGHT (IN)	SHEETING REMARKS	SIGN LEGEND	NEW SIGNS "A"	NEW SIGNS "B"	EXISTING SIGNS RETAIN	EXISTING SIGNS SALVAGE FROM	EXISTING SIGNS SALVAGE TO	EXISTING SIGNS REMOVE	EXIST POST RETAIN	EXIST POST REMOVE	NUMBER OF NEW POSTS	SQUARE STEEL (IN) 1.75 (LB / FT) 1.88	SQUARE STEEL (IN) 2.00 (LB / FT) 2.42	SQUARE STEEL (IN) 2.50 (LB / FT) 3.35	TUBULAR STEEL Ø (IN) FOUNDATION	TUBULAR STEEL Ø (IN) 3.00 (LB / FT) 7.60	TUBULAR STEEL Ø (IN) 3.50 (LB / FT) 9.00	TUBULAR STEEL Ø (IN) 4.00 (LB / FT) 10.80	TUBULAR STEEL Ø (IN) 5.00 (LB / FT) 14.60	SIGN FRAME REQUIRED	REMARKS	SIGN DETAIL: DETAIL IN SHS	SIGN DETAIL: DETAIL ON SHEET NUMBER	SIGN DETAIL: DETAIL ON STD SHEET NUMBER
EDEN VT 100							FY-FLUORESCENT YELLOW FYG-FLUORESCENT YELLOW GREEN																			"SHS"-STANDARD HIGHWAY SIGNS			
		F	M3-1S	24	12								1																
		F	M1-5	30	24								1																
		F	M6-1S	21	15								1																
		F	M3-3	24	12			2.00								2			X						2B	GREEN ON WHITE SHEETING	X	7	
		F	M1-5	30	24			5.00																				E-136B
		F	M6-3	21	15			2.19																		GREEN ON WHITE SHEETING	X		
		F	M3-1	24	12			2.00																	GREEN ON WHITE SHEETING	X		
		F	M1-5	30	24			5.00																				E-136B
		F	M6-1R	21	15			2.19																		GREEN ON WHITE SHEETING	X		
SB	2.882	F	M3-3S	24	12								1		X														
		F	M1-5	30	24								1																
		F	M3-3	24	12			2.00								1		X								GREEN ON WHITE SHEETING	X		
		F	M1-5	30	24			5.00																				E-136B
SB	2.844	F	R2-1	24	30								1		X															
		F	R2-1	24	30			5.00								1		X									X		
							SHEET TOTALS	30.38	0.00	0	0	0	6	0	0	4		60											
								SF	SF	EA	EA	EA	EA	EA	EA	EA		FT											
							TOWN TOTALS	462.5	0.0	40.0	2.0	2.0	86	0.0	0.0	77		1155.0											

SIGN SUMMARY SHEET

VERMONT AGENCY OF TRANSPORTATION

PROJECT NAME: **Moretown-Newport Town VT100**
PROJECT NUMBER: **STPG SIGN(28)**

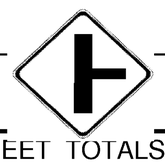FILE NAME: **Eden.xls** PLOT DATE: **9/30/2009**
PROJECT MANAGER: **N. Avery** DRAWN BY: **I. Shea**
DESIGNED BY: **D. Crossley** CHECKED BY: **J. Kelly**
EDEN SHEET 13 SHEET **116** OF **166**

DIRECTION	MILEPOINT	LOCATION CODE (SHEET 2)	SIGN CODE	WIDTH (IN)	HEIGHT (IN)	SHEETING REMARKS	SIGN LEGEND	NEW SIGNS "A"	NEW SIGNS "B"	EXISTING SIGNS RETAIN	EXISTING SIGNS SALVAGE FROM	EXISTING SIGNS SALVAGE TO	EXISTING SIGNS REMOVE	EXIST POST RETAIN	EXIST POST REMOVE	NUMBER OF NEW POSTS	SQUARE STEEL (IN) 1.75 (LB / FT) 1.88	SQUARE STEEL (IN) 2.00 (LB / FT) 2.42	SQUARE STEEL (IN) 2.50 (LB / FT) 3.35	TUBULAR STEEL Ø (IN) FOUNDATION	TUBULAR STEEL Ø (IN) 3.00 (LB / FT) 7.60	TUBULAR STEEL Ø (IN) 3.50 (LB / FT) 9.00	TUBULAR STEEL Ø (IN) 4.00 (LB / FT) 10.80	TUBULAR STEEL Ø (IN) 5.00 (LB / FT) 14.60	SIGN FRAME REQUIRED	REMARKS	SIGN DETAIL: DETAIL IN SHS	SIGN DETAIL: DETAIL ON SHEET NUMBER	SIGN DETAIL: DETAIL ON STD SHEET NUMBER
EDEN VT 100							FY-FLUORESCENT YELLOW FYG-FLUORESCENT YELLOW GREEN																			"SHS"-STANDARD HIGHWAY SIGNS			
SB	2.808	F	W7-1	30	30		HILL						1		X														
SB	2.160	G	VR-017	24	30								1		X												DEUSO RD TH-15			
		G	VR-017	24	30			5.00								1		X											E-141
SB	2.151	H	R1-1	24	24								1		X												DEUSO RD TH-15			
		H	R1-1	30	30			6.25								1		X									X		
SB	2.070	F	S1-1YG	36	36		SCHOOL			1				X															
		F	W16-9YG	36	20		AHEAD			1																			
SB	1.985	F	D1-1E	72	12					1				X															
SB	1.941	G	VR-017	24	30								1		X												KNOWLES FLAT RD TH-13			
		G	VR-017	24	30			5.00								1		X											E-141
SB	1.932	H	R1-1	30	30								1		X												KNOWLES FLAT RD TH-13			
		H	R1-1	30	30			6.25								1		X									X		
SB	1.360	F	W2-2R	30	30		RIGHT SIDE ROAD (MOD.)						1		X															
SB	1.322	F	W2-2MaR	30	30			6.25								1		X									INSTALL 200' +/- SOUTH OF ORIGINAL SIGN LOCATION		6	
							SHEET TOTALS	28.75 SF	0.00 SF	3 EA	0 EA	0 EA	6 EA	0 EA	0 EA	5 EA	75 FT									
							TOWN TOTALS	462.5	0.0	40.0	2.0	2.0	86	0.0	0.0	77	1155.0									

SIGN SUMMARY SHEET

VERMONT AGENCY OF TRANSPORTATION

PROJECT NAME: **Moretown-Newport Town VT100**
PROJECT NUMBER: **STPG SIGN(28)**

FILE NAME: **Eden.xls**
PROJECT MANAGER: **N. Averv**
DESIGNED BY: **D. Crossley**
EDEN SHEET 14

PLOT DATE: **9/30/2009**
DRAWN BY: **I. Shea**
CHECKED BY: **J. Kelly**
SHEET **117** OF **166**

DIRECTION	MILEPOINT	LOCATION CODE (SHEET 2)	SIGN CODE	WIDTH (IN)	HEIGHT (IN)	SHEETING REMARKS	SIGN LEGEND	NEW SIGNS "A"	NEW SIGNS "B"	EXISTING SIGNS RETAIN	EXISTING SIGNS SALVAGE FROM	EXISTING SIGNS SALVAGE TO	EXISTING SIGNS REMOVE	EXIST POST RETAIN	EXIST POST REMOVE	NUMBER OF NEW POSTS	SQUARE STEEL (IN) (LB / FT) 1.75 / 1.88	SQUARE STEEL (IN) (LB / FT) 2.00 / 2.42	SQUARE STEEL (IN) (LB / FT) 2.50 / 3.35	TUBULAR STEEL Ø (IN) FOUNDATION	TUBULAR STEEL Ø (IN) (LB / FT) 3.00 / 7.60	TUBULAR STEEL Ø (IN) (LB / FT) 3.50 / 9.00	TUBULAR STEEL Ø (IN) (LB / FT) 4.00 / 10.80	TUBULAR STEEL Ø (IN) (LB / FT) 5.00 / 14.60	SIGN FRAME REQUIRED	REMARKS	SIGN DETAIL: DETAIL IN SHS	SIGN DETAIL: DETAIL ON SHEET NUMBER	SIGN DETAIL: DETAIL ON STD SHEET NUMBER
EDEN VT 100							FY-FLUORESCENT YELLOW FYG-FLUORESCENT YELLOW GREEN																			"SHS"-STANDARD HIGHWAY SIGNS			
SB	1.273	G	VR-017	24	30								1		X											WHITE RD TH-7			
		G	VR-017	24	30			5.00								1		X										E-141
SB	1.265	H	R1-1	24	24								1		X											WHITE RD TH-7			
		H	R1-1	30	30			6.25								1		X									X		
SB	0.657	F	VW-001A	30	30		MOOSE SYMBOL						1		X														
		F	W7-3A	24	18								1																
		F	VW-001	30	30			6.25								1		X									6	
		F	W7-3A	24	18			3.00																			X		
SB	0.207	G	VR-017	24	30								1		X											OBER HILL RD TH-5			
		G	VR-017	24	30			5.00								1		X										E-141
SB	0.196	H	R1-1	30	30								1		X											OBER HILL RD TH-5			
		H	R1-1	30	30			6.25								1		X									X		
SB	0.000	G	VD-024	60	7.5		TOWNLINE SIGN						1		X														
SIGN SUMMARY SHEET							SHEET TOTALS	31.75 SF	0.00 SF	0 EA	0 EA	0 EA	7 EA	0 EA	0 EA	5 EA		75 FT										
VERMONT AGENCY OF TRANSPORTATION							TOWN TOTALS	462.5	0.0	40.0	2.0	2.0	86	0.0	0.0	77		1155.0										

PROJECT NAME: **Moretown-Newport Town VT100**
PROJECT NUMBER: **STPG SIGN(28)**
FILE NAME: **Eden.xls** PLOT DATE: **9/30/2009**
PROJECT MANAGER: **N. Averv** DRAWN BY: **I. Shea**
DESIGNED BY: **D. Crossley** CHECKED BY: **J. Kelly**
EDEN SHEET 15 SHEET **118** OF **166**

DIRECTION	MILEPOINT	LOCATION CODE (SHEET 2)	SIGN CODE	WIDTH (IN)	HEIGHT (IN)	SHEETING REMARKS	SIGN LEGEND	NEW SIGNS "A"	NEW SIGNS "B"	EXISTING SIGNS RETAIN	EXISTING SIGNS SALVAGE FROM	EXISTING SIGNS SALVAGE TO	EXISTING SIGNS REMOVE	EXIST POST RETAIN	EXIST POST REMOVE	NUMBER OF NEW POSTS	SQUARE STEEL (IN) 1.75 (LB / FT) 1.88	SQUARE STEEL (IN) 2.00 (LB / FT) 2.42	SQUARE STEEL (IN) 2.50 (LB / FT) 3.35	TUBULAR STEEL Ø (IN) FOUNDATION	TUBULAR STEEL Ø (IN) 3.00 (LB / FT) 7.60	TUBULAR STEEL Ø (IN) 3.50 (LB / FT) 9.00	TUBULAR STEEL Ø (IN) 4.00 (LB / FT) 10.80	TUBULAR STEEL Ø (IN) 5.00 (LB / FT) 14.60	SIGN FRAME REQUIRED	REMARKS	SIGN DETAIL: DETAIL IN SHS	SIGN DETAIL: DETAIL ON SHEET NUMBER	SIGN DETAIL: DETAIL ON STD SHEET NUMBER
LOWELL VT 100							FY-FLUORESCENT YELLOW FYG-FLUORESCENT YELLOW GREEN																			"SHS"-STANDARD HIGHWAY SIGNS			
NB	-0.025	C	VD-024	72	12		LOWELL / EDEN				1				X														
		C	VD-025	72	12		ORLEANS CO. / LAMOILLE CO.				1																		
NB	0.000	C	VD-024	72	12		LOWELL/EDEN					1				2		X									INSTALL OPPOSITE BROKEN CONCRETE BOUND JUST SOUTH OF VT 100 SOUTH SIGN			
		C	VD-025	72	12		ORLEANS CO/LAMOILLE CO					1																	
		C	VD-700	6	10		1000 1013 0000	0.42																			INSTALL ON LEFT POST			
		C	VD-700	6	10		1000 0803 0769	0.42																			INSTALL ON RIGHT POST			
NB	0.880	A	W1-3 R	30	30		RIGHT REVERSE TURN						1		X														
NB	0.940	A	W1-2 R	30	30			6.25								1		X									INSTALL 300' +/- NORTH OF REMOVED RIGHT REVERSE TURN SIGN	X		
NB	1.123	A	W1-2L	30	30								1		X														
		A	W1-2L	30	30			6.25								1		X										X		
NB	1.638	C	VR-017	24	24		LEGAL LOAD LIMIT 24,000 LBS						1		X												STEWART RD TH-55 (SOUTH)			
		D	R1-1	24	24		STOP						1																
NB	1.800	C	VR-017	24	24		LEGAL LOAD LIMIT 24,000 POUNDS						1		X												STEWART RD TH-55 (NORTH)			
		C	VR-017	24	30			5.00								1		X												E-141
NB	1.810	D	R1-1	24	24								1		X												STEWART RD TH-55 (NORTH) W/STREET SIGN			
							SHEET TOTALS	18.34	0.00	0	2	2	6	0	0	5		75											
								SF	SF	EA	EA	EA	EA	EA	EA	EA		FT											
							TOWN TOTALS	489.3	0.0	8.0	2.0	2.0	100	0.0	0.0	74		1110.0											

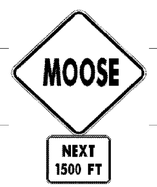
SIGN SUMMARY SHEET

VERMONT AGENCY OF TRANSPORTATION

PROJECT NAME: **Moretown-Newport Town VT100**
PROJECT NUMBER: **STPG SIGN(28)**

FILE NAME: **Lowell.xls**
PROJECT MANAGER: **N. Avery**
DESIGNED BY: **D. Crossley**
LOWELL SHEET 1

PLOT DATE: **9/30/2009**
DRAWN BY: **I. Shea**
CHECKED BY: **J. Kelly**


DIRECTION	MILEPOINT	LOCATION CODE (SHEET 2)	SIGN CODE	WIDTH (IN)	HEIGHT (IN)	SHEETING REMARKS	SIGN LEGEND	NEW SIGNS "A"	NEW SIGNS "B"	EXISTING SIGNS RETAIN	EXISTING SIGNS SALVAGE FROM	EXISTING SIGNS SALVAGE TO	EXISTING SIGNS REMOVE	EXIST POST RETAIN	EXIST POST REMOVE	NUMBER OF NEW POSTS	SQUARE STEEL (IN) 1.75 (LB / FT) 1.88	SQUARE STEEL (IN) 2.00 (LB / FT) 2.42	SQUARE STEEL (IN) 2.50 (LB / FT) 3.35	TUBULAR STEEL Ø (IN) FOUNDATION	TUBULAR STEEL Ø (IN) 3.00 (LB / FT) 7.60	TUBULAR STEEL Ø (IN) 3.50 (LB / FT) 9.00	TUBULAR STEEL Ø (IN) 4.00 (LB / FT) 10.80	TUBULAR STEEL Ø (IN) 5.00 (LB / FT) 14.60	SIGN FRAME REQUIRED	REMARKS	SIGN DETAIL: DETAIL IN SHS	SIGN DETAIL: DETAIL ON SHEET NUMBER	SIGN DETAIL: DETAIL ON STD SHEET NUMBER
LOWELL VT 100							FY-FLUORESCENT YELLOW FYG-FLUORESCENT YELLOW GREEN																			"SHS"-STANDARD HIGHWAY SIGNS			
		D	R1-1	30	30			6.25								1		X								X		
NB	2.302	A	W2-3ML	30	30		MODIFIED LEFT ANGLE SIDE ROAD			1				X														
		A	W16-8A	24	8		MINK FARM RD			1																		
NB	2.350	A	S3-1	30	30		SCHOOL BUS STOP AHEAD			1				X														
NB	2.895	A	OM-3R	12	36		RIGHT OBJECT MARKER						1		X													
NB	2.905	B	OM-3L	12	36		LEFT OBJECT MARKER						1		X												X	
NB	3.130	A	VW-001	30	30								1		X													
		A	W16-4	24	18								1														
		A	VW-001	30	30			6.25								1		X									6	
		A	W16-4	24	18			3.00																			X	
NB	3.791	A	VD-062A	72	16		BUSINESS SIGN			1				X														
NB	4.050	A	R2-5C	24	30		SPEED ZONE AHEAD 						1		X													
		A	W3-5	36	36			9.00								2		X									X	
NB	4.160	A	VD-018	30	18								1		X													
		A	VD-018	30	18			3.75								1		X										E-128B
							SHEET TOTALS	28.25	0.00	4	0	0	6	0	0	5		75									
								SF	SF	EA	EA	EA	EA	EA	EA	EA		FT									
							TOWN TOTALS	489.3	0.0	8.0	2.0	2.0	100	0.0	0.0	74		1110.0									

SIGN SUMMARY SHEET


VERMONT AGENCY OF TRANSPORTATION

PROJECT NAME: **Moretown-Newport Town VT100**
PROJECT NUMBER: **STPG SIGN(28)**

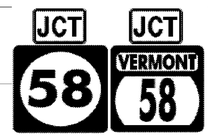
FILE NAME: **Lowell.xls** PLOT DATE: **9/30/2009**
PROJECT MANAGER: **N. Avery** DRAWN BY: **I. Shea**
DESIGNED BY: **D. Crossley** CHECKED BY: **J. Kelly**
LOWELL SHEET 2 SHEET **120** OF **166**

DIRECTION	MILEPOINT	LOCATION CODE (SHEET 2)	SIGN CODE	WIDTH (IN)	HEIGHT (IN)	SHEETING REMARKS	SIGN LEGEND	NEW SIGNS "A"	NEW SIGNS "B"	EXISTING SIGNS RETAIN	EXISTING SIGNS SALVAGE FROM	EXISTING SIGNS SALVAGE TO	EXISTING SIGNS REMOVE	EXIST POST RETAIN	EXIST POST REMOVE	NUMBER OF NEW POSTS	SQUARE STEEL (IN) (LB / FT) 1.75 / 1.88	SQUARE STEEL (IN) (LB / FT) 2.00 / 2.42	SQUARE STEEL (IN) (LB / FT) 2.50 / 3.35	TUBULAR STEEL Ø (IN) FOUNDATION	TUBULAR STEEL Ø (IN) (LB / FT) 3.00 / 7.60	TUBULAR STEEL Ø (IN) (LB / FT) 3.50 / 9.00	TUBULAR STEEL Ø (IN) (LB / FT) 4.00 / 10.80	TUBULAR STEEL Ø (IN) (LB / FT) 5.00 / 14.60	SIGN FRAME REQUIRED	REMARKS	SIGN DETAIL: DETAIL IN SHS	SIGN DETAIL: DETAIL ON SHEET NUMBER	SIGN DETAIL: DETAIL ON STD SHEET NUMBER
LOWELL VT 100							FY-FLUORESCENT YELLOW FYG-FLUORESCENT YELLOW GREEN																			"SHS"-STANDARD HIGHWAY SIGNS			
NB	4.213	C	VR-017	24	24								1		X											IRISH HILL RD TH-29			
		C	VR-017	24	30			5.00								1		X										E-141
NB	4.218	D	R1-1	24	24								1		X											IRISH HILL RD TH-29			
		D	R1-1	30	30			6.25								1		X									X		
NB	4.222	A	VD-370	24	24		BAYLEY HAZEN MILITARY ROAD			1				X															
NB	4.240	A	R2-1	24	30								1		X														
		A	R2-1	30	36			7.50								1		X										6	
NB	4.263	A	M2-1	21	15								1		X														
		A	M1-6	24	24								1																
		A	M2-1	21	15			2.19								2		X							1	GREEN ON WHITE SHEETING	X	7	
		A	M1-5	24	24			4.00																					E-136B
		A	M2-1	21	15			2.19																				
		A	M1-6	24	24			4.00																					
NB	4.283	A	D1-1A	72	10								1		X														
		A	D1-1A	72	10								1																
SIGN SUMMARY SHEET							SHEET TOTALS	31.13	0.00	1	0	0	7	0	0	5		75										
								SF	SF	EA	EA	EA	EA	EA	EA	EA		FT										
VERMONT AGENCY OF TRANSPORTATION							TOWN TOTALS	489.3	0.0	8.0	2.0	2.0	100	0.0	0.0	74		1110.0										

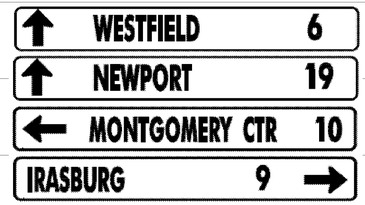PROJECT NAME: **Moretown-Newport Town VT100**
PROJECT NUMBER: **STPG SIGN(28)**
FILE NAME: **Lowell.xls**
PROJECT MANAGER: **N. Averv**
DESIGNED BY: **D. Crossley**
LOWELL SHEET 3
PLOT DATE: **9/30/2009**
DRAWN BY: **I. Shea**
CHECKED BY: **J. Kelly**
SHEET **121** OF **166**

DIRECTION	MILEPOINT	LOCATION CODE (SHEET 2)	SIGN CODE	WIDTH (IN)	HEIGHT (IN)	SHEETING REMARKS	SIGN LEGEND	NEW SIGNS "A"	NEW SIGNS "B"	EXISTING SIGNS RETAIN	EXISTING SIGNS SALVAGE FROM	EXISTING SIGNS SALVAGE TO	EXISTING SIGNS REMOVE	EXIST POST RETAIN	EXIST POST REMOVE	NUMBER OF NEW POSTS	SQUARE STEEL (IN) (LB / FT) 1.75 / 1.88	SQUARE STEEL (IN) (LB / FT) 2.00 / 2.42	SQUARE STEEL (IN) (LB / FT) 2.50 / 3.35	TUBULAR STEEL Ø (IN) FOUNDATION	TUBULAR STEEL Ø (IN) (LB / FT) 3.00 / 7.60	TUBULAR STEEL Ø (IN) (LB / FT) 3.50 / 9.00	TUBULAR STEEL Ø (IN) (LB / FT) 4.00 / 10.80	TUBULAR STEEL Ø (IN) (LB / FT) 5.00 / 14.60	SIGN FRAME REQUIRED	REMARKS	SIGN DETAIL: DETAIL IN SHS	SIGN DETAIL: DETAIL ON SHEET NUMBER	SIGN DETAIL: DETAIL ON STD SHEET NUMBER
LOWELL VT 100							FY-FLUORESCENT YELLOW FYG-FLUORESCENT YELLOW GREEN																			"SHS"-STANDARD HIGHWAY SIGNS			
		A	D1-1A	72	10								1																
		A	D1-1A	72	10								1																
		A	D1-1A	72	12			6.00								2			X									5	
		A	D1-1A	72	12			6.00																		5	
		A	D1-1A	72	12			6.00																				5	
		A	D1-1A	72	12			6.00																				5	
NB	4.348	A	M3-4	24	12								1		X														
		A	M1-6	24	24								1																
		A	M6-1 L	21	15								1																
		A	M3-1	24	12								1																
		A	M1-6	30	24								1																
		A	M6-3	21	15								1																
		A	M3-2	24	12								1																
		A	M1-6	24	24								1																
		A	M6-1 R	21	15								1																
SIGN SUMMARY SHEET							SHEET TOTALS	24.00	0.00	0	0	0	11	0	0	2			30								
								SF	SF	EA	EA	EA	EA	EA	EA	EA			FT								
VERMONT AGENCY OF TRANSPORTATION							TOWN TOTALS	489.3	0.0	8.0	2.0	2.0	100	0.0	0.0	74			1110.0								

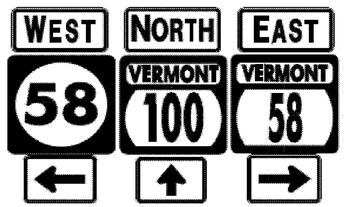PROJECT NAME: **Moretown-Newport Town VT100**
PROJECT NUMBER: **STPG SIGN(28)**
FILE NAME: **Lowell.xls** PLOT DATE: **9/30/2009**
PROJECT MANAGER: **N. Avery** DRAWN BY: **I. Shea**
DESIGNED BY: **D. Crossley** CHECKED BY: **J. Kelly**
LOWELL SHEET 4 SHEET **122** OF **166**



DIRECTION	MILEPOINT	LOCATION CODE (SHEET 2)	SIGN CODE	WIDTH (IN)	HEIGHT (IN)	SHEETING REMARKS	SIGN LEGEND	NEW SIGNS "A"	NEW SIGNS "B"	EXISTING SIGNS RETAIN	EXISTING SIGNS SALVAGE FROM	EXISTING SIGNS SALVAGE TO	EXISTING SIGNS REMOVE	EXIST POST RETAIN	EXIST POST REMOVE	NUMBER OF NEW POSTS	SQUARE STEEL (IN) 1.75 (LB / FT) 1.88	SQUARE STEEL (IN) 2.00 (LB / FT) 2.42	SQUARE STEEL (IN) 2.50 (LB / FT) 3.35	TUBULAR STEEL Ø (IN) FOUNDATION	TUBULAR STEEL Ø (IN) 3.00 (LB / FT) 7.60	TUBULAR STEEL Ø (IN) 3.50 (LB / FT) 9.00	TUBULAR STEEL Ø (IN) 4.00 (LB / FT) 10.80	TUBULAR STEEL Ø (IN) 5.00 (LB / FT) 14.60	SIGN FRAME REQUIRED	REMARKS	SIGN DETAIL: DETAIL IN SHS	SIGN DETAIL: DETAIL ON SHEET NUMBER	SIGN DETAIL: DETAIL ON STD SHEET NUMBER
LOWELL VT 100							FY-FLUORESCENT YELLOW FYG-FLUORESCENT YELLOW GREEN																			"SHS"-STANDARD HIGHWAY SIGNS			
		A	M3-4	24	12			2.00								2			X						3B	BLACK ON WHITE SHEETING	X	7	
		A	M1-6	24	24			4.00																			X		
		A	M6-1 L	21	15			2.19																		BLACK ON WHITE SHEETING	X		
		A	M3-1	24	12			2.00																		GREEN ON WHITE SHEETING	X		
		A	M1-5	30	24			5.00																					E-136B
		A	M6-3	21	15			2.19																GREEN ON WHITE SHEETING	X		
		A	M3-2	24	12			2.00																		GREEN ON WHITE SHEETING	X		
		A	M1-5	24	24			4.00																					E-136B
		A	M6-1 R	21	15			2.19																		GREEN ON WHITE SHEETING	X		
NB	4.385	C	D1-1	72	12								1		X													
		C	D1-1	72	12								1															
		C	D1-1	72	12								1															
		C	M3-1	24	12								1															
		C	M1-5	30	24								1															
		C	M6-1 L	21	15								1															
							SHEET TOTALS	25.57 SF	0.00 SF	0 EA	0 EA	0 EA	6 EA	0 EA	0 EA	2 EA	30 FT											
							TOWN TOTALS	489.3	0.0	8.0	2.0	2.0	100	0.0	0.0	74	1110.0											

SIGN SUMMARY SHEET

VERMONT AGENCY OF TRANSPORTATION



PROJECT NAME: **Moretown-Newport Town VT100**
PROJECT NUMBER: **STPG SIGN(28)**

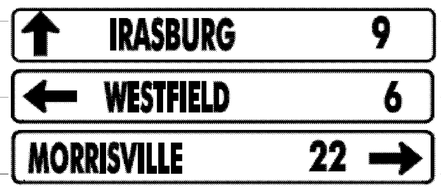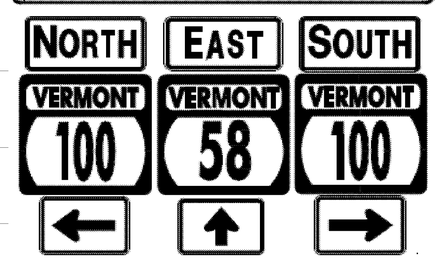FILE NAME: **Lowell.xls** PLOT DATE: **9/30/2009**
PROJECT MANAGER: **N. Avery** DRAWN BY: **I. Shea**
DESIGNED BY: **D. Crossley** CHECKED BY: **J. Kelly**
LOWELL SHEET 5

DIRECTION	MILEPOINT	LOCATION CODE (SHEET 2)	SIGN CODE	WIDTH (IN)	HEIGHT (IN)	SHEETING REMARKS	SIGN LEGEND	NEW SIGNS "A"	NEW SIGNS "B"	EXISTING SIGNS RETAIN	EXISTING SIGNS SALVAGE FROM	EXISTING SIGNS SALVAGE TO	EXISTING SIGNS REMOVE	EXIST POST RETAIN	EXIST POST REMOVE	NUMBER OF NEW POSTS	SQUARE STEEL (IN) 1.75 (LB / FT) 1.88	SQUARE STEEL (IN) 2.00 (LB / FT) 2.42	SQUARE STEEL (IN) 2.50 (LB / FT) 3.35	TUBULAR STEEL Ø (IN) FOUNDATION	TUBULAR STEEL Ø (IN) 3.00 (LB / FT) 7.60	TUBULAR STEEL Ø (IN) 3.50 (LB / FT) 9.00	TUBULAR STEEL Ø (IN) 4.00 (LB / FT) 10.80	TUBULAR STEEL Ø (IN) 5.00 (LB / FT) 14.60	SIGN FRAME REQUIRED	REMARKS	SIGN DETAIL: DETAIL IN SHS	SIGN DETAIL: DETAIL ON SHEET NUMBER	SIGN DETAIL: DETAIL ON STD SHEET NUMBER
LOWELL VT 100							FY-FLUORESCENT YELLOW FYG-FLUORESCENT YELLOW GREEN																			"SHS"-STANDARD HIGHWAY SIGNS			
		C	M3-2	24	12								1																
		C	M1-5	24	24								1																
		C	M6-3	21	15								1																
		C	M3-3	24	12								1																
		C	M1-5	30	24								1																
		C	M6-1 R	21	15								1																
		C	D1-1	72	12			6.00								2			X									5	
		C	D1-1	72	12			6.00																				5	
		C	D1-1	72	12			6.00																				5	
		C	M3-1	24	12			2.00																3B	GREEN ON WHITE SHEETING	X	7	
		C	M1-5	30	24			5.00																					E-136B
		C	M6-1 L	21	15			2.19																	GREEN ON WHITE SHEETING	X		
		C	M3-2	24	12			2.00																			GREEN ON WHITE SHEETING	X		
		C	M1-5	24	24			4.00																				X		E-136B
		C	M6-3	21	15			2.19																			GREEN ON WHITE SHEETING	X		
SIGN SUMMARY SHEET							SHEET TOTALS	35.38	0.00	0	0	0	6	0	0	2		30										
								SF	SF	EA	EA	EA	EA	EA	EA	EA		FT										
VERMONT AGENCY OF TRANSPORTATION							TOWN TOTALS	489.3	0.0	8.0	2.0	2.0	100	0.0	0.0	74		1110.0										

PROJECT NAME: **Moretown-Newport Town VT100**
PROJECT NUMBER: **STPG SIGN(28)**

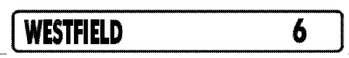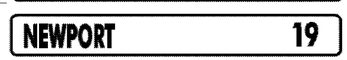FILE NAME: **Lowell.xls** PLOT DATE: **9/30/2009**
PROJECT MANAGER: **N. Avery** DRAWN BY: **I. Shea**
DESIGNED BY: **D. Crossley** CHECKED BY: **J. Kelly**
LOWELL SHEET 6 SHEET **124** OF **166**

DIRECTION	MILEPOINT	LOCATION CODE (SHEET 2)	SIGN CODE	WIDTH (IN)	HEIGHT (IN)	SHEETING REMARKS	SIGN LEGEND	NEW SIGNS "A"	NEW SIGNS "B"	EXISTING SIGNS RETAIN	EXISTING SIGNS SALVAGE FROM	EXISTING SIGNS SALVAGE TO	EXISTING SIGNS REMOVE	EXIST POST RETAIN	EXIST POST REMOVE	NUMBER OF NEW POSTS	SQUARE STEEL (IN) (LB / FT) 1.75 / 1.88	SQUARE STEEL (IN) (LB / FT) 2.00 / 2.42	SQUARE STEEL (IN) (LB / FT) 2.50 / 3.35	TUBULAR STEEL Ø (IN) FOUNDATION	TUBULAR STEEL Ø (IN) (LB / FT) 3.00 / 7.60	TUBULAR STEEL Ø (IN) (LB / FT) 3.50 / 9.00	TUBULAR STEEL Ø (IN) (LB / FT) 4.00 / 10.80	TUBULAR STEEL Ø (IN) (LB / FT) 5.00 / 14.60	SIGN FRAME REQUIRED	REMARKS	SIGN DETAIL: DETAIL IN SHS	SIGN DETAIL: DETAIL ON SHEET NUMBER	SIGN DETAIL: DETAIL ON STD SHEET NUMBER
LOWELL VT 100							FY-FLUORESCENT YELLOW FYG-FLUORESCENT YELLOW GREEN																			"SHS"-STANDARD HIGHWAY SIGNS			
		C	M3-3	24	12			2.00																		GREEN ON WHITE SHEETING	X		
		C	M1-5	30	24			5.00																					E-136B
		C	M6-1 R	21	15			2.19																		GREEN ON WHITE SHEETING	X		
NB	4.395	F	W11-8	30	30								1		X														
		F	W11-8	30	30			6.25								1		X									X		
NB	4.410	A	M3-1	24	12								1		X														
		A	M1-6	30	24								1																
		A	M3-1	24	12			2.00								1		X								GREEN ON WHITE SHEETING	X		
		A	M1-5	30	24			5.00																					E-136B
NB	4.443	A	D2-1	72	10		TROY 10						1		X														
		A	D2-1	72	12			6.00								2		X									5	
		A	D2-1	72	12			6.00																				
NB	4.478	A	R2-1	24	30								1		X														
		A	R2-1	24	30			5.00								1		X									X		
NB	4.670	A	S1-1	36	36								1		X														
SIGN SUMMARY SHEET							SHEET TOTALS	34.44	0.00	0	0	0	6	0	0	5		75										
								SF	SF	EA	EA	EA	EA	EA	EA	EA		FT										
VERMONT AGENCY OF TRANSPORTATION							TOWN TOTALS	489.3	0.0	8.0	2.0	2.0	100	0.0	0.0	74		1110.0										

PROJECT NAME: **Moretown-Newport Town VT100**
PROJECT NUMBER: **STPG SIGN(28)**

FILE NAME: **Lowell.xls** PLOT DATE: **9/30/2009**
PROJECT MANAGER: **N. Averv** DRAWN BY: **I. Shea**
DESIGNED BY: **D. Crosslev** CHECKED BY: **J. Kelly**
LOWELL SHEET 7 SHEET **125** OF **166**

DIRECTION	MILEPOINT	LOCATION CODE (SHEET 2)	SIGN CODE	WIDTH (IN)	HEIGHT (IN)	SHEETING REMARKS	SIGN LEGEND	NEW SIGNS "A"	NEW SIGNS "B"	EXISTING SIGNS RETAIN	EXISTING SIGNS SALVAGE FROM	EXISTING SIGNS SALVAGE TO	EXISTING SIGNS REMOVE	EXIST POST RETAIN	EXIST POST REMOVE	NUMBER OF NEW POSTS	SQUARE STEEL (IN) 1.75 (LB / FT) 1.88	SQUARE STEEL (IN) 2.00 (LB / FT) 2.42	SQUARE STEEL (IN) 2.50 (LB / FT) 3.35	TUBULAR STEEL Ø (IN) FOUNDATION	TUBULAR STEEL Ø (IN) 3.00 (LB / FT) 7.60	TUBULAR STEEL Ø (IN) 3.50 (LB / FT) 9.00	TUBULAR STEEL Ø (IN) 4.00 (LB / FT) 10.80	TUBULAR STEEL Ø (IN) 5.00 (LB / FT) 14.60	SIGN FRAME REQUIRED	REMARKS	SIGN DETAIL: DETAIL IN SHS	SIGN DETAIL: DETAIL ON SHEET NUMBER	SIGN DETAIL: DETAIL ON STD SHEET NUMBER
LOWELL VT 100							FY-FLUORESCENT YELLOW FYG-FLUORESCENT YELLOW GREEN																			"SHS"-STANDARD HIGHWAY SIGNS			
		A	S1-1	36	36	FYG		6.25								2		X									X		
			W16-9	24	12	FYG		2.00																			X		
NB	4.700	A	W11-6 H	30	30		SNOWMOBILE (HINGED)						1		X														
		A	D1-1	72	20			10.00								2		X										5	
NB	4.895	A	R2-1	24	30								1		X															
		A	R2-1	24	30			5.00								1		X									X		
NB	4.905	C	VR-017	24	24								1		X												CARTER RD TH-33			
		C	VR-017	24	30			5.00								1		X											W-141
NB	4.910	D	R1-1	24	24								1		X												CARTER RD TH-33			
		D	R1-1	30	30			6.25								1		X									X		
NB	5.260	A	W11-6 H	30	30			6.25								1		X									INSTALL AT SOUTHERN WHITE FENCE			E-153
NB	6.127	C	VR-017	24	30								1		X												STEPHENSON RD TH-35			
		C	VR-017	24	30			5.00								1		X											E-141
NB	6.135	D	R1-1	30	30								1		X												STEPHENSON RD TH-35			
		D	R1-1	30	30			6.25								1		X									X		
SIGN SUMMARY SHEET							SHEET TOTALS	52.00	0.00	0	0	0	6	0	0	10		150									
								SF	SF	EA	EA	EA	EA	EA	EA	EA		FT									
VERMONT AGENCY OF TRANSPORTATION							TOWN TOTALS	489.3	0.0	8.0	2.0	2.0	100	0.0	0.0	74		1110.0									

PROJECT NAME: **Moretown-Newport Town VT100**
PROJECT NUMBER: **STPG SIGN(28)**

FILE NAME: **Lowell.xls**
PROJECT MANAGER: **N. Averv**
DESIGNED BY: **D. Crosslev**
LOWELL SHEET 8

PLOT DATE: **9/30/2009**
DRAWN BY: **I. Shea**
CHECKED BY: **J. Kelly**
SHEET **126** OF **166**

DIRECTION	MILEPOINT	LOCATION CODE (SHEET 2)	SIGN CODE	WIDTH (IN)	HEIGHT (IN)	SHEETING REMARKS	SIGN LEGEND	NEW SIGNS "A"	NEW SIGNS "B"	EXISTING SIGNS RETAIN	EXISTING SIGNS SALVAGE FROM	EXISTING SIGNS SALVAGE TO	EXISTING SIGNS REMOVE	EXIST POST RETAIN	EXIST POST REMOVE	NUMBER OF NEW POSTS	SQUARE STEEL (IN) 1.75 (LB / FT) 1.88	SQUARE STEEL (IN) 2.00 (LB / FT) 2.42	SQUARE STEEL (IN) 2.50 (LB / FT) 3.35	TUBULAR STEEL Ø (IN) FOUNDATION	TUBULAR STEEL Ø (IN) 3.00 (LB / FT) 7.60	TUBULAR STEEL Ø (IN) 3.50 (LB / FT) 9.00	TUBULAR STEEL Ø (IN) 4.00 (LB / FT) 10.80	TUBULAR STEEL Ø (IN) 5.00 (LB / FT) 14.60	SIGN FRAME REQUIRED	REMARKS	SIGN DETAIL: DETAIL IN SHS	SIGN DETAIL: DETAIL ON SHEET NUMBER	SIGN DETAIL: DETAIL ON STD SHEET NUMBER
LOWELL VT 100							FY-FLUORESCENT YELLOW FYG-FLUORESCENT YELLOW GREEN																			"SHS"-STANDARD HIGHWAY SIGNS			
SB	5.600	G	VM-607	24	30		43RD INF DIV MEMORIAL HIGHWAY			1				X															
SB	5.553	G	VR-017	24	24								1		X											POPE RD TH-25			
		G	VR-017	24	30			5.00								1		X											E-141
SB	5.546	H	R1-1	24	24								1		X											POPE RD TH-25			
		H	R1-1	30	30			6.25								1		X										X		
SB	5.390	F	W11-6 H	30	30			6.25								1		X									INSTALL 200' +/- NORTH OF ORIGINAL SIGN LOCATION			E-153
SB	5.350	F	W11-6 H	30	30		SNOWMOBILE - HINGED						1		X														
SB	5.037	F	R2-5C	24	30		SPEED ZONE AHEAD						1		X														
		F	W3-5	36	36			9.00								2		X										X		
SB	4.959	F	VD-018	30	18								1		X														
		F	VD-018	30	18			3.75								1		X											E-128B
SB	4.904	F	W11-6 H	30	30		SNOWMOBILE - HINGED						1		X														
SB	4.880	F	R2-1	24	30								1		X														
		F	R2-1	30	36			7.50								1		X										6		
SB	4.871	F	S1-1	36	36								1		X														
							SHEET TOTALS	37.75 SF	0.00 SF	1 EA	0 EA	0 EA	8 EA	0 EA	0 EA	7 EA		105 FT											
							TOWN TOTALS	489.3	0.0	8.0	2.0	2.0	100	0.0	0.0	74		1110.0											

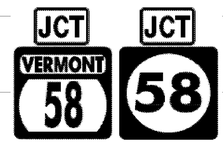
SIGN SUMMARY SHEET

VERMONT AGENCY OF TRANSPORTATION

PROJECT NAME: **Moretown-Newport Town VT100**
PROJECT NUMBER: **STPG SIGN(28)**

FILE NAME: **Lowell.xls**
PROJECT MANAGER: **N. Averv**
DESIGNED BY: **D. Crossley**
LOWELL SHEET 9

PLOT DATE: **9/30/2009**
DRAWN BY: **I. Shea**
CHECKED BY: **J. Kelly**
SHEET **127** OF **166**

DIRECTION	MILEPOINT	LOCATION CODE (SHEET 2)	SIGN CODE	WIDTH (IN)	HEIGHT (IN)	SHEETING REMARKS	SIGN LEGEND	NEW SIGNS "A"	NEW SIGNS "B"	EXISTING SIGNS RETAIN	EXISTING SIGNS SALVAGE FROM	EXISTING SIGNS SALVAGE TO	EXISTING SIGNS REMOVE	EXIST POST RETAIN	EXIST POST REMOVE	NUMBER OF NEW POSTS	SQUARE STEEL (IN) 1.75 (LB / FT) 1.88	SQUARE STEEL (IN) 2.00 (LB / FT) 2.42	SQUARE STEEL (IN) 2.50 (LB / FT) 3.35	TUBULAR STEEL Ø (IN) FOUNDATION	TUBULAR STEEL Ø (IN) 3.00 (LB / FT) 7.60	TUBULAR STEEL Ø (IN) 3.50 (LB / FT) 9.00	TUBULAR STEEL Ø (IN) 4.00 (LB / FT) 10.80	TUBULAR STEEL Ø (IN) 5.00 (LB / FT) 14.60	SIGN FRAME REQUIRED	REMARKS	SIGN DETAIL: DETAIL IN SHS	SIGN DETAIL: DETAIL ON SHEET NUMBER	SIGN DETAIL: DETAIL ON STD SHEET NUMBER
LOWELL VT 100							FY-FLUORESCENT YELLOW FYG-FLUORESCENT YELLOW GREEN																			"SHS"-STANDARD HIGHWAY SIGNS			
			S1-1	36	36	FYG		6.25								2		X									X		
			W16-9	24	12	FYG		2.00																			X		
SB	4.820	F	D1-1	72	20			10.00								2		X									INSTALL 250'+/- NORTH OF SCHOOL DRIVE.		5	
SB	4.602	F	W11-8	30	30								1		X															
		F	W11-8	30	30			6.25								1		X									X		
SB	4.505	F	M2-1	21	15								1		X															
		F	M1-6	24	24								1																	
		F	M2-1	21	15			2.19								2		X								1	GREEN ON WHITE SHEETING	X	7	
		F	M1-5	24	24			4.00																					E-136B
		F	M2-1	21	15			2.19																					
		F	M1-6	24	24			4.00																					
SB	4.460	F	D1-1	72	10								1		X															
		F	D1-1	72	10								1																	
		F	D1-1	72	10								1																	
		F	D1-1	72	12			6.00								2			X									5		
SIGN SUMMARY SHEET							SHEET TOTALS	42.88	0.00	0	0	0	6	0	0	9		135										
								SF	SF	EA	EA	EA	EA	EA	EA	EA		FT										
VERMONT AGENCY OF TRANSPORTATION							TOWN TOTALS	489.3	0.0	8.0	2.0	2.0	100	0.0	0.0	74		1110.0										

PROJECT NAME: **Moretown-Newport Town VT100**
PROJECT NUMBER: **STPG SIGN(28)**

FILE NAME: **Lowell.xls** PLOT DATE: **9/30/2009**
PROJECT MANAGER: **N. Avery** DRAWN BY: **I. Shea**
DESIGNED BY: **D. Crossley** CHECKED BY: **J. Kelly**
LOWELL SHEET 10 SHEET **128** OF **166**

DIRECTION	MILEPOINT	LOCATION CODE (SHEET 2)	SIGN CODE	WIDTH (IN)	HEIGHT (IN)	SHEETING REMARKS	SIGN LEGEND	NEW SIGNS "A"	NEW SIGNS "B"	EXISTING SIGNS RETAIN	EXISTING SIGNS SALVAGE FROM	EXISTING SIGNS SALVAGE TO	EXISTING SIGNS REMOVE	EXIST POST RETAIN	EXIST POST REMOVE	NUMBER OF NEW POSTS	SQUARE STEEL (IN) 1.75 (LB / FT) 1.88	SQUARE STEEL (IN) 2.00 (LB / FT) 2.42	SQUARE STEEL (IN) 2.50 (LB / FT) 3.35	TUBULAR STEEL Ø (IN) FOUNDATION	TUBULAR STEEL Ø (IN) 3.00 (LB / FT) 7.60	TUBULAR STEEL Ø (IN) 3.50 (LB / FT) 9.00	TUBULAR STEEL Ø (IN) 4.00 (LB / FT) 10.80	TUBULAR STEEL Ø (IN) 5.00 (LB / FT) 14.60	SIGN FRAME REQUIRED	REMARKS	SIGN DETAIL: DETAIL IN SHS	SIGN DETAIL: DETAIL ON SHEET NUMBER	SIGN DETAIL: DETAIL ON STD SHEET NUMBER
LOWELL VT 100							FY-FLUORESCENT YELLOW FYG-FLUORESCENT YELLOW GREEN																			"SHS"-STANDARD HIGHWAY SIGNS			
		F	D1-1	72	12		EDEN 9	6.00																				5	
		F	D1-1	72	12		MORRISVILLE 22	6.00																				5	
		F	D1-1	72	12		IRASBURG 9	6.00																				5	
		F	D1-1	72	12		MONTGOMERY CTR 10	6.00																				5	
SB	4.400	F	M3-2	24	12								1		X														
		F	M1-6	24	24								1																
		F	M3-3	24	12								1																
		F	M1-6	30	24								1																
		F	M6-3	21	15								1																
		F	M3-3	24	12								1																
		F	M1-6	24	24								1																
		F	M6-1	21	15								1																
		F	M3-2	24	12			2.00								2			X						3B	GREEN ON WHITE SHEETING	X	7	
		F	M1-5	24	24			4.00																					E-136B
		F	M6-1 L	21	15			2.19																		GREEN ON WHITE SHEETING	X		
							SHEET TOTALS	26.19	0.00	0	0	0	9	0	0	2			30									
								SF	SF	EA	EA	EA	EA	EA	EA	EA			FT									
							TOWN TOTALS	489.3	0.0	8.0	2.0	2.0	100	0.0	0.0	74			1110.0									

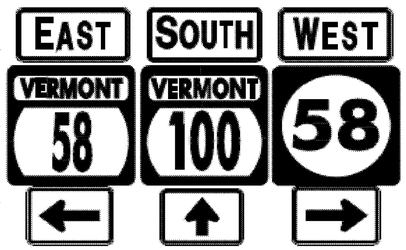
SIGN SUMMARY SHEET

VERMONT AGENCY OF TRANSPORTATION

PROJECT NAME: **Moretown-Newport Town VT100**
PROJECT NUMBER: **STPG SIGN(28)**

FILE NAME: **Lowell.xls**
PROJECT MANAGER: **N. Averv**
DESIGNED BY: **D. Crossley**
LOWELL SHEET 11

PLOT DATE: **9/30/2009**
DRAWN BY: **I. Shea**
CHECKED BY: **J. Kelly**
SHEET **129** OF **166**


DIRECTION	MILEPOINT	LOCATION CODE (SHEET 2)	SIGN CODE	WIDTH (IN)	HEIGHT (IN)	SHEETING REMARKS	SIGN LEGEND	NEW SIGNS "A"	NEW SIGNS "B"	EXISTING SIGNS RETAIN	EXISTING SIGNS SALVAGE FROM	EXISTING SIGNS SALVAGE TO	EXISTING SIGNS REMOVE	EXIST POST RETAIN	EXIST POST REMOVE	NUMBER OF NEW POSTS	SQUARE STEEL (IN) 1.75 (LB / FT) 1.88	SQUARE STEEL (IN) 2.00 (LB / FT) 2.42	SQUARE STEEL (IN) 2.50 (LB / FT) 3.35	TUBULAR STEEL Ø (IN) FOUNDATION	TUBULAR STEEL Ø (IN) 3.00 (LB / FT) 7.60	TUBULAR STEEL Ø (IN) 3.50 (LB / FT) 9.00	TUBULAR STEEL Ø (IN) 4.00 (LB / FT) 10.80	TUBULAR STEEL Ø (IN) 5.00 (LB / FT) 14.60	SIGN FRAME REQUIRED	REMARKS	SIGN DETAIL: DETAIL IN SHS	SIGN DETAIL: DETAIL ON SHEET NUMBER	SIGN DETAIL: DETAIL ON STD SHEET NUMBER
LOWELL VT 100							FY-FLUORESCENT YELLOW FYG-FLUORESCENT YELLOW GREEN																			"SHS"-STANDARD HIGHWAY SIGNS			
		F	M3-3	24	12			2.00																		GREEN ON WHITE SHEETING	X		
		F	M1-5	30	24			5.00																				E-136B
		F	M6-3	21	15			2.19																		GREEN ON WHITE SHEETING	X		
		F	M3-3	24	12			2.00																		BLACK ON WHITE SHEETING			
		F	M1-6	24	24			4.00																				E-136B
		F	M6-1R	21	15			2.19																		BLACK ON WHITE SHEETING	X		
SB	4.391	G	VR-017	24	24								1		X											HAZEN NOTCH RD TH-1 SNR			
		H	R1-1	24	24		STOP 						1															
		G	VR-017	24	30			5.00								1	X											E-141
SB	4.477	H	R1-1	24	24								1		X													
		H	R1-1	36	36			9.00								2	X									HAZEN NOTCH RD TH-1 SNR	X		
SB	4.481	F	VD-370	24	24		BAYLEY HAZEN MILITARY ROAD						1		X													
SB	4.357	F	M3-3	24	12								1		X													
		F	M1-6	24	24								1															
		F	M3-3	24	12			2.00								1	X									GREEN ON WHITE SHEETING	X		
							SHEET TOTALS	33.38	0.00	0	0	0	6	0	0	4	60											
								SF	SF	EA	EA	EA	EA	EA	EA	EA	FT											
							TOWN TOTALS	489.3	0.0	8.0	2.0	2.0	100	0.0	0.0	74	1110.0											

SIGN SUMMARY SHEET

VERMONT AGENCY OF TRANSPORTATION

PROJECT NAME: **Moretown-Newport Town VT100**
PROJECT NUMBER: **STPG SIGN(28)**

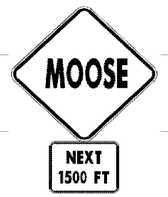FILE NAME: **Lowell.xls** PLOT DATE: **9/30/2009**
PROJECT MANAGER: **N. Averv** DRAWN BY: **I. Shea**
DESIGNED BY: **D. Crosslev** CHECKED BY: **J. Kelly**
LOWELL SHEET 12 SHEET **130** OF **166**

DIRECTION	MILEPOINT	LOCATION CODE (SHEET 2)	SIGN CODE	WIDTH (IN)	HEIGHT (IN)	SHEETING REMARKS	SIGN LEGEND	NEW SIGNS "A"	NEW SIGNS "B"	EXISTING SIGNS RETAIN	EXISTING SIGNS SALVAGE FROM	EXISTING SIGNS SALVAGE TO	EXISTING SIGNS REMOVE	EXIST POST RETAIN	EXIST POST REMOVE	NUMBER OF NEW POSTS	SQUARE STEEL (IN) 1.75 (LB/FT) 1.88	SQUARE STEEL (IN) 2.00 (LB/FT) 2.42	SQUARE STEEL (IN) 2.50 (LB/FT) 3.35	TUBULAR STEEL Ø (IN) FOUNDATION	TUBULAR STEEL Ø (IN) 3.00 (LB/FT) 7.60	TUBULAR STEEL Ø (IN) 3.50 (LB/FT) 9.00	TUBULAR STEEL Ø (IN) 4.00 (LB/FT) 10.80	TUBULAR STEEL Ø (IN) 5.00 (LB/FT) 14.60	SIGN FRAME REQUIRED	REMARKS	SIGN DETAIL: DETAIL IN SHS	SIGN DETAIL: DETAIL ON SHEET NUMBER	SIGN DETAIL: DETAIL ON STD SHEET NUMBER
LOWELL VT 100							FY-FLUORESCENT YELLOW FYG-FLUORESCENT YELLOW GREEN																			"SHS"-STANDARD HIGHWAY SIGNS			
		F	M1-5	30	24			5.00																				E-136B
SB	4.317	F	D2-1	72	10								1		X														
		F	D2-1	72	12			6.00								2		X										5	
		F	D2-1	72	12			6.00																				5	
SB	4.240	F	R2-1	24	30								1		X															
		F	R2-1	24	30			5.00								1		X									INSTALL ACROSS FROM NORTHBOUND SPEED LIMIT 35	X		
SB	4.180	G	VR-017	24	30			5.00								1		X									LOWER VILLAGE RD TH-2			E-141
SB	4.173	H	R1-1	24	24								1		X													LOWER VILLAGE RD TH-2			
		H	R1-1	30	30			6.25								1		X										X		
SB	4.160	F	R2-1	24	30		SPEED LIMIT 50						1		X															
SB	3.500	F	VW-001	30	30								1		X															
		F	W16-4	24	18								1																	
		F	VW-001	30	30			6.25								1		X										6	
		F	W16-4	24	18			3.00																				X		
SB	3.269	G	VR-017	24	24								1		X												FINNEGAN RD TH-57			
SIGN SUMMARY SHEET							SHEET TOTALS	42.50	0.00	0	0	0	7	0	0	6		90										
								SF	SF	EA	EA	EA	EA	EA	EA	EA		FT										
VERMONT AGENCY OF TRANSPORTATION							TOWN TOTALS	489.3	0.0	8.0	2.0	2.0	100	0.0	0.0	74		1110.0										

PROJECT NAME: **Moretown-Newport Town VT100**
PROJECT NUMBER: **STPG SIGN(28)**

FILE NAME: **Lowell.xls**
PROJECT MANAGER: **N. Avery**
DESIGNED BY: **D. Crossley**
LOWELL SHEET 13

PLOT DATE: **9/30/2009**
DRAWN BY: **I. Shea**
CHECKED BY: **J. Kelly**

DIRECTION	MILEPOINT	LOCATION CODE (SHEET 2)	SIGN CODE	WIDTH (IN)	HEIGHT (IN)	SHEETING REMARKS	SIGN LEGEND	NEW SIGNS "A"	NEW SIGNS "B"	EXISTING SIGNS RETAIN	EXISTING SIGNS SALVAGE FROM	EXISTING SIGNS SALVAGE TO	EXISTING SIGNS REMOVE	EXIST POST RETAIN	EXIST POST REMOVE	NUMBER OF NEW POSTS	SQUARE STEEL (IN) (LB / FT) 1.75 / 1.88	SQUARE STEEL (IN) (LB / FT) 2.00 / 2.42	SQUARE STEEL (IN) (LB / FT) 2.50 / 3.35	TUBULAR STEEL Ø (IN) FOUNDATION	TUBULAR STEEL Ø (IN) (LB / FT) 3.00 / 7.60	TUBULAR STEEL Ø (IN) (LB / FT) 3.50 / 9.00	TUBULAR STEEL Ø (IN) (LB / FT) 4.00 / 10.80	TUBULAR STEEL Ø (IN) (LB / FT) 5.00 / 14.60	SIGN FRAME REQUIRED	REMARKS	SIGN DETAIL: DETAIL IN SHS	SIGN DETAIL: DETAIL ON SHEET NUMBER	SIGN DETAIL: DETAIL ON STD SHEET NUMBER
LOWELL VT 100							FY-FLUORESCENT YELLOW FYG-FLUORESCENT YELLOW GREEN																			"SHS"-STANDARD HIGHWAY SIGNS			
		G	VR-017	24	30		LEGAL LOAD LIMIT 24,000 POUNDS	5.00								1		X										E-141
SB	3.261	H	R1-1	24	24		STOP						1		X											FINNEGAN RD TH-57		
		H	R1-1	30	30			6.25								1		X									X	
SB	2.905	F	OM-3R	12	36		RIGHT OBJECT MARKER						1		X													
SB	2.895	E	OM-3L	12	36		LEFT OBJECT MARKER						1		X													
SB	2.554	G	VR-017	24	30		LEGAL LOAD LIMIT 16,000 POUNDS	5.00								1		X									RICABY RD TH-21			E-141
SB	2.546	H	R1-1	24	24								1		X											RICABY RD TH-21		
		G	VR-017	24	24		LEGAL LOAD LIMIT 16,000 LBS						1															
		H	R1-1	30	30		STOP LEGAL LOAD LIMIT 24,000 POUNDS	6.25								1		X									X	
SB	2.400	G	VR-017	24	30			5.00								1		X									MINK FARM RD TH-15 (NORTH)			E-136B
SB	2.390	H	R1-1	24	24								1		X											MINK FARM RD TH-15 (NORTH)		
		G	VR-017	24	24		LEGAL LOAD LIMIT 24,000 LBS						1															
		H	R1-1	30	30		STOP LEGAL LOAD LIMIT 24,000 POUNDS	6.25								1		X									X	
SB	1.808	G	VR-017	24	30			5.00								1		X									MINK FARM RD TH-15 (SOUTH)			E-141
SB	1.800	H	R1-1	24	24								1		X											MINK FARM RD TH-15 (SOUTH)		
							SHEET TOTALS	38.75 SF	0.00 SF	0 EA	0 EA	0 EA	8 EA	0 EA	0 EA	7 EA		105 FT										
							TOWN TOTALS	489.3	0.0	8.0	2.0	2.0	100	0.0	0.0	74		1110.0										

SIGN SUMMARY SHEET

VERMONT AGENCY OF TRANSPORTATION

PROJECT NAME: **Moretown-Newport Town VT100**
PROJECT NUMBER: **STPG SIGN(28)**

FILE NAME: **Lowell.xls**
PROJECT MANAGER: **N. Averv**
DESIGNED BY: **D. Crosslev**
LOWELL SHEET 14


PLOT DATE: **9/30/2009**
DRAWN BY: **I. Shea**
CHECKED BY: **J. Kelly**
SHEET **132** OF **166**

DIRECTION	MILEPOINT	LOCATION CODE (SHEET 2)	SIGN CODE	WIDTH (IN)	HEIGHT (IN)	SHEETING REMARKS	SIGN LEGEND	NEW SIGNS "A"	NEW SIGNS "B"	EXISTING SIGNS RETAIN	EXISTING SIGNS SALVAGE FROM	EXISTING SIGNS SALVAGE TO	EXISTING SIGNS REMOVE	EXIST POST RETAIN	EXIST POST REMOVE	NUMBER OF NEW POSTS	SQUARE STEEL (IN) 1.75 (LB / FT) 1.88	SQUARE STEEL (IN) 2.00 (LB / FT) 2.42	SQUARE STEEL (IN) 2.50 (LB / FT) 3.35	TUBULAR STEEL Ø (IN) FOUNDATION	TUBULAR STEEL Ø (IN) 3.00 (LB / FT) 7.60	TUBULAR STEEL Ø (IN) 3.50 (LB / FT) 9.00	TUBULAR STEEL Ø (IN) 4.00 (LB / FT) 10.80	TUBULAR STEEL Ø (IN) 5.00 (LB / FT) 14.60	SIGN FRAME REQUIRED	REMARKS	SIGN DETAIL: DETAIL IN SHS	SIGN DETAIL: DETAIL ON SHEET NUMBER	SIGN DETAIL: DETAIL ON STD SHEET NUMBER
LOWELL VT 100							FY-FLUORESCENT YELLOW FYG-FLUORESCENT YELLOW GREEN																			"SHS"-STANDARD HIGHWAY SIGNS			
		G	VR-017	24	24								1																
		H	R1-1	30	30			6.25								1		X									X	
SB	1.430	F	W11-4	30	30		CATTLE						1		X													
SB	1.240	F	W1-2 R	30	30			6.25								1		X									X	
SB	1.070	F	W1-2 L	30	30			6.25								1		X									X	
SB	0.001	F	M3-3S	24	12		SOUTH			1				X														
		F	M1-5	30	24		VERMONT 100			1																		
SIGN SUMMARY SHEET							SHEET TOTALS	18.75	0.00	2	0	0	2	0	0	3		45										
								SF	SF	EA	EA	EA	EA	EA	EA	EA		FT										
VERMONT AGENCY OF TRANSPORTATION							TOWN TOTALS	489.3	0.0	8.0	2.0	2.0	100	0.0	0.0	74		1110.0										


PROJECT NAME: **Moretown-Newport Town VT100**
PROJECT NUMBER: **STPG SIGN(28)**

FILE NAME: **Lowell.xls**
PROJECT MANAGER: **N. Avery**
DESIGNED BY: **D. Crossley**
LOWELL SHEET 15

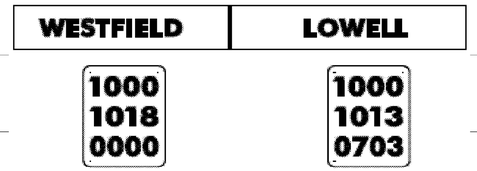
PLOT DATE: **9/30/2009**
DRAWN BY: **I. Shea**
CHECKED BY: **J. Kelly**
SHEET **133** OF **166**

DIRECTION	MILEPOINT	LOCATION CODE (SHEET 2)	SIGN CODE	WIDTH (IN)	HEIGHT (IN)	SHEETING REMARKS	SIGN LEGEND	NEW SIGNS "A"	NEW SIGNS "B"	EXISTING SIGNS RETAIN	EXISTING SIGNS SALVAGE FROM	EXISTING SIGNS SALVAGE TO	EXISTING SIGNS REMOVE	EXIST POST RETAIN	EXIST POST REMOVE	NUMBER OF NEW POSTS	SQUARE STEEL (IN) 1.75 (LB / FT) 1.88	SQUARE STEEL (IN) 2.00 (LB / FT) 2.42	SQUARE STEEL (IN) 2.50 (LB / FT) 3.35	TUBULAR STEEL Ø (IN) FOUNDATION	TUBULAR STEEL Ø (IN) 3.00 (LB / FT) 7.60	TUBULAR STEEL Ø (IN) 3.50 (LB / FT) 9.00	TUBULAR STEEL Ø (IN) 4.00 (LB / FT) 10.80	TUBULAR STEEL Ø (IN) 5.00 (LB / FT) 14.60	SIGN FRAME REQUIRED	REMARKS	SIGN DETAIL: DETAIL IN SHS	SIGN DETAIL: DETAIL ON SHEET NUMBER	SIGN DETAIL: DETAIL ON STD SHEET NUMBER
WESTFIELD VT 100							FY-FLUORESCENT YELLOW FYG-FLUORESCENT YELLOW GREEN																			"SHS"-STANDARD HIGHWAY SIGNS			
NB	0.000	C	VD-024	72	10			5.00								2		X							INSTALL OPPOSITE EXISTING SB TOWNLINE SIGN		4	
		C	VD-700	6	10			0.42																				
		C	VD-700	6	10			0.42																				
NB	0.120	A	OM-3R	12	36		RIGHT OBJECT MARKER						1		X													
																											X	
NB	0.142	B	OM-3L	12	36		LEFT OBJECT MARKER						1		X													
NB	0.570	A	W11-6	30	30		 MISSING						~~1~~		~~X~~													
		A	W11-6H	30	30			6.25								1		X								INSTALL IN CLOSED POSITION			E-152
NB	1.130	A	W11-6	30	30		SNOWMOBILE - HINGED						1		X													
NB	1.153	D	R1-1	24	24		STOP						1		X											TH-23 CLASS 4			
NB	1.917	A	W1-2L	30	30		LEFT CURVE 						1		X													
NB	1.974	A	W1-2L	30	30			6.25								1		X								INSTALL 300'+/- NORTH OF ORIGINAL SIGN LOCATION	X		
NB	3.135	C	VR-017	24	30								1		X												CEMETERY RD TH- 15			
		C	VR-017	24	30			5.00								1		X											E-141
SIGN SUMMARY SHEET							SHEET TOTALS	23.34 SF	0.00 SF	0 EA	0 EA	0 EA	7 EA	0 EA	0 EA	5 EA		75 FT										
VERMONT AGENCY OF TRANSPORTATION							TOWN TOTALS	149.5	0.0	15.0	0.0	0.0	28	0.0	0.0	26		390.0										

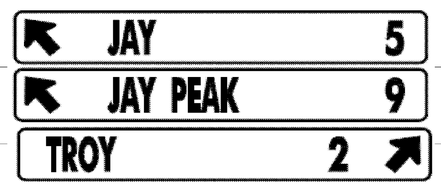PROJECT NAME: **Moretown-Newport Town VT100**
PROJECT NUMBER: **STPG SIGN(28)**
FILE NAME: **Westfield.xls**
PROJECT MANAGER: **N. Avery**
DESIGNED BY: **D. Crossley**
WESTFIELD SHEET 1
PLOT DATE: **9/30/2009**
DRAWN BY: **I. Shea**
CHECKED BY: **J. Kelly**
SHEET **134** OF **166**

DIRECTION	MILEPOINT	LOCATION CODE (SHEET 2)	SIGN CODE	WIDTH (IN)	HEIGHT (IN)	SHEETING REMARKS	SIGN LEGEND	NEW SIGNS "A"	NEW SIGNS "B"	EXISTING SIGNS RETAIN	EXISTING SIGNS SALVAGE FROM	EXISTING SIGNS SALVAGE TO	EXISTING SIGNS REMOVE	EXIST POST RETAIN	EXIST POST REMOVE	NUMBER OF NEW POSTS	SQUARE STEEL (IN) (LB / FT) 1.75 / 1.88	SQUARE STEEL (IN) (LB / FT) 2.00 / 2.42	SQUARE STEEL (IN) (LB / FT) 2.50 / 3.35	TUBULAR STEEL Ø (IN) FOUNDATION	TUBULAR STEEL Ø (IN) (LB / FT) 3.00 / 7.60	TUBULAR STEEL Ø (IN) (LB / FT) 3.50 / 9.00	TUBULAR STEEL Ø (IN) (LB / FT) 4.00 / 10.80	TUBULAR STEEL Ø (IN) (LB / FT) 5.00 / 14.60	SIGN FRAME REQUIRED	REMARKS	SIGN DETAIL: DETAIL IN SHS	SIGN DETAIL: DETAIL ON SHEET NUMBER	SIGN DETAIL: DETAIL ON STD SHEET NUMBER
WESTFIELD VT 100							FY-FLUORESCENT YELLOW FYG-FLUORESCENT YELLOW GREEN																			"SHS"-STANDARD HIGHWAY SIGNS			
NB	3.145	D	R1-1	24	24								1		X											CEMETERY RD TH- 15			
		D	R1-1	30	30			6.25								1		X									X		
NB	3.360	A	R2-5A	24	30		REDUCED SPEED AHEAD 						1		X															
		A	W3-5	36	36			9.00								2		X									X		
NB	3.430	A	VD-018	30	18		WESTFIELD TROY 2			1				X															
NB	3.500	A	R2-1	24	30								1		X															
		A	R2-1	30	36			7.50								1		X									6		
NB	3.700	A	W1-2R	30	30		RIGHT CURVE						1		X															
NB	3.740	A	D1-1A	72	10		<--- (45 DEG) JAY 5						1		X															
		A	D1-1GA	72	10		<--- (45 DEG) JAY PEAK 9						1																	
		A	D1-1A	72	12			6.00								2		X								5		
		A	D1-1A	72	12			6.00																				5		
		A	D1-1A	72	12			6.00																				5		
NB	3.770	A	W1-2MgR	30	30			6.25								1		X								INSTALL 150'+/- NORTH OF JAY DESTINATION SIGNS		7	
		A	W16-8	30	8			1.67																				8		
SIGN SUMMARY SHEET							SHEET TOTALS	48.67	0.00	1	0	0	6	0	0	7		105										
								SF	SF	EA	EA	EA	EA	EA	EA	EA		FT										
VERMONT AGENCY OF TRANSPORTATION							TOWN TOTALS	149.5	0.0	15.0	0.0	0.0	28	0.0	0.0	26		390.0										

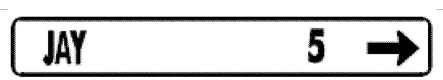PROJECT NAME: **Moretown-Newport Town VT100**
PROJECT NUMBER: **STPG SIGN(28)**
FILE NAME: **Westfield.xls**
PROJECT MANAGER: **N. Avery**
DESIGNED BY: **D. Crossley**
WESTFIELD SHEET 2
PLOT DATE: **9/30/2009**
DRAWN BY: **I. Shea**
CHECKED BY: **J. Kelly**
SHEET **135** OF **166**

DIRECTION	MILEPOINT	LOCATION CODE (SHEET 2)	SIGN CODE	WIDTH (IN)	HEIGHT (IN)	SHEETING REMARKS	SIGN LEGEND	NEW SIGNS "A"	NEW SIGNS "B"	EXISTING SIGNS RETAIN	EXISTING SIGNS SALVAGE FROM	EXISTING SIGNS SALVAGE TO	EXISTING SIGNS REMOVE	EXIST POST RETAIN	EXIST POST REMOVE	NUMBER OF NEW POSTS	SQUARE STEEL (IN) 1.75 (LB / FT) 1.88	SQUARE STEEL (IN) 2.00 (LB / FT) 2.42	SQUARE STEEL (IN) 2.50 (LB / FT) 3.35	TUBULAR STEEL Ø (IN) FOUNDATION	TUBULAR STEEL Ø (IN) 3.00 (LB / FT) 7.60	TUBULAR STEEL Ø (IN) 3.50 (LB / FT) 9.00	TUBULAR STEEL Ø (IN) 4.00 (LB / FT) 10.80	TUBULAR STEEL Ø (IN) 5.00 (LB / FT) 14.60	SIGN FRAME REQUIRED	REMARKS	SIGN DETAIL DETAIL IN SHS	SIGN DETAIL DETAIL ON SHEET NUMBER	SIGN DETAIL DETAIL ON STD SHEET NUMBER
WESTFIELD VT 100							FY-FLUORESCENT YELLOW FYG-FLUORESCENT YELLOW GREEN																			"SHS"-STANDARD HIGHWAY SIGNS			
NB	3.870	A	R2-1	24	30			5.00								I		X								INSTALL 20' SOUTH OF UTILITY POLE 42/A	X		
NB	4.220	A	R2-1	24	30		SPEED LIMIT 50			1				~~X~~														
NB	4.402	C	VR-017	24	24								1		X											LOOP RD TH-4			
		C	VR-017	24	30			5.00								1		X										E-1471
NB	4.410	D	R1-1	24	24								1		X											LOOP RD TH-4			
		D	R1-1	30	30			6.25								1		X									X		
SB	4.340	F	R2-5A	24	30		REDUCED SPEED AHEAD 						1		X														
		F	W3-5	36	36			9.00								2		X									X		
SB	4.300	F	VD-018	30	18		WESTFIELD LOWELL 7			1				X														
SB	4.260	F	VW-060	30	30		HIDDEN DRIVES			1				X														
SB	4.220	F	R2-1	24	30								1		X														
		F	R2-1	30	36			7.50								1		X										6	
SB	4.005	F	R2-1	24	30			5.00								1		X								INSTALL SOUTH OF DRIVE TO CAR DEALER AND 10' NORTH OF POLE.	X		
SB	3.930	F	W1-2L	30	30		LEFT CURVE						1		X														
		F	D1-1A	72	12			6.00								2		X									5	
SIGN SUMMARY SHEET							SHEET TOTALS	43.75 SF	0.00 SF	3 EA	0 EA	0 EA	5 EA	0 EA	0 EA	8 EA		120 FT									
VERMONT AGENCY OF TRANSPORTATION							TOWN TOTALS	149.5	0.0	15.0	0.0	0.0	28	0.0	0.0	26		390.0									

PROJECT NAME: **Moretown-Newport Town VT100**
PROJECT NUMBER: **STPG SIGN(28)**

FILE NAME: **Westfield.xls** PLOT DATE: **9/30/2009**
PROJECT MANAGER: **N. Averv** DRAWN BY: **I. Shea**
DESIGNED BY: **D. Crossley** CHECKED BY: **J. Kelly**
WESTFIELD SHEET 3 SHEET **136** OF **166**

DIRECTION	MILEPOINT	LOCATION CODE (SHEET 2)	SIGN CODE	WIDTH (IN)	HEIGHT (IN)	SHEETING REMARKS	SIGN LEGEND	NEW SIGNS "A"	NEW SIGNS "B"	EXISTING SIGNS RETAIN	EXISTING SIGNS SALVAGE FROM	EXISTING SIGNS SALVAGE TO	EXISTING SIGNS REMOVE	EXIST POST RETAIN	EXIST POST REMOVE	NUMBER OF NEW POSTS	SQUARE STEEL (IN) 1.75 (LB / FT) 1.88	SQUARE STEEL (IN) 2.00 (LB / FT) 2.42	SQUARE STEEL (IN) 2.50 (LB / FT) 3.35	TUBULAR STEEL Ø (IN) FOUNDATION	TUBULAR STEEL Ø (IN) 3.00 (LB / FT) 7.60	TUBULAR STEEL Ø (IN) 3.50 (LB / FT) 9.00	TUBULAR STEEL Ø (IN) 4.00 (LB / FT) 10.80	TUBULAR STEEL Ø (IN) 5.00 (LB / FT) 14.60	SIGN FRAME REQUIRED	REMARKS	SIGN DETAIL: DETAIL IN SHS	SIGN DETAIL: DETAIL ON SHEET NUMBER	SIGN DETAIL: DETAIL ON STD SHEET NUMBER
WESTFIELD VT 100							FY-FLUORESCENT YELLOW FYG-FLUORESCENT YELLOW GREEN																			"SHS"-STANDARD HIGHWAY SIGNS			
SB	3.890	F	D1-1A	72	10		JAY 5 ---> 						1		X														
		F	W1-10L	30	30			6.25								1		X									X		
SB	3.849	G	VR-017	24	24								1		X											TH-31			
		G	VR-017	24	30			5.00								1		X											E-141
SB	3.840	H	R1-1	30	30		STOP			1				X													TH-31		
SB	3.840	F	M3-3S	24	12		SOUTH			1				X															
		F	M1-5	30	24		VERMONT 100			1																			
		F	M6-2S	21	15		<--- LEFT (45 DEG)			1																			
SB	3.810	H	R1-1	30	30		STOP			1				X													NORTH HILL RD TH-1	X	
SB	3.801	G	VR-017	24	24								1		X											NORTH HILL RD TH-1			
		G	VR-017	24	30			5.00								1		X											E-141
SB	3.800	E	M3-1S	24	12		NORTH			1				X															
		E	M1-5	30	24		VERMONT 100			1																			
		E	M6-2S	21	15		RIGHT ---> (45 DEG)			1																			
SB	3.740	F	M3-3S	24	12		SOUTH			1				X															
							SHEET TOTALS	16.25 SF	0.00 SF	9 EA	0 EA	0 EA	3 EA	0 EA	0 EA	3 EA	45 FT												
							TOWN TOTALS	149.5	0.0	15.0	0.0	0.0	28	0.0	0.0	26	390.0												

SIGN SUMMARY SHEET

VERMONT AGENCY OF TRANSPORTATION

PROJECT NAME: **Moretown-Newport Town VT100**
PROJECT NUMBER: **STPG SIGN(28)**


FILE NAME: **Westfield.xls**
PROJECT MANAGER: **N. Avery**
DESIGNED BY: **D. Crossley**
WESTFIELD SHEET 4

PLOT DATE: **9/30/2009**
DRAWN BY: **I. Shea**
CHECKED BY: **J. Kelly**
SHEET **137** OF **166**

DIRECTION	MILEPOINT	LOCATION CODE (SHEET 2)	SIGN CODE	WIDTH (IN)	HEIGHT (IN)	SHEETING REMARKS	SIGN LEGEND	NEW SIGNS "A"	NEW SIGNS "B"	EXISTING SIGNS RETAIN	EXISTING SIGNS SALVAGE FROM	EXISTING SIGNS SALVAGE TO	EXISTING SIGNS REMOVE	EXIST POST RETAIN	EXIST POST REMOVE	NUMBER OF NEW POSTS	SQUARE STEEL (IN) 1.75 (LB / FT) 1.88	SQUARE STEEL (IN) 2.00 (LB / FT) 2.42	SQUARE STEEL (IN) 2.50 (LB / FT) 3.35	TUBULAR STEEL Ø (IN) FOUNDATION	TUBULAR STEEL Ø (IN) 3.00 (LB / FT) 7.60	TUBULAR STEEL Ø (IN) 3.50 (LB / FT) 9.00	TUBULAR STEEL Ø (IN) 4.00 (LB / FT) 10.80	TUBULAR STEEL Ø (IN) 5.00 (LB / FT) 14.60	SIGN FRAME REQUIRED	REMARKS	SIGN DETAIL: DETAIL IN SHS	SIGN DETAIL: DETAIL ON SHEET NUMBER	SIGN DETAIL: DETAIL ON STD SHEET NUMBER
WESTFIELD VT 100							FY-FLUORESCENT YELLOW FYG-FLUORESCENT YELLOW GREEN																			"SHS"-STANDARD HIGHWAY SIGNS			
		F	M1-5	30	24		VERMONT 100			1																		
SB	3.500	F	R2-1	24	30		SPEED LIMIT 50			1				X														
SB	2.631	G	VR-017	24	24								1		X											BUCK HILL RD TH -19			
		G	VR-017	24	30			5.00								1		X										E-141
SB	2.624	H	R1-1	24	24								1		X											BUCK HILL RD TH -19			
		H	R1-1	30	30			6.25								1		X									X	
SB	1.370	F	W11-6	30	30		SNOWMOBILE						1		X													
SB	0.810	F	W11-6	30	30								1		X													
		F	W11-6H	30	30			6.25								1		X								INSTALL IN CLOSED POSITION			E-152
SB	0.142	F	OM-3R	12	36								1		X													
SB	0.120	E	OM-3L	12	36								1		X													
SB	0.000	G	VD-024	60	7.5		LOWELL/WESTFIELD						1		X													
SIGN SUMMARY SHEET							SHEET TOTALS	17.50 SF	0.00 SF	2 EA	0 EA	0 EA	7 EA	0 EA	0 EA	3 EA	45 FT										
VERMONT AGENCY OF TRANSPORTATION							TOWN TOTALS	149.5	0.0	15.0	0.0	0.0	28	0.0	0.0	26	390.0										

PROJECT NAME: **Moretown-Newport Town VT100**
PROJECT NUMBER: **STPG SIGN(28)**

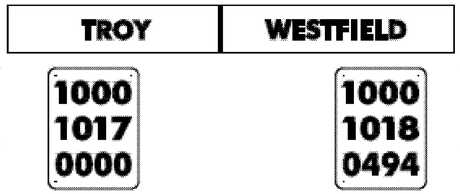
FILE NAME: **Westfield.xls** PLOT DATE: **9/30/2009**
PROJECT MANAGER: **N. Avery** DRAWN BY: **I. Shea**
DESIGNED BY: **D. Crossley** CHECKED BY: **J. Kelly**
WESTFIELD SHEET 5 SHEET **138** OF **166**

DIRECTION	MILEPOINT	LOCATION CODE (SHEET 2)	SIGN CODE	WIDTH (IN)	HEIGHT (IN)	SHEETING REMARKS	SIGN LEGEND	NEW SIGNS "A"	NEW SIGNS "B"	EXISTING SIGNS RETAIN	EXISTING SIGNS SALVAGE FROM	EXISTING SIGNS SALVAGE TO	EXISTING SIGNS REMOVE	EXIST POST RETAIN	EXIST POST REMOVE	NUMBER OF NEW POSTS	SQUARE STEEL (IN) 1.75 (LB / FT) 1.88	SQUARE STEEL (IN) 2.00 (LB / FT) 2.42	SQUARE STEEL (IN) 2.50 (LB / FT) 3.35	TUBULAR STEEL Ø (IN) FOUNDATION	TUBULAR STEEL Ø (IN) 3.00 (LB / FT) 7.60	TUBULAR STEEL Ø (IN) 3.50 (LB / FT) 9.00	TUBULAR STEEL Ø (IN) 4.00 (LB / FT) 10.80	TUBULAR STEEL Ø (IN) 5.00 (LB / FT) 14.60	SIGN FRAME REQUIRED	REMARKS	SIGN DETAIL: DETAIL IN SHS	SIGN DETAIL: DETAIL ON SHEET NUMBER	SIGN DETAIL: DETAIL ON STD SHEET NUMBER
TROY VT 100							FY-FLUORESCENT YELLOW FYG-FLUORESCENT YELLOW GREEN																			"SHS"-STANDARD HIGHWAY SIGNS			
NB	0.000	C	VD-024	60	7.5								1		X													
		C	VD-024	72	10			5.00								2 ~~1~~		X								4	
		C	VD-700	6	10			0.42																				E-138
		C	VD-700	6	10			0.42																				E-138
NB	0.004	A	VD-062AL	72	16		BUSINESS SIGN			1				X														
		A	VD-062AS	72	16		BUSINESS SIGN			1																		
		A	VD-062AL	72	16		BUSINESS SIGN			1																		
NB	0.110	A	R2-5A	24	30		REDUCED SPEED AHEAD 						1		X														
		A	W3-5	36	36			9.00								2		X									X	
NB	0.150	A	VD-018	30	18								1		X													
		A	VD-018	30	18			3.75								1		X										E-128B
NB	0.190	A	M2-1	21	15		MISSING						~~1~~		~~X~~													
		A	M1-5	30	24								1															
		A	M2-1	21	15			2.19								1		X								GREEN ON WHITE SHEETING	X	
		A	M1-5	30	24			5.00																				E-136B
SIGN SUMMARY SHEET							SHEET TOTALS	25.78	0.00	3	0	0	5	0	0	5		75										
								SF	SF	EA	EA	EA	EA	EA	EA	EA		FT										
VERMONT AGENCY OF TRANSPORTATION							TOWN TOTALS	334.5	0.0	7.0	2.0	2.0	60	0.0	0.0	55		825.0										

PROJECT NAME: **Moretown-Newport Town VT100**
PROJECT NUMBER: **STPG SIGN(28)**

FILE NAME: **Trov.xls**
PROJECT MANAGER: **N. Averv**
DESIGNED BY: **D. Crossley**
TROY SHEET 1

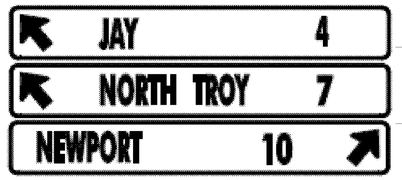PLOT DATE: **9/30/2009**
DRAWN BY: **I. Shea**
CHECKED BY: **J. Kelly**
SHEET **139** OF **166**

DIRECTION	MILEPOINT	LOCATION CODE (SHEET 2)	SIGN CODE	WIDTH (IN)	HEIGHT (IN)	SHEETING REMARKS	SIGN LEGEND	NEW SIGNS "A"	NEW SIGNS "B"	EXISTING SIGNS RETAIN	EXISTING SIGNS SALVAGE FROM	EXISTING SIGNS SALVAGE TO	EXISTING SIGNS REMOVE	EXIST POST RETAIN	EXIST POST REMOVE	NUMBER OF NEW POSTS	SQUARE STEEL (IN) 1.75 (LB / FT) 1.88	SQUARE STEEL (IN) 2.00 (LB / FT) 2.42	SQUARE STEEL (IN) 2.50 (LB / FT) 3.35	TUBULAR STEEL Ø (IN) FOUNDATION	TUBULAR STEEL Ø (IN) 3.00 (LB / FT) 7.60	TUBULAR STEEL Ø (IN) 3.50 (LB / FT) 9.00	TUBULAR STEEL Ø (IN) 4.00 (LB / FT) 10.80	TUBULAR STEEL Ø (IN) 5.00 (LB / FT) 14.60	SIGN FRAME REQUIRED	REMARKS	SIGN DETAIL: DETAIL IN SHS	SIGN DETAIL: DETAIL ON SHEET NUMBER	SIGN DETAIL: DETAIL ON STD SHEET NUMBER
TROY VT 100							FY-FLUORESCENT YELLOW FYG-FLUORESCENT YELLOW GREEN																			"SHS"-STANDARD HIGHWAY SIGNS			
NB	0.230	A	W11-8	30	30								1		X														
		A	W11-8	30	30			6.25								1		X									X		
NB	0.270	A	D1-1	72	12			6.00								2		X										5	
			D1-1	72	12			6.00																				5	
			D1-1	72	12			6.00																				5	
NB	0.310	A	R2-1	24	30								1		X														
		A	R2-1	30	36			7.50								1		X										6	
NB	0.440	A	R2-1	24	30								1		X														
		A	R2-1	24	30			5.00								1		X									X		
NB	0.495	A	S1-1	36	36		SCHOOL 						1		X														
		A	W11-2	30	30	FYG		6.25								1		X									X		
NB	0.560	A	M3-1S	24	12								1		X														
		A	M1-5	30	24								1																
		A	M3-1	24	12			2.00								1		X								GREEN ON WHITE SHEETING	X		
		A	M1-5	30	24			5.00																					E-136B
SIGN SUMMARY SHEET							SHEET TOTALS	50.00 SF	0.00 SF	0 EA	0 EA	0 EA	6 EA	0 EA	0 EA	7 EA		105 FT										
VERMONT AGENCY OF TRANSPORTATION							TOWN TOTALS	334.5	0.0	7.0	2.0	2.0	60	0.0	0.0	55		825.0										

PROJECT NAME: **Moretown-Newport Town VT100**
PROJECT NUMBER: **STPG SIGN(28)**

FILE NAME: **Trov.xls**
PROJECT MANAGER: **N. Averv**
DESIGNED BY: **D. Crossley**
TROY SHEET 2

PLOT DATE: **9/30/2009**
DRAWN BY: **I. Shea**
CHECKED BY: **J. Kelly**
SHEET **140** OF **166**

DIRECTION	MILEPOINT	LOCATION CODE (SHEET 2)	SIGN CODE	WIDTH (IN)	HEIGHT (IN)	SHEETING REMARKS	SIGN LEGEND	NEW SIGNS "A"	NEW SIGNS "B"	EXISTING SIGNS RETAIN	EXISTING SIGNS SALVAGE FROM	EXISTING SIGNS SALVAGE TO	EXISTING SIGNS REMOVE	EXIST POST RETAIN	EXIST POST REMOVE	NUMBER OF NEW POSTS	SQUARE STEEL (IN) 1.75 (LB / FT) 1.88	SQUARE STEEL (IN) 2.00 (LB / FT) 2.42	SQUARE STEEL (IN) 2.50 (LB / FT) 3.35	TUBULAR STEEL Ø (IN) FOUNDATION	TUBULAR STEEL Ø (IN) 3.00 (LB / FT) 7.60	TUBULAR STEEL Ø (IN) 3.50 (LB / FT) 9.00	TUBULAR STEEL Ø (IN) 4.00 (LB / FT) 10.80	TUBULAR STEEL Ø (IN) 5.00 (LB / FT) 14.60	SIGN FRAME REQUIRED	REMARKS	SIGN DETAIL: DETAIL IN SHS	SIGN DETAIL: DETAIL ON SHEET NUMBER	SIGN DETAIL: DETAIL ON STD SHEET NUMBER
TROY VT 100							FY-FLUORESCENT YELLOW FYG-FLUORESCENT YELLOW GREEN																			"SHS"-STANDARD HIGHWAY SIGNS			
NB	0.640	A	R2-1	24	30								1		X													
		A	R2-1	24	30			5.00								1		X									X	
NB	0.810	A	R2-1	24	30								1		X													
		A	R2-1	24	30			5.00								1		X									X	
NB	0.820	A	OM-3R	12	36		RIGHT OBJECT MARKER						1		X													
NB	0.850	B	OM-3L	12	36		LEFT OBJECT MARKER 						1		X													
NB	0.922	C	VR-017	24	30			5.00								1		X									LOOP RD TH-28			E-141
NB	0.930	D	R1-1	30	30								1		X												LOOP RD TH-28			
		D	R1-1	30	30			6.25								1		X									X	
NB	1.050	A	W1-4L	30	30		LEFT REVERSE CURVE 						1		X													
NB	1.145	A	W1-4L	30	30			6.25								1		X									INSTALL 500' +/- NORTH OF ORIGINAL LOCATION	X		
NB	1.182	A	W1-6	48	24			8.00								2		X									INSTALL 200'+/- NORTH OF LEFT REVERSE CURVE SIGN	X		
NB	1.183	B	W1-6	48	24			8.00								2		X										X		
NB	1.410	A	W1-2R	30	30		RIGHT CURVE				1				X													
		A	VW-054L	30	30		HIDDEN DRIVE LEFT				1																	
							SHEET TOTALS	43.50 SF	0.00 SF	0 EA	2 EA	0 EA	6 EA	0 EA	0 EA	9 EA	135 FT											
							TOWN TOTALS	334.5	0.0	7.0	2.0	2.0	60	0.0	0.0	55	825.0											

SIGN SUMMARY SHEET

VERMONT AGENCY OF TRANSPORTATION

PROJECT NAME: **Moretown-Newport Town VT100**
PROJECT NUMBER: **STPG SIGN(28)**

FILE NAME: **Trov.xls**
PROJECT MANAGER: **N. Avery**
DESIGNED BY: **D. Crosslev**
TROY SHEET 3

PLOT DATE: **9/30/2009**
DRAWN BY: **I. Shea**
CHECKED BY: **J. Kelly**

DIRECTION	MILEPOINT	LOCATION CODE (SHEET 2)	SIGN CODE	WIDTH (IN)	HEIGHT (IN)	SHEETING REMARKS	SIGN LEGEND	NEW SIGNS "A"	NEW SIGNS "B"	EXISTING SIGNS RETAIN	EXISTING SIGNS SALVAGE FROM	EXISTING SIGNS SALVAGE TO	EXISTING SIGNS REMOVE	EXIST POST RETAIN	EXIST POST REMOVE	NUMBER OF NEW POSTS	SQUARE STEEL (IN) (LB / FT) 1.75 — 1.88	SQUARE STEEL (IN) (LB / FT) 2.00 — 2.42	SQUARE STEEL (IN) (LB / FT) 2.50 — 3.35	TUBULAR STEEL Ø (IN) FOUNDATION	TUBULAR STEEL Ø (IN) (LB / FT) 3.00 — 7.60	TUBULAR STEEL Ø (IN) (LB / FT) 3.50 — 9.00	TUBULAR STEEL Ø (IN) (LB / FT) 4.00 — 10.80	TUBULAR STEEL Ø (IN) (LB / FT) 5.00 — 14.60	SIGN FRAME REQUIRED	REMARKS	SIGN DETAIL: DETAIL IN SHS	SIGN DETAIL: DETAIL ON SHEET NUMBER	SIGN DETAIL: DETAIL ON STD SHEET NUMBER
TROY VT 100							FY-FLUORESCENT YELLOW FYG-FLUORESCENT YELLOW GREEN																			"SHS"-STANDARD HIGHWAY SIGNS			
NB	1.430	A	W1-2R	30	30		RIGHT CURVE					1				2		X								INSTALL 100'+/- NORTH OF ORIGINAL LOCATION	X		
		A	VW-054L	30	30		HIDDEN DRIVE LEFT					1																	E-154
NB	1.450	A	W11-6H	30	30		HINGED SNOWMOBILE						1		X														
NB	1.550	A	W11-5	30	30		FARM MACHINERY			1				X															
NB	1.980	A	W11-4	30	30		CATTLE						1		X														
NB	2.199	C	VR-017	24	30								1		X												BONNEAU RD TH-27			
		C	VR-017	24	30			5.00								1		X											E-141
NB	2.040	D	R1-1	30	30								1		X												BONNEAU RD TH-27			
		D	R1-1	30	30			6.25								1		X									X		
NB	2.700	A	W1-2L	30	30		LEFT CURVE 						1		X														
NB	2.757	A	W1-2L	30	30			6.25								1		X								INSTALL 300' NORTH OF ORIGINAL SIGN LOCATION	X		
NB	2.830	A	W11-6H	30	30		HINGED SNOWMOBILE						1		X														
SB	2.963	G	VR-017	24	30								1		X												ROUTHIER RD TH-44			
		G	VR-017	24	30			5.00								1		X											E-141
SB	2.958	H	R1-1	30	30								1		X											ROUTHIER RD TH-44			
							SHEET TOTALS	22.50 SF	0.00 SF	1 EA	0 EA	2 EA	8 EA	0 EA	0 EA	6 EA		90 FT									
							TOWN TOTALS	334.5	0.0	7.0	2.0	2.0	60	0.0	0.0	55		825.0									

SIGN SUMMARY SHEET

VERMONT AGENCY OF TRANSPORTATION

PROJECT NAME: **Moretown-Newport Town VT100**
PROJECT NUMBER: **STPG SIGN(28)**

FILE NAME: **Trov.xls**
PROJECT MANAGER: **N. Averv**
DESIGNED BY: **D. Crossley**
TROY SHEET 4

PLOT DATE: **9/30/2009**
DRAWN BY: **I. Shea**
CHECKED BY: **J. Kelly**


DIRECTION	MILEPOINT	LOCATION CODE (SHEET 2)	SIGN CODE	WIDTH (IN)	HEIGHT (IN)	SHEETING REMARKS	SIGN LEGEND	NEW SIGNS "A"	NEW SIGNS "B"	EXISTING SIGNS RETAIN	EXISTING SIGNS SALVAGE FROM	EXISTING SIGNS SALVAGE TO	EXISTING SIGNS REMOVE	EXIST POST RETAIN	EXIST POST REMOVE	NUMBER OF NEW POSTS	SQUARE STEEL (IN) (LB / FT) 1.75 / 1.88	SQUARE STEEL (IN) (LB / FT) 2.00 / 2.42	SQUARE STEEL (IN) (LB / FT) 2.50 / 3.35	TUBULAR STEEL Ø (IN) FOUNDATION	TUBULAR STEEL Ø (IN) (LB / FT) 3.00 / 7.60	TUBULAR STEEL Ø (IN) (LB / FT) 3.50 / 9.00	TUBULAR STEEL Ø (IN) (LB / FT) 4.00 / 10.80	TUBULAR STEEL Ø (IN) (LB / FT) 5.00 / 14.60	SIGN FRAME REQUIRED	REMARKS	SIGN DETAIL: DETAIL IN SHS	SIGN DETAIL: DETAIL ON SHEET NUMBER	SIGN DETAIL: DETAIL ON STD SHEET NUMBER
TROY VT 100							FY-FLUORESCENT YELLOW FYG-FLUORESCENT YELLOW GREEN																			"SHS"-STANDARD HIGHWAY SIGNS			
		H	R1-1	30	30			6.25								1		X									X		
SB	2.870	F	W1-2R	30	30		RIGHT CURVE 						1		X											INSTALL 150' +/- SOUTH OF ORIGINAL SIGN LOCATION			
SB	2.840	F	W1-2R	30	30	FY		~~6.25~~								~~1~~		~~X~~									X		
SB	2.112	G	VR-017	24	30			5.00								1		X									EAST HILL RD TH-2			E-141
SB	2.105	H	R1-1	30	30								1		X												EAST HILL RD TH-2			
		H	R1-1	30	30			6.25								1		X									X		
SB	1.880	F	W11-5	30	30		FARM MACHINERY			1				X															
SB	1.570	F	VW-133	30	30		HIDDEN DRIVE LEFT						1		X															
SB	1.530	F	S3-1	30	30		SCHOOL BUS STOP AHEAD 						1		X															
SB	1.510	F	S3-1	30	30			6.25								2		X								INSTALL 100'+/- SOUTH OF ORIGINAL SCHOOL BUS STOP AHEAD SIGN LOCATION	X		
		F	VW-054L	30	30			6.25																					E-154
SB	1.391	F	W1-4L	30	30		LEFT REVERSE CURVE						1		X															
SB	1.360	F	VW-054	30	30		HIDDEN DRIVE RIGHT 						1		X															
SB	1.340	F	W1-4L	30	30			6.25								2		X								INSTALL 100' +/- SOUTH OF ORIGINAL HIDDEN DRIVE RIGHT SIGN LOCATION	X		
		F	VW-054R	30	30			6.25																					E-154
							SHEET TOTALS	48.75 SF	0.00 SF	1 EA	0 EA	0 EA	6 EA	0 EA	0 EA	8 EA	120 FT											
							TOWN TOTALS	334.5	0.0	7.0	2.0	2.0	60	0.0	0.0	55	825.0											

SIGN SUMMARY SHEET

VERMONT AGENCY OF TRANSPORTATION


PROJECT NAME: **Moretown-Newport Town VT100**
PROJECT NUMBER: **STPG SIGN(28)**

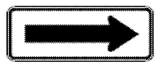FILE NAME: **Trov.xls** PLOT DATE: **9/30/2009**
PROJECT MANAGER: **N. Avery** DRAWN BY: **I. Shea**
DESIGNED BY: **D. Crossley** CHECKED BY: **J. Kelly**
TROY SHEET 5 SHEET **143** OF **166**

DIRECTION	MILEPOINT	LOCATION CODE (SHEET 2)	SIGN CODE	WIDTH (IN)	HEIGHT (IN)	SHEETING REMARKS	SIGN LEGEND	NEW SIGNS "A"	NEW SIGNS "B"	EXISTING SIGNS RETAIN	EXISTING SIGNS SALVAGE FROM	EXISTING SIGNS SALVAGE TO	EXISTING SIGNS REMOVE	EXIST POST RETAIN	EXIST POST REMOVE	NUMBER OF NEW POSTS	SQUARE STEEL (IN) 1.75 (LB / FT) 1.88	SQUARE STEEL (IN) 2.00 (LB / FT) 2.42	SQUARE STEEL (IN) 2.50 (LB / FT) 3.35	TUBULAR STEEL Ø (IN) FOUNDATION	TUBULAR STEEL Ø (IN) 3.00 (LB / FT) 7.60	TUBULAR STEEL Ø (IN) 3.50 (LB / FT) 9.00	TUBULAR STEEL Ø (IN) 4.00 (LB / FT) 10.80	TUBULAR STEEL Ø (IN) 5.00 (LB / FT) 14.60	SIGN FRAME REQUIRED	REMARKS	SIGN DETAIL: DETAIL IN SHS	SIGN DETAIL: DETAIL ON SHEET NUMBER	SIGN DETAIL: DETAIL ON STD SHEET NUMBER
TROY VT 100							FY-FLUORESCENT YELLOW FYG-FLUORESCENT YELLOW GREEN																			"SHS"-STANDARD HIGHWAY SIGNS			
SB	1.310	F	W1-6	48	24			8.00								2		X								INSTALL150 '+/- SOUTH OF LEFT REVERSE CURVE SIGN	X		
		E	W1-6	48	24			8.00								2		X									X		
SB	1.050	F	VD-062AL	72	16		BUSINESS SIGN			1				X															
		F	VD-062AS	72	16		BUSINESS SIGN			1																			
SB	0.960	F	R2-5A	24	30		REDUCED SPEED AHEAD 						1		X														
		F	W3-5	36	36			9.00								2		X									X		
SB	0.850	F	VD-018	30	18								1		X														
		F	VD-018	30	18			3.75								1		X											E-128B
SB	0.850	F	OM-3R	12	36		OBJECT MARKER						1		X														
SB	0.820	E	OM-3R	12	36		OBJECT MARKER						1		X														
SB	0.810	F	R2-1	24	30								1		X														
		F	R2-1	30	36		DO NOT PLACE PER PROPERTY OWNER	~~7.50~~								~~1~~		~~X~~									6		
SB	0.734	G	VR-017	24	30								1		X												RIVER RD TH-22		
		G	VR-017	24	30			5.00								1		X											E-141
SB	0.726	H	R1-1	30	30								1		X												RIVER RD TH-22		
SIGN SUMMARY SHEET							SHEET TOTALS	41.25	0.00	2	0	0	7	0	0	9		135										
								SF	SF	EA	EA	EA	EA	EA	EA	EA		FT										
VERMONT AGENCY OF TRANSPORTATION							TOWN TOTALS	334.5	0.0	7.0	2.0	2.0	60	0.0	0.0	55		825.0										

PROJECT NAME: **Moretown-Newport Town VT100**
PROJECT NUMBER: **STPG SIGN(28)**

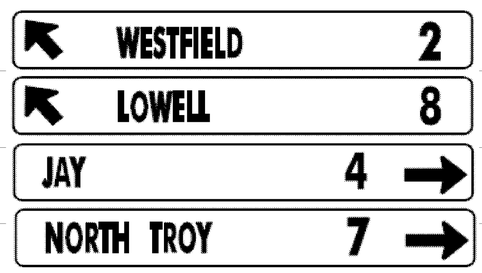FILE NAME: **Troy.xls** PLOT DATE: **9/30/2009**
PROJECT MANAGER: **N. Avery** DRAWN BY: **I. Shea**
DESIGNED BY: **D. Crossley** CHECKED BY: **J. Kelly**
TROY SHEET 6 SHEET **144** OF **166**


DIRECTION	MILEPOINT	LOCATION CODE (SHEET 2)	SIGN CODE	WIDTH (IN)	HEIGHT (IN)	SHEETING REMARKS	SIGN LEGEND	NEW SIGNS "A"	NEW SIGNS "B"	EXISTING SIGNS RETAIN	EXISTING SIGNS SALVAGE FROM	EXISTING SIGNS SALVAGE TO	EXISTING SIGNS REMOVE	EXIST POST RETAIN	EXIST POST REMOVE	NUMBER OF NEW POSTS	SQUARE STEEL (IN) (LB / FT) 1.75 / 1.88	SQUARE STEEL (IN) (LB / FT) 2.00 / 2.42	SQUARE STEEL (IN) (LB / FT) 2.50 / 3.35	TUBULAR STEEL Ø (IN) FOUNDATION	TUBULAR STEEL Ø (IN) (LB / FT) 3.00 / 7.60	TUBULAR STEEL Ø (IN) (LB / FT) 3.50 / 9.00	TUBULAR STEEL Ø (IN) (LB / FT) 4.00 / 10.80	TUBULAR STEEL Ø (IN) (LB / FT) 5.00 / 14.60	SIGN FRAME REQUIRED	REMARKS	SIGN DETAIL: DETAIL IN SHS	SIGN DETAIL: DETAIL ON SHEET NUMBER	SIGN DETAIL: DETAIL ON STD SHEET NUMBER
TROY VT 100							FY-FLUORESCENT YELLOW FYG-FLUORESCENT YELLOW GREEN																			"SHS"-STANDARD HIGHWAY SIGNS			
		H	R1-1	30	30			6.25								1		X									X		
SB	0.720	F	S1-1	36	36		SCHOOL						1		X														
		F	S3-1	30	30		SCHOOL BUS STOP AHEAD 						1																
		F	W11-2	30	30	FYG		6.25								1		X									X		
SB	0.660	F	R2-1	24	30								1		X															
		F	R2-1	24	30			5.00								1	X												
SB	0.630	F	N/A				KNIGHTS OF COLUMBUS SIGN --- REMOVE AND RETURN TO TOWN 						1		X														
		f	S3-1	30	30			6.25								1		X									X		
SB	0.510	F	D1-1	72	10								1		X														
		F	D1-1	72	10								1																
		F	D1-1	72	10								1																
		F	D1-1	72	10								1																
		F	D1-1	72	12			6.00								2			X									5	
		F	D1-1	72	12			6.00																				5	
		F	D1-1	72	12			6.00																				5	
							SHEET TOTALS	41.75	0.00	0	0	0	8	0	0	6		90											
								SF	SF	EA	EA	EA	EA	EA	EA	EA		FT											
							TOWN TOTALS	334.5	0.0	7.0	2.0	2.0	60	0.0	0.0	55		825.0											

SIGN SUMMARY SHEET

VERMONT AGENCY OF TRANSPORTATION

PROJECT NAME: **Moretown-Newport Town VT100**
PROJECT NUMBER: **STPG SIGN(28)**

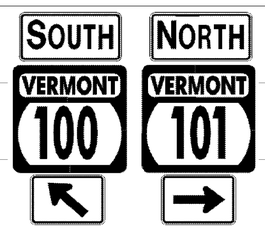FILE NAME: **Troy.xls** PLOT DATE: **9/30/2009**
PROJECT MANAGER: **N. Avery** DRAWN BY: **I. Shea**
DESIGNED BY: **D. Crossley** CHECKED BY: **J. Kelly**
TROY SHEET 7 SHEET **145** OF **166**

DIRECTION	MILEPOINT	LOCATION CODE (SHEET 2)	SIGN CODE	WIDTH (IN)	HEIGHT (IN)	SHEETING REMARKS	SIGN LEGEND	NEW SIGNS "A"	NEW SIGNS "B"	EXISTING SIGNS RETAIN	EXISTING SIGNS SALVAGE FROM	EXISTING SIGNS SALVAGE TO	EXISTING SIGNS REMOVE	EXIST POST RETAIN	EXIST POST REMOVE	NUMBER OF NEW POSTS	SQUARE STEEL (IN) 1.75 (LB / FT) 1.88	SQUARE STEEL (IN) 2.00 (LB / FT) 2.42	SQUARE STEEL (IN) 2.50 (LB / FT) 3.35	TUBULAR STEEL Ø (IN) FOUNDATION	TUBULAR STEEL Ø (IN) 3.00 (LB / FT) 7.60	TUBULAR STEEL Ø (IN) 3.50 (LB / FT) 9.00	TUBULAR STEEL Ø (IN) 4.00 (LB / FT) 10.80	TUBULAR STEEL Ø (IN) 5.00 (LB / FT) 14.60	SIGN FRAME REQUIRED	REMARKS	SIGN DETAIL: DETAIL IN SHS	SIGN DETAIL: DETAIL ON SHEET NUMBER	SIGN DETAIL: DETAIL ON STD SHEET NUMBER
TROY VT 100							FY-FLUORESCENT YELLOW FYG-FLUORESCENT YELLOW GREEN																			"SHS"-STANDARD HIGHWAY SIGNS			
		F	D1-1	72	12			6.00																				5
SB	0.485	F	W11-8	30	30			6.25								1		X								INSTALL OPPOSITE SLAUGHTERHOUSE SIGN	X		
SB	0.400	F	M3-3S	24	12								1		X														
		F	M1-5	30	24								1																
		F	M6-2S	21	15								1																
		F	M3-1S	24	12								1																
		F	M1-5	30	24								1																
		F	M6-1S	21	15								1																
		F	M3-3	24	12			2.00								2			X						1-B	GREEN ON WHITE SHEETING	X	7	
		F	M1-5	30	24			5.00																					E-136B
		F	M6-2L	21	15			2.19																		GREEN ON WHITE SHEETING	X		
		F	M3-1	24	12			2.00																		GREEN ON WHITE SHEETING	X		
		F	M1-5	30	24			5.00																					E-136B
		F	M6-1R	21	15			2.19																		GREEN ON WHITE SHEETING	X		
SB	0.380	E	M3-1S	24	12		MISSING						~~1~~		~~X~~														
SIGN SUMMARY SHEET							SHEET TOTALS	30.63	0.00	0	0	0	7	0	0	3		45										
								SF	SF	EA	EA	EA	EA	EA	EA	EA		FT										
VERMONT AGENCY OF TRANSPORTATION							TOWN TOTALS	334.5	0.0	7.0	2.0	2.0	60	0.0	0.0	55		825.0										

PROJECT NAME: **Moretown-Newport Town VT100**
PROJECT NUMBER: **STPG SIGN(28)**

FILE NAME: **Troy.xls** PLOT DATE: **9/30/2009**
PROJECT MANAGER: **N. Avery** DRAWN BY: **I. Shea**
DESIGNED BY: **D. Crossley** CHECKED BY: **J. Kelly**
TROY SHEET 8 SHEET **146** OF **166**

DIRECTION	MILEPOINT	LOCATION CODE (SHEET 2)	SIGN CODE	WIDTH (IN)	HEIGHT (IN)	SHEETING REMARKS	SIGN LEGEND	NEW SIGNS "A"	NEW SIGNS "B"	EXISTING SIGNS RETAIN	EXISTING SIGNS SALVAGE FROM	EXISTING SIGNS SALVAGE TO	EXISTING SIGNS REMOVE	EXIST POST RETAIN	EXIST POST REMOVE	NUMBER OF NEW POSTS	SQUARE STEEL (IN) 1.75 (LB / FT) 1.88	SQUARE STEEL (IN) 2.00 (LB / FT) 2.42	SQUARE STEEL (IN) 2.50 (LB / FT) 3.35	TUBULAR STEEL Ø (IN) FOUNDATION	TUBULAR STEEL Ø (IN) 3.00 (LB / FT) 7.60	TUBULAR STEEL Ø (IN) 3.50 (LB / FT) 9.00	TUBULAR STEEL Ø (IN) 4.00 (LB / FT) 10.80	TUBULAR STEEL Ø (IN) 5.00 (LB / FT) 14.60	SIGN FRAME REQUIRED	REMARKS	SIGN DETAIL: DETAIL IN SHS	SIGN DETAIL: DETAIL ON SHEET NUMBER	SIGN DETAIL: DETAIL ON STD SHEET NUMBER
TROY VT 100							FY-FLUORESCENT YELLOW FYG-FLUORESCENT YELLOW GREEN																			"SHS"-STANDARD HIGHWAY SIGNS			
		E	M1-5	24	24								1																
		E	M6-2S	21	15								1																
		E	M3-1S	24	12								1																
		E	M1-5	24	24								1																
		E	M6-2S	21	15								1																
		E	M3-1	24	12			2.00																	2B	GREEN ON WHITE SHEETING	X	7	
		E	M1-5	30	24			5.00																			E-136B
		E	M6-2L	21	15			2.19																		GREEN ON WHITE SHEETING	X		
		E	M3-1	24	12			2.00																		GREEN ON WHITE SHEETING	X		
		E	M1-5	30	24			5.00																					E-136B
		E	M6-2R	21	15		PLACED BY DISTRICT	~~2.19~~																		GREEN ON WHITE SHEETING	X		
SB	0.340	F	W11-6 H	30	30		SNOWMOBILE HINGED						1		X														
		F	M3-3	24	12			2.00								1	X									GREEN ON WHITE SHEETING	X		
		F	M1-5	30	24			5.00																					E-136B
SB	0.310	F	R2-1	24	30								1		X														
							SHEET TOTALS	25.38	0.00	0	0	0	7	0	0	1		15											
								SF	SF	EA	EA	EA	EA	EA	EA	EA		FT											
							TOWN TOTALS	334.5	0.0	7.0	2.0	2.0	60	0.0	0.0	55		825.0											

SIGN SUMMARY SHEET

VERMONT AGENCY OF TRANSPORTATION

PROJECT NAME: **Moretown-Newport Town VT100**
PROJECT NUMBER: **STPG SIGN(28)**

FILE NAME: **Trov.xls**
PROJECT MANAGER: **N. Averv**
DESIGNED BY: **D. Crosslev**
TROY SHEET 9

PLOT DATE: **9/30/2009**
DRAWN BY: **I. Shea**
CHECKED BY: **J. Kelly**
SHEET **147** OF **166**

DIRECTION	MILEPOINT	LOCATION CODE (SHEET 2)	SIGN CODE	WIDTH (IN)	HEIGHT (IN)	SHEETING REMARKS	SIGN LEGEND	NEW SIGNS		EXISTING SIGNS				EXIST POST		NUMBER OF NEW POSTS	SQUARE STEEL (IN)			TUBULAR STEEL Ø (IN)				SIGN FRAME REQUIRED	REMARKS	SIGN DETAIL		
								"A"	"B"	RETAIN	SALVAGE FROM	SALVAGE TO	REMOVE	RETAIN	REMOVE		1.75 (LB / FT) 1.88	2.00 (LB / FT) 2.42	2.50 (LB / FT) 3.35	FOUNDATION	3.00 (LB / FT) 7.60	3.50 (LB / FT) 9.00	4.00 (LB / FT) 10.80	5.00 (LB / FT) 14.60			DETAIL IN SHS	DETAIL ON SHEET NUMBER	DETAIL ON STD SHEET NUMBER
TROY VT 100							FY-FLUORESCENT YELLOW FYG-FLUORESCENT YELLOW GREEN																		"SHS"-STANDARD HIGHWAY SIGNS			
		F	R2-1	24	30			5.00								1		X								X		

DIRECTION	MILEPOINT	LOCATION CODE (SHEET 2)	SIGN CODE	WIDTH (IN)	HEIGHT (IN)	SHEETING REMARKS	SIGN LEGEND	NEW SIGNS "A"	NEW SIGNS "B"	EXISTING SIGNS RETAIN	EXISTING SIGNS SALVAGE FROM	EXISTING SIGNS SALVAGE TO	EXISTING SIGNS REMOVE	EXIST POST RETAIN	EXIST POST REMOVE	NUMBER OF NEW POSTS	SQUARE STEEL (IN) (LB / FT) 1.75 / 1.88	SQUARE STEEL (IN) (LB / FT) 2.00 / 2.42	SQUARE STEEL (IN) (LB / FT) 2.50 / 3.35	TUBULAR STEEL Ø (IN) FOUNDATION	TUBULAR STEEL Ø (IN) (LB / FT) 3.00 / 7.60	TUBULAR STEEL Ø (IN) (LB / FT) 3.50 / 9.00	TUBULAR STEEL Ø (IN) (LB / FT) 4.00 / 10.80	TUBULAR STEEL Ø (IN) (LB / FT) 5.00 / 14.60	SIGN FRAME REQUIRED	REMARKS	SIGN DETAIL: DETAIL IN SHS	SIGN DETAIL: DETAIL ON SHEET NUMBER	SIGN DETAIL: DETAIL ON STD SHEET NUMBER
NEWPORT TOWN VT100							FY-FLUORESCENT YELLOW FYG-FLUORESCENT YELLOW GREEN																			"SHS"-STANDARD HIGHWAY SIGNS			
NB	0.000	C	VD-024	60	7.5								1		X													
		C	VD-024	72	10		NEWPORT TOWN / TROY	5.00								2		X										4	
		C	VD-700	6	10		1000 1016 0000 / 1000 1017 0318	0.42																				E-138
		C	VD-700	6	10			0.42																				E-138
NB	0.115	A	S3-1	30	30		SCHOOL BUS STOP AHEAD						1		X													
NB	0.801	C	VR-017	24	30		LEGAL LOAD LIMIT 24,000 POUNDS						1		X												TETREAULT RD TH-22		
		C	VR-017	24	30			5.00								1		X										E-141
NB	0.812	D	R1-1	30	30		STOP						1		X												TETREAULT RD TH-22		
		D	R1-1	30	30			6.25								1		X										X	
NB	0.830	A	W11-6 H	30	30		SNOWMOBILE HINGED						1		X														
NB	1.215	A	VW-001	30	30		MOOSE	6.25								1		X									INSTALL 100' +/- NORTH OF SHERLAW LN PVT.		6	
		A	W7-3A	24	18		NEXT 1/2 MILE	3.00																				X	
NB	1.488	A	S3-1	30	30		SCHOOL BUS STOP AHEAD						1		X														
NB	1.884	A	W2-2MR	30	30		MODIFIED RIGHT SIDE ROAD			1				X															
		A	W16-8A	36	8		COLLINS MILL RD			1																			
							SHEET TOTALS	26.34	0.00	2	0	0	6	0	0	5		75										
								SF	SF	EA	EA	EA	EA	EA	EA	EA		FT										
							TOWN TOTALS	342.4	0.0	29.0	9.0	9.0	83	0.0	0.0	50		750.0										

SIGN SUMMARY SHEET

VERMONT AGENCY OF TRANSPORTATION

PROJECT NAME: Moretown-Newport Town VT100
PROJECT NUMBER: STPG SIGN(28)

FILE NAME: Newport Town.xls
PROJECT MANAGER: N. Avery
DESIGNED BY: D. Crossley
NEWPORT TOWN SHEET 1

PLOT DATE: 9/30/2009
DRAWN BY: I. Shea
CHECKED BY: J. Kelly


DIRECTION	MILEPOINT	LOCATION CODE (SHEET 2)	SIGN CODE	WIDTH (IN)	HEIGHT (IN)	SHEETING REMARKS	SIGN LEGEND	NEW SIGNS "A"	NEW SIGNS "B"	EXISTING SIGNS RETAIN	EXISTING SIGNS SALVAGE FROM	EXISTING SIGNS SALVAGE TO	EXISTING SIGNS REMOVE	EXIST POST RETAIN	EXIST POST REMOVE	NUMBER OF NEW POSTS	SQUARE STEEL (IN) 1.75 (LB / FT) 1.88	SQUARE STEEL (IN) 2.00 (LB / FT) 2.42	SQUARE STEEL (IN) 2.50 (LB / FT) 3.35	TUBULAR STEEL Ø (IN) FOUNDATION	TUBULAR STEEL Ø (IN) 3.00 (LB / FT) 7.60	TUBULAR STEEL Ø (IN) 3.50 (LB / FT) 9.00	TUBULAR STEEL Ø (IN) 4.00 (LB / FT) 10.80	TUBULAR STEEL Ø (IN) 5.00 (LB / FT) 14.60	SIGN FRAME REQUIRED	REMARKS	SIGN DETAIL: DETAIL IN SHS	SIGN DETAIL: DETAIL ON SHEET NUMBER	SIGN DETAIL: DETAIL ON STD SHEET NUMBER
NEWPORT TOWN VT100							FY-FLUORESCENT YELLOW FYG-FLUORESCENT YELLOW GREEN																			"SHS"-STANDARD HIGHWAY SIGNS			
NB	1.962	C	VR-017	24	30								1		X											COLLINS MILL RD TH-25			
		C	VR-017	24	30			5.00								1		X										E-141
NB	1.970	D	R1-1	30	30								1		X											COLLINS MILL RD TH-25			
		D	R1-1	30	30			6.25								1		X								X		
NB	2.635	C	VR-017	24	30								1		X											POGINY RD TH-26			
		C	VR-017	24	30			5.00								1		X										E-141
NB	2.644	D	R1-1	30	30								1		X											POGINY RD TH-26			
		D	R1-1	30	30			6.25								1		X								X		
NB	2.890	A	VD-062B	72	16		BUSINESS SIGN 			1				X														
NB	2.940	A	W1-2R	30	30			6.25								1		X								INSTALL JUST NORTH OF WEEPING WILLOW TREE AT POLE #9?/20 W/GUY WIRE	X		
NB	3.069	A	M2-1S	21	15								1		X													
		A	M1-5	24	24								1															
		A	M2-1	21	15			2.19								1		X								GREEN ON WHITE SHEETING	X		
		A	M1-5	24	24			4.00																				E-136B
NB	3.106	A	M3-1S	24	12								1		X													
							SHEET TOTALS	34.94 SF	0.00 SF	1 EA	0 EA	0 EA	7 EA	0 EA	0 EA	6 EA		90 FT										
							TOWN TOTALS	342.4	0.0	29.0	9.0	9.0	83	0.0	0.0	50		750.0										

SIGN SUMMARY SHEET

VERMONT AGENCY OF TRANSPORTATION

PROJECT NAME: **Moretown-Newport Town VT100**
PROJECT NUMBER: **STPG SIGN(28)**

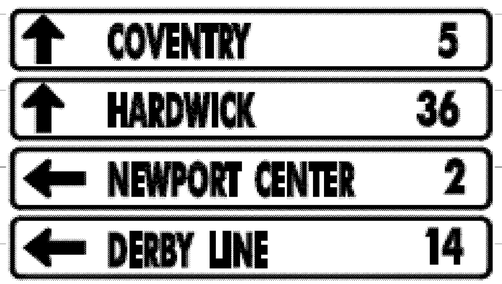FILE NAME: **Newport Town.xls** PLOT DATE: **9/30/2009**
PROJECT MANAGER: **N. Avery** DRAWN BY: **I. Shea**
DESIGNED BY: **D. Crossley** CHECKED BY: **J. Kelly**
NEWPORT TOWN SHEET 2 SHEET **150** OF **166**

DIRECTION	MILEPOINT	LOCATION CODE (SHEET 2)	SIGN CODE	WIDTH (IN)	HEIGHT (IN)	SHEETING REMARKS	SIGN LEGEND	NEW SIGNS "A"	NEW SIGNS "B"	EXISTING SIGNS RETAIN	EXISTING SIGNS SALVAGE FROM	EXISTING SIGNS SALVAGE TO	EXISTING SIGNS REMOVE	EXIST POST RETAIN	EXIST POST REMOVE	NUMBER OF NEW POSTS	SQUARE STEEL (IN) (LB / FT) 1.75 / 1.88	SQUARE STEEL (IN) (LB / FT) 2.00 / 2.42	SQUARE STEEL (IN) (LB / FT) 2.50 / 3.35	TUBULAR STEEL Ø (IN) FOUNDATION	TUBULAR STEEL Ø (IN) (LB / FT) 3.00 / 7.60	TUBULAR STEEL Ø (IN) (LB / FT) 3.50 / 9.00	TUBULAR STEEL Ø (IN) (LB / FT) 4.00 / 10.80	TUBULAR STEEL Ø (IN) (LB / FT) 5.00 / 14.60	SIGN FRAME REQUIRED	REMARKS	SIGN DETAIL: DETAIL IN SHS	SIGN DETAIL: DETAIL ON SHEET NUMBER	SIGN DETAIL: DETAIL ON STD SHEET NUMBER
NEWPORT TOWN VT100							FY-FLUORESCENT YELLOW FYG-FLUORESCENT YELLOW GREEN																			"SHS"-STANDARD HIGHWAY SIGNS			
		A	M1-5	30	24								1															
		A	M5-1S	21	15								1														
		A	M3-1	24	12			2.00								1		X								GREEN ON WHITE SHEETING	X		
		A	M1-5	30	24			5.00																				E-136B
		A	M5-1L	21	15			2.19																		GREEN ON WHITE SHEETING	X		
NB	3.171	A	D1-1A	72	10								1		X													
		A	D1-1A	72	10								1															
		A	D1-1A	72	10								1															
		A	D1-1A	72	12			6.00								2		X							5
		A	D1-1A	72	12			6.00																			5
		A	D1-1A	72	12			6.00																			5
		A	D1-1A	72	12			6.00																			5
NB	3.193	A	R14-1	24	18								1		X													
		A	M3-2S	24	12								1															
SIGN SUMMARY SHEET							SHEET TOTALS	33.19	0.00	0	0	0	8	0	0	3		45									
								SF	SF	EA	EA	EA	EA	EA	EA	EA		FT									
VERMONT AGENCY OF TRANSPORTATION							TOWN TOTALS	342.4	0.0	29.0	9.0	9.0	83	0.0	0.0	50		750.0									

PROJECT NAME: **Moretown-Newport Town VT100**
PROJECT NUMBER: **STPG SIGN(28)**

FILE NAME: **Newport Town.xls** PLOT DATE: **9/30/2009**
PROJECT MANAGER: **N. Avery** DRAWN BY: **I. Shea**
DESIGNED BY: **D. Crossley** CHECKED BY: **J. Kelly**
NEWPORT TOWN SHEET 3 SHEET **151** OF **166**

DIRECTION	MILEPOINT	LOCATION CODE (SHEET 2)	SIGN CODE	WIDTH (IN)	HEIGHT (IN)	SHEETING REMARKS	SIGN LEGEND	NEW SIGNS "A"	NEW SIGNS "B"	EXISTING SIGNS RETAIN	EXISTING SIGNS SALVAGE FROM	EXISTING SIGNS SALVAGE TO	EXISTING SIGNS REMOVE	EXIST POST RETAIN	EXIST POST REMOVE	NUMBER OF NEW POSTS	SQUARE STEEL (IN) (LB / FT) 1.75 / 1.88	SQUARE STEEL (IN) (LB / FT) 2.00 / 2.42	SQUARE STEEL (IN) (LB / FT) 2.50 / 3.35	TUBULAR STEEL Ø (IN) FOUNDATION	TUBULAR STEEL Ø (IN) (LB / FT) 3.00 / 7.60	TUBULAR STEEL Ø (IN) (LB / FT) 3.50 / 9.00	TUBULAR STEEL Ø (IN) (LB / FT) 4.00 / 10.80	TUBULAR STEEL Ø (IN) (LB / FT) 5.00 / 14.60	SIGN FRAME REQUIRED	REMARKS	SIGN DETAIL: DETAIL IN SHS	SIGN DETAIL: DETAIL ON SHEET NUMBER	SIGN DETAIL: DETAIL ON STD SHEET NUMBER
NEWPORT TOWN VT100							FY-FLUORESCENT YELLOW FYG-FLUORESCENT YELLOW GREEN																			"SHS"-STANDARD HIGHWAY SIGNS			
		A	M1-5	30	24								1															
		A	M6-3S	21	15								1															
		A	M4-5	24	12								1															
		A	M1-4	24	24								1															
		A	M6-3	21	15								1															
		A	R14-1	24	18			3.00								2			X							2A	INSTALL OVER EAST / 105/ ^	X		
		A	M3-2	24	12			2.00																			GREEN ON WHITE SHEETING	X		
		A	M1-5	30	24			5.00																						E-141
		A	M6-3	21	15			2.19																			GREEN ON WHITE SHEETING	X		
		A	M4-5	24	12			2.00																			BLACK ON WHITE SHEETING	X		
		A	M1-4	24	24			4.00																				X		
		A	M6-3	21	15			2.19																			BLACK ON WHITE SHEETING	X		
NB	3.243	A	M3-1S	24	12		NORTH			1				X															
		A	M1-5	30	24		VERMONT 100			1																			
		A	M6-1S	21	15		<--- LEFT			1																			
							SHEET TOTALS	20.38	0.00	3	0	0	5	0	0	2			30										
								SF	SF	EA	EA	EA	EA	EA	EA	EA			FT										
							TOWN TOTALS	342.4	0.0	29.0	9.0	9.0	83	0.0	0.0	50			750.0										

SIGN SUMMARY SHEET

VERMONT AGENCY OF TRANSPORTATION

PROJECT NAME: **Moretown-Newport Town VT100**
PROJECT NUMBER: **STPG SIGN(28)**

FILE NAME: **Newport Town.xls** PLOT DATE: **9/30/2009**
PROJECT MANAGER: **N. Avery** DRAWN BY: **I. Shea**
DESIGNED BY: **D. Crossley** CHECKED BY: **J. Kelly**
NEWPORT TOWN SHEET 4 SHEET **152** OF **166**

E-141


DIRECTION	MILEPOINT	LOCATION CODE (SHEET 2)	SIGN CODE	WIDTH (IN)	HEIGHT (IN)	SHEETING REMARKS	SIGN LEGEND	NEW SIGNS		EXISTING SIGNS				EXIST POST		NUMBER OF NEW POSTS	SQUARE STEEL (IN)			TUBULAR STEEL Ø (IN)				SIGN FRAME REQUIRED	REMARKS	SIGN DETAIL		
								"A"	"B"	RETAIN	SALVAGE FROM	SALVAGE TO	REMOVE	RETAIN	REMOVE		1.75	2.00	2.50	FOUNDATION	3.00	3.50	4.00	5.00			DETAIL IN SHS	DETAIL ON SHEET NUMBER	DETAIL ON STD SHEET NUMBER
																	(LB / FT)				(LB / FT)								
																	1.88	2.42	3.35		7.60	9.00	10.80	14.60					
NEWPORT TOWN VT100							FY-FLUORESCENT YELLOW FYG-FLUORESCENT YELLOW GREEN																			"SHS"-STANDARD HIGHWAY SIGNS			
		A	M4-5S	24	12		TO			1																			
		A	M1-5	30	24		VERMONT 105			1																			
		A	M6-1S	21	15		<--- LEFT			1																			
		A	M3-3S	24	12		SOUTH			1																			
		A	M1-5	24	24		VERMONT 14			1																			
		A	M6-3S	21	15		^UP ARROW			1																			
NB	3.244	C	W1-7	48	24		DOUBLE ARROW			1				X															
NB	3.257	B	R1-1	30	30		STOP			1				X															
		A	OM1-1	18	18		YELLOW CLUSTER						1																
NB	3.381	B	W3-1	36	36		STOP AHEAD			1				X															
NB	3.388	C	VR-017	24	30		LEGAL LOAD LIMIT 24,000 LBS			1				X												BUCK RD TH-42			
NB	3.395	D	R1-1	30	30		STOP			1				X												BUCK RD TH-42			
NB	3.406	A	M3-1	24	12								1		X														
		A	M1-5	30	24								1																
		A	M4-5	24	12								1																
							SHEET TOTALS	0.00	0.00	11	0	0	4	0	0	0	0												
								SF	SF	EA	EA	EA	EA	EA	EA	EA	FT												
							TOWN TOTALS	342.4	0.0	29.0	9.0	9.0	83	0.0	0.0	50	750.0												

SIGN SUMMARY SHEET

VERMONT AGENCY OF TRANSPORTATION

PROJECT NAME: **Moretown-Newport Town VT100**
PROJECT NUMBER: **STPG SIGN(28)**

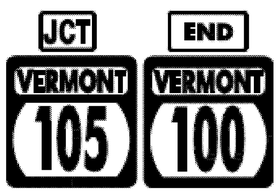FILE NAME: **Newport Town.xls** PLOT DATE: **9/30/2009**
PROJECT MANAGER: **N. Avery** DRAWN BY: **I. Shea**
DESIGNED BY: **D. Crossley** CHECKED BY: **J. Kelly**

DIRECTION	MILEPOINT	LOCATION CODE (SHEET 2)	SIGN CODE	WIDTH (IN)	HEIGHT (IN)	SHEETING REMARKS	SIGN LEGEND	NEW SIGNS "A"	NEW SIGNS "B"	EXISTING SIGNS RETAIN	EXISTING SIGNS SALVAGE FROM	EXISTING SIGNS SALVAGE TO	EXISTING SIGNS REMOVE	EXIST POST RETAIN	EXIST POST REMOVE	NUMBER OF NEW POSTS	SQUARE STEEL (IN) 1.75 (LB / FT) 1.88	SQUARE STEEL (IN) 2.00 (LB / FT) 2.42	SQUARE STEEL (IN) 2.50 (LB / FT) 3.35	TUBULAR STEEL Ø (IN) FOUNDATION	TUBULAR STEEL Ø (IN) 3.00 (LB / FT) 7.60	TUBULAR STEEL Ø (IN) 3.50 (LB / FT) 9.00	TUBULAR STEEL Ø (IN) 4.00 (LB / FT) 10.80	TUBULAR STEEL Ø (IN) 5.00 (LB / FT) 14.60	SIGN FRAME REQUIRED	REMARKS	SIGN DETAIL: DETAIL IN SHS	SIGN DETAIL: DETAIL ON SHEET NUMBER	SIGN DETAIL: DETAIL ON STD SHEET NUMBER
NEWPORT TOWN VT100							FY-FLUORESCENT YELLOW FYG-FLUORESCENT YELLOW GREEN																			"SHS"-STANDARD HIGHWAY SIGNS			
		A	M1-5	30	24								1																
		A	M3-1	24	12			2.00								2		X							1B	GREEN ON WHITE SHEETING	X	7	
		A	M1-5	30	24			5.00																				E-136B
		A	M4-5	24	12			2.00																		GREEN ON WHITE SHEETING	X		
		A	M1-5	30	24			5.00																					E-136B
NB	3.948	A	M2-1S	21	15								1		X														
		A	M1-5	24	30								1																
		A	M4-6S	24	12								1																
		A	M1-5	24	30								1																
		A	M2-1	21	15			2.19								2		X							1B	GREEN ON WHITE SHEETING	X	7	
		A	M1-5	30	24			5.00																				E-136B
		A	M4-6	24	12			2.00																		GREEN ON WHITE SHEETING	X		
		A	M1-5	30	24			5.00																					E-136B
NB	3.990	A	D1-1A	72	10								1		X														
		A	D1-1A	72	10								1																
							SHEET TOTALS	28.19	0.00	0	0	0	7	0	0	4		60											
								SF	SF	EA	EA	EA	EA	EA	EA	EA		FT											
							TOWN TOTALS	342.4	0.0	29.0	9.0	9.0	83	0.0	0.0	50		750.0											

SIGN SUMMARY SHEET

VERMONT AGENCY OF TRANSPORTATION

PROJECT NAME: **Moretown-Newport Town VT100**
PROJECT NUMBER: **STPG SIGN(28)**

FILE NAME: **Newport Town.xls** PLOT DATE: **9/30/2009**
PROJECT MANAGER: **N. Avery** DRAWN BY: **I. Shea**
DESIGNED BY: **D. Crossley** CHECKED BY: **J. Kelly**


DIRECTION	MILEPOINT	LOCATION CODE (SHEET 2)	SIGN CODE	WIDTH (IN)	HEIGHT (IN)	SHEETING REMARKS	SIGN LEGEND	NEW SIGNS "A"	NEW SIGNS "B"	EXISTING SIGNS RETAIN	EXISTING SIGNS SALVAGE FROM	EXISTING SIGNS SALVAGE TO	EXISTING SIGNS REMOVE	EXIST POST RETAIN	EXIST POST REMOVE	NUMBER OF NEW POSTS	SQUARE STEEL (IN) 1.75 (LB / FT) 1.88	SQUARE STEEL (IN) 2.00 (LB / FT) 2.42	SQUARE STEEL (IN) 2.50 (LB / FT) 3.35	TUBULAR STEEL Ø (IN) FOUNDATION	TUBULAR STEEL Ø (IN) 3.00 (LB / FT) 7.60	TUBULAR STEEL Ø (IN) 3.50 (LB / FT) 9.00	TUBULAR STEEL Ø (IN) 4.00 (LB / FT) 10.80	TUBULAR STEEL Ø (IN) 5.00 (LB / FT) 14.60	SIGN FRAME REQUIRED	REMARKS	SIGN DETAIL: DETAIL IN SHS	SIGN DETAIL: DETAIL ON SHEET NUMBER	SIGN DETAIL: DETAIL ON STD SHEET NUMBER
NEWPORT TOWN VT100							FY-FLUORESCENT YELLOW FYG-FLUORESCENT YELLOW GREEN																			"SHS"-STANDARD HIGHWAY SIGNS			
		A	D1-1A	72	10								1																
		A	D1-1A	72	10								1																
		A	D1-1A	72	12			6.00								2			X									5
		A	D1-1A	72	12			6.00																				5
		A	D1-1A	72	12			6.00																				5
		A	D1-1A	72	12			6.00																				5
NB	4.020	A	R4-6	24	30		TRUCK LANE 500 FEET						1		X														
NB	4.053	A	M3-4S	24	12								1		X														
		A	M1-5	24	30								1																
		A	M6-1S	21	15								1																
		A	M3-2S	24	12								1																
		A	M1-5	24	30								1																
		A	M6-3S	21	15								1																
		A	M3-4	24	12			2.00								2			X							2B	GREEN ON WHITE SHEETING	X	7	
		A	M1-5	30	24			5.00																					E-136B
							SHEET TOTALS	31.00	0.00	0	0	0	9	0	0	4			60									
								SF	SF	EA	EA	EA	EA	EA	EA	EA			FT									
							TOWN TOTALS	342.4	0.0	29.0	9.0	9.0	83	0.0	0.0	50			750.0									

SIGN SUMMARY SHEET

VERMONT AGENCY OF TRANSPORTATION



PROJECT NAME: **Moretown-Newport Town VT100**
PROJECT NUMBER: **STPG SIGN(28)**

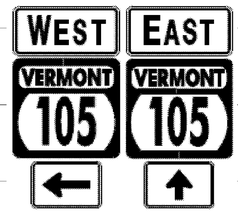FILE NAME: **Newport Town.xls** PLOT DATE: **9/30/2009**
PROJECT MANAGER: **N. Avery** DRAWN BY: **I. Shea**
DESIGNED BY: **D. Crossley** CHECKED BY: **J. Kelly**
NEWPORT TOWN SHEET 7 SHEET **155** OF **166**

DIRECTION	MILEPOINT	LOCATION CODE (SHEET 2)	SIGN CODE	WIDTH (IN)	HEIGHT (IN)	SHEETING REMARKS	SIGN LEGEND	NEW SIGNS "A"	NEW SIGNS "B"	EXISTING SIGNS RETAIN	EXISTING SIGNS SALVAGE FROM	EXISTING SIGNS SALVAGE TO	EXISTING SIGNS REMOVE	EXIST POST RETAIN	EXIST POST REMOVE	NUMBER OF NEW POSTS	SQUARE STEEL (IN) 1.75 (LB / FT) 1.88	SQUARE STEEL (IN) 2.00 (LB / FT) 2.42	SQUARE STEEL (IN) 2.50 (LB / FT) 3.35	TUBULAR STEEL Ø (IN) FOUNDATION	TUBULAR STEEL Ø (IN) 3.00 (LB / FT) 7.60	TUBULAR STEEL Ø (IN) 3.50 (LB / FT) 9.00	TUBULAR STEEL Ø (IN) 4.00 (LB / FT) 10.80	TUBULAR STEEL Ø (IN) 5.00 (LB / FT) 14.60	SIGN FRAME REQUIRED	REMARKS	SIGN DETAIL: DETAIL IN SHS	SIGN DETAIL: DETAIL ON SHEET NUMBER	SIGN DETAIL: DETAIL ON STD SHEET NUMBER
NEWPORT TOWN VT100							FY-FLUORESCENT YELLOW FYG-FLUORESCENT YELLOW GREEN																			"SHS"-STANDARD HIGHWAY SIGNS			
		A	M6-1L	21	15			2.19																	GREEN ON WHITE SHEETING	X		
		A	M3-2	24	12			2.00																	GREEN ON WHITE SHEETING	X		
		A	M1-5	30	24			5.00																				E-136B
		A	M6-3	21	15			2.19																	GREEN ON WHITE SHEETING	X		
NB	4.070	A	VR-921L	36	30								1		X													
		A	VR-921L	36	30			7.50								1		X										E-145A
SB	4.099	F	M3-3S	24	12								1	X														
		F	M1-5	24	30								1															
		F	M4-5S	24	12								1															
		F	M1-5	24	24								1															
		F	M4-4S	24	12								1															
		F	M3-2S	24	12								1															
		F	M1-5	24	30								1															
		F	M3-3	24	12			2.00								2			X						3B	GREEN ON WHITE SHEETING	X		
		F	M1-5	30	24			5.00																				E-136B
SIGN SUMMARY SHEET							SHEET TOTALS	25.88	0.00	0	0	0	8	0	0	3		45										
								SF	SF	EA	EA	EA	EA	EA	EA	EA		FT										
VERMONT AGENCY OF TRANSPORTATION							TOWN TOTALS	342.4	0.0	29.0	9.0	9.0	83	0.0	0.0	50		750.0										

PROJECT NAME: **Moretown-Newport Town VT100**
PROJECT NUMBER: **STPG SIGN(28)**

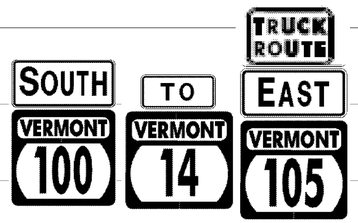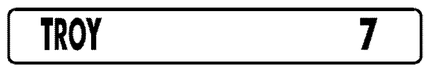FILE NAME: **Newport Town.xls** PLOT DATE: **9/30/2009**
PROJECT MANAGER: **N. Avery** DRAWN BY: **I. Shea**
DESIGNED BY: **D. Crossley** CHECKED BY: **J. Kelly**
NEWPORT TOWN SHEET 8 SHEET **156** OF **166**

DIRECTION	MILEPOINT	LOCATION CODE (SHEET 2)	SIGN CODE	WIDTH (IN)	HEIGHT (IN)	SHEETING REMARKS	SIGN LEGEND	NEW SIGNS "A"	NEW SIGNS "B"	EXISTING SIGNS RETAIN	EXISTING SIGNS SALVAGE FROM	EXISTING SIGNS SALVAGE TO	EXISTING SIGNS REMOVE	EXIST POST RETAIN	EXIST POST REMOVE	NUMBER OF NEW POSTS	SQUARE STEEL (IN) 1.75 (LB / FT) 1.88	SQUARE STEEL (IN) 2.00 (LB / FT) 2.42	SQUARE STEEL (IN) 2.50 (LB / FT) 3.35	TUBULAR STEEL Ø (IN) FOUNDATION	TUBULAR STEEL Ø (IN) 3.00 (LB / FT) 7.60	TUBULAR STEEL Ø (IN) 3.50 (LB / FT) 9.00	TUBULAR STEEL Ø (IN) 4.00 (LB / FT) 10.80	TUBULAR STEEL Ø (IN) 5.00 (LB / FT) 14.60	SIGN FRAME REQUIRED	REMARKS	SIGN DETAIL: DETAIL IN SHS	SIGN DETAIL: DETAIL ON SHEET NUMBER	SIGN DETAIL: DETAIL ON STD SHEET NUMBER
NEWPORT TOWN VT100							FY-FLUORESCENT YELLOW FYG-FLUORESCENT YELLOW GREEN																			"SHS"-STANDARD HIGHWAY SIGNS			
		F	M4-5	24	12			2.00																		GREEN ON WHITE SHEETING	X		
		F	M1-5	24	24			4.00																					E-136B
		F	R14-1	24	12			2.00																			X		
		F	M3-2	24	12			2.00																		GREEN ON WHITE SHEETING	X		
		F	M1-5	30	24			5.00																					E-136B
SB	4.059	F	D2-1	72	10								1		X														
		F	D2-1	72	12			6.00								2		X									5	
SB	4.033	G	VM-607	24	30		43RD INF DIV MEMORIAL HIGHWAY			1				X															
SB	3.709	F	W11-6 H	30	30		SNOWMOBILE HINGED						1		X														
SB	3.470	F	W1-8 L	18	24		CHEVRON				1	1			X	1		X											
SB	3.457	F	W1-8 L	18	24		CHEVRON				1	1			X	1		X											
SB	3.441	F	M2-1S	21	15		JCT			1				X															
		F	M1-5	24	24		VERMONT 14			1																			
SB	3.424	G	VR-017	24	30		LEGAL LOAD LIMIT 24,000 LBS			1				X													WHEELER CORNER RD TH-??			
SB	3.418	F	R1-1	30	30		STOP			1				X													WHEELER CORNER RD TH-??			
							SHEET TOTALS	21.00	0.00	5	2	2	2	0	0	4		60											
								SF	SF	EA	EA	EA	EA	EA	EA	EA		FT											
							TOWN TOTALS	342.4	0.0	29.0	9.0	9.0	83	0.0	0.0	50		750.0											

SIGN SUMMARY SHEET

VERMONT AGENCY OF TRANSPORTATION

PROJECT NAME: **Moretown-Newport Town VT100**
PROJECT NUMBER: **STPG SIGN(28)**

FILE NAME: **Newport Town.xls**
PROJECT MANAGER: **N. Avery**
DESIGNED BY: **D. Crossley**
NEWPORT TOWN SHEET 9

PLOT DATE: **9/30/2009**
DRAWN BY: **I. Shea**
CHECKED BY: **J. Kelly**

DIRECTION	MILEPOINT	LOCATION CODE (SHEET 2)	SIGN CODE	WIDTH (IN)	HEIGHT (IN)	SHEETING REMARKS	SIGN LEGEND	NEW SIGNS "A"	NEW SIGNS "B"	EXISTING SIGNS RETAIN	EXISTING SIGNS SALVAGE FROM	EXISTING SIGNS SALVAGE TO	EXISTING SIGNS REMOVE	EXIST POST RETAIN	EXIST POST REMOVE	NUMBER OF NEW POSTS	SQUARE STEEL (IN) 1.75 (LB / FT) 1.88	SQUARE STEEL (IN) 2.00 (LB / FT) 2.42	SQUARE STEEL (IN) 2.50 (LB / FT) 3.35	TUBULAR STEEL Ø (IN) FOUNDATION	TUBULAR STEEL Ø (IN) 3.00 (LB / FT) 7.60	TUBULAR STEEL Ø (IN) 3.50 (LB / FT) 9.00	TUBULAR STEEL Ø (IN) 4.00 (LB / FT) 10.80	TUBULAR STEEL Ø (IN) 5.00 (LB / FT) 14.60	SIGN FRAME REQUIRED	REMARKS	SIGN DETAIL: DETAIL IN SHS	SIGN DETAIL: DETAIL ON SHEET NUMBER	SIGN DETAIL: DETAIL ON STD SHEET NUMBER
NEWPORT TOWN VT100							FY-FLUORESCENT YELLOW FYG-FLUORESCENT YELLOW GREEN																			"SHS"-STANDARD HIGHWAY SIGNS			
SB	3.407	F	R14-1	24	18								1		X														
		F	M3-1	24	12								1																
		F	M1-4	24	24								1																
		F	M5-1	21	15								1																
		F	M3-2S	24	12								1																
		F	M1-5	30	24								1																
		F	M5-1S	21	15								1																
		F	R14-1	24	18			3.00								2			X						2A		X	7	
		F	M3-2	24	12			2.00																		GREEN ON WHITE SHEETING	X		
		F	M1-5	30	24			5.00																					E-136B
		F	M5-1L	21	15		PLACED BY DISTRICT	~~2.19~~																		GREEN ON WHITE SHEETING	X		
		F	M4-5	24	12			2.00																		BLACK ON WHITE SHEETING	X		
		F	M3-1	24	12			2.00																		BLACK ON WHITE SHEETING	X		
		F	M1-4	24	24			4.00																			X		
		F	M5-1L	21	15			2.19																		BLACK ON WHITE SHEETING	X		
							SHEET TOTALS	22.38	0.00	0	0	0	7	0	0	2		30										
								SF	SF	EA	EA	EA	EA	EA	EA	EA		FT										
							TOWN TOTALS	342.4	0.0	29.0	9.0	9.0	83	0.0	0.0	50		750.0										



SIGN SUMMARY SHEET

VERMONT AGENCY OF TRANSPORTATION

PROJECT NAME: **Moretown-Newport Town VT100**
PROJECT NUMBER: **STPG SIGN(28)**

FILE NAME: **Newport Town.xls**
PROJECT MANAGER: **N. Avery**
DESIGNED BY: **D. Crossley**
NEWPORT TOWN SHEET 10

PLOT DATE: **9/30/2009**
DRAWN BY: **I. Shea**
CHECKED BY: **J. Kelly**
SHEET **158** OF **166**

DIRECTION	MILEPOINT	LOCATION CODE (SHEET 2)	SIGN CODE	WIDTH (IN)	HEIGHT (IN)	SHEETING REMARKS	SIGN LEGEND	NEW SIGNS "A"	NEW SIGNS "B"	EXISTING SIGNS RETAIN	EXISTING SIGNS SALVAGE FROM	EXISTING SIGNS SALVAGE TO	EXISTING SIGNS REMOVE	EXIST POST RETAIN	EXIST POST REMOVE	NUMBER OF NEW POSTS	SQUARE STEEL (IN) 1.75 (LB / FT) 1.88	SQUARE STEEL (IN) 2.00 (LB / FT) 2.42	SQUARE STEEL (IN) 2.50 (LB / FT) 3.35	TUBULAR STEEL Ø (IN) FOUNDATION	TUBULAR STEEL Ø (IN) 3.00 (LB / FT) 7.60	TUBULAR STEEL Ø (IN) 3.50 (LB / FT) 9.00	TUBULAR STEEL Ø (IN) 4.00 (LB / FT) 10.80	TUBULAR STEEL Ø (IN) 5.00 (LB / FT) 14.60	SIGN FRAME REQUIRED	REMARKS	SIGN DETAIL: DETAIL IN SHS	SIGN DETAIL: DETAIL ON SHEET NUMBER	SIGN DETAIL: DETAIL ON STD SHEET NUMBER
NEWPORT TOWN VT100							FY-FLUORESCENT YELLOW FYG-FLUORESCENT YELLOW GREEN																			"SHS"-STANDARD HIGHWAY SIGNS			
SB	3.367	F	W3-1	36	36		STOP AHEAD			1				X															
SB	3.335	F	D1-1A	72	10								1		X														
		F	D1-1A	72	10								1																
		F	D1-1A	72	10								1																
		F	D1-1A	72	10								1																
		F	D1-1A	72	10								1																
		F	D1-1A	72	12			6.00								2			X										5
		F	D1-1A	72	12		COVENTRY 5 HARDWICK 36 TROY 6 MORRISVILLE 37	6.00																					5
		F	D1-1A	72	12			6.00																					5
		F	D1-1A	72	12			6.00																					5
SB	3.292	F	M3-3S	24	12		SOUTH				1				X														
		F	M1-5	24	24		VT 14				1																		
		F	M6-1S	21	15		LEFT ARROW				1																		
		F	M3-3S	24	12		SOUTH				1																		
							SHEET TOTALS	24.00	0.00	1	4	0	5	0	0	2			30										
								SF	SF	EA	EA	EA	EA	EA	EA	EA			FT										
							TOWN TOTALS	342.4	0.0	29.0	9.0	9.0	83	0.0	0.0	50			750.0										

SIGN SUMMARY SHEET

VERMONT AGENCY OF TRANSPORTATION

PROJECT NAME: Moretown-Newport Town VT100
PROJECT NUMBER: STPG SIGN(28)

FILE NAME: Newport Town.xls
PROJECT MANAGER: N. Avery
DESIGNED BY: D. Crossley
NEWPORT TOWN SHEET 11

PLOT DATE: 9/30/2009
DRAWN BY: I. Shea
CHECKED BY: J. Kelly

DIRECTION	MILEPOINT	LOCATION CODE (SHEET 2)	SIGN CODE	WIDTH (IN)	HEIGHT (IN)	SHEETING REMARKS	SIGN LEGEND	NEW SIGNS "A"	NEW SIGNS "B"	EXISTING SIGNS RETAIN	EXISTING SIGNS SALVAGE FROM	EXISTING SIGNS SALVAGE TO	EXISTING SIGNS REMOVE	EXIST POST RETAIN	EXIST POST REMOVE	NUMBER OF NEW POSTS	SQUARE STEEL (IN) 1.75 (LB / FT) 1.88	SQUARE STEEL (IN) 2.00 (LB / FT) 2.42	SQUARE STEEL (IN) 2.50 (LB / FT) 3.35	TUBULAR STEEL Ø (IN) FOUNDATION	TUBULAR STEEL Ø (IN) 3.00 (LB / FT) 7.60	TUBULAR STEEL Ø (IN) 3.50 (LB / FT) 9.00	TUBULAR STEEL Ø (IN) 4.00 (LB / FT) 10.80	TUBULAR STEEL Ø (IN) 5.00 (LB / FT) 14.60	SIGN FRAME REQUIRED	REMARKS	SIGN DETAIL: DETAIL IN SHS	SIGN DETAIL: DETAIL ON SHEET NUMBER	SIGN DETAIL: DETAIL ON STD SHEET NUMBER
NEWPORT TOWN VT100							FY-FLUORESCENT YELLOW FYG-FLUORESCENT YELLOW GREEN																			"SHS"-STANDARD HIGHWAY SIGNS			
		F	M1-5	30	24		VT 100				1	I																
		F	M6-1S	21	15		RIGHT ARROW				1	I																
		F	M3-3S	24	12		SOUTH					1																
		F	M1-5	24	24		VT 14					1																
		F	M6-1S	21	15		LEFT ARROW					1																
		F	R14-1	24	18		 PLACED BY DISTRICT	~~3.00~~								2			X					3B	INSTALL BETWEEN ROUTE 14 RIGHT AND ROUTE 100 LEFT	X	7	
		F	M3-2	24	12			2.00																			GREEN ON WHITE SHEETING	X		
		F	M1-5	30	24			5.00																						E-136B
		F	M6-1L	21	15			2.19																			GREEN ON WHITE SHEETING	X		
		F	M3-3S	24	12		SOUTH					1																
		F	M1-5	30	24		VT 100					1																
		F	M6-1S	21	15		RIGHT ARROW					1																
SB	3.253	F	R1-1	30	30		STOP			1				X														
		E	OM1-1	18	18		YELLOW CLUSTER			1																		
SB	3.211	F	M3-3S	24	12		SOUTH			1				X														
							SHEET TOTALS	12.19 SF	0.00 SF	3 EA	2 EA	6 EA	0 EA	0 EA	0 EA	2 EA	30 FT											
							TOWN TOTALS	342.4	0.0	29.0	9.0	9.0	83	0.0	0.0	50	750.0											

SIGN SUMMARY SHEET

VERMONT AGENCY OF TRANSPORTATION


PROJECT NAME: **Moretown-Newport Town VT100**
PROJECT NUMBER: **STPG SIGN(28)**

FILE NAME: **Newport Town.xls** PLOT DATE: **9/30/2009**
PROJECT MANAGER: **N. Avery** DRAWN BY: **I. Shea**
DESIGNED BY: **D. Crossley** CHECKED BY: **J. Kelly**
NEWPORT TOWN SHEET 12 SHEET **160** OF **166**

DIRECTION	MILEPOINT	LOCATION CODE (SHEET 2)	SIGN CODE	WIDTH (IN)	HEIGHT (IN)	SHEETING REMARKS	SIGN LEGEND	NEW SIGNS "A"	NEW SIGNS "B"	EXISTING SIGNS RETAIN	EXISTING SIGNS SALVAGE FROM	EXISTING SIGNS SALVAGE TO	EXISTING SIGNS REMOVE	EXIST POST RETAIN	EXIST POST REMOVE	NUMBER OF NEW POSTS	SQUARE STEEL (IN) 1.75 (LB/FT) 1.88	SQUARE STEEL (IN) 2.00 (LB/FT) 2.42	SQUARE STEEL (IN) 2.50 (LB/FT) 3.35	TUBULAR STEEL Ø (IN) FOUNDATION	TUBULAR STEEL Ø (IN) 3.00 (LB/FT) 7.60	TUBULAR STEEL Ø (IN) 3.50 (LB/FT) 9.00	TUBULAR STEEL Ø (IN) 4.00 (LB/FT) 10.80	TUBULAR STEEL Ø (IN) 5.00 (LB/FT) 14.60	SIGN FRAME REQUIRED	REMARKS	SIGN DETAIL: DETAIL IN SHS	SIGN DETAIL: DETAIL ON SHEET NUMBER	SIGN DETAIL: DETAIL ON STD SHEET NUMBER
NEWPORT TOWN VT100							FY-FLUORESCENT YELLOW FYG-FLUORESCENT YELLOW GREEN																			"SHS"-STANDARD HIGHWAY SIGNS			
	3.176	F	M1-5	30	24		VERMONT 100			1																		
SB	3.172	F	VR-041	24	24		THROUGH WAY BEGINS HERE						1		X													
		F	R2-1	24	30		SPEED LIMIT 50				1	1				1		X									
		E	VR-040	24	24		THROUGH WAY ENDS HERE						1															
SB	3.021	E	W1-8 R	18	24		CHEVRON						1		X													
		F	W1-8 L	18	24			3.00								1		X									X	
		E	W1-8 R	18	24			3.00								1		X									X	
SB	3.000	F	W1-8 L	18	24		NEW ONES WERE IN PLACE	~~3.00~~								~~1~~		~~X~~								INSTALL 1OO FT SOUTH OF EXISTING	X	
		E	W1-8 R	18	24			~~3.00~~								~~1~~		~~X~~									X	
SB	2.936	F	M3-3S	24	12		SOUTH						1		X													
		F	M1-5	30	24		VERMONT 100						1															
SB	2.792	F	W2-2ML	30	30		LEFT SIDE ROAD						1		X													
SB	2.732	F	W1-2Mb L	30	30		Poginy Hill M	6.25								1		X								INSTALL 300' +/- SOUTH OF ORIGINAL SIGN LOCATION ON LEFT SIDE ROAD SIGN		6	
		F	W16-8A	30	8			1.67																				8
SB	2.504	G	VR-017	24	30								1		X											NILES RD TH-16		
SIGN SUMMARY SHEET							SHEET TOTALS	19.92	0.00	1	1	1	7	0	0	6		90								
								SF	SF	EA	EA	EA	EA	EA	EA	EA		FT								
VERMONT AGENCY OF TRANSPORTATION							TOWN TOTALS	342.4	0.0	29.0	9.0	9.0	83	0.0	0.0	50		750.0								

PROJECT NAME: **Moretown-Newport Town VT100**
PROJECT NUMBER: **STPG SIGN(28)**

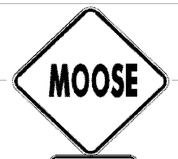FILE NAME: **Newport Town.xls** PLOT DATE: **9/30/2009**
PROJECT MANAGER: **N. Avery** DRAWN BY: **I. Shea**
DESIGNED BY: **D. Crossley** CHECKED BY: **J. Kelly**
NEWPORT TOWN SHEET 13 SHEET **161** OF **166**

DIRECTION	MILEPOINT	LOCATION CODE (SHEET 2)	SIGN CODE	WIDTH (IN)	HEIGHT (IN)	SHEETING REMARKS	SIGN LEGEND	NEW SIGNS "A"	NEW SIGNS "B"	EXISTING SIGNS RETAIN	EXISTING SIGNS SALVAGE FROM	EXISTING SIGNS SALVAGE TO	EXISTING SIGNS REMOVE	EXIST POST RETAIN	EXIST POST REMOVE	NUMBER OF NEW POSTS	SQUARE STEEL (IN) 1.75 (LB / FT) 1.88	SQUARE STEEL (IN) 2.00 (LB / FT) 2.42	SQUARE STEEL (IN) 2.50 (LB / FT) 3.35	TUBULAR STEEL Ø (IN) FOUNDATION	TUBULAR STEEL Ø (IN) 3.00 (LB / FT) 7.60	TUBULAR STEEL Ø (IN) 3.50 (LB / FT) 9.00	TUBULAR STEEL Ø (IN) 4.00 (LB / FT) 10.80	TUBULAR STEEL Ø (IN) 5.00 (LB / FT) 14.60	SIGN FRAME REQUIRED	REMARKS	SIGN DETAIL: DETAIL IN SHS	SIGN DETAIL: DETAIL ON SHEET NUMBER	SIGN DETAIL: DETAIL ON STD SHEET NUMBER
NEWPORT TOWN VT100							FY-FLUORESCENT YELLOW FYG-FLUORESCENT YELLOW GREEN																			"SHS"-STANDARD HIGHWAY SIGNS			
		G	VR-017	24	30			5.00								1		X										E-141
SB	2.493	H	R1-1	24	24								1		X											NILES RD TH-16			
		H	R1-1	30	30			6.25								1		X									X		
SB	2.125	F	VW-000	30	30		MOOSE CROSSING						1		X														
		F	W16-4	24	18		NEXT 3500 FT						1																
		F	VW-001	30	30			6.25								1		X									6	
		F	W7-3A	24	18			3.00																		X		
SB	2.050	F	W2-2ML	30	30		MODIFIED LEFT SIDE ROAD			1				X														
		F	W16-8A	36	8		COLLINS MILL RD			1																		
SB	1.166	G	VR-017	24	30								1		X											CROSS RD TH-1			
		G	VR-017	24	30			5.00								1		X										E-141
SB	1.154	H	R1-1	30	30								1		X											CROSS RD TH-1 W/ STREET SIGN			
		H	R1-1	30	30			6.25								1		X									X		
SB	1.077	F	30	30			SNOWMOBILE HINGED						1		X														
SB	0.231	G	VR-017	24	30								1		X											NO. 12 ROAD TH-4			
							SHEET TOTALS	31.75 SF	0.00 SF	2 EA	0 EA	0 EA	7 EA	0 EA	0 EA	5 EA		75 FT										
							TOWN TOTALS	342.4	0.0	29.0	9.0	9.0	83	0.0	0.0	50		750.0										

SIGN SUMMARY SHEET

VERMONT AGENCY OF TRANSPORTATION

PROJECT NAME: **Moretown-Newport Town VT100**
PROJECT NUMBER: **STPG SIGN(28)**

FILE NAME: **Newport Town.xls**
PROJECT MANAGER: **N. Avery**
DESIGNED BY: **D. Crossley**
NEWPORT TOWN SHEET 14

PLOT DATE: **9/30/2009**
DRAWN BY: **I. Shea**
CHECKED BY: **J. Kelly**

DIRECTION	MILEPOINT	LOCATION CODE (SHEET 2)	SIGN CODE	WIDTH (IN)	HEIGHT (IN)	SHEETING REMARKS	SIGN LEGEND	NEW SIGNS "A"	NEW SIGNS "B"	EXISTING SIGNS RETAIN	EXISTING SIGNS SALVAGE FROM	EXISTING SIGNS SALVAGE TO	EXISTING SIGNS REMOVE	EXIST POST RETAIN	EXIST POST REMOVE	NUMBER OF NEW POSTS	SQUARE STEEL (IN) 1.75 (LB / FT) 1.88	SQUARE STEEL (IN) 2.00 (LB / FT) 2.42	SQUARE STEEL (IN) 2.50 (LB / FT) 3.35	TUBULAR STEEL Ø (IN) FOUNDATION	TUBULAR STEEL Ø (IN) 3.00 (LB / FT) 7.60	TUBULAR STEEL Ø (IN) 3.50 (LB / FT) 9.00	TUBULAR STEEL Ø (IN) 4.00 (LB / FT) 10.80	TUBULAR STEEL Ø (IN) 5.00 (LB / FT) 14.60	SIGN FRAME REQUIRED	REMARKS	SIGN DETAIL: DETAIL IN SHS	SIGN DETAIL: DETAIL ON SHEET NUMBER	SIGN DETAIL: DETAIL ON STD SHEET NUMBER
NEWPORT TOWN VT100							FY-FLUORESCENT YELLOW FYG-FLUORESCENT YELLOW GREEN																			"SHS"-STANDARD HIGHWAY SIGNS			
		G	VR-017	24	30			5.00								1		X										E-141
SB	0..222	H	R1-1	30	30								1		X											NO. 12 ROAD TH-4			
		H	R1-1	30	30			6.25								1		X									X		

SIGN SUMMARY SHEET		SHEET TOTALS	11.25	0.00	0	0	0	1	0	0	2	30																	
			SF	SF	EA	EA	EA	EA	EA	EA	EA	FT																	
VERMONT AGENCY OF TRANSPORTATION		TOWN TOTALS	342.4	0.0	29.0	9.0	9.0	83	0.0	0.0	50	750.0																	

PROJECT NAME: **Moretown-Newport Town VT100**
PROJECT NUMBER: **STPG SIGN(28)**
FILE NAME: **Newport Town.xls**
PROJECT MANAGER: **N. Avery**
DESIGNED BY: **D. Crossley**
NEWPORT TOWN SHEET 15
PLOT DATE: **9/30/2009**
DRAWN BY: **I. Shea**
CHECKED BY: **J. Kelly**
SHEET **163** OF **166**

TOWN TOTAL SIGN SUMMARY SHEET

VT ROUTE 100 **MORETOWN - NEWPORT TOWN STPG SIGN (28)**

Townname	County	Town Mileage	NEW SIGNS (SF)		EXISTING SIGNS (EA)				EXIST POST (EA)		NUMBER OF NEW POSTS (EA)				SQUARE STEEL (IN)			TUBULAR STEEL Ø (IN)				
											1.75"	2"	2.5"		1.75	2.00	2.50		3.00	3.50	4.00	5.00
											(LB / FT)				(LB / FT)				(LB / FT)			
			TYPE A	TYPE B	RETAIN	SALVAGE FROM	SALVAGE TO	REMOVE	RETAIN	REMOVE	1.88	2.42	3.35	TOTAL POSTS	1.88	2.42	3.35	FOUNDATION	7.60	9.00	10.80	14.60
Moretown	Washington	1.227	228.6	0	22	0	0	60	0	0	0	23	4	27	0	345	60					
Duxbury	Washington	6.234	345.2	0	68	1	1	65	0	0	0	59	3	62	0	885	45					
Waterbury	Washington	6.743	622.8	0	89	5	5	115	0	0	0	101	4	105	0	1515	60					
Stowe	Lamoille	6.819	582.8	0	65	6	6	105	0	0	0	101	2	103	0	1515	30					
Morristown	Lamoille	6.601	369.7	0	77	5	5	65	0	0	0	68	0	68	0	1020	0					
Hyde Park	Lamoille	6.513	287.3	0	80	0	0	54	0	0	0	40	2	42	0	600	30					
Eden	Lamoille	7.689	462.5	0	40	2	2	86	0	0	0	71	6	77	0	1065	90					
Lowell	Orleans	7.031	489.3	0	8	2	2	100	0	0	0	64	10	74	0	960	150					
Westfield	Orleans	4.942	149.5	0	15	0	0	28	0	0	0	26	0	26	0	390	0					
Troy	Orleans	3.122	334.5	0	7	2	2	60	0	0	0	51	4	55	0	765	60					
Newport Town	Orleans	4.211	342.4	0	29	9	9	83	0	0	0	36	14	50	0	540	210					
				Sub-Total		32	32	821						**Sub-Total**	0	9600	735					
Estimated Salvaged Street Name Signs to be erected onto new posts =							2															
Salvaged From signs to be added to Remove total =								32														
		TOTAL =	4214.6	0	500	32	34	853	0	0	0	640	49	689	10335			0	0	0	0	0

PROJECT NAME:	MORETOWN - NEWPORT TOWN
PROJECT NUMBER:	STPG SIGN (28)
FILE NAME: 09b060_TS.DGN	PLOT DATE: 30-SEP-2009
PROJECT LEADER: N. AVERY	DRAWN BY: N. AVERY
DESIGNED BY: N. AVERY	CHECKED BY: A. GAMBLE
TOWN TOTAL SIGN SUMMARY SHEET	SHEET 164 OF 166

Table 6H-2. Meaning of Symbols on Typical Application Diagrams

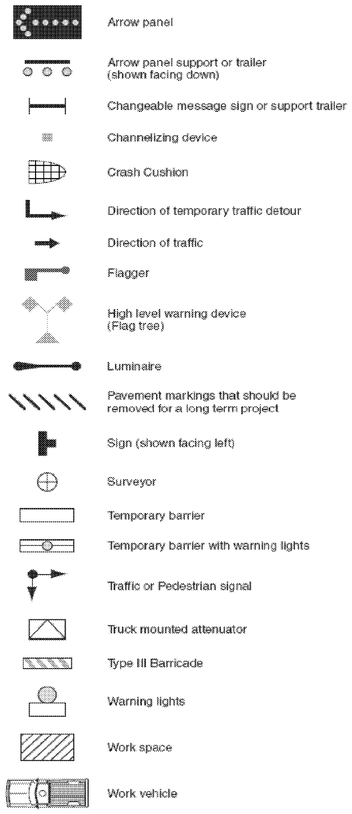


Figure 6E-1. Use of Hand-Signaling Devices by Flaggers

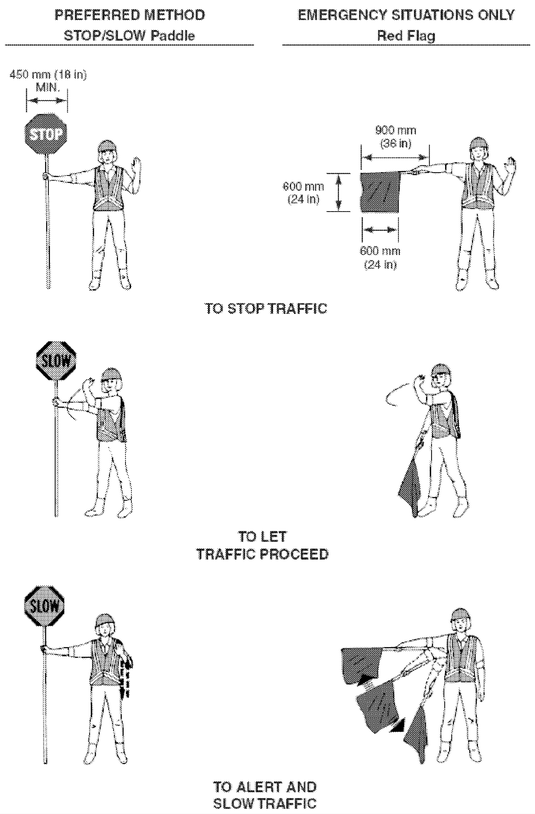


Figure 6C-2. Types of Tapers and Buffer Spaces


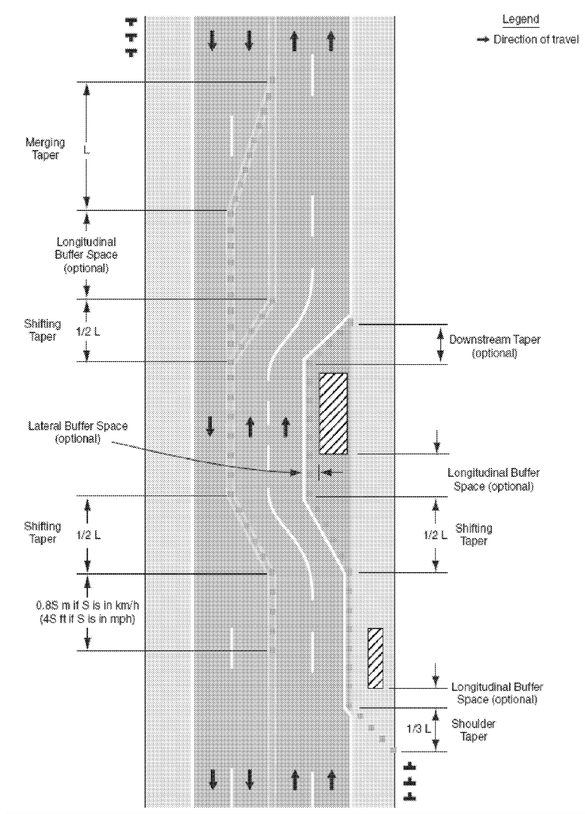


Figure 6H-1. Work Beyond the Shoulder (TA-1)

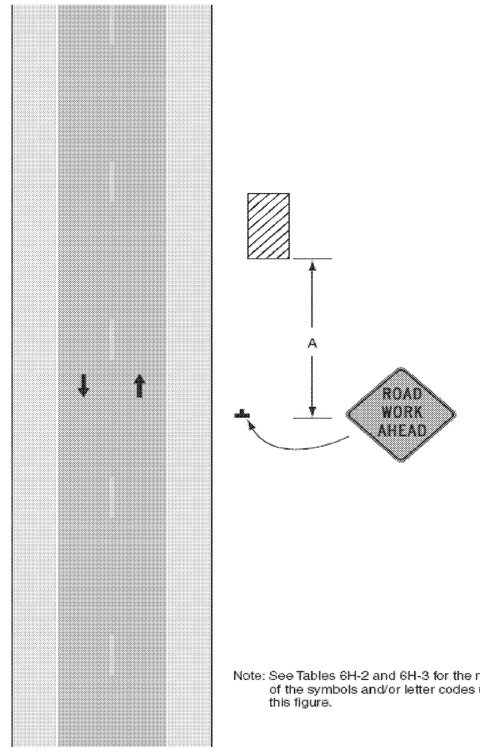

Note: See Tables 6H-2 and 6H-3 for the meaning of the symbols and/or letter codes used in this figure.

Typical Application 1

Table 6C-3. Taper Length Criteria for Temporary Traffic Control Zones

Type of Taper	Taper Length (L)*
Merging Taper	at least L
Shifting Taper	at least 0.5L
Shoulder Taper	at least 0.33L
One-Lane, Two-Way Traffic Taper	30 m (100 ft) maximum
Downstream Taper	30 m (100 ft) per lane

Table 6C-4. Formulas for Determining Taper Lengths

Speed Limit (S)	Taper Length (L) Meters
60 km/h or less	$L = \frac{WS^2}{155}$
70 km/h or more	$L = \frac{WS}{1.6}$

Speed Limit (S)	Taper Length (L) Feet
40 mph or less	$L = \frac{WS^2}{60}$
45 mph or more	L = WS

Where: L = taper length in meters (feet)
W = width of offset in meters (feet)
S = posted speed limit, or off-peak 85th-percentile speed prior to work starting, or the anticipated operating speed in km/h (mph)


Table 6H-3. Meaning of Letter Codes on Typical Application Diagrams

Road Type	Distance Between Signs**		
	A	B	C
Urban (low speed)*	30 (100)	30 (100)	30 (100)
Urban (high speed)*	100 (350)	100 (350)	100 (350)
Rural	150 (500)	150 (500)	150 (500)
Expressway / Freeway	300 (1,000)	450 (1,500)	800 (2,640)

* Speed category to be determined by highway agency

** Distances are shown in meters (feet). The column headings A, B, and C are the dimensions shown in Figures shown on the Traffic Control Detail Sheets. The A dimension is the distance from the transition or point of restriction to the first sign. The B dimension is the distance between the first and second signs. The C dimension is the distance between the second and third signs. (The third sign is the first one in a three-sign series encountered by a driver approaching a TTC zone.)

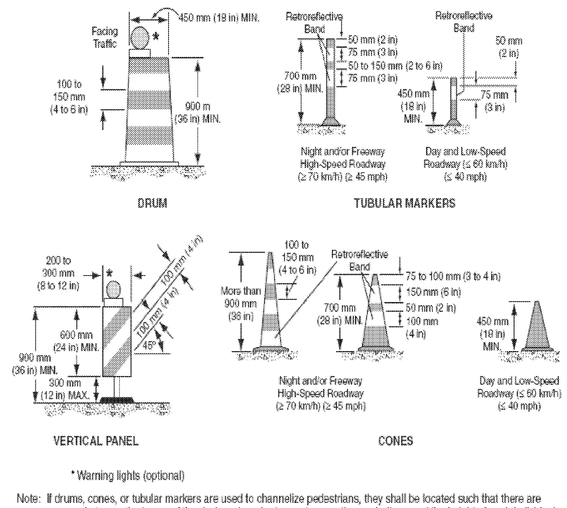Figure 6F-7. Channelizing Devices (Sheet 1 of 2)



* Warning lights (optional)

Note: If drums, cones, or tubular markers are used to channelize pedestrians, they shall be located such that there are no gaps between the bases of the devices, in order to create a continuous bottom, and the height of each individual drum, cone, or tubular marker shall be no less than 900 mm (36 in) to be detectable to users of long canes.

TEMPORARY TRAFFIC CONTROL NOTES

1. ALL TEMPORARY TRAFFIC CONTROL SHALL BE IN ACCORDANCE WITH THESE PROJECT PLANS, APPLICABLE VTRANS E-SERIES STANDARD DRAWINGS, AND THE MANUAL ON UNIFORM TRAFFIC CONTROL DEVICES (MUTCD),DATED 2003, AND ITS LATEST REVISIONS, OR AS DIRECTED BY THE RESIDENT ENGINEER. IF THE CONTRACTOR DOES NOT WISH TO FOLLOW THE TEMPORARY TRAFFIC CONTROL PROVIDED, HE/SHE MAY SUBMIT AN ALTERNATE PROPOSAL AT THE PRE-CONSTRUCTION MEETING IMPLEMENTING THE PROPOSED CHANGES FOR REVIEW AND APPROVAL BY THE RESIDENT ENGINEER.
2. THE CONTRACTOR MUST PROVIDE ACCESS THROUGH THE WORK ZONE FOR EMERGENCY VEHICLES AT ALL TIMES.
3. THE CONTRACTOR SHALL CONDUCT THE WORK AT ALL TIMES IN SUCH A MANNER AND IN SUCH SEQUENCE SO AS TO ENSURE THE LEAST INTERFERENCE WITH TRAFFIC OCCURS.
4. SIGNS SHALL ONLY BE VISIBLE TO MOTORIST AT THE TIMES WHEN THE MESSAGE IS PERTINENT, I.E. A "FLAGGER AHEAD" SIGN SHALL ONLY BE VISIBLE TO MOTORIST WHEN THE FLAGGER IS ACTUALLY PRESENT PERFORMING THEIR DUTIES.
5. PAYMENT FOR CONSTRUCTION SIGNING WILL BE MADE UNDER CONTRACT ITEM 641.10.


PROJECT NAME: MORETOWN - NEWPORT TOWN

PROJECT NUMBER: STPG SIGN (28)

FILE NAME: 09B060_TS.DGN
PROJECT LEADER: N. AVERY
DESIGNED BY: N. AVERY
TRAFFIC CONTROL I

PLOT DATE: 30-SEP-2009
DRAWN BY: N. AVERY
CHECKED BY: A. GAMBLE
SHEET 165 OF 166

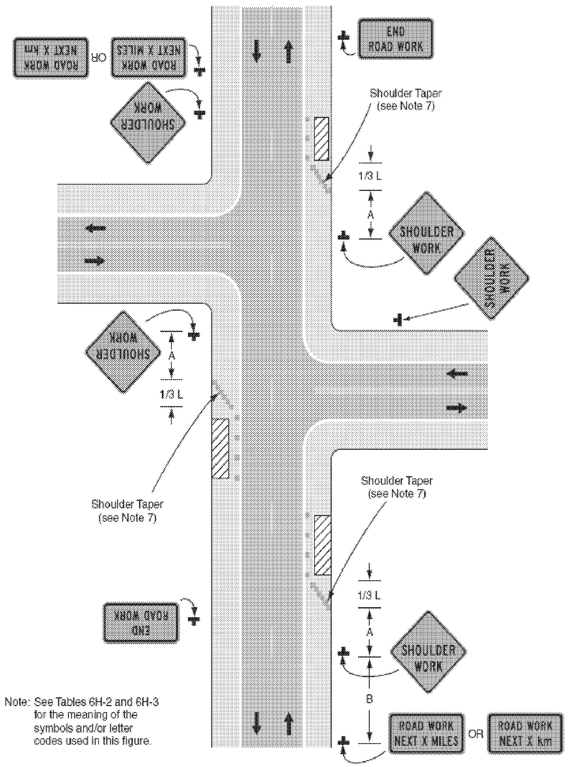
Figure 6H-3. Work on Shoulders (TA-3)



Note: See Tables 6H-2 and 6H-3 for the meaning of the symbols and/or letter codes used in this figure.


Typical Application 3

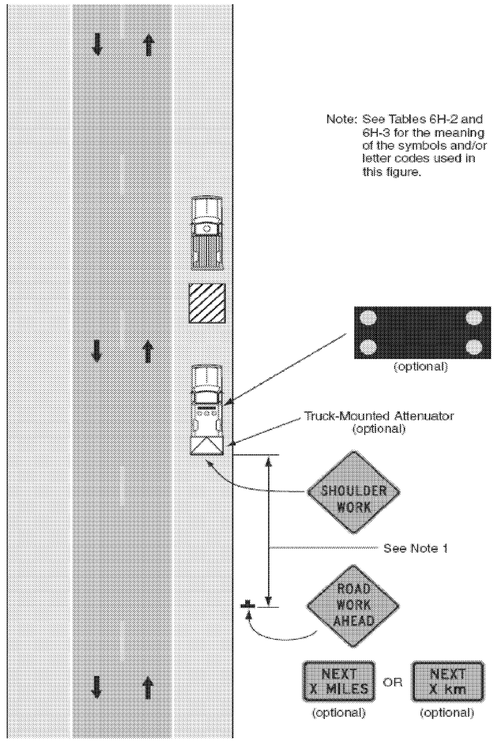Figure 6H-4. Short-Duration or Mobile Operation on Shoulder (TA-4)




Typical Application 4

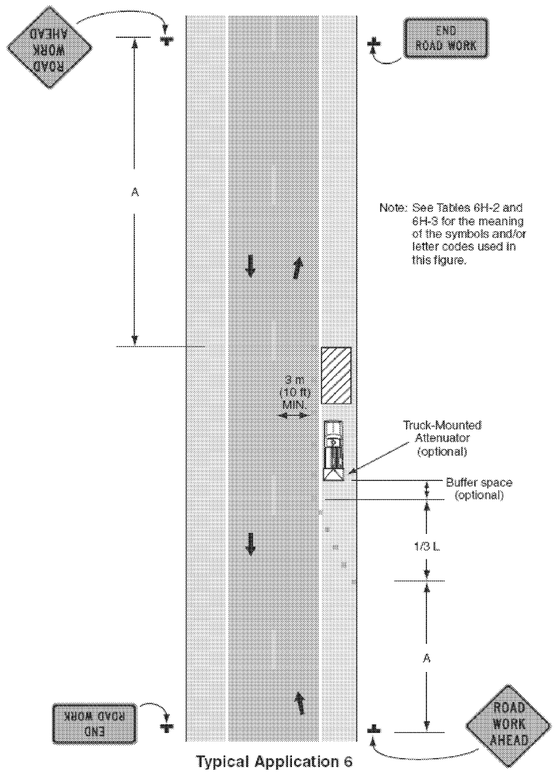Figure 6H-6. Shoulder Work with Minor Encroachment (TA-6)



Typical Application 6

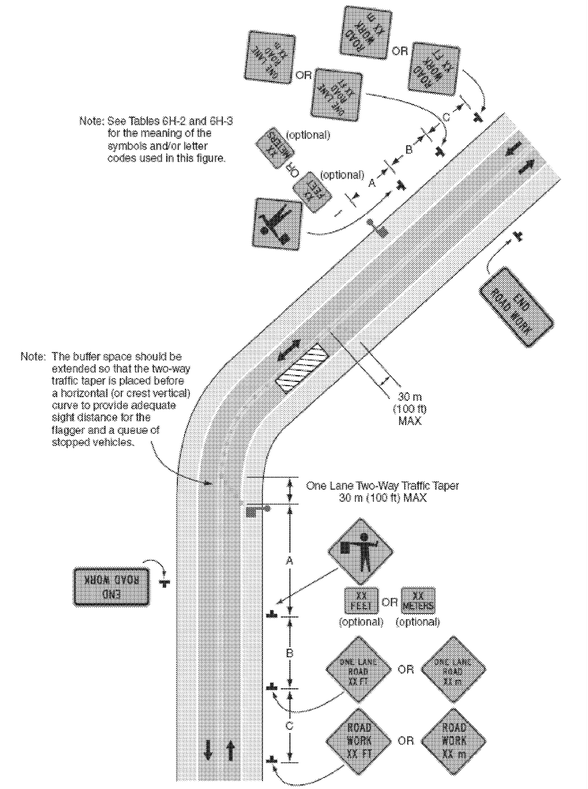Figure 6H-10. Lane Closure on Two-Lane Road Using Flaggers (TA-10)



Typical Application 10

PROJECT NAME: MORETOWN - NEWPORT TOWN	
PROJECT NUMBER: STPG SIGN (28)	
FILE NAME: 09B060_TS.DGN	PLOT DATE: 30-SEP-2009
PROJECT LEADER: N. AVERY	DRAWN BY: N. AVERY
DESIGNED BY: N. AVERY	CHECKED BY: A. GAMBLE
TRAFFIC CONTROL 2	SHEET 166 OF 166