STATE OF VERMONT
AGENCY OF TRANSPORTATION

ST ALBANS - BERKSHIRE
PROJECT LOCATION

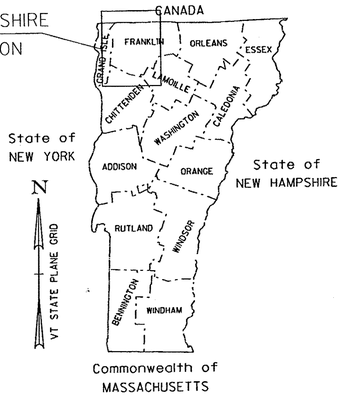

INDEX OF SHEETS
SEE SHEET 2

PROPOSED IMPROVEMENT
TOWNS OF ST ALBANS, SWANTON, SHELDON, ENOSBURG AND BERKSHIRE
COUNTY OF FRANKLIN
VERMONT ROUTE 105

SIGN REPLACEMENT - 25.730 MILES ON VT 105 BEGINNING AT ST. ALBANS TOWN M.P. 0.000 EXTENDING EASTERLY TO BERKSHIRE M.P. 3.700 INCLUDING 1.040 MILES OF ENOSBURG CLASS 1 TOWN HIGHWAY

LENGTH OF ROADWAY = 25.730 MILES
LENGTH OF PROJECT = 25.730 MILES

WORK TO BE PERFORMED UNDER THIS PROJECT INCLUDES THE REMOVAL OF EXISTING SIGNS AND POSTS AND THE INSTALLATION OF NEW SIGNS AND SIGN POSTS AND INCIDENTAL ITEMS.

END STPG SIGN(36)
BERKSHIRE MP 3.700

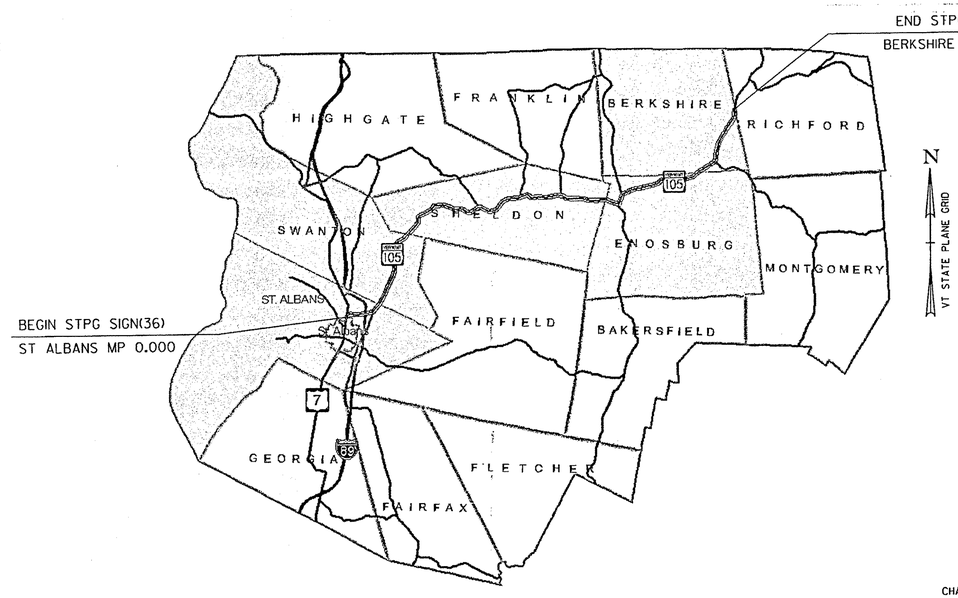

BEGIN STPG SIGN(36)
ST ALBANS MP 0.000

RECORD PLANS

CONTRACTOR: F. R. LAFAYETTE, INC.- ESSEX JUNCTION, VT
RESIDENT ENGINEER: JEFF COTA
CONSTRUCTION BEGAN: AUGUST 17, 2011
CONSTRUCTION COMPLETE: JANUARY 10, 2012
RECORD PLANS BY: JEFF COTA & JENNA HYDE

I HEREBY CERTIFY THAT ALL THE CONSTUCTION REQUIRED BY THIS SET OF DRAWINGS HAS BEEN ACCOMPLISHED AS INDICATED HEREIN.

BY _____ RESIDENT ENGINEER
DATE 10/15/12

NOTE: Any further information concerning final quantities, amounts or other details relative to this project may be found at Central Files in the electronic archives.

QUALITY ASSURANCE PROGRAM: LEVEL 3

CONVENTIONAL SYMBOLS

COUNTY LINE
TOWN LINE
LIMITS OF ACCESS
POINT OF ACCESS
FENCE LINE
STONE WALL
TRAVELED WAY
GUARD RAIL
RAILROAD
SURVEY LINE
CULVERT
POWER POLE
TELEPHONE POLE
TREES
CONTROL OF ACCESS
PROPERTY LINE
R.O.W. TAKING LINE
SLOPE RIGHTS
TOP OF CUT
TOE OF SLOPE

SURVEYED BY : N/A
SURVEYED DATE : N/A

DATUM
VERTICAL N/A
HORIZONTAL N/A

NOT TO SCALE

THESE PLANS ARE SUBJECT TO SUCH ENGINEERING CHANGES AS MAY BE REQUIRED BY THE FEDERAL HIGHWAY ADMINISTRATION OR THE DIRECTOR OF PROGRAM DEVELOPMENT.

CONSTRUCTION IS TO BE CARRIED ON IN ACCORDANCE WITH THESE PLANS AND THE STANDARD SPECIFICATIONS FOR CONSTRUCTION DATED 2006, AS APPROVED BY THE FEDERAL HIGHWAY ADMINISTRATION ON JUNE 15, 2006 FOR USE ON THIS PROJECT, INCLUDING ALL SUBSEQUENT REVISIONS AND SUCH REVISED SPECIFICATIONS AND SPECIAL PROVISIONS AS ARE INCORPORATED IN THESE PLANS.

DIRECTOR OF PROGRAM DEVELOPMENT
APPROVED _____ DATE 5-24-11
PROJECT MANAGER : AMY GAMBLE

PROJECT NAME : ST. ALBANS - BERKSHIRE
PROJECT NUMBER : STPG SIGN (36)

SHEET 1 OF 109 SHEETS

INDEX OF SHEETS

1	TITLE SHEET
2	GENERAL NOTES
3	QUANTITY SHEET
4-7	DETAIL SHEETS 1 - 4
8	ST ALBANS TOWN VT 105 (SEYMOUR RD) EASTBOUND TRAFFIC SIGN SUMMARY SHEET
9-11	ST ALBANS TOWN VT 105 (SEYMOUR RD) WESTBOUND TRAFFIC SIGN SUMMARY SHEETS
12-18	ST ALBANS TOWN VT 105 EASTBOUND TRAFFIC SIGN SUMMARY SHEETS
19-27	ST ALBANS TOWN VT 105 WESTBOUND TRAFFIC SIGN SUMMARY SHEETS
28-29	SWANTON VT 105 EASTBOUND TRAFFIC SIGN SUMMARY SHEETS
30-31	SWANTON VT 105 WESTBOUND TRAFFIC SIGN SUMMARY SHEET
32-48	SHELDON VT 105 EASTBOUND TRAFFIC SIGN SUMMARY SHEETS
49-65	SHELDON VT 105 WESTBOUND TRAFFIC SIGN SUMMARY SHEETS
66-80	ENOSBURG VT 105 EASTBOUND TRAFFIC SIGN SUMMARY SHEETS
81-93	ENOSBURG VT 105 WESTBOUND TRAFFIC SIGN SUMMARY SHEETS
94-100	BERKSHIRE VT 105 EASTBOUND TRAFFIC SIGN SUMMARY SHEETS
101-108	BERKSHIRE VT 105 WESTBOUND TRAFFIC SIGN SUMMARY SHEETS
109	TOWN TOTAL SIGN SUMMARY SHEET

STANDARDS

E-121	STANDARD SIGN PLACEMENT CONVENTIONAL ROAD	08/08/1995
E-136A	U.S. ROUTE MARKER SIGN DETAILS	08/08/1995
E-136B	STATE ROUTE MARKER SIGN DETAILS	08/08/1995
E-136C	STATE NUMBERED TOWN HIGHWAY SIGN DETAILS	08/08/1995
E-138	MILEMARKER DETAILS STATE AND TOWN HIGHWAYS	05/30/2003
E-150	WARNING SIGN DETAILS	05/01/2004
E-153	WARNING SIGN DETAILS	05/01/2004
E-163	TUBULAR STEEL SIGN POST	05/20/1999
E-164	SQUARE STEEL SIGN POST	06/08/2009

SIGN SIZE	12" X 12"		
	18" X 18"		
	21" X 15"		
	24"X 8"		
	24" X 10"		48" X 18"
	24" X 12"	36" X 12"	48" X 24"
	24" X 18"	36" X 15"	48" X 30"
	24" X 24"	36" X 18"	48" X 42"
	24" X 30"	36" X 24"	48" X 48"
	30" X 15"	36" X 36"	48" X 60"
	30" X 18"	36" X 42"	72" X 10"
	30" X 30"	36" X 48"	72" X 12"
	30" X 42"	36" X 54"	72" X 20"
THICKNESS	0.080"	0.100"	0.125"

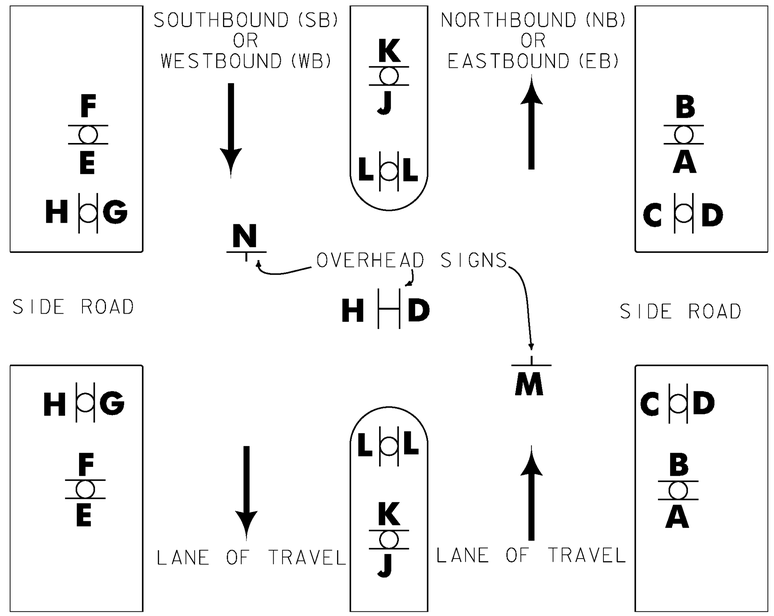

THE TRAFFIC SIGN LOCATION CODES ARE TO BE USED IN CONJUNCTION WITH THE SIGN SUMMARY SHEETS TO ESTABLISH PROPER SIGN INSTALLATION IN THE FIELD.

TRAFFIC SIGN LOCATION CODES

2.5" SOIL BEARING SLIP BASE LOCATIONS

TOWN	MILEPOINT	# SLIP BASES
ST ALBANS (SEYMOUR RD):		
	MP 0.066 WB	2
ST ALBANS:		
	MP 1.329 EB	2
	MP 1.374 EB	2
	MP 1.520 WB	2
	MP 0.038 WB	2
SHELDON:		
	MP 8.700 WB	2
	MP 6.660 WB	2
	MP 4.490 WB	2
	MP 4.320 WB	2
ENOSBURG:		
	MP 0.670 EB	2
BERKSHIRE:		
	MP 0.950 EB	2
	MP 1.110 WB	2
	MP 1.080 WB	2
	MP 1.010 WB	2
	TOTAL:	28

TEMPORARY TRAFFIC CONTROL NOTES

1. THE CONTRACTOR SHALL SUBMIT SITE SPECIFIC TRAFFIC CONTROL PLANS CONFORMING TO THE MANUAL ON UNIFORM TRAFFIC CONTROL DEVICES (MUTCD), DATED 2009, AND ITS LATEST REVISIONS, AT THE PRE-CONSTRUCTION MEETING FOR REVIEW AND APPROVAL BY THE RESIDENT ENGINEER.
2. WHEN WORKING IN THE VICINITY OF EXISTING PEDESTRIAN FACILITIES, ADA ACCESSIBLE PEDESTRIAN ACCOMODATIONS SHALL BE MAINTAINED AT ALL TIMES. PAYMENT SHALL BE INCLUDED IN THE UNIT BID PRICE FOR CONTRACT ITEM 641.10 TRAFFIC CONTROL.
3. THE CONTRACTOR MUST PROVIDE ACCESS THROUGH THE WORK ZONE FOR EMERGENCY VEHICLES AT ALL TIMES.
4. THE CONTRACTOR SHALL CONDUCT THE WORK AT ALL TIMES IN SUCH A MANNER AND IN SUCH SEQUENCE SO AS TO ENSURE THE LEAST INTERFERENCE WITH TRAFFIC OCCURS.
5. SIGNS SHALL ONLY BE VISIBLE TO MOTORISTS AT THE TIMES WHEN THE MESSAGE IS PERTINENT, I.E. A "FLAGGER AHEAD" SIGN SHALL ONLY BE VISIBLE TO MOTORISTS WHEN THE FLAGGER IS ACTUALLY PRESENT PERFORMING THEIR DUTIES.
6. PAYMENT FOR CONSTRUCTION SIGNING WILL BE MADE UNDER CONTRACT ITEM 641.10.
7. SIGNS SHALL BE MOVED AS WORK AREA MOVES. AT NO TIME SHALL THE FLAGGER SIGN BE GREATER THAN 1000 FEET IN ADVANCE OF THE FLAGGER STATION.

PROJECT NAME: ST ALBANS - BERKSHIRE

PROJECT NUMBER: STPG SIGN (36)

FILE NAME: 10B338.DGN
PROJECT LEADER: A. GAMBLE
DESIGNED BY: T. GUAZZONI
GENERAL NOTES

PLOT DATE: $$$$DATE$$$
DRAWN BY: T. GUAZZONI
CHECKED BY: A. GAMBLE
SHEET 2 OF 109

STATE OF VERMONT
AGENCY OF TRANSPORTATION

QUANTITY SHEET 1

SUMMARY OF ESTIMATED QUANTITIES	TOTALS		DESCRIPTIONS				DETAILED SUMMARY OF QUANTITIES		
ROADWAY	GRAND TOTAL	FINAL	UNIT	ITEMS	ITEM NUMBER	ROUND	QUANTITIES	UNIT	ITEMS
5	5		EACH	THINNING AND TRIMMING FOR SIGNS	201.31	EST.			
1	1		CY	TRENCH EXCAVATION OF EARTH, EXPLORATORY (N.A.B.I.)	204.22				
50	50		HR	UNIFORMED TRAFFIC OFFICERS	630.10	EST.			
876	876		HR	FLAGGERS	630.15	EST.			
1	1		LS	MOBILIZATION/DEMOBILIZATION	635.11				
1	1		LS	TRAFFIC CONTROL	641.10				
2800	2800		SF	TRAFFIC SIGNS, TYPE A	675.20	EST.			
839.8	839.8		LB	TUBULAR STEEL SIGN POST	675.33	EST.			
6375	6375		LF	SQUARE TUBE SIGN POST AND ANCHOR	675.341	EST.			
8	8		EACH	FOUNDATION FOR TUBULAR STEEL POST	675.43	EST.			
712	712		EACH	REMOVING SIGNS	675.50	EST.			
42	42		EACH	ERECTING SALVAGED SIGNS	675.60	EST.			
28	28		EACH	SPECIAL PROVISION (SOIL BEARING SLIP BASE)(2 1/2")	900.620	EST.			

PROJECT NAME: ST ALBANS - BERKSHIRE

PROJECT NUMBER: STPG SIGN (36)

FILE NAME: 10B338.DGN
PROJECT LEADER: A. GAMBLE
DESIGNED BY: T. GUAZZONI
QUANTITY SHEET

PLOT DATE: 25-APR-2011
DRAWN BY: T. GUAZZONI
CHECKED BY: A. GAMBLE
SHEET 3 OF 109

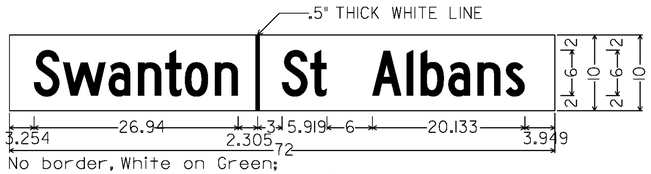

No border, White on Green;
[Swanton] C 2K; [St Albans] C 2K 95) spacing;

VD-024

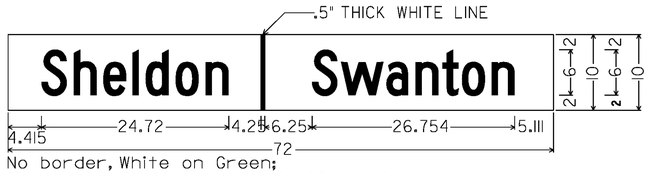

No border, White on Green;
[Sheldon] C 2K; [Swanton] C 2K 95) spacing;

VD-024

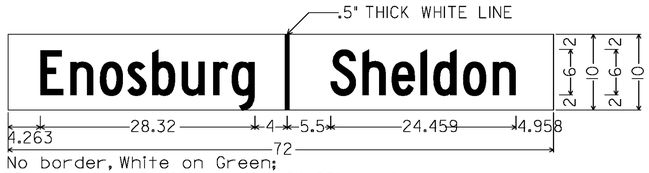

No border, White on Green;
[Enosburg] C 2K; [Sheldon] C 2K 95) spacing;

VD-024

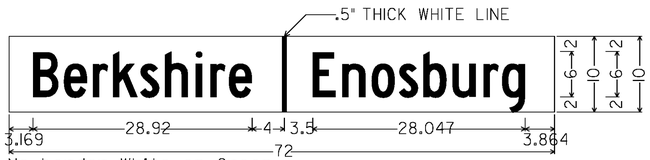

No border, White on Green;
[Berkshire] C 2K; [Enosburg] C 2K 95) spacing;

VD-024

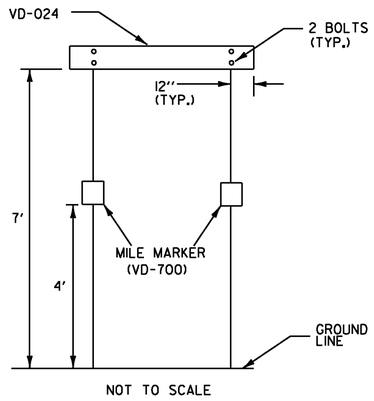

NOT TO SCALE

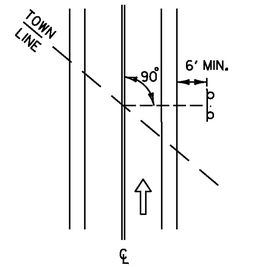

THE SIGN SHALL BE MOUNTED PARALLEL WITH THE ROADWAY, NORMALLY ON RIGHT SIDE TRAVELING WEST TO EAST OR SOUTH TO NORTH.

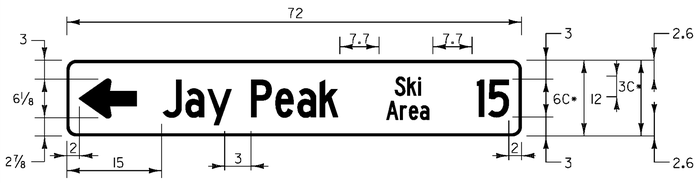

VD1-1S

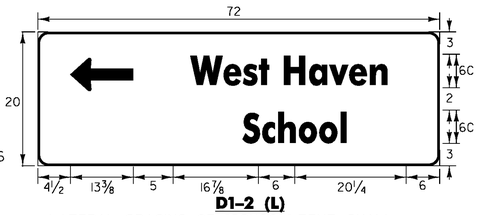

D1-2 (L)

LATERAL SPACING OF "SCHOOL" TEXT SHALL BE CENTERED TO TOP LINE TEXT. WHITE ON GREEN

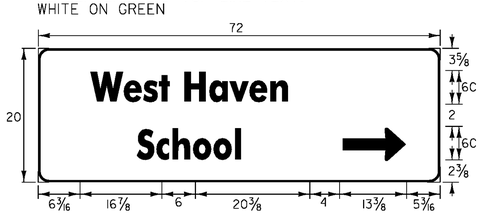

D1-2 (R)

LATERAL SPACING OF "SCHOOL" TEXT SHALL BE CENTERED TO TOP LINE TEXT. WHITE ON GREEN

VD1-1

VD1-1A

VD1-1A

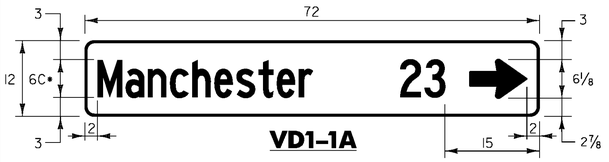

VD1-1A

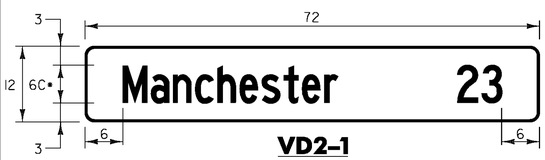

VD2-1

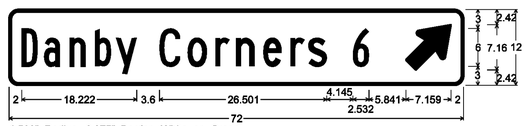

1.500" Radius, 0.375" Border, White on Green;
Standard Arrow Custom 9.000" X 6.125" 45°;

VD1-1A

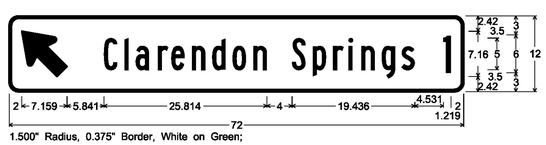

1.500" Radius, 0.375" Border, White on Green;
Standard Arrow Custom 9.000" X 6.125" 135°

VD1-1A

• SEE NOTE 2 BELOW:

STANDARD DESTINATION SIGN NOTES VD1-1, VD1-1A, VD2-1

1.) THE DESTINATION SIGNS SHOWN ON THIS SHEET SHALL HAVE WHITE RETROREFLECTIVE ASTM TYPE III OR IV TEXT, ARROWS AND BORDERS ON A GREEN RETROREFLECTIVE ASTM TYPE III OR IV BACKGROUND.

2.) USE THE LARGEST LETTER / THICKEST FONT AVAILABLE THAT WILL SATISFY THE MINIMUM SPACING REQUIREMENTS, AS SHOWN IN THE DETAILS ABOVE; i.e. IF A 6" SERIES C LETTER DOES NOT WORK, DUE TO THE LENGTH OF THE WORD, USE A 6" SERIES B LETTER. IF A 6" SERIES B LETTER DOES NOT WORK, USE A 5" SERIES C. USE NO LESS THAN 80% KERNING.

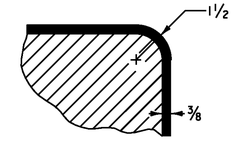

BORDER DETAIL

TRIM CORNERS

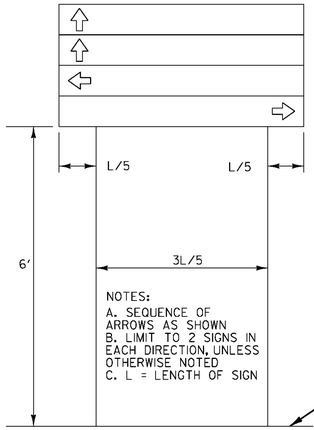

DESTINATION ASSEMBLY

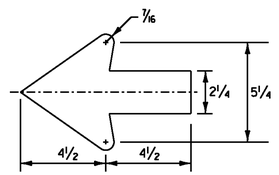

STANDARD SHS 2.25" ARROW

ALL DIMENSIONS SHOWN IN INCHES, EXCEPT WHERE NOTED.

PROJECT NAME: ST ALBANS - BERKSHIRE	
PROJECT NUMBER: STPG SIGN (36)	
FILE NAME: I0B338.DGN	PLOT DATE: $$$$DATE$$$
PROJECT LEADER: A. GAMBLE	DRAWN BY: T. GUAZZONI
DESIGNED BY: T. GUAZZONI	CHECKED BY: A. GAMBLE
DETAIL SHEET I	SHEET 4 OF 109

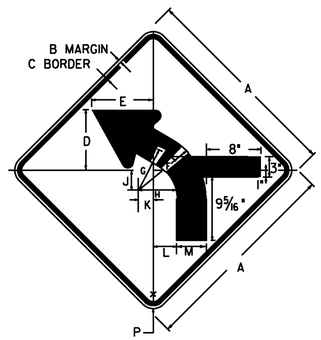

W1-2Mc L(R)

DIMENSIONS NOT SHOWN
FOR THIS DETAIL SHALL CONFORM
TO THE LATEST EDITION OF THE 2009 MUTCD
FOR SIGN DETAIL W1-2.
UNLESS OTHERWISE NOTED FOR THIS DETAIL.
BLACK ON YELLOW

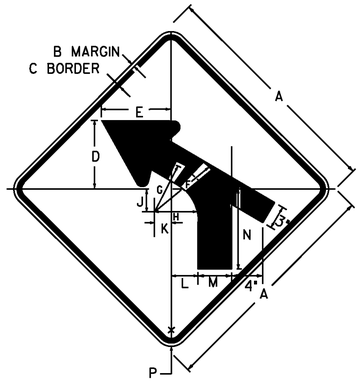

W1-2Mh L(R)

DIMENSIONS NOT SHOWN
FOR THIS DETAIL SHALL CONFORM
TO THE LATEST EDITION OF THE 2009 MUTCD
FOR SIGN DETAIL W1-2.
UNLESS OTHERWISE NOTED FOR THIS DETAIL
BLACK ON YELLOW

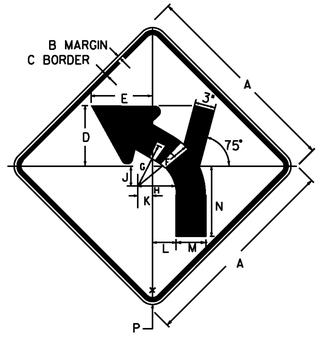

W1-2Mi L(R)

DIMENSIONS NOT SHOWN
FOR THIS DETAIL SHALL CONFORM
TO THE LATEST EDITION OF THE 2009 MUTCD
FOR SIGN DETAIL W1-2.
UNLESS OTHERWISE NOTED FOR THIS DETAIL
BLACK ON YELLOW

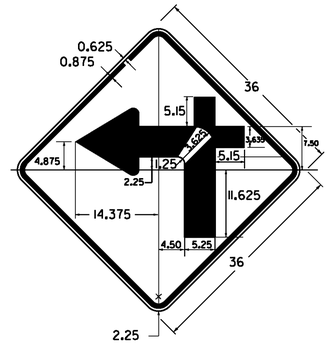

W1-1Mc L(R)

BLACK ON YELLOW

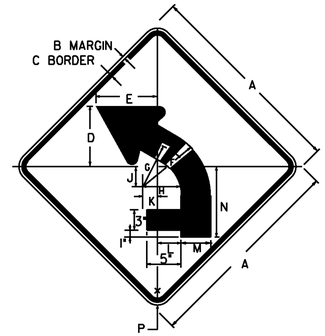

W1-2Mj L(R)

DIMENSIONS NOT SHOWN
FOR THIS DETAIL SHALL CONFORM
TO THE LATEST EDITION OF THE 2009 MUTCD
FOR SIGN DETAIL W1-2.
UNLESS OTHERWISE NOTED FOR THIS DETAIL
BLACK ON YELLOW

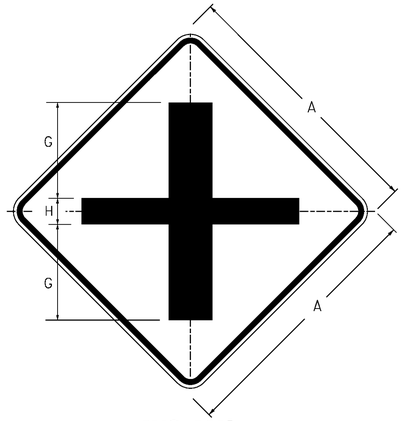

W2-1Mb

DIMENSIONS NOT SHOWN
FOR THIS DETAIL SHALL CONFORM
TO THE LATEST EDITION OF THE 2009 MUTCD
FOR SIGN DETAIL W2-1.
UNLESS OTHERWISE NOTED FOR THIS DETAIL
BLACK ON YELLOW

SIGN	DIMENSIONS (IN)		
	A	G	H
MIN & STD.	30	11	3
SPECIAL	36	13	4

ALL DIMENSIONS SHOWN IN INCHES, EXCEPT WHERE NOTED.

PROJECT NAME: ST ALBANS - BERKSHIRE

PROJECT NUMBER: STPG SIGN (36)

FILE NAME: 10B338.DGN
PROJECT LEADER: A. GAMBLE
DESIGNED BY: T. GUAZZONI
DETAIL SHEET 2

PLOT DATE: $$$$DATE$$$
DRAWN BY: T. GUAZZONI
CHECKED BY: A. GAMBLE
SHEET 5 OF 109

ROUTE MARKER ASSEMBLY FRAMES

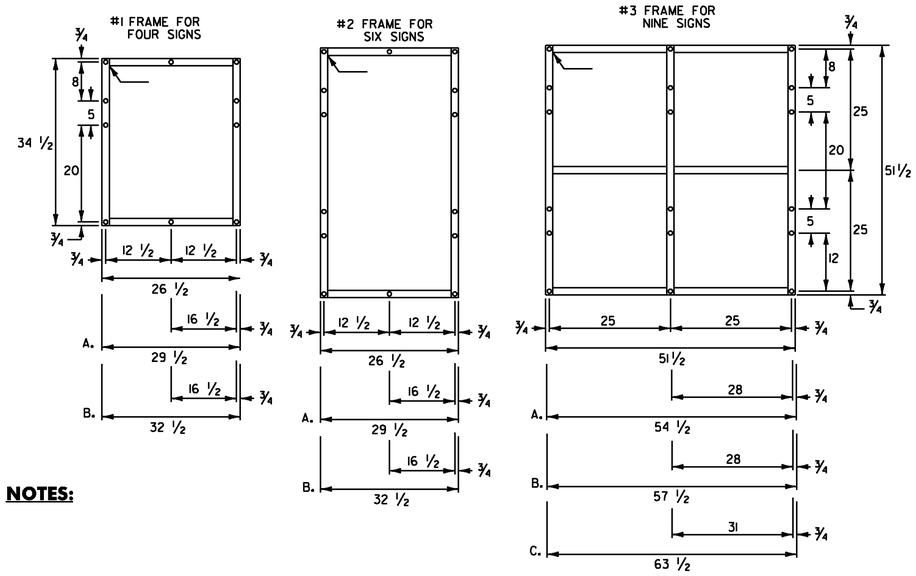

NOTES:

STANDARD MOUNTING OF ROUTE MARKER ASSEMBLIES

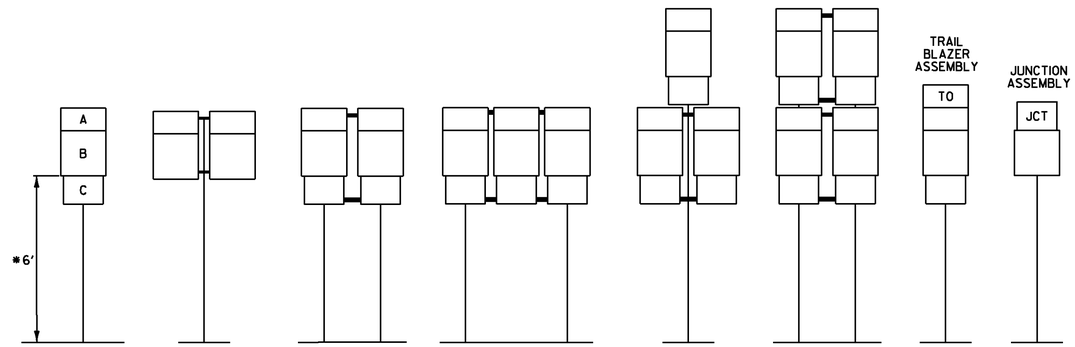

A - CARDINAL DIRECTION MARKER
B - ROUTE NUMBER
C - ADVANCE TURN ARROW OR DIRECTIONAL ARROW

* WHERE PARKING OR PEDESTRIAN TRAFFIC WILL OCCUR IN THE IMMEDIATE VICINITY OF THESE SIGNS MINIMUM VERTICAL CLEARANCE SHALL BE INCREASED TO SEVEN FEET

INSTALLATION SEQUENCE:

IN MULTIPLE HORIZONTAL MOUNTINGS PLACE A ROUTE MARKER ASSEMBLY INDICATING A LEFT TURN ON THE LEFT SIDE OF THE ASSEMBLY; RIGHT TURN ON THE RIGHT SIDE. FOR VERTICALLY STACKED MOUNTINGS PLACE THE STRAIGHT THROUGH MOVE INDICATION ON TOP, THE LEFT OR RIGHT TURNS AS APPROPRIATE BENEATH.

NOTE:
VERTICAL FRAME MEMBERS SHALL LINE UP WITH SIGN POST ON WHICH THEY ARE MOUNTED.

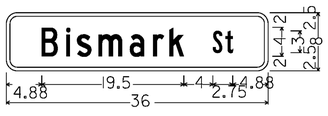

D3-1

D3-1

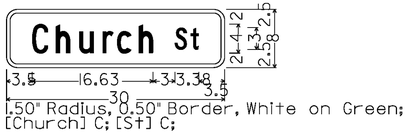

D3-1

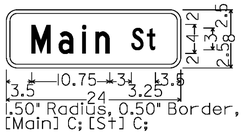

D3-1

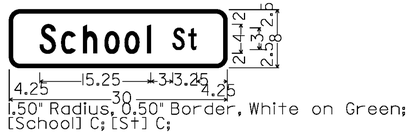

D3-1

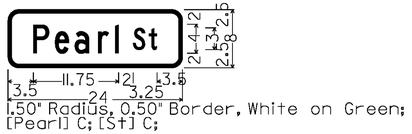

D3-1

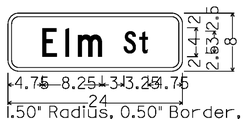

D3-1

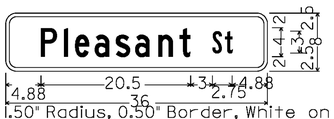

D3-1

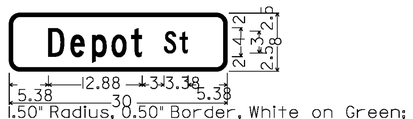

D3-1

ALL DIMENSIONS SHOWN IN INCHES, UNLESS OTHERWISE NOTED.

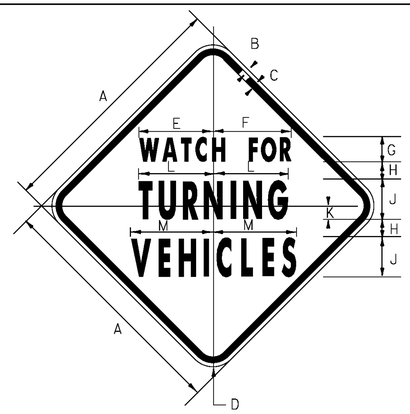

VW-205

BLACK ON YELLOW

SIGN	DIMENSIONS (INCHES)											
	A	B	C	D	E	F	G	H	J	K	L	M
MIN.	30	1/2	3/4	1 7/8	9 5/8	9 3/4	4B	2	5B	2	9 1/4	10 1/4
STD.	36	5/8	7/8	2 1/4	11 3/4	12	4C	2 1/2	5C	2	11 1/2	12 7/8
EXPWY.	48	3/4	1 1/4	3	14 3/4	15 3/8	5C	3 3/8	8B	2 5/8	14 1/8	16 7/8

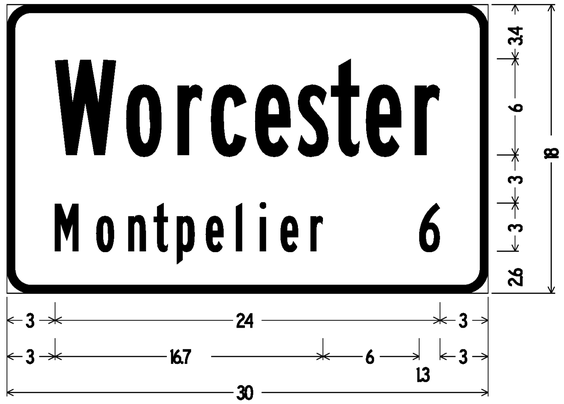

1.5" Radius, 0.5" Border, White on Green;
Worcester B 2K specified length;
Montpelier 6 B 2K specified length;

VD-018

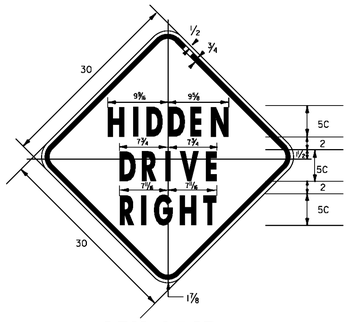

VW-054R

BLACK ON YELLOW

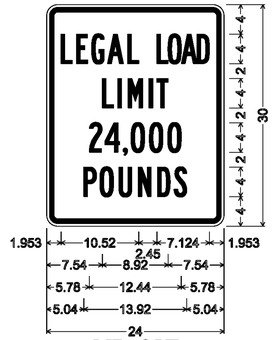

VR-017

1.500" Radius, 0.625" Border, 0.375" Indent, Black on White;
"LEGAL" B 2K " LOAD" Highway B;
"LIMIT" B 2K;
"24,000" B 2K;
"POUNDS" B 2K;

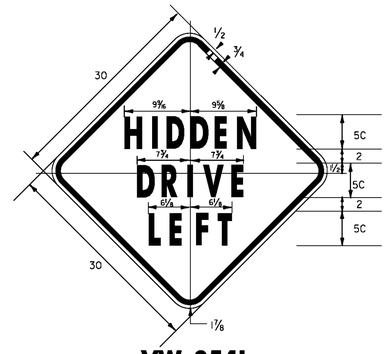

VW-054L

BLACK ON YELLOW

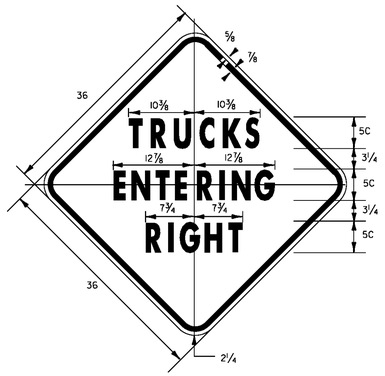

VW-081

BLACK ON YELLOW

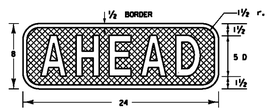

VD-058

WHITE ON BROWN

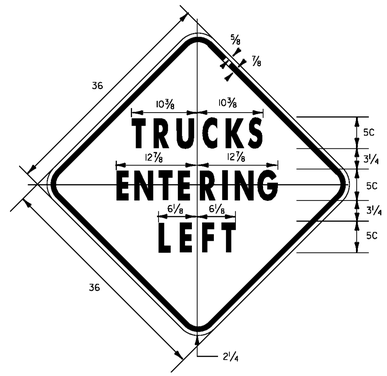

VW-084

BLACK ON YELLOW

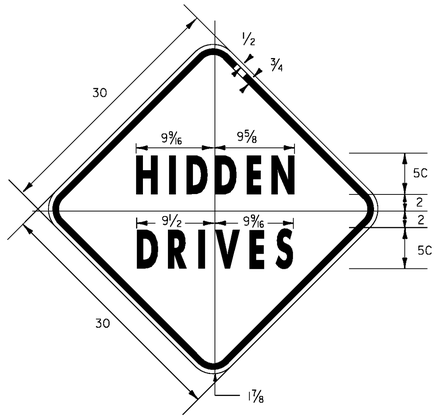

VW-060

BLACK ON YELLOW

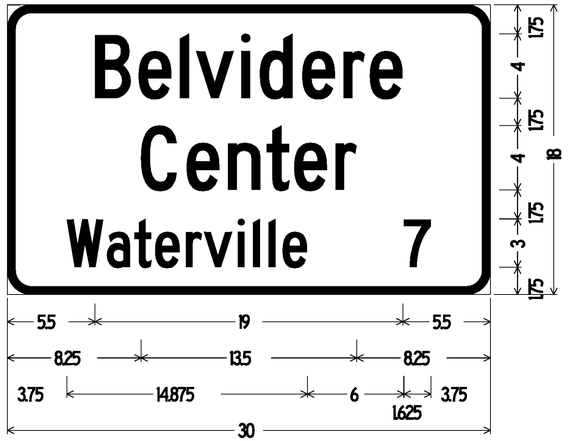

1.500" Radius, 0.500" Border, White on Green;
Belvidere C 2K; Center C 2K;
Waterville 7 C 2K;

VD-018

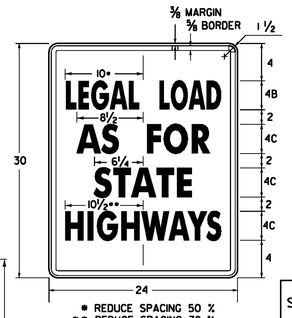

* REDUCE SPACING 50 %
** REDUCE SPACING 38 %

VR-079

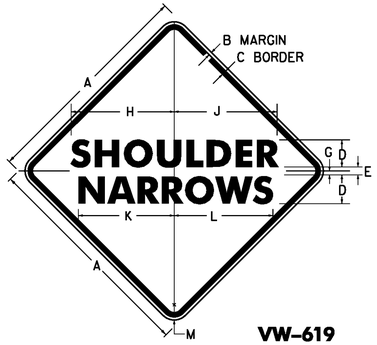

VW-619

SIGN	DIMENSIONS (INCHES)											
	A	B	C	D	E	F	G	H	J	K	L	M
MIN & STD.	36	5/8	7/8	5C	3	6D	I	13 11/16	13 1/16	17 5/8	18 1/4	2 1/4
EXPWY.	48	3/4	1 1/4	7D	3 1/2	7D	I	23 13/16	23 7/8	21 1/2	21 13/16	3

BLACK ON YELLOW

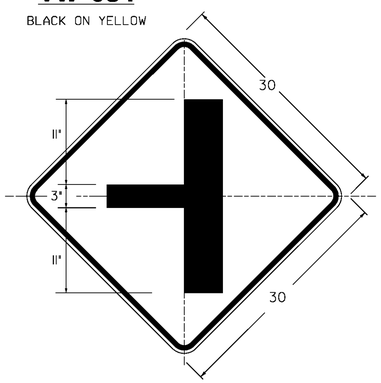

W2-2Ma L(R)

DIMENSIONS NOT SHOWN
FOR THIS DETAIL SHALL CONFORM
TO THE LATEST EDITION OF THE 2009 MUTCD
FOR SIGN DETAIL W2-2.
UNLESS OTHERWISE NOTED FOR THIS DETAIL
BLACK ON YELLOW

1.500" Radius, 0.625" Border, 0.375" Indent, Black on White;
STATE C 2K;
HIGHWAY C 2K;
BEGINS C 2K;

VR-039

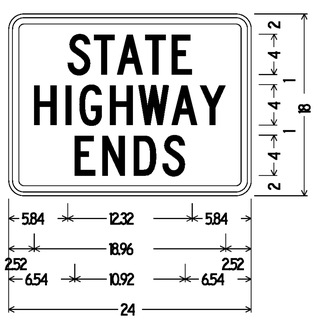

1.500" Radius, 0.625" Border, 0.375" Indent, Black on White;
STATE C 2K;
HIGHWAY C 2K;
ENDS C 2K;

VR-038

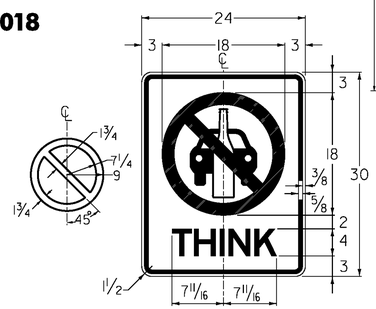

VR-072

TEXT - E FONT - BLACK (NON-REFL.)
CAR & BOTTLE SYMBOL - BLACK (NON-REFL.)
PROHIBITED SYMBOL - RED (NON-REFL.)
BACKGROUND - WHITE (REFL.)

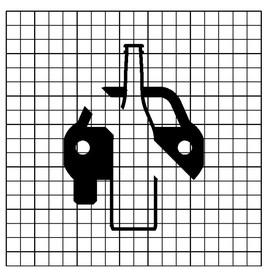

1 SQUARE = 1"

ALL DIMENSIONS SHOWN IN INCHES, EXCEPT WHERE NOTED.

PROJECT NAME:	ST ALBANS - BERKSHIRE
PROJECT NUMBER:	STPG SIGN (36)
FILE NAME: 10B338.DGN	PLOT DATE: $$$$DATE$$$
PROJECT LEADER: A. GAMBLE	DRAWN BY: T. GUAZZONI
DESIGNED BY: T. GUAZZONI	CHECKED BY: A. GAMBLE
DETAIL SHEET 4	SHEET 7 OF 109

DIRECTION	MILEPOINT	LOCATION CODE (SHEET 2)	SIGN CODE	WIDTH (IN)	HEIGHT (IN)	SHEETING REMARKS	SIGN LEGEND	NEW SIGNS		EXISTING SIGNS				EXIST POST		NUMBER OF NEW POSTS	SQUARE STEEL (IN)			TUBULAR STEEL Ø (IN)				SIGN FRAME REQUIRED	REMARKS	SIGN DETAIL LOCATION		
								"A"	"B"	RETAIN	SALVAGE FROM	SALVAGE TO	REMOVE	RETAIN	REMOVE		1.75	2.00	2.50	3.00	3.50	4.00	5.00			SHSM	PROJECT SHEET #	STANDARD SHEET #
																	(LB / FT)			(LB / FT)								
																	1.88	2.42	3.35	7.60	9.00	10.80	14.60					
ST ALBANS VT 105 (SEYMOUR RD)							FY-FLUORESCENT YELLOW FYG-FLUORESCENT YELLOW GREEN																		"SHSM"-STANDARD HIGHWAY SIGNS AND MARKINGS			
EB	0.000	A	VR-079	24	24		LEGAL LOAD AS FOR STATE HIGHWAYS						1		X													
EB	0.035	A	VW-622A	36	36		RECREATIONAL TRAIL						1		X													
		A	VW-622P	24	18		ALL SEASON PLAQUE						1															
EB	0.080	A	R2-1	24	30								1		X													
		A	R2-1	24	30		SPEED LIMIT 40	5.00								1		X								X		
EB	0.095	A	VW-622B	30	30		RECREATIONAL TRAIL						1		X													
		A	W16-5p	UNK	UNK		LEFT DIAGONAL ARROW						1															
		A	W11-15a	30	30		TRAIL CROSSING	6.25								1		X								X		
		A	W16-7pL	24	12			2.00																		X		
EB	0.140	A	R1-1	30	30		MM STOP						~~1~~ 2		~~X~~ 3													
		A	R1-1	30	30			6.25								1		X								X		

SIGN SUMMARY SHEET

VERMONT AGENCY OF TRANSPORTATION

SHEET TOTALS	19.50	0.00	0	0	~~0~~ 2	~~7~~ 9	0	0	3	45.0		0	0.0	0.0	0.0	0.0						
	SF	SF	EA	EA	EA	EA	EA	EA	EA	FT		EA	LB	LB	LB	LB						
TOWN DIRECTIONAL TOTALS	19.5	0.0	0	0	0	7	0	0	3	45.0		0	0.0									

PROJECT NAME: St Albans - Berkshire
PROJECT NUMBER: STPG SIGN(36)

FILE NAME: StAlbansAppEB.xls
PROJECT MANAGER: A. Gamble
DESIGNED BY: T. Guazzoni
ST ALBANS APP EB SHEET 1

PLOT DATE: 5/17/2011
DRAWN BY: T. Guazzoni
CHECKED A. Gamble
SHEET 8 OF 109

DIRECTION	MILEPOINT	LOCATION CODE (SHEET 2)	SIGN CODE	WIDTH (IN)	HEIGHT (IN)	SHEETING REMARKS	SIGN LEGEND	NEW SIGNS "A"	NEW SIGNS "B"	EXISTING SIGNS RETAIN	EXISTING SIGNS SALVAGE FROM	EXISTING SIGNS SALVAGE TO	EXISTING SIGNS REMOVE	EXIST POST RETAIN	EXIST POST REMOVE	NUMBER OF NEW POSTS	SQUARE STEEL (IN) 1.75 (LB/FT) 1.88	SQUARE STEEL (IN) 2.00 (LB/FT) 2.42	SQUARE STEEL (IN) 2.50 (LB/FT) 3.35	TUBULAR STEEL Ø (IN) FOUNDATION	TUBULAR STEEL Ø (IN) 3.00 (LB/FT) 7.60	TUBULAR STEEL Ø (IN) 3.50 (LB/FT) 9.00	TUBULAR STEEL Ø (IN) 4.00 (LB/FT) 10.80	TUBULAR STEEL Ø (IN) 5.00 (LB/FT) 14.60	SIGN FRAME REQUIRED	REMARKS	SIGN DETAIL LOCATION SHSM	SIGN DETAIL LOCATION PROJECT SHEET #	SIGN DETAIL LOCATION STANDARD SHEET #
ST ALBANS VT105 (SEYMOUR RD)							FY-FLUORESCENT YELLOW FYG-FLUORESCENT YELLOW GREEN																			"SHSM"-STANDARD HIGHWAY SIGNS AND MARKINGS			
WB	0.220	F	VW-622A	36	36		RECREATIONAL TRAIL						1		X														
		F	VW-622P	24	18		ALL SEASON PLAQUE						2 ~~1~~																
WB	0.127	F	W3-1	30	30								1		X														
		F	W3-1	30	30		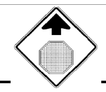	6.25								1		X									X	
WB	0.113	A	VW-622A	36	36		RECREATIONAL TRAIL						1		X														
		A	W1-7	21	15		<---> DOUBLE ARROW						1																
		A	W11-15a	30	30			6.25								1		X									X	
		A	W16-7pL	24	12			2.00																				X	
WB	0.080	G	VR-017	24	30		LEGAL LOAD LIMIT 24000 LBS			1				X													SAMANTHA LN (PVT)			
WB	0.075	H	R1-1	30	30		STOP			1				X													SAMANTHA LN (PVT)			
WB	0.066	F	M3-3	24	12		SOUTH						1		X														
		F	M1-4	24	24		US ROUTE 7						1																
		F	M4-5	24	12		TO						1																
		F	M3-3	24	12		SOUTH						1																
		F	M1-1	24	24		INTERSTATE 89						1																
							SHEET TOTALS	14.50	0.00	2	0	0	10	0	0	2		30.0			0	0.0	0.0	0.0	0.0				
								SF	SF	EA	EA	EA	EA	EA	EA	EA		FT			EA	LB	LB	LB	LB				
							TOWN DIRECTIONAL TOTALS	45.3	0.0	2	0	0	18	0	0	5		75.0			0	0.0							

SIGN SUMMARY SHEET

VERMONT AGENCY OF TRANSPORTATION

PROJECT NAME: **St Albans - Berkshire**
PROJECT NUMBER: **STPG SIGN(36)**

FILE NAME: **StAlbansAppWB.xls** PLOT DATE: **5/17/2011**
PROJECT MANAGER: **A. Gamble** DRAWN BY: **T. Guazzoni**
DESIGNED BY: **T. Guazzoni** CHECKED **A. Gamble**
ST ALBANS APP WB SHEET 1 SHEET **9** OF **109**

DIRECTION	MILEPOINT	LOCATION CODE (SHEET 2)	SIGN CODE	WIDTH (IN)	HEIGHT (IN)	SHEETING REMARKS	SIGN LEGEND	NEW SIGNS "A"	NEW SIGNS "B"	EXISTING SIGNS RETAIN	EXISTING SIGNS SALVAGE FROM	EXISTING SIGNS SALVAGE TO	EXISTING SIGNS REMOVE	EXIST POST RETAIN	EXIST POST REMOVE	NUMBER OF NEW POSTS	SQUARE STEEL (IN) 1.75 (LB / FT) 1.88	SQUARE STEEL (IN) 2.00 (LB / FT) 2.42	SQUARE STEEL (IN) 2.50 (LB / FT) 3.35	FOUNDATION	TUBULAR STEEL Ø (IN) 3.00 (LB / FT) 7.60	TUBULAR STEEL Ø (IN) 3.50 (LB / FT) SLIP BASE ~~9.00~~	TUBULAR STEEL Ø (IN) 4.00 (LB / FT) 10.80	TUBULAR STEEL Ø (IN) 5.00 (LB / FT) 14.60	SIGN FRAME REQUIRED	REMARKS	SIGN DETAIL LOCATION SHSM	SIGN DETAIL LOCATION PROJECT SHEET #	SIGN DETAIL LOCATION STANDARD SHEET #
ST ALBANS VT105 (SEYMOUR RD)							FY-FLUORESCENT YELLOW FYG-FLUORESCENT YELLOW GREEN																			"SHSM"-STANDARD HIGHWAY SIGNS AND MARKINGS			
		F	M6-1	21	15		LEFT						1															
		F	M3-1	24	12		NORTH						1															
		F	M1-4	24	24		US ROUTE 7						1															
		F	M4-5	24	12		TO						1															
		F	M3-1	24	12		NORTH						1															
		F	M1-1	24	24		INTERSTATE 89						1															
		F	M6-1	21	15		RIGHT						1															
		F	M3-3	24	12			2.00								2			X			2				#3	BLACK ON WHITE. INSTALL ASSEMBLY ON 2 1/2" SLIP BASES	X	6	
		F	M1-4	24	24			4.00																				E-136A
		F	M6-1L	21	15			2.19																			BLACK ON WHITE	X		
		F	M3-1	24	12			2.00																			BLACK ON WHITE	X		
		F	M1-4	24	24			4.00																				E-136A
		F	M6-1R	21	15		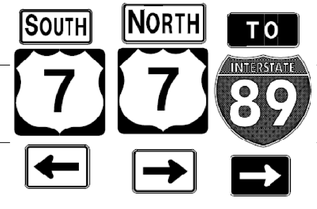	2.19																			BLACK ON WHITE	X		
		F	M4-5	24	12			2.00																			WHITE ON BLUE	X		
		F	M1-1	24	24			4.00																				X		
							SHEET TOTALS	22.38	0.00	0	0	0	7	0	0	2		30.0			0	0.0	~~0.0~~ 2	0.0	0.0				
								SF	SF	EA	EA	EA	EA	EA	EA	EA		FT			EA	LB	LB	LB	LB				
							TOWN DIRECTIONAL TOTALS	45.3	0.0	2	0	0	18	0	0	5		75.0			0	0.0							

SIGN SUMMARY SHEET

VERMONT AGENCY OF TRANSPORTATION

PROJECT NAME: St Albans - Berkshire
PROJECT NUMBER: STPG SIGN(36)

FILE NAME: StAlbansAppWB.xls
PROJECT MANAGER: A. Gamble
DESIGNED BY: T. Guazzoni
ST ALBANS APP WB SHEET 2

PLOT DATE: 5/17/2011
DRAWN BY: T. Guazzoni
CHECKED A. Gamble
SHEET 10 OF 109

DIRECTION	MILEPOINT	LOCATION CODE (SHEET 2)	SIGN CODE	WIDTH (IN)	HEIGHT (IN)	SHEETING REMARKS	SIGN LEGEND	NEW SIGNS "A"	NEW SIGNS "B"	EXISTING SIGNS RETAIN	EXISTING SIGNS SALVAGE FROM	EXISTING SIGNS SALVAGE TO	EXISTING SIGNS REMOVE	EXIST POST RETAIN	EXIST POST REMOVE	NUMBER OF NEW POSTS	SQUARE STEEL (IN) 1.75 (LB / FT) 1.88	SQUARE STEEL (IN) 2.00 (LB / FT) 2.42	SQUARE STEEL (IN) 2.50 (LB / FT) 3.35	TUBULAR STEEL Ø (IN) FOUNDATION	TUBULAR STEEL Ø (IN) 3.00 (LB / FT) 7.60	TUBULAR STEEL Ø (IN) 3.50 (LB / FT) 9.00	TUBULAR STEEL Ø (IN) 4.00 (LB / FT) 10.80	TUBULAR STEEL Ø (IN) 5.00 (LB / FT) 14.60	SIGN FRAME REQUIRED	REMARKS	SIGN DETAIL LOCATION SHSM	SIGN DETAIL LOCATION PROJECT SHEET #	SIGN DETAIL LOCATION STANDARD SHEET #
ST ALBANS VT105 (SEYMOUR RD)							FY-FLUORESCENT YELLOW FYG-FLUORESCENT YELLOW GREEN																			"SHSM"-STANDARD HIGHWAY SIGNS AND MARKINGS			
		F	M6-1R	21	15			2.19																		WHITE ON BLUE	X		
WB	0.007	F	R1-1	30	30								~~1~~ 2		X													
		F	R1-1	30	30		STOP	6.25								1		X									X		

DIRECTION	MILEPOINT	LOCATION CODE (SHEET 2)	SIGN CODE	WIDTH (IN)	HEIGHT (IN)	SHEETING REMARKS	SIGN LEGEND	NEW SIGNS		EXISTING SIGNS				EXIST POST		NUMBER OF NEW POSTS	SQUARE STEEL (IN)			TUBULAR STEEL Ø (IN)				SIGN FRAME REQUIRED	REMARKS	SIGN DETAIL LOCATION		
								"A"	"B"	RETAIN	SALVAGE FROM	SALVAGE TO	REMOVE	RETAIN	REMOVE		1.75	2.00	2.50	3.00	3.50	4.00	5.00			SHSM	PROJECT SHEET #	STANDARD SHEET #
																	(LB / FT)			(LB / FT)								
																	1.88	2.42	3.35	7.60	9.00	10.80	14.60					
ST ALBANS TOWN VT105 EB							FY-FLUORESCENT YELLOW FYG-FLUORESCENT YELLOW GREEN																		"SHSM"-STANDARD HIGHWAY SIGNS AND MARKINGS			
EB	0.000	A	VR-041	24	24		THROUGHWAY BEGINS HERE						1		X													
		A	VR-039	24	18								1															
		B	VR-040	24	18		THROUGHWAY ENDS HERE						1															
		B	VR-038	24	18								1															
		A	VR-039	24	18		STATE HIGHWAY ENDS BACK TO BACK STATE HIGHWAY BEGINS	3.00								1		X									7	
		A	R2-1	24	30		SPEED LIMIT 40	5.00																		X		
		B	VR-038	24	18			3.00																			7	
EB	0.022	A	R2-1	24	30		SPEED LIMIT 40						1		X													
EB	0.039	A	M3-2	24	12								1		X													
		A	M1-5	30	24								1															
		A	M3-2	24	12		EAST VERMONT 105	2.00								1		X							GREEN ON WHITE	X		
		A	M1-5	30	24			5.00																				E-136B
EB	0.089	A	W1-10R	30	30		MODIFIED RIGHT CURVE W/SIDEROAD						1		X													
		A	W13-1	18	18		35 MPH ADVISORY PLAQUE						1															
EB	0.110	B	W3-1	36	36								1		X													
SIGN SUMMARY SHEET							SHEET TOTALS	18.00	0.00	0	0	0	10	0	0	2		30.0		0	0.0	0.0	0.0	0.0					
								SF	SF	EA	EA	EA	EA	EA	EA	EA		FT		EA	LB	LB	LB	LB					
VERMONT AGENCY OF TRANSPORTATION							TOWN DIRECTIONAL TOTALS	215.5	0.0	0	0	0	47	0	0	32		480.0		0	0.0								

PROJECT NAME: **St Albans - Berkshire**
PROJECT NUMBER: **STPG SIGN(36)**

FILE NAME: **St. Albans EB.xls** PLOT DATE: **5/17/2011**
PROJECT MANAGER: **A. Gamble** DRAWN BY: **T. Guazzoni**
DESIGNED BY: **T. Guazzoni** CHECKED **A. Gamble**
ST ALBANS TOWN EB SHEET 1 SHEET **12** OF **109**

DIRECTION	MILEPOINT	LOCATION CODE (SHEET 2)	SIGN CODE	WIDTH (IN)	HEIGHT (IN)	SHEETING REMARKS	SIGN LEGEND	NEW SIGNS "A"	NEW SIGNS "B"	EXISTING SIGNS RETAIN	EXISTING SIGNS SALVAGE FROM	EXISTING SIGNS SALVAGE TO	EXISTING SIGNS REMOVE	EXIST POST RETAIN	EXIST POST REMOVE	NUMBER OF NEW POSTS	SQUARE STEEL (IN) 1.75 (LB / FT) 1.88	SQUARE STEEL (IN) 2.00 (LB / FT) 2.42	SQUARE STEEL (IN) 2.50 (LB / FT) 3.35	TUBULAR STEEL Ø (IN) FOUNDATION	TUBULAR STEEL Ø (IN) 3.00 (LB / FT) 7.60	TUBULAR STEEL Ø (IN) 3.50 (LB / FT) 9.00	TUBULAR STEEL Ø (IN) 4.00 (LB / FT) 10.80	TUBULAR STEEL Ø (IN) 5.00 (LB / FT) 14.60	SIGN FRAME REQUIRED	REMARKS	SIGN DETAIL LOCATION SHSM	SIGN DETAIL LOCATION PROJECT SHEET #	SIGN DETAIL LOCATION STANDARD SHEET #
ST ALBANS TOWN VT105 EB							FY-FLUORESCENT YELLOW FYG-FLUORESCENT YELLOW GREEN																			"SHSM"-STANDARD HIGHWAY SIGNS AND MARKINGS			
		B	W3-1	30	30		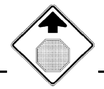	6.25								1		X									X		
EB	0.154	A	W1-2MhR	36	36			9.00								2		X								INSTALL 340' +/- EAST OF EXISTING ASSEMBLY		5	
		A	W13-1	18	18			2.25																		INSTALL ON LEFT POST	X		
EB	0.304	A	M3-2	24	12								1		X														
		A	M1-5	30	24								1																
		A	M3-2	24	12			2.00								1		X								GREEN ON WHITE	X		
		A	M1-5	30	24			5.00																					E-136B
EB	0.319	C	VR-017	24	30		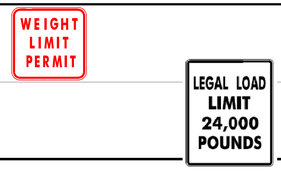					I	2 ~~1~~		X														
		C	VR-017	24	30			5.00								1		X								HIGH ST (TH-7)		7	
EB	0.324	D	R1-1	30	30								1		X														
		D	R1-1	30	30			6.25								1		X								HIGH ST (TH-7)	X		
EB	0.369	A	D2-1	72	10								1		X														
		A	D2-1	72	10								1																
		A	VD2-1	72	12		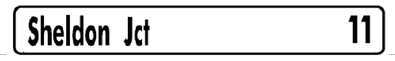	6.00								2		X										4	
		A	VD2-1	72	12			6.00																				4	
SIGN SUMMARY SHEET							SHEET TOTALS	47.75	0.00	0	0	I ~~0~~	7 ~~6~~	0	0	8		120.0		0	0.0	0.0	0.0	0.0					
								SF	SF	EA	EA	EA	EA	EA	EA	EA		FT		EA	LB	LB	LB	LB					
VERMONT AGENCY OF TRANSPORTATION							TOWN DIRECTIONAL TOTALS	215.5	0.0	0	0	0	47	0	0	32		480.0		0	0.0								

PROJECT NAME: **St Albans - Berkshire**
PROJECT NUMBER: **STPG SIGN(36)**

FILE NAME: **St. Albans EB.xls** PLOT DATE: **5/17/2011**
PROJECT MANAGER: **A. Gamble** DRAWN BY: **T. Guazzoni**
DESIGNED BY: **T. Guazzoni** CHECKED **A. Gamble**
ST ALBANS TOWN EB SHEET 2 SHEET **13** OF **109**

DIRECTION	MILEPOINT	LOCATION CODE (SHEET 2)	SIGN CODE	WIDTH (IN)	HEIGHT (IN)	SHEETING REMARKS	SIGN LEGEND	NEW SIGNS "A"	NEW SIGNS "B"	EXISTING SIGNS RETAIN	EXISTING SIGNS SALVAGE FROM	EXISTING SIGNS SALVAGE TO	EXISTING SIGNS REMOVE	EXIST POST RETAIN	EXIST POST REMOVE	NUMBER OF NEW POSTS	SQUARE STEEL (IN) 1.75 (LB / FT) 1.88	SQUARE STEEL (IN) 2.00 (LB / FT) 2.42	SQUARE STEEL (IN) 2.50 (LB / FT) 3.35	TUBULAR STEEL Ø (IN) FOUNDATION	TUBULAR STEEL Ø (IN) 3.00 (LB / FT) 7.60	TUBULAR STEEL Ø (IN) 3.50 (LB / FT) 9.00	TUBULAR STEEL Ø (IN) 4.00 (LB / FT) 10.80	TUBULAR STEEL Ø (IN) 5.00 (LB / FT) 14.60	SIGN FRAME REQUIRED	REMARKS	SIGN DETAIL LOCATION SHSM	SIGN DETAIL LOCATION PROJECT SHEET #	SIGN DETAIL LOCATION STANDARD SHEET #
ST ALBANS TOWN VT105 EB							FY-FLUORESCENT YELLOW FYG-FLUORESCENT YELLOW GREEN																			"SHSM"-STANDARD HIGHWAY SIGNS AND MARKINGS			
EB	0.424	A	R2-1	24	30								1		X													
		A	R2-1	24	30			5.00								1		X									X		
EB	0.520	A	VW-205	30	30								1		X													
		A	VW-205	36	36			9.00								2		X										7	
EB	0.624	A	VW-092	30	30								1		X													
		A	VW-092	36	36			9.00								2		X											E-150
EB	0.969	A	R2-1	24	30								1		X													
		A	R2-1	24	30			5.00								1		X									X		
EB	1.214	A	M2-1	21	15								1		X													
		A	M1-5	30	24								1															
		A	M2-1	21	15			2.19								1		X								GREEN ON WHITE	X		
		A	M1-5	30	24			5.00																					E-136B
EB	1.249	A	W3-3	36	36								1		X													
		A	W3-3	30	30		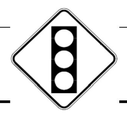	6.25								1		X									X		
EB	1.289	A	W11-4	30	30								1		X													
SIGN SUMMARY SHEET							SHEET TOTALS	41.44	0.00	0	0	0	8	0	0	8		120.0		0	0.0	0.0	0.0	0.0					
								SF	SF	EA	EA	EA	EA	EA	EA	EA		FT		EA	LB	LB	LB	LB					
VERMONT AGENCY OF TRANSPORTATION							TOWN DIRECTIONAL TOTALS	215.5	0.0	0	0	0	47	0	0	32		480.0		0		0.0							

PROJECT NAME: **St Albans - Berkshire**
PROJECT NUMBER: **STPG SIGN(36)**
FILE NAME: **St. Albans EB.xls** PLOT DATE: **5/17/2011**
PROJECT MANAGER: **A. Gamble** DRAWN BY: **T. Guazzoni**
DESIGNED BY: **T. Guazzoni** CHECKED **A. Gamble**
ST ALBANS TOWN EB SHEET 3 SHEET **14** OF **109**

DIRECTION	MILEPOINT	LOCATION CODE (SHEET 2)	SIGN CODE	WIDTH (IN)	HEIGHT (IN)	SHEETING REMARKS	SIGN LEGEND	NEW SIGNS "A"	NEW SIGNS "B"	EXISTING SIGNS RETAIN	EXISTING SIGNS SALVAGE FROM	EXISTING SIGNS SALVAGE TO	EXISTING SIGNS REMOVE	EXIST POST RETAIN	EXIST POST REMOVE	NUMBER OF NEW POSTS	SQUARE STEEL (IN) 1.75 (LB / FT) 1.88	SQUARE STEEL (IN) 2.00 (LB / FT) 2.42	SQUARE STEEL (IN) 2.50 (LB / FT) 3.35	TUBULAR STEEL Ø (IN) FOUNDATION	TUBULAR STEEL Ø (IN) 3.00 (LB / FT) 7.60	TUBULAR STEEL Ø (IN) 3.50 (LB / FT) SLIP BASE ~~9.00~~	TUBULAR STEEL Ø (IN) 4.00 (LB / FT) 10.80	TUBULAR STEEL Ø (IN) 5.00 (LB / FT) 14.60	SIGN FRAME REQUIRED	REMARKS	SIGN DETAIL LOCATION SHSM	SIGN DETAIL LOCATION PROJECT SHEET #	SIGN DETAIL LOCATION STANDARD SHEET #
ST ALBANS TOWN VT105 EB							FY-FLUORESCENT YELLOW FYG-FLUORESCENT YELLOW GREEN																			"SHSM"-STANDARD HIGHWAY SIGNS AND MARKINGS			
		A	W11-4	30	30			6.25								1		X									X		
EB	1.329	A	D1-1A	72	10								1		X														
		A	D1-1A	72	10								1																
		A	D1-1A	72	10								1																
		A	D1-1A	72	10								1																
		A	VD1-1A	72	12			6.00								2			X			2				INSTALL ON 2 1/2" SLIP BASES		4	
		A	VD1-1A	72	12		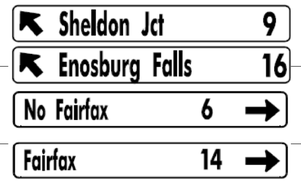	6.00																				4	
		A	VD1-1A	72	12			6.00																				4	
		A	VD1-1A	72	12			6.00																				4	
EB	1.374	A	M3-2	24	12		ROUTE MARKER ASSEMBLY (9)						1		X														
		A	M1-5	30	24								1																
		A	M6-2	21	15								1																
		A	M3-3	24	12								1																
		A	M1-5	30	24								1																
		A	M6-1	21	15								1																
SIGN SUMMARY SHEET							SHEET TOTALS	30.25	0.00	0	0	0	10	0	0	3		45.0		0	0.0	0.0	0.0	0.0					
								SF	SF	EA	EA	EA	EA	EA	EA	EA		FT		EA	LB	LB	LB	LB					
VERMONT AGENCY OF TRANSPORTATION							TOWN DIRECTIONAL TOTALS	215.5	0.0	0	0	0	47	0	0	32		480.0		0	0.0								

PROJECT NAME: **St Albans - Berkshire**
PROJECT NUMBER: **STPG SIGN(36)**

FILE NAME: **St. Albans EB.xls**
PROJECT MANAGER: **A. Gamble**
DESIGNED BY: **T. Guazzoni**
ST ALBANS TOWN EB SHEET 4

PLOT DATE: **5/17/2011**
DRAWN BY: **T. Guazzoni**
CHECKED **A. Gamble**
SHEET **15** OF **109**

DIRECTION	MILEPOINT	LOCATION CODE (SHEET 2)	SIGN CODE	WIDTH (IN)	HEIGHT (IN)	SHEETING REMARKS	SIGN LEGEND	NEW SIGNS "A"	NEW SIGNS "B"	EXISTING SIGNS RETAIN	EXISTING SIGNS SALVAGE FROM	EXISTING SIGNS SALVAGE TO	EXISTING SIGNS REMOVE	EXIST POST RETAIN	EXIST POST REMOVE	NUMBER OF NEW POSTS	SQUARE STEEL (IN) (LB / FT) 1.75 / 1.88	SQUARE STEEL (IN) (LB / FT) 2.00 / 2.42	SQUARE STEEL (IN) (LB / FT) 2.50 / 3.35	TUBULAR STEEL Ø (IN) FOUNDATION	TUBULAR STEEL Ø (IN) (LB / FT) 3.00 / 7.60	TUBULAR STEEL Ø (IN) (LB / FT) 3.50 SLIP BASE / ~~9.00~~	TUBULAR STEEL Ø (IN) (LB / FT) 4.00 / 10.80	TUBULAR STEEL Ø (IN) (LB / FT) 5.00 / 14.60	SIGN FRAME REQUIRED	REMARKS	SIGN DETAIL LOCATION SHSM	SIGN DETAIL LOCATION PROJECT SHEET #	SIGN DETAIL LOCATION STANDARD SHEET #
ST ALBANS TOWN VT105 EB							FY-FLUORESCENT YELLOW FYG-FLUORESCENT YELLOW GREEN																			"SHSM"-STANDARD HIGHWAY SIGNS AND MARKINGS			
		A	M4-5	24	12								1															
		A	M1-1	24	24								1															
		A	M6-1	21	15								1															
		A	M3-2	24	12			2.00								2			X			2			#3B	GREEN ON WHITE. INSTALL ON 2 1/2" SLIP BASES	X	6	
		A	M1-5	30	24			5.00																				E-136B
		A	M6-2L	21	15			2.19																		GREEN ON WHITE	X		
		A	M3-3	24	12			2.00																		GREEN ON WHITE	X		
		A	M1-5	30	24			5.00																				E-136B
		A	M6-1R	21	15			2.19																		GREEN ON WHITE	X		
		A	M4-5	24	12			2.00																		WHITE ON BLUE	X		
		A	M1-1	24	24			4.00																			X		
		A	M6-1R	21	15			2.19																		WHITE ON BLUE	X		
EB	1.434	A	R2-1	24	30			5.00								1			X							INSTALL SIGN 160' +/- WEST OF ROUTE MARKER ASSEMBLY	X		
EB	1.464	A	M3-2	24	12								1		X													
		A	M1-5	30	24								1															

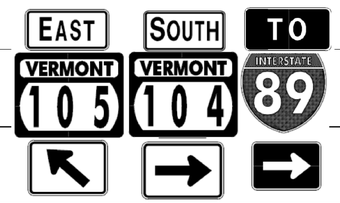

SIGN SUMMARY SHEET	SHEET TOTALS	31.57	0.00	0	0	0	5	0	0	3		45.0		0	0.0	~~0.0~~ 2	0.0	0.0										
		SF	SF	EA	EA	EA	EA	EA	EA	EA		FT		EA	LB	LB	LB	LB										
VERMONT AGENCY OF TRANSPORTATION	TOWN DIRECTIONAL TOTALS	215.5	0.0	0	0	0	47	0	0	32		480.0		0		0.0												

PROJECT NAME: **St Albans - Berkshire**
PROJECT NUMBER: **STPG SIGN(36)**
FILE NAME: **St. Albans EB.xls**
PROJECT MANAGER: **A. Gamble**
DESIGNED BY: **T. Guazzoni**
PLOT DATE: **5/17/2011**
DRAWN BY: **T. Guazzoni**
CHECKED **A. Gamble**
ST ALBANS TOWN EB SHEET 5
SHEET **16** OF **109**

DIRECTION	MILEPOINT	LOCATION CODE (SHEET 2)	SIGN CODE	WIDTH (IN)	HEIGHT (IN)	SHEETING REMARKS	SIGN LEGEND	NEW SIGNS "A"	NEW SIGNS "B"	EXISTING SIGNS RETAIN	EXISTING SIGNS SALVAGE FROM	EXISTING SIGNS SALVAGE TO	EXISTING SIGNS REMOVE	EXIST POST RETAIN	EXIST POST REMOVE	NUMBER OF NEW POSTS	SQUARE STEEL (IN) 1.75 (LB / FT) 1.88	SQUARE STEEL (IN) 2.00 (LB / FT) 2.42	SQUARE STEEL (IN) 2.50 (LB / FT) 3.35	TUBULAR STEEL Ø (IN) FOUNDATION	TUBULAR STEEL Ø (IN) 3.00 (LB / FT) 7.60	TUBULAR STEEL Ø (IN) 3.50 (LB / FT) 9.00	TUBULAR STEEL Ø (IN) 4.00 (LB / FT) 10.80	TUBULAR STEEL Ø (IN) 5.00 (LB / FT) 14.60	SIGN FRAME REQUIRED	REMARKS	SIGN DETAIL LOCATION SHSM	SIGN DETAIL LOCATION PROJECT SHEET #	SIGN DETAIL LOCATION STANDARD SHEET #
ST ALBANS TOWN VT105 EB							FY-FLUORESCENT YELLOW FYG-FLUORESCENT YELLOW GREEN																			"SHSM"-STANDARD HIGHWAY SIGNS AND MARKINGS			
		A	M3-2	24	12			2.00								1		X							GREEN ON WHITE	X		
		A	M1-5	30	24			5.00																					E-136B
EB	1.509	A	D2-1	72	10								1		X														
		A	D2-1	72	10								1																
		A	VD2-1	72	12		Sheldon Jct 9	6.00								2		X										4	
		A	VD2-1	72	12		Enosburg Falls 16	6.00																				4	
EB	1.540	A	R2-1	24	30		SPEED LIMIT 50						1		X														
EB	1.625	C	VR-017	24	30								1		X															
		C	VR-017	24	30			5.00								1		X									BUSHEY DR (TH-59)		7	
EB	1.630	D	R1-1	30	30		MM BUSHEY DR					2	3 ~~1~~		X														
		D	R1-1	30	30			6.25								1		X								BUSHEY DR (TH-59)	X		
EB	1.820	A	R2-1	24	30								1		X														
		A	R2-1	24	30			5.00								1		X										X	
EB	1.835	C	VR-017	24	30								1		X														
		C	VR-017	24	30			5.00								1		X									LEBEL DR (TH-60)		7	
							SHEET TOTALS	40.25	0.00	0	0	2 ~~0~~	9 ~~7~~	0	0	7		105.0		0	0.0	0.0	0.0	0.0				
								SF	SF	EA	EA	EA	EA	EA	EA	EA		FT		EA	LB	LB	LB	LB				
							TOWN DIRECTIONAL TOTALS	215.5	0.0	0	0	0	47	0	0	32		480.0		0	0.0							

SIGN SUMMARY SHEET

VERMONT AGENCY OF TRANSPORTATION

PROJECT NAME: **St Albans - Berkshire**
PROJECT NUMBER: **STPG SIGN(36)**

FILE NAME: **St. Albans EB.xls**
PROJECT MANAGER: **A. Gamble**
DESIGNED BY: **T. Guazzoni**
ST ALBANS TOWN EB SHEET 6

PLOT DATE: **5/17/2011**
DRAWN BY: **T. Guazzoni**
CHECKED **A. Gamble**
SHEET **17** OF **109**

DIRECTION	MILEPOINT	LOCATION CODE (SHEET 2)	SIGN CODE	WIDTH (IN)	HEIGHT (IN)	SHEETING REMARKS	SIGN LEGEND	NEW SIGNS		EXISTING SIGNS				EXIST POST		NUMBER OF NEW POSTS	SQUARE STEEL (IN)			TUBULAR STEEL Ø (IN)				SIGN FRAME REQUIRED	REMARKS	SIGN DETAIL LOCATION		
								"A"	"B"	RETAIN	SALVAGE FROM	SALVAGE TO	REMOVE	RETAIN	REMOVE		1.75	2.00	2.50	3.00	3.50	4.00	5.00			SHSM	PROJECT SHEET #	STANDARD SHEET #
																	(LB / FT)			(LB / FT)								
																	1.88	2.42	3.35	FOUNDATION	7.60	9.00	10.80	14.60					
ST ALBANS TOWN VT105 EB							FY-FLUORESCENT YELLOW FYG-FLUORESCENT YELLOW GREEN																		"SHSM"-STANDARD HIGHWAY SIGNS AND MARKINGS			
EB	1.840	D	R1-1	30	30								1		X													
		D	R1-1	30	30			6.25								1		X								LEBEL DR (TH-60)	X		

SIGN SUMMARY SHEET	SHEET TOTALS	6.25	0.00	0	0	0	1	0	0	1		15.0		0	0.0	0.0	0.0	0.0											
		SF	SF	EA	EA	EA	EA	EA	EA	EA		FT		EA	LB	LB	LB	LB											
VERMONT AGENCY OF TRANSPORTATION	TOWN DIRECTIONAL TOTALS	215.5	0.0	0	0	0	47	0	0	32		480.0		0	0.0														

PROJECT NAME: **St Albans - Berkshire**
PROJECT NUMBER: **STPG SIGN(36)**

FILE NAME: **St. Albans EB.xls** PLOT DATE: **5/17/2011**
PROJECT MANAGER: **A. Gamble** DRAWN BY: **T. Guazzoni**
DESIGNED BY: **T. Guazzoni** CHECKED **A. Gamble**
ST ALBANS TOWN EB SHEET 7 SHEET **18** OF **109**

DIRECTION	MILEPOINT	LOCATION CODE (SHEET 2)	SIGN CODE	WIDTH (IN)	HEIGHT (IN)	SHEETING REMARKS	SIGN LEGEND	NEW SIGNS "A"	NEW SIGNS "B"	EXISTING SIGNS RETAIN	EXISTING SIGNS SALVAGE FROM	EXISTING SIGNS SALVAGE TO	EXISTING SIGNS REMOVE	EXIST POST RETAIN	EXIST POST REMOVE	NUMBER OF NEW POSTS	SQUARE STEEL (IN) 1.75 (LB / FT) 1.88	SQUARE STEEL (IN) 2.00 (LB / FT) 2.42	SQUARE STEEL (IN) 2.50 (LB / FT) 3.35	TUBULAR STEEL Ø (IN) FOUNDATION	TUBULAR STEEL Ø (IN) 3.00 (LB / FT) 7.60	TUBULAR STEEL Ø (IN) 3.50 (LB / FT) SLIP BASE ~~9.00~~	TUBULAR STEEL Ø (IN) 4.00 (LB / FT) 10.80	TUBULAR STEEL Ø (IN) 5.00 (LB / FT) 14.60	SIGN FRAME REQUIRED	REMARKS	SIGN DETAIL LOCATION SHSM	SIGN DETAIL LOCATION PROJECT SHEET #	SIGN DETAIL LOCATION STANDARD SHEET #
ST ALBANS TOWN VT105 WB							FY-FLUORESCENT YELLOW FYG-FLUORESCENT YELLOW GREEN																			"SHSM"-STANDARD HIGHWAY SIGNS AND MARKINGS			
WB	1.620	F	W11-4	30	30								1		X														
		F	W11-4	30	30			6.25								1		X									X		
WB	1.591	F	W3-3	36	36		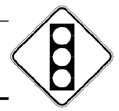						1		X														
		F	W3-3	30	30			6.25								1		X									X		
WB	1.540	F	M2-1	21	15								1		X														
		F	M1-5	30	24								1																
		F	M2-1	21	15			2.19								1		X									GREEN ON WHITE	X		
		F	M1-5	30	24			5.00																					E-136B
WB	1.520	F	D1-1A	72	10		DESTINATION BOARD ASSEMBLY (5)						1		X														
		F	D1-1A	72	10								1																
		F	D1-1A	72	10		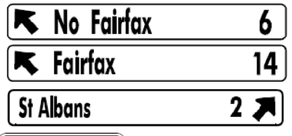						1																
		F	D9-2	24	24								1																
		F	D9-2A	24	6								1																
		F	VD1-1A	72	12			6.00								2			X								INSTALL ON 2 1/2" SLIP BASES		4	
		F	VD1-1A	72	12			6.00																				4	
SIGN SUMMARY SHEET							SHEET TOTALS	31.69	0.00	0	0	0	9	0	0	5		75.0		0	0.0	2 ~~0.0~~	0.0	0.0				
								SF	SF	EA	EA	EA	EA	EA	EA	EA		FT		EA	LB	LB	LB	LB				
VERMONT AGENCY OF TRANSPORTATION							TOWN DIRECTIONAL TOTALS	242.2	0.0	1	0	0	69	0	0	26		390.0		4		433.2						

PROJECT NAME: **St Albans - Berkshire**
PROJECT NUMBER: **STPG SIGN(36)**
FILE NAME: **StAlbansWB.xls**
PROJECT MANAGER: **A. Gamble**
DESIGNED BY: **T. Guazzoni**
PLOT DATE: **5/17/2011**
DRAWN BY: **T. Guazzoni**
CHECKED **A. Gamble**
ST ALBANS TOWN WB SHEET 1
SHEET **19** OF **109**

DIRECTION	MILEPOINT	LOCATION CODE (SHEET 2)	SIGN CODE	WIDTH (IN)	HEIGHT (IN)	SHEETING REMARKS	SIGN LEGEND	NEW SIGNS		EXISTING SIGNS				EXIST POST		NUMBER OF NEW POSTS	SQUARE STEEL (IN)			TUBULAR STEEL Ø (IN)				SIGN FRAME REQUIRED	REMARKS	SIGN DETAIL LOCATION		
								"A"	"B"	RETAIN	SALVAGE FROM	SALVAGE TO	REMOVE	RETAIN	REMOVE		1.75 (LB / FT)	2.00 (LB / FT)	2.50 (LB / FT)	FOUNDATION	3.00 (LB / FT)	3.50 (LB / FT)	4.00 (LB / FT)	5.00 (LB / FT)			SHSM	PROJECT SHEET #	STANDARD SHEET #
																	1.88	2.42	3.35		7.60	9.00	10.80	14.60					
ST ALBANS TOWN VT105 WB							FY-FLUORESCENT YELLOW FYG-FLUORESCENT YELLOW GREEN																			"SHSM"-STANDARD HIGHWAY SIGNS AND MARKINGS			
		F	VD1-1A	72	12			6.00																				4	
		F	D9-2	24	24			4.00																		INSTALL ON LEFT POST	X		
		F	M6-1L	21	15			2.19																		WHITE ON BLUE. INSTALL ON LEFT POST	X		
WB	1.450	F	M3-3	24	12		ROUTE MARKER ASSEMBLY (14)						1		X														
		F	M1-5	30	24								1																
		F	M4-5	24	12								1																
		F	M3-3	24	12								1																
		F	M1-1	24	24								1																
		F	M6-1	21	15								1																
		F	M3-4	24	12								1																
		F	M1-5	24	24								1																
		F	M4-5	24	12								1																
		F	M3-1	24	12								1																
		F	M1-1	24	24								1																
		F	M6-2	21	15								1																
							SHEET TOTALS	12.19	0.00	0	0	0	12	0	0	0		0.0			0	0.0	0.0	0.0	0.0					
								SF	SF	EA	EA	EA	EA	EA	EA	EA		FT			EA	LB	LB	LB	LB					
							TOWN DIRECTIONAL TOTALS	242.2	0.0	1	0	0	69	0	0	26		390.0			4	433.2								

SIGN SUMMARY SHEET

VERMONT AGENCY OF TRANSPORTATION

PROJECT NAME: **St Albans - Berkshire**
PROJECT NUMBER: **STPG SIGN(36)**

FILE NAME: **StAlbansWB.xls**
PROJECT MANAGER: **A. Gamble**
DESIGNED BY: **T. Guazzoni**
PLOT DATE: **5/17/2011**
DRAWN BY: **T. Guazzoni**
CHECKED **A. Gamble**

DIRECTION	MILEPOINT	LOCATION CODE (SHEET 2)	SIGN CODE	WIDTH (IN)	HEIGHT (IN)	SHEETING REMARKS	SIGN LEGEND	NEW SIGNS		EXISTING SIGNS				EXIST POST		NUMBER OF NEW POSTS	SQUARE STEEL (IN)			TUBULAR STEEL Ø (IN)				SIGN FRAME REQUIRED	REMARKS	SIGN DETAIL LOCATION		
																	1.75	2.00	2.50	3.00	3.50	4.00	5.00					
																	(LB / FT)			(LB / FT)								
								"A"	"B"	RETAIN	SALVAGE FROM	SALVAGE TO	REMOVE	RETAIN	REMOVE		1.88	2.42	3.35	FOUNDATION	7.60	9.00	10.80	14.60			SHSM	PROJECT SHEET #	STANDARD SHEET #
ST ALBANS TOWN VT105 WB							FY-FLUORESCENT YELLOW FYG-FLUORESCENT YELLOW GREEN																		"SHSM"-STANDARD HIGHWAY SIGNS AND MARKINGS			
		F	M3-3	24	12			2.00												2	245.1 ~~239.4~~				*	GREEN ON WHITE. *INSTALL ON 2 #2B SIGN FRAMES	X	6	
		F	M1-5	30	24			5.00																				E-136B
		F	M6-2L	21	15			2.19																		GREEN ON WHITE	X		
		F	M4-5	24	12			2.00																		GREEN ON WHITE	X		
		F	M3-3	24	12			2.00																		WHITE ON BLUE	X		
		F	M1-1	24	24			4.00																			X		
		F	M6-2L	21	15			2.19																		WHITE ON BLUE	X		
		F	M3-4	24	12			2.00																		GREEN ON WHITE	X		
		F	M1-5	30	24			5.00																				E-136B
		F	M6-2R	21	15			2.19																		GREEN ON WHITE	X		
		F	M4-5	24	12			2.00																		WHITE ON BLUE	X		
		F	M3-1	24	12			2.00																		WHITE ON BLUE	X		
		F	M1-1	24	24			4.00																			X		
		F	M6-2 R	21	15			2.19																		WHITE ON BLUE	X		
WB	1.380	F	M3-4	24	12		WEST						1		X														
							SHEET TOTALS	38.76	0.00	0	0	0	1	0	0	0	0.0			2	245.1 ~~239.4~~	0.0	0.0	0.0					
								SF	SF	EA	EA	EA	EA	EA	EA	EA	FT			EA	LB	LB	LB	LB					
							TOWN DIRECTIONAL TOTALS	242.2	0.0	1	0	0	69	0	0	26	390.0			4	433.2								

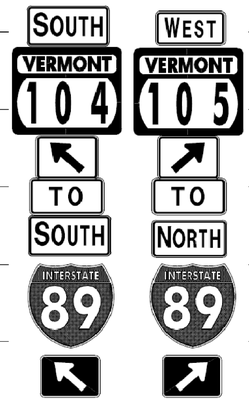

SIGN SUMMARY SHEET

VERMONT AGENCY OF TRANSPORTATION

PROJECT NAME: St Albans - Berkshire
PROJECT NUMBER: STPG SIGN(36)

FILE NAME: StAlbansWB.xls
PROJECT MANAGER: A. Gamble
DESIGNED BY: T. Guazzoni
ST ALBANS TOWN WB SHEET 3

PLOT DATE: 5/17/2011
DRAWN BY: T. Guazzoni
CHECKED A. Gamble
SHEET 21 OF 109

DIRECTION	MILEPOINT	LOCATION CODE (SHEET 2)	SIGN CODE	WIDTH (IN)	HEIGHT (IN)	SHEETING REMARKS	SIGN LEGEND	NEW SIGNS "A"	NEW SIGNS "B"	EXISTING SIGNS RETAIN	EXISTING SIGNS SALVAGE FROM	EXISTING SIGNS SALVAGE TO	EXISTING SIGNS REMOVE	EXIST POST RETAIN	EXIST POST REMOVE	NUMBER OF NEW POSTS	SQUARE STEEL (IN) 1.75 (LB / FT) 1.88	SQUARE STEEL (IN) 2.00 (LB / FT) 2.42	SQUARE STEEL (IN) 2.50 (LB / FT) 3.35	TUBULAR STEEL Ø (IN) FOUNDATION	TUBULAR STEEL Ø (IN) 3.00 (LB / FT) 7.60	TUBULAR STEEL Ø (IN) 3.50 (LB / FT) 9.00	TUBULAR STEEL Ø (IN) 4.00 (LB / FT) 10.80	TUBULAR STEEL Ø (IN) 5.00 (LB / FT) 14.60	SIGN FRAME REQUIRED	REMARKS	SIGN DETAIL LOCATION SHSM	SIGN DETAIL LOCATION PROJECT SHEET #	SIGN DETAIL LOCATION STANDARD SHEET #
ST ALBANS TOWN VT105 WB							FY-FLUORESCENT YELLOW FYG-FLUORESCENT YELLOW GREEN																			"SHSM"-STANDARD HIGHWAY SIGNS AND MARKINGS			
		F	M1-5	30	24		VERMONT 105						1																
		F	M4-5	24	12		TO						1																
		F	M3-1	24	12		NORTH						1																
		F	M1-1	24	24		I-89						1																
		F	R2-1	30	36		SPEED LIMIT 40	7.50								1		X								X		
WB	1.371	F	R2-1	24	30		SPEED LIMIT 40						1		X														
		F	M3-4	24	12			2.00								2		X							#1A	GREEN ON WHITE	X	6	
		F	M1-5	30	24			5.00																					E-136B
		F	M4-5	24	12			2.00																		WHITE ON BLUE	X		
		F	M3-1	24	12		WEST VERMONT 105 TO NORTH INTERSTATE 89	2.00																		WHITE ON BLUE	X		
		F	M1-1	24	24			4.00																		WHITE ON BLUE	X		
WB	1.320	F	D2-1	72	10								1		X														
		F	VD2-1	72	12		St Albans 2	6.00								2		X										4	
WB	0.981	F	R2-1	24	30								1		X														
		F	R2-1	24	30		SPEED LIMIT 40	5.00								1		X									X		
							SHEET TOTALS	33.50	0.00	0	0	0	7	0	0	6		90.0		0	0.0	0.0	0.0	0.0					
								SF	SF	EA	EA	EA	EA	EA	EA	EA		FT		EA	LB	LB	LB	LB					
							TOWN DIRECTIONAL TOTALS	242.2	0.0	1	0	0	69	0	0	26		390.0		4	433.2								

SIGN SUMMARY SHEET

VERMONT AGENCY OF TRANSPORTATION

PROJECT NAME: St Albans - Berkshire
PROJECT NUMBER: STPG SIGN(36)

FILE NAME: StAlbansWB.xls
PROJECT MANAGER: A. Gamble
DESIGNED BY: T. Guazzoni
PLOT DATE: 5/17/2011
DRAWN BY: T. Guazzoni
CHECKED A. Gamble
ST ALBANS TOWN WB SHEET 4
SHEET 22 OF 109

DIRECTION	MILEPOINT	LOCATION CODE (SHEET 2)	SIGN CODE	WIDTH (IN)	HEIGHT (IN)	SHEETING REMARKS	SIGN LEGEND	NEW SIGNS "A"	NEW SIGNS "B"	EXISTING SIGNS RETAIN	EXISTING SIGNS SALVAGE FROM	EXISTING SIGNS SALVAGE TO	EXISTING SIGNS REMOVE	EXIST POST RETAIN	EXIST POST REMOVE	NUMBER OF NEW POSTS	SQUARE STEEL (IN) 1.75 (LB / FT) 1.88	SQUARE STEEL (IN) 2.00 (LB / FT) 2.42	SQUARE STEEL (IN) 2.50 (LB / FT) 3.35	TUBULAR STEEL Ø (IN) FOUNDATION	TUBULAR STEEL Ø (IN) 3.00 (LB / FT) 7.60	TUBULAR STEEL Ø (IN) 3.50 (LB / FT) 9.00	TUBULAR STEEL Ø (IN) 4.00 (LB / FT) 10.80	TUBULAR STEEL Ø (IN) 5.00 (LB / FT) 14.60	SIGN FRAME REQUIRED	REMARKS	SIGN DETAIL LOCATION SHSM	SIGN DETAIL LOCATION PROJECT SHEET #	SIGN DETAIL LOCATION STANDARD SHEET #
ST ALBANS TOWN VT105 WB							FY-FLUORESCENT YELLOW FYG-FLUORESCENT YELLOW GREEN																			"SHSM"-STANDARD HIGHWAY SIGNS AND MARKINGS			
WB	0.838	F	VW-092	30	30								1		X														
		F	VW-092	36	36			9.00								2		X									E-150
WB	0.690	F	VW-205	30	30		WATCH FOR TURNING VEHICLES			1				X															
WB	0.450	F	R2-1	24	30								1		X														
		F	R2-1	24	30			5.00								1		X								X		
WB	0.415	F	W1-2ML	30	30		MODIFIED LEFT CURVE						1		X														
		F	W13-1	18	18		35 MPH PLAQUE						1																
WB	0.375	F	M2-1	21	15		JCT						1		X														
		F	M1-4	24	24		US 7						1																
		F	W1-2MiL	36	36			9.00								2		X									5
		F	W13-1	18	18			2.25																			INSTALL ON LEFT POST	X	
WB	0.340	F	D1-1	72	10								1		X														
		F	VD1-1	72	12			6.00													2	193.8						4
		F	M4-5	24	12			2.00																		#3	BLACK ON WHITE	X	6
		F	M3-3	24	12			2.00																			BLACK ON WHITE	X	
							SHEET TOTALS	35.25	0.00	1	0	0	7	0	0	5		75.0		2	193.8	0.0	0.0	0.0				
								SF	SF	EA	EA	EA	EA	EA	EA	EA		FT		EA	LB	LB	LB	LB				
							TOWN DIRECTIONAL TOTALS	242.2	0.0	1	0	0	69	0	0	26		390.0		4	433.2							

SIGN SUMMARY SHEET

VERMONT AGENCY OF TRANSPORTATION

PROJECT NAME: **St Albans - Berkshire**
PROJECT NUMBER: **STPG SIGN(36)**

FILE NAME: **StAlbansWB.xls** PLOT DATE: **5/17/2011**
PROJECT MANAGER: **A. Gamble** DRAWN BY: **T. Guazzoni**
DESIGNED BY: **T. Guazzoni** CHECKED **A. Gamble**

DIRECTION	MILEPOINT	LOCATION CODE (SHEET 2)	SIGN CODE	WIDTH (IN)	HEIGHT (IN)	SHEETING REMARKS	SIGN LEGEND	NEW SIGNS		EXISTING SIGNS				EXIST POST		NUMBER OF NEW POSTS	SQUARE STEEL (IN)			TUBULAR STEEL Ø (IN)				SIGN FRAME REQUIRED	REMARKS	SIGN DETAIL LOCATION		
								"A"	"B"	RETAIN	SALVAGE FROM	SALVAGE TO	REMOVE	RETAIN	REMOVE		1.75 (LB / FT) 1.88	2.00 (LB / FT) 2.42	2.50 (LB / FT) 3.35	FOUNDATION	3.00 (LB / FT) 7.60	3.50 (LB / FT) 9.00	4.00 (LB / FT) 10.80	5.00 (LB / FT) 14.60			SHSM	PROJECT SHEET #	STANDARD SHEET #
ST ALBANS TOWN VT105 WB							FY-FLUORESCENT YELLOW FYG-FLUORESCENT YELLOW GREEN																		"SHSM"-STANDARD HIGHWAY SIGNS AND MARKINGS			
		F	M1-4	24	24			4.00																				E-136A
		F	M6-2L	21	15			2.19																	BLACK ON WHITE	X		
		F	M4-5	24	12			2.00																	BLACK ON WHITE	X		
		F	M3-1	24	12			2.00																	BLACK ON WHITE	X		
		F	M1-4	24	24		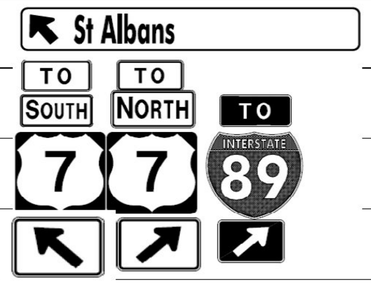	4.00																		E-136A
		F	M6-2R	21	15			2.19																	BLACK ON WHITE	X		
		F	M4-5	24	12			2.00																	WHITE ON BLUE	X		
		F	M1-1	24	24			4.00																		X		
		F	M6-2R	21	15			2.19																	WHITE ON BLUE	X		
WB	0.285	F	M3-3	24	12		SOUTH						1		X													
		F	M1-4	24	24		US ROUTE 7						1															
		F	M4-5	24	12		TO						1															
		F	M3-3	24	12		SOUTH						1															
		F	M1-1	24	24		INTERSTATE 89						1															
		F	M6-2	21	15		LEFT ARROW (45 DEG)						1															
							SHEET TOTALS	24.57	0.00	0	0	0	6	0	0	0	0.0			0	0.0	0.0	0.0	0.0				
								SF	SF	EA	EA	EA	EA	EA	EA	EA		FT		EA	LB	LB	LB	LB				
							TOWN DIRECTIONAL TOTALS	242.2	0.0	1	0	0	69	0	0	26	390.0			4	433.2							

SIGN SUMMARY SHEET

VERMONT AGENCY OF TRANSPORTATION

PROJECT NAME: St Albans - Berkshire
PROJECT NUMBER: STPG SIGN(36)
FILE NAME: StAlbansWB.xls
PROJECT MANAGER: A. Gamble
DESIGNED BY: T. Guazzoni
ST ALBANS TOWN WB SHEET 6
PLOT DATE: 5/17/2011
DRAWN BY: T. Guazzoni
CHECKED A. Gamble
SHEET 24 OF 109

DIRECTION	MILEPOINT	LOCATION CODE (SHEET 2)	SIGN CODE	WIDTH (IN)	HEIGHT (IN)	SHEETING REMARKS	SIGN LEGEND	NEW SIGNS		EXISTING SIGNS				EXIST POST		NUMBER OF NEW POSTS	SQUARE STEEL (IN)			TUBULAR STEEL Ø (IN)				FOUNDATION	SIGN FRAME REQUIRED	REMARKS	SIGN DETAIL LOCATION		
								"A"	"B"	RETAIN	SALVAGE FROM	SALVAGE TO	REMOVE	RETAIN	REMOVE		1.75 (LB / FT) 1.88	2.00 (LB / FT) 2.42	2.50 (LB / FT) 3.35	3.00 (LB / FT) 7.60	3.50 (LB / FT) 9.00	4.00 (LB / FT) 10.80	5.00 (LB / FT) 14.60				SHSM	PROJECT SHEET #	STANDARD SHEET #
ST ALBANS TOWN VT105 WB							FY-FLUORESCENT YELLOW FYG-FLUORESCENT YELLOW GREEN																			"SHSM"-STANDARD HIGHWAY SIGNS AND MARKINGS			
		F	M3-1	24	12		NORTH						1															
		F	M1-4	24	24		US ROUTE 7						1															
		F	M4-5	24	12		TO						1															
		F	M3-1	24	12		NORTH						1															
		F	M1-1	24	24		INTERSTATE 89						1															
		F	M6-3	21	15		UP ARROW						1															
WB	0.250	F	W1-6	48	24								1		X													
		F	W1-6L	48	24			8.00								2		X									X		
WB	0.215	E	W1-6	48	24								1		X													
		E	W1-6R	48	24			8.00								2		X									X		
WB	0.185	F	M2-1	21	15								1		X													
		F	M1-4	24	24								1															
		F	M4-6	24	12								1															
		F	M1-5	30	24								1															
		F	M2-1	21	15			2.19								2		X							#1A	BLACK ON WHITE	X	6	
							SHEET TOTALS	18.19 SF	0.00 SF	0 EA	0 EA	0 EA	12 EA	0 EA	0 EA	6 EA		90.0 FT		0 EA	0.0 LB	0.0 LB	0.0 LB	0.0 LB					
							TOWN DIRECTIONAL TOTALS	242.2	0.0	1	0	0	69	0	0	26		390.0		4	433.2									

SIGN SUMMARY SHEET

VERMONT AGENCY OF TRANSPORTATION

PROJECT NAME: **St Albans - Berkshire**
PROJECT NUMBER: **STPG SIGN(36)**

FILE NAME: **StAlbansWB.xls** PLOT DATE: **5/17/2011**
PROJECT MANAGER: **A. Gamble** DRAWN BY: **T. Guazzoni**
DESIGNED BY: **T. Guazzoni** CHECKED **A. Gamble**

DIRECTION	MILEPOINT	LOCATION CODE (SHEET 2)	SIGN CODE	WIDTH (IN)	HEIGHT (IN)	SHEETING REMARKS	SIGN LEGEND	NEW SIGNS		EXISTING SIGNS				EXIST POST		NUMBER OF NEW POSTS	SQUARE STEEL (IN)			TUBULAR STEEL Ø (IN)				SIGN FRAME REQUIRED	REMARKS	SIGN DETAIL LOCATION		
								"A"	"B"	RETAIN	SALVAGE FROM	SALVAGE TO	REMOVE	RETAIN	REMOVE		1.75 (LB / FT)	2.00 (LB / FT)	2.50 (LB / FT)	FOUNDATION	3.00 (LB / FT)	3.50 (LB / FT)	4.00 (LB / FT)	5.00 (LB / FT)			SHSM	PROJECT SHEET #	STANDARD SHEET #
																	1.88	2.42	3.35		7.60	9.00	10.80	14.60					
ST ALBANS TOWN VT105 WB							FY-FLUORESCENT YELLOW FYG-FLUORESCENT YELLOW GREEN																			"SHSM"-STANDARD HIGHWAY SIGNS AND MARKINGS			
		F	M1-4	24	24			4.00																				E-136A
		F	M4-6	24	12			2.00																		GREEN ON WHITE	X		
		F	M1-5	30	24			5.00																				E-136B
WB	0.145	F	W3-1	36	36								1		X														
		F	W3-1	30	30		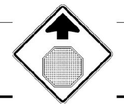	6.25								1		X								X		
WB	0.038	F	M3-3	24	12		SOUTH						1		X														
		F	M1-4	24	24		US ROUTE 7						1																
		F	M4-5	24	12		TO						1																
		F	M3-3	24	12		SOUTH						1																
		F	M1-1	24	24		INTERSTATE 89						1																
		F	M6-1	21	15		LEFT						1																
		F	M3-1	24	12		NORTH						1																
		F	M1-4	24	24		US ROUTE 7						1																
		F	M4-5	24	12		TO						1																
		F	M3-1	24	12		NORTH						1																
SIGN SUMMARY SHEET							SHEET TOTALS	17.25	0.00	0	0	0	11	0	0	1		15.0		0	0.0	0.0	0.0	0.0					
								SF	SF	EA	EA	EA	EA	EA	EA	EA		FT		EA	LB	LB	LB	LB					
VERMONT AGENCY OF TRANSPORTATION							TOWN DIRECTIONAL TOTALS	242.2	0.0	1	0	0	69	0	0	26		390.0		4	433.2								

PROJECT NAME: **St Albans - Berkshire**
PROJECT NUMBER: **STPG SIGN(36)**

FILE NAME: **StAlbansWB.xls** PLOT DATE: **5/17/2011**
PROJECT MANAGER: **A. Gamble** DRAWN BY: **T. Guazzoni**
DESIGNED BY: **T. Guazzoni** CHECKED **A. Gamble**
ST ALBANS TOWN WB SHEET 8 SHEET **26** OF **109**

DIRECTION	MILEPOINT	LOCATION CODE (SHEET 2)	SIGN CODE	WIDTH (IN)	HEIGHT (IN)	SHEETING REMARKS	SIGN LEGEND	NEW SIGNS		EXISTING SIGNS				EXIST POST		NUMBER OF NEW POSTS	SQUARE STEEL (IN)			TUBULAR STEEL Ø (IN)					SIGN FRAME REQUIRED	REMARKS	SIGN DETAIL LOCATION		
																	1.75	2.00	2.50	3.00	3.50	4.00	5.00					
																	(LB / FT)			(LB / FT)								
								"A"	"B"	RETAIN	SALVAGE FROM	SALVAGE TO	REMOVE	RETAIN	REMOVE		1.88	2.42	3.35	FOUNDATION 7.60	SLIP BASE ~~9.00~~	10.80	14.60				SHSM	PROJECT SHEET #	STANDARD SHEET #
ST ALBANS TOWN VT105 WB							FY-FLUORESCENT YELLOW FYG-FLUORESCENT YELLOW GREEN																			"SHSM"-STANDARD HIGHWAY SIGNS AND MARKINGS			
		F	M1-1	24	24		INTERSTATE 89						1															
		F	M6-1	21	15		RIGHT						1															
		F	M3-3	24	12			2.00								2			X		2			#3	BLACK ON WHITE. INSTALL ON 2 1/2" SLIP BASES	X	6	
		F	M1-4	24	24			4.00																				E-136A
		F	M6-1L	21	15			2.19																	BLACK ON WHITE	X		
		F	M3-1	24	12			2.00																	BLACK ON WHITE	X		
		F	M1-4	24	24			4.00																				E-136A
		F	M6-1R	21	15			2.19																	BLACK ON WHITE	X		
		F	M4-5	24	12		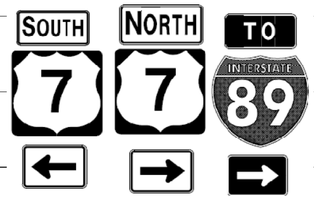	2.00																	WHITE ON BLUE	X		
		F	M1-1	24	24			4.00																		X		
		F	M6-1R	21	15			2.19																	WHITE ON BLUE	X		
WB	0.030	G	VM-607	24	30		PEARL HARBOR MEMORIAL HIGHWAY						1		X													
WB	0.000	F	R1-1	30	30		MM 				~~1~~		~~1~~ 2		X													
		F	R1-1	30	30			6.25								1		X								X		
SIGN SUMMARY SHEET							SHEET TOTALS	30.82	0.00	0	0	~~1~~ 0	~~5~~ 4	0	0	3	45.0			0	0.0	~~2~~ 0.0	0.0	0.0					
								SF	SF	EA	EA	EA	EA	EA	EA	EA		FT		EA	LB	LB	LB	LB					
VERMONT AGENCY OF TRANSPORTATION							TOWN DIRECTIONAL TOTALS	242.2	0.0	1	0	0	69	0	0	26	390.0			4	433.2								

PROJECT NAME: **St Albans - Berkshire**
PROJECT NUMBER: **STPG SIGN(36)**
FILE NAME: **StAlbansWB.xls**
PROJECT MANAGER: **A. Gamble**
DESIGNED BY: **T. Guazzoni**
PLOT DATE: **5/17/2011**
DRAWN BY: **T. Guazzoni**
CHECKED **A. Gamble**
ST ALBANS TOWN WB SHEET 9
SHEET **27** OF **109**

DIRECTION	MILEPOINT	LOCATION CODE (SHEET 2)	SIGN CODE	WIDTH (IN)	HEIGHT (IN)	SHEETING REMARKS	SIGN LEGEND	NEW SIGNS "A"	NEW SIGNS "B"	EXISTING SIGNS RETAIN	EXISTING SIGNS SALVAGE FROM	EXISTING SIGNS SALVAGE TO	EXISTING SIGNS REMOVE	EXIST POST RETAIN	EXIST POST REMOVE	NUMBER OF NEW POSTS	SQUARE STEEL (IN) (LB / FT) 1.75 / 1.88	SQUARE STEEL (IN) (LB / FT) 2.00 / 2.42	SQUARE STEEL (IN) (LB / FT) 2.50 / 3.35	TUBULAR STEEL Ø (IN) FOUNDATION	TUBULAR STEEL Ø (IN) (LB / FT) 3.00 / 7.60	TUBULAR STEEL Ø (IN) (LB / FT) 3.50 / 9.00	TUBULAR STEEL Ø (IN) (LB / FT) 4.00 / 10.80	TUBULAR STEEL Ø (IN) (LB / FT) 5.00 / 14.60	SIGN FRAME REQUIRED	REMARKS	SIGN DETAIL LOCATION SHSM	SIGN DETAIL LOCATION PROJECT SHEET #	SIGN DETAIL LOCATION STANDARD SHEET #
SWANTON VT105 EB							FY-FLUORESCENT YELLOW FYG-FLUORESCENT YELLOW GREEN																			"SHSM"-STANDARD HIGHWAY SIGNS AND MARKINGS			
EB	0.000	C	VD-024	60	7.5								3 ~~1~~		X													
		C	VD-024	72	10			5.00								2		X									4	
		C	VD-700	6	10		Swanton / St Albans 1050 0615 0000 / 1050 0613 0195	0.42																				E-138
		C	VD-700	6	10			0.42																				E-138
EB	0.538	A	W11-4	30	30		CATTLE CROSSING						1		X													
EB	1.630	D	R1-1	30	30		STOP						1		X													
EB	1.630	C	VR-017	24	30								1		X													
		C	VR-017	24	30		LEGAL LOAD LIMIT 24,000 POUNDS	5.00								1		X									POND RD (TH-5)		7	
EB	1.635	D	R1-1	30	30							1	~~1~~ 2		X													
		D	R1-1	36	36		STOP	9.00								2		X									POND RD (TH-5)	X		
EB	1.665	A	R2-1	24	30								1		X													
		A	R2-1	24	30		SPEED LIMIT 50	5.00								1		X										X		
EB	1.720	A	VW-622A	36	36		RECREATIONAL TRAIL						1		X													
		A	VW-622P	24	18		ALL SEASON PLAQUE						1															
EB	1.875	A	VW-622A	36	36		RECREATIONAL TRAIL						1		X													
							SHEET TOTALS	24.84	0.00	0	0	~~1~~ 0	~~12~~ 9	0	0	6		90.0		0	0.0	0.0	0.0	0.0					
								SF	SF	EA	EA	EA	EA	EA	EA	EA		FT		EA	LB	LB	LB	LB					
							TOWN DIRECTIONAL TOTALS	65.3	0.0	0	0	0	13	0	0	13		195.0		0			0.0					

SIGN SUMMARY SHEET

VERMONT AGENCY OF TRANSPORTATION

PROJECT NAME: St Albans - Berkshire
PROJECT NUMBER: STPG SIGN(36)

FILE NAME: SwantonEB.xls
PROJECT MANAGER: A. Gamble
DESIGNED BY: T. Guazzoni
SWANTON EB SHEET 1

PLOT DATE: 5/17/2011
DRAWN BY: T. Guazzoni
CHECKED A. Gamble
SHEET 28 OF 109

DIRECTION	MILEPOINT	LOCATION CODE (SHEET 2)	SIGN CODE	WIDTH (IN)	HEIGHT (IN)	SHEETING REMARKS	SIGN LEGEND	NEW SIGNS "A"	NEW SIGNS "B"	EXISTING SIGNS RETAIN	EXISTING SIGNS SALVAGE FROM	EXISTING SIGNS SALVAGE TO	EXISTING SIGNS REMOVE	EXIST POST RETAIN	EXIST POST REMOVE	NUMBER OF NEW POSTS	SQUARE STEEL (IN) 1.75 (LB / FT) 1.88	SQUARE STEEL (IN) 2.00 (LB / FT) 2.42	SQUARE STEEL (IN) 2.50 (LB / FT) 3.35	TUBULAR STEEL Ø (IN) FOUNDATION	TUBULAR STEEL Ø (IN) 3.00 (LB / FT) 7.60	TUBULAR STEEL Ø (IN) 3.50 (LB / FT) 9.00	TUBULAR STEEL Ø (IN) 4.00 (LB / FT) 10.80	TUBULAR STEEL Ø (IN) 5.00 (LB / FT) 14.60	SIGN FRAME REQUIRED	REMARKS	SIGN DETAIL LOCATION SHSM	SIGN DETAIL LOCATION PROJECT SHEET #	SIGN DETAIL LOCATION STANDARD SHEET #
SWANTON VT105 EB							FY-FLUORESCENT YELLOW FYG-FLUORESCENT YELLOW GREEN																			"SHSM"-STANDARD HIGHWAY SIGNS AND MARKINGS			
		A	W1-7	24	12		<---> DOUBLE ARROW						1															
		A	W11-15a	30	30			6.25								1		X								X		
		A	W16-7pL	24	12			2.00																			X		
EB	1.997	A	M3-2	24	12			2.00								1		X								GREEN ON WHITE. INSTALL 40' +/- WEST OF MAILBOX #2101	X		
		A	M1-5A	30	24			5.00																					E-136B
EB	2.035	A	R2-1	24	30			5.00								1		X								INSTALL 290' +/- WEST OF MAILBOX #2112	X		
EB	3.086	A	W1-2MR	30	30		MODIFIED RIGHT CURVE						1		X														
EB	3.110	A	W1-10R	36	36			9.00								2		X								INSTALL 125' +/- EAST OF EXISTING LOCATION	X		
EB	3.340	A	R2-1	24	30								1		X														
		A	R2-1	24	30			5.00								1		X									X		
EB	3.450	A	W11-6	30	30								1		X														
		A	W11-6H	30	30			6.25								1		X								INSTALL IN CLOSED POSITION			E-153
SIGN SUMMARY SHEET							SHEET TOTALS	40.50	0.00	0	0	0	4	0	0	7		105.0		0	0.0	0.0	0.0	0.0					
								SF	SF	EA	EA	EA	EA	EA	EA	EA		FT		EA	LB	LB	LB	LB					
VERMONT AGENCY OF TRANSPORTATION							TOWN DIRECTIONAL TOTALS	65.3	0.0	0	0	0	13	0	0	13		195.0		0		0.0							

PROJECT NAME: **St Albans - Berkshire**
PROJECT NUMBER: **STPG SIGN(36)**

FILE NAME: **SwantonEB.xls** PLOT DATE: **5/17/2011**
PROJECT MANAGER: **A. Gamble** DRAWN BY: **T. Guazzoni**
DESIGNED BY: **T. Guazzoni** CHECKED **A. Gamble**
SWANTON EB SHEET 2 SHEET **29** OF **109**

DIRECTION	MILEPOINT	LOCATION CODE (SHEET 2)	SIGN CODE	WIDTH (IN)	HEIGHT (IN)	SHEETING REMARKS	SIGN LEGEND	NEW SIGNS "A"	NEW SIGNS "B"	EXISTING SIGNS RETAIN	EXISTING SIGNS SALVAGE FROM	EXISTING SIGNS SALVAGE TO	EXISTING SIGNS REMOVE	EXIST POST RETAIN	EXIST POST REMOVE	NUMBER OF NEW POSTS	SQUARE STEEL (IN) 1.75 (LB / FT) 1.88	SQUARE STEEL (IN) 2.00 (LB / FT) 2.42	SQUARE STEEL (IN) 2.50 (LB / FT) 3.35	TUBULAR STEEL Ø (IN) FOUNDATION	TUBULAR STEEL Ø (IN) 3.00 (LB / FT) 7.60	TUBULAR STEEL Ø (IN) 3.50 (LB / FT) 9.00	TUBULAR STEEL Ø (IN) 4.00 (LB / FT) 10.80	TUBULAR STEEL Ø (IN) 5.00 (LB / FT) 14.60	SIGN FRAME REQUIRED	REMARKS	SIGN DETAIL LOCATION SHSM	SIGN DETAIL LOCATION PROJECT SHEET #	SIGN DETAIL LOCATION STANDARD SHEET #
SWANTON VT105 WB							FY-FLUORESCENT YELLOW FYG-FLUORESCENT YELLOW GREEN																				"SHSM"-STANDARD HIGHWAY SIGNS AND MARKINGS			
WB	3.380	F	W1-2ML	30	30		MODIFIED LEFT CURVE						1		X														
WB	3.310	F	W1-10L	36	36			9.00								2		X									INSTALL 370' +/- WEST OF EXISTING	X		
WB	3.175	G	VR-017	24	30								0 ~~1~~		X														
		G	VR-017	24	30			5.00								1		X									RUSSELL RD (TH-23)		7	
WB	3.180	H	R1-1	30	30							2	~~3~~ ~~1~~		X														
		H	R1-1	30	30			6.25								1		X									RUSSELL RD (TH-23)	X		
WB	3.029	F	R2-1	24	30			5.00								1		X									INSTALL SIGN 50' +/- EAST OF EXISTING	X		
WB	3.020	F	R2-1	24	30		SPEED LIMIT 50						1		X														
WB	2.040	F	W11-4	30	30		CATTLE CROSSING						1		X														
WB	1.982	F	VW-622A	36	36		RECREATIONAL TRAIL						1		X														
		F	VW-622P	24	18		ALL SEASON PLAQUE						1																
WB	1.935	G	VR-017	24	30							1	~~2~~ ~~1~~		X														
		G	VR-017	24	30			5.00								1		X									VIENS RD (TH-27)		7	
WB	1.930	H	R1-1	30	30							2	~~2~~ ~~1~~		X														
		H	R1-1	30	30			6.25								1		X									VIENS RD (TH-27)	X		
							SHEET TOTALS	36.50	0.00	0	0	~~5~~ 0	~~12~~ ~~9~~	0	0	7		105.0		0	0.0	0.0	0.0	0.0					
								SF	SF	EA	EA	EA	EA	EA	EA	EA		FT		EA	LB	LB	LB	LB					
							TOWN DIRECTIONAL TOTALS	61.0	0.0	0	0	0	15	0	0	11		165.0		0	0.0								

SIGN SUMMARY SHEET

VERMONT AGENCY OF TRANSPORTATION

PROJECT NAME: **St Albans - Berkshire**
PROJECT NUMBER: **STPG SIGN(36)**

FILE NAME: **SwantonWB.xls** PLOT DATE: **5/17/2011**
PROJECT MANAGER: **A. Gamble** DRAWN BY: **T. Guazzoni**
DESIGNED BY: **T. Guazzoni** CHECKED **A. Gamble**
SWANTON WB SHEET 1 SHEET **30** OF **109**

DIRECTION	MILEPOINT	LOCATION CODE (SHEET 2)	SIGN CODE	WIDTH (IN)	HEIGHT (IN)	SHEETING REMARKS	SIGN LEGEND	NEW SIGNS "A"	NEW SIGNS "B"	EXISTING SIGNS RETAIN	EXISTING SIGNS SALVAGE FROM	EXISTING SIGNS SALVAGE TO	EXISTING SIGNS REMOVE	EXIST POST RETAIN	EXIST POST REMOVE	NUMBER OF NEW POSTS	SQUARE STEEL (IN) (LB / FT) 1.88	SQUARE STEEL (IN) (LB / FT) 2.42	SQUARE STEEL (IN) (LB / FT) 3.35	TUBULAR STEEL Ø (IN) FOUNDATION	TUBULAR STEEL Ø (IN) (LB / FT) 7.60	TUBULAR STEEL Ø (IN) (LB / FT) 9.00	TUBULAR STEEL Ø (IN) (LB / FT) 10.80	TUBULAR STEEL Ø (IN) (LB / FT) 14.60	SIGN FRAME REQUIRED	REMARKS	SIGN DETAIL LOCATION SHSM	SIGN DETAIL LOCATION PROJECT SHEET #	SIGN DETAIL LOCATION STANDARD SHEET #
SWANTON VT105 WB							FY-FLUORESCENT YELLOW FYG-FLUORESCENT YELLOW GREEN																			"SHSM"-STANDARD HIGHWAY SIGNS AND MARKINGS			
WB	1.885	F	VW-622A	36	36		RECREATIONAL TRAIL						1		X														
		F	W1-7	24	12		<---> DOUBLE ARROW						1																
		F	W11-15a	30	30		TRAIL CROSSING	6.25								1		X										X	
		F	W16-7pL	24	12			2.00																				X	
WB	1.602	F	R2-1	24	30								1		X														
		F	R2-1	24	30		SPEED LIMIT 50	5.00								1		X										X	
WB	0.877	F	W11-4	30	30		CATTLE CROSSING						1		X														
WB	0.655	G	VR-017	24	30								1		X														
		G	VR-017	24	30		LEGAL LOAD LIMIT 24,000 POUNDS	5.00								1		X									SHOLAN RD (TH-37)		7	
WB	0.650	H	R1-1	30	30								1		X														
		H	R1-1	30	30		STOP	6.25								1		X									SHOLAN RD (TH-37)	X		

SIGN SUMMARY SHEET

VERMONT AGENCY OF TRANSPORTATION

SHEET TOTALS	24.50	0.00	0	0	2 0	6	0	0	4	60.0		0	0.0	0.0	0.0	0.0					
	SF	SF	EA	EA	EA	EA	EA	EA	EA	FT		EA	LB	LB	LB	LB					
TOWN DIRECTIONAL TOTALS	61.0	0.0	0	0	0	15	0	0	11	165.0		0	0.0								

PROJECT NAME: **St Albans - Berkshire**
PROJECT NUMBER: **STPG SIGN(36)**
FILE NAME: **SwantonWB.xls** PLOT DATE: **5/17/2011**
PROJECT MANAGER: **A. Gamble** DRAWN BY: **T. Guazzoni**
DESIGNED BY: **T. Guazzoni** CHECKED **A. Gamble**
SWANTON WB SHEET 2 SHEET **31** OF **109**

DIRECTION	MILEPOINT	LOCATION CODE (SHEET 2)	SIGN CODE	WIDTH (IN)	HEIGHT (IN)	SHEETING REMARKS	SIGN LEGEND	NEW SIGNS "A"	NEW SIGNS "B"	EXISTING SIGNS RETAIN	EXISTING SIGNS SALVAGE FROM	EXISTING SIGNS SALVAGE TO	EXISTING SIGNS REMOVE	EXIST POST RETAIN	EXIST POST REMOVE	NUMBER OF NEW POSTS	SQUARE STEEL (IN) 1.75 (LB/FT) 1.88	SQUARE STEEL (IN) 2.00 (LB/FT) 2.42	SQUARE STEEL (IN) 2.50 (LB/FT) 3.35	TUBULAR STEEL Ø (IN) FOUNDATION	TUBULAR STEEL Ø (IN) 3.00 (LB/FT) 7.60	TUBULAR STEEL Ø (IN) 3.50 (LB/FT) 9.00	TUBULAR STEEL Ø (IN) 4.00 (LB/FT) 10.80	TUBULAR STEEL Ø (IN) 5.00 (LB/FT) 14.60	SIGN FRAME REQUIRED	REMARKS	SIGN DETAIL LOCATION SHSM	SIGN DETAIL LOCATION PROJECT SHEET #	SIGN DETAIL LOCATION STANDARD SHEET #
SHELDON VT105 EB							FY-FLUORESCENT YELLOW FYG-FLUORESCENT YELLOW GREEN																			"SHSM"-STANDARD HIGHWAY SIGNS AND MARKINGS			
EB	0.000	C	VD-024	60	7.5								3 ~~1~~		X														
		C	VD-024	72	10			5.00								2		X										4	
		C	VD-700	6	10		Sheldon 1050 0614 0000 / Swanton 1050 0615 0390	0.42																					E-138
		C	VD-700	6	10			0.42																					E-138
EB	0.545	A	W1-2ML	30	30		MODIFIED LEFT CURVE						1		X														
		A	W13-1	18	18		40 MPH PLAQUE						1																
EB	0.580	A	W1-10L	36	36			9.00								2		X									INSTALL NEW SIGNS 185' +/- EAST OF EXISTING LOCATION	X	
		A	W13-1	18	18		40 M.P.H.	2.25																			INSTALL ON LEFT POST	X	
EB	0.664	A	S3-1	30	30		SCHOOL BUS STOP AHEAD						1		X														
EB	0.709	A	W1-8	18	24		CHEVRON						1		X														
EB	0.719	A	W1-8	18	24		CHEVRON						1		X														
EB	0.729	A	W1-8	18	24		CHEVRON						1		X														
		A	W1-6L	24	48			8.00								2		X										X	
EB	0.739	A	W1-8	18	24		CHEVRON						1		X														
EB	0.745	C	VR-017	24	30								1		X														
SIGN SUMMARY SHEET							SHEET TOTALS	25.08	0.00	0	0	~~0~~	~~9~~	0	0	6	90.0			0	0.0	0.0	0.0	0.0					
								SF	SF	EA	EA	EA	EA	EA	EA	EA	FT			EA	LB	LB	LB	LB					
VERMONT AGENCY OF TRANSPORTATION							TOWN DIRECTIONAL TOTALS	417.6	0.0	48	2	2	108	0	0	72	1080.0			0	0.0								

PROJECT NAME: **St Albans - Berkshire**
PROJECT NUMBER: **STPG SIGN(36)**

FILE NAME: **SheldonWB.xls** PLOT DATE: **5/17/2011**
PROJECT MANAGER: **A. Gamble** DRAWN BY: **T. Guazzoni**
DESIGNED BY: **T. Guazzoni** CHECKED **A. Gamble**
SHELDON EB SHEET 1 SHEET **32** OF **109**

DIRECTION	MILEPOINT	LOCATION CODE (SHEET 2)	SIGN CODE	WIDTH (IN)	HEIGHT (IN)	SHEETING REMARKS	SIGN LEGEND	NEW SIGNS "A"	NEW SIGNS "B"	EXISTING SIGNS RETAIN	EXISTING SIGNS SALVAGE FROM	EXISTING SIGNS SALVAGE TO	EXISTING SIGNS REMOVE	EXIST POST RETAIN	EXIST POST REMOVE	NUMBER OF NEW POSTS	SQUARE STEEL (IN) 1.75 (LB / FT) 1.88	SQUARE STEEL (IN) 2.00 (LB / FT) 2.42	SQUARE STEEL (IN) 2.50 (LB / FT) 3.35	TUBULAR STEEL Ø (IN) FOUNDATION	TUBULAR STEEL Ø (IN) 3.00 (LB / FT) 7.60	TUBULAR STEEL Ø (IN) 3.50 (LB / FT) 9.00	TUBULAR STEEL Ø (IN) 4.00 (LB / FT) 10.80	TUBULAR STEEL Ø (IN) 5.00 (LB / FT) 14.60	SIGN FRAME REQUIRED	REMARKS	SIGN DETAIL LOCATION SHSM	SIGN DETAIL LOCATION PROJECT SHEET #	SIGN DETAIL LOCATION STANDARD SHEET #
SHELDON VT105 EB							FY-FLUORESCENT YELLOW FYG-FLUORESCENT YELLOW GREEN																			"SHSM"-STANDARD HIGHWAY SIGNS AND MARKINGS			
		C	VR-017	24	30			5.00								1		X								BEDARD RD (TH-34)		7	
EB	0.750	D	R1-1	30	30							2	3 ~~1~~		X													
		D	R1-1	30	30			6.25								1		X								BEDARD RD (TH-34)	X		
EB	0.755	D	R1-1	30	30								1		X													
		D	R1-1	30	30			6.25								1		X								BEDARD RD (TH-34)	X		
EB	0.910	A	W1-1MR	30	30		MODIFIED RIGHT TURN						1		X													
		A	W13-1	18	18		30 MPH PLAQUE						1															
EB	0.980	A	W1-1McR	36	36			9.00								2		X								INSTALL 370' +/- EAST OF EXISTING LOCATION		5	
		A	W13-1	18	18			2.25																		INSTALL ON LEFT POST	X		
EB	0.995 - 1.08	A	UNK	6	8		WHITE DELINEATORS	2.64								8		X								INSTALL BACK TO BACK AT 50' SPACING, BEGINNING 80' EAST OF CURVE WARNING SIGN			
		B	UNK	6	8		WHITE DELINEATORS	2.64																				
EB	1.130	A	R2-1	24	30								1		X													
		A	R2-1	24	30			5.00								1		X									X		
EB	1.280	A	S3-1	30	30		SCHOOL BUS STOP AHEAD						1		X													
EB	1.860	A	W1-2R	30	30								1		X													
							SHEET TOTALS	39.03	0.00	0	0	~~2~~ 0	~~9~~ 7	0	0	14		210.0		0	0.0	0.0	0.0	0.0					
								SF	SF	EA	EA	EA	EA	EA	EA	EA		FT		EA	LB	LB	LB	LB					
							TOWN DIRECTIONAL TOTALS	417.6	0.0	48	2	2	108	0	0	72		1080.0		0	0.0								

SIGN SUMMARY SHEET

VERMONT AGENCY OF TRANSPORTATION

PROJECT NAME: **St Albans - Berkshire**
PROJECT NUMBER: **STPG SIGN(36)**

FILE NAME: **SheldonWB.xls**
PROJECT MANAGER: **A. Gamble**
DESIGNED BY: **T. Guazzoni**
SHELDON EB SHEET 2

PLOT DATE: **5/17/2011**
DRAWN BY: **T. Guazzoni**
CHECKED **A. Gamble**
SHEET **33** OF **109**

DIRECTION	MILEPOINT	LOCATION CODE (SHEET 2)	SIGN CODE	WIDTH (IN)	HEIGHT (IN)	SHEETING REMARKS	SIGN LEGEND	NEW SIGNS "A"	NEW SIGNS "B"	EXISTING SIGNS RETAIN	EXISTING SIGNS SALVAGE FROM	EXISTING SIGNS SALVAGE TO	EXISTING SIGNS REMOVE	EXIST POST RETAIN	EXIST POST REMOVE	NUMBER OF NEW POSTS	SQUARE STEEL (IN) 1.75 (LB / FT) 1.88	SQUARE STEEL (IN) 2.00 (LB / FT) 2.42	SQUARE STEEL (IN) 2.50 (LB / FT) 3.35	TUBULAR STEEL Ø (IN) FOUNDATION	TUBULAR STEEL Ø (IN) 3.00 (LB / FT) 7.60	TUBULAR STEEL Ø (IN) 3.50 (LB / FT) 9.00	TUBULAR STEEL Ø (IN) 4.00 (LB / FT) 10.80	TUBULAR STEEL Ø (IN) 5.00 (LB / FT) 14.60	SIGN FRAME REQUIRED	REMARKS	SIGN DETAIL LOCATION SHSM	SIGN DETAIL LOCATION PROJECT SHEET #	SIGN DETAIL LOCATION STANDARD SHEET #
SHELDON VT105 EB							FY-FLUORESCENT YELLOW FYG-FLUORESCENT YELLOW GREEN																			"SHSM"-STANDARD HIGHWAY SIGNS AND MARKINGS			
		A	W1-2R	30	30			6.25								1		X									X		
EB	1.970	A	VR-072	24	30								1		X														
		A	VR-072	24	30			5.00								1		X										7	
EB	2.190	A	VD-062AL	72	16		BUSINESS SIGN			1				X															
		A	VD-062AL	72	16		BUSINESS SIGN			1																			
EB	2.250	A	W1-2R	30	30		RIGHT CURVE						1		X														
EB	2.275	A	W11-8	30	30			6.25								1		X									INSTALL SIGN 130' +/- EAST OF EXISTING RIGHT CURVE SIGN	X		
EB	2.340	A	W1-2R	30	30		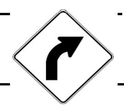	6.25								1		X									INSTALL SIGN 475' +/- EAST OF EXISTING LOCATION	X		
EB	2.535	A	W3-5	36	36		SPEED REDUCTION 40 MPH			1				X															
EB	2.570	A	VW-622A	36	36		RECREATIONAL TRAIL						1		X														
		A	VW-622P	24	18		ALL SEASON PLAQUE						1																
EB	2.640	A	R2-1	24	30								1		X														
		A	R2-1	30	36			7.50								1		X										X	
EB	2.695	A	VW-622A	36	36		RECREATIONAL TRAIL						1		X														
		A	W1-7	24	12		<---> DOUBLE ARROW						1																
							SHEET TOTALS	31.25	0.00	3	0	0	7	0	0	5		75.0		0	0.0	0.0	0.0	0.0					
								SF	SF	EA	EA	EA	EA	EA	EA	EA		FT		EA	LB	LB	LB	LB					
							TOWN DIRECTIONAL TOTALS	417.6	0.0	48	2	2	108	0	0	72		1080.0		0		0.0							

SIGN SUMMARY SHEET

VERMONT AGENCY OF TRANSPORTATION

PROJECT NAME: **St Albans - Berkshire**
PROJECT NUMBER: **STPG SIGN(36)**

FILE NAME: **SheldonWB.xls** PLOT DATE: **5/17/2011**
PROJECT MANAGER: **A. Gamble** DRAWN BY: **T. Guazzoni**
DESIGNED BY: **T. Guazzoni** CHECKED **A. Gamble**
SHELDON EB SHEET 3 SHEET **34** OF **109**

DIRECTION	MILEPOINT	LOCATION CODE (SHEET 2)	SIGN CODE	WIDTH (IN)	HEIGHT (IN)	SHEETING REMARKS	SIGN LEGEND	NEW SIGNS "A"	NEW SIGNS "B"	EXISTING SIGNS RETAIN	EXISTING SIGNS SALVAGE FROM	EXISTING SIGNS SALVAGE TO	EXISTING SIGNS REMOVE	EXIST POST RETAIN	EXIST POST REMOVE	NUMBER OF NEW POSTS	SQUARE STEEL (IN) 1.75 (LB/FT) 1.88	SQUARE STEEL (IN) 2.00 (LB/FT) 2.42	SQUARE STEEL (IN) 2.50 (LB/FT) 3.35	FOUNDATION	TUBULAR STEEL Ø (IN) 3.00 (LB/FT) 7.60	TUBULAR STEEL Ø (IN) 3.50 (LB/FT) 9.00	TUBULAR STEEL Ø (IN) 4.00 (LB/FT) 10.80	TUBULAR STEEL Ø (IN) 5.00 (LB/FT) 14.60	SIGN FRAME REQUIRED	REMARKS	SIGN DETAIL LOCATION SHSM	SIGN DETAIL LOCATION PROJECT SHEET #	SIGN DETAIL LOCATION STANDARD SHEET #
SHELDON VT105 EB							FY-FLUORESCENT YELLOW FYG-FLUORESCENT YELLOW GREEN																				"SHSM"-STANDARD HIGHWAY SIGNS AND MARKINGS			
		A	W11-15a	30	30			6.25								1		X								X		
		A	W16-7pL	24	12			2.00																		INSTALL ON LEFT POST	X		
EB	2.750	C	VR-017	24	30		LEGAL LOAD LIMIT 24000 LBS			1				X												SWEET HOLLOW RD (TH-28)			
EB	2.755	D	R1-1	30	30		STOP			1				X												SWEET HOLLOW RD (TH-28)			
EB	2.800	A	VD-018	30	18								1		X															
		A	VD-018	30	18			3.75								1		X										7	
EB	2.936	A	S1-1	36	36		SCHOOL SYMBOL			1				X															
		A	W16-9	30	18		AHEAD						1																
		A	S4-3p	24	8	FYG		1.33																		INSTALL BENEATH SCHOOL SYMBOL SIGN	X		
EB	2.990	A	S4-3	24	8		SCHOOL			1				X															
		A	R2-1	24	30		SPEED LIMIT 35			1																			
		A	S4-4	24	12		WHEN FLASHING			1																			
EB	3.030	C	VR-017	24	30		LEGAL LOAD LIMIT 24000 LBS			1				X												SCHOOL ST (TH-48)			
EB	3.040	D	R1-1	30	30		STOP			1				X												SCHOOL ST (TH-48)			
EB	3.050	A	S1-1	36	36		SCHOOL SYMBOL			1				X															
							SHEET TOTALS	13.33	0.00	9	0	0	2	0	0	2		30.0		0	0.0	0.0	0.0	0.0					
								SF	SF	EA	EA	EA	EA	EA	EA	EA		FT		EA	LB	LB	LB	LB					
							TOWN DIRECTIONAL TOTALS	417.6	0.0	48	2	2	108	0	0	72		1080.0		0			0.0						

SIGN SUMMARY SHEET

VERMONT AGENCY OF TRANSPORTATION

PROJECT NAME: **St Albans - Berkshire**
PROJECT NUMBER: **STPG SIGN(36)**
FILE NAME: **SheldonWB.xls** PLOT DATE: **5/17/2011**
PROJECT MANAGER: **A. Gamble** DRAWN BY: **T. Guazzoni**
DESIGNED BY: **T. Guazzoni** CHECKED BY: **A. Gamble**
SHELDON EB SHEET 4 SHEET **35** OF **109**

DIRECTION	MILEPOINT	LOCATION CODE (SHEET 2)	SIGN CODE	WIDTH (IN)	HEIGHT (IN)	SHEETING REMARKS	SIGN LEGEND	NEW SIGNS "A"	NEW SIGNS "B"	EXISTING SIGNS RETAIN	EXISTING SIGNS SALVAGE FROM	EXISTING SIGNS SALVAGE TO	EXISTING SIGNS REMOVE	EXIST POST RETAIN	EXIST POST REMOVE	NUMBER OF NEW POSTS	SQUARE STEEL (IN) 1.75 (LB / FT) 1.88	SQUARE STEEL (IN) 2.00 (LB / FT) 2.42	SQUARE STEEL (IN) 2.50 (LB / FT) 3.35	FOUNDATION	TUBULAR STEEL Ø (IN) 3.00 (LB / FT) 7.60	TUBULAR STEEL Ø (IN) 3.50 (LB / FT) 9.00	TUBULAR STEEL Ø (IN) 4.00 (LB / FT) 10.80	TUBULAR STEEL Ø (IN) 5.00 (LB / FT) 14.60	SIGN FRAME REQUIRED	REMARKS	SIGN DETAIL LOCATION SHSM	SIGN DETAIL LOCATION PROJECT SHEET #	SIGN DETAIL LOCATION STANDARD SHEET #
SHELDON VT105 EB							FY-FLUORESCENT YELLOW FYG-FLUORESCENT YELLOW GREEN																			"SHSM"-STANDARD HIGHWAY SIGNS AND MARKINGS			
		A	W16-7pL	30	18		LEFT (45 DEG)			1																		
EB	3.120	A	D1-1E	72	10								1		X													
		A	D1-2(R)	72	20			10.00								2		X									4
EB	3.150	C	VR-017	24	30		LEGAL LOAD LIMIT 24000 LBS			1				X													POOR FARM RD (TH-28)		
EB	3.160	D	R1-1	30	30		STOP			1				X													POOR FARM RD (TH-28)		
EB	3.175	A	S1-1	36	36		SCHOOL SYMBOL			1				X														
		A	W16-7pL	30	18		LEFT (45 DEG)			1																		
EB	3.221	A	R2-1	24	30		SPEED LIMIT 40				1	1	1		X	1		X										
		A	S5-3	24	30			5.00																	INSTALL SIGN BELOW EXISTING 40 MPH SIGN	X		
EB	3.337	A	R2-1	24	30		SPEED LIMIT 50			1				X														
EB	3.630	A	VD-062BRN	72	16		BUSINESS SIGN			1				X														
EB	3.700	A	W3-5	36	36		SPEED REDUCTION 40 MPH			1				X														
EB	3.754	A	W2-2MR	30	30		MODIFIED RIGHT SIDE ROAD			1				X														
EB	3.754	A	W16-8A	24	8		MAIN ST PLAQUE			1																		
EB	3.780	A	R2-1	24	30								1		X													
							SHEET TOTALS	15.00	0.00	10	1	1	3	0	0	3		45.0		0	0.0	0.0	0.0	0.0				
								SF	SF	EA	EA	EA	EA	EA	EA	EA		FT		EA	LB	LB	LB	LB				
							TOWN DIRECTIONAL TOTALS	417.6	0.0	48	2	2	108	0	0	72		1080.0		0		0.0						

SIGN SUMMARY SHEET

VERMONT AGENCY OF TRANSPORTATION

PROJECT NAME: **St Albans - Berkshire**
PROJECT NUMBER: **STPG SIGN(36)**
FILE NAME: **SheldonWB.xls** PLOT DATE: **5/17/2011**
PROJECT MANAGER: **A. Gamble** DRAWN BY: **T. Guazzoni**
DESIGNED BY: **T. Guazzoni** CHECKED **A. Gamble**
SHELDON EB SHEET 5 SHEET **36** OF **109**

DIRECTION	MILEPOINT	LOCATION CODE (SHEET 2)	SIGN CODE	WIDTH (IN)	HEIGHT (IN)	SHEETING REMARKS	SIGN LEGEND	NEW SIGNS "A"	NEW SIGNS "B"	EXISTING SIGNS RETAIN	EXISTING SIGNS SALVAGE FROM	EXISTING SIGNS SALVAGE TO	EXISTING SIGNS REMOVE	EXIST POST RETAIN	EXIST POST REMOVE	NUMBER OF NEW POSTS	SQUARE STEEL (IN) 1.75 (LB/FT) 1.88	SQUARE STEEL (IN) 2.00 (LB/FT) 2.42	SQUARE STEEL (IN) 2.50 (LB/FT) 3.35	TUBULAR STEEL Ø (IN) FOUNDATION	TUBULAR STEEL Ø (IN) 3.00 (LB/FT) 7.60	TUBULAR STEEL Ø (IN) 3.50 (LB/FT) 9.00	TUBULAR STEEL Ø (IN) 4.00 (LB/FT) 10.80	TUBULAR STEEL Ø (IN) 5.00 (LB/FT) 14.60	SIGN FRAME REQUIRED	REMARKS	SIGN DETAIL LOCATION SHSM	SIGN DETAIL LOCATION PROJECT SHEET #	SIGN DETAIL LOCATION STANDARD SHEET #
SHELDON VT105 EB							FY-FLUORESCENT YELLOW FYG-FLUORESCENT YELLOW GREEN																			"SHSM"-STANDARD HIGHWAY SIGNS AND MARKINGS			
		A	R2-1	30	36			7.50								1		X								X		
EB	3.830	A	D1-1A	72	10								1		X														
		A	D1-1A	72	10								1																
		A	VD1-1A	72	12		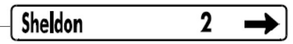	6.00								2		X									4		
		A	VD1-1A	72	12			6.00																			4		
EB	3.855	A	VW-622A	36	36		RECREATIONAL TRAIL						1		X														
		A	VW-622P	24	18		ALL SEASON PLAQUE						1																
EB	3.875	C	VR-017	24	30		LEGAL LOAD LIMIT 24000 LBS			1				X													MAIN ST (TH-4)			
EB	3.880	D	R1-1	30	30		STOP			1				X													MAIN ST (TH-4)			
EB	3.910	A	VW-622A	36	36								1		X														
		A	W16-7pL	30	18								1																
		A	W11-15a	30	30			6.25								1		X								X		
		A	W16-7pL	24	12			2.00																		X			
EB	3.942	A	M3-2	24	12		EAST						1		X														
		A	M1-5	30	24		VERMONT 105						1																
							SHEET TOTALS	27.75	0.00	2	0	0	8	0	0	4		60.0		0	0.0	0.0	0.0	0.0					
								SF	SF	EA	EA	EA	EA	EA	EA	EA		FT		EA	LB	LB	LB	LB					
							TOWN DIRECTIONAL TOTALS	417.6	0.0	48	2	2	108	0	0	72		1080.0		0	0.0								

SIGN SUMMARY SHEET

VERMONT AGENCY OF TRANSPORTATION

PROJECT NAME: **St Albans - Berkshire**
PROJECT NUMBER: **STPG SIGN(36)**

FILE NAME: **SheldonWB.xls** PLOT DATE: **5/17/2011**
PROJECT MANAGER: **A. Gamble** DRAWN BY: **T. Guazzoni**
DESIGNED BY: **T. Guazzoni** CHECKED **A. Gamble**
SHELDON EB SHEET 6 SHEET **37** OF **109**

DIRECTION	MILEPOINT	LOCATION CODE (SHEET 2)	SIGN CODE	WIDTH (IN)	HEIGHT (IN)	SHEETING REMARKS	SIGN LEGEND	NEW SIGNS "A"	NEW SIGNS "B"	EXISTING SIGNS RETAIN	EXISTING SIGNS SALVAGE FROM	EXISTING SIGNS SALVAGE TO	EXISTING SIGNS REMOVE	EXIST POST RETAIN	EXIST POST REMOVE	NUMBER OF NEW POSTS	SQUARE STEEL (IN) 1.75 (LB/FT) 1.88	SQUARE STEEL (IN) 2.00 (LB/FT) 2.42	SQUARE STEEL (IN) 2.50 (LB/FT) 3.35	FOUNDATION	TUBULAR STEEL Ø (IN) 3.00 (LB/FT) 7.60	TUBULAR STEEL Ø (IN) 3.50 (LB/FT) 9.00	TUBULAR STEEL Ø (IN) 4.00 (LB/FT) 10.80	TUBULAR STEEL Ø (IN) 5.00 (LB/FT) 14.60	SIGN FRAME REQUIRED	REMARKS	SIGN DETAIL LOCATION SHSM	SIGN DETAIL LOCATION PROJECT SHEET #	SIGN DETAIL LOCATION STANDARD SHEET #
SHELDON VT105 EB							FY-FLUORESCENT YELLOW FYG-FLUORESCENT YELLOW GREEN																				"SHSM"-STANDARD HIGHWAY SIGNS AND MARKINGS			
		A	M3-2	24	12			2.00								1		X								GREEN ON WHITE	X		
		A	M1-5	30	24			5.00																				E-136C
EB	4.030	A	R2-1	24	30								1		X													
		A	R2-1	24	30			5.00								1		X									X		
EB	4.210	A	RL-90	24	24		BICYCLE			1				X														
		A	RS-034	24	24		PARKING			1																		
		A	M6-1R	21	15		RIGHT ARROW			1																		
EB	4.240	C	VR-079	24	24		LEGAL LOAD AS FOR STATE HIGHWAYS			1				X													SEVERENCE RD (TH-41)			
EB	4.250	D	R1-1	30	30		STOP			1				X													SEVERENCE RD (TH-41)			
EB	4.290	A	M2-1	21	15								1		X													
		A	M1-5	24	24								1															
		A	M2-1	21	15			2.19								1		X								GREEN ON WHITE	X		
		A	M1-5	24	24			4.00																				E-136B
EB	4.370	A	D1-1A	72	10		DESTINATION SIGN ASSEMBLY (4)						1		X													
		A	D1-1A	72	10								1															
							SHEET TOTALS	18.19	0.00	5	0	0	5	0	0	3		45.0		0	0.0	0.0	0.0	0.0					
								SF	SF	EA	EA	EA	EA	EA	EA	EA		FT		EA	LB	LB	LB	LB					
							TOWN DIRECTIONAL TOTALS	417.6	0.0	48	2	2	108	0	0	72		1080.0		0			0.0					

SIGN SUMMARY SHEET

VERMONT AGENCY OF TRANSPORTATION

PROJECT NAME: **St Albans - Berkshire**
PROJECT NUMBER: **STPG SIGN(36)**
FILE NAME: **SheldonWB.xls** PLOT DATE: **5/17/2011**
PROJECT MANAGER: **A. Gamble** DRAWN BY: **T. Guazzoni**
DESIGNED BY: **T. Guazzoni** CHECKED **A. Gamble**
SHELDON EB SHEET 7 SHEET **38** OF **109**

DIRECTION	MILEPOINT	LOCATION CODE (SHEET 2)	SIGN CODE	WIDTH (IN)	HEIGHT (IN)	SHEETING REMARKS	SIGN LEGEND	NEW SIGNS "A"	NEW SIGNS "B"	EXISTING SIGNS RETAIN	EXISTING SIGNS SALVAGE FROM	EXISTING SIGNS SALVAGE TO	EXISTING SIGNS REMOVE	EXIST POST RETAIN	EXIST POST REMOVE	NUMBER OF NEW POSTS	SQUARE STEEL (IN) 1.75 (LB / FT) 1.88	SQUARE STEEL (IN) 2.00 (LB / FT) 2.42	SQUARE STEEL (IN) 2.50 (LB / FT) 3.35	TUBULAR STEEL Ø (IN) FOUNDATION	TUBULAR STEEL Ø (IN) 3.00 (LB / FT) 7.60	TUBULAR STEEL Ø (IN) 3.50 (LB / FT) 9.00	TUBULAR STEEL Ø (IN) 4.00 (LB / FT) 10.80	TUBULAR STEEL Ø (IN) 5.00 (LB / FT) 14.60	SIGN FRAME REQUIRED	REMARKS	SIGN DETAIL LOCATION SHSM	SIGN DETAIL LOCATION PROJECT SHEET #	SIGN DETAIL LOCATION STANDARD SHEET #
SHELDON VT105 EB							FY-FLUORESCENT YELLOW FYG-FLUORESCENT YELLOW GREEN																			"SHSM"-STANDARD HIGHWAY SIGNS AND MARKINGS			
		A	D1-1A	72	10								1																
		A	D1-1A	72	10								1																
		A	VD1-1A	72	12			6.00								2		X										4	
		A	VD1-1A	72	12		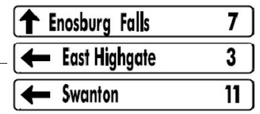	6.00																			4	
		A	VD1-1A	72	12			6.00																				4	
EB	4.380	A	M3-4	24	12		ROUTE MARKERS (6)						1		X														
		A	M1-5	24	24								1																
		A	M6-1	21	15								1																
		A	M3-2	24	12								1																
		A	M1-5	30	24								1																
		A	M6-3	21	15								1																
		A	M3-4	24	12			2.00								2		X								#2A	GREEN ON WHITE	X	6	
		A	M1-5	24	24		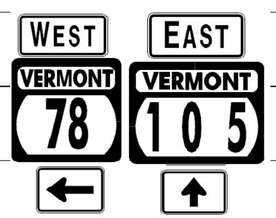	4.00																				E-136B	
		A	M6-1	21	15			2.19																			GREEN ON WHITE	X		
		A	M3-2	24	12			2.00																			GREEN ON WHITE	X		
SIGN SUMMARY SHEET							SHEET TOTALS	28.19	0.00	0	0	0	8	0	0	4		60.0		0	0.0	0.0	0.0	0.0					
								SF	SF	EA	EA	EA	EA	EA	EA	EA		FT		EA	LB	LB	LB	LB					
VERMONT AGENCY OF TRANSPORTATION							TOWN DIRECTIONAL TOTALS	417.6	0.0	48	2	2	108	0	0	72		1080.0		0	0.0								

PROJECT NAME: St Albans - Berkshire
PROJECT NUMBER: STPG SIGN(36)

FILE NAME: SheldonWB.xls
PROJECT MANAGER: A. Gamble
DESIGNED BY: T. Guazzoni
SHELDON EB SHEET 8

PLOT DATE: 5/17/2011
DRAWN BY: T. Guazzoni
CHECKED A. Gamble
SHEET 39 OF 109

DIRECTION	MILEPOINT	LOCATION CODE (SHEET 2)	SIGN CODE	WIDTH (IN)	HEIGHT (IN)	SHEETING REMARKS	SIGN LEGEND	NEW SIGNS		EXISTING SIGNS				EXIST POST		NUMBER OF NEW POSTS	SQUARE STEEL (IN)			TUBULAR STEEL Ø (IN)				SIGN FRAME REQUIRED	REMARKS	SIGN DETAIL LOCATION		
																	1.75	2.00	2.50	3.00	3.50	4.00	5.00					
																	(LB / FT)			(LB / FT)								
								"A"	"B"	RETAIN	SALVAGE FROM	SALVAGE TO	REMOVE	RETAIN	REMOVE		1.88	2.42	3.35	FOUNDATION	7.60	9.00	10.80	14.60			SHSM	PROJECT SHEET #	STANDARD SHEET #
SHELDON VT105 EB							FY-FLUORESCENT YELLOW FYG-FLUORESCENT YELLOW GREEN																		"SHSM"-STANDARD HIGHWAY SIGNS AND MARKINGS			
		A	M1-5	30	24			5.00																				E-136B
		A	M6-3	21	15			2.19																	GREEN ON WHITE	X		
EB	4.416	C	W1-7	48	24		<---> DOUBLE ARROW			1				X														
EB	4.451	A	R2-1	24	30		SPEED LIMIT 40			1				X														
EB	4.494	A	VW-092	30	30		UNSAFE TO PASS			1				X														
EB	4.510	A	M3-2	24	12								1		X													
		A	M1-5	30	24								1															
		A	M3-2	24	12			2.00								1		X							GREEN ON WHITE	X		
		A	M1-5	30	24			5.00																				E-136B
EB	4.570	A	D2-1	72	10		DESTINATION SIGN						1		X													
		A	D2-1	72	10								1															
		A	VD2-1	72	12		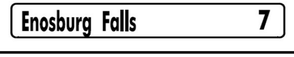	6.00								2		X								4	
EB	4.630	A	VW-092	30	30		UNSAFE TO PASS			1				X														
EB	4.675	C	VR-017	24	30		LEGAL LOAD LIMIT 24000 LBS			1				X											CASINO RD (TH-40)			
EB	4.680	D	R1-1	30	30		STOP			1				X											CASINO RD (TH-40)			
							SHEET TOTALS	20.19	0.00	6	0	0	4	0	0	3	45.0			0	0.0	0.0	0.0	0.0					
								SF	SF	EA	EA	EA	EA	EA	EA	EA		FT		EA	LB	LB	LB	LB					
							TOWN DIRECTIONAL TOTALS	417.6	0.0	48	2	2	108	0	0	72	1080.0			0	0.0								

SIGN SUMMARY SHEET

VERMONT AGENCY OF TRANSPORTATION

PROJECT NAME: **St Albans - Berkshire**
PROJECT NUMBER: **STPG SIGN(36)**

FILE NAME: **SheldonWB.xls** PLOT DATE: **5/17/2011**
PROJECT MANAGER: **A. Gamble** DRAWN BY: **T. Guazzoni**
DESIGNED BY: **T. Guazzoni** CHECKED **A. Gamble**
SHELDON EB SHEET 9 SHEET **40** OF **109**

DIRECTION	MILEPOINT	LOCATION CODE (SHEET 2)	SIGN CODE	WIDTH (IN)	HEIGHT (IN)	SHEETING REMARKS	SIGN LEGEND	NEW SIGNS "A"	NEW SIGNS "B"	EXISTING SIGNS RETAIN	EXISTING SIGNS SALVAGE FROM	EXISTING SIGNS SALVAGE TO	EXISTING SIGNS REMOVE	EXIST POST RETAIN	EXIST POST REMOVE	NUMBER OF NEW POSTS	SQUARE STEEL (IN) 1.75 (LB/FT) 1.88	SQUARE STEEL (IN) 2.00 (LB/FT) 2.42	SQUARE STEEL (IN) 2.50 (LB/FT) 3.35	TUBULAR STEEL Ø (IN) FOUNDATION	TUBULAR STEEL Ø (IN) 3.00 (LB/FT) 7.60	TUBULAR STEEL Ø (IN) 3.50 (LB/FT) 9.00	TUBULAR STEEL Ø (IN) 4.00 (LB/FT) 10.80	TUBULAR STEEL Ø (IN) 5.00 (LB/FT) 14.60	SIGN FRAME REQUIRED	REMARKS	SIGN DETAIL LOCATION SHSM	SIGN DETAIL LOCATION PROJECT SHEET #	SIGN DETAIL LOCATION STANDARD SHEET #
SHELDON VT105 EB							FY-FLUORESCENT YELLOW FYG-FLUORESCENT YELLOW GREEN																			"SHSM"-STANDARD HIGHWAY SIGNS AND MARKINGS			
EB	4.710	A	R2-1	24	30								1		X														
		A	R2-1	24	30		SPEED LIMIT 50	5.00								1		X										X		
EB	4.734	A	VW-218	30	30		CENTER RUMBLE STRIPS			1				X															
			W16-4p	24	18		NEXT 6 MILES			1																			
EB	4.740	A	W1-10L	30	30		MODIFIED LEFT CURVE						1		X														
EB	4.800	A	W1-2MjL	36	36			9.00								2		X									INSTALL SIGN 315' +/- EAST OF EXISTING LOCATION		5	
EB	5.640	A	VR-072	24	30								1		X														
		A	VR-072	24	30		THINK	5.00								1		X												
EB	6.040	A	VR-072	24	30		THINK/ENCARE			1				X															
EB	6.235	A	W11-6H	30	30			6.25								1		X									INSTALL IN CLOSED POSITION 1000' +/- EAST OF THINK SIGN			E-153
EB	6.550	A	W2-1	36	36		CROSSROAD						1		X														
EB	6.600	A	M2-1	21	15								1		X														
		A	M1-5	30	24								1																
		A	M2-1	21	15		JCT VERMONT 120	2.19								1		X									GREEN ON WHITE	X		
		A	M1-5	30	24			5.00																					E-136B
							SHEET TOTALS	32.44 SF	0.00 SF	3 EA	0 EA	0 EA	6 EA	0 EA	0 EA	6 EA		90.0 FT		0 EA	0.0 LB	0.0 LB	0.0 LB	0.0 LB					
							TOWN DIRECTIONAL TOTALS	417.6	0.0	48	2	2	108	0	0	72		1080.0		0	0.0									

SIGN SUMMARY SHEET

VERMONT AGENCY OF TRANSPORTATION

PROJECT NAME: **St Albans - Berkshire**
PROJECT NUMBER: **STPG SIGN(36)**
FILE NAME: **SheldonWB.xls**
PROJECT MANAGER: **A. Gamble**
DESIGNED BY: **T. Guazzoni**
DRAWN BY: **T. Guazzoni**
CHECKED BY: **A. Gamble**
PLOT DATE: **5/17/2011**
SHELDON EB SHEET 10
SHEET **41** OF **109**

DIRECTION	MILEPOINT	LOCATION CODE (SHEET 2)	SIGN CODE	WIDTH (IN)	HEIGHT (IN)	SHEETING REMARKS	SIGN LEGEND	NEW SIGNS		EXISTING SIGNS				EXIST POST		NUMBER OF NEW POSTS	SQUARE STEEL (IN)			TUBULAR STEEL Ø (IN)				SIGN FRAME REQUIRED	REMARKS	SIGN DETAIL LOCATION		
								"A"	"B"	RETAIN	SALVAGE FROM	SALVAGE TO	REMOVE	RETAIN	REMOVE		1.75 (LB / FT)	2.00 (LB / FT)	2.50 (LB / FT)	FOUNDATION	3.00 (LB / FT)	3.50 (LB / FT)	4.00 (LB / FT)	5.00 (LB / FT)			SHSM	PROJECT SHEET #	STANDARD SHEET #
																	1.88	2.42	3.35		7.60	9.00	10.80	14.60					
SHELDON VT105 EB							FY-FLUORESCENT YELLOW FYG-FLUORESCENT YELLOW GREEN																			"SHSM"-STANDARD HIGHWAY SIGNS AND MARKINGS			
EB	6.650	A	D1-1A	72	12		<--- FRANKLIN VT 5						1		X														
		A	D1-1A	72	12		^UP ENOSBURG FALLS 5						1																
		A	D1-1A	72	12		^UP RICHFORD VT 15						1																
		A	VD1-1A	72	12			6.00								2		X										4	
		A	VD1-1A	72	12		Enosburg Falls 5	6.00																				4	
		A	VD1-1A	72	12		Richford 15 Franklin 5	6.00																				4	
EB	6.700	A	M3-1	24	12		ROUTE MARKER ASSEMBLY (6)						1		X														
		A	M1-5	24	30								1																
		A	M6-1	21	15								1																
		A	M3-2	24	12								1																
		A	M1-5	30	24								1																
		A	M6-3	21	15								1																
		A	M3-1	24	12			2.00								2		X								#2B	GREEN ON WHITE	X	6	
		A	M1-5	30	24			5.00																					E-136B
		A	M6-1	21	15			2.19																			GREEN ON WHITE	X		
SIGN SUMMARY SHEET							SHEET TOTALS	27.19	0.00	0	0	0	9	0	0	4		60.0		0	0.0	0.0	0.0	0.0					
								SF	SF	EA	EA	EA	EA	EA	EA	EA		FT		EA	LB	LB	LB	LB					
VERMONT AGENCY OF TRANSPORTATION							TOWN DIRECTIONAL TOTALS	417.6	0.0	48	2	2	108	0	0	72		1080.0		0	0.0								

PROJECT NAME: St Albans - Berkshire
PROJECT NUMBER: STPG SIGN(36)

FILE NAME: SheldonWB.xls
PROJECT MANAGER: A. Gamble
DESIGNED BY: T. Guazzoni
SHELDON EB SHEET 11

PLOT DATE: 5/17/2011
DRAWN BY: T. Guazzoni
CHECKED A. Gamble
SHEET 42 OF 109

DIRECTION	MILEPOINT	LOCATION CODE (SHEET 2)	SIGN CODE	WIDTH (IN)	HEIGHT (IN)	SHEETING REMARKS	SIGN LEGEND	NEW SIGNS "A"	NEW SIGNS "B"	EXISTING SIGNS RETAIN	EXISTING SIGNS SALVAGE FROM	EXISTING SIGNS SALVAGE TO	EXISTING SIGNS REMOVE	EXIST POST RETAIN	EXIST POST REMOVE	NUMBER OF NEW POSTS	SQUARE STEEL (IN) 1.75 (LB / FT) 1.88	SQUARE STEEL (IN) 2.00 (LB / FT) 2.42	SQUARE STEEL (IN) 2.50 (LB / FT) 3.35	TUBULAR STEEL Ø (IN) FOUNDATION	TUBULAR STEEL Ø (IN) 3.00 (LB / FT) 7.60	TUBULAR STEEL Ø (IN) 3.50 (LB / FT) 9.00	TUBULAR STEEL Ø (IN) 4.00 (LB / FT) 10.80	TUBULAR STEEL Ø (IN) 5.00 (LB / FT) 14.60	SIGN FRAME REQUIRED	REMARKS	SIGN DETAIL LOCATION SHSM	SIGN DETAIL LOCATION PROJECT SHEET #	SIGN DETAIL LOCATION STANDARD SHEET #
SHELDON VT105 EB							FY-FLUORESCENT YELLOW FYG-FLUORESCENT YELLOW GREEN																				"SHSM"-STANDARD HIGHWAY SIGNS AND MARKINGS			
		A	M3-2	24	12			2.00																		GREEN ON WHITE	X		
		A	M1-5	30	24			5.00																				E-136B
		A	M6-3	21	15			2.19																		GREEN ON WHITE	X		
EB	6.705	C	VR-017	24	30		LEGAL LOAD LIMIT 24000 LBS			1				X												KANE RD (TH-3)			
EB	6.710	D	R1-1	30	30		STOP			1				X												KANE RD (TH-3)			
EB	6.730	A	VW-622A	36	36		RECREATIONAL TRAIL						1		X														
		A	VW-622P	24	18		ALL SEASON PLAQUE						1																
		A	R2-1	24	30			5.00								1		X							X		
EB	6.800	A	M3-2	24	12								1		X														
		A	M1-5	30	24								1																
		A	M3-2	24	12			2.00								1		X							GREEN ON WHITE	X		
		A	M1-5	30	24			5.00																				E-136B
EB	6.840	A	R2-1	24	30		SPEED LIMIT 50						1		X														
EB	6.900	A	W1-4R	30	30								1		X														
		A	W13-1	18	18								1																
SIGN SUMMARY SHEET							SHEET TOTALS	21.19	0.00	2	0	0	7	0	0	2		30.0		0	0.0	0.0	0.0	0.0					
								SF	SF	EA	EA	EA	EA	EA	EA	EA		FT		EA	LB	LB	LB	LB					
VERMONT AGENCY OF TRANSPORTATION							TOWN DIRECTIONAL TOTALS	417.6	0.0	48	2	2	108	0	0	72		1080.0		0		0.0							

PROJECT NAME: **St Albans - Berkshire**
PROJECT NUMBER: **STPG SIGN(36)**

FILE NAME: **SheldonWB.xls** PLOT DATE: **5/17/2011**
PROJECT MANAGER: **A. Gamble** DRAWN BY: **T. Guazzoni**
DESIGNED BY: **T. Guazzoni** CHECKED **A. Gamble**
SHELDON EB SHEET 12 SHEET **43** OF **109**

DIRECTION	MILEPOINT	LOCATION CODE (SHEET 2)	SIGN CODE	WIDTH (IN)	HEIGHT (IN)	SHEETING REMARKS	SIGN LEGEND	NEW SIGNS "A"	NEW SIGNS "B"	EXISTING SIGNS RETAIN	EXISTING SIGNS SALVAGE FROM	EXISTING SIGNS SALVAGE TO	EXISTING SIGNS REMOVE	EXIST POST RETAIN	EXIST POST REMOVE	NUMBER OF NEW POSTS	SQUARE STEEL (IN) 1.75 (LB / FT) 1.88	SQUARE STEEL (IN) 2.00 (LB / FT) 2.42	SQUARE STEEL (IN) 2.50 (LB / FT) 3.35	FOUNDATION	TUBULAR STEEL Ø (IN) 3.00 (LB / FT) 7.60	TUBULAR STEEL Ø (IN) 3.50 (LB / FT) 9.00	TUBULAR STEEL Ø (IN) 4.00 (LB / FT) 10.80	TUBULAR STEEL Ø (IN) 5.00 (LB / FT) 14.60	SIGN FRAME REQUIRED	REMARKS	SIGN DETAIL LOCATION SHSM	SIGN DETAIL LOCATION PROJECT SHEET #	SIGN DETAIL LOCATION STANDARD SHEET #
SHELDON VT105 EB							FY-FLUORESCENT YELLOW FYG-FLUORESCENT YELLOW GREEN																			"SHSM"-STANDARD HIGHWAY SIGNS AND MARKINGS			
		A	W1-4R	30	30			6.25								1		X									X		
		A	W13-1	18	18			2.25																		X		
EB	6.960	A	VW-622A	36	36		RECREATIONAL TRAIL						1		X													
		A	W1-7	21	15		<---> DOUBLE ARROW						1															
		A	W11-15a	30	30			6.25								1		X								X		
		A	W16-7pL	24	12			2.00																		X		
EB	7.100	A	D4-1	30	24		PARKING --->			1				X														
EB	7.130	C	VM-607	24	30		PEARL HARBOR MEMORIAL HIGHWAY			1				X														
EB	7.150	C	VR-023B	24	36		$500 FINE FOR LITTERING			1				X														
EB	7.480	A	D5-5A	24	24		PICNIC SYMBOL						1		X													
		A	VD-058	24	8		AHEAD						1															
EB	7.605	A	RS-044	24	24		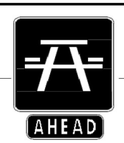	4.00								1		X								INSTALL 500' +/- WEST OF PICNIC AREA ENTRANCE	X		
		A	VD-058	24	8			1.33																		WHITE ON BROWN		7	
EB	7.695	A	RS-044	24	24			4.00								1		X								INSTALL SIGNS 80' +/- WEST OF EXISTING LOCATION. INSTALL BACK-TO-BACK	X		
		A	M6-1L	21	15			2.19																		WHITE ON BROWN	X		
							SHEET TOTALS	28.27	0.00	3	0	0	4	0	0	4		60.0		0	0.0	0.0	0.0	0.0					
								SF	SF	EA	EA	EA	EA	EA	EA	EA		FT		EA	LB	LB	LB	LB					
							TOWN DIRECTIONAL TOTALS	417.6	0.0	48	2	2	108	0	0	72		1080.0		0		0.0							

SIGN SUMMARY SHEET

VERMONT AGENCY OF TRANSPORTATION

PROJECT NAME: **St Albans - Berkshire**
PROJECT NUMBER: **STPG SIGN(36)**

FILE NAME: **SheldonWB.xls** PLOT DATE: **5/17/2011**
PROJECT MANAGER: **A. Gamble** DRAWN BY: **T. Guazzoni**
DESIGNED BY: **T. Guazzoni** CHECKED **A. Gamble**
SHELDON EB SHEET 13 SHEET **44** OF **109**

DIRECTION	MILEPOINT	LOCATION CODE (SHEET 2)	SIGN CODE	WIDTH (IN)	HEIGHT (IN)	SHEETING REMARKS	SIGN LEGEND	NEW SIGNS		EXISTING SIGNS				EXIST POST		NUMBER OF NEW POSTS	SQUARE STEEL (IN)			TUBULAR STEEL Ø (IN)				SIGN FRAME REQUIRED	REMARKS	SIGN DETAIL LOCATION		
																	1.75	2.00	2.50	3.00	3.50	4.00	5.00					
																	(LB / FT)			(LB / FT)								
								"A"	"B"	RETAIN	SALVAGE FROM	SALVAGE TO	REMOVE	RETAIN	REMOVE		1.88	2.42	3.35	FOUNDATION	7.60	9.00	10.80	14.60			SHSM	PROJECT SHEET #	STANDARD SHEET #
SHELDON VT105 EB							FY-FLUORESCENT YELLOW FYG-FLUORESCENT YELLOW GREEN																		"SHSM"-STANDARD HIGHWAY SIGNS AND MARKINGS			
		B	RS-044	24	24		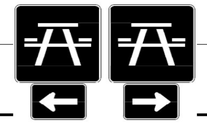	4.00																			X		
		B	M6-1R	21	15			2.19																		WHITE ON BROWN	X		
EB	7.710	A	D5-5A	24	24		PICNIC SYMBOL						1		X														
		A	D9-2A	24	6		LEFT ARROW						1																
		B	D5-5A	24	24		PICNIC SYMBOL						1																
		B	D9-2A	24	6		RIGHT ARROW						1																
EB	8.570	A	VD-062BRN	72	16		BUSINESS SIGN			1				X															
EB	8.650	A	M2-1	21	15								1		X														
		A	M1-5	30	24								1																
		A	M2-1	21	15			2.19								1		X								GREEN ON WHITE	X		
		A	M1-5	30	24			5.00																					E-136B
EB	8.700	A	D1-1A	72	10								1		X														
		A	D1-1A	72	10								1																
		A	D1-1A	72	10								1																
		A	VD1-1A	72	12			6.00								2		X									4		
							SHEET TOTALS	19.38	0.00	1	0	0	9	0	0	3		45.0		0	0.0	0.0	0.0	0.0					
								SF	SF	EA	EA	EA	EA	EA	EA	EA		FT		EA	LB	LB	LB	LB					
							TOWN DIRECTIONAL TOTALS	417.6	0.0	48	2	2	108	0	0	72		1080.0		0		0.0							

SIGN SUMMARY SHEET

VERMONT AGENCY OF TRANSPORTATION

PROJECT NAME: **St Albans - Berkshire**
PROJECT NUMBER: **STPG SIGN(36)**

FILE NAME: **SheldonWB.xls**
PROJECT MANAGER: **A. Gamble**
DESIGNED BY: **T. Guazzoni**
SHELDON EB SHEET 14

PLOT DATE: **5/17/2011**
DRAWN BY: **T. Guazzoni**
CHECKED **A. Gamble**
SHEET **45** OF **109**

DIRECTION	MILEPOINT	LOCATION CODE (SHEET 2)	SIGN CODE	WIDTH (IN)	HEIGHT (IN)	SHEETING REMARKS	SIGN LEGEND	NEW SIGNS "A"	NEW SIGNS "B"	EXISTING SIGNS RETAIN	EXISTING SIGNS SALVAGE FROM	EXISTING SIGNS SALVAGE TO	EXISTING SIGNS REMOVE	EXIST POST RETAIN	EXIST POST REMOVE	NUMBER OF NEW POSTS	SQUARE STEEL (IN) 1.75 (LB/FT) 1.88	SQUARE STEEL (IN) 2.00 (LB/FT) 2.42	SQUARE STEEL (IN) 2.50 (LB/FT) 3.35	FOUNDATION	TUBULAR STEEL Ø (IN) 3.00 (LB/FT) 7.60	TUBULAR STEEL Ø (IN) 3.50 (LB/FT) 9.00	TUBULAR STEEL Ø (IN) 4.00 (LB/FT) 10.80	TUBULAR STEEL Ø (IN) 5.00 (LB/FT) 14.60	SIGN FRAME REQUIRED	REMARKS	SIGN DETAIL LOCATION SHSM	SIGN DETAIL LOCATION PROJECT SHEET #	SIGN DETAIL LOCATION STANDARD SHEET #
SHELDON VT105 EB							FY-FLUORESCENT YELLOW FYG-FLUORESCENT YELLOW GREEN																				"SHSM"-STANDARD HIGHWAY SIGNS AND MARKINGS			
		A	VD1-1A	72	12		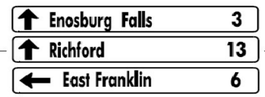	6.00																					4	
		A	VD1-1A	72	12			6.00																					4	
EB	8.725	A	M3-1	24	12		ROUTE MARKERS (6)						1		X															
		A	M1-5	30	24								1																	
		A	M6-1	21	15								1																	
		A	M3-2	24	12								1																	
		A	M1-5	30	24								1																	
		A	M6-3	21	15								1																	
		A	M3-1	24	12			2.00								2		X								#2B	GREEN ON WHITE	X	6	
		A	M1-5	30	24			5.00																						E-136B
		A	M6-1	21	15			2.19																			GREEN ON WHITE	X		
		A	M3-2	24	12			2.00																			GREEN ON WHITE	X		
		A	M1-5	30	24			5.00																						E-136B
		A	M6-3	21	15			2.19																			GREEN ON WHITE	X		
EB	8.740	C	W1-7	60	30		DOUBLE ARROW			1				X																
							SHEET TOTALS	30.38	0.00	1	0	0	6	0	0	2		30.0		0	0.0	0.0	0.0	0.0					
								SF	SF	EA	EA	EA	EA	EA	EA	EA		FT		EA	LB	LB	LB	LB					
							TOWN DIRECTIONAL TOTALS	417.6	0.0	48	2	2	108	0	0	72		1080.0		0		0.0							

SIGN SUMMARY SHEET

VERMONT AGENCY OF TRANSPORTATION

PROJECT NAME: St Albans - Berkshire
PROJECT NUMBER: STPG SIGN(36)
FILE NAME: SheldonWB.xls
PROJECT MANAGER: A. Gamble
DESIGNED BY: T. Guazzoni
SHELDON EB SHEET 15
PLOT DATE: 5/17/2011
DRAWN BY: T. Guazzoni
CHECKED A. Gamble
SHEET 46 OF 109

DIRECTION	MILEPOINT	LOCATION CODE (SHEET 2)	SIGN CODE	WIDTH (IN)	HEIGHT (IN)	SHEETING REMARKS	SIGN LEGEND	NEW SIGNS "A"	NEW SIGNS "B"	EXISTING SIGNS RETAIN	EXISTING SIGNS SALVAGE FROM	EXISTING SIGNS SALVAGE TO	EXISTING SIGNS REMOVE	EXIST POST RETAIN	EXIST POST REMOVE	NUMBER OF NEW POSTS	SQUARE STEEL (IN) 1.75 (LB / FT) 1.88	SQUARE STEEL (IN) 2.00 (LB / FT) 2.42	SQUARE STEEL (IN) 2.50 (LB / FT) 3.35	TUBULAR STEEL Ø (IN) FOUNDATION	TUBULAR STEEL Ø (IN) 3.00 (LB / FT) 7.60	TUBULAR STEEL Ø (IN) 3.50 (LB / FT) 9.00	TUBULAR STEEL Ø (IN) 4.00 (LB / FT) 10.80	TUBULAR STEEL Ø (IN) 5.00 (LB / FT) 14.60	SIGN FRAME REQUIRED	REMARKS	SIGN DETAIL LOCATION SHSM	SIGN DETAIL LOCATION PROJECT SHEET #	SIGN DETAIL LOCATION STANDARD SHEET #
SHELDON VT105 EB							FY-FLUORESCENT YELLOW FYG-FLUORESCENT YELLOW GREEN																			"SHSM"-STANDARD HIGHWAY SIGNS AND MARKINGS			
EB	8.760	A	M3-2	24	12								1		X														
		A	M1-5	30	24								1																
		A	M3-2	24	12			2.00								1		X								GREEN ON WHITE	X		
		A	M1-5	30	24			5.00																					E-136B
EB	8.790	A	D2-1	72	10								1		X														
		A	D2-1	72	10								1																
		A	VD2-1	72	12		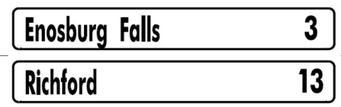	6.00								2		X									4	
		A	VD2-1	72	12			6.00																			4	
EB	8.850	A	R2-1	24	30								1		X														
		A	R2-1	24	30			5.00								1		X									X	
EB	8.920	A	W1-2L	30	30		LEFT CURVE						1		X														
		A	W13-1	18	18		35 MPH PLAQUE						1																
EB	8.990	A	VW-622A	36	36		RECREATIONAL TRAIL						1		X														
		A	VW-622P	24	18		ALL SEASON PLAQUE						1																
EB	9.050	A	W1-2L	30	30			6.25								1		X									INSTALL 200' +/- WEST OF LEFT LARGE ARROW	X		
							SHEET TOTALS	30.25	0.00	0	0	0	9	0	0	5		75.0		0	0.0	0.0	0.0	0.0				
								SF	SF	EA	EA	EA	EA	EA	EA	EA		FT		EA	LB	LB	LB	LB				
							TOWN DIRECTIONAL TOTALS	417.6	0.0	48	2	2	108	0	0	72		1080.0		0		0.0						

SIGN SUMMARY SHEET

VERMONT AGENCY OF TRANSPORTATION

PROJECT NAME: **St Albans - Berkshire**
PROJECT NUMBER: **STPG SIGN(36)**

FILE NAME: **SheldonWB.xls** PLOT DATE: **5/17/2011**
PROJECT MANAGER: **A. Gamble** DRAWN BY: **T. Guazzoni**
DESIGNED BY: **T. Guazzoni** CHECKED **A. Gamble**
SHELDON EB SHEET 16 SHEET **47** OF **109**

DIRECTION	MILEPOINT	LOCATION CODE (SHEET 2)	SIGN CODE	WIDTH (IN)	HEIGHT (IN)	SHEETING REMARKS	SIGN LEGEND	NEW SIGNS		EXISTING SIGNS				EXIST POST		NUMBER OF NEW POSTS	SQUARE STEEL (IN)			TUBULAR STEEL Ø (IN)				SIGN FRAME REQUIRED	REMARKS	SIGN DETAIL LOCATION		
								"A"	"B"	RETAIN	SALVAGE FROM	SALVAGE TO	REMOVE	RETAIN	REMOVE		1.75 (LB / FT)	2.00 (LB / FT)	2.50 (LB / FT)	FOUNDATION	3.00 (LB / FT)	3.50 (LB / FT)	4.00 (LB / FT)	5.00 (LB / FT)			SHSM	PROJECT SHEET #	STANDARD SHEET #
																	1.88	2.42	3.35		7.60	9.00	10.80	14.60					
SHELDON VT105 EB							FY-FLUORESCENT YELLOW FYG-FLUORESCENT YELLOW GREEN																			"SHSM"-STANDARD HIGHWAY SIGNS AND MARKINGS			
		A	W13-1	18	18			2.25																		X		
EB	9.090	A	W1-6	48	24		<--- LEFT LARGE ARROW				1		1															
EB	9.100	A	W1-6	48	24		<--- LEFT LARGE ARROW					1				1		X								SALVAGED SIGN FROM MP 9.090.			
EB	9.100	B	W1-6	48	24		RIGHT ---> LARGE ARROW			1				X														
EB	9.190	A	VW-622A	36	36		RECREATIONAL TRAIL						1		X													
		A	W1-7	21	15		<---> DOUBLE ARROW						1															
		A	W11-15a	30	30			6.25								1		X								X		
		A	W16-7pL	24	12			2.00																		X		
EB	10.930	A	VW-622A	36	36		RECREATIONAL TRAIL						1		X													
		A	VW-622P	24	18		ALL SEASON PLAQUE						1															
EB	10.930	A	VW-218	30	30		CENTER RUMBLE STRIPS			1				X														
			W16-4p	24	18		ENDS 1000 FT			1																		
SIGN SUMMARY SHEET							SHEET TOTALS	10.50	0.00	3	1	1	5	0	0	2		30.0		0	0.0	0.0	0.0	0.0					
								SF	SF	EA	EA	EA	EA	EA	EA	EA		FT		EA	LB	LB	LB	LB					
VERMONT AGENCY OF TRANSPORTATION							TOWN DIRECTIONAL TOTALS	417.6	0.0	48	2	2	108	0	0	72		1080.0		0			0.0					

PROJECT NAME: **St Albans - Berkshire**
PROJECT NUMBER: **STPG SIGN(36)**

FILE NAME: **SheldonWB.xls** PLOT DATE: **5/17/2011**
PROJECT MANAGER: **A. Gamble** DRAWN BY: **T. Guazzoni**
DESIGNED BY: **T. Guazzoni** CHECKED **A. Gamble**
SHELDON EB SHEET 17 SHEET **48** OF **109**

DIRECTION	MILEPOINT	LOCATION CODE (SHEET 2)	SIGN CODE	WIDTH (IN)	HEIGHT (IN)	SHEETING REMARKS	SIGN LEGEND	NEW SIGNS		EXISTING SIGNS				EXIST POST		NUMBER OF NEW POSTS	SQUARE STEEL (IN)			TUBULAR STEEL Ø (IN)				SIGN FRAME REQUIRED	REMARKS	SIGN DETAIL LOCATION		
								"A"	"B"	RETAIN	SALVAGE FROM	SALVAGE TO	REMOVE	RETAIN	REMOVE		1.75 (LB / FT) 1.88	2.00 (LB / FT) 2.42	2.50 (LB / FT) 3.35	FOUNDATION	3.00 (LB / FT) 7.60	3.50 (LB / FT) 9.00	4.00 (LB / FT) 10.80	5.00 (LB / FT) 14.60			SHSM	PROJECT SHEET #	STANDARD SHEET #
SHELDON VT105 WB							FY-FLUORESCENT YELLOW FYG-FLUORESCENT YELLOW GREEN																		"SHSM"-STANDARD HIGHWAY SIGNS AND MARKINGS			
WB	10.410	G	VR-017	24	30		LEGAL LOAD LIMIT 24000 LBS			1				X											COLTON RD (TH-8)			
WB	10.405	H	R1-1	30	30		STOP			1				X											COLTON RD (TH-8)			
WB	10.280	F	S3-1	30	30								1		X													
		F	S3-1	36	36	FYG		9.00								2		X								X		
WB	9.365	A	VW-622A	36	36		RECREATIONAL TRAIL						1		X													
		A	VW-622P	24	18		ALL SEASON PLAQUE						1															
WB	9.290	A	VW-622A	36	36		RECREATIONAL TRAIL						1		X													
		A	W1-7	21	15		<---> DOUBLE ARROW						1															
WB	9.245	F	W1-2R	30	30		RIGHT CURVE						1		X													
		F	W13-1	18	18		35 MPH PLAQUE						1															
		F	W11-5	30	30			6.25								1		X								X		
WB	9.215	F	W11-5	30	30		FARM MACHINERY SYMBOL						1		X													
		F	W11-15a	30	30			6.25								1		X								X		
		F	W16-7pL	24	12			2.00																		X		
WB	9.105	F	W1-2R	30	30			6.25								1		X							INSTALL NEW SIGNS 740' +/- WEST OF EXISTING	X		
							SHEET TOTALS	29.75	0.00	2	0	0	8	0	0	5		75.0		0	0.0	0.0	0.0	0.0				
								SF	SF	EA	EA	EA	EA	EA	EA	EA		FT		EA	LB	LB	LB	LB				
							TOWN DIRECTIONAL TOTALS	488.5	0.0	48	7	7	103	0	0	81		1215.0		0	0.0							

SIGN SUMMARY SHEET

VERMONT AGENCY OF TRANSPORTATION

PROJECT NAME: **St Albans - Berkshire**
PROJECT NUMBER: **STPG SIGN(36)**

FILE NAME: **SheldonWB.xls** PLOT DATE: **5/17/2011**
PROJECT MANAGER: **A. Gamble** DRAWN BY: **T. Guazzoni**
DESIGNED BY: **T. Guazzoni** CHECKED **A. Gamble**
SHELDON WB SHEET 1 SHEET **49** OF **109**

DIRECTION	MILEPOINT	LOCATION CODE (SHEET 2)	SIGN CODE	WIDTH (IN)	HEIGHT (IN)	SHEETING REMARKS	SIGN LEGEND	NEW SIGNS "A"	NEW SIGNS "B"	EXISTING SIGNS RETAIN	EXISTING SIGNS SALVAGE FROM	EXISTING SIGNS SALVAGE TO	EXISTING SIGNS REMOVE	EXIST POST RETAIN	EXIST POST REMOVE	NUMBER OF NEW POSTS	SQUARE STEEL (IN) 1.75 (LB / FT) 1.88	SQUARE STEEL (IN) 2.00 (LB / FT) 2.42	SQUARE STEEL (IN) 2.50 (LB / FT) 3.35	TUBULAR STEEL Ø (IN) FOUNDATION	TUBULAR STEEL Ø (IN) 3.00 (LB / FT) 7.60	TUBULAR STEEL Ø (IN) 3.50 (LB / FT) 9.00	TUBULAR STEEL Ø (IN) 4.00 (LB / FT) 10.80	TUBULAR STEEL Ø (IN) 5.00 (LB / FT) 14.60	SIGN FRAME REQUIRED	REMARKS	SIGN DETAIL LOCATION SHSM	SIGN DETAIL LOCATION PROJECT SHEET #	SIGN DETAIL LOCATION STANDARD SHEET #
SHELDON VT105 WB							FY-FLUORESCENT YELLOW FYG-FLUORESCENT YELLOW GREEN																				"SHSM"-STANDARD HIGHWAY SIGNS AND MARKINGS			
			W13-1	18	18			2.25																			X		
WB	8.850	F	M2-1	21	15								1		X														
		F	M1-5	30	24								1																
		F	M2-1	21	15			2.19								1		X								GREEN ON WHITE	X		
		F	M1-5	30	24			5.00																					E-136B
WB	8.810	F	VD-062BRN	72	16		BUSINESS SIGN			1				X															
WB	8.780	F	D1-1A	72	10								1		X														
		F	D1-1A	72	10								1																
		F	D1-1A	72	10								1																
		F	VD1-1A	72	12			6.00								2		X										4	
		F	VD1-1A	72	12		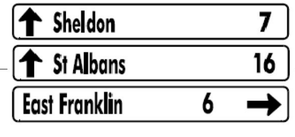	6.00																			4	
		F	VD1-1A	72	12			6.00																				4	
WB	8.750	F	M3-4	24	12		ROUTE MARKERS (6)						1		X														
		F	M1-5	30	24								1																
		F	M6-3	21	15								1																
SIGN SUMMARY SHEET							SHEET TOTALS	27.44	0.00	1	0	0	8	0	0	3		45.0		0	0.0	0.0	0.0	0.0					
								SF	SF	EA	EA	EA	EA	EA	EA	EA		FT		EA	LB	LB	LB	LB					
VERMONT AGENCY OF TRANSPORTATION							TOWN DIRECTIONAL TOTALS	488.5	0.0	48	7	7	103	0	0	81		1215.0		0		0.0							

PROJECT NAME: **St Albans - Berkshire**
PROJECT NUMBER: **STPG SIGN(36)**

FILE NAME: **SheldonWB.xls** PLOT DATE: **5/17/2011**
PROJECT MANAGER: **A. Gamble** DRAWN BY: **T. Guazzoni**
DESIGNED BY: **T. Guazzoni** CHECKED **A. Gamble**
SHELDON WB SHEET 2 SHEET **50** OF **109**

DIRECTION	MILEPOINT	LOCATION CODE (SHEET 2)	SIGN CODE	WIDTH (IN)	HEIGHT (IN)	SHEETING REMARKS	SIGN LEGEND	NEW SIGNS		EXISTING SIGNS				EXIST POST		NUMBER OF NEW POSTS	SQUARE STEEL (IN)			TUBULAR STEEL Ø (IN)				SIGN FRAME REQUIRED	REMARKS	SIGN DETAIL LOCATION		
																	1.75	2.00	2.50	3.00	3.50	4.00	5.00					
																	(LB / FT)			(LB / FT)								
								"A"	"B"	RETAIN	SALVAGE FROM	SALVAGE TO	REMOVE	RETAIN	REMOVE		1.88	2.42	3.35	FOUNDATION	7.60	SLIP BASE ~~9.00~~	10.80	14.60			SHSM	PROJECT SHEET #	STANDARD SHEET #
SHELDON VT105 WB							FY-FLUORESCENT YELLOW FYG-FLUORESCENT YELLOW GREEN																		"SHSM"-STANDARD HIGHWAY SIGNS AND MARKINGS			
		F	M3-1	24	12								1															
		F	M1-5	30	24								1															
		F	M6-1	21	15								1															
		F	M3-4	24	12			2.00								2		X						#2B	GREEN ON WHITE	X		
		F	M1-5	30	24			5.00																				E-136B
		F	M6-3	21	15			2.19																	GREEN ON WHITE	X		
		F	M3-1	24	12		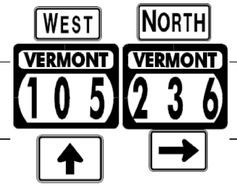	2.00																	GREEN ON WHITE	X		
		F	M1-5	30	24			5.00																				E-136B
		F	M6-1	21	15			2.19																	GREEN ON WHITE	X		
WB	8.700	F	M3-4	24	12		ROUTE MARKERS (2)						1		X													
		F	M1-5	30	24								1															
		F	VD2-1	72	12			6.00								2			X			2			INSTALL ON 2 1/2" SLIP BASES		4	
		F	VD2-1	72	12		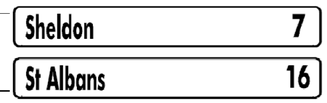	6.00																				4	
		F	M3-4	24	12			2.00																	GREEN ON WHITE	X		
		F	M1-5	30	24			5.00																				E-136B
							SHEET TOTALS	37.38	0.00	0	0	0	5	0	0	4		60.0		0	0.0	2 0.0	0.0	0.0					
								SF	SF	EA	EA	EA	EA	EA	EA	EA		FT		EA	LB	LB	LB	LB					
							TOWN DIRECTIONAL TOTALS	488.5	0.0	48	7	7	103	0	0	81		1215.0		0		0.0							

SIGN SUMMARY SHEET

VERMONT AGENCY OF TRANSPORTATION

PROJECT NAME: **St Albans - Berkshire**
PROJECT NUMBER: **STPG SIGN(36)**

FILE NAME: **SheldonWB.xls**
PROJECT MANAGER: **A. Gamble**
DESIGNED BY: **T. Guazzoni**
DRAWN BY: **T. Guazzoni**
CHECKED **A. Gamble**
PLOT DATE: **5/17/2011**

DIRECTION	MILEPOINT	LOCATION CODE (SHEET 2)	SIGN CODE	WIDTH (IN)	HEIGHT (IN)	SHEETING REMARKS	SIGN LEGEND	NEW SIGNS		EXISTING SIGNS				EXIST POST		NUMBER OF NEW POSTS	SQUARE STEEL (IN)			TUBULAR STEEL Ø (IN)				SIGN FRAME REQUIRED	REMARKS	SIGN DETAIL LOCATION		
								"A"	"B"	RETAIN	SALVAGE FROM	SALVAGE TO	REMOVE	RETAIN	REMOVE		1.75 (LB / FT)	2.00 (LB / FT)	2.50 (LB / FT)	FOUNDATION	3.00 (LB / FT)	3.50 (LB / FT)	4.00 (LB / FT)	5.00 (LB / FT)			SHSM	PROJECT SHEET #	STANDARD SHEET #
																	1.88	2.42	3.35		7.60	9.00	10.80	14.60					
SHELDON VT105 WB							FY-FLUORESCENT YELLOW FYG-FLUORESCENT YELLOW GREEN																			"SHSM"-STANDARD HIGHWAY SIGNS AND MARKINGS			
WB	8.520	F	R2-1	24	30								1		X														
		F	R2-1	24	30		SPEED LIMIT 50	5.00								1		X									X		
WB	7.960	F	D5-5A	24	24		PICNIC AREA SYMBOL						1		X														
		F	VD-058	24	6		AHEAD PLAQUE						1																
WB	7.794	F	RS-044	24	24			4.00								1		X								INSTALL 500' +/- WEST OF PICNIC AREA DRIVEWAY	X		
		F	W16-2A	24	12		500 FT	1.00																		WHITE ON BROWN	X		
WB	7.470	F	W1-4R	30	30		RIGHT REVERSE CURVE						1		X														
		F	W13-1	18	18		40 MPH PLAQUE						1																
WB	7.390	F	W1-4R	30	30			6.25								1		X								INSTALL 420' +/- WEST OF EXISTING LOCATION	X		
		F	W13-1	18	18		40 M.P.H.	2.25																			X		
WB	7.210	F	VW-622A	36	36		RECREATIONAL TRAIL			1				X															
		F	VW-622P	24	18		ALL SEASON PLAQUE			1																			
WB	7.175	F	D4-1	30	24		PARKING			1				X															
WB	7.115	F	W1-6L	48	24			8.00								2		X								INSTALL 50' +/- WEST OF DRIVE #7155	X		
WB	7.080	F	VW-619	36	36		SHOULDER NARROWS						1		X														
SIGN SUMMARY SHEET							SHEET TOTALS	26.50	0.00	3	0	0	6	0	0	5		75.0		0	0.0	0.0	0.0	0.0					
								SF	SF	EA	EA	EA	EA	EA	EA	EA		FT		EA	LB	LB	LB	LB					
VERMONT AGENCY OF TRANSPORTATION							TOWN DIRECTIONAL TOTALS	488.5	0.0	48	7	7	103	0	0	81		1215.0		0		0.0							

PROJECT NAME: **St Albans - Berkshire**
PROJECT NUMBER: **STPG SIGN(36)**

FILE NAME: **SheldonWB.xls** PLOT DATE: **5/17/2011**
PROJECT MANAGER: **A. Gamble** DRAWN BY: **T. Guazzoni**
DESIGNED BY: **T. Guazzoni** CHECKED **A. Gamble**
SHELDON WB SHEET 4 SHEET **52** OF **109**

DIRECTION	MILEPOINT	LOCATION CODE (SHEET 2)	SIGN CODE	WIDTH (IN)	HEIGHT (IN)	SHEETING REMARKS	SIGN LEGEND	NEW SIGNS "A"	NEW SIGNS "B"	EXISTING SIGNS RETAIN	EXISTING SIGNS SALVAGE FROM	EXISTING SIGNS SALVAGE TO	EXISTING SIGNS REMOVE	EXIST POST RETAIN	EXIST POST REMOVE	NUMBER OF NEW POSTS	SQUARE STEEL (IN) 1.75 (LB/FT) 1.88	SQUARE STEEL (IN) 2.00 (LB/FT) 2.42	SQUARE STEEL (IN) 2.50 (LB/FT) 3.35	FOUNDATION	TUBULAR STEEL Ø (IN) 3.00 (LB/FT) 7.60	TUBULAR STEEL Ø (IN) 3.50 (LB/FT) 9.00	TUBULAR STEEL Ø (IN) 4.00 (LB/FT) 10.80	TUBULAR STEEL Ø (IN) 5.00 (LB/FT) 14.60	SIGN FRAME REQUIRED	REMARKS	SIGN DETAIL LOCATION SHSM	SIGN DETAIL LOCATION PROJECT SHEET #	SIGN DETAIL LOCATION STANDARD SHEET #
SHELDON VT105 WB							FY-FLUORESCENT YELLOW FYG-FLUORESCENT YELLOW GREEN																			"SHSM"-STANDARD HIGHWAY SIGNS AND MARKINGS			
WB	7.040	F	VW-622B	36	36		RECREATIONAL TRAIL						1		X													
		F	W1-7	21	15		<---> DOUBLE ARROW						1															
		F	W11-15a	30	30			6.25								1		X								X		
		F	W16-7pL	24	12			2.00																				X		
WB	7.038	B	W1-6R	48	24			8.00								2		X									INSTALL SIGN 10' +/- WEST OF TRAIL CROSSING SIGN	X		
WB	7.000	F	VW-619	36	36			9.00								2		X									INSTALL 420' +/- WEST OF "RECREATIONAL TRAIL" SIGN		7	
WB	6.870	F	M2-1	21	15		JCT						1		X													
		F	M1-5	30	24		VERMONT 120						1															
WB	6.858	F	M2-1	21	15			2.19								1		X									GREEN ON WHITE. INSTALL SIGNS 65' +/- WEST OF EXISTING SIGNS	X		
		F	M1-5	30	24			5.00																						E-136B
WB	6.830	F	D1-1A	72	12		^ SHELDON 5						1		X													
		F	D1-1A	72	12		^ ST ALBANS 15						1															
		F	D1-1A	72	12		FRANKLIN 5 --->						1															
WB	6.778	F	VD1-1A	72	12		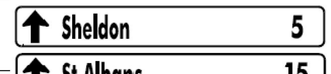	6.00								2		X									INSTALL SIGNS 275' +/- WEST OF EXISTING LOCATION		4	
		F	VD1-1A	72	12		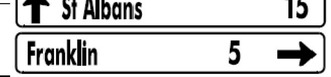	6.00																					4	
							SHEET TOTALS	44.44	0.00	0	0	0	7	0	0	8		120.0		0	0.0	0.0	0.0	0.0				
								SF	SF	EA	EA	EA	EA	EA	EA	EA		FT		EA	LB	LB	LB	LB				
							TOWN DIRECTIONAL TOTALS	488.5	0.0	48	7	7	103	0	0	81		1215.0		0	0.0							

SIGN SUMMARY SHEET

VERMONT AGENCY OF TRANSPORTATION

PROJECT NAME: **St Albans - Berkshire**
PROJECT NUMBER: **STPG SIGN(36)**

FILE NAME: **SheldonWB.xls** PLOT DATE: **5/17/2011**
PROJECT MANAGER: **A. Gamble** DRAWN BY: **T. Guazzoni**
DESIGNED BY: **T. Guazzoni** CHECKED **A. Gamble**

DIRECTION	MILEPOINT	LOCATION CODE (SHEET 2)	SIGN CODE	WIDTH (IN)	HEIGHT (IN)	SHEETING REMARKS	SIGN LEGEND	NEW SIGNS		EXISTING SIGNS				EXIST POST		NUMBER OF NEW POSTS	SQUARE STEEL (IN)			TUBULAR STEEL Ø (IN)				SIGN FRAME REQUIRED	REMARKS	SIGN DETAIL LOCATION		
								"A"	"B"	RETAIN	SALVAGE FROM	SALVAGE TO	REMOVE	RETAIN	REMOVE		1.75 (LB / FT)	2.00 (LB / FT)	2.50 (LB / FT)	FOUNDATION	3.00 (LB / FT)	3.50 (LB / FT)	4.00 (LB / FT)	5.00 (LB / FT)			SHSM	PROJECT SHEET #	STANDARD SHEET #
																	1.88	2.42	3.35		7.60	9.00	10.80	14.60					
SHELDON VT105 WB							FY-FLUORESCENT YELLOW FYG-FLUORESCENT YELLOW GREEN																			"SHSM"-STANDARD HIGHWAY SIGNS AND MARKINGS			
		F	VD1-1A	72	12			6.00																			4	
WB	6.770	F	M3-4	24	12		WEST						1		X													
		F	M1-5	30	24		VERMONT 105						1															
		F	M6-3	21	15		UP ARROW						1															
		F	M3-1	24	12		NORTH						1															
		F	M1-5	30	24		VERMONT 120						1															
		F	M6-1R	21	15		RIGHT ARROW						1															
WB	6.740	F	M3-4	24	12			2.00								2		X							#2B	GREEN ON WHITE. INSTALL SIGNS 10 +/- EAST OF EXISTING UTILITY POLE	X		
		F	M1-5	30	24			5.00																				E-136B
		F	M6-3	21	15			2.19																		GREEN ON WHITE	X		
		F	M3-1	24	12		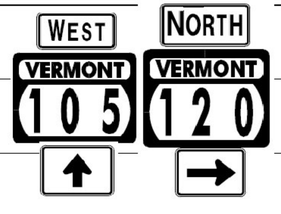	2.00																		GREEN ON WHITE	X		
		F	M1-5	30	24			5.00																				E-136B
		F	M6-1R	21	15			2.19																		GREEN ON WHITE	X		
WB	6.660	F	M3-4	24	12								1		X													
		F	M1-5	24	30								1															
SIGN SUMMARY SHEET							SHEET TOTALS	24.38	0.00	0	0	0	8	0	0	2		30.0		0	0.0	0.0	0.0	0.0					
								SF	SF	EA	EA	EA	EA	EA	EA	EA		FT		EA	LB	LB	LB	LB					
VERMONT AGENCY OF TRANSPORTATION							TOWN DIRECTIONAL TOTALS	488.5	0.0	48	7	7	103	0	0	81		1215.0		0		0.0							

PROJECT NAME: St Albans - Berkshire
PROJECT NUMBER: STPG SIGN(36)

FILE NAME: SheldonWB.xls
PROJECT MANAGER: A. Gamble
DESIGNED BY: T. Guazzoni
SHELDON WB SHEET 6

PLOT DATE: 5/17/2011
DRAWN BY: T. Guazzoni
CHECKED A. Gamble
SHEET 54 OF 109

DIRECTION	MILEPOINT	LOCATION CODE (SHEET 2)	SIGN CODE	WIDTH (IN)	HEIGHT (IN)	SHEETING REMARKS	SIGN LEGEND	NEW SIGNS "A"	NEW SIGNS "B"	EXISTING SIGNS RETAIN	EXISTING SIGNS SALVAGE FROM	EXISTING SIGNS SALVAGE TO	EXISTING SIGNS REMOVE	EXIST POST RETAIN	EXIST POST REMOVE	NUMBER OF NEW POSTS	SQUARE STEEL (IN) 1.75 (LB / FT) 1.88	SQUARE STEEL (IN) 2.00 (LB / FT) 2.42	SQUARE STEEL (IN) 2.50 (LB / FT) 3.35	FOUNDATION	TUBULAR STEEL Ø (IN) 3.00 (LB / FT) 7.60	TUBULAR STEEL Ø (IN) 3.50 (LB / FT) SLIP BASE ~~9.00~~	TUBULAR STEEL Ø (IN) 4.00 (LB / FT) 10.80	TUBULAR STEEL Ø (IN) 5.00 (LB / FT) 14.60	SIGN FRAME REQUIRED	REMARKS	SIGN DETAIL LOCATION SHSM	SIGN DETAIL LOCATION PROJECT SHEET #	SIGN DETAIL LOCATION STANDARD SHEET #
SHELDON VT105 WB							FY-FLUORESCENT YELLOW FYG-FLUORESCENT YELLOW GREEN																			"SHSM"-STANDARD HIGHWAY SIGNS AND MARKINGS			
		F	VD2-1	72	12			6.00								2			X			2				INSTALL ON 2 1/2" SLIP BASES		4	
		F	VD2-1	72	12		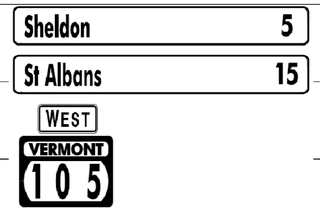	6.00																				4	
		F	M3-4	24	12			2.00																		GREEN ON WHITE	X		
		F	M1-5	24	30			5.00																					E-136B
WB	6.600	F	R2-1	24	30		SPEED LIMIT 50						1		X														
WB	6.580	F	R2-1	24	30			5.00								1		X								INSTALL NEW SIGN 100' +/- WEST OF EXISTING LOCATION	X		
WB	6.500	F	W11-6H	30	30								1		X														
		F	W11-6H	30	30			6.25								1		X								INSTALL IN CLOSED POSITION, 530' +/- WEST OF EXISTING 50 MPH SIGN			E-153
WB	6.040	F	VR-072	24	30								1		X														
		F	VR-072	24	30			5.00								1		X										7	
WB	5.640	F	VR-072	24	30								1		X														
		F	VR-072	24	30			5.00								1		X										7	
WB	5.250	G	VR-017	24	24		LEGAL LOAD LIMIT 24000 LBS			1				X												DANYOW RD (TH-39)			
WB	5.240	H	R1-1	30	30		STOP			1				X												DANYOW RD (TH-39)			
WB	5.130	F	W1-2MbR	36	36		MODIFIED RIGHT CURVE				1		1		X											SALVAGE SIGN TO MP 5.04 +/-			
							SHEET TOTALS	40.25	0.00	2	1	0	5	0	0	6	90.0			0	0.0	~~0.0~~ 2	0.0	0.0				
								SF	SF	EA	EA	EA	EA	EA	EA	EA	FT			EA	LB	LB	LB	LB				
							TOWN DIRECTIONAL TOTALS	488.5	0.0	48	7	7	103	0	0	81	1215.0			0	0.0							

SIGN SUMMARY SHEET

VERMONT AGENCY OF TRANSPORTATION

PROJECT NAME: **St Albans - Berkshire**
PROJECT NUMBER: **STPG SIGN(36)**

FILE NAME: **SheldonWB.xls** PLOT DATE: **5/17/2011**
PROJECT MANAGER: **A. Gamble** DRAWN BY: **T. Guazzoni**
DESIGNED BY: **T. Guazzoni** CHECKED **A. Gamble**
SHELDON WB SHEET 7 SHEET **55** OF **109**

DIRECTION	MILEPOINT	LOCATION CODE (SHEET 2)	SIGN CODE	WIDTH (IN)	HEIGHT (IN)	SHEETING REMARKS	SIGN LEGEND	NEW SIGNS		EXISTING SIGNS				EXIST POST		NUMBER OF NEW POSTS	SQUARE STEEL (IN)			TUBULAR STEEL Ø (IN)				SIGN FRAME REQUIRED	REMARKS	SIGN DETAIL LOCATION		
								"A"	"B"	RETAIN	SALVAGE FROM	SALVAGE TO	REMOVE	RETAIN	REMOVE		1.75 (LB / FT) 1.88	2.00 (LB / FT) 2.42	2.50 (LB / FT) 3.35	FOUNDATION	3.00 (LB / FT) 7.60	3.50 (LB / FT) 9.00	4.00 (LB / FT) 10.80	5.00 (LB / FT) 14.60			SHSM	PROJECT SHEET #	STANDARD SHEET #
SHELDON VT105 WB							FY-FLUORESCENT YELLOW FYG-FLUORESCENT YELLOW GREEN																		"SHSM"-STANDARD HIGHWAY SIGNS AND MARKINGS			
WB	5.040	F	W1-2MbR	36	36		MODIFIED RIGHT CURVE					1				~~2~~ 1		X							INSTALL 475' +/- WEST OF EXISTING LOCATION			
WB	5.000	G	VR-017	24	30		LEGAL LOAD LIMIT 24000 LBS			1				X											DANYOW RD (TH-39)			
WB	4.995	H	R1-1	30	30		STOP			1				X											DANYOW RD (TH-39)			
WB	4.980	H	R1-1	30	30		STOP			1				X											DANYOW RD (TH-39)			
WB	4.889	A	VW-218	30	30		CENTER RUMBLE STRIPS			1				X														
			W16-4p	24	18		ENDS 1000 FT			1																		
WB	4.804	F	W3-5	36	36		SPEED REDUCTION 40 MPH			1				X														
WB	4.740	F	VD-018	30	18		Sheldon Jct Sheldon Springs 1						1		X													
		F	VD-018	30	18			3.75								1		X									7	
WB	4.730	G	VR-017	24	30		LEGAL LOAD LIMIT 24000 LBS			1				X											SHELDON HTS (TH-51)			
WB	4.720	H	R1-1	30	30		STOP			1				X											SHELDON HTS (TH-51)			
WB	4.700	F	R2-1	24	30								1		X													
		F	R2-1	30	36		SPEED LIMIT 40	7.50								1		X									X	
WB	4.683	G	W1-7	48	24		<---> DOUBLE ARROW			1				X														
WB	4.530	F	M2-1	21	15		JCT			1				X														
							SHEET TOTALS	11.25	0.00	10	0	1	2	0	0	~~3~~ 4		60.0		0	0.0	0.0	0.0	0.0				
								SF	SF	EA	EA	EA	EA	EA	EA	EA		FT		EA	LB	LB	LB	LB				
							TOWN DIRECTIONAL TOTALS	488.5	0.0	48	7	7	103	0	0	81		1215.0		0		0.0						

SIGN SUMMARY SHEET

VERMONT AGENCY OF TRANSPORTATION

PROJECT NAME: St Albans - Berkshire
PROJECT NUMBER: STPG SIGN(36)

FILE NAME: SheldonWB.xls
PROJECT MANAGER: A. Gamble
DESIGNED BY: T. Guazzoni
SHELDON WB SHEET 8

PLOT DATE: 5/17/2011
DRAWN BY: T. Guazzoni
CHECKED A. Gamble
SHEET 56 OF 109

DIRECTION	MILEPOINT	LOCATION CODE (SHEET 2)	SIGN CODE	WIDTH (IN)	HEIGHT (IN)	SHEETING REMARKS	SIGN LEGEND	NEW SIGNS		EXISTING SIGNS				EXIST POST		NUMBER OF NEW POSTS	SQUARE STEEL (IN)			TUBULAR STEEL Ø (IN)				SIGN FRAME REQUIRED	REMARKS	SIGN DETAIL LOCATION		
																	1.75	2.00	2.50	3.00	3.50	4.00	5.00				
																	(LB / FT)			(LB / FT)							
								"A"	"B"	RETAIN	SALVAGE FROM	SALVAGE TO	REMOVE	RETAIN	REMOVE		1.88	2.42	3.35	FOUNDATION	7.60	SLIP BASE 9.00	10.80	14.60			SHSM	PROJECT SHEET #	STANDARD SHEET #
SHELDON VT105 WB							FY-FLUORESCENT YELLOW FYG-FLUORESCENT YELLOW GREEN																		"SHSM"-STANDARD HIGHWAY SIGNS AND MARKINGS			
		F	M1-5	24	24		VERMONT 78			1																		
WB	4.490	F	D1-1A	72	10		DESTINATION SIGNS (4)						1		X													
		F	D1-1A	72	10								1															
		F	D1-1A	72	10								1															
		F	D1-1A	72	10								1															
		F	VD1-1A	72	12			6.00								2			X			2					4	
		F	VD1-1A	72	12		Sheldon 3	6.00																			4	
		F	VD1-1A	72	12		St Albans 12	6.00																			4	
		F	VD1-1A	72	12		East Highgate 3	6.00																			4	
		F	VD1-1A	72	12		Swanton 11	6.00																			4	
WB	4.430	F	M3-4	24	12		ROUTE MARKERS (6)						1		X													
		F	M1-5	30	24								1															
		F	M6-2	21	15								1															
		F	M3-4	24	12								1															
		F	M1-5	24	24								1															
		F	M6-2	21	15								1															
							SHEET TOTALS	24.00	0.00	1	0	0	10	0	0	2		30.0		0	0.0	2 ~~0.0~~	0.0	0.0					
								SF	SF	EA	EA	EA	EA	EA	EA	EA		FT		EA	LB	LB	LB	LB					
							TOWN DIRECTIONAL TOTALS	488.5	0.0	48	7	7	103	0	0	81		1215.0		0		0.0							

SIGN SUMMARY SHEET

VERMONT AGENCY OF TRANSPORTATION

PROJECT NAME: St Albans - Berkshire
PROJECT NUMBER: STPG SIGN(36)

FILE NAME: SheldonWB.xls
PROJECT MANAGER: A. Gamble
DESIGNED BY: T. Guazzoni
SHELDON WB SHEET 9

PLOT DATE: 5/17/2011
DRAWN BY: T. Guazzoni
CHECKED A. Gamble
SHEET 57 OF 109

DIRECTION	MILEPOINT	LOCATION CODE (SHEET 2)	SIGN CODE	WIDTH (IN)	HEIGHT (IN)	SHEETING REMARKS	SIGN LEGEND	NEW SIGNS		EXISTING SIGNS				EXIST POST		NUMBER OF NEW POSTS	SQUARE STEEL (IN)			FOUNDATION	TUBULAR STEEL Ø (IN)				SIGN FRAME REQUIRED	REMARKS	SIGN DETAIL LOCATION		
								"A"	"B"	RETAIN	SALVAGE FROM	SALVAGE TO	REMOVE	RETAIN	REMOVE		1.75 (LB / FT) 1.88	2.00 (LB / FT) 2.42	2.50 (LB / FT) 3.35		3.00 (LB / FT) 7.60	3.50 SLIP BASE (LB / FT) 9.00	4.00 (LB / FT) 10.80	5.00 (LB / FT) 14.60			SHSM	PROJECT SHEET #	STANDARD SHEET #
SHELDON VT105 WB							FY-FLUORESCENT YELLOW FYG-FLUORESCENT YELLOW GREEN																			"SHSM"-STANDARD HIGHWAY SIGNS AND MARKINGS			
		F	M3-4	24	12			2.00								2		X							#2A	GREEN ON WHITE	X		
		F	M1-5	30	24			5.00																					E-136B
		F	M6-2L	21	15			2.19																		GREEN ON WHITE	X		
		F	M3-4	24	12			2.00																		GREEN ON WHITE	X		
		F	M1-5	24	24			4.00																					E-136B
		F	M6-2R	21	15			2.19																		GREEN ON WHITE	X		
WB	4.410	F	R2-1	24	30								1		X														
		F	R2-1	24	30			5.00								1		X			2						X		
WB	4.320	F	M3-4	24	12								1		X														
		F	M1-5	30	24								1																
		F	VD2-1	72	12		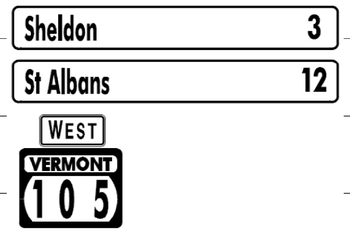	6.00								2			X							INSTALL ON 2 1/2" SLIP BASES		4	
		F	VD2-1	72	12			6.00																				4	
		F	M3-4	24	12			2.00																		INSTALL ON LEFT POST. GREEN ON WHITE	X		
		F	M1-5	30	24			5.00																					E-136B
WB	4.300	F	RL-90	24	24		BICYCLE			1				X															
							SHEET TOTALS	41.38	0.00	1	0	0	3	0	0	5	75.0			0	0.0	2 ~~0.0~~	0.0	0.0					
								SF	SF	EA	EA	EA	EA	EA	EA	EA		FT		EA	LB	LB	LB	LB					
							TOWN DIRECTIONAL TOTALS	488.5	0.0	48	7	7	103	0	0	81	1215.0			0	0.0								

SIGN SUMMARY SHEET

VERMONT AGENCY OF TRANSPORTATION

PROJECT NAME: St Albans - Berkshire
PROJECT NUMBER: STPG SIGN(36)

FILE NAME: SheldonWB.xls
PROJECT MANAGER: A. Gamble
DESIGNED BY: T. Guazzoni
SHELDON WB SHEET 10

PLOT DATE: 5/17/2011
DRAWN BY: T. Guazzoni
CHECKED A. Gamble
SHEET 58 OF 109

DIRECTION	MILEPOINT	LOCATION CODE (SHEET 2)	SIGN CODE	WIDTH (IN)	HEIGHT (IN)	SHEETING REMARKS	SIGN LEGEND	NEW SIGNS		EXISTING SIGNS				EXIST POST		NUMBER OF NEW POSTS	SQUARE STEEL (IN)			TUBULAR STEEL Ø (IN)				SIGN FRAME REQUIRED	REMARKS	SIGN DETAIL LOCATION		
								"A"	"B"	RETAIN	SALVAGE FROM	SALVAGE TO	REMOVE	RETAIN	REMOVE		1.75 (LB / FT) 1.88	2.00 (LB / FT) 2.42	2.50 (LB / FT) 3.35	FOUNDATION	3.00 (LB / FT) 7.60	3.50 (LB / FT) 9.00	4.00 (LB / FT) 10.80	5.00 (LB / FT) 14.60			SHSM	PROJECT SHEET #	STANDARD SHEET #
SHELDON VT105 WB							FY-FLUORESCENT YELLOW FYG-FLUORESCENT YELLOW GREEN																		"SHSM"-STANDARD HIGHWAY SIGNS AND MARKINGS			
		F	RS-034	24	24		PARKING			1																		
		F	M1-6L	21	15		LEFT ARROW			1																		
WB	4.275	F	D2-1	72	10		SHELDON SPRINGS 1						1		X													
		F	D2-1	72	10		ST ALBANS 12						1															
WB	4.250	G	VR-017	24	30		LEGAL LOAD LIMIT 24000 LBS			1				X											CLARK RD (TH-47)			
WB	4.240	H	R1-1	30	30		STOP			1				X											CLARK RD (TH-47)			
WB	4.010	F	VW-622A	36	36		RECREATIONAL TRAIL						~~1~~ 2		X													
		F	VW-622P	24	18		ALL SEASON PLAQUE						1															
WB	3.976	F	VD-062BRN	72	16		BUSINESS SIGN			1				X														
WB	3.933	F	D1-1A	72	12								1		X													
		F	D1-1A	72	12								1															
		F	VD1-1A	72	12		← Sheldon 2	6.00								2		X									4	
		F	VD1-1A	72	12		← Fairfield 8	6.00																			4	
WB	3.905	F	VW-622A	36	36		RECREATIONAL TRAIL						1		X													
		F	W16-7pL	24	12		45 DEG LEFT ARROW						1															
SIGN SUMMARY SHEET							SHEET TOTALS	12.00	0.00	5	0	0	~~9~~ 8	0	0	2		30.0		0	0.0	0.0	0.0	0.0				
								SF	SF	EA	EA	EA	EA	EA	EA	EA		FT		EA	LB	LB	LB	LB				
VERMONT AGENCY OF TRANSPORTATION							TOWN DIRECTIONAL TOTALS	488.5	0.0	48	7	7	103	0	0	81		1215.0		0	0.0							

PROJECT NAME: **St Albans - Berkshire**
PROJECT NUMBER: **STPG SIGN(36)**
FILE NAME: **SheldonWB.xls**
PROJECT MANAGER: **A. Gamble**
DESIGNED BY: **T. Guazzoni**
SHELDON WB SHEET 11
PLOT DATE: **5/17/2011**
DRAWN BY: **T. Guazzoni**
CHECKED **A. Gamble**
SHEET **59** OF **109**

DIRECTION	MILEPOINT	LOCATION CODE (SHEET 2)	SIGN CODE	WIDTH (IN)	HEIGHT (IN)	SHEETING REMARKS	SIGN LEGEND	NEW SIGNS		EXISTING SIGNS				EXIST POST		NUMBER OF NEW POSTS	SQUARE STEEL (IN)			TUBULAR STEEL Ø (IN)				SIGN FRAME REQUIRED	REMARKS	SIGN DETAIL LOCATION		
								"A"	"B"	RETAIN	SALVAGE FROM	SALVAGE TO	REMOVE	RETAIN	REMOVE		1.75	2.00	2.50	3.00	3.50	4.00	5.00			SHSM	PROJECT SHEET #	STANDARD SHEET #
																	(LB / FT)			(LB / FT)								
																	1.88	2.42	3.35	7.60	9.00	10.80	14.60					
SHELDON VT105 WB							FY-FLUORESCENT YELLOW FYG-FLUORESCENT YELLOW GREEN																		"SHSM"-STANDARD HIGHWAY SIGNS AND MARKINGS				
		F	W11-15a	30	30			6.25								1		X								X		
		F	W16-7pL	24	12			2.00																		X		
WB	3.880	G	W1-7	48	24		<---> LARGE ARROW			1				X														
WB	3.866	F	M3-4	24	12		WEST			1				X														
		F	M1-5	30	24		VERMONT 105			1																		
WB	3.800	F	R2-1	24	30								1		X													
		F	R2-1	24	30			5.00								1		X						X		
WB	3.640	G	VR-017	24	30		LEGAL LOAD LIMIT 24000 LBS			1				X											BERGERON RD (TH-21)			
WB	3.630	H	R1-1	30	30		STOP			1				X											BERGERON RD (TH-21)			
WB	3.432	F	W3-5	36	36		SPEED REDUCTION 40 MPH			1				X														
WB	3.350	F	VD-018	30	18		VILLAGE SIGN			1				X														
WB	3.337	F	R2-1	24	30								1		X													
		F	R2-1	30	36			7.50								1		X						X		
WB	3.261	F	S1-1	36	36		SCHOOL			1				X														
		F	W16-9	30	18		AHEAD						1															
SIGN SUMMARY SHEET							SHEET TOTALS	20.75	0.00	8	0	0	3	0	0	3	45.0			0	0.0	0.0	0.0	0.0					
								SF	SF	EA	EA	EA	EA	EA	EA	EA	FT			EA	LB	LB	LB	LB					
VERMONT AGENCY OF TRANSPORTATION							TOWN DIRECTIONAL TOTALS	488.5	0.0	48	7	7	103	0	0	81	1215.0			0	0.0								

PROJECT NAME: **St Albans - Berkshire**
PROJECT NUMBER: **STPG SIGN(36)**

FILE NAME: **SheldonWB.xls** PLOT DATE: **5/17/2011**
PROJECT MANAGER: **A. Gamble** DRAWN BY: **T. Guazzoni**
DESIGNED BY: **T. Guazzoni** CHECKED **A. Gamble**
SHELDON WB SHEET 12 SHEET **60** OF **109**

DIRECTION	MILEPOINT	LOCATION CODE (SHEET 2)	SIGN CODE	WIDTH (IN)	HEIGHT (IN)	SHEETING REMARKS	SIGN LEGEND	NEW SIGNS "A"	NEW SIGNS "B"	EXISTING SIGNS RETAIN	EXISTING SIGNS SALVAGE FROM	EXISTING SIGNS SALVAGE TO	EXISTING SIGNS REMOVE	EXIST POST RETAIN	EXIST POST REMOVE	NUMBER OF NEW POSTS	SQUARE STEEL (IN) 1.75 (LB/FT) 1.88	SQUARE STEEL (IN) 2.00 (LB/FT) 2.42	SQUARE STEEL (IN) 2.50 (LB/FT) 3.35	FOUNDATION	TUBULAR STEEL Ø (IN) 3.00 (LB/FT) 7.60	TUBULAR STEEL Ø (IN) 3.50 (LB/FT) 9.00	TUBULAR STEEL Ø (IN) 4.00 (LB/FT) 10.80	TUBULAR STEEL Ø (IN) 5.00 (LB/FT) 14.60	SIGN FRAME REQUIRED	REMARKS	SIGN DETAIL LOCATION SHSM	SIGN DETAIL LOCATION PROJECT SHEET #	SIGN DETAIL LOCATION STANDARD SHEET #
SHELDON VT105 WB							FY-FLUORESCENT YELLOW FYG-FLUORESCENT YELLOW GREEN																			"SHSM"-STANDARD HIGHWAY SIGNS AND MARKINGS			
		F	S4-3p	36	12	FYG	SCHOOL	3.00																		INSTALL BELOW EXISTING SCHOOL SYMBOL SIGN	X		
WB	3.245	F	D1-1E	72	10								1		X													
		F	D1-2(L)	72	20		Sheldon Elementary School	10.00								2		X										4	
WB	3.221	F	S4-3	24	8		SCHOOL PLAQUE			1				X														
		F	R2-1	24	30		SPEED LIMIT 35			1																		
		F	S4-4	24	12		WHEN FLASHING			1																		
WB	3.180	F	S1-1	36	36		SCHOOL			1				X														
		F	W16-7pL	24	12		DIAGONAL ARROW LEFT (45 DEG)			1																		
WB	3.084	F	W2-3R	30	30		INTERSECTION WARNING				1		1		X													
		F	W16-8A	24	8		MILL ST PLAQUE				1		1															
		F	W11-8	30	30			6.25								2		X								INSTALL ON TOP OF POSTS	X		
		F	W2-3R	30	30		INTERSECTION WARNING					1														INSTALL BELOW EMERGENCY VEHICLE SIGN			
		F	W16-8A	24	8		MILL ST PLAQUE					1														INSTALL ON LEFT POST			
WB	3.051	F	S1-1	30	30		SCHOOL			1				X														
		F	W16-7	24	12		DIAGONAL ARROW LEFT (45 DEG)			1																		
							SHEET TOTALS	19.25	0.00	7	2	2	3	0	0	4		60.0		0	0.0	0.0	0.0	0.0					
								SF	SF	EA	EA	EA	EA	EA	EA	EA		FT		EA	LB	LB	LB	LB					
							TOWN DIRECTIONAL TOTALS	488.5	0.0	48	7	7	103	0	0	81		1215.0		0		0.0							

SIGN SUMMARY SHEET

VERMONT AGENCY OF TRANSPORTATION

PROJECT NAME: **St Albans - Berkshire**
PROJECT NUMBER: **STPG SIGN(36)**

FILE NAME: **SheldonWB.xls**
PROJECT MANAGER: **A. Gamble**
DESIGNED BY: **T. Guazzoni**
SHELDON WB SHEET 13

PLOT DATE: **5/17/2011**
DRAWN BY: **T. Guazzoni**
CHECKED **A. Gamble**
SHEET **61** OF **109**

DIRECTION	MILEPOINT	LOCATION CODE (SHEET 2)	SIGN CODE	WIDTH (IN)	HEIGHT (IN)	SHEETING REMARKS	SIGN LEGEND	NEW SIGNS "A"	NEW SIGNS "B"	EXISTING SIGNS RETAIN	EXISTING SIGNS SALVAGE FROM	EXISTING SIGNS SALVAGE TO	EXISTING SIGNS REMOVE	EXIST POST RETAIN	EXIST POST REMOVE	NUMBER OF NEW POSTS	SQUARE STEEL (IN) 1.75 (LB / FT) 1.88	SQUARE STEEL (IN) 2.00 (LB / FT) 2.42	SQUARE STEEL (IN) 2.50 (LB / FT) 3.35	TUBULAR STEEL Ø (IN) FOUNDATION	TUBULAR STEEL Ø (IN) 3.00 (LB / FT) 7.60	TUBULAR STEEL Ø (IN) 3.50 (LB / FT) 9.00	TUBULAR STEEL Ø (IN) 4.00 (LB / FT) 10.80	TUBULAR STEEL Ø (IN) 5.00 (LB / FT) 14.60	SIGN FRAME REQUIRED	REMARKS	SIGN DETAIL LOCATION SHSM	SIGN DETAIL LOCATION PROJECT SHEET #	SIGN DETAIL LOCATION STANDARD SHEET #
SHELDON VT105 WB							FY-FLUORESCENT YELLOW FYG-FLUORESCENT YELLOW GREEN																			"SHSM"-STANDARD HIGHWAY SIGNS AND MARKINGS			
WB	2.980	F	R2-1	24	30		SPEED LIMIT 40				1	1	1		X	1		X									
		F	S5-3	24	30		END SCHOOL SPEED LIMIT	5.00																			X		
WB	2.970	H	R1-1	30	30		STOP			1				X												MILL ST (TH-1)			
		G	VR-017	24	30		LEGAL LOAD LIMIT 24000 LBS				1	1	1			1		X								MILL ST (TH-1) INSTALL SIGN ON NEW POST DIRECTLY BEHIND STOP SIGN			
WB	2.950	H	R1-1	30	30		STOP			1				X												MILL ST (TH-1)			
WB	2.869	F	R2-1	24	30		SPEED LIMIT 40			1				X															
WB	2.830	F	VW-622A	36	36		RECREATIONAL TRAIL						1		X														
		F	VW-622P	24	18		ALL SEASON PLAQUE						1																
WB	2.750	G	VR-017	24	30		LEGAL LOAD LIMIT 24000 LBS			1				X												SHAWVILLE RD (TH-28)			
WB	2.745	H	R1-1	30	30		STOP			1				X												SHAWVILLE RD (TH-28)			
WB	2.730	F	VW-622A	36	36		RECREATIONAL TRAIL						1		X														
		F	W1-7	24	12		<---> DOUBLE ARROW						1																
		F	W11-15a	30	30		TRAIL CROSSING	6.25								1		X									X		
		F	W16-7pL	24	12			2.00																			X		
WB	2.640	F	R2-1	24	30		SPEED LIMIT 50			1				X															
							SHEET TOTALS	13.25	0.00	6	2	2	6	0	0	3		45.0		0	0.0	0.0	0.0	0.0					
								SF	SF	EA	EA	EA	EA	EA	EA	EA		FT		EA	LB	LB	LB	LB					
							TOWN DIRECTIONAL TOTALS	488.5	0.0	48	7	7	103	0	0	81		1215.0		0		0.0							

SIGN SUMMARY SHEET

VERMONT AGENCY OF TRANSPORTATION

PROJECT NAME: **St Albans - Berkshire**
PROJECT NUMBER: **STPG SIGN(36)**

FILE NAME: **SheldonWB.xls** PLOT DATE: **5/17/2011**
PROJECT MANAGER: **A. Gamble** DRAWN BY: **T. Guazzoni**
DESIGNED BY: **T. Guazzoni** CHECKED **A. Gamble**
SHELDON WB SHEET 14 SHEET **62** OF **109**

DIRECTION	MILEPOINT	LOCATION CODE (SHEET 2)	SIGN CODE	WIDTH (IN)	HEIGHT (IN)	SHEETING REMARKS	SIGN LEGEND	NEW SIGNS "A"	NEW SIGNS "B"	EXISTING SIGNS RETAIN	EXISTING SIGNS SALVAGE FROM	EXISTING SIGNS SALVAGE TO	EXISTING SIGNS REMOVE	EXIST POST RETAIN	EXIST POST REMOVE	NUMBER OF NEW POSTS	SQUARE STEEL (IN) 1.75 (LB / FT) 1.88	SQUARE STEEL (IN) 2.00 (LB / FT) 2.42	SQUARE STEEL (IN) 2.50 (LB / FT) 3.35	TUBULAR STEEL Ø (IN) FOUNDATION	TUBULAR STEEL Ø (IN) 3.00 (LB / FT) 7.60	TUBULAR STEEL Ø (IN) 3.50 (LB / FT) 9.00	TUBULAR STEEL Ø (IN) 4.00 (LB / FT) 10.80	TUBULAR STEEL Ø (IN) 5.00 (LB / FT) 14.60	SIGN FRAME REQUIRED	REMARKS	SIGN DETAIL LOCATION SHSM	SIGN DETAIL LOCATION PROJECT SHEET #	SIGN DETAIL LOCATION STANDARD SHEET #
SHELDON VT105 WB							FY-FLUORESCENT YELLOW FYG-FLUORESCENT YELLOW GREEN																			"SHSM"-STANDARD HIGHWAY SIGNS AND MARKINGS			
WB	2.489	F	W2-3R	30	30		RIGHT ANGLE SIDE ROAD					1				1		X								SALVAGED FROM MP 2.484			
		F	W16-8A	24	8		MILL ST PLAQUE					1																	
WB	2.484	F	W2-3R	30	30		RIGHT ANGLE SIDE ROAD				1		1		X											SIGNS BEHIND POLE. SALVAGE TO MP 2.489			
		F	W16-8A	24	8		MILL ST PLAQUE				1		1																
WB	2.380	G	VR-017	24	30		LEGAL LOAD LIMIT 24000 LBS			1				X												MILL ST (TH-43)			
WB	2.375	H	R1-1	30	30		STOP			1				X												MILL ST (TH-43)			
WB	2.360	H	R1-1	30	30		STOP						1		X											MILL ST (TH-43)			
WB	2.130	F	W1-2L	30	30		LEFT CURVE						1		X														
WB	2.040	F	W1-2L	30	30			6.25								1		X								INSTALL SIGN 475' +/- WEST OF EXISTING	X		
WB	1.860	F	VW-060	30	30								1		X														
		F	VW-060	30	30			6.25								1		X									7	
WB	1.800	F	S3-1	30	30								1		X														
		F	S3-1	36	36	FYG		9.00								2		X									X		
WB	1.310	F	W11-4	30	30		CATTLE						1		X														
WB	1.160	F	W1-1ML	30	30		MODIFIED LEFT TURN						1		X														
							SHEET TOTALS	21.50	0.00	2	2	2	8	0	0	5		75.0		0	0.0	0.0	0.0	0.0					
								SF	SF	EA	EA	EA	EA	EA	EA	EA		FT		EA	LB	LB	LB	LB					
							TOWN DIRECTIONAL TOTALS	488.5	0.0	48	7	7	103	0	0	81		1215.0		0	0.0								

SIGN SUMMARY SHEET

VERMONT AGENCY OF TRANSPORTATION

PROJECT NAME: **St Albans - Berkshire**
PROJECT NUMBER: **STPG SIGN(36)**

FILE NAME: **SheldonWB.xls** PLOT DATE: **5/17/2011**
PROJECT MANAGER: **A. Gamble** DRAWN BY: **T. Guazzoni**
DESIGNED BY: **T. Guazzoni** CHECKED **A. Gamble**
SHELDON WB SHEET 15 SHEET **63** OF **109**

DIRECTION	MILEPOINT	LOCATION CODE (SHEET 2)	SIGN CODE	WIDTH (IN)	HEIGHT (IN)	SHEETING REMARKS	SIGN LEGEND	NEW SIGNS "A"	NEW SIGNS "B"	EXISTING SIGNS RETAIN	EXISTING SIGNS SALVAGE FROM	EXISTING SIGNS SALVAGE TO	EXISTING SIGNS REMOVE	EXIST POST RETAIN	EXIST POST REMOVE	NUMBER OF NEW POSTS	SQUARE STEEL (IN) 1.75 (LB / FT) 1.88	SQUARE STEEL (IN) 2.00 (LB / FT) 2.42	SQUARE STEEL (IN) 2.50 (LB / FT) 3.35	TUBULAR STEEL Ø (IN) FOUNDATION	TUBULAR STEEL Ø (IN) 3.00 (LB / FT) 7.60	TUBULAR STEEL Ø (IN) 3.50 (LB / FT) 9.00	TUBULAR STEEL Ø (IN) 4.00 (LB / FT) 10.80	TUBULAR STEEL Ø (IN) 5.00 (LB / FT) 14.60	SIGN FRAME REQUIRED	REMARKS	SIGN DETAIL LOCATION SHSM	SIGN DETAIL LOCATION PROJECT SHEET #	SIGN DETAIL LOCATION STANDARD SHEET #
SHELDON VT105 WB							FY-FLUORESCENT YELLOW FYG-FLUORESCENT YELLOW GREEN																			"SHSM"-STANDARD HIGHWAY SIGNS AND MARKINGS			
		F	W13-1	18	18		30 MPH PLAQUE						1															
WB	1.080	F	W1-1McL	36	36			9.00								2		X								INSTALL 425' +/- WEST OF EXISTING		5	
		F	W13-1	18	18			2.25																			X		
WB	1.060	F	W1-6L	48	24			8.00								2		X								INSTALL SIGN TO FACE WB TRAFFIC, 5' +/- EAST OF EXISTING ARROW	X		
WB	1.060	E	W1-6	48	24								1		X														
		E	W1-6R	48	24			8.00								2		X									X		
WB	1.050	E	W1-6	48	24		LARGE ARROW						1		X														
WB	1.040	G	VR-017	24	30								1		X														
		G	VR-017	24	30			5.00								1		X								MACHIA RD (TH-6)		7	
WB	1.020	H	R1-1	30	30								1		X														
		H	R1-1	30	30			6.25								1		X								MACHIA RD (TH-6)	X		
WB	1.020	F	W1-6	48	24								1		X														
		F	W1-6L	48	24			8.00								2		X									X		
WB	1.020	E	W1-6R	48	24			8.00								2		X								INSTALL SIGN TO FACE WB TRAFFIC, 5' +/- EAST OF EXISTING ARROW	X		
WB	1.020	G	VR-017	24	30								1		X														
							SHEET TOTALS	54.50	0.00	0	0	0	7	0	0	12		180.0		0	0.0	0.0	0.0	0.0					
								SF	SF	EA	EA	EA	EA	EA	EA	EA		FT		EA	LB	LB	LB	LB					
							TOWN DIRECTIONAL TOTALS	488.5	0.0	48	7	7	103	0	0	81		1215.0		0		0.0							

SIGN SUMMARY SHEET

VERMONT AGENCY OF TRANSPORTATION

PROJECT NAME: **St Albans - Berkshire**
PROJECT NUMBER: **STPG SIGN(36)**

FILE NAME: **SheldonWB.xls** PLOT DATE: **5/17/2011**
PROJECT MANAGER: **A. Gamble** DRAWN BY: **T. Guazzoni**
DESIGNED BY: **T. Guazzoni** CHECKED **A. Gamble**
SHELDON WB SHEET 16 SHEET **64** OF **109**

DIRECTION	MILEPOINT	LOCATION CODE (SHEET 2)	SIGN CODE	WIDTH (IN)	HEIGHT (IN)	SHEETING REMARKS	SIGN LEGEND	NEW SIGNS		EXISTING SIGNS				EXIST POST		NUMBER OF NEW POSTS	SQUARE STEEL (IN)			TUBULAR STEEL Ø (IN)				FOUNDATION	SIGN FRAME REQUIRED	REMARKS	SIGN DETAIL LOCATION		
								"A"	"B"	RETAIN	SALVAGE FROM	SALVAGE TO	REMOVE	RETAIN	REMOVE		1.75	2.00	2.50	3.00	3.50	4.00	5.00				SHSM	PROJECT SHEET #	STANDARD SHEET #
																	(LB / FT)			(LB / FT)									
																	1.88	2.42	3.35	7.60	9.00	10.80	14.60						
SHELDON VT105 WB							FY-FLUORESCENT YELLOW FYG-FLUORESCENT YELLOW GREEN																			"SHSM"-STANDARD HIGHWAY SIGNS AND MARKINGS			
		G	VR-017	24	30		LEGAL LOAD LIMIT 24,000 POUNDS	5.00								1		X								WOODS HILL RD (TH-5)		7	
WB	1.010	H	R1-1	30	30								1		X											HAD TO USE OLD POSTS. SEE NOTE BELOW			
		H	R1-1	30	30		STOP	6.25								~~1~~		X								WOODS HILL RD (TH-5)	X		
WB	1.010	F	W1-6	48	24								1		X														
		F	W1-6	48	24			8.00								~~2~~		X								HAD TO USE OLD POSTS. THEY WERE IN PAVEMENT, DID NOT WANT TO DISTURB.	X		
WB	0.950	F	R2-1	24	30								1		X														
		F	R2-1	24	30		SPEED LIMIT 50	5.00								1		X									X		
WB	0.843	F	W1-2MR	30	30		MODIFIED RIGHT CURVE						1		X														
		F	W13-1	18	18		40 MPH PLAQUE						1																
WB	0.785	F	W1-2McR	36	36			9.00				~~1~~	1			2		X								INSTALL 300' +/- WEST OF EXISTING LOCATION		5	
		F	W1-2McR	18	18		40 M.P.H.	2.25																		MOVES AT PROPERTY OWNERS REQUEST.	X		
WB	0.586	F	R2-1	24	30								1		X														
		F	R2-1	24	30		SPEED LIMIT 50	5.00								1		X									X		
							SHEET TOTALS	40.50	0.00	0	0	~~0~~ 1	~~6~~ 7	0	0	~~8~~ 5		120.0		0	0.0	0.0	0.0	0.0						
								SF	SF	EA	EA	EA	EA	EA	EA	EA		FT		EA	LB	LB	LB	LB						
							TOWN DIRECTIONAL TOTALS	488.5	0.0	48	7	7	103	0	0	81		1215.0		0			0.0						

SIGN SUMMARY SHEET

VERMONT AGENCY OF TRANSPORTATION

PROJECT NAME: **St Albans - Berkshire**
PROJECT NUMBER: **STPG SIGN(36)**

FILE NAME: **SheldonWB.xls**
PROJECT MANAGER: **A. Gamble**
DESIGNED BY: **T. Guazzoni**
SHELDON WB SHEET 17

PLOT DATE: **5/17/2011**
DRAWN BY: **T. Guazzoni**
CHECKED **A. Gamble**
SHEET **65** OF **109**

DIRECTION	MILEPOINT	LOCATION CODE (SHEET 2)	SIGN CODE	WIDTH (IN)	HEIGHT (IN)	SHEETING REMARKS	SIGN LEGEND	NEW SIGNS "A"	NEW SIGNS "B"	EXISTING SIGNS RETAIN	EXISTING SIGNS SALVAGE FROM	EXISTING SIGNS SALVAGE TO	EXISTING SIGNS REMOVE	EXIST POST RETAIN	EXIST POST REMOVE	NUMBER OF NEW POSTS	SQUARE STEEL (IN) 1.75 / 2.00 / 2.50 (LB / FT) 1.88 / 2.42 / 3.35	FOUNDATION	TUBULAR STEEL Ø (IN) 3.00 / 3.50 / 4.00 / 5.00 (LB / FT) 7.60 / 9.00 / 10.80 / 14.60	SIGN FRAME REQUIRED	REMARKS	SIGN DETAIL LOCATION SHSM	SIGN DETAIL LOCATION PROJECT SHEET #	SIGN DETAIL LOCATION STANDARD SHEET #
ENOSBURG VT105 EB							FY-FLUORESCENT YELLOW FYG-FLUORESCENT YELLOW GREEN														"SHSM"-STANDARD HIGHWAY SIGNS AND MARKINGS			
EB	0.000	C	VD-024	60	7.5								3 ~~1~~		X									
		C	VD-024	72	10			5.00								2	X					4	
		C	VD-700	6	10			0.42															E-138
		C	VD-700	6	10			0.42															E-138
EB	0.044	A	R2-5A	24	30		REDUCED SPEED AHEAD						1		X									
		A	W3-5	36	36			9.00								2	X					X		
EB	0.070	A	VW-622A	36	36		RECREATIONAL TRAIL						1		X									
		A	W1-7	24	12		<----> DOUBLE ARROW						1											
		A	W11-15a	30	30			6.25								1	X					X	
		A	W16-7pL	24	12			2.00														X		
EB	0.082	A	VD-018	30	18								1		X									
		A	VD-018	30	18			3.75								1	X						7	
EB	0.100	A	VR-072	24	30								1		X									
		A	VR-072	24	30			5.00								1	X						7	
EB	0.120	A	R2-1	24	30								1		X									
							SHEET TOTALS	31.84	0.00	0	0	0	~~9~~ 7	0	0	7	105.0		0	0.0	0.0	0.0	0.0			
								SF	SF	EA	EA	EA	EA	EA	EA	EA	FT		EA	LB	LB	LB	LB			
							TOWN DIRECTIONAL TOTALS	393.9	0.0	25	4	4	94	0	0	58	870.0		2	235.6						

SIGN SUMMARY SHEET

VERMONT AGENCY OF TRANSPORTATION

PROJECT NAME: **St Albans - Berkshire**
PROJECT NUMBER: **STPG SIGN(36)**

FILE NAME: **EnosburgEB.xls**
PROJECT MANAGER: **A. Gamble**
DESIGNED BY: **T. Guazzoni**
DRAWN BY: **T. Guazzoni**
CHECKED **A. Gamble**
PLOT DATE: **5/17/2011**
ENOSBURG EB SHEET 1
SHEET **66** OF **109**

DIRECTION	MILEPOINT	LOCATION CODE (SHEET 2)	SIGN CODE	WIDTH (IN)	HEIGHT (IN)	SHEETING REMARKS	SIGN LEGEND	NEW SIGNS "A"	NEW SIGNS "B"	EXISTING SIGNS RETAIN	EXISTING SIGNS SALVAGE FROM	EXISTING SIGNS SALVAGE TO	EXISTING SIGNS REMOVE	EXIST POST RETAIN	EXIST POST REMOVE	NUMBER OF NEW POSTS	SQUARE STEEL (IN) 1.75 (LB / FT) 1.88	SQUARE STEEL (IN) 2.00 (LB / FT) 2.42	SQUARE STEEL (IN) 2.50 (LB / FT) 3.35	FOUNDATION	TUBULAR STEEL Ø (IN) 3.00 (LB / FT) 7.60	TUBULAR STEEL Ø (IN) 3.50 (LB / FT) 9.00	TUBULAR STEEL Ø (IN) 4.00 (LB / FT) 10.80	TUBULAR STEEL Ø (IN) 5.00 (LB / FT) 14.60	SIGN FRAME REQUIRED	REMARKS	SIGN DETAIL LOCATION SHSM	SIGN DETAIL LOCATION PROJECT SHEET #	SIGN DETAIL LOCATION STANDARD SHEET #
ENOSBURG VT105 EB							FY-FLUORESCENT YELLOW FYG-FLUORESCENT YELLOW GREEN																				"SHSM"-STANDARD HIGHWAY SIGNS AND MARKINGS			
		A	R2-1	30	36			7.50								1		X								X		
EB	0.295	C	VR-017	24	24		LEGAL LOAD LIMIT 24000 LBS			1				X												ST ALBANS ST (TH-7)			
EB	0.300	D	R1-1	24	24		STOP			1				X												ST ALBANS ST (TH-7)			
EB	0.305	D	R1-1	24	24		STOP			1				X												ST ALBANS ST (TH-7)			
EB	0.360	A	VD-062AS	72	16		BUSINESS SIGN			1				X															
		A	VD-062AL	72	16		BUSINESS SIGN			1																			
		A	VD-062AS	72	16		BUSINESS SIGN			1																			
EB	0.400	A	R2-5A	24	30		REDUCED SPEED AHEAD						1		X															
		A	W3-5	36	36			9.00								2		X									X		
EB	0.410	C	VR-017	24	24		LEGAL LOAD LIMIT 24000 LBS			1				X												CENTER ST (TH-103)			
EB	0.415	D	R1-1	24	24		STOP			1				X												CENTER ST (TH-103)			
EB	0.464	A	R2-1	24	30								1		X														
		A	VR-038	24	18								1																
		A	VR-038	24	18			3.00								1		X								X		
		A	R2-1	24	30			5.00																					
							SHEET TOTALS	24.50	0.00	8	0	0	3	0	0	4		60.0		0	0.0	0.0	0.0	0.0					
								SF	SF	EA	EA	EA	EA	EA	EA	EA		FT		EA	LB	LB	LB	LB					
							TOWN DIRECTIONAL TOTALS	393.9	0.0	25	4	4	94	0	0	58		870.0		2		235.6							

SIGN SUMMARY SHEET

VERMONT AGENCY OF TRANSPORTATION

PROJECT NAME: **St Albans - Berkshire**
PROJECT NUMBER: **STPG SIGN(36)**

FILE NAME: **EnosburgEB.xls** PLOT DATE: **5/17/2011**
PROJECT MANAGER: **A. Gamble** DRAWN BY: **T. Guazzoni**
DESIGNED BY: **T. Guazzoni** CHECKED **A. Gamble**
ENOSBURG EB SHEET 2 SHEET **67** OF **109**

DIRECTION	MILEPOINT	LOCATION CODE (SHEET 2)	SIGN CODE	WIDTH (IN)	HEIGHT (IN)	SHEETING REMARKS	SIGN LEGEND	NEW SIGNS "A"	NEW SIGNS "B"	EXISTING SIGNS RETAIN	EXISTING SIGNS SALVAGE FROM	EXISTING SIGNS SALVAGE TO	EXISTING SIGNS REMOVE	EXIST POST RETAIN	EXIST POST REMOVE	NUMBER OF NEW POSTS	SQUARE STEEL (IN) 1.75 (LB/FT) 1.88	SQUARE STEEL (IN) 2.00 (LB/FT) 2.42	SQUARE STEEL (IN) 2.50 (LB/FT) 3.35	FOUNDATION	TUBULAR STEEL Ø (IN) 3.00 (LB/FT) 7.60	TUBULAR STEEL Ø (IN) 3.50 (LB/FT) 9.00	TUBULAR STEEL Ø (IN) 4.00 (LB/FT) 10.80	TUBULAR STEEL Ø (IN) 5.00 (LB/FT) 14.60	SIGN FRAME REQUIRED	REMARKS	SIGN DETAIL LOCATION SHSM	SIGN DETAIL LOCATION PROJECT SHEET #	SIGN DETAIL LOCATION STANDARD SHEET #
ENOSBURG VT105 EB							FY-FLUORESCENT YELLOW FYG-FLUORESCENT YELLOW GREEN																				"SHSM"-STANDARD HIGHWAY SIGNS AND MARKINGS			
			BEGIN CLASS 1 SECTION - VILLAGE OF ENOSBURG FALLS"																										
EB	0.527	A	W11-2	30	30	**FYG**		6.25								1		X								INSTALL 200' +/- WEST OF EXISTING ROUTE MARKER ASSEMBLY	X		
		A	W7-3A	24	18	**FYG**		~~2.00~~ 3.00																			X		
EB	0.560	A	UNK.	UNK	UNK		EVANGALIST CHURCH						1		X												RETURN SIGN TO VILLAGE			
EB	0.565	A	M2-1	21	15								1		X															
		A	M1-5A	30	24								1																	
		A	M2-1	21	15			2.19								1		X								GREEN ON WHITE	X		
		A	M1-5A	30	24			5.00																					E-136B
EB	0.615	A	W11-2	30	30		PEDESTRIAN			1				X																
		A	W16-7pL	24	12		LEFT DIAGONAL ARROW			1																				
EB	0.620	C	VR-017	24	30			5.00								1		X								CHURCH ST (TH-105). INSTALL ON RT SIDE OF CHURCH ST.		7	
EB	0.630	D	R1-1	30	30								1		X															
		C	D3-1	UNK	UNK								1																	
		A	D3-1	UNK	UNK								1																	
		C	D3-1	24	8			1.33																			INSTALL ABOVE STOP SIGN		6	
SIGN SUMMARY SHEET							SHEET TOTALS	~~21.77~~ 22.77	0.00	2	0	0	6	0	0	3		45.0		0	0.0	0.0	0.0	0.0					
								SF	SF	EA	EA	EA	EA	EA	EA	EA		FT		EA	LB	LB	LB	LB					
VERMONT AGENCY OF TRANSPORTATION							TOWN DIRECTIONAL TOTALS	393.9	0.0	25	4	4	94	0	0	58		870.0		2		235.6							

PROJECT NAME: **St Albans - Berkshire**
PROJECT NUMBER: **STPG SIGN(36)**
FILE NAME: **EnosburgEB.xls**
PROJECT MANAGER: **A. Gamble**
DESIGNED BY: **T. Guazzoni**
ENOSBURG EB SHEET 3
PLOT DATE: **5/17/2011**
DRAWN BY: **T. Guazzoni**
CHECKED **A. Gamble**
SHEET **68** OF **109**

DIRECTION	MILEPOINT	LOCATION CODE (SHEET 2)	SIGN CODE	WIDTH (IN)	HEIGHT (IN)	SHEETING REMARKS	SIGN LEGEND	NEW SIGNS "A"	NEW SIGNS "B"	EXISTING SIGNS RETAIN	EXISTING SIGNS SALVAGE FROM	EXISTING SIGNS SALVAGE TO	EXISTING SIGNS REMOVE	EXIST POST RETAIN	EXIST POST REMOVE	NUMBER OF NEW POSTS	SQUARE STEEL (IN) 1.75 (LB / FT) 1.88	SQUARE STEEL (IN) 2.00 (LB / FT) 2.42	SQUARE STEEL (IN) 2.50 (LB / FT) 3.35	TUBULAR STEEL Ø (IN) FOUNDATION	TUBULAR STEEL Ø (IN) 3.00 (LB / FT) 7.60	TUBULAR STEEL Ø (IN) 3.50 (LB / FT) 9.00	TUBULAR STEEL Ø (IN) 4.00 (LB / FT) 10.80	TUBULAR STEEL Ø (IN) 5.00 (LB / FT) 14.60	SIGN FRAME REQUIRED	REMARKS	SIGN DETAIL LOCATION SHSM	SIGN DETAIL LOCATION PROJECT SHEET #	SIGN DETAIL LOCATION STANDARD SHEET #
ENOSBURG VT105 EB							FY-FLUORESCENT YELLOW FYG-FLUORESCENT YELLOW GREEN																			"SHSM"-STANDARD HIGHWAY SIGNS AND MARKINGS			
		A	D3-1	30	8			1.67																		INSTALL ABOVE STOP SIGN		6	
		D	R1-1	30	30			6.25								1		X							CHURCH ST (TH-105)	X		
EB	0.655	A	D1-1A	72	10								1		X														
		A	D1-1A	72	10								1																
		A	D1-1A	72	10								1																
		A	UNK.	UNK	UNK		"BRIDGE OF FLOWERS + LIGHT" SIGN				1		1																
		A	UNK.	UNK	UNK		DEAF CHILD AREA						1														RETURN SIGN TO TOWN			
		A	VD1-1A	72	12		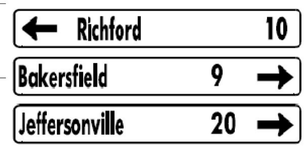	6.00								2		X									4	
		A	VD1-1A	72	12			6.00																			4	
		A	VD1-1A	72	12			6.00																			4	
		A	UNK.	UNK	UNK		"BRIDGE OF FLOWERS + LIGHT" SIGN					1														INSTALL SIGN ON NEW POSTS, AT BOTTOM OF ASSEMBLY			
EB	0.670	A	M3-2	24	12		ROUTE MARKER ASSEMBLY (8)						1		X														
		A	M1-5	30	24								1																
		A	M3-1	24	12								1																
		A	M1-5	30	24								1																
							SHEET TOTALS	25.92	0.00	0	1	1	9	0	0	3		45.0		0	0.0	0.0	0.0	0.0					
								SF	SF	EA	EA	EA	EA	EA	EA	EA		FT		EA	LB	LB	LB	LB					
							TOWN DIRECTIONAL TOTALS	393.9	0.0	25	4	4	94	0	0	58		870.0		2		235.6							

SIGN SUMMARY SHEET

VERMONT AGENCY OF TRANSPORTATION

PROJECT NAME: **St Albans - Berkshire**
PROJECT NUMBER: **STPG SIGN(36)**

FILE NAME: **EnosburgEB.xls** PLOT DATE: **5/17/2011**
PROJECT MANAGER: **A. Gamble** DRAWN BY: **T. Guazzoni**
DESIGNED BY: **T. Guazzoni** CHECKED **A. Gamble**
ENOSBURG EB SHEET 4 SHEET **69** OF **109**

DIRECTION	MILEPOINT	LOCATION CODE (SHEET 2)	SIGN CODE	WIDTH (IN)	HEIGHT (IN)	SHEETING REMARKS	SIGN LEGEND	NEW SIGNS		EXISTING SIGNS				EXIST POST		NUMBER OF NEW POSTS	SQUARE STEEL (IN)			TUBULAR STEEL Ø (IN)				SIGN FRAME REQUIRED	REMARKS	SIGN DETAIL LOCATION		
																	1.75	2.00	2.50	3.00	3.50	4.00	5.00					
																	(LB / FT)			(LB / FT)								
								"A"	"B"	RETAIN	SALVAGE FROM	SALVAGE TO	REMOVE	RETAIN	REMOVE		1.88	2.42	3.35	FOUNDATION	7.60	SLIP BASE 9.00	10.80	14.60			SHSM	PROJECT SHEET #	STANDARD SHEET #
ENOSBURG VT105 EB							FY-FLUORESCENT YELLOW FYG-FLUORESCENT YELLOW GREEN																		"SHSM"-STANDARD HIGHWAY SIGNS AND MARKINGS			
		A	M6-1L	21	15								1															
		A	M3-3	24	12								1															
		A	M1-5	30	24								1															
		A	M6-1R	21	15								1															
		A	M3-2	24	12			~~2.19~~ 2.00								2			X					#3C	GREEN ON WHITE. INSTALL ON 2 1/2" SLIP BASES	X		
		A	M1-5	30	24			5.00																				E-136B
		A	M6-1L	21	15			2.19																	GREEN ON WHITE	X		
		A	M3-1	24	12			2.00														2			GREEN ON WHITE	X		
		A	M1-5	30	24			5.00																				E-136B
		A	M6-1L	21	15		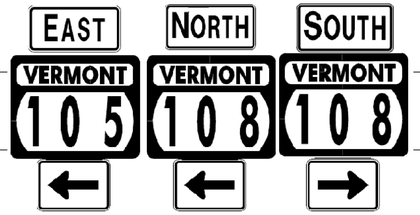	2.19																	GREEN ON WHITE	X		
		A	M3-3	24	12			2.00																	GREEN ON WHITE	X		
		A	M1-5	30	24			5.00																				E-136B
		A	M6-1R	21	15			2.19																	GREEN ON WHITE	X		
EB	0.690	A	R1-1	30	30								1		X													
		C	M1-5	30	24		VERMONT 105						1															
							SHEET TOTALS	~~27.76~~ 27.57	0.00	0	0	0	6	0	0	2	30.0			0	0.0	~~0.0~~ 2	0.0	0.0					
								SF	SF	EA	EA	EA	EA	EA	EA	EA	FT			EA	LB	LB	LB	LB					
							TOWN DIRECTIONAL TOTALS	393.9	0.0	25	4	4	94	0	0	58	870.0			2	235.6								

SIGN SUMMARY SHEET

VERMONT AGENCY OF TRANSPORTATION

PROJECT NAME: St Albans - Berkshire
PROJECT NUMBER: STPG SIGN(36)

FILE NAME: EnosburgEB.xls
PROJECT MANAGER: A. Gamble
DESIGNED BY: T. Guazzoni
ENOSBURG EB SHEET 5

PLOT DATE: 5/17/2011
DRAWN BY: T. Guazzoni
CHECKED A. Gamble
SHEET 70 OF 109

DIRECTION	MILEPOINT	LOCATION CODE (SHEET 2)	SIGN CODE	WIDTH (IN)	HEIGHT (IN)	SHEETING REMARKS	SIGN LEGEND	NEW SIGNS "A"	NEW SIGNS "B"	EXISTING SIGNS RETAIN	EXISTING SIGNS SALVAGE FROM	EXISTING SIGNS SALVAGE TO	EXISTING SIGNS REMOVE	EXIST POST RETAIN	EXIST POST REMOVE	NUMBER OF NEW POSTS	SQUARE STEEL (IN) 1.75 (LB / FT) 1.88	SQUARE STEEL (IN) 2.00 (LB / FT) 2.42	SQUARE STEEL (IN) 2.50 (LB / FT) 3.35	TUBULAR STEEL Ø (IN) FOUNDATION	TUBULAR STEEL Ø (IN) 3.00 (LB / FT) 7.60	TUBULAR STEEL Ø (IN) 3.50 (LB / FT) 9.00	TUBULAR STEEL Ø (IN) 4.00 (LB / FT) 10.80	TUBULAR STEEL Ø (IN) 5.00 (LB / FT) 14.60	SIGN FRAME REQUIRED	REMARKS	SIGN DETAIL LOCATION SHSM	SIGN DETAIL LOCATION PROJECT SHEET #	SIGN DETAIL LOCATION STANDARD SHEET #
ENOSBURG VT105 EB							FY-FLUORESCENT YELLOW FYG-FLUORESCENT YELLOW GREEN																			"SHSM"-STANDARD HIGHWAY SIGNS AND MARKINGS			
		C	D3-1	UNK	UNK								1																
		A	D3-1	UNK	UNK								1																
		C	M3-2	24	12		WEST						1																
		C	M6-1R	21	15		RIGHT						1																
		C	D3-1	24	8			1.33																	INSTALL ABOVE STOP SIGN		6	
		A	D3-1	24	8			1.33																	INSTALL ABOVE STOP SIGN		6	
		A	R1-1	30	30			6.25								1		X							MAIN ST (VT105/108)	X		
EB	0.695	B	M3-4	24	12			2.00								1		X							GREEN ON WHITE. INSTALL SIGNS DIRECTLY ACROSS FROM INSERSECTION FACING WB TRAFFIC	X		
		B	M1-5	30	24			5.00																				E-136B
		B	M6-1R	21	15			2.19																	GREEN ON WHITE	X		
EB	0.710	A	M3-2	24	12			2.00								1		X							INSTALL SIGNS 160' +/- WEST OF EXISTING LOCATION. GREEN ON WHITE	X		
		A	M1-5	30	24			5.00																#1B				E-136B
		A	M3-1	24	12			2.00																	GREEN ON WHITE	X		
		A	M1-5	30	24			5.00																				E-136B
EB	0.740	A	M3-2	24	12		EAST						1		X														
SIGN SUMMARY SHEET							SHEET TOTALS	32.10	0.00	0	0	0	5	0	0	3		45.0		0	0.0	0.0	0.0	0.0				
								SF	SF	EA	EA	EA	EA	EA	EA	EA		FT		EA	LB	LB	LB	LB				
VERMONT AGENCY OF TRANSPORTATION							TOWN DIRECTIONAL TOTALS	393.9	0.0	25	4	4	94	0	0	58		870.0		2		235.6						

PROJECT NAME: **St Albans - Berkshire**
PROJECT NUMBER: **STPG SIGN(36)**
FILE NAME: **EnosburgEB.xls**
PROJECT MANAGER: **A. Gamble**
DESIGNED BY: **T. Guazzoni**
ENOSBURG EB SHEET 6
PLOT DATE: **5/17/2011**
DRAWN BY: **T. Guazzoni**
CHECKED **A. Gamble**
SHEET **71** OF **109**

DIRECTION	MILEPOINT	LOCATION CODE (SHEET 2)	SIGN CODE	WIDTH (IN)	HEIGHT (IN)	SHEETING REMARKS	SIGN LEGEND	NEW SIGNS "A"	NEW SIGNS "B"	EXISTING SIGNS RETAIN	EXISTING SIGNS SALVAGE FROM	EXISTING SIGNS SALVAGE TO	EXISTING SIGNS REMOVE	EXIST POST RETAIN	EXIST POST REMOVE	NUMBER OF NEW POSTS	SQUARE STEEL (IN) 1.75 (LB / FT) 1.88	SQUARE STEEL (IN) 2.00 (LB / FT) 2.42	SQUARE STEEL (IN) 2.50 (LB / FT) 3.35	TUBULAR STEEL Ø (IN) FOUNDATION	TUBULAR STEEL Ø (IN) 3.00 (LB / FT) 7.60	TUBULAR STEEL Ø (IN) 3.50 (LB / FT) 9.00	TUBULAR STEEL Ø (IN) 4.00 (LB / FT) 10.80	TUBULAR STEEL Ø (IN) 5.00 (LB / FT) 14.60	SIGN FRAME REQUIRED	REMARKS	SIGN DETAIL LOCATION SHSM	SIGN DETAIL LOCATION PROJECT SHEET #	SIGN DETAIL LOCATION STANDARD SHEET #
ENOSBURG VT105 EB							FY-FLUORESCENT YELLOW FYG-FLUORESCENT YELLOW GREEN																			"SHSM"-STANDARD HIGHWAY SIGNS AND MARKINGS			
		A	M1-5	30	24		VERMONT 105						1																
		A	M3-1	24	12		NORTH						1																
		A	M1-5	30	24		VERMONT 108						1																
EB	0.750	A	W11-2	30	30		PEDESTRIAN			1				X															
		A	W16-7pL	24	12		LEFT DIAGONAL ARROW			1																			
EB	0.755	C	VR-017	24	30		LEGAL LOAD LIMIT 24,000 POUNDS	5.00								1		X									DICKINSON AVE (TH-106)		7	
EB	0.760	C	D3-1	UNK	UNK								1																
		A	D3-1	UNK	UNK								1																
		C	D3-1	24	8		Main St	1.33																			INSTALL ABOVE STOP SIGN		6	
		A	D3-1	36	8		Dickinson Ave	2.00																			INSTALL ABOVE STOP SIGN		6	
		D	R1-1	30	30		STOP			1				X													DICKINSON AVE (TH-106)			
EB	0.815	A	VW-622A	36	36		RECREATIONAL TRAIL						1		X														
		A	VW-622P	24	18		ALL SEASON PLAQUE						1																
		A	UNK.	UNK	UNK		SHUTTLE SIGN						1														RETURN SIGN TO VILLAGE			
EB	0.835	A	W11-2	30	30		PEDESTRIAN			1				X															
SIGN SUMMARY SHEET							SHEET TOTALS	8.33	0.00	4	0	0	8	0	0	1		15.0		0	0.0	0.0	0.0	0.0					
								SF	SF	EA	EA	EA	EA	EA	EA	EA		FT		EA	LB	LB	LB	LB					
VERMONT AGENCY OF TRANSPORTATION							TOWN DIRECTIONAL TOTALS	393.9	0.0	25	4	4	94	0	0	58		870.0		2		235.6							

PROJECT NAME: **St Albans - Berkshire**
PROJECT NUMBER: **STPG SIGN(36)**

FILE NAME: **EnosburgEB.xls**
PROJECT MANAGER: **A. Gamble**
DESIGNED BY: **T. Guazzoni**
ENOSBURG EB SHEET 7

PLOT DATE: **5/17/2011**
DRAWN BY: **T. Guazzoni**
CHECKED **A. Gamble**
SHEET **72** OF **109**

DIRECTION	MILEPOINT	LOCATION CODE (SHEET 2)	SIGN CODE	WIDTH (IN)	HEIGHT (IN)	SHEETING REMARKS	SIGN LEGEND	NEW SIGNS		EXISTING SIGNS				EXIST POST		NUMBER OF NEW POSTS	SQUARE STEEL (IN)			TUBULAR STEEL Ø (IN)				SIGN FRAME REQUIRED	REMARKS	SIGN DETAIL LOCATION		
								"A"	"B"	RETAIN	SALVAGE FROM	SALVAGE TO	REMOVE	RETAIN	REMOVE		1.75 (LB / FT) 1.88	2.00 (LB / FT) 2.42	2.50 (LB / FT) 3.35	FOUNDATION	3.00 (LB / FT) 7.60	3.50 (LB / FT) 9.00	4.00 (LB / FT) 10.80	5.00 (LB / FT) 14.60			SHSM	PROJECT SHEET #	STANDARD SHEET #
ENOSBURG VT105 EB							FY-FLUORESCENT YELLOW FYG-FLUORESCENT YELLOW GREEN																		"SHSM"-STANDARD HIGHWAY SIGNS AND MARKINGS			
EB	0.855	C	VR-017	24	30		LEGAL LOAD LIMIT 24,000 POUNDS	5.00				I	I			1		X							SCHOOL ST (TH-112). INSTALL SIGN ON RT SIDE OF SCHOOL ST		7	
EB	0.860	D	R1-1	30	30								1		X													
		C	D3-1	UNK	UNK								1															
		A	D3-1	UNK	UNK								1															
		C	D3-1	24	8		Main St	1.33																			6	
		A	D3-1	30	8		School St	1.67																			6	
		D	R1-1	30	30		STOP	6.25								1		X							SCHOOL ST(TH-112)	X		
EB	0.900	C	VR-017	24	30		LEGAL LOAD LIMIT 24,000 POUNDS	5.00								1		X							MISSISQUOI ST (TH-109). INSTALL SIGN ON RT SIDE OF MISSISQUOI ST		7	
EB	0.905	D	R1-1	30	30								1		X													
		D	R1-1	30	30		STOP	6.25								1		X							MISSISQUOI ST (TH-109)	X		
EB	0.905	A	W11-2	30	30		PEDESTRIAN			1				X														
		A	W16-7pL	24	12		LEFT DIAGONAL ARROW			1																		
EB	0.935	A	W11-2	30	30		PEDESTRIAN			1				X														
		A	W16-7pL	24	12		LEFT DIAGONAL ARROW			1																		
EB	0.955	A	VW-622A	36	36		RECREATIONAL TRAIL						1		X													
							SHEET TOTALS	25.50	0.00	4	0	~~0~~ 1	~~5~~ 6	0	0	4		60.0		0	0.0	0.0	0.0	0.0				
								SF	SF	EA	EA	EA	EA	EA	EA	EA		FT		EA	LB	LB	LB	LB				
							TOWN DIRECTIONAL TOTALS	393.9	0.0	25	4	4	94	0	0	58		870.0		2		235.6						

SIGN SUMMARY SHEET

VERMONT AGENCY OF TRANSPORTATION

PROJECT NAME: **St Albans - Berkshire**
PROJECT NUMBER: **STPG SIGN(36)**

FILE NAME: **EnosburgEB.xls**
PROJECT MANAGER: **A. Gamble**
DESIGNED BY: **T. Guazzoni**
ENOSBURG EB SHEET 8

PLOT DATE: **5/17/2011**
DRAWN BY: **T. Guazzoni**
CHECKED **A. Gamble**
SHEET **73** OF **109**

DIRECTION	MILEPOINT	LOCATION CODE (SHEET 2)	SIGN CODE	WIDTH (IN)	HEIGHT (IN)	SHEETING REMARKS	SIGN LEGEND	NEW SIGNS "A"	NEW SIGNS "B"	EXISTING SIGNS RETAIN	EXISTING SIGNS SALVAGE FROM	EXISTING SIGNS SALVAGE TO	EXISTING SIGNS REMOVE	EXIST POST RETAIN	EXIST POST REMOVE	NUMBER OF NEW POSTS	SQUARE STEEL (IN) 1.75 (LB / FT) 1.88	SQUARE STEEL (IN) 2.00 (LB / FT) 2.42	SQUARE STEEL (IN) 2.50 (LB / FT) 3.35	TUBULAR STEEL Ø (IN) FOUNDATION	TUBULAR STEEL Ø (IN) 3.00 (LB / FT) 7.60	TUBULAR STEEL Ø (IN) 3.50 (LB / FT) 9.00	TUBULAR STEEL Ø (IN) 4.00 (LB / FT) 10.80	TUBULAR STEEL Ø (IN) 5.00 (LB / FT) 14.60	SIGN FRAME REQUIRED	REMARKS	SIGN DETAIL LOCATION SHSM	SIGN DETAIL LOCATION PROJECT SHEET #	SIGN DETAIL LOCATION STANDARD SHEET #
ENOSBURG VT105 EB							FY-FLUORESCENT YELLOW FYG-FLUORESCENT YELLOW GREEN																			"SHSM"-STANDARD HIGHWAY SIGNS AND MARKINGS			
		A	W1-7	24	12		<---> DOUBLE ARROW						1																
EB	0.980	A	W11-2	30	30		PEDESTRIAN				1	1	1		X	1		X								SALVAGE SIGNS TO NEW POST AT SAME LOCATION			
		A	W16-7pL	24	12		LEFT DIAGONAL ARROW				1	1	1																
EB	0.990	C	VR-017	24	30			5.00								1		X								DEPOT ST (TH-6). INSTALL SIGN ON RT SIDE OF DEPOT ST		7	
EB	0.995	D	R1-1	30	30								1		X														
		C	D3-1	UNK	UNK								1																
		A	D3-1	UNK	UNK								1																
		C	D3-1	24	8			1.33																	INSTALL ABOVE STOP SIGN		6	
		A	D3-1	30	8			1.67																	INSTALL ABOVE STOP SIGN		6	
		D	R1-1	30	30			6.25								1		X							DEPOT ST (TH-6).	X		
EB	1.120	A	D1-1A	54	7.5		RICHFORD 10 --->						1		X														
		A	M3-1	24	12		ROUTE MARKERS (6)						1																
		A	M1-5	30	24								1																
		A	M6-2L	21	15								1																
		A	M3-2	24	12								1																
SIGN SUMMARY SHEET							SHEET TOTALS	14.25	0.00	0	2	2	11	0	0	3		45.0		0	0.0	0.0	0.0	0.0					
								SF	SF	EA	EA	EA	EA	EA	EA	EA		FT		EA	LB	LB	LB	LB					
VERMONT AGENCY OF TRANSPORTATION							TOWN DIRECTIONAL TOTALS	393.9	0.0	25	4	4	94	0	0	58		870.0		2		235.6							

PROJECT NAME: **St Albans - Berkshire**
PROJECT NUMBER: **STPG SIGN(36)**

FILE NAME: **EnosburgEB.xls** PLOT DATE: **5/17/2011**
PROJECT MANAGER: **A. Gamble** DRAWN BY: **T. Guazzoni**
DESIGNED BY: **T. Guazzoni** CHECKED **A. Gamble**
ENOSBURG EB SHEET 9 SHEET **74** OF **109**

DIRECTION	MILEPOINT	LOCATION CODE (SHEET 2)	SIGN CODE	WIDTH (IN)	HEIGHT (IN)	SHEETING REMARKS	SIGN LEGEND	NEW SIGNS		EXISTING SIGNS				EXIST POST		NUMBER OF NEW POSTS	SQUARE STEEL (IN)			TUBULAR STEEL Ø (IN)					SIGN FRAME REQUIRED	REMARKS	SIGN DETAIL LOCATION		
								"A"	"B"	RETAIN	SALVAGE FROM	SALVAGE TO	REMOVE	RETAIN	REMOVE		1.75 (LB / FT) 1.88	2.00 (LB / FT) 2.42	2.50 (LB / FT) 3.35	FOUNDATION	3.00 (LB / FT) 7.60	3.50 (LB / FT) 9.00	4.00 (LB / FT) 10.80	5.00 (LB / FT) 14.60			SHSM	PROJECT SHEET #	STANDARD SHEET #
ENOSBURG VT105 EB							FY-FLUORESCENT YELLOW FYG-FLUORESCENT YELLOW GREEN																		"SHSM"-STANDARD HIGHWAY SIGNS AND MARKINGS			
		A	M1-5	30	24								1															
		A	M6-2R	21	15								1															
		A	VD1-1A	72	12			6.00												2	235.6						4	
		A	VD1-1A	72	12			6.00																			4	
		A	M3-1	24	12			2.00																	#2B	GREEN ON WHITE	X	6	
		A	M1-5	30	24		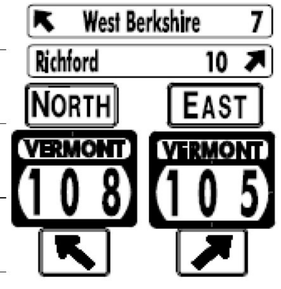	5.00																			E-136B
		A	M6-2L	21	15			2.19																		GREEN ON WHITE	X		
		A	M3-2	24	12			2.00																		GREEN ON WHITE	X		
		A	M1-5	30	24			5.00																				E-136B
		A	M6-2R	21	15			2.19																		GREEN ON WHITE	X		
EB	1.200	A	M3-1	24	12			2.00								1		X								INSTALL DIRECTLY ACROSS FROM INTERSECTION WITH ROUTE 108. GREEN ON WHITE	X		
		A	M1-5	30	24			5.00																				E-136B
		A	M6-1L	21	15			2.19																		GREEN ON WHITE	X		
EB	1.220	A	M3-2	24	12			2.00								1		X								INSTALL 105' +/- EAST OF INTERSECTION OF VT 108. GREEN ON WHITE	X		
		A	M1-5	30	24			5.00																				E-136B
SIGN SUMMARY SHEET							SHEET TOTALS	46.57	0.00	0	0	0	2	0	0	2		30.0		2	235.6	0.0	0.0	0.0				
								SF	SF	EA	EA	EA	EA	EA	EA	EA		FT		EA	LB	LB	LB	LB				
VERMONT AGENCY OF TRANSPORTATION							TOWN DIRECTIONAL TOTALS	393.9	0.0	25	4	4	94	0	0	58		870.0		2	235.6							

PROJECT NAME: **St Albans - Berkshire**
PROJECT NUMBER: **STPG SIGN(36)**

FILE NAME: **EnosburgEB.xls** PLOT DATE: **5/17/2011**
PROJECT MANAGER: **A. Gamble** DRAWN BY: **T. Guazzoni**
DESIGNED BY: **T. Guazzoni** CHECKED **A. Gamble**
ENOSBURG EB SHEET 10 SHEET **75** OF **109**

DIRECTION	MILEPOINT	LOCATION CODE (SHEET 2)	SIGN CODE	WIDTH (IN)	HEIGHT (IN)	SHEETING REMARKS	SIGN LEGEND	NEW SIGNS "A"	NEW SIGNS "B"	EXISTING SIGNS RETAIN	EXISTING SIGNS SALVAGE FROM	EXISTING SIGNS SALVAGE TO	EXISTING SIGNS REMOVE	EXIST POST RETAIN	EXIST POST REMOVE	NUMBER OF NEW POSTS	SQUARE STEEL (IN) 1.75 (LB / FT) 1.88	SQUARE STEEL (IN) 2.00 (LB / FT) 2.42	SQUARE STEEL (IN) 2.50 (LB / FT) 3.35	TUBULAR STEEL Ø (IN) FOUNDATION	TUBULAR STEEL Ø (IN) 3.00 (LB / FT) 7.60	TUBULAR STEEL Ø (IN) 3.50 (LB / FT) 9.00	TUBULAR STEEL Ø (IN) 4.00 (LB / FT) 10.80	TUBULAR STEEL Ø (IN) 5.00 (LB / FT) 14.60	SIGN FRAME REQUIRED	REMARKS	SIGN DETAIL LOCATION SHSM	SIGN DETAIL LOCATION PROJECT SHEET #	SIGN DETAIL LOCATION STANDARD SHEET #
ENOSBURG VT105 EB							FY-FLUORESCENT YELLOW FYG-FLUORESCENT YELLOW GREEN																			"SHSM"-STANDARD HIGHWAY SIGNS AND MARKINGS			
EB	1.335	A	M3-2	24	12		EAST						1		X													
		A	M1-5	30	24		VERMONT ROUTE 105						1															
EB	1.355	A	W11-2	30	30		PEDESTRIAN			1				X														
		A	W16-7pL	24	12		LEFT DIAGONAL ARROW			1																		
EB	1.355	C	D3-1	UNK	UNK								1															
		A	D3-1	UNK	UNK								1															
		C	D3-1	24	8		Elm St	1.33																		INSTALL ABOVE STOP SIGN		6	
		A	D3-1	36	8		Pleasant St	2.00																		INSTALL ABOVE STOP SIGN		6	
		A	R1-1	30	30		STOP	6.25								1		X								INSTALL GATE POSTED STOP SIGN ON RT SIDE OF PLEASANT ST, 10' +/- AWAY FROM UTILITY POLE	X		
EB	1.355	C	VR-017	24	30		LEGAL LOAD LIMIT 24,000 POUNDS	5.00								1		X								PLEASANT ST. INSTALL SIGN ON RT SIDE OF PLEASANT ST		7	
EB	1.365	D	R1-1	30	30		STOP	6.25								1		X								PLEASANT ST. INSTALL SIGN 50' BEFORE INTERSECTION WITH VT105 ON PLEASANT ST	X		
EB	1.470	A	D1-1A	54	7.5								1		X													
		A	VD1-1A	72	12		← Berkshire 4	6.00								2		X										4	
			END CLASS 1 SECTION - VILLAGE OF ENOSBURG FALLS																										
EB	1.519	B	VR-039	24	18		STATE HIGHWAY BEGINS			1				X														
							SHEET TOTALS	26.83	0.00	3	0	0	5	0	0	5		75.0		0	0.0	0.0	0.0	0.0				
								SF	SF	EA	EA	EA	EA	EA	EA	EA		FT		EA	LB	LB	LB	LB				
							TOWN DIRECTIONAL TOTALS	393.9	0.0	25	4	4	94	0	0	58		870.0		2		235.6						

SIGN SUMMARY SHEET

VERMONT AGENCY OF TRANSPORTATION

PROJECT NAME: **St Albans - Berkshire**
PROJECT NUMBER: **STPG SIGN(36)**

FILE NAME: **EnosburgEB.xls** PLOT DATE: **5/17/2011**
PROJECT MANAGER: **A. Gamble** DRAWN BY: **T. Guazzoni**
DESIGNED BY: **T. Guazzoni** CHECKED **A. Gamble**
ENOSBURG EB SHEET 11 SHEET **76** OF **109**

DIRECTION	MILEPOINT	LOCATION CODE (SHEET 2)	SIGN CODE	WIDTH (IN)	HEIGHT (IN)	SHEETING REMARKS	SIGN LEGEND	NEW SIGNS "A"	NEW SIGNS "B"	EXISTING SIGNS RETAIN	EXISTING SIGNS SALVAGE FROM	EXISTING SIGNS SALVAGE TO	EXISTING SIGNS REMOVE	EXIST POST RETAIN	EXIST POST REMOVE	NUMBER OF NEW POSTS	SQUARE STEEL (IN) 1.75 (LB/FT) 1.88	SQUARE STEEL (IN) 2.00 (LB/FT) 2.42	SQUARE STEEL (IN) 2.50 (LB/FT) 3.35	TUBULAR STEEL Ø (IN) FOUNDATION	TUBULAR STEEL Ø (IN) 3.00 (LB/FT) 7.60	TUBULAR STEEL Ø (IN) 3.50 (LB/FT) 9.00	TUBULAR STEEL Ø (IN) 4.00 (LB/FT) 10.80	TUBULAR STEEL Ø (IN) 5.00 (LB/FT) 14.60	SIGN FRAME REQUIRED	REMARKS	SIGN DETAIL LOCATION SHSM	SIGN DETAIL LOCATION PROJECT SHEET #	SIGN DETAIL LOCATION STANDARD SHEET #
ENOSBURG VT105 EB							FY-FLUORESCENT YELLOW FYG-FLUORESCENT YELLOW GREEN																			"SHSM"-STANDARD HIGHWAY SIGNS AND MARKINGS			
		A	R2-1	24	30		SPEED LIMIT 30			0 ~~1~~																		
EB	1.602	A	VW-054L	30	30			6.25								1		X							INSTALL SIGN 200' +/- WEST OF EXISTING LOCATION		7	
EB	1.640	A	VW-054L	30	30		HIDDEN DRIVE LEFT						1		X														
		A	S3-1	30	30		SCHOOL BUS STOP AHEAD						1														
		A	S3-1	36	36	**FYG**		~~2.00~~ ~~9.00~~								2		X								X		
EB	1.680	A	R2-1	24	30		SPEED LIMIT 40			1				X														
EB	2.021	A	R2-1	24	30		SPEED LIMIT 50			1				X														
EB	2.220	A	VW-081L	30	30		TRUCKS ENTERING						1		X														
		A	VW-084	36	36			9.00								2		X								7		
EB	2.570	C	VR-017	24	24								1		X														
		C	VR-017	24	30			5.00								1		X							WHITE RD (TH-40)		7	
EB	2.580	D	R1-1	24	24							~~2~~	~~3~~ 1		X														
		D	R1-1	30	30			6.25								1		X							WHITE RD (TH-40)	X		
EB	2.950	A	S3-1	30	30		SCHOOL BUS STOP AHEAD						1		X														
EB	3.000	A	W1-2L	30	30		LEFT CURVE						1		X														
SIGN SUMMARY SHEET							SHEET TOTALS	35.50	0.00	3	0	~~0~~ ~~2~~	~~7~~ ~~9~~	0	0	7		105.0		0	0.0	0.0	0.0	0.0				
								SF	SF	EA	EA	EA	EA	EA	EA	EA		FT		EA	LB	LB	LB	LB				
VERMONT AGENCY OF TRANSPORTATION							TOWN DIRECTIONAL TOTALS	393.9	0.0	25	4	4	94	0	0	58		870.0		2	235.6							

PROJECT NAME: **St Albans - Berkshire**
PROJECT NUMBER: **STPG SIGN(36)**
FILE NAME: **EnosburgEB.xls** PLOT DATE: **5/17/2011**
PROJECT MANAGER: **A. Gamble** DRAWN BY: **T. Guazzoni**
DESIGNED BY: **T. Guazzoni** CHECKED **A. Gamble**
ENOSBURG EB SHEET 12 SHEET **77** OF **109**

DIRECTION	MILEPOINT	LOCATION CODE (SHEET 2)	SIGN CODE	WIDTH (IN)	HEIGHT (IN)	SHEETING REMARKS	SIGN LEGEND	NEW SIGNS "A"	NEW SIGNS "B"	EXISTING SIGNS RETAIN	EXISTING SIGNS SALVAGE FROM	EXISTING SIGNS SALVAGE TO	EXISTING SIGNS REMOVE	EXIST POST RETAIN	EXIST POST REMOVE	NUMBER OF NEW POSTS	SQUARE STEEL (IN) 1.75 (LB / FT) 1.88	SQUARE STEEL (IN) 2.00 (LB / FT) 2.42	SQUARE STEEL (IN) 2.50 (LB / FT) 3.35	FOUNDATION	TUBULAR STEEL Ø (IN) 3.00 (LB / FT) 7.60	TUBULAR STEEL Ø (IN) 3.50 (LB / FT) 9.00	TUBULAR STEEL Ø (IN) 4.00 (LB / FT) 10.80	TUBULAR STEEL Ø (IN) 5.00 (LB / FT) 14.60	SIGN FRAME REQUIRED	REMARKS	SIGN DETAIL LOCATION SHSM	SIGN DETAIL LOCATION PROJECT SHEET #	SIGN DETAIL LOCATION STANDARD SHEET #
ENOSBURG VT105 EB							FY-FLUORESCENT YELLOW FYG-FLUORESCENT YELLOW GREEN																				"SHSM"-STANDARD HIGHWAY SIGNS AND MARKINGS			
EB	3.040	A	W1-2L	30	30			6.25								1		X								INSTALL SIGN 200' +/- EAST OF EXISTING LOCATION	X		
EB	3.100	A	VW-622	36	36		RECRECATIONAL TRAIL						1		X													
		A	VW-622P	24	18		ALL SEASON PLAQUE						1															
EB	3.140	A	W1-2R	30	30		RIGHT CURVE						1		X													
		A	W13-1	18	18		35 MPH						1															
EB	3.200	A	W1-2R	30	30			6.25								1		X								INSTALL 315' +/- EAST OF EXISTING SIGN LOCATION	X		
		A	W13-1	18	18			2.25																			X	
EB	3.300	A	VW-622A	36	36		RECRECATIONAL TRAIL						1		X													
		A	M6-4	21	15		<---> DOUBLE ARROW						1															
		A	W11-15a	30	30			6.25								1		X									X		
		A	W16-7pL	24	12			2.00																			X	
EB	3.440	A	W1-4R	30	30		RIGHT REVERSE CURVE						1		X													
		A	VD-062AS	72	16		BUSINESS SIGN (BROOKSIDE CAMPGROUND)					1				2		X								INSTALL SALVAGED SIGN FROM MP 3.470			
EB	3.470	A	VD-062AS	72	16		BUSINESS SIGN (BROOKSIDE CAMPGROUND)				1		1		X											SALVAGE SIGN TO MP 3.440			
		A	W1-4R	30	30			6.25								1		X									X		
							SHEET TOTALS	29.25	0.00	0	1	1	8	0	0	6		90.0		0	0.0	0.0	0.0	0.0					
								SF	SF	EA	EA	EA	EA	EA	EA	EA		FT		EA	LB	LB	LB	LB					
							TOWN DIRECTIONAL TOTALS	393.9	0.0	25	4	4	94	0	0	58		870.0		2	235.6								

SIGN SUMMARY SHEET

VERMONT AGENCY OF TRANSPORTATION

PROJECT NAME: **St Albans - Berkshire**
PROJECT NUMBER: **STPG SIGN(36)**

FILE NAME: **EnosburgEB.xls** PLOT DATE: **5/17/2011**
PROJECT MANAGER: **A. Gamble** DRAWN BY: **T. Guazzoni**
DESIGNED BY: **T. Guazzoni** CHECKED **A. Gamble**
ENOSBURG EB SHEET 13 SHEET **78** OF **109**

DIRECTION	MILEPOINT	LOCATION CODE (SHEET 2)	SIGN CODE	WIDTH (IN)	HEIGHT (IN)	SHEETING REMARKS	SIGN LEGEND	NEW SIGNS "A"	NEW SIGNS "B"	EXISTING SIGNS RETAIN	EXISTING SIGNS SALVAGE FROM	EXISTING SIGNS SALVAGE TO	EXISTING SIGNS REMOVE	EXIST POST RETAIN	EXIST POST REMOVE	NUMBER OF NEW POSTS	SQUARE STEEL (IN) 1.75 (LB / FT) 1.88	SQUARE STEEL (IN) 2.00 (LB / FT) 2.42	SQUARE STEEL (IN) 2.50 (LB / FT) 3.35	TUBULAR STEEL Ø (IN) FOUNDATION	TUBULAR STEEL Ø (IN) 3.00 (LB / FT) 7.60	TUBULAR STEEL Ø (IN) 3.50 (LB / FT) 9.00	TUBULAR STEEL Ø (IN) 4.00 (LB / FT) 10.80	TUBULAR STEEL Ø (IN) 5.00 (LB / FT) 14.60	SIGN FRAME REQUIRED	REMARKS	SIGN DETAIL LOCATION SHSM	SIGN DETAIL LOCATION PROJECT SHEET #	SIGN DETAIL LOCATION STANDARD SHEET #
ENOSBURG VT105 EB							FY-FLUORESCENT YELLOW FYG-FLUORESCENT YELLOW GREEN																			"SHSM"-STANDARD HIGHWAY SIGNS AND MARKINGS			
EB	3.610	A	VW-622	36	36		RECREATION TRAIL						1		X														
		A	VW-622P	24	18		ALL SEASON PLAQUE						1																
EB	3.630	B	W1-6	48	24								1		X														
		B	W1-6R	48	24			8.00								2		X									X		
EB	3.630	C	VR-017	24	24								1		X														
		C	VR-017	24	30			5.00								1		X								BOSTON POST RD (TH-2)		7	
EB	3.635	D	R1-1	30	30								1		X														
		D	R1-1	30	30			6.25								1		X								BOSTON POST RD (TH-2)	X		
EB	3.630	A	W1-6	48	24		<--- LEFT LARGE ARROW						1		X														
EB	3.635	A	W1-6L	48	24			8.00								2		X								INSTALL 25' +/- EAST OF EXISTING LOCATION	X		
EB	3.830	A	VW-622A	36	36		RECREATIONAL TRAIL						1		X														
		A	M6-4	21	15		<----> DOUBLE ARROW						1																
		A	W11-15a	30	30			6.25								1		X									X		
		A	W16-7pL	24	12			2.00																			X		
EB	4.485	C	VM-607	24	30		PEARL HARBOR MEMORIAL HIGHWAY			1				X															
							SHEET TOTALS	35.50	0.00	1	0	0	8	0	0	7		105.0		0	0.0	0.0	0.0	0.0				
								SF	SF	EA	EA	EA	EA	EA	EA	EA		FT		EA	LB	LB	LB	LB				
							TOWN DIRECTIONAL TOTALS	393.9	0.0	25	4	4	94	0	0	58		870.0		2		235.6							

SIGN SUMMARY SHEET

VERMONT AGENCY OF TRANSPORTATION

PROJECT NAME: **St Albans - Berkshire**
PROJECT NUMBER: **STPG SIGN(36)**

FILE NAME: **EnosburgEB.xls** PLOT DATE: **5/17/2011**
PROJECT MANAGER: **A. Gamble** DRAWN BY: **T. Guazzoni**
DESIGNED BY: **T. Guazzoni** CHECKED **A. Gamble**
ENOSBURG EB SHEET 14 SHEET **79** OF **109**

DIRECTION	MILEPOINT	LOCATION CODE (SHEET 2)	SIGN CODE	WIDTH (IN)	HEIGHT (IN)	SHEETING REMARKS	SIGN LEGEND	NEW SIGNS		EXISTING SIGNS				EXIST POST		NUMBER OF NEW POSTS	SQUARE STEEL (IN)			TUBULAR STEEL Ø (IN)				SIGN FRAME REQUIRED	REMARKS	SIGN DETAIL LOCATION		
								"A"	"B"	RETAIN	SALVAGE FROM	SALVAGE TO	REMOVE	RETAIN	REMOVE		1.75 (LB / FT) 1.88	2.00 (LB / FT) 2.42	2.50 (LB / FT) 3.35	FOUNDATION	3.00 (LB / FT) 7.60	3.50 (LB / FT) 9.00	4.00 (LB / FT) 10.80	5.00 (LB / FT) 14.60			SHSM	PROJECT SHEET #	STANDARD SHEET #
ENOSBURG VT105 EB							FY-FLUORESCENT YELLOW FYG-FLUORESCENT YELLOW GREEN																		"SHSM"-STANDARD HIGHWAY SIGNS AND MARKINGS			
EB	4.505	A	VW-622	36	36		RECREATIONAL TRAIL						1		X													
		A	VW-622P	14	14		ALL SEASON PLAQUE						1															
EB	4.685	A	VW-622A	36	36		RECREATIONAL TRAIL						1		X													
		A	W1-7	21	15		<--> DOUBLE ARROW						1															
		A	W11-15a	30	30			6.25								1		X								X		
		A	W16-7pL	24	12			2.00																		X		
SIGN SUMMARY SHEET							SHEET TOTALS	8.25	0.00	0	0	0	4	0	0	1	15.0			0	0.0	0.0	0.0	0.0					
								SF	SF	EA	EA	EA	EA	EA	EA	EA	FT			EA	LB	LB	LB	LB					
VERMONT AGENCY OF TRANSPORTATION							TOWN DIRECTIONAL TOTALS	393.9	0.0	25	4	4	94	0	0	58	870.0			2	235.6								

PROJECT NAME: **St Albans - Berkshire**
PROJECT NUMBER: **STPG SIGN(36)**

FILE NAME: **EnosburgEB.xls** PLOT DATE: **5/17/2011**
PROJECT MANAGER: **A. Gamble** DRAWN BY: **T. Guazzoni**
DESIGNED BY: **T. Guazzoni** CHECKED **A. Gamble**
ENOSBURG EB SHEET 15 SHEET **80** OF **109**

DIRECTION	MILEPOINT	LOCATION CODE (SHEET 2)	SIGN CODE	WIDTH (IN)	HEIGHT (IN)	SHEETING REMARKS	SIGN LEGEND	NEW SIGNS		EXISTING SIGNS				EXIST POST		NUMBER OF NEW POSTS	SQUARE STEEL (IN)			TUBULAR STEEL Ø (IN)				SIGN FRAME REQUIRED	REMARKS	SIGN DETAIL LOCATION		
								"A"	"B"	RETAIN	SALVAGE FROM	SALVAGE TO	REMOVE	RETAIN	REMOVE		1.75 (LB / FT) 1.88	2.00 (LB / FT) 2.42	2.50 (LB / FT) 3.35	FOUNDATION	3.00 (LB / FT) 7.60	3.50 (LB / FT) 9.00	4.00 (LB / FT) 10.80	5.00 (LB / FT) 14.60			SHSM	PROJECT SHEET #	STANDARD SHEET #
ENOSBURG VT105 WB							FY-FLUORESCENT YELLOW FYG-FLUORESCENT YELLOW GREEN																		"SHSM"-STANDARD HIGHWAY SIGNS AND MARKINGS			
WB	4.950	F	W2-2MaR	30	30		RIGHT SIDE ROAD						1		X													
WB	4.935	F	W2-2MaR	30	30			6.25								1		X								INSTALL SIGN 10' EAST OF LARGE PINE TREE		7	
WB	4.865	F	VW-622	36	36		RECREATIONAL TRAIL						1		X													
		F	VW-622P	24	18		ALL SEASON PLAQUE						1															
WB	4.850	G	VR-017	24	24		<---> DOUBLE ARROW						1		X													
		G	VR-017	24	30			5.00								1		X								CHOQUETTE RD (TH-9)		7	
WB	4.850	H	R1-1	24	24								1		X													
		H	R1-1	24	30			5.00								1		X								CHOQUETTE RD (TH-9)	X		
WB	4.760	F	VW-622A	36	36		RECREATIONAL TRAIL						1		X													
		F	W1-7	24	12		<---> DOUBLE ARROW						1															
		F	W11-15a	30	30			6.25								1		X									X		
		F	W16-7pL	24	12			2.00																			X		
WB	4.460	F	VW-054R	30	30								0 ~~1~~		X													
		F	VW-054R	30	30			6.25								1		X										7	
WB	4.090	F	VD-062AS	72	16		BUSINESS SIGN			1				X															
							SHEET TOTALS	30.75	0.00	1	0	0	~~8~~ 7	0	0	5	75.0			0	0.0	0.0	0.0	0.0					
								SF	SF	EA	EA	EA	EA	EA	EA	EA		FT		EA	LB	LB	LB	LB					
							TOWN DIRECTIONAL TOTALS	359.7	0.0	23	0	0	89	0	0	51	765.0			2	171.0								

SIGN SUMMARY SHEET

VERMONT AGENCY OF TRANSPORTATION

PROJECT NAME: **St Albans - Berkshire**
PROJECT NUMBER: **STPG SIGN(36)**

FILE NAME: **EnosburgWB.xls** PLOT DATE: **5/17/2011**
PROJECT MANAGER: **A. Gamble** DRAWN BY: **T. Guazzoni**
DESIGNED BY: **T. Guazzoni** CHECKED **A. Gamble**
ENOSBURG WB SHEET 1 SHEET **81** OF **109**

DIRECTION	MILEPOINT	LOCATION CODE (SHEET 2)	SIGN CODE	WIDTH (IN)	HEIGHT (IN)	SHEETING REMARKS	SIGN LEGEND	NEW SIGNS "A"	NEW SIGNS "B"	EXISTING SIGNS RETAIN	EXISTING SIGNS SALVAGE FROM	EXISTING SIGNS SALVAGE TO	EXISTING SIGNS REMOVE	EXIST POST RETAIN	EXIST POST REMOVE	NUMBER OF NEW POSTS	SQUARE STEEL (IN) 1.75 (LB / FT) 1.88	SQUARE STEEL (IN) 2.00 (LB / FT) 2.42	SQUARE STEEL (IN) 2.50 (LB / FT) 3.35	FOUNDATION	TUBULAR STEEL Ø (IN) 3.00 (LB / FT) 7.60	TUBULAR STEEL Ø (IN) 3.50 (LB / FT) 9.00	TUBULAR STEEL Ø (IN) 4.00 (LB / FT) 10.80	TUBULAR STEEL Ø (IN) 5.00 (LB / FT) 14.60	SIGN FRAME REQUIRED	REMARKS	SIGN DETAIL LOCATION SHSM	SIGN DETAIL LOCATION PROJECT SHEET #	SIGN DETAIL LOCATION STANDARD SHEET #
ENOSBURG VT105 WB							FY-FLUORESCENT YELLOW FYG-FLUORESCENT YELLOW GREEN																			"SHSM"-STANDARD HIGHWAY SIGNS AND MARKINGS			
WB	4.015	F	VW-622	36	36		RECREATIONAL TRAIL						1		X													
		F	VW-622P	24	18		ALL SEASON PLAQUE						1															
WB	3.830	F	VW-622A	36	36		RECREATIONAL TRAIL						1		X													
		F	W1-7	24	12		<---> DOUBLE ARROW						1															
		F	W11-15a	30	30			6.25								1		X							X		
		F	W16-7pL	24	12			2.00																			X		
WB	3.775	F	W1-4R	30	30		RIGHT REVERSE CURVE						1		X													
WB	3.690	F	WI-4R	30	30			6.25								1		X								INSTALL 450' +/- WEST OF EXISTING LOCATION	X		
WB	3.535	F	VW-622	36	36		RECREATIONAL TRAIL						1		X													
		F	VW-622P	24	18		ALL SEASON PLAQUE						1															
WB	3.390	F	W1-1L	30	30								1		X													
		F	W13-1	18	18								1															
		F	W1-1L	30	30			6.25								1		X									X		
		F	W13-1	18	18			2.25																			X		
WB	3.370	F	VW-622A	36	36		RECREATIONAL TRAIL						1		X													
SIGN SUMMARY SHEET							SHEET TOTALS	23.00	0.00	0	0	0	10	0	0	3		45.0		0	0.0	0.0	0.0	0.0					
								SF	SF	EA	EA	EA	EA	EA	EA	EA		FT		EA	LB	LB	LB	LB					
VERMONT AGENCY OF TRANSPORTATION							TOWN DIRECTIONAL TOTALS	359.7	0.0	23	0	0	89	0	0	51		765.0		2		171.0							

PROJECT NAME: **St Albans - Berkshire**
PROJECT NUMBER: **STPG SIGN(36)**

FILE NAME: **EnosburgWB.xls** PLOT DATE: **5/17/2011**
PROJECT MANAGER: **A. Gamble** DRAWN BY: **T. Guazzoni**
DESIGNED BY: **T. Guazzoni** CHECKED **A. Gamble**
ENOSBURG WB SHEET 2 SHEET **82** OF **109**

DIRECTION	MILEPOINT	LOCATION CODE (SHEET 2)	SIGN CODE	WIDTH (IN)	HEIGHT (IN)	SHEETING REMARKS	SIGN LEGEND	NEW SIGNS "A"	NEW SIGNS "B"	EXISTING SIGNS RETAIN	EXISTING SIGNS SALVAGE FROM	EXISTING SIGNS SALVAGE TO	EXISTING SIGNS REMOVE	EXIST POST RETAIN	EXIST POST REMOVE	NUMBER OF NEW POSTS	SQUARE STEEL (IN) 1.75 (LB / FT) 1.88	SQUARE STEEL (IN) 2.00 (LB / FT) 2.42	SQUARE STEEL (IN) 2.50 (LB / FT) 3.35	TUBULAR STEEL Ø (IN) FOUNDATION	TUBULAR STEEL Ø (IN) 3.00 (LB / FT) 7.60	TUBULAR STEEL Ø (IN) 3.50 (LB / FT) 9.00	TUBULAR STEEL Ø (IN) 4.00 (LB / FT) 10.80	TUBULAR STEEL Ø (IN) 5.00 (LB / FT) 14.60	SIGN FRAME REQUIRED	REMARKS	SIGN DETAIL LOCATION SHSM	SIGN DETAIL LOCATION PROJECT SHEET #	SIGN DETAIL LOCATION STANDARD SHEET #
ENOSBURG VT105 WB							FY-FLUORESCENT YELLOW FYG-FLUORESCENT YELLOW GREEN																			"SHSM"-STANDARD HIGHWAY SIGNS AND MARKINGS			
		F	W1-7	21	15		<---> DOUBLE ARROW						1																
WB	3.345	F	W11-15a	30	30			6.25								1		X								INSTALL 130' +/- WEST OF RECREATIONAL TRAIL SIGN ASSEMBLY LOCATION	X		
		F	W16-7pL	24	12			2.00																			X		
WB	3.320	F	W1-6	48	24		<--- LEFT LARGE ARROW						1		X														
WB	3.305	F	W1-6L	48	24			8.00								2		X								INSTALL 75' +/- WEST OF EXISTING LOCATION	X		
WB	3.290	F	W1-6	48	24								1		X														
		E	W1-6	48	24								1																
		F	W1-6L	48	24			8.00								2		X								INSTALL SIGNS ON SEPARATE POSTS, ANGLED TOWARD TRAFFIC THE SIGN IS FACING	X		
		E	W1-6R	48	24			8.00								2		X									X		
WB	3.255	E	W1-6R	48	24								1		X														
		E	W1-6R	48	24			8.00								2		X									X		
WB	3.140	F	VW-060	30	30		HIDDEN DRIVES						1		X														
		E	W1-2R	30	30		RIGHT CURVE						1																
		E	W13-1	18	18		35 MPH PLAQUE						1																
		F	W1-2R	30	30			6.25								2		X									X		
SIGN SUMMARY SHEET							SHEET TOTALS	46.50	0.00	0	0	0	8	0	0	11		165.0		0	0.0	0.0	0.0	0.0					
								SF	SF	EA	EA	EA	EA	EA	EA	EA		FT		EA	LB	LB	LB	LB					
VERMONT AGENCY OF TRANSPORTATION							TOWN DIRECTIONAL TOTALS	359.7	0.0	23	0	0	89	0	0	51		765.0		2	171.0								

PROJECT NAME: **St Albans - Berkshire**
PROJECT NUMBER: **STPG SIGN(36)**

FILE NAME: **EnosburaWB.xls** PLOT DATE: **5/17/2011**
PROJECT MANAGER: **A. Gamble** DRAWN BY: **T. Guazzoni**
DESIGNED BY: **T. Guazzoni** CHECKED **A. Gamble**
ENOSBURG WB SHEET 3 SHEET **83** OF **109**

DIRECTION	MILEPOINT	LOCATION CODE (SHEET 2)	SIGN CODE	WIDTH (IN)	HEIGHT (IN)	SHEETING REMARKS	SIGN LEGEND	NEW SIGNS "A"	NEW SIGNS "B"	EXISTING SIGNS RETAIN	EXISTING SIGNS SALVAGE FROM	EXISTING SIGNS SALVAGE TO	EXISTING SIGNS REMOVE	EXIST POST RETAIN	EXIST POST REMOVE	NUMBER OF NEW POSTS	SQUARE STEEL (IN) 1.75 (LB/FT) 1.88	SQUARE STEEL (IN) 2.00 (LB/FT) 2.42	SQUARE STEEL (IN) 2.50 (LB/FT) 3.35	FOUNDATION	TUBULAR STEEL Ø (IN) 3.00 (LB/FT) 7.60	TUBULAR STEEL Ø (IN) 3.50 (LB/FT) 9.00	TUBULAR STEEL Ø (IN) 4.00 (LB/FT) 10.80	TUBULAR STEEL Ø (IN) 5.00 (LB/FT) 14.60	SIGN FRAME REQUIRED	REMARKS	SIGN DETAIL LOCATION SHSM	SIGN DETAIL LOCATION PROJECT SHEET #	SIGN DETAIL LOCATION STANDARD SHEET #
ENOSBURG VT105 WB							FY-FLUORESCENT YELLOW FYG-FLUORESCENT YELLOW GREEN																				"SHSM"-STANDARD HIGHWAY SIGNS AND MARKINGS			
		F	VW-060	30	30			6.25																				7	
WB	2.330	F	VW-202	30	30		TRUCKS ENTERING						1		X														
		F	VW-081	36	36			9.00								2		X								7	
WB	2.115	F	W3-5	36	36		SPEED REDUCTION SPEED LIMIT 40			1					X														
WB	2.060	F	VD-018	30	18								1		X														
		F	VD-018	30	18		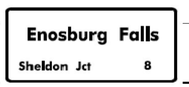	3.75								1		X								7	
WB	2.021	F	R2-1	24	30								1		X														
		F	R2-1	30	36			7.50								1		X									X	
WB	1.960	F	VD-062AL	72	16		BUSINESS SIGN			1				X														
WB	1.870	F	VD-062AS	72	16		BUSINESS SIGN			1				X														
WB	1.755	F	W3-5	36	36		SPEED REDUCTION SPEED LIMIT 30			1				X														
WB	1.680	F	R2-1	24	30								1		X														
		F	R2-1	30	36			7.50								1		X									X	
WB	1.540	F	D1-1A	72	10								1		X														
		F	VD1-1A	72	12		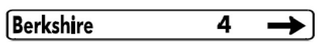	6.00								2		X									4	
							SHEET TOTALS	40.00	0.00	4	0	0	5	0	0	7		105.0		0	0.0	0.0	0.0	0.0				
								SF	SF	EA	EA	EA	EA	EA	EA	EA		FT		EA	LB	LB	LB	LB				
							TOWN DIRECTIONAL TOTALS	359.7	0.0	23	0	0	89	0	0	51		765.0		2		171.0						

SIGN SUMMARY SHEET

VERMONT AGENCY OF TRANSPORTATION

PROJECT NAME: St Albans - Berkshire
PROJECT NUMBER: STPG SIGN(36)

FILE NAME: EnosburaWB.xls
PROJECT MANAGER: A. Gamble
DESIGNED BY: T. Guazzoni

PLOT DATE: 5/17/2011
DRAWN BY: T. Guazzoni
CHECKED A. Gamble

DIRECTION	MILEPOINT	LOCATION CODE (SHEET 2)	SIGN CODE	WIDTH (IN)	HEIGHT (IN)	SHEETING REMARKS	SIGN LEGEND	NEW SIGNS "A"	NEW SIGNS "B"	EXISTING SIGNS RETAIN	EXISTING SIGNS SALVAGE FROM	EXISTING SIGNS SALVAGE TO	EXISTING SIGNS REMOVE	EXIST POST RETAIN	EXIST POST REMOVE	NUMBER OF NEW POSTS	SQUARE STEEL (IN) 1.75 (LB / FT) 1.88	SQUARE STEEL (IN) 2.00 (LB / FT) 2.42	SQUARE STEEL (IN) 2.50 (LB / FT) 3.35	FOUNDATION	TUBULAR STEEL Ø (IN) 3.00 (LB / FT) 7.60	TUBULAR STEEL Ø (IN) 3.50 (LB / FT) 9.00	TUBULAR STEEL Ø (IN) 4.00 (LB / FT) 10.80	TUBULAR STEEL Ø (IN) 5.00 (LB / FT) 14.60	SIGN FRAME REQUIRED	REMARKS	SIGN DETAIL LOCATION SHSM	SIGN DETAIL LOCATION PROJECT SHEET #	SIGN DETAIL LOCATION STANDARD SHEET #
ENOSBURG VT105 WB							FY-FLUORESCENT YELLOW FYG-FLUORESCENT YELLOW GREEN																				"SHSM"-STANDARD HIGHWAY SIGNS AND MARKINGS			
WB	1.510	G	VR-017	24	24		LEGAL LOAD LIMIT 24,000 POUNDS						1		X														
		G	VR-017	24	30			5.00								1		X									WATER TOWER RD (TH-4)		7	
WB	1.505	H	R1-1	36	36		STOP			1				X													WATER TOWER RD (TH-4)			
WB	1.495	F	VR-038	24	18		STATE HIGHWAY ENDS			1				X															
		F	R2-1	24	30		SPEED LIMIT 25			1																			
			BEGIN CLASS 1 SECTION - VILLAGE OF ENOSBURG FALLS																											
WB	1.420	F	W11-2	30	30	FYG	NEXT 1 MILE	6.25								1		X									INSTALL 400' +/- WEST OF CLASS 1 LIMIT	X		
		F	W7-3A	24	18	FYG		3.00																				X	
WB	1.380	G	R1-1	24	24		STOP						1		X												PLEASANT ST			
WB	1.370	F	W11-2	30	30		PEDESTRIAN			1				X															
		F	W16-7pL	24	12		LEFT DIAGONAL ARROW			1																			
WB	1.340	F	M2-1	21	15								1		X														
		F	M1-5	30	24								~~1~~ 0																
		F	M2-1	21	15		JCT VERMONT 108	2.19								1		X									GREEN ON WHITE	X		
		F	M1-5	30	24			5.00																					E-136B
							SHEET TOTALS	21.44	0.00	5	0	0	~~4~~ 3	0	0	3		45.0		0	0.0	0.0	0.0	0.0					
								SF	SF	EA	EA	EA	EA	EA	EA	EA		FT		EA	LB	LB	LB	LB					
							TOWN DIRECTIONAL TOTALS	359.7	0.0	23	0	0	89	0	0	51		765.0		2		171.0							

SIGN SUMMARY SHEET

VERMONT AGENCY OF TRANSPORTATION

PROJECT NAME: **St Albans - Berkshire**
PROJECT NUMBER: **STPG SIGN(36)**
FILE NAME: **EnosburgWB.xls**
PROJECT MANAGER: **A. Gamble**
DESIGNED BY: **T. Guazzoni**
DRAWN BY: **T. Guazzoni**
CHECKED **A. Gamble**
PLOT DATE: **5/17/2011**
ENOSBURG WB SHEET 5
SHEET **85** OF **109**

DIRECTION	MILEPOINT	LOCATION CODE (SHEET 2)	SIGN CODE	WIDTH (IN)	HEIGHT (IN)	SHEETING REMARKS	SIGN LEGEND	NEW SIGNS		EXISTING SIGNS				EXIST POST		NUMBER OF NEW POSTS	SQUARE STEEL (IN)			TUBULAR STEEL Ø (IN)				SIGN FRAME REQUIRED	REMARKS	SIGN DETAIL LOCATION		
								"A"	"B"	RETAIN	SALVAGE FROM	SALVAGE TO	REMOVE	RETAIN	REMOVE		1.75 (LB / FT)	2.00 (LB / FT)	2.50 (LB / FT)	FOUNDATION	3.00 (LB / FT)	3.50 (LB / FT)	4.00 (LB / FT)	5.00 (LB / FT)			SHSM	PROJECT SHEET #	STANDARD SHEET #
																	1.88	2.42	3.35		7.60	9.00	10.80	14.60					
ENOSBURG VT105 WB							FY-FLUORESCENT YELLOW FYG-FLUORESCENT YELLOW GREEN																			"SHSM"-STANDARD HIGHWAY SIGNS AND MARKINGS			
WB	1.240	F	M3-4	24	12		ROUTE MARKERS (9)						1		X														
		F	M1-5	30	24								1																
		F	M6-3	21	15								1																
		F	M3-3	24	12								1																
		F	M1-5	30	24								1																
		F	M6-3	21	15								1																
		F	M3-1	24	12								1																
		F	M1-5	30	24								1																
		F	M6-1R	21	15								1																
		F	VD1-1A	72	12			6.00																				4	
		F	M3-4	24	12			2.00													2	171			#3C	GREEN ON WHITE	X	6	
		F	M1-5	30	24			5.00																					E-136B
		F	M6-3	21	15			2.19																		GREEN ON WHITE	X		
		F	M3-3	24	12			2.00																		GREEN ON WHITE	X		
		F	M1-5	30	24			5.00																					E-136B
							SHEET TOTALS	22.19	0.00	0	0	0	9	0	0	0		0.0			2	171.0	0.0	0.0	0.0					
								SF	SF	EA	EA	EA	EA	EA	EA	EA		FT			EA	LB	LB	LB	LB					
							TOWN DIRECTIONAL TOTALS	359.7	0.0	23	0	0	89	0	0	51		765.0			2	171.0								

SIGN SUMMARY SHEET

VERMONT AGENCY OF TRANSPORTATION

PROJECT NAME: **St Albans - Berkshire**
PROJECT NUMBER: **STPG SIGN(36)**

FILE NAME: **EnosburgWB.xls** PLOT DATE: **5/17/2011**
PROJECT MANAGER: **A. Gamble** DRAWN BY: **T. Guazzoni**
DESIGNED BY: **T. Guazzoni** CHECKED **A. Gamble**
ENOSBURG WB SHEET 6 SHEET **86** OF **109**

DIRECTION	MILEPOINT	LOCATION CODE (SHEET 2)	SIGN CODE	WIDTH (IN)	HEIGHT (IN)	SHEETING REMARKS	SIGN LEGEND	NEW SIGNS "A"	NEW SIGNS "B"	EXISTING SIGNS RETAIN	EXISTING SIGNS SALVAGE FROM	EXISTING SIGNS SALVAGE TO	EXISTING SIGNS REMOVE	EXIST POST RETAIN	EXIST POST REMOVE	NUMBER OF NEW POSTS	SQUARE STEEL (IN) 1.75 (LB / FT) 1.88	SQUARE STEEL (IN) 2.00 (LB / FT) 2.42	SQUARE STEEL (IN) 2.50 (LB / FT) 3.35	TUBULAR STEEL Ø (IN) FOUNDATION	TUBULAR STEEL Ø (IN) 3.00 (LB / FT) 7.60	TUBULAR STEEL Ø (IN) 3.50 (LB / FT) 9.00	TUBULAR STEEL Ø (IN) 4.00 (LB / FT) 10.80	TUBULAR STEEL Ø (IN) 5.00 (LB / FT) 14.60	SIGN FRAME REQUIRED	REMARKS	SIGN DETAIL LOCATION SHSM	SIGN DETAIL LOCATION PROJECT SHEET #	SIGN DETAIL LOCATION STANDARD SHEET #
ENOSBURG VT105 WB							FY-FLUORESCENT YELLOW FYG-FLUORESCENT YELLOW GREEN																			"SHSM"-STANDARD HIGHWAY SIGNS AND MARKINGS			
		F	M6-3	21	15		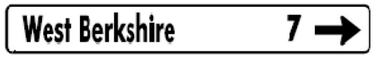	2.19																		GREEN ON WHITE	X		
		F	M3-1	24	12		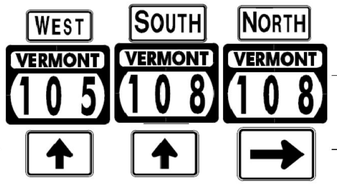	2.00																	GREEN ON WHITE	X		
		F	M1-5	30	24			5.00																					E-136B
		F	M6-1R	21	15			2.19																		GREEN ON WHITE	X		
WB	1.220	E	W1-6R	48	24		LARGE ARROW RIGHT						1		X														
		E	OM1-1	12	12		OBJECT MARKER						1																
		E	W1-6R	48	24			8.00								2		X								X		
WB	1.210	H	R1-1	30	30								1		X														
		G	D3-1	UNK.	UNK.								1																
		F	D3-1	UNK.	UNK.								1																
		G	D3-1	24	8			1.33																	INSTALL ABOVE STOP SIGN		6	
		F	D3-1	42	8			2.33																	INSTALL ABOVE STOP SIGN		6	
		H	R1-1	30	30			6.25								1		X							WEST BERKSHIRE RD (VT108)	X		
WB	1.210	E	W1-6L	48	24		LARGE ARROW LEFT						1		X														
		E	OM1-1	12	12		OBJECT MARKER						1																
SIGN SUMMARY SHEET							SHEET TOTALS	29.29	0.00	0	0	0	7	0	0	3		45.0		0	0.0	0.0	0.0	0.0				
								SF	SF	EA	EA	EA	EA	EA	EA	EA		FT		EA	LB	LB	LB	LB				
VERMONT AGENCY OF TRANSPORTATION							TOWN DIRECTIONAL TOTALS	359.7	0.0	23	0	0	89	0	0	51		765.0		2	171.0							

PROJECT NAME: **St Albans - Berkshire**
PROJECT NUMBER: **STPG SIGN(36)**

FILE NAME: **EnosburgWB.xls** PLOT DATE: **5/17/2011**
PROJECT MANAGER: **A. Gamble** DRAWN BY: **T. Guazzoni**
DESIGNED BY: **T. Guazzoni** CHECKED **A. Gamble**
ENOSBURG WB SHEET 7 SHEET **87** OF **109**

DIRECTION	MILEPOINT	LOCATION CODE (SHEET 2)	SIGN CODE	WIDTH (IN)	HEIGHT (IN)	SHEETING REMARKS	SIGN LEGEND	NEW SIGNS		EXISTING SIGNS				EXIST POST		NUMBER OF NEW POSTS	SQUARE STEEL (IN)			TUBULAR STEEL Ø (IN)				SIGN FRAME REQUIRED	REMARKS	SIGN DETAIL LOCATION		
								"A"	"B"	RETAIN	SALVAGE FROM	SALVAGE TO	REMOVE	RETAIN	REMOVE		1.75 (LB / FT) 1.88	2.00 (LB / FT) 2.42	2.50 (LB / FT) 3.35	FOUNDATION	3.00 (LB / FT) 7.60	3.50 (LB / FT) 9.00	4.00 (LB / FT) 10.80	5.00 (LB / FT) 14.60			SHSM	PROJECT SHEET #	STANDARD SHEET #
ENOSBURG VT105 WB							FY-FLUORESCENT YELLOW FYG-FLUORESCENT YELLOW GREEN																		"SHSM"-STANDARD HIGHWAY SIGNS AND MARKINGS			
		E	W1-6L	48	24		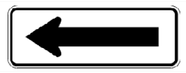	8.00								2		X								X		
WB	1.190	F	M3-4	24	12			2.00								2 ~~1~~		X							#2B	GREEN ON WHITE. INSTALL 425' +/- EAST OF EXISTING SIGN LOCATION	X	6	
		F	M1-5	30	24			5.00																				E-136B
		F	M3-3	24	12			2.00																		GREEN ON WHITE	X		
		F	M1-5	30	24			5.00																				E-136B
WB	1.110	F	M3-4	24	12		WEST						1		X													
		F	M1-5	30	24		VERMONT 105						1															
		F	M3-3	24	12		SOUTH						1															
		F	M1-5	30	24		VERMONT 108						1															
WB	1.095	F	W11-2	30	30		PEDESTRIAN						1		X													
WB	1.035	G	VR-017	24	30		LEGAL LOAD LIMIT 24000 LBS			1				X												ORCHARD ST (TH-8)			
WB	1.030	H	R1-1	30	30		STOP			1				X												ORCHARD ST (TH-8)			
		G	D3-1	UNK.	UNK.								1															
		F	D3-1	UNK.	UNK.								1															
		G	D3-1	24	8		Main St	1.33																		INSTALL ABOVE STOP SIGN		6	
							SHEET TOTALS	23.33	0.00	2	0	0	7	0	0	~~3~~ 4	45.0			0	0.0	0.0	0.0	0.0				
								SF	SF	EA	EA	EA	EA	EA	EA	EA	FT			EA	LB	LB	LB	LB				
							TOWN DIRECTIONAL TOTALS	359.7	0.0	23	0	0	89	0	0	51	765.0			2	171.0							

SIGN SUMMARY SHEET

VERMONT AGENCY OF TRANSPORTATION

PROJECT NAME: **St Albans - Berkshire**
PROJECT NUMBER: **STPG SIGN(36)**
FILE NAME: **EnosburgWB.xls**
PROJECT MANAGER: **A. Gamble**
DESIGNED BY: **T. Guazzoni**
ENOSBURG WB SHEET 8
PLOT DATE: **5/17/2011**
DRAWN BY: **T. Guazzoni**
CHECKED **A. Gamble**
~~SHEET~~ **88** OF **109**

DIRECTION	MILEPOINT	LOCATION CODE (SHEET 2)	SIGN CODE	WIDTH (IN)	HEIGHT (IN)	SHEETING REMARKS	SIGN LEGEND	NEW SIGNS		EXISTING SIGNS				EXIST POST		NUMBER OF NEW POSTS	SQUARE STEEL (IN)			TUBULAR STEEL Ø (IN)				SIGN FRAME REQUIRED	REMARKS	SIGN DETAIL LOCATION		
								"A"	"B"	RETAIN	SALVAGE FROM	SALVAGE TO	REMOVE	RETAIN	REMOVE		1.75 (LB / FT) 1.88	2.00 (LB / FT) 2.42	2.50 (LB / FT) 3.35	FOUNDATION	3.00 (LB / FT) 7.60	3.50 (LB / FT) 9.00	4.00 (LB / FT) 10.80	5.00 (LB / FT) 14.60			SHSM	PROJECT SHEET #	STANDARD SHEET #
ENOSBURG VT105 WB							FY-FLUORESCENT YELLOW FYG-FLUORESCENT YELLOW GREEN																		"SHSM"-STANDARD HIGHWAY SIGNS AND MARKINGS			
		F	D3-1	36	8		Orchard St	2.00																	INSTALL ABOVE STOP SIGN		6	
WB	1.025	F	VW-622	36	36		RECREATIONAL TRAIL						1		X													
		F	VW-622P	24	18		ALL SEASON PLAQUE						1															
		F	W1-7	24	12		<---> DOUBLE ARROW						1															
WB	1.020	F	VR-004A	24	30		YIELD TO PEDESTRIAN IN CROSSWALK						1		X													
WB	0.995	F	W11-2	30	30		PEDESTRIAN			1				X														
		F	W16-7pL	24	12		LEFT DIAGONAL ARROW			1																		
WB	0.975-0.900	G	UNK.	UNK.	UNK.		HANDICAP SIGNS			2				X														
WB	0.950	G	VR-017	24	30		LEGAL LOAD LIMIT 24,000 POUNDS	5.00								1		X							BISMARK ST (TH-102). INSTALL SIGN ON RT SIDE OF BISMARK ST.		7	
WB	0.945	H	R1-1	30	30								1		X													
		G	D3-1	UNK.	UNK.								1															
		F	D3-1	UNK.	UNK.		Main St						1															
		G	D3-1	24	8		Bismark St	1.33																	INSTALL ABOVE STOP SIGN		6	
		F	D3-1	36	8		STOP	2.00																	INSTALL ABOVE STOP SIGN		6	
		H	R1-1	30	30			6.25								1*		X							* EXISTING IN CONCRETE BISMARK ST (TH-102)	X		
							SHEET TOTALS	16.58	0.00	4	0	0	7	0	0	2		30.0		0	0.0	0.0	0.0	0.0				
								SF	SF	EA	EA	EA	EA	EA	EA	EA		FT		EA	LB	LB	LB	LB				
							TOWN DIRECTIONAL TOTALS	359.7	0.0	23	0	0	89	0	0	51		765.0		2		171.0						

SIGN SUMMARY SHEET

VERMONT AGENCY OF TRANSPORTATION

PROJECT NAME: **St Albans - Berkshire**
PROJECT NUMBER: **STPG SIGN(36)**

FILE NAME: **EnosburgWB.xls**
PROJECT MANAGER: **A. Gamble**
DESIGNED BY: **T. Guazzoni**
ENOSBURG WB SHEET 9

PLOT DATE: **5/17/2011**
DRAWN BY: **T. Guazzoni**
CHECKED **A. Gamble**
SHEET **89** OF **109**

DIRECTION	MILEPOINT	LOCATION CODE (SHEET 2)	SIGN CODE	WIDTH (IN)	HEIGHT (IN)	SHEETING REMARKS	SIGN LEGEND	NEW SIGNS		EXISTING SIGNS				EXIST POST		NUMBER OF NEW POSTS	SQUARE STEEL (IN)			TUBULAR STEEL Ø (IN)				SIGN FRAME REQUIRED	REMARKS	SIGN DETAIL LOCATION		
								"A"	"B"	RETAIN	SALVAGE FROM	SALVAGE TO	REMOVE	RETAIN	REMOVE		1.75 (LB / FT) 1.88	2.00 (LB / FT) 2.42	2.50 (LB / FT) 3.35	FOUNDATION	3.00 (LB / FT) 7.60	3.50 (LB / FT) 9.00	4.00 (LB / FT) 10.80	5.00 (LB / FT) 14.60			SHSM	PROJECT SHEET #	STANDARD SHEET #
ENOSBURG VT105 WB							FY-FLUORESCENT YELLOW FYG-FLUORESCENT YELLOW GREEN																		"SHSM"-STANDARD HIGHWAY SIGNS AND MARKINGS			
WB	0.880	F	VR-004A	24	30		YIELD TO PEDESTRIAN IN CROSSWALK						1		X													
WB	0.860	F	W11-2	30	30		PEDESTRIAN			1				X														
		F	W16-7pL	24	12		LEFT DIAGONAL ARROW			1																		
		E	W11-2	30	30	**FYG**		6.25																	INSTALL SIGNS BACK TO BACK TO EXISTING	X		
		E	W16-7pR	24	12	**FYG**		2.00																	NOTE THAT ARROW POINTS RIGHT	X		
WB	0.764	F	W11-2	30	30		PEDESTRIAN			1				X														
		F	W16-7pL	24	12		LEFT DIAGONAL ARROW			1																		
WB	0.755	F	M3-4	24	12		WEST						1		X													
		F	M1-5	30	24		VERMONT 105						1															
		F	M6-1R	21	15		RIGHT ARROW						~~1~~ 2															
WB	0.735	F	M3-3	24	12		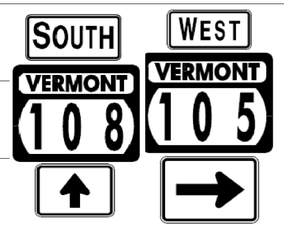	2.00								~~1~~ 2		X							#2B	GREEN ON WHITE. INSTALL 105' +/- WEST OF EXISTING LOCATION	X		
		F	M1-5	30	24			5.00																				E-136B
		F	M6-3	21	15			2.19																	GREEN ON WHITE	X		
		F	M3-4	24	12			2.00																	GREEN ON WHITE	X		
		F	M1-5	30	24			5.00																				E-136B
							SHEET TOTALS	24.44	0.00	4	0	0	~~4~~ 5	0	0	1		15.0		0	0.0	0.0	0.0	0.0				
								SF	SF	EA	EA	EA	EA	EA	EA	EA		FT		EA	LB	LB	LB	LB				
							TOWN DIRECTIONAL TOTALS	359.7	0.0	23	0	0	89	0	0	51		765.0		2		171.0						

SIGN SUMMARY SHEET

VERMONT AGENCY OF TRANSPORTATION

PROJECT NAME: **St Albans - Berkshire**
PROJECT NUMBER: **STPG SIGN(36)**

FILE NAME: **EnosburgWB.xls** PLOT DATE: **5/17/2011**
PROJECT MANAGER: **A. Gamble** DRAWN BY: **T. Guazzoni**
DESIGNED BY: **T. Guazzoni** CHECKED **A. Gamble**
ENOSBURG WB SHEET 10 SHEET **90** OF **109**

DIRECTION	MILEPOINT	LOCATION CODE (SHEET 2)	SIGN CODE	WIDTH (IN)	HEIGHT (IN)	SHEETING REMARKS	SIGN LEGEND	NEW SIGNS		EXISTING SIGNS				EXIST POST		NUMBER OF NEW POSTS	SQUARE STEEL (IN)			TUBULAR STEEL Ø (IN)				SIGN FRAME REQUIRED	REMARKS	SIGN DETAIL LOCATION		
								"A"	"B"	RETAIN	SALVAGE FROM	SALVAGE TO	REMOVE	RETAIN	REMOVE		1.75 (LB / FT)	2.00 (LB / FT)	2.50 (LB / FT)	FOUNDATION	3.00 (LB / FT)	3.50 (LB / FT)	4.00 (LB / FT)	5.00 (LB / FT)			SHSM	PROJECT SHEET #	STANDARD SHEET #
																	1.88	2.42	3.35		7.60	9.00	10.80	14.60					
ENOSBURG VT105 WB							FY-FLUORESCENT YELLOW FYG-FLUORESCENT YELLOW GREEN																			"SHSM"-STANDARD HIGHWAY SIGNS AND MARKINGS			
		F	M6-1R	21	15			2.19																		GREEN ON WHITE	X		
WB	0.640	F	W11-2	30	30		PEDESTRIAN			1				X															
		F	R1-6	12	36		STATE LAW YIELD TO PEDESTRIAN IN CROSSWALK						1													RETURN SIGN TO VILLAGE			
		F	W16-7pL	24	12	**FYG**		2.00																		INSTALL BELOW PEDESTRIAN SIGN	X		
WB	0.635	G	VR-017	24	30			5.00								1		X								CHURCH ST (TH-105). INSTALL SIGN ON RT SIDE OF CHURCH ST		7	
WB	0.630	H	R1-1	30	30								1		X														
		G	D3-1	UNK.	UNK.								1																
		F	D3-1	UNK.	UNK.								1																
		G	D3-1	24	8			1.33																	INSTALL ABOVE STOP SIGN		6	
		F	D3-1	30	8			1.67																	INSTALL ABOVE STOP SIGN		6	
		H	R1-1	30	30			6.25									1		X						CHURCH ST (TH-105)	X		
WB	0.600	F	R2-1	24	30								~~1~~ 0		~~X~~														
		F	R2-1	24	30			5.00								1		X								X		
WB	0.520	F	M3-4	24	12								1		X														
		F	M1-5	30	24								1																
							SHEET TOTALS	23.44	0.00	1	0	0	~~7~~ 6	0	0	3		45.0			0	0.0	0.0	0.0	0.0					
								SF	SF	EA	EA	EA	EA	EA	EA	EA		FT			EA	LB	LB	LB	LB					
							TOWN DIRECTIONAL TOTALS	359.7	0.0	23	0	0	89	0	0	51		765.0			2		171.0							

SIGN SUMMARY SHEET

VERMONT AGENCY OF TRANSPORTATION

PROJECT NAME: **St Albans - Berkshire**
PROJECT NUMBER: **STPG SIGN(36)**

FILE NAME: **EnosburgWB.xls**
PROJECT MANAGER: **A. Gamble**
DESIGNED BY: **T. Guazzoni**
ENOSBURG WB SHEET 11

PLOT DATE: **5/17/2011**
DRAWN BY: **T. Guazzoni**
CHECKED **A. Gamble**
SHEET **91** OF **109**

DIRECTION	MILEPOINT	LOCATION CODE (SHEET 2)	SIGN CODE	WIDTH (IN)	HEIGHT (IN)	SHEETING REMARKS	SIGN LEGEND	NEW SIGNS "A"	NEW SIGNS "B"	EXISTING SIGNS RETAIN	EXISTING SIGNS SALVAGE FROM	EXISTING SIGNS SALVAGE TO	EXISTING SIGNS REMOVE	EXIST POST RETAIN	EXIST POST REMOVE	NUMBER OF NEW POSTS	SQUARE STEEL (IN) 1.75 (LB / FT) 1.88	SQUARE STEEL (IN) 2.00 (LB / FT) 2.42	SQUARE STEEL (IN) 2.50 (LB / FT) 3.35	TUBULAR STEEL Ø (IN) FOUNDATION	TUBULAR STEEL Ø (IN) 3.00 (LB / FT) 7.60	TUBULAR STEEL Ø (IN) 3.50 (LB / FT) 9.00	TUBULAR STEEL Ø (IN) 4.00 (LB / FT) 10.80	TUBULAR STEEL Ø (IN) 5.00 (LB / FT) 14.60	SIGN FRAME REQUIRED	REMARKS	SIGN DETAIL LOCATION SHSM	SIGN DETAIL LOCATION PROJECT SHEET #	SIGN DETAIL LOCATION STANDARD SHEET #
ENOSBURG VT105 WB							FY-FLUORESCENT YELLOW FYG-FLUORESCENT YELLOW GREEN																			"SHSM"-STANDARD HIGHWAY SIGNS AND MARKINGS			
		F	M3-4	24	12			2.00								1		X							GREEN ON WHITE	X		
		F	M1-5	30	24			5.00																					E-136B
WB	0.500	F	UNK.	UNK.	UNK.		DWI YOU CANT AFFORD IT						1		X											RETURN SIGN TO VILLAGE			
			END CLASS 1 SECTION - VILLAGE OF ENOSBURG FALLS																											
WB	0.460	F	R2-1	24	30								1		X															
		F	VR-039	24	18								1																	
		F	VR-039	24	18			3.00								1		X									7	
		F	R2-1	24	30			5.00																			X		
WB	0.320	F	VW-622	36	36		RECRECATIONAL TRAIL						1		X															
		F	VW-622P	24	18		ALL SEASON PLAQUE						1																	
WB	0.300	G	W1-7	48	24								1		X															
		G	W1-7	48	24		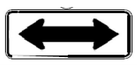	8.00								2		X									X		
WB	0.191	F	VW-218	30	30		CENTER RUMBLE STRIPS			1				X															
		F	W16-4p	24	18		NEXT 6 MILES			1																			
WB	0.150	F	VW-622A	36	36		RECRECATIONAL TRAIL						1		X															
							SHEET TOTALS	23.00	0.00	2	0	0	7	0	0	4		60.0		0	0.0	0.0	0.0	0.0					
								SF	SF	EA	EA	EA	EA	EA	EA	EA		FT		EA	LB	LB	LB	LB					
							TOWN DIRECTIONAL TOTALS	359.7	0.0	23	0	0	89	0	0	51		765.0		2		171.0							

SIGN SUMMARY SHEET

VERMONT AGENCY OF TRANSPORTATION

PROJECT NAME: **St Albans - Berkshire**
PROJECT NUMBER: **STPG SIGN(36)**

FILE NAME: **EnosburgWB.xls** PLOT DATE: **5/17/2011**
PROJECT MANAGER: **A. Gamble** DRAWN BY: **T. Guazzoni**
DESIGNED BY: **T. Guazzoni** CHECKED **A. Gamble**
ENOSBURG WB SHEET 12 SHEET **92** OF **109**

DIRECTION	MILEPOINT	LOCATION CODE (SHEET 2)	SIGN CODE	WIDTH (IN)	HEIGHT (IN)	SHEETING REMARKS	SIGN LEGEND	NEW SIGNS		EXISTING SIGNS				EXIST POST		NUMBER OF NEW POSTS	SQUARE STEEL (IN)			TUBULAR STEEL Ø (IN)				SIGN FRAME REQUIRED	REMARKS	SIGN DETAIL LOCATION		
																	1.75	2.00	2.50		3.00	3.50	4.00	5.00					
																	(LB / FT)				(LB / FT)								
								"A"	"B"	RETAIN	SALVAGE FROM	SALVAGE TO	REMOVE	RETAIN	REMOVE		1.88	2.42	3.35	FOUNDATION	7.60	9.00	10.80	14.60			SHSM	PROJECT SHEET #	STANDARD SHEET #
ENOSBURG VT105 WB							FY-FLUORESCENT YELLOW FYG-FLUORESCENT YELLOW GREEN																		"SHSM"-STANDARD HIGHWAY SIGNS AND MARKINGS			
		F	M6-4	21	15		<---> DOUBLE						1																
		F	W11-15A	30	30			6.25								1		X									X		
		F	W16-7pL	24	12			2.00																			X		
WB	0.120	F	R2-1	24	30								1		X														
		F	R2-1	24	30			5.00								~~1~~		X									X		
WB	0.120	F	VR-072	24	30								1		X														
		F	VR-072	24	30			5.00								1		X										7	
WB	0.110	G	VR-017	24	30							1	2 ~~1~~		X														
		G	VR-017	24	30			5.00								1		X								ORCHARD ST (TH-8)		7	
WB	0.090	H	R1-1	24	24							2	3 ~~1~~		X														
		H	R1-1	30	30			6.25								1		X								ORCHARD ST (TH-8) INSTALL SIGN IN GRASS ISLAND	X		
WB	0.085	H	R1-1	24	24							1	2 ~~1~~		X														
		H	R1-1	30	30			6.25								1		X								ORCHARD ST (TH-8) INSTALL SIGN ON LEFT SIDE OF ORCHARD ST	X		
							SHEET TOTALS	35.75	0.00	0	0	~~0~~ 4	~~6~~ 10	0	0	6		90.0		0	0.0	0.0	0.0	0.0					
								SF	SF	EA	EA	EA	EA	EA	EA	EA		FT		EA	LB	LB	LB	LB					
							TOWN DIRECTIONAL TOTALS	359.7	0.0	23	0	0	89	0	0	51		765.0		2		171.0							

SIGN SUMMARY SHEET

VERMONT AGENCY OF TRANSPORTATION

PROJECT NAME: **St Albans - Berkshire**
PROJECT NUMBER: **STPG SIGN(36)**

FILE NAME: **EnosburgWB.xls**
PROJECT MANAGER: **A. Gamble**
DESIGNED BY: **T. Guazzoni**
ENOSBURG WB SHEET 13

PLOT DATE: **5/17/2011**
DRAWN BY: **T. Guazzoni**
CHECKED **A. Gamble**
SHEET **93** OF **109**

DIRECTION	MILEPOINT	LOCATION CODE (SHEET 2)	SIGN CODE	WIDTH (IN)	HEIGHT (IN)	SHEETING REMARKS	SIGN LEGEND	NEW SIGNS "A"	NEW SIGNS "B"	EXISTING SIGNS RETAIN	EXISTING SIGNS SALVAGE FROM	EXISTING SIGNS SALVAGE TO	EXISTING SIGNS REMOVE	EXIST POST RETAIN	EXIST POST REMOVE	NUMBER OF NEW POSTS	SQUARE STEEL (IN) 1.75 (LB/FT) 1.88	SQUARE STEEL (IN) 2.00 (LB/FT) 2.42	SQUARE STEEL (IN) 2.50 (LB/FT) 3.35	TUBULAR STEEL Ø (IN) FOUNDATION	TUBULAR STEEL Ø (IN) 3.00 (LB/FT) 7.60	TUBULAR STEEL Ø (IN) 3.50 (LB/FT) 9.00	TUBULAR STEEL Ø (IN) 4.00 (LB/FT) 10.80	TUBULAR STEEL Ø (IN) 5.00 (LB/FT) 14.60	SIGN FRAME REQUIRED	REMARKS	SIGN DETAIL LOCATION SHSM	SIGN DETAIL LOCATION PROJECT SHEET #	SIGN DETAIL LOCATION STANDARD SHEET #
BERKSHIRE VT 105 EB							FY-FLUORESCENT YELLOW FYG-FLUORESCENT YELLOW GREEN																			"SHSM"-STANDARD HIGHWAY SIGNS AND MARKINGS			
EB	0.000	C	VD-024	72	10			5.00								2		X									4	
		C	VD-700	6	10		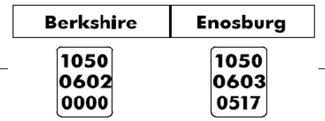	0.42																		INSTALL ON LEFT POST			E-138
		C	VD-700	6	10			0.42																		INSTALL ON RIGHT POST			E-138
EB	0.170	A	VW-622A	36	36		RECREATIONAL TRAIL						1		X														
		A	VW-622P	24	18		ALL SEASON PLAQUE						1																
EB	0.310	A	W1-4L	30	30								1		X														
		A	W1-4L	30	30			6.25								1		X									X		
EB	0.360	B	W1-6	48	24		LARGE ARROW RIGHT						1		X														
EB	0.390	A	W1-6	48	24		LARGE ARROW LEFT						1		X														
EB	0.400	A	VW-622B	36	36								1		X														
		A	W1-7	21	15								1																
		A	W11-15a	30	30			6.25								1		X									X		
		A	W16-7pL	24	12			2.00																			X		
EB	0.650	A	R2-5A	24	30		REDUCED SPEED AHEAD						1		X															
		A	W3-5	36	36			9.00								2		X									X		
SIGN SUMMARY SHEET							SHEET TOTALS	29.34	0.00	0	0	0	8	0	0	6		90.0		0	0.0	0.0	0.0	0.0					
								SF	SF	EA	EA	EA	EA	EA	EA	EA		FT		EA	LB	LB	LB	LB					
VERMONT AGENCY OF TRANSPORTATION							TOWN DIRECTIONAL TOTALS	235.4	0.0	0	0	0	53	0	0	40		600.0		0	0.0								

PROJECT NAME: **St Albans - Berkshire**
PROJECT NUMBER: **STPG SIGN(36)**

FILE NAME: **BerkshireEB.xls** PLOT DATE: **5/17/2011**
PROJECT MANAGER: **A. Gamble** DRAWN BY: **T. Guazzoni**
DESIGNED BY: **T. Guazzoni** CHECKED **A. Gamble**
BERKSHIRE EB SHEET 1 SHEET **94** OF **109**

DIRECTION	MILEPOINT	LOCATION CODE (SHEET 2)	SIGN CODE	WIDTH (IN)	HEIGHT (IN)	SHEETING REMARKS	SIGN LEGEND	NEW SIGNS "A"	NEW SIGNS "B"	EXISTING SIGNS RETAIN	EXISTING SIGNS SALVAGE FROM	EXISTING SIGNS SALVAGE TO	EXISTING SIGNS REMOVE	EXIST POST RETAIN	EXIST POST REMOVE	NUMBER OF NEW POSTS	SQUARE STEEL (IN) 1.75 (LB / FT) 1.88	SQUARE STEEL (IN) 2.00 (LB / FT) 2.42	SQUARE STEEL (IN) 2.50 (LB / FT) 3.35	FOUNDATION	TUBULAR STEEL Ø (IN) 3.00 (LB / FT) 7.60	TUBULAR STEEL Ø (IN) 3.50 (LB / FT) 9.00	TUBULAR STEEL Ø (IN) 4.00 (LB / FT) 10.80	TUBULAR STEEL Ø (IN) 5.00 (LB / FT) 14.60	SIGN FRAME REQUIRED	REMARKS	SIGN DETAIL LOCATION SHSM	SIGN DETAIL LOCATION PROJECT SHEET #	SIGN DETAIL LOCATION STANDARD SHEET #
BERKSHIRE VT 105 EB							FY-FLUORESCENT YELLOW FYG-FLUORESCENT YELLOW GREEN																			"SHSM"-STANDARD HIGHWAY SIGNS AND MARKINGS			
EB	0.670	A	VW-622A	36	36		RECREATIONAL TRAIL						1		X														
		A	VW-622P	24	18		ALL SEASON PLAQUE						1																
EB	0.720	A	VD-018	30	18								1		X														
		A	VD-018	30	18		East Berkshire Richford 5	3.75								1		X											7	
EB	0.760	A	R2-1	24	30								1		X														
		A	R2-1	30	36		SPEED LIMIT 35	7.50								1		X										X		
EB	0.820	A	VW-622B	36	36								1		X														
		A	W1-7	21	15								1																
		A	W11-15a	30	30		TRAIL CROSSING	6.25								1		X										X		
		A	W16-7pL	24	12			2.00																				X		
EB	0.844	A	M2-1	21	15								1		X														
		A	M1-5	30	24								1																
		A	M2-1	21	15		JCT VERMONT 118	2.19								1		X									GREEN ON WHITE	X		
		A	M1-5	30	24			5.00																					E-136B
EB	0.910	A	D1-1A	72	10								1		X														
SIGN SUMMARY SHEET							SHEET TOTALS	26.69	0.00	0	0	0	9	0	0	4		60.0		0	0.0	0.0	0.0	0.0					
								SF	SF	EA	EA	EA	EA	EA	EA	EA		FT		EA	LB	LB	LB	LB					
VERMONT AGENCY OF TRANSPORTATION							TOWN DIRECTIONAL TOTALS	235.4	0.0	0	0	0	53	0	0	40		600.0		0	0.0								

PROJECT NAME: **St Albans - Berkshire**
PROJECT NUMBER: **STPG SIGN(36)**
FILE NAME: **BerkshireEB.xls**
PROJECT MANAGER: **A. Gamble**
DESIGNED BY: **T. Guazzoni**
BERKSHIRE EB SHEET 2
PLOT DATE: **5/17/2011**
DRAWN BY: **T. Guazzoni**
CHECKED **A. Gamble**
SHEET **95** OF **109**

DIRECTION	MILEPOINT	LOCATION CODE (SHEET 2)	SIGN CODE	WIDTH (IN)	HEIGHT (IN)	SHEETING REMARKS	SIGN LEGEND	NEW SIGNS		EXISTING SIGNS				EXIST POST		NUMBER OF NEW POSTS	SQUARE STEEL (IN)			TUBULAR STEEL Ø (IN)				SIGN FRAME REQUIRED	REMARKS	SIGN DETAIL LOCATION		
																	1.75	2.00	2.50	3.00	3.50	4.00	5.00					
																	(LB / FT)			(LB / FT)								
								"A"	"B"	RETAIN	SALVAGE FROM	SALVAGE TO	REMOVE	RETAIN	REMOVE		1.88	2.42	3.35	FOUNDATION 7.60	SLIP BASE ~~9.00~~	10.80	14.60			SHSM	PROJECT SHEET #	STANDARD SHEET #
BERKSHIRE VT 105 EB							FY-FLUORESCENT YELLOW FYG-FLUORESCENT YELLOW GREEN																		"SHSM"-STANDARD HIGHWAY SIGNS AND MARKINGS			
		A	D1-1A	72	10								1															
		A	D1-1A	72	10								1															
		A	VD1-1A	72	12			6.00								2		X									4	
		A	VD1-1A	72	12		Richford 5 Berkshire 4	6.00																			4	
		A	VD1-1A	72	12		Montgomery 5	6.00								–											4	
EB	0.950	A	M3-1	24	12		ROUTE MARKERS (9)						1		X													
		A	M1-5	24	24								1															
		A	M6-1	21	15								1															
		A	M3-2	24	12								1															
		A	M1-5	30	24								1															
		A	M6-3	21	15								1															
		A	M3-3	24	12								1															
		A	M1-5	24	24								1															
		A	M5-1	21	15								1															
		A	M3-1	24	12			2.00								2			X		2			#3C	BLACK ON WHITE. INSTALL ON 2 1/2" SLIP BASES	X	6	
							SHEET TOTALS	20.00	0.00	0	0	0	11	0	0	4	60.0			0	0.0	~~0.0~~ 2	0.0	0.0				
								SF	SF	EA	EA	EA	EA	EA	EA	EA		FT		EA	LB	LB	LB	LB				
							TOWN DIRECTIONAL TOTALS	235.4	0.0	0	0	0	53	0	0	40	600.0			0	0.0							

SIGN SUMMARY SHEET

VERMONT AGENCY OF TRANSPORTATION

PROJECT NAME: St Albans - Berkshire
PROJECT NUMBER: STPG SIGN(36)
FILE NAME: BerkshireEB.xls
PROJECT MANAGER: A. Gamble
DESIGNED BY: T. Guazzoni
BERKSHIRE EB SHEET 3
PLOT DATE: 5/17/2011
DRAWN BY: T. Guazzoni
CHECKED A. Gamble
SHEET 96 OF 109

DIRECTION	MILEPOINT	LOCATION CODE (SHEET 2)	SIGN CODE	WIDTH (IN)	HEIGHT (IN)	SHEETING REMARKS	SIGN LEGEND	NEW SIGNS		EXISTING SIGNS				EXIST POST		NUMBER OF NEW POSTS	SQUARE STEEL (IN)			TUBULAR STEEL Ø (IN)				SIGN FRAME REQUIRED	REMARKS	SIGN DETAIL LOCATION		
								"A"	"B"	RETAIN	SALVAGE FROM	SALVAGE TO	REMOVE	RETAIN	REMOVE		1.75	2.00	2.50	3.00	3.50	4.00	5.00			SHSM	PROJECT SHEET #	STANDARD SHEET #
																	(LB / FT)			(LB / FT)								
																FOUNDATION	1.88	2.42	3.35	7.60	9.00	10.80	14.60					
BERKSHIRE VT 105 EB							FY-FLUORESCENT YELLOW FYG-FLUORESCENT YELLOW GREEN																		"SHSM"-STANDARD HIGHWAY SIGNS AND MARKINGS			
		A	M1-5	30	24			5.00																	BLACK ON WHITE			E-136C
		A	M6-1	21	15			2.19																	BLACK ON WHITE	X		
		A	M3-2	24	12			2.00																	GREEN ON WHITE	X		
		A	M1-5	30	24			5.00																				E-136B
		A	M6-3	21	15			2.19																	GREEN ON WHITE	X		
		A	M3-3	24	12		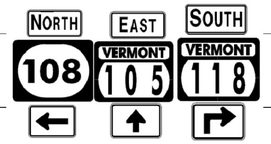	2.00																	GREEN ON WHITE	X		
		A	M1-5	30	24			5.00																				E-136B
		A	M5-1	21	15			2.19																	GREEN ON WHITE	X		
EB	0.970	A	R2-1	24	30								1		X													
		A	R2-1	24	30			5.00								1		X								X		
EB	1.130	A	VW-622A	36	36		RECRECATIONAL TRAIL						1		X													
		A	VW-622P	24	18		ALL SEASON PLAQUE						1															
EB	1.206	A	M3-2	24	12								1		X													
		A	M1-5	24	30								1															
		A	M3-2	24	12			2.00								1		X							GREEN ON WHITE	X		
SIGN SUMMARY SHEET							SHEET TOTALS	32.57	0.00	0	0	0	5	0	0	2		30.0		0	0.0	0.0	0.0	0.0					
								SF	SF	EA	EA	EA	EA	EA	EA	EA		FT		EA	LB	LB	LB	LB					
VERMONT AGENCY OF TRANSPORTATION							TOWN DIRECTIONAL TOTALS	235.4	0.0	0	0	0	53	0	0	40		600.0		0	0.0								

PROJECT NAME: **St Albans - Berkshire**
PROJECT NUMBER: **STPG SIGN(36)**

FILE NAME: **BerkshireEB.xls** PLOT DATE: **5/17/2011**
PROJECT MANAGER: **A. Gamble** DRAWN BY: **T. Guazzoni**
DESIGNED BY: **T. Guazzoni** CHECKED **A. Gamble**
BERKSHIRE EB SHEET 4 SHEET **97** OF **109**

DIRECTION	MILEPOINT	LOCATION CODE (SHEET 2)	SIGN CODE	WIDTH (IN)	HEIGHT (IN)	SHEETING REMARKS	SIGN LEGEND	NEW SIGNS		EXISTING SIGNS				EXIST POST		NUMBER OF NEW POSTS	SQUARE STEEL (IN)			FOUNDATION	TUBULAR STEEL Ø (IN)				SIGN FRAME REQUIRED	REMARKS	SIGN DETAIL LOCATION		
								"A"	"B"	RETAIN	SALVAGE FROM	SALVAGE TO	REMOVE	RETAIN	REMOVE		1.75 (LB / FT) 1.88	2.00 (LB / FT) 2.42	2.50 (LB / FT) 3.35		3.00 (LB / FT) 7.60	3.50 (LB / FT) 9.00	4.00 (LB / FT) 10.80	5.00 (LB / FT) 14.60			SHSM	PROJECT SHEET #	STANDARD SHEET #
BERKSHIRE VT 105 EB							FY-FLUORESCENT YELLOW FYG-FLUORESCENT YELLOW GREEN																			"SHSM"-STANDARD HIGHWAY SIGNS AND MARKINGS			
		A	M1-5	30	24			5.00																				E-136B
EB	1.250	A	VW-622B	36	36								1		X														
		A	W1-7	21	15								1																
		A	W11-15a	30	30			6.25								1		X									X		
		A	W16-7pL	24	12			2.00								–											X		
EB	1.390	A	R2-1	24	30								1		X														
		A	R2-1	24	30			5.00								1		X									X		
EB	1.760	A	VW-092	30	30								0 ~~1~~		0 ~~X~~														
		A	VW-092	36	36			9.00								2		X										E-150	
EB	1.890	C	VR-017	24	24								1		X														
		C	VR-017	24	30			5.00								1		X									RIVER RD (TH-46)		7	
EB	1.880	D	R1-1	30	30							~~3~~	~~4~~ ~~1~~		X														
		D	R1-1	30	30			6.25								1		X									RIVER RD (TH-46)	X		
EB	1.890	A	VW-092	30	30								1		X														
		A	VW-092	36	36			9.00								2		X										E-150	
							SHEET TOTALS	47.50	0.00	0	0	~~0~~ 3	~~7~~ 9	0	0	8		120.0		0	0.0	0.0	0.0	0.0					
								SF	SF	EA	EA	EA	EA	EA	EA	EA		FT		EA	LB	LB	LB	LB					
							TOWN DIRECTIONAL TOTALS	235.4	0.0	0	0	0	53	0	0	40		600.0		0	0.0								

SIGN SUMMARY SHEET

VERMONT AGENCY OF TRANSPORTATION

PROJECT NAME: **St Albans - Berkshire**
PROJECT NUMBER: **STPG SIGN(36)**

FILE NAME: **BerkshireEB.xls**
PROJECT MANAGER: **A. Gamble**
DESIGNED BY: **T. Guazzoni**
CHECKED **A. Gamble**
BERKSHIRE EB SHEET 5

PLOT DATE: **5/17/2011**
DRAWN BY: **T. Guazzoni**
SHEET **98** OF **109**

DIRECTION	MILEPOINT	LOCATION CODE (SHEET 2)	SIGN CODE	WIDTH (IN)	HEIGHT (IN)	SHEETING REMARKS	SIGN LEGEND	NEW SIGNS "A"	NEW SIGNS "B"	EXISTING SIGNS RETAIN	EXISTING SIGNS SALVAGE FROM	EXISTING SIGNS SALVAGE TO	EXISTING SIGNS REMOVE	EXIST POST RETAIN	EXIST POST REMOVE	NUMBER OF NEW POSTS	SQUARE STEEL (IN) 1.75 (LB / FT) 1.88	SQUARE STEEL (IN) 2.00 (LB / FT) 2.42	SQUARE STEEL (IN) 2.50 (LB / FT) 3.35	FOUNDATION	TUBULAR STEEL Ø (IN) 3.00 (LB / FT) 7.60	TUBULAR STEEL Ø (IN) 3.50 (LB / FT) 9.00	TUBULAR STEEL Ø (IN) 4.00 (LB / FT) 10.80	TUBULAR STEEL Ø (IN) 5.00 (LB / FT) 14.60	SIGN FRAME REQUIRED	REMARKS	SIGN DETAIL LOCATION SHSM	SIGN DETAIL LOCATION PROJECT SHEET #	SIGN DETAIL LOCATION STANDARD SHEET #
BERKSHIRE VT 105 EB							FY-FLUORESCENT YELLOW FYG-FLUORESCENT YELLOW GREEN																			"SHSM"-STANDARD HIGHWAY SIGNS AND MARKINGS			
EB	2.260	A	W2-1M	30	30								1		X													
		A	VW-205	30	30		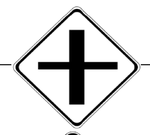						1															
		A	W2-1Mb	30	30			6.25								2		X									5	
		A	VW-205	30	30			6.25																		7	
EB	2.360	A	VW-092	30	30								1		X													
		A	VW-092	36	36			9.00								2		X									E-150
EB	2.450	C	VR-017	24	30								1		X													
		C	VR-017	24	30			5.00								1		X								RIVER RD (TH-46)		7	
EB	2.455	D	R1-1	30	30							3	~~1~~ 4		X													
		D	R1-1	30	30			6.25								1		X								RIVER RD (TH-46)	X		
EB	2.510	A	VW-092	30	30								1		X													
		A	VW-092	36	36			9.00								2		X									E-150
EB	2.535	A	OM-3R	12	36								1		X													
		A	OM-3R	12	36			3.00								1		X									X		
EB	2.570	B	OM-3L	12	36								1		X													
							SHEET TOTALS	44.75	0.00	0	0	~~0~~ 3	~~8~~ 11	0	0	9		135.0		0	0.0	0.0	0.0	0.0					
								SF	SF	EA	EA	EA	EA	EA	EA	EA		FT		EA	LB	LB	LB	LB					
							TOWN DIRECTIONAL TOTALS	235.4	0.0	0	0	0	53	0	0	40		600.0		0		0.0							

SIGN SUMMARY SHEET

VERMONT AGENCY OF TRANSPORTATION

PROJECT NAME: **St Albans - Berkshire**
PROJECT NUMBER: **STPG SIGN(36)**

FILE NAME: **BerkshireEB.xls**
PROJECT MANAGER: **A. Gamble**
DESIGNED BY: **T. Guazzoni**
BERKSHIRE EB SHEET 6

PLOT DATE: **5/17/2011**
DRAWN BY: **T. Guazzoni**
CHECKED **A. Gamble**
SHEET **99** OF **109**

DIRECTION	MILEPOINT	LOCATION CODE (SHEET 2)	SIGN CODE	WIDTH (IN)	HEIGHT (IN)	SHEETING REMARKS	SIGN LEGEND	NEW SIGNS		EXISTING SIGNS				EXIST POST		NUMBER OF NEW POSTS	SQUARE STEEL (IN)			TUBULAR STEEL Ø (IN)				SIGN FRAME REQUIRED	REMARKS	SIGN DETAIL LOCATION		
								"A"	"B"	RETAIN	SALVAGE FROM	SALVAGE TO	REMOVE	RETAIN	REMOVE		1.75 (LB / FT) 1.88	2.00 (LB / FT) 2.42	2.50 (LB / FT) 3.35	FOUNDATION	3.00 (LB / FT) 7.60	3.50 (LB / FT) 9.00	4.00 (LB / FT) 10.80	5.00 (LB / FT) 14.60			SHSM	PROJECT SHEET #	STANDARD SHEET #
BERKSHIRE VT 105 EB							FY-FLUORESCENT YELLOW FYG-FLUORESCENT YELLOW GREEN																		"SHSM"-STANDARD HIGHWAY SIGNS AND MARKINGS			
		B	OM-3L	12	36			3.00								1		X									X		
EB	2.630	C	VR-017	24	30								1		X														
		C	VR-017	24	30			5.00								1		X								HORSE SHOE RD (TH-43)		7	
EB	2.635	D	R1-1	30	30							3	~~1~~ 4		X														
		D	R1-1	30	30			6.25								1		X								HORSE SHOE RD (TH-43)	X		
EB	3.045	A	VW-092	30	30								1		X														
		A	VW-092	36	36			9.00								2		X											E-150
EB	3.130	C	VR-017	24	30								1		X														
		C	VR-017	24	30		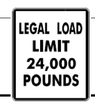	5.00								1		X								HORSE SHOE RD (TH-42)		7	
EB	3.140	D	R1-1	30	30							3	~~1~~ 4		X														
		D	R1-1	30	30			6.25								1		X								HORSE SHOE RD (TH-42)	X		

SIGN SUMMARY SHEET

VERMONT AGENCY OF TRANSPORTATION

SHEET TOTALS	34.50	0.00	0	0	~~0~~ 6	~~5~~ 11	0	0	7	105.0	0	0.0	0.0	0.0	0.0
	SF	SF	EA	EA	EA	EA	EA	EA	EA	FT	EA	LB	LB	LB	LB
TOWN DIRECTIONAL TOTALS	235.4	0.0	0	0	0	53	0	0	40	600.0	0	0.0			

PROJECT NAME: **St Albans - Berkshire**
PROJECT NUMBER: **STPG SIGN(36)**

FILE NAME: **BerkshireEB.xls**
PROJECT MANAGER: **A. Gamble**
DESIGNED BY: **T. Guazzoni**
BERKSHIRE EB SHEET 7

PLOT DATE: **5/17/2011**
DRAWN BY: **T. Guazzoni**
CHECKED **A. Gamble**
SHEET **100** OF **109**

DIRECTION	MILEPOINT	LOCATION CODE (SHEET 2)	SIGN CODE	WIDTH (IN)	HEIGHT (IN)	SHEETING REMARKS	SIGN LEGEND	NEW SIGNS		EXISTING SIGNS				EXIST POST		NUMBER OF NEW POSTS	SQUARE STEEL (IN)			TUBULAR STEEL Ø (IN)				SIGN FRAME REQUIRED	REMARKS	SIGN DETAIL LOCATION		
								"A"	"B"	RETAIN	SALVAGE FROM	SALVAGE TO	REMOVE	RETAIN	REMOVE		1.75	2.00	2.50	3.00	3.50	4.00	5.00			SHSM	PROJECT SHEET #	STANDARD SHEET #
																	(LB / FT)			(LB / FT)							
																	1.88	2.42	3.35	7.60	9.00	10.80	14.60					
BERKSHIRE VT105 WB							FY-FLUORESCENT YELLOW FYG-FLUORESCENT YELLOW GREEN																		"SHSM"-STANDARD HIGHWAY SIGNS AND MARKINGS			
WB	3.220	F	VW-092	30	30								1		X													
		F	VW-092	36	36			9.00								2		X									E-150
WB	2.730	F	W2-2MaR	30	30								1		X													
		F	W2-2MaR	30	30			6.25								2		X								7	
		F	VW-092	30	30			6.25																			E-150
WB	2.630	F	VW-092	30	30		UNSAFE TO PASS						1		X													
WB	2.580	F	W2-1M	30	30								1		X													
		F	VW-205	30	30		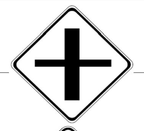						1															
		F	W2-1Mb	30	30			6.25								2		X								5	
		F	VW-205	30	30			6.25																		7	
WB	2.570	A	OM-3R	12	36								1		X													
		A	OM-3R	12	36			3.00								1		X								X	
WB	2.530	A	OM-3L	12	36								1		X													
		A	OM-3L	12	36			3.00								1		X								X	
WB	2.450	G	VR-017	24	30								1		X													
SIGN SUMMARY SHEET							SHEET TOTALS	40.00	0.00	0	0	0	8	0	0	8		120.0		0	0.0	0.0	0.0	0.0				
								SF	SF	EA	EA	EA	EA	EA	EA	EA		FT		EA	LB	LB	LB	LB				
VERMONT AGENCY OF TRANSPORTATION							TOWN DIRECTIONAL TOTALS	256.1	0.0	0	0	0	61	0	0	35		525.0		0	0.0							

PROJECT NAME: **St Albans - Berkshire**
PROJECT NUMBER: **STPG SIGN(36)**

FILE NAME: **BerkshireWB.xls** PLOT DATE: **5/17/2011**
PROJECT MANAGER: **A. Gamble** DRAWN BY: **T. Guazzoni**
DESIGNED BY: **T. Guazzoni** CHECKED **A. Gamble**
BERKSHIRE WB SHEET 1 SHEET **101** OF **109**

DIRECTION	MILEPOINT	LOCATION CODE (SHEET 2)	SIGN CODE	WIDTH (IN)	HEIGHT (IN)	SHEETING REMARKS	SIGN LEGEND	NEW SIGNS "A"	NEW SIGNS "B"	EXISTING SIGNS RETAIN	EXISTING SIGNS SALVAGE FROM	EXISTING SIGNS SALVAGE TO	EXISTING SIGNS REMOVE	EXIST POST RETAIN	EXIST POST REMOVE	NUMBER OF NEW POSTS	SQUARE STEEL (IN) 1.75 (LB / FT) 1.88	SQUARE STEEL (IN) 2.00 (LB / FT) 2.42	SQUARE STEEL (IN) 2.50 (LB / FT) 3.35	TUBULAR STEEL Ø (IN) FOUNDATION	TUBULAR STEEL Ø (IN) 3.00 (LB / FT) 7.60	TUBULAR STEEL Ø (IN) 3.50 (LB / FT) 9.00	TUBULAR STEEL Ø (IN) 4.00 (LB / FT) 10.80	TUBULAR STEEL Ø (IN) 5.00 (LB / FT) 14.60	SIGN FRAME REQUIRED	REMARKS	SIGN DETAIL LOCATION SHSM	SIGN DETAIL LOCATION PROJECT SHEET #	SIGN DETAIL LOCATION STANDARD SHEET #
BERKSHIRE VT105 WB							FY-FLUORESCENT YELLOW FYG-FLUORESCENT YELLOW GREEN																			"SHSM"-STANDARD HIGHWAY SIGNS AND MARKINGS			
		G	VR-017	24	30			5.00								1		X								KING RD (TH-29)		7	
WB	2.440	H	R1-1	30	30								1		X														
		H	R1-1	30	30			6.25								1		X								KING RD (TH-29)	X		
WB	2.110	F	VW-092	30	30								1		X														
		F	VW-092	36	36			9.00								2		X											E-150
WB	1.975	F	VW-092	30	30		UNSAFE TO PASS						1		X														
WB	1.530	F	R2-5A	24	30		REDUCED SPEED AHEAD						1		X														
		F	W3-5	36	36			9.00								2		X									X		
WB	1.500	F	VW-622A	36	36		RECREATIONAL TRAIL						1		X														
		F	VW-622P	24	16		ALL SEASON PLAQUE						1																
WB	1.450	F	VD-018	30	18								1		X														
		F	VD-018	30	18			3.75								1		X										7	
WB	1.390	F	R2-1	24	30								1		X														
		F	R2-1	30	36			7.50								1		X									X		
WB	1.320	F	VW-622B	36	36		RECREATIONAL TRAIL						1		X														
SIGN SUMMARY SHEET							SHEET TOTALS	40.50	0.00	0	0	0	9	0	0	8		120.0		0	0.0	0.0	0.0	0.0				
								SF	SF	EA	EA	EA	EA	EA	EA	EA		FT		EA	LB	LB	LB	LB				
VERMONT AGENCY OF TRANSPORTATION							TOWN DIRECTIONAL TOTALS	256.1	0.0	0	0	0	61	0	0	35		525.0		0	0.0							

PROJECT NAME: **St Albans - Berkshire**
PROJECT NUMBER: **STPG SIGN(36)**

FILE NAME: **BerkshireWB.xls** PLOT DATE: **5/17/2011**
PROJECT MANAGER: **A. Gamble** DRAWN BY: **T. Guazzoni**
DESIGNED BY: **T. Guazzoni** CHECKED **A. Gamble**
BERKSHIRE WB SHEET 2 SHEET **102** OF **109**

DIRECTION	MILEPOINT	LOCATION CODE (SHEET 2)	SIGN CODE	WIDTH (IN)	HEIGHT (IN)	SHEETING REMARKS	SIGN LEGEND	NEW SIGNS "A"	NEW SIGNS "B"	EXISTING SIGNS RETAIN	EXISTING SIGNS SALVAGE FROM	EXISTING SIGNS SALVAGE TO	EXISTING SIGNS REMOVE	EXIST POST RETAIN	EXIST POST REMOVE	NUMBER OF NEW POSTS	SQUARE STEEL (IN) 1.75 (LB / FT) 1.88	SQUARE STEEL (IN) 2.00 (LB / FT) 2.42	SQUARE STEEL (IN) 2.50 (LB / FT) 3.35	TUBULAR STEEL Ø (IN) FOUNDATION	TUBULAR STEEL Ø (IN) 3.00 (LB / FT) 7.60	TUBULAR STEEL Ø (IN) 3.50 (LB / FT) 9.00	TUBULAR STEEL Ø (IN) 4.00 (LB / FT) 10.80	TUBULAR STEEL Ø (IN) 5.00 (LB / FT) 14.60	SIGN FRAME REQUIRED	REMARKS	SIGN DETAIL LOCATION SHSM	SIGN DETAIL LOCATION PROJECT SHEET #	SIGN DETAIL LOCATION STANDARD SHEET #
BERKSHIRE VT105 WB							FY-FLUORESCENT YELLOW FYG-FLUORESCENT YELLOW GREEN																			"SHSM"-STANDARD HIGHWAY SIGNS AND MARKINGS			
		F	W1-7	21	15		<---> DOUBLE ARROW						1															
		F	W11-15a	30	30			6.25								1		X								X		
		F	W16-7pL	24	12			2.00																		X		
WB	1.210	F	D9-1	24	30		PHONE SERVICE						1		X													
		F	VD-058	24	8		AHEAD						1															
WB	1.170	F	R2-1	24	30								1		X													
		F	R2-1	24	30			5.00								1		X								X		
WB	1.150	F	M2-1	21	15								1		X													
		F	M1-5	24	24								1															
		F	M2-1	21	15			2.19								1		X							GREEN ON WHITE	X		
		F	M1-5	30	24			5.00																				E-136B
WB	1.110	F	D1-1A	72	10		DESTINATION SIGNS (5)						1		X													
		F	D1-1A	72	10								1															
		F	D1-1A	72	10								1															
		F	D1-1S	72	10								1															
							SHEET TOTALS	20.44	0.00	0	0	0	10	0	0	3		45.0		0	0.0	0.0	0.0	0.0					
								SF	SF	EA	EA	EA	EA	EA	EA	EA		FT		EA	LB	LB	LB	LB					
							TOWN DIRECTIONAL TOTALS	256.1	0.0	0	0	0	61	0	0	35		525.0		0		0.0							

SIGN SUMMARY SHEET

VERMONT AGENCY OF TRANSPORTATION

PROJECT NAME: **St Albans - Berkshire**
PROJECT NUMBER: **STPG SIGN(36)**

FILE NAME: **BerkshireWB.xls** PLOT DATE: **5/17/2011**
PROJECT MANAGER: **A. Gamble** DRAWN BY: **T. Guazzoni**
DESIGNED BY: **T. Guazzoni** CHECKED **A. Gamble**
BERKSHIRE WB SHEET 3 SHEET **103** OF **109**

DIRECTION	MILEPOINT	LOCATION CODE (SHEET 2)	SIGN CODE	WIDTH (IN)	HEIGHT (IN)	SHEETING REMARKS	SIGN LEGEND	NEW SIGNS		EXISTING SIGNS				EXIST POST		NUMBER OF NEW POSTS	SQUARE STEEL (IN)			TUBULAR STEEL Ø (IN)				SIGN FRAME REQUIRED	REMARKS	SIGN DETAIL LOCATION		
																	1.75	2.00	2.50	3.00	3.50	4.00	5.00					
																	(LB / FT)			(LB / FT)							
								"A"	"B"	RETAIN	SALVAGE FROM	SALVAGE TO	REMOVE	RETAIN	REMOVE		1.88	2.42	3.35	FOUNDATION	7.60	SLIP BASE ~~9.00~~	10.80	14.60			SHSM	PROJECT SHEET #	STANDARD SHEET #
BERKSHIRE VT105 WB							FY-FLUORESCENT YELLOW FYG-FLUORESCENT YELLOW GREEN																		"SHSM"-STANDARD HIGHWAY SIGNS AND MARKINGS			
		F	D1-1A	72	10								1															
		F	VD1-1A	72	12			6.00								2			X			2			INSTALL ON 2 1/2" SLIP BASES		4	
		F	VD1-1A	72	12		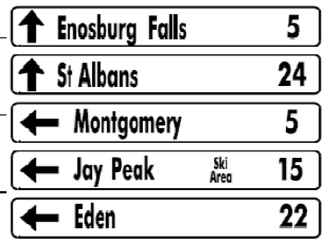	6.00																		4	
		F	VD1-1A	72	12			6.00																			4	
		F	VD1-1S	72	12			6.00																			4	
		F	VD1-1A	72	12			6.00																			4	
WB	1.080	F	M3-3	24	12		ROUTE MARKERS (9)						1		X													
		F	M1-5	30	24								1															
		F	M6-1	21	15								1															
		F	M3-4	24	12								1															
		F	M1-5	24	24								1															
		F	M6-3	21	15								1															
		F	M3-1	24	12								1															
		F	M1-5A	24	24								1															
		F	M6-1	21	15								1															
							SHEET TOTALS	30.00	0.00	0	0	0	10	0	0	2		30.0		0	0.0	~~0.0~~ 2	0.0	0.0					
								SF	SF	EA	EA	EA	EA	EA	EA	EA		FT		EA	LB	LB	LB	LB					
							TOWN DIRECTIONAL TOTALS	256.1	0.0	0	0	0	61	0	0	35		525.0		0		0.0							

SIGN SUMMARY SHEET

VERMONT AGENCY OF TRANSPORTATION

PROJECT NAME: **St Albans - Berkshire**
PROJECT NUMBER: **STPG SIGN(36)**
FILE NAME: **BerkshireWB.xls**
PROJECT MANAGER: **A. Gamble**
DESIGNED BY: **T. Guazzoni**
DRAWN BY: **T. Guazzoni**
CHECKED **A. Gamble**
PLOT DATE: **5/17/2011**
BERKSHIRE WB SHEET 4
SHEET **104** OF **109**

DIRECTION	MILEPOINT	LOCATION CODE (SHEET 2)	SIGN CODE	WIDTH (IN)	HEIGHT (IN)	SHEETING REMARKS	SIGN LEGEND	NEW SIGNS		EXISTING SIGNS				EXIST POST		NUMBER OF NEW POSTS	SQUARE STEEL (IN)			FOUNDATION	TUBULAR STEEL Ø (IN)				SIGN FRAME REQUIRED	REMARKS	SIGN DETAIL LOCATION		
																	1.75	2.00	2.50		3.00	3.50	4.00	5.00					
																	(LB / FT)				(LB / FT)								
								"A"	"B"	RETAIN	SALVAGE FROM	SALVAGE TO	REMOVE	RETAIN	REMOVE		1.88	2.42	3.35		7.60	SLIP BASE ~~9.00~~	10.80	14.60			SHSM	PROJECT SHEET #	STANDARD SHEET #
BERKSHIRE VT105 WB							FY-FLUORESCENT YELLOW FYG-FLUORESCENT YELLOW GREEN																			"SHSM"-STANDARD HIGHWAY SIGNS AND MARKINGS			
		F	M3-3	24	12			2.00								2			X			2			#3C	GREEN ON WHITE . INSTALL ON 2 1/2" SLIP BASES	X	6	
		F	M1-5	30	24			5.00																					E-136B
		F	M6-1L	21	15			2.19																		GREEN ON WHITE	X		
		F	M3-4	24	12			2.00																		GREEN ON WHITE	X		
		F	M1-5	30	24			5.00																					E-136B
		F	M6-3	21	15			2.19																		GREEN ON WHITE	X		
		F	M3-1	24	12			2.00																		BLACK ON WHITE	X		
		F	M1-5A	30	24			5.00																					E-136C
		F	M5-1R	21	15			2.19																		BLACK ON WHITE	X		
WB	1.050	F	M3-3	24	12			2.00								1		X								INSTALL ACROSS FROM VT118, 10' WEST OF UTILITY POLE. GREEN ON WHITE	X		
		F	M1-5	30	24			5.00																					E-136B
		F	6-1L	21	15			2.19																		GREEN ON WHITE	X		
WB	1.010	F	D1-1A	72	10								1		X														
		F	D1-1A	72	10								1																
		F	D1-1A	72	10								1																
							SHEET TOTALS	36.76	0.00	0	0	0	3	0	0	3		45.0		0	0.0	~~0.0~~ 2	0.0	0.0					
								SF	SF	EA	EA	EA	EA	EA	EA	EA		FT		EA	LB	LB	LB	LB					
							TOWN DIRECTIONAL TOTALS	256.1	0.0	0	0	0	61	0	0	35		525.0		0		0.0							

SIGN SUMMARY SHEET

VERMONT AGENCY OF TRANSPORTATION

PROJECT NAME: **St Albans - Berkshire**
PROJECT NUMBER: **STPG SIGN(36)**
FILE NAME: **BerkshireWB.xls**
PROJECT MANAGER: **A. Gamble**
DESIGNED BY: **T. Guazzoni**
BERKSHIRE WB SHEET 5
PLOT DATE: **5/17/2011**
DRAWN BY: **T. Guazzoni**
CHECKED **A. Gamble**
SHEET **105** OF **109**

DIRECTION	MILEPOINT	LOCATION CODE (SHEET 2)	SIGN CODE	WIDTH (IN)	HEIGHT (IN)	SHEETING REMARKS	SIGN LEGEND	NEW SIGNS "A"	NEW SIGNS "B"	EXISTING SIGNS RETAIN	EXISTING SIGNS SALVAGE FROM	EXISTING SIGNS SALVAGE TO	EXISTING SIGNS REMOVE	EXIST POST RETAIN	EXIST POST REMOVE	NUMBER OF NEW POSTS	SQUARE STEEL (IN) (LB / FT) 1.75 1.88	SQUARE STEEL (IN) (LB / FT) 2.00 2.42	SQUARE STEEL (IN) (LB / FT) 2.50 3.35	TUBULAR STEEL Ø (IN) FOUNDATION	TUBULAR STEEL Ø (IN) (LB / FT) 3.00 7.60	TUBULAR STEEL Ø (IN) (LB / FT) 3.50 SLIP BASE ~~9.00~~	TUBULAR STEEL Ø (IN) (LB / FT) 4.00 10.80	TUBULAR STEEL Ø (IN) (LB / FT) 5.00 14.60	SIGN FRAME REQUIRED	REMARKS	SIGN DETAIL LOCATION SHSM	SIGN DETAIL LOCATION PROJECT SHEET #	SIGN DETAIL LOCATION STANDARD SHEET #
BERKSHIRE VT105 WB							FY-FLUORESCENT YELLOW FYG-FLUORESCENT YELLOW GREEN																			"SHSM"-STANDARD HIGHWAY SIGNS AND MARKINGS			
		F	D1-1A	72	10								1															
		F	VD1-1A	72	12			6.00				I				2			X							INSTALL ON 2 1/2" SLIP BASES		4	
		F	VD1-1A	72	12		Enosburg Falls 5	6.00																				4	
		F	VD1-1A	72	12		St Albans 24	6.00																				4	
		F	VD1-1A	72	12		Berkshire 4 →	6.00																				4	
		F	VD1-1A	72	12		W Berkshire 7 →	6.00																				4	
WB	0.980	F	M3-4	24	12		ROUTE MARKERS (6)						1		X														
		F	M1-5	30	24								1																
		F	M6-3	21	15								1																
		F	M3-1	24	12								1																
		F	M1-5A	30	24								1																
		F	M6-1	21	15								1																
		F	M3-4	24	12			2.00								2			X							#1B	GREEN ON WHITE	X	6	
		F	M1-5	30	24			5.00																					E-136B
		F	M6-3	21	15			2.19																			GREEN ON WHITE	X		
		F	M3-1	24	12			2.00																			BLACK ON WHITE	X		
							SHEET TOTALS	35.19	0.00	0	0	~~0~~ 1	7	0	0	4		60.0		0	0.0	~~0.0~~ 2	0.0	0.0				
								SF	SF	EA	EA	EA	EA	EA	EA	EA		FT		EA	LB	LB	LB	LB				
							TOWN DIRECTIONAL TOTALS	256.1	0.0	0	0	0	61	0	0	35		525.0		0		0.0						

SIGN SUMMARY SHEET

VERMONT AGENCY OF TRANSPORTATION

PROJECT NAME: **St Albans - Berkshire**
PROJECT NUMBER: **STPG SIGN(36)**

FILE NAME: **BerkshireWB.xls**
PROJECT MANAGER: **A. Gamble**
DESIGNED BY: **T. Guazzoni**
BERKSHIRE WB SHEET 6

PLOT DATE: **5/17/2011**
DRAWN BY: **T. Guazzoni**
CHECKED **A. Gamble**
SHEET **106** OF **109**

DIRECTION	MILEPOINT	LOCATION CODE (SHEET 2)	SIGN CODE	WIDTH (IN)	HEIGHT (IN)	SHEETING REMARKS	SIGN LEGEND	NEW SIGNS "A"	NEW SIGNS "B"	EXISTING SIGNS RETAIN	EXISTING SIGNS SALVAGE FROM	EXISTING SIGNS SALVAGE TO	EXISTING SIGNS REMOVE	EXIST POST RETAIN	EXIST POST REMOVE	NUMBER OF NEW POSTS	SQUARE STEEL (IN) 1.75 (LB / FT) 1.88	SQUARE STEEL (IN) 2.00 (LB / FT) 2.42	SQUARE STEEL (IN) 2.50 (LB / FT) 3.35	FOUNDATION	TUBULAR STEEL Ø (IN) 3.00 (LB / FT) 7.60	TUBULAR STEEL Ø (IN) 3.50 (LB / FT) 9.00	TUBULAR STEEL Ø (IN) 4.00 (LB / FT) 10.80	TUBULAR STEEL Ø (IN) 5.00 (LB / FT) 14.60	SIGN FRAME REQUIRED	REMARKS	SIGN DETAIL LOCATION SHSM	SIGN DETAIL LOCATION PROJECT SHEET #	SIGN DETAIL LOCATION STANDARD SHEET #
BERKSHIRE VT105 WB							FY-FLUORESCENT YELLOW FYG-FLUORESCENT YELLOW GREEN																			"SHSM"-STANDARD HIGHWAY SIGNS AND MARKINGS			
		F	M1-5A	30	24			5.00																			E-136C
		F	M6-1R	21	15			2.19																		BLACK ON WHITE	X		
WB	0.970	G	VR-079	24	24								1		X														
		G	VR-079	24	30			5.00								1		X								BERKSHIRE CENTER RD (SNTH-118)		7	
WB	0.960	H	R1-1	30	30							3 ~~0~~	4 ~~1~~		X														
		H	R1-1	30	30			6.25								1		X								BERKSHIRE CENTER RD (SNTH-118)	X		
WB	0.950	F	VW-622A	36	36		RECREATIONAL TRAIL						1		X														
		F	VW-622P	24	18		ALL SEASON PLAQUE						1																
WB	0.880	F	M3-4	24	12			2.00								1		X								INSTALL 50' +/- EAST OF EXISTING LOCATION. GREEN ON WHITE	X		
		F	M1-5	30	24			5.00																				E-136B
WB	0.870	F	M3-4	24	12		WEST						1		X														
		F	M1-5	30	24		VERMONT 105						1																
		F	VW-622B	36	36		RECREATIONAL TRAIL XING						1																
		F	W1-7	21	15		<---> DOUBLE ARROW						1																
WB	0.845	F	W11-15a	30	30			6.25								1		X								INSTALL BEHIND GUARDRAIL, 10' EAST OF POLE	X		
							SHEET TOTALS	31.69	0.00	0	0	3 ~~0~~	11 ~~8~~	0	0	4	60.0			0	0.0	0.0	0.0	0.0				
								SF	SF	EA	EA	EA	EA	EA	EA	EA	FT				EA	LB	LB	LB	LB				
							TOWN DIRECTIONAL TOTALS	256.1	0.0	0	0	0	61	0	0	35	525.0			0	0.0							

SIGN SUMMARY SHEET

VERMONT AGENCY OF TRANSPORTATION

PROJECT NAME: St Albans - Berkshire
PROJECT NUMBER: STPG SIGN(36)

FILE NAME: BerkshireWB.xls
PROJECT MANAGER: A. Gamble
DESIGNED BY: T. Guazzoni
BERKSHIRE WB SHEET 7

PLOT DATE: 5/17/2011
DRAWN BY: T. Guazzoni
CHECKED A. Gamble
SHEET 107 OF 109

DIRECTION	MILEPOINT	LOCATION CODE (SHEET 2)	SIGN CODE	WIDTH (IN)	HEIGHT (IN)	SHEETING REMARKS	SIGN LEGEND	NEW SIGNS "A"	NEW SIGNS "B"	EXISTING SIGNS RETAIN	EXISTING SIGNS SALVAGE FROM	EXISTING SIGNS SALVAGE TO	EXISTING SIGNS REMOVE	EXIST POST RETAIN	EXIST POST REMOVE	NUMBER OF NEW POSTS	SQUARE STEEL (IN) 1.75 (LB / FT) 1.88	SQUARE STEEL (IN) 2.00 (LB / FT) 2.42	SQUARE STEEL (IN) 2.50 (LB / FT) 3.35	TUBULAR STEEL Ø (IN) FOUNDATION	TUBULAR STEEL Ø (IN) 3.00 (LB / FT) 7.60	TUBULAR STEEL Ø (IN) 3.50 (LB / FT) 9.00	TUBULAR STEEL Ø (IN) 4.00 (LB / FT) 10.80	TUBULAR STEEL Ø (IN) 5.00 (LB / FT) 14.60	SIGN FRAME REQUIRED	REMARKS	SIGN DETAIL LOCATION SHSM	SIGN DETAIL LOCATION PROJECT SHEET #	SIGN DETAIL LOCATION STANDARD SHEET #
BERKSHIRE VT105 WB							FY-FLUORESCENT YELLOW FYG-FLUORESCENT YELLOW GREEN																			"SHSM"-STANDARD HIGHWAY SIGNS AND MARKINGS			
		F	W16-7pL	24	12			2.00																		INSTALL ON LEFT POST	X		
WB	0.790	F	R2-1	24	30								1		X														
		F	R2-1	24	30			5.00								1		X									X		
WB	0.670	F	VW-622A	36	36		RECREATIONAL TRAIL						1		X														
		F	VW-622P	24	18		ALL SEASON PLAQUE						1																
WB	0.510	F	W1-4L	30	30		LEFT REVERSE CURVE						1		X														
WB	0.472	F	W1-4L	30	30			6.25								1		X									INSTALL 200' +/- WEST OF EXISTING SIGN	X		
WB	0.410	F	VW-622B	36	36		RECREATIONAL TRAIL					I	~~1~~ 2		X														
		F	W1-7	21	15		<---> DOUBLE ARROW						1																
		F	W11-15a	30	30			6.25								1		X									X		
		F	W16-7pL	24	12			2.00																			X		

SIGN SUMMARY SHEET

VERMONT AGENCY OF TRANSPORTATION

	NEW SIGNS "A"	NEW SIGNS "B"	EXISTING SIGNS RETAIN	EXISTING SIGNS SALVAGE FROM	EXISTING SIGNS SALVAGE TO	EXISTING SIGNS REMOVE	EXIST POST RETAIN	EXIST POST REMOVE	NUMBER OF NEW POSTS	SQUARE STEEL (IN)	TUBULAR STEEL Ø (IN) FOUNDATION	TUBULAR STEEL Ø (IN) 3.00	TUBULAR STEEL Ø (IN) 3.50	TUBULAR STEEL Ø (IN) 4.00	TUBULAR STEEL Ø (IN) 5.00
SHEET TOTALS	21.50	0.00	0	0	I ~~0~~	7 ~~6~~	0	0	3	45.0	0	0.0	0.0	0.0	0.0
	SF	SF	EA	EA	EA	EA	EA	EA	EA	FT	EA	LB	LB	LB	LB
TOWN DIRECTIONAL TOTALS	256.1	0.0	0	0	0	61	0	0	35	525.0	0	0.0			

PROJECT NAME: **St Albans - Berkshire**
PROJECT NUMBER: **STPG SIGN(36)**

FILE NAME: **BerkshireWB.xls** PLOT DATE: **5/17/2011**
PROJECT MANAGER: **A. Gamble** DRAWN BY: **T. Guazzoni**
DESIGNED BY: **T. Guazzoni** CHECKED **A. Gamble**
BERKSHIRE WB SHEET 8 SHEET **108** OF **109**

TOWN TOTAL SIGN SUMMARY SHEET

ST ALBANS - BERKSHIRE STPG SIGN (36)

TOWN NAME	COUNTY	TOWN MILEAGE	NEW SIGNS (SF)		EXISTING SIGNS (EA)						NUMBER OF NEW POSTS (EA)				SQUARE STEEL (IN)			TUBULAR STEEL Ø (IN)				
															1.75	2.00	2.50		3.00	3.50	4.00	5.00
											1.75"	2"	2.5"		(LB / FT)				(LB / FT)			
			TYPE A	TYPE B	RETAIN	SALVAGE FROM	SALVAGE TO	REMOVE		POSTS LF	1.88	2.42	3.35	TOTAL POSTS	1.88	2.42	3.35	FOUNDATION	7.60	SLIP BASE 9.00	10.80	14.60
STALBANS VT105 AP EB	FRANKLIN		19.5	0	~~0~~	0	0	~~7~~			0	~~3~~	~~0~~	~~3~~	0	~~45~~	0	0				
STALBANS VT105AP WB	FRANKLIN		45.3	0	~~2~~	0	0	~~18~~			0	~~3~~	~~2~~	~~5~~	0	~~45~~	~~30~~	0				
ST ALBANS VT105 EB	FRANKLIN	~~1.930~~	215.5	0	~~0~~	0	0	~~47~~			0	~~28~~	~~4~~	~~32~~	0	~~420~~	~~60~~	0	438.9			
ST ALBANS VT105 WB	FRANKLIN	522.55	242.2	0	~~1~~	0	6 ~~0~~	~~69~~	148.0	895.0	0	~~22~~	~~4~~	~~26~~	0	~~330~~	~~60~~	4	~~433.2~~	10.0		
SWANTON VT105 EB	FRANKLIN	~~3.900~~	65.3	0	~~0~~	0	8 ~~0~~	~~13~~			0	~~13~~	0	~~13~~	0	~~195~~	0	0				
SWANTON VT105 WB	FRANKLIN	126.34	61.0	0	~~0~~	0	~~0~~	~~15~~	34	320.25	0	~~11~~	0	~~11~~	0	~~165~~	0	0				
SHELDON VT105 EB	FRANKLIN	~~11.015~~	417.6	0	~~48~~	2	~~2~~	~~108~~			0	~~72~~	0	~~72~~	0	~~1080~~	0	0				
SHELDON VT105 WB	FRANKLIN	906.13	488.5	0	~~48~~	7	13 ~~7~~	~~103~~	217	2024.25	0	~~73~~	8	~~81~~	0	~~1095~~	~~120~~	0	197.6			
ENOSBURG VT105 EB	FRANKLIN	~~5.167~~	393.9	0	~~25~~	4	~~4~~	~~94~~			0	56	2	58	0	~~840~~	~~30~~	2	~~235.6~~	8.0		
ENOSBURG VT105 WB	FRANKLIN	754.39	359.7	0	~~23~~	0	11 ~~0~~	~~89~~	190	1512.0	0	49	0	49	0	~~735~~	0	2	~~171.0~~			
BERKSHIRE VT105 EB	FRANKLIN	~~3.700~~	235.4	0	~~0~~	0	~~0~~	~~53~~			0	38	2	40	0	~~570~~	~~30~~	0	186.2	2		
BERKSHIRE VT105 WB	FRANKLIN	491.43	256.1	0	~~0~~	0	17 ~~0~~	~~61~~	129	995.25	0	29	6	35	0	~~435~~	~~90~~	0		8		
				Sub-Total		13	13	677				**SUB TOTALS**			0	5955	420					
Estimated Salvaged Street Name Signs to be erected onto new posts (Sheet 2, General Note 4):							10	10														
Salvaged Mile Marker Signs to be erected onto new posts (Sheet 2, General Notes 2 &3):							19	25														
			2800.84				55	718								5746.75			822.7	28		
		TOTAL =	~~2800.0~~	0	147	26	~~42~~	~~712~~		5746.75	0	~~397~~	~~28~~	~~425~~	~~6375~~			8	~~839.8~~	~~0.0~~	0.0	0.0

PROJECT NAME: ST ALBANS - BERKSHIRE

PROJECT NUMBER: STPG SIGN (36)

FILE NAME: 10B338.DGN
PROJECT LEADER: A. GAMBLE
DESIGNED BY: T. GUAZZONI
TOWN TOTAL SIGN SUMMARY SHEET

PLOT DATE: 25-APR-2011
DRAWN BY: T. GUAZZONI
CHECKED BY: A. GAMBLE
SHEET 109 OF 109