STATE OF VERMONT

AGENCY OF TRANSPORTATION

INDEX OF SHEETS
SEE SHEET 2

RECORD PLANS

CONTRACTOR: L&D SAFETY MARKINGS CORP.-BERLIN, VT

RESIDENT ENGINEER: MARK HAUGHWOUT

CONSTRUCTION BEGAN: JUNE 20, 2011

CONSTRUCTION COMPLETE: NOVEMBER 17, 2011

RECORD PLANS BY: MARK HAUGHWOUT & JENNA HYDE

I HEREBY CERTIFY THAT ALL THE CONSTUCTION REQUIRED BY THIS SET OF DRAWINGS HAS BEEN ACCOMPLISHED AS INDICATED HEREIN.

BY Mark W. Haughwout RESIDENT ENGINEER

DATE August 20, 2013

NOTE: Any further information concerning final quantities, amounts or other details relative to this project may be found at Central Files in the electronic archives.

PROPOSED IMPROVEMENT

TOWNS OF BRATTLEBORO, NEWFANE, TOWNSHEND, ROCKINGHAM, CHESTER, SPRINGFIELD AND WEATHERSFIELD
COUNTIES OF WINDHAM AND WINDSOR
VERMONT ROUTES 9, 10, 30, 131 AND US ROUTE 5

SOUTHEAST REGION SIGN REPLACEMENT - 37.589 MILES ON VT 9 BRATTLEBORO MP 0.000-4.190 (EXCLUDING CLASS I), VT 30 NEWFANE MP 0.000-TOWNSHEND MP 7.357, US 5 ROCKINGHAM MP 1.493-8.853, VT 10 CHESTER MP 0.000-SPRINGFIELD MP 0.833 AND VT 131 WEATHERSFIELD MP 0.000-8.647

LENGTH OF ROADWAY = 37.589 MILES
LENGTH OF PROJECT = 37.589 MILES

WORK TO BE PERFORMED UNDER THIS PROJECT INCLUDES THE REMOVAL OF EXISTING SIGNS AND POSTS AND THE INSTALLATION OF NEW SIGNS, SIGN POSTS AND INCIDENTAL ITEMS.

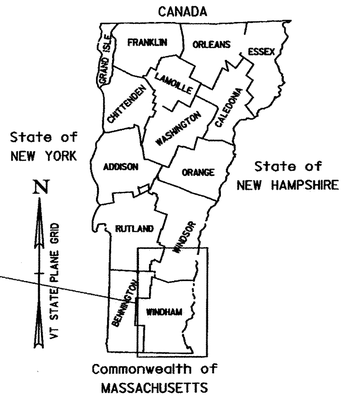

PROJECT LOCATION
STATEWIDE-SOUTHEAST REGION
STPG SIGN (31)

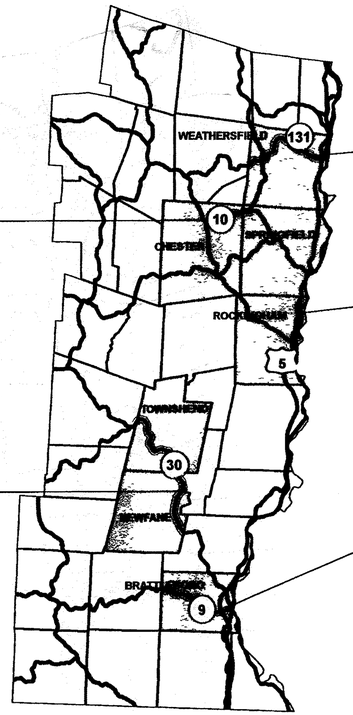

WEATHERSFIELD VT 131
MP 0.000-8.647

CHESTER-SPRINGFIELD VT 10
CHESTER MP 0.000-3.540
SPRINGFIELD MP 0.000-0.833

ROCKINGHAM US 5
MP 1.493-8.853

NEWFANE-TOWNSHEND VT 30
NEWFANE MP 0.000-5.662
TOWNSHEND MP 0.000-7.357

BRATTLEBORO VT 9
MP 0.000-4.190

NOT TO SCALE

QUALITY ASSURANCE PROGRAM: LEVEL

CONVENTIONAL SYMBOLS

COUNTY LINE
TOWN LINE
LIMITS OF ACCESS
POINT OF ACCESS
FENCE LINE
STONE WALL
TRAVELED WAY
GUARD RAIL
RAILROAD
SURVEY LINE
CULVERT
POWER POLE
TELEPHONE POLE
TREES
CONTROL OF ACCESS
PROPERTY LINE
R.O.W. TAKING LINE
SLOPE RIGHTS
TOP OF CUT
TOE OF SLOPE

SURVEYED BY : N/A
SURVEYED DATE : N/A

DATUM
VERTICAL N/A
HORIZONTAL N/A

THESE PLANS ARE SUBJECT TO SUCH ENGINEERING CHANGES AS MAY BE REQUIRED BY THE FEDERAL HIGHWAY ADMINISTRATION OR THE DIRECTOR OF PROGRAM DEVELOPMENT.

CONSTRUCTION IS TO BE CARRIED ON IN ACCORDANCE WITH THESE PLANS AND THE STANDARD SPECIFICATIONS FOR CONSTRUCTION DATED 2006, AS APPROVED BY THE FEDERAL HIGHWAY ADMINISTRATION ON JUNE 15, 2006 FOR USE ON THIS PROJECT, INCLUDING ALL SUBSEQUENT REVISIONS AND SUCH REVISED SPECIFICATIONS AND SPECIAL PROVISIONS AS ARE INCORPORATED IN THESE PLANS.

DIRECTOR OF PROGRAM DEVELOPMENT
APPROVED Richard Tetreault DATE 10-12-10

PROJECT MANAGER : AMY GAMBLE

PROJECT NAME : STATEWIDE - SOUTHEAST REGION
PROJECT NUMBER : STPG SIGN (31)

SHEET 1 OF 175 SHEETS

INDEX OF SHEETS

1	TITLE SHEET
2	GENERAL NOTES
3	QUANTITY SHEET
4-9	SIGN DETAILS
10-19	BRATTLEBORO VT 9 EASTBOUND TRAFFIC SIGN SUMMARY SHEETS
20-28	BRATTLEBORO VT 9 WESTBOUND TRAFFIC SIGN SUMMARY SHEETS
29-37	NEWFANE VT 30 NORTHBOUND TRAFFIC SIGN SUMMARY SHEETS
38-47	NEWFANE VT 30 SOUTHBOUND TRAFFIC SIGN SUMMARY SHEETS
48-60	TOWNSHEND VT 30 NORTHBOUND TRAFFIC SIGN SUMMARY SHEETS
61-71	TOWNSHEND VT 30 SOUTHBOUND TRAFFIC SIGN SUMMARY SHEETS
72-87	ROCKINGHAM US 5 NORTHBOUND TRAFFIC SIGN SUMMARY SHEETS
88-100	ROCKINGHAM US 5 SOUTHBOUND TRAFFIC SIGN SUMMARY SHEETS
101-105	CHESTER VT 10 EASTBOUND TRAFFIC SIGN SUMMARY SHEETS
106-112	CHESTER VT 10 WESTBOUND TRAFFIC SIGN SUMMARY SHEETS
113-118	SPRINGFIELD VT 10 EASTBOUND TRAFFIC SIGN SUMMARY SHEETS
119-121	SPRINGFIELD VT 10 WESTBOUND TRAFFIC SIGN SUMMARY SHEETS
122-150	WEATHERSFIELD VT 131 EASTBOUND TRAFFIC SIGN SUMMARY SHEETS
151-172	WEATHERSFIELD VT 131 WESTBOUND TRAFFIC SIGN SUMMARY SHEETS
173	TOWN TOTAL SIGN SUMMARY SHEET
174-175	TRAFFIC CONTROL SHEETS

STANDARDS

E-121	STANDARD SIGN PLACEMENT CONVENTIONAL ROAD	08/08/1995
E-136B	STATE ROUTE MARKER SIGN DETAILS	08/08/1995
E-138	MILE MARKER DETAILS STATE AND TOWN HIGHWAYS	05/30/2003
E-154	WARNING SIGN DETAILS	05/01/2004
E-164	SQUARE STEEL SIGN POST	06/08/2009

ATTACHMENT TO SHEET #5
S3-1 SYMBOL SIGN
36"X36"

SIGN DESIGN AND FABRICATION:

1. ALL SIGNS SHALL BE DESIGNED IN ACCORDANCE WITH THE LATEST REVISION OF THE 2009 MUTCD AND THE 2004 STANDARD HIGHWAY SIGN AND MARKINGS BOOK (SHS), VAOT STANDARDS OR AS DETAILED ON THE PLANS.

2. ALL LETTERS AND NUMBERS USED FOR ALL SIGNS SHALL CONFORM TO THE APPLICABLE FONT AS DEFINED AND DETAILED IN THE 2004 SHS.

3. ALL ARROWS AND SYMBOLS SHALL CONFORM WITH THE 2004 SHS UNLESS OTHERWISE DETAILED ON THE PLANS.

4. COLORS USED ON ALL SIGNS SHALL CONFORM WITH THE REQUIREMENTS OF SECTION 1A.12 OF THE MUTCD. FY = FLUORESCENT YELLOW, FYG = FLUORESCENT YELLOW GREEN.

5. SIGN SHEETING FOR FLUORESCENT YELLOW AND FLUORESCENT YELLOW GREEN SHALL BE ASTM D4956 TYPE VII, VIII OR IX. ALL OTHER SIGN SHEETING SHALL BE TYPE III OR IV.

6. SHEETING TYPES AND MANUFACTURERS SHALL NOT BE MIXED ON A SINGLE SIGN ASSEMBLY. SHEETING COLOR/TYPE SHOULD BE BY THE SAME MANUFACTURER AND BE CONSISTENT THROUGHOUT THE PROJECT.

7. SIGN BASE MATERIAL FOR DELINEATORS AND MILE MARKER PLAQUES (VD-700) SHALL BE 0.063" THICK FLAT SHEET ALUMINUM. UNLESS OTHERWISE NOTED ON THE PLANS, ALL OTHER SIGNS SHALL BE FLAT SHEET ALUMINUM WITH THE FOLLOWING MINIMUM THICKNESSES:

SIGN SIZE	12" X 12"		
	18" X 18"		
	21" X 15"		
	24"X 8"		
	24" X 10"		48" X 18"
	24" X 12"	36" X 12"	48" X 24"
	24" X 18"	36" X 15"	48" X 30"
	24" X 24"	36" X 18"	48" X 42"
	24" X 30"	36" X 24"	48" X 48"
	30" X 15"	36" X 36"	48" X 60"
	30" X 18"	36" X 42"	72" X 10"
	30" X 30"	36" X 48"	72" X 12"
	30" X 42"	36" X 54"	72" X 20"
THICKNESS	0.080"	0.100"	0.125"

SIGN POSTS:

1. ALL SIGN POSTS SHALL BE INSTALLED IN A NEW ANCHOR. ALL SIGNS INSTALLED IN PAVED OR CONCRETE ISLANDS OR SIDEWALKS SHALL ALSO BE INSTALLED WITH AN 18" SLEEVE. PAYMENT FOR SLEEVE SHALL BE INCIDENTAL TO THE SIGN POST.

2. 1.75" SQUARE STEEL POSTS SHALL BE 14 GAUGE STEEL. 2" AND 2.5" SQUARE STEEL POSTS SHALL BE 12 GAUGE STEEL.

SIGN INSTALLATION:

1. THE CONTRACTOR SHALL BE RESPONSIBLE FOR REPAIRING ANY DAMAGE TO PRIVATE OR PUBLIC PROPERTY CAUSED BY THE CONTRACTOR, AT THEIR EXPENSE.

2. ALL SIGNS WITHIN THE PROJECT LIMITS ARE TO BE REPLACED UNLESS OTHERWISE NOTED OR AS DIRECTED BY THE RESIDENT ENGINEER. SIGN LOCATIONS AS SHOWN ON THE PLANS ARE APPROXIMATE. EXACT LOCATIONS TO BE DETERMINED IN THE FIELD.

3. ALL SIGN PLACEMENT SHALL BE IN CONFORMANCE WITH VAOT STANDARD E-121 STANDARD SIGN PLACEMENT CONVENTIONAL ROADS, UNLESS OTHERWISE NOTED.

4. ALL SIGNS, FRAMES, MOUNTING HARDWARE, POSTS, AND ANCHORS FOR ANY SIGN ASSEMBLY SHALL BE REPLACED AT THE SAME TIME. MIXING OF OLD AND NEW SIGNS ON THE SAME ASSEMBLY WILL NOT BE ALLOWED.

5. NEW SIGNS WITH THEIR GREATER NIGHTTIME REFLECTIVITY CAN OBSCURE OLDER SIGNS MOUNTED ADJACENT TO THEM. TO AVOID CONFUSION OF ROAD USERS, WORK SHALL BE COORDINATED SUCH THAT ALL SIGNS ASSOCIATED WITH A CURVE, INTERSECTION, OR SPEED CHANGES, SHALL BE REPLACED ON THE SAME DAY AND NOT LEFT INCOMPLETE OR WITH A MIXTURE OF OLD AND NEW SIGNS WITHIN A GROUP OF ASSOCIATED SIGNS.

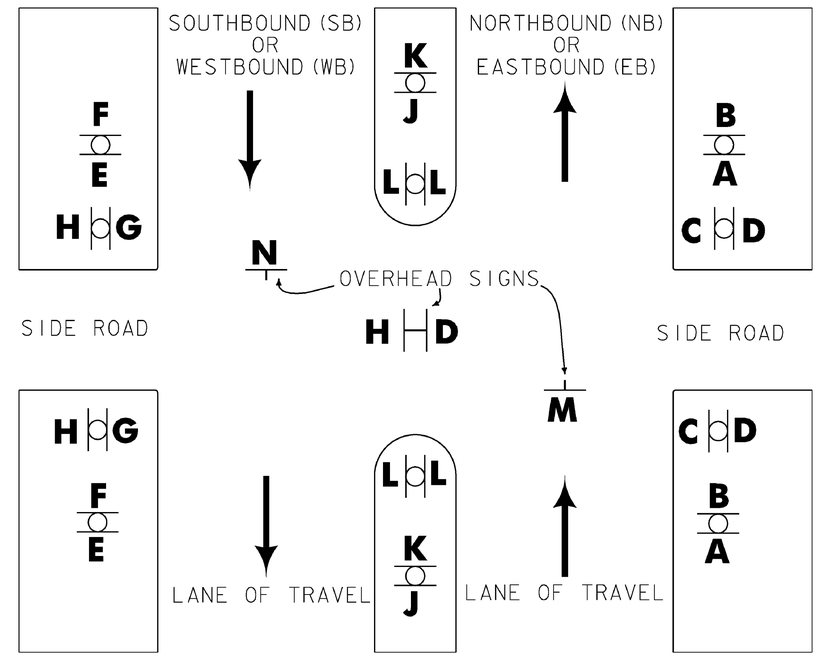

THE TRAFFIC SIGN LOCATION CODES ARE TO BE USED IN CONJUNCTION WITH THE SIGN SUMMARY SHEETS TO ESTABLISH PROPER SIGN INSTALLATION IN THE FIELD.

TRAFFIC SIGN LOCATION CODES

GENERAL NOTES:

1. ALL EXISTING MILE MARKER PLAQUES ATTACHED TO A DELINEATOR POST OR ATTACHED TO A RETAINED STAND ALONE SIGN POST ASSEMBLY SHALL BE RETAINED. IF AN EXISTING MILE MARKER PLAQUE IS ATTACHED TO A SIGN POST THAT IS TO BE REMOVED AND REPLACED IN THE SAME LOCATION, THE MILE MARKER PLAQUE SHALL BE REMOVED, SALVAGED AND INSTALLED ONTO THE NEW SIGN POST. IF AN EXISTING MILE MARKER PLAQUE IS ATTACHED TO A SIGN POST THAT IS TO BE RELOCATED TO A DIFFERENT LOCATION, THE MILE MARKER PLAQUE SHALL BE REMOVED, UNLESS OTHERWISE DIRECTED BY THE ENGINEER. PAYMENT FOR THIS WORK SHALL BE INCIDENTAL TO ITEM 675.341 SQUARE TUBE SIGN POST AND ANCHOR. PAYMENT FOR NEW MILE MARKERS AS SHOWN ON THESE PLANS SHALL BE PAID FOR AS ITEM 675.20 TRAFFIC SIGNS, TYPE A.

2. SALVAGED SIGN TOTALS HAVE BEEN ADDED TO THE TOTAL SIGN REMOVAL COLUMN ON THE TOWN TOTAL SIGN SUMMARY SHEET.

3. EXISTING STREET NAME SIGNS ATTACHED TO SIGN POSTS THAT ARE TO BE REPLACED SHALL BE REMOVED AND INSTALLED ONTO NEW POST. ALL WORK AND MATERIALS NECESSARY TO REMOVE AND INSTALL THE STREET NAME SIGNS SHALL BE PAID UNDER ITEM 675.60 ERECTING SALVAGED SIGNS. AN ESTIMATED QUANTITY HAS BEEN ADDED TO ITEM 675.60 TO PAY FOR THIS WORK.

4. ALL EXISTING STREET NAME OR BUS STOP SIGNS INSTALLED ON STAND ALONE SIGN POSTS SHALL BE RETAINED UNLESS OTHERWISE NOTED.

5. SELECTIVE CUTTING OF TREES OR TREE BRANCHES MAY BE NECESSARY TO PROVIDE FULL VISIBILITY FOR ANY EXISTING (RETAINED) OR NEW SIGN LOCATIONS. THIS WORK WILL BE PERFORMED AT THE DIRECTION OF THE RESIDENT ENGINEER IN ACCORDANCE WITH SUBSECTION 201.05 THINNING AND TRIMMING PART (a); AND SHALL BE INCIDENTALTO ITEM 675.20 TRAFFIC SIGNS, TYPE A. UNLESS OTHERWISE DIRECTED BY THE RESIDENT ENGINEER ALL CUT MATERIAL SHALL BE DISPOSED OF IN COMPLIANCE WITH APPLICABLE LAWS OF THE STATE OF VERMONT.

PROJECT NAME: STATEWIDE - SOUTHEAST REGION

PROJECT NUMBER: STPG SIGN (31)

FILE NAME: 108010.GN
PROJECT LEADER: A. GAMBLE
DESIGNED BY: M. MILLER
GENERAL NOTES

PLOT DATE: 07-OCT-2010
DRAWN BY: M. MILLER
CHECKED BY: A. GAMBLE
SHEET 2 OF 175

STATE OF VERMONT
AGENCY OF TRANSPORTATION

QUANTITY SHEET 1

SUMMARY OF ESTIMATED QUANTITIES	TOTALS		DESCRIPTIONS				DETAILED SUMMARY OF QUANTITIES		
ROADWAY	GRAND TOTAL	FINAL	UNIT	ITEMS	ITEM NUMBER	ROUND	QUANTITIES	UNIT	ITEMS
1	1		CY	TRENCH EXCAVATION OF EARTH, EXPLORATORY (N.A.B.I.)	204.22				
30	30		HR	UNIFORMED TRAFFIC OFFICERS	630.10				
500	500		HR	FLAGGERS	630.15				
1	1		LS	MOBILIZATION/DEMOBILIZATION	635.11				
1	1		LS	TRAFFIC CONTROL	641.10				
4780.9	4780.9		SF	TRAFFIC SIGNS, TYPE A	675.20				
11280	11280		LF	SQUARE TUBE SIGN POST AND ANCHOR	675.341				
1049	1049		EACH	REMOVING SIGNS	675.50				
31	31		EACH	ERECTING SALVAGED SIGNS	675.60				

PROJECT NAME: STATEWIDE - SOUTHEAST REGION

PROJECT NUMBER: STPG SIGN (31)

FILE NAME: 108010.QS
PROJECT LEADER: A. GAMBLE
DESIGNED BY: M. MILLER
QUANTITY SHEET

PLOT DATE: 07-OCT-2010
DRAWN BY: M.MILLER
CHECKED BY: A. GAMBLE
SHEET 3 OF 175

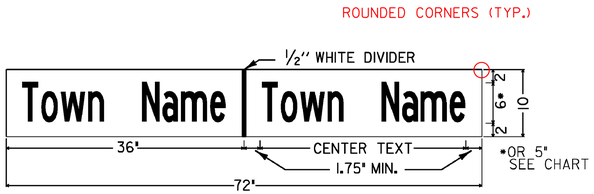

NO BORDER, WHITE ON GREEN

VD-024
VD-025 SIMILIAR

TOWN NAMES

TEXT	FONT	DIMENSION
Brattleboro	B	32.50
Cavendish	C	32.50
Chester	C	28.46
Dummerston	C	32.50
Marlboro	C	32.50
Newfane	C	29.73
Springfield	B	32.50
Townshend	B	31.70
Weathersfield	B (5")	32.50

TOWN/COUNTY LINE SIGN NOTES:

1. WORD TO WORD SPACING FOR COUNTIES AND TWO WORD TOWN NAMES IS ADJUSTABLE TO ACCOMMODATE DIMENSION REQUIREMENT.
2. FONT SPACING MAY BE ADJUSTED TO MEET DIMENSION REQUIREMENT.
3. DIMENSIONS SHOWN ARE APPROXIMATE AND MAY BE ADJUSTED SLIGHTLY TO ACCOMMODATE VARIOUS MANUFACTURER'S LETTER WIDTHS.

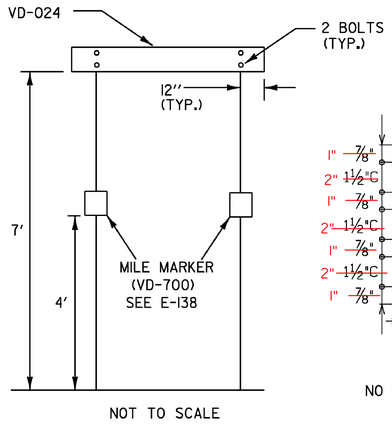

NOT TO SCALE

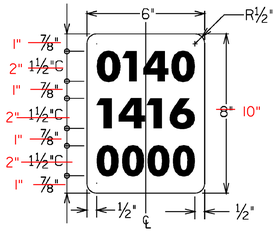

VD-700
NO BORDER, WHITE ON GREEN

WHEN CROSSING COUNTY BOUNDARIES AN ADDITIONAL COUNTY LINE SIGN (VD-025) SHALL BE MOUNTED BELOW THE TOWN LINE SIGN (VD-024) MAINTAINING AN SEVEN FOOT CLEARANCE.

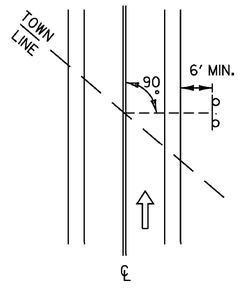

THE SIGN SHALL BE MOUNTED PARALLEL WITH THE ROADWAY, NORMALLY ON RIGHT SIDE TRAVELING WEST TO EAST OR SOUTH TO NORTH.

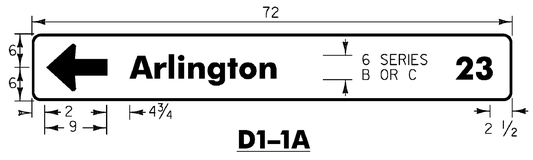

D1-1A

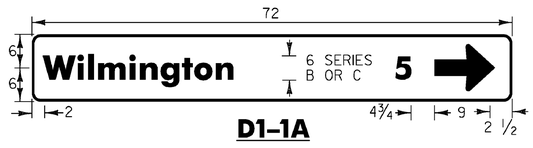

D1-1A

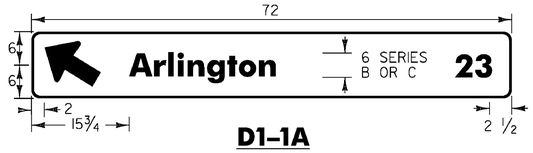

D1-1A

Standard Arrow Custom 9.0" X 6.0" 45°

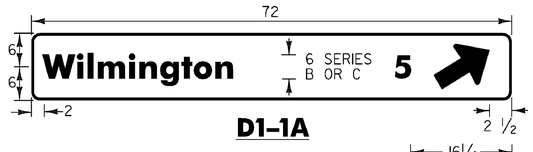

D1-1A

Standard Arrow Custom 9.0" X 6.0" 45°

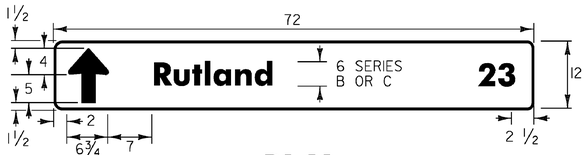

D1-1A

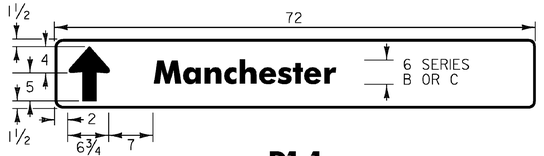

D1-1

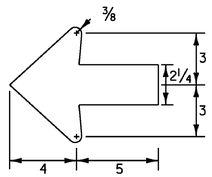

STANDARD ARROW

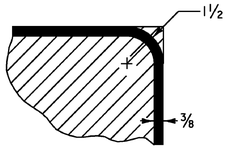

BORDER DETAIL

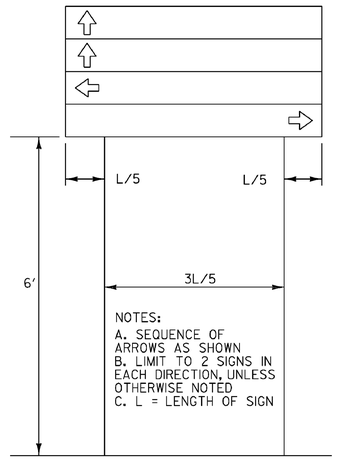

DESTINATION ASSEMBLY

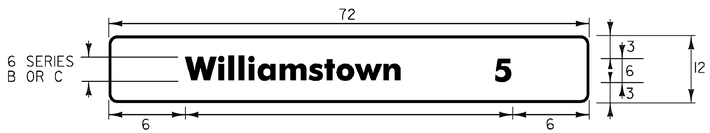

D2-1

STANDARD DESTINATION SIGN NOTES
D1-1, D1-1A, D2-1

THE DESTINATION SIGNS SHOWN ON THIS SHEET SHALL HAVE WHITE RETROREFLECTIVE ASTM TYPE III OR IV TEXT, ARROWS AND BORDERS ON A GREEN RETROREFLECTIVE ASTM TYPE III OR IV BACKGROUND.

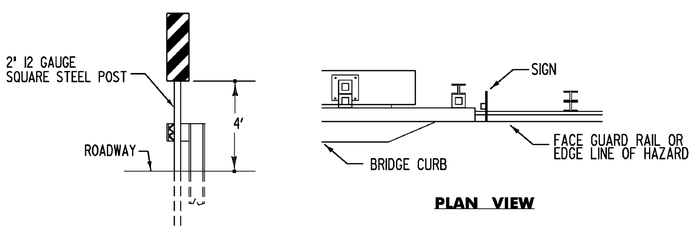

ELEVATION

PLAN VIEW

OBJECT MARKER SHOULD BE INSTALLED SO INSIDE EDGE OF SIGN IS AS CLOSE AS POSSIBLE TO FACE OF GUARD RAIL OR INSIDE EDGE OF HAZARD.

SIGN SHALL BE MOUNTED SO THE DIAGONAL STRIPES SLOPE DOWNWARDS TOWARD ROAD CENTERLINE.

ASSEMBLY HARDWARE SHALL CONFORM TO SECTION 750.12 (a). RIVETS SHALL NOT BE USED.

SIGN BASE MATERIAL SHALL BE 0.100" FLAT SHEET ALUMINUM.

MOUNTING HARDWARE FOR SIGNS ATTACHED TO ABUTMENTS OR HAZARDS SHALL BE APPROVED BY RESIDENT ENGINEER.

PAYMENT FOR ALL MATERIALS AND LABOR NECESSARY TO ATTACH OM-3 SIGN TO ANYTHING OTHER THAN SIGN POST WILL BE PAID FOR AS ONE 2" SQUARE STEEL SIGN POST 15 FEET LONG.

OM-3 INSTALLATION

ALL DIMENSIONS SHOWN IN INCHES EXCEPT WHERE NOTED.

PROJECT NAME:	STATEWIDE - SOUTHEAST REGION
PROJECT NUMBER:	STPG SIGN (31)
FILE NAME: 10B010.SD_1	PLOT DATE: 07-OCT-2010
PROJECT LEADER: A. GAMBLE	DRAWN BY: M. MILLER
DESIGNED BY: M. MILLER	CHECKED BY: A. GAMBLE
SIGN DETAILS 1	SHEET 4 OF 175

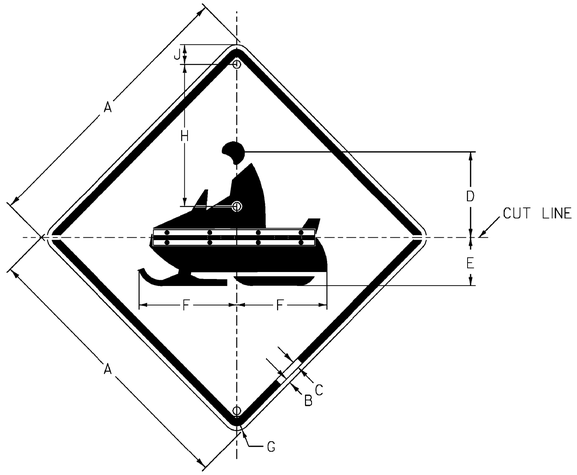

W11-6H

SIGN	DIMENSIONS (INCHES)								
	A	B	C	D	E	F	G	H	J
STD.	30	1/2	3/4	11 7/16	5 9/16	12 11/16	1 7/8	14	2 1/2
SPECIAL	36	5/8	7/8	14 1/8	6 3/4	15 1/4	2 1/4	19	2 1/2

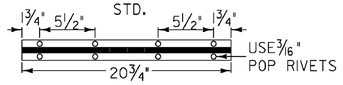

USE STANDARD 2" (BLACK) PIANO HINGE

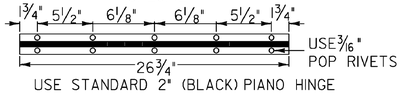

USE STANDARD 2" (BLACK) PIANO HINGE

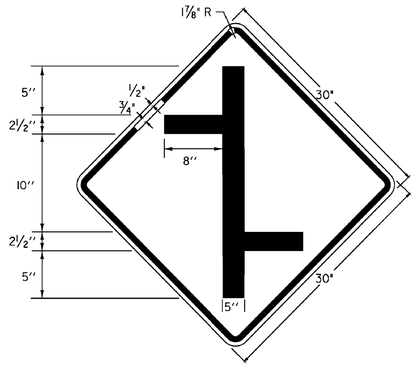

W2-1Md

NOTE: OPTICALLY CENTER

THIS SIGN WAS REPLACED BY 3 SIGNS: W16-18P, R2-1, R2-5P

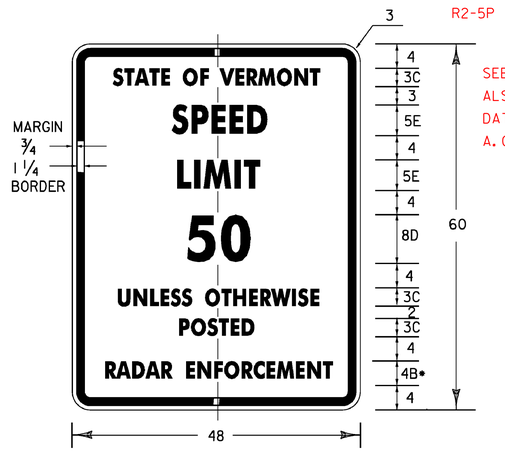

SEE SHEET #172
ALSO REFER TO E-MAIL, DATED 04/04/2011, FROM A. GAMBLE TRAFFIC OPS.

• REDUCE SPACING 25%

VR-114

BLACK TEXT AND BORDER
WHITE RETRORFLECTIVE BACKGROUND

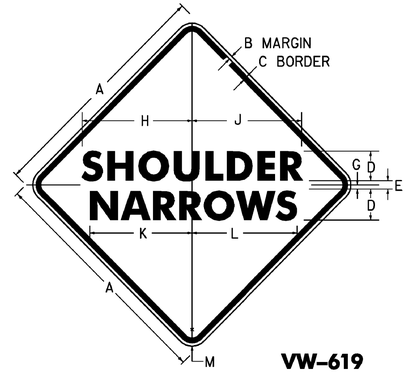

VW-619

SIGN	DIMENSIONS (INCHES)											
	A	B	C	D	E	F	G	H	J	K	L	M
MIN & STD.	36	5/8	7/8	5C	3	6D	I	13 11/16	13 1/16	17 5/8	18 1/4	2 1/4
EXPWY.	48	3/4	1 1/4	7D	3 1/2	7D	I	23 13/16	23 7/8	21 1/2	21 9/16	3

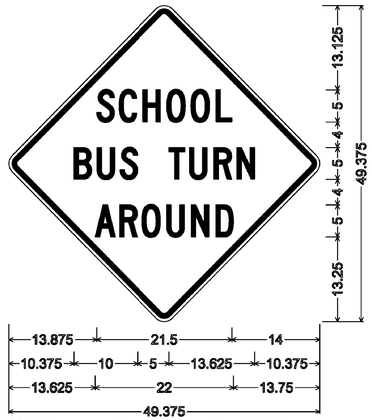

36.000" across sides 1.875" Radius, 0.750" Border, 0.500" Indent, Black on Bright yellow green; "SCHOOL" C; "BUS TURN" C; "AROUND" C

VS3-4

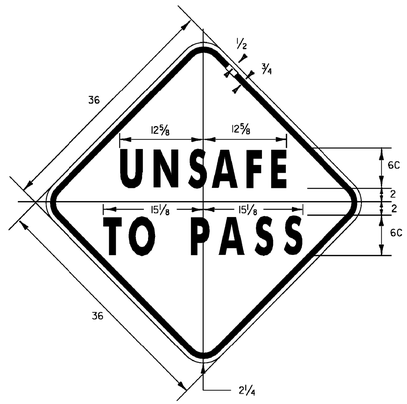

VW-092

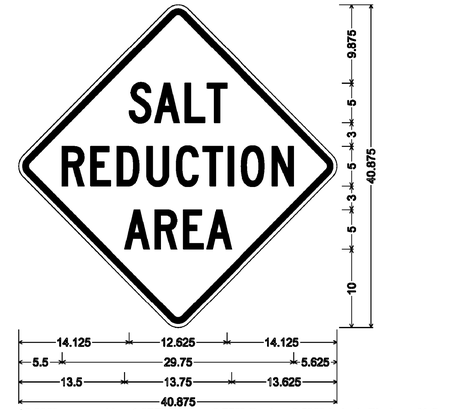

30.000" across sides 1.875" Radius, 0.750" Border, 0.500" Indent, Black on Yellow; "SALT" C 2K; "REDUCTION" C 2K; "AREA" C 2K;

VW-290

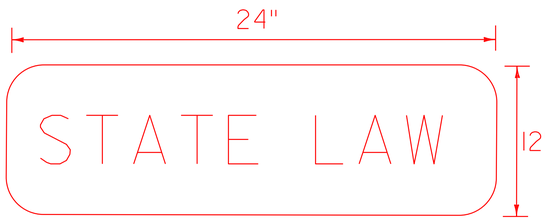

FLUORESCENT YELLOW BACKGROUND W/BLACK LETTERS

W16-18P

ALL DIMENSIONS SHOWN IN INCHES EXCEPT WHERE NOTED.

PROJECT NAME: STATEWIDE - SOUTHEAST REGION

PROJECT NUMBER: STPG SIGN (31)

FILE NAME: 10B010.SD_2
PROJECT LEADER: A. GAMBLE
DESIGNED BY: M. MILLER
SIGN DETAILS 2

PLOT DATE: 07-OCT-2010
DRAWN BY: M. MILLER
CHECKED BY: A. GAMBLE
SHEET 5 OF 175

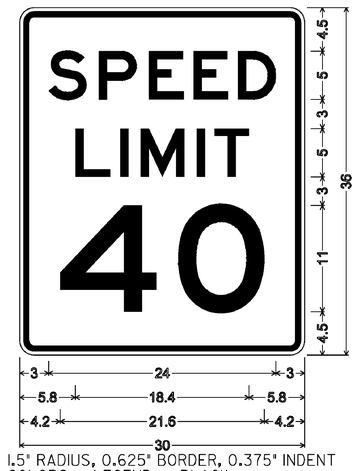

1.5" RADIUS, 0.625" BORDER, 0.375" INDENT
COLORS: LEGEND - BLACK
BACKGROUND - WHITE
TEXT STYLE: "SPEED" E; "LIMIT" E; "40" E

R2-1

* REDUCE SPACING 40%
** REDUCE SPACING 60%
COLORS: LEGEND - BLACK
BACKGROUND - WHITE

VR-023b

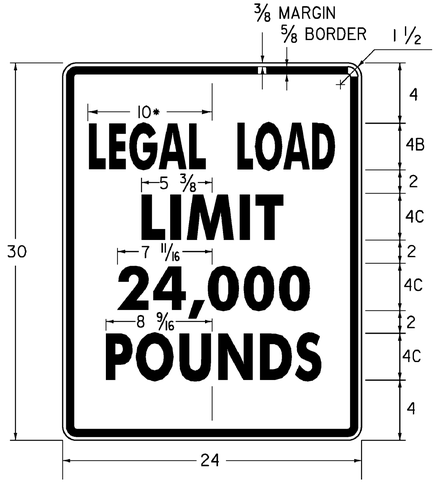

* REDUCE SPACING 50 %
LINE 3 ALTERNATE - **16,000**

VR-017

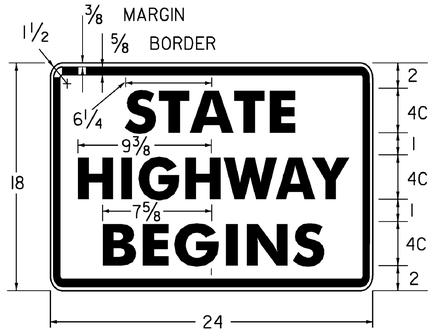

VR-039

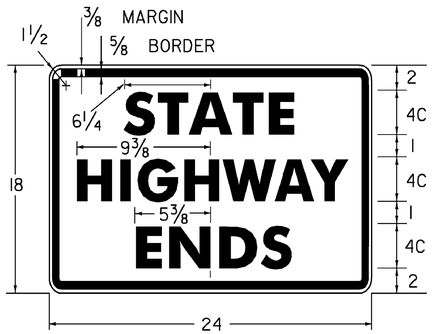

VR-038

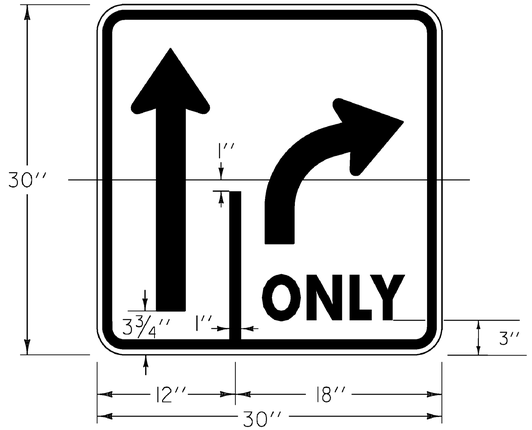

VR-921 (R)

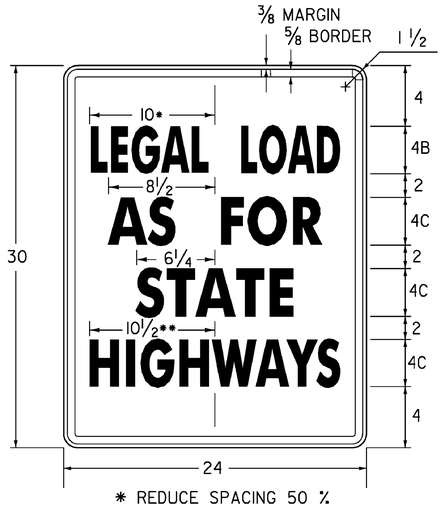

* REDUCE SPACING 50 %
** REDUCE SPACING 38 %

VR-079

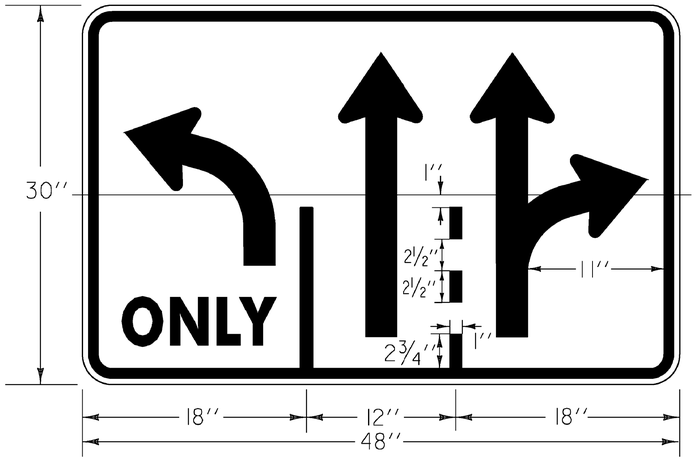

VR-934

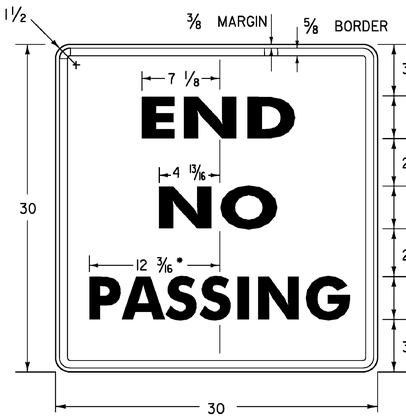

* REDUCE SPACING 50 %

VR-417

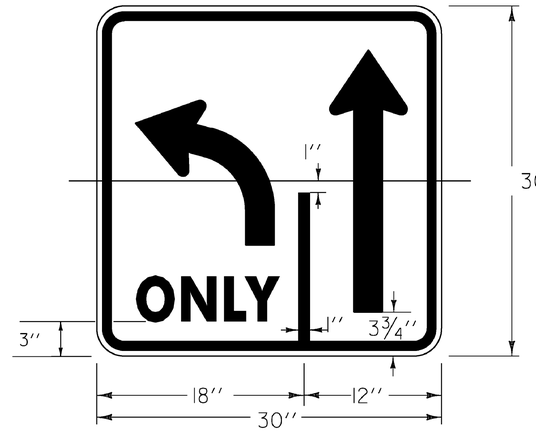

VR-921 (L)

SEE 2004 SHS FOR ADDITIONAL DIMENSIONS
BLACK TEXT AND BORDER
WHITE RETRORFLECTIVE BACKGROUND

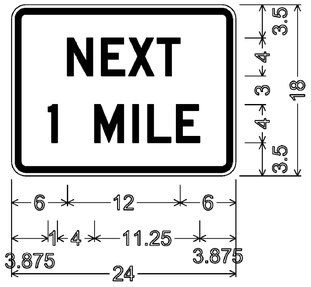

1.500" Radius, 0.625" Border, 0.375" Indent,
Black on White; "NEXT" D; "1 MILE" D

W7-3A

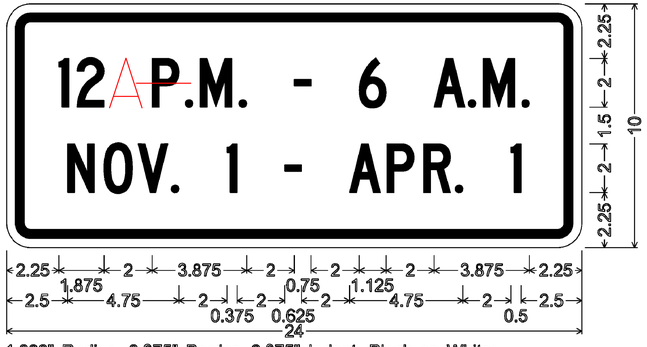

1.000" Radius, 0.375" Border, 0.375" Indent, Black on White;
"12 P.M. - 6 A.M." C; "NOV. 1 - APR. 1" C

VR-071

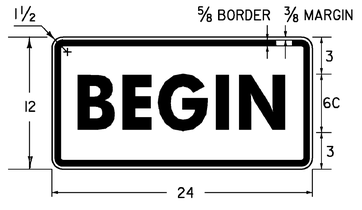

VR-644P

BLACK TEXT AND BORDER
WHITE RETRORFLECTIVE BACKGROUND

ALL DIMENSIONS SHOWN IN INCHES EXCEPT WHERE NOTED.

PROJECT NAME: STATEWIDE - SOUTHEAST REGION	
PROJECT NUMBER: STPG SIGN (31)	
FILE NAME: 10B010.SD_3	PLOT DATE: 07-OCT-2010
PROJECT LEADER: A. GAMBLE	DRAWN BY: M. MILLER
DESIGNED BY: M. MILLER	CHECKED BY: A. GAMBLE
SIGN DETAILS 3	SHEET 6 OF 175

ROUTE MARKER ASSEMBLY FRAMES

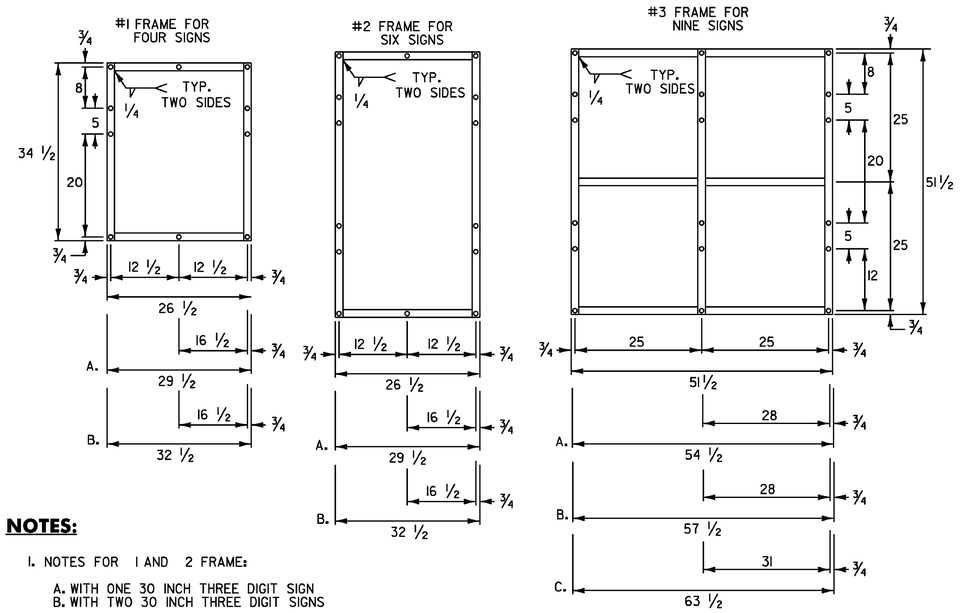

NOTES:

1. NOTES FOR 1 AND 2 FRAME:
   - A. WITH ONE 30 INCH THREE DIGIT SIGN
   - B. WITH TWO 30 INCH THREE DIGIT SIGNS

2. NOTES FOR 3 FRAME:
   - A. WITH ONE 30 INCH THREE DIGIT SIGN IN AN OUTSIDE POSITION.
   - B. WITH ONE 30 INCH THREE DIGIT SIGN IN THE CENTER POSITION OR TWO SUCH SIGNS IN THE OUTSIDE POSITIONS.
   - C. WITH THREE 30 INCH THREE DIGIT SIGNS.

3. ALL HOLES SHALL BE 7/16 INCH DIAMETER. FOR OTHER SIGN COMBINATIONS. THAN ABOVE, THE FRAME DIMENSIONS AND HOLE SPACING SHALL BE MODIFIED AS NECESSARY. THE FRAME SHALL BE PAINTED WITH ONE COAT OF PRIMER AND A SECOND COAT OF BLACK PAINT. THE PAINT SHALL BE OF THE TYPE USED ON EXTERIOR METAL SURFACES TO PREVENT METAL CORROSION.

4. STANDARD FRAMES SHALL BE 5/16 INCH × 1 1/2 INCH WELDED A-36 STEEL.

STANDARD MOUNTING OF ROUTE MARKER ASSEMBLIES

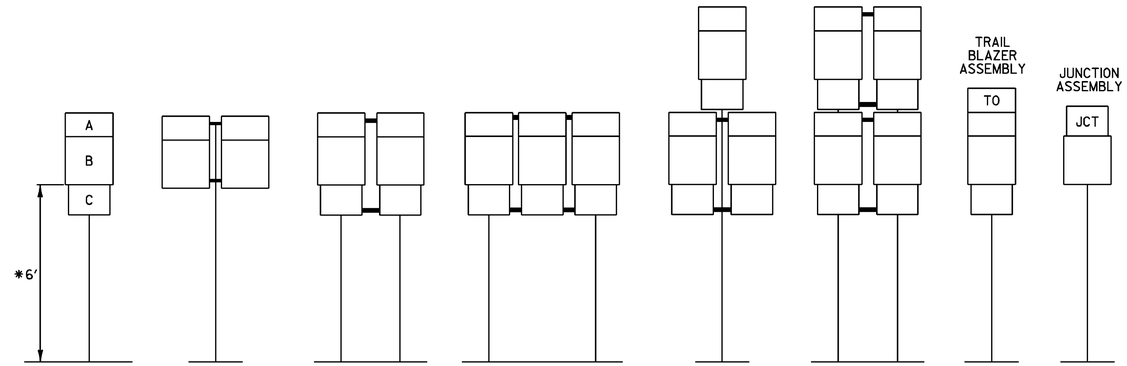

A - CARDINAL DIRECTION MARKER
B - ROUTE NUMBER
C - ADVANCE TURN ARROW OR DIRECTIONAL ARROW

* WHERE PARKING OR PEDESTRIAN TRAFFIC WILL OCCUR IN THE IMMEDIATE VICINITY OF THESE SIGNS MINIMUM VERTICAL CLEARANCE SHALL BE INCREASED TO SEVEN FEET

INSTALLATION SEQUENCE:

IN MULTIPLE HORIZONTAL MOUNTINGS PLACE A ROUTE MARKER ASSEMBLY INDICATING A LEFT TURN ON THE LEFT SIDE OF THE ASSEMBLY; RIGHT TURN ON THE RIGHT SIDE. FOR VERTICALLY STACKED MOUNTINGS PLACE THE STRAIGHT THROUGH MOVE INDICATION ON TOP, THE LEFT OR RIGHT TURNS AS APPROPRIATE BENEATH.

NOTE:
VERTICAL FRAME MEMBERS SHALL LINE UP WITH SIGN POST ON WHICH THEY ARE MOUNTED.

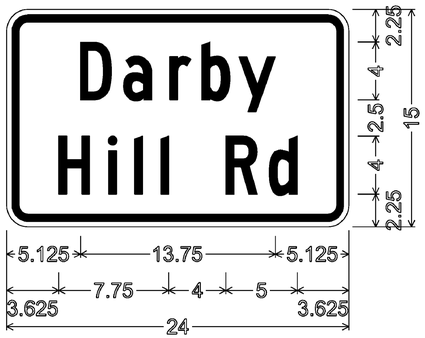

1.500" Radius, 0.500" Border, 0.375" Indent, Black on Yellow; "Darby" C; "Hill Rd" C

W16-8

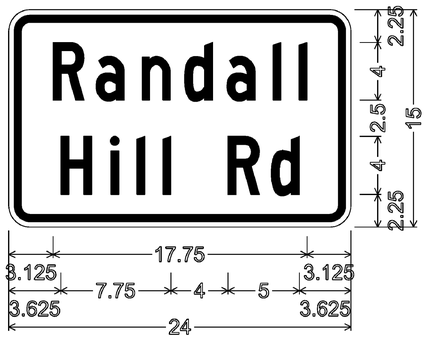

1.500" Radius, 0.500" Border, 0.375" Indent, Black on Yellow; "Randall" C; "Hill Rd" C

W16-8

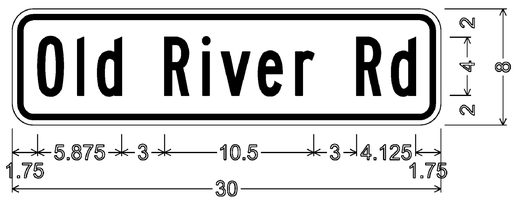

1.500" Radius, 0.375" Border, 0.375" Indent, Black on Yellow; "Old River Rd" B

W16-8

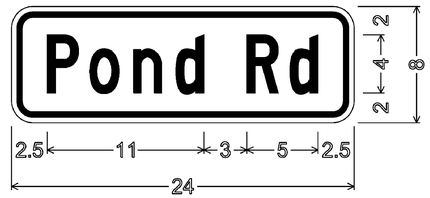

1.500" Radius, 0.375" Border, 0.375" Indent, Black on Yellow; "Pond Rd" C

W16-8

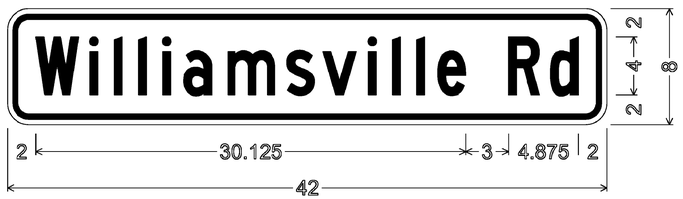

1.500" Radius, 0.375" Border, 0.375" Indent, Black on Yellow; "Williamsville Rd" C

W16-8

ALL DIMENSIONS SHOWN IN INCHES UNLESS OTHERWISE NOTED.

PROJECT NAME: STATEWIDE - SOUTHEAST REGION	
PROJECT NUMBER: STPG SIGN (31)	
FILE NAME: 10B010.SD_4	PLOT DATE: 07-OCT-2010
PROJECT LEADER: A. GAMBLE	DRAWN BY: M. MILLER
DESIGNED BY: M. MILLER	CHECKED BY: A. GAMBLE
SIGN DETAILS 4	SHEET 7 OF 175

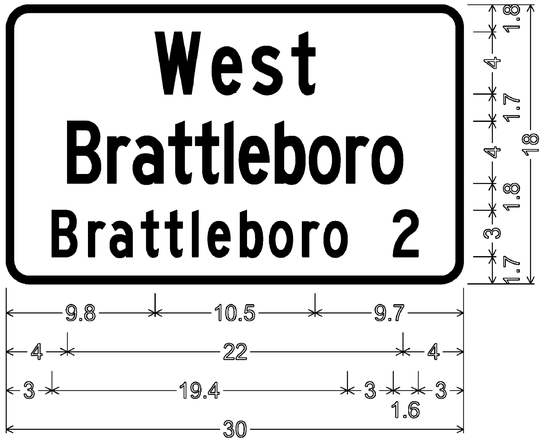

1.5" Radius, 0.5" Border, White on Green;
"West" C; "Brattleboro" C; "Brattleboro 2" C

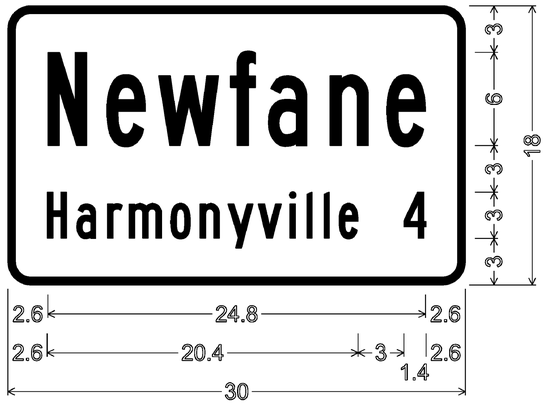

1.5" Radius, 0.5" Border, White on Green;
"Newfane" B 90% spacing;
"Harmonyville 4" B 90% spacing

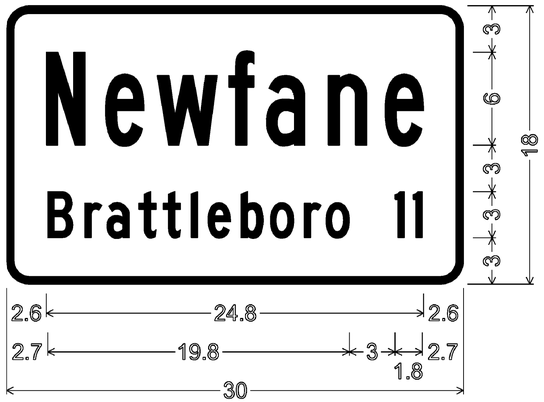

1.5" Radius, 0.5" Border, White on Green;
"Newfane" B 90% spacing;
"Brattleboro 11" C 90% spacing

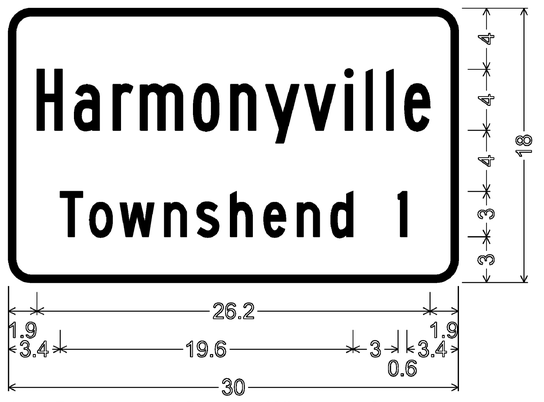

1.5" Radius, 0.5" Border, White on Green;
"Harmonyville" B 80% spacing;
"Townshend 1" C

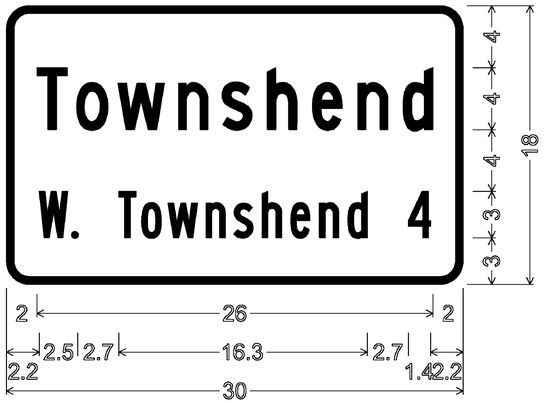

1.5" Radius, 0.5" Border, White on Green;
"Townshend" C specified length;
"W. Townshend 4" B 90% spacing

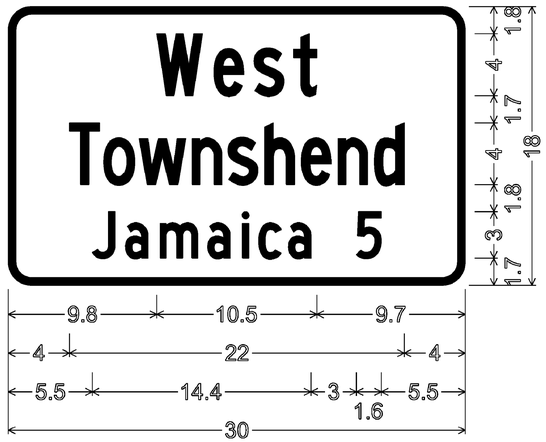

1.5" Radius, 0.5" Border, White on Green;
"West" C specified length;
"Townshend" C specified length;
"Jamaica 5" C specified length

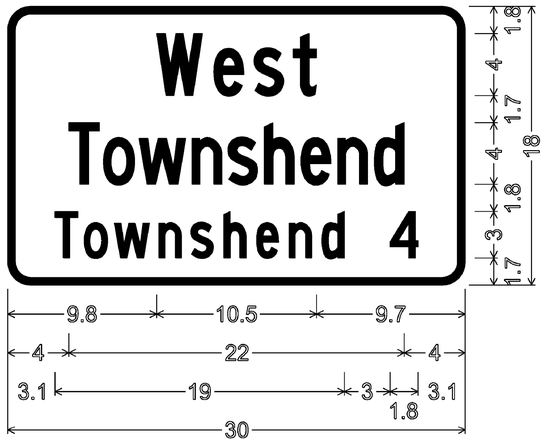

1.5" Radius, 0.5" Border, White on Green;
"West" C specified length;
"Townshend" C specified length;
"Townshend 4" C 90% spacing

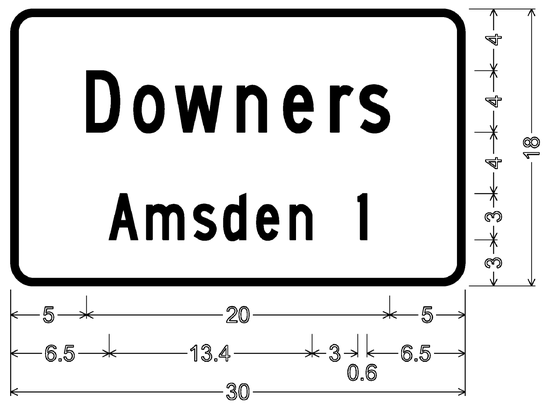

1.5" Radius, 0.5" Border, White on Green;
"Downers" C specified length;
"Amsden 1" C specified length

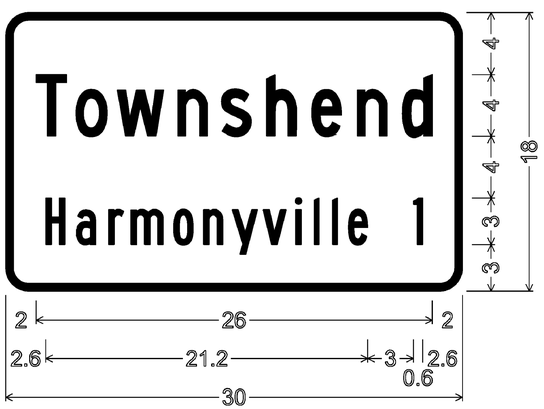

1.5" Radius, 0.5" Border, White on Green;
"Townshend" C specified length;
"Harmonyville 1" B

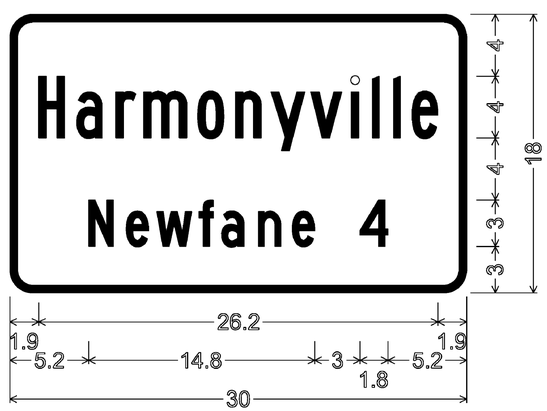

1.5" Radius, 0.5" Border, White on Green;
"Harmonyville" B 80% spacing;
"Newfane 4" C

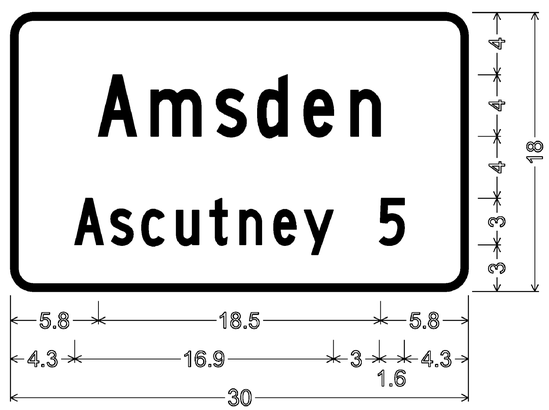

1.5" Radius, 0.5" Border, White on Green;
"Amsden" C specified length;
"Ascutney 5" C specified length

ALL SIGNS ON THIS PAGE, SIGN CODE: VD-018

ALL DIMENSIONS SHOWN IN INCHES EXCEPT WHERE NOTED.

PROJECT NAME: STATEWIDE - SOUTHEAST REGION	
PROJECT NUMBER: STPG SIGN (31)	
FILE NAME: 10B010.SD_5	PLOT DATE: 07-OCT-2010
PROJECT LEADER: A. GAMBLE	DRAWN BY: M. MILLER
DESIGNED BY: M. MILLER	CHECKED BY: A. GAMBLE
SIGN DETAILS 5	SHEET 8 OF 175

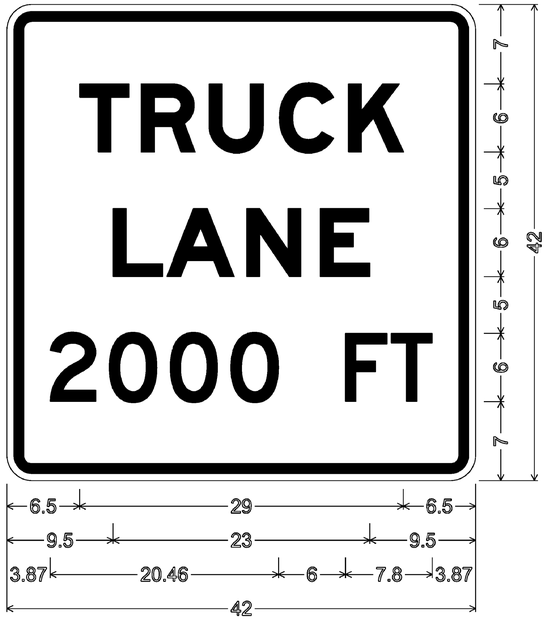

2.250" Radius, 0.875" Border, 0.625" Indent,
White on Green; "TRUCK" E Mod specified length;
"LANE" E Mod specified length; "2000 FT" D

D17–2

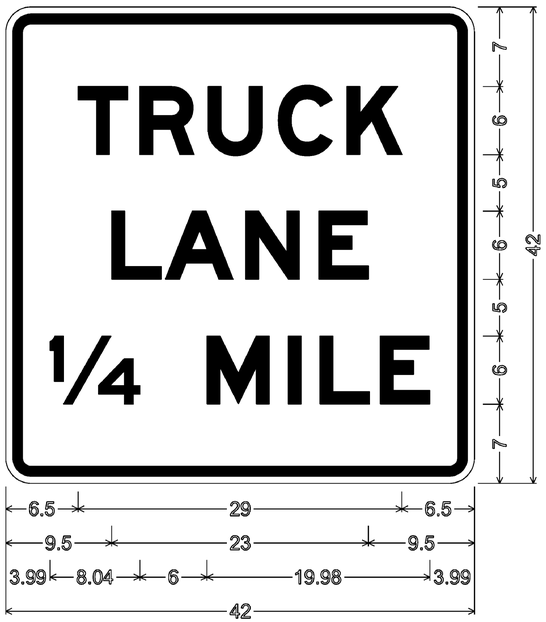

2.250" Radius, 0.875" Border, 0.625" Indent,
White on Green; "TRUCK" E Mod specified length;
"LANE" E Mod specified length; "¼ MILE" E Mod

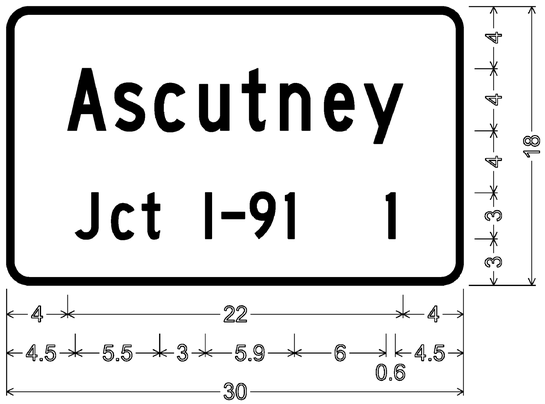

1.5" Radius, 0.5" Border, White on Green;
"Ascutney" C specified length;
"Jct I-91 1" C specified length

VD–018

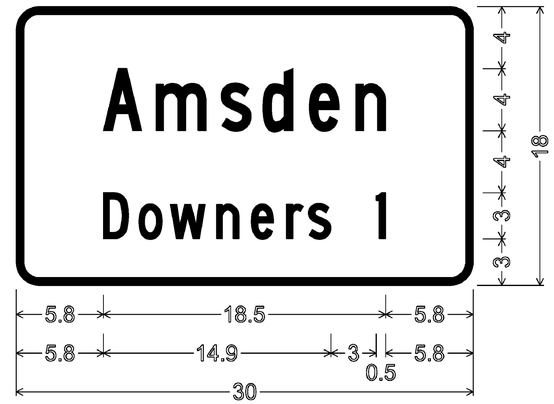

1.5" Radius, 0.5" Border, White on Green;
"Amsden" C specified length;
"Downers 1" C specified length

VD–018

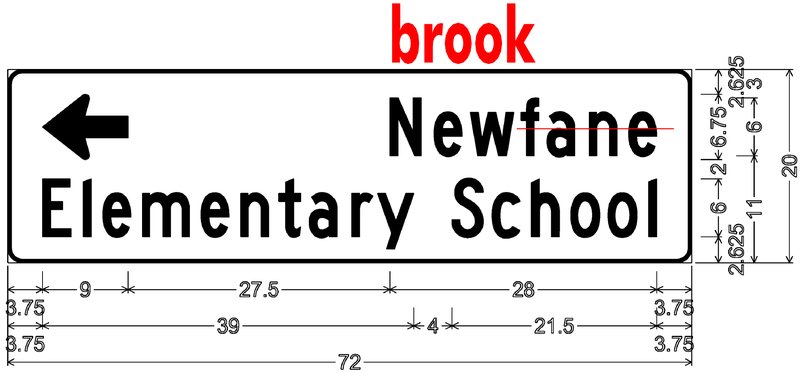

1.500" Radius, 0.375" Border, White on Green;
Standard Arrow Custom 9.000" X 6.750" 180°;
"Newfane" C 80% spacing; "Elementary School" C 80% spacing

D1–2

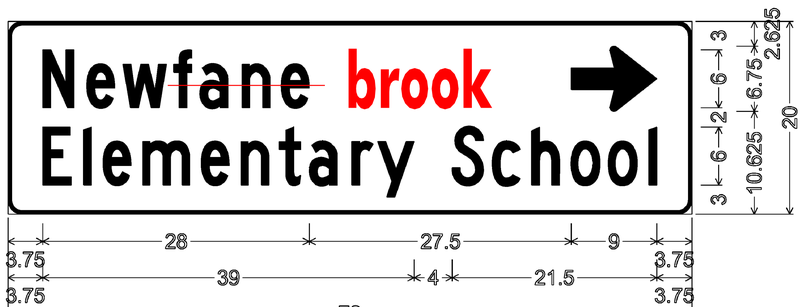

1.500" Radius, 0.375" Border, White on Green;
"Newfane" C 80% spacing; Standard Arrow Custom 9.000" X 6.750" 0°;
"Elementary School" C 80% spacing

D1–2

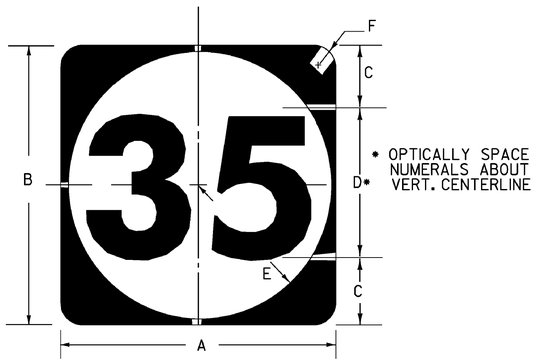

1 OR 2 DIGIT
STATE ROUTE MARKERS

SIGN	DIMENSIONS (INCHES)						
	A	B	C	D	E	F	G
1,2-digits	24	24	6	12D	11	1½	-
1,2-digits	36	36	9	18D	16½	2¼	-
3,-digits	30	24	6	12D	11	1½	3
3,-digits	45	36	9	18D	16½	2¼	4½

STATE NUMBERED TOWN HIGHWAY ROUTE MARKERS
SHALL HAVE BLACK TEXT AND BORDER ON
REFLECTORIZED WHITE BACKGROUNDS.

M1–6

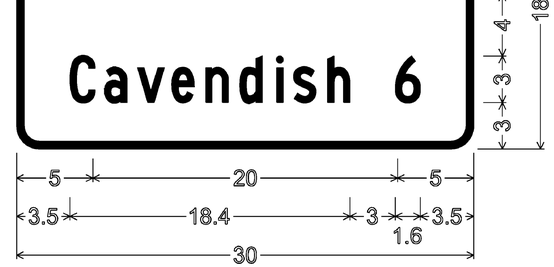

1.5" Radius, 0.5" Border, White on Green;
"Downers" C specified length;
"Cavendish 6" C specified length

VD–018

ALL DIMENSIONS SHOWN IN INCHES EXCEPT WHERE NOTED.

PROJECT NAME:	STATEWIDE - SOUTHEAST REGION
PROJECT NUMBER:	STPG SIGN (31)
FILE NAME: 10B010.SD_6	PLOT DATE: 07-OCT-2010
PROJECT LEADER: A. GAMBLE	DRAWN BY: M. MILLER
DESIGNED BY: M. MILLER	CHECKED BY: A. GAMBLE
SIGN DETAILS 6	SHEET 9 OF 175

DIRECTION	MILEPOINT	LOCATION CODE (SHEET 2)	SIGN CODE	WIDTH (IN)	HEIGHT (IN)	SHEETING REMARKS	SIGN LEGEND	NEW SIGNS "A"	NEW SIGNS "B"	EXISTING SIGNS RETAIN	EXISTING SIGNS SALVAGE FROM	EXISTING SIGNS SALVAGE TO	EXISTING SIGNS REMOVE	EXIST POST RETAIN	EXIST POST REMOVE	NUMBER OF NEW POSTS	SQUARE STEEL (IN) 1.75 (LB / FT) 1.88	SQUARE STEEL (IN) 2.00 (LB / FT) 2.42	SQUARE STEEL (IN) 2.50 (LB / FT) 3.35	TUBULAR STEEL Ø (IN) FOUNDATION	TUBULAR STEEL Ø (IN) 3.00 (LB / FT) 7.60	TUBULAR STEEL Ø (IN) 3.50 (LB / FT) 9.00	TUBULAR STEEL Ø (IN) 4.00 (LB / FT) 10.80	TUBULAR STEEL Ø (IN) 5.00 (LB / FT) 14.60	SIGN FRAME REQUIRED	REMARKS	SIGN DETAIL: DETAIL IN SHS	SIGN DETAIL: DETAIL ON SHEET NUMBER	SIGN DETAIL: DETAIL ON STD SHEET NUMBER
BRATTLEBORO EB							FY-FLUORESCENT YELLOW FYG-FLUORESCENT YELLOW GREEN ✳ SEE NOTES																			"SHS"-STANDARD HIGHWAY SIGNS			
EB	0.000	C	VD-024	60	7.5								1		X													
		C	VD-700	6	8								1															
		C	VD-700	6	8								1															
		C	VD-024	72	10		Brattleboro | Marlboro *	5.00								2		12.75 12.75 X								INSTALL THE NEW SIGN IN THE SAME POSITION AS THE REMOVAL		4	
		C	VD-700	6	10		0090 1302 0000 * 0090 1311 0830 *	0.42																		BRATTLEBORO MILE MARKER; INSTALL ON THE LEFT POST		4	
		C	VD-700	6	10			0.42																		MARLBORO MILE MARKER; INSTALL ON THE RIGHT POST		4	
EB	0.015	C	VR-023B	24	30		$500 FINE FOR THROWING TRASH ON HIGHWAYS AND STREAMS *						1		X													
		C	VR-023B	24	30			5.00								1		13.25 X			SEE ABOVE						INSTALL PARALLEL TO VT-9 AT THE EDGE AND MIDPOINT ± OF THE PAVED PULLOUT		6	
EB	0.038	A	W1-5R	36	36		NEXT 4 MILES	9.00								2		14.25 14.25 X									INSTALL BEHIND RAIL 200 FT ± WEST OF THE TOWN LINE SIGN	X		
		A	W7-3A	24	18			3.00																			INSTALL PLAQUE ON LEFT SIDE POST	X		
EB	0.175	A	W1-1L	30	30		LEFT TURN SYMBOL						1		X												TO BE REPLACED 75 FT ± AHEAD			
		A	W13-1	18	18		30-MPH PLAQUE						1																	
EB	0.190	A	W1-1L	30	30			6.25			1	1	1			1		15.0 X			ON 8/28/11 THE "30 MPH" SIGN WAS DESTROYED AS WAS THE POST. BOTH ITEMS WERE REPLACED ON THE THIS PROJECT.						INSTALL BEHIND RAIL 75 FT ± EAST OF PREVIOUS POSITION	X		
		A	W13-1	24	24		30 MPH *	4.00✳										*15.0										X		
EB	0.230	A	W1-6	48	24								1		X						CURVE SIGN WAS REMOVED AND SLVAGED ON THE NEW POST								6	
							SHEET TOTALS	~~37.09~~ 33.09 SF	0.00 SF	0 EA	~~1~~ 0 EA	~~1~~ 0 EA	~~8~~ 7 EA	0 EA	0 EA	6 EA		~~97.5~~ 90 FT											
							TOWN DIRECTIONAL TOTALS	305.3	0.0	4.0	1.0	1.0	66	0.0	0.0	53		795.0											

SIGN SUMMARY SHEET

VERMONT AGENCY OF TRANSPORTATION

PROJECT NAME: STATEWIDE SOUTHEAST REGION
PROJECT NUMBER: STPG SIGN (31)

FILE NAME: BRATTLEBORO EASTBOUND
PROJECT MANAGER: A. GAMBLE
DESIGNED BY: M. MILLER
BRATTLEBORO VT-9 EASTBOUND 1

PLOT DATE: 8/11/2010
DRAWN BY: M. MILLER
CHECKED BY: A. GAMBLE
SHEET 10 OF 175

DIRECTION	MILEPOINT	LOCATION CODE (SHEET 2)	SIGN CODE	WIDTH (IN)	HEIGHT (IN)	SHEETING REMARKS	SIGN LEGEND	NEW SIGNS "A"	NEW SIGNS "B"	EXISTING SIGNS RETAIN	EXISTING SIGNS SALVAGE FROM	EXISTING SIGNS SALVAGE TO	EXISTING SIGNS REMOVE	EXIST POST RETAIN	EXIST POST REMOVE	NUMBER OF NEW POSTS	SQUARE STEEL (IN) 1.75 (LB / FT) 1.88	SQUARE STEEL (IN) 2.00 (LB / FT) 2.42	SQUARE STEEL (IN) 2.50 (LB / FT) 3.35	TUBULAR STEEL Ø (IN) FOUNDATION	TUBULAR STEEL Ø (IN) 3.00 (LB / FT) 7.60	TUBULAR STEEL Ø (IN) 3.50 (LB / FT) 9.00	TUBULAR STEEL Ø (IN) 4.00 (LB / FT) 10.80	TUBULAR STEEL Ø (IN) 5.00 (LB / FT) 14.60	SIGN FRAME REQUIRED	REMARKS	SIGN DETAIL: DETAIL IN SHS	SIGN DETAIL: DETAIL ON SHEET NUMBER	SIGN DETAIL: DETAIL ON STD SHEET NUMBER
BRATTLEBORO EB							FY-FLUORESCENT YELLOW FYG-FLUORESCENT YELLOW GREEN ✳ SEE NOTES																				"SHS"-STANDARD HIGHWAY SIGNS			
EB	0.230	A	W1-6	48	24			8.00								2		13.0' 13.5' X								INSTALL IN THE SAME POSITION AS THE REMOVAL	X		
EB	0.244	B	W1-6	48	24			8.00								2		11.5' 12.25' X								FACES WB TRAFFIC; INSTALL BEHIND RAIL 75 FT ± EAST OF THE EB-FACING ARROW	X		
EB	0.308	A	W11-2	30	30		PEDESTRIAN (SYMBOL)	6.25					1		X													
		A	W16-4	24	18		NEXT 1000 FT (PLAQUE)	5.00					1													ON 08/28/11 THIS ENTIRE ASSEMBLY WAS DESTROYED BY TROPICAL STORM IRENE. IT WAS REPLACED ON THIS PROJECT.			
		A	W11-2	30	30	FYG	*	6.25								1		*17.0' X								INSTALL IN SAME POSITION AS REMOVAL	X		
		A	W16-4	30	24	FYG	NEXT 600 FT *	5.00										14.75'								BOTH SIGNS HAVE FLUORESCENT YELLOW-GREEN BACKGROUND SHEETING	X		
EB	0.338	B	W1-6	48	24		LARGE ARROW RIGHT ===>						1		X													
EB	0.419	A	W1-2R	30	30		RIGHT CURVE						1		X												TO BE REPLACED FURTHER AHEAD			
		A	W13-1	18	18		40-MPH (PLAQUE)						1															
EB	0.468	A	VS3-4	30	30		SCHOOL BUS TURN AROUND						1		X												TO BE REPLACED FURTHER AHEAD			
		A	W1-2R	30	30			6.25								1		15.75' X									X		
		A	W13-1	18	18		40 MPH	2.25																				X		
EB	0.600	A	W1-2L	30	30		LEFT CURVE SYMBOL						1		X												*SEE ABOVE			
		A	W13-1	18	18		40-MPH PLAQUE						1					13.0' 13.25'											
		A	VS3-4	36	36	FYG	SCHOOL BUS TURN AROUND *	9.00								2		*14.25' *15.0' X								FLUORESCENT YELLOW-GREEN BACKGROUND SHEETING			6
							SHEET TOTALS	~~65.00~~ 44.75 SF	0.00 SF	0 EA	0 EA	0 EA	8 EA	0 EA	0 EA	8 EA	~~153.25~~ 120 FT									
							TOWN DIRECTIONAL TOTALS	305.3	0.0	4.0	1.0	1.0	66	0.0	0.0	53	795.0									

NOTES SHOULD BE SWITCHED

SIGN SUMMARY SHEET

VERMONT AGENCY OF TRANSPORTATION

PROJECT NAME: **STATEWIDE SOUTHEAST REGION**
PROJECT NUMBER: **STPG SIGN (31)**

FILE NAME: **BRATTLEBORO EASTBOUND** PLOT DATE: **8/11/2010**
PROJECT MANAGER: **A. GAMBLE** DRAWN BY: **M. MILLER**
DESIGNED BY: **M. MILLER** CHECKED BY: **A. GAMBLE**
BRATTLEBORO VT-9 EASTBOUND 2 SHEET **11** OF **175**

DIRECTION	MILEPOINT	LOCATION CODE (SHEET 2)	SIGN CODE	WIDTH (IN)	HEIGHT (IN)	SHEETING REMARKS	SIGN LEGEND	NEW SIGNS "A"	NEW SIGNS "B"	EXISTING SIGNS RETAIN	EXISTING SIGNS SALVAGE FROM	EXISTING SIGNS SALVAGE TO	EXISTING SIGNS REMOVE	EXIST POST RETAIN	EXIST POST REMOVE	NUMBER OF NEW POSTS	SQUARE STEEL (IN) 1.75 (LB / FT) 1.88	SQUARE STEEL (IN) 2.00 (LB / FT) 2.42	SQUARE STEEL (IN) 2.50 (LB / FT) 3.35	TUBULAR STEEL Ø (IN) FOUNDATION	TUBULAR STEEL Ø (IN) 3.00 (LB / FT) 7.60	TUBULAR STEEL Ø (IN) 3.50 (LB / FT) 9.00	TUBULAR STEEL Ø (IN) 4.00 (LB / FT) 10.80	TUBULAR STEEL Ø (IN) 5.00 (LB / FT) 14.60	SIGN FRAME REQUIRED	REMARKS	SIGN DETAIL: DETAIL IN SHS	SIGN DETAIL: DETAIL ON SHEET NUMBER	SIGN DETAIL: DETAIL ON STD SHEET NUMBER
BRATTLEBORO EB							FY-FLUORESCENT YELLOW FYG-FLUORESCENT YELLOW GREEN																			"SHS"-STANDARD HIGHWAY SIGNS			
EB	0.667	C	VR-023B	24	36		$500 FINE FOR THROWING TRASH ON HIGHWAYS AND STREAMS EXISTING SIGN IS MISSING																			EXISTING SIGN IS MISSING			
		C	VR-023B	24	30			5.00								1		13.5' X								INSTALL PARALLEL TO VT-9 AT THE EDGE AND MIDPOINT ± OF THE PAVED PULLOUT		6	
EB	0.807	A	W1-2R	30	30		RIGHT CURVE						1		X														
EB	0.954	A	M3-2	24	12		EAST						1		X														
		A	M1-5	24	24		VT 9						1																
EB	0.986	A	R2-1	24	30		SPEED LIMIT 50						1		X														
EB	1.195	A	VW-285	30	30		FALLING ROCK (SYMBOL)			1				X													RETAIN			
EB	1.408	C	VR-017	24	30		LEGAL LOAD LIMIT 24,000 POUNDS STARK ROAD				1	1	1		X												STARK RD (TH-48)			
		C	VR-017	24	30			5.00								1		13.0' X										6	
EB	1.416	D	R1-1	30	30		STOP						1		X														
		D	R1-1	30	30			6.25								1		12.25' X										X	
EB	1.450	A	M3-2	24	12								1		X														
		A	M1-5	24	24								1																
		A	M3-2	24	12		EAST VERMONT 9	2.00								1		13.5' X								GREEN ON WHITE	X		
		A	M1-5	24	24			4.00																				6	E-136B
SIGN SUMMARY SHEET							SHEET TOTALS	22.25	0.00	1	~~1~~ 0	~~1~~ 0	8	0	0	4			52.25 60									
								SF	SF	EA	EA	EA	EA	EA	EA	EA			FT									
VERMONT AGENCY OF TRANSPORTATION							TOWN DIRECTIONAL TOTALS	305.3	0.0	4.0	1.0	1.0	66	0.0	0.0	53			795.0									

PROJECT NAME: **STATEWIDE SOUTHEAST REGION**
PROJECT NUMBER: **STPG SIGN (31)**

FILE NAME: **BRATTLEBORO EASTBOUND** PLOT DATE: **8/11/2010**
PROJECT MANAGER: **A. GAMBLE** DRAWN BY: **M. MILLER**
DESIGNED BY: **M. MILLER** CHECKED BY: **A. GAMBLE**
BRATTLEBORO VT-9 EASTBOUND 3 SHEET **12** OF **175**

DIRECTION	MILEPOINT	LOCATION CODE (SHEET 2)	SIGN CODE	WIDTH (IN)	HEIGHT (IN)	SHEETING REMARKS	SIGN LEGEND	NEW SIGNS "A"	NEW SIGNS "B"	EXISTING SIGNS RETAIN	EXISTING SIGNS SALVAGE FROM	EXISTING SIGNS SALVAGE TO	EXISTING SIGNS REMOVE	EXIST POST RETAIN	EXIST POST REMOVE	NUMBER OF NEW POSTS	SQUARE STEEL (IN) 1.75 (LB / FT) 1.88	SQUARE STEEL (IN) 2.00 (LB / FT) 2.42	SQUARE STEEL (IN) 2.50 (LB / FT) 3.35	TUBULAR STEEL Ø (IN) FOUNDATION	TUBULAR STEEL Ø (IN) 3.00 (LB / FT) 7.60	TUBULAR STEEL Ø (IN) 3.50 (LB / FT) 9.00	TUBULAR STEEL Ø (IN) 4.00 (LB / FT) 10.80	TUBULAR STEEL Ø (IN) 5.00 (LB / FT) 14.60	SIGN FRAME REQUIRED	REMARKS	SIGN DETAIL: DETAIL IN SHS	SIGN DETAIL: DETAIL ON SHEET NUMBER	SIGN DETAIL: DETAIL ON STD SHEET NUMBER
BRATTLEBORO EB							FY-FLUORESCENT YELLOW * SEE NOTES FYG-FLUORESCENT YELLOW GREEN																			"SHS"-STANDARD HIGHWAY SIGNS			
EB	1.488	A	R2-1	24	30		SPEED LIMIT 50						1		X											WILL NOT BE REPLACED			
EB	1.610	A	VW-619	36	36		SHOULDER NARROWS *	9.00					1		X		13.0' 13.25' X			SEE NOTE FOR EB MM.								
		A	VW-619	36	36			9.00								2	*13.25' *14.25' X			0.308 DN SHEET#11 DUE TO T.S.							5	
EB	1.990	A	VW-202	30	30		TRUCKS ENTERING *						1		X		15.25' X			TRENE, THE POST *WAS DESTROYED AND WAS REPLACED ON THIS PROJECT								
		A	VW-202	30	30			6.25			1	1	1			1	16.75'* X			THESE TWO SIGNS AND AND POST WERE								E-154
EB	2.126	C	VR-017	24	30						1	1	1		X					SALVAGED AND RE-INSTALLED AT THE NEW BRIDGE LOCATION 50' SOUTH SEE NOTE ABOVE.							COOKE RD (TH-50)		
		D	R1-1	30	30		LEGAL LOAD LIMIT 16,000 POUNDS * COOKE ROAD						1													EXISTING STOP SIGN IS ON BACK OF THE LEGAL LOAD LIMIT SIGN; TO BE SEPERATED			
		C	VR-017	24	30			5.00			2	2	2			1	12.25' X											6	
EB	2.132	D	R1-1	30	30		STOP *	6.25			1	1	1			1	13.0' X										INSTALL NEW IN THE STANDARD STOP SIGN POSITION	X		
EB	2.160	A	M3-2	24	12		EAST						1		X														
		A	M1-5	24	24		VT 9						1																
EB	2.250	A	R2-5A	24	30		REDUCED SPEED AHEAD						1		X														
EB	2.283	A	W3-5	36	36		SPEED LIMIT 40	9.00								2	14.75' 15.25' X										INSTALL 175 FT ± ~~NORTH~~ WEST OF THE REMOVED "REDUCED SPEED AHEAD" SIGN	X		
EB	2.400	A	R2-1	24	30		SPEED LIMIT 40						1		X														
		A	R2-1	30	36			7.50								1	13.5' X										NOTE THAT THIS IS A LARGER SIZED SIGN		6	
							SHEET TOTALS	~~43.00~~ 52.00 SF	0.00 SF	0 EA	~~5~~ 0 EA	~~5~~ 0 EA	~~13~~ 9 EA	0 EA	0 EA	8 EA	~~155.0~~ 120 FT									
							TOWN DIRECTIONAL TOTALS	305.3	0.0	4.0	1.0	1.0	66	0.0	0.0	53	795.0									

SIGN SUMMARY SHEET

VERMONT AGENCY OF TRANSPORTATION

PROJECT NAME: **STATEWIDE SOUTHEAST REGION**
PROJECT NUMBER: **STPG SIGN (31)**

FILE NAME: **BRATTLEBORO EASTBOUND** PLOT DATE: **8/11/2010**
PROJECT MANAGER: **A. GAMBLE** DRAWN BY: **M. MILLER**
DESIGNED BY: **M. MILLER** CHECKED BY: **A. GAMBLE**
BRATTLEBORO VT-9 EASTBOUND 4 SHEET **13** OF **175**

DIRECTION	MILEPOINT	LOCATION CODE (SHEET 2)	SIGN CODE	WIDTH (IN)	HEIGHT (IN)	SHEETING REMARKS	SIGN LEGEND	NEW SIGNS "A"	NEW SIGNS "B"	EXISTING SIGNS RETAIN	EXISTING SIGNS SALVAGE FROM	EXISTING SIGNS SALVAGE TO	EXISTING SIGNS REMOVE	EXIST POST RETAIN	EXIST POST REMOVE	NUMBER OF NEW POSTS	SQUARE STEEL (IN) 1.75 (LB / FT) 1.88	SQUARE STEEL (IN) 2.00 (LB / FT) 2.42	SQUARE STEEL (IN) 2.50 (LB / FT) 3.35	FOUNDATION	TUBULAR STEEL Ø (IN) 3.00 (LB / FT) 7.60	TUBULAR STEEL Ø (IN) 3.50 (LB / FT) 9.00	TUBULAR STEEL Ø (IN) 4.00 (LB / FT) 10.80	TUBULAR STEEL Ø (IN) 5.00 (LB / FT) 14.60	SIGN FRAME REQUIRED	REMARKS	SIGN DETAIL: DETAIL IN SHS	SIGN DETAIL: DETAIL ON SHEET NUMBER	SIGN DETAIL: DETAIL ON STD SHEET NUMBER
BRATTLEBORO EB							FY-FLUORESCENT YELLOW FYG-FLUORESCENT YELLOW GREEN																			"SHS"-STANDARD HIGHWAY SIGNS			
EB	2.780	A	R2-1	24	30																					**SIGN AND POST MISSING**			
		A	R2-1	24	30			5.00								1		15.0' X								INSTALL 185 FT ± IN ADVANCE OF RIGHT-SIDE DRIVE TO "RASHED'S GARDEN CENTER"	X		
EB	2.890	A	unknown	18	24		GUN SAFETY ZONE SIGN, BLACK ON WHITE						1		X											ILLEGALLY INSTALLED SIGN, REMOVE ALL			
EB	2.965	A	W1-3L	30	30		LEFT REVERSE TURN SYMBOL						1		X											TO BE REPLACED w/ NEW SIGN 250 FT ± AHEAD			
		A	W13-1	18	18		35-MPH (PLAQUE)						1													EAST			
EB	3.012	A	W1-4L	30	30			6.25								1		15.0' X								INSTALL 250 FT ± ~~NORTH~~ OF REMOVAL; NOTE DIFFERENT SYMBOL AND NO PLAQUE	X		
EB	3.169	A	R8-3A	24	24								1		X														
		A	M4-11	24	12								1																
		A	VR-644P	24	12			2.00								1		13.5' X								**BLACK ON WHITE**; INSTALL THIS PLAQUE ON TOP		6	
		A	R8-3A	24	24			4.00																			X		
		A	W7-3A	24	18			3.00																		**BLACK ON WHITE**; INSTALL THIS PLAQUE ON THE BOTTOM; NOTE SINGULAR "MILE"		6	
EB	3.200	A	VR-921R	30	30								1		X															
		A	VR-921R	30	30			6.25								1		13.5' X										6	
EB	3.221	C	VR-017	24	30								1													STOCKWELL DRIVE (TH-703); ~~EXISTING SIGN AND POST MISSING~~			
		C	VR-017	24	30			5.00								1		13.5' X										6	
SIGN SUMMARY SHEET							SHEET TOTALS	31.50 SF	0.00 SF	0 EA	0 EA	0 EA	~~6~~ 7 EA	0 EA	0 EA	5 EA		~~75~~ 70.5' FT											
VERMONT AGENCY OF TRANSPORTATION							TOWN DIRECTIONAL TOTALS	305.3	0.0	4.0	1.0	1.0	66	0.0	0.0	53		795.0										

PROJECT NAME: **STATEWIDE SOUTHEAST REGION**
PROJECT NUMBER: **STPG SIGN (31)**

FILE NAME: **BRATTLEBORO EASTBOUND** PLOT DATE: **8/11/2010**
PROJECT MANAGER: **A. GAMBLE** DRAWN BY: **M. MILLER**
DESIGNED BY: **M. MILLER** CHECKED BY: **A. GAMBLE**
BRATTLEBORO VT-9 EASTBOUND 5 SHEET **14** OF **175**

DIRECTION	MILEPOINT	LOCATION CODE (SHEET 2)	SIGN CODE	WIDTH (IN)	HEIGHT (IN)	SHEETING REMARKS	SIGN LEGEND	NEW SIGNS "A"	NEW SIGNS "B"	EXISTING SIGNS RETAIN	EXISTING SIGNS SALVAGE FROM	EXISTING SIGNS SALVAGE TO	EXISTING SIGNS REMOVE	EXIST POST RETAIN	EXIST POST REMOVE	NUMBER OF NEW POSTS	SQUARE STEEL (IN) 1.75 (LB / FT) 1.88	SQUARE STEEL (IN) 2.00 (LB / FT) 2.42	SQUARE STEEL (IN) 2.50 (LB / FT) 3.35	TUBULAR STEEL Ø (IN) FOUNDATION	TUBULAR STEEL Ø (IN) 3.00 (LB / FT) 7.60	TUBULAR STEEL Ø (IN) 3.50 (LB / FT) 9.00	TUBULAR STEEL Ø (IN) 4.00 (LB / FT) 10.80	TUBULAR STEEL Ø (IN) 5.00 (LB / FT) 14.60	SIGN FRAME REQUIRED	REMARKS	SIGN DETAIL: DETAIL IN SHS	SIGN DETAIL: DETAIL ON SHEET NUMBER	SIGN DETAIL: DETAIL ON STD SHEET NUMBER
BRATTLEBORO EB							FY-FLUORESCENT YELLOW FYG-FLUORESCENT YELLOW GREEN																			"SHS"-STANDARD HIGHWAY SIGNS			
EB	3.229	D	R1-1	30	30								1		X														
		D	R1-1	30	30			6.25								1		13.5' X										X	
EB	3.236	A	W11-2	30	30								1		X														
		A	W7-3A	24	18								1																
		A	W11-2	30	30	FYG		6.25								1		14.75' X								FLUORESCENT YELLOW-GREEN SHEETING FOR BOTH NEW SIGNS	X	
		A	W7-3A	24	18	FYG		3.00																			X	
EB	3.269	A	R8-3A	24	24								1		X														
		A	R8-3A	24	24			4.00								1		13.5' X									X	
EB	3.298	A	VW-092	36	36								1		X														
		A	VW-092	36	36			9.00								2		13.75' 14.75' X										5
EB	3.317	C	VR-017	24	30								1		X												WESTGATE DR (TH-88)		
		C	VR-017	24	30			5.00								1		12.5' X										6
EB	3.323	D	R1-1	30	30								1		X														
		D	R1-1	30	30			6.25								1		12.5' X									X	
EB	3.368	A	M3-2	24	12								1		X														6
SIGN SUMMARY SHEET							SHEET TOTALS	39.75	0.00	0	0	0	8	0	0	7		~~105~~ 95.25										
VERMONT AGENCY OF TRANSPORTATION								SF	SF	EA	EA	EA	EA	EA	EA	EA		FT										
							TOWN DIRECTIONAL TOTALS	305.3	0.0	4.0	1.0	1.0	66	0.0	0.0	53		795.0										

PROJECT NAME: **STATEWIDE SOUTHEAST REGION**
PROJECT NUMBER: **STPG SIGN (31)**

FILE NAME: **BRATTLEBORO EASTBOUND** PLOT DATE: **8/11/2010**
PROJECT MANAGER: **A. GAMBLE** DRAWN BY: **M. MILLER**
DESIGNED BY: **M. MILLER** CHECKED BY: **A. GAMBLE**
BRATTLEBORO VT-9 EASTBOUND 6 SHEET **15** OF **175**

DIRECTION	MILEPOINT	LOCATION CODE (SHEET 2)	SIGN CODE	WIDTH (IN)	HEIGHT (IN)	SHEETING REMARKS	SIGN LEGEND	NEW SIGNS "A"	NEW SIGNS "B"	EXISTING SIGNS RETAIN	EXISTING SIGNS SALVAGE FROM	EXISTING SIGNS SALVAGE TO	EXISTING SIGNS REMOVE	EXIST POST RETAIN	EXIST POST REMOVE	NUMBER OF NEW POSTS	SQUARE STEEL (IN) (LB / FT) 1.75 1.88	SQUARE STEEL (IN) (LB / FT) 2.00 2.42	SQUARE STEEL (IN) (LB / FT) 2.50 3.35	TUBULAR STEEL Ø (IN) FOUNDATION	TUBULAR STEEL Ø (IN) (LB / FT) 3.00 7.60	TUBULAR STEEL Ø (IN) (LB / FT) 3.50 9.00	TUBULAR STEEL Ø (IN) (LB / FT) 4.00 10.80	TUBULAR STEEL Ø (IN) (LB / FT) 5.00 14.60	SIGN FRAME REQUIRED	REMARKS	SIGN DETAIL: DETAIL IN SHS	SIGN DETAIL: DETAIL ON SHEET NUMBER	SIGN DETAIL: DETAIL ON STD SHEET NUMBER
BRATTLEBORO EB							FY-FLUORESCENT YELLOW FYG-FLUORESCENT YELLOW GREEN																			"SHS"-STANDARD HIGHWAY SIGNS			
		A	M1-5	24	24								1															
		A	VM-120	18	24						1		1							PAY FOR REMOVAL						TO BE SALVAGED TO BELOW THE NEW ROUTE MARKER SIGNS			
		A	M3-2	24	12		EAST / VERMONT 9	2.00								1		15.0' X								GREEN ON WHITE	X		
		A	M1-5	24	24			4.00																				E-136B
		A	VM-120	18	24		MOLLY STARK BYWAY					1														SALVAGE TO BELOW THE ROUTE MARKER SIGNS			
EB	3.409	A	R2-1	24	30		SPEED LIMIT 40						1		X													
		A	R2-1	24	30			5.00								1		13.5' X									X		
EB	3.503	A	R3-9b	24	36		CENTER LANE ONLY						1		X													
		A	R3-9b	24	36			6.00								1		13.5' X									X		
EB	3.576	A	R8-3A	24	24								1		X													
		A	R8-3A	24	24			4.00								1		12.0' X									X		
EB	3.805	A	R8-3A	24	24								1		X													
		A	R8-3A	24	24			4.00								1		14.75' X									X		
EB	3.894	A	R2-1	24	30		SPEED LIMIT 40 (MISSING)																			EXISTING SIGN IS MISSING			
		A	R2-1	24	30			5.00								1		15.0' X								INSTALL ~~260~~ 150 FT ± IN ADVANCE OF THE (3) BUSINESS SIGN ASSEMBLY AHEAD		6	
							SHEET TOTALS	30.00 SF	0.00 SF	0 EA	1 EA	1 EA	~~5~~ 6 EA	0 EA	0 EA	6 EA	~~90~~ 83.75 FT									
							TOWN DIRECTIONAL TOTALS	305.3	0.0	4.0	1.0	1.0	66	0.0	0.0	53	795.0											

SIGN SUMMARY SHEET

VERMONT AGENCY OF TRANSPORTATION

PROJECT NAME: **STATEWIDE SOUTHEAST REGION**
PROJECT NUMBER: **STPG SIGN (31)**

FILE NAME: **BRATTLEBORO EASTBOUND** PLOT DATE: **8/11/2010**
PROJECT MANAGER: **A. GAMBLE** DRAWN BY: **M. MILLER**
DESIGNED BY: **M. MILLER** CHECKED BY: **A. GAMBLE**
BRATTLEBORO VT-9 EASTBOUND 7 SHEET **16** OF **175**

DIRECTION	MILEPOINT	LOCATION CODE (SHEET 2)	SIGN CODE	WIDTH (IN)	HEIGHT (IN)	SHEETING REMARKS	SIGN LEGEND	NEW SIGNS "A"	NEW SIGNS "B"	EXISTING SIGNS RETAIN	EXISTING SIGNS SALVAGE FROM	EXISTING SIGNS SALVAGE TO	EXISTING SIGNS REMOVE	EXIST POST RETAIN	EXIST POST REMOVE	NUMBER OF NEW POSTS	SQUARE STEEL (IN) 1.75 (LB / FT) 1.88	SQUARE STEEL (IN) 2.00 (LB / FT) 2.42	SQUARE STEEL (IN) 2.50 (LB / FT) 3.35	TUBULAR STEEL Ø (IN) FOUNDATION	TUBULAR STEEL Ø (IN) 3.00 (LB / FT) 7.60	TUBULAR STEEL Ø (IN) 3.50 (LB / FT) 9.00	TUBULAR STEEL Ø (IN) 4.00 (LB / FT) 10.80	TUBULAR STEEL Ø (IN) 5.00 (LB / FT) 14.60	SIGN FRAME REQUIRED	REMARKS	SIGN DETAIL: DETAIL IN SHS	SIGN DETAIL: DETAIL ON SHEET NUMBER	SIGN DETAIL: DETAIL ON STD SHEET NUMBER
BRATTLEBORO EB							FY-FLUORESCENT YELLOW FYG-FLUORESCENT YELLOW GREEN																			"SHS"-STANDARD HIGHWAY SIGNS			
EB	3.943	A	VD-062BRN	72	16		BUSINESS DIRECTORY SIGN			1				X												DALEM'S CHALET			
		A	VD-062BRN	72	16		BUSINESS DIRECTORY SIGN			1																MEADOWBROOK INN			
		A	VD-062BRN	72	16		BUSINESS DIRECTORY SIGN			1																MOLLY STARK BYWAY ^			
EB	3.964	A	R8-3A	24	24		NO PARKING SYMBOL						1		X														
EB	4.065	A	W11-2	30	30								1		X														
		A	W16-9P	24	12								1																
		A	W11-2	30	30	FYG		6.25								1	15.0' X							BOTH NEW SIGNS WILL HAVE FLUORESCENT YELLOW-GREEN SHEETING	X		
		A	W16-9P	24	12	FYG		2.00																			X		
EB	4.102	A	R2-5A	24	30		REDUCED SPEED AHEAD						1		X														
		A	R8-3A	24	24		NO PARKING (SYMBOL)						1																
		A	W3-5	36	36			9.00								2	13.75' 14.5' X										X		
EB	4.124	A	VD-018	30	18			3.75								1	12.75' X										INSTALL 140 FT ± EAST OF THE SPEED REDUCTION 30-MPH SIGN		8	
EB	4.146	A	unknown	n/a	n/a		**REMOVE EMPTY POST**								X												REMOVE THE EMPTY RUSTED POST			
EB	4.152	A	VD-018	30	18		WEST BRATTLEBORO BRATTLEBORO 2						1		X														
EB	4.155	A	unknown	24	30		BICYCLE (SYMBOL) LANE AHEAD (TEXT)						2 1 8		X												2 SIGNS WERE REMOVED		6	
SIGN SUMMARY SHEET							SHEET TOTALS	21.00 SF	0.00 SF	3 EA	0 EA	0 EA	7 EA	0 EA	0 EA	4 EA	55.0 60 FT												
VERMONT AGENCY OF TRANSPORTATION							TOWN DIRECTIONAL TOTALS	305.3	0.0	4.0	1.0	1.0	66	0.0	0.0	53	795.0												

PROJECT NAME: **STATEWIDE SOUTHEAST REGION**
PROJECT NUMBER: **STPG SIGN (31)**

FILE NAME: **BRATTLEBORO EASTBOUND** PLOT DATE: **8/11/2010**
PROJECT MANAGER: **A. GAMBLE** DRAWN BY: **M. MILLER**
DESIGNED BY: **M. MILLER** CHECKED BY: **A. GAMBLE**
BRATTLEBORO VT-9 EASTBOUND 8 SHEET **17** OF **175**

DIRECTION	MILEPOINT	LOCATION CODE (SHEET 2)	SIGN CODE	WIDTH (IN)	HEIGHT (IN)	SHEETING REMARKS	SIGN LEGEND	NEW SIGNS "A"	NEW SIGNS "B"	EXISTING SIGNS RETAIN	EXISTING SIGNS SALVAGE FROM	EXISTING SIGNS SALVAGE TO	EXISTING SIGNS REMOVE	EXIST POST RETAIN	EXIST POST REMOVE	NUMBER OF NEW POSTS	SQUARE STEEL (IN) 1.75 (LB / FT) 1.88	SQUARE STEEL (IN) 2.00 (LB / FT) 2.42	SQUARE STEEL (IN) 2.50 (LB / FT) 3.35	TUBULAR STEEL Ø (IN) FOUNDATION	TUBULAR STEEL Ø (IN) 3.00 (LB / FT) 7.60	TUBULAR STEEL Ø (IN) 3.50 (LB / FT) 9.00	TUBULAR STEEL Ø (IN) 4.00 (LB / FT) 10.80	TUBULAR STEEL Ø (IN) 5.00 (LB / FT) 14.60	SIGN FRAME REQUIRED	REMARKS	SIGN DETAIL: DETAIL IN SHS	SIGN DETAIL: DETAIL ON SHEET NUMBER	SIGN DETAIL: DETAIL ON STD SHEET NUMBER
BRATTLEBORO EB							FY-FLUORESCENT YELLOW FYG-FLUORESCENT YELLOW GREEN																			"SHS"-STANDARD HIGHWAY SIGNS			
		A	R3-17	30	24			5.00								1		14.5' X								NOTE DIFFERENT DESIGN COMPARED TO EXISTING	X		
		A	R3-17a	30	12			2.50																			INSTALL PLAQUE ON BOTTOM	X		
EB	4.174	A	unknown	24	6		CARS (PLAQUE)						1		X														
		A	R2-1	24	30		SPEED LIMIT 30						1																
		A	unknown	24	12		BUS / TRUCKS (PLAQUE)						1		X														
		A	R2-1	24	30		SPEED LIMIT 25						1																
		A	VR-038	24	18		STATE HIGHWAY ENDS						1																
		A	VR-038	24	18			3.00								2		14.5' 15.0' X						# 1	INSTALL "STATE HIGHWAY ENDS" SIGN ON LEFT SIDE, ABOVE THE NEW SPEED LIMIT SIGNS		6	
		A	R2-1	24	30			5.00																			INSTALL SPEED LIMIT 30 UNDER THE STATE HIGHWAY ENDS SIGN	X		
		A	R2-2	24	24			4.00																			INSTALL TRUCK SPEED LIMIT SIGN UNDER THE SPEED LIMIT 30 SIGN	X		
		A	M4-6	24	12			2.00																			**BLACK ON WHITE**; INSTALL ON TOP TO RIGHT OF STATE HIGHWAY ENDS SIGN; USE A SIGN FRAME	X		
		A	R8-3A	24	24			4.00																			NO PARKING SYMBOL BELOW THE "END" PLAQUE	X		
EB	4.187	D	R1-1	30	30		0090 1302 04.26 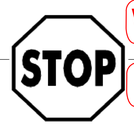 WESTERN AVE. EDWARD HEIGHTS						1		X							MILE MARKER WAS RE-INSTALLED ON THE NEW POST					EDWARD HEIGHTS RD (TH-700)			
		D	R1-1	30	30			6.25			2	2				1		12.75' X									(NO LEGAL LOAD SIGN TO BE INSTALLED HERE)	X		
EB	4.188	A	W11-2	30	30								1		X														6
							SHEET TOTALS	31.75 SF	0.00 SF	0 EA	~~2~~ 0 EA	~~2~~ 0 EA	7 EA	0 EA	0 EA	4 EA		~~60~~ 56.75 FT										
							TOWN DIRECTIONAL TOTALS	305.3	0.0	4.0	1.0	1.0	66	0.0	0.0	53		795.0										

SIGN SUMMARY SHEET

VERMONT AGENCY OF TRANSPORTATION

PROJECT NAME: **STATEWIDE SOUTHEAST REGION**
PROJECT NUMBER: **STPG SIGN (31)**

FILE NAME: **BRATTLEBORO EASTBOUND** PLOT DATE: **8/11/2010**
PROJECT MANAGER: **A. GAMBLE** DRAWN BY: **M. MILLER**
DESIGNED BY: **M. MILLER** CHECKED BY: **A. GAMBLE**
BRATTLEBORO VT-9 EASTBOUND 9 SHEET **18** OF **175**

DIRECTION	MILEPOINT	LOCATION CODE (SHEET 2)	SIGN CODE	WIDTH (IN)	HEIGHT (IN)	SHEETING REMARKS	SIGN LEGEND	NEW SIGNS "A"	NEW SIGNS "B"	EXISTING SIGNS RETAIN	EXISTING SIGNS SALVAGE FROM	EXISTING SIGNS SALVAGE TO	EXISTING SIGNS REMOVE	EXIST POST RETAIN	EXIST POST REMOVE	NUMBER OF NEW POSTS	SQUARE STEEL (IN) 1.75 (LB / FT) 1.88	SQUARE STEEL (IN) 2.00 (LB / FT) 2.42	SQUARE STEEL (IN) 2.50 (LB / FT) 3.35	TUBULAR STEEL Ø (IN) FOUNDATION	TUBULAR STEEL Ø (IN) 3.00 (LB / FT) 7.60	TUBULAR STEEL Ø (IN) 3.50 (LB / FT) 9.00	TUBULAR STEEL Ø (IN) 4.00 (LB / FT) 10.80	TUBULAR STEEL Ø (IN) 5.00 (LB / FT) 14.60	SIGN FRAME REQUIRED	REMARKS	SIGN DETAIL: DETAIL IN SHS	SIGN DETAIL: DETAIL ON SHEET NUMBER	SIGN DETAIL: DETAIL ON STD SHEET NUMBER
BRATTLEBORO EB							FY-FLUORESCENT YELLOW FYG-FLUORESCENT YELLOW GREEN																			"SHS"-STANDARD HIGHWAY SIGNS			
	4.188	A	W16-7P	24	12								1																
		A	W11-2	30	30	FYG		6.25								1		13.0' X								BOTH NEW SIGNS HAVE FLUORESCENT YELLOW-GREEN SHEETING	X		
		A	W16-7	24	12	FYG		2.00																			X		

DIRECTION	MILEPOINT	LOCATION CODE (SHEET 2)	SIGN CODE	WIDTH (IN)	HEIGHT (IN)	SHEETING REMARKS	SIGN LEGEND	NEW SIGNS "A"	NEW SIGNS "B"	EXISTING SIGNS RETAIN	EXISTING SIGNS SALVAGE FROM	EXISTING SIGNS SALVAGE TO	EXISTING SIGNS REMOVE	EXIST POST RETAIN	EXIST POST REMOVE	NUMBER OF NEW POSTS	SQUARE STEEL (IN) 1.75 (LB / FT) 1.88	SQUARE STEEL (IN) 2.00 (LB / FT) 2.42	SQUARE STEEL (IN) 2.50 (LB / FT) 3.35	TUBULAR STEEL Ø (IN) FOUNDATION	TUBULAR STEEL Ø (IN) 3.00 (LB / FT) 7.60	TUBULAR STEEL Ø (IN) 3.50 (LB / FT) 9.00	TUBULAR STEEL Ø (IN) 4.00 (LB / FT) 10.80	TUBULAR STEEL Ø (IN) 5.00 (LB / FT) 14.60	SIGN FRAME REQUIRED	REMARKS	SIGN DETAIL: DETAIL IN SHS	SIGN DETAIL: DETAIL ON SHEET NUMBER	SIGN DETAIL: DETAIL ON STD SHEET NUMBER
BRATTLEBORO WB							FY-FLUORESCENT YELLOW FYG-FLUORESCENT YELLOW GREEN																			"SHS"-STANDARD HIGHWAY SIGNS			
WB	4.190	F	W11-2	30	30								1		X														
		F	W16-7P	24	12								1																
		F	W11-2	30	30	FYG		6.25								1		14.75' X								BOTH NEW SIGNS HAVE FLUORESCENT YELLOW-GREEN SHEETING	X		
		F	W16-7	24	12	FYG		2.00																			X		
WB	4.175	F	R2-1	24	30								1		X														
		F	VR-039	24	18								1																
		F	VR-039	24	18			3.00								1		13.5' X								INSTALL PLAQUE ABOVE THE SPEED LIMIT 40 SIGN		6	
		F	R2-1	24	30			5.00																			X		
WB	4.163	G	unknown	12	12		NO PARKING						1		X														
		G	unknown	12	6		UNKNOWN NO PARKING (PLAQUE)						1														COMPLETELY FADED; **NEW SIGNS WILL FACE WESTBOUND TRAFFIC**			
		F	VR-644P	24	12			2.00								1		13.75' X								**BLACK ON WHITE**; INSTALL THE "BEGIN" PLAQUE ABOVE THE NO PARKING SIGN		6	
		F	R8-3A	24	24			4.00								~~1~~		~~X~~									X		
		F	W7-3A	24	18			3.00																		**BLACK ON WHITE**; INSTALL THIS PLAQUE ON THE BOTTOM; NOTE SINGULAR "MILE"		6	
WB	4.073	F	R8-3A	24	24								~~1~~		~~X~~											SIGN WAS REMOVED PRIOR TO THE PROJECT			
		F	R8-3A	24	24			4.00								1		12.5' X								INSTALL 475 FT ± WEST OF THE "NO PARKING BEGIN" SIGNS	X		
SIGN SUMMARY SHEET							SHEET TOTALS	29.25	0.00	0	0	0	6 ~~7~~	0	0	5		~~75~~ 54.5										
								SF	SF	EA	EA	EA	EA	EA	EA	EA		FT										
VERMONT AGENCY OF TRANSPORTATION							TOWN DIRECTIONAL TOTALS	268.5	0.0	2.0	1.0	1.0	64	0.0	0.0	47		705.0										

PROJECT NAME: **STATEWIDE SOUTHEAST REGION**
PROJECT NUMBER: **STPG SIGN (31)**

FILE NAME: **BRATTLEBORO WESTBOUND** PLOT DATE: **8/11/2010**
PROJECT MANAGER: **A. GAMBLE** DRAWN BY: **M. MILLER**
DESIGNED BY: **M. MILLER** CHECKED BY: **A. GAMBLE**
BRATTLEBORO VT-9 WESTBOUND 1 SHEET **20** OF **175**

DIRECTION	MILEPOINT	LOCATION CODE (SHEET 2)	SIGN CODE	WIDTH (IN)	HEIGHT (IN)	SHEETING REMARKS	SIGN LEGEND	NEW SIGNS "A"	NEW SIGNS "B"	EXISTING SIGNS RETAIN	EXISTING SIGNS SALVAGE FROM	EXISTING SIGNS SALVAGE TO	EXISTING SIGNS REMOVE	EXIST POST RETAIN	EXIST POST REMOVE	NUMBER OF NEW POSTS	SQUARE STEEL (IN) (LB / FT) 1.75 1.88	SQUARE STEEL (IN) (LB / FT) 2.00 2.42	SQUARE STEEL (IN) (LB / FT) 2.50 3.35	TUBULAR STEEL Ø (IN) FOUNDATION	TUBULAR STEEL Ø (IN) (LB / FT) 3.00 7.60	TUBULAR STEEL Ø (IN) (LB / FT) 3.50 9.00	TUBULAR STEEL Ø (IN) (LB / FT) 4.00 10.80	TUBULAR STEEL Ø (IN) (LB / FT) 5.00 14.60	SIGN FRAME REQUIRED	REMARKS	SIGN DETAIL: DETAIL IN SHS	SIGN DETAIL: DETAIL ON SHEET NUMBER	SIGN DETAIL: DETAIL ON STD SHEET NUMBER
BRATTLEBORO WB							FY-FLUORESCENT YELLOW FYG-FLUORESCENT YELLOW GREEN																			"SHS"-STANDARD HIGHWAY SIGNS			
WB	3.965	F	R8-3A	24	24								1		X													
		F	R8-3A	24	24			4.00								1		12.25' X									X	
WB	3.803	F	R8-3A	24	24								1		X													
		F	R8-3A	24	24			4.00								1		12.5' X									X	
WB	3.730	F	R2-1	24	30			5.00								1		13.25' X								INSTALL 385 FT ± WEST OF THE PREVIOUS "NO PARKING" SIGN	X	
WB	3.640	F	R8-3A	24	24								1		X													
		F	R8-3A	24	24			4.00								1		12.25' X									X	
WB	3.588	F	R8-3A	24	24		NO PARKING SYMBOL						1		X											ADJACENT TO BEGINNING OF CONCRETE SIDEWALK IN ADVANCE OF "CUMB. FARMS"		
WB	3.565	F	R3-9b	24	36								1		X													
		F	R3-9b	24	36			6.00								1		13.5' X									X	
WB	3.560	F	VW-092	36	36		UNSAFE TO PASS						1		X													
WB	3.495	F	VW-133R	30	30		HIDDEN DRIVES RIGHT						1		X													
WB	3.470	F	W11-2	30	30								1		X													
		F	W7-3A	24	18								1															
		F	W11-2	30	30	FYG		6.25								1		13.5' X								FLUORESCENT YELLOW-GREEN SHEETING FOR BOTH NEW SIGNS	X	
							SHEET TOTALS	29.25 SF	0.00 SF	0 EA	0 EA	0 EA	9 EA	0 EA	0 EA	6 EA	~~90~~ 77.25' FT									
							TOWN DIRECTIONAL TOTALS	268.5	0.0	2.0	1.0	1.0	64	0.0	0.0	47	705.0									

SIGN SUMMARY SHEET

VERMONT AGENCY OF TRANSPORTATION

PROJECT NAME: **STATEWIDE SOUTHEAST REGION**
PROJECT NUMBER: **STPG SIGN (31)**

FILE NAME: **BRATTLEBORO WESTBOUND** PLOT DATE: **8/11/2010**
PROJECT MANAGER: **A. GAMBLE** DRAWN BY: **M. MILLER**
DESIGNED BY: **M. MILLER** CHECKED BY: **A. GAMBLE**
BRATTLEBORO VT-9 WESTBOUND 2 SHEET **21** OF **175**

DIRECTION	MILEPOINT	LOCATION CODE (SHEET 2)	SIGN CODE	WIDTH (IN)	HEIGHT (IN)	SHEETING REMARKS	SIGN LEGEND	NEW SIGNS "A"	NEW SIGNS "B"	EXISTING SIGNS RETAIN	EXISTING SIGNS SALVAGE FROM	EXISTING SIGNS SALVAGE TO	EXISTING SIGNS REMOVE	EXIST POST RETAIN	EXIST POST REMOVE	NUMBER OF NEW POSTS	SQUARE STEEL (IN) 1.75 / 2.00 / 2.50 (LB / FT) 1.88 / 2.42 / 3.35	TUBULAR STEEL Ø (IN) FOUNDATION	TUBULAR STEEL Ø (IN) 3.00 / 3.50 / 4.00 / 5.00 (LB / FT) 7.60 / 9.00 / 10.80 / 14.60	SIGN FRAME REQUIRED	REMARKS	SIGN DETAIL: DETAIL IN SHS	SIGN DETAIL: DETAIL ON SHEET NUMBER	SIGN DETAIL: DETAIL ON STD SHEET NUMBER
BRATTLEBORO WB							FY-FLUORESCENT YELLOW FYG-FLUORESCENT YELLOW GREEN														"SHS"-STANDARD HIGHWAY SIGNS			
		F	W7-3A	24	18	FYG	(PLAQUE SAYS "NEXT 1/4 MILE")	3.00														X		
WB	3.405	F	R2-1	24	30			5.00								1	14.75' X				INSTALL 345 FT ± WEST OF THE PEDESTRIAN WARNING SIGNS	X		
		F	R8-3A	24	24			4.00													INSTALL THE SPEED LIMIT ON TOP, NO PARKING SIGN ON BOTTOM	X		
WB	3.342	F	VR-921L	36	30								1		X									
		F	VR-921L	30	30			6.25								1	13.0' X				(MIRRORED DESIGN)		6	
WB	3.330	F	R8-3A	24	24		NO PARKING SYMBOL						1		X									
WB	3.300	F	VD-062AL	72	16		BUSINESS DIRECTORY SIGN			1				X							DOUGLAS COX ===>			
WB	3.273	F	VR-921L	30	30								1		X									
		F	VR-921L	30	30			6.25								1	13.5' X				(MIRRORED DESIGN)		6	
WB	3.242	F	R8-3A	24	24		NO PARKING SYMBOL						1		X						ADJACENT TO "ROYAL CHELSEA DINER"			
WB	3.205	F	W1-3L	30	30		LEFT REVERSE TURN SYMBOL						1		X									
		F	W13-1	18	18		30-MPH (PLAQUE)						1								ADVISORY SPEED PLAQUE WILL NOT BE REPLACED			
		F	W1-4L	30	30			6.25								1	13.5' X				NOTE SLIGHT CHANGE IN SYMBOL DESIGN FROM EXISTING	X		
WB	3.174	F	R8-3A	24	24																EXISTING SIGNS AND POST ARE MISSING			
		F	M4-6	24	12																			

SIGN SUMMARY SHEET

VERMONT AGENCY OF TRANSPORTATION

	NEW SIGNS "A"	NEW SIGNS "B"	EXISTING SIGNS RETAIN	EXISTING SIGNS SALVAGE FROM	EXISTING SIGNS SALVAGE TO	EXISTING SIGNS REMOVE	EXIST POST RETAIN	EXIST POST REMOVE	NUMBER OF NEW POSTS	SQUARE STEEL (IN)	TUBULAR STEEL Ø (IN)
SHEET TOTALS	30.75	0.00	1	0	0	6	0	0	4	~~60~~ 54.75	
	SF	SF	EA	EA	EA	EA	EA	EA	EA	FT	
TOWN DIRECTIONAL TOTALS	268.5	0.0	2.0	1.0	1.0	64	0.0	0.0	47	705.0	

PROJECT NAME: **STATEWIDE SOUTHEAST REGION**
PROJECT NUMBER: **STPG SIGN (31)**

FILE NAME: **BRATTLEBORO WESTBOUND** PLOT DATE: **8/11/2010**
PROJECT MANAGER: **A. GAMBLE** DRAWN BY: **M. MILLER**
DESIGNED BY: **M. MILLER** CHECKED BY: **A. GAMBLE**
BRATTLEBORO VT-9 WESTBOUND 3 SHEET **22** OF **175**

DIRECTION	MILEPOINT	LOCATION CODE (SHEET 2)	SIGN CODE	WIDTH (IN)	HEIGHT (IN)	SHEETING REMARKS	SIGN LEGEND	NEW SIGNS "A"	NEW SIGNS "B"	EXISTING SIGNS RETAIN	EXISTING SIGNS SALVAGE FROM	EXISTING SIGNS SALVAGE TO	EXISTING SIGNS REMOVE	EXIST POST RETAIN	EXIST POST REMOVE	NUMBER OF NEW POSTS	SQUARE STEEL (IN) 1.75 (LB / FT) 1.88	SQUARE STEEL (IN) 2.00 (LB / FT) 2.42	SQUARE STEEL (IN) 2.50 (LB / FT) 3.35	TUBULAR STEEL Ø (IN) FOUNDATION	TUBULAR STEEL Ø (IN) 3.00 (LB / FT) 7.60	TUBULAR STEEL Ø (IN) 3.50 (LB / FT) 9.00	TUBULAR STEEL Ø (IN) 4.00 (LB / FT) 10.80	TUBULAR STEEL Ø (IN) 5.00 (LB / FT) 14.60	SIGN FRAME REQUIRED	REMARKS	SIGN DETAIL: DETAIL IN SHS	SIGN DETAIL: DETAIL ON SHEET NUMBER	SIGN DETAIL: DETAIL ON STD SHEET NUMBER
BRATTLEBORO WB							FY-FLUORESCENT YELLOW FYG-FLUORESCENT YELLOW GREEN																			"SHS"-STANDARD HIGHWAY SIGNS			
		F	M4-6	24	12		END	2.00								1		14.5' X								**BLACK ON WHITE**; INSTALL PLAQUE ON TOP	X		
		F	R8-3A	24	24		®	4.00																		INSTALL ASSEMBLY 165 FT ± WEST OF THE NEW REVERSE CURVE WARNING SIGN ABOVE	X		
WB	3.166	G	VR-017	24	30		LEGAL LOAD LIMIT 24,000 POUNDS / SAFETY ZONE NO FIREARM SHOOTING						1		X											SUNSET LAKE RD (TH-12)			
		G	VR-017	24	30			5.00			1	1	1			1		14.75' X			SAFETY ZONE SIGN WAS RE-INSTALLED ON TOWN'S SPEED LIMIT 30 SIGN FURTHER UP THE SIDE ROAD (PAY FOR REMOVAL)								6	
WB	3.160	H	R1-1	30	30		STOP 0090 1302 0326 SUNSET LAKE RD. MARLBORO RD.						1		X														
		H	R1-1	30	30			6.25			2	2				1		13.5' X									X		
WB	3.133	F	W1-6	48	24								1		X														
		F	W1-6	48	24			8.00								2		13.5' 14.5' X									X		
WB	3.098	F	M3-4	24	12								1		X														
		F	M1-5	24	24								1																
		F	VM-120	18	24		MOLLY STARK BYWAY (SYMBOL)				1																		
		F	M3-4	24	12		WEST VERMONT 9	2.00								1		15.25' X								**GREEN ON WHITE**; INSTALL ON TOP	X		
		F	M1-5	24	24			4.00																					E-136B
		F	VM-120	18	24		MOLLY STARK BYWAY (SYMBOL)					1														SALVAGE THIS SIGN TO BELOW THE NEW VT-9 ROUTE MARKER			
WB	3.077	F	R2-1	24	30								1		X														
SIGN SUMMARY SHEET							SHEET TOTALS	31.25	0.00	0	~~4~~ 1	~~4~~ 1	~~7~~ 6	0	0	6		~~90~~ 86.0										
VERMONT AGENCY OF TRANSPORTATION								SF	SF	EA	EA	EA	EA	EA	EA	EA		FT										
							TOWN DIRECTIONAL TOTALS	268.5	0.0	2.0	1.0	1.0	64	0.0	0.0	47		705.0										

PROJECT NAME: **STATEWIDE SOUTHEAST REGION**
PROJECT NUMBER: **STPG SIGN (31)**

FILE NAME: **BRATTLEBORO WESTBOUND** PLOT DATE: **8/11/2010**
PROJECT MANAGER: **A. GAMBLE** DRAWN BY: **M. MILLER**
DESIGNED BY: **M. MILLER** CHECKED BY: **A. GAMBLE**
BRATTLEBORO VT-9 WESTBOUND 4 SHEET **23** OF **175**

DIRECTION	MILEPOINT	LOCATION CODE (SHEET 2)	SIGN CODE	WIDTH (IN)	HEIGHT (IN)	SHEETING REMARKS	SIGN LEGEND	NEW SIGNS "A"	NEW SIGNS "B"	EXISTING SIGNS RETAIN	EXISTING SIGNS SALVAGE FROM	EXISTING SIGNS SALVAGE TO	EXISTING SIGNS REMOVE	EXIST POST RETAIN	EXIST POST REMOVE	NUMBER OF NEW POSTS	SQUARE STEEL (IN) 1.75 (LB / FT) 1.88	SQUARE STEEL (IN) 2.00 (LB / FT) 2.42	SQUARE STEEL (IN) 2.50 (LB / FT) 3.35	TUBULAR STEEL Ø (IN) FOUNDATION	TUBULAR STEEL Ø (IN) 3.00 (LB / FT) 7.60	TUBULAR STEEL Ø (IN) 3.50 (LB / FT) 9.00	TUBULAR STEEL Ø (IN) 4.00 (LB / FT) 10.80	TUBULAR STEEL Ø (IN) 5.00 (LB / FT) 14.60	SIGN FRAME REQUIRED	REMARKS	SIGN DETAIL: DETAIL IN SHS	SIGN DETAIL: DETAIL ON SHEET NUMBER	SIGN DETAIL: DETAIL ON STD SHEET NUMBER
BRATTLEBORO WB							FY-FLUORESCENT YELLOW FYG-FLUORESCENT YELLOW GREEN																			"SHS"-STANDARD HIGHWAY SIGNS			
		F	R2-1	24	30		SPEED LIMIT 40	5.00								1		13.0' X									X	
WB	2.757	F	R2-1	24	30		SPEED LIMIT 40 (MISSING)																			EXISTING SIGN AND POST ARE MISSING		
		F	R2-1	24	30			5.00								1		11.5' X								INSTALL 280 FT ± WEST OF THE DRIVE (ON LEFT) TO "RASHED'S GARDEN CENTER"	X	
WB	2.395	F	R2-1	24	30		SPEED LIMIT 50						1		X													
		F	R2-1	24	30			5.00								1		13.25' X								INSTALL ACROSS FROM ± THE EB SPEED LIMIT 40; THIS IS THE TRANSITION POINT	X	
WB	2.237	F	VW-202	36	36		TRUCKS ENTERING						1		X													
WB	1.980	F	M3-4	24	12		WEST						1		X													
		F	M1-5	24	24		VT-9						1															
WB	1.940	F	R2-1	24	30		SPEED LIMIT 50						1		X													
		F	D17-2	42	42		TRUCK LANE 2000 FT	12.25								2		14.75' 15.0' X								(NOTE:D17-2 IS THE FUTURE SHS SIGN CODE FOR THIS SIGN)		9
WB	1.626	F	R4-6	24	30		TRUCK LANE 500 FT						1		X													
WB	1.525	F	R4-3	24	30		SLOWER TRAFFIC KEEP RIGHT						1		X													
WB	1.497	F	VW-285	30	30		FALLING ROCK SYMBOL			1				X												RETAIN		
WB	1.422	F	W9-1R	36	36		RIGHT LANE ENDS	9.00								2		14.25' 15.25' X								INSTALL 400 FT ± WEST OF THE FALLING ROCK SYMBOL	X	
WB	1.375	F	W9-1	36	36								1		X													
							SHEET TOTALS	36.25 SF	0.00 SF	1 EA	0 EA	0 EA	8 EA	0 EA	0 EA	7 EA		~~105~~ 97.0 FT										
							TOWN DIRECTIONAL TOTALS	268.5	0.0	2.0	1.0	1.0	64	0.0	0.0	47		705.0										

SIGN SUMMARY SHEET

VERMONT AGENCY OF TRANSPORTATION

PROJECT NAME: **STATEWIDE SOUTHEAST REGION**
PROJECT NUMBER: **STPG SIGN (31)**

FILE NAME: **BRATTLEBORO WESTBOUND** PLOT DATE: **8/11/2010**
PROJECT MANAGER: **A. GAMBLE** DRAWN BY: **M. MILLER**
DESIGNED BY: **M. MILLER** CHECKED BY: **A. GAMBLE**
BRATTLEBORO VT-9 WESTBOUND 5 SHEET **24** OF **175**

DIRECTION	MILEPOINT	LOCATION CODE (SHEET 2)	SIGN CODE	WIDTH (IN)	HEIGHT (IN)	SHEETING REMARKS	SIGN LEGEND	NEW SIGNS "A"	NEW SIGNS "B"	EXISTING SIGNS RETAIN	EXISTING SIGNS SALVAGE FROM	EXISTING SIGNS SALVAGE TO	EXISTING SIGNS REMOVE	EXIST POST RETAIN	EXIST POST REMOVE	NUMBER OF NEW POSTS	SQUARE STEEL (IN) 1.75 (LB / FT) 1.88	SQUARE STEEL (IN) 2.00 (LB / FT) 2.42	SQUARE STEEL (IN) 2.50 (LB / FT) 3.35	TUBULAR STEEL Ø (IN) FOUNDATION	TUBULAR STEEL Ø (IN) 3.00 (LB / FT) 7.60	TUBULAR STEEL Ø (IN) 3.50 (LB / FT) 9.00	TUBULAR STEEL Ø (IN) 4.00 (LB / FT) 10.80	TUBULAR STEEL Ø (IN) 5.00 (LB / FT) 14.60	SIGN FRAME REQUIRED	REMARKS	SIGN DETAIL: DETAIL IN SHS	SIGN DETAIL: DETAIL ON SHEET NUMBER	SIGN DETAIL: DETAIL ON STD SHEET NUMBER
BRATTLEBORO WB							FY-FLUORESCENT YELLOW FYG-FLUORESCENT YELLOW GREEN																			"SHS"-STANDARD HIGHWAY SIGNS			
		F	W4-2R	36	36			9.00								2		14.25' 14.75' X								NEW SYMBOL LOOKS SLIGHTLY DIFFERENT THAN EXISTING	X		
WB	1.354	F	M3-4	24	12		WEST						1		X											TO BE REPLACED FURTHER AHEAD			
		F	M1-5	24	24		VT-9						1																
WB	1.285	F	R2-1	24	30		SPEED LIMIT 50						1		X											WILL NOT BE REPLACED			
WB	1.253	F	VR-186E	24	30		TRUCK LANE ENDS						1		X											THIS REMOVAL POINT BEING REFERENCED FOR NEXT SIGN			
WB	1.167	F	M3-4	24	12			2.00								1		14.25; X								**GREEN ON WHITE;** INSTALL 450 FT ± WEST OF THE "TRUCK LANE ENDS" REMOVAL	X		
		F	M1-5	24	24			4.00																					E-136B
WB	0.978	F	W1-2L	30	30								1		X															
		F	W1-2L	30	30			6.25								1		11.5' X								NEEDED, DUE TO ROCK FILL (BUT NOT MORE, SIGN IS AT IDEAL SPOT AT CREST OF HILL)	X		
WB	0.912	G	VR-017	24	30								1		X												HAMILTON RD (TH-8)			
		G	VR-017	24	30			5.00								1		10.25' X										6	
WB	0.905	H	R1-1	30	30		0090 1302 0093 HAMILTON RD.						1		X							MILE MARKER WAS RE-INSTALLED ON THE NEW POST							
		H	R1-1	30	30			6.25								1		13.0' X									X		
WB	0.865	F	M3-4	24	12		WEST						1		X														
		F	M1-5	24	24		VT-9						1																
SIGN SUMMARY SHEET							SHEET TOTALS	32.50 SF	0.00 SF	0 EA	0 EA	0 EA	9 EA	0 EA	0 EA	6 EA			~~90~~ 78.0 FT										
VERMONT AGENCY OF TRANSPORTATION							TOWN DIRECTIONAL TOTALS	268.5	0.0	2.0	1.0	1.0	64	0.0	0.0	47			705.0									

PROJECT NAME: **STATEWIDE SOUTHEAST REGION**
PROJECT NUMBER: **STPG SIGN (31)**

FILE NAME: **BRATTLEBORO WESTBOUND** PLOT DATE: **8/11/2010**
PROJECT MANAGER: **A. GAMBLE** DRAWN BY: **M. MILLER**
DESIGNED BY: **M. MILLER** CHECKED BY: **A. GAMBLE**
BRATTLEBORO VT-9 WESTBOUND 6 SHEET **25** OF **175**

DIRECTION	MILEPOINT	LOCATION CODE (SHEET 2)	SIGN CODE	WIDTH (IN)	HEIGHT (IN)	SHEETING REMARKS	SIGN LEGEND	NEW SIGNS "A"	NEW SIGNS "B"	EXISTING SIGNS RETAIN	EXISTING SIGNS SALVAGE FROM	EXISTING SIGNS SALVAGE TO	EXISTING SIGNS REMOVE	EXIST POST RETAIN	EXIST POST REMOVE	NUMBER OF NEW POSTS	SQUARE STEEL (IN) 1.75 (LB / FT) 1.88	SQUARE STEEL (IN) 2.00 (LB / FT) 2.42	SQUARE STEEL (IN) 2.50 (LB / FT) 3.35	TUBULAR STEEL Ø (IN) FOUNDATION	TUBULAR STEEL Ø (IN) 3.00 (LB / FT) 7.60	TUBULAR STEEL Ø (IN) 3.50 (LB / FT) 9.00	TUBULAR STEEL Ø (IN) 4.00 (LB / FT) 10.80	TUBULAR STEEL Ø (IN) 5.00 (LB / FT) 14.60	SIGN FRAME REQUIRED	REMARKS	SIGN DETAIL: DETAIL IN SHS	SIGN DETAIL: DETAIL ON SHEET NUMBER	SIGN DETAIL: DETAIL ON STD SHEET NUMBER
BRATTLEBORO WB							FY-FLUORESCENT YELLOW FYG-FLUORESCENT YELLOW GREEN																			"SHS"-STANDARD HIGHWAY SIGNS			
WB	0.827	F	R2-1	24	30		SPEED LIMIT 50						1		X														
WB	0.762	F	W1-2R	30	30		RIGHT CURVE						1		X												A NEW WARNING SYMBOL TO BE INSTALLED JUST AHEAD			
		F	W13-1	18	18		40-MPH (PLAQUE)						1																
WB	~~0.709~~ 0.705	F	W1-4R	30	30			6.25								1		16.75' X								280 INSTALL ~~300~~ FT ± WEST OF THE PREVIOUS WARNING SIGN REMOVAL	X		
		F	W13-1	18	18			2.25																				X	
WB	0.650	F	W1-2L	30	30		LEFT CURVE SYMBOL						1		X														
		F	W13-1	18	18		40-MPH (PLAQUE)						1																
WB	0.608	E	W1-8	18	24								1		X														
		E	W1-8	24	30			5.00								1		14.0' X								FACES EB TRAFFIC	X		
WB	0.593	F	W1-6	48	24								1		X														
		E	W1-8	18	24								1																
		F	W1-6	48	24		(BACK-TO-BACK)	8.00								2		13.5' 14.5 X								LARGE ARROW FACES WB TRAFFIC	X		
		E	W1-8	24	30			5.00																		CHEVRON FACES EB TRAFFIC, INSTALLED ON BACK OF THE LARGE ARROW RIGHT-SIDE POST	X		
WB	0.558	F	W1-8	18	24								1		X														
		F	W1-8	24	30			5.00								1		13.5' X								FACES WB TRAFFIC	X		
							SHEET TOTALS	31.50	0.00	0	0	0	9	0	0	5		~~75~~ 72.25											
								SF	SF	EA	EA	EA	EA	EA	EA	EA		FT											
							TOWN DIRECTIONAL TOTALS	268.5	0.0	2.0	1.0	1.0	64	0.0	0.0	47		705.0											

SIGN SUMMARY SHEET

VERMONT AGENCY OF TRANSPORTATION

PROJECT NAME: **STATEWIDE SOUTHEAST REGION**
PROJECT NUMBER: **STPG SIGN (31)**

FILE NAME: **BRATTLEBORO WESTBOUND** PLOT DATE: **8/11/2010**
PROJECT MANAGER: **A. GAMBLE** DRAWN BY: **M. MILLER**
DESIGNED BY: **M. MILLER** CHECKED BY: **A. GAMBLE**
BRATTLEBORO VT-9 WESTBOUND 7 SHEET **26** OF **175**

DIRECTION	MILEPOINT	LOCATION CODE (SHEET 2)	SIGN CODE	WIDTH (IN)	HEIGHT (IN)	SHEETING REMARKS	SIGN LEGEND	NEW SIGNS "A"	NEW SIGNS "B"	EXISTING SIGNS RETAIN	EXISTING SIGNS SALVAGE FROM	EXISTING SIGNS SALVAGE TO	EXISTING SIGNS REMOVE	EXIST POST RETAIN	EXIST POST REMOVE	NUMBER OF NEW POSTS	SQUARE STEEL (IN) 1.75 (LB / FT) 1.88	SQUARE STEEL (IN) 2.00 (LB / FT) 2.42	SQUARE STEEL (IN) 2.50 (LB / FT) 3.35	TUBULAR STEEL Ø (IN) FOUNDATION	TUBULAR STEEL Ø (IN) 3.00 (LB / FT) 7.60	TUBULAR STEEL Ø (IN) 3.50 (LB / FT) 9.00	TUBULAR STEEL Ø (IN) 4.00 (LB / FT) 10.80	TUBULAR STEEL Ø (IN) 5.00 (LB / FT) 14.60	SIGN FRAME REQUIRED	REMARKS	SIGN DETAIL: DETAIL IN SHS	SIGN DETAIL: DETAIL ON SHEET NUMBER	SIGN DETAIL: DETAIL ON STD SHEET NUMBER
BRATTLEBORO WB							FY-FLUORESCENT YELLOW FYG-FLUORESCENT YELLOW GREEN																			"SHS"-STANDARD HIGHWAY SIGNS			
WB	0.557	E	W1-8	18	24								1		X														
		E	W1-8	24	30			5.00								1		13.75' X									FACES EB TRAFFIC; INSTALL 5 FT ± WEST OF THE WB-FACING CHEVRON	X		
WB	0.532	F	W1-8	18	24		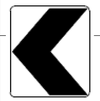						1		X														
		F	W1-8	24	30			5.00								1		13.5' X									FACES WB TRAFFIC	X		
WB	0.531	E	W1-8	18	24								1		X														
		E	W1-8	24	30			5.00								1		13.5' X									FACES EB TRAFFIC; INSTALL 5 FT ± WEST OF THE WB-FACING CHEVRON	X		
WB	0.505	E	W1-6	48	24		LARGE ARROW RIGHT						1		X												FACES EB TRAFFC			
		F	W1-8	24	30		(BACK-TO-BACK)	5.00								2		12.75' 13.25' X									CHEVRON FACES WB TRAFFIC; INSTALL ON LEFT POST, EB-FACING LARGE ARROW WILL BE ON BACK	X		
		E	W1-6	48	24			8.00																			FACES EB TRAFFIC;	X		
WB	0.470	F	W11-2	30	30		PEDESTRIAN (SYMBOL)						1		X														
		F	W16-4	24	18		NEXT 1000 FT (PLAQUE)						1																
		F	W11-2	30	30	FYG		6.25								1		15.0' X									INSTALL IN SAME POSITION AS REMOVAL	X		
		F	W16-4	30	24	FYG	NEXT 600 FT	5.00																			BOTH SIGNS HAVE FLUORESCENT YELLOW-GREEN BACKGROUND SHEETING	X		
WB	0.320	F	W1-1R	30	30		RIGHT TURN SYMBOL						1		X														
		F	W13-1	18	18		30-MPH (PLAQUE)						1																
							SHEET TOTALS	39.25	0.00	0	0	0	8	0	0	6										~~90~~ 81.75			
								SF	SF	EA	EA	EA	EA	EA	EA	EA										FT			
							TOWN DIRECTIONAL TOTALS	268.5	0.0	2.0	1.0	1.0	64	0.0	0.0	47										705.0			

SIGN SUMMARY SHEET

VERMONT AGENCY OF TRANSPORTATION

PROJECT NAME: STATEWIDE SOUTHEAST REGION
PROJECT NUMBER: STPG SIGN (31)

FILE NAME: BRATTLEBORO WESTBOUND
PROJECT MANAGER: A. GAMBLE
DESIGNED BY: M. MILLER
BRATTLEBORO VT-9 WESTBOUND 8

PLOT DATE: 8/11/2010
DRAWN BY: M. MILLER
CHECKED BY: A. GAMBLE
SHEET 27 OF 175

DIRECTION	MILEPOINT	LOCATION CODE (SHEET 2)	SIGN CODE	WIDTH (IN)	HEIGHT (IN)	SHEETING REMARKS	SIGN LEGEND	NEW SIGNS "A"	NEW SIGNS "B"	EXISTING SIGNS RETAIN	EXISTING SIGNS SALVAGE FROM	EXISTING SIGNS SALVAGE TO	EXISTING SIGNS REMOVE	EXIST POST RETAIN	EXIST POST REMOVE	NUMBER OF NEW POSTS	SQUARE STEEL (IN) 1.75 (LB / FT) 1.88	SQUARE STEEL (IN) 2.00 (LB / FT) 2.42	SQUARE STEEL (IN) 2.50 (LB / FT) 3.35	TUBULAR STEEL Ø (IN) FOUNDATION	TUBULAR STEEL Ø (IN) 3.00 (LB / FT) 7.60	TUBULAR STEEL Ø (IN) 3.50 (LB / FT) 9.00	TUBULAR STEEL Ø (IN) 4.00 (LB / FT) 10.80	TUBULAR STEEL Ø (IN) 5.00 (LB / FT) 14.60	SIGN FRAME REQUIRED	REMARKS	SIGN DETAIL: DETAIL IN SHS	SIGN DETAIL: DETAIL ON SHEET NUMBER	SIGN DETAIL: DETAIL ON STD SHEET NUMBER
BRATTLEBORO WB							FY-FLUORESCENT YELLOW FYG-FLUORESCENT YELLOW GREEN																			"SHS"-STANDARD HIGHWAY SIGNS			
WB	0.348	F	W1-5R	30	30			6.25								2		13.25' X		NEW SIGN INSTALLED 150' EAST						NOTE CHANGE OF SYMBOL FROM EXISTING	X		
		F	W13-1	18	18			2.25																		NOTE CHANGE OF ADVISORY SPEED FROM EXISTING	X		
WB	0.231	F	W1-5R	30	30		RIGHT "WINDING ROAD" SYMBOL						1		X														
		F	W13-1	18	18		40-MPH (PLAQUE)						1																
SIGN SUMMARY SHEET							SHEET TOTALS	8.50	0.00	0	0	0	2	0	0	2		~~30~~ 13.25										
VERMONT AGENCY OF TRANSPORTATION								SF	SF	EA	EA	EA	EA	EA	EA	EA		FT										
							TOWN DIRECTIONAL TOTALS	268.5	0.0	2.0	1.0	1.0	64	0.0	0.0	47		705.0										

PROJECT NAME: **STATEWIDE SOUTHEAST REGION**
PROJECT NUMBER: **STPG SIGN (31)**

FILE NAME: **BRATTLEBORO WESTBOUND** PLOT DATE: **8/11/2010**
PROJECT MANAGER: **A. GAMBLE** DRAWN BY: **M. MILLER**
DESIGNED BY: **M. MILLER** CHECKED BY: **A. GAMBLE**
BRATTLEBORO VT-9 WESTBOUND 9 SHEET **28** OF **175**

DIRECTION	MILEPOINT	LOCATION CODE (SHEET 2)	SIGN CODE	WIDTH (IN)	HEIGHT (IN)	SHEETING REMARKS	SIGN LEGEND	NEW SIGNS "A"	NEW SIGNS "B"	EXISTING SIGNS RETAIN	EXISTING SIGNS SALVAGE FROM	EXISTING SIGNS SALVAGE TO	EXISTING SIGNS REMOVE	EXIST POST RETAIN	EXIST POST REMOVE	NUMBER OF NEW POSTS	SQUARE STEEL (IN) 1.75 (LB / FT) 1.88	SQUARE STEEL (IN) 2.00 (LB / FT) 2.42	SQUARE STEEL (IN) 2.50 (LB / FT) 3.35	TUBULAR STEEL Ø (IN) FOUNDATION	TUBULAR STEEL Ø (IN) 3.00 (LB / FT) 7.60	TUBULAR STEEL Ø (IN) 3.50 (LB / FT) 9.00	TUBULAR STEEL Ø (IN) 4.00 (LB / FT) 10.80	TUBULAR STEEL Ø (IN) 5.00 (LB / FT) 14.60	SIGN FRAME REQUIRED	REMARKS	SIGN DETAIL: DETAIL IN SHS	SIGN DETAIL: DETAIL ON SHEET NUMBER	SIGN DETAIL: DETAIL ON STD SHEET NUMBER
NEWFANE NB							FY-FLUORESCENT YELLOW FYG-FLUORESCENT YELLOW GREEN																				"SHS"-STANDARD HIGHWAY SIGNS			
NB	0.000	C	VD-024	60	7.5								1		X												**NOTE:** TOWN LINE SIGN IS 228 FT± NORTH OF ACTUAL TOWN LINE, WHICH IS AT CENTER OF BRIDGE ±			
		C	VD-700	6	8								1														**NOTE:** ALL SUBSEQUENT EXISTING MILE MARKER PLAQUES IN THE FIELD MAY BE INCORRECT			
		C	VD-700	6	8								1																
		C	VD-024	72	10		Newfane / Dummerston	5.00								2		13.0' 13.0' X								INSTALL NEW SIGNS IN SAME POSITION AS REMOVED SIGNS		4	
		C	VD-700	6	10		0300 1312 0004 / 0300 1305 0510	0.42																		NEWFANE MILE MARKER; INSTALL ON LEFT-SIDE POST UNDER "NEWFANE"		4	
		C	VD-700	6	10			0.42																		DUMMERSTON MILE MARKER; INSTALL ON RIGHT-SIDE POST		4	
NB	0.190	A	R2-1	24	30		SPEED LIMIT 50						1		X														
		A	R2-1	24	30			5.00								1		13.0' X										X	
NB	0.484	A	VW-054	30	30		HIDDEN DRIVE RIGHT						1		X												TO BE REPLACED FURTHER AHEAD, NOTE REMOVAL POINT AS REFERENCE FOR NEW SIGN			
NB	0.519	A	VW-054	30	30			6.25								1		14.5' X								INSTALL THE NEW SIGN 185 FT ± NORTH OF THE PREVIOUS LOCATION; 20 FT ± SOUTH OF THE UTILITY POLE			E-154
NB	0.850	A	M3-1	24	12		NORTH	2.00								1		15.0' X								**GREEN ON WHITE**	X		
		A	M1-5	24	24		VERMONT 30	4.00																		INSTALL 75 FEET ± NORTH OF AND ACROSS FROM THE JCT WITH GRIMES HILL ROAD (TH-5)			E-136B
NB	0.930	A	S2-1	36	36	FYG	SCHOOL ZONE WITH CROSSWALK LINES						1		X														
		A	W16-9	36	20	FYG	AHEAD (PLAQUE)						1																
		A	S1-1	36	36	FYG	SCHOOL	9.00								2		13.0' 13.25 X								BOTH NEW SIGNS HAVE FLUORESCENT YELLOW-GREEN SHEETING WITH NO X-WALK LINES	X		
							SHEET TOTALS	32.09 SF	0.00 SF	0 EA	0 EA	0 EA	7 EA	0 EA	0 EA	7 EA									~~105~~ 94.75 FT			
							TOWN DIRECTIONAL TOTALS	261.0	0.0	27.0	0.0	0.0	52	0.0	0.0	47									705.0			

SIGN SUMMARY SHEET

VERMONT AGENCY OF TRANSPORTATION

PROJECT NAME: **STATEWIDE SOUTHEAST REGION**
PROJECT NUMBER: **STPG SIGN (31)**

FILE NAME: **NEWFANE NORTHBOUND** PLOT DATE: **8/12/2010**
PROJECT MANAGER: **A. GAMBLE** DRAWN BY: **M. MILLER**
DESIGNED BY: **M. MILLER** CHECKED BY: **A. GAMBLE**
NEWFANE VT-30 NORTHBOUND 1 SHEET **29** OF **175**

DIRECTION	MILEPOINT	LOCATION CODE (SHEET 2)	SIGN CODE	WIDTH (IN)	HEIGHT (IN)	SHEETING REMARKS	SIGN LEGEND	NEW SIGNS "A"	NEW SIGNS "B"	EXISTING SIGNS RETAIN	EXISTING SIGNS SALVAGE FROM	EXISTING SIGNS SALVAGE TO	EXISTING SIGNS REMOVE	EXIST POST RETAIN	EXIST POST REMOVE	NUMBER OF NEW POSTS	SQUARE STEEL (IN) 1.75 (LB / FT) 1.88	SQUARE STEEL (IN) 2.00 (LB / FT) 2.42	SQUARE STEEL (IN) 2.50 (LB / FT) 3.35	TUBULAR STEEL Ø (IN) FOUNDATION	TUBULAR STEEL Ø (IN) 3.00 (LB / FT) 7.60	TUBULAR STEEL Ø (IN) 3.50 (LB / FT) 9.00	TUBULAR STEEL Ø (IN) 4.00 (LB / FT) 10.80	TUBULAR STEEL Ø (IN) 5.00 (LB / FT) 14.60	SIGN FRAME REQUIRED	REMARKS	SIGN DETAIL: DETAIL IN SHS	SIGN DETAIL: DETAIL ON SHEET NUMBER	SIGN DETAIL: DETAIL ON STD SHEET NUMBER
NEWFANE NB							FY-FLUORESCENT YELLOW FYG-FLUORESCENT YELLOW GREEN																			"SHS"-STANDARD HIGHWAY SIGNS			
		A	S4-3P	24	8	FYG		1.33																		SPAN THE PLAQUE ACROSS BOTH POSTS, CENTERED UNDER THE PRIMARY SIGN	X		
NB	0.967	A	D1-2	72	20		Newfane Elementary School →						~~2~~ 1		X													
		A	D1-2	72	20			10.00								2		12.5' 14.0' X		TWO SIGNS WERE REMOVED AT THIS LOCATION							9	
NB	1.041	C	VR-017	24	30		LEGAL LOAD LIMIT 24,000 POUNDS; SCHOOL SPEED LIMIT 15 OTHERWISE 25; OVERWEIGHT PERMIT REQUIRED						1		X											BROOK STREET (TH-84)			
		C	VR-017	24	30			5.00			2	2	2			1		16.0' X		PAY FOR REMOVAL					SIGNS SALVAGED ONTO THE NEW POST.		6	
NB	1.049	D	R1-1	30	30		STOP						1		X													
		D	R1-1	30	30			6.25								1		12.75' X									X	
NB	1.064	A	M3-1	24	12		NORTH						1		X													
		A	M1-5	24	24		VERMONT 30						1															
NB	1.100	A	R2-1	24	30		SPEED LIMIT 50						1		X													
		A	R2-1	24	30			5.00								1		13.0' X									X	
NB	1.432	A	W3-5	36	36		SPEED REDUCTION 40-MPH SYMBOL			~~1~~	1	1	1	~~X~~	X			13.0' 13.0' X		POST WERE DAMAGED , SO THEY WERE REPLACED. PAY FOR REMOVAL					~~AS-NEW, RETAIN ALL~~			
NB	1.466	C	VR-017	24	24		LEGAL LOAD LIMIT 24,000 POUNDS; OVERWEIGHT PERMIT REQUIRED						1		X											BROOK STREET (TH-84)			
		C	VR-017	24	30			5.00			1	1	1			1		14.5' X							SIGNS SALVAGED ONTO THE NEW POST.		6	
NB	1.478	D	R1-1	30	30		STOP			~~1~~	1	1	1	~~X~~	X			12.75' X		POST WAS DAMAGED, SO A NEW POST WAS INSTALLED.					AS-NEW, RETAIN ALL PAY FOR REMOVAL			
SIGN SUMMARY SHEET							SHEET TOTALS	32.58	0.00	~~0~~ 2	~~5~~ 0	~~5~~ 0	~~13~~ 7	0	0	6		~~90~~ 121.50										
								SF	SF	EA	EA	EA	EA	EA	EA	EA		FT										
VERMONT AGENCY OF TRANSPORTATION							TOWN DIRECTIONAL TOTALS	261.0	0.0	27.0	0.0	0.0	52	0.0	0.0	47		705.0										

PROJECT NAME: **STATEWIDE SOUTHEAST REGION**
PROJECT NUMBER: **STPG SIGN (31)**

FILE NAME: **NEWFANE NORTHBOUND** PLOT DATE: **8/12/2010**
PROJECT MANAGER: **A. GAMBLE** DRAWN BY: **M. MILLER**
DESIGNED BY: **M. MILLER** CHECKED BY: **A. GAMBLE**
NEWFANE VT-30 NORTHBOUND 2 SHEET **30** OF **175**

DIRECTION	MILEPOINT	LOCATION CODE (SHEET 2)	SIGN CODE	WIDTH (IN)	HEIGHT (IN)	SHEETING REMARKS	SIGN LEGEND	NEW SIGNS "A"	NEW SIGNS "B"	EXISTING SIGNS RETAIN	EXISTING SIGNS SALVAGE FROM	EXISTING SIGNS SALVAGE TO	EXISTING SIGNS REMOVE	EXIST POST RETAIN	EXIST POST REMOVE	NUMBER OF NEW POSTS	SQUARE STEEL (IN) 1.75 (LB / FT) 1.88	SQUARE STEEL (IN) 2.00 (LB / FT) 2.42	SQUARE STEEL (IN) 2.50 (LB / FT) 3.35	TUBULAR STEEL Ø (IN) FOUNDATION	TUBULAR STEEL Ø (IN) 3.00 (LB / FT) 7.60	TUBULAR STEEL Ø (IN) 3.50 (LB / FT) 9.00	TUBULAR STEEL Ø (IN) 4.00 (LB / FT) 10.80	TUBULAR STEEL Ø (IN) 5.00 (LB / FT) 14.60	SIGN FRAME REQUIRED	REMARKS	SIGN DETAIL: DETAIL IN SHS	SIGN DETAIL: DETAIL ON SHEET NUMBER	SIGN DETAIL: DETAIL ON STD SHEET NUMBER
NEWFANE NB							FY-FLUORESCENT YELLOW FYG-FLUORESCENT YELLOW GREEN																			"SHS"-STANDARD HIGHWAY SIGNS			
NB	1.488	A	M3-1	24	12								1		X													
		A	M1-5	24	24								1															
		A	M3-1	24	12		NORTH / VERMONT 30	2.00								1		13.5' X								GREEN ON WHITE	X	
		A	M1-5	24	24			4.00																				E-136B
NB	1.526	A	VW-619	30	30		SHOULDER NARROWS						1		X													
		A	VW-619	36	36			9.00								2		13.5' 14.0' X										5
NB	1.604	A	R2-1	24	30		SPEED LIMIT 40						1		X													
		A	R2-1	30	36			7.50								1		14.0' X								NOTE THAT NEW SIGN IS SLIGHTLY LARGER		6
NB	1.728	A	OM-3R	12	36		RIGHT OBJECT MARKER						~~1~~		~~X~~					SIGNS WERE REMOVED PRIOR TO THE PROJECT.						NOT WARRANTED		
NB	1.737	B	OM-3L	12	36		LEFT OBJECT MARKER						~~1~~		~~X~~											NOT WARRANTED		
NB	1.826	A	R2-1	24	30		SPEED LIMIT 40						1		X													
		A	R2-1	24	30			5.00								1		13.25' X									X	
NB	1.971	A	W1-4R	30	30		RIGHT REVERSE CURVE						1		X													
NB	2.004	A	W1-4R	30	30		0300 1312 0200	6.25								1		13.0' X								INSTALL 175 FT ± NORTH OF PREVIOUS POSITION	X	
NB	2.045	A	VW-054	30	30								1		X													
							SHEET TOTALS	33.75 SF	0.00 SF	0 EA	0 EA	0 EA	~~9~~ 7 EA	0 EA	0 EA	6 EA		~~90~~ 81.25 FT										
							TOWN DIRECTIONAL TOTALS	261.0	0.0	27.0	0.0	0.0	52	0.0	0.0	47		705.0										

SIGN SUMMARY SHEET

VERMONT AGENCY OF TRANSPORTATION

PROJECT NAME: STATEWIDE SOUTHEAST REGION
PROJECT NUMBER: STPG SIGN (31)

FILE NAME: NEWFANE NORTHBOUND
PROJECT MANAGER: A. GAMBLE
DESIGNED BY: M. MILLER
NEWFANE VT-30 NORTHBOUND 3

PLOT DATE: 8/12/2010
DRAWN BY: M. MILLER
CHECKED BY: A. GAMBLE
SHEET 31 OF 175

DIRECTION	MILEPOINT	LOCATION CODE (SHEET 2)	SIGN CODE	WIDTH (IN)	HEIGHT (IN)	SHEETING REMARKS	SIGN LEGEND	NEW SIGNS "A"	NEW SIGNS "B"	EXISTING SIGNS RETAIN	EXISTING SIGNS SALVAGE FROM	EXISTING SIGNS SALVAGE TO	EXISTING SIGNS REMOVE	EXIST POST RETAIN	EXIST POST REMOVE	NUMBER OF NEW POSTS	SQUARE STEEL (IN) 1.75 (LB / FT) 1.88	SQUARE STEEL (IN) 2.00 (LB / FT) 2.42	SQUARE STEEL (IN) 2.50 (LB / FT) 3.35	TUBULAR STEEL Ø (IN) FOUNDATION	TUBULAR STEEL Ø (IN) 3.00 (LB / FT) 7.60	TUBULAR STEEL Ø (IN) 3.50 (LB / FT) 9.00	TUBULAR STEEL Ø (IN) 4.00 (LB / FT) 10.80	TUBULAR STEEL Ø (IN) 5.00 (LB / FT) 14.60	SIGN FRAME REQUIRED	REMARKS	SIGN DETAIL: DETAIL IN SHS	SIGN DETAIL: DETAIL ON SHEET NUMBER	SIGN DETAIL: DETAIL ON STD SHEET NUMBER
NEWFANE NB							FY-FLUORESCENT YELLOW FYG-FLUORESCENT YELLOW GREEN																			"SHS"-STANDARD HIGHWAY SIGNS			
NB	2.045	A	VW-054	30	30			6.25								1		14.25' X										E-154
NB	2.240	C	VR-017	24	30		LEGAL LOAD LIMIT 24000 POUNDS			1				X												BACK STREET (TH-18); NEWFANE-TOWNSHEND STP 2401(1) TO REPLACE IN 2010			
NB	2.250	D	R1-1	30	30		0300 1312 0227 STOP			1				X												NEWFANE-TOWNSHEND STP 2401(1) TO REPLACE IN 2010			
NB	2.267	A	R2-1	24	30								1		X															
		A	R2-1	24	30			5.00								1		13.0' X									X		
NB	2.430	A	W3-5	36	36								1		X															
		A	W3-5	36	36			9.00								2		13.75' 14.0' X									X		
NB	2.527	A	R2-1	24	30								1		X															
		A	R2-1	30	36			7.50								1		14.0' X								NOTE THAT NEW SIGN IS SLIGHTLY LARGER		6	
NB	2.535	C	VR-017	24	30		LEGAL LOAD LIMIT 24000 POUNDS			1				X												BACK STREET (TH-18); NEWFANE-TOWNSHEND STP 2401(1) TO REPLACE IN 2010			
NB	2.545	D	R1-1	30	30		0300 1312 0258 STOP			1				X												NEWFANE-TOWNSHEND STP 2401(1) TO REPLACE IN 2010			
NB	2.551	A	VW-290	30	30								1		X														
		A	W7-3A	24	18								1																
		A	VW-290	30	30			6.25								1		16.5' X									5	
		A	W7-3A	24	18			3.00																			X		
							SHEET TOTALS	37.00 SF	0.00 SF	4 EA	0 EA	0 EA	5 EA	0 EA	0 EA	6 EA		~~90~~ 85.5' FT											
							TOWN DIRECTIONAL TOTALS	261.0	0.0	27.0	0.0	0.0	52	0.0	0.0	47		705.0											

SIGN SUMMARY SHEET

VERMONT AGENCY OF TRANSPORTATION

PROJECT NAME: STATEWIDE SOUTHEAST REGION
PROJECT NUMBER: STPG SIGN (31)

FILE NAME: NEWFANE NORTHBOUND
PROJECT MANAGER: A. GAMBLE
DESIGNED BY: M. MILLER
NEWFANE VT-30 NORTHBOUND 4

PLOT DATE: 8/12/2010
DRAWN BY: M. MILLER
CHECKED BY: A. GAMBLE

DIRECTION	MILEPOINT	LOCATION CODE (SHEET 2)	SIGN CODE	WIDTH (IN)	HEIGHT (IN)	SHEETING REMARKS	SIGN LEGEND	NEW SIGNS "A"	NEW SIGNS "B"	EXISTING SIGNS RETAIN	EXISTING SIGNS SALVAGE FROM	EXISTING SIGNS SALVAGE TO	EXISTING SIGNS REMOVE	EXIST POST RETAIN	EXIST POST REMOVE	NUMBER OF NEW POSTS	SQUARE STEEL (IN) 1.75 (LB / FT) 1.88	SQUARE STEEL (IN) 2.00 (LB / FT) 2.42	SQUARE STEEL (IN) 2.50 (LB / FT) 3.35	TUBULAR STEEL Ø (IN) FOUNDATION	TUBULAR STEEL Ø (IN) 3.00 (LB / FT) 7.60	TUBULAR STEEL Ø (IN) 3.50 (LB / FT) 9.00	TUBULAR STEEL Ø (IN) 4.00 (LB / FT) 10.80	TUBULAR STEEL Ø (IN) 5.00 (LB / FT) 14.60	SIGN FRAME REQUIRED	REMARKS	SIGN DETAIL: DETAIL IN SHS	SIGN DETAIL: DETAIL ON SHEET NUMBER	SIGN DETAIL: DETAIL ON STD SHEET NUMBER
NEWFANE NB							FY-FLUORESCENT YELLOW FYG-FLUORESCENT YELLOW GREEN																			"SHS"-STANDARD HIGHWAY SIGNS			
NB	2.596	A	VD-018	30	18								~~1~~		X													
		A	VD-018	30	18			3.75								1		11.5' X								INSTALL 5 FT ± NORTH OF THE TOWN-INSTALLED "NEWFANE VILLAGE" SIGN, 5 FT ± FROM THE UTILITY POLE		8	
NB	2.645	A	VD-062B	72	16		BUSINESS DIRECTORY SIGN			1				X												FOUR COLUMNS INN <===			
		A	VD-062B	72	16		BUSINESS DIRECTORY SIGN			1																OLDE & NEW ENGLAND <===			
NB	2.724	A	R2-1	24	30								1		X															
		A	R2-1	24	30			5.00								1		13.0' X									X		
NB	2.892	C	VR-017	24	30		LEGAL LOAD LIMIT 24000 POUNDS			1				X												JAIL STREET (SOUTH TH-56) NEWFANE-TOWNSHEND STP 2401(1) TO REPLACE IN 2010			
NB	2.897	D	R1-1	30	30		STOP			1				X												NEWFANE-TOWNSHEND STP 2401(1) TO REPLACE IN 2010			
NB	2.946	C	VR-017	24	30		LEGAL LOAD LIMIT 24000 POUNDS			1				X												JAIL STREET (NORTH TH-56) NEWFANE-TOWNSHEND STP 2401(1) TO REPLACE IN 2010			
NB	2.954	D	R1-1	30	30		STOP			1				X												NEWFANE-TOWNSHEND STP 2401(1) TO REPLACE IN 2010			
NB	2.970	C	VR-017	24	30		LEGAL LOAD LIMIT 24000 POUNDS			1				X												CEMETERY HILL ROAD (TH-16) NEWFANE-TOWNSHEND STP 2401(1) TO REPLACE IN 2010			
NB	2.975	D	R1-1	30	30		STOP			1				X												NEWFANE-TOWNSHEND STP 2401(1) TO REPLACE IN 2010			
NB	3.018	A	R2-1	24	30								1		X															
		A	R2-1	24	30			5.00								1		13.25' X									X		
NB	3.162	A	M3-1	24	12								1		X														
							SHEET TOTALS	13.75	0.00	8	0	0	~~4~~ 3	0	0	3		~~45~~ 37.75											
								SF	SF	EA	EA	EA	EA	EA	EA	EA		FT											
							TOWN DIRECTIONAL TOTALS	261.0	0.0	27.0	0.0	0.0	52	0.0	0.0	47		705.0											

SIGN SUMMARY SHEET

VERMONT AGENCY OF TRANSPORTATION

PROJECT NAME: **STATEWIDE SOUTHEAST REGION**
PROJECT NUMBER: **STPG SIGN (31)**

FILE NAME: **NEWFANE NORTHBOUND** PLOT DATE: **8/12/2010**
PROJECT MANAGER: **A. GAMBLE** DRAWN BY: **M. MILLER**
DESIGNED BY: **M. MILLER** CHECKED BY: **A. GAMBLE**
NEWFANE VT-30 NORTHBOUND 5 SHEET **33** OF **175**

DIRECTION	MILEPOINT	LOCATION CODE (SHEET 2)	SIGN CODE	WIDTH (IN)	HEIGHT (IN)	SHEETING REMARKS	SIGN LEGEND	NEW SIGNS "A"	NEW SIGNS "B"	EXISTING SIGNS RETAIN	EXISTING SIGNS SALVAGE FROM	EXISTING SIGNS SALVAGE TO	EXISTING SIGNS REMOVE	EXIST POST RETAIN	EXIST POST REMOVE	NUMBER OF NEW POSTS	SQUARE STEEL (IN) 1.75 (LB / FT) 1.88	SQUARE STEEL (IN) 2.00 (LB / FT) 2.42	SQUARE STEEL (IN) 2.50 (LB / FT) 3.35	TUBULAR STEEL Ø (IN) FOUNDATION	TUBULAR STEEL Ø (IN) 3.00 (LB / FT) 7.60	TUBULAR STEEL Ø (IN) 3.50 (LB / FT) 9.00	TUBULAR STEEL Ø (IN) 4.00 (LB / FT) 10.80	TUBULAR STEEL Ø (IN) 5.00 (LB / FT) 14.60	SIGN FRAME REQUIRED	REMARKS	SIGN DETAIL: DETAIL IN SHS	SIGN DETAIL: DETAIL ON SHEET NUMBER	SIGN DETAIL: DETAIL ON STD SHEET NUMBER
NEWFANE NB							FY-FLUORESCENT YELLOW FYG-FLUORESCENT YELLOW GREEN																			"SHS"-STANDARD HIGHWAY SIGNS			
		A	M1-5	24	24				1																				
		A	M3-1	24	12		NORTH / VERMONT 30 0300 1312 0320	2.00								1		13.25' X								GREEN ON WHITE	X		
		A	M1-5	24	24			4.00																					E-136B
NB	3.296	A	R2-1	24	30		SPEED LIMIT 40		1						X														
		A	R2-1	24	30			5.00								1		13.75' X									X		
NB	3.333	A	W11-8	30	30		FIRE ENGINE SYMBOL		1						X											NOTE LOCATION OF REMOVAL FOR REFERENCE, FOR REPLACEMENT SIGN AHEAD			
NB	3.368	A	W11-8	30	30			6.25								1		15.0' X								INSTALL 185 FT ± NORTH OF PREVIOUS POSITION; MAINTAIN 10 FT MINIMUM TO UTILITY POLE	X		
NB	3.536	A	R2-1	24	30		SPEED LIMIT 40		1						X														
		A	R2-1	24	30			5.00								1		13.5' X									X		
NB	3.685	A	VD-062B	72	16		BUSINESS DIRECTORY SIGN			1				X												WINDMILL HILL ALPACA FARM ~~LOG CABIN AT ===>~~			
		A	VD-062AL	72	16		BUSINESS DIRECTORY SIGN			1																Z POTS ===>			
NB	3.714	A	W2-2R	30	30		RIGHT SIDE ROAD (SYMBOL)						1		X											TO BE REPLACED FURTHER AHEAD			
NB	3.753	A	VD-062B	72	16		BUSINESS DIRECTORY SIGN			1				X												KENOLIE VILLAGE ==>			
		A	VD-062AS	72	16		BUSINESS DIRECTORY SIGN			1																WEST RIVER LODGE ===>			
		A	VD-062AL	72	16		BUSINESS DIRECTORY SIGN			1																WINCHESTER STABLES ===>			
							SHEET TOTALS	22.25 SF	0.00 SF	5 EA	0 EA	0 EA	5 EA	0 EA	0 EA	4 EA			~~60~~ 55.5 FT										
							TOWN DIRECTIONAL TOTALS	261.0	0.0	27.0	0.0	0.0	52	0.0	0.0	47			705.0										

SIGN SUMMARY SHEET

VERMONT AGENCY OF TRANSPORTATION

PROJECT NAME: **STATEWIDE SOUTHEAST REGION**
PROJECT NUMBER: **STPG SIGN (31)**

FILE NAME: **NEWFANE NORTHBOUND** PLOT DATE: **8/12/2010**
PROJECT MANAGER: **A. GAMBLE** DRAWN BY: **M. MILLER**
DESIGNED BY: **M. MILLER** CHECKED BY: **A. GAMBLE**
NEWFANE VT-30 NORTHBOUND 6 SHEET **34** OF **175**

DIRECTION	MILEPOINT	LOCATION CODE (SHEET 2)	SIGN CODE	WIDTH (IN)	HEIGHT (IN)	SHEETING REMARKS	SIGN LEGEND	NEW SIGNS "A"	NEW SIGNS "B"	EXISTING SIGNS RETAIN	EXISTING SIGNS SALVAGE FROM	EXISTING SIGNS SALVAGE TO	EXISTING SIGNS REMOVE	EXIST POST RETAIN	EXIST POST REMOVE	NUMBER OF NEW POSTS	SQUARE STEEL (IN) 1.75 (LB / FT) 1.88	SQUARE STEEL (IN) 2.00 (LB / FT) 2.42	SQUARE STEEL (IN) 2.50 (LB / FT) 3.35	TUBULAR STEEL Ø (IN) FOUNDATION	TUBULAR STEEL Ø (IN) 3.00 (LB / FT) 7.60	TUBULAR STEEL Ø (IN) 3.50 (LB / FT) 9.00	TUBULAR STEEL Ø (IN) 4.00 (LB / FT) 10.80	TUBULAR STEEL Ø (IN) 5.00 (LB / FT) 14.60	SIGN FRAME REQUIRED	REMARKS	SIGN DETAIL: DETAIL IN SHS	SIGN DETAIL: DETAIL ON SHEET NUMBER	SIGN DETAIL: DETAIL ON STD SHEET NUMBER
NEWFANE NB							FY-FLUORESCENT YELLOW FYG-FLUORESCENT YELLOW GREEN																			"SHS"-STANDARD HIGHWAY SIGNS			
NB	3.778	A	W2-R	30	30			6.25								1		13.25' X								INSTALL 130 FT ± NORTH OF THE (3) BUSINESS SIGNS; **SOME TREE TRIMMING MAY BE REQUIRED**	X		
NB	3.814	A	D1-1A	72	10																					EXISTING SIGN AND POSTS MISSING			
		A	D1-1A	72	12		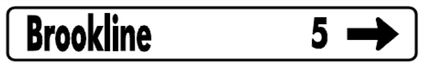	6.00								2		11.25' 11.5' X								INSTALL 190 FT ± NORTH OF THE NEW WARNING SIGN ABOVE		4	
NB	3.882	C	VR-017	24	30		LEGAL LOAD LIMIT 24000 POUNDS			1				X												RADWAY HILL ROAD (TH-4); NEWFANE-TOWNSHEND STP 2401(1) TO REPLACE IN 2010			
NB	3.892	D	R1-1	30	30		0300 1312 0392 STOP			1				X												NEWFANE-TOWNSHEND STP 2401(1) TO REPLACE IN 2010			
NB	3.956	A	M3-1	24	12								1		X														
		A	M1-5	24	24								1																
		A	M3-1	24	12			2.00								1		10.5' X		MILE MARKER RE-INSTALLED ON NEW POST						GREEN ON WHITE	X		
		A	M1-5	24	24			4.00																		SOME TREE BRANCH TRIMMING MAY BE REQUIRED			E-136B
NB	3.993	A	R2-1	24	30								1		X															
		A	R2-1	24	30			5.00								1		13.0' X									X		
NB	4.035	A	W1-5L	30	30								1		X														
		A	W13-1	18	18								1																
		A	W1-5L	30	30	FY	CORRECT CODE, INCORRECT SYMBOL	6.25								1		15.75' X								BOTH NEW SIGNS TO HAVE FLUORESCENT YELLOW SHEETING	X		
		A	W13-1	18	18	FY		2.25																			X		
							SHEET TOTALS	31.75 SF	0.00 SF	2 EA	0 EA	0 EA	5 EA	0 EA	0 EA	6 EA		~~90~~ 75.25 FT											
							TOWN DIRECTIONAL TOTALS	261.0	0.0	27.0	0.0	0.0	52	0.0	0.0	47		705.0											

SIGN SUMMARY SHEET

VERMONT AGENCY OF TRANSPORTATION

PROJECT NAME: **STATEWIDE SOUTHEAST REGION**
PROJECT NUMBER: **STPG SIGN (31)**

FILE NAME: **NEWFANE NORTHBOUND**
PROJECT MANAGER: **A. GAMBLE**
DESIGNED BY: **M. MILLER**
NEWFANE VT-30 NORTHBOUND 7

PLOT DATE: **8/12/2010**
DRAWN BY: **M. MILLER**
CHECKED BY: **A. GAMBLE**
SHEET **35** OF **175**

DIRECTION	MILEPOINT	LOCATION CODE (SHEET 2)	SIGN CODE	WIDTH (IN)	HEIGHT (IN)	SHEETING REMARKS	SIGN LEGEND	NEW SIGNS "A"	NEW SIGNS "B"	EXISTING SIGNS RETAIN	EXISTING SIGNS SALVAGE FROM	EXISTING SIGNS SALVAGE TO	EXISTING SIGNS REMOVE	EXIST POST RETAIN	EXIST POST REMOVE	NUMBER OF NEW POSTS	SQUARE STEEL (IN) 1.75 (LB / FT) 1.88	SQUARE STEEL (IN) 2.00 (LB / FT) 2.42	SQUARE STEEL (IN) 2.50 (LB / FT) 3.35	TUBULAR STEEL Ø (IN) FOUNDATION	TUBULAR STEEL Ø (IN) 3.00 (LB / FT) 7.60	TUBULAR STEEL Ø (IN) 3.50 (LB / FT) 9.00	TUBULAR STEEL Ø (IN) 4.00 (LB / FT) 10.80	TUBULAR STEEL Ø (IN) 5.00 (LB / FT) 14.60	SIGN FRAME REQUIRED	REMARKS	SIGN DETAIL: DETAIL IN SHS	SIGN DETAIL: DETAIL ON SHEET NUMBER	SIGN DETAIL: DETAIL ON STD SHEET NUMBER
NEWFANE NB							FY-FLUORESCENT YELLOW FYG-FLUORESCENT YELLOW GREEN																			"SHS"-STANDARD HIGHWAY SIGNS			
NB	4.390	C	VR-017	24	30		ROAD CLOSED TO THRU TRAFFIC — LEGAL LOAD LIMIT 24000 POUNDS			1				X												UPPER RIVER ROAD (TH-15); NEWFANE-TOWNSHEND STP 2401(1) TO REPLACE IN 2010			
NB	4.390	D	R1-1	30	30		STOP			~~1~~	1	1	1	X												SIGN WAS REMOVED AND RE-INSTALLED SINCE IT ORIGINALLY FACED AWAY FROM MOTORISTS ON THE TOWN HIGNWAY. USED SAME POST (PAY FOR REMOVAL)	NEWFANE-TOWNSHEND STP 2401(1) TO REPLACE IN 2010			
NB	4.458	A	R2-1	24	30		SPEED LIMIT 50						1		X														
		A	R2-1	24	30			5.00								1		15.0' X										X	
NB	4.594	A	W1-2L	30	30								1		X														
		A	W13-1	24	24								1																
		A	W1-2L	30	30			6.25								1		15.0' X										X	
		A	W13-1	24	24		40 MPH	4.00																		NOTE LARGER SIZED PLAQUE COMPARED TO OTHER LOCATIONS; ALSO, INCREASED ADVISORY SPEED		X	
NB	4.652	A	VW-060	30	30		HIDDEN DRIVES						1		X														
		A	VW-060	30	30			6.25								1		14.75' X											E-154
NB	5.009	A	W1-2L	30	30		LEFT CURVE						1		X												TO BE REPLACED WITH A DIFFERENT SYMBOL FURTHER AHEAD			
		A	W13-1	18	18		40 MPH (PLAQUE)						1																
NB	5.056	A	W1-4L	30	30			6.25								1		15.0' X									INSTALL BEHIND RAIL 250 FT ± NORTH OF PREVIOUS LOCATION	X		
		A	W13-1	18	18		40 MPH	2.25																				X	
NB	5.390	A	VW-202	30	30		TRUCKS ENTERING	6.25								1		14.25' X									INSTALL ADJACENT TO THE BEGIN OF THE WHITE SPLIT-RAIL FENCE (RIVER BEND LODGE)			E-154
							SHEET TOTALS	36.25 SF	0.00 SF	~~1~~ 2 EA	~~1~~ 0 EA	~~1~~ 0 EA	~~7~~ 6 EA	0 EA	0 EA	5 EA		~~75~~ 74.0 FT								
							TOWN DIRECTIONAL TOTALS	261.0	0.0	27.0	0.0	0.0	52	0.0	0.0	47		705.0								

SIGN SUMMARY SHEET

VERMONT AGENCY OF TRANSPORTATION

PROJECT NAME: **STATEWIDE SOUTHEAST REGION**
PROJECT NUMBER: **STPG SIGN (31)**

FILE NAME: **NEWFANE NORTHBOUND** PLOT DATE: **8/12/2010**
PROJECT MANAGER: **A. GAMBLE** DRAWN BY: **M. MILLER**
DESIGNED BY: **M. MILLER** CHECKED BY: **A. GAMBLE**
NEWFANE VT-30 NORTHBOUND 8 SHEET **36** OF **175**

DIRECTION	MILEPOINT	LOCATION CODE (SHEET 2)	SIGN CODE	WIDTH (IN)	HEIGHT (IN)	SHEETING REMARKS	SIGN LEGEND	NEW SIGNS "A"	NEW SIGNS "B"	EXISTING SIGNS RETAIN	EXISTING SIGNS SALVAGE FROM	EXISTING SIGNS SALVAGE TO	EXISTING SIGNS REMOVE	EXIST POST RETAIN	EXIST POST REMOVE	NUMBER OF NEW POSTS	SQUARE STEEL (IN) 1.75 (LB / FT) 1.88	SQUARE STEEL (IN) 2.00 (LB / FT) 2.42	SQUARE STEEL (IN) 2.50 (LB / FT) 3.35	TUBULAR STEEL Ø (IN) FOUNDATION	TUBULAR STEEL Ø (IN) 3.00 (LB / FT) 7.60	TUBULAR STEEL Ø (IN) 3.50 (LB / FT) 9.00	TUBULAR STEEL Ø (IN) 4.00 (LB / FT) 10.80	TUBULAR STEEL Ø (IN) 5.00 (LB / FT) 14.60	SIGN FRAME REQUIRED	REMARKS	SIGN DETAIL: DETAIL IN SHS	SIGN DETAIL: DETAIL ON SHEET NUMBER	SIGN DETAIL: DETAIL ON STD SHEET NUMBER
NEWFANE NB							FY-FLUORESCENT YELLOW FYG-FLUORESCENT YELLOW GREEN																			"SHS"-STANDARD HIGHWAY SIGNS			
NB	5.480	A	S1-1	36	36	FYG	SCHOOL w/ CROSSWALK LINES SYMBOL						1		X													
		A	W16-9	24	10	FYG	AHEAD (PLAQUE)						1															
		A	S1-1	36	36	FYG		9.00								2		13.75' 13.75' X								BOTH NEW SIGNS WILL HAVE FLUORESCENT YELLOW-GREEN BACKGROUND SHEETING	X		
		A	S4-3	24	8	FYG		1.33																		SPAN THE PLAQUE ACROSS BOTH POSTS, CENTERED UNDER THE PRIMARY SIGN	X		
NB	5.544	A	VD-062AS	72	16		BUSINESS DIRECTORY SIGN			1				X												CAMPERAMA ===>			
		A	VD-062AS	72	16		0300 1312 BUSINESS DIRECTORY SIGN			1																BALD MTN. <===			
		A	VD-062BRN	72	16		0560 BUSINESS DIRECTORY SIGN			1																TOWNSEND STATE PARK <===			
NB	5.574	A	W1-10R	30	30		CURVE LEFT W/ SIDE ROAD RIGHT SYMBOL						1		X													
		A	W13-1	18	18		40 MPH (PLAQUE)						1															
NB	5.583	A	W1-10R	36	36			9.00								2		14.5' 14.75' X								NOTE: NEW SIGN IS LARGER; INSTALL 50 FEET ± NORTH OF PREVIOUS POSITION	X		
		A	W13-1	18	18			2.25																		INSTALL PLAQUE ON LEFT-SIDE POST	X		
NB	5.620	A	VD-062B	72	16		BUSINESS DIRECTORY SIGN			1				X												REDWING FARM B&B <===			
							SHEET TOTALS	21.58 SF	0.00 SF	4 EA	0 EA	0 EA	4 EA	0 EA	0 EA	4 EA			~~60~~ 56.75 FT									
							TOWN DIRECTIONAL TOTALS	261.0	0.0	27.0	0.0	0.0	52	0.0	0.0	47			705.0									

SIGN SUMMARY SHEET

VERMONT AGENCY OF TRANSPORTATION

PROJECT NAME: **STATEWIDE SOUTHEAST REGION**
PROJECT NUMBER: **STPG SIGN (31)**

FILE NAME: **NEWFANE NORTHBOUND** PLOT DATE: **8/12/2010**
PROJECT MANAGER: **A. GAMBLE** DRAWN BY: **M. MILLER**
DESIGNED BY: **M. MILLER** CHECKED BY: **A. GAMBLE**
NEWFANE VT-30 NORTHBOUND 9 SHEET **37** OF **175**

DIRECTION	MILEPOINT	LOCATION CODE (SHEET 2)	SIGN CODE	WIDTH (IN)	HEIGHT (IN)	SHEETING REMARKS	SIGN LEGEND	NEW SIGNS "A"	NEW SIGNS "B"	EXISTING SIGNS RETAIN	EXISTING SIGNS SALVAGE FROM	EXISTING SIGNS SALVAGE TO	EXISTING SIGNS REMOVE	EXIST POST RETAIN	EXIST POST REMOVE	NUMBER OF NEW POSTS	SQUARE STEEL (IN) 1.75 (LB / FT) 1.88	SQUARE STEEL (IN) 2.00 (LB / FT) 2.42	SQUARE STEEL (IN) 2.50 (LB / FT) 3.35	TUBULAR STEEL Ø (IN) FOUNDATION	TUBULAR STEEL Ø (IN) 3.00 (LB / FT) 7.60	TUBULAR STEEL Ø (IN) 3.50 (LB / FT) 9.00	TUBULAR STEEL Ø (IN) 4.00 (LB / FT) 10.80	TUBULAR STEEL Ø (IN) 5.00 (LB / FT) 14.60	SIGN FRAME REQUIRED	REMARKS	SIGN DETAIL: DETAIL IN SHS	SIGN DETAIL: DETAIL ON SHEET NUMBER	SIGN DETAIL: DETAIL ON STD SHEET NUMBER
NEWFANE SB							FY-FLUORESCENT YELLOW FYG-FLUORESCENT YELLOW GREEN																			"SHS"-STANDARD HIGHWAY SIGNS			
SB	5.277	F	W1-2R	30	30		RIGHT CURVE						1		X											~~INSTALL STOP SIGN ON A SEPARATE POST (MUTCD REQ) 5 - 10 FT ± IN ADVANCE OF THE DO NOT ENTER / ONE WAY SIGNS BELOW.~~			
		F	W13-1	18	18		40 MPH (PLAQUE)						1													~~INSTALL DO NOT ENTER AND ONE WAY SIGNS ON A SEPARATE POST, ACROSS FROM THE OTHER DO NOT ENTER / ONE WAY SIGNS~~			
SB	~~5.182~~ 5.191	F	W1-4L	30	30			6.25								1		14.0' X								INSTALL ~~500~~ 450 FT ± SOUTH OF THE RIGHT CURVE SIGN THAT WAS JUST REMOVED	X		
		F	W13-1	18	18			2.25																			X		
SB	4.861	F	VW-054	30	30								1		X														
		F	W16-2	30	18								1																
		F	VW-054	30	30			6.25								1		14.0' X										E-154
		F	W16-2	24	18			3.00																			X		
SB	4.814	F	W1-2R	30	30		CURVE RIGHT						1		X														
		F	W13-1	18	18		35 MPH PLAQUE						1																
		F	W1-2R	30	30			6.25								1		14.75' X									X		
		F	W13-1	18	18			2.25																		NOTE THAT ADVISORY SPEED IS NOW 40 MPH	X		
SB	4.549	F	R2-5A	24	30		REDUCED SPEED AHEAD						1		X														
		F	W3-5	36	36			9.00								2		13.5' 13.5' X									X		
SB	4.440	F	R2-1	~~30~~ 24	~~36~~ 30								1		X														
							SHEET TOTALS	35.25 SF	0.00 SF	0 EA	0 EA	0 EA	8 EA	0 EA	0 EA	5 EA										~~75~~ 69.75 FT			
							TOWN DIRECTIONAL TOTALS	284.2	0.0	23.0	2.0	2.0	55	0.0	0.0	50										750.0			

SIGN SUMMARY SHEET

VERMONT AGENCY OF TRANSPORTATION

PROJECT NAME: STATEWIDE SOUTHEAST REGION
PROJECT NUMBER: STPG SIGN (31)

FILE NAME: NEWFANE SOUTHBOUND
PROJECT MANAGER: A. GAMBLE
DESIGNED BY: M. MILLER
NEWFANE VT-30 SOUTHBOUND 1

PLOT DATE: 8/12/2010
DRAWN BY: M. MILLER
CHECKED BY: A. GAMBLE

DIRECTION	MILEPOINT	LOCATION CODE (SHEET 2)	SIGN CODE	WIDTH (IN)	HEIGHT (IN)	SHEETING REMARKS	SIGN LEGEND	NEW SIGNS "A"	NEW SIGNS "B"	EXISTING SIGNS RETAIN	EXISTING SIGNS SALVAGE FROM	EXISTING SIGNS SALVAGE TO	EXISTING SIGNS REMOVE	EXIST POST RETAIN	EXIST POST REMOVE	NUMBER OF NEW POSTS	SQUARE STEEL (IN) 1.75 (LB / FT) 1.88	SQUARE STEEL (IN) 2.00 (LB / FT) 2.42	SQUARE STEEL (IN) 2.50 (LB / FT) 3.35	TUBULAR STEEL Ø (IN) FOUNDATION	TUBULAR STEEL Ø (IN) 3.00 (LB / FT) 7.60	TUBULAR STEEL Ø (IN) 3.50 (LB / FT) 9.00	TUBULAR STEEL Ø (IN) 4.00 (LB / FT) 10.80	TUBULAR STEEL Ø (IN) 5.00 (LB / FT) 14.60	SIGN FRAME REQUIRED	REMARKS	SIGN DETAIL: DETAIL IN SHS	SIGN DETAIL: DETAIL ON SHEET NUMBER	SIGN DETAIL: DETAIL ON STD SHEET NUMBER
NEWFANE SB							FY-FLUORESCENT YELLOW FYG-FLUORESCENT YELLOW GREEN																			"SHS"-STANDARD HIGHWAY SIGNS			
SB	4.440	F	R2-1	30	36			7.50								1		14.75' X								~~INSTALL STOP SIGN ON A SEPARATE POST (MUTCD REQ) 5 - 10 FT ± IN ADVANCE OF THE DO NOT ENTER / ONE WAY SIGNS BELOW;~~		6	
SB	4.336	F	W1-5L	30	30	FY		6.25								1		14.5' X								~~INSTALL DO NOT ENTER AND ONE WAY SIGNS ON A SEPARATE POST ACROSS FROM THE OTHER DO NOT ENTER / ONE WAY SIGNS~~	X		
SB	4.032	F	VD-062AL	72	16		BUSINESS DIRECTORY SIGN			1				X												Z POTS <===			
		F	VD-062B	72	16		BUSINESS DIRECTORY SIGN			1																~~WINDMILL HILL LOG CABIN AT <=== ALPACA FARM~~			
SB	3.985	F	D1-1A	72	10																					**EXISTING SIGN AND POSTS MISSING**			
		F	D1-1A	72	12			6.00								2		15.25' 16.75' X								INSTALL 175 FT ± IN ADVANCE OF THE NEXT (3) BUSINESS SIGN ASSEMBLY		4	
SB	3.952	F	VD-062B	72	16		BUSINESS DIRECTORY SIGN			1				X												KENOLIE VILLAGE <===			
		F	VD-062AL	72	16		BUSINESS DIRECTORY SIGN			1																WINCHESTER STABLES <===			
		F	VD-062B	72	16		~~BUSINESS DIRECTORY SIGN~~			1																~~WEST RIVER LODGE <===~~			
SB	3.848	F	M3-3S	24	12								1		X														
		F	M1-5	24	24								1																
		F	M3-3	24	12			2.00								1		13.5' X								GREEN ON WHITE	X		
		F	M1-5	24	24			4.00																					E-136B
SB	3.806	F	VW-060	30	30								1		X														
		F	VW-060	30	30			6.25								1		15.0' X										E-154
SIGN SUMMARY SHEET							SHEET TOTALS	32.00	0.00	5	0	0	3	0	0	6		~~90~~ 89.75'										
								SF	SF	EA	EA	EA	EA	EA	EA	EA		FT										
VERMONT AGENCY OF TRANSPORTATION							TOWN DIRECTIONAL TOTALS	284.2	0.0	23.0	2.0	2.0	55	0.0	0.0	50		750.0										

PROJECT NAME: **STATEWIDE SOUTHEAST REGION**
PROJECT NUMBER: **STPG SIGN (31)**

FILE NAME: **NEWFANE SOUTHBOUND** PLOT DATE: **8/12/2010**
PROJECT MANAGER: **A. GAMBLE** DRAWN BY: **M. MILLER**
DESIGNED BY: **M. MILLER** CHECKED BY: **A. GAMBLE**
NEWFANE VT-30 SOUTHBOUND 2 SHEET **39** OF **175**

DIRECTION	MILEPOINT	LOCATION CODE (SHEET 2)	SIGN CODE	WIDTH (IN)	HEIGHT (IN)	SHEETING REMARKS	SIGN LEGEND	NEW SIGNS "A"	NEW SIGNS "B"	EXISTING SIGNS RETAIN	EXISTING SIGNS SALVAGE FROM	EXISTING SIGNS SALVAGE TO	EXISTING SIGNS REMOVE	EXIST POST RETAIN	EXIST POST REMOVE	NUMBER OF NEW POSTS	SQUARE STEEL (IN) 1.75 (LB / FT) 1.88	SQUARE STEEL (IN) 2.00 (LB / FT) 2.42	SQUARE STEEL (IN) 2.50 (LB / FT) 3.35	TUBULAR STEEL Ø (IN) FOUNDATION	TUBULAR STEEL Ø (IN) 3.00 (LB / FT) 7.60	TUBULAR STEEL Ø (IN) 3.50 (LB / FT) 9.00	TUBULAR STEEL Ø (IN) 4.00 (LB / FT) 10.80	TUBULAR STEEL Ø (IN) 5.00 (LB / FT) 14.60	SIGN FRAME REQUIRED	REMARKS	SIGN DETAIL: DETAIL IN SHS	SIGN DETAIL: DETAIL ON SHEET NUMBER	SIGN DETAIL: DETAIL ON STD SHEET NUMBER
NEWFANE SB							FY-FLUORESCENT YELLOW FYG-FLUORESCENT YELLOW GREEN																			"SHS"-STANDARD HIGHWAY SIGNS			
SB	3.785	F	R2-1	24	30								1		X												~~INSTALL STOP SIGN ON A SEPARATE POST (MUTCD REQ) 5 - 10 FT ± IN ADVANCE OF THE DO NOT ENTER / ONE WAY SIGNS BELOW;~~			
		F	R2-1	24	30			5.00								1		12.5' X								~~INSTALL DO NOT ENTER AND ONE WAY SIGNS ON A SEPARATE POST ACROSS FROM THE OTHER DO NOT ENTER / ONE WAY SIGNS~~	X		
SB	3.605	F	W11-8	30	30								1		X														
		F	W11-8	30	30			6.25								1		14.0' X									X		
SB	3.540	F	R2-1	24	30								1		X														
		F	R2-1	24	30			5.00								1		12.5' X									X		
SB	3.396	F	W3-5	36	36								1		X														
		F	W3-5	36	36			9.00								2		12.5' 14.0' X									X		
SB	3.365	F	VD-018	30	18		NEWFANE BRATTLEBORO 11						1		X												TO BE REPLACED 100 FT ± AHEAD			
SB	3.346	F	VD-018	30	18		0300 1312 0340	3.75								1		12.0' X			MILE MARKER RE-INSTALLED ON NEW POST						INSTALL 100 FT ± SOUTH OF THE PREVIOUS LOCATION		8	
SB	3.296	F	R2-1	24	30								1		X														
		F	R2-1	30	36			7.50								1		14.0' X								NOTE: LARGER SIGN		6	
SB	3.259	F	VW-290	30	30								1		X														
		F	W7-3A	24	18								1																
		F	VW-290	30	30			6.25								1		14.0' X										5	
SIGN SUMMARY SHEET							SHEET TOTALS	42.75 SF	0.00 SF	0 EA	0 EA	0 EA	8 EA	0 EA	0 EA	8 EA		120 ~~105.5~~ FT											
VERMONT AGENCY OF TRANSPORTATION							TOWN DIRECTIONAL TOTALS	284.2	0.0	23.0	2.0	2.0	55	0.0	0.0	50		750.0										

PROJECT NAME: **STATEWIDE SOUTHEAST REGION**
PROJECT NUMBER: **STPG SIGN (31)**

FILE NAME: **NEWFANE SOUTHBOUND** PLOT DATE: **8/12/2010**
PROJECT MANAGER: **A. GAMBLE** DRAWN BY: **M. MILLER**
DESIGNED BY: **M. MILLER** CHECKED BY: **A. GAMBLE**
NEWFANE VT-30 SOUTHBOUND 3 SHEET **40** OF **175**

DIRECTION	MILEPOINT	LOCATION CODE (SHEET 2)	SIGN CODE	WIDTH (IN)	HEIGHT (IN)	SHEETING REMARKS	SIGN LEGEND	NEW SIGNS "A"	NEW SIGNS "B"	EXISTING SIGNS RETAIN	EXISTING SIGNS SALVAGE FROM	EXISTING SIGNS SALVAGE TO	EXISTING SIGNS REMOVE	EXIST POST RETAIN	EXIST POST REMOVE	NUMBER OF NEW POSTS	SQUARE STEEL (IN) 1.75 (LB / FT) 1.88	SQUARE STEEL (IN) 2.00 (LB / FT) 2.42	SQUARE STEEL (IN) 2.50 (LB / FT) 3.35	TUBULAR STEEL Ø (IN) FOUNDATION	TUBULAR STEEL Ø (IN) 3.00 (LB / FT) 7.60	TUBULAR STEEL Ø (IN) 3.50 (LB / FT) 9.00	TUBULAR STEEL Ø (IN) 4.00 (LB / FT) 10.80	TUBULAR STEEL Ø (IN) 5.00 (LB / FT) 14.60	SIGN FRAME REQUIRED	REMARKS	SIGN DETAIL: DETAIL IN SHS	SIGN DETAIL: DETAIL ON SHEET NUMBER	SIGN DETAIL: DETAIL ON STD SHEET NUMBER
NEWFANE SB							FY-FLUORESCENT YELLOW FYG-FLUORESCENT YELLOW GREEN																			"SHS"-STANDARD HIGHWAY SIGNS			
		F	W7-3A	24	18			3.00																		INSTALL STOP SIGN ON A SEPARATE POST (MUTCD REQ) 5 - 10 FT ± IN ADVANCE OF THE DO NOT ENTER / ONE WAY SIGNS BELOW;	X		
SB	3.064	G	VR-017	24	30		SPEED LIMIT 25 LEGAL LOAD LIMIT 24000 POUNDS			1				X												INSTALL DO NOT ENTER AND ONE WAY SIGNS ON A SEPARATE POST ACROSS FROM THE OTHER DO NOT ENTER / ONE WAY SIGNS			
SB	3.058	H	R1-1	30	30		0300 1312 0310 STOP			1				X												NEWFANE-TOWNSHEND STP 2401(1) TO REPLACE IN 2010			
SB	3.021	F	R2-1	24	30		SPEED LIMIT 30						1		X														
		F	R2-1	24	30			5.00								1		13.75' X										X	
SB	2.960	G	VR-345	24	30		NO PARKING ANY TIME NO PARKING HERE TO CORNER						1		X														
		G	R7-1L	12	18			1.50								1		12.0' X									**INSTALLED PARALLEL TO ROUTE 30 IN "G" POSITION**; ARROW DESIGN IN SHS	X		
SB	2.953	G	VR-017	24	30		LEGAL LOAD LIMIT 24000 POUNDS			1				X												COURT STREET (TH-1); NEWFANE-TOWNSHEND STP 2401(1) TO REPLACE IN 2010			
SB	2.948	H	R1-1	30	30		0300 1312 0299 STOP			1				X												NEWFANE-TOWNSHEND STP 2401(1) TO REPLACE IN 2010			
SB	2.902	G	VR-017	24	30		LEGAL LOAD LIMIT 24000 POUNDS			1				X												WEST STREET (TH-1); NEWFANE-TOWNSHEND STP 2401(1) TO REPLACE IN 2010			
SB	2.893	H	R1-1	30	30		0300 1312 0293 STOP			1				X												NEWFANE-TOWNSHEND STP 2401(1) TO REPLACE IN 2010			
SB	2.871	F	M3-3	24	12								1		X														
		F	M1-5	24	24								1																
		F	M3-3	24	12		SOUTH VERMONT 30	2.00								1		13.5' X								GREEN ON WHITE	X		
		F	M1-5	24	24			4.00																					E-136B
SIGN SUMMARY SHEET							SHEET TOTALS	15.50	0.00	6	0	0	4	0	0	3	45											
								SF	SF	EA	EA	EA	EA	EA	EA	EA	~~39.25~~ FT											
VERMONT AGENCY OF TRANSPORTATION							TOWN DIRECTIONAL TOTALS	284.2	0.0	23.0	2.0	2.0	55	0.0	0.0	50	750.0											

PROJECT NAME: **STATEWIDE SOUTHEAST REGION**
PROJECT NUMBER: **STPG SIGN (31)**

FILE NAME: **NEWFANE SOUTHBOUND** PLOT DATE: **8/12/2010**
PROJECT MANAGER: **A. GAMBLE** DRAWN BY: **M. MILLER**
DESIGNED BY: **M. MILLER** CHECKED BY: **A. GAMBLE**
NEWFANE VT-30 SOUTHBOUND 4 SHEET **41** OF **175**

DIRECTION	MILEPOINT	LOCATION CODE (SHEET 2)	SIGN CODE	WIDTH (IN)	HEIGHT (IN)	SHEETING REMARKS	SIGN LEGEND	NEW SIGNS "A"	NEW SIGNS "B"	EXISTING SIGNS RETAIN	EXISTING SIGNS SALVAGE FROM	EXISTING SIGNS SALVAGE TO	EXISTING SIGNS REMOVE	EXIST POST RETAIN	EXIST POST REMOVE	NUMBER OF NEW POSTS	SQUARE STEEL (IN) 1.75 (LB/FT) 1.88	SQUARE STEEL (IN) 2.00 (LB/FT) 2.42	SQUARE STEEL (IN) 2.50 (LB/FT) 3.35	TUBULAR STEEL Ø (IN) FOUNDATION	TUBULAR STEEL Ø (IN) 3.00 (LB/FT) 7.60	TUBULAR STEEL Ø (IN) 3.50 (LB/FT) 9.00	TUBULAR STEEL Ø (IN) 4.00 (LB/FT) 10.80	TUBULAR STEEL Ø (IN) 5.00 (LB/FT) 14.60	SIGN FRAME REQUIRED	REMARKS	SIGN DETAIL: DETAIL IN SHS	SIGN DETAIL: DETAIL ON SHEET NUMBER	SIGN DETAIL: DETAIL ON STD SHEET NUMBER
NEWFANE SB							FY-FLUORESCENT YELLOW FYG-FLUORESCENT YELLOW GREEN																			"SHS"-STANDARD HIGHWAY SIGNS			
SB	2.725	F	R2-1	24	30								1		X												~~INSTALL STOP SIGN ON A SEPARATE POST (MUTCD REQ) 5 - 10 FT ± IN ADVANCE OF THE DO NOT ENTER / ONE WAY SIGNS BELOW;~~			
		F	R2-1	24	30			5.00								1		14.75' X								~~INSTALL DO NOT ENTER AND ONE WAY SIGNS ON A SEPARATE POST ACROSS FROM THE OTHER DO NOT ENTER / ONE WAY SIGNS~~	X		
SB	2.692	G	VR-017	24	30		LEGAL LOAD LIMIT 24000 POUNDS			1				X												LOOP ROAD (TH-76); NEWFANE TOWNSHEND STP 2401(1) TO REPLACE IN 2010			
SB	2.682	H	R1-1	30	30		0300 1312 0272 STOP			1				X												NEWFANE-TOWNSHEND STP 2401(1) TO REPLACE IN 2010			
SB	2.662	F	W2-1M	30	30		CROSSROAD MODIFIED SYMBOL						1		X											REMOVE THE EXISTING SIGN AND POST; THE NEW SYMBOL (BELOW) WILL BE 180 FT ± SOUTH OF THE EXISTING ASSEMBLY;			
SB	2.627	F	W2-1Md	30	30			6.25								1		13.75' X								THIS NEW SPLIT CROSSROAD SYMBOL REPLICATES THE 2009 SHS W2-7R, WHICH IS NOT YET AVAILABLE.		5	
SB	2.568	G	VR-017	24	30		LEGAL LOAD LIMIT 24000 POUNDS			1				X												BRUCE BROOK ROAD (TH-21); NEWFANE-TOWNSHEND STP 2401(1) TO REPLACE IN 2010			
SB	2.560	H	R1-1	30	30		0300 1312 0261 STOP			1				X												NEWFANE-TOWNSHEND STP 2401(1) TO REPLACE IN 2010			
SB	2.528	F	R2-1	24	30								1		X															
		F	R2-1	24	30			5.00								1		12.75' X									X		
SB	2.349	F	W1-4R	30	30		RIGHT REVERSE CURVE (SYMBOL)						1		X											TO BE REPLACED FURTHER AHEAD			
SB	2.275	F	S3-1	30	30		SCHOOL BUS STOP AHEAD						1		X															
		F	W1-4R	30	30			6.25								1		12.5' X								CURVE WARNING SIGN REPLACES THE SCHOOL BUS STOP AHEAD	X		
SB	2.200	F	R2-1	24	30								1		X												~~TO BE REPLACED SLIGHTLY FURTHER AHEAD~~			
		F	R2-1	24	30			5.00								1		14.0' X									X		
SIGN SUMMARY SHEET							SHEET TOTALS	27.50 SF	0.00 SF	4 EA	0 EA	0 EA	6 EA	0 EA	0 EA	5 EA		~~75~~ 67.75 FT											
VERMONT AGENCY OF TRANSPORTATION							TOWN DIRECTIONAL TOTALS	284.2	0.0	23.0	2.0	2.0	55	0.0	0.0	50		750.0										

PROJECT NAME: **STATEWIDE SOUTHEAST REGION**
PROJECT NUMBER: **STPG SIGN (31)**

FILE NAME: **NEWFANE SOUTHBOUND** PLOT DATE: **8/12/2010**
PROJECT MANAGER: **A. GAMBLE** DRAWN BY: **M. MILLER**
DESIGNED BY: **M. MILLER** CHECKED BY: **A. GAMBLE**
NEWFANE VT-30 SOUTHBOUND 5 SHEET **42** OF **175**

DIRECTION	MILEPOINT	LOCATION CODE (SHEET 2)	SIGN CODE	WIDTH (IN)	HEIGHT (IN)	SHEETING REMARKS	SIGN LEGEND	NEW SIGNS "A"	NEW SIGNS "B"	EXISTING SIGNS RETAIN	EXISTING SIGNS SALVAGE FROM	EXISTING SIGNS SALVAGE TO	EXISTING SIGNS REMOVE	EXIST POST RETAIN	EXIST POST REMOVE	NUMBER OF NEW POSTS	SQUARE STEEL (IN) 1.75 (LB/FT) 1.88	SQUARE STEEL (IN) 2.00 (LB/FT) 2.42	SQUARE STEEL (IN) 2.50 (LB/FT) 3.35	TUBULAR STEEL Ø (IN) FOUNDATION	TUBULAR STEEL Ø (IN) 3.00 (LB/FT) 7.60	TUBULAR STEEL Ø (IN) 3.50 (LB/FT) 9.00	TUBULAR STEEL Ø (IN) 4.00 (LB/FT) 10.80	TUBULAR STEEL Ø (IN) 5.00 (LB/FT) 14.60	SIGN FRAME REQUIRED	REMARKS	SIGN DETAIL: DETAIL IN SHS	SIGN DETAIL: DETAIL ON SHEET NUMBER	SIGN DETAIL: DETAIL ON STD SHEET NUMBER
NEWFANE SB							FY-FLUORESCENT YELLOW FYG-FLUORESCENT YELLOW GREEN																			"SHS"-STANDARD HIGHWAY SIGNS			
SB	1.828	F	R2-1	24	30		SPEED LIMIT 40						1		X											~~INSTALL STOP SIGN ON A SEPARATE POST (MUTCD REQ) 5 - 10 FT ± IN ADVANCE OF THE DO NOT ENTER / ONE WAY SIGNS BELOW;~~			
		F	R2-1	24	30			5.00								1	12.75' X									~~INSTALL DO NOT ENTER AND ONE WAY SIGNS ON A SEPARATE POST ACROSS FROM THE OTHER DO NOT ENTER / ONE WAY SIGNS~~	X		
SB	1.738	F	OM-3R	12	36		RIGHT OBJECT MARKER						~~1~~		~~X~~					SIGN WAS REMOVED PRIOR TO PROJECT						NOT WARRANTED			
SB	1.730	E	OM-3L	12	36		LEFT OBJECT MARKER						~~1~~		~~X~~					SIGN WAS REMOVED PRIOR TO PROJECT						NOT WARRANTED			
SB	1.659	G	VR-017	24	30		LEGAL LOAD LIMIT 24000 POUNDS			1							X									BROWNS ROAD (TH-45); NEWFANE-TOWNSHEND STP 2401(1) TO REPLACE IN 2010			
SB	1.652	H	R1-1	30	30		Browns RD TH#22 0300 1312 ~~0160~~ STOP			1							X									NEWFANE-TOWNSHEND STP 2401(1) TO REPLACE IN 2010			
SB	1.607	F	R2-1	24	30		SPEED LIMIT 50						1		X														
		F	R2-1	24	30			5.00								1	12.5' X										X		
SB	~~1.457~~ 1.471	F	M3-3	24	12								1		X														
		F	M1-5	24	24								1																
		F	M3-3	24	12		SOUTH	2.00								1	13.25' X									GREEN ON WHITE	X		
		F	M1-5	24	24		VERMONT 30	4.00																		MOVED 75' SOUTH			E-136B
SB	1.434	F	R2-1	24	30		SPEED LIMIT 50						1		X														
		F	R2-1	24	30			5.00								1	13.0' X										X		
SB	1.156	F	S2-1	36	36		SCHOOL ZONE (WITH CROSSWALK LINES)						1		X														
							SHEET TOTALS	21.00	0.00	2	0	0	~~6~~ 8	0	0	4	51.5 ~~60~~												
								SF	SF	EA	EA	EA	EA	EA	EA	EA	FT												
							TOWN DIRECTIONAL TOTALS	284.2	0.0	23.0	2.0	2.0	55	0.0	0.0	50	750.0												

SIGN SUMMARY SHEET

VERMONT AGENCY OF TRANSPORTATION

PROJECT NAME: STATEWIDE SOUTHEAST REGION
PROJECT NUMBER: STPG SIGN (31)

FILE NAME: NEWFANE SOUTHBOUND
PROJECT MANAGER: A. GAMBLE
DESIGNED BY: M. MILLER
NEWFANE VT-30 SOUTHBOUND 6

PLOT DATE: 8/12/2010
DRAWN BY: M. MILLER
CHECKED BY: A. GAMBLE

DIRECTION	MILEPOINT	LOCATION CODE (SHEET 2)	SIGN CODE	WIDTH (IN)	HEIGHT (IN)	SHEETING REMARKS	SIGN LEGEND	NEW SIGNS "A"	NEW SIGNS "B"	EXISTING SIGNS RETAIN	EXISTING SIGNS SALVAGE FROM	EXISTING SIGNS SALVAGE TO	EXISTING SIGNS REMOVE	EXIST POST RETAIN	EXIST POST REMOVE	NUMBER OF NEW POSTS	SQUARE STEEL (IN) 1.75 (LB / FT) 1.88	SQUARE STEEL (IN) 2.00 (LB / FT) 2.42	SQUARE STEEL (IN) 2.50 (LB / FT) 3.35	TUBULAR STEEL Ø (IN) FOUNDATION	TUBULAR STEEL Ø (IN) 3.00 (LB / FT) 7.60	TUBULAR STEEL Ø (IN) 3.50 (LB / FT) 9.00	TUBULAR STEEL Ø (IN) 4.00 (LB / FT) 10.80	TUBULAR STEEL Ø (IN) 5.00 (LB / FT) 14.60	SIGN FRAME REQUIRED	REMARKS	SIGN DETAIL: DETAIL IN SHS	SIGN DETAIL: DETAIL ON SHEET NUMBER	SIGN DETAIL: DETAIL ON STD SHEET NUMBER
NEWFANE SB							FY-FLUORESCENT YELLOW FYG-FLUORESCENT YELLOW GREEN																			"SHS"-STANDARD HIGHWAY SIGNS			
SB	1.156	F	W16-9	36	20		AHEAD (PLAQUE)						1													~~INSTALL STOP SIGN ON A SEPARATE POST (MUTCD REQ) 5 - 10 FT ± IN ADVANCE OF THE DO NOT ENTER / ONE WAY SIGNS BELOW;~~			
		F	S1-1	36	36	FYG		9.00								2		12.75' 13.25' X								~~INSTALL DO NOT ENTER AND ONE WAY SIGNS ON A SEPARATE POST ACROSS FROM THE OTHER DO NOT ENTER / ONE WAY SIGNS~~	X		
		F	S4-3P	24	8	FYG	SCHOOL	1.33																		SPAN THE PLAQUE ACROSS BOTH POSTS, CENTERED UNDER THE PRIMARY SIGN	X		
SB	1.118	F	D1-2	72	20		Newbrook ~~Newfane~~ Elementary School						~~2~~ 1		X											2 SIGNS WERE REMOVED AT THIS LOCATION			
		F	D1-2	72	20			10.00								2		13.0' 13.5' X										9	
SB	1.034	F	M3-3	24	12		SOUTH						1		X														
		F	M1-5	24	24		VERMONT 30						1																
SB	0.996	F	R2-1	24	30		~~0300~~ ~~1312~~ ~~0100~~ SPEED LIMIT 50						1		X														
SB	0.940	F	VD-062AS	72	16		BUSINESS DIRECTORY SIGN			1				X													OLALLIE DAYLILY GRDN. ===>			
SB	0.876	F	D1-1A	72	12						1		1		X											PAY FOR THE SALVAGED SIGNS TO BE REMOVED.			
		F	D1-1A	72	12						1		1															
		F	D1-1A	72	12		Williamsville 2 →					1				2		13.5' 14.5' X								SALVAGE BOTH SIGNS ONTO A NEW SET OF POSTS			
		F	D1-1A	72	12		South Newfane 4 →					1																
SB	0.840	G	VR-017	24	24		LEGAL LOAD LIMIT 24,000 POUNDS OVERWEIGHT PERMIT REQUIRED						~~2~~ 1		X												GRIMES HILL ROAD (TH-5)			
		G	VR-017	24	30			5.00								1		13.0' X								PERMIT SIGN SALVAGED ONTGO THE NEW POST.		6	
							SHEET TOTALS	25.33	0.00	1	~~3~~ ~~2~~	~~3~~ ~~2~~	~~10~~ ~~6~~	0	0	7		93.5' ~~105~~										
								SF	SF	EA	EA	EA	EA	EA	EA	EA		FT										
							TOWN DIRECTIONAL TOTALS	284.2	0.0	23.0	2.0	2.0	55	0.0	0.0	50		750.0										

SIGN SUMMARY SHEET

VERMONT AGENCY OF TRANSPORTATION

PROJECT NAME: STATEWIDE SOUTHEAST REGION
PROJECT NUMBER: STPG SIGN (31)

FILE NAME: NEWFANE SOUTHBOUND
PROJECT MANAGER: A. GAMBLE
DESIGNED BY: M. MILLER
NEWFANE VT-30 SOUTHBOUND 7

PLOT DATE: 8/12/2010
DRAWN BY: M. MILLER
CHECKED BY: A. GAMBLE

DIRECTION	MILEPOINT	LOCATION CODE (SHEET 2)	SIGN CODE	WIDTH (IN)	HEIGHT (IN)	SHEETING REMARKS	SIGN LEGEND	NEW SIGNS "A"	NEW SIGNS "B"	EXISTING SIGNS RETAIN	EXISTING SIGNS SALVAGE FROM	EXISTING SIGNS SALVAGE TO	EXISTING SIGNS REMOVE	EXIST POST RETAIN	EXIST POST REMOVE	NUMBER OF NEW POSTS	SQUARE STEEL (IN) 1.75 (LB / FT) 1.88	SQUARE STEEL (IN) 2.00 (LB / FT) 2.42	SQUARE STEEL (IN) 2.50 (LB / FT) 3.35	TUBULAR STEEL Ø (IN) FOUNDATION	TUBULAR STEEL Ø (IN) 3.00 (LB / FT) 7.60	TUBULAR STEEL Ø (IN) 3.50 (LB / FT) 9.00	TUBULAR STEEL Ø (IN) 4.00 (LB / FT) 10.80	TUBULAR STEEL Ø (IN) 5.00 (LB / FT) 14.60	SIGN FRAME REQUIRED	REMARKS	SIGN DETAIL: DETAIL IN SHS	SIGN DETAIL: DETAIL ON SHEET NUMBER	SIGN DETAIL: DETAIL ON STD SHEET NUMBER
NEWFANE SB							FY-FLUORESCENT YELLOW FYG-FLUORESCENT YELLOW GREEN																			"SHS"-STANDARD HIGHWAY SIGNS			
SB	0.832	H	R1-1	30	30		GRIMES HILL RD TH 5 STOP 0300 1312 0080			~~1~~	1	1	1	~~X~~	X	1		12.5' X								STREET SIGN WAS SALVAGED ONTO THE NEW POST ALSO MILE MARKER.	~~INSTALL STOP SIGN ON A SEPARATE POST (MUTCD REQ) 5 - 10 FT ± IN ADVANCE OF THE DO NOT ENTER / ONE WAY SIGNS BELOW;~~			
		H	R1-1	30	30			6.25								1		X								~~INSTALL DO NOT ENTER AND ONE WAY SIGNS ON A SEPARATE POST ACROSS FROM THE OTHER DO NOT ENTER / ONE WAY SIGNS~~	X		
SB	0.812	F	M3-3	24	12		SOUTH VERMONT 30	2.00								1		13.5' X								**GREEN ON WHITE**	X		
		F	M1-5	24	24			4.00																		INSTALL 100 FEET ± SOUTH OF THE JCT WITH GRIMES HILL ROAD (TH-5)			E-136B
SB	0.802	F	R2-1	24	30		SPEED LIMIT 50	5.00								1		13.5' X								INSTALL 100 FEET ± SOUTH OF THE NEW ROUTE MARKER SIGNS ABOVE	X		
SB	0.570	G	R5-1	30	30								1		X											SEARS ROAD (TH-44) THIS ROAD IS A ONE-WAY EXIT			
		F	R6-1L	36	12						MISSING		~~1~~													THIS ASSEMBLY IS LOCATED ON THE NORTHERLY SIDE OF TH-44			
		E	R6-1R	36	12						MISSING		~~1~~																
		G	R5-1	30	30		DO NOT ENTER	6.25								1		13.25' X									X		
		F	R6-1L	36	12		ONE WAY	3.00																			X		
		E	R6-1R	36	12		ONE WAY	3.00																			X		
SB	0.566	G	R5-1	30	30		DO NOT ENTER						1		X											SEARS ROAD (TH-44) THIS ROAD IS A ONE-WAY EXIT			
		H	R1-1	30	30		STOP						1																
		F	R6-1L	36	12		ONE WAY (LEFT ARROW)						1																
		E	R6-1R	36	12		ONE WAY (RIGHT ARROW)						1																
							SHEET TOTALS	29.50	0.00	1	~~1~~ 0	~~1~~ 0	~~6~~ 7	0	0	4		~~52.75~~ 60										
								SF	SF	EA	EA	EA	EA	EA	EA	EA		FT										
							TOWN DIRECTIONAL TOTALS	284.2	0.0	23.0	2.0	2.0	55	0.0	0.0	50		750.0										

SIGN SUMMARY SHEET

VERMONT AGENCY OF TRANSPORTATION

PROJECT NAME: **STATEWIDE SOUTHEAST REGION**
PROJECT NUMBER: **STPG SIGN (31)**

FILE NAME: **NEWFANE SOUTHBOUND** PLOT DATE: **8/12/2010**
PROJECT MANAGER: **A. GAMBLE** DRAWN BY: **M. MILLER**
DESIGNED BY: **M. MILLER** CHECKED BY: **A. GAMBLE**
NEWFANE VT-30 SOUTHBOUND 8 SHEET **45** OF **175**

DIRECTION	MILEPOINT	LOCATION CODE (SHEET 2)	SIGN CODE	WIDTH (IN)	HEIGHT (IN)	SHEETING REMARKS	SIGN LEGEND	NEW SIGNS "A"	NEW SIGNS "B"	EXISTING SIGNS RETAIN	EXISTING SIGNS SALVAGE FROM	EXISTING SIGNS SALVAGE TO	EXISTING SIGNS REMOVE	EXIST POST RETAIN	EXIST POST REMOVE	NUMBER OF NEW POSTS	SQUARE STEEL (IN) 1.75 (LB / FT) 1.88	SQUARE STEEL (IN) 2.00 (LB / FT) 2.42	SQUARE STEEL (IN) 2.50 (LB / FT) 3.35	TUBULAR STEEL Ø (IN) FOUNDATION	TUBULAR STEEL Ø (IN) 3.00 (LB / FT) 7.60	TUBULAR STEEL Ø (IN) 3.50 (LB / FT) 9.00	TUBULAR STEEL Ø (IN) 4.00 (LB / FT) 10.80	TUBULAR STEEL Ø (IN) 5.00 (LB / FT) 14.60	SIGN FRAME REQUIRED	REMARKS	SIGN DETAIL: DETAIL IN SHS	SIGN DETAIL: DETAIL ON SHEET NUMBER	SIGN DETAIL: DETAIL ON STD SHEET NUMBER
NEWFANE SB							FY-FLUORESCENT YELLOW FYG-FLUORESCENT YELLOW GREEN																			"SHS"-STANDARD HIGHWAY SIGNS			
SB	0.566	H	R1-1	30	30			6.25								1		13.25' X								INSTALL STOP SIGN ON A SEPARATE POST (MUTCD REQ) 5 - 10 FT ± IN ADVANCE OF THE DO NOT ENTER / ONE WAY SIGNS BELOW;	X		
		G	R5-1	30	30			6.25								1		13.0' X								INSTALL DO NOT ENTER AND ONE WAY SIGNS ON A SEPARATE POST, ACROSS FROM THE OTHER DO NOT ENTER / ONE WAY SIGNS	X		
		F	R6-1L	36	12			3.00																		LOCATED ON THE SOUTHERLY SIDE OF TH-44	X		
		E	R6-1R	36	12			3.00																			X		
SB	0.530	F	W7-1	30	30			6.25								1		14.25' X								INSTALL 190 FT ± SOUTH OF JCT WITH TH-44 ABOVE	X		
		F	W7-3A	24	18			3.00																			X		
SB	0.463	F	W7-1	30	30		0300 1312 0040 HILL (SYMBOL)						1		X											MILE MARKER WAS DISCARDED.			
SB	0.389	G	VR-017	24	30								1		X											WILDWOOD ACRES RD (NORTH) (TH-75)			
		G	VR-017	24	30			5.00								1		11.5' X								SOME TREE BRANCH REMOVAL MAY BE REQUIRED		6	
SB	0.383	H	R1-1	30	30		STOP			~~1~~	1	1	1	~~X~~	X	1		13.0' X								POST WAS DAMAGED, SO IT WAS REPLACED. INSTALLED IN 2007			
SB	0.177	G	VR-017	24	30								1		X											WILDWOOD ACRES RD (SOUTH) (TH-75)			
		G	VR-017	24	30			5.00								1		11.5' X										6	
SB	0.166	H	R1-1	30	30					~~1~~			1	X															
		H	R1-1	30	30			6.25								1		12.5' X									X		
SB	0.156	F	W1-10L	30	30								1		X														
SIGN SUMMARY SHEET							SHEET TOTALS	44.00	0.00	~~0~~ 2	~~1~~ 0	~~1~~ 0	~~6~~ 4	0	0	6		89.0 90											
								SF	SF	EA	EA	EA	EA	EA	EA	EA		FT											
VERMONT AGENCY OF TRANSPORTATION							TOWN DIRECTIONAL TOTALS	284.2	0.0	23.0	2.0	2.0	55	0.0	0.0	50		750.0											

PROJECT NAME: **STATEWIDE SOUTHEAST REGION**
PROJECT NUMBER: **STPG SIGN (31)**

FILE NAME: **NEWFANE SOUTHBOUND** PLOT DATE: **8/12/2010**
PROJECT MANAGER: **A. GAMBLE** DRAWN BY: **M. MILLER**
DESIGNED BY: **M. MILLER** CHECKED BY: **A. GAMBLE**
NEWFANE VT-30 SOUTHBOUND 9 SHEET **46** OF **175**

DIRECTION	MILEPOINT	LOCATION CODE (SHEET 2)	SIGN CODE	WIDTH (IN)	HEIGHT (IN)	SHEETING REMARKS	SIGN LEGEND	NEW SIGNS "A"	NEW SIGNS "B"	EXISTING SIGNS RETAIN	EXISTING SIGNS SALVAGE FROM	EXISTING SIGNS SALVAGE TO	EXISTING SIGNS REMOVE	EXIST POST RETAIN	EXIST POST REMOVE	NUMBER OF NEW POSTS	SQUARE STEEL (IN) 1.75 (LB / FT) 1.88	SQUARE STEEL (IN) 2.00 (LB / FT) 2.42	SQUARE STEEL (IN) 2.50 (LB / FT) 3.35	TUBULAR STEEL Ø (IN) FOUNDATION	TUBULAR STEEL Ø (IN) 3.00 (LB / FT) 7.60	TUBULAR STEEL Ø (IN) 3.50 (LB / FT) 9.00	TUBULAR STEEL Ø (IN) 4.00 (LB / FT) 10.80	TUBULAR STEEL Ø (IN) 5.00 (LB / FT) 14.60	SIGN FRAME REQUIRED	REMARKS	SIGN DETAIL: DETAIL IN SHS	SIGN DETAIL: DETAIL ON SHEET NUMBER	SIGN DETAIL: DETAIL ON STD SHEET NUMBER
NEWFANE SB							FY-FLUORESCENT YELLOW FYG-FLUORESCENT YELLOW GREEN																			"SHS"-STANDARD HIGHWAY SIGNS			
SB	0.156	F	W16-8A	36	18								1													~~INSTALL STOP SIGN ON A SEPARATE POST (MUTCD REQ) 5 - 10 FT ± IN ADVANCE OF THE DO NOT ENTER / ONE WAY SIGNS BELOW;~~			
		F	W1-10L	36	36			9.00								2		15.25' 15.25' X								~~INSTALL DO NOT ENTER AND ONE WAY SIGNS ON A SEPARATE POST, ACROSS FROM THE OTHER DO NOT ENTER / ONE WAY SIGNS~~	X		
		F	W16-8	42	8		Williamsville Rd	2.33																		SPAN PLAQUE ACROSS BOTH POSTS		7	
SB	0.076	F	W11-2	30	30	FYG	PEDESTRIAN SYMBOL			1				X												AS-NEW; RETAIN ALL			
		F	W16-4	24	18	FYG	NEXT 600 FT (PLAQUE)			1																			
SIGN SUMMARY SHEET							SHEET TOTALS	11.33	0.00	2	0	0	1	0	0	2		~~30~~ 30.5										
VERMONT AGENCY OF TRANSPORTATION								SF	SF	EA	EA	EA	EA	EA	EA	EA		FT										
							TOWN DIRECTIONAL TOTALS	284.2	0.0	23.0	2.0	2.0	55	0.0	0.0	50		750.0										

PROJECT NAME: **STATEWIDE SOUTHEAST REGION**
PROJECT NUMBER: **STPG SIGN (31)**

FILE NAME: **NEWFANE SOUTHBOUND** PLOT DATE: **8/12/2010**
PROJECT MANAGER: **A. GAMBLE** DRAWN BY: **M. MILLER**
DESIGNED BY: **M. MILLER** CHECKED BY: **A. GAMBLE**
NEWFANE VT-30 SOUTHBOUND 10 SHEET **47** OF **175**

DIRECTION	MILEPOINT	LOCATION CODE (SHEET 2)	SIGN CODE	WIDTH (IN)	HEIGHT (IN)	SHEETING REMARKS	SIGN LEGEND	NEW SIGNS "A"	NEW SIGNS "B"	EXISTING SIGNS RETAIN	EXISTING SIGNS SALVAGE FROM	EXISTING SIGNS SALVAGE TO	EXISTING SIGNS REMOVE	EXIST POST RETAIN	EXIST POST REMOVE	NUMBER OF NEW POSTS	SQUARE STEEL (IN) 1.75 (LB / FT) 1.88	SQUARE STEEL (IN) 2.00 (LB / FT) 2.42	SQUARE STEEL (IN) 2.50 (LB / FT) 3.35	TUBULAR STEEL Ø (IN) FOUNDATION	TUBULAR STEEL Ø (IN) 3.00 (LB / FT) 7.60	TUBULAR STEEL Ø (IN) 3.50 (LB / FT) 9.00	TUBULAR STEEL Ø (IN) 4.00 (LB / FT) 10.80	TUBULAR STEEL Ø (IN) 5.00 (LB / FT) 14.60	SIGN FRAME REQUIRED	REMARKS	SIGN DETAIL: DETAIL IN SHS	SIGN DETAIL: DETAIL ON SHEET NUMBER	SIGN DETAIL: DETAIL ON STD SHEET NUMBER
TOWNSHEND NB							FY-FLUORESCENT YELLOW FYG-FLUORESCENT YELLOW GREEN																			"SHS"-STANDARD HIGHWAY SIGNS			
NB	0.000	C	VD-024	60	7.5								1		X													
		C	VD-700	6	10								1															
		C	VD-700	6	10								1															
		C	VD-024	72	10		Townshend / Newfane	5.00								2		12.75' 13.0' X								REPLACE IN SAME LOCATION AS REMOVAL		4	
		C	VD-700	6	10		0300 1317 0000 / 0300 1312 0566	0.42																		TOWNSHEND MILE MARKER; INSTALL ON LEFT POST UNDER TOWNSHEND		4	
		C	VD-700	6	10			0.42																		NEWFANE MILE MARKER; INSTALL ON RIGHT POST UNDER NEWFANE		4	
NB	0.445	C	VR-017	24	30		LEGAL LOAD LIMIT 24,000 POUNDS			1			~~1~~	X	~~X~~											SING WAS DAMAGED IN SPRING 2011. IT WAS REPLACED BY THE STATE SIGN CREW IN EARLY AUGUST 2011			
		C	VR-017	24	30			~~5.00~~								~~1~~		~~X~~								ELLEN WARE RD (TH-33)		6	
NB	0.451	D	R1-1	30	30		STOP			1			~~1~~	X	~~X~~												REPLACED IN 2010 AS PART OF NEWFANE-TOWNSHEND STP2401(1)			
		D	R1-1	30	30			~~6.25~~								~~1~~		~~X~~									X		
NB	0.911	A	R2-5A	24	30		SPEED LIMIT 35 REDUCED SPEED AHEAD						~~1~~		~~X~~											OLD SIGN WAS MISSING			
		A	W3-5	36	36			9.00								2		14.0' 15.0' X									X		
NB	0.958	A	VD-018	30	18		Harmonyville Townshend 1						1		X															
		A	VD-018	30	18			3.75								1		13.0' X										8	
NB	0.973	C	VR-017	24	30		LEGAL LOAD LIMIT 24000 POUNDS			1				X												PLUMB ROAD (TH-32); NEWFANE-TOWNSHEND STP 2401(1) TO REPLACE IN 2010			
							SHEET TOTALS	~~18.59~~ ~~29.84~~ SF	0.00 SF	1 EA	0 EA	0 EA	~~4~~ ~~7~~ EA	0 EA	0 EA	7 EA	~~67.75'~~ ~~105~~ FT								
							TOWN DIRECTIONAL TOTALS	334.0	0.0	25.0	0.0	0.0	81	0.0	0.0	54	810.0								

SIGN SUMMARY SHEET

VERMONT AGENCY OF TRANSPORTATION

PROJECT NAME: STATEWIDE SOUTHEAST REGION
PROJECT NUMBER: STPG SIGN (31)

FILE NAME: TOWNSHEND NORTHBOUND
PROJECT MANAGER: A. GAMBLE
DESIGNED BY: M. MILLER
TOWNSHEND VT-30 NORTHBOUND 1

PLOT DATE: 8/12/2010
DRAWN BY: M. MILLER
CHECKED BY: A. GAMBLE

DIRECTION	MILEPOINT	LOCATION CODE (SHEET 2)	SIGN CODE	WIDTH (IN)	HEIGHT (IN)	SHEETING REMARKS	SIGN LEGEND	NEW SIGNS "A"	NEW SIGNS "B"	EXISTING SIGNS RETAIN	EXISTING SIGNS SALVAGE FROM	EXISTING SIGNS SALVAGE TO	EXISTING SIGNS REMOVE	EXIST POST RETAIN	EXIST POST REMOVE	NUMBER OF NEW POSTS	SQUARE STEEL (IN) 1.75 (LB / FT) 1.88	SQUARE STEEL (IN) 2.00 (LB / FT) 2.42	SQUARE STEEL (IN) 2.50 (LB / FT) 3.35	TUBULAR STEEL Ø (IN) FOUNDATION	TUBULAR STEEL Ø (IN) 3.00 (LB / FT) 7.60	TUBULAR STEEL Ø (IN) 3.50 (LB / FT) 9.00	TUBULAR STEEL Ø (IN) 4.00 (LB / FT) 10.80	TUBULAR STEEL Ø (IN) 5.00 (LB / FT) 14.60	SIGN FRAME REQUIRED	REMARKS	SIGN DETAIL: DETAIL IN SHS	SIGN DETAIL: DETAIL ON SHEET NUMBER	SIGN DETAIL: DETAIL ON STD SHEET NUMBER
TOWNSHEND NB							FY-FLUORESCENT YELLOW FYG-FLUORESCENT YELLOW GREEN																			"SHS"-STANDARD HIGHWAY SIGNS			
NB	0.982	D	R1-1	30	30		0300 1317 0096 STOP			1				X												NEWFANE-TOWNSHEND STP 2401(1) TO REPLACE IN 2010			
NB	0.997	A	VW-054	30	30		HIDDEN DRIVE RIGHT						1		X											SIGHT DISTANCE TO DRIVE IS OK			
NB	1.050	A	R2-1	24	30		SPEED LIMIT 35						1		X														
		A	R2-1	30	36			7.50								1		13.5' X								NOTE LARGER SIZE		6	
NB	1.277	C	VR-017	24	30		SPEED LIMIT 30 LEGAL LOAD LIMIT 24000 POUNDS			~~2~~ 1				X												SAW DUST ALLEY (TH-70); NEWFANE TOWNSHEND STP 2401(1) TO REPLACE IN 2010			
NB	1.285	D	R1-1	30	30		0300 1317 0126 STOP			1				X												NEWFANE-TOWNSHEND STP 2401(1) TO REPLACE IN 2010			
NB	1.293	A	W2-1	30	30		OFFSET CROSSROAD (SYMBOL)						1		X											REMOVE ALL			
		A	W5-2	30	30		NARROW BRIDGE (TEXT)						1													NEXT ENTRY REFERENCING THIS REMOVAL POINT			
NB	1.306	A	W1-2L	30	30			6.25								1		14.25' X								INSTALL 70 FEET ± NORTH OF THE TWO-SIGN ASSEMBLY JUST REMOVED	X		
NB	1.333	A	S3-1	30	30		SCHOOL BUS STOP AHEAD						1		X														
NB	1.393	C	VR-017	24	30		LEGAL LOAD LIMIT 24000 POUNDS			1				X												EAST HILL ROAD (TH-25); NEWFANE-TOWNSHEND STP 2401(1) TO REPLACE IN 2010			
NB	1.399	D	R1-1	30	30		0300 1317 0140 STOP			1				X												NEWFANE-TOWNSHEND STP 2401(1) TO REPLACE IN 2010			
NB	1.527	A	VD-062B	72	16		BUSINESS DIRECTORY SIGN			1				X												GRACE COTTAGE HOSP. ===>			
		A	VD-062B	72	16		BUSINESS DIRECTORY SIGN			1				X												SECOND CHANCE ===>			
		A	VD-062B	72	16		BUSINESS DIRECTORY SIGN			1				X												OLD FARMHOUSE B&B ===>			
							SHEET TOTALS	13.75 SF	0.00 SF	8 EA	0 EA	0 EA	5 EA	0 EA	0 EA	2 EA		~~30~~ 27.75 FT										
							TOWN DIRECTIONAL TOTALS	334.0	0.0	25.0	0.0	0.0	81	0.0	0.0	54		810.0										

SIGN SUMMARY SHEET

VERMONT AGENCY OF TRANSPORTATION

PROJECT NAME: STATEWIDE SOUTHEAST REGION
PROJECT NUMBER: STPG SIGN (31)

FILE NAME: TOWNSHEND NORTHBOUND
PROJECT MANAGER: A. GAMBLE
DESIGNED BY: M. MILLER
TOWNSHEND VT-30 NORTHBOUND 2

PLOT DATE: 8/12/2010
DRAWN BY: M. MILLER
CHECKED BY: A. GAMBLE

DIRECTION	MILEPOINT	LOCATION CODE (SHEET 2)	SIGN CODE	WIDTH (IN)	HEIGHT (IN)	SHEETING REMARKS	SIGN LEGEND	NEW SIGNS "A"	NEW SIGNS "B"	EXISTING SIGNS RETAIN	EXISTING SIGNS SALVAGE FROM	EXISTING SIGNS SALVAGE TO	EXISTING SIGNS REMOVE	EXIST POST RETAIN	EXIST POST REMOVE	NUMBER OF NEW POSTS	SQUARE STEEL (IN) 1.75 (LB / FT) 1.88	SQUARE STEEL (IN) 2.00 (LB / FT) 2.42	SQUARE STEEL (IN) 2.50 (LB / FT) 3.35	TUBULAR STEEL Ø (IN) FOUNDATION	TUBULAR STEEL Ø (IN) 3.00 (LB / FT) 7.60	TUBULAR STEEL Ø (IN) 3.50 (LB / FT) 9.00	TUBULAR STEEL Ø (IN) 4.00 (LB / FT) 10.80	TUBULAR STEEL Ø (IN) 5.00 (LB / FT) 14.60	SIGN FRAME REQUIRED	REMARKS	SIGN DETAIL: DETAIL IN SHS	SIGN DETAIL: DETAIL ON SHEET NUMBER	SIGN DETAIL: DETAIL ON STD SHEET NUMBER
TOWNSHEND NB							FY-FLUORESCENT YELLOW FYG-FLUORESCENT YELLOW GREEN																			"SHS"-STANDARD HIGHWAY SIGNS			
NB	1.547	A	R2-1	24	30		SPEED LIMIT 35						1		X											TO BE REPLACED FURTHER AHEAD			
NB	1.580	A	R2-1	24	30			5.00								1		15.0' X								INSTALL BEHIND RAIL, 175 FT ± NORTH OF PREVIOUS POSITION	X		
NB	1.742	A	R2-5A	24	30		REDUCED SPEED AHEAD						1		X											ONLY A 5-MPH DROP IN SPEED LIMIT; SIGN WILL NOT BE REPLACED			
		A	W11-2	30	30	FYG		6.25								1		18.0' X								INSTALL IN THE SAME POSITION AS THE JUST-REMOVED SPEED REDUCTION SIGN	X		
		A	W7-3A	24	18	FYG	NEXT 1/2 MILE	3.00																		FLUORESCENT YELLOW-GREEN SHEETING ON BOTH SIGNS	X		
NB	1.770	A	VD-018	30	18		Townshend						1		X														
		A	VD-018	30	18		W. Townshend 4	3.75								1		12.25' X										8	
NB	1.816	A	M4-11	24	12								1		X														
		A	R8-3A	24	24								1																
		A	VR-071	24	10								1																
		A	VR-644P	24	12		BEGIN	2.00								1		14.75' X								BLACK ON WHITE		6	
		A	R8-3A	24	24			4.00																			X		
		A	VR-071	24	10		12 P.M. - 6 A.M. NOV. 1 - APR. 1	1.67																				6	
NB	1.847	A	R2-1	24	30		SPEED LIMIT 30						1		X														
		A	R2-1	30	36			7.50								1		14.75' X								NOTE LARGER SIZE		6	
							SHEET TOTALS	33.17 SF	0.00 SF	0 EA	0 EA	0 EA	7 EA	0 EA	0 EA	5 EA		74.75' ~~75~~ FT										
							TOWN DIRECTIONAL TOTALS	334.0	0.0	25.0	0.0	0.0	81	0.0	0.0	54		810.0										

SIGN SUMMARY SHEET

VERMONT AGENCY OF TRANSPORTATION

PROJECT NAME: STATEWIDE SOUTHEAST REGION
PROJECT NUMBER: STPG SIGN (31)

FILE NAME: TOWNSHEND NORTHBOUND
PROJECT MANAGER: A. GAMBLE
DESIGNED BY: M. MILLER
PLOT DATE: 8/12/2010
DRAWN BY: M. MILLER
CHECKED BY: A. GAMBLE

DIRECTION	MILEPOINT	LOCATION CODE (SHEET 2)	SIGN CODE	WIDTH (IN)	HEIGHT (IN)	SHEETING REMARKS	SIGN LEGEND	NEW SIGNS "A"	NEW SIGNS "B"	EXISTING SIGNS RETAIN	EXISTING SIGNS SALVAGE FROM	EXISTING SIGNS SALVAGE TO	EXISTING SIGNS REMOVE	EXIST POST RETAIN	EXIST POST REMOVE	NUMBER OF NEW POSTS	SQUARE STEEL (IN) 1.75 (LB / FT) 1.88	SQUARE STEEL (IN) 2.00 (LB / FT) 2.42	SQUARE STEEL (IN) 2.50 (LB / FT) 3.35	TUBULAR STEEL Ø (IN) FOUNDATION	TUBULAR STEEL Ø (IN) 3.00 (LB / FT) 7.60	TUBULAR STEEL Ø (IN) 3.50 (LB / FT) 9.00	TUBULAR STEEL Ø (IN) 4.00 (LB / FT) 10.80	TUBULAR STEEL Ø (IN) 5.00 (LB / FT) 14.60	SIGN FRAME REQUIRED	REMARKS	SIGN DETAIL: DETAIL IN SHS	SIGN DETAIL: DETAIL ON SHEET NUMBER	SIGN DETAIL: DETAIL ON STD SHEET NUMBER
TOWNSHEND NB							FY-FLUORESCENT YELLOW FYG-FLUORESCENT YELLOW GREEN																			"SHS"-STANDARD HIGHWAY SIGNS			
NB	1.878	A	M2-1	21	15		JCT						1		X											TO BE REPLACED FURTHER AHEAD			
		A	M1-6	24	24		ROUTE 35						1																
NB	1.910	A	W11-2	30	30		PEDESTRIAN SYMBOL						1		X														
		A	W16-9	24	10		AHEAD (PLAQUE)						1																
		A	M2-1	21	15		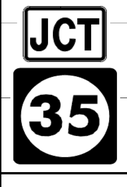	2.19								1	14.75' X							**BLACK ON WHITE** (NOT A STATE HIGHWAY)	X		
		A	M1-6	24	24			4.00																			INSTALL IN THE SAME POSITION AS THE REMOVED PED SIGNS		9	
NB	1.926	A	R8-3A	24	24								1		X														
		A	VR-071	24	10								1																
		A	R8-3A	24	24			4.00								1	13.75' X											X		
		A	VR-071	24	10			1.67																				6	
NB	1.953	A	D1-1A	72	10								1		X														
		A	D1-1A	72	10								1																
		A	D1-1A	72	10		(6 DESTINATION / HOSPITAL SIGN ASSEMBLY)						1																
		A	D1-1A	72	10								1																
		A	D9-2	24	24								1																
							SHEET TOTALS	11.86	0.00	0	0	0	11	0	0	2	~~30~~ 28.5												
								SF	SF	EA	EA	EA	EA	EA	EA	EA	FT												
							TOWN DIRECTIONAL TOTALS	334.0	0.0	25.0	0.0	0.0	81	0.0	0.0	54	810.0												

SIGN SUMMARY SHEET

VERMONT AGENCY OF TRANSPORTATION

PROJECT NAME: **STATEWIDE SOUTHEAST REGION**
PROJECT NUMBER: **STPG SIGN (31)**

FILE NAME: **TOWNSHEND NORTHBOUND** PLOT DATE: **8/12/2010**
PROJECT MANAGER: **A. GAMBLE** DRAWN BY: **M. MILLER**
DESIGNED BY: **M. MILLER** CHECKED BY: **A. GAMBLE**
TOWNSHEND VT-30 NORTHBOUND 4 SHEET **51** OF **175**

DIRECTION	MILEPOINT	LOCATION CODE (SHEET 2)	SIGN CODE	WIDTH (IN)	HEIGHT (IN)	SHEETING REMARKS	SIGN LEGEND	NEW SIGNS "A"	NEW SIGNS "B"	EXISTING SIGNS RETAIN	EXISTING SIGNS SALVAGE FROM	EXISTING SIGNS SALVAGE TO	EXISTING SIGNS REMOVE	EXIST POST RETAIN	EXIST POST REMOVE	NUMBER OF NEW POSTS	SQUARE STEEL (IN) 1.75 (LB / FT) 1.88	SQUARE STEEL (IN) 2.00 (LB / FT) 2.42	SQUARE STEEL (IN) 2.50 (LB / FT) 3.35	TUBULAR STEEL Ø (IN) FOUNDATION	TUBULAR STEEL Ø (IN) 3.00 (LB / FT) 7.60	TUBULAR STEEL Ø (IN) 3.50 (LB / FT) 9.00	TUBULAR STEEL Ø (IN) 4.00 (LB / FT) 10.80	TUBULAR STEEL Ø (IN) 5.00 (LB / FT) 14.60	SIGN FRAME REQUIRED	REMARKS	SIGN DETAIL: DETAIL IN SHS	SIGN DETAIL: DETAIL ON SHEET NUMBER	SIGN DETAIL: DETAIL ON STD SHEET NUMBER
TOWNSHEND NB							FY-FLUORESCENT YELLOW FYG-FLUORESCENT YELLOW GREEN																			"SHS"-STANDARD HIGHWAY SIGNS			
NB	1.953	A	M6-2	21	15				1																			
		A	D1-1A	72	12		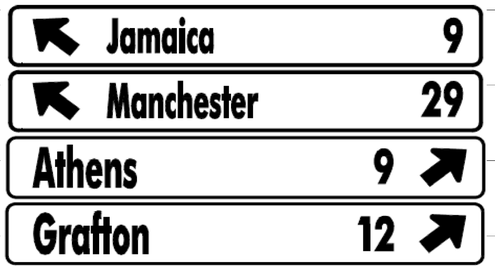	6.00								2		15.75' 15.75' X								4
		A	D1-1A	72	12			6.00																				4
		A	D1-1A	72	12			6.00																				4
		A	D1-1A	72	12			6.00																				4
		A	D9-2	24	24			4.00																			INSTALL HOSPITAL SIGNS ON RIGHT-SIDE POST	X	
		A	M6-2	21	15			2.19																			**WHITE ON BLUE**	X	
NB	1.975	A	W1-10L	30	30								1		X														
		A	W1-10L	30	30			6.25								1		13.0' X										X	
NB	1.995	A	W11-2	30	30	FYG	PEDESTRIAN SYMBOL			1				X													NEWFANE-TOWNSHEND STP 2401(1) TO REPLACE IN 2010			
		A	W16-7	24	12	FYG	DIAGONAL ARROW (45 DEG DOWN)			1																				
NB	2.015	A	M3-1	24	12								1		X														
		A	M1-5	24	24								1																
		A	M6-2	21	15		(6) SIGN ROUTE MARKER ASSEMBLY						1																	
		A	M3-1	24	12								1																
							SHEET TOTALS	36.44	0.00	2	0	0	6	0	0	3		44.5 ~~45~~										
								SF	SF	EA	EA	EA	EA	EA	EA	EA		FT										
							TOWN DIRECTIONAL TOTALS	334.0	0.0	25.0	0.0	0.0	81	0.0	0.0	54		810.0										

SIGN SUMMARY SHEET

VERMONT AGENCY OF TRANSPORTATION

PROJECT NAME: **STATEWIDE SOUTHEAST REGION**
PROJECT NUMBER: **STPG SIGN (31)**

FILE NAME: **TOWNSHEND NORTHBOUND** PLOT DATE: **8/12/2010**
PROJECT MANAGER: **A. GAMBLE** DRAWN BY: **M. MILLER**
DESIGNED BY: **M. MILLER** CHECKED BY: **A. GAMBLE**
TOWNSHEND VT-30 NORTHBOUND 5 SHEET **52** OF **175**

DIRECTION	MILEPOINT	LOCATION CODE (SHEET 2)	SIGN CODE	WIDTH (IN)	HEIGHT (IN)	SHEETING REMARKS	SIGN LEGEND	NEW SIGNS "A"	NEW SIGNS "B"	EXISTING SIGNS RETAIN	EXISTING SIGNS SALVAGE FROM	EXISTING SIGNS SALVAGE TO	EXISTING SIGNS REMOVE	EXIST POST RETAIN	EXIST POST REMOVE	NUMBER OF NEW POSTS	SQUARE STEEL (IN) 1.75 (LB / FT) 1.88	SQUARE STEEL (IN) 2.00 (LB / FT) 2.42	SQUARE STEEL (IN) 2.50 (LB / FT) 3.35	TUBULAR STEEL Ø (IN) FOUNDATION	TUBULAR STEEL Ø (IN) 3.00 (LB / FT) 7.60	TUBULAR STEEL Ø (IN) 3.50 (LB / FT) 9.00	TUBULAR STEEL Ø (IN) 4.00 (LB / FT) 10.80	TUBULAR STEEL Ø (IN) 5.00 (LB / FT) 14.60	SIGN FRAME REQUIRED	REMARKS	SIGN DETAIL: DETAIL IN SHS	SIGN DETAIL: DETAIL ON SHEET NUMBER	SIGN DETAIL: DETAIL ON STD SHEET NUMBER
TOWNSHEND NB							FY-FLUORESCENT YELLOW FYG-FLUORESCENT YELLOW GREEN																			"SHS"-STANDARD HIGHWAY SIGNS			
NB	2.015	A	M1-6	24	24								1															
		A	M6-2	21	15								1															
		A	M3-1	24	12			2.00								2		15.0' 15.0' X						#2	GREEN ON WHITE	X		
		A	M1-5	24	24			4.00																				E-136B
		A	M6-2	21	15			2.19																			GREEN ON WHITE	X		
		A	M3-1	24	12			2.00																			BLACK ON WHITE	X		
		A	M1-6	24	24			4.00																			BLACK ON WHITE (NOT A STATE HIGHWAY)		9	
		A	M6-2	21	15			2.19																			BLACK ON WHITE	X		
NB	2.039	A	S1-1	30	30	FYG							1		X															
		A	W16-9	24	10	FYG							1																	
		A	S1-1	30	30	FYG		6.25								1		13.75' X									FLUORESCENT YELLOW-GREEN SHEETING ON BOTH SIGNS	X		
		A	W16-9	24	12	FYG		2.00																				X		
NB	2.055	A	R8-3A	24	24			4.00								1		12.5' X									INSTALL BETWEEN TREE AND DRIVE TO LIBRARY; SOME TREE TRIMMING MIGHT BE REQUIRED?	X		
		A	VR-071	24	10			1.67																			80 FEET ± NORTH OF "SCHOOL AHEAD" ASSEMBLY ABOVE		6	
NB	2.065	A	S1-1	30	30	FYG							1		X															
							SHEET TOTALS	30.30	0.00	0	0	0	5	0	0	4		44.5 ~~60~~											
								SF	SF	EA	EA	EA	EA	EA	EA	EA		FT											
							TOWN DIRECTIONAL TOTALS	334.0	0.0	25.0	0.0	0.0	81	0.0	0.0	54		810.0											

SIGN SUMMARY SHEET

VERMONT AGENCY OF TRANSPORTATION

PROJECT NAME: **STATEWIDE SOUTHEAST REGION**
PROJECT NUMBER: **STPG SIGN (31)**

FILE NAME: **TOWNSHEND NORTHBOUND** PLOT DATE: **8/12/2010**
PROJECT MANAGER: **A. GAMBLE** DRAWN BY: **M. MILLER**
DESIGNED BY: **M. MILLER** CHECKED BY: **A. GAMBLE**
TOWNSHEND VT-30 NORTHBOUND 6 SHEET **53** OF **175**

DIRECTION	MILEPOINT	LOCATION CODE (SHEET 2)	SIGN CODE	WIDTH (IN)	HEIGHT (IN)	SHEETING REMARKS	SIGN LEGEND	NEW SIGNS "A"	NEW SIGNS "B"	EXISTING SIGNS RETAIN	EXISTING SIGNS SALVAGE FROM	EXISTING SIGNS SALVAGE TO	EXISTING SIGNS REMOVE	EXIST POST RETAIN	EXIST POST REMOVE	NUMBER OF NEW POSTS	SQUARE STEEL (IN) 1.75 (LB / FT) 1.88	SQUARE STEEL (IN) 2.00 (LB / FT) 2.42	SQUARE STEEL (IN) 2.50 (LB / FT) 3.35	TUBULAR STEEL Ø (IN) FOUNDATION	TUBULAR STEEL Ø (IN) 3.00 (LB / FT) 7.60	TUBULAR STEEL Ø (IN) 3.50 (LB / FT) 9.00	TUBULAR STEEL Ø (IN) 4.00 (LB / FT) 10.80	TUBULAR STEEL Ø (IN) 5.00 (LB / FT) 14.60	SIGN FRAME REQUIRED	REMARKS	SIGN DETAIL: DETAIL IN SHS	SIGN DETAIL: DETAIL ON SHEET NUMBER	SIGN DETAIL: DETAIL ON STD SHEET NUMBER
TOWNSHEND NB							FY-FLUORESCENT YELLOW FYG-FLUORESCENT YELLOW GREEN																			"SHS"-STANDARD HIGHWAY SIGNS			
NB	2.065	A	W16-7	24	12	FYG							1																
		A	S1-1	30	30	FYG		6.25								1		14.0' X								NEXT TO SCHOOL CROSSWALK; FACING NB TRAFFIC	X		
		A	W16-7	24	12	FYG		2.00																		FLUORESCENT YELLOW-GREEN SHEETING ON BOTH SIGNS	X		
NB	2.066	B	S1-1	30	30	FYG							1		X														
		B	W16-7	24	12	FYG							1																
		B	S1-1	30	30	FYG		6.25								1		14.0' X								NEXT TO SCHOOL CROSSWALK; ANGLED TO FACE SB TRAFFIC	X		
		B	W16-7	24	12	FYG		2.00																		FLUORESCENT YELLOW-GREEN SHEETING ON BOTH SIGNS	X		
NB	2.079	D	R1-1	30	30		0300 1317 0205 STOP			1				X												GRAFTON ROAD (TH-1); NEWFANE-TOWNSHEND STP 2401(1) TO REPLACE IN 2010			
NB	2.081	A	R8-3A	24	24								1		X														
		A	D9-2	24	24		(BACK-TO-BACK)	4.00								1		15.75' X								INSTALL BACK-TO-BACK ON SAME POST; INSTALL IN SAME POSITION AS REMOVED NO PARKING SIGN	X		
		A	M6-1R	21	15			2.19																		WHITE ON BLUE (ALL FOUR SIGNS)	X		
		B	D9-2	24	24			4.00																			X		
		B	M6-1L	21	15		SEE NEXT SHEET	2.19	ARROW QUANTITY									SEE ALSO NEXT SHEET	NO PARKING WAS INSTALLED BELOW THE ARROW SIGN ON THE SAME POST.						X		
NB	2.083	A	D9-2	24	24		HOSPITAL						1		X														
		A	N/A	24	6		SKINNY ARROW RIGHT						1																
							SHEET TOTALS	28.88	0.00	1	0	0	6	0	0	3		~~45~~ 43.75										
								SF	SF	EA	EA	EA	EA	EA	EA	EA		FT										
							TOWN DIRECTIONAL TOTALS	334.0	0.0	25.0	0.0	0.0	81	0.0	0.0	54		810.0										

SIGN SUMMARY SHEET

VERMONT AGENCY OF TRANSPORTATION

PROJECT NAME: **STATEWIDE SOUTHEAST REGION**
PROJECT NUMBER: **STPG SIGN (31)**

FILE NAME: **TOWNSHEND NORTHBOUND** PLOT DATE: **8/12/2010**
PROJECT MANAGER: **A. GAMBLE** DRAWN BY: **M. MILLER**
DESIGNED BY: **M. MILLER** CHECKED BY: **A. GAMBLE**
TOWNSHEND VT-30 NORTHBOUND 7 SHEET **54** OF **175**

DIRECTION	MILEPOINT	LOCATION CODE (SHEET 2)	SIGN CODE	WIDTH (IN)	HEIGHT (IN)	SHEETING REMARKS	SIGN LEGEND	NEW SIGNS "A"	NEW SIGNS "B"	EXISTING SIGNS RETAIN	EXISTING SIGNS SALVAGE FROM	EXISTING SIGNS SALVAGE TO	EXISTING SIGNS REMOVE	EXIST POST RETAIN	EXIST POST REMOVE	NUMBER OF NEW POSTS	SQUARE STEEL (IN) 1.75 (LB / FT) 1.88	SQUARE STEEL (IN) 2.00 (LB / FT) 2.42	SQUARE STEEL (IN) 2.50 (LB / FT) 3.35	TUBULAR STEEL Ø (IN) FOUNDATION	TUBULAR STEEL Ø (IN) 3.00 (LB / FT) 7.60	TUBULAR STEEL Ø (IN) 3.50 (LB / FT) 9.00	TUBULAR STEEL Ø (IN) 4.00 (LB / FT) 10.80	TUBULAR STEEL Ø (IN) 5.00 (LB / FT) 14.60	SIGN FRAME REQUIRED	REMARKS	SIGN DETAIL: DETAIL IN SHS	SIGN DETAIL: DETAIL ON SHEET NUMBER	SIGN DETAIL: DETAIL ON STD SHEET NUMBER
TOWNSHEND NB							FY-FLUORESCENT YELLOW FYG-FLUORESCENT YELLOW GREEN																			"SHS"-STANDARD HIGHWAY SIGNS			
NB	2.081	C ~~A~~	R8-3A	24	24			4.00							X	~~1~~		THIS NEW SIGN WAS INSTALLED AT NB MM 2.081 ~~X~~		SEE PREVIOUS SHEET.						INSTALL IN SAME POSITION AS THE REMOVED HOSPITAL SIGN CLOSEST TO ROUTE 30	X		
NB	2.083	B	D9-2	24	24		HOSPITAL						1		X											FACES SB TRAFFIC			
		B	N/A	24	6		SKINNY ARROW LEFT						1																
NB	2.083	D	R1-1	30	30		STOP	6.25		1				X				ON 8/15/2011 THIS POST AND SIGN WERE DESTROYED IN AN ACCIDENT. NEW POST AND SIGN WERE RE-INSTALLED AS PART OF THIS PROJECT. X 13.252'								NEWFANE-TOWNSHEND STP 2401(1) TO REPLACE IN 2010			
NB	2.092	D	R1-1	30	30		STOP			1				X												NEWFANE-TOWNSHEND STP 2401(1) TO REPLACE IN 2010			
NB	2.103	A	M3-1	24	12								1		X														
		A	M1-5	24	24								1																
		A	M3-1	24	12			2.00								1	13.75' X							GREEN ON WHITE	X		
		A	M1-5	24	24			4.00																					E-136B
NB	2.113	A	R8-3A	24	24								1		X														
		A	VR-122	24	10								1																
		A	R8-3A	24	24			4.00								1	14.0' X										X		
		A	VR-071	24	10			1.67																				6	
NB	2.130	C	VR-017	24	30		NO THRU TRAFFIC LLL 24K			1				X												COMMON ROAD (TH-53); NEWFANE-TOWNSHEND STP 2401(1) TO REPLACE IN 2010			
NB	2.138	D	R1-1	30	30		0300 1317 0211 STOP			1				X												NEWFANE-TOWNSHEND STP 2401(1) TO REPLACE IN 2010			
							SHEET TOTALS	~~21.92~~ ~~15.67~~	0.00	4	0	0	6	0	0	3	~~41.0~~ ~~45~~										
								SF	SF	EA	EA	EA	EA	EA	EA	EA	FT										
							TOWN DIRECTIONAL TOTALS	334.0	0.0	25.0	0.0	0.0	81	0.0	0.0	54	810.0										

SIGN SUMMARY SHEET

VERMONT AGENCY OF TRANSPORTATION

PROJECT NAME: **STATEWIDE SOUTHEAST REGION**
PROJECT NUMBER: **STPG SIGN (31)**

FILE NAME: **TOWNSHEND NORTHBOUND** PLOT DATE: **8/12/2010**
PROJECT MANAGER: **A. GAMBLE** DRAWN BY: **M. MILLER**
DESIGNED BY: **M. MILLER** CHECKED BY: **A. GAMBLE**
TOWNSHEND VT-30 NORTHBOUND 8 SHEET **55** OF **175**

DIRECTION	MILEPOINT	LOCATION CODE (SHEET 2)	SIGN CODE	WIDTH (IN)	HEIGHT (IN)	SHEETING REMARKS	SIGN LEGEND	NEW SIGNS "A"	NEW SIGNS "B"	EXISTING SIGNS RETAIN	EXISTING SIGNS SALVAGE FROM	EXISTING SIGNS SALVAGE TO	EXISTING SIGNS REMOVE	EXIST POST RETAIN	EXIST POST REMOVE	NUMBER OF NEW POSTS	SQUARE STEEL (IN) 1.75 (LB / FT) 1.88	SQUARE STEEL (IN) 2.00 (LB / FT) 2.42	SQUARE STEEL (IN) 2.50 (LB / FT) 3.35	TUBULAR STEEL Ø (IN) FOUNDATION	TUBULAR STEEL Ø (IN) 3.00 (LB / FT) 7.60	TUBULAR STEEL Ø (IN) 3.50 (LB / FT) 9.00	TUBULAR STEEL Ø (IN) 4.00 (LB / FT) 10.80	TUBULAR STEEL Ø (IN) 5.00 (LB / FT) 14.60	SIGN FRAME REQUIRED	REMARKS	SIGN DETAIL: DETAIL IN SHS	SIGN DETAIL: DETAIL ON SHEET NUMBER	SIGN DETAIL: DETAIL ON STD SHEET NUMBER
TOWNSHEND NB							FY-FLUORESCENT YELLOW FYG-FLUORESCENT YELLOW GREEN																			"SHS"-STANDARD HIGHWAY SIGNS			
NB	2.141	A	S1-1	30	30	FYG							1		X													
		A	W16-7P	24	12	FYG							1															
		A	S1-1	30	30	FYG		6.25								1		14.0' X								FLUORESCENT YELLOW-GREEN SHEETING ON BOTH SIGNS	X	
		A	W16-7P	24	12	FYG		2.00																			X	
NB	2.170	A	R8-3A	24	24								1		X													
		A	VR-071	24	10								1															
		A	R8-3A	24	24			4.00								1		13.75' X									X	
		A	VR-071	24	10			1.67																				6
NB	2.215	A	VW-054	30	30								1		X													
		A	VW-054	30	30			6.25								1		10.25' X										E-154
NB	2.284	A	R2-1	24	30								1		X													
		A	R2-1	24	30			5.00								2		10.5' 11.75' X							# 1	INSTALL THE SPEED LIMIT SIGN ALONE ON THE RIGHT SIDE POST;	X	
		A	M4-6	24	12			2.00																		**BLACK ON WHITE**, INSTALL THE "END" PLAQUE ON TOP; THE NO PARKING SIGNS WILL BE ON THE	X	
		A	R8-3A	24	24			4.00																		LEFT-SIDE POST; USE A FRAME TO STABILIZE THE ASSEMBLY	X	
		A	VR-071	24	10			1.67																		**BLACK ON WHITE**, INSTALL BELOW THE NO PARKING SYMBOL		6
SIGN SUMMARY SHEET							SHEET TOTALS	32.84 SF	0.00 SF	0 EA	0 EA	0 EA	6 EA	0 EA	0 EA	5 EA	60.25 ~~75~~ FT										
VERMONT AGENCY OF TRANSPORTATION							TOWN DIRECTIONAL TOTALS	334.0	0.0	25.0	0.0	0.0	81	0.0	0.0	54	810.0										

PROJECT NAME: **STATEWIDE SOUTHEAST REGION**
PROJECT NUMBER: **STPG SIGN (31)**

FILE NAME: **TOWNSHEND NORTHBOUND** PLOT DATE: **8/12/2010**
PROJECT MANAGER: **A. GAMBLE** DRAWN BY: **M. MILLER**
DESIGNED BY: **M. MILLER** CHECKED BY: **A. GAMBLE**
TOWNSHEND VT-30 NORTHBOUND 9 SHEET **56** OF **175**

DIRECTION	MILEPOINT	LOCATION CODE (SHEET 2)	SIGN CODE	WIDTH (IN)	HEIGHT (IN)	SHEETING REMARKS	SIGN LEGEND	NEW SIGNS "A"	NEW SIGNS "B"	EXISTING SIGNS RETAIN	EXISTING SIGNS SALVAGE FROM	EXISTING SIGNS SALVAGE TO	EXISTING SIGNS REMOVE	EXIST POST RETAIN	EXIST POST REMOVE	NUMBER OF NEW POSTS	SQUARE STEEL (IN) 1.75 (LB / FT) 1.88	SQUARE STEEL (IN) 2.00 (LB / FT) 2.42	SQUARE STEEL (IN) 2.50 (LB / FT) 3.35	TUBULAR STEEL Ø (IN) FOUNDATION	TUBULAR STEEL Ø (IN) 3.00 (LB / FT) 7.60	TUBULAR STEEL Ø (IN) 3.50 (LB / FT) 9.00	TUBULAR STEEL Ø (IN) 4.00 (LB / FT) 10.80	TUBULAR STEEL Ø (IN) 5.00 (LB / FT) 14.60	SIGN FRAME REQUIRED	REMARKS	SIGN DETAIL: DETAIL IN SHS	SIGN DETAIL: DETAIL ON SHEET NUMBER	SIGN DETAIL: DETAIL ON STD SHEET NUMBER
TOWNSHEND NB							FY-FLUORESCENT YELLOW FYG-FLUORESCENT YELLOW GREEN																			"SHS"-STANDARD HIGHWAY SIGNS			
NB	2.334	A	M3-1	24	12								1		X														
		A	M1-5	24	24								1																
		A	M3-1	24	12			2.00								1		13.75' X							GREEN ON WHITE	X		
		A	M1-5	24	24			4.00																					E-136B
NB	2.426	A	VW-054	30	30		HIDDEN DRIVES RIGHT						1		X												TO BE REPLACED FURTHER AHEAD			
NB	2.474	A	R2-1	24	30								1		X															
		A	R2-1	24	30			5.00								1	12.75' X										X		
NB	2.498	A	VW-054	30	30			6.25								1	14.25' X									INSTALL 125 FEET ± NORTH OF THE SPEED LIMIT 50 SIGN			E-154
NB	2.903	A	VW-205	30	30		WATCH FOR TURNING VEHICLES						1		X														
NB	3.270	A	VW-285	36	36		FALLING ROCK (SYMBOL)			1				X													INSTALLED IN SUMMER 2007			
		A	W7-3A	30	18		NEXT 2 MILES (PLAQUE)			1																			
NB	3.306	A	S3-1	30	30		SCHOOL BUS STOP AHEAD						1		X														
NB	5.547	A	S3-1	30	30		SCHOOL BUS STOP AHEAD						1		X														
NB	5.902	C	VR-017	24	30		LEGAL LOAD LIMIT 24000 POUNDS			1				X													WINSLOW DRIVE (TH-22); NEWFANE-TOWNSHEND STP 2401(1) TO REPLACE IN 2010			
NB	5.908	D	R1-1	30	30		0300 1317 0588 STOP			1				X													NEWFANE-TOWNSHEND STP 2401(1) TO REPLACE IN 2010			
							SHEET TOTALS	17.25 SF	0.00 SF	4 EA	0 EA	0 EA	7 EA	0 EA	0 EA	3 EA	40.75 ~~45~~ FT									
							TOWN DIRECTIONAL TOTALS	334.0	0.0	25.0	0.0	0.0	81	0.0	0.0	54	810.0									

SIGN SUMMARY SHEET

VERMONT AGENCY OF TRANSPORTATION

PROJECT NAME: **STATEWIDE SOUTHEAST REGION**
PROJECT NUMBER: **STPG SIGN (31)**

FILE NAME: **TOWNSHEND NORTHBOUND** PLOT DATE: **8/12/2010**
PROJECT MANAGER: **A. GAMBLE** DRAWN BY: **M. MILLER**
DESIGNED BY: **M. MILLER** CHECKED BY: **A. GAMBLE**
TOWNSHEND VT-30 NORTHBOUND 10 SHEET **57** OF **175**

DIRECTION	MILEPOINT	LOCATION CODE (SHEET 2)	SIGN CODE	WIDTH (IN)	HEIGHT (IN)	SHEETING REMARKS	SIGN LEGEND	NEW SIGNS "A"	NEW SIGNS "B"	EXISTING SIGNS RETAIN	EXISTING SIGNS SALVAGE FROM	EXISTING SIGNS SALVAGE TO	EXISTING SIGNS REMOVE	EXIST POST RETAIN	EXIST POST REMOVE	NUMBER OF NEW POSTS	SQUARE STEEL (IN) 1.75 (LB / FT) 1.88	SQUARE STEEL (IN) 2.00 (LB / FT) 2.42	SQUARE STEEL (IN) 2.50 (LB / FT) 3.35	TUBULAR STEEL Ø (IN) FOUNDATION	TUBULAR STEEL Ø (IN) 3.00 (LB / FT) 7.60	TUBULAR STEEL Ø (IN) 3.50 (LB / FT) 9.00	TUBULAR STEEL Ø (IN) 4.00 (LB / FT) 10.80	TUBULAR STEEL Ø (IN) 5.00 (LB / FT) 14.60	SIGN FRAME REQUIRED	REMARKS	SIGN DETAIL: DETAIL IN SHS	SIGN DETAIL: DETAIL ON SHEET NUMBER	SIGN DETAIL: DETAIL ON STD SHEET NUMBER
TOWNSHEND NB							FY-FLUORESCENT YELLOW FYG-FLUORESCENT YELLOW GREEN																			"SHS"-STANDARD HIGHWAY SIGNS			
NB	6.161	A	R2-5A	24	30								1		X													
		A	W3-5	36	36			9.00								2		11.25' 13.25' X									X	
NB	6.200	A	VD-018	30	18								1		X													
		A	VD-018	30	18			3.75								1		12.0' X										8
NB	6.244	A	R2-1	24	30								1		X													
		A	R2-1	30	36			7.50								1		12.25' X									NOTE LARGER SIZE	6
NB	6.279	A	VD-062B	72	16		BUSINESS DIRECTORY SIGN			1				X													WINDHAM HILL INN ===>			
NB	6.369	A	R2-5A	24	30		REDUCED SPEED AHEAD						1		X													
		A	W3-5	36	36			9.00								2		8.5' 9.75' X										X	
NB	6.398	A	N/A	N/A	N/A		REMOVE EMPTY POST						1		X												SIGN IS MISSING; REMOVE EMPTY POST			
NB	6.408	A	VW-205	36	36			9.00								2		9.5' 11.0' X									INSTALL 50 FEET ± NORTH OF EMTPY POST REMOVAL			E-154
NB	6.453	A	R2-1	24	30								1		X													
		A	R2-1	30	36			7.50								1		13.25' X									NOTE LARGER SIZE		6	
NB	6.517	A	S3-1	30	30		SCHOOL BUS STOP AHEAD						1		X												BEHIND RAIL / FENCE ~ CAN ONLY ACCESS FROM PRIVATE PROPERTY TO REMOVE			
NB	6.531	A	W2-2MR	30	30		MODIFIED RIGHT SIDE ROAD SYMBOL						1		X												BEHIND RAIL / FENCE ~ CAN ONLY ACCESS FROM PRIVATE PROPERTY TO REMOVE			
							SHEET TOTALS	45.75	0.00	1	0	0	8	0	0	9		100.75 ~~135~~											
								SF	SF	EA	EA	EA	EA	EA	EA	EA		FT											
							TOWN DIRECTIONAL TOTALS	334.0	0.0	25.0	0.0	0.0	81	0.0	0.0	54		810.0											

SIGN SUMMARY SHEET

VERMONT AGENCY OF TRANSPORTATION

PROJECT NAME: **STATEWIDE SOUTHEAST REGION**
PROJECT NUMBER: **STPG SIGN (31)**

FILE NAME: **TOWNSHEND NORTHBOUND** PLOT DATE: **8/12/2010**
PROJECT MANAGER: **A. GAMBLE** DRAWN BY: **M. MILLER**
DESIGNED BY: **M. MILLER** CHECKED BY: **A. GAMBLE**
TOWNSHEND VT-30 NORTHBOUND 11 SHEET **58** OF **175**

DIRECTION	MILEPOINT	LOCATION CODE (SHEET 2)	SIGN CODE	WIDTH (IN)	HEIGHT (IN)	SHEETING REMARKS	SIGN LEGEND	NEW SIGNS "A"	NEW SIGNS "B"	EXISTING SIGNS RETAIN	EXISTING SIGNS SALVAGE FROM	EXISTING SIGNS SALVAGE TO	EXISTING SIGNS REMOVE	EXIST POST RETAIN	EXIST POST REMOVE	NUMBER OF NEW POSTS	SQUARE STEEL (IN) 1.75 (LB / FT) 1.88	SQUARE STEEL (IN) 2.00 (LB / FT) 2.42	SQUARE STEEL (IN) 2.50 (LB / FT) 3.35	TUBULAR STEEL Ø (IN) FOUNDATION	TUBULAR STEEL Ø (IN) 3.00 (LB / FT) 7.60	TUBULAR STEEL Ø (IN) 3.50 (LB / FT) 9.00	TUBULAR STEEL Ø (IN) 4.00 (LB / FT) 10.80	TUBULAR STEEL Ø (IN) 5.00 (LB / FT) 14.60	SIGN FRAME REQUIRED	REMARKS	SIGN DETAIL: DETAIL IN SHS	SIGN DETAIL: DETAIL ON SHEET NUMBER	SIGN DETAIL: DETAIL ON STD SHEET NUMBER
TOWNSHEND NB							FY-FLUORESCENT YELLOW FYG-FLUORESCENT YELLOW GREEN																			"SHS"-STANDARD HIGHWAY SIGNS			
NB	6.540	C	VR-017	24	30		LEGAL LOAD LIMIT 24000 POUNDS			1				X												BACK WINDHAM RD (TH-7); NEWFANE-TOWNSHEND STP 2401(1) TO REPLACE IN 2010			
NB	6.550	D	R1-1	24	24		0300 1317 0652 STOP			1				X												NEWFANE-TOWNSHEND STP 2401(1) TO REPLACE IN 2010			
NB	6.567	A	R2-1	24	30		SPEED LIMIT 30						1		X														
		A	R2-1	24	30			5.00								1		11.25' X									X		
NB	6.585	A	D1-1A	54	7.5								1		X														
		A	D1-1A	72	12		Windham 7 →	6.00								2		11.0' 11.0' X									4		
NB	6.604	C	VR-017	24	30		LEGAL LOAD LIMIT 24000 POUNDS			1				X												WINDHAM HILL RD (TH-3); NEWFANE-TOWNSHEND STP 2401(1) TO REPLACE IN 2010			
NB	6.612	D	R1-1	30	30		0300 1317 0657 STOP			1				X												NEWFANE-TOWNSHEND STP 2401(1) TO REPLACE IN 2010			
NB	6.646	A	M3-1	24	12								1		X														
		A	M1-5	24	24								1																
		A	M3-1	24	12		NORTH	2.00								1		13.0' X								GREEN ON WHITE	X		
		A	M1-5	24	24		VERMONT 30	4.00																					E-136B
NB	6.675	A	R2-1	24	30		SPEED LIMIT 30						1		X														
		A	R2-1	24	30			5.00								1		13.25' X									X		
NB	6.828	A	R2-1	24	30								1		X														
							SHEET TOTALS	22.00 SF	0.00 SF	4 EA	0 EA	0 EA	6 EA	0 EA	0 EA	5 EA		59.5 ~~75~~ FT											
							TOWN DIRECTIONAL TOTALS	334.0	0.0	25.0	0.0	0.0	81	0.0	0.0	54		810.0											

SIGN SUMMARY SHEET

VERMONT AGENCY OF TRANSPORTATION

PROJECT NAME: STATEWIDE SOUTHEAST REGION
PROJECT NUMBER: STPG SIGN (31)

FILE NAME: TOWNSHEND NORTHBOUND
PROJECT MANAGER: A. GAMBLE
DESIGNED BY: M. MILLER
TOWNSHEND VT-30 NORTHBOUND 12

PLOT DATE: 8/12/2010
DRAWN BY: M. MILLER
CHECKED BY: A. GAMBLE
SHEET 59 OF 175

DIRECTION	MILEPOINT	LOCATION CODE (SHEET 2)	SIGN CODE	WIDTH (IN)	HEIGHT (IN)	SHEETING REMARKS	SIGN LEGEND	NEW SIGNS "A"	NEW SIGNS "B"	EXISTING SIGNS RETAIN	EXISTING SIGNS SALVAGE FROM	EXISTING SIGNS SALVAGE TO	EXISTING SIGNS REMOVE	EXIST POST RETAIN	EXIST POST REMOVE	NUMBER OF NEW POSTS	SQUARE STEEL (IN) 1.75 (LB / FT) 1.88	SQUARE STEEL (IN) 2.00 (LB / FT) 2.42	SQUARE STEEL (IN) 2.50 (LB / FT) 3.35	TUBULAR STEEL Ø (IN) FOUNDATION	TUBULAR STEEL Ø (IN) 3.00 (LB / FT) 7.60	TUBULAR STEEL Ø (IN) 3.50 (LB / FT) 9.00	TUBULAR STEEL Ø (IN) 4.00 (LB / FT) 10.80	TUBULAR STEEL Ø (IN) 5.00 (LB / FT) 14.60	SIGN FRAME REQUIRED	REMARKS	SIGN DETAIL: DETAIL IN SHS	SIGN DETAIL: DETAIL ON SHEET NUMBER	SIGN DETAIL: DETAIL ON STD SHEET NUMBER
TOWNSHEND NB							FY-FLUORESCENT YELLOW FYG-FLUORESCENT YELLOW GREEN																			"SHS"-STANDARD HIGHWAY SIGNS			
NB	6.818	A	R2-1	24	30		SPEED LIMIT 40	5.00								1		12.75' X									X	
NB	6.860	A	W1-2L	30	30			6.25								1		13.75' X		SEE NOTE BELOW.						INSTALL 170 FT ± NORTH OF SPEED LIMIT 40 SIGN	X	
NB	6.992	A	R2-1	24	30		SPEED LIMIT 50						1		X													
		A	R2-1	24	30			5.00								1		13.75' X									X	
NB	6.860	A	W1-2L	30	30						1	1	1													AT THE REQUEST OF THE PROPERTY OWNER THIS SIGN WAS MOVED NORTH ABOUT 30'. IT INTERFERED WITH HIS SNOW REMOVAL.		
																										BUSINESS (TIS) SIGN-ADDED TO RECORD PLANS	CAMPERAMA ¼ MI	
NB	1.188	A	VD-062B	72	16		BUSINESS DIRECTORY SIGN			1				X														
							SHEET TOTALS	16.25 SF	0.00 SF	~~1~~ 0 EA	~~1~~ 0 EA	~~1~~ 0 EA	~~2~~ 1 EA	0 EA	0 EA	3 EA	45 FT										
							TOWN DIRECTIONAL TOTALS	334.0	0.0	25.0	0.0	0.0	81	0.0	0.0	54	810.0										

SIGN SUMMARY SHEET

VERMONT AGENCY OF TRANSPORTATION

PROJECT NAME: **STATEWIDE SOUTHEAST REGION**
PROJECT NUMBER: **STPG SIGN (31)**

FILE NAME: **TOWNSHEND NORTHBOUND** PLOT DATE: **8/12/2010**
PROJECT MANAGER: **A. GAMBLE** DRAWN BY: **M. MILLER**
DESIGNED BY: **M. MILLER** CHECKED BY: **A. GAMBLE**
TOWNSHEND VT-30 NORTHBOUND 13 SHEET **60** OF **175**

DIRECTION	MILEPOINT	LOCATION CODE (SHEET 2)	SIGN CODE	WIDTH (IN)	HEIGHT (IN)	SHEETING REMARKS	SIGN LEGEND	NEW SIGNS "A"	NEW SIGNS "B"	EXISTING SIGNS RETAIN	EXISTING SIGNS SALVAGE FROM	EXISTING SIGNS SALVAGE TO	EXISTING SIGNS REMOVE	EXIST POST RETAIN	EXIST POST REMOVE	NUMBER OF NEW POSTS	SQUARE STEEL (IN) 1.75 (LB / FT) 1.88	SQUARE STEEL (IN) 2.00 (LB / FT) 2.42	SQUARE STEEL (IN) 2.50 (LB / FT) 3.35	TUBULAR STEEL Ø (IN) FOUNDATION	TUBULAR STEEL Ø (IN) 3.00 (LB / FT) 7.60	TUBULAR STEEL Ø (IN) 3.50 (LB / FT) 9.00	TUBULAR STEEL Ø (IN) 4.00 (LB / FT) 10.80	TUBULAR STEEL Ø (IN) 5.00 (LB / FT) 14.60	SIGN FRAME REQUIRED	REMARKS	SIGN DETAIL: DETAIL IN SHS	SIGN DETAIL: DETAIL ON SHEET NUMBER	SIGN DETAIL: DETAIL ON STD SHEET NUMBER
TOWNSHEND SB							FY-FLUORESCENT YELLOW FYG-FLUORESCENT YELLOW GREEN																			"SHS"-STANDARD HIGHWAY SIGNS			
SB	7.147	F	W1-2R	30	30			6.25								1		15.0' X								INSTALL 260 FT ± IN ADVANCE OF THE REDUCED SPEED AHEAD SIGN	X		
SB	7.098	F	R2-5A	24	30		REDUCED SPEED AHEAD						1		X														
SB	7.062	F	W3-5	36	36			9.00								2		15.0' 15.0' X									X		
SB	7.058	F	VD-018	30	18		WEST TOWNSHEND TOWNSHEND 4						1		X											TO BE REPLACED FURTHER AHEAD			
SB	7.012	F	VD-062B	72	16		BUSINESS DIRECTORY SIGN			1				X												WINDHAM HILL INN <===			
SB	6.974	F	R2-1	24	30								1		X														
		F	R2-1	30	36			7.50								1		13.75' X								NOTE LARGER SIZE		6	
SB	~~7.058~~ ~~6.926~~	F	VD-018	30	18			3.75								1		14.0' X			NEW SIGN WAS INSTALLED AT ITS ORIGINAL LOCATION.						~~INSTALL 5 FT ± BEYOND THE "WELCOME TO TOWNSHEND" PRIVATE SIGN~~		8	
SB	6.911	F	R2-5A	24	30		REDUCED SPEED AHEAD						1		X														
SB	6.870	F	W3-5	36	36			9.00								2		12.75' 13.75' X								INSTALL 215 FT ± SOUTH OF THE WEST TOWNSHEND / TOWNSHEND 4 VILLAGE SIGN	X		
SB	6.818	F	R2-1	24	30								1		X														
		F	R2-1	30	36			7.50								1		13.5' X								NOTE LARGER SIZE		6	
SB	6.808	G	VR-017	24	30		LEGAL LOAD LIMIT 24000 POUNDS			1				X												WORDEN LANE (TH-60); NEWFANE-TOWNSHEND STP 2401(1) TO REPLACE IN 2010			
SB	6.796	H	R1-1	30	30		STOP			1				X												NEWFANE-TOWNSHEND STP 2401(1) TO REPLACE IN 2010			
SB	6.709	F	W2-3ML	30	30		MODIFIED LEFT ANGLE SIDE ROAD						1		X														
							SHEET TOTALS	43.00	0.00	3	0	0	6	0	0	8		~~112.75~~ ~~120~~											
								SF	SF	EA	EA	EA	EA	EA	EA	EA		FT											
							TOWN DIRECTIONAL TOTALS	304.7	0.0	25.0	2.0	2.0	68	0.0	0.0	55		825.0											

SIGN SUMMARY SHEET

VERMONT AGENCY OF TRANSPORTATION

PROJECT NAME: **STATEWIDE SOUTHEAST REGION**
PROJECT NUMBER: **STPG SIGN (31)**

FILE NAME: **TOWNSHEND SOUTHBOUND**
PROJECT MANAGER: **A. GAMBLE**
DESIGNED BY: **M. MILLER**
TOWNSHEND VT-30 SOUTHBOUND 1

PLOT DATE: **8/12/2010**
DRAWN BY: **M. MILLER**
CHECKED BY: **A. GAMBLE**
SHEET **61** OF **175**

DIRECTION	MILEPOINT	LOCATION CODE (SHEET 2)	SIGN CODE	WIDTH (IN)	HEIGHT (IN)	SHEETING REMARKS	SIGN LEGEND	NEW SIGNS "A"	NEW SIGNS "B"	EXISTING SIGNS RETAIN	EXISTING SIGNS SALVAGE FROM	EXISTING SIGNS SALVAGE TO	EXISTING SIGNS REMOVE	EXIST POST RETAIN	EXIST POST REMOVE	NUMBER OF NEW POSTS	SQUARE STEEL (IN) 1.75 (LB / FT) 1.88	SQUARE STEEL (IN) 2.00 (LB / FT) 2.42	SQUARE STEEL (IN) 2.50 (LB / FT) 3.35	TUBULAR STEEL Ø (IN) FOUNDATION	TUBULAR STEEL Ø (IN) 3.00 (LB / FT) 7.60	TUBULAR STEEL Ø (IN) 3.50 (LB / FT) 9.00	TUBULAR STEEL Ø (IN) 4.00 (LB / FT) 10.80	TUBULAR STEEL Ø (IN) 5.00 (LB / FT) 14.60	SIGN FRAME REQUIRED	REMARKS	SIGN DETAIL: DETAIL IN SHS	SIGN DETAIL: DETAIL ON SHEET NUMBER	SIGN DETAIL: DETAIL ON STD SHEET NUMBER
TOWNSHEND SB							FY-FLUORESCENT YELLOW FYG-FLUORESCENT YELLOW GREEN																			"SHS"-STANDARD HIGHWAY SIGNS			
SB	6.709	F	R2-1	24	30		SPEED LIMIT 30	5.00								1		13.0' X									X		
SB	6.663	F	R2-1	24	30								1		X														
		F	W2-2L	30	30			6.25								1		13.5' X									X		
SB	6.636	F	D1-1A	72	10								1		X														
		F	D1-1A	72	12		← Windham 7	6.00								2		11.75' 11.75' X										4	
SB	6.577	F	W2-1M	30	30		MODIFIED CROSSROAD SYMBOL						1		X															
		F	W2-2	30	30			6.25								1		13.5' X									X		
SB	6.530	F	M3-3	24	12		SOUTH						1		X														
		F	M1-5	24	24		VT 30						1																
		F	M3-3	24	12		SOUTH VERMONT 30	2.00								1		13.0' X								GREEN ON WHITE	X		
		F	M1-5	24	24			4.00																					E-136B
SB	6.521	G	VR-017	24	30		LEGAL LOAD LIMIT 24000 POUNDS			1				X												ISLAND RD (TH-49); NEWFANE-TOWNSHEND STP 2401(1) TO REPLACE IN 2010			
SB	6.503	H	R1-1	30	30		0300 1317 0648 STOP			1				X												NEWFANE-TOWNSHEND STP 2401(1) TO REPLACE IN 2010			
SB	6.451	F	R2-1	24	30		SPEED LIMIT 40						1		X														
		F	R2-1	24	30			5.00								1		12.75' X									X		
							SHEET TOTALS	34.50	0.00	2	0	0	6	0	0	7		~~89.25~~ 105											
								SF	SF	EA	EA	EA	EA	EA	EA	EA		FT											
							TOWN DIRECTIONAL TOTALS	304.7	0.0	25.0	2.0	2.0	68	0.0	0.0	55		825.0											

SIGN SUMMARY SHEET

VERMONT AGENCY OF TRANSPORTATION

PROJECT NAME: STATEWIDE SOUTHEAST REGION
PROJECT NUMBER: STPG SIGN (31)

FILE NAME: TOWNSHEND SOUTHBOUND
PROJECT MANAGER: A. GAMBLE
DESIGNED BY: M. MILLER
TOWNSHEND VT-30 SOUTHBOUND 2

PLOT DATE: 8/12/2010
DRAWN BY: M. MILLER
CHECKED BY: A. GAMBLE
SHEET 62 OF 175

DIRECTION	MILEPOINT	LOCATION CODE (SHEET 2)	SIGN CODE	WIDTH (IN)	HEIGHT (IN)	SHEETING REMARKS	SIGN LEGEND	NEW SIGNS "A"	NEW SIGNS "B"	EXISTING SIGNS RETAIN	EXISTING SIGNS SALVAGE FROM	EXISTING SIGNS SALVAGE TO	EXISTING SIGNS REMOVE	EXIST POST RETAIN	EXIST POST REMOVE	NUMBER OF NEW POSTS	SQUARE STEEL (IN) 1.75 (LB / FT) 1.88	SQUARE STEEL (IN) 2.00 (LB / FT) 2.42	SQUARE STEEL (IN) 2.50 (LB / FT) 3.35	TUBULAR STEEL Ø (IN) FOUNDATION	TUBULAR STEEL Ø (IN) 3.00 (LB / FT) 7.60	TUBULAR STEEL Ø (IN) 3.50 (LB / FT) 9.00	TUBULAR STEEL Ø (IN) 4.00 (LB / FT) 10.80	TUBULAR STEEL Ø (IN) 5.00 (LB / FT) 14.60	SIGN FRAME REQUIRED	REMARKS	SIGN DETAIL: DETAIL IN SHS	SIGN DETAIL: DETAIL ON SHEET NUMBER	SIGN DETAIL: DETAIL ON STD SHEET NUMBER
TOWNSHEND SB							FY-FLUORESCENT YELLOW FYG-FLUORESCENT YELLOW GREEN																			"SHS"-STANDARD HIGHWAY SIGNS			
SB	6.357	G	VR-017	24	30		LEGAL LOAD LIMIT 24000 POUNDS			1				X								THIS FORMER T.H. IS A PRIVATE DRIVE			FAVREOUS COR (TH-51); NEWFANE-TOWNSHEND STP 2401(1) TO REPLACE IN 2010			
SB	6.348	H	R1-1	30	30		STOP			1				X								THIS FORMER T.H. IS A PRIVATE DRIVE			NEWFANE-TOWNSHEND STP 2401(1) TO REPLACE IN 2010			
SB	6.234	F	R2-1	24	30								1		X														
		F	R2-1	24	30			5.00								1		13.0' X										X	
SB	5.815	F	VW-285	36	36						1		1		X											PAY FOR REMOVAL			
		F	W7-3A	30	18						1		1																
		F	VW-285	36	36		FALLING ROCK (SYMBOL)					1				2		14.25' 14.75' X								SALVAGE THE SIGNS ONTO A NEW SET OF POSTS			
		F	W7-3A	30	18		NEXT 2 MILES (PLAQUE)					1														SPAN THE PLAQUE ACROSS BOTH POSTS, AS EXISTING WAS			
SB	4.385	F	VD-062B	72	16		BUSINESS DIRECTORY SIGN			1				X												REDWING FARM & ===>			
		F	VD-062BRN	72	16		BUSINESS DIRECTORY SIGN			1																TOWNSHEND STATE PARK ===>			
SB	4.329	F	VW-205	30	30		WATCH FOR TURNING VEHICLES						1		X														
		F	VW-444	30	30		WATCH FOR FALLEN ROCK						1																	
SB	4.310	F	VW-205	36	36			9.00								2		12.75' 13.75 X								INSTALL 200 FEET ± SOUTH OF (BEYOND) PREVIOUS POSITION			E-154
SB	3.994	F	VW-060	30	30								1		X														
		F	VW-202	30	30								1																
							SHEET TOTALS	14.00 SF	0.00 SF	4 EA	2 EA	2 EA	7 ~~5~~ EA	0 EA	0 EA	5 EA										68.5 ~~75~~ FT				
							TOWN DIRECTIONAL TOTALS	304.7	0.0	25.0	2.0	2.0	68	0.0	0.0	55										825.0				

SIGN SUMMARY SHEET

VERMONT AGENCY OF TRANSPORTATION

PROJECT NAME: **STATEWIDE SOUTHEAST REGION**
PROJECT NUMBER: **STPG SIGN (31)**

FILE NAME: **TOWNSHEND SOUTHBOUND** PLOT DATE: **8/12/2010**
PROJECT MANAGER: **A. GAMBLE** DRAWN BY: **M. MILLER**
DESIGNED BY: **M. MILLER** CHECKED BY: **A. GAMBLE**
TOWNSHEND VT-30 SOUTHBOUND 3 SHEET **63** OF **175**

DIRECTION	MILEPOINT	LOCATION CODE (SHEET 2)	SIGN CODE	WIDTH (IN)	HEIGHT (IN)	SHEETING REMARKS	SIGN LEGEND	NEW SIGNS "A"	NEW SIGNS "B"	EXISTING SIGNS RETAIN	EXISTING SIGNS SALVAGE FROM	EXISTING SIGNS SALVAGE TO	EXISTING SIGNS REMOVE	EXIST POST RETAIN	EXIST POST REMOVE	NUMBER OF NEW POSTS	SQUARE STEEL (IN) 1.75 (LB / FT) 1.88	SQUARE STEEL (IN) 2.00 (LB / FT) 2.42	SQUARE STEEL (IN) 2.50 (LB / FT) 3.35	TUBULAR STEEL Ø (IN) FOUNDATION	TUBULAR STEEL Ø (IN) 3.00 (LB / FT) 7.60	TUBULAR STEEL Ø (IN) 3.50 (LB / FT) 9.00	TUBULAR STEEL Ø (IN) 4.00 (LB / FT) 10.80	TUBULAR STEEL Ø (IN) 5.00 (LB / FT) 14.60	SIGN FRAME REQUIRED	REMARKS	SIGN DETAIL: DETAIL IN SHS	SIGN DETAIL: DETAIL ON SHEET NUMBER	SIGN DETAIL: DETAIL ON STD SHEET NUMBER
TOWNSHEND SB							FY-FLUORESCENT YELLOW FYG-FLUORESCENT YELLOW GREEN																			"SHS"-STANDARD HIGHWAY SIGNS			
SB	3.994	F	VW-060	30	30		HIDDEN DRIVES	6.25								2		15.5' 16.25' X										E-154
		F	VW-202	30	30		TRUCKS ENTERING	6.25																				E-154
SB	3.502	G	VR-017	24	30		LEGAL LOAD LIMIT 24000 POUNDS			1				X												STEPHENSON CURVE N. (TH-48); NEWFANE-TOWNSHEND STP 2401(1) TO REPLACE IN 2010			
SB	3.496	H	R1-1	30	30		0300 1317 0341 STOP			1				X												NEWFANE-TOWNSHEND STP 2401(1) TO REPLACE IN 2010			
SB	3.380	F	VW-205	30	30		WATCH FOR TURNING VEHICLES						1		X														
		F	VW-205	36	36			9.00								2		13.75' 13.75' X								NOTE LARGER SIZE			E-154
SB	3.354	G	VR-017	24	30		LEGAL LOAD LIMIT 24000 POUNDS			1				X												STEPHENSON CURVE S. (TH-48); NEWFANE-TOWNSHEND STP 2401(1) TO REPLACE IN 2010			
SB	3.345	H	R1-1	30	30		STOP			1				X												NEWFANE-TOWNSHEND STP 2401(1) TO REPLACE IN 2010			
SB	2.552	F	R2-5A	24	30		REDUCED SPEED AHEAD						1		X														
		F	W3-5	36	36		SPEED LIMIT 40	9.00								2		14.0' 15.0' X									X		
SB	2.501	F	VD-018	30	18		TOWNSHEND HARMONYVILLE 1						1		X												TO BE REPLACED FURTHER AHEAD			
SB	2.463	F	R2-1	24	30		SPEED LIMIT 40						1		X														
		F	R2-1	30	36			7.50								1		14.0' X								NOTE LARGER SIZE		6	
SB	2.416	F	VD-018	30	18		Townshend Harmonyville 1	3.75								1		12.0' X								INSTALL 250 FT ± SOUTH OF (BEYOND) THE SPEED LIMIT 40 SIGN		8	
SB	2.352	F	R2-5A	24	30		REDUCED SPEED AHEAD						1		X														
SIGN SUMMARY SHEET							SHEET TOTALS	41.75	0.00	4	0	0	5	0	0	8		114.25 ~~120~~											
								SF	SF	EA	EA	EA	EA	EA	EA	EA		FT											
VERMONT AGENCY OF TRANSPORTATION							TOWN DIRECTIONAL TOTALS	304.7	0.0	25.0	2.0	2.0	68	0.0	0.0	55		825.0											

PROJECT NAME: **STATEWIDE SOUTHEAST REGION**
PROJECT NUMBER: **STPG SIGN (31)**

FILE NAME: **TOWNSHEND SOUTHBOUND** PLOT DATE: **8/12/2010**
PROJECT MANAGER: **A. GAMBLE** DRAWN BY: **M. MILLER**
DESIGNED BY: **M. MILLER** CHECKED BY: **A. GAMBLE**
TOWNSHEND VT-30 SOUTHBOUND 4 SHEET **64** OF **175**

DIRECTION	MILEPOINT	LOCATION CODE (SHEET 2)	SIGN CODE	WIDTH (IN)	HEIGHT (IN)	SHEETING REMARKS	SIGN LEGEND	NEW SIGNS "A"	NEW SIGNS "B"	EXISTING SIGNS RETAIN	EXISTING SIGNS SALVAGE FROM	EXISTING SIGNS SALVAGE TO	EXISTING SIGNS REMOVE	EXIST POST RETAIN	EXIST POST REMOVE	NUMBER OF NEW POSTS	SQUARE STEEL (IN) 1.75 (LB / FT) 1.88	SQUARE STEEL (IN) 2.00 (LB / FT) 2.42	SQUARE STEEL (IN) 2.50 (LB / FT) 3.35	TUBULAR STEEL Ø (IN) FOUNDATION	TUBULAR STEEL Ø (IN) 3.00 (LB / FT) 7.60	TUBULAR STEEL Ø (IN) 3.50 (LB / FT) 9.00	TUBULAR STEEL Ø (IN) 4.00 (LB / FT) 10.80	TUBULAR STEEL Ø (IN) 5.00 (LB / FT) 14.60	SIGN FRAME REQUIRED	REMARKS	SIGN DETAIL: DETAIL IN SHS	SIGN DETAIL: DETAIL ON SHEET NUMBER	SIGN DETAIL: DETAIL ON STD SHEET NUMBER
TOWNSHEND SB							FY-FLUORESCENT YELLOW FYG-FLUORESCENT YELLOW GREEN																			"SHS"-STANDARD HIGHWAY SIGNS			
SB	2.352	F	W3-5	36	36			9.00								2		14.0' 15.0' X									X		
SB	3 2.020	F	M4-11	24	12								1		X														
		F	R8-3A	24	24								1																
		F	VR-122	18	8								1																
		F	VR-644P	24	12			2.00								1		13.0' X								BLACK ON WHITE		6	
		F	R8-3A	24	24			4.00																			X		
		F	VR-071	24	10		12 P.M. - 6 A.M. NOV. 1 - APR. 1	1.67																				6	
SB	2.275	F	R2-1	24	30								1		X															
		F	R2-1	30	36			7.50								1		12.25' X								NOTE LARGER SIZE		6	
SB	2.231	F	S1-1	36	36	FYG							1		X														
		F	W16-9	36	20	FYG							1																
		F	S1-1	30	30	FYG		6.25								1		13.25' X								FLUORESCENT YELLOW-GREEN SHEETING ON BOTH SIGNS	X		
		F	W16-9	24	12	FYG		2.00																			X		
SB	2.208	G	VR-017	24	30		LEGAL LOAD LIMIT 24000 POUNDS			1				X												OAKWOOD CEMETERY RD (TH-54); NEWFANE-TOWNSHEND STP 2401(1) TO REPLACE IN 2010			
SB	2.204	H	R1-1	30	30		0300 1317 0219 STOP			1				X												NEWFANE-TOWNSHEND STP 2401(1) TO REPLACE IN 2010			
							SHEET TOTALS	32.42 SF	0.00 SF	2 EA	0 EA	0 EA	6 EA	0 EA	0 EA	5 EA	67.5 ~~75~~ FT										
							TOWN DIRECTIONAL TOTALS	304.7	0.0	25.0	2.0	2.0	68	0.0	0.0	55	825.0												

SIGN SUMMARY SHEET

VERMONT AGENCY OF TRANSPORTATION

PROJECT NAME: **STATEWIDE SOUTHEAST REGION**
PROJECT NUMBER: **STPG SIGN (31)**

FILE NAME: **TOWNSHEND SOUTHBOUND** PLOT DATE: **8/12/2010**
PROJECT MANAGER: **A. GAMBLE** DRAWN BY: **M. MILLER**
DESIGNED BY: **M. MILLER** CHECKED BY: **A. GAMBLE**
TOWNSHEND VT-30 SOUTHBOUND 5 SHEET **65** OF **175**

DIRECTION	MILEPOINT	LOCATION CODE (SHEET 2)	SIGN CODE	WIDTH (IN)	HEIGHT (IN)	SHEETING REMARKS	SIGN LEGEND	NEW SIGNS "A"	NEW SIGNS "B"	EXISTING SIGNS RETAIN	EXISTING SIGNS SALVAGE FROM	EXISTING SIGNS SALVAGE TO	EXISTING SIGNS REMOVE	EXIST POST RETAIN	EXIST POST REMOVE	NUMBER OF NEW POSTS	SQUARE STEEL (IN) 1.75 (LB / FT) 1.88	SQUARE STEEL (IN) 2.00 (LB / FT) 2.42	SQUARE STEEL (IN) 2.50 (LB / FT) 3.35	TUBULAR STEEL Ø (IN) FOUNDATION	TUBULAR STEEL Ø (IN) 3.00 (LB / FT) 7.60	TUBULAR STEEL Ø (IN) 3.50 (LB / FT) 9.00	TUBULAR STEEL Ø (IN) 4.00 (LB / FT) 10.80	TUBULAR STEEL Ø (IN) 5.00 (LB / FT) 14.60	SIGN FRAME REQUIRED	REMARKS	SIGN DETAIL: DETAIL IN SHS	SIGN DETAIL: DETAIL ON SHEET NUMBER	SIGN DETAIL: DETAIL ON STD SHEET NUMBER
TOWNSHEND SB							FY-FLUORESCENT YELLOW FYG-FLUORESCENT YELLOW GREEN																			"SHS"-STANDARD HIGHWAY SIGNS			
SB	2.200	F	M2-1	21	15								1		X													
		F	M1-6	24	24								1															
		F	M2-1	21	15			2.19								1		14.5' X									BLACK ON WHITE (NOT A STATE HIGHWAY)	X		
		F	M1-6	24	24			4.00																			BLACK ON WHITE (NOT A STATE HIGHWAY)		9	
SB	2.172	F	D1-1A	72	10								1		X													
		F	D1-1A	72	10								1															
		F	D1-1A	72	10		(6) DESTINATION / HOSPITAL SIGN ASSEMBLY						1															
		F	D1-1A	72	10								1															
		F	D9-2	24	24								1															
		F	N/A	24	6								1															
		F	D1-1A	72	12			6.00								2		14.75' 15.0' X										4	
		F	D1-1A	72	12			6.00																				4	
		F	D1-1A	72	12		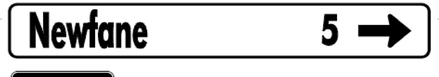	6.00																				4	
		F	D9-2	24	24			4.00																			INSTALL HOSPITAL SIGNS ON LEFT-SIDE POST	X		
		F	M6-1L	21	15			2.19																			HOSPITAL SIGN AND LEFT ARROW ARE WHITE ON BLUE	X		
							SHEET TOTALS	30.38	0.00	0	0	0	8	0	0	3		44.25 ~~45~~										
								SF	SF	EA	EA	EA	EA	EA	EA	EA		FT										
							TOWN DIRECTIONAL TOTALS	304.7	0.0	25.0	2.0	2.0	68	0.0	0.0	55		825.0										

SIGN SUMMARY SHEET

VERMONT AGENCY OF TRANSPORTATION

PROJECT NAME: **STATEWIDE SOUTHEAST REGION**
PROJECT NUMBER: **STPG SIGN (31)**

FILE NAME: **TOWNSHEND SOUTHBOUND** PLOT DATE: **8/12/2010**
PROJECT MANAGER: **A. GAMBLE** DRAWN BY: **M. MILLER**
DESIGNED BY: **M. MILLER** CHECKED BY: **A. GAMBLE**
TOWNSHEND VT-30 SOUTHBOUND 6 SHEET **66** OF **175**

DIRECTION	MILEPOINT	LOCATION CODE (SHEET 2)	SIGN CODE	WIDTH (IN)	HEIGHT (IN)	SHEETING REMARKS	SIGN LEGEND	NEW SIGNS "A"	NEW SIGNS "B"	EXISTING SIGNS RETAIN	EXISTING SIGNS SALVAGE FROM	EXISTING SIGNS SALVAGE TO	EXISTING SIGNS REMOVE	EXIST POST RETAIN	EXIST POST REMOVE	NUMBER OF NEW POSTS	SQUARE STEEL (IN) 1.75 (LB / FT) 1.88	SQUARE STEEL (IN) 2.00 (LB / FT) 2.42	SQUARE STEEL (IN) 2.50 (LB / FT) 3.35	TUBULAR STEEL Ø (IN) FOUNDATION	TUBULAR STEEL Ø (IN) 3.00 (LB / FT) 7.60	TUBULAR STEEL Ø (IN) 3.50 (LB / FT) 9.00	TUBULAR STEEL Ø (IN) 4.00 (LB / FT) 10.80	TUBULAR STEEL Ø (IN) 5.00 (LB / FT) 14.60	SIGN FRAME REQUIRED	REMARKS	SIGN DETAIL: DETAIL IN SHS	SIGN DETAIL: DETAIL ON SHEET NUMBER	SIGN DETAIL: DETAIL ON STD SHEET NUMBER
TOWNSHEND SB							FY-FLUORESCENT YELLOW FYG-FLUORESCENT YELLOW GREEN																			"SHS"-STANDARD HIGHWAY SIGNS			
SB	2.170	F	R8-3A	24	24								1		X														
		F	VR-071	24	10								1																
		F	R8-3A	24	24			4.00								1		13.25' X									X	
		F	VR-071	24	10			1.67																				6
SB	2.148	F	W1-10R	30	30								2 ~~1~~		X											ANOTHER SIGN WAS REMOVED AT THIS LOCATION			
		F	W1-10R	30	30			6.25								1		13.5' X									X	
SB	2.131	F	S1-1	30	30	FYG							1		X														
		F	W16-7	24	12	FYG							1																
		F	S1-1	30	30	FYG		6.25								1		13.75' X							FLUORESCENT YELLOW-GREEN SHEETING ON BOTH SIGNS	X		
		F	W16-7	24	12	FYG		2.00																			X	
SB	2.097	F	M3-1	24	12								1		X														
		F	M1-6	24	24								1																
		F	M6-1L	21	15		(6) SIGN ROUTE MARKER ASSEMBLY						1																
		F	M3-3	24	12								1																
		F	M1-5	24	24								1																
							SHEET TOTALS	20.17	0.00	0	0	0	~~11~~ ~~10~~	0	0	3		~~40.5~~ ~~45~~										
								SF	SF	EA	EA	EA	EA	EA	EA	EA		FT										
							TOWN DIRECTIONAL TOTALS	304.7	0.0	25.0	2.0	2.0	68	0.0	0.0	55		825.0										

SIGN SUMMARY SHEET

VERMONT AGENCY OF TRANSPORTATION

PROJECT NAME: **STATEWIDE SOUTHEAST REGION**
PROJECT NUMBER: **STPG SIGN (31)**

FILE NAME: **TOWNSHEND SOUTHBOUND** PLOT DATE: **8/12/2010**
PROJECT MANAGER: **A. GAMBLE** DRAWN BY: **M. MILLER**
DESIGNED BY: **M. MILLER** CHECKED BY: **A. GAMBLE**
TOWNSHEND VT-30 SOUTHBOUND 7 SHEET **67** OF **175**

DIRECTION	MILEPOINT	LOCATION CODE (SHEET 2)	SIGN CODE	WIDTH (IN)	HEIGHT (IN)	SHEETING REMARKS	SIGN LEGEND	NEW SIGNS "A"	NEW SIGNS "B"	EXISTING SIGNS RETAIN	EXISTING SIGNS SALVAGE FROM	EXISTING SIGNS SALVAGE TO	EXISTING SIGNS REMOVE	EXIST POST RETAIN	EXIST POST REMOVE	NUMBER OF NEW POSTS	SQUARE STEEL (IN) (LB / FT) 1.75 / 1.88	SQUARE STEEL (IN) (LB / FT) 2.00 / 2.42	SQUARE STEEL (IN) (LB / FT) 2.50 / 3.35	TUBULAR STEEL Ø (IN) FOUNDATION	TUBULAR STEEL Ø (IN) (LB / FT) 3.00 / 7.60	TUBULAR STEEL Ø (IN) (LB / FT) 3.50 / 9.00	TUBULAR STEEL Ø (IN) (LB / FT) 4.00 / 10.80	TUBULAR STEEL Ø (IN) (LB / FT) 5.00 / 14.60	SIGN FRAME REQUIRED	REMARKS	SIGN DETAIL: DETAIL IN SHS	SIGN DETAIL: DETAIL ON SHEET NUMBER	SIGN DETAIL: DETAIL ON STD SHEET NUMBER
TOWNSHEND SB							FY-FLUORESCENT YELLOW FYG-FLUORESCENT YELLOW GREEN																			"SHS"-STANDARD HIGHWAY SIGNS			
SB	2.097	F	M6-2	21	15								1															
		F	M3-1	24	12			2.00								2		14.5' 14.5' X						#1	**BLACK ON WHITE**	X		
		F	M1-6	24	24			4.00																				9	
		F	M6-1L	21	15			2.19																			**BLACK ON WHITE**	X		
		F	M3-3	24	12			2.00																			**GREEN ON WHITE**	X		
		F	M1-5	24	24			4.00																						E-136B
		F	M5-1R	21	15			2.19																			**GREEN ON WHITE**; NOTE DIFFERENT ARROW FROM EXISTING	X		
SB	2.043	F	R8-3A	24	24								1		X														
		F	VR-071	24	10								1																
		F	R8-3A	24	24			4.00								1		12.75' X								X		
		F	VR-071	24	10			1.67																					6	
SB	2.027	F	M3-3	24	12								1		X														
		F	M1-5	24	24								1																
		F	M3-3	24	12			2.00								1		12.75' X							**GREEN ON WHITE**	X		
		F	M1-5	24	24		0300 1317 0200	4.00																					E-136B
SIGN SUMMARY SHEET							SHEET TOTALS	28.05	0.00	0	0	0	5	0	0	4		54.5 60										
VERMONT AGENCY OF TRANSPORTATION								SF	SF	EA	EA	EA	EA	EA	EA	EA		FT										
							TOWN DIRECTIONAL TOTALS	304.7	0.0	25.0	2.0	2.0	68	0.0	0.0	55		825.0										

PROJECT NAME: **STATEWIDE SOUTHEAST REGION**
PROJECT NUMBER: **STPG SIGN (31)**

FILE NAME: **TOWNSHEND SOUTHBOUND** PLOT DATE: **8/12/2010**
PROJECT MANAGER: **A. GAMBLE** DRAWN BY: **M. MILLER**
DESIGNED BY: **M. MILLER** CHECKED BY: **A. GAMBLE**
TOWNSHEND VT-30 SOUTHBOUND 8 SHEET **68** OF **175**

DIRECTION	MILEPOINT	LOCATION CODE (SHEET 2)	SIGN CODE	WIDTH (IN)	HEIGHT (IN)	SHEETING REMARKS	SIGN LEGEND	NEW SIGNS "A"	NEW SIGNS "B"	EXISTING SIGNS RETAIN	EXISTING SIGNS SALVAGE FROM	EXISTING SIGNS SALVAGE TO	EXISTING SIGNS REMOVE	EXIST POST RETAIN	EXIST POST REMOVE	NUMBER OF NEW POSTS	SQUARE STEEL (IN) 1.75 (LB / FT) 1.88	SQUARE STEEL (IN) 2.00 (LB / FT) 2.42	SQUARE STEEL (IN) 2.50 (LB / FT) 3.35	TUBULAR STEEL Ø (IN) FOUNDATION	TUBULAR STEEL Ø (IN) 3.00 (LB / FT) 7.60	TUBULAR STEEL Ø (IN) 3.50 (LB / FT) 9.00	TUBULAR STEEL Ø (IN) 4.00 (LB / FT) 10.80	TUBULAR STEEL Ø (IN) 5.00 (LB / FT) 14.60	SIGN FRAME REQUIRED	REMARKS	SIGN DETAIL: DETAIL IN SHS	SIGN DETAIL: DETAIL ON SHEET NUMBER	SIGN DETAIL: DETAIL ON STD SHEET NUMBER
TOWNSHEND SB							FY-FLUORESCENT YELLOW FYG-FLUORESCENT YELLOW GREEN																			"SHS"-STANDARD HIGHWAY SIGNS			
SB	1.990	F	W11-2	30	30		PEDESTRIAN SYMBOL			1				X												NEWFANE-TOWNSHEND STP 2401(1) TO REPLACE IN 2010			
		F	W16-7	24	12		DIAGONAL ARROW			1																		
SB	1.966	F	R2-1	24	30								1		X														
		F	R2-1	24	30			5.00								1		12.5' X								X		
SB	1.929	F	R8-3A	24	24								1		X														
		F	VR-071	24	10								1																
		F	R8-3A	24	24			4.00								1		12.5' X							X		
		F	VR-071	24	10		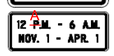	1.67																			6
SB	1.848	F	R2-1	24	30								1		X														
		F	R2-1	24	30			5.00								1		12.75' X								X		
SB	1.811	F	M4-6	24	12								1		X														
		F	R8-3A	24	24								1																
		F	VR-071	24	10		END						1																
		F	M4-6	24	12			2.00								1		14.0' X							BLACK ON WHITE; INSTALL ON TOP	X		
		F	R8-3A	24	24		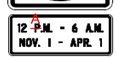	4.00								~~1~~											X		
							SHEET TOTALS	21.67	0.00	2	0	0	7	0	0	~~4~~ 5		51.75 75									
								SF	SF	EA	EA	EA	EA	EA	EA	EA		FT									
							TOWN DIRECTIONAL TOTALS	304.7	0.0	25.0	2.0	2.0	68	0.0	0.0	55		825.0									

SIGN SUMMARY SHEET

VERMONT AGENCY OF TRANSPORTATION

PROJECT NAME: **STATEWIDE SOUTHEAST REGION**
PROJECT NUMBER: **STPG SIGN (31)**

FILE NAME: **TOWNSHEND SOUTHBOUND** PLOT DATE: **8/12/2010**
PROJECT MANAGER: **A. GAMBLE** DRAWN BY: **M. MILLER**
DESIGNED BY: **M. MILLER** CHECKED BY: **A. GAMBLE**
TOWNSHEND VT-30 SOUTHBOUND 9 SHEET **69** OF **175**

DIRECTION	MILEPOINT	LOCATION CODE (SHEET 2)	SIGN CODE	WIDTH (IN)	HEIGHT (IN)	SHEETING REMARKS	SIGN LEGEND	NEW SIGNS "A"	NEW SIGNS "B"	EXISTING SIGNS RETAIN	EXISTING SIGNS SALVAGE FROM	EXISTING SIGNS SALVAGE TO	EXISTING SIGNS REMOVE	EXIST POST RETAIN	EXIST POST REMOVE	NUMBER OF NEW POSTS	SQUARE STEEL (IN) 1.75 (LB / FT) 1.88	SQUARE STEEL (IN) 2.00 (LB / FT) 2.42	SQUARE STEEL (IN) 2.50 (LB / FT) 3.35	TUBULAR STEEL Ø (IN) FOUNDATION	TUBULAR STEEL Ø (IN) 3.00 (LB / FT) 7.60	TUBULAR STEEL Ø (IN) 3.50 (LB / FT) 9.00	TUBULAR STEEL Ø (IN) 4.00 (LB / FT) 10.80	TUBULAR STEEL Ø (IN) 5.00 (LB / FT) 14.60	SIGN FRAME REQUIRED	REMARKS	SIGN DETAIL: DETAIL IN SHS	SIGN DETAIL: DETAIL ON SHEET NUMBER	SIGN DETAIL: DETAIL ON STD SHEET NUMBER
TOWNSHEND SB							FY-FLUORESCENT YELLOW FYG-FLUORESCENT YELLOW GREEN																			"SHS"-STANDARD HIGHWAY SIGNS			
		F	VR-071	24	10			1.67																				6
SB	1.692	F	VD-062B	72	16		BUSINESS DIRECTORY SIGN			1				X												CAMPERAMA ===>		
SB	1.617	F	VD-018	30	18								1		X													
		F	VD-018	30	18			3.75								1		12.5' X									8
SB	1.546	F	R2-1	24	30		0300 1317 0160						1		X													
		F	R2-1	24	30			5.00								1		13.0' X								X	
SB	1.502	F	W5-2	30	30		NARROW BRIDGE						1		X													
		F	VW-060	30	30		HIDDEN DRIVES						1															
SB	1.448	G	VR-017	24	30		LEGAL LOAD LIMIT 24000 POUNDS			1				X												DEPOT ROAD (TH-35); NEWFANE-TOWNSHEND STP 2401(1) TO REPLACE IN 2010		
SB	1.444	H	R1-1	30	30		0300 1317 0143 STOP			1				X												NEWFANE-TOWNSHEND STP 2401(1) TO REPLACE IN 2010		
SB	1.078	F	W2-2R	30	30		RIGHT SIDE ROAD (SYMBOL)						1		X													
SB	1.048	F	R2-1	24	30								1		X													
		F	R2-1	24	30			5.00								1		13.0' X								X	
SB	0.827	G	VR-017	24	30		LEGAL LOAD LIMIT 24000 POUNDS			1				X												RIVERDALE ROAD (TH-55); NEWFANE-TOWNSHEND STP 2401(1) TO REPLACE IN 2010		
SB	0.817	H	R1-1	30	30		0300 1317 0082 STOP			1				X												NEWFANE-TOWNSHEND STP 2401(1) TO REPLACE IN 2010		
SIGN SUMMARY SHEET							SHEET TOTALS	15.42	0.00	5	0	0	6	0	0	3		38.5 ~~45~~										
								SF	SF	EA	EA	EA	EA	EA	EA	EA		FT										
VERMONT AGENCY OF TRANSPORTATION							TOWN DIRECTIONAL TOTALS	304.7	0.0	25.0	2.0	2.0	68	0.0	0.0	55		825.0										

PROJECT NAME: **STATEWIDE SOUTHEAST REGION**
PROJECT NUMBER: **STPG SIGN (31)**

FILE NAME: **TOWNSHEND SOUTHBOUND** PLOT DATE: **8/12/2010**
PROJECT MANAGER: **A. GAMBLE** DRAWN BY: **M. MILLER**
DESIGNED BY: **M. MILLER** CHECKED BY: **A. GAMBLE**
TOWNSHEND VT-30 SOUTHBOUND 10 SHEET **70** OF **175**

DIRECTION	MILEPOINT	LOCATION CODE (SHEET 2)	SIGN CODE	WIDTH (IN)	HEIGHT (IN)	SHEETING REMARKS	SIGN LEGEND	NEW SIGNS "A"	NEW SIGNS "B"	EXISTING SIGNS RETAIN	EXISTING SIGNS SALVAGE FROM	EXISTING SIGNS SALVAGE TO	EXISTING SIGNS REMOVE	EXIST POST RETAIN	EXIST POST REMOVE	NUMBER OF NEW POSTS	SQUARE STEEL (IN) 1.75 (LB / FT) 1.88	SQUARE STEEL (IN) 2.00 (LB / FT) 2.42	SQUARE STEEL (IN) 2.50 (LB / FT) 3.35	TUBULAR STEEL Ø (IN) FOUNDATION	TUBULAR STEEL Ø (IN) 3.00 (LB / FT) 7.60	TUBULAR STEEL Ø (IN) 3.50 (LB / FT) 9.00	TUBULAR STEEL Ø (IN) 4.00 (LB / FT) 10.80	TUBULAR STEEL Ø (IN) 5.00 (LB / FT) 14.60	SIGN FRAME REQUIRED	REMARKS	SIGN DETAIL: DETAIL IN SHS	SIGN DETAIL: DETAIL ON SHEET NUMBER	SIGN DETAIL: DETAIL ON STD SHEET NUMBER
TOWNSHEND SB							FY-FLUORESCENT YELLOW FYG-FLUORESCENT YELLOW GREEN																			"SHS"-STANDARD HIGHWAY SIGNS			
SB	0.393	F	VD-062B	72	16		BUSINESS DIRECTORY SIGN			1				X												BALD MOUNTAIN RIGHT ===>			
SB	0.330	F	W1-10L	30	30		LEFT CURVE w/ SIDE ROAD RIGHT (SYMBOL)						1		X												TO BE REPLACED FURTHER AHEAD			
		F	W13-1	18	18		40 MPH (PLAQUE)						1																
SB	0.256	F	S1-1YG	36	36	FYG	SCHOOL (SYMBOL)						1		X												TO BE REPLACED FURTHER AHEAD			
		F	W16-9FYG	24	10	FYG	AHEAD (PLAQUE)						1																
		F	W1-10L	36	36			9.00								2		13.0' 14.0' X									X		
		F	W13-1	24	24			4.00																		INSTALL PLAQUE ON LEFT POST	X		
SB	0.153	F	S1-1	36	36	FYG		9.00								2		12.5' 13.25' X								BOTH NEW SIGNS HAVE FLUORESCENT YELLOW-GREEN BACKGROUND SHEETING;	X		
		F	S4-3P	24	8	FYG		1.33																		INSTALL THE NEW SIGNS ON SOUTH END OF BRIDGE, 525 FEET ± SOUTH OF THE PREVIOUS POSITION	X		
SB	0.097	G	VR-017	24	30		LEGAL LOAD LIMIT 24000 POUNDS			1				X												STATE FOREST ROAD (TH-4); NEWFANE-TOWNSHEND STP 2401(1) TO REPLACE IN 2010			
SB	0.085	H	R1-1	30	30		0300 1317 0058 STOP			1				X												NEWFANE-TOWNSHEND STP 2401(1) TO REPLACE IN 2010			
SB	0.097	H	R1-1	30	30		STOP						1	X												SIGN WAS REMOVED. IT WAS LOCATED ON THE LT. SIDE OF THE SIDE OF THE ROAD AND WAS NOT NEEDED.			
							SHEET TOTALS	23.33	0.00	3	0	0	5 ~~4~~	0	0	4										52.75 ~~60~~				
								SF	SF	EA	EA	EA	EA	EA	EA	EA										FT			
							TOWN DIRECTIONAL TOTALS	304.7	0.0	25.0	2.0	2.0	68	0.0	0.0	55										825.0			

SIGN SUMMARY SHEET

VERMONT AGENCY OF TRANSPORTATION

PROJECT NAME: **STATEWIDE SOUTHEAST REGION**
PROJECT NUMBER: **STPG SIGN (31)**

FILE NAME: **TOWNSHEND SOUTHBOUND** PLOT DATE: **8/12/2010**
PROJECT MANAGER: **A. GAMBLE** DRAWN BY: **M. MILLER**
DESIGNED BY: **M. MILLER** CHECKED BY: **A. GAMBLE**
TOWNSHEND VT-30 SOUTHBOUND 11 SHEET **71** OF **175**

DIRECTION	MILEPOINT	LOCATION CODE (SHEET 2)	SIGN CODE	WIDTH (IN)	HEIGHT (IN)	SHEETING REMARKS	SIGN LEGEND	NEW SIGNS "A"	NEW SIGNS "B"	EXISTING SIGNS RETAIN	EXISTING SIGNS SALVAGE FROM	EXISTING SIGNS SALVAGE TO	EXISTING SIGNS REMOVE	EXIST POST RETAIN	EXIST POST REMOVE	NUMBER OF NEW POSTS	SQUARE STEEL (IN) 1.75 (LB / FT) 1.88	SQUARE STEEL (IN) 2.00 (LB / FT) 2.42	SQUARE STEEL (IN) 2.50 (LB / FT) 3.35	TUBULAR STEEL Ø (IN) FOUNDATION	TUBULAR STEEL Ø (IN) 3.00 (LB / FT) 7.60	TUBULAR STEEL Ø (IN) 3.50 (LB / FT) 9.00	TUBULAR STEEL Ø (IN) 4.00 (LB / FT) 10.80	TUBULAR STEEL Ø (IN) 5.00 (LB / FT) 14.60	SIGN FRAME REQUIRED	REMARKS	SIGN DETAIL: DETAIL IN SHS	SIGN DETAIL: DETAIL ON SHEET NUMBER	SIGN DETAIL: DETAIL ON STD SHEET NUMBER
ROCKINGHAM NB							FY-FLUORESCENT YELLOW FYG-FLUORESCENT YELLOW GREEN																			"SHS"-STANDARD HIGHWAY SIGNS			
NB	1.520	B	VR-038	24	18		STATE HIGHWAY ENDS						1		X											SIGN IS ON BACK			
		A	R2-1	24	30		SPEED LIMIT 40						1																
		A	VR-041	24	24		THROUGH WAY BEGINS HERE						1																
		A	VR-039	24	18		STATE HIGHWAY BEGINS / SPEED LIMIT 40	3.00								1		13.0' X									INSTALL ON TOP		6	
		A	R2-1	24	30			5.00																				X		
NB	1.576	A	M3-1	24	12		NORTH / 5	2.00								1		13.75' X									INSTALL 5 TO 10 FT ± IN ADVANCE OF THE EXISTING SIGNS, DUE TO THE TREE	X		
		A	M1-4	24	24			4.00																				X		
NB	1.578	A	M3-1	24	12		NORTH						1		X															
		A	M1-4	24	24		US-5						1																	
NB	1.852	A	VR-644P	24	12		BEGIN / R	2.00								1		14.0' X									INSTALL ON TOP. **BLACK LETTERS ON WHITE BACKGROUND.**		6	
		A	R8-3A	24	24			4.00																			INSTALL ACROSS FROM ± THE SB FACING "NO PARKING END" SIGNS	X		
NB	1.896	A	R8-3A	24	24		NO PARKING SYMBOL						1		X															
		A	N/A	12	18		BUS ROUTE SIGN (PVT)				~~2~~ X		2														PRIVATE BUS ROUTE SIGN TO BE REMOVED AND SALVAGED - 2 SIGNS			
		A	R8-3A	24	24		R	4.00								1		13.0' X										X		
		A	N/A	12	18		BUS ROUTE SIGN (PVT)					~~2~~ 1															SALVAGE TO BELOW THE NEW NO PARKING SYMBOL			
							SHEET TOTALS	24.00	0.00	0	~~2~~ 0	~~2~~ 1	~~8~~ 6	0	0	4		~~53.75~~ 60											
								SF	SF	EA	EA	EA	EA	EA	EA	EA		FT											
							TOWN DIRECTIONAL TOTALS	506.0	0.0	9.0	6.0	7.0	93	0.0	0.0	76		1140.0											

SIGN SUMMARY SHEET

VERMONT AGENCY OF TRANSPORTATION

PROJECT NAME: **STATEWIDE SOUTHEAST REGION**
PROJECT NUMBER: **STPG SIGN (31)**

FILE NAME: **ROCKINGHAM NORTHBOUND** PLOT DATE: **8/13/2010**
PROJECT MANAGER: **A. GAMBLE** DRAWN BY: **M. MILLER**
DESIGNED BY: **M. MILLER** CHECKED BY: **A. GAMBLE**
ROCKINGHAM US-5 NORTHBOUND 1 SHEET **72** OF **175**

DIRECTION	MILEPOINT	LOCATION CODE (SHEET 2)	SIGN CODE	WIDTH (IN)	HEIGHT (IN)	SHEETING REMARKS	SIGN LEGEND	NEW SIGNS "A"	NEW SIGNS "B"	EXISTING SIGNS RETAIN	EXISTING SIGNS SALVAGE FROM	EXISTING SIGNS SALVAGE TO	EXISTING SIGNS REMOVE	EXIST POST RETAIN	EXIST POST REMOVE	NUMBER OF NEW POSTS	SQUARE STEEL (IN) 1.75 (LB / FT) 1.88	SQUARE STEEL (IN) 2.00 (LB / FT) 2.42	SQUARE STEEL (IN) 2.50 (LB / FT) 3.35	TUBULAR STEEL Ø (IN) FOUNDATION	TUBULAR STEEL Ø (IN) 3.00 (LB / FT) 7.60	TUBULAR STEEL Ø (IN) 3.50 (LB / FT) 9.00	TUBULAR STEEL Ø (IN) 4.00 (LB / FT) 10.80	TUBULAR STEEL Ø (IN) 5.00 (LB / FT) 14.60	SIGN FRAME REQUIRED	REMARKS	SIGN DETAIL: DETAIL IN SHS	SIGN DETAIL: DETAIL ON SHEET NUMBER	SIGN DETAIL: DETAIL ON STD SHEET NUMBER
ROCKINGHAM NB							FY-FLUORESCENT YELLOW FYG-FLUORESCENT YELLOW GREEN																			"SHS"-STANDARD HIGHWAY SIGNS			
NB	1.916	A	R8-3A	24	24		NO PARKING SYMBOL						1		X											SIGN ASSEMBLY IS BEHIND RAIL			
		A	M4-6	24	12		END (PLAQUE)						1																
NB	1.933	A	M4-6	24	12		END	2.00																		INSTALL ON TOP. **BLACK LETTERS ON WHITE BACKGROUND.**	X		
		A	R8-3A	24	24		®	4.00								1		14.25' X							INSTALL ASSEMBLY BEHIND RAIL 100 FEET ± NORTH OF REMOVAL.	X		
NB	1.963	A	R2-1	24	30								1		X														
		A	R2-1	24	30		SPEED LIMIT 50	5.00								1		13.5' X								X		
NB	2.247	A	M3-1	24	12		NORTH						1		X														
		A	M1-4	24	24		US 5						1																
NB	2.364	A	R2-5A	24	30		REDUCED SPEED AHEAD						1		X														
NB	2.411	A	VD-062AS	72	16		0050 1314 0240 BUSINESS DIRECTORY SIGN			1				X												MORNING STAR <===			
NB	2.455	A	W2-2	30	30			6.25								1		13.75' X								INSTALL 225 FT± IN ADVANCE OF "SPEED LIMIT 45 / DO NOT PASS" SIGN ASSEMBLY.	X		
		A	W16-8aP	24	15		Darby Hill Rd	2.50																		WILL BE BEHIND RAIL		7	
NB	2.498	A	R2-1	24	30								1																
		A	R4-1	24	30		SPEED LIMIT 45						1																
		A	R2-1	24	30		DO NOT PASS	5.00								1		15.75' X								X		
SIGN SUMMARY SHEET							SHEET TOTALS	24.75	0.00	1	0	0	8	0	0	4		57.25 ~~60~~										
								SF	SF	EA	EA	EA	EA	EA	EA	EA		FT										
VERMONT AGENCY OF TRANSPORTATION							TOWN DIRECTIONAL TOTALS	506.0	0.0	9.0	6.0	7.0	93	0.0	0.0	76		1140.0										

PROJECT NAME: **STATEWIDE SOUTHEAST REGION**
PROJECT NUMBER: **STPG SIGN (31)**

FILE NAME: **ROCKINGHAM NORTHBOUND** PLOT DATE: **8/13/2010**
PROJECT MANAGER: **A. GAMBLE** DRAWN BY: **M. MILLER**
DESIGNED BY: **M. MILLER** CHECKED BY: **A. GAMBLE**
ROCKINGHAM US-5 NORTHBOUND 2 SHEET **73** OF **175**

DIRECTION	MILEPOINT	LOCATION CODE (SHEET 2)	SIGN CODE	WIDTH (IN)	HEIGHT (IN)	SHEETING REMARKS	SIGN LEGEND	NEW SIGNS "A"	NEW SIGNS "B"	EXISTING SIGNS RETAIN	EXISTING SIGNS SALVAGE FROM	EXISTING SIGNS SALVAGE TO	EXISTING SIGNS REMOVE	EXIST POST RETAIN	EXIST POST REMOVE	NUMBER OF NEW POSTS	SQUARE STEEL (IN) 1.75 (LB / FT) 1.88	SQUARE STEEL (IN) 2.00 (LB / FT) 2.42	SQUARE STEEL (IN) 2.50 (LB / FT) 3.35	TUBULAR STEEL Ø (IN) FOUNDATION	TUBULAR STEEL Ø (IN) 3.00 (LB / FT) 7.60	TUBULAR STEEL Ø (IN) 3.50 (LB / FT) 9.00	TUBULAR STEEL Ø (IN) 4.00 (LB / FT) 10.80	TUBULAR STEEL Ø (IN) 5.00 (LB / FT) 14.60	SIGN FRAME REQUIRED	REMARKS	SIGN DETAIL: DETAIL IN SHS	SIGN DETAIL: DETAIL ON SHEET NUMBER	SIGN DETAIL: DETAIL ON STD SHEET NUMBER
ROCKINGHAM NB							FY-FLUORESCENT YELLOW FYG-FLUORESCENT YELLOW GREEN																			"SHS"-STANDARD HIGHWAY SIGNS			
		A	R4-1	24	30			5.00																		INSTALL BELOW SPEED LIMIT SIGN.	X		
NB	2.635	A	D17-2	42	42		TRUCK LANE ¼ MILE	12.25								2		14.25' 16.25' X								**SIGN CODE NOT YET IN SHS**; INSTALL BEHIND RAIL 175 FT ± NORTH OF DARBY HILL RD (TH-46)		9	
NB	2.696	A	VD-062AL	72	16		BUSINESS DIRECTORY SIGN			1				X												WHITNEY ===>			
NB	2.708	A	R4-6	24	30		TRUCK LANE 500 FEET						1		X														
NB	2.752	A	VR-417	30	30		END NO PASSING						1		X														
NB	2.777	C	VR-017	24	30		LEGAL LOAD LIMIT 24,000 POUNDS																				BEZANSON ROAD (TH-48); **EXISTING SIGN AND POST MISSING**			
		C	VR-017	24	30			5.00								1		13.0' X										6	
NB	2.791	D	R1-1	30	30		STOP 0050 1314 0280						1		X														
		D	R1-1	30	30			6.25								1		13.0' X								INDUSTRIAL DRIVE TH 83- STREET SIGN RETAINED ON SEPARATE POST MILE MARKER RE-INSTALLED ON NEW POST		X	
NB	2.798	A	R4-3	24	30		SLOWER TRAFFIC KEEP RIGHT						1		X														
		B	W14-3	48	36		NO PASSING ZONE PENNANT (ON BACK)						1														NOT WARRANTED, WILL NOT BE REPLACED			
		A	VR-417	30	30		END NO PASSING	6.25								1		15.0' X										6	
		A	R4-3	24	30		SLOWER TRAFFIC KEEP RIGHT	5.00																		INSTALL ON BOTTOM	X		
NB	2.836	A	M3-1	24	12		NORTH 5	2.00								1		14.25' X								INSTALL BEHIND RAIL 200 FEET ± NORTH OF SIGN ASSEMBLY ABOVE	X		
		A	M1-4	24	24			4.00																			X		
SIGN SUMMARY SHEET							SHEET TOTALS	45.75	0.00	1	0	0	5	0	0	6		~~85.75~~ ~~90~~											
VERMONT AGENCY OF TRANSPORTATION								SF	SF	EA	EA	EA	EA	EA	EA	EA		FT											
							TOWN DIRECTIONAL TOTALS	506.0	0.0	9.0	6.0	7.0	93	0.0	0.0	76		1140.0											

PROJECT NAME: **STATEWIDE SOUTHEAST REGION**
PROJECT NUMBER: **STPG SIGN (31)**

FILE NAME: **ROCKINGHAM NORTHBOUND** PLOT DATE: **8/13/2010**
PROJECT MANAGER: **A. GAMBLE** DRAWN BY: **M. MILLER**
DESIGNED BY: **M. MILLER** CHECKED BY: **A. GAMBLE**
ROCKINGHAM US-5 NORTHBOUND 3 SHEET **74** OF **175**

DIRECTION	MILEPOINT	LOCATION CODE (SHEET 2)	SIGN CODE	WIDTH (IN)	HEIGHT (IN)	SHEETING REMARKS	SIGN LEGEND	NEW SIGNS "A"	NEW SIGNS "B"	EXISTING SIGNS RETAIN	EXISTING SIGNS SALVAGE FROM	EXISTING SIGNS SALVAGE TO	EXISTING SIGNS REMOVE	EXIST POST RETAIN	EXIST POST REMOVE	NUMBER OF NEW POSTS	SQUARE STEEL (IN) 1.75 / 2.00 / 2.50 (LB / FT) 1.88 / 2.42 / 3.35	TUBULAR STEEL Ø (IN) 3.00 / 3.50 / 4.00 / 5.00 (LB / FT) 7.60 / 9.00 / 10.80 / 14.60	FOUNDATION	SIGN FRAME REQUIRED	REMARKS	SIGN DETAIL: DETAIL IN SHS	SIGN DETAIL: DETAIL ON SHEET NUMBER	SIGN DETAIL: DETAIL ON STD SHEET NUMBER
ROCKINGHAM NB							FY-FLUORESCENT YELLOW FYG-FLUORESCENT YELLOW GREEN														"SHS"-STANDARD HIGHWAY SIGNS			
NB	2.864	A	R2-1	24	30		SPEED LIMIT 45	5.00								1	14.75' X				INSTALL BEHIND RAIL 150 FEET ± NORTH OF "NORTH US-5" SIGN ASSEMBLY.	X		
NB	3.062	A	W9-1	36	36		RIGHT LANE ENDS	9.00								2	10.0' 11.25' X				TEXT SIGN. INSTALL 250 FT ± IN ADVANCE OF "RIGHT LANE DROP" SYMBOL AHEAD (NEXT ENTRY).	X		
NB	3.109	A	W4-2R	30	30								1		X									
		A	W4-2R	36	36			9.00								2	10.0' 11.0' X					X		
NB	3.147	A	VR-186E	24	30		TRUCK LANE ENDS						1		X									
NB	3.184	A	VW-205	30	30		WATCH FOR TURNING VEHICLES						1		X									
NB	3.203	A	VW-205	36	36		WATCH FOR TURNING VEHICLES	9.00								2	14.75' 15.0' X				INSTALL 100 FT ± NORTH OF PREVIOUS POSITION			E-154
NB	3.278	A	R2-1	24	30								1		X									
		A	R4-1	24	30								1		X									
		A	R2-1	24	30		SPEED LIMIT 45	5.00								1	16.25' X				SPEED LIMIT SIGN IN UPPER POSITION.	X		
		A	R4-1	24	30		DO NOT PASS	5.00														X		
NB	3.317	C	VR-017	24	30																SPENCER DRIVE (TH-83); **SIGN AND POST MISSING**			
		C	VR-017	24	30		LEGAL LOAD LIMIT 24,000 POUNDS	5.00								1	13.0' X						6	
NB	3.324	D	R1-1	30	30		STOP						1		X									
		A		36	8		SPENCER DRIVE (TH-83)				1													
							SHEET TOTALS	47.00	0.00	0	1	0	6	0	0	9	116 ~~135~~							
								SF	SF	EA	EA	EA	EA	EA	EA	EA	FT							
							TOWN DIRECTIONAL TOTALS	506.0	0.0	9.0	6.0	7.0	93	0.0	0.0	76	1140.0							

SIGN SUMMARY SHEET

VERMONT AGENCY OF TRANSPORTATION

PROJECT NAME: **STATEWIDE SOUTHEAST REGION**
PROJECT NUMBER: **STPG SIGN (31)**

FILE NAME: **ROCKINGHAM NORTHBOUND** PLOT DATE: **8/13/2010**
PROJECT MANAGER: **A. GAMBLE** DRAWN BY: **M. MILLER**
DESIGNED BY: **M. MILLER** CHECKED BY: **A. GAMBLE**
ROCKINGHAM US-5 NORTHBOUND 4 SHEET **75** OF **175**

DIRECTION	MILEPOINT	LOCATION CODE (SHEET 2)	SIGN CODE	WIDTH (IN)	HEIGHT (IN)	SHEETING REMARKS	SIGN LEGEND	NEW SIGNS "A"	NEW SIGNS "B"	EXISTING SIGNS RETAIN	EXISTING SIGNS SALVAGE FROM	EXISTING SIGNS SALVAGE TO	EXISTING SIGNS REMOVE	EXIST POST RETAIN	EXIST POST REMOVE	NUMBER OF NEW POSTS	SQUARE STEEL (IN) 1.75 (LB / FT) 1.88	SQUARE STEEL (IN) 2.00 (LB / FT) 2.42	SQUARE STEEL (IN) 2.50 (LB / FT) 3.35	TUBULAR STEEL Ø (IN) FOUNDATION	TUBULAR STEEL Ø (IN) 3.00 (LB / FT) 7.60	TUBULAR STEEL Ø (IN) 3.50 (LB / FT) 9.00	TUBULAR STEEL Ø (IN) 4.00 (LB / FT) 10.80	TUBULAR STEEL Ø (IN) 5.00 (LB / FT) 14.60	SIGN FRAME REQUIRED	REMARKS	SIGN DETAIL: DETAIL IN SHS	SIGN DETAIL: DETAIL ON SHEET NUMBER	SIGN DETAIL: DETAIL ON STD SHEET NUMBER
ROCKINGHAM NB							FY-FLUORESCENT YELLOW FYG-FLUORESCENT YELLOW GREEN																			"SHS"-STANDARD HIGHWAY SIGNS			
NB	3.324	D	R1-1	30	30		STOP	6.25								1		13.75' X									X		
		A		36	8		0050 1314 0331 SPENCER DRIVE (TH-83)					1														SALVAGE STREET NAME SIGN TO TOP OF STOP SIGN POST			
NB	3.329	A	R3-2	24	24								1		X														
		A	R3-2	24	24			4.00								1		13.75' X									X		
NB	3.357	C	W1-7	48	24								~~1~~		~~X~~											THIS SIGN WAS REPLACED PRIOR TO THIS PROJECT			
		C	W1-7	48	24			~~8.00~~								~~2~~		~~X~~								INSTALL IN SAME POSITION AS REMOVAL	X		
NB	3.359	C	M3-1	24	12								1		X														
		C	M1-4	24	24								1																
		C	M6-1	21	15								1																
		C	M4-5	24	12								1																
		C	M1-5	30	24		(9) SIGN ROUTE MARKER ASSEMBLY						1																	
		C	M6-1	21	15								1																
		C	M3-3	24	12								1																
		C	M1-4	24	24								1																
		C	M6-1	21	15								1																
SIGN SUMMARY SHEET							SHEET TOTALS	~~10.25~~ 18.25 SF	0.00 SF	0 EA	0 EA	1 EA	~~10~~ 11 EA	0 EA	0 EA	4 EA	~~27.5~~ 60 FT												
VERMONT AGENCY OF TRANSPORTATION							TOWN DIRECTIONAL TOTALS	506.0	0.0	9.0	6.0	7.0	93	0.0	0.0	76	1140.0											

PROJECT NAME: STATEWIDE SOUTHEAST REGION
PROJECT NUMBER: STPG SIGN (31)

FILE NAME: ROCKINGHAM NORTHBOUND
PROJECT MANAGER: A. GAMBLE
DESIGNED BY: M. MILLER
ROCKINGHAM US-5 NORTHBOUND 5

PLOT DATE: 8/13/2010
DRAWN BY: M. MILLER
CHECKED BY: A. GAMBLE
SHEET 76 OF 175

DIRECTION	MILEPOINT	LOCATION CODE (SHEET 2)	SIGN CODE	WIDTH (IN)	HEIGHT (IN)	SHEETING REMARKS	SIGN LEGEND	NEW SIGNS "A"	NEW SIGNS "B"	EXISTING SIGNS RETAIN	EXISTING SIGNS SALVAGE FROM	EXISTING SIGNS SALVAGE TO	EXISTING SIGNS REMOVE	EXIST POST RETAIN	EXIST POST REMOVE	NUMBER OF NEW POSTS	SQUARE STEEL (IN) 1.75 (LB / FT) 1.88	SQUARE STEEL (IN) 2.00 (LB / FT) 2.42	SQUARE STEEL (IN) 2.50 (LB / FT) 3.35	TUBULAR STEEL Ø (IN) FOUNDATION	TUBULAR STEEL Ø (IN) 3.00 (LB / FT) 7.60	TUBULAR STEEL Ø (IN) 3.50 (LB / FT) 9.00	TUBULAR STEEL Ø (IN) 4.00 (LB / FT) 10.80	TUBULAR STEEL Ø (IN) 5.00 (LB / FT) 14.60	SIGN FRAME REQUIRED	REMARKS	SIGN DETAIL: DETAIL IN SHS	SIGN DETAIL: DETAIL ON SHEET NUMBER	SIGN DETAIL: DETAIL ON STD SHEET NUMBER
ROCKINGHAM NB							FY-FLUORESCENT YELLOW FYG-FLUORESCENT YELLOW GREEN																			"SHS"-STANDARD HIGHWAY SIGNS			
NB	3.359	C	M3-1	24	12		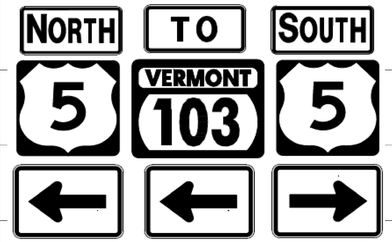	2.00								2		15.0' 15.0' X							# 3B	NEW SIGN FRAME REQUIRED (SEE E-123)	X		
		C	M1-4	24	24			4.00																			X		
		C	M6-1	21	15			2.19																			X		
		C	M4-5	24	12			2.00																		GREEN ON WHITE	X		
		C	M1-5	30	24			5.00																		GREEN ON WHITE			E-136B
		C	M6-1	21	15			2.19																		GREEN ON WHITE	X		
		C	M3-3	24	12			2.00																			X		
		C	M1-4	24	24			4.00																			X		
		C	M6-1	21	15			2.19																			X		
NB	3.378	A	M3-1	24	12			2.00								2		15.0' 15.0' X							#1A	SIGN FRAME REQUIRED (SEE E-123)	X		
		A	M1-4	24	24			4.00																		INSTALL 75 FT± IN ADVANCE OF SPEED LIMIT 45 / DO NOT PASS ASSEMBLY	X		
		A	M4-5	24	12			2.00																		GREEN ON WHITE	X		
		A	M1-5	30	24			5.00																		GREEN ON WHITE			E-136B
NB	3.392	A	R2-1	24	30		SPEED LIMIT 45						1		X											TO BE REPLACED FURTHER AHEAD			
		A	R4-1	24	30		DO NOT PASS						1																
							SHEET TOTALS	38.57 SF	0.00 SF	0 EA	0 EA	0 EA	2 EA	0 EA	0 EA	4 EA		60 FT											
							TOWN DIRECTIONAL TOTALS	506.0	0.0	9.0	6.0	7.0	93	0.0	0.0	76		1140.0											

SIGN SUMMARY SHEET

VERMONT AGENCY OF TRANSPORTATION

PROJECT NAME: **STATEWIDE SOUTHEAST REGION**
PROJECT NUMBER: **STPG SIGN (31)**

FILE NAME: **ROCKINGHAM NORTHBOUND** PLOT DATE: **8/13/2010**
PROJECT MANAGER: **A. GAMBLE** DRAWN BY: **M. MILLER**
DESIGNED BY: **M. MILLER** CHECKED BY: **A. GAMBLE**
ROCKINGHAM US-5 NORTHBOUND 6 SHEET **77** OF **175**

DIRECTION	MILEPOINT	LOCATION CODE (SHEET 2)	SIGN CODE	WIDTH (IN)	HEIGHT (IN)	SHEETING REMARKS	SIGN LEGEND	NEW SIGNS "A"	NEW SIGNS "B"	EXISTING SIGNS RETAIN	EXISTING SIGNS SALVAGE FROM	EXISTING SIGNS SALVAGE TO	EXISTING SIGNS REMOVE	EXIST POST RETAIN	EXIST POST REMOVE	NUMBER OF NEW POSTS	SQUARE STEEL (IN) 1.75 (LB / FT) 1.88	SQUARE STEEL (IN) 2.00 (LB / FT) 2.42	SQUARE STEEL (IN) 2.50 (LB / FT) 3.35	TUBULAR STEEL Ø (IN) FOUNDATION	TUBULAR STEEL Ø (IN) 3.00 (LB / FT) 7.60	TUBULAR STEEL Ø (IN) 3.50 (LB / FT) 9.00	TUBULAR STEEL Ø (IN) 4.00 (LB / FT) 10.80	TUBULAR STEEL Ø (IN) 5.00 (LB / FT) 14.60	SIGN FRAME REQUIRED	REMARKS	SIGN DETAIL: DETAIL IN SHS	SIGN DETAIL: DETAIL ON SHEET NUMBER	SIGN DETAIL: DETAIL ON STD SHEET NUMBER
ROCKINGHAM NB							FY-FLUORESCENT YELLOW FYG-FLUORESCENT YELLOW GREEN																			"SHS"-STANDARD HIGHWAY SIGNS			
NB	3.404	A	D1-1A	72	10								1		X														
		A	D1-1A	72	10								1																
		A	D1-1A	72	12			6.00								2		13.0' 13.0' X								4	
		A	D1-1A	72	12			6.00																		4	
NB	3.426	A	R2-1	24	30			5.00								1		15.0' X							INSTALL 100 FT± NORTH OF THE DESTINATION SIGN ASSEMBLY	X		
		A	R4-1	24	30			5.00																		THIS POSITION WILL BE MIDWAY BETWEEN ± THE SIGN ASSEMBLIES ABOVE AND BELOW	X		
NB	3.447	A	VD-062B	72	16		BUSINESS DIRECTORY SIGN			1				X												VERMED, INC. ===>			
		A	VD-062B	72	16		BUSINESS DIRECTORY SIGN			1				X												CHROMA ===>			
		A	VD-062B	72	16		BUSINESS DIRECTORY SIGN			1				X												SONNAX ===>			
NB	3.466	A	R8-3A	24	24		NO PARKING SYMBOL						1		X														
		A	M4-11	24	12		BEGIN (PLAQUE)						1																
		A	VR-644P	24	12			2.00								1		13.25' X							INSTALL ON TOP. **BLACK ON WHITE.**		6	
		A	R8-3A	24	24			4.00																			X		
NB	3.497	A	R8-3A	24	24								1		X														
		A	R8-3A	24	24			4.00								1		12.0' X									X		
SIGN SUMMARY SHEET							SHEET TOTALS	32.00	0.00	3	0	0	5	0	0	5		66.25 ~~75~~										
								SF	SF	EA	EA	EA	EA	EA	EA	EA		FT										
VERMONT AGENCY OF TRANSPORTATION							TOWN DIRECTIONAL TOTALS	506.0	0.0	9.0	6.0	7.0	93	0.0	0.0	76		1140.0										

PROJECT NAME: **STATEWIDE SOUTHEAST REGION**
PROJECT NUMBER: **STPG SIGN (31)**

FILE NAME: **ROCKINGHAM NORTHBOUND** PLOT DATE: **8/13/2010**
PROJECT MANAGER: **A. GAMBLE** DRAWN BY: **M. MILLER**
DESIGNED BY: **M. MILLER** CHECKED BY: **A. GAMBLE**
ROCKINGHAM US-5 NORTHBOUND 7 SHEET **78** OF **175**

DIRECTION	MILEPOINT	LOCATION CODE (SHEET 2)	SIGN CODE	WIDTH (IN)	HEIGHT (IN)	SHEETING REMARKS	SIGN LEGEND	NEW SIGNS "A"	NEW SIGNS "B"	EXISTING SIGNS RETAIN	EXISTING SIGNS SALVAGE FROM	EXISTING SIGNS SALVAGE TO	EXISTING SIGNS REMOVE	EXIST POST RETAIN	EXIST POST REMOVE	NUMBER OF NEW POSTS	SQUARE STEEL (IN) 1.75 (LB / FT) 1.88	SQUARE STEEL (IN) 2.00 (LB / FT) 2.42	SQUARE STEEL (IN) 2.50 (LB / FT) 3.35	TUBULAR STEEL Ø (IN) FOUNDATION	TUBULAR STEEL Ø (IN) 3.00 (LB / FT) 7.60	TUBULAR STEEL Ø (IN) 3.50 (LB / FT) 9.00	TUBULAR STEEL Ø (IN) 4.00 (LB / FT) 10.80	TUBULAR STEEL Ø (IN) 5.00 (LB / FT) 14.60	SIGN FRAME REQUIRED	REMARKS	SIGN DETAIL: DETAIL IN SHS	SIGN DETAIL: DETAIL ON SHEET NUMBER	SIGN DETAIL: DETAIL ON STD SHEET NUMBER
ROCKINGHAM NB							FY-FLUORESCENT YELLOW FYG-FLUORESCENT YELLOW GREEN																			"SHS"-STANDARD HIGHWAY SIGNS			
NB	3.525	C	VR-017	24	30								1		X											IMTEC LANE (TH-112)			
		C	VR-017	24	30			5.00								1		13.0' X									6	
NB	3.534	D	R1-1	30	30		STOP						1		X													
		A	n/a	30	8		IMTEC LANE (TH-112)				1																	
		D	R1-1	30	30			6.25								1		13.25' X								X	
		A	n/a	30	8		0050 1314 0352 IMTEC LANE (TH-112)					1														SALVAGE STREET NAME SIGN TO TOP OF STOP SIGN POST		
NB	3.544	A	M4-5	24	12								1		X													
		A	M1-1	24	24								1															
		C	R8-3A	24	24								1															
		C	M6-4	12	9								1															
		A	M4-5	24	12			2.00								1		17.0' X								WHITE ON BLUE	X	
		A	M1-1	24	24			4.00																				X	
		C	R8-3A	24	24		(INSTALL ON SIDE OF POST)	4.00																		NO PARKING SIGNS ARE INSTALLED UNDER THE I-91 SIGNS **BUT ON SIDE OF POST, PARALLEL TO US-5**	X	
		C	M6-4	21	15		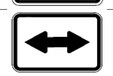 (INSTALL ON SIDE OF POST)	2.19																		BLACK ON WHITE	X	
NB	3.575	A	R8-3A	24	24		NO PARKING (SYMBOL)						1		X													
							SHEET TOTALS	23.44	0.00	0	1	1	7	0	0	3		43.25 ~~45~~										
								SF	SF	EA	EA	EA	EA	EA	EA	EA		FT										
							TOWN DIRECTIONAL TOTALS	506.0	0.0	9.0	6.0	7.0	93	0.0	0.0	76		1140.0										

SIGN SUMMARY SHEET

VERMONT AGENCY OF TRANSPORTATION

PROJECT NAME: **STATEWIDE SOUTHEAST REGION**
PROJECT NUMBER: **STPG SIGN (31)**

FILE NAME: **ROCKINGHAM NORTHBOUND** PLOT DATE: **8/13/2010**
PROJECT MANAGER: **A. GAMBLE** DRAWN BY: **M. MILLER**
DESIGNED BY: **M. MILLER** CHECKED BY: **A. GAMBLE**
ROCKINGHAM US-5 NORTHBOUND 8 SHEET **79** OF **175**

DIRECTION	MILEPOINT	LOCATION CODE (SHEET 2)	SIGN CODE	WIDTH (IN)	HEIGHT (IN)	SHEETING REMARKS	SIGN LEGEND	NEW SIGNS "A"	NEW SIGNS "B"	EXISTING SIGNS RETAIN	EXISTING SIGNS SALVAGE FROM	EXISTING SIGNS SALVAGE TO	EXISTING SIGNS REMOVE	EXIST POST RETAIN	EXIST POST REMOVE	NUMBER OF NEW POSTS	SQUARE STEEL (IN) 1.75 (LB / FT) 1.88	SQUARE STEEL (IN) 2.00 (LB / FT) 2.42	SQUARE STEEL (IN) 2.50 (LB / FT) 3.35	TUBULAR STEEL Ø (IN) FOUNDATION	TUBULAR STEEL Ø (IN) 3.00 (LB / FT) 7.60	TUBULAR STEEL Ø (IN) 3.50 (LB / FT) 9.00	TUBULAR STEEL Ø (IN) 4.00 (LB / FT) 10.80	TUBULAR STEEL Ø (IN) 5.00 (LB / FT) 14.60	SIGN FRAME REQUIRED	REMARKS	SIGN DETAIL: DETAIL IN SHS	SIGN DETAIL: DETAIL ON SHEET NUMBER	SIGN DETAIL: DETAIL ON STD SHEET NUMBER
ROCKINGHAM NB							FY-FLUORESCENT YELLOW FYG-FLUORESCENT YELLOW GREEN																			"SHS"-STANDARD HIGHWAY SIGNS			
NB	3.575	A	M4-6	24	12		END (PLAQUE)						1																
		A	M4-6	24	12			2.00								1		14.5' X							INSTALL PLAQUE ABOVE NO PARKING SYMBOL; **BLACK ON WHITE**	X		
		A	R8-3A	24	24			4.00																			X		
NB	3.700	A	R2-1	24	30		SPEED LIMIT 50						1		X														
		B	W14-3	48	36		NO PASSING PENNANT (ON BACK)						1																
NB	~~3.747~~ 3.737	A	VR-417	30	30		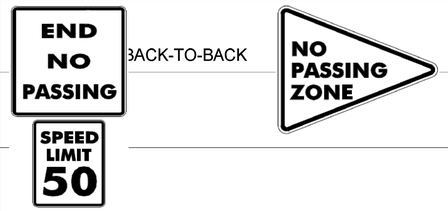 BACK-TO-BACK	6.25								1		16.75' X							INSTALL THE END NO PASSING SIGN ON TOP, SPEED LIMIT 50 BELOW THAT, THE PENNANT WILL BE ON BACK		6	
		A	R2-1	24	30			5.00																			INSTALL ~~175~~ 250 FT± NORTH OF PREVIOUS POSITION, ACROSS FROM THE SB SPEED LIMIT 45 / DNP SIGNS	X		
		B	W14-3	48	36			5.56																			NO PASSING ZONE PENNANT IS INSTALLED ON THE BACK OF THE SPEED LIMIT SIGN	X		
NB	3.746	A	M2-1	21	15		JCT						1		X														
		A	M1-5	30	24		VT 10~~7~~ 3						1																
NB	3.779	A	M2-1	21	15			2.19								1		15.0' X							INSTALL 175 FT ± NORTH OF THE PREVIOUS POSITION. **GREEN ON WHITE**	X		
		A	M1-5	30	24			5.00																					E-136B
NB	3.815	A	VR-731	30	36		DOUBLE ARROW ONLY TURN LANES			1				X															
NB	~~3.856~~ 3.837	A	M3-1	24	12			2.00								2		~~X~~		SEE NOTE ON NEXT SHEET					#3A	SIGN FRAME REQUIRED (SEE E-123) **GREEN ON WHITE**	X		
		A	M1-5	30	24			5.00																		~~INSTALL THIS NEW ASSEMBLY 100 FT ± IN ADVANCE OF THE EXISTING ROUTE MARKER ASSEMBLY~~			E-136B
							SHEET TOTALS	37.00	0.00	1	0	0	5	0	0	5		~~46.25~~ 75									
								SF	SF	EA	EA	EA	EA	EA	EA	EA		FT									
							TOWN DIRECTIONAL TOTALS	506.0	0.0	9.0	6.0	7.0	93	0.0	0.0	76		1140.0									

SIGN SUMMARY SHEET

VERMONT AGENCY OF TRANSPORTATION

PROJECT NAME: **STATEWIDE SOUTHEAST REGION**
PROJECT NUMBER: **STPG SIGN (31)**

FILE NAME: **ROCKINGHAM NORTHBOUND** PLOT DATE: **8/13/2010**
PROJECT MANAGER: **A. GAMBLE** DRAWN BY: **M. MILLER**
DESIGNED BY: **M. MILLER** CHECKED BY: **A. GAMBLE**
ROCKINGHAM US-5 NORTHBOUND 9 SHEET **80** OF **175**

DIRECTION	MILEPOINT	LOCATION CODE (SHEET 2)	SIGN CODE	WIDTH (IN)	HEIGHT (IN)	SHEETING REMARKS	SIGN LEGEND	NEW SIGNS "A"	NEW SIGNS "B"	EXISTING SIGNS RETAIN	EXISTING SIGNS SALVAGE FROM	EXISTING SIGNS SALVAGE TO	EXISTING SIGNS REMOVE	EXIST POST RETAIN	EXIST POST REMOVE	NUMBER OF NEW POSTS	SQUARE STEEL (IN) 1.75 (LB / FT) 1.88	SQUARE STEEL (IN) 2.00 (LB / FT) 2.42	SQUARE STEEL (IN) 2.50 (LB / FT) 3.35	TUBULAR STEEL Ø (IN) FOUNDATION	TUBULAR STEEL Ø (IN) 3.00 (LB / FT) 7.60	TUBULAR STEEL Ø (IN) 3.50 (LB / FT) 9.00	TUBULAR STEEL Ø (IN) 4.00 (LB / FT) 10.80	TUBULAR STEEL Ø (IN) 5.00 (LB / FT) 14.60	SIGN FRAME REQUIRED	REMARKS	SIGN DETAIL: DETAIL IN SHS	SIGN DETAIL: DETAIL ON SHEET NUMBER	SIGN DETAIL: DETAIL ON STD SHEET NUMBER
ROCKINGHAM NB							FY-FLUORESCENT YELLOW FYG-FLUORESCENT YELLOW GREEN																			"SHS"-STANDARD HIGHWAY SIGNS			
NB	3.8556	A	M6-2L	21	15			2.19																		GREEN ON WHITE	X		
		A	M2-1	21	15		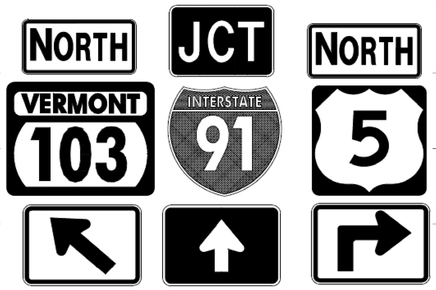	2.19																		WHITE ON BLUE	X		
		A	M1-1	24	24			4.00																			X		
		A	M6-3	21	15			2.19																		WHITE ON BLUE	X		
		A	M3-1	24	12			2.00																		BLACK ON WHITE	X		
		A	M1-4	24	24			4.00																			X		
		A	M5-1R	21	15			2.19																		BLACK ON WHITE	X		
NB	3.856	A	M3-1	24	12		NORTH						1	X	~~X~~											THE NEW SIGNS AND FRAME ASSEMBLY WERE INSTALLED AT THIS LOCATION. THE TUBULAR ALUMINUM POSTS WERE RETAINED.			
		A	M1-5	30	24		VT 103						1																
		A	M6-3	21	15		^UP ARROW						1																
		A	M2-1	21	15		JCT						1																
		A	M1-1	24	24		I-91						1																
		A	M6-3	21	15		^UP ARROW						1																
		A	M3-1	24	12		NORTH						1																
		A	M1-4	24	24		US 5						1																
SIGN SUMMARY SHEET							SHEET TOTALS	18.76	0.00	0	0	0	8	0	0	0	0											
								SF	SF	EA	EA	EA	EA	EA	EA	EA	FT											
VERMONT AGENCY OF TRANSPORTATION							TOWN DIRECTIONAL TOTALS	506.0	0.0	9.0	6.0	7.0	93	0.0	0.0	76	1140.0											

PROJECT NAME: STATEWIDE SOUTHEAST REGION
PROJECT NUMBER: STPG SIGN (31)

FILE NAME: ROCKINGHAM NORTHBOUND
PROJECT MANAGER: A. GAMBLE
DESIGNED BY: M. MILLER
ROCKINGHAM US-5 NORTHBOUND 10

PLOT DATE: 8/13/2010
DRAWN BY: M. MILLER
CHECKED BY: A. GAMBLE
SHEET 81 OF 175

DIRECTION	MILEPOINT	LOCATION CODE (SHEET 2)	SIGN CODE	WIDTH (IN)	HEIGHT (IN)	SHEETING REMARKS	SIGN LEGEND	NEW SIGNS "A"	NEW SIGNS "B"	EXISTING SIGNS RETAIN	EXISTING SIGNS SALVAGE FROM	EXISTING SIGNS SALVAGE TO	EXISTING SIGNS REMOVE	EXIST POST RETAIN	EXIST POST REMOVE	NUMBER OF NEW POSTS	SQUARE STEEL (IN) 1.75 (LB / FT) 1.88	SQUARE STEEL (IN) 2.00 (LB / FT) 2.42	SQUARE STEEL (IN) 2.50 (LB / FT) 3.35	TUBULAR STEEL Ø (IN) FOUNDATION	TUBULAR STEEL Ø (IN) 3.00 (LB / FT) 7.60	TUBULAR STEEL Ø (IN) 3.50 (LB / FT) 9.00	TUBULAR STEEL Ø (IN) 4.00 (LB / FT) 10.80	TUBULAR STEEL Ø (IN) 5.00 (LB / FT) 14.60	SIGN FRAME REQUIRED	REMARKS	SIGN DETAIL: DETAIL IN SHS	SIGN DETAIL: DETAIL ON SHEET NUMBER	SIGN DETAIL: DETAIL ON STD SHEET NUMBER
ROCKINGHAM NB							FY-FLUORESCENT YELLOW FYG-FLUORESCENT YELLOW GREEN																			"SHS"-STANDARD HIGHWAY SIGNS			
		A	M5-1	21	15		ADVANCE RIGHT ---> (90 DEG)						1																
NB	3.905	A	M3-1	24	12		NORTH			~~1~~	1	1	1		X	1		16.0' X							THE POST WAS DAMAGED, SO IT WAS REPLACED. THE SIGNS WERE SALVAGED ONTO THE NEW POST. PAY FOR REMOVALS.			
		A	M1-4	24	24		US 5			~~1~~	1	1	1															
		A	M6-1	21	15		RIGHT --->			~~1~~	1	1	1															
NB	3.933	J	R4-7	24	30								1		X											ASSEMBLY AT BEGIN OF MEDIAN ON LEFT			
		J	OM1-1	18	18								1																
		K	R1-1	30	30								1													ON BACK SIDE OF RIGHT BULLNOSE			
		K	OM1-1	18	18								1													ON BACK, UNDER THE STOP SIGN			
		J	R4-7	24	30		BACK-TO-BACK	5.00								1		13.0' X								X	
		J	OM1-1	18	18			2.25																			X		
		K	R1-1	30	30			6.25																	ON BACK SIDE OF RIGHT BULLNOSE	X		
		K	OM1-1	18	18			2.25																	ON BACK, UNDER THE STOP SIGN	X		
NB	3.944	A	M3-1	24	12			2.00								1		17.0' X							INSTALL 85 FT ± IN ADVANCE OF EXISTING ASSEMBLY; **BLACK ON WHITE**	X		
		A	M1-4	24	24			4.00																		X		
		A	D6-4A	18	9		AMERICA'S BYWAYS					1													SALVAGE TO BELOW THE NEW ROUTE MARKER SIGNS			
							SHEET TOTALS	21.75	0.00	3	~~3~~ 0	~~4~~ 1	~~8~~ 5	0	0	2		~~46.0~~ 30									
								SF	SF	EA	EA	EA	EA	EA	EA	EA		FT									
							TOWN DIRECTIONAL TOTALS	506.0	0.0	9.0	6.0	7.0	93	0.0	0.0	76		1140.0									

SIGN SUMMARY SHEET

VERMONT AGENCY OF TRANSPORTATION

PROJECT NAME: **STATEWIDE SOUTHEAST REGION**
PROJECT NUMBER: **STPG SIGN (31)**

FILE NAME: **ROCKINGHAM NORTHBOUND** PLOT DATE: **8/13/2010**
PROJECT MANAGER: **A. GAMBLE** DRAWN BY: **M. MILLER**
DESIGNED BY: **M. MILLER** CHECKED BY: **A. GAMBLE**
ROCKINGHAM US-5 NORTHBOUND 11 SHEET **82** OF **175**

DIRECTION	MILEPOINT	LOCATION CODE (SHEET 2)	SIGN CODE	WIDTH (IN)	HEIGHT (IN)	SHEETING REMARKS	SIGN LEGEND	NEW SIGNS "A"	NEW SIGNS "B"	EXISTING SIGNS RETAIN	EXISTING SIGNS SALVAGE FROM	EXISTING SIGNS SALVAGE TO	EXISTING SIGNS REMOVE	EXIST POST RETAIN	EXIST POST REMOVE	NUMBER OF NEW POSTS	SQUARE STEEL (IN) 1.75 (LB / FT) 1.88	SQUARE STEEL (IN) 2.00 (LB / FT) 2.42	SQUARE STEEL (IN) 2.50 (LB / FT) 3.35	TUBULAR STEEL Ø (IN) FOUNDATION	TUBULAR STEEL Ø (IN) 3.00 (LB / FT) 7.60	TUBULAR STEEL Ø (IN) 3.50 (LB / FT) 9.00	TUBULAR STEEL Ø (IN) 4.00 (LB / FT) 10.80	TUBULAR STEEL Ø (IN) 5.00 (LB / FT) 14.60	SIGN FRAME REQUIRED	REMARKS	SIGN DETAIL: DETAIL IN SHS	SIGN DETAIL: DETAIL ON SHEET NUMBER	SIGN DETAIL: DETAIL ON STD SHEET NUMBER
ROCKINGHAM NB							FY-FLUORESCENT YELLOW FYG-FLUORESCENT YELLOW GREEN																			"SHS"-STANDARD HIGHWAY SIGNS			
		A	VM-120	18	24		CT RIVER BYWAY (PLAQUE)					1																
NB	3.960	A	M3-1	24	12		NORTH						1		X													
		A	M1-4	24	24		US 5						1															
		A	D6-4A	18	9		AMERICA'S BYWAYS				1		1													PAY FOR REMOVALS.			
		A	VM-120	18	24		CT RIVER BYWAY (PLAQUE)				1		1															
NB	3.983	A	R2-1	24	30		SPEED LIMIT 40						1		X													
NB	4.002	A	R2-1	24	30		SPEED LIMIT 40	5.00								1		13.75' X								INSTALL 100 FT ± NORTH OF PREVIOUS LOCATION	X		
NB	4.050	A	W1-2R	30	30		RIGHT CURVE						1		X											NOTE LOCATION OF REMOVAL AS REFERENCE FOR NEXT SIGN			
NB	4.107	A	W1-2R	30	30			6.25								2		16.0' 16.75' X								INSTALL 300 FT ± NORTH OF CURVE RIGHT SIGN THAT WAS REMOVED; 2 POST ASSEMBLY	X		
		A	VW-054R	30	30		HIDDEN DRIVE RIGHT	6.25																		BEHIND RAIL: **SOME BRUSH CUTTING LIKELY REQUIRED**			E-154
NB	4.215	A	W5-2	30	30		NARROW BRIDGES						1		X													
		A	VW-060	30	30		HIDDEN DRIVES						1															
		A	W5-2	30	30		NARROW BRIDGE	6.25								2		15.0' 15.0' X								INSTALL SIGNS ON A 2 POST ASSEMBLY	X		
		A	VW-054R	30	30		HIDDEN DRIVE RIGHT 0050 1314 0420	6.25																				E-154
NB	4.277	A	OM-3R	12	36								1		X													
							SHEET TOTALS	30.00	0.00	0	2	1	9 ~~7~~	0	0	5		~~76.5~~ ~~75~~										
								SF	SF	EA	EA	EA	EA	EA	EA	EA		FT										
							TOWN DIRECTIONAL TOTALS	506.0	0.0	9.0	6.0	7.0	93	0.0	0.0	76		1140.0										

SIGN SUMMARY SHEET

VERMONT AGENCY OF TRANSPORTATION

PROJECT NAME: **STATEWIDE SOUTHEAST REGION**
PROJECT NUMBER: **STPG SIGN (31)**

FILE NAME: **ROCKINGHAM NORTHBOUND** PLOT DATE: **8/13/2010**
PROJECT MANAGER: **A. GAMBLE** DRAWN BY: **M. MILLER**
DESIGNED BY: **M. MILLER** CHECKED BY: **A. GAMBLE**
ROCKINGHAM US-5 NORTHBOUND 12 SHEET **83** OF **175**

DIRECTION	MILEPOINT	LOCATION CODE (SHEET 2)	SIGN CODE	WIDTH (IN)	HEIGHT (IN)	SHEETING REMARKS	SIGN LEGEND	NEW SIGNS "A"	NEW SIGNS "B"	EXISTING SIGNS RETAIN	EXISTING SIGNS SALVAGE FROM	EXISTING SIGNS SALVAGE TO	EXISTING SIGNS REMOVE	EXIST POST RETAIN	EXIST POST REMOVE	NUMBER OF NEW POSTS	SQUARE STEEL (IN) 1.75 / 2.00 / 2.50 (LB / FT) 1.88 / 2.42 / 3.35	TUBULAR STEEL Ø (IN) 3.00 / 3.50 / 4.00 / 5.00 (LB / FT) 7.60 / 9.00 / 10.80 / 14.60	FOUNDATION	SIGN FRAME REQUIRED	REMARKS	SIGN DETAIL: DETAIL IN SHS	SIGN DETAIL: DETAIL ON SHEET NUMBER	SIGN DETAIL: DETAIL ON STD SHEET NUMBER
ROCKINGHAM NB							FY-FLUORESCENT YELLOW FYG-FLUORESCENT YELLOW GREEN														"SHS"-STANDARD HIGHWAY SIGNS			
NB	4.277	A	OM-3R	12	36			3.00								1	10.5' X					X		
NB	4.288	B	OM-3L	12	36								1		X									
		B	OM-3L	12	36			3.00								1	10.0' X				IN "B" POSITION FACING SB TRAFFIC	X		
NB	4.330	A	OM-3R	12	36								1		X									
		A	OM-3R	12	36			3.00								1	10.75' X					X		
NB	4.380	B	OM-3L	12	36								1		X									
		B	OM-3L	12	36			3.00								1	10.0' X				IN "B" POSITION FACING SB TRAFFIC	X		
NB	4.445	A	R2-1	24	30								1		X									
		A	R2-1	24	30			~~5.00~~ ~~6.25~~								1	13.25' X					X		
NB	4.603	A	W1-2L	30	30		LEFT CURVE						1		X									
NB	4.641	A	W1-2L	30	30			6.25								1	15.0' X				INSTALL 200 FT ± NORTH OF REMOVAL; BEHIND RAIL	X		
NB	4.690	C	VR-017	24	30								1		X						HERRICKS COVE ROAD (TH-32)			
		C	VR-017	24	30			5.00								1	13.0' X						6	
NB	4.702	D	R1-1	30	30								1		X									
		D	D3-1	unknown			HERRICKS COVE ROAD				1													
							SHEET TOTALS	~~28.25~~ ~~29.50~~	0.00	0	1	0	7	0	0	7	~~82.5~~ ~~105~~							
								SF	SF	EA	EA	EA	EA	EA	EA	EA	FT							
							TOWN DIRECTIONAL TOTALS	506.0	0.0	9.0	6.0	7.0	93	0.0	0.0	76	1140.0							

SIGN SUMMARY SHEET

VERMONT AGENCY OF TRANSPORTATION

PROJECT NAME: **STATEWIDE SOUTHEAST REGION**
PROJECT NUMBER: **STPG SIGN (31)**

FILE NAME: **ROCKINGHAM NORTHBOUND** PLOT DATE: **8/13/2010**
PROJECT MANAGER: **A. GAMBLE** DRAWN BY: **M. MILLER**
DESIGNED BY: **M. MILLER** CHECKED BY: **A. GAMBLE**
ROCKINGHAM US-5 NORTHBOUND 13 SHEET **84** OF **175**

DIRECTION	MILEPOINT	LOCATION CODE (SHEET 2)	SIGN CODE	WIDTH (IN)	HEIGHT (IN)	SHEETING REMARKS	SIGN LEGEND	NEW SIGNS "A"	NEW SIGNS "B"	EXISTING SIGNS RETAIN	EXISTING SIGNS SALVAGE FROM	EXISTING SIGNS SALVAGE TO	EXISTING SIGNS REMOVE	EXIST POST RETAIN	EXIST POST REMOVE	NUMBER OF NEW POSTS	SQUARE STEEL (IN) (LB / FT) 1.75 1.88	SQUARE STEEL (IN) (LB / FT) 2.00 2.42	SQUARE STEEL (IN) (LB / FT) 2.50 3.35	TUBULAR STEEL Ø (IN) FOUNDATION	TUBULAR STEEL Ø (IN) (LB / FT) 3.00 7.60	TUBULAR STEEL Ø (IN) (LB / FT) 3.50 9.00	TUBULAR STEEL Ø (IN) (LB / FT) 4.00 10.80	TUBULAR STEEL Ø (IN) (LB / FT) 5.00 14.60	SIGN FRAME REQUIRED	REMARKS	SIGN DETAIL: DETAIL IN SHS	SIGN DETAIL: DETAIL ON SHEET NUMBER	SIGN DETAIL: DETAIL ON STD SHEET NUMBER
ROCKINGHAM NB							FY-FLUORESCENT YELLOW FYG-FLUORESCENT YELLOW GREEN																			"SHS"-STANDARD HIGHWAY SIGNS			
NB	4.702	D	R1-1	30	30		STOP	6.25								1		12.75' X								SOUTHERLY APPROACH FOR TH-32 AT THIS "Y" INTERSECTION	X		
		D	D3-1	unknown			0050 1314 0467 HERRICKS COVE ROAD					1									MILE MARKER RE-INSTALLED ON NEW POST.					SALVAGE STREET NAME SIGN TO TOP OF STOP SIGN POST			
NB	4.710	D	R1-1	30	30		STOP						1		X														
		D	R1-1	30	30			6.25								1		13.5' X								NORTHERLY APPROACH FOR TH-32 AT THIS "Y" INTERSECTION	X		
NB	4.853	A	R2-1	24	30		SPEED LIMIT 50						1		X														
		A	R2-1	24	30			5.00								1		14.0' X									X		
NB	5.520	A	VW-054	30	30		HIDDEN DRIVES RIGHT						1		X											BEHIND RAIL			
		A	W1-2R	30	30	FY	40 MPH	6.25								1		14.75' X								NEW SIGNS HAVE TYPE VII, VIII or IX FLUORESCENT-YELLOW BACKGROUND SHEETING	X		
		A	W13-1P	18	18	FY	HIDDEN DRIVES RIGHT	2.25																			X		
NB	5.558	A	VW-054	30	30			6.25								1		15.0' X								INSTALL 200 FT ± NORTH OF RIGHT CURVE SIGN ASSEMBLY			E-154
NB	6.225	C	VR-017	24	24		LEGAL LOAD LIMIT 24,000 POUNDS						1		X											UPPER MEADOWS RD (TH-23)			
		C	VR-017	24	30			5.00								1		11.5' X										6	
NB	6.240	D	R1-1	24	24		STOP 0050 1314 0623						1		X														
		D	R1-1	30	30			6.25								1		13.0' X								MILE MARKER RE-INSTALLED ON NEW POST.	X		
NB	6.718	A	VW-054	30	30		HIDDEN DRIVES RIGHT	6.25								1		12.75' X								INSTALL 165 FT ± NORTH OF AND ACROSS FROM THE "SCHOOL BUS STOP AHEAD" SIGN			E-154
							SHEET TOTALS	49.75 SF	0.00 SF	0 EA	0 EA	1 EA	5 EA	0 EA	0 EA	8 EA		107.25 ~~120~~ FT									
							TOWN DIRECTIONAL TOTALS	506.0	0.0	9.0	6.0	7.0	93	0.0	0.0	76		1140.0											

SIGN SUMMARY SHEET

VERMONT AGENCY OF TRANSPORTATION

PROJECT NAME: STATEWIDE SOUTHEAST REGION
PROJECT NUMBER: STPG SIGN (31)

FILE NAME: ROCKINGHAM NORTHBOUND
PROJECT MANAGER: A. GAMBLE
DESIGNED BY: M. MILLER
ROCKINGHAM US-5 NORTHBOUND 14

PLOT DATE: 8/13/2010
DRAWN BY: M. MILLER
CHECKED BY: A. GAMBLE

DIRECTION	MILEPOINT	LOCATION CODE (SHEET 2)	SIGN CODE	WIDTH (IN)	HEIGHT (IN)	SHEETING REMARKS	SIGN LEGEND	NEW SIGNS "A"	NEW SIGNS "B"	EXISTING SIGNS RETAIN	EXISTING SIGNS SALVAGE FROM	EXISTING SIGNS SALVAGE TO	EXISTING SIGNS REMOVE	EXIST POST RETAIN	EXIST POST REMOVE	NUMBER OF NEW POSTS	SQUARE STEEL (IN) 1.75 (LB / FT) 1.88	SQUARE STEEL (IN) 2.00 (LB / FT) 2.42	SQUARE STEEL (IN) 2.50 (LB / FT) 3.35	TUBULAR STEEL Ø (IN) FOUNDATION	TUBULAR STEEL Ø (IN) 3.00 (LB / FT) 7.60	TUBULAR STEEL Ø (IN) 3.50 (LB / FT) 9.00	TUBULAR STEEL Ø (IN) 4.00 (LB / FT) 10.80	TUBULAR STEEL Ø (IN) 5.00 (LB / FT) 14.60	SIGN FRAME REQUIRED	REMARKS	SIGN DETAIL: DETAIL IN SHS	SIGN DETAIL: DETAIL ON SHEET NUMBER	SIGN DETAIL: DETAIL ON STD SHEET NUMBER
ROCKINGHAM NB							FY-FLUORESCENT YELLOW FYG-FLUORESCENT YELLOW GREEN																			"SHS"-STANDARD HIGHWAY SIGNS			
NB	7.375	A	W1-2R	30	30			6.25								1		13.75' X								INSTALL NEXT TO MILE MARKER 0050 / 1314 / 0740	X		
		A	W13-1P	18	18			2.25																			X		
NB	7.564	A	W12-2	36	36		14'-0"						1		X											(13'-6" OR LESS REQUIRES SIGNS, THESE SIGNS ARE NOT REQUIRED)			
		A	W16-3	24	18		3 MILES (PLAQUE)						1																
		A	W1-10R	36	36			9.00								2		14.0' 14.0' X								INSTALL IN SAME POSITION AS REMOVED HEIGHT RESTRICTION SIGNS	X		
		A	W16-8aP	24	15			2.50																		INSTALL PLAQUE ON LEFT POST		7	
NB	7.692	A	N/A	30	30		HIDDEN DRIVE						1		X														
		A	VW-133R	30	30			6.25								1		13.75' X											E-154
NB	7.862	A	W1-2L	30	30			6.25								1		14.0' X								INSTALL 900 FT ± NORTH OF HIDDEN DRIVE RIGHT SIGN, JUST BEFORE BEGIN OF GUARDRAIL / CURVE LEFT	X		
NB	8.055	A	VW-202	30	30		TRUCKS ENTERING						1		X														
~~NB~~	~~8.060~~	~~A~~	~~VW-202~~	~~30~~	~~30~~			~~6.25~~								~~1~~		~~X~~								~~INSTALL 25 FT ± NORTH OF THE PREVIOUS POSITION, TO GET AWAY FROM UTILITY POLE~~			E-154
							SIGN NOT INSTALLED SEE NOTE ON SHEET #88 FOR SB MM. 8.229																						
NB	8.136	A	W7-1a	30	30			6.25								1		14.0' X								INSTALL 400 FT ± NORTH OF TRUCKS ENTERING SIGN	X		
		A	W7-3aP	24	18			3.00																			X		
NB	8.401	A	W1-2L	30	30			6.25								1		13.75' X								INSTALL 1400 FT ± NORTH OF HILL SYMBOL SIGNS, JUST BEFORE BEGIN OF GUARDRAIL / CURVE LEFT	X		
NB	8.597	C	VR-017	24	30								1		X														
							SHEET TOTALS	~~48.00~~ ~~54.25~~ SF	0.00 SF	0 EA	0 EA	0 EA	5 EA	0 EA	0 EA	~~7~~ ~~8~~ EA		97.25 ~~120~~ FT										
							TOWN DIRECTIONAL TOTALS	506.0	0.0	9.0	6.0	7.0	93	0.0	0.0	76		1140.0										

SIGN SUMMARY SHEET

VERMONT AGENCY OF TRANSPORTATION

PROJECT NAME: **STATEWIDE SOUTHEAST REGION**
PROJECT NUMBER: **STPG SIGN (31)**

FILE NAME: **ROCKINGHAM NORTHBOUND** PLOT DATE: **8/13/2010**
PROJECT MANAGER: **A. GAMBLE** DRAWN BY: **M. MILLER**
DESIGNED BY: **M. MILLER** CHECKED BY: **A. GAMBLE**
ROCKINGHAM US-5 NORTHBOUND 15 SHEET **86** OF **175**

DIRECTION	MILEPOINT	LOCATION CODE (SHEET 2)	SIGN CODE	WIDTH (IN)	HEIGHT (IN)	SHEETING REMARKS	SIGN LEGEND	NEW SIGNS "A"	NEW SIGNS "B"	EXISTING SIGNS RETAIN	EXISTING SIGNS SALVAGE FROM	EXISTING SIGNS SALVAGE TO	EXISTING SIGNS REMOVE	EXIST POST RETAIN	EXIST POST REMOVE	NUMBER OF NEW POSTS	SQUARE STEEL (IN) 1.75 (LB / FT) 1.88	SQUARE STEEL (IN) 2.00 (LB / FT) 2.42	SQUARE STEEL (IN) 2.50 (LB / FT) 3.35	TUBULAR STEEL Ø (IN) FOUNDATION	TUBULAR STEEL Ø (IN) 3.00 (LB / FT) 7.60	TUBULAR STEEL Ø (IN) 3.50 (LB / FT) 9.00	TUBULAR STEEL Ø (IN) 4.00 (LB / FT) 10.80	TUBULAR STEEL Ø (IN) 5.00 (LB / FT) 14.60	SIGN FRAME REQUIRED	REMARKS	SIGN DETAIL: DETAIL IN SHS	SIGN DETAIL: DETAIL ON SHEET NUMBER	SIGN DETAIL: DETAIL ON STD SHEET NUMBER
ROCKINGHAM NB							FY-FLUORESCENT YELLOW FYG-FLUORESCENT YELLOW GREEN																			"SHS"-STANDARD HIGHWAY SIGNS			
NB	8.597	C	VR-017	24	30		LEGAL LOAD LIMIT 24,000 POUNDS	5.00								1		11.5' X									6	
		A	D3-1	unknown			RIVER FRONT DRIVE TH-107					1														SALVAGE STREET NAME SIGN TO TOP OF LEGAL LOAD LIMIT SIGN (FOR BETTER VISIBILITY)			
NB	8.615	D	R1-1	30	30		0050 1314 0858						1		X											EXISTING STOP SIGN IS CURRENTLY ON BACK OF THE LEGAL LOAD LIMIT SIGN, WHICH IS INCORRECT			
		A	D3-1	unknown			RIVER FRONT DRIVE TH-107				1																	
		D	R1-1	30	30		STOP	6.25								1		12.75' X								INSTALL STOP SIGN ON RIGHT SIDE OF TH-107 AS EXITING TH-107 ONTO US-5	X		

DIRECTION	MILEPOINT	LOCATION CODE (SHEET 2)	SIGN CODE	WIDTH (IN)	HEIGHT (IN)	SHEETING REMARKS	SIGN LEGEND	NEW SIGNS "A"	NEW SIGNS "B"	EXISTING SIGNS RETAIN	EXISTING SIGNS SALVAGE FROM	EXISTING SIGNS SALVAGE TO	EXISTING SIGNS REMOVE	EXIST POST RETAIN	EXIST POST REMOVE	NUMBER OF NEW POSTS	SQUARE STEEL (IN) 1.75 (LB / FT) 1.88	SQUARE STEEL (IN) 2.00 (LB / FT) 2.42	SQUARE STEEL (IN) 2.50 (LB / FT) 3.35	TUBULAR STEEL Ø (IN) FOUNDATION	TUBULAR STEEL Ø (IN) 3.00 (LB / FT) 7.60	TUBULAR STEEL Ø (IN) 3.50 (LB / FT) 9.00	TUBULAR STEEL Ø (IN) 4.00 (LB / FT) 10.80	TUBULAR STEEL Ø (IN) 5.00 (LB / FT) 14.60	SIGN FRAME REQUIRED	REMARKS	SIGN DETAIL: DETAIL IN SHS	SIGN DETAIL: DETAIL ON SHEET NUMBER	SIGN DETAIL: DETAIL ON STD SHEET NUMBER
ROCKINGHAM SB							FY-FLUORESCENT YELLOW FYG-FLUORESCENT YELLOW GREEN																			"SHS"-STANDARD HIGHWAY SIGNS			
SB	8.558	F	W1-2R	30	30			6.25								1		13.75' X								INSTALL 100 FT ± SOUTH OF THE JUNCTION WITH TH-107.	X		
~~SB~~	~~8.229~~	~~F~~	~~VW-202~~	~~30~~	~~30~~			~~6.25~~								~~1~~		~~X~~		THIS SIGN WAS NOT INSTALLED. BFI IS CLOSED						~~INSTALL 400 FT ± IN ADVANCE OF THE DRIVE TO "BFI WASTE SYSTEMS" (DRIVE #854)~~			E-154
SB	8.006	F	W1-2R	30	30			6.25								1		13.5' X								INSTALL AT NORTHERLY CORNER OF WHITE PICKET FENCE TO DRIVE # 856	X		
SB	7.780	F	W1-2L	30	30			6.25								1		13.5' X								INSTALL ON NORTH SIDE OF DRIVE, IN ADVANCE OF LEFT CURVE, 1200 FT ± ~~NORTH~~ SOUTH OF CURVE RIGHT SIGN	X		
SB	7.600	G	VR-017	24	24								1		X											RANDALL HILL ROAD (TH-20)			
		G	VR-017	24	30			5.00								1		12.5' X										6	
SB	7.592	H	R1-1	24	24								1		X														
		H	R1-1	30	30			6.25								1		13.0' X									X		
SB	7.117	G	VR-017	24	30								1		X											ALDEN ROAD (TH-22)			
		G	VR-017	24	30			5.00			1	1	1			1		13.5' 12.25' X			ON 10/12/11, THIS POST WAS FOUND DAMAGED AND IT WAS REPLACED BY CONTRACTOR.								6	
SB	7.108	H	R1-1	30	30								1		X														
		H	R1-1	30	30			6.25								1		12.25' X									X		
SB	6.821	F	W7-1	30	30		HILL SYMBOL						1		X														
SB	6.792	F	W7-1a	30	30			6.25								1		13.75' X								INSTALL 150 FT ± SOUTH OF HILL SIGN THAT WAS REMOVED	X		
SIGN SHEET #100		F	W7-3aP	24	18			3.00																			X		
							SHEET TOTALS	~~50.5~~ ~~56.75~~ SF	0.00 SF	0 EA	1 ~~0~~ EA	1 ~~0~~ EA	6 ~~5~~ EA	0 EA	0 EA	9 EA									~~118.0~~ ~~135~~ FT				
							TOWN DIRECTIONAL TOTALS	442.6	0.0	9.0	3.0	3.0	78	0.0	0.0	73									1095.0				

SIGN SUMMARY SHEET

VERMONT AGENCY OF TRANSPORTATION

PROJECT NAME: **STATEWIDE SOUTHEAST REGION**
PROJECT NUMBER: **STPG SIGN (31)**

FILE NAME: **ROCKINGHAM SOUTHBOUND** PLOT DATE: **8/13/2010**
PROJECT MANAGER: **A. GAMBLE** DRAWN BY: **M. MILLER**
DESIGNED BY: **M. MILLER** CHECKED BY: **A. GAMBLE**
ROCKINGHAM US-5 SOUTHBOUND 1 SHEET **88** OF **175**

DIRECTION	MILEPOINT	LOCATION CODE (SHEET 2)	SIGN CODE	WIDTH (IN)	HEIGHT (IN)	SHEETING REMARKS	SIGN LEGEND	NEW SIGNS "A"	NEW SIGNS "B"	EXISTING SIGNS RETAIN	EXISTING SIGNS SALVAGE FROM	EXISTING SIGNS SALVAGE TO	EXISTING SIGNS REMOVE	EXIST POST RETAIN	EXIST POST REMOVE	NUMBER OF NEW POSTS	SQUARE STEEL (IN) 1.75 (LB / FT) 1.88	SQUARE STEEL (IN) 2.00 (LB / FT) 2.42	SQUARE STEEL (IN) 2.50 (LB / FT) 3.35	TUBULAR STEEL Ø (IN) FOUNDATION	TUBULAR STEEL Ø (IN) 3.00 (LB / FT) 7.60	TUBULAR STEEL Ø (IN) 3.50 (LB / FT) 9.00	TUBULAR STEEL Ø (IN) 4.00 (LB / FT) 10.80	TUBULAR STEEL Ø (IN) 5.00 (LB / FT) 14.60	SIGN FRAME REQUIRED	REMARKS	SIGN DETAIL: DETAIL IN SHS	SIGN DETAIL: DETAIL ON SHEET NUMBER	SIGN DETAIL: DETAIL ON STD SHEET NUMBER
ROCKINGHAM SB							FY-FLUORESCENT YELLOW FYG-FLUORESCENT YELLOW GREEN																			"SHS"-STANDARD HIGHWAY SIGNS			
SB	6.652	F	S3-1	30	30		SCHOOL BUS STOP AHEAD						1		X													
SB	5.833	F	VW-133L	30	30								1		X													
		F	VW-133L	30	30			6.25								1	14.0' X											E-154
SB	5.697	F	VW-133L	30	30								1		X													
		F	VW-133L	30	30			6.25								1	13.25' X											E-154
SB	5.610	F	W1-6L	48	24			8.00								2	12.0' 12.25' X										INSTALL 25 FT ± IN ADVANCE OF UTILITY POLE, IN ADVANCE OF HORSESHOE DRIVE ON LEFT	X		
SB	5.608	E	W1-6R	48	24			8.00								2	12.25' 12.75' X										THIS SIGN FACES NORTHBOUND TRAFFIC; INSTALL 10 FT ± SOUTH OF THE SOUTHBOUND-FACING SIGN	X		
SB	4.936	F	R2-5A	24	30		REDUCED SPEED AHEAD						1		X													
		F	W3-5	36	36			9.00								2	13.0' 14.0' X											X		
SB	4.874	F	W1-2R	30	30		RIGHT CURVE						1		X													
SB	4.828	F	R2-1	24	30								1		X													
		F	R2-1	~~30~~ 24	~~36~~ 30			7.50 ~~5.00~~								1	11.75' X										SEE E-MAIL, DATED 4/4/11, FROM A. GAMBLE, TRAFFIC OPS. NOTE LARGER SIZE	X		
SB	4.799	F	W1-10R	36	36			9.00								2	12.25' 13.5' X										INSTALL 150 FT ± SOUTH OF THE SPEED LIMIT 40 SIGN	X		
SB	4.718	F	N/A	30	30		HIDDEN DRIVE						1		X													
		F	W2-2	30	30			6.25								1	14.5' X											X		
							SHEET TOTALS	~~60.25~~ ~~57.75~~	0.00	0	0	0	7	0	0	12	~~155.5~~ ~~180~~												
								SF	SF	EA	EA	EA	EA	EA	EA	EA	FT												
							TOWN DIRECTIONAL TOTALS	442.6	0.0	9.0	3.0	3.0	78	0.0	0.0	73	1095.0												

SIGN SUMMARY SHEET

VERMONT AGENCY OF TRANSPORTATION

PROJECT NAME: **STATEWIDE SOUTHEAST REGION**
PROJECT NUMBER: **STPG SIGN (31)**

FILE NAME: **ROCKINGHAM SOUTHBOUND** PLOT DATE: **8/13/2010**
PROJECT MANAGER: **A. GAMBLE** DRAWN BY: **M. MILLER**
DESIGNED BY: **M. MILLER** CHECKED BY: **A. GAMBLE**
ROCKINGHAM US-5 SOUTHBOUND 2 SHEET **89** OF **175**

DIRECTION	MILEPOINT	LOCATION CODE (SHEET 2)	SIGN CODE	WIDTH (IN)	HEIGHT (IN)	SHEETING REMARKS	SIGN LEGEND	NEW SIGNS "A"	NEW SIGNS "B"	EXISTING SIGNS RETAIN	EXISTING SIGNS SALVAGE FROM	EXISTING SIGNS SALVAGE TO	EXISTING SIGNS REMOVE	EXIST POST RETAIN	EXIST POST REMOVE	NUMBER OF NEW POSTS	SQUARE STEEL (IN) 1.75 (LB / FT) 1.88	SQUARE STEEL (IN) 2.00 (LB / FT) 2.42	SQUARE STEEL (IN) 2.50 (LB / FT) 3.35	TUBULAR STEEL Ø (IN) FOUNDATION	TUBULAR STEEL Ø (IN) 3.00 (LB / FT) 7.60	TUBULAR STEEL Ø (IN) 3.50 (LB / FT) 9.00	TUBULAR STEEL Ø (IN) 4.00 (LB / FT) 10.80	TUBULAR STEEL Ø (IN) 5.00 (LB / FT) 14.60	SIGN FRAME REQUIRED	REMARKS	SIGN DETAIL: DETAIL IN SHS	SIGN DETAIL: DETAIL ON SHEET NUMBER	SIGN DETAIL: DETAIL ON STD SHEET NUMBER
ROCKINGHAM SB							FY-FLUORESCENT YELLOW FYG-FLUORESCENT YELLOW GREEN																			"SHS"-STANDARD HIGHWAY SIGNS			
		F	W16-8P	30	8			1.67																			7	
SB	4.645	G	VR-017	24	30								1		X											OLD RIVER ROAD (TH-28)			
		G	VR-017	24	30			5.00								1		12.0' X									6	
SB	4.637	H	R1-1	30	30		RIVER RD TH#28						1		X														
		H	R1-1	30	30		0050 1314 0467	6.25			1	1				1		12.0' X							STREET SIGN SALVAGED ONTO THE NEW POST.	X		
SB	4.535	F	VD-062C	74.75	16		TRAVEL INFORMATION LOGOS			1				X															
		F	VD-062BC	74.75	16		TRAVEL INFORMATION SIGN			1				X															
SB	4.499	F	W5-2	30	30		NARROW BRIDGE						1		X														
SB	4.457	F	R2-1	24	30		SPEED LIMIT 40						1		X														
		F	W5-2	36	36			9.00								2		10.5' 11.5' X								X		
SB	4.430	G	VR-017	24	30								1		X											OLD RIVER ROAD (TH-28 / TH-29)			
		G	VR-017	24	30			5.00								1		12.0' X									6	
SB	4.424	H	R1-1	30	30		0050 1314 0443						1		X															
		H	R1-1	30	30			6.25								1		10.5' X								X		
SB	4.405	F	R2-1	24	30			5.00								1		12.5' X							INSTALL 100 FT ± SOUTH OF THE JCT WITH TH-29; WILL BE BEHIND RAIL	X		
							SHEET TOTALS	38.17	0.00	2	~~1~~ 0	~~1~~ 0	6	0	0	7	~~81.0~~ 105									
								SF	SF	EA	EA	EA	EA	EA	EA	EA	FT									
							TOWN DIRECTIONAL TOTALS	442.6	0.0	9.0	3.0	3.0	78	0.0	0.0	73	1095.0									

SIGN SUMMARY SHEET

VERMONT AGENCY OF TRANSPORTATION

PROJECT NAME: **STATEWIDE SOUTHEAST REGION**
PROJECT NUMBER: **STPG SIGN (31)**

FILE NAME: **ROCKINGHAM SOUTHBOUND** PLOT DATE: **8/13/2010**
PROJECT MANAGER: **A. GAMBLE** DRAWN BY: **M. MILLER**
DESIGNED BY: **M. MILLER** CHECKED BY: **A. GAMBLE**
ROCKINGHAM US-5 SOUTHBOUND 3 SHEET **90** OF **175**

DIRECTION	MILEPOINT	LOCATION CODE (SHEET 2)	SIGN CODE	WIDTH (IN)	HEIGHT (IN)	SHEETING REMARKS	SIGN LEGEND	NEW SIGNS "A"	NEW SIGNS "B"	EXISTING SIGNS RETAIN	EXISTING SIGNS SALVAGE FROM	EXISTING SIGNS SALVAGE TO	EXISTING SIGNS REMOVE	EXIST POST RETAIN	EXIST POST REMOVE	NUMBER OF NEW POSTS	SQUARE STEEL (IN) 1.75 (LB / FT) 1.88	SQUARE STEEL (IN) 2.00 (LB / FT) 2.42	SQUARE STEEL (IN) 2.50 (LB / FT) 3.35	TUBULAR STEEL Ø (IN) FOUNDATION	TUBULAR STEEL Ø (IN) 3.00 (LB / FT) 7.60	TUBULAR STEEL Ø (IN) 3.50 (LB / FT) 9.00	TUBULAR STEEL Ø (IN) 4.00 (LB / FT) 10.80	TUBULAR STEEL Ø (IN) 5.00 (LB / FT) 14.60	SIGN FRAME REQUIRED	REMARKS	SIGN DETAIL: DETAIL IN SHS	SIGN DETAIL: DETAIL ON SHEET NUMBER	SIGN DETAIL: DETAIL ON STD SHEET NUMBER
ROCKINGHAM SB							FY-FLUORESCENT YELLOW FYG-FLUORESCENT YELLOW GREEN																			"SHS"-STANDARD HIGHWAY SIGNS			
SB	4.352	F	OM-3R	12	36								1		X													
		F	OM-3R	12	36			3.00								1		11.0' X										X	
SB	4.304	E	OM-3L	12	36								1		X													
		E	OM-3L	12	36			3.00								1		11.0' X										X	
SB	4.260	F	OM-3R	12	36								1		X													
		F	OM-3R	12	36			3.00								1		10.75' X										X	
SB	4.248	E	OM-3L	12	36								1		X													
		E	OM-3L	12	36			3.00								1		10.0' X										X	
SB	~~4.242~~ 4.220	E	W1-6	48	24		LARGE ARROW RIGHT						1		X												LARGE ARROW FACES NB TRAFFIC; REMOVE ALL			
		E	OM1-1	18	18		YELLOW OBJECT MARKER						1														NEW SIGN WAS MOVED 115' NORTH TO BE ADVANCE OF THE CURVE.			
		F	W1-2L	30	30			6.25								1		~~14.25'~~ X									INSTALL FACING SB TRAFFIC; MAINTAIN 10 FT MINIMUM DISTANCE TO THE UTILITY POLE	X		
SB	4.077	F	M2-1	21	15		JCT (BLACK & WHITE)						1		X													
		F	M1-6	30	24		ROUTE 103 (BLACK & WHITE)						1																
		F	M6-3	21	15		UP ARROW (BLACK & WHITE)						1														UP ARROW WILL NOT BE REPLACED			
		F	M2-1	21	15			2.19								1		14.25' X									GREEN ON WHITE	X		
SIGN SUMMARY SHEET							SHEET TOTALS	20.44	0.00	0	0	0	9	0	0	6		~~71.25~~ 90										
								SF	SF	EA	EA	EA	EA	EA	EA	EA		FT										
VERMONT AGENCY OF TRANSPORTATION							TOWN DIRECTIONAL TOTALS	442.6	0.0	9.0	3.0	3.0	78	0.0	0.0	73		1095.0										

PROJECT NAME: **STATEWIDE SOUTHEAST REGION**
PROJECT NUMBER: **STPG SIGN (31)**

FILE NAME: **ROCKINGHAM SOUTHBOUND** PLOT DATE: **8/13/2010**
PROJECT MANAGER: **A. GAMBLE** DRAWN BY: **M. MILLER**
DESIGNED BY: **M. MILLER** CHECKED BY: **A. GAMBLE**
ROCKINGHAM US-5 SOUTHBOUND 4 SHEET **91** OF **175**

DIRECTION	MILEPOINT	LOCATION CODE (SHEET 2)	SIGN CODE	WIDTH (IN)	HEIGHT (IN)	SHEETING REMARKS	SIGN LEGEND	NEW SIGNS "A"	NEW SIGNS "B"	EXISTING SIGNS RETAIN	EXISTING SIGNS SALVAGE FROM	EXISTING SIGNS SALVAGE TO	EXISTING SIGNS REMOVE	EXIST POST RETAIN	EXIST POST REMOVE	NUMBER OF NEW POSTS	SQUARE STEEL (IN) 1.75 (LB / FT) 1.88	SQUARE STEEL (IN) 2.00 (LB / FT) 2.42	SQUARE STEEL (IN) 2.50 (LB / FT) 3.35	TUBULAR STEEL Ø (IN) FOUNDATION	TUBULAR STEEL Ø (IN) 3.00 (LB / FT) 7.60	TUBULAR STEEL Ø (IN) 3.50 (LB / FT) 9.00	TUBULAR STEEL Ø (IN) 4.00 (LB / FT) 10.80	TUBULAR STEEL Ø (IN) 5.00 (LB / FT) 14.60	SIGN FRAME REQUIRED	REMARKS	SIGN DETAIL: DETAIL IN SHS	SIGN DETAIL: DETAIL ON SHEET NUMBER	SIGN DETAIL: DETAIL ON STD SHEET NUMBER
ROCKINGHAM SB							FY-FLUORESCENT YELLOW FYG-FLUORESCENT YELLOW GREEN																			"SHS"-STANDARD HIGHWAY SIGNS			
		F	M1-5	30	24			5.00																				E-136B
SB	4.026	F	W1-1R	30	30								1		X														
		F	W1-1R	36	36	FY		9.00								2		9.5' 11.5' X								FLUORESCENT YELLOW BACKRGROUND SHEETING	X		
SB	3.998	F	W3-1	30	30		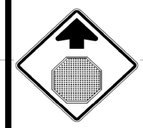						1		X														
		F	W3-1	36	36	FY	0050 1314 0400	9.00								2		13.5' 13.75' X								FLUORESCENT YELLOW BACKRGROUND SHEETING	X		
SB	3.975	F	D1-1A	72	10								1		X														
		F	D1-1A	72	10								1																
		F	D1-1A	72	12			6.00								2		10.25' 12.25' X										4
		F	D1-1A	72	12			6.00																				4
SB	3.937	F	M3-3	24	12		SOUTH						1		X														
		F	M1-4	24	24		US 5						1																
		F	M6-1	21	15		LEFT						1																
		F	M3-1	24	12		NORTH						1																
		F	M1-6	24	24		103						1																
		F	M6-1	21	15		RIGHT						1																
							SHEET TOTALS	35.00	0.00	0	0	0	10	0	0	6		70.75 ~~90~~										
								SF	SF	EA	EA	EA	EA	EA	EA	EA		FT										
							TOWN DIRECTIONAL TOTALS	442.6	0.0	9.0	3.0	3.0	78	0.0	0.0	73		1095.0										

SIGN SUMMARY SHEET

VERMONT AGENCY OF TRANSPORTATION

PROJECT NAME: STATEWIDE SOUTHEAST REGION
PROJECT NUMBER: STPG SIGN (31)

FILE NAME: ROCKINGHAM SOUTHBOUND
PROJECT MANAGER: A. GAMBLE
DESIGNED BY: M. MILLER
ROCKINGHAM US-5 SOUTHBOUND 5

PLOT DATE: 8/13/2010
DRAWN BY: M. MILLER
CHECKED BY: A. GAMBLE

DIRECTION	MILEPOINT	LOCATION CODE (SHEET 2)	SIGN CODE	WIDTH (IN)	HEIGHT (IN)	SHEETING REMARKS	SIGN LEGEND	NEW SIGNS "A"	NEW SIGNS "B"	EXISTING SIGNS RETAIN	EXISTING SIGNS SALVAGE FROM	EXISTING SIGNS SALVAGE TO	EXISTING SIGNS REMOVE	EXIST POST RETAIN	EXIST POST REMOVE	NUMBER OF NEW POSTS	SQUARE STEEL (IN) 1.75 (LB / FT) 1.88	SQUARE STEEL (IN) 2.00 (LB / FT) 2.42	SQUARE STEEL (IN) 2.50 (LB / FT) 3.35	TUBULAR STEEL Ø (IN) FOUNDATION	TUBULAR STEEL Ø (IN) 3.00 (LB / FT) 7.60	TUBULAR STEEL Ø (IN) 3.50 (LB / FT) 9.00	TUBULAR STEEL Ø (IN) 4.00 (LB / FT) 10.80	TUBULAR STEEL Ø (IN) 5.00 (LB / FT) 14.60	SIGN FRAME REQUIRED	REMARKS	SIGN DETAIL: DETAIL IN SHS	SIGN DETAIL: DETAIL ON SHEET NUMBER	SIGN DETAIL: DETAIL ON STD SHEET NUMBER
ROCKINGHAM SB							FY-FLUORESCENT YELLOW FYG-FLUORESCENT YELLOW GREEN																			"SHS"-STANDARD HIGHWAY SIGNS			
SB	3.937	F	M3-3	24	12		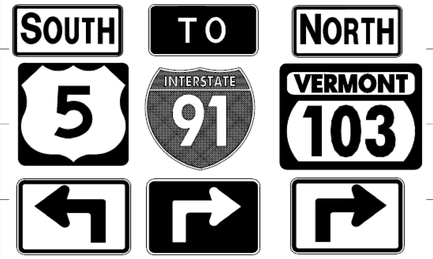	2.00								2		15.0' 16.25' X							#3A	BLACK ON WHITE	X		
		F	M1-4	24	24			4.00																				X		
		F	M5-1L	21	15			2.19																			BLACK ON WHITE	X		
		F	M4-5	24	12			2.00																			WHITE ON BLUE	X		
		F	M1-1	24	24			4.00																				X		
		F	M5-1R	21	15			2.19																			WHITE ON BLUE	X		
		F	M3-1	24	12			2.00																			GREEN ON WHITE	X		
		F	M1-6	30	24			5.00																						E-136B
		F	M5-1R	21	15			2.19																			GREEN ON WHITE	X		
SB	3.930	K	R4-7	24	30							1		X													ASSEMBLY LOCATED AT BEGINNING OF RAISED MEDIAN			
		K	OM1-1	18	18							1																		
		J	OM1-1	18	18							1															ON BACK OF POST FACING NB TRAFFIC			
		K	R4-7	24	30			5.00								1		12.75' X									X		
		K	OM1-1	18	18		BACK-TO-BACK	2.25																			X		
		J	OM1-1	18	18			2.25																			ON BACK OF POST FACING NB TRAFFIC	X		
							SHEET TOTALS	35.07	0.00	0	0	0	3	0	0	3			44.0 45									
								SF	SF	EA	EA	EA	EA	EA	EA	EA			FT									
							TOWN DIRECTIONAL TOTALS	442.6	0.0	9.0	3.0	3.0	78	0.0	0.0	73			1095.0									

SIGN SUMMARY SHEET

VERMONT AGENCY OF TRANSPORTATION

PROJECT NAME: STATEWIDE SOUTHEAST REGION
PROJECT NUMBER: STPG SIGN (31)

FILE NAME: ROCKINGHAM SOUTHBOUND
PROJECT MANAGER: A. GAMBLE
DESIGNED BY: M. MILLER
ROCKINGHAM US-5 SOUTHBOUND 6

PLOT DATE: 8/13/2010
DRAWN BY: M. MILLER
CHECKED BY: A. GAMBLE

DIRECTION	MILEPOINT	LOCATION CODE (SHEET 2)	SIGN CODE	WIDTH (IN)	HEIGHT (IN)	SHEETING REMARKS	SIGN LEGEND	NEW SIGNS "A"	NEW SIGNS "B"	EXISTING SIGNS RETAIN	EXISTING SIGNS SALVAGE FROM	EXISTING SIGNS SALVAGE TO	EXISTING SIGNS REMOVE	EXIST POST RETAIN	EXIST POST REMOVE	NUMBER OF NEW POSTS	SQUARE STEEL (IN) 1.75 (LB / FT) 1.88	SQUARE STEEL (IN) 2.00 (LB / FT) 2.42	SQUARE STEEL (IN) 2.50 (LB / FT) 3.35	TUBULAR STEEL Ø (IN) FOUNDATION	TUBULAR STEEL Ø (IN) 3.00 (LB / FT) 7.60	TUBULAR STEEL Ø (IN) 3.50 (LB / FT) 9.00	TUBULAR STEEL Ø (IN) 4.00 (LB / FT) 10.80	TUBULAR STEEL Ø (IN) 5.00 (LB / FT) 14.60	SIGN FRAME REQUIRED	REMARKS	SIGN DETAIL: DETAIL IN SHS	SIGN DETAIL: DETAIL ON SHEET NUMBER	SIGN DETAIL: DETAIL ON STD SHEET NUMBER
ROCKINGHAM SB							FY-FLUORESCENT YELLOW FYG-FLUORESCENT YELLOW GREEN																			"SHS"-STANDARD HIGHWAY SIGNS			
SB ~~3.907~~ 3.913		F	R1-1	30	30								1		X														
		F	R1-1	36	36			9.00								2		12.75' 12.75' X									NEW RIGHT-SIDE STOP SIGN IS NOW LARGER AND ON 2 POSTS	X		
SB	3.881	F	M3-3	24	12								1																
		F	M1-4	24	24								1																
		~~F~~	~~VM-120~~	~~18~~	~~24~~		~~CT RIVER BYWAY~~				~~1~~																SIGNS WERE MISSING BYWAY SIGNS MAY BE MISSING?			
		~~F~~	~~D6-4A~~	~~18~~	~~9~~		~~AMERICA'S BYWAY (PLAQUE)~~				~~1~~																		
		F	M3-3	24	12			2.00								1		13.5' X								BLACK ON WHITE	X		
		F	M1-4	24	24			4.00																				X		
		~~F~~	~~VM-120~~	~~18~~	~~24~~		~~CT RIVER BYWAY~~					~~1~~															SEE NOTE ABOVE IF NOT MISSING, SALVAGE TO BELOW THE ROUTE MARKER SIGNS			
		~~F~~	~~D6-4A~~	~~18~~	~~9~~		~~AMERICA'S BYWAY (PLAQUE)~~					~~1~~															SEE NOTE ABOVE			
SB	3.824	F	W3-5	36	36								1		X																
		F	W3-5	36	36			9.00								2		13.75' 14.25' X										X		
SB	3.757	F	VD-062B	72	16		BUSINESS SIGN			1				X																
		F	VD-062B	72	16		BUSINESS SIGN			1																	CHROMA <===			
		F	VD-062B	72	16		BUSINESS SIGN			1																	VERMED, INC <===			
							SHEET TOTALS	24.00	0.00	3	~~2~~	~~2~~	4	0	0	5		~~67.0~~ 75											
								SF	SF	EA	EA	EA	EA	EA	EA	EA		FT											
							TOWN DIRECTIONAL TOTALS	442.6	0.0	9.0	3.0	3.0	78	0.0	0.0	73		1095.0											

SIGN SUMMARY SHEET

VERMONT AGENCY OF TRANSPORTATION

PROJECT NAME: STATEWIDE SOUTHEAST REGION
PROJECT NUMBER: STPG SIGN (31)

FILE NAME: ROCKINGHAM SOUTHBOUND
PROJECT MANAGER: A. GAMBLE
DESIGNED BY: M. MILLER
ROCKINGHAM US-5 SOUTHBOUND 7

PLOT DATE: 8/13/2010
DRAWN BY: M. MILLER
CHECKED BY: A. GAMBLE

DIRECTION	MILEPOINT	LOCATION CODE (SHEET 2)	SIGN CODE	WIDTH (IN)	HEIGHT (IN)	SHEETING REMARKS	SIGN LEGEND	NEW SIGNS "A"	NEW SIGNS "B"	EXISTING SIGNS RETAIN	EXISTING SIGNS SALVAGE FROM	EXISTING SIGNS SALVAGE TO	EXISTING SIGNS REMOVE	EXIST POST RETAIN	EXIST POST REMOVE	NUMBER OF NEW POSTS	SQUARE STEEL (IN) 1.75 (LB / FT) 1.88	SQUARE STEEL (IN) 2.00 (LB / FT) 2.42	SQUARE STEEL (IN) 2.50 (LB / FT) 3.35	TUBULAR STEEL Ø (IN) FOUNDATION	TUBULAR STEEL Ø (IN) 3.00 (LB / FT) 7.60	TUBULAR STEEL Ø (IN) 3.50 (LB / FT) 9.00	TUBULAR STEEL Ø (IN) 4.00 (LB / FT) 10.80	TUBULAR STEEL Ø (IN) 5.00 (LB / FT) 14.60	SIGN FRAME REQUIRED	REMARKS	SIGN DETAIL: DETAIL IN SHS	SIGN DETAIL: DETAIL ON SHEET NUMBER	SIGN DETAIL: DETAIL ON STD SHEET NUMBER
ROCKINGHAM SB							FY-FLUORESCENT YELLOW FYG-FLUORESCENT YELLOW GREEN																			"SHS"-STANDARD HIGHWAY SIGNS			
~~SB~~	3.711	F	R2-1	24	30								1		X													
		F	R4-1	24	30								1														
		F	R2-1	~~24~~	~~30~~			7.50 ~~5.00~~								1		15.75' X							INSTALL ACROSS FROM THE "SPEED LIMIT 50 / NO PASSING ZONE PENNANT" ASSEMBLY NOTE: LARGER SIZE SIGN SIZE CHANGED. SEE E-MAIL DATED, 4/4/11, FROM A. GAMBLE, TRAFFIC OPS.	X		
		F	R4-1	24	30			5.00																			X	
SB	3.668	G	unknown	30	36		HOUSEHOLD TRASH DISPOSAL SIGN						1		X												AT EDGE OF GRAVEL PULL-OFF, FACING PARALLEL TO US-5; TOWN-INSTALLED, REMOVE ALL			
SB	3.630	F	VW-205	36	36			9.00								2		14.0' 14.25' X							SOUTH INSTALL 200 FT± ~~WEST~~ OF PREVIOUS HOUSEHOLD TRASH SIGN REMOVAL			E-154
		A	W16-4	30	24			5.00																	INSTALL PLAQUE ON LEFT SIDE POST	X		
SB	3.420	F	VW-205	30	30		WATCH FOR TURNING VEHICLES						1		X													
SB	3.353	F	W4-1R	30	30		MERGE RIGHT SYMBOL						1		X												NOT WARRANTED HERE		
SB	3.290	F	M3-3	24	12																						**EXISTING SIGNS AND POST ARE MISSING**		
		F	M1-4	24	24																								
		F	M3-3	24	12			2.00								1		13.0' X							**BLACK ON WHITE**	X		
		F	M1-4	24	24			4.00																	INSTALL BEHIND RAIL, JUST BEYOND THE JCT w/ SPENCER DR (TH-83) ON LEFT	X		
SB	3.252	F	R2-1	24	30		(REFER TO NEXT PAGE)						1		X													
		F	R4-1	24	30								1															
SIGN SUMMARY SHEET							SHEET TOTALS	~~32.50~~ ~~30.00~~	0.00	0	0	0	7	0	0	4			~~57.0~~ ~~60~~									
								SF	SF	EA	EA	EA	EA	EA	EA	EA			FT									
VERMONT AGENCY OF TRANSPORTATION							TOWN DIRECTIONAL TOTALS	442.6	0.0	9.0	3.0	3.0	78	0.0	0.0	73			1095.0									

PROJECT NAME: **STATEWIDE SOUTHEAST REGION**
PROJECT NUMBER: **STPG SIGN (31)**

FILE NAME: **ROCKINGHAM SOUTHBOUND** PLOT DATE: **8/13/2010**
PROJECT MANAGER: **A. GAMBLE** DRAWN BY: **M. MILLER**
DESIGNED BY: **M. MILLER** CHECKED BY: **A. GAMBLE**
ROCKINGHAM US-5 SOUTHBOUND 8 SHEET **95** OF **175**

DIRECTION	MILEPOINT	LOCATION CODE (SHEET 2)	SIGN CODE	WIDTH (IN)	HEIGHT (IN)	SHEETING REMARKS	SIGN LEGEND	NEW SIGNS "A"	NEW SIGNS "B"	EXISTING SIGNS RETAIN	EXISTING SIGNS SALVAGE FROM	EXISTING SIGNS SALVAGE TO	EXISTING SIGNS REMOVE	EXIST POST RETAIN	EXIST POST REMOVE	NUMBER OF NEW POSTS	SQUARE STEEL (IN) 1.75 (LB / FT) 1.88	SQUARE STEEL (IN) 2.00 (LB / FT) 2.42	SQUARE STEEL (IN) 2.50 (LB / FT) 3.35	TUBULAR STEEL Ø (IN) FOUNDATION	TUBULAR STEEL Ø (IN) 3.00 (LB / FT) 7.60	TUBULAR STEEL Ø (IN) 3.50 (LB / FT) 9.00	TUBULAR STEEL Ø (IN) 4.00 (LB / FT) 10.80	TUBULAR STEEL Ø (IN) 5.00 (LB / FT) 14.60	SIGN FRAME REQUIRED	REMARKS	SIGN DETAIL: DETAIL IN SHS	SIGN DETAIL: DETAIL ON SHEET NUMBER	SIGN DETAIL: DETAIL ON STD SHEET NUMBER
ROCKINGHAM SB							FY-FLUORESCENT YELLOW FYG-FLUORESCENT YELLOW GREEN																			"SHS"-STANDARD HIGHWAY SIGNS			
SB	3.252	E	W14-3	48	36				1																				
		F	R2-1	24	30		BACK-TO-BACK	5.00								1		15.0' X								X	
		F	R4-1	24	30			5.00																				X	
		E	W14-3	48	36			5.56																			THE PENNANT FACES NB TRAFFIC; INSTALL ON BACK OF THE SPEED LIMIT 45 SIGN	X	
SB	3.111	F	W2-3R	30	30			6.25								1		11.5' X									INSTALL 150 FT ± SOUTH OF PRIVATE SIGN "WHIPPOWILL GIFTS"	X	
SB	3.030	G	VR-017	24	30								1		X												ROCKINGHAM POST RD (TH-47)		
		G	VR-017	24	30			5.00								1		11.25' X											6
SB	3.030	H	R1-1	30	30		0050 1314 0308						1		X														
		H	R1-1	30	30			6.25								1		12.25' X									SKEWED INTERSECTION	X	
SB	2.888	F	VD-062AL	72	16		BUSINESS SIGN			1				X													WHITNEY <===		
SB	2.830	F	VD-062AS	72	16		BUSINESS SIGN			1				X													MORNING STAR ===>		
SB	2.758	F	R2-1	24	30		SPEED LIMIT 45						1		X														
		F	R4-1	24	30		DO NOT PASS						1																
SB	2.753	F	R2-1	24	30			5.00								1		15.0' X									SOUTH INSTALL BEHIND RAIL 25 FT ± ~~WEST~~ OF PREVIOUS POSITION, IF POSSIBLE	X	
		F	R4-1	24	30			5.00																			"DO NOT PASS" BELOW THE SPEED LIMIT SIGN	X	
							SHEET TOTALS	43.06	0.00	2	0	0	5	0	0	5		65.0 75										
								SF	SF	EA	EA	EA	EA	EA	EA	EA		FT										
							TOWN DIRECTIONAL TOTALS	442.6	0.0	9.0	3.0	3.0	78	0.0	0.0	73		1095.0										

SIGN SUMMARY SHEET

VERMONT AGENCY OF TRANSPORTATION

PROJECT NAME: **STATEWIDE SOUTHEAST REGION**
PROJECT NUMBER: **STPG SIGN (31)**

FILE NAME: **ROCKINGHAM SOUTHBOUND** PLOT DATE: **8/13/2010**
PROJECT MANAGER: **A. GAMBLE** DRAWN BY: **M. MILLER**
DESIGNED BY: **M. MILLER** CHECKED BY: **A. GAMBLE**
ROCKINGHAM US-5 SOUTHBOUND 9 SHEET **96** OF **175**

DIRECTION	MILEPOINT	LOCATION CODE (SHEET 2)	SIGN CODE	WIDTH (IN)	HEIGHT (IN)	SHEETING REMARKS	SIGN LEGEND	NEW SIGNS "A"	NEW SIGNS "B"	EXISTING SIGNS RETAIN	EXISTING SIGNS SALVAGE FROM	EXISTING SIGNS SALVAGE TO	EXISTING SIGNS REMOVE	EXIST POST RETAIN	EXIST POST REMOVE	NUMBER OF NEW POSTS	SQUARE STEEL (IN) 1.75 (LB / FT) 1.88	SQUARE STEEL (IN) 2.00 (LB / FT) 2.42	SQUARE STEEL (IN) 2.50 (LB / FT) 3.35	TUBULAR STEEL Ø (IN) FOUNDATION	TUBULAR STEEL Ø (IN) 3.00 (LB / FT) 7.60	TUBULAR STEEL Ø (IN) 3.50 (LB / FT) 9.00	TUBULAR STEEL Ø (IN) 4.00 (LB / FT) 10.80	TUBULAR STEEL Ø (IN) 5.00 (LB / FT) 14.60	SIGN FRAME REQUIRED	REMARKS	SIGN DETAIL: DETAIL IN SHS	SIGN DETAIL: DETAIL ON SHEET NUMBER	SIGN DETAIL: DETAIL ON STD SHEET NUMBER
ROCKINGHAM SB							FY-FLUORESCENT YELLOW FYG-FLUORESCENT YELLOW GREEN																			"SHS"-STANDARD HIGHWAY SIGNS			
SB	2.588	G	VR-017	24	30								1		X											DARBY HILL ROAD (TH-46)			
		G	VR-017	24	30			5.00								1		12.5' X									6	
SB	2.578	H	R1-1	30	30								1		X														
		H	R1-1	30	30			6.25								1		13.0' X									X	
SB	2.558	F	M3-3	24	12			2.00								1		13.0' X								**BLACK ON WHITE**	X	
		F	M1-4	24	24			4.00																	INSTALL ASSEMBLY 100 FEET ± SOUTH OF THE DARBY HILL RD (TH-46) INTERSECTION	X	
SB	2.479	F	R2-1	24	30								1		X													
		F	W14-3	48	36								1															
		F	R2-1	24	30		BACK-TO-BACK	5.00								1		13.5' X									X	
		F	W14-3	48	36			5.56																	PENNANT FACES NB TRAFFIC AND IS INSTALLED ON BACK OF THE SPEED LIMIT SIGN	X	
SB	2.151	F	VD-062C	74.75	16		TRAVEL INFORMATION SIGN			1				X											SIGNS WERE FOUND ON THE GROUND. THEY WERE NOT PART OF THIS CONTRACT TO BE RE-INSTALLED.	RETAIN		
		F	VD-062C	74.75	16		TRAVEL INFORMATION SIGN			1																RETAIN		
SB	2.066	F	R2-5A	24	30		REDUCED SPEED AHEAD						1		X													
SB	2.012	F	W3-5	36	36			9.00								2		11.5' 12.25' X								INSTALL 285 FEET ± SOUTH OF THE "REDUCED SPEED AHEAD" SIGN THAT WAS JUST REMOVED	X	
SB	1.940	F	R2-1	24	30								1		X													

SIGN SUMMARY SHEET

VERMONT AGENCY OF TRANSPORTATION

	NEW SIGNS "A"	NEW SIGNS "B"	EXISTING SIGNS RETAIN	EXISTING SIGNS SALVAGE FROM	EXISTING SIGNS SALVAGE TO	EXISTING SIGNS REMOVE	EXIST POST RETAIN	EXIST POST REMOVE	NUMBER OF NEW POSTS	SQUARE STEEL (IN)
SHEET TOTALS	36.81	0.00	2	0	0	6	0	0	6	~~75.75~~ ~~90~~
	SF	SF	EA	EA	EA	EA	EA	EA	EA	FT
TOWN DIRECTIONAL TOTALS	442.6	0.0	9.0	3.0	3.0	78	0.0	0.0	73	1095.0

PROJECT NAME: **STATEWIDE SOUTHEAST REGION**
PROJECT NUMBER: **STPG SIGN (31)**

FILE NAME: **ROCKINGHAM SOUTHBOUND** PLOT DATE: **8/13/2010**
PROJECT MANAGER: **A. GAMBLE** DRAWN BY: **M. MILLER**
DESIGNED BY: **M. MILLER** CHECKED BY: **A. GAMBLE**
ROCKINGHAM US-5 SOUTHBOUND 10 SHEET **97** OF **175**

DIRECTION	MILEPOINT	LOCATION CODE (SHEET 2)	SIGN CODE	WIDTH (IN)	HEIGHT (IN)	SHEETING REMARKS	SIGN LEGEND	NEW SIGNS "A"	NEW SIGNS "B"	EXISTING SIGNS RETAIN	EXISTING SIGNS SALVAGE FROM	EXISTING SIGNS SALVAGE TO	EXISTING SIGNS REMOVE	EXIST POST RETAIN	EXIST POST REMOVE	NUMBER OF NEW POSTS	SQUARE STEEL (IN) 1.75 (LB / FT) 1.88	SQUARE STEEL (IN) 2.00 (LB / FT) 2.42	SQUARE STEEL (IN) 2.50 (LB / FT) 3.35	TUBULAR STEEL Ø (IN) FOUNDATION	TUBULAR STEEL Ø (IN) 3.00 (LB / FT) 7.60	TUBULAR STEEL Ø (IN) 3.50 (LB / FT) 9.00	TUBULAR STEEL Ø (IN) 4.00 (LB / FT) 10.80	TUBULAR STEEL Ø (IN) 5.00 (LB / FT) 14.60	SIGN FRAME REQUIRED	REMARKS	SIGN DETAIL: DETAIL IN SHS	SIGN DETAIL: DETAIL ON SHEET NUMBER	SIGN DETAIL: DETAIL ON STD SHEET NUMBER
ROCKINGHAM SB							FY-FLUORESCENT YELLOW FYG-FLUORESCENT YELLOW GREEN																			"SHS"-STANDARD HIGHWAY SIGNS			
SB	1.940	F	R2-1	30	36			7.50								1		11.25' X								INSTALL ACROSS FROM THE NB SPEED LIMIT 50 SIGN; NOTE LARGER SIZED SIGN		6	
SB	1.902	F	R8-3A	24	24								1		X													
		F	M4-11	24	12								1													CURRENTLY BELOW THE NO PARKING SYMBOL			
		F	VR-644P	24	12			2.00								1		11.25' X								INSTALL ON TOP ABOVE THE NO PARKING SYMBOL. **BLACK ON WHITE.**		6	
		F	R8-3A	24	24			4.00																			X		
SB	1.854	F	R8-3A	24	24		NO PARKING SYMBOL						1		X											NOT NECESSARY			
SB	1.828	F	R8-3A	24	30								1		X													
		F	M4-6	24	12								1															
		F	M4-6	24	12			2.00								1		11.0' X								INSTALL PLAQUE ON TOP. **BLACK ON WHITE.**	X		
		F	R8-3A	24	24			4.00																			X		
SB	1.783	G	VR-017	24	30								1		X											WEBB TERRACE (TH-49)			
		G	VR-017	24	30			5.00								1		12.25' X										6	
SB	1.773	H	R1-1	24	24		STOP						1		X													
		F	D3-1	unknown			WEBB TERRACE TH-49				1																		
		H	R1-1	30	30			6.25								1		12.25' X									X		
							SHEET TOTALS	30.75	0.00	0	1	0	7	0	0	5		58.0 75											
								SF	SF	EA	EA	EA	EA	EA	EA	EA		FT											
							TOWN DIRECTIONAL TOTALS	442.6	0.0	9.0	3.0	3.0	78	0.0	0.0	73		1095.0											

SIGN SUMMARY SHEET

VERMONT AGENCY OF TRANSPORTATION

PROJECT NAME: **STATEWIDE SOUTHEAST REGION**
PROJECT NUMBER: **STPG SIGN (31)**

FILE NAME: **ROCKINGHAM SOUTHBOUND** PLOT DATE: **8/13/2010**
PROJECT MANAGER: **A. GAMBLE** DRAWN BY: **M. MILLER**
DESIGNED BY: **M. MILLER** CHECKED BY: **A. GAMBLE**
ROCKINGHAM US-5 SOUTHBOUND 11 SHEET **98** OF **175**

DIRECTION	MILEPOINT	LOCATION CODE (SHEET 2)	SIGN CODE	WIDTH (IN)	HEIGHT (IN)	SHEETING REMARKS	SIGN LEGEND	NEW SIGNS "A"	NEW SIGNS "B"	EXISTING SIGNS RETAIN	EXISTING SIGNS SALVAGE FROM	EXISTING SIGNS SALVAGE TO	EXISTING SIGNS REMOVE	EXIST POST RETAIN	EXIST POST REMOVE	NUMBER OF NEW POSTS	SQUARE STEEL (IN) 1.75 (LB / FT) 1.88	SQUARE STEEL (IN) 2.00 (LB / FT) 2.42	SQUARE STEEL (IN) 2.50 (LB / FT) 3.35	TUBULAR STEEL Ø (IN) FOUNDATION	TUBULAR STEEL Ø (IN) 3.00 (LB / FT) 7.60	TUBULAR STEEL Ø (IN) 3.50 (LB / FT) 9.00	TUBULAR STEEL Ø (IN) 4.00 (LB / FT) 10.80	TUBULAR STEEL Ø (IN) 5.00 (LB / FT) 14.60	SIGN FRAME REQUIRED	REMARKS	SIGN DETAIL: DETAIL IN SHS	SIGN DETAIL: DETAIL ON SHEET NUMBER	SIGN DETAIL: DETAIL ON STD SHEET NUMBER
ROCKINGHAM SB							FY-FLUORESCENT YELLOW FYG-FLUORESCENT YELLOW GREEN																			"SHS"-STANDARD HIGHWAY SIGNS			
SB	1.773	F	D3-1	unknown			WEBB TERRACE TH-49					1														SALVAGE STREET NAME SIGN TO TOP OF STOP SIGN POST (SEE PREVIOUS PAGE)			
SB	1.595	F	R2-1	24	30		SPEED LIMIT 40						1		X														
		F	W2-2R	30	30			6.25								1		14.0' X								X		
		F	W16-8P	24	8			1.33																				7
SB	1.585	F	n/a	30	30		PEDESTRIAN (SYMBOL) w/ 2000 FT (TEXT)					~~1~~			~~X~~											ILLEGAL TOWN-INSTALLED SIGN; REMOVE ALL			PRIOR TO PROJECT, SIGN WAS REMOVED
SB	1.552	F	R3-1	24	30		NO RIGHT TURN (TEXT)						1		X														
		F	R3-1	24	24			4.00								1		12.25' X								X		
SB	1.545	G	VR-017	24	30								1		X											POND ROAD (TH-302)			
		G	VR-017	24	30			5.00								1		12.75' X										6
SB	1.540	H	R1-1	24	24		STOP						1		X														
		H	R3-2	24	24		NO LEFT TURN (TEXT)						1																
		H	R1-1	30	30			6.25								1		11.75' X								X		
		H	R3-1	24	24		0050 1314 0156	4.00																		INSTALL THE NO LEFT TURN SYMBOL BELOW THE STOP SIGN (BOTH SIGNS FACE THE SAME DIRECTION)		X	
SB	1.467	F	R2-1	24	30		SPEED LIMIT 35						1		X														
		F	VR-040	24	24		THROUGH WAY ENDS HERE						1																
SIGN SUMMARY SHEET							SHEET TOTALS	26.83	0.00	0	0	1	~~7~~ 8	0	0	4			~~50.75~~ 60									
								SF	SF	EA	EA	EA	EA	EA	EA	EA			FT									
VERMONT AGENCY OF TRANSPORTATION							TOWN DIRECTIONAL TOTALS	442.6	0.0	9.0	3.0	3.0	78	0.0	0.0	73			1095.0									

PROJECT NAME: **STATEWIDE SOUTHEAST REGION**
PROJECT NUMBER: **STPG SIGN (31)**

FILE NAME: **ROCKINGHAM SOUTHBOUND** PLOT DATE: **8/13/2010**
PROJECT MANAGER: **A. GAMBLE** DRAWN BY: **M. MILLER**
DESIGNED BY: **M. MILLER** CHECKED BY: **A. GAMBLE**
ROCKINGHAM US-5 SOUTHBOUND 12 SHEET **99** OF **175**

DIRECTION	MILEPOINT	LOCATION CODE (SHEET 2)	SIGN CODE	WIDTH (IN)	HEIGHT (IN)	SHEETING REMARKS	SIGN LEGEND	NEW SIGNS "A"	NEW SIGNS "B"	EXISTING SIGNS RETAIN	EXISTING SIGNS SALVAGE FROM	EXISTING SIGNS SALVAGE TO	EXISTING SIGNS REMOVE	EXIST POST RETAIN	EXIST POST REMOVE	NUMBER OF NEW POSTS	SQUARE STEEL (IN) 1.75 (LB / FT) 1.88	SQUARE STEEL (IN) 2.00 (LB / FT) 2.42	SQUARE STEEL (IN) 2.50 (LB / FT) 3.35	TUBULAR STEEL Ø (IN) FOUNDATION	TUBULAR STEEL Ø (IN) 3.00 (LB / FT) 7.60	TUBULAR STEEL Ø (IN) 3.50 (LB / FT) 9.00	TUBULAR STEEL Ø (IN) 4.00 (LB / FT) 10.80	TUBULAR STEEL Ø (IN) 5.00 (LB / FT) 14.60	SIGN FRAME REQUIRED	REMARKS	SIGN DETAIL: DETAIL IN SHS	SIGN DETAIL: DETAIL ON SHEET NUMBER	SIGN DETAIL: DETAIL ON STD SHEET NUMBER
ROCKINGHAM SB							FY-FLUORESCENT YELLOW FYG-FLUORESCENT YELLOW GREEN																			"SHS"-STANDARD HIGHWAY SIGNS			
SB	1.467	E	VR-039	18	18		STATE HIGHWAY BEGINS (ON BACK)						1															
		F	VR-038	24	18		STATE HIGHWAY ENDS	3.00								1		12.75' X								INSTALL ON TOP		6	
		F	R2-1	~~24~~ 30	~~30~~ 36		SPEED LIMIT 35	~~5.00~~ 7.50																		NOTE LARGER SIZE OF NEW SIGN. SEE E-MAIL FROM A. GAMBLE, TRAFFIC OPS., DATED 4/4/11	X		
SB	6.745	F	VW-133R	30	30		HIDDEN DRIVE RIGHT	6.25								1		12.5' X								THIS NEW SIGN WAS ADDED TO PROJECT AT THE REQUEST OF DIST#2			
							SHEET TOTALS	~~8.00~~ 16.75	0.00	0	0	0	1	0	0	1		~~15~~ 25.25								
								SF	SF	EA	EA	EA	EA	EA	EA	EA		FT										
							TOWN DIRECTIONAL TOTALS	442.6	0.0	9.0	3.0	3.0	78	0.0	0.0	73		1095.0										

SIGN SUMMARY SHEET

VERMONT AGENCY OF TRANSPORTATION

PROJECT NAME: **STATEWIDE SOUTHEAST REGION**
PROJECT NUMBER: **STPG SIGN (31)**

FILE NAME: **ROCKINGHAM SOUTHBOUND** PLOT DATE: **8/13/2010**
PROJECT MANAGER: **A. GAMBLE** DRAWN BY: **M. MILLER**
DESIGNED BY: **M. MILLER** CHECKED BY: **A. GAMBLE**
ROCKINGHAM US-5 SOUTHBOUND 13 SHEET **100** OF **175**

DIRECTION	MILEPOINT	LOCATION CODE (SHEET 2)	SIGN CODE	WIDTH (IN)	HEIGHT (IN)	SHEETING REMARKS	SIGN LEGEND	NEW SIGNS "A"	NEW SIGNS "B"	EXISTING SIGNS RETAIN	EXISTING SIGNS SALVAGE FROM	EXISTING SIGNS SALVAGE TO	EXISTING SIGNS REMOVE	EXIST POST RETAIN	EXIST POST REMOVE	NUMBER OF NEW POSTS	SQUARE STEEL (IN) 1.75 (LB / FT) 1.88	SQUARE STEEL (IN) 2.00 (LB / FT) 2.42	SQUARE STEEL (IN) 2.50 (LB / FT) 3.35	TUBULAR STEEL Ø (IN) FOUNDATION	TUBULAR STEEL Ø (IN) 3.00 (LB / FT) 7.60	TUBULAR STEEL Ø (IN) 3.50 (LB / FT) 9.00	TUBULAR STEEL Ø (IN) 4.00 (LB / FT) 10.80	TUBULAR STEEL Ø (IN) 5.00 (LB / FT) 14.60	SIGN FRAME REQUIRED	REMARKS	SIGN DETAIL: DETAIL IN SHS	SIGN DETAIL: DETAIL ON SHEET NUMBER	SIGN DETAIL: DETAIL ON STD SHEET NUMBER
CHESTER EB							FY-FLUORESCENT YELLOW FYG-FLUORESCENT YELLOW GREEN																			"SHS"-STANDARD HIGHWAY SIGNS			
EB	0.035	A	R2-1	24	30		SPEED LIMIT 40						1		X													
		A	M3-2	24	12			2.00								1		13.0' X							GREEN ON WHITE	X		
		A	M1-5	24	24			4.00																				E-136B
EB	0.060	A	M3-2	24	12		EAST						1		X													
		A	M1-5	24	24		VERMONT 10						1														
		A	R2-1	24	30			5.00								1			13.0' X								X	
EB	0.085	A	W11-7	30	30		EQUESTRIAN SYMBOL						1		X													
		B	W3-1	30	30		STOP AHEAD SYMBOL (ON BACK)						1															
		A	W11-7	30	30			6.25								1			14.0' X								X	
EB	0.130	A	W1-2R	30	30		CURVE RIGHT						1		X													
		A	W13-1	18	18		35-MPH (PLAQUE)						1															
EB	0.162	A	VW-054R	30	30		HIDDEN DRIVE RIGHT						1		X													
EB	0.197	A	S3-1	30	30		SCHOOL BUS STOP AHEAD						1		X													
		A	W1-2R	30	30			6.25								1		15.0' X								X	
		A	W13-1	18	18			2.25																				X
SIGN SUMMARY SHEET							SHEET TOTALS	25.75	0.00	0	0	0	9	0	0	4			~~55.0~~ ~~60~~									
								SF	SF	EA	EA	EA	EA	EA	EA	EA			FT									
VERMONT AGENCY OF TRANSPORTATION							TOWN DIRECTIONAL TOTALS	163.5	0.0	1.0	0.0	0.0	33	0.0	0.0	30			450.0									

PROJECT NAME: **STATEWIDE SOUTHEAST REGION**
PROJECT NUMBER: **STPG SIGN (31)**

FILE NAME: **CHESTER EASTBOUND** PLOT DATE: **8/13/2010**
PROJECT MANAGER: **A. GAMBLE** DRAWN BY: **M. MILLER**
DESIGNED BY: **M. MILLER** CHECKED BY: **A. GAMBLE**
CHESTER VT-10 EASTBOUND 1 SHEET **101** OF **175**

DIRECTION	MILEPOINT	LOCATION CODE (SHEET 2)	SIGN CODE	WIDTH (IN)	HEIGHT (IN)	SHEETING REMARKS	SIGN LEGEND	NEW SIGNS "A"	NEW SIGNS "B"	EXISTING SIGNS RETAIN	EXISTING SIGNS SALVAGE FROM	EXISTING SIGNS SALVAGE TO	EXISTING SIGNS REMOVE	EXIST POST RETAIN	EXIST POST REMOVE	NUMBER OF NEW POSTS	SQUARE STEEL (IN) 1.75 (LB / FT) 1.88	SQUARE STEEL (IN) 2.00 (LB / FT) 2.42	SQUARE STEEL (IN) 2.50 (LB / FT) 3.35	TUBULAR STEEL Ø (IN) FOUNDATION	TUBULAR STEEL Ø (IN) 3.00 (LB / FT) 7.60	TUBULAR STEEL Ø (IN) 3.50 (LB / FT) 9.00	TUBULAR STEEL Ø (IN) 4.00 (LB / FT) 10.80	TUBULAR STEEL Ø (IN) 5.00 (LB / FT) 14.60	SIGN FRAME REQUIRED	REMARKS	SIGN DETAIL: DETAIL IN SHS	SIGN DETAIL: DETAIL ON SHEET NUMBER	SIGN DETAIL: DETAIL ON STD SHEET NUMBER
CHESTER EB							FY-FLUORESCENT YELLOW FYG-FLUORESCENT YELLOW GREEN																			"SHS"-STANDARD HIGHWAY SIGNS			
EB	0.222	A	R2-1	24	30		SPEED LIMIT 40						1		X														
		A	VW-054	30	30			6.25								1		13.25' X										E-154
EB	0.590	A	R2-1	24	30								1		X														
		A	R2-1	24	30		0100 1407 0060	5.00								1		13.0' X							X		
EB	0.772	A	S3-1	30	30		SCHOOL BUS STOP AHEAD						1		X														
		A	VW-133	30	30		HIDDEN DRIVES						1																
		A	VW-133	30	30			6.25								1		13.5' X								SINGULAR "DRIVE"		E-154
EB	0.938	A	VD-062B	72	16		BUSINESS DIRECTORY SIGN			1				X															
EB	1.032	C	VR-017	24	30																						WARREN ROAD (TH-80); **EXISTING SIGN AND POST MISSING**			
		C	VR-017	24	30			5.00								1		12.75' X										6	
EB	1.036	D	R1-1	30	30								1		X														
		D	R1-1	30	30			6.25								1		13.0' X							X		
EB	1.045	A	W1-2L	30	30		CURVE LEFT						1		X														
EB	1.085	A	W1-5L	30	30			6.25								1		14.25' X									INSTALL 50 FEET ± IN ADVANCE OF THE SPEED LIMIT 40 SIGN (WHICH WILL BE REMOVED)	X		
EB	1.095	A	R2-1	24	30		SPEED LIMIT 40						1		X														
SIGN SUMMARY SHEET							SHEET TOTALS	35.00	0.00	1	0	0	7	0	0	6												
								SF	SF	EA	EA	EA	EA	EA	EA	EA			FT									
VERMONT AGENCY OF TRANSPORTATION							TOWN DIRECTIONAL TOTALS	163.5	0.0	1.0	0.0	0.0	33	0.0	0.0	30			450.0									

79.75 ~~90~~

PROJECT NAME: **STATEWIDE SOUTHEAST REGION**
PROJECT NUMBER: **STPG SIGN (31)**

FILE NAME: **CHESTER EASTBOUND** PLOT DATE: **8/13/2010**
PROJECT MANAGER: **A. GAMBLE** DRAWN BY: **M. MILLER**
DESIGNED BY: **M. MILLER** CHECKED BY: **A. GAMBLE**
CHESTER VT-10 EASTBOUND 2 SHEET **102** OF **175**

DIRECTION	MILEPOINT	LOCATION CODE (SHEET 2)	SIGN CODE	WIDTH (IN)	HEIGHT (IN)	SHEETING REMARKS	SIGN LEGEND	NEW SIGNS "A"	NEW SIGNS "B"	EXISTING SIGNS RETAIN	EXISTING SIGNS SALVAGE FROM	EXISTING SIGNS SALVAGE TO	EXISTING SIGNS REMOVE	EXIST POST RETAIN	EXIST POST REMOVE	NUMBER OF NEW POSTS	SQUARE STEEL (IN) 1.75 (LB / FT) 1.88	SQUARE STEEL (IN) 2.00 (LB / FT) 2.42	SQUARE STEEL (IN) 2.50 (LB / FT) 3.35	TUBULAR STEEL Ø (IN) FOUNDATION	TUBULAR STEEL Ø (IN) 3.00 (LB / FT) 7.60	TUBULAR STEEL Ø (IN) 3.50 (LB / FT) 9.00	TUBULAR STEEL Ø (IN) 4.00 (LB / FT) 10.80	TUBULAR STEEL Ø (IN) 5.00 (LB / FT) 14.60	SIGN FRAME REQUIRED	REMARKS	SIGN DETAIL: DETAIL IN SHS	SIGN DETAIL: DETAIL ON SHEET NUMBER	SIGN DETAIL: DETAIL ON STD SHEET NUMBER
CHESTER EB							FY-FLUORESCENT YELLOW FYG-FLUORESCENT YELLOW GREEN																			"SHS"-STANDARD HIGHWAY SIGNS			
EB	1.110	C	VR-017	24	30		LEGAL LOAD LIMIT 24,000 POUNDS																			MATTSON ROAD (TH-30); **EXISTING SIGN AND POST MISSING**			
		C	VR-017	24	30			5.00								1		12.75' X										6
EB	1.114	D	R1-1	30	30		STOP 0100 1407 0112						1		X													
		D	R1-1	30	30			6.25								1		12.5' X									X	
EB	1.125	A	W1-5L	30	30		SPEED LIMIT 40 LEFT WINDING CURVES						1		X													
		A	R2-1	24	30			5.00								1		12.0' X									X	
EB	1.535	B	W1-6	48	24		LARGE ARROW RIGHT						1		X											FACES WB TRAFFIC		
EB	1.715	A	R2-1	24	30		SPEED LIMIT 50						1		X													
		A	R2-1	24	30			5.00								1		13.25' X									X	
EB	2.176	C	VR-017	24	24		LEGAL LOAD LIMIT 24,000 POUNDS			1			~~1~~		X					SIGN WAS REPLACED IN 2008. POST WAS DAMAGED AND REPLACED ON THIS PROJECT.						MINERAL SPRINGS ROAD (TH-31)		
		C	VR-017	24	30			~~5.00~~								1		12.25' X										6
EB	2.184	D	R1-1	24	24		MINERAL SPRINGS RD TH31 STOP			2			~~1~~		X					SIGN WAS REPLACED IN 2008.								
		D	R1-1	30	30			~~6.25~~								1		X									X	
EB	2.225	A	R2-1	24	30		SPEED LIMIT 50	5.00								1		13.25 X									INSTALL 200 FT ± EAST OF THE JCT WITH MINERAL SPRINGS ROAD	X	
EB	2.410	A	W5-1	30	30		ROAD NARROWS						1		X													
							SHEET TOTALS	~~26.25~~ 37.50 SF	0.00 SF	~~3~~ 0 EA	0 EA	0 EA	~~5~~ 7 EA	0 EA	0 EA	7 EA			~~76.0~~ 105 FT									
							TOWN DIRECTIONAL TOTALS	163.5	0.0	1.0	0.0	0.0	33	0.0	0.0	30			450.0									

SIGN SUMMARY SHEET

VERMONT AGENCY OF TRANSPORTATION

PROJECT NAME: **STATEWIDE SOUTHEAST REGION**
PROJECT NUMBER: **STPG SIGN (31)**

FILE NAME: **CHESTER EASTBOUND**
PROJECT MANAGER: **A. GAMBLE**
DESIGNED BY: **M. MILLER**
CHESTER VT-10 EASTBOUND 3

PLOT DATE: **8/13/2010**
DRAWN BY: **M. MILLER**
CHECKED BY: **A. GAMBLE**
SHEET **103** OF **175**

DIRECTION	MILEPOINT	LOCATION CODE (SHEET 2)	SIGN CODE	WIDTH (IN)	HEIGHT (IN)	SHEETING REMARKS	SIGN LEGEND	NEW SIGNS "A"	NEW SIGNS "B"	EXISTING SIGNS RETAIN	EXISTING SIGNS SALVAGE FROM	EXISTING SIGNS SALVAGE TO	EXISTING SIGNS REMOVE	EXIST POST RETAIN	EXIST POST REMOVE	NUMBER OF NEW POSTS	SQUARE STEEL (IN) 1.75 (LB / FT) 1.88	SQUARE STEEL (IN) 2.00 (LB / FT) 2.42	SQUARE STEEL (IN) 2.50 (LB / FT) 3.35	TUBULAR STEEL Ø (IN) FOUNDATION	TUBULAR STEEL Ø (IN) 3.00 (LB / FT) 7.60	TUBULAR STEEL Ø (IN) 3.50 (LB / FT) 9.00	TUBULAR STEEL Ø (IN) 4.00 (LB / FT) 10.80	TUBULAR STEEL Ø (IN) 5.00 (LB / FT) 14.60	SIGN FRAME REQUIRED	REMARKS	SIGN DETAIL: DETAIL IN SHS	SIGN DETAIL: DETAIL ON SHEET NUMBER	SIGN DETAIL: DETAIL ON STD SHEET NUMBER
CHESTER EB							FY-FLUORESCENT YELLOW FYG-FLUORESCENT YELLOW GREEN																			"SHS"-STANDARD HIGHWAY SIGNS			
		A	VW-619	36	36		SHOULDER NARROWS 0100 1407 0240	9.00								2		14.0' 14.75' X								BEHIND RAIL		5	
EB	2.470	A	W11-7	30	30		EQUESTRIAN SYMBOL						1		X														
EB	2.536	C	VR-017	24	30		LEGAL LOAD LIMIT 24,000 POUNDS	5.00								1		13.0' X								DAVIDSON HILL ROAD (TH-81); INSTALL NEW ON TH-81 JUST BEYOND THE "Y" INTERSECTION		6	
EB	2.540	C	VR-017	24	24		LLL 24K (B-B w/ EXISTING STOP SIGN)						1		X												DAVIDSON HILL ROAD (TH-81)			
		D	R1-1	24	24		0100 1407 0255 STOP						1														EXISTING LEGAL LOAD LIMIT AND STOP SIGN ARE MOUNTED BACK-TO-BACK; REMOVE ALL			
		D	R1-1	30	30		STOP	6.25								1		12.5' X								INSTALL NEW FOR THE WESTERLY APPROACH AT THIS "Y" INTERSECTION	X		
EB	2.548	D	R1-1	30	30		STOP	6.25								1		11.0' X								INSTALL NEW FOR THE EASTERLY APPROACH AT THIS "Y" INTERSECTION	X		
EB	~~2.628~~ 2.600	A	W1-2R	30	30								1		X														
		A	W13-1	18	18								1																
		A	W1-2R	30	30			6.25			1	1	1			1		14.0' X								DUE TO POOR VISIBILITY BOTH SIGNS WERE MOVED 150' EAST AFTER THE ORIGINAL INSTALLATION. PAY FOR REMOVALS.	X		
		A	W13-1	18	18		35 MPH	2.25			1	1	1															X	
EB	2.780	A	VW-060	30	30		HIDDEN DRIVES	6.25								1		13.5' X								INSTALL 150 FT ± IN ADVANCE OF THE EXISTING SIGN, TO SEPARATE IT FROM THE SBSA SIGN.			E-154
EB	2.810	A	S3-1	30	30		SCHOOL BUS STOP AHEAD						1		X														
		A	VW-060	30	30		~~CHANGED TO SYMBOL SIGN. SEE SHEET #~~ ~~HIDDEN DRIVES~~						1													SYMBOL SIGN INSTALLED. SEE E-MAIL, DATED 4/4/11, FROM A. GAMBLE, TRAFFIC OPS.			
		A	S3-1	36	36	FYG	SCHOOL BUS STOP AHEAD 0100 1407 0281	9.00								2		12.5' 14.0' X								FLUORESCENT YELLOW-GREEN; LARGER SIGN ON 2 POSTS. (TEXT VERSION FROM 2004 SHS).	X		
							SHEET TOTALS	50.25 SF	0.00 SF	0 EA	~~2~~ 0 EA	~~2~~ 0 EA	7 EA	0 EA	0 EA	9 EA		~~119.25~~ 135 FT										
							TOWN DIRECTIONAL TOTALS	163.5	0.0	1.0	0.0	0.0	33	0.0	0.0	30		450.0										

SIGN SUMMARY SHEET

VERMONT AGENCY OF TRANSPORTATION

PROJECT NAME: **STATEWIDE SOUTHEAST REGION**
PROJECT NUMBER: **STPG SIGN (31)**

FILE NAME: **CHESTER EASTBOUND**
PROJECT MANAGER: **A. GAMBLE**
DESIGNED BY: **M. MILLER**
CHESTER VT-10 EASTBOUND 4

PLOT DATE: **8/13/2010**
DRAWN BY: **M. MILLER**
CHECKED BY: **A. GAMBLE**
SHEET **104** OF **175**

DIRECTION	MILEPOINT	LOCATION CODE (SHEET 2)	SIGN CODE	WIDTH (IN)	HEIGHT (IN)	SHEETING REMARKS	SIGN LEGEND	NEW SIGNS "A"	NEW SIGNS "B"	EXISTING SIGNS RETAIN	EXISTING SIGNS SALVAGE FROM	EXISTING SIGNS SALVAGE TO	EXISTING SIGNS REMOVE	EXIST POST RETAIN	EXIST POST REMOVE	NUMBER OF NEW POSTS	SQUARE STEEL (IN) 1.75 (LB / FT) 1.88	SQUARE STEEL (IN) 2.00 (LB / FT) 2.42	SQUARE STEEL (IN) 2.50 (LB / FT) 3.35	TUBULAR STEEL Ø (IN) FOUNDATION	TUBULAR STEEL Ø (IN) 3.00 (LB / FT) 7.60	TUBULAR STEEL Ø (IN) 3.50 (LB / FT) 9.00	TUBULAR STEEL Ø (IN) 4.00 (LB / FT) 10.80	TUBULAR STEEL Ø (IN) 5.00 (LB / FT) 14.60	SIGN FRAME REQUIRED	REMARKS	SIGN DETAIL: DETAIL IN SHS	SIGN DETAIL: DETAIL ON SHEET NUMBER	SIGN DETAIL: DETAIL ON STD SHEET NUMBER
CHESTER EB							FY-FLUORESCENT YELLOW FYG-FLUORESCENT YELLOW GREEN																			"SHS"-STANDARD HIGHWAY SIGNS			
EB	3.190	A	OM-3R	12	36								~~1~~		X											THIS BRIDGE DECK WAS REPLACED AND WIDENED RECENTLY. DUE TO THE WIDER SHOULDERS THE SIGNS WERE ALREADY REMOVED. NEW SIGNS WERE NOT NEEDED.			
		A	OM-3R	12	36			~~3.00~~								1		X									X		
EB	3.210	B	OM-3L	12	36								~~1~~		X											SEE ABOVE REMARKS			
		B	OM-3L	12	36			~~3.00~~								1		X									X		
EB	3.425	A	R2-1	24	30		SPEED LIMIT 50						1		X														
EB	3.400	A	W1-10L	36	36			9.00								2		13.5' 14.0' X								INSTALL 100 FT ± NORTH OF THE REMOVED SPEED LIMIT 50 SIGN	X		

DIRECTION	MILEPOINT	LOCATION CODE (SHEET 2)	SIGN CODE	WIDTH (IN)	HEIGHT (IN)	SHEETING REMARKS	SIGN LEGEND	NEW SIGNS "A"	NEW SIGNS "B"	EXISTING SIGNS RETAIN	EXISTING SIGNS SALVAGE FROM	EXISTING SIGNS SALVAGE TO	EXISTING SIGNS REMOVE	EXIST POST RETAIN	EXIST POST REMOVE	NUMBER OF NEW POSTS	SQUARE STEEL (IN) 1.75 (LB / FT) 1.88	SQUARE STEEL (IN) 2.00 (LB / FT) 2.42	SQUARE STEEL (IN) 2.50 (LB / FT) 3.35	TUBULAR STEEL Ø (IN) FOUNDATION	TUBULAR STEEL Ø (IN) 3.00 (LB / FT) 7.60	TUBULAR STEEL Ø (IN) 3.50 (LB / FT) 9.00	TUBULAR STEEL Ø (IN) 4.00 (LB / FT) 10.80	TUBULAR STEEL Ø (IN) 5.00 (LB / FT) 14.60	SIGN FRAME REQUIRED	REMARKS	SIGN DETAIL: DETAIL IN SHS	SIGN DETAIL: DETAIL ON SHEET NUMBER	SIGN DETAIL: DETAIL ON STD SHEET NUMBER
CHESTER WB							FY-FLUORESCENT YELLOW FYG-FLUORESCENT YELLOW GREEN																			"SHS"-STANDARD HIGHWAY SIGNS			
WB	3.400	F	W5-1	30	30		ROAD NARROWS						1		X														
WB	3.445	F	VW-619	36	36			9.00								2		~~15.0'~~ 16.0' ~~X~~								INSTALL 25 FT ± WEST OF JUST-REMOVED SIGN		5	
WB	3.425	F	M3-4	24	12			2.00								1		~~13.0'~~ ~~X~~			DUE TO PLAN DESIGN ERROR, THIS SIGN WAS CHANGED TO A SPEED LIMIT 50 SIGN. SEE SHEET #112					**GREEN ON WHITE**	X		
		F	M1-5	24	24			4.00																		INSTALL THIS NEW ASSEMBLY 175 FT ± WEST OF THE "SHOULDER NARROWS" SIGN.			E-136B
WB	3.380	F	M1-6	15	13		ROUTE 10 (BLACK & WHITE)						1		X														
WB	3.205	F	OM-3R	12	36								~~1~~		~~X~~														
		F	OM-3R	12	36			~~3.00~~								~~1~~		~~X~~		THIS BRIDGE NOW HAS WIDER SHOULDERS DUE TO RECENT DECK REPLACEMENT PROJECT.						X		
WB	3.190	E	OM-3L	12	36								~~1~~		~~X~~					SEE MM 3.205 ABOVE								
		E	OM-3L	12	36			~~3.00~~								~~1~~		~~X~~									X		
WB	3.035	F	W11-7	30	30		EQUESTRIAN SYMBOL						1		X														
WB	2.955	F	W1-2L	30	30		LEFT CURVE						1		X														
		F	W13-1	18	18		35 MPH (PLAQUE)						1																
WB	2.953	G	VR-017	24	30			5.00								1		12.0' X								INSTALL NEW ACROSS FROM THE STOP SIGN; **NOTE 16,000 LIMIT**		6	
WB	2.949	H	R1-1	24	24		STOP						1		X												GOULD ROAD (TH-27)			
		G	VR-017	24	24		LEGAL LOAD LIMIT 16,000 POUNDS						1														LEGAL LOAD AND STOP SIGNS INSTALLED BACK-TO-BACK; TO BE SEPERATED			
							SHEET TOTALS	~~20.00~~ ~~26.00~~	0.00	0	0	0	~~7~~ ~~9~~	0	0	~~4~~ ~~6~~		~~56.0~~ ~~90~~								
								SF	SF	EA	EA	EA	EA	EA	EA	EA		FT											
							TOWN DIRECTIONAL TOTALS	275.0	0.0	0.0	0.0	0.0	53	0.0	0.0	48		720.0											

SIGN SUMMARY SHEET

VERMONT AGENCY OF TRANSPORTATION

PROJECT NAME: **STATEWIDE SOUTHEAST REGION**
PROJECT NUMBER: **STPG SIGN (31)**

FILE NAME: **CHESTER WESTBOUND** PLOT DATE: **8/13/2010**
PROJECT MANAGER: **A. GAMBLE** DRAWN BY: **M. MILLER**
DESIGNED BY: **M. MILLER** CHECKED BY: **A. GAMBLE**
CHESTER VT-10 WESTBOUND 1 SHEET **106** OF **175**

DIRECTION	MILEPOINT	LOCATION CODE (SHEET 2)	SIGN CODE	WIDTH (IN)	HEIGHT (IN)	SHEETING REMARKS	SIGN LEGEND	NEW SIGNS "A"	NEW SIGNS "B"	EXISTING SIGNS RETAIN	EXISTING SIGNS SALVAGE FROM	EXISTING SIGNS SALVAGE TO	EXISTING SIGNS REMOVE	EXIST POST RETAIN	EXIST POST REMOVE	NUMBER OF NEW POSTS	SQUARE STEEL (IN) 1.75 (LB/FT) 1.88	SQUARE STEEL (IN) 2.00 (LB/FT) 2.42	SQUARE STEEL (IN) 2.50 (LB/FT) 3.35	TUBULAR STEEL Ø (IN) FOUNDATION	TUBULAR STEEL Ø (IN) 3.00 (LB/FT) 7.60	TUBULAR STEEL Ø (IN) 3.50 (LB/FT) 9.00	TUBULAR STEEL Ø (IN) 4.00 (LB/FT) 10.80	TUBULAR STEEL Ø (IN) 5.00 (LB/FT) 14.60	SIGN FRAME REQUIRED	REMARKS	SIGN DETAIL: DETAIL IN SHS	SIGN DETAIL: DETAIL ON SHEET NUMBER	SIGN DETAIL: DETAIL ON STD SHEET NUMBER
CHESTER WB							FY-FLUORESCENT YELLOW FYG-FLUORESCENT YELLOW GREEN																			"SHS"-STANDARD HIGHWAY SIGNS			
WB	2.949	H	R1-1	30	30		STOP 0100 1407 0295	6.25								1		13.0' X									X		
WB	2.905	F	W1-2L	30	30			6.25								1		15.75' X								INSTALL 220 FT ± WEST OF GOULD ROAD, JUST BEFORE THE BEGINNING OF THE TREELINE	X		
		F	W13-1	18	18		35 MPH	2.25																			X		
WB	2.870	F	W1-6	48	24								1		X											DURING THE SNOWSTORM ON 10/29/11, THE SIGN AND POST WERE DAMAGED WHEN THEY WERE HIT BY A VEHICLE. ON 11/17/11 THE CONTRACTOR REPLACED THE POST AND SIGN				
		F	W1-6	48	24			8.00								2		12.75' 12.5' X									X		
WB	2.865	E	W1-6	48	24			8.00								2		11.75' 12.25' X				SEE ABOVE ALSO DAMAGED.				INSTALL 25 FT ± BEYOND THE LARGE ARROW LEFT, TO 10 FT± BEYOND THE UTILITY POLE; FACES EB TRAFFIC	X	SEE SHEET #112A.	
WB	2.840	F	W1-6	48	24								1		X							SEE SHEET #112A.							
		F	W1-6	48	24			8.00								2		13.0' 12.25' X				SEE SHEET #112A.					X		
WB	2.839	E	W1-6	48	24								1		X											FACES EB TRAFFIC			
		E	W1-6	48	24			8.00								2		12.5' 13.0' X									X		
WB	2.715	F	W1-6	48	24		LARGE ARROW LEFT						1		X														
WB	2.647	G	VR-017	24	24		AMSDEN HILL RD. TH 24						1		X							ROAD SIGN WAS SALVAGED AND RE-ERECTED.				AMSDEN HILL ROAD (TH-24); EXISTING SIGNS ARE MOUNTED BACK-TO-BACK			
		H	R1-1	24	24								1																
		G	VR-017	24	30		LEGAL LOAD LIMIT 16,000 POUNDS BACK-TO-BACK STOP	5.00			1	1				1		12.75' X								INSTALL BACK-TO-BACK; **NOTE 16,000 POUND LIMIT**		6	
		H	R1-1	30	30			6.25																		NOTE: THE EXTRA STOP SIGN ON THE LEFT IS DUE TO THE HOUSE ON THE RIGHT THAT RESTRICTS VISIBILITY	X		
							SHEET TOTALS	58.00	0.00	0	~~1~~ 0	~~1~~ 0	6	0	0	11		~~141.5~~ 165										
								SF	SF	EA	EA	EA	EA	EA	EA	EA		FT										
							TOWN DIRECTIONAL TOTALS	275.0	0.0	0.0	0.0	0.0	53	0.0	0.0	48		720.0										

SIGN SUMMARY SHEET

VERMONT AGENCY OF TRANSPORTATION

PROJECT NAME: **STATEWIDE SOUTHEAST REGION**
PROJECT NUMBER: **STPG SIGN (31)**

FILE NAME: **CHESTER WESTBOUND**
PROJECT MANAGER: **A. GAMBLE**
DESIGNED BY: **M. MILLER**
CHESTER VT-10 WESTBOUND 2

PLOT DATE: **8/13/2010**
DRAWN BY: **M. MILLER**
CHECKED BY: **A. GAMBLE**
SHEET **107** OF **175**

DIRECTION	MILEPOINT	LOCATION CODE (SHEET 2)	SIGN CODE	WIDTH (IN)	HEIGHT (IN)	SHEETING REMARKS	SIGN LEGEND	NEW SIGNS "A"	NEW SIGNS "B"	EXISTING SIGNS RETAIN	EXISTING SIGNS SALVAGE FROM	EXISTING SIGNS SALVAGE TO	EXISTING SIGNS REMOVE	EXIST POST RETAIN	EXIST POST REMOVE	NUMBER OF NEW POSTS	SQUARE STEEL (IN) 1.75 (LB/FT) 1.88	SQUARE STEEL (IN) 2.00 (LB/FT) 2.42	SQUARE STEEL (IN) 2.50 (LB/FT) 3.35	TUBULAR STEEL Ø (IN) FOUNDATION	TUBULAR STEEL Ø (IN) 3.00 (LB/FT) 7.60	TUBULAR STEEL Ø (IN) 3.50 (LB/FT) 9.00	TUBULAR STEEL Ø (IN) 4.00 (LB/FT) 10.80	TUBULAR STEEL Ø (IN) 5.00 (LB/FT) 14.60	SIGN FRAME REQUIRED	REMARKS	SIGN DETAIL: DETAIL IN SHS	SIGN DETAIL: DETAIL ON SHEET NUMBER	SIGN DETAIL: DETAIL ON STD SHEET NUMBER
CHESTER WB							FY-FLUORESCENT YELLOW FYG-FLUORESCENT YELLOW GREEN																			"SHS"-STANDARD HIGHWAY SIGNS			
WB	2.640	H	R1-1	30	30		STOP	6.25								1		11.75' X								INSTALL RIGHT-SIDE SIGN UP TO 50 FT ± BACK FROM THE INTERSECTING ROUTE 10 EDGELINE	X		
WB	2.550	F	R2-1	24	30		SPEED LIMIT 50	5.00								1		13.0' X								INSTALL 100 FT ± WEST OF THE LEFT-SIDE JCT WITH DAVIDSON HILL RD (TH-81)	X		
WB	2.160	F	W1-2R	30	30			6.25								1		14.5' X								INSTALL 100 FT ± WEST OF THE LEFT-SIDE JCT WITH MINERAL SPRING ROAD (TH-31)	X		
WB	1.860	F	R2-5A	24	30		REDUCED SPEED AHEAD						1		X											NOTE THE LOCATION OF THIS REMOVAL FOR THE NEXT SIGN			
WB	1.815	F	W3-5	36	36		SPEED LIMIT 40	9.00								2		13.5' 15.0' X								INSTALL 240 FT ± WEST OF JUST-REMOVED "REDUCED SPEED AHEAD" SIGN	X		
WB	1.755	F	W5-1	36	36								1		X														
		F	VW-619	36	36		SHOULDER NARROWS	9.00								2		14.25' 14.5' X										5	
WB	1.715	F	R2-1	24	30								1		X														
		F	R2-1	30	36		SPEED LIMIT 40	7.50								1		14.25' X										6	
WB	1.618	F	W1-5R	30	30		WINDING CURVES RIGHT						1		X														
WB	1.595	F	W8-9	30	30		LOW SHOULDER						~~1~~		~~X~~											SIGNS WERE REMOVED PRIOR TO THE PROJECT.			
		F	W16-4	24	18		NEXT 1200 FEET (PLAQUE)						~~1~~		~~X~~														
		F	W1-5R	30	30			6.25								1		14.0' X									X		
WB	1.547	F	R2-1	24	30		SPEED LIMIT 40	5.00								1		13.0' X								INSTALL 75 FT ± IN ADVANCE OF THE EXISTING SPEED LIMIT SIGN	X		
WB	1.532	F	R2-1	24	30		SPEED LIMIT 40						1		X														
							SHEET TOTALS	54.25	0.00	0	0	0	~~5~~ 7	0	0	10		~~137.75~~ 150											
								SF	SF	EA	EA	EA	EA	EA	EA	EA		FT											
							TOWN DIRECTIONAL TOTALS	275.0	0.0	0.0	0.0	0.0	53	0.0	0.0	48		720.0											

SIGN SUMMARY SHEET

VERMONT AGENCY OF TRANSPORTATION

PROJECT NAME: **STATEWIDE SOUTHEAST REGION**
PROJECT NUMBER: **STPG SIGN (31)**

FILE NAME: **CHESTER WESTBOUND** PLOT DATE: **8/13/2010**
PROJECT MANAGER: **A. GAMBLE** DRAWN BY: **M. MILLER**
DESIGNED BY: **M. MILLER** CHECKED BY: **A. GAMBLE**
CHESTER VT-10 WESTBOUND 3 SHEET **108** OF **175**

DIRECTION	MILEPOINT	LOCATION CODE (SHEET 2)	SIGN CODE	WIDTH (IN)	HEIGHT (IN)	SHEETING REMARKS	SIGN LEGEND	NEW SIGNS "A"	NEW SIGNS "B"	EXISTING SIGNS RETAIN	EXISTING SIGNS SALVAGE FROM	EXISTING SIGNS SALVAGE TO	EXISTING SIGNS REMOVE	EXIST POST RETAIN	EXIST POST REMOVE	NUMBER OF NEW POSTS	SQUARE STEEL (IN) (LB / FT) 1.75 / 1.88	SQUARE STEEL (IN) (LB / FT) 2.00 / 2.42	SQUARE STEEL (IN) (LB / FT) 2.50 / 3.35	TUBULAR STEEL Ø (IN) FOUNDATION	TUBULAR STEEL Ø (IN) (LB / FT) 3.00 / 7.60	TUBULAR STEEL Ø (IN) (LB / FT) 3.50 / 9.00	TUBULAR STEEL Ø (IN) (LB / FT) 4.00 / 10.80	TUBULAR STEEL Ø (IN) (LB / FT) 5.00 / 14.60	SIGN FRAME REQUIRED	REMARKS	SIGN DETAIL: DETAIL IN SHS	SIGN DETAIL: DETAIL ON SHEET NUMBER	SIGN DETAIL: DETAIL ON STD SHEET NUMBER
CHESTER WB							FY-FLUORESCENT YELLOW FYG-FLUORESCENT YELLOW GREEN																			"SHS"-STANDARD HIGHWAY SIGNS			
WB	1.305	F	W11-7	30	30		EQUESTRIAN SYMBOL						1		X													
WB	1.205	G	VR-017	24	30		LEGAL LOAD LIMIT 24,000 POUNDS CHANDLER RD TH 32						1		X											CHANDLER RD (TH-20)		
		G	VR-017	24	30			5.00			1	1				1		12.0' X		STREET SIGN WAS SALVAGED AND RE-ERECTED							6
WB	1.200	H	R1-1	30	30		STOP						1		X													
		H	R1-1	30	30			6.25								1		12.75' X									X	
WB	1.097	F	R2-1	24	30		SPEED LIMIT 40						1		X													
		F	R2-1	24	30			5.00								1		10.75' X									X	
WB	0.590	F	R2-1	24	30		SPEED LIMIT 40						1		X													
		F	R2-1	24	30			5.00								1		12.75' X									X	
WB	0.380	F	W1-2L	30	30		LEFT CURVE						1		X													
		F	W13-1	18	18		35 MPH (PLAQUE)						1															
WB	0.280	F	W2-4	36	36		"T" INTERSECTION (SYMBOL)						1		X													
		F	W16-4	24	18		1500 FEET (PLAQUE)						1															
		F	W1-2L	30	30		35 MPH	6.25								1		15.0' X									X	
		F	W13-1	18	18			2.25																			X	
							SHEET TOTALS	29.75 SF	0.00 SF	0 EA	~~0~~ 1 EA	~~0~~ 1 EA	9 EA	0 EA	0 EA	5 EA		~~75~~ 63.25 FT										
							TOWN DIRECTIONAL TOTALS	275.0	0.0	0.0	0.0	0.0	53	0.0	0.0	48		720.0										

SIGN SUMMARY SHEET

VERMONT AGENCY OF TRANSPORTATION

PROJECT NAME: **STATEWIDE SOUTHEAST REGION**
PROJECT NUMBER: **STPG SIGN (31)**

FILE NAME: **CHESTER WESTBOUND**
PROJECT MANAGER: **A. GAMBLE**
DESIGNED BY: **M. MILLER**
CHESTER VT-10 WESTBOUND 4

PLOT DATE: **8/13/2010**
DRAWN BY: **M. MILLER**
CHECKED BY: **A. GAMBLE**

DIRECTION	MILEPOINT	LOCATION CODE (SHEET 2)	SIGN CODE	WIDTH (IN)	HEIGHT (IN)	SHEETING REMARKS	SIGN LEGEND	NEW SIGNS "A"	NEW SIGNS "B"	EXISTING SIGNS RETAIN	EXISTING SIGNS SALVAGE FROM	EXISTING SIGNS SALVAGE TO	EXISTING SIGNS REMOVE	EXIST POST RETAIN	EXIST POST REMOVE	NUMBER OF NEW POSTS	SQUARE STEEL (IN) 1.75 (LB / FT) 1.88	SQUARE STEEL (IN) 2.00 (LB / FT) 2.42	SQUARE STEEL (IN) 2.50 (LB / FT) 3.35	TUBULAR STEEL Ø (IN) FOUNDATION	TUBULAR STEEL Ø (IN) 3.00 (LB / FT) 7.60	TUBULAR STEEL Ø (IN) 3.50 (LB / FT) 9.00	TUBULAR STEEL Ø (IN) 4.00 (LB / FT) 10.80	TUBULAR STEEL Ø (IN) 5.00 (LB / FT) 14.60	SIGN FRAME REQUIRED	REMARKS	SIGN DETAIL: DETAIL IN SHS	SIGN DETAIL: DETAIL ON SHEET NUMBER	SIGN DETAIL: DETAIL ON STD SHEET NUMBER
CHESTER WB							FY-FLUORESCENT YELLOW FYG-FLUORESCENT YELLOW GREEN																			"SHS"-STANDARD HIGHWAY SIGNS			
WB	0.230	F	W1-6	48	24		0100 1407 0020						1		X													
		E	W1-6	48	24								1															
		F	W1-6	48	24		BACK-TO-BACK	8.00								2		12.75' 13.25' X							INSTALLED BACK-TO-BACK ON THE SAME POSTS	X		
		E	W1-6	48	24			8.00																		X		
WB	0.197	F	M2-1	21	15		JCT						1		X			13.25' 13.25'										
		F	M1-5	30	24		VERMONT 103						1															
		F	M4-6	24	12		END						1															
		F	M1-5	24	24		VERMONT 10						1															
WB	0.160	F	M2-1	21	15			2.19								2		13.25' 13.25' X							#1A	GREEN ON WHITE	X		
		F	M1-5	30	24			5.00																			INSTALL ASSEMBLY 200 FT ± WEST OF PREVIOUS POSITION			E-136B
		F	M4-6	24	12			2.00																			GREEN ON WHITE	X		
		F	M1-5	24	24			4.00																						E-136B
WB	0.120	F	W3-1A	36	36		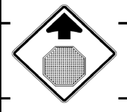	9.00								2		13.0' 13.0' X								INSTALL 200 FT ± WEST OF THE NEW ROUTE MARKER SIGNS JUST-INSTALLED	X		
WB	0.800	F	W3-1A	30	30		STOP AHEAD SYMBOL						1		X													
WB	0.057	F	D1-1A	72	10								1		X													
							SHEET TOTALS	38.19	0.00	0	0	0	8	0	0	6		~~90~~ 78.5										
								SF	SF	EA	EA	EA	EA	EA	EA	EA		FT										
							TOWN DIRECTIONAL TOTALS	275.0	0.0	0.0	0.0	0.0	53	0.0	0.0	48		720.0										

SIGN SUMMARY SHEET

VERMONT AGENCY OF TRANSPORTATION

PROJECT NAME: **STATEWIDE SOUTHEAST REGION**
PROJECT NUMBER: **STPG SIGN (31)**

FILE NAME: **CHESTER WESTBOUND** PLOT DATE: **8/13/2010**
PROJECT MANAGER: **A. GAMBLE** DRAWN BY: **M. MILLER**
DESIGNED BY: **M. MILLER** CHECKED BY: **A. GAMBLE**
CHESTER VT-10 WESTBOUND 5 SHEET **110** OF **175**

DIRECTION	MILEPOINT	LOCATION CODE (SHEET 2)	SIGN CODE	WIDTH (IN)	HEIGHT (IN)	SHEETING REMARKS	SIGN LEGEND	NEW SIGNS "A"	NEW SIGNS "B"	EXISTING SIGNS RETAIN	EXISTING SIGNS SALVAGE FROM	EXISTING SIGNS SALVAGE TO	EXISTING SIGNS REMOVE	EXIST POST RETAIN	EXIST POST REMOVE	NUMBER OF NEW POSTS	SQUARE STEEL (IN) 1.75 (LB / FT) 1.88	SQUARE STEEL (IN) 2.00 (LB / FT) 2.42	SQUARE STEEL (IN) 2.50 (LB / FT) 3.35	TUBULAR STEEL Ø (IN) FOUNDATION	TUBULAR STEEL Ø (IN) 3.00 (LB / FT) 7.60	TUBULAR STEEL Ø (IN) 3.50 (LB / FT) 9.00	TUBULAR STEEL Ø (IN) 4.00 (LB / FT) 10.80	TUBULAR STEEL Ø (IN) 5.00 (LB / FT) 14.60	SIGN FRAME REQUIRED	REMARKS	SIGN DETAIL: DETAIL IN SHS	SIGN DETAIL: DETAIL ON SHEET NUMBER	SIGN DETAIL: DETAIL ON STD SHEET NUMBER
CHESTER WB							FY-FLUORESCENT YELLOW FYG-FLUORESCENT YELLOW GREEN																			"SHS"-STANDARD HIGHWAY SIGNS			
WB	0.057	F	D1-1A	72	10								1															
		F	D1-1A	72	10								1															
		F	D1-1A	72	10								1															
		F	D1-1A	72	12		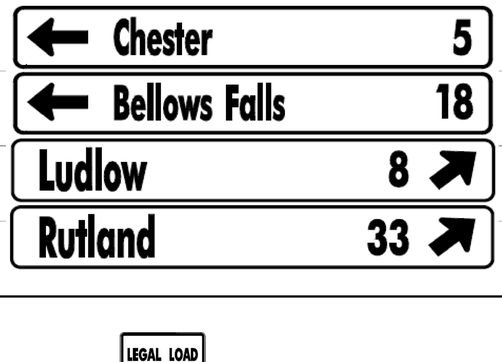	6.00								2	14.25' 15.75' X									4	
		F	D1-1A	72	12			6.00																				4	
		F	D1-1A	72	12			6.00																				4	
		F	D1-1A	72	12			6.00																				4	
WB	0.037	G	VR-017	24	30								1		X												CLEMONS ROAD (TH-21)			
		G	VR-017	24	30			5.00								1	13.0' X											6	
WB	0.031	H	R1-1	30	30		0100 1407 0004						1		X															
		H	R1-1	30	30			6.25								1	12.75' X											X	
WB	0.025	F	M3-3	24	12								1		X														
		F	M1-5	30	24								1																
		F	M6-1	21	15		(6) SIGN ROUTE MARKER ASSEMBLY						1																	
		F	M3-1	24	12								1																
							SHEET TOTALS	35.25	0.00	0	0	0	9	0	0	4	55.75 ~~60~~												
								SF	SF	EA	EA	EA	EA	EA	EA	EA	FT												
							TOWN DIRECTIONAL TOTALS	275.0	0.0	0.0	0.0	0.0	53	0.0	0.0	48	720.0												

SIGN SUMMARY SHEET

VERMONT AGENCY OF TRANSPORTATION

PROJECT NAME: STATEWIDE SOUTHEAST REGION
PROJECT NUMBER: STPG SIGN (31)

FILE NAME: CHESTER WESTBOUND
PROJECT MANAGER: A. GAMBLE
DESIGNED BY: M. MILLER
CHESTER VT-10 WESTBOUND 6

PLOT DATE: 8/13/2010
DRAWN BY: M. MILLER
CHECKED BY: A. GAMBLE
SHEET 111 OF 175

DIRECTION	MILEPOINT	LOCATION CODE (SHEET 2)	SIGN CODE	WIDTH (IN)	HEIGHT (IN)	SHEETING REMARKS	SIGN LEGEND	NEW SIGNS "A"	NEW SIGNS "B"	EXISTING SIGNS RETAIN	EXISTING SIGNS SALVAGE FROM	EXISTING SIGNS SALVAGE TO	EXISTING SIGNS REMOVE	EXIST POST RETAIN	EXIST POST REMOVE	NUMBER OF NEW POSTS	SQUARE STEEL (IN) 1.75 (LB / FT) 1.88	SQUARE STEEL (IN) 2.00 (LB / FT) 2.42	SQUARE STEEL (IN) 2.50 (LB / FT) 3.35	TUBULAR STEEL Ø (IN) FOUNDATION	TUBULAR STEEL Ø (IN) 3.00 (LB / FT) 7.60	TUBULAR STEEL Ø (IN) 3.50 (LB / FT) 9.00	TUBULAR STEEL Ø (IN) 4.00 (LB / FT) 10.80	TUBULAR STEEL Ø (IN) 5.00 (LB / FT) 14.60	SIGN FRAME REQUIRED	REMARKS	SIGN DETAIL: DETAIL IN SHS	SIGN DETAIL: DETAIL ON SHEET NUMBER	SIGN DETAIL: DETAIL ON STD SHEET NUMBER
CHESTER WB							FY-FLUORESCENT YELLOW FYG-FLUORESCENT YELLOW GREEN																			"SHS"-STANDARD HIGHWAY SIGNS			
WB	0.025	F	M1-5	30	24								1																
		F	M6-2R	21	15								1																
		F	M3-3	24	12		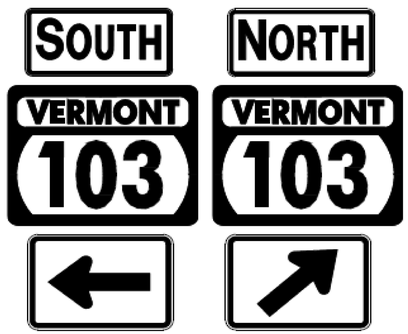	2.00								2		14.5' 15.0' X						#1B	GREEN ON WHITE	X		
		F	M1-5	30	24			5.00																					E-136B
		F	M6-1	21	15			2.19																			GREEN ON WHITE	X		
		F	M3-1	24	12			2.00																			GREEN ON WHITE	X		
		F	M1-5	30	24			5.00																					E-136B
		F	M6-2R	21	15			2.19																			GREEN ON WHITE	X		
WB	0.010	F	OM1-1	18	18								1		X														
		F	OM1-1	18	18			2.25								1	9.0' X										INSTALLED IN THE GORE BETWEEN THE TWO APPROACHES TO VT-103	X		
~~WB~~ ~~EB~~	0.002	D	R1-1	36	36								1		X														
		D	R1-1	36	36		1030 1407 0778 STOP 0100 1407 0000	9.00								2		13.25' 13.25' X										X		
~~WB~~ ~~EB~~	0.002	D	R1-2	30	30								1		X															
		D	R1-2	36	36			3.89								1		12.5' X									ON THE SLIP-LANE APPROACH TO NB VT 103	X		
WB	3.425	F	R2-1	24	30		NEW SPEED LIMIT 50 WEST REMOVE 10 REMOVE	5.00					2														THIS NEW SIGN WAS INSTALLED FOR WB MOTORISTS. SEE SHEET #106	RETAIN POST		
							SHEET TOTALS	~~38.52~~ 33.52 SF	0.00 SF	0 EA	0 EA	0 EA	~~7~~ 5 EA	0 EA	0 EA	6 EA			~~77.5~~ 90 FT							
							TOWN DIRECTIONAL TOTALS	275.0	0.0	0.0	0.0	0.0	53	0.0	0.0	48			720.0											

SIGN SUMMARY SHEET

VERMONT AGENCY OF TRANSPORTATION

PROJECT NAME: **STATEWIDE SOUTHEAST REGION**
PROJECT NUMBER: **STPG SIGN (31)**

FILE NAME: **CHESTER WESTBOUND** PLOT DATE: **8/13/2010**
PROJECT MANAGER: **A. GAMBLE** DRAWN BY: **M. MILLER**
DESIGNED BY: **M. MILLER** CHECKED BY: **A. GAMBLE**
CHESTER VT-10 WESTBOUND 7 SHEET **112** OF **175**

DIRECTION	MILEPOINT	LOCATION CODE (SHEET 2)	SIGN CODE	WIDTH (IN)	HEIGHT (IN)	SHEETING REMARKS	SIGN LEGEND	NEW SIGNS "A"	NEW SIGNS "B"	EXISTING SIGNS RETAIN	EXISTING SIGNS SALVAGE FROM	EXISTING SIGNS SALVAGE TO	EXISTING SIGNS REMOVE	EXIST POST RETAIN	EXIST POST REMOVE	NUMBER OF NEW POSTS	SQUARE STEEL (IN) 1.75 (LB / FT) 1.88	SQUARE STEEL (IN) 2.00 (LB / FT) 2.42	SQUARE STEEL (IN) 2.50 (LB / FT) 3.35	TUBULAR STEEL Ø (IN) FOUNDATION	TUBULAR STEEL Ø (IN) 3.00 (LB / FT) 7.60	TUBULAR STEEL Ø (IN) 3.50 (LB / FT) 9.00	TUBULAR STEEL Ø (IN) 4.00 (LB / FT) 10.80	TUBULAR STEEL Ø (IN) 5.00 (LB / FT) 14.60	SIGN FRAME REQUIRED	REMARKS	SIGN DETAIL LOCATION SHSM	SIGN DETAIL LOCATION PROJECT SHEET #	SIGN DETAIL LOCATION STANDARD SHEET #
CHESTER WB							FY-FLUORESCENT YELLOW FYG-FLUORESCENT YELLOW GREEN																				"SHSM"-STANDARD HIGHWAY SIGNS AND MARKINGS			
WB	2.870	F	W1-6	48	24			8.00					1		X	2		12.0' 12.0' X								SEE NOTE ON SHEET 107			
WB	2.865	E	W1-6	48	24			8.00					1		X	2		12.0' 12.0' X											
WB	2.840	F	W1-6	48	24						1	1	1		X	2		12.0' 12.0' X								THESE SIGNS WERE NOT DAMAGED, BUT THE POSTS WERE DAMAGED AND REPLACED. PAY FOR REMOVAL WORK.			
WB	2.839	E	W1-6	48	24						1	1	1		X	2		12.0' 12.0' X											

DIRECTION	MILEPOINT	LOCATION CODE (SHEET 2)	SIGN CODE	WIDTH (IN)	HEIGHT (IN)	SHEETING REMARKS	SIGN LEGEND	NEW SIGNS "A"	NEW SIGNS "B"	EXISTING SIGNS RETAIN	EXISTING SIGNS SALVAGE FROM	EXISTING SIGNS SALVAGE TO	EXISTING SIGNS REMOVE	EXIST POST RETAIN	EXIST POST REMOVE	NUMBER OF NEW POSTS	SQUARE STEEL (IN) 1.75 (LB / FT) 1.88	SQUARE STEEL (IN) 2.00 (LB / FT) 2.42	SQUARE STEEL (IN) 2.50 (LB / FT) 3.35	TUBULAR STEEL Ø (IN) FOUNDATION	TUBULAR STEEL Ø (IN) 3.00 (LB / FT) 7.60	TUBULAR STEEL Ø (IN) 3.50 (LB / FT) 9.00	TUBULAR STEEL Ø (IN) 4.00 (LB / FT) 10.80	TUBULAR STEEL Ø (IN) 5.00 (LB / FT) 14.60	SIGN FRAME REQUIRED	REMARKS	SIGN DETAIL: DETAIL IN SHS	SIGN DETAIL: DETAIL ON SHEET NUMBER	SIGN DETAIL: DETAIL ON STD SHEET NUMBER
SPRINGFIELD EB							FY-FLUORESCENT YELLOW FYG-FLUORESCENT YELLOW GREEN																			"SHS"-STANDARD HIGHWAY SIGNS			
EB	0.000	C	VD-024	60	7.5								1		X														
		C	VD-700	6	8								1																
		C	VD-700	6	8								1																
		C	VD-024	72	10		Springfield / Chester	5.00								2		14.0' 14.0' X								TOWN LINE SIGN ON TOP; CENTER AND INSTALL THE ASSEMBLY IN THE SAME POSITION AS THE REMOVAL		4	
		C	VD-700	6	10		0100 1418 0000 / 0100 1407 0354	0.42																		INSTALL ON THE LEFT-SIDE POST UNDER "SPRINGFIELD"		4	
		C	VD-700	6	10			0.42																		INSTALL ON THE RIGHT-SIDE POST UNDER "CHESTER"		4	
EB	0.005	A	unknown	24	30		SPEED LIMIT 25 WITHIN SPRINGFIELD...						1		X											REMOVE ALL; THESE ARE ILLEGALLY INSTALLED WITHIN THE STATE HIGHWAY R.O.W.			
		A	unknown	24	30		NO OVERNIGHT PARKING...						1																
EB	0.020	A	unknown	24	12		NO TRUCKS						1		X											REMOVE; NOT A LEGAL SIGN			
EB	0.030	A	M3-2	24	12		EAST						1		X														
		A	M1-6	24	24		ROUTE 10 (BLACK & WHITE)						1																
		A	M6-2	21	15		ARROW 45 DEG LEFT (BLACK & WHITE)						1																
		A	M3-2	24	12		EAST	2.00								1		15.0' X								GREEN ON WHITE	X		
		A	M1-5	24	24		VERMONT 10	4.00																					E-136B
		A	M6-2L	21	15			2.19																		GREEN ON WHITE	X		
							SHEET TOTALS	14.03	0.00	0	0	0	9	0	0	3		43.0 ~~45~~										
								SF	SF	EA	EA	EA	EA	EA	EA	EA		FT										
							TOWN DIRECTIONAL TOTALS	146.7	0.0	7.0	0.0	0.0	35	0.0	0.0	22		330.0										

SIGN SUMMARY SHEET

VERMONT AGENCY OF TRANSPORTATION

PROJECT NAME: **STATEWIDE SOUTHEAST REGION**
PROJECT NUMBER: **STPG SIGN (31)**

FILE NAME: **SPRINGFIELD EASTBOUND** PLOT DATE: **8/13/2010**
PROJECT MANAGER: **A. GAMBLE** DRAWN BY: **M. MILLER**
DESIGNED BY: **M. MILLER** CHECKED BY: **A. GAMBLE**
SPRINGFIELD VT-10 EASTBOUND 1 SHEET **113** OF **175**

DIRECTION	MILEPOINT	LOCATION CODE (SHEET 2)	SIGN CODE	WIDTH (IN)	HEIGHT (IN)	SHEETING REMARKS	SIGN LEGEND	NEW SIGNS "A"	NEW SIGNS "B"	EXISTING SIGNS RETAIN	EXISTING SIGNS SALVAGE FROM	EXISTING SIGNS SALVAGE TO	EXISTING SIGNS REMOVE	EXIST POST RETAIN	EXIST POST REMOVE	NUMBER OF NEW POSTS	SQUARE STEEL (IN) 1.75 (LB / FT) 1.88	SQUARE STEEL (IN) 2.00 (LB / FT) 2.42	SQUARE STEEL (IN) 2.50 (LB / FT) 3.35	TUBULAR STEEL Ø (IN) FOUNDATION	TUBULAR STEEL Ø (IN) 3.00 (LB / FT) 7.60	TUBULAR STEEL Ø (IN) 3.50 (LB / FT) 9.00	TUBULAR STEEL Ø (IN) 4.00 (LB / FT) 10.80	TUBULAR STEEL Ø (IN) 5.00 (LB / FT) 14.60	SIGN FRAME REQUIRED	REMARKS	SIGN DETAIL: DETAIL IN SHS	SIGN DETAIL: DETAIL ON SHEET NUMBER	SIGN DETAIL: DETAIL ON STD SHEET NUMBER
SPRINGFIELD EB							FY-FLUORESCENT YELLOW FYG-FLUORESCENT YELLOW GREEN																			"SHS"-STANDARD HIGHWAY SIGNS			
EB	0.035	A	VR-079	30	24		LEGAL LOAD AS FOR STATE HIGHWAY						1		X											MAIN STREET NS (TH-6)			
		A	unknown	30	24		LEGAL LOAD AS FOR STATE HIGHWAYS BUSINESS DISTRICT						1																
		A	VR-079	24	30			5.00								1		12.5' X										6	
EB	0.060	D	R1-1	30	30		STOP						1		X											LEFT-SIDE STOP SIGN FACING THE ENTRANCE TO VT-10 FROM TH-6			
EB	0.065	C	unknown	24	18		LEGAL LOAD AS FOR STATE HIGHWAYS NO TRUCKS						1													NOT A LEGAL SIGN			
		C	VR-079	24	30			5.00								1		14.5' X										6	
EB	0.078	D	R1-1	30	30		STOP						1		X											MAIN STREET NS (TH-6)			
		C	VR-079	24	24		STOP LEGAL LOAD AS FOR STATE HIGHWAY 0140 1418 0007						1													EXISTING SIGNS INSTALLED BACK-TO-BACK; REMOVE ALL			
		D	R1-1	36	36			9.00								2		12.5' 12.5' X								INSTALL ON TWO POSTS	X		
EB	0.100	A	M3-2	24	12		EAST VERMONT 10	2.00								1		14.0' X								**GREEN ON WHITE**	X		
		A	M1-5	24	24			4.00																		INSTALL ASSEMBLY 115 FT ± EAST OF THE JUCTION WITH TH-6			E-136B
EB	0.140	A	R2-1	24	30		SPEED LIMIT 50	5.00								1		13.0' X								INSTALL THIS NEW SIGN 200 FT ± EAST OF THE NEW "EAST VT-10" ROUTE MARKER ASSEMBLY	X		
EB	0.420	A	VD-062AS	72	16		BUSINESS DIRECTORY SIGN			1				X												NO. SPRINGFIELD ===>			
EB	0.460	A	VD-062B	72	16		BUSINESS DIRECTORY SIGN			1				X												SPRINGFIELD CO-OP ^UP			
		A	VD-062AL	72	16		BUSINESS DIRECTORY SIGN			1																CVPS SERVICE CTR. ===>			
							SHEET TOTALS	30.00	0.00	3	0	0	6	0	0	6		79.0 ~~90~~											
								SF	SF	EA	EA	EA	EA	EA	EA	EA		FT											
							TOWN DIRECTIONAL TOTALS	146.7	0.0	7.0	0.0	0.0	35	0.0	0.0	22		330.0											

SIGN SUMMARY SHEET

VERMONT AGENCY OF TRANSPORTATION

PROJECT NAME: **STATEWIDE SOUTHEAST REGION**
PROJECT NUMBER: **STPG SIGN (31)**

FILE NAME: **SPRINGFIELD EASTBOUND**
PROJECT MANAGER: **A. GAMBLE**
DESIGNED BY: **M. MILLER**
SPRINGFIELD VT-10 EASTBOUND 2

PLOT DATE: **8/13/2010**
DRAWN BY: **M. MILLER**
CHECKED BY: **A. GAMBLE**
SHEET **114** OF **175**

DIRECTION	MILEPOINT	LOCATION CODE (SHEET 2)	SIGN CODE	WIDTH (IN)	HEIGHT (IN)	SHEETING REMARKS	SIGN LEGEND	NEW SIGNS "A"	NEW SIGNS "B"	EXISTING SIGNS RETAIN	EXISTING SIGNS SALVAGE FROM	EXISTING SIGNS SALVAGE TO	EXISTING SIGNS REMOVE	EXIST POST RETAIN	EXIST POST REMOVE	NUMBER OF NEW POSTS	SQUARE STEEL (IN) 1.75 (LB / FT) 1.88	SQUARE STEEL (IN) 2.00 (LB / FT) 2.42	SQUARE STEEL (IN) 2.50 (LB / FT) 3.35	TUBULAR STEEL Ø (IN) FOUNDATION	TUBULAR STEEL Ø (IN) 3.00 (LB / FT) 7.60	TUBULAR STEEL Ø (IN) 3.50 (LB / FT) 9.00	TUBULAR STEEL Ø (IN) 4.00 (LB / FT) 10.80	TUBULAR STEEL Ø (IN) 5.00 (LB / FT) 14.60	SIGN FRAME REQUIRED	REMARKS	SIGN DETAIL: DETAIL IN SHS	SIGN DETAIL: DETAIL ON SHEET NUMBER	SIGN DETAIL: DETAIL ON STD SHEET NUMBER
SPRINGFIELD EB							FY-FLUORESCENT YELLOW FYG-FLUORESCENT YELLOW GREEN																			"SHS"-STANDARD HIGHWAY SIGNS			
		~~A~~	~~VD-062AL~~	~~72~~	~~16~~		~~BUSINESS DIRECTORY SIGN~~			~~1~~																~~COGER'S SUGAR <===~~			
EB	0.555	A	W2-1	30	30			6.25								1		14.25' X								INSTALL 300 FT ± IN ADVANCE OF THE NEXT SET OF (3) BUSINESS SIGNS	X		
EB	0.620	A	VD-062B	72	16		BUSINESS DIRECTORY SIGN			1				X												VERMONT TIMBER ===>			
		A	VD-062B	72	16		BUSINESS DIRECTORY SIGN			1																HANCOR DRAINAGE ===>			
		A	VD-062AS	72	16		BUSINESS DIRECTORY SIGN			1																HOLIDAY INN ^UP			
EB	0.665	C	VR-079	24	30			5.00								1		12.5' X								COUNTY ROAD (TH-712)		6	
EB	0.675	D	R1-1	30	30		STOP (BACK-TO-BACK WITH)						1		X														
		C	VR-079	24	24		LEGAL LOAD AS FOR STATE HIGHWAY						1															
		D	R1-1	30	30			6.25								1		13.0' X									X		
EB	0.700	A	M4-6	24	12		END						1		X														
		A	M1-5	24	24		VT 10						1																
		A	M2-1	21	15		JCT						1																
		A	M1-5	30	24		VT 106						1																
		A	M4-6	24	12			2.00								2		14.75' 14.0' X								#1A GREEN ON WHITE	X		
		A	M1-5	24	24			4.00																					E-136B
							SHEET TOTALS	23.50	0.00	4	0	0	6	0	0	5		~~68.5~~ ~~75~~										
								SF	SF	EA	EA	EA	EA	EA	EA	EA		FT										
							TOWN DIRECTIONAL TOTALS	146.7	0.0	7.0	0.0	0.0	35	0.0	0.0	22		330.0										

SIGN SUMMARY SHEET

VERMONT AGENCY OF TRANSPORTATION

PROJECT NAME: **STATEWIDE SOUTHEAST REGION**
PROJECT NUMBER: **STPG SIGN (31)**

FILE NAME: **SPRINGFIELD EASTBOUND** PLOT DATE: **8/13/2010**
PROJECT MANAGER: **A. GAMBLE** DRAWN BY: **M. MILLER**
DESIGNED BY: **M. MILLER** CHECKED BY: **A. GAMBLE**
SPRINGFIELD VT-10 EASTBOUND 3 SHEET **115** OF **175**

DIRECTION	MILEPOINT	LOCATION CODE (SHEET 2)	SIGN CODE	WIDTH (IN)	HEIGHT (IN)	SHEETING REMARKS	SIGN LEGEND	NEW SIGNS "A"	NEW SIGNS "B"	EXISTING SIGNS RETAIN	EXISTING SIGNS SALVAGE FROM	EXISTING SIGNS SALVAGE TO	EXISTING SIGNS REMOVE	EXIST POST RETAIN	EXIST POST REMOVE	NUMBER OF NEW POSTS	SQUARE STEEL (IN) 1.75 (LB / FT) 1.88	SQUARE STEEL (IN) 2.00 (LB / FT) 2.42	SQUARE STEEL (IN) 2.50 (LB / FT) 3.35	TUBULAR STEEL Ø (IN) FOUNDATION	TUBULAR STEEL Ø (IN) 3.00 (LB / FT) 7.60	TUBULAR STEEL Ø (IN) 3.50 (LB / FT) 9.00	TUBULAR STEEL Ø (IN) 4.00 (LB / FT) 10.80	TUBULAR STEEL Ø (IN) 5.00 (LB / FT) 14.60	SIGN FRAME REQUIRED	REMARKS	SIGN DETAIL: DETAIL IN SHS	SIGN DETAIL: DETAIL ON SHEET NUMBER	SIGN DETAIL: DETAIL ON STD SHEET NUMBER
SPRINGFIELD EB							FY-FLUORESCENT YELLOW FYG-FLUORESCENT YELLOW GREEN																			"SHS"-STANDARD HIGHWAY SIGNS			
		A	M2-1	21	15			2.19																GREEN ON WHITE	X		
		A	M1-5	30	24			5.00																				E-136B
EB	0.750	C	VR-017	24	30			5.00								1		13.0' X								CEMETERY ROAD (TH-722)		6	
EB	0.765	D	R1-1	24	24		STOP (BACK-TO-BACK WITH)						1		X													
		C	VR-017	24	24		LEGAL LOAD LIMIT 24000 POUNDS						1													
		D	R1-1	30	30			6.25								1		13.0' X									X		
EB	0.770	A	M3-1	24	12		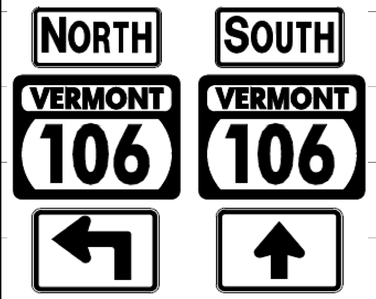	2.00								2		15.0' 14.5' X							#2B	GREEN ON WHITE	X		
		A	M1-5	30	24			5.00																		INSTALL ASSEMBLY 50 FT ± EAST OF JCT WITH CEMETERY ROAD (TH-722)			E-136B
		A	M5-1L	21	15			2.19																		GREEN ON WHITE	X		
		A	M3-3	24	12			2.00																		GREEN ON WHITE	X		
		A	M1-5	30	24			5.00																					E-136B
		A	M6-3	21	15			2.19																		GREEN ON WHITE	X		
EB	0.790	A	D1-1A	72	10		^UP SPRINGFIELD 4						1		X													
		A	D1-1A	72	10		<--- PERKINSVILLE 3						1															
		A	D1-1A	72	10		<--- WOODSTOCK 23						1															
SIGN SUMMARY SHEET							SHEET TOTALS	36.82	0.00	0	0	0	5	0	0	4		55.5 ~~60~~										
								SF	SF	EA	EA	EA	EA	EA	EA	EA		FT										
VERMONT AGENCY OF TRANSPORTATION							TOWN DIRECTIONAL TOTALS	146.7	0.0	7.0	0.0	0.0	35	0.0	0.0	22		330.0										

PROJECT NAME: **STATEWIDE SOUTHEAST REGION**
PROJECT NUMBER: **STPG SIGN (31)**

FILE NAME: **SPRINGFIELD EASTBOUND** PLOT DATE: **8/13/2010**
PROJECT MANAGER: **A. GAMBLE** DRAWN BY: **M. MILLER**
DESIGNED BY: **M. MILLER** CHECKED BY: **A. GAMBLE**
SPRINGFIELD VT-10 EASTBOUND 4 SHEET **116** OF **175**

DIRECTION	MILEPOINT	LOCATION CODE (SHEET 2)	SIGN CODE	WIDTH (IN)	HEIGHT (IN)	SHEETING REMARKS	SIGN LEGEND	NEW SIGNS "A"	NEW SIGNS "B"	EXISTING SIGNS RETAIN	EXISTING SIGNS SALVAGE FROM	EXISTING SIGNS SALVAGE TO	EXISTING SIGNS REMOVE	EXIST POST RETAIN	EXIST POST REMOVE	NUMBER OF NEW POSTS	SQUARE STEEL (IN) 1.75 (LB / FT) 1.88	SQUARE STEEL (IN) 2.00 (LB / FT) 2.42	SQUARE STEEL (IN) 2.50 (LB / FT) 3.35	TUBULAR STEEL Ø (IN) FOUNDATION	TUBULAR STEEL Ø (IN) 3.00 (LB / FT) 7.60	TUBULAR STEEL Ø (IN) 3.50 (LB / FT) 9.00	TUBULAR STEEL Ø (IN) 4.00 (LB / FT) 10.80	TUBULAR STEEL Ø (IN) 5.00 (LB / FT) 14.60	SIGN FRAME REQUIRED	REMARKS	SIGN DETAIL: DETAIL IN SHS	SIGN DETAIL: DETAIL ON SHEET NUMBER	SIGN DETAIL: DETAIL ON STD SHEET NUMBER
SPRINGFIELD EB							FY-FLUORESCENT YELLOW FYG-FLUORESCENT YELLOW GREEN																			"SHS"-STANDARD HIGHWAY SIGNS			
		A	VD-502	54	7.5		<--- AIRPORT						1																
		A	D9-2	24	24		HOSPITAL						1													HOSPITAL REFERENCE WILL NOT BE REPLACED			
		A	D9-2A	21	15		^UP ARROW						1																
EB	0.800	A	D1-1A	72	12		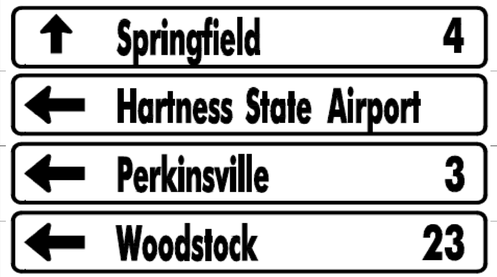	6.00								2		15.0' 16.0' X							INSTALL ASSEMBLY 50 FT ± EAST OF PREVIOUS LOCATION		4	
		A	D1-1A	72	12			6.00																				4	
		A	D1-1A	72	12			6.00																				4	
		A	D1-1A	72	12			6.00																				4	
EB	0.833	A	M3-1	24	12								1		X														
		A	M1-5	30	24								1																
		A	M6-1	21	15		(6) SIGN ROUTE MARKER ASSEMBLY						1																
		A	M3-3	24	12								1																
		A	M1-5	30	24								1																
		A	M6-3	21	15								1																
		A	M3-1	24	12			2.00								2		14.0' 14.5' X							#2B	GREEN ON WHITE	X		
		A	M1-5	30	24			5.00																					E-136B
SIGN SUMMARY SHEET							SHEET TOTALS	31.00	0.00	0	0	0	9	0	0	4		59.5 ~~60~~										
								SF	SF	EA	EA	EA	EA	EA	EA	EA		FT										
VERMONT AGENCY OF TRANSPORTATION							TOWN DIRECTIONAL TOTALS	146.7	0.0	7.0	0.0	0.0	35	0.0	0.0	22		330.0										

PROJECT NAME: **STATEWIDE SOUTHEAST REGION**
PROJECT NUMBER: **STPG SIGN (31)**

FILE NAME: **SPRINGFIELD EASTBOUND** PLOT DATE: **8/13/2010**
PROJECT MANAGER: **A. GAMBLE** DRAWN BY: **M. MILLER**
DESIGNED BY: **M. MILLER** CHECKED BY: **A. GAMBLE**
SPRINGFIELD VT-10 EASTBOUND 5 SHEET **117** OF **175**

DIRECTION	MILEPOINT	LOCATION CODE (SHEET 2)	SIGN CODE	WIDTH (IN)	HEIGHT (IN)	SHEETING REMARKS	SIGN LEGEND	NEW SIGNS "A"	NEW SIGNS "B"	EXISTING SIGNS RETAIN	EXISTING SIGNS SALVAGE FROM	EXISTING SIGNS SALVAGE TO	EXISTING SIGNS REMOVE	EXIST POST RETAIN	EXIST POST REMOVE	NUMBER OF NEW POSTS	SQUARE STEEL (IN) 1.75 (LB / FT) 1.88	SQUARE STEEL (IN) 2.00 (LB / FT) 2.42	SQUARE STEEL (IN) 2.50 (LB / FT) 3.35	TUBULAR STEEL Ø (IN) FOUNDATION	TUBULAR STEEL Ø (IN) 3.00 (LB / FT) 7.60	TUBULAR STEEL Ø (IN) 3.50 (LB / FT) 9.00	TUBULAR STEEL Ø (IN) 4.00 (LB / FT) 10.80	TUBULAR STEEL Ø (IN) 5.00 (LB / FT) 14.60	SIGN FRAME REQUIRED	REMARKS	SIGN DETAIL: DETAIL IN SHS	SIGN DETAIL: DETAIL ON SHEET NUMBER	SIGN DETAIL: DETAIL ON STD SHEET NUMBER
SPRINGFIELD EB							FY-FLUORESCENT YELLOW FYG-FLUORESCENT YELLOW GREEN																			"SHS"-STANDARD HIGHWAY SIGNS			
		A	M6-1	21	15		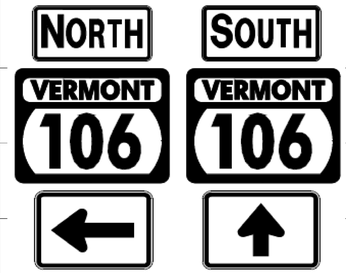	2.19																		GREEN ON WHITE	X		
		A	M3-3	24	12			2.00																		GREEN ON WHITE	X		
		A	M1-5	30	24			5.00																					E-136B
		A	M6-3	21	15			2.19										15.0' 16.0'								GREEN ON WHITE	X		
																		14.0' 14.5'											
SIGN SUMMARY SHEET							SHEET TOTALS	11.38	0.00	0	0	0	0	0	0	0		59.5 ~~0~~											
VERMONT AGENCY OF TRANSPORTATION								SF	SF	EA	EA	EA	EA	EA	EA	EA		FT											
							TOWN DIRECTIONAL TOTALS	146.7	0.0	7.0	0.0	0.0	35	0.0	0.0	22		330.0											

PROJECT NAME: STATEWIDE SOUTHEAST REGION
PROJECT NUMBER: STPG SIGN (31)

FILE NAME: SPRINGFIELD EASTBOUND
PROJECT MANAGER: A. GAMBLE
DESIGNED BY: M. MILLER
SPRINGFIELD VT-10 EASTBOUND 6

PLOT DATE: 8/13/2010
DRAWN BY: M. MILLER
CHECKED BY: A. GAMBLE
SHEET 118 OF 175

DIRECTION	MILEPOINT	LOCATION CODE (SHEET 2)	SIGN CODE	WIDTH (IN)	HEIGHT (IN)	SHEETING REMARKS	SIGN LEGEND	NEW SIGNS "A"	NEW SIGNS "B"	EXISTING SIGNS RETAIN	EXISTING SIGNS SALVAGE FROM	EXISTING SIGNS SALVAGE TO	EXISTING SIGNS REMOVE	EXIST POST RETAIN	EXIST POST REMOVE	NUMBER OF NEW POSTS	SQUARE STEEL (IN) 1.75 (LB / FT) 1.88	SQUARE STEEL (IN) 2.00 (LB / FT) 2.42	SQUARE STEEL (IN) 2.50 (LB / FT) 3.35	TUBULAR STEEL Ø (IN) FOUNDATION	TUBULAR STEEL Ø (IN) 3.00 (LB / FT) 7.60	TUBULAR STEEL Ø (IN) 3.50 (LB / FT) 9.00	TUBULAR STEEL Ø (IN) 4.00 (LB / FT) 10.80	TUBULAR STEEL Ø (IN) 5.00 (LB / FT) 14.60	SIGN FRAME REQUIRED	REMARKS	SIGN DETAIL: DETAIL IN SHS	SIGN DETAIL: DETAIL ON SHEET NUMBER	SIGN DETAIL: DETAIL ON STD SHEET NUMBER
SPRINGFIELD WB							FY-FLUORESCENT YELLOW FYG-FLUORESCENT YELLOW GREEN																			"SHS"-STANDARD HIGHWAY SIGNS			
WB	0.776	F	M3-4	24	12								1		X													
		F	M1-5	24	24		WEST						1															
		F	M3-4	24	12		VERMONT 10	2.00								1		14.0' X								GREEN ON WHITE	X	
		F	M1-5	24	24		LEGAL LOAD LIMIT 24,000 POUNDS	4.00																				E-136B
WB	0.754	G	VR-017	24	30			5.00								1		13.0' X								COUNTY ROAD (TH-718)		6	
WB	0.746	H	R1-1	24	24		STOP (BACK-TO-BACK WITH)						1		X													
		G	VR-017	24	24		STOP LEGAL LOAD LIMIT 24000 POUNDS						1															
		H	R1-1	30	30		0100 1418 0075	6.25								1		13.0' X									X	
WB	0.738	F	W2-1	30	30								1		X													
		F	W2-1	30	30			6.25								1		15.0' X									X	
WB	0.700	F	VD-062B	72	16		BUSINESS DIRECTORY SIGN			1				X												IVEK CORPORATION <===		
		F	VD-062B	72	16		BUSINESS DIRECTORY SIGN			1																SPRINGFIELD PRINTING <===		
		F	VD-062B	72	16		BUSINESS DIRECTORY SIGN			1																VERMONT TIMBER <===		
WB	0.670	G	M4-5	24	12		TO (BLACK ON WHITE)						1		X													
		G	M1-6	24	24		ROUTE 106 (BLACK ON WHITE)						1															
							SHEET TOTALS	23.50 SF	0.00 SF	3 EA	0 EA	0 EA	7 EA	0 EA	0 EA	4 EA		55.0 ~~60~~ FT										
							TOWN DIRECTIONAL TOTALS	66.9	0.0	3.0	0.0	0.0	13	0.0	0.0	11		165.0										

SIGN SUMMARY SHEET

VERMONT AGENCY OF TRANSPORTATION

PROJECT NAME: **STATEWIDE SOUTHEAST REGION**
PROJECT NUMBER: **STPG SIGN (31)**

FILE NAME: **SPRINGFIELD WESTBOUND** PLOT DATE: **8/13/2010**
PROJECT MANAGER: **A. GAMBLE** DRAWN BY: **M. MILLER**
DESIGNED BY: **M. MILLER** CHECKED BY: **A. GAMBLE**
SPRINGFIELD VT-10 WESTBOUND 1 SHEET **119** OF **175**

DIRECTION	MILEPOINT	LOCATION CODE (SHEET 2)	SIGN CODE	WIDTH (IN)	HEIGHT (IN)	SHEETING REMARKS	SIGN LEGEND	NEW SIGNS "A"	NEW SIGNS "B"	EXISTING SIGNS RETAIN	EXISTING SIGNS SALVAGE FROM	EXISTING SIGNS SALVAGE TO	EXISTING SIGNS REMOVE	EXIST POST RETAIN	EXIST POST REMOVE	NUMBER OF NEW POSTS	SQUARE STEEL (IN) 1.75 (LB / FT) 1.88	SQUARE STEEL (IN) 2.00 (LB / FT) 2.42	SQUARE STEEL (IN) 2.50 (LB / FT) 3.35	TUBULAR STEEL Ø (IN) FOUNDATION	TUBULAR STEEL Ø (IN) 3.00 (LB / FT) 7.60	TUBULAR STEEL Ø (IN) 3.50 (LB / FT) 9.00	TUBULAR STEEL Ø (IN) 4.00 (LB / FT) 10.80	TUBULAR STEEL Ø (IN) 5.00 (LB / FT) 14.60	SIGN FRAME REQUIRED	REMARKS	SIGN DETAIL: DETAIL IN SHS	SIGN DETAIL: DETAIL ON SHEET NUMBER	SIGN DETAIL: DETAIL ON STD SHEET NUMBER
SPRINGFIELD WB							FY-FLUORESCENT YELLOW FYG-FLUORESCENT YELLOW GREEN																			"SHS"-STANDARD HIGHWAY SIGNS			
		G	M6-1	21	15		RIGHT ARROW (BLACK ON WHITE)		1																			
		G	M4-5	24	12		TO VERMONT 106	2.00								1		15.25' X								GREEN ON WHITE	X	
		G	M1-5	~~24~~ 30	24			5.00																		SIGN ASSEMBLY IS PARALLEL TO VT 10 WESTBOUND, FACING COUNTY ROAD (TH-712) ON THE LEFT			E-136B
		G	M6-1	21	15		0100 1418 0067	2.19																		GREEN ON WHITE	X	
WB	0.664	G	VR-017	24	24		LEGAL LOAD LIMIT 24,000 POUNDS						~~1~~		~~X~~						SIGN AND POST WERE MISSING					BALTIMORE ROAD (TH-8)			
		G	VR-017	24	30			5.00								1		12.25' X										6
WB	0.656	H	R1-1	30	30		STOP						1		X													
		H	R1-1	30	30			6.25								1		12.5' X									X	
WB	0.640	F	D2-1	72	10								1		X													
		F	D2-1	72	12		Gassets 4	6.00								2		17.25' 15.5' X										4
		F	M3-4	24	12		WEST VERMONT 10	2.00																		GREEN ON WHITE	X	
		F	M1-5	24	24			4.00																		INSTALL THE ROUTE MARKERS UNDER THE DESTINATION SIGN, ON THE LEFT-SIDE POST			E-136B
WB	0.600	F	R2-1	24	30		SPEED LIMIT 50						1		X													
		F	R2-1	24	30			5.00								1		13.25' X									X	
WB	0.002	F	R2-1	24	30		SPEED LIMIT 50						1		X													
							SHEET TOTALS	37.44 SF	0.00 SF	0 EA	0 EA	0 EA	~~5~~ 6 EA	0 EA	0 EA	6 EA			~~86.0~~ 90 FT									
							TOWN DIRECTIONAL TOTALS	66.9	0.0	3.0	0.0	0.0	13	0.0	0.0	11			165.0									

SIGN SUMMARY SHEET

VERMONT AGENCY OF TRANSPORTATION

PROJECT NAME: **STATEWIDE SOUTHEAST REGION**
PROJECT NUMBER: **STPG SIGN (31)**

FILE NAME: **SPRINGFIELD WESTBOUND** PLOT DATE: **8/13/2010**
PROJECT MANAGER: **A. GAMBLE** DRAWN BY: **M. MILLER**
DESIGNED BY: **M. MILLER** CHECKED BY: **A. GAMBLE**
SPRINGFIELD VT-10 WESTBOUND 2 SHEET **120** OF **175**

DIRECTION	MILEPOINT	LOCATION CODE (SHEET 2)	SIGN CODE	WIDTH (IN)	HEIGHT (IN)	SHEETING REMARKS	SIGN LEGEND	NEW SIGNS "A"	NEW SIGNS "B"	EXISTING SIGNS RETAIN	EXISTING SIGNS SALVAGE FROM	EXISTING SIGNS SALVAGE TO	EXISTING SIGNS REMOVE	EXIST POST RETAIN	EXIST POST REMOVE	NUMBER OF NEW POSTS	SQUARE STEEL (IN) 1.75 (LB / FT) 1.88	SQUARE STEEL (IN) 2.00 (LB / FT) 2.42	SQUARE STEEL (IN) 2.50 (LB / FT) 3.35	TUBULAR STEEL Ø (IN) FOUNDATION	TUBULAR STEEL Ø (IN) 3.00 (LB / FT) 7.60	TUBULAR STEEL Ø (IN) 3.50 (LB / FT) 9.00	TUBULAR STEEL Ø (IN) 4.00 (LB / FT) 10.80	TUBULAR STEEL Ø (IN) 5.00 (LB / FT) 14.60	SIGN FRAME REQUIRED	REMARKS	SIGN DETAIL: DETAIL IN SHS	SIGN DETAIL: DETAIL ON SHEET NUMBER	SIGN DETAIL: DETAIL ON STD SHEET NUMBER
SPRINGFIELD WB							FY-FLUORESCENT YELLOW FYG-FLUORESCENT YELLOW GREEN																			"SHS"-STANDARD HIGHWAY SIGNS			
		F	M3-4	24	12			2.00								1		14.0' X								GREEN ON WHITE	X		
		F	M1-5	24	24			4.00																				E-136B

DIRECTION	MILEPOINT	LOCATION CODE (SHEET 2)	SIGN CODE	WIDTH (IN)	HEIGHT (IN)	SHEETING REMARKS	SIGN LEGEND	NEW SIGNS "A"	NEW SIGNS "B"	EXISTING SIGNS RETAIN	EXISTING SIGNS SALVAGE FROM	EXISTING SIGNS SALVAGE TO	EXISTING SIGNS REMOVE	EXIST POST RETAIN	EXIST POST REMOVE	NUMBER OF NEW POSTS	SQUARE STEEL (IN) 1.75 (LB / FT) 1.88	SQUARE STEEL (IN) 2.00 (LB / FT) 2.42	SQUARE STEEL (IN) 2.50 (LB / FT) 3.35	TUBULAR STEEL Ø (IN) FOUNDATION	TUBULAR STEEL Ø (IN) 3.00 (LB / FT) 7.60	TUBULAR STEEL Ø (IN) 3.50 (LB / FT) 9.00	TUBULAR STEEL Ø (IN) 4.00 (LB / FT) 10.80	TUBULAR STEEL Ø (IN) 5.00 (LB / FT) 14.60	SIGN FRAME REQUIRED	REMARKS	SIGN DETAIL: DETAIL IN SHS	SIGN DETAIL: DETAIL ON SHEET NUMBER	SIGN DETAIL: DETAIL ON STD SHEET NUMBER
WEATHERSFIELD EB							FY-FLUORESCENT YELLOW FYG-FLUORESCENT YELLOW GREEN																			"SHS"-STANDARD HIGHWAY SIGNS			
EB	0.000	A	VD-024	72	10		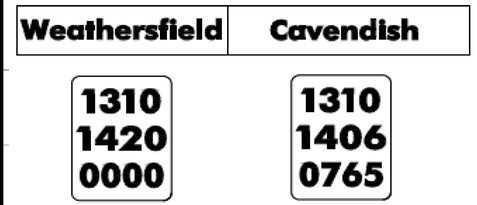	5.00								2		12.5' 12.0' X								INSTALL BEHIND RAIL DIRECTLY ACROSS FROM THE EXISTING TOWN LINE SIGN (WHICH WILL BE REMOVED)		4	
		A	VD-700	6	10			0.42																		CAVENDISH MILE MARKER; INSTALL ON RIGHT-SIDE POST		4	
		A	VD-700	6	10			0.42																		WEATHERSFIELD MILE MARKER; INSTALL ON LEFT-SIDE POST		4	
EB	0.774	A	VD-062B	72	16		BUSINESS DIRECTORY SIGN			1				X												ROCKLEDGE FARM <===			
EB	0.905	A	W2-1M	30	30		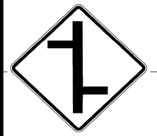						1		X															
		A	W2-1Md	30	30			6.25								1		14.0' X										5	
EB	0.940	A	W3-5	36	36								1		X															
		A	W3-5	36	36			9.00								2		15.0' 14.0' X									X		
EB	0.970	A	VD-018	30	18								1		X															
		A	VD-018	30	18			3.75								1		11.5' X										8	
EB	0.984	C	VR-017	24	30		LEGAL LOAD LIMIT 6 TONS	5.00		~~1~~				~~X~~		1		12.5' X		OLD SIGN MISSING NEW SIGN INSTALLED.					UPPER FALLS ROAD (TH-20); RETAIN SIGN AND POST, BOTH ARE AS-NEW			
EB	0.990	D	R1-1	30	30								1		X															
		D	R1-1	30	30			6.25								1		12.5' X		MM SALVAGED ONTO THE NEW POST							X		
EB	1.050	A	R2-1	24	30								1		X															
		A	R2-1	30	36			7.50								1		14.5' X										6	
SIGN SUMMARY SHEET							SHEET TOTALS	43.59 ~~38.59~~	0.00	~~1~~ ~~2~~	0	0	5	0	0	8		118.5 ~~120~~										
								SF	SF	EA	EA	EA	EA	EA	EA	EA		FT										
VERMONT AGENCY OF TRANSPORTATION							TOWN DIRECTIONAL TOTALS	778.3	0.0	47.0	9.0	9.0	180	0.0	0.0	108		1620.0										

PROJECT NAME: **STATEWIDE SOUTHEAST REGION**
PROJECT NUMBER: **STPG SIGN (31)**

FILE NAME: **WEATHERSFIELD EASTBOUND** PLOT DATE: **8/19/2010**
PROJECT MANAGER: **A. GAMBLE** DRAWN BY: **M. MILLER**
DESIGNED BY: **M. MILLER** CHECKED BY: **A. GAMBLE**
WEATHERSFIELD VT-131 EB 1 SHEET **122** OF **175**

DIRECTION	MILEPOINT	LOCATION CODE (SHEET 2)	SIGN CODE	WIDTH (IN)	HEIGHT (IN)	SHEETING REMARKS	SIGN LEGEND	NEW SIGNS "A"	NEW SIGNS "B"	EXISTING SIGNS RETAIN	EXISTING SIGNS SALVAGE FROM	EXISTING SIGNS SALVAGE TO	EXISTING SIGNS REMOVE	EXIST POST RETAIN	EXIST POST REMOVE	NUMBER OF NEW POSTS	SQUARE STEEL (IN) 1.75 (LB / FT) 1.88	SQUARE STEEL (IN) 2.00 (LB / FT) 2.42	SQUARE STEEL (IN) 2.50 (LB / FT) 3.35	TUBULAR STEEL Ø (IN) FOUNDATION	TUBULAR STEEL Ø (IN) 3.00 (LB / FT) 7.60	TUBULAR STEEL Ø (IN) 3.50 (LB / FT) 9.00	TUBULAR STEEL Ø (IN) 4.00 (LB / FT) 10.80	TUBULAR STEEL Ø (IN) 5.00 (LB / FT) 14.60	SIGN FRAME REQUIRED	REMARKS	SIGN DETAIL: DETAIL IN SHS	SIGN DETAIL: DETAIL ON SHEET NUMBER	SIGN DETAIL: DETAIL ON STD SHEET NUMBER
WEATHERSFIELD EB							FY-FLUORESCENT YELLOW FYG-FLUORESCENT YELLOW GREEN																			"SHS"-STANDARD HIGHWAY SIGNS			
EB	1.148	A	M2-1	21	15								1		X														
		A	M1-5	30	24								1																
		A	M2-1	21	15			2.19								1		15.0' X								GREEN ON WHITE	X		
		A	M1-5	30	24			5.00																					E-136B
EB	1.192	A	W3-1	36	36								1		X														
		A	W16-2	24	18		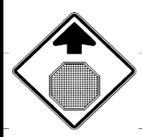						1																
		A	W3-1	36	36			9.00								2		14.5' 14.5' X								INSTALL NEW SIGN ON 2 POSTS	X		
		A	W16-2	24	18		1310 1420 0120 2 EA. BACK TO BACK	3.00													MM'S SALVAGED ONTO0 THE NEW POST					INSTALL PLAQUE ON LEFT POST	X		
EB	1.231	A	D1-1A	72	10								1	X													RETAIN THE EXISTING TUBULAR STEEL POSTS			
		A	D1-1A	72	10								1																
		A	D1-1A	72	10		(6) DESTINATION SIGNS						1																
		A	D1-1A	72	10								1																
		A	D1-1A	72	10								1																
		A	D1-1A	72	10																						SPRINGFIELD SIGN IS MISSING			
		A	D1-1A	72	12		(SEE NEXT PAGE)	6.00								~~2~~		~~X~~								INSTALL IN THE SAME VERTICAL ORDER AS SHOWN		4	
							SHEET TOTALS	25.19	0.00	0	0	0	9	0	0	5		44.0 ~~75~~											
								SF	SF	EA	EA	EA	EA	EA	EA	EA		FT											
							TOWN DIRECTIONAL TOTALS	778.3	0.0	47.0	9.0	9.0	180	0.0	0.0	108		1620.0											

SIGN SUMMARY SHEET

VERMONT AGENCY OF TRANSPORTATION

PROJECT NAME: **STATEWIDE SOUTHEAST REGION**
PROJECT NUMBER: **STPG SIGN (31)**

FILE NAME: **WEATHERSFIELD EASTBOUND** PLOT DATE: **8/19/2010**
PROJECT MANAGER: **A. GAMBLE** DRAWN BY: **M. MILLER**
DESIGNED BY: **M. MILLER** CHECKED BY: **A. GAMBLE**
WEATHERSFIELD VT-131 EB 2 SHEET **123** OF **175**

DIRECTION	MILEPOINT	LOCATION CODE (SHEET 2)	SIGN CODE	WIDTH (IN)	HEIGHT (IN)	SHEETING REMARKS	SIGN LEGEND	NEW SIGNS "A"	NEW SIGNS "B"	EXISTING SIGNS RETAIN	EXISTING SIGNS SALVAGE FROM	EXISTING SIGNS SALVAGE TO	EXISTING SIGNS REMOVE	EXIST POST RETAIN	EXIST POST REMOVE	NUMBER OF NEW POSTS	SQUARE STEEL (IN) 1.75 (LB / FT) 1.88	SQUARE STEEL (IN) 2.00 (LB / FT) 2.42	SQUARE STEEL (IN) 2.50 (LB / FT) 3.35	TUBULAR STEEL Ø (IN) FOUNDATION	TUBULAR STEEL Ø (IN) 3.00 (LB / FT) 7.60	TUBULAR STEEL Ø (IN) 3.50 (LB / FT) 9.00	TUBULAR STEEL Ø (IN) 4.00 (LB / FT) 10.80	TUBULAR STEEL Ø (IN) 5.00 (LB / FT) 14.60	SIGN FRAME REQUIRED	REMARKS	SIGN DETAIL: DETAIL IN SHS	SIGN DETAIL: DETAIL ON SHEET NUMBER	SIGN DETAIL: DETAIL ON STD SHEET NUMBER
WEATHERSFIELD EB							FY-FLUORESCENT YELLOW FYG-FLUORESCENT YELLOW GREEN																			"SHS"-STANDARD HIGHWAY SIGNS			
		A	D1-1A	72	12			6.00																				
		A	D1-1A	72	12			6.00																				
		A	D1-1A	72	12		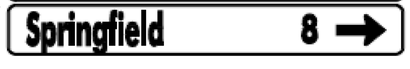	6.00																				
EB	1.250	A	M4-5	24	12								1		X													
		A	M1-1	24	24								1															
		A	M6-3	21	15								1															
		A	M4-5	24	12			2.00								1		13.0' X							WHITE ON BLUE	X		
		A	M1-1	24	24			4.00																			X	
		A	M6-3	21	15			2.19																			WHITE ON BLUE	X		
EB	1.280	A	M3-1	24	12								1	X													RETAIN THE EXISTING POSTS; REPLACE THE SIGN FRAME			
		A	M1-5	24	24								1															
		A	M6-1	21	15								1															
		A	M3-2	24	12		(9) ROUTE MARKER SIGN ASSEMBLY						1																
							SHEET TOTALS	38.19	0.00	0	0	0	7	0	0	1		13.0 ~~15~~										
								SF	SF	EA	EA	EA	EA	EA	EA	EA		FT										
							TOWN DIRECTIONAL TOTALS	778.3	0.0	47.0	9.0	9.0	180	0.0	0.0	108		1620.0										

SIGN SUMMARY SHEET

VERMONT AGENCY OF TRANSPORTATION

PROJECT NAME: **STATEWIDE SOUTHEAST REGION**
PROJECT NUMBER: **STPG SIGN (31)**

FILE NAME: **WEATHERSFIELD EASTBOUND** PLOT DATE: **8/19/2010**
PROJECT MANAGER: **A. GAMBLE** DRAWN BY: **M. MILLER**
DESIGNED BY: **M. MILLER** CHECKED BY: **A. GAMBLE**
WEATHERSFIELD VT-131 EB 3 SHEET **124** OF **175**

DIRECTION	MILEPOINT	LOCATION CODE (SHEET 2)	SIGN CODE	WIDTH (IN)	HEIGHT (IN)	SHEETING REMARKS	SIGN LEGEND	NEW SIGNS "A"	NEW SIGNS "B"	EXISTING SIGNS RETAIN	EXISTING SIGNS SALVAGE FROM	EXISTING SIGNS SALVAGE TO	EXISTING SIGNS REMOVE	EXIST POST RETAIN	EXIST POST REMOVE	NUMBER OF NEW POSTS	SQUARE STEEL (IN) 1.75 (LB / FT) 1.88	SQUARE STEEL (IN) 2.00 (LB / FT) 2.42	SQUARE STEEL (IN) 2.50 (LB / FT) 3.35	TUBULAR STEEL Ø (IN) FOUNDATION	TUBULAR STEEL Ø (IN) 3.00 (LB / FT) 7.60	TUBULAR STEEL Ø (IN) 3.50 (LB / FT) 9.00	TUBULAR STEEL Ø (IN) 4.00 (LB / FT) 10.80	TUBULAR STEEL Ø (IN) 5.00 (LB / FT) 14.60	SIGN FRAME REQUIRED	REMARKS	SIGN DETAIL: DETAIL IN SHS	SIGN DETAIL: DETAIL ON SHEET NUMBER	SIGN DETAIL: DETAIL ON STD SHEET NUMBER
WEATHERSFIELD EB							FY-FLUORESCENT YELLOW FYG-FLUORESCENT YELLOW GREEN																			"SHS"-STANDARD HIGHWAY SIGNS			
		A	M1-5	24	24								1															
		A	M6-3	21	15								1															
		A	M3-3	24	12								1															
		A	M1-5	24	24								1															
		A	M6-1	21	15								1															
		A	M3-1	24	12		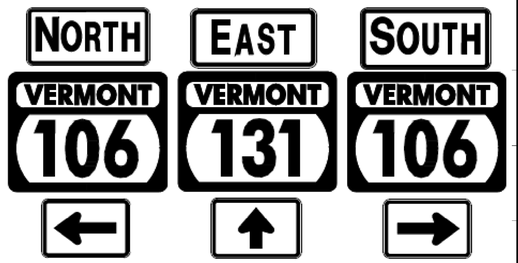	2.00						X		~~2~~		~~X~~ SEE NOTE ON PREVIOUS SHEET					~~# 30~~	GREEN ON WHITE	X		
		A	M1-5	30	24			5.00																				E-136B
		A	M6-1	21	15			2.19																			GREEN ON WHITE	X		
		A	M3-2	24	12			2.00																			GREEN ON WHITE	X		
		A	M1-5	30	24			5.00																				E-136B
		A	M6-3	21	15			2.19																			GREEN ON WHITE	X		
		A	M3-3	24	12			2.00																			GREEN ON WHITE	X		
		A	M1-5	30	24			5.00																				E-136B
		A	M6-1	21	15			2.19																			GREEN ON WHITE	X		
EB	1.302	A	R1-1	48	48								1		X														
							SHEET TOTALS	27.57	0.00	0	0	0	6	0	0	~~0~~ 2	~~0.0~~ 30												
								SF	SF	EA	EA	EA	EA	EA	EA	EA	FT											
							TOWN DIRECTIONAL TOTALS	778.3	0.0	47.0	9.0	9.0	180	0.0	0.0	108	1620.0											

SIGN SUMMARY SHEET

VERMONT AGENCY OF TRANSPORTATION

PROJECT NAME: STATEWIDE SOUTHEAST REGION
PROJECT NUMBER: STPG SIGN (31)

FILE NAME: WEATHERSFIELD EASTBOUND
PROJECT MANAGER: A. GAMBLE
DESIGNED BY: M. MILLER
WEATHERSFIELD VT-131 EB 4

PLOT DATE: 8/19/2010
DRAWN BY: M. MILLER
CHECKED BY: A. GAMBLE
SHEET 125 OF 175

DIRECTION	MILEPOINT	LOCATION CODE (SHEET 2)	SIGN CODE	WIDTH (IN)	HEIGHT (IN)	SHEETING REMARKS	SIGN LEGEND	NEW SIGNS "A"	NEW SIGNS "B"	EXISTING SIGNS RETAIN	EXISTING SIGNS SALVAGE FROM	EXISTING SIGNS SALVAGE TO	EXISTING SIGNS REMOVE	EXIST POST RETAIN	EXIST POST REMOVE	NUMBER OF NEW POSTS	SQUARE STEEL (IN) 1.75 (LB / FT) 1.88	SQUARE STEEL (IN) 2.00 (LB / FT) 2.42	SQUARE STEEL (IN) 2.50 (LB / FT) 3.35	TUBULAR STEEL Ø (IN) FOUNDATION	TUBULAR STEEL Ø (IN) 3.00 (LB / FT) 7.60	TUBULAR STEEL Ø (IN) 3.50 (LB / FT) 9.00	TUBULAR STEEL Ø (IN) 4.00 (LB / FT) 10.80	TUBULAR STEEL Ø (IN) 5.00 (LB / FT) 14.60	SIGN FRAME REQUIRED	REMARKS	SIGN DETAIL: DETAIL IN SHS	SIGN DETAIL: DETAIL ON SHEET NUMBER	SIGN DETAIL: DETAIL ON STD SHEET NUMBER
WEATHERSFIELD EB							FY-FLUORESCENT YELLOW FYG-FLUORESCENT YELLOW GREEN																			"SHS"-STANDARD HIGHWAY SIGNS			
EB	1.302	A	R1-1	48	48		1310 1420 0132	16.00								2		14.5' 14.75' X									X		
EB	1.325	B	R1-1	36	36								1		X														
		B	R1-1	36	36			9.00								2		13.25' 13.5' X								FACES WESTBOUND TRAFFIC	X		
EB	1.340	A	R2-1	24	30								1		X														
		A	R2-1	24	30			5.00								1		14.0' X								SOME TREE TRIMMING MAY BE REQUIRED TO THE RIGHT OF THIS SIGN	X		
EB	1.374	A	D2-1	72	10								1		X														
		A	D2-1	72	10								1																
		A	M3-2	24	12		(6 SIGNS) DESTINATION AND ROUTE MARKERS						1																
		A	M1-5	30	24								1																
		A	M4-5	24	12		1310 1420 0140						1								MM SALVAGED ONTO THE NEW POST.								
		A	M1-1	24	24								1																
		A	D2-1	72	12		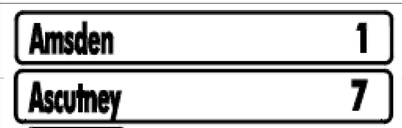	6.00								2		15.25' 15.25' X										4	
		A	D2-1	72	12			6.00																				4	
		A	M3-2	24	12			2.00																		GREEN ON WHITE	X		
		A	M1-5	30	24			5.00																		INSTALL VT-131 SIGNS ON LEFT SIDE POST			E-136B
							SHEET TOTALS	49.00	0.00	0	0	0	8	0	0	7		~~100.5~~ 105											
								SF	SF	EA	EA	EA	EA	EA	EA	EA		FT											
							TOWN DIRECTIONAL TOTALS	778.3	0.0	47.0	9.0	9.0	180	0.0	0.0	108		1620.0											

SIGN SUMMARY SHEET

VERMONT AGENCY OF TRANSPORTATION

PROJECT NAME: STATEWIDE SOUTHEAST REGION
PROJECT NUMBER: STPG SIGN (31)

FILE NAME: WEATHERSFIELD EASTBOUND
PROJECT MANAGER: A. GAMBLE
DESIGNED BY: M. MILLER
WEATHERSFIELD VT-131 EB 5

PLOT DATE: 8/19/2010
DRAWN BY: M. MILLER
CHECKED BY: A. GAMBLE
SHEET 126 OF 175

DIRECTION	MILEPOINT	LOCATION CODE (SHEET 2)	SIGN CODE	WIDTH (IN)	HEIGHT (IN)	SHEETING REMARKS	SIGN LEGEND	NEW SIGNS "A"	NEW SIGNS "B"	EXISTING SIGNS RETAIN	EXISTING SIGNS SALVAGE FROM	EXISTING SIGNS SALVAGE TO	EXISTING SIGNS REMOVE	EXIST POST RETAIN	EXIST POST REMOVE	NUMBER OF NEW POSTS	SQUARE STEEL (IN) 1.75 (LB / FT) 1.88	SQUARE STEEL (IN) 2.00 (LB / FT) 2.42	SQUARE STEEL (IN) 2.50 (LB / FT) 3.35	TUBULAR STEEL Ø (IN) FOUNDATION	TUBULAR STEEL Ø (IN) 3.00 (LB / FT) 7.60	TUBULAR STEEL Ø (IN) 3.50 (LB / FT) 9.00	TUBULAR STEEL Ø (IN) 4.00 (LB / FT) 10.80	TUBULAR STEEL Ø (IN) 5.00 (LB / FT) 14.60	SIGN FRAME REQUIRED	REMARKS	SIGN DETAIL: DETAIL IN SHS	SIGN DETAIL: DETAIL ON SHEET NUMBER	SIGN DETAIL: DETAIL ON STD SHEET NUMBER
WEATHERSFIELD EB							FY-FLUORESCENT YELLOW FYG-FLUORESCENT YELLOW GREEN																			"SHS"-STANDARD HIGHWAY SIGNS			
		A	M4-5	24	12			2.00																		**WHITE ON BLUE**	X		
		A	M1-1	24	24			4.00																		INSTALL I-91 SIGNS ON RIGHT SIDE POST	X		
EB	1.458	A	W1-5R	30	30	**FY**	RIGHT WINDING CURVES				1		1		X											THIS SIGN AND THE PLAQUE TO BE SALVAGED ONTO A NEW POST			
		A	W7-3A	24	18	**FY**	NEXT 1/2 MILE				1		1													PAY AS REMOVALS			
		B	W3-1	36	36		STOP AHEAD (ON BACK)						1													**REMOVE THIS SIGN**			
		A	W1-5R	30	30	**FY**	RIGHT WINDING CURVES					1				1		14.25' X								RE-INSTALL ON A NEW POST			
		A	W7-3A	24	18	**FY**	NEXT 1/2 MILE					1																	
EB	1.500	A	VW-202	30	30								1		X															
		A	VW-202	30	30			6.25								1		14.75' X										E-154
EB	1.550	A	W1-8	24	30	**FY**							1		X													
		B	W1-8	24	30	**FY**							1		X													
		A	W1-8	24	30	**FY**		5.00								1		13.25' X								FACES EB; FLUORESCENT-YELLOW SHEETING	X		
		B	W1-8	24	30	**FY**		5.00								1		13.25' X								FACES WB; FLUORESCENT-YELLOW SHEETING	X		
EB	1.565	A	W1-8	24	30	**FY**							1		X													
		B	W1-8	24	30	**FY**							1		X													
							SHEET TOTALS	22.25	0.00	0	2	2	~~8~~ 6	0	0	4		~~55.5~~ 60											
								SF	SF	EA	EA	EA	EA	EA	EA	EA		FT											
							TOWN DIRECTIONAL TOTALS	778.3	0.0	47.0	9.0	9.0	180	0.0	0.0	108		1620.0											

SIGN SUMMARY SHEET

VERMONT AGENCY OF TRANSPORTATION

PROJECT NAME: **STATEWIDE SOUTHEAST REGION**
PROJECT NUMBER: **STPG SIGN (31)**

FILE NAME: **WEATHERSFIELD EASTBOUND** PLOT DATE: **8/19/2010**
PROJECT MANAGER: **A. GAMBLE** DRAWN BY: **M. MILLER**
DESIGNED BY: **M. MILLER** CHECKED BY: **A. GAMBLE**
WEATHERSFIELD VT-131 EB 6 SHEET **127** OF **175**

DIRECTION	MILEPOINT	LOCATION CODE (SHEET 2)	SIGN CODE	WIDTH (IN)	HEIGHT (IN)	SHEETING REMARKS	SIGN LEGEND	NEW SIGNS "A"	NEW SIGNS "B"	EXISTING SIGNS RETAIN	EXISTING SIGNS SALVAGE FROM	EXISTING SIGNS SALVAGE TO	EXISTING SIGNS REMOVE	EXIST POST RETAIN	EXIST POST REMOVE	NUMBER OF NEW POSTS	SQUARE STEEL (IN) 1.75 (LB / FT) 1.88	SQUARE STEEL (IN) 2.00 (LB / FT) 2.42	SQUARE STEEL (IN) 2.50 (LB / FT) 3.35	TUBULAR STEEL Ø (IN) FOUNDATION	TUBULAR STEEL Ø (IN) 3.00 (LB / FT) 7.60	TUBULAR STEEL Ø (IN) 3.50 (LB / FT) 9.00	TUBULAR STEEL Ø (IN) 4.00 (LB / FT) 10.80	TUBULAR STEEL Ø (IN) 5.00 (LB / FT) 14.60	SIGN FRAME REQUIRED	REMARKS	SIGN DETAIL: DETAIL IN SHS	SIGN DETAIL: DETAIL ON SHEET NUMBER	SIGN DETAIL: DETAIL ON STD SHEET NUMBER
WEATHERSFIELD EB							FY-FLUORESCENT YELLOW FYG-FLUORESCENT YELLOW GREEN																			"SHS"-STANDARD HIGHWAY SIGNS			
EB	1.565	A	W1-8	24	30	FY		5.00								1		13.75' X								FACES EB; FLUORESCENT-YELLOW SHEETING	X		
		B	W1-8	24	30	FY		5.00								1		13.75' X								FACES WB; FLUORESCENT-YELLOW SHEETING	X		
EB	1.570	C	VR-017	24	30								1		X											BRANCH BROOK RD (TH-82)			
		C	VR-017	24	30			5.00								1		12.25' X								AT WESTERLY APPROACH OF THIS "Y" INTERSECTION		6	
EB	1.578	D	R1-1	30	30		1310 1420 0156						1		X														
		D	R1-1	30	30			6.25								1		12.0' X			MM SALVAGED ONTO THE NEW POST.					AT WESTERLY APPROACH OF THIS "Y" INTERSECTION	X		
EB	1.580	A	W1-8	24	30	FY							1		X														
		B	W1-8	24	30	FY							1		X														
		A	W1-8	24	30	FY		5.00								1		12.5' X								FACES EB; FLUORESCENT-YELLOW SHEETING	X		
		B	W1-8	24	30	FY		5.00								1		12.5' X								FACES WB; FLUORESCENT-YELLOW SHEETING	X		
EB	1.590	A	W1-8	24	30	FY							1		X														
		B	W1-8	24	30	FY							1		X														
		A	W1-8	24	30	FY		5.00								1		12.75' X								FACES EB; FLUORESCENT-YELLOW SHEETING	X		
		B	W1-8	24	30	FY		5.00								1		12.75' X								FACES WB; FLUORESCENT-YELLOW SHEETING	X		
EB	1.600	A	W1-8	24	30	FY							1		X														
							SHEET TOTALS	41.25 SF	0.00 SF	0 EA	0 EA	0 EA	7 EA	0 EA	0 EA	8 EA		~~120~~ 102.25 FT											
							TOWN DIRECTIONAL TOTALS	778.3	0.0	47.0	9.0	9.0	180	0.0	0.0	108		1620.0										

SIGN SUMMARY SHEET

VERMONT AGENCY OF TRANSPORTATION

PROJECT NAME: **STATEWIDE SOUTHEAST REGION**
PROJECT NUMBER: **STPG SIGN (31)**

FILE NAME: **WEATHERSFIELD EASTBOUND** PLOT DATE: **8/19/2010**
PROJECT MANAGER: **A. GAMBLE** DRAWN BY: **M. MILLER**
DESIGNED BY: **M. MILLER** CHECKED BY: **A. GAMBLE**
WEATHERSFIELD VT-131 EB 7 SHEET **128** OF **175**

DIRECTION	MILEPOINT	LOCATION CODE (SHEET 2)	SIGN CODE	WIDTH (IN)	HEIGHT (IN)	SHEETING REMARKS	SIGN LEGEND	NEW SIGNS "A"	NEW SIGNS "B"	EXISTING SIGNS RETAIN	EXISTING SIGNS SALVAGE FROM	EXISTING SIGNS SALVAGE TO	EXISTING SIGNS REMOVE	EXIST POST RETAIN	EXIST POST REMOVE	NUMBER OF NEW POSTS	SQUARE STEEL (IN) 1.75 (LB / FT) 1.88	SQUARE STEEL (IN) 2.00 (LB / FT) 2.42	SQUARE STEEL (IN) 2.50 (LB / FT) 3.35	TUBULAR STEEL Ø (IN) FOUNDATION	TUBULAR STEEL Ø (IN) 3.00 (LB / FT) 7.60	TUBULAR STEEL Ø (IN) 3.50 (LB / FT) 9.00	TUBULAR STEEL Ø (IN) 4.00 (LB / FT) 10.80	TUBULAR STEEL Ø (IN) 5.00 (LB / FT) 14.60	SIGN FRAME REQUIRED	REMARKS	SIGN DETAIL: DETAIL IN SHS	SIGN DETAIL: DETAIL ON SHEET NUMBER	SIGN DETAIL: DETAIL ON STD SHEET NUMBER
WEATHERSFIELD EB							FY-FLUORESCENT YELLOW FYG-FLUORESCENT YELLOW GREEN																			"SHS"-STANDARD HIGHWAY SIGNS			
EB	1.600	B	W1-8	24	30	FY							1		X														
		A	W1-8	24	30	FY		5.00								1		12.5' X								FACES EB; FLUORESCENT-YELLOW SHEETING	X		
		B	W1-8	24	30	FY		5.00								1		12.5' X								FACES WB; FLUORESCENT-YELLOW SHEETING	X		
EB	1.613	C	VR-017	24	30								1		X												BRANCH BROOK RD (TH-82)			
		C	VR-017	24	30			5.00								1		13.75' X								AT EASTERLY APPROACH OF THIS "Y" INTERSECTION		6	
EB	1.621	D	R1-1	30	30		1310 1420 0163						1		X														
		D	R1-1	30	30			6.25								1		14.0' X								AT EASTERLY APPROACH OF THIS "Y" INTERSECTION	X		
EB	1.704	A	VD-018	30	18								1		X														
		A	VD-018	30	18			3.75								1		13.75' X										8
EB	1.740	A	S3-1	30	30		SCHOOL BUS STOP AHEAD						1		X														
		A	R2-1	24	30			5.00								1		13.75' X									X	
EB	1.778	A	R2-1	24	30		SPEED LIMIT 35						1		X														
EB	1.835	C	VR-017	24	30								1		X														
		C	VR-017	24	30			5.00								1		12.5' X								AMSDEN HOLLOW RD (TH-94); WESTERLY APPROACH		6
EB	1.843	D	R1-1	30	30								1		X														
SIGN SUMMARY SHEET							SHEET TOTALS	35.00	0.00	0	0	0	8	0	0	7		92.75 ~~105~~										
VERMONT AGENCY OF TRANSPORTATION								SF	SF	EA	EA	EA	EA	EA	EA	EA		FT										
							TOWN DIRECTIONAL TOTALS	778.3	0.0	47.0	9.0	9.0	180	0.0	0.0	108		1620.0										

PROJECT NAME: **STATEWIDE SOUTHEAST REGION**
PROJECT NUMBER: **STPG SIGN (31)**

FILE NAME: **WEATHERSFIELD EASTBOUND** PLOT DATE: **8/19/2010**
PROJECT MANAGER: **A. GAMBLE** DRAWN BY: **M. MILLER**
DESIGNED BY: **M. MILLER** CHECKED BY: **A. GAMBLE**
WEATHERSFIELD VT-131 EB 8 SHEET **129** OF **175**

DIRECTION	MILEPOINT	LOCATION CODE (SHEET 2)	SIGN CODE	WIDTH (IN)	HEIGHT (IN)	SHEETING REMARKS	SIGN LEGEND	NEW SIGNS "A"	NEW SIGNS "B"	EXISTING SIGNS RETAIN	EXISTING SIGNS SALVAGE FROM	EXISTING SIGNS SALVAGE TO	EXISTING SIGNS REMOVE	EXIST POST RETAIN	EXIST POST REMOVE	NUMBER OF NEW POSTS	SQUARE STEEL (IN) 1.75 (LB / FT) 1.88	SQUARE STEEL (IN) 2.00 (LB / FT) 2.42	SQUARE STEEL (IN) 2.50 (LB / FT) 3.35	TUBULAR STEEL Ø (IN) FOUNDATION	TUBULAR STEEL Ø (IN) 3.00 (LB / FT) 7.60	TUBULAR STEEL Ø (IN) 3.50 (LB / FT) 9.00	TUBULAR STEEL Ø (IN) 4.00 (LB / FT) 10.80	TUBULAR STEEL Ø (IN) 5.00 (LB / FT) 14.60	SIGN FRAME REQUIRED	REMARKS	SIGN DETAIL: DETAIL IN SHS	SIGN DETAIL: DETAIL ON SHEET NUMBER	SIGN DETAIL: DETAIL ON STD SHEET NUMBER
WEATHERSFIELD EB							FY-FLUORESCENT YELLOW FYG-FLUORESCENT YELLOW GREEN																			"SHS"-STANDARD HIGHWAY SIGNS			
EB	1.843	D	R1-1	30	30		STOP 1310 1420 0183	6.25								1		12.5' X									X	
EB	1.860	A	S3-1	30	30		SCHOOL BUS STOP AHEAD						1		X													
EB	1.902	A	R2-1	24	30		SPEED LIMIT 35						1		X											TO BE REPLACED SLIGHTLY AHEAD		
EB	1.912	A	R2-1	24	30		SPEED LIMIT 35	5.00								1		15.5' X								INSTALL 50 FEET ± EAST OF PREVIOUS POSITION	X	
EB	1.964	C	VR-017	24	30		LEGAL LOAD LIMIT 24,000 POUNDS						1		X													
		C	VR-017	24	30		LEGAL LOAD LIMIT 24,000 POUNDS	5.00								1		11.0' X								AMSDEN HOLLOW RD (TH-94); EASTERLY APPROACH		6
EB	1.968	D	R1-1	30	30		STOP 1310 1420 0199						~~1~~		X					OLD SIGN WAS MISSING								
		D	R1-1	30	30		STOP 1310 1420 0199	6.25								1		12.5' X									X	
EB	2.087	A	W1-2R	30	30		RIGHT CURVE						1		X													
		A	S3-1	30	30		SCHOOL BUS STOP AHEAD						1													SCHOOL BUS STOP AHEAD SIGN WILL NOT BE REPLACED		
		A	W1-2R	30	30		SCHOOL BUS STOP AHEAD	6.25								1		13.5' X									X	
EB	2.134	A	W11-6	30	30								1		X											SIGN MAY BE MISSING		
		A	W11-6H	30	30			6.25								1		12.5' X								**HINGED SIGN:** INSTALL WITH SIGN FOLDED CLOSED		5
EB	2.164	A	R2-1	24	30		SPEED LIMIT 35						1		X													
		A	R2-1	24	30		SPEED LIMIT 35	5.00								1		13.5' X									X	
							SHEET TOTALS	40.00 SF	0.00 SF	0 EA	0 EA	0 EA	~~7~~ 8 EA	0 EA	0 EA	7 EA	~~91.0~~ 105 FT										
							TOWN DIRECTIONAL TOTALS	778.3	0.0	47.0	9.0	9.0	180	0.0	0.0	108	1620.0										

SIGN SUMMARY SHEET

VERMONT AGENCY OF TRANSPORTATION

PROJECT NAME: **STATEWIDE SOUTHEAST REGION**
PROJECT NUMBER: **STPG SIGN (31)**

FILE NAME: **WEATHERSFIELD EASTBOUND** PLOT DATE: **8/19/2010**
PROJECT MANAGER: **A. GAMBLE** DRAWN BY: **M. MILLER**
DESIGNED BY: **M. MILLER** CHECKED BY: **A. GAMBLE**
WEATHERSFIELD VT-131 EB 9 SHEET **130** OF **175**

DIRECTION	MILEPOINT	LOCATION CODE (SHEET 2)	SIGN CODE	WIDTH (IN)	HEIGHT (IN)	SHEETING REMARKS	SIGN LEGEND	NEW SIGNS "A"	NEW SIGNS "B"	EXISTING SIGNS RETAIN	EXISTING SIGNS SALVAGE FROM	EXISTING SIGNS SALVAGE TO	EXISTING SIGNS REMOVE	EXIST POST RETAIN	EXIST POST REMOVE	NUMBER OF NEW POSTS	SQUARE STEEL (IN) 1.75 (LB / FT) 1.88	SQUARE STEEL (IN) 2.00 (LB / FT) 2.42	SQUARE STEEL (IN) 2.50 (LB / FT) 3.35	TUBULAR STEEL Ø (IN) FOUNDATION	TUBULAR STEEL Ø (IN) 3.00 (LB / FT) 7.60	TUBULAR STEEL Ø (IN) 3.50 (LB / FT) 9.00	TUBULAR STEEL Ø (IN) 4.00 (LB / FT) 10.80	TUBULAR STEEL Ø (IN) 5.00 (LB / FT) 14.60	SIGN FRAME REQUIRED	REMARKS	SIGN DETAIL: DETAIL IN SHS	SIGN DETAIL: DETAIL ON SHEET NUMBER	SIGN DETAIL: DETAIL ON STD SHEET NUMBER
WEATHERSFIELD EB							FY-FLUORESCENT YELLOW FYG-FLUORESCENT YELLOW GREEN																			"SHS"-STANDARD HIGHWAY SIGNS			
EB	2.230	A	VW-054	30	30								1		X														
		A	VW-054	30	30			6.25								1		13.75' X										E-154
EB	2.262	A	VW-202	30	30								1		X														
		A	VW-202	30	30			6.25								1		13.0' X										E-154
EB	2.363	A	R2-1	24	30			5.00								1		13.5' X								INSTALL 35 FEET ± EAST OF AND ACROSS FROM THE WB SPEED LIMIT 35 SIGN	X		
EB	2.399	A	R2-1	24	30		SPEED LIMIT 50						1		X											THIS SIGN HAS BEEN TOO FAR EAST AT THE SPEED LIMIT TRANSITION POINT			
EB	2.600	C	VR-017	24	30								1		X												GULF ROAD (TH-8)			
		C	VR-017	24	30			5.00								1		14.25' X										6
EB	2.610	D	R1-1	30	30		1310 1420 0261						1		X														
		D	R1-1	30	30			6.25								1		12.25' X									X	
EB	3.485	C	VR-017	24	30								1		X												PIPER ROAD (TH-4)			
		C	VR-017	24	30			5.00								1		12.25' X										6
EB	3.490	D	R1-1	30	30		1310 1420 0352						1		X														
		D	R1-1	30	30			6.25								1		13.0' X									X	
EB	3.522	A	M3-2	24	12								1		X													
							SHEET TOTALS	40.00	0.00	0	0	0	8	0	0	7		92.0 ~~105~~										
								SF	SF	EA	EA	EA	EA	EA	EA	EA		FT										
							TOWN DIRECTIONAL TOTALS	778.3	0.0	47.0	9.0	9.0	180	0.0	0.0	108		1620.0										

SIGN SUMMARY SHEET

VERMONT AGENCY OF TRANSPORTATION

PROJECT NAME: **STATEWIDE SOUTHEAST REGION**
PROJECT NUMBER: **STPG SIGN (31)**

FILE NAME: **WEATHERSFIELD EASTBOUND** PLOT DATE: **8/19/2010**
PROJECT MANAGER: **A. GAMBLE** DRAWN BY: **M. MILLER**
DESIGNED BY: **M. MILLER** CHECKED BY: **A. GAMBLE**
WEATHERSFIELD VT-131 EB 10 SHEET **131** OF **175**

DIRECTION	MILEPOINT	LOCATION CODE (SHEET 2)	SIGN CODE	WIDTH (IN)	HEIGHT (IN)	SHEETING REMARKS	SIGN LEGEND	NEW SIGNS "A"	NEW SIGNS "B"	EXISTING SIGNS RETAIN	EXISTING SIGNS SALVAGE FROM	EXISTING SIGNS SALVAGE TO	EXISTING SIGNS REMOVE	EXIST POST RETAIN	EXIST POST REMOVE	NUMBER OF NEW POSTS	SQUARE STEEL (IN) 1.75 (LB / FT) 1.88	SQUARE STEEL (IN) 2.00 (LB / FT) 2.42	SQUARE STEEL (IN) 2.50 (LB / FT) 3.35	TUBULAR STEEL Ø (IN) FOUNDATION	TUBULAR STEEL Ø (IN) 3.00 (LB / FT) 7.60	TUBULAR STEEL Ø (IN) 3.50 (LB / FT) 9.00	TUBULAR STEEL Ø (IN) 4.00 (LB / FT) 10.80	TUBULAR STEEL Ø (IN) 5.00 (LB / FT) 14.60	SIGN FRAME REQUIRED	REMARKS	SIGN DETAIL: DETAIL IN SHS	SIGN DETAIL: DETAIL ON SHEET NUMBER	SIGN DETAIL: DETAIL ON STD SHEET NUMBER
WEATHERSFIELD EB							FY-FLUORESCENT YELLOW FYG-FLUORESCENT YELLOW GREEN																			"SHS"-STANDARD HIGHWAY SIGNS			
EB	3.522	A	M1-5	30	24				1																			
		A	M3-2	24	12			2.00								1	14.75' X								GREEN ON WHITE	X		
		A	M1-5	30	24			5.00																					E-136B
EB	3.580	A	R2-1	24	30				1						X														
		A	R2-1	24	30			5.00								1	15.75' X										X		
EB	3.745	A	W1-2R	30	30			6.25								1	14.75' X								INSTALL 150 FT ± IN ADVANCE OF JCT w/ HENRY GOULD RD (TH-65) ON LEFT	X		
EB	4.796	C	VR-017	24	30				1						X											GRAVELIN ROAD (TH-9)			
		C	VR-017	24	30			5.00								1	14.25' X											6	
EB	4.804	D	R1-1	30	30		1310 1420 0481		1						X														
		D	R1-1	30	30			6.25								1	14.75' X										X		
EB	4.826	A	VW-133	30	30				1						X														
		A	VW-133	30	30			6.25								1	13.0' X												E-154
EB	4.865	A	S3-1	30	30		SCHOOL BUS STOP AHEAD		1						X											SCHOOL BUS STOP AHEAD SIGN WILL NOT BE REPLACED			
		A	W11-7	30	30				1																				
		A	W11-7	30	30			6.25								1	13.0' X										X		
							SHEET TOTALS	42.00 SF	0.00 SF	0 EA	0 EA	0 EA	7 EA	0 EA	0 EA	7 EA	~~100.25~~ 105 FT												
							TOWN DIRECTIONAL TOTALS	778.3	0.0	47.0	9.0	9.0	180	0.0	0.0	108	1620.0												

SIGN SUMMARY SHEET

VERMONT AGENCY OF TRANSPORTATION

PROJECT NAME: **STATEWIDE SOUTHEAST REGION**
PROJECT NUMBER: **STPG SIGN (31)**

FILE NAME: **WEATHERSFIELD EASTBOUND** PLOT DATE: **8/19/2010**
PROJECT MANAGER: **A. GAMBLE** DRAWN BY: **M. MILLER**
DESIGNED BY: **M. MILLER** CHECKED BY: **A. GAMBLE**
WEATHERSFIELD VT-131 EB 11 SHEET **132** OF **175**

DIRECTION	MILEPOINT	LOCATION CODE (SHEET 2)	SIGN CODE	WIDTH (IN)	HEIGHT (IN)	SHEETING REMARKS	SIGN LEGEND	NEW SIGNS "A"	NEW SIGNS "B"	EXISTING SIGNS RETAIN	EXISTING SIGNS SALVAGE FROM	EXISTING SIGNS SALVAGE TO	EXISTING SIGNS REMOVE	EXIST POST RETAIN	EXIST POST REMOVE	NUMBER OF NEW POSTS	SQUARE STEEL (IN) 1.75 (LB / FT) 1.88	SQUARE STEEL (IN) 2.00 (LB / FT) 2.42	SQUARE STEEL (IN) 2.50 (LB / FT) 3.35	TUBULAR STEEL Ø (IN) FOUNDATION	TUBULAR STEEL Ø (IN) 3.00 (LB / FT) 7.60	TUBULAR STEEL Ø (IN) 3.50 (LB / FT) 9.00	TUBULAR STEEL Ø (IN) 4.00 (LB / FT) 10.80	TUBULAR STEEL Ø (IN) 5.00 (LB / FT) 14.60	SIGN FRAME REQUIRED	REMARKS	SIGN DETAIL: DETAIL IN SHS	SIGN DETAIL: DETAIL ON SHEET NUMBER	SIGN DETAIL: DETAIL ON STD SHEET NUMBER
WEATHERSFIELD EB							FY-FLUORESCENT YELLOW FYG-FLUORESCENT YELLOW GREEN																			"SHS"-STANDARD HIGHWAY SIGNS			
EB	4.938	A	VD-062AS	72	16		BUSINESS DIRECTORY SIGN			1				X												WEATHERSFIELD TRAIL <===			
EB	5.138	C	VR-017	24	30								1		X												GULF ROAD (TH-8)			
		C	VR-017	24	30			5.00								1		13.0' X										6	
EB	5.146	D	R1-1	30	30		1310 1420 0514						1		X															
		D	R1-1	30	30			6.25								1		12.5' X										X	
EB	5.160	A	M3-2	24	12			2.00								1		14.25 X								**GREEN ON WHITE**	X		
		A	M1-5	30	24			5.00																		INSTALL 75 FEET ± EAST OF GULF ROAD			E-136B
EB	5.573	A	W7-1A	30	30		HILL SYMBOL 8%						1		X											NOTE REMOVAL POSITION FOR NEW SIGN FURTHER AHEAD			
EB	5.650	A	W7-1A	36	36			9.00								2		16.5' 15.5' X								INSTALL 410 FEET ± EAST OF THE PREVIOUS LOCATION	X		
EB	5.715	C	VR-017	24	30								1		X												JARVIS EXT (TH-14)			
		C	VR-017	24	30			5.00								1		12.0' X										6	
EB	5.723	D	R1-1	30	30		1310 1420 0572						1		X															
		D	R1-1	30	30			6.25								1		11.75' X										X	
EB	5.848	C	VR-017	24	30								1		X												JARVIS ROAD (TH-71)			
		C	VR-017	24	30			5.00								1		13.25' X										6	
							SHEET TOTALS	43.50	0.00	1	0	0	6	0	0	8		~~108.75~~ ~~120~~											
								SF	SF	EA	EA	EA	EA	EA	EA	EA		FT											
							TOWN DIRECTIONAL TOTALS	778.3	0.0	47.0	9.0	9.0	180	0.0	0.0	108		1620.0											

SIGN SUMMARY SHEET

VERMONT AGENCY OF TRANSPORTATION

PROJECT NAME: **STATEWIDE SOUTHEAST REGION**
PROJECT NUMBER: **STPG SIGN (31)**

FILE NAME: **WEATHERSFIELD EASTBOUND** PLOT DATE: **8/19/2010**
PROJECT MANAGER: **A. GAMBLE** DRAWN BY: **M. MILLER**
DESIGNED BY: **M. MILLER** CHECKED BY: **A. GAMBLE**
WEATHERSFIELD VT-131 EB 12 SHEET **133** OF **175**

DIRECTION	MILEPOINT	LOCATION CODE (SHEET 2)	SIGN CODE	WIDTH (IN)	HEIGHT (IN)	SHEETING REMARKS	SIGN LEGEND	NEW SIGNS "A"	NEW SIGNS "B"	EXISTING SIGNS RETAIN	EXISTING SIGNS SALVAGE FROM	EXISTING SIGNS SALVAGE TO	EXISTING SIGNS REMOVE	EXIST POST RETAIN	EXIST POST REMOVE	NUMBER OF NEW POSTS	SQUARE STEEL (IN) 1.75 (LB / FT) 1.88	SQUARE STEEL (IN) 2.00 (LB / FT) 2.42	SQUARE STEEL (IN) 2.50 (LB / FT) 3.35	TUBULAR STEEL Ø (IN) FOUNDATION	TUBULAR STEEL Ø (IN) 3.00 (LB / FT) 7.60	TUBULAR STEEL Ø (IN) 3.50 (LB / FT) 9.00	TUBULAR STEEL Ø (IN) 4.00 (LB / FT) 10.80	TUBULAR STEEL Ø (IN) 5.00 (LB / FT) 14.60	SIGN FRAME REQUIRED	REMARKS	SIGN DETAIL: DETAIL IN SHS	SIGN DETAIL: DETAIL ON SHEET NUMBER	SIGN DETAIL: DETAIL ON STD SHEET NUMBER
WEATHERSFIELD EB							FY-FLUORESCENT YELLOW FYG-FLUORESCENT YELLOW GREEN																			"SHS"-STANDARD HIGHWAY SIGNS			
EB	5.856	D	R1-1	30	30		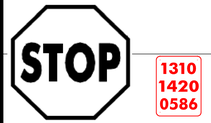 1310 1420 0586						1		X													
		D	R1-1	30	30			6.25								1		13.0' X								X		
EB	5.955	A	VD-062B	72	16		BUSINESS DIRECTORY SIGN			1				X												WELLWOOD ORCHARDS ===>			
		A	VD-062AS	72	16		BUSINESS DIRECTORY SIGN			1																CROWN POINT CC ===>			
EB	6.125	A	W2-2R	30	30								1		X													
		A	W2-2R	30	30			6.25								1		11.75' X								X		
EB	6.200	C	VR-017	24	30								1		X												WEATHERSFIELD CENTER ROAD (TH-1)			
		C	VR-017	24	30			5.00								1		13.0' X									6	
EB	6.210	D	R1-1	30	30								1		X													
		D	R1-1	30	30			6.25								1		11.75' X								X		
EB	6.240	A	M3-2	24	12								1		X													
		A	M1-5	30	24								1															
		A	M3-2	24	12		1310 1420 0621	2.00								1		13.0' X						GREEN ON WHITE	X		
		A	M1-5	30	24			5.00																					E-136B
EB	6.263	A	W1-2L	30	30		LEFT CURVE						1		X													
							SHEET TOTALS	30.75 SF	0.00 SF	2 EA	0 EA	0 EA	7 EA	0 EA	0 EA	5 EA	62.5 ~~75~~ FT											
							TOWN DIRECTIONAL TOTALS	778.3	0.0	47.0	9.0	9.0	180	0.0	0.0	108	1620.0											

SIGN SUMMARY SHEET

VERMONT AGENCY OF TRANSPORTATION

PROJECT NAME: STATEWIDE SOUTHEAST REGION
PROJECT NUMBER: STPG SIGN (31)

FILE NAME: WEATHERSFIELD EASTBOUND
PROJECT MANAGER: A. GAMBLE
DESIGNED BY: M. MILLER
WEATHERSFIELD VT-131 EB 13

PLOT DATE: 8/19/2010
DRAWN BY: M. MILLER
CHECKED BY: A. GAMBLE

DIRECTION	MILEPOINT	LOCATION CODE (SHEET 2)	SIGN CODE	WIDTH (IN)	HEIGHT (IN)	SHEETING REMARKS	SIGN LEGEND	NEW SIGNS "A"	NEW SIGNS "B"	EXISTING SIGNS RETAIN	EXISTING SIGNS SALVAGE FROM	EXISTING SIGNS SALVAGE TO	EXISTING SIGNS REMOVE	EXIST POST RETAIN	EXIST POST REMOVE	NUMBER OF NEW POSTS	SQUARE STEEL (IN) 1.75 (LB / FT) 1.88	SQUARE STEEL (IN) 2.00 (LB / FT) 2.42	SQUARE STEEL (IN) 2.50 (LB / FT) 3.35	TUBULAR STEEL Ø (IN) FOUNDATION	TUBULAR STEEL Ø (IN) 3.00 (LB / FT) 7.60	TUBULAR STEEL Ø (IN) 3.50 (LB / FT) 9.00	TUBULAR STEEL Ø (IN) 4.00 (LB / FT) 10.80	TUBULAR STEEL Ø (IN) 5.00 (LB / FT) 14.60	SIGN FRAME REQUIRED	REMARKS	SIGN DETAIL: DETAIL IN SHS	SIGN DETAIL: DETAIL ON SHEET NUMBER	SIGN DETAIL: DETAIL ON STD SHEET NUMBER
WEATHERSFIELD EB							FY-FLUORESCENT YELLOW FYG-FLUORESCENT YELLOW GREEN																			"SHS"-STANDARD HIGHWAY SIGNS			
EB	6.310	A	W1-4L	30	30			6.25								1		14.5' X								INSTALL BEHIND RAIL 25 FEET ± IN ADVANCE OF (WEST OF) THE SPEED LIMIT 50 SIGN	X		
EB	6.315	A	R2-1	24	30		SPEED LIMIT 50						1		X														
EB	6.545	A	S3-1	30	30		SCHOOL BUS STOP AHEAD						1		X														
EB	6.712	A	W1-4L	30	30		REVERSE CURVE LEFT						1		X												TO BE REPLACED FURTHER AHEAD			
		A	W13-1	18	18		35 MPH (PLAQUE)						1																
EB	6.792	A	W1-4L	30	30			6.25								1		16.0' X								INSTALL BEHIND RAIL 425 FT ± EAST OF THE PREVIOUS POSITION	X		
		A	W13-1	18	18			2.25																				X		
EB	7.210	A	VW-133	30	30		HIDDEN DRIVE LEFT						1		X														
		A	W11-7	30	30		EQUESTRIAN SYMBOL						1																
		A	W11-7	30	30			6.25								1		16.0' X								STILL VALID	X		
EB	7.246	A	W2-2R	30	30		RIGHT SIDE ROAD (SYMBOL)						1		X												TO BE REPLACED FURTHER AHEAD			
		A	VW-133	30	30			6.25								1		13.75' X								MAINTAIN 10 FT MIN TO UTILITY POLE; NOTE CHANGE TO **DRIVES**			E-154
EB	7.297	A	S3-1	30	30		SCHOOL BUS STOP AHEAD						1		X														
EB	7.325	A	W2-2R	30	30			6.25								1		16.75' X								INSTALL 150 FEET ± EAST OF THE JUST-REMOVED SCHOOL BUS STOP AHEAD SIGN	X		
EB	7.398	A	W3-5	36	36						1		1		X												PAY FOR REMOVAL			
							SHEET TOTALS	33.50	0.00	0	1	0	9 ~~8~~	0	0	5		77.0 ~~75~~											
								SF	SF	EA	EA	EA	EA	EA	EA	EA		FT											
							TOWN DIRECTIONAL TOTALS	778.3	0.0	47.0	9.0	9.0	180	0.0	0.0	108		1620.0											

SIGN SUMMARY SHEET

VERMONT AGENCY OF TRANSPORTATION

PROJECT NAME: **STATEWIDE SOUTHEAST REGION**
PROJECT NUMBER: **STPG SIGN (31)**

FILE NAME: **WEATHERSFIELD EASTBOUND** PLOT DATE: **8/19/2010**
PROJECT MANAGER: **A. GAMBLE** DRAWN BY: **M. MILLER**
DESIGNED BY: **M. MILLER** CHECKED BY: **A. GAMBLE**
WEATHERSFIELD VT-131 EB 14 SHEET **135** OF **175**

DIRECTION	MILEPOINT	LOCATION CODE (SHEET 2)	SIGN CODE	WIDTH (IN)	HEIGHT (IN)	SHEETING REMARKS	SIGN LEGEND	NEW SIGNS "A"	NEW SIGNS "B"	EXISTING SIGNS RETAIN	EXISTING SIGNS SALVAGE FROM	EXISTING SIGNS SALVAGE TO	EXISTING SIGNS REMOVE	EXIST POST RETAIN	EXIST POST REMOVE	NUMBER OF NEW POSTS	SQUARE STEEL (IN) (LB / FT) 1.75 / 1.88	SQUARE STEEL (IN) (LB / FT) 2.00 / 2.42	SQUARE STEEL (IN) (LB / FT) 2.50 / 3.35	TUBULAR STEEL Ø (IN) FOUNDATION	TUBULAR STEEL Ø (IN) (LB / FT) 3.00 / 7.60	TUBULAR STEEL Ø (IN) (LB / FT) 3.50 / 9.00	TUBULAR STEEL Ø (IN) (LB / FT) 4.00 / 10.80	TUBULAR STEEL Ø (IN) (LB / FT) 5.00 / 14.60	SIGN FRAME REQUIRED	REMARKS	SIGN DETAIL: DETAIL IN SHS	SIGN DETAIL: DETAIL ON SHEET NUMBER	SIGN DETAIL: DETAIL ON STD SHEET NUMBER
WEATHERSFIELD EB							FY-FLUORESCENT YELLOW FYG-FLUORESCENT YELLOW GREEN																			"SHS"-STANDARD HIGHWAY SIGNS			
EB	7.393	A	W3-5	36	36		SPEED REDUCTION 40 MPH					1				2		15.5' 15.0' X							SIGN WAS REPLACED IN 2007; SALVAGE ONTO A NEW SET OF POSTS			
EB	7.435	C	--	24	30		LEGAL LOAD LIMIT 8 TONS						1		X											LAVIGNE ROAD (TH-102)			
		C	VR-017	24	30			5.00								1		14.0' X								NEW SIGN HAS DIFFERENT TEXT COMPARED TO EXISTING SIGN		6	
EB	7.441	D	R1-1	30	30		STOP 1310 1420 0744						1		X														
		D	R1-1	30	30			6.25								1		12.5' X									X		
EB	7.470	A	VD-018A	30	18		Ascutney Jct I-91 1						1		X														
		A	VD-018	30	18			3.75								1		15.0' X										9	
EB	7.508	A	R2-1	30	36		SPEED LIMIT 40			1				X												SIGN WAS REPLACED IN 2007			
EB	7.660	C	VR-017	24	30		LEGAL LOAD LIMIT 24,000 POUNDS						1		X											GOULDEN RIDGE ROAD (TH-46)			
		C	VR-017	24	30			5.00								1		12.5' X										6	
EB	7.670	D	R1-1	30	30		1310 1420 0767 STOP			1				X												SIGN WAS REPLACED IN 2007			
EB	7.768	A	R2-1	24	30		SPEED LIMIT 40						1		X											SIGN WAS REPLACED IN 2007 BUT HAS SLIGHT DAMAGE			
		A	R2-1	24	30			5.00								1		14.75' X									X		
EB	7.928	A	W11-8	36	36								1		X														
		A	W11-8	30	30			6.25								1		15.75' X									X		
							SHEET TOTALS	31.25	0.00	2	0	1	6	0	0	8		115.0 ~~120~~											
								SF	SF	EA	EA	EA	EA	EA	EA	EA		FT											
							TOWN DIRECTIONAL TOTALS	778.3	0.0	47.0	9.0	9.0	180	0.0	0.0	108		1620.0											

SIGN SUMMARY SHEET

VERMONT AGENCY OF TRANSPORTATION

PROJECT NAME: **STATEWIDE SOUTHEAST REGION**
PROJECT NUMBER: **STPG SIGN (31)**

FILE NAME: **WEATHERSFIELD EASTBOUND** PLOT DATE: **8/19/2010**
PROJECT MANAGER: **A. GAMBLE** DRAWN BY: **M. MILLER**
DESIGNED BY: **M. MILLER** CHECKED BY: **A. GAMBLE**
WEATHERSFIELD VT-131 EB 15 SHEET **136** OF **175**

DIRECTION	MILEPOINT	LOCATION CODE (SHEET 2)	SIGN CODE	WIDTH (IN)	HEIGHT (IN)	SHEETING REMARKS	SIGN LEGEND	NEW SIGNS "A"	NEW SIGNS "B"	EXISTING SIGNS RETAIN	EXISTING SIGNS SALVAGE FROM	EXISTING SIGNS SALVAGE TO	EXISTING SIGNS REMOVE	EXIST POST RETAIN	EXIST POST REMOVE	NUMBER OF NEW POSTS	SQUARE STEEL (IN) 1.75 (LB / FT) 1.88	SQUARE STEEL (IN) 2.00 (LB / FT) 2.42	SQUARE STEEL (IN) 2.50 (LB / FT) 3.35	TUBULAR STEEL Ø (IN) FOUNDATION	TUBULAR STEEL Ø (IN) 3.00 (LB / FT) 7.60	TUBULAR STEEL Ø (IN) 3.50 (LB / FT) 9.00	TUBULAR STEEL Ø (IN) 4.00 (LB / FT) 10.80	TUBULAR STEEL Ø (IN) 5.00 (LB / FT) 14.60	SIGN FRAME REQUIRED	REMARKS	SIGN DETAIL: DETAIL IN SHS	SIGN DETAIL: DETAIL ON SHEET NUMBER	SIGN DETAIL: DETAIL ON STD SHEET NUMBER
WEATHERSFIELD EB							FY-FLUORESCENT YELLOW FYG-FLUORESCENT YELLOW GREEN																			"SHS"-STANDARD HIGHWAY SIGNS			
EB	7.998	A	R2-1	24	30		SPEED LIMIT 40 1310 1420 0800			~~1~~			1	~~X~~	X					THIS WAS AN OLD SIGN, SO IT WAS REPLACED.						SEE WB MM 7.998 ~~SIGN WAS REPLACED IN 2007~~			
		A	R2-1	24	30			5.00								1		14.75' X									X	
EB	8.028	A	M2-1	21	15								1		X													
		A	M1-1	24	24								1															
		A	M2-1	21	15		JCT INTERSTATE 91	2.19								1		13.75' X								WHITE ON BLUE	X	
		A	M1-1	24	24			4.00																			X	
EB	8.054	A	VR-644P	24	12		BEGIN			1				X														
		A	R8-3A	24	24		NO PARKING (SYMBOL)			1																		
EB	8.078	A	M4-6P	24	12		END			1				X														
		A	R8-3A	24	24		NO PARKING (SYMBOL)			1																		
EB	8.086	A	D1-1A	72	10		^UP Ascutney 1			1				X													ALL SIGNS AS-NEW, RETAIN ALL			
		A	D1-1A	72	10		^UP Claremont N.H. 5			1																		
		A	D1-1A	72	10		Springfield 10 --->			1																		
		A	D1-1A	72	10		Brattleboro 42 --->			1																		
EB	8.101	A	D4-2	30	36		PARK & RIDE (BACK-TO-BACK)			1				X													BOTH SIGNS AS-NEW, RETAIN			
							SHEET TOTALS	11.19	0.00	10	0	0	~~3~~ 2	0	0	2			~~28.5~~ ~~30~~									
								SF	SF	EA	EA	EA	EA	EA	EA	EA			FT									
							TOWN DIRECTIONAL TOTALS	778.3	0.0	47.0	9.0	9.0	180	0.0	0.0	108			1620.0									

SIGN SUMMARY SHEET

VERMONT AGENCY OF TRANSPORTATION

PROJECT NAME: **STATEWIDE SOUTHEAST REGION**
PROJECT NUMBER: **STPG SIGN (31)**

FILE NAME: **WEATHERSFIELD EASTBOUND** PLOT DATE: **8/19/2010**
PROJECT MANAGER: **A. GAMBLE** DRAWN BY: **M. MILLER**
DESIGNED BY: **M. MILLER** CHECKED BY: **A. GAMBLE**
WEATHERSFIELD VT-131 EB 16 SHEET **137** OF **175**

DIRECTION	MILEPOINT	LOCATION CODE (SHEET 2)	SIGN CODE	WIDTH (IN)	HEIGHT (IN)	SHEETING REMARKS	SIGN LEGEND	NEW SIGNS		EXISTING SIGNS				EXIST POST		NUMBER OF NEW POSTS	SQUARE STEEL (IN)			TUBULAR STEEL Ø (IN)				SIGN FRAME REQUIRED	REMARKS	SIGN DETAIL		
								"A"	"B"	RETAIN	SALVAGE FROM	SALVAGE TO	REMOVE	RETAIN	REMOVE		1.75 (LB / FT) 1.88	2.00 (LB / FT) 2.42	2.50 (LB / FT) 3.35	FOUNDATION	3.00 (LB / FT) 7.60	3.50 (LB / FT) 9.00	4.00 (LB / FT) 10.80	5.00 (LB / FT) 14.60			DETAIL IN SHS	DETAIL ON SHEET NUMBER	DETAIL ON STD SHEET NUMBER
WEATHERSFIELD EB							FY-FLUORESCENT YELLOW FYG-FLUORESCENT YELLOW GREEN																		"SHS"-STANDARD HIGHWAY SIGNS			
		B	D4-2	30	36		PARK & RIDE (BACK-TO-BACK)			1																		
EB	8.110	A	M3-1	24	12								1	X														
		A	M1-1	24	24								1												RETAIN THE EXISTING TUBULAR POSTS; REPLACE THE SIGN FRAME			
		A	M6-3	21	15								1														
		A	M4-5	24	12								1														
		A	M1-5	24	24		LARGE 12-SIGN ROUTE MARKER ASSEMBLY						1															
		A	M6-3	21	15								1														
		A	M3-2	24	12								1														
		A	M1-5	30	24								1														
		A	M6-3	21	15								1														
		A	M3-3	24	12								1														
		A	M1-1	24	24								1														
		A	M6-1	21	15								1														
		A	M3-1	24	12		(ASSEMBLY SHOWN ON NEXT PAGE)	2.00																	# 3B	WHITE ON BLUE; (EXISTING POSTS BEING RETAINED BUT WITH A NEW SIGN FRAME)	X		
		A	M1-1	24	24			4.00																		X		
							SHEET TOTALS	6.00	0.00	1	0	0	12	0	0	0	0											
								SF	SF	EA	EA	EA	EA	EA	EA	EA	FT											
							TOWN DIRECTIONAL TOTALS	778.3	0.0	47.0	9.0	9.0	180	0.0	0.0	108	1620.0											

SIGN SUMMARY SHEET

VERMONT AGENCY OF TRANSPORTATION

PROJECT NAME: **STATEWIDE SOUTHEAST REGION**
PROJECT NUMBER: **STPG SIGN (31)**

FILE NAME: **WEATHERSFIELD EASTBOUND** PLOT DATE: **8/19/2010**
PROJECT MANAGER: **A. GAMBLE** DRAWN BY: **M. MILLER**
DESIGNED BY: **M. MILLER** CHECKED BY: **A. GAMBLE**
WEATHERSFIELD VT-131 EB 17 SHEET **138** OF **175**

DIRECTION	MILEPOINT	LOCATION CODE (SHEET 2)	SIGN CODE	WIDTH (IN)	HEIGHT (IN)	SHEETING REMARKS	SIGN LEGEND	NEW SIGNS "A"	NEW SIGNS "B"	EXISTING SIGNS RETAIN	EXISTING SIGNS SALVAGE FROM	EXISTING SIGNS SALVAGE TO	EXISTING SIGNS REMOVE	EXIST POST RETAIN	EXIST POST REMOVE	NUMBER OF NEW POSTS	SQUARE STEEL (IN) 1.75 (LB / FT) 1.88	SQUARE STEEL (IN) 2.00 (LB / FT) 2.42	SQUARE STEEL (IN) 2.50 (LB / FT) 3.35	TUBULAR STEEL Ø (IN) FOUNDATION	TUBULAR STEEL Ø (IN) 3.00 (LB / FT) 7.60	TUBULAR STEEL Ø (IN) 3.50 (LB / FT) 9.00	TUBULAR STEEL Ø (IN) 4.00 (LB / FT) 10.80	TUBULAR STEEL Ø (IN) 5.00 (LB / FT) 14.60	SIGN FRAME REQUIRED	REMARKS	SIGN DETAIL: DETAIL IN SHS	SIGN DETAIL: DETAIL ON SHEET NUMBER	SIGN DETAIL: DETAIL ON STD SHEET NUMBER
WEATHERSFIELD EB							FY-FLUORESCENT YELLOW FYG-FLUORESCENT YELLOW GREEN																			"SHS"-STANDARD HIGHWAY SIGNS			
		A	M6-3	21	15		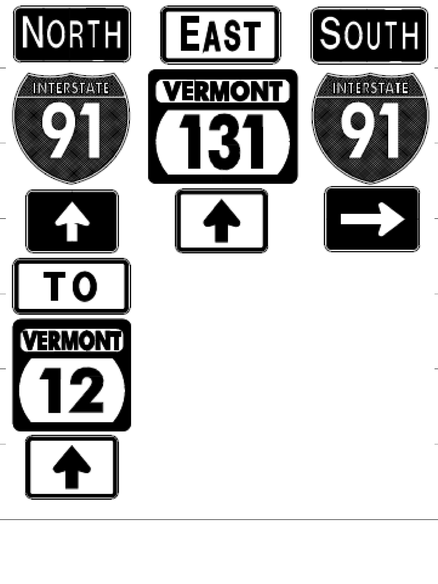	2.19																	WHITE ON BLUE	X		
		A	M4-5	24	12			2.00																			GREEN ON WHITE	X		
		A	M1-5	24	24			4.00																						E-136B
		A	M6-3	21	15			2.19																			GREEN ON WHITE	X		
		A	M3-2	24	12			2.00																			GREEN ON WHITE	X		
		A	M1-5	30	24			5.00																						E-136B
		A	M6-3	21	15			2.19																			GREEN ON WHITE	X		
		A	M3-3	24	12			2.00																			WHITE ON BLUE	X		
		A	M1-1	24	24			4.00																				X		
		A	M6-1	21	15			2.19																			WHITE ON BLUE	X		
EB	8.124	A	M3-3	24	12								1		X															
		A	M1-1	24	24								1																	
		A	M6-1	21	15		(6) SIGN ROUTE MARKER ASSEMBLY, INSTALLED BACK-TO-BACK						1																	
		B	M3-3	24	12								1																	
		B	M1-1	24	24								1																	
							SHEET TOTALS	27.76	0.00	0	0	0	5	0	0	0	0													
								SF	SF	EA	EA	EA	EA	EA	EA	EA	FT													
							TOWN DIRECTIONAL TOTALS	778.3	0.0	47.0	9.0	9.0	180	0.0	0.0	108	1620.0													

SIGN SUMMARY SHEET

VERMONT AGENCY OF TRANSPORTATION

PROJECT NAME: STATEWIDE SOUTHEAST REGION
PROJECT NUMBER: STPG SIGN (31)

FILE NAME: WEATHERSFIELD EASTBOUND
PROJECT MANAGER: A. GAMBLE
DESIGNED BY: M. MILLER
WEATHERSFIELD VT-131 EB 18

PLOT DATE: 8/19/2010
DRAWN BY: M. MILLER
CHECKED BY: A. GAMBLE
SHEET 139 OF 175

DIRECTION	MILEPOINT	LOCATION CODE (SHEET 2)	SIGN CODE	WIDTH (IN)	HEIGHT (IN)	SHEETING REMARKS	SIGN LEGEND	NEW SIGNS "A"	NEW SIGNS "B"	EXISTING SIGNS RETAIN	EXISTING SIGNS SALVAGE FROM	EXISTING SIGNS SALVAGE TO	EXISTING SIGNS REMOVE	EXIST POST RETAIN	EXIST POST REMOVE	NUMBER OF NEW POSTS	SQUARE STEEL (IN) 1.75 (LB / FT) 1.88	SQUARE STEEL (IN) 2.00 (LB / FT) 2.42	SQUARE STEEL (IN) 2.50 (LB / FT) 3.35	TUBULAR STEEL Ø (IN) FOUNDATION	TUBULAR STEEL Ø (IN) 3.00 (LB / FT) 7.60	TUBULAR STEEL Ø (IN) 3.50 (LB / FT) 9.00	TUBULAR STEEL Ø (IN) 4.00 (LB / FT) 10.80	TUBULAR STEEL Ø (IN) 5.00 (LB / FT) 14.60	SIGN FRAME REQUIRED	REMARKS	SIGN DETAIL: DETAIL IN SHS	SIGN DETAIL: DETAIL ON SHEET NUMBER	SIGN DETAIL: DETAIL ON STD SHEET NUMBER
WEATHERSFIELD EB							FY-FLUORESCENT YELLOW FYG-FLUORESCENT YELLOW GREEN																			"SHS"-STANDARD HIGHWAY SIGNS			
EB	8.124	B	M6-1	21	15								1															
		A	M3-3	24	12		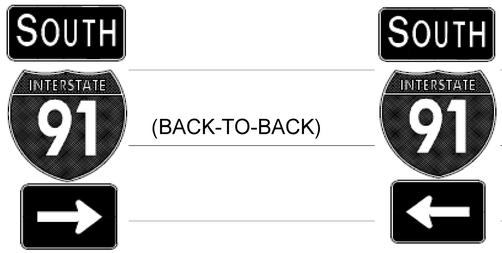	2.00								1		X							WHITE ON BLUE	X		
		A	M1-1	24	24			4.00																			X		
		A	M6-1	21	15			2.19																		WHITE ON BLUE	X		
		B	M3-3	24	12			2.00																		WHITE ON BLUE	X		
		B	M1-1	24	24			4.00																		(BACK-TO-BACK SIGN ASSEMBLY)	X		
		B	M6-1	21	15			2.19																		WHITE ON BLUE	X		
EB	8.146	C	M3-2	24	12								1	X														
		C	M1-5	30	24								1													RETAIN THE EXISTING TUBULAR POSTS; REPLACE THE SIGN FRAME			
		C	M6-1	21	15								1															
		C	M4-5	24	12								1															
		C	M1-5	24	24								1															
		C	M6-1	21	15		LARGE 12-SIGN ROUTE MARKER ASSEMBLY (FACES SB-OFF RAMP, IN "C" POSITION)																						
		C	M4-5	24	12								1															
		C	M1-4	24	24								1															
							SHEET TOTALS	16.38	0.00	0	0	0	9	0	0	1		15											
								SF	SF	EA	EA	EA	EA	EA	EA	EA		FT											
							TOWN DIRECTIONAL TOTALS	778.3	0.0	47.0	9.0	9.0	180	0.0	0.0	108		1620.0											

SIGN SUMMARY SHEET

VERMONT AGENCY OF TRANSPORTATION

PROJECT NAME: **STATEWIDE SOUTHEAST REGION**
PROJECT NUMBER: **STPG SIGN (31)**

FILE NAME: **WEATHERSFIELD EASTBOUND** PLOT DATE: **8/19/2010**
PROJECT MANAGER: **A. GAMBLE** DRAWN BY: **M. MILLER**
DESIGNED BY: **M. MILLER** CHECKED BY: **A. GAMBLE**
WEATHERSFIELD VT-131 EB 19 SHEET **140** OF **175**

DIRECTION	MILEPOINT	LOCATION CODE (SHEET 2)	SIGN CODE	WIDTH (IN)	HEIGHT (IN)	SHEETING REMARKS	SIGN LEGEND	NEW SIGNS "A"	NEW SIGNS "B"	EXISTING SIGNS RETAIN	EXISTING SIGNS SALVAGE FROM	EXISTING SIGNS SALVAGE TO	EXISTING SIGNS REMOVE	EXIST POST RETAIN	EXIST POST REMOVE	NUMBER OF NEW POSTS	SQUARE STEEL (IN) 1.75 (LB / FT) 1.88	SQUARE STEEL (IN) 2.00 (LB / FT) 2.42	SQUARE STEEL (IN) 2.50 (LB / FT) 3.35	TUBULAR STEEL Ø (IN) FOUNDATION	TUBULAR STEEL Ø (IN) 3.00 (LB / FT) 7.60	TUBULAR STEEL Ø (IN) 3.50 (LB / FT) 9.00	TUBULAR STEEL Ø (IN) 4.00 (LB / FT) 10.80	TUBULAR STEEL Ø (IN) 5.00 (LB / FT) 14.60	SIGN FRAME REQUIRED	REMARKS	SIGN DETAIL: DETAIL IN SHS	SIGN DETAIL: DETAIL ON SHEET NUMBER	SIGN DETAIL: DETAIL ON STD SHEET NUMBER
WEATHERSFIELD EB							FY-FLUORESCENT YELLOW FYG-FLUORESCENT YELLOW GREEN																			"SHS"-STANDARD HIGHWAY SIGNS			
		C	M6-1	21	15								1															
		C	M3-4	24	12								1															
		C	M1-5	30	24								1															
		C	M6-1	21	15								1															
		C	M3-2	24	12		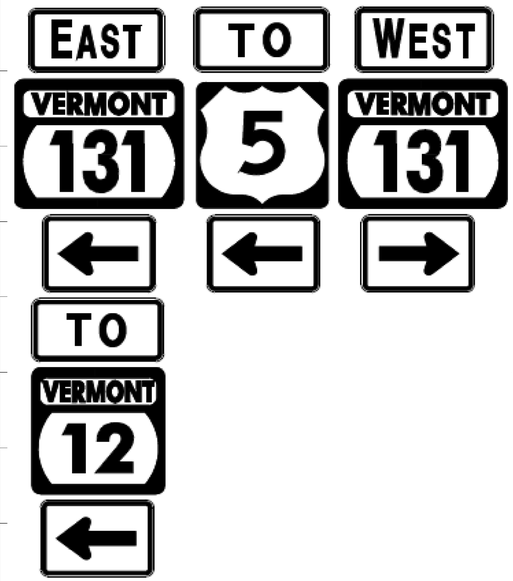	2.00																# 3B	GREEN ON WHITE; (EXISTING POSTS BEING RETAINED BUT WITH A NEW SIGN FRAME)	X		
		C	M1-5	30	24			5.00																				E-136B
		C	M6-1	21	15			2.19																			GREEN ON WHITE	X		
		C	M4-5	24	12			2.00																			GREEN ON WHITE	X		
		C	M1-5	24	24			4.00																						E-136B
		C	M6-1	21	15			2.19																			GREEN ON WHITE	X		
		C	M4-5	24	12			2.00																			BLACK ON WHITE	X		
		C	M1-4	24	24			4.00																				X		
		C	M6-1	21	15			2.19																			BLACK ON WHITE	X		
		C	M3-4	24	12			2.00																			GREEN ON WHITE	X		
		C	M1-5	30	24			5.00																						E-136B
SIGN SUMMARY SHEET							SHEET TOTALS	32.57	0.00	0	0	0	4	0	0	0	0												
								SF	SF	EA	EA	EA	EA	EA	EA	EA	FT												
VERMONT AGENCY OF TRANSPORTATION							TOWN DIRECTIONAL TOTALS	778.3	0.0	47.0	9.0	9.0	180	0.0	0.0	108	1620.0												

PROJECT NAME: **STATEWIDE SOUTHEAST REGION**
PROJECT NUMBER: **STPG SIGN (31)**
FILE NAME: **WEATHERSFIELD EASTBOUND** PLOT DATE: **8/19/2010**
PROJECT MANAGER: **A. GAMBLE** DRAWN BY: **M. MILLER**
DESIGNED BY: **M. MILLER** CHECKED BY: **A. GAMBLE**
WEATHERSFIELD VT-131 EB 20 SHEET **141** OF **175**

DIRECTION	MILEPOINT	LOCATION CODE (SHEET 2)	SIGN CODE	WIDTH (IN)	HEIGHT (IN)	SHEETING REMARKS	SIGN LEGEND	NEW SIGNS		EXISTING SIGNS				EXIST POST		NUMBER OF NEW POSTS	SQUARE STEEL (IN)			TUBULAR STEEL Ø (IN)				SIGN FRAME REQUIRED	REMARKS	SIGN DETAIL		
																	1.75	2.00	2.50	3.00	3.50	4.00	5.00					
																	(LB / FT)			(LB / FT)							
								"A"	"B"	RETAIN	SALVAGE FROM	SALVAGE TO	REMOVE	RETAIN	REMOVE		1.88	2.42	3.35	FOUNDATION	7.60	9.00	10.80	14.60			DETAIL IN SHS	DETAIL ON SHEET NUMBER	DETAIL ON STD SHEET NUMBER
WEATHERSFIELD EB							FY-FLUORESCENT YELLOW FYG-FLUORESCENT YELLOW GREEN																		"SHS"-STANDARD HIGHWAY SIGNS			
		C	M6-1	21	15			2.19																	**GREEN ON WHITE**	X		
EB	8.215	A	D1-1A	72	12		^UP ASCUTNEY 1			1				X											ALL REPLACED IN 2007, RETAIN ALL			
		A	D1-1A	72	12		^UP WINDSOR 5			1																		
		A	D1-1M	72	12		^UP CLAREMONT NH 5			1																		
		A	D1-1A	72	12		<--- (90 DEG) HARTLAND 10			1																		
		A	D1-1A	72	12		<--- (90 DEG) WHITE RIVER JCT 18			1																		
EB	8.270	A	M3-2	24	12								1		X													
		A	M1-5	30	24								1															
		A	M6-3	21	15								1															
		A	M4-5	24	12		(9) SIGN ROUTE MARKER ASSEMBLY						1															
		A	M1-4	24	24								1															
		A	M6-3	21	15								1															
		A	M4-5	24	12								1															
		A	M1-5	24	24								1															
		A	M6-3	21	15								1															
							SHEET TOTALS	2.19	0.00	5	0	0	9	0	0	0	0											
								SF	SF	EA	EA	EA	EA	EA	EA	EA	FT											
							TOWN DIRECTIONAL TOTALS	778.3	0.0	47.0	9.0	9.0	180	0.0	0.0	108	1620.0											

SIGN SUMMARY SHEET

VERMONT AGENCY OF TRANSPORTATION

PROJECT NAME: **STATEWIDE SOUTHEAST REGION**
PROJECT NUMBER: **STPG SIGN (31)**

FILE NAME: **WEATHERSFIELD EASTBOUND**
PROJECT MANAGER: **A. GAMBLE**
DESIGNED BY: **M. MILLER**
WEATHERSFIELD VT-131 EB 21

PLOT DATE: **8/19/2010**
DRAWN BY: **M. MILLER**
CHECKED BY: **A. GAMBLE**
SHEET **142** OF **175**

DIRECTION	MILEPOINT	LOCATION CODE (SHEET 2)	SIGN CODE	WIDTH (IN)	HEIGHT (IN)	SHEETING REMARKS	SIGN LEGEND	NEW SIGNS "A"	NEW SIGNS "B"	EXISTING SIGNS RETAIN	EXISTING SIGNS SALVAGE FROM	EXISTING SIGNS SALVAGE TO	EXISTING SIGNS REMOVE	EXIST POST RETAIN	EXIST POST REMOVE	NUMBER OF NEW POSTS	SQUARE STEEL (IN) 1.75 (LB / FT) 1.88	SQUARE STEEL (IN) 2.00 (LB / FT) 2.42	SQUARE STEEL (IN) 2.50 (LB / FT) 3.35	TUBULAR STEEL Ø (IN) FOUNDATION	TUBULAR STEEL Ø (IN) 3.00 (LB / FT) 7.60	TUBULAR STEEL Ø (IN) 3.50 (LB / FT) 9.00	TUBULAR STEEL Ø (IN) 4.00 (LB / FT) 10.80	TUBULAR STEEL Ø (IN) 5.00 (LB / FT) 14.60	SIGN FRAME REQUIRED	REMARKS	SIGN DETAIL: DETAIL IN SHS	SIGN DETAIL: DETAIL ON SHEET NUMBER	SIGN DETAIL: DETAIL ON STD SHEET NUMBER
WEATHERSFIELD EB							FY-FLUORESCENT YELLOW FYG-FLUORESCENT YELLOW GREEN																			"SHS"-STANDARD HIGHWAY SIGNS			
EB	8.270	A	M3-2	24	12			2.00								2		16.5' 17.0' X							# 1A	**GREEN ON WHITE**	X		
		A	M1-5	30	24			5.00																				E-136B
		A	M4-5	24	12			2.00																		**GREEN ON WHITE**	X		
		A	M1-5	24	24			4.00																	INSTALL THE "TO VT-12" SIGNS ON THE LEFT POST, UNDER THE EAST VT-131 SIGNS			E-136B
		A	M4-5	24	12			2.00																		**BLACK ON WHITE**	X		
		A	M1-4	24	24			4.00																		INSTALL THE "TO US-5" SIGN ON THE RIGHT-SIDE POST.	X		
EB	8.287	C	VR-017	24	30								1		X											TENNEY HILL RD (TH-40)			
		C	VR-017	24	30			5.00								1		12.0' X										6
EB	8.297	D	R1-1	30	30		1310 1416 0831 STOP			1				X												REPLACED IN 2007			
EB	8.313	A	D1-1A	72	12		^UP ASCUTNEY 1			1				X												REPLACED IN 2007			
		A	D1-1A	72	12		^UP WINDSOR 5			1																			
		A	D1-1M	72	12		^UP CLAREMONT NH 5			1																			
EB	8.333	A	VD-062AS	72	16		BUSINESS DIRECTORY SIGN			1				X												RUNNING BEAR <===			
		A	VD-062BRN	72	16		BUSINESS DIRECTORY SIGN			1																WILGUS S.P. ===>			
		A	VD-062BRN	72	16		BUSINESS DIRECTORY SIGN			1																MT. ASCUTNEY S.P. <===			
							SHEET TOTALS	24.00	0.00	7	0	0	1	0	0	3		45.5 ~~45~~										
								SF	SF	EA	EA	EA	EA	EA	EA	EA		FT										
							TOWN DIRECTIONAL TOTALS	778.3	0.0	47.0	9.0	9.0	180	0.0	0.0	108		1620.0										

SIGN SUMMARY SHEET

VERMONT AGENCY OF TRANSPORTATION

PROJECT NAME: **STATEWIDE SOUTHEAST REGION**
PROJECT NUMBER: **STPG SIGN (31)**

FILE NAME: **WEATHERSFIELD EASTBOUND** PLOT DATE: **8/19/2010**
PROJECT MANAGER: **A. GAMBLE** DRAWN BY: **M. MILLER**
DESIGNED BY: **M. MILLER** CHECKED BY: **A. GAMBLE**
WEATHERSFIELD VT-131 EB 22 SHEET **143** OF **175**

DIRECTION	MILEPOINT	LOCATION CODE (SHEET 2)	SIGN CODE	WIDTH (IN)	HEIGHT (IN)	SHEETING REMARKS	SIGN LEGEND	NEW SIGNS "A"	NEW SIGNS "B"	EXISTING SIGNS RETAIN	EXISTING SIGNS SALVAGE FROM	EXISTING SIGNS SALVAGE TO	EXISTING SIGNS REMOVE	EXIST POST RETAIN	EXIST POST REMOVE	NUMBER OF NEW POSTS	SQUARE STEEL (IN) 1.75 (LB / FT) 1.88	SQUARE STEEL (IN) 2.00 (LB / FT) 2.42	SQUARE STEEL (IN) 2.50 (LB / FT) 3.35	TUBULAR STEEL Ø (IN) FOUNDATION	TUBULAR STEEL Ø (IN) 3.00 (LB / FT) 7.60	TUBULAR STEEL Ø (IN) 3.50 (LB / FT) 9.00	TUBULAR STEEL Ø (IN) 4.00 (LB / FT) 10.80	TUBULAR STEEL Ø (IN) 5.00 (LB / FT) 14.60	SIGN FRAME REQUIRED	REMARKS	SIGN DETAIL: DETAIL IN SHS	SIGN DETAIL: DETAIL ON SHEET NUMBER	SIGN DETAIL: DETAIL ON STD SHEET NUMBER
WEATHERSFIELD EB							FY-FLUORESCENT YELLOW FYG-FLUORESCENT YELLOW GREEN																			"SHS"-STANDARD HIGHWAY SIGNS			
EB	8.360	A	R2-1	24	30		SPEED LIMIT 40 1310 1420 0840						1		X					CONTRACTOR WAS ALLOWED TO USE HORIZONTAL BRACKETS					# 1	PROVIDE A NEW SIGN FRAME TO HELP BRACE THE ASSEMBLY			
		A	R2-1	24	30			5.00								1		14.25' X								INSTALL IN SAME POSITION AS REMOVAL, NEXT TO "NO PARKING BEGINS" SIGNS	X		
		A	VR-644	24	12		BEGIN			1	1	1	1	~~X~~	X	1		14.75' X		POST WAS DAMAGED, SO IT WAS REPLACED. WERE SALVAGED AND RE-ERECTED PAY FOR REMOVALS.						REPLACED IN 2007			
		A	R8-3A	24	24		NO PARKING (SYMBOL)			1	1	1	1																
EB	8.402	A	W3-3	36	36								1		X														
		A	W3-3	36	36			9.00								2		14.25' 14.75' X								INSTALL BEHIND RAIL IN SAME POSITION AS REMOVAL	X		
EB	8.434	A	VD-062AS	72	16		BUSINESS DIRECTORY SIGN			1				X												YANKEE MOTEL <===			
		A	VD-062AS	72	16		BUSINESS DIRECTORY SIGN			1																CASA DEL SOL <===			
		A	VD-062AS	72	16		BUSINESS DIRECTORY SIGN			1																GETAWAY MTN. C.G. ===>			
EB	8.450	A	M2-1	21	15		JCT						1		X											(EXISTING SIGNS ON A SINGLE POST)			
		A	M1-4	24	24		US 5						1																
		A	M2-1	21	15		JCT						1																
		A	M1-5	24	24		VT 12						1																
		A	M2-1	21	15		(SEE NEXT PAGE)	2.19								2		16.5' 17.0' X							# 1A	BLACK ON WHITE	X		
		A	M1-4	24	24			4.00																		US-5			E-136B
SIGN SUMMARY SHEET							SHEET TOTALS	20.19	0.00	5	~~2~~ 0	~~2~~ 0	~~8~~ 6	0	0	5										~~91.5~~ ~~75~~			
								SF	SF	EA	EA	EA	EA	EA	EA	EA										FT			
VERMONT AGENCY OF TRANSPORTATION							TOWN DIRECTIONAL TOTALS	778.3	0.0	47.0	9.0	9.0	180	0.0	0.0	108										1620.0			

PROJECT NAME: **STATEWIDE SOUTHEAST REGION**
PROJECT NUMBER: **STPG SIGN (31)**

FILE NAME: **WEATHERSFIELD EASTBOUND** PLOT DATE: **8/19/2010**
PROJECT MANAGER: **A. GAMBLE** DRAWN BY: **M. MILLER**
DESIGNED BY: **M. MILLER** CHECKED BY: **A. GAMBLE**
WEATHERSFIELD VT-131 EB 23 SHEET **144** OF **175**

DIRECTION	MILEPOINT	LOCATION CODE (SHEET 2)	SIGN CODE	WIDTH (IN)	HEIGHT (IN)	SHEETING REMARKS	SIGN LEGEND	NEW SIGNS "A"	NEW SIGNS "B"	EXISTING SIGNS RETAIN	EXISTING SIGNS SALVAGE FROM	EXISTING SIGNS SALVAGE TO	EXISTING SIGNS REMOVE	EXIST POST RETAIN	EXIST POST REMOVE	NUMBER OF NEW POSTS	SQUARE STEEL (IN) 1.75 (LB / FT) 1.88	SQUARE STEEL (IN) 2.00 (LB / FT) 2.42	SQUARE STEEL (IN) 2.50 (LB / FT) 3.35	TUBULAR STEEL Ø (IN) FOUNDATION	TUBULAR STEEL Ø (IN) 3.00 (LB / FT) 7.60	TUBULAR STEEL Ø (IN) 3.50 (LB / FT) 9.00	TUBULAR STEEL Ø (IN) 4.00 (LB / FT) 10.80	TUBULAR STEEL Ø (IN) 5.00 (LB / FT) 14.60	SIGN FRAME REQUIRED	REMARKS	SIGN DETAIL: DETAIL IN SHS	SIGN DETAIL: DETAIL ON SHEET NUMBER	SIGN DETAIL: DETAIL ON STD SHEET NUMBER
WEATHERSFIELD EB							FY-FLUORESCENT YELLOW FYG-FLUORESCENT YELLOW GREEN																			"SHS"-STANDARD HIGHWAY SIGNS			
		A	M2-1	21	15			2.19																	**GREEN ON WHITE;** INSTALL THE "JCT 12" SIGNS TO THE RIGHT OF "JCT 5"	X		
		A	M1-5	24	24			4.00																	VT-12			E-136B
		A	M4-6	24	12			2.00																	**GREEN ON WHITE;** INSTALL THE "END 131" SIGNS UNDER "JCT 5"	X		
		A	M1-5	30	24			5.00																	VT-131	X		
EB	8.484	J	R4-7	24	30								1		X										LOCATED IN THE CENTER MEDIAN ISLAND			
		J	OM1-1	18	18								1															
		K	OM1-1	18	18								1															
		J	R4-7	24	30			5.00								1	12.5' X									X		
		J	OM1-1	18	18			2.25																		X		
		K	OM1-1	18	18		(BACK-TO-BACK)	2.25																	INSTALL THIS CLUSTER ON BACK OF THE OTHER CLUSTER	X		
EB	8.484	A	D1-1A	72	12						1		1		X										ALL SIGNS IN AS-NEW CONDITION, REPLACED IN 2007 (POSTS ARE IN POOR CONDITION, HOWEVER)			
		A	D1-1A	72	12						1		1												PAY FOR REMOVALS			
		A	D1-1A	72	12		(6 SIGNS) DESTINATION AND HOSPITAL SIGNS				1		1																
		A	D1-1S	72	12						1		1															
		A	D9-2	24	24						1		1															
							SHEET TOTALS	22.69	0.00	0	5	0	~~8~~ 3	0	0	1	~~12.5~~ 15											
								SF	SF	EA	EA	EA	EA	EA	EA	EA	FT											
							TOWN DIRECTIONAL TOTALS	778.3	0.0	47.0	9.0	9.0	180	0.0	0.0	108	1620.0											

SIGN SUMMARY SHEET

VERMONT AGENCY OF TRANSPORTATION

PROJECT NAME: **STATEWIDE SOUTHEAST REGION**
PROJECT NUMBER: **STPG SIGN (31)**

FILE NAME: **WEATHERSFIELD EASTBOUND** PLOT DATE: **8/19/2010**
PROJECT MANAGER: **A. GAMBLE** DRAWN BY: **M. MILLER**
DESIGNED BY: **M. MILLER** CHECKED BY: **A. GAMBLE**
WEATHERSFIELD VT-131 EB 24 SHEET **145** OF **175**

DIRECTION	MILEPOINT	LOCATION CODE (SHEET 2)	SIGN CODE	WIDTH (IN)	HEIGHT (IN)	SHEETING REMARKS	SIGN LEGEND	NEW SIGNS		EXISTING SIGNS				EXIST POST		NUMBER OF NEW POSTS	SQUARE STEEL (IN)			TUBULAR STEEL Ø (IN)				SIGN FRAME REQUIRED	REMARKS	SIGN DETAIL		
								"A"	"B"	RETAIN	SALVAGE FROM	SALVAGE TO	REMOVE	RETAIN	REMOVE		1.75 (LB / FT) 1.88	2.00 (LB / FT) 2.42	2.50 (LB / FT) 3.35	FOUNDATION	3.00 (LB / FT) 7.60	3.50 (LB / FT) 9.00	4.00 (LB / FT) 10.80	5.00 (LB / FT) 14.60			DETAIL IN SHS	DETAIL ON SHEET NUMBER	DETAIL ON STD SHEET NUMBER
WEATHERSFIELD EB							FY-FLUORESCENT YELLOW FYG-FLUORESCENT YELLOW GREEN																		"SHS"-STANDARD HIGHWAY SIGNS			
EB	8.484	A	D9-2A	24	6						1		1													PAY FOR REMOVAL			
		A	D1-1A	72	12		^UP CLAREMONT 5					1				2			17.0' 18.5' X							SALVAGE ALL EXISTING SIGNS ONTO A NEW SET OF POSTS			
		A	D1-1A	72	12		<--- (90 DEG) ASCUTNEY					1																	
		A	D1-1A	72	12		<--- (90 DEG) WINDSOR 5					1																	
		A	D1-1S	72	12		<--- (90 DEG) MT ASCUTNEY SKI					1																	
		A	D9-2	24	24		HOSPITAL (SYMBOL)					1														INSTALL THE HOSPITAL SIGNS ON THE LEFT-SIDE POST			
		A	D9-2A	24	6		LEFT ARROW					1																	
EB	8.505	A	M4-6	24	12								1		X														
		A	R8-3A	24	24								1																
		A	M4-6	24	12		END	2.00								1	14.75' X									BLACK ON WHITE; INSTALL PLAQUE ON TOP	X		
		A	R8-3A	24	24		R	4.00																			X		
EB	8.532	A	M3-1	24	12		NORTH			1				X												ALL SIGNS IN AS-NEW CONDITION; POSTS OK			
		A	M1-4	24	24		US-5			1																			
		A	M6-1	21	15		<--- LEFT			1																			
		A	M3-3	24	12		SOUTH			1																			
SIGN SUMMARY SHEET							SHEET TOTALS	6.00	0.00	4	1	6	~~3~~ 2	0	0	3	~~50.25~~ 45											
								SF	SF	EA	EA	EA	EA	EA	EA	EA	FT											
VERMONT AGENCY OF TRANSPORTATION							TOWN DIRECTIONAL TOTALS	778.3	0.0	47.0	9.0	9.0	180	0.0	0.0	108	1620.0											

PROJECT NAME: **STATEWIDE SOUTHEAST REGION**
PROJECT NUMBER: **STPG SIGN (31)**

FILE NAME: **WEATHERSFIELD EASTBOUND** PLOT DATE: **8/19/2010**
PROJECT MANAGER: **A. GAMBLE** DRAWN BY: **M. MILLER**
DESIGNED BY: **M. MILLER** CHECKED BY: **A. GAMBLE**
WEATHERSFIELD VT-131 EB 25 SHEET **146** OF **175**

DIRECTION	MILEPOINT	LOCATION CODE (SHEET 2)	SIGN CODE	WIDTH (IN)	HEIGHT (IN)	SHEETING REMARKS	SIGN LEGEND	NEW SIGNS "A"	NEW SIGNS "B"	EXISTING SIGNS RETAIN	EXISTING SIGNS SALVAGE FROM	EXISTING SIGNS SALVAGE TO	EXISTING SIGNS REMOVE	EXIST POST RETAIN	EXIST POST REMOVE	NUMBER OF NEW POSTS	SQUARE STEEL (IN) 1.75 (LB / FT) 1.88	SQUARE STEEL (IN) 2.00 (LB / FT) 2.42	SQUARE STEEL (IN) 2.50 (LB / FT) 3.35	TUBULAR STEEL Ø (IN) FOUNDATION	TUBULAR STEEL Ø (IN) 3.00 (LB / FT) 7.60	TUBULAR STEEL Ø (IN) 3.50 (LB / FT) 9.00	TUBULAR STEEL Ø (IN) 4.00 (LB / FT) 10.80	TUBULAR STEEL Ø (IN) 5.00 (LB / FT) 14.60	SIGN FRAME REQUIRED	REMARKS	SIGN DETAIL: DETAIL IN SHS	SIGN DETAIL: DETAIL ON SHEET NUMBER	SIGN DETAIL: DETAIL ON STD SHEET NUMBER
WEATHERSFIELD EB							FY-FLUORESCENT YELLOW FYG-FLUORESCENT YELLOW GREEN																			"SHS"-STANDARD HIGHWAY SIGNS			
		A	M1-5	24	24		VT-12			1			1															
		A	M6-3	21	15		^UP ARROW			1																		
		A	M3-3	24	12		SOUTH			1																		
		A	M1-4	24	24		US-5			1																		
		A	M5-1	21	15		RIGHT ---> (90 DEG)			1																		
		A	M3-1	24	12		NORTH			1																		
		A	M1-5	24	24		VT-12			1																		
		A	M6-1	21	15		<--- LEFT			1																		
		A	M4-6	24	12		END						1														REMOVE ONLY THE "END VT-131" SIGNS; BEING INSTALLED NEW FURTHER BACK AT 8.435			
		A	M1-5	30	24		VT-131						1																
EB	8.558	A	VR-934	~~66~~ 48	~~36~~ 30								1		X														
		A	VR-934	48	30			10.00								2		13.75' 14.25'		X								6
EB	8.600	D	R3-2	24	24								1		X														
		D	R3-2	24	24			4.00								1		12.0' X									FACES GAS STATION DRIVE	X	
EB	8.628	J	OM1-1	18	18								1		X														
SIGN SUMMARY SHEET							SHEET TOTALS	14.00	0.00	8	0	0	5	0	0	3												
								SF	SF	EA	EA	EA	EA	EA	EA	EA			~~40.0~~ 45 FT									
VERMONT AGENCY OF TRANSPORTATION							TOWN DIRECTIONAL TOTALS	778.3	0.0	47.0	9.0	9.0	180	0.0	0.0	108			1620.0									

PROJECT NAME: **STATEWIDE SOUTHEAST REGION**
PROJECT NUMBER: **STPG SIGN (31)**

FILE NAME: **WEATHERSFIELD EASTBOUND** PLOT DATE: **8/19/2010**
PROJECT MANAGER: **A. GAMBLE** DRAWN BY: **M. MILLER**
DESIGNED BY: **M. MILLER** CHECKED BY: **A. GAMBLE**
WEATHERSFIELD VT-131 EB 26 SHEET **147** OF **175**

DIRECTION	MILEPOINT	LOCATION CODE (SHEET 2)	SIGN CODE	WIDTH (IN)	HEIGHT (IN)	SHEETING REMARKS	SIGN LEGEND	NEW SIGNS "A"	NEW SIGNS "B"	EXISTING SIGNS RETAIN	EXISTING SIGNS SALVAGE FROM	EXISTING SIGNS SALVAGE TO	EXISTING SIGNS REMOVE	EXIST POST RETAIN	EXIST POST REMOVE	NUMBER OF NEW POSTS	SQUARE STEEL (IN) 1.75 (LB / FT) 1.88	SQUARE STEEL (IN) 2.00 (LB / FT) 2.42	SQUARE STEEL (IN) 2.50 (LB / FT) 3.35	TUBULAR STEEL Ø (IN) FOUNDATION	TUBULAR STEEL Ø (IN) 3.00 (LB / FT) 7.60	TUBULAR STEEL Ø (IN) 3.50 (LB / FT) 9.00	TUBULAR STEEL Ø (IN) 4.00 (LB / FT) 10.80	TUBULAR STEEL Ø (IN) 5.00 (LB / FT) 14.60	SIGN FRAME REQUIRED	REMARKS	SIGN DETAIL: DETAIL IN SHS	SIGN DETAIL: DETAIL ON SHEET NUMBER	SIGN DETAIL: DETAIL ON STD SHEET NUMBER
WEATHERSFIELD EB							FY-FLUORESCENT YELLOW FYG-FLUORESCENT YELLOW GREEN																			"SHS"-STANDARD HIGHWAY SIGNS			
EB	8.628	K	R4-7	24	30								1																
		K	OM1-1	18	18								1																
		J	OM1-1	18	18			2.25								1		12.5' ~~X~~								FACES EB TRAFFIC AT END OF CENTER MEDIAN	X		
		K	R4-7	24	30			5.00																		FACES WB TRAFFIC AT END OF CENTER MEDIAN	X		
		K	OM1-1	18	18		(BACK-TO-BACK)	2.25																		FACES WB TRAFFIC AT END OF CENTER MEDIAN; INSTALL BACK TO BACK w/ EB FACING CLUSTER	X		
EB	~~8.628~~ ~~8.632~~	M	R10-12	24	30		THIS SIGN WAS INSTALLED ON THE BACKSIDE OF THE ASSEMBLY ABOVE. FACES EB TRAFFIC.			1			~~1~~																
SEE NOTE ABOVE MM.		N	R10-12	24	30					1			~~1~~														NOTE THAT REPLACEMENT SIGNS ARE SLIGHTLY LARGER THAN EXISTING SIGNS, PER 2009 MUTCD			
		M	R10-12	30	36		~~LEFT TURN YIELD ON GREEN~~ ~~(ON OVERHEAD SPAN WIRE)~~ SEE SHEET #172 WB MM. 8.640 ~~(BACK-TO-BACK)~~ LEFT TURN YIELD ON GREEN	7.50																		~~ATTACH TO SIGNAL SPAN WIRE, NO POST, FACES WB TRAFFIC~~	X		
		N	R10-12	30	36			7.50																		~~ATTACHED TO SIGNAL SPAN WIRE ON BACK OF OTHER SIGN, FACES EB TRAFFIC~~	X		
EB	8.640	A	M3-1	24	12								1	X													RETAIN THE EXISTING POSTS AND SIGN FRAME			
		A	M1-4	24	24		(12) SIGN ROUTE MARKER ASSEMBLY						1														THIS ASSEMBLY IS LOCATED AT THE S.E. CORNER OF THE SIGNALIZED INTERSECTION			
		A	M6-1	21	15								1																
		A	M3-1	24	12								1																
		A	M1-5	24	24								1																
		A	M6-1	21	15								1																
							SHEET TOTALS	24.50	0.00	~~2~~ 0	0	0	~~8~~ 10	0	0	1			~~12.5~~ 15										
								SF	SF	EA	EA	EA	EA	EA	EA	EA			FT										
							TOWN DIRECTIONAL TOTALS	778.3	0.0	47.0	9.0	9.0	180	0.0	0.0	108			1620.0										

SIGN SUMMARY SHEET

VERMONT AGENCY OF TRANSPORTATION

PROJECT NAME: **STATEWIDE SOUTHEAST REGION**
PROJECT NUMBER: **STPG SIGN (31)**

FILE NAME: **WEATHERSFIELD EASTBOUND** PLOT DATE: **8/19/2010**
PROJECT MANAGER: **A. GAMBLE** DRAWN BY: **M. MILLER**
DESIGNED BY: **M. MILLER** CHECKED BY: **A. GAMBLE**
WEATHERSFIELD VT-131 EB 27 SHEET **148** OF **175**

DIRECTION	MILEPOINT	LOCATION CODE (SHEET 2)	SIGN CODE	WIDTH (IN)	HEIGHT (IN)	SHEETING REMARKS	SIGN LEGEND	NEW SIGNS		EXISTING SIGNS				EXIST POST		NUMBER OF NEW POSTS	SQUARE STEEL (IN)			TUBULAR STEEL Ø (IN)				SIGN FRAME REQUIRED	REMARKS	SIGN DETAIL		
																	1.75	2.00	2.50	3.00	3.50	4.00	5.00					
																	(LB / FT)			(LB / FT)							
								"A"	"B"	RETAIN	SALVAGE FROM	SALVAGE TO	REMOVE	RETAIN	REMOVE		1.88	2.42	3.35	FOUNDATION	7.60	9.00	10.80	14.60			DETAIL IN SHS	DETAIL ON SHEET NUMBER	DETAIL ON STD SHEET NUMBER
WEATHERSFIELD EB							FY-FLUORESCENT YELLOW FYG-FLUORESCENT YELLOW GREEN																		"SHS"-STANDARD HIGHWAY SIGNS			
		A	M3-3	24	12								1															
		A	M1-5	24	24								1															
		A	M6-3	21	15								1															
		A	M3-3	24	12								1															
		A	M1-4	24	24								1															
		A	M6-1	21	15								1															
		A	M3-1	24	12				2.00														BLACK ON WHITE	X		
		A	M1-4	24	24				4.00																	X		
		A	M6-1	21	15				2.19																BLACK ON WHITE	X		
		A	M3-1	24	12				2.00																GREEN ON WHITE	X		
		A	M1-5	24	24				4.00																			E-136B
		A	M6-1	21	15				2.19																GREEN ON WHITE	X		
		A	M3-3	24	12				2.00																GREEN ON WHITE	X		
		A	M1-5	24	24				4.00																			E-136B
		A	M6-3	21	15				2.19																GREEN ON WHITE	X		
SHEET TOTALS								24.57	0.00	0	0	0	6	0	0	0	0											
								SF	SF	EA	EA	EA	EA	EA	EA	EA	FT											
TOWN DIRECTIONAL TOTALS								778.3	0.0	47.0	9.0	9.0	180	0.0	0.0	108	1620.0											

SIGN SUMMARY SHEET

VERMONT AGENCY OF TRANSPORTATION

PROJECT NAME: **STATEWIDE SOUTHEAST REGION**
PROJECT NUMBER: **STPG SIGN (31)**

FILE NAME: **WEATHERSFIELD EASTBOUND** PLOT DATE: **8/19/2010**
PROJECT MANAGER: **A. GAMBLE** DRAWN BY: **M. MILLER**
DESIGNED BY: **M. MILLER** CHECKED BY: **A. GAMBLE**
WEATHERSFIELD VT-131 EB 28 SHEET **149** OF **175**

DIRECTION	MILEPOINT	LOCATION CODE (SHEET 2)	SIGN CODE	WIDTH (IN)	HEIGHT (IN)	SHEETING REMARKS	SIGN LEGEND	NEW SIGNS "A"	NEW SIGNS "B"	EXISTING SIGNS RETAIN	EXISTING SIGNS SALVAGE FROM	EXISTING SIGNS SALVAGE TO	EXISTING SIGNS REMOVE	EXIST POST RETAIN	EXIST POST REMOVE	NUMBER OF NEW POSTS	SQUARE STEEL (IN) 1.75 (LB / FT) 1.88	SQUARE STEEL (IN) 2.00 (LB / FT) 2.42	SQUARE STEEL (IN) 2.50 (LB / FT) 3.35	TUBULAR STEEL Ø (IN) FOUNDATION	TUBULAR STEEL Ø (IN) 3.00 (LB / FT) 7.60	TUBULAR STEEL Ø (IN) 3.50 (LB / FT) 9.00	TUBULAR STEEL Ø (IN) 4.00 (LB / FT) 10.80	TUBULAR STEEL Ø (IN) 5.00 (LB / FT) 14.60	SIGN FRAME REQUIRED	REMARKS	SIGN DETAIL: DETAIL IN SHS	SIGN DETAIL: DETAIL ON SHEET NUMBER	SIGN DETAIL: DETAIL ON STD SHEET NUMBER
WEATHERSFIELD EB							FY-FLUORESCENT YELLOW FYG-FLUORESCENT YELLOW GREEN																			"SHS"-STANDARD HIGHWAY SIGNS			
		A	M3-3	24	12			2.00																		**BLACK ON WHITE**	X		
		A	M1-4	24	24			4.00																			X		
		A	M6-1	21	15			2.19																		**BLACK ON WHITE**	X		
EB	5.320	F	W11-6H	24	24			4.00								1		14.5' X								SEE NOTES ON STREET #172 FOR THIS SIGN INSTALLED NEW. FOLDED SIGN.			
EB	6.40												4													FOUR FOLDING STOP SIGNS WERE REMOVED BY THE CONTRACTOR. THEY WERE LOCATED AT THE U.S. 5/VT. 131 INTERSECTION. THEY WERE USED BY THE FIRE DEPT., BUT WERE NOT IN COMPLIANCE WITH THE MUTCD.			
							SHEET TOTALS	~~12.19~~ 8.19 SF	0.00 SF	0 EA	0 EA	0 EA	~~4~~ 0 EA	0 EA	0 EA	0 EA		~~14.5~~ 0 FT									
							TOWN DIRECTIONAL TOTALS	778.3	0.0	47.0	9.0	9.0	180	0.0	0.0	108		1620.0									

SIGN SUMMARY SHEET

VERMONT AGENCY OF TRANSPORTATION

PROJECT NAME: **STATEWIDE SOUTHEAST REGION**
PROJECT NUMBER: **STPG SIGN (31)**

FILE NAME: **WEATHERSFIELD EASTBOUND** PLOT DATE: **8/19/2010**
PROJECT MANAGER: **A. GAMBLE** DRAWN BY: **M. MILLER**
DESIGNED BY: **M. MILLER** CHECKED BY: **A. GAMBLE**
WEATHERSFIELD VT-131 EB 29 SHEET **150** OF **175**

DIRECTION	MILEPOINT	LOCATION CODE (SHEET 2)	SIGN CODE	WIDTH (IN)	HEIGHT (IN)	SHEETING REMARKS	SIGN LEGEND	NEW SIGNS		EXISTING SIGNS				EXIST POST		NUMBER OF NEW POSTS	SQUARE STEEL (IN)			TUBULAR STEEL Ø (IN)				SIGN FRAME REQUIRED	REMARKS	SIGN DETAIL		
								"A"	"B"	RETAIN	SALVAGE FROM	SALVAGE TO	REMOVE	RETAIN	REMOVE		1.75 (LB / FT) 1.88	2.00 (LB / FT) 2.42	2.50 (LB / FT) 3.35	FOUNDATION	3.00 (LB / FT) 7.60	3.50 (LB / FT) 9.00	4.00 (LB / FT) 10.80	5.00 (LB / FT) 14.60			DETAIL IN SHS	DETAIL ON SHEET NUMBER	DETAIL ON STD SHEET NUMBER
WEATHERSFIELD WB							FY-FLUORESCENT YELLOW FYG-FLUORESCENT YELLOW GREEN																		"SHS"-STANDARD HIGHWAY SIGNS			
WB	8.630	F	M3-3	24	12								1	X											RETAIN THE EXISTING POSTS; SIGN FRAME TO BE REPLACED			
		F	M1-4	24	24		(15) SIGN ROUTE MARKER ASSEMBLY						1															
		F	M6-1	21	15								1															
		F	M4-5	24	12								1												THIS SIGN WILL NOT BE REPLACED			
		F	M1-1	24	24								1												THIS SIGN WILL NOT BE REPLACED			
		F	M6-3	21	15								1												THIS SIGN WILL NOT BE REPLACED			
		F	M3-4	24	12								1															
		F	M1-5	30	24								1															
		F	M6-3	21	15								1															
		F	M3-1	24	12								1															
		F	M1-4	24	24								1															
		F	M6-1	21	15								1															
		F	M3-1	24	12								1															
		F	M1-5	24	24								1															
		F	M6-1	21	15								1															
							SHEET TOTALS	0.00 SF	0.00 SF	0 EA	0 EA	0 EA	15 EA	0 EA	0 EA	0 EA	0 FT											
							TOWN DIRECTIONAL TOTALS	644.2	0.0	17.0	1.0	1.0	153	0.0	0.0	78	1170.0											

SIGN SUMMARY SHEET

VERMONT AGENCY OF TRANSPORTATION

PROJECT NAME: **STATEWIDE SOUTHEAST REGION**
PROJECT NUMBER: **STPG SIGN (31)**

FILE NAME: **WEATHERSFIELD WESTBOUND** PLOT DATE: **8/19/2010**
PROJECT MANAGER: **A. GAMBLE** DRAWN BY: **M. MILLER**
DESIGNED BY: **M. MILLER** CHECKED BY: **A. GAMBLE**
WEATHERSFIELD VT-131 WB 1 SHEET **151** OF **175**

DIRECTION	MILEPOINT	LOCATION CODE (SHEET 2)	SIGN CODE	WIDTH (IN)	HEIGHT (IN)	SHEETING REMARKS	SIGN LEGEND	NEW SIGNS "A"	NEW SIGNS "B"	EXISTING SIGNS RETAIN	EXISTING SIGNS SALVAGE FROM	EXISTING SIGNS SALVAGE TO	EXISTING SIGNS REMOVE	EXIST POST RETAIN	EXIST POST REMOVE	NUMBER OF NEW POSTS	SQUARE STEEL (IN) 1.75 (LB / FT) 1.88	SQUARE STEEL (IN) 2.00 (LB / FT) 2.42	SQUARE STEEL (IN) 2.50 (LB / FT) 3.35	TUBULAR STEEL Ø (IN) FOUNDATION	TUBULAR STEEL Ø (IN) 3.00 (LB / FT) 7.60	TUBULAR STEEL Ø (IN) 3.50 (LB / FT) 9.00	TUBULAR STEEL Ø (IN) 4.00 (LB / FT) 10.80	TUBULAR STEEL Ø (IN) 5.00 (LB / FT) 14.60	SIGN FRAME REQUIRED	REMARKS	SIGN DETAIL: DETAIL IN SHS	SIGN DETAIL: DETAIL ON SHEET NUMBER	SIGN DETAIL: DETAIL ON STD SHEET NUMBER
WEATHERSFIELD WB							FY-FLUORESCENT YELLOW FYG-FLUORESCENT YELLOW GREEN																			"SHS"-STANDARD HIGHWAY SIGNS			
		F	M3-3	24	12		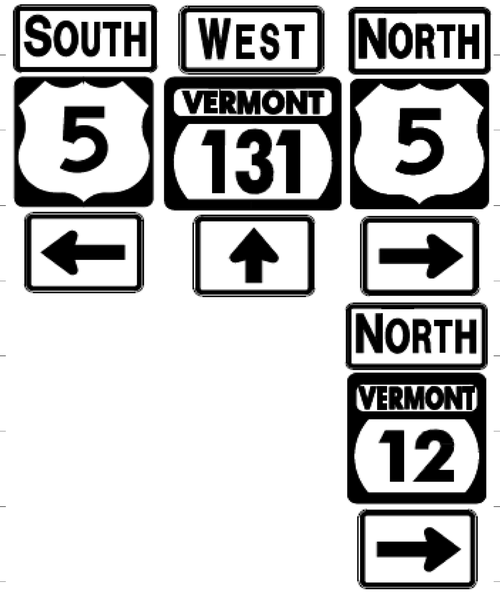	2.00						X									#3B	BLACK ON WHITE	X		
		F	M1-4	24	24			4.00																				X		
		F	M6-1	21	15			2.19																			BLACK ON WHITE	X		
		F	M3-4	24	12			2.00																			GREEN ON WHITE	X		
		F	M1-5	30	24			5.00																						E-136B
		F	M6-3	21	15			2.19																			GREEN ON WHITE	X		
		F	M3-1	24	12			2.00																			BLACK ON WHITE	X		
		F	M1-4	24	24			4.00																				X		
		F	M6-1	21	15			2.19																			BLACK ON WHITE	X		
		F	M3-1	24	12			2.00																			GREEN ON WHITE	X		
		F	M1-5	24	24			4.00																						E-136B
		F	M6-1	21	15			2.19																			GREEN ON WHITE	X		
WB	8.625	F	W4-1R	30	30		MERGE RIGHT SYMBOL						1		X												NOT WARRANTED			
WB	8.618	H	R1-2	36	36		YIELD			1				X													REPLACED IN 2007			
WB	8.600	F	M3-4	24	12								1		X															
							SHEET TOTALS	33.76	0.00	1	0	0	2	0	0	0	0													
								SF	SF	EA	EA	EA	EA	EA	EA	EA	FT													
							TOWN DIRECTIONAL TOTALS	644.2	0.0	17.0	1.0	1.0	153	0.0	0.0	78	1170.0													

SIGN SUMMARY SHEET

VERMONT AGENCY OF TRANSPORTATION

PROJECT NAME: **STATEWIDE SOUTHEAST REGION**
PROJECT NUMBER: **STPG SIGN (31)**

FILE NAME: **WEATHERSFIELD WESTBOUND** PLOT DATE: **8/19/2010**
PROJECT MANAGER: **A. GAMBLE** DRAWN BY: **M. MILLER**
DESIGNED BY: **M. MILLER** CHECKED BY: **A. GAMBLE**
WEATHERSFIELD VT-131 WB 2 SHEET **152** OF **175**

DIRECTION	MILEPOINT	LOCATION CODE (SHEET 2)	SIGN CODE	WIDTH (IN)	HEIGHT (IN)	SHEETING REMARKS	SIGN LEGEND	NEW SIGNS "A"	NEW SIGNS "B"	EXISTING SIGNS RETAIN	EXISTING SIGNS SALVAGE FROM	EXISTING SIGNS SALVAGE TO	EXISTING SIGNS REMOVE	EXIST POST RETAIN	EXIST POST REMOVE	NUMBER OF NEW POSTS	SQUARE STEEL (IN) 1.75 (LB / FT) 1.88	SQUARE STEEL (IN) 2.00 (LB / FT) 2.42	SQUARE STEEL (IN) 2.50 (LB / FT) 3.35	TUBULAR STEEL Ø (IN) FOUNDATION	TUBULAR STEEL Ø (IN) 3.00 (LB / FT) 7.60	TUBULAR STEEL Ø (IN) 3.50 (LB / FT) 9.00	TUBULAR STEEL Ø (IN) 4.00 (LB / FT) 10.80	TUBULAR STEEL Ø (IN) 5.00 (LB / FT) 14.60	SIGN FRAME REQUIRED	REMARKS	SIGN DETAIL: DETAIL IN SHS	SIGN DETAIL: DETAIL ON SHEET NUMBER	SIGN DETAIL: DETAIL ON STD SHEET NUMBER
WEATHERSFIELD WB							FY-FLUORESCENT YELLOW FYG-FLUORESCENT YELLOW GREEN																			"SHS"-STANDARD HIGHWAY SIGNS			
WB	8.600	F	M1-5	30	24								1															
		F	M4-5	24	12								1															
		F	M1-1	24	24								1															
		F	M3-4	24	12			2.00								2		13.5' 14.0' X						# 1A	GREEN ON WHITE	X		
		F	M1-5	30	24			5.00																				E-136B
		F	M4-5	24	12			2.00																			WHITE ON BLUE	X		
		F	M1-1	24	24			4.00																				X		
WB	8.539	F	D2-1	72	12		CAVENDISH 15			1				X													AS-NEW. BOTH SIGNS REPLACED IN 2007, RETAIN ALL			
		F	D2-1	72	12		LUDLOW 24			1																				
WB	8.508	F	R2-1	24	30								1		X															
		F	VR-644	24	12								1		X												(TWO POSTS TO REMOVE)			
		F	R8-3A	24	24								1																	
		F	R2-1	24	30			5.00								2		15.25' 15.75' X			USED A HORIZON-TAL BRACE.		# 1	~~USE A SIGN FRAME TO~~ BRACE THE TWO ~~ASSEMBLIES~~; INSTALL AS SHOWN POST.	X		
		F	VR-644P	24	12			2.00																			INSTALL PLAQUE ON TOP; **BLACK ON WHITE** (2009 MUTCD SIGN CODE, BUT USE THE DETAIL)		6	
		F	R8-3A	24	24			4.00																				X		
							SHEET TOTALS	24.00	0.00	2	0	0	6	0	0	4			~~58.5~~ ~~60~~										
								SF	SF	EA	EA	EA	EA	EA	EA	EA			FT										
							TOWN DIRECTIONAL TOTALS	644.2	0.0	17.0	1.0	1.0	153	0.0	0.0	78			1170.0										

SIGN SUMMARY SHEET

VERMONT AGENCY OF TRANSPORTATION

PROJECT NAME: **STATEWIDE SOUTHEAST REGION**
PROJECT NUMBER: **STPG SIGN (31)**

FILE NAME: **WEATHERSFIELD WESTBOUND** PLOT DATE: **8/19/2010**
PROJECT MANAGER: **A. GAMBLE** DRAWN BY: **M. MILLER**
DESIGNED BY: **M. MILLER** CHECKED BY: **A. GAMBLE**
WEATHERSFIELD VT-131 WB 3 SHEET **153** OF **175**

DIRECTION	MILEPOINT	LOCATION CODE (SHEET 2)	SIGN CODE	WIDTH (IN)	HEIGHT (IN)	SHEETING REMARKS	SIGN LEGEND	NEW SIGNS "A"	NEW SIGNS "B"	EXISTING SIGNS RETAIN	EXISTING SIGNS SALVAGE FROM	EXISTING SIGNS SALVAGE TO	EXISTING SIGNS REMOVE	EXIST POST RETAIN	EXIST POST REMOVE	NUMBER OF NEW POSTS	SQUARE STEEL (IN) 1.75 (LB / FT) 1.88	SQUARE STEEL (IN) 2.00 (LB / FT) 2.42	SQUARE STEEL (IN) 2.50 (LB / FT) 3.35	TUBULAR STEEL Ø (IN) FOUNDATION	TUBULAR STEEL Ø (IN) 3.00 (LB / FT) 7.60	TUBULAR STEEL Ø (IN) 3.50 (LB / FT) 9.00	TUBULAR STEEL Ø (IN) 4.00 (LB / FT) 10.80	TUBULAR STEEL Ø (IN) 5.00 (LB / FT) 14.60	SIGN FRAME REQUIRED	REMARKS	SIGN DETAIL: DETAIL IN SHS	SIGN DETAIL: DETAIL ON SHEET NUMBER	SIGN DETAIL: DETAIL ON STD SHEET NUMBER
WEATHERSFIELD WB							FY-FLUORESCENT YELLOW FYG-FLUORESCENT YELLOW GREEN																			"SHS"-STANDARD HIGHWAY SIGNS			
WB	8.482	G	VR-017	24	30								1		X												CEMETERY RD (TH-74)			
		G	VR-017	24	30			5.00								1		13.0' X										6	
WB	8.474	H	R1-1	30	30		0140 1420 0849 STOP			1				X													REPLACED IN 2007			
WB	8.454	F	M2-1	21	15								1		X															
		F	M1-1	24	24								1																	
		F	M2-1	21	15			2.19								1		12.75' X								**WHITE ON BLUE**	X		
		F	M1-1	24	24			4.00																				X		
WB	8.422	F	E1-4	108	96		LARGE DIAGRAMMATIC SYMBOL SIGN						1		X												REMOVE ALL EXISTING, TO BE REPLACED WITH THE NEW SIGN ASSEMBLY BELOW			
		F	M3-3	24	12		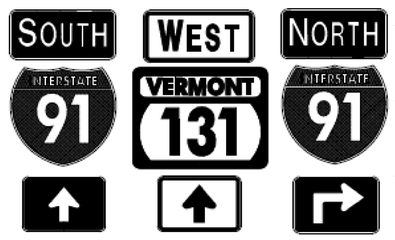	2.00								2		15.25' 17.0' X							#3B	**WHITE ON BLUE**	X		
		F	M1-1	24	24			4.00																			I-91	X		
		F	M6-3	21	15			2.19																			**WHITE ON BLUE**	X		
		F	M3-4	24	12			2.00																			**GREEN ON WHITE**	X		
		F	M1-5	30	24			5.00																			VT-131			E-136B
		F	M6-3	21	15			2.19																			**GREEN ON WHITE**	X		
		F	M3-1	24	12			2.00																			**WHITE ON BLUE**	X		
							SHEET TOTALS	30.57 SF	0.00 SF	1 EA	0 EA	0 EA	4 EA	0 EA	0 EA	4 EA			58.0 ~~60~~ FT									
							TOWN DIRECTIONAL TOTALS	644.2	0.0	17.0	1.0	1.0	153	0.0	0.0	78			1170.0									

SIGN SUMMARY SHEET

VERMONT AGENCY OF TRANSPORTATION

PROJECT NAME: **STATEWIDE SOUTHEAST REGION**
PROJECT NUMBER: **STPG SIGN (31)**

FILE NAME: **WEATHERSFIELD WESTBOUND** PLOT DATE: **8/19/2010**
PROJECT MANAGER: **A. GAMBLE** DRAWN BY: **M. MILLER**
DESIGNED BY: **M. MILLER** CHECKED BY: **A. GAMBLE**
WEATHERSFIELD VT-131 WB 4 SHEET **154** OF **175**

DIRECTION	MILEPOINT	LOCATION CODE (SHEET 2)	SIGN CODE	WIDTH (IN)	HEIGHT (IN)	SHEETING REMARKS	SIGN LEGEND	NEW SIGNS "A"	NEW SIGNS "B"	EXISTING SIGNS RETAIN	EXISTING SIGNS SALVAGE FROM	EXISTING SIGNS SALVAGE TO	EXISTING SIGNS REMOVE	EXIST POST RETAIN	EXIST POST REMOVE	NUMBER OF NEW POSTS	SQUARE STEEL (IN) 1.75 (LB / FT) 1.88	SQUARE STEEL (IN) 2.00 (LB / FT) 2.42	SQUARE STEEL (IN) 2.50 (LB / FT) 3.35	FOUNDATION	TUBULAR STEEL Ø (IN) 3.00 (LB / FT) 7.60	TUBULAR STEEL Ø (IN) 3.50 (LB / FT) 9.00	TUBULAR STEEL Ø (IN) 4.00 (LB / FT) 10.80	TUBULAR STEEL Ø (IN) 5.00 (LB / FT) 14.60	SIGN FRAME REQUIRED	REMARKS	SIGN DETAIL: DETAIL IN SHS	SIGN DETAIL: DETAIL ON SHEET NUMBER	SIGN DETAIL: DETAIL ON STD SHEET NUMBER
WEATHERSFIELD WB							FY-FLUORESCENT YELLOW FYG-FLUORESCENT YELLOW GREEN																			"SHS"-STANDARD HIGHWAY SIGNS			
		F	M1-1	24	24			4.00																		I-91	X		
		F	M5-1R	21	15			2.19																		**WHITE ON BLUE**	X		
WB	8.370	F	R2-1	24	30								1		X													
		F	M4-6	24	12								1															
		F	R8-3A	24	24								1															
		F	R2-1	24	30			5.00								2	14.0' 14.25' X							#1 ~~1~~	INSTALL THE SIGNS SIDE-BY-SIDE AS SHOWN, AND STABILIZE THE ASSEMBLY WITH ~~A SIGN FRAME~~ HORIZONTAL BRACES	X		
		F	M4-6	24	12			2.00																	INSTALL PLAQUE ON TOP; **BLACK ON WHITE**	X		
		F	R8-3A	24	24			4.00																		THE "END NO PARKING" SIGNS ON THE RIGHT-SIDE POST	X		
WB	8.350	F	D1-1A	72	10								~~1~~		~~X~~					ALL SIGNS AND POSTS WERE REMOVED BY DIST. #2 AFTER BEING DAMAGED IN AN ACCIDENT PRIOR TO PROJECT										
		F	D1-1A	72	10								~~1~~																
		F	D1-1A	72	10								~~1~~																
		F	D1-1A	72	10								~~1~~																
		F	D1-1A	72	12		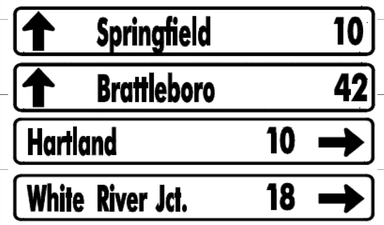	6.00								2	15.0' 15.25' X										4	
		F	D1-1A	72	12			6.00																				4	
		F	D1-1A	72	12			6.00																				4	
							SHEET TOTALS	35.19 SF	0.00 SF	0 EA	0 EA	0 EA	~~3~~ 7 EA	0 EA	0 EA	4 EA	~~58.5~~ 60 FT										
							TOWN DIRECTIONAL TOTALS	644.2	0.0	17.0	1.0	1.0	153	0.0	0.0	78	1170.0										

SIGN SUMMARY SHEET

VERMONT AGENCY OF TRANSPORTATION

PROJECT NAME: **STATEWIDE SOUTHEAST REGION**
PROJECT NUMBER: **STPG SIGN (31)**

FILE NAME: **WEATHERSFIELD WESTBOUND**
PROJECT MANAGER: **A. GAMBLE**
DESIGNED BY: **M. MILLER**
WEATHERSFIELD VT-131 WB 5

PLOT DATE: **8/19/2010**
DRAWN BY: **M. MILLER**
CHECKED BY: **A. GAMBLE**
SHEET **155** OF **175**

DIRECTION	MILEPOINT	LOCATION CODE (SHEET 2)	SIGN CODE	WIDTH (IN)	HEIGHT (IN)	SHEETING REMARKS	SIGN LEGEND	NEW SIGNS "A"	NEW SIGNS "B"	EXISTING SIGNS RETAIN	EXISTING SIGNS SALVAGE FROM	EXISTING SIGNS SALVAGE TO	EXISTING SIGNS REMOVE	EXIST POST RETAIN	EXIST POST REMOVE	NUMBER OF NEW POSTS	SQUARE STEEL (IN) 1.75 (LB / FT) 1.88	SQUARE STEEL (IN) 2.00 (LB / FT) 2.42	SQUARE STEEL (IN) 2.50 (LB / FT) 3.35	TUBULAR STEEL Ø (IN) FOUNDATION	TUBULAR STEEL Ø (IN) 3.00 (LB / FT) 7.60	TUBULAR STEEL Ø (IN) 3.50 (LB / FT) 9.00	TUBULAR STEEL Ø (IN) 4.00 (LB / FT) 10.80	TUBULAR STEEL Ø (IN) 5.00 (LB / FT) 14.60	SIGN FRAME REQUIRED	REMARKS	SIGN DETAIL: DETAIL IN SHS	SIGN DETAIL: DETAIL ON SHEET NUMBER	SIGN DETAIL: DETAIL ON STD SHEET NUMBER
WEATHERSFIELD WB							FY-FLUORESCENT YELLOW FYG-FLUORESCENT YELLOW GREEN																			"SHS"-STANDARD HIGHWAY SIGNS			
		F	D1-1A	72	12		(SEE PREVIOUS PAGE)	6.00																					
WB	8.311	F	M3-4	24	12								1	X												RETAIN THE EXISTING POSTS; REPLACE THE SIGN FRAME			
		F	M1-5	30	24								1																
		F	M6-3	21	15								1																
		F	M3-3	24	12								1																
		F	M1-1	24	24		(9) SIGN ROUTE MARKER ASSEMBLY						1																
		F	M6-3	21	15								1																
		F	M3-1	24	12								1																
		F	M1-1	24	24								1																
		F	M6-1	21	15								1																
		F	M3-4	24	12		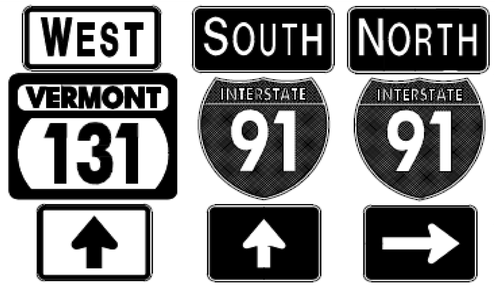	2.00						X								# 3A	GREEN ON WHITE	X		
		F	M1-5	30	24			5.00																					E-136B
		F	M6-3	21	15			2.19																			GREEN ON WHITE	X		
		F	M3-3I	24	12			2.00																			WHITE ON BLUE	X		
		F	M1-1	24	24			4.00																				X		
							SHEET TOTALS	21.19	0.00	0	0	0	9	0	0	0	0													
								SF	SF	EA	EA	EA	EA	EA	EA	EA	FT													
							TOWN DIRECTIONAL TOTALS	644.2	0.0	17.0	1.0	1.0	153	0.0	0.0	78	1170.0													

SIGN SUMMARY SHEET

VERMONT AGENCY OF TRANSPORTATION

PROJECT NAME: **STATEWIDE SOUTHEAST REGION**
PROJECT NUMBER: **STPG SIGN (31)**

FILE NAME: **WEATHERSFIELD WESTBOUND** PLOT DATE: **8/19/2010**
PROJECT MANAGER: **A. GAMBLE** DRAWN BY: **M. MILLER**
DESIGNED BY: **M. MILLER** CHECKED BY: **A. GAMBLE**
WEATHERSFIELD VT-131 WB 6 SHEET **156** OF **175**

DIRECTION	MILEPOINT	LOCATION CODE (SHEET 2)	SIGN CODE	WIDTH (IN)	HEIGHT (IN)	SHEETING REMARKS	SIGN LEGEND	NEW SIGNS "A"	NEW SIGNS "B"	EXISTING SIGNS RETAIN	EXISTING SIGNS SALVAGE FROM	EXISTING SIGNS SALVAGE TO	EXISTING SIGNS REMOVE	EXIST POST RETAIN	EXIST POST REMOVE	NUMBER OF NEW POSTS	SQUARE STEEL (IN) 1.75 (LB / FT) 1.88	SQUARE STEEL (IN) 2.00 (LB / FT) 2.42	SQUARE STEEL (IN) 2.50 (LB / FT) 3.35	TUBULAR STEEL Ø (IN) FOUNDATION	TUBULAR STEEL Ø (IN) 3.00 (LB / FT) 7.60	TUBULAR STEEL Ø (IN) 3.50 (LB / FT) 9.00	TUBULAR STEEL Ø (IN) 4.00 (LB / FT) 10.80	TUBULAR STEEL Ø (IN) 5.00 (LB / FT) 14.60	SIGN FRAME REQUIRED	REMARKS	SIGN DETAIL: DETAIL IN SHS	SIGN DETAIL: DETAIL ON SHEET NUMBER	SIGN DETAIL: DETAIL ON STD SHEET NUMBER
WEATHERSFIELD WB							FY-FLUORESCENT YELLOW FYG-FLUORESCENT YELLOW GREEN																			"SHS"-STANDARD HIGHWAY SIGNS			
		F	M6-3	21	15			2.19																		**WHITE ON BLUE**	X		
		F	M3-1	24	12			2.00																		**WHITE ON BLUE**	X		
		F	M1-1	24	24			4.00																			X		
		F	M6-1	21	15			2.19																		**WHITE ON BLUE**	X		
WB	8.300	F	VR-921R	30	30		(BEING SALVAGED FROM HERE…)				1		1		X						PAY FOR REMOVAL						TO BE RELOCATED JUST AHEAD; SIGN IS FROM 2007			
WB	8.291	F	R3-7R	30	30		RIGHT LANE MUST TURN RIGHT						1		X														
		F	VR-921R	30	30		(…TO HERE)					1				1	13.5' X									INSTALL THE NEW POST ADJACENT TO THE BEGIN OF THE SOLID WHITE LANE DIVIDER LINE			
WB	8.278	F	M3-1	24	12								1		X														
		F	M1-1	24	24		(6) SIGN ROUTE MARKER ASSEMBLY						1																	
		F	M6-1	21	15								1																
		E	M3-1	24	12								1																
		E	M1-1	24	24								1																
		E	M6-1	21	15								1																
		F	M3-1	24	12			2.00								1	X									**WHITE ON BLUE**	X		
		F	M1-1	24	24		(SEE NEXT PAGE)	4.00																			X		
SIGN SUMMARY SHEET							SHEET TOTALS	16.38	0.00	0	1	1	~~8~~ 7	0	0	2	~~28.75~~ 30											
								SF	SF	EA	EA	EA	EA	EA	EA	EA	FT											
VERMONT AGENCY OF TRANSPORTATION							TOWN DIRECTIONAL TOTALS	644.2	0.0	17.0	1.0	1.0	153	0.0	0.0	78	1170.0											

PROJECT NAME: **STATEWIDE SOUTHEAST REGION**
PROJECT NUMBER: **STPG SIGN (31)**

FILE NAME: **WEATHERSFIELD WESTBOUND** PLOT DATE: **8/19/2010**
PROJECT MANAGER: **A. GAMBLE** DRAWN BY: **M. MILLER**
DESIGNED BY: **M. MILLER** CHECKED BY: **A. GAMBLE**
WEATHERSFIELD VT-131 WB 7 SHEET **157** OF **175**

DIRECTION	MILEPOINT	LOCATION CODE (SHEET 2)	SIGN CODE	WIDTH (IN)	HEIGHT (IN)	SHEETING REMARKS	SIGN LEGEND	NEW SIGNS "A"	NEW SIGNS "B"	EXISTING SIGNS RETAIN	EXISTING SIGNS SALVAGE FROM	EXISTING SIGNS SALVAGE TO	EXISTING SIGNS REMOVE	EXIST POST RETAIN	EXIST POST REMOVE	NUMBER OF NEW POSTS	SQUARE STEEL (IN) 1.75 (LB / FT) 1.88	SQUARE STEEL (IN) 2.00 (LB / FT) 2.42	SQUARE STEEL (IN) 2.50 (LB / FT) 3.35	TUBULAR STEEL Ø (IN) FOUNDATION	TUBULAR STEEL Ø (IN) 3.00 (LB / FT) 7.60	TUBULAR STEEL Ø (IN) 3.50 (LB / FT) 9.00	TUBULAR STEEL Ø (IN) 4.00 (LB / FT) 10.80	TUBULAR STEEL Ø (IN) 5.00 (LB / FT) 14.60	SIGN FRAME REQUIRED	REMARKS	SIGN DETAIL: DETAIL IN SHS	SIGN DETAIL: DETAIL ON SHEET NUMBER	SIGN DETAIL: DETAIL ON STD SHEET NUMBER
WEATHERSFIELD WB							FY-FLUORESCENT YELLOW FYG-FLUORESCENT YELLOW GREEN																			"SHS"-STANDARD HIGHWAY SIGNS			
		F	M6-1	21	15		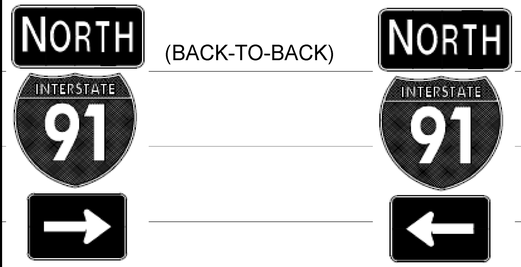 (BACK-TO-BACK)	2.19																		**WHITE ON BLUE**	X		
		E	M3-1	24	12			2.00																		**WHITE ON BLUE;** INSTALL ON BACK FACING EB TRAFFIC	X		
		E	M1-1	24	24			4.00																		INSTALL ON BACK FACING EB TRAFFIC	X		
		E	M6-1	21	15			2.19																		**WHITE ON BLUE;** INSTALL ON BACK FACING EB TRAFFIC	X		
WB	8.243	G	M3-4	24	12								1	X												RETAIN THE EXISTING POSTS; REPLACE THE SIGN FRAME			
		G	M1-5	30	24		(12) SIGN ROUTE MARKER ASSEMBLY						1																
		G	M6-1	21	15								1																
		G	M3-2	24	12								1																
		G	M1-5	30	24								1																
		G	M6-1	24	12								1																
		G	M4-5	24	12								1																
		G	M1-4	24	24								1																
		G	M6-1	24	12								1																
		G	M4-5	24	12								1																
		G	M1-5	30	24								1																
SIGN SUMMARY SHEET							SHEET TOTALS	10.38	0.00	0	0	0	11	0	0	0	0											
								SF	SF	EA	EA	EA	EA	EA	EA	EA	FT											
VERMONT AGENCY OF TRANSPORTATION							TOWN DIRECTIONAL TOTALS	644.2	0.0	17.0	1.0	1.0	153	0.0	0.0	78	1170.0											

PROJECT NAME: **STATEWIDE SOUTHEAST REGION**
PROJECT NUMBER: **STPG SIGN (31)**

FILE NAME: **WEATHERSFIELD WESTBOUND** PLOT DATE: **8/19/2010**
PROJECT MANAGER: **A. GAMBLE** DRAWN BY: **M. MILLER**
DESIGNED BY: **M. MILLER** CHECKED BY: **A. GAMBLE**
WEATHERSFIELD VT-131 WB 8 SHEET **158** OF **175**

DIRECTION	MILEPOINT	LOCATION CODE (SHEET 2)	SIGN CODE	WIDTH (IN)	HEIGHT (IN)	SHEETING REMARKS	SIGN LEGEND	NEW SIGNS "A"	NEW SIGNS "B"	EXISTING SIGNS RETAIN	EXISTING SIGNS SALVAGE FROM	EXISTING SIGNS SALVAGE TO	EXISTING SIGNS REMOVE	EXIST POST RETAIN	EXIST POST REMOVE	NUMBER OF NEW POSTS	SQUARE STEEL (IN) 1.75 (LB / FT) 1.88	SQUARE STEEL (IN) 2.00 (LB / FT) 2.42	SQUARE STEEL (IN) 2.50 (LB / FT) 3.35	TUBULAR STEEL Ø (IN) FOUNDATION	TUBULAR STEEL Ø (IN) 3.00 (LB / FT) 7.60	TUBULAR STEEL Ø (IN) 3.50 (LB / FT) 9.00	TUBULAR STEEL Ø (IN) 4.00 (LB / FT) 10.80	TUBULAR STEEL Ø (IN) 5.00 (LB / FT) 14.60	SIGN FRAME REQUIRED	REMARKS	SIGN DETAIL: DETAIL IN SHS	SIGN DETAIL: DETAIL ON SHEET NUMBER	SIGN DETAIL: DETAIL ON STD SHEET NUMBER
WEATHERSFIELD WB							FY-FLUORESCENT YELLOW FYG-FLUORESCENT YELLOW GREEN																			"SHS"-STANDARD HIGHWAY SIGNS			
		G	M6-1	24	12				1																			
		G	M3-4	24	12		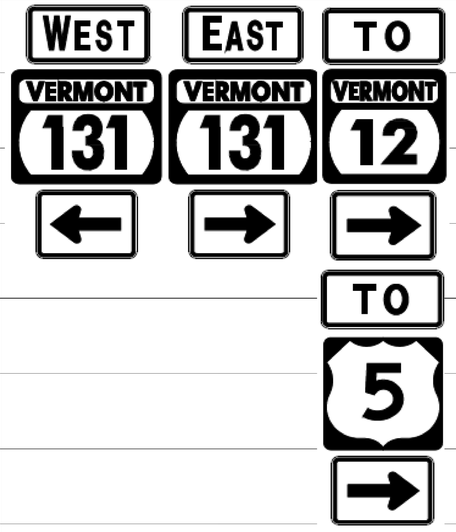	2.00																# 3C	SIGNS FACE THE I-91 NB OFF RAMP; **GREEN ON WHITE**	X		
		G	M1-5	30	24			5.00																			INSTALL THE SIGNS AS SHOWN			E-136B
		G	M6-1	21	15			2.19																			**GREEN ON WHITE**	X		
		G	M3-2	24	12			2.00																			**GREEN ON WHITE**	X		
		G	M1-5	30	24			5.00																						E-136B
		G	M6-1	24	12			2.19																			**GREEN ON WHITE**	X		
		G	M4-5	24	12			2.00																			**GREEN ON WHITE**	X		
		G	M1-5	30	24			4.00																						E-136B
		G	M6-1	24	12			2.19																			**GREEN ON WHITE**	X		
		G	M4-5	24	12			2.00																			**BLACK ON WHITE**	X		
		G	M1-4	24	24			4.00																				X		
		G	M6-1	24	12			2.19																			**BLACK ON WHITE**	X		
WB	8.225	F	R2-1	24	30				1						X														
		F	R2-1	24	30			5.00								1												X		
							SHEET TOTALS	39.76 SF	0.00 SF	0 EA	0 EA	0 EA	2 EA	0 EA	0 EA	1 EA										13.75' ~~15~~ FT				
							TOWN DIRECTIONAL TOTALS	644.2	0.0	17.0	1.0	1.0	153	0.0	0.0	78										1170.0				

SIGN SUMMARY SHEET

VERMONT AGENCY OF TRANSPORTATION

PROJECT NAME: **STATEWIDE SOUTHEAST REGION**
PROJECT NUMBER: **STPG SIGN (31)**
FILE NAME: **WEATHERSFIELD WESTBOUND** PLOT DATE: **8/19/2010**
PROJECT MANAGER: **A. GAMBLE** DRAWN BY: **M. MILLER**
DESIGNED BY: **M. MILLER** CHECKED BY: **A. GAMBLE**
WEATHERSFIELD VT-131 WB 9 SHEET **159** OF **175**

DIRECTION	MILEPOINT	LOCATION CODE (SHEET 2)	SIGN CODE	WIDTH (IN)	HEIGHT (IN)	SHEETING REMARKS	SIGN LEGEND	NEW SIGNS "A"	NEW SIGNS "B"	EXISTING SIGNS RETAIN	EXISTING SIGNS SALVAGE FROM	EXISTING SIGNS SALVAGE TO	EXISTING SIGNS REMOVE	EXIST POST RETAIN	EXIST POST REMOVE	NUMBER OF NEW POSTS	SQUARE STEEL (IN) 1.75 (LB / FT) 1.88	SQUARE STEEL (IN) 2.00 (LB / FT) 2.42	SQUARE STEEL (IN) 2.50 (LB / FT) 3.35	TUBULAR STEEL Ø (IN) FOUNDATION	TUBULAR STEEL Ø (IN) 3.00 (LB / FT) 7.60	TUBULAR STEEL Ø (IN) 3.50 (LB / FT) 9.00	TUBULAR STEEL Ø (IN) 4.00 (LB / FT) 10.80	TUBULAR STEEL Ø (IN) 5.00 (LB / FT) 14.60	SIGN FRAME REQUIRED	REMARKS	SIGN DETAIL: DETAIL IN SHS	SIGN DETAIL: DETAIL ON SHEET NUMBER	SIGN DETAIL: DETAIL ON STD SHEET NUMBER
WEATHERSFIELD WB							FY-FLUORESCENT YELLOW FYG-FLUORESCENT YELLOW GREEN																			"SHS"-STANDARD HIGHWAY SIGNS			
WB	8.216	F	D1-1A	72	12		^UP CAVENDISH 15			1				X												REPLACED IN 2007			
		F	D1-1A	72	12		^UP LUDLOW 20			1																REPLACED IN 2007			
		F	D1-1A	72	12		<--- (90 DEG) SPRINGFIELD 10			1																REPLACED IN 2007			
WB	8.195	F	W11-8	36	36								1		X														
		F	W11-8	~~36~~ 30	~~36~~ 30			~~9.00~~ 6.25								~~2~~ 1		14.0' X								SIGN DOWNSIZED PER M. MILLER, TRAFFIC OPS., 04/28/2011	X		
WB	8.155	F	M3-3	24	12		SOUTH						1		X														
		F	M1-1	24	24		I-91						1																
		F	M6-1	21	15		LEFT						1																
		F	M3-4	24	12		WEST						1														~~WEST VT-131 UP ARROW SIGNS NOT BEING REPLACED~~			
		F	M1-5	30	24		VT 131						1																
		F	M6-3	21	15		^UP ARROW						1								THIS SIGN WAS NOT REPLACED.						ABOVE NOTE WAS MISLEADING			
		F	M3-3	24	12			2.00								1	14.25' X							WHITE ON BLUE	X		
		F	M1-1	24	24			4.00																			X		
		F	M6-1	21	15			2.19																		WHITE ON BLUE	X		
WB	8.118	F	M3-4	24	12								1		X														
							SHEET TOTALS	~~14.44~~ 17.19 SF	0.00 SF	3 EA	0 EA	0 EA	8 EA	0 EA	0 EA	~~2~~ 3 EA	~~28.25~~ 45 FT												
							TOWN DIRECTIONAL TOTALS	644.2	0.0	17.0	1.0	1.0	153	0.0	0.0	78	1170.0												

SIGN SUMMARY SHEET

VERMONT AGENCY OF TRANSPORTATION

PROJECT NAME: STATEWIDE SOUTHEAST REGION
PROJECT NUMBER: STPG SIGN (31)

FILE NAME: WEATHERSFIELD WESTBOUND
PROJECT MANAGER: A. GAMBLE
DESIGNED BY: M. MILLER
WEATHERSFIELD VT-131 WB 10

PLOT DATE: 8/19/2010
DRAWN BY: M. MILLER
CHECKED BY: A. GAMBLE
SHEET 160 OF 175

DIRECTION	MILEPOINT	LOCATION CODE (SHEET 2)	SIGN CODE	WIDTH (IN)	HEIGHT (IN)	SHEETING REMARKS	SIGN LEGEND	NEW SIGNS "A"	NEW SIGNS "B"	EXISTING SIGNS RETAIN	EXISTING SIGNS SALVAGE FROM	EXISTING SIGNS SALVAGE TO	EXISTING SIGNS REMOVE	EXIST POST RETAIN	EXIST POST REMOVE	NUMBER OF NEW POSTS	SQUARE STEEL (IN) 1.75 (LB / FT) 1.88	SQUARE STEEL (IN) 2.00 (LB / FT) 2.42	SQUARE STEEL (IN) 2.50 (LB / FT) 3.35	TUBULAR STEEL Ø (IN) FOUNDATION	TUBULAR STEEL Ø (IN) 3.00 (LB / FT) 7.60	TUBULAR STEEL Ø (IN) 3.50 (LB / FT) 9.00	TUBULAR STEEL Ø (IN) 4.00 (LB / FT) 10.80	TUBULAR STEEL Ø (IN) 5.00 (LB / FT) 14.60	SIGN FRAME REQUIRED	REMARKS	SIGN DETAIL: DETAIL IN SHS	SIGN DETAIL: DETAIL ON SHEET NUMBER	SIGN DETAIL: DETAIL ON STD SHEET NUMBER
WEATHERSFIELD WB							FY-FLUORESCENT YELLOW FYG-FLUORESCENT YELLOW GREEN																			"SHS"-STANDARD HIGHWAY SIGNS			
		F	M1-5	30	24								1															
		F	M3-4	24	12		WEST VERMONT 131	2.00								1		14.25' X								GREEN ON WHITE	X		
		F	M1-5	30	24			5.00																				E-136B
WB	8.087	F	D2-1	72	12		CAVENDISH 15			1				X												REPLACED IN 2007			
		F	D2-1	72	12		LUDLOW 20			1																REPLACED IN 2007			
WB	8.000	F	R2-1	24	30		SPEED LIMIT 40						1		X											SIGN RELACED IN 2007 RETAINED POST AND SIGN.			
	~~———~~	F	R2-1	24	30			5.00								1		~~X~~									X		
WB	7.711	F	W11-7	30	30								1		X														
		F	W11-7	30	30			6.25								1		12.25' X								STILL VALID	X		
WB	7.595	G	VR-017	24	30		LEGAL LOAD LIMIT 24,000 POUNDS						1		X											VICTORY DRIVE (TH-88)			
		G	VR-017	24	30			5.00								1		13.75' X										6	
WB	7.587	H	R1-1	30	30		STOP 1310 1420 0759						1		X														
		H	R1-1	30	30			6.25								1		13.0' X									X		
WB	7.510	F	VR-114	48	60		STATE OF VERMONT SPEED LIMIT 50 UNLESS OTHERWISE POSTED RADAR ENFORCEMENT						1		X											THIS SIGN IS NOT BEING USED ANYMORE. IT WAS REMOVED			
	~~———~~	F	VR-114	48	60			20.00								~~2~~		~~X~~								SEE SHEET# 172. SEE MEMO FROM A. GAMBLE, TRAFFIC OPTS., 04/04/2011		5	
							SHEET TOTALS	~~24.5~~ ~~49.50~~ SF	0.00 SF	2 EA	0 EA	0 EA	~~5~~ ~~6~~ EA	0 EA	0 EA	7 EA	~~53.25~~ ~~105~~ FT									
							TOWN DIRECTIONAL TOTALS	644.2	0.0	17.0	1.0	1.0	153	0.0	0.0	78	1170.0												

SIGN SUMMARY SHEET

VERMONT AGENCY OF TRANSPORTATION

PROJECT NAME: STATEWIDE SOUTHEAST REGION
PROJECT NUMBER: STPG SIGN (31)

FILE NAME: WEATHERSFIELD WESTBOUND
PROJECT MANAGER: A. GAMBLE
DESIGNED BY: M. MILLER
WEATHERSFIELD VT-131 WB 11

PLOT DATE: 8/19/2010
DRAWN BY: M. MILLER
CHECKED BY: A. GAMBLE
SHEET 161 OF 175

DIRECTION	MILEPOINT	LOCATION CODE (SHEET 2)	SIGN CODE	WIDTH (IN)	HEIGHT (IN)	SHEETING REMARKS	SIGN LEGEND	NEW SIGNS "A"	NEW SIGNS "B"	EXISTING SIGNS RETAIN	EXISTING SIGNS SALVAGE FROM	EXISTING SIGNS SALVAGE TO	EXISTING SIGNS REMOVE	EXIST POST RETAIN	EXIST POST REMOVE	NUMBER OF NEW POSTS	SQUARE STEEL (IN) 1.75 (LB / FT) 1.88	SQUARE STEEL (IN) 2.00 (LB / FT) 2.42	SQUARE STEEL (IN) 2.50 (LB / FT) 3.35	TUBULAR STEEL Ø (IN) FOUNDATION	TUBULAR STEEL Ø (IN) 3.00 (LB / FT) 7.60	TUBULAR STEEL Ø (IN) 3.50 (LB / FT) 9.00	TUBULAR STEEL Ø (IN) 4.00 (LB / FT) 10.80	TUBULAR STEEL Ø (IN) 5.00 (LB / FT) 14.60	SIGN FRAME REQUIRED	REMARKS	SIGN DETAIL: DETAIL IN SHS	SIGN DETAIL: DETAIL ON SHEET NUMBER	SIGN DETAIL: DETAIL ON STD SHEET NUMBER
WEATHERSFIELD WB							FY-FLUORESCENT YELLOW FYG-FLUORESCENT YELLOW GREEN																			"SHS"-STANDARD HIGHWAY SIGNS			
WB	7.118	F	W1-4L	30	30		LEFT REVERSE CURVE						1		X														
		F	W13-1	18	18		35 MPH (PLAQUE)						1																
WB	7.000	F	VW-054	30	30		HIDDEN DRIVE RIGHT						1		X												TO BE REPLACED FURTHER AHEAD			
WB	6.983	F	W1-2R	30	30			6.25								1		13.0′ X								INSTALL 90 FEET ± WEST OF THE REMOVED HIDDEN DRIVE RIGHT SIGN	X		
		F	W13-1	18	18		40 MPH	2.25																			X		
WB	6.945	F	VW-054	30	30		HIDDEN DRIVE RIGHT	6.25								1		14.5′ X								INSTALL 200 FEET ± WEST OF THE RIGHT CURVE SIGN			E-154
WB	6.518	G	VR-017	24	30		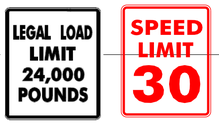						1		X												THRASHER ROAD (TH-37)			
		G	VR-017	24	30		LEGAL LOAD LIMIT 24,000 POUNDS / SPEED LIMIT 30	5.00								1		12.25′ X										6	
WB	6.512	H	R1-1	30	30								1		X														
		H	R1-1	30	30		STOP 1310 1420 0652	6.25								1		13.25′ X									X		
WB	6.435	F	VD-062B	72	16		BUSINESS DIRECTORY SIGN			1				X												WELLWOOD ORCHARDS <===			
		F	VD-062AL	72	16		BUSINESS DIRECTORY SIGN			1																MUSEUM & <===			
		F	VD-062AS	72	16		BUSINESS DIRECTORY SIGN			1																CROWN POINT CC <===			
WB	6.134	F	M3-4	24	12								1		X														
		F	M1-5	30	24								1																
SIGN SUMMARY SHEET							SHEET TOTALS	26.00	0.00	3	0	0	7	0	0	4		53.0 ~~60~~										
								SF	SF	EA	EA	EA	EA	EA	EA	EA		FT										
VERMONT AGENCY OF TRANSPORTATION							TOWN DIRECTIONAL TOTALS	644.2	0.0	17.0	1.0	1.0	153	0.0	0.0	78		1170.0										

PROJECT NAME: **STATEWIDE SOUTHEAST REGION**
PROJECT NUMBER: **STPG SIGN (31)**

FILE NAME: **WEATHERSFIELD WESTBOUND** PLOT DATE: **8/19/2010**
PROJECT MANAGER: **A. GAMBLE** DRAWN BY: **M. MILLER**
DESIGNED BY: **M. MILLER** CHECKED BY: **A. GAMBLE**
WEATHERSFIELD VT-131 WB 12 SHEET **162** OF **175**

DIRECTION	MILEPOINT	LOCATION CODE (SHEET 2)	SIGN CODE	WIDTH (IN)	HEIGHT (IN)	SHEETING REMARKS	SIGN LEGEND	NEW SIGNS "A"	NEW SIGNS "B"	EXISTING SIGNS RETAIN	EXISTING SIGNS SALVAGE FROM	EXISTING SIGNS SALVAGE TO	EXISTING SIGNS REMOVE	EXIST POST RETAIN	EXIST POST REMOVE	NUMBER OF NEW POSTS	SQUARE STEEL (IN) 1.75 (LB / FT) 1.88	SQUARE STEEL (IN) 2.00 (LB / FT) 2.42	SQUARE STEEL (IN) 2.50 (LB / FT) 3.35	TUBULAR STEEL Ø (IN) FOUNDATION	TUBULAR STEEL Ø (IN) 3.00 (LB / FT) 7.60	TUBULAR STEEL Ø (IN) 3.50 (LB / FT) 9.00	TUBULAR STEEL Ø (IN) 4.00 (LB / FT) 10.80	TUBULAR STEEL Ø (IN) 5.00 (LB / FT) 14.60	SIGN FRAME REQUIRED	REMARKS	SIGN DETAIL: DETAIL IN SHS	SIGN DETAIL: DETAIL ON SHEET NUMBER	SIGN DETAIL: DETAIL ON STD SHEET NUMBER
WEATHERSFIELD WB							FY-FLUORESCENT YELLOW FYG-FLUORESCENT YELLOW GREEN																			"SHS"-STANDARD HIGHWAY SIGNS			
WB	6.134	F	M3-4	24	12			2.00								1		13.75' X								GREEN ON WHITE	X		
		F	M1-5	30	24			5.00																				E-136B
WB	6.116	G	VR-017	24	30								1		X											WHEELER CAMP ROAD (TH-29)			
		G	VR-017	24	30			5.00								1		12.5' X										6	
WB	6.105	H	R1-1	30	30		1310 1420 0612						1		X														
		H	R1-1	30	30			6.25								1		13.0' X									X		
WB	6.080	F	R2-1	24	30								1		X														
		F	R2-1	24	30			5.00								1		13.25' X									X		
WB	5.964	G	VR-017	24	30																					SOUTH MOUNTAIN RD (TH-28); **EXISTING SIGN AND POST MISSING**			
		G	VR-017	24	30			5.00								1		13.0' X										6	
WB	5.954	H	R1-1	30	30		1310 1420 0600						1		X														
		H	R1-1	30	30			6.25								1		13.0' X									X		
WB	5.542	F	unknown	n/a	n/a		REMOVE EMPTY POST								X											REMOVE EMPTY POST			
WB	5.460 SNOWMOBILE CROSSING SIGN-SEE PAGE 172																												
WB	5.282	F	W11-7	30	30								1		X														
		F	W11-7	30	30			6.25								1		16.0' X									X		
SIGN SUMMARY SHEET							SHEET TOTALS	40.75	0.00	0	0	0	5	0	0	7		94.5 ~~105~~											
VERMONT AGENCY OF TRANSPORTATION								SF	SF	EA	EA	EA	EA	EA	EA	EA		FT											
							TOWN DIRECTIONAL TOTALS	644.2	0.0	17.0	1.0	1.0	153	0.0	0.0	78		1170.0											

PROJECT NAME: **STATEWIDE SOUTHEAST REGION**
PROJECT NUMBER: **STPG SIGN (31)**

FILE NAME: **WEATHERSFIELD WESTBOUND** PLOT DATE: **8/19/2010**
PROJECT MANAGER: **A. GAMBLE** DRAWN BY: **M. MILLER**
DESIGNED BY: **M. MILLER** CHECKED BY: **A. GAMBLE**
WEATHERSFIELD VT-131 WB 13 SHEET **163** OF **175**

DIRECTION	MILEPOINT	LOCATION CODE (SHEET 2)	SIGN CODE	WIDTH (IN)	HEIGHT (IN)	SHEETING REMARKS	SIGN LEGEND	NEW SIGNS "A"	NEW SIGNS "B"	EXISTING SIGNS RETAIN	EXISTING SIGNS SALVAGE FROM	EXISTING SIGNS SALVAGE TO	EXISTING SIGNS REMOVE	EXIST POST RETAIN	EXIST POST REMOVE	NUMBER OF NEW POSTS	SQUARE STEEL (IN) 1.75 (LB / FT) 1.88	SQUARE STEEL (IN) 2.00 (LB / FT) 2.42	SQUARE STEEL (IN) 2.50 (LB / FT) 3.35	TUBULAR STEEL Ø (IN) FOUNDATION	TUBULAR STEEL Ø (IN) 3.00 (LB / FT) 7.60	TUBULAR STEEL Ø (IN) 3.50 (LB / FT) 9.00	TUBULAR STEEL Ø (IN) 4.00 (LB / FT) 10.80	TUBULAR STEEL Ø (IN) 5.00 (LB / FT) 14.60	SIGN FRAME REQUIRED	REMARKS	SIGN DETAIL: DETAIL IN SHS	SIGN DETAIL: DETAIL ON SHEET NUMBER	SIGN DETAIL: DETAIL ON STD SHEET NUMBER
WEATHERSFIELD WB							FY-FLUORESCENT YELLOW FYG-FLUORESCENT YELLOW GREEN																			"SHS"-STANDARD HIGHWAY SIGNS			
WB	5.093	F	VD-062AS	72	16		BUSINESS DIRECTORY SIGN			1				X												WEATHERSFIELD TRAIL ===>			
WB	5.015	G	VR-017	24	30		LEGAL LOAD LIMIT 24,000 POUNDS						1		X											CASCADE FALLS RD (TH-79)			
		G	VR-017	24	30			5.00								1		14.25' X										6	
WB	5.007	H	R1-1	30	30		STOP CASCADE FALLS RD TH79 - 2 EA. 1310 1420 0502						1		X			14.0'* X								ON 9/16/11 THE STOP SIGN POST WAS DAMAGED IN AN ACCIDENT. A. GAMMELL, R.C.E., AUTHIRIZED			
		H	R1-1	30	30			6.25			3	3	3			1		12.0' X								THE REPLACEMENT OF THIS SIGN POST. 3 SIGNS WERE SALVAGED ONTO THE NEW POST. (PAY FOR REMOVALS)	X		
WB	4.993	F	M3-4	24	12		WEST VERMONT 131	2.00								1		16.25' X								GREEN ON WHITE	X		
		F	M1-5	30	24			5.00																		INSTALL ASSEMBLY 75 FT ± WEST OF TH-79			E-136B
WB	4.480	F	W7-1B	30	30		8%						1		X															
		F	W7-1A	30	30			6.25								1		15.0' X								W7-1B SIGN CODE IS FROM 2004 SHS; (2009 MUTCD WILL CALL THIS DESIGN A W7-1A)	X		
WB	4.310	F	S3-1	30	30		SCHOOL BUS STOP AHEAD						1		X															
WB	4.075	F	VD-062AS	72	16		BUSINESS DIRECTORY SIGN			1				X												CANVASWORKS ===>			
WB	3.998	G	VR-017	24	30		LEGAL LOAD LIMIT 24,000 POUNDS						1		X											ASCUTNEY NOTCH RD (TH-79)			
		G	VR-017	24	30			5.00								1		12.75' X										6	
WB	3.992	H	R1-1	30	30		STOP 1310 1420 0401						1		X															
		H	R1-1	30	30			6.25								1		13.0' X									X		
SIGN SUMMARY SHEET							SHEET TOTALS	35.75	0.00	2	~~3~~ 0	~~3~~ 0	~~9~~ 6	0	0	6			~~97.25~~ 90										
VERMONT AGENCY OF TRANSPORTATION								SF	SF	EA	EA	EA	EA	EA	EA	EA			FT									
							TOWN DIRECTIONAL TOTALS	644.2	0.0	17.0	1.0	1.0	153	0.0	0.0	78			1170.0										

PROJECT NAME: **STATEWIDE SOUTHEAST REGION**
PROJECT NUMBER: **STPG SIGN (31)**

FILE NAME: **WEATHERSFIELD WESTBOUND** PLOT DATE: **8/19/2010**
PROJECT MANAGER: **A. GAMBLE** DRAWN BY: **M. MILLER**
DESIGNED BY: **M. MILLER** CHECKED BY: **A. GAMBLE**
WEATHERSFIELD VT-131 WB 14 SHEET **164** OF **175**

DIRECTION	MILEPOINT	LOCATION CODE (SHEET 2)	SIGN CODE	WIDTH (IN)	HEIGHT (IN)	SHEETING REMARKS	SIGN LEGEND	NEW SIGNS "A"	NEW SIGNS "B"	EXISTING SIGNS RETAIN	EXISTING SIGNS SALVAGE FROM	EXISTING SIGNS SALVAGE TO	EXISTING SIGNS REMOVE	EXIST POST RETAIN	EXIST POST REMOVE	NUMBER OF NEW POSTS	SQUARE STEEL (IN) 1.75 (LB / FT) 1.88	SQUARE STEEL (IN) 2.00 (LB / FT) 2.42	SQUARE STEEL (IN) 2.50 (LB / FT) 3.35	TUBULAR STEEL Ø (IN) FOUNDATION	TUBULAR STEEL Ø (IN) 3.00 (LB / FT) 7.60	TUBULAR STEEL Ø (IN) 3.50 (LB / FT) 9.00	TUBULAR STEEL Ø (IN) 4.00 (LB / FT) 10.80	TUBULAR STEEL Ø (IN) 5.00 (LB / FT) 14.60	SIGN FRAME REQUIRED	REMARKS	SIGN DETAIL: DETAIL IN SHS	SIGN DETAIL: DETAIL ON SHEET NUMBER	SIGN DETAIL: DETAIL ON STD SHEET NUMBER
WEATHERSFIELD WB							FY-FLUORESCENT YELLOW FYG-FLUORESCENT YELLOW GREEN																			"SHS"-STANDARD HIGHWAY SIGNS			
WB	3.766	G	VR-017	24	30		LEGAL LOAD LIMIT 24,000 POUNDS																			HENRY GOULD RD (TH-65); **SIGN AND POST MISSING**			
		G	VR-017	24	30			5.00								1		13.75' X										6
WB	3.760	H	R1-1	30	30		STOP 1310 1420 0342																			**SIGN AND POST MISSING**			
		H	R1-1	30	30			6.25								1		12.25' X									X		
WB	3.406	G	VR-017	24	30		LEGAL LOAD LIMIT 24,000 POUNDS						1		X											LITTLE ASCUTNEY RD (TH-5)			
		G	VR-017	24	30			5.00								1		11.0' X										6
WB	3.400	H	R1-1	30	30		STOP						1		X													
		H	R1-1	30	30			6.25								1		12.0' X									X		
WB	3.380	F	M3-4	24	12								1		X													
		F	M1-5	30	24		WEST VERMONT 131						1															
		F	M3-4	24	12			2.00								1		12.0' X								GREEN ON WHITE	X		
		F	M1-5	30	24			5.00																					E-136B
WB	3.333	F	W7-1B	30	30		SPEED LIMIT 50 HILL SYMBOL 7% GRADE						1		X											BEING REPLACED FURTHER AHEAD			
		F	R2-1	24	30			5.00								1		14.5' X								INSTALL WHERE THE HILL SYMBOL WAS	X		
WB	3.303	F	R2-1	24	30		SPEED LIMIT 50						1		X											NOTE LOCATION OF THIS REMOVAL FOR A NEW SIGN AHEAD			
							SHEET TOTALS	34.50 SF	0.00 SF	0 EA	0 EA	0 EA	6 EA	0 EA	0 EA	6 EA	~~77.0~~ 90 FT											
							TOWN DIRECTIONAL TOTALS	644.2	0.0	17.0	1.0	1.0	153	0.0	0.0	78	1170.0											

SIGN SUMMARY SHEET

VERMONT AGENCY OF TRANSPORTATION

PROJECT NAME: **STATEWIDE SOUTHEAST REGION**
PROJECT NUMBER: **STPG SIGN (31)**

FILE NAME: **WEATHERSFIELD WESTBOUND** PLOT DATE: **8/19/2010**
PROJECT MANAGER: **A. GAMBLE** DRAWN BY: **M. MILLER**
DESIGNED BY: **M. MILLER** CHECKED BY: **A. GAMBLE**
WEATHERSFIELD VT-131 WB 15 SHEET **165** OF **175**

DIRECTION	MILEPOINT	LOCATION CODE (SHEET 2)	SIGN CODE	WIDTH (IN)	HEIGHT (IN)	SHEETING REMARKS	SIGN LEGEND	NEW SIGNS "A"	NEW SIGNS "B"	EXISTING SIGNS RETAIN	EXISTING SIGNS SALVAGE FROM	EXISTING SIGNS SALVAGE TO	EXISTING SIGNS REMOVE	EXIST POST RETAIN	EXIST POST REMOVE	NUMBER OF NEW POSTS	SQUARE STEEL (IN) 1.75 (LB / FT) 1.88	SQUARE STEEL (IN) 2.00 (LB / FT) 2.42	SQUARE STEEL (IN) 2.50 (LB / FT) 3.35	TUBULAR STEEL Ø (IN) FOUNDATION	TUBULAR STEEL Ø (IN) 3.00 (LB / FT) 7.60	TUBULAR STEEL Ø (IN) 3.50 (LB / FT) 9.00	TUBULAR STEEL Ø (IN) 4.00 (LB / FT) 10.80	TUBULAR STEEL Ø (IN) 5.00 (LB / FT) 14.60	SIGN FRAME REQUIRED	REMARKS	SIGN DETAIL: DETAIL IN SHS	SIGN DETAIL: DETAIL ON SHEET NUMBER	SIGN DETAIL: DETAIL ON STD SHEET NUMBER
WEATHERSFIELD WB							FY-FLUORESCENT YELLOW FYG-FLUORESCENT YELLOW GREEN																			"SHS"-STANDARD HIGHWAY SIGNS			
WB	3.245	F	W7-1B	30	30			6.25								1		15.75' X								INSTALL 305 FEET ± WEST OF THE SPEED LIMIT 50 SIGN THAT WAS REMOVED	X		
WB	2.460	F	W3-5	36	36								1		X													
		F	W3-5	36	36			9.00								2		13.5' 14.0' X									X		
WB	2.404	F	S3-1	30	30		SCHOOL BUS STOP AHEAD						1		X														
WB	2.346	F	R2-1	24	30								1		X															
		F	R2-1	30	36			7.50								1		15.5' X										6	
WB	2.313	F	W2-2MR	30	30		SIDE ROAD RIGHT (SYMBOL)						1		X															
		F	W1-10RL	36	36			9.00								2		13.75' 14.25' X								SOME TREE BRANCH REMOVAL MIGHT BE REQUIRED	X		
WB	2.263	F	W1-2L	30	30		LEFT CURVE						1		X														
WB	2.253	G	VR-017	24	30								1		X												LOTTERY LANE (TH-11)			
		G	VR-017	24	30			5.00								1		12.25' X										6	
WB	2.245	H	R1-1	30	30		1310 1420 0226						1		X															
		H	R1-1	30	30			6.25								1		12.25' X									X		
WB	2.182	F	VD-018	30	18		1310 1420 0220						1		X															
		F	VD-018	30	18			3.75								1		14.75' X										9	
SIGN SUMMARY SHEET							SHEET TOTALS	46.75	0.00	0	0	0	8	0	0	9		126.0 ~~135~~											
								SF	SF	EA	EA	EA	EA	EA	EA	EA		FT											
VERMONT AGENCY OF TRANSPORTATION							TOWN DIRECTIONAL TOTALS	644.2	0.0	17.0	1.0	1.0	153	0.0	0.0	78		1170.0											

PROJECT NAME: **STATEWIDE SOUTHEAST REGION**
PROJECT NUMBER: **STPG SIGN (31)**

FILE NAME: **WEATHERSFIELD WESTBOUND** PLOT DATE: **8/19/2010**
PROJECT MANAGER: **A. GAMBLE** DRAWN BY: **M. MILLER**
DESIGNED BY: **M. MILLER** CHECKED BY: **A. GAMBLE**
WEATHERSFIELD VT-131 WB 16 SHEET **166** OF **175**

DIRECTION	MILEPOINT	LOCATION CODE (SHEET 2)	SIGN CODE	WIDTH (IN)	HEIGHT (IN)	SHEETING REMARKS	SIGN LEGEND	NEW SIGNS "A"	NEW SIGNS "B"	EXISTING SIGNS RETAIN	EXISTING SIGNS SALVAGE FROM	EXISTING SIGNS SALVAGE TO	EXISTING SIGNS REMOVE	EXIST POST RETAIN	EXIST POST REMOVE	NUMBER OF NEW POSTS	SQUARE STEEL (IN) 1.75 (LB / FT) 1.88	SQUARE STEEL (IN) 2.00 (LB / FT) 2.42	SQUARE STEEL (IN) 2.50 (LB / FT) 3.35	TUBULAR STEEL Ø (IN) FOUNDATION	TUBULAR STEEL Ø (IN) 3.00 (LB / FT) 7.60	TUBULAR STEEL Ø (IN) 3.50 (LB / FT) 9.00	TUBULAR STEEL Ø (IN) 4.00 (LB / FT) 10.80	TUBULAR STEEL Ø (IN) 5.00 (LB / FT) 14.60	SIGN FRAME REQUIRED	REMARKS	SIGN DETAIL: DETAIL IN SHS	SIGN DETAIL: DETAIL ON SHEET NUMBER	SIGN DETAIL: DETAIL ON STD SHEET NUMBER
WEATHERSFIELD WB							FY-FLUORESCENT YELLOW FYG-FLUORESCENT YELLOW GREEN																			"SHS"-STANDARD HIGHWAY SIGNS			
WB	2.157	F	R2-1	24	30								1		X														
		F	R2-1	24	30			5.00								1		15.0' X									X	
WB	2.065	F	S3-1	30	30		SCHOOL BUS STOP AHEAD						1		X														
WB	2.012	G	VR-017	24	30								1		X												AMSDEN SCHOOL RD (TH-10)			
		G	VR-017	24	30			5.00								1		12.75' X										6
WB	2.006	H	R1-1	30	30		1310 1420 0202						1		X														
		H	R1-1	30	30			6.25								1		13.25' X									X	
WB	1.987	F	W1-5R	30	30	FY	RIGHT WINDING CURVES			1				X														
		F	W7-3A	24	18	FY	NEXT 1/2 MILE (PLAQUE)			1																		
WB	1.771	F	R2-1	24	30								1		X														
		F	R2-1	24	30			5.00								1		10.0' X									X	
WB	1.675	F	VD-062B	72	16		BUSINESS DIRECTORY SIGN			1				X													ROCKLEDGE FARM ===>			
WB	1.637	F	VW-202	30	30		TRUCKS ENTERING						1		X														
		F	S3-1	30	30		SCHOOL BUS STOP AHEAD						1														SCHOOL BUS STOP AHEAD SIGN WILL NOT BE REPLACED			
		F	VW-202	30	30			6.25								1		12.75' X										E-154
							SHEET TOTALS	27.50 SF	0.00 SF	3 EA	0 EA	0 EA	7 EA	0 EA	0 EA	5 EA		63.75 ~~75~~ FT										
							TOWN DIRECTIONAL TOTALS	644.2	0.0	17.0	1.0	1.0	153	0.0	0.0	78		1170.0										

SIGN SUMMARY SHEET

VERMONT AGENCY OF TRANSPORTATION

PROJECT NAME: **STATEWIDE SOUTHEAST REGION**
PROJECT NUMBER: **STPG SIGN (31)**

FILE NAME: **WEATHERSFIELD WESTBOUND** PLOT DATE: **8/19/2010**
PROJECT MANAGER: **A. GAMBLE** DRAWN BY: **M. MILLER**
DESIGNED BY: **M. MILLER** CHECKED BY: **A. GAMBLE**
WEATHERSFIELD VT-131 WB 17 SHEET **167** OF **175**

DIRECTION	MILEPOINT	LOCATION CODE (SHEET 2)	SIGN CODE	WIDTH (IN)	HEIGHT (IN)	SHEETING REMARKS	SIGN LEGEND	NEW SIGNS "A"	NEW SIGNS "B"	EXISTING SIGNS RETAIN	EXISTING SIGNS SALVAGE FROM	EXISTING SIGNS SALVAGE TO	EXISTING SIGNS REMOVE	EXIST POST RETAIN	EXIST POST REMOVE	NUMBER OF NEW POSTS	SQUARE STEEL (IN) 1.75 (LB / FT) 1.88	SQUARE STEEL (IN) 2.00 (LB / FT) 2.42	SQUARE STEEL (IN) 2.50 (LB / FT) 3.35	TUBULAR STEEL Ø (IN) FOUNDATION	TUBULAR STEEL Ø (IN) 3.00 (LB / FT) 7.60	TUBULAR STEEL Ø (IN) 3.50 (LB / FT) 9.00	TUBULAR STEEL Ø (IN) 4.00 (LB / FT) 10.80	TUBULAR STEEL Ø (IN) 5.00 (LB / FT) 14.60	SIGN FRAME REQUIRED	REMARKS	SIGN DETAIL: DETAIL IN SHS	SIGN DETAIL: DETAIL ON SHEET NUMBER	SIGN DETAIL: DETAIL ON STD SHEET NUMBER
WEATHERSFIELD WB							FY-FLUORESCENT YELLOW FYG-FLUORESCENT YELLOW GREEN																			"SHS"-STANDARD HIGHWAY SIGNS			
WB	1.605	F	D9-1	24	24		PHONE (SYMBOL)						1		X														
		F	VD-058	24	8		AHEAD (PLAQUE)						1																
WB	1.527	F	W11-8	30	30								1		X														
		F	W11-8	30	30			6.25								1		13.0' X									X		
WB	1.506	F	VD-018	30	18								1		X																
		F	VD-018	30	18			3.75								1		12.0' X										9	
WB	1.485	F	M2-1	21	15								1		X														
		F	M1-5	30	24								1																
		F	M2-1	21	15			2.19								1		13.0' X								GREEN ON WHITE	X		
		F	M1-5	30	24			5.00																					E-136B
WB	1.454	F	W3-1	36	36		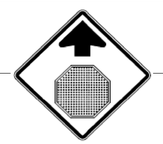						1		X														
		F	W3-1	36	36			9.00								2		12.75' 12.75' X									X		
WB	1.405	F	D1-1A	72	10								1	X												RETAIN THE EXISTING POSTS			
		F	D1-1A	72	10		(6) DESTINATION SIGN ASSEMBLY						1																
		F	D1-1A	72	10								1																
SIGN SUMMARY SHEET							SHEET TOTALS	26.19	0.00	0	0	0	10	0	0	5		~~63.75~~ 75										
								SF	SF	EA	EA	EA	EA	EA	EA	EA		FT										
VERMONT AGENCY OF TRANSPORTATION							TOWN DIRECTIONAL TOTALS	644.2	0.0	17.0	1.0	1.0	153	0.0	0.0	78		1170.0										

PROJECT NAME: **STATEWIDE SOUTHEAST REGION**
PROJECT NUMBER: **STPG SIGN (31)**

FILE NAME: **WEATHERSFIELD WESTBOUND** PLOT DATE: **8/19/2010**
PROJECT MANAGER: **A. GAMBLE** DRAWN BY: **M. MILLER**
DESIGNED BY: **M. MILLER** CHECKED BY: **A. GAMBLE**
WEATHERSFIELD VT-131 WB 18 SHEET **168** OF **175**

DIRECTION	MILEPOINT	LOCATION CODE (SHEET 2)	SIGN CODE	WIDTH (IN)	HEIGHT (IN)	SHEETING REMARKS	SIGN LEGEND	NEW SIGNS "A"	NEW SIGNS "B"	EXISTING SIGNS RETAIN	EXISTING SIGNS SALVAGE FROM	EXISTING SIGNS SALVAGE TO	EXISTING SIGNS REMOVE	EXIST POST RETAIN	EXIST POST REMOVE	NUMBER OF NEW POSTS	SQUARE STEEL (IN) 1.75 (LB / FT) 1.88	SQUARE STEEL (IN) 2.00 (LB / FT) 2.42	SQUARE STEEL (IN) 2.50 (LB / FT) 3.35	TUBULAR STEEL Ø (IN) FOUNDATION	TUBULAR STEEL Ø (IN) 3.00 (LB / FT) 7.60	TUBULAR STEEL Ø (IN) 3.50 (LB / FT) 9.00	TUBULAR STEEL Ø (IN) 4.00 (LB / FT) 10.80	TUBULAR STEEL Ø (IN) 5.00 (LB / FT) 14.60	SIGN FRAME REQUIRED	REMARKS	SIGN DETAIL: DETAIL IN SHS	SIGN DETAIL: DETAIL ON SHEET NUMBER	SIGN DETAIL: DETAIL ON STD SHEET NUMBER
WEATHERSFIELD WB							FY-FLUORESCENT YELLOW FYG-FLUORESCENT YELLOW GREEN																			"SHS"-STANDARD HIGHWAY SIGNS			
		F	D1-1A	72	10								1																
		F	D1-1A	72	10								1																
		F	D1-1A	72	10								1																
		F	D1-1A	72	12			6.00						X													4	
		F	D1-1A	72	12			6.00																		4	
		F	D1-1A	72	12			6.00																		4	
		F	D1-1A	72	12			6.00																		4	
		F	D1-1A	72	12			6.00																		4	
		F	D1-1A	72	12		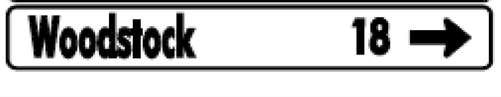	6.00																		4	
WB	1.362	F	M3-3	24	12								1	X													RETAIN THE EXISTING POSTS AND SIGN FRAME			
		F	M1-5	30	24		(9) SIGN ROUTE MARKER ASSEMBLY						1																	
		F	M6-1	21	15								1																
		F	M3-4	24	12								1																
		F	M1-5	24	24								1																
		F	M6-3	21	15								1																
							SHEET TOTALS	36.00	0.00	0	0	0	9	0	0	0	0												
								SF	SF	EA	EA	EA	EA	EA	EA	EA	FT												
							TOWN DIRECTIONAL TOTALS	644.2	0.0	17.0	1.0	1.0	153	0.0	0.0	78	1170.0												

SIGN SUMMARY SHEET

VERMONT AGENCY OF TRANSPORTATION

PROJECT NAME: **STATEWIDE SOUTHEAST REGION**
PROJECT NUMBER: **STPG SIGN (31)**

FILE NAME: **WEATHERSFIELD WESTBOUND** PLOT DATE: **8/19/2010**
PROJECT MANAGER: **A. GAMBLE** DRAWN BY: **M. MILLER**
DESIGNED BY: **M. MILLER** CHECKED BY: **A. GAMBLE**
WEATHERSFIELD VT-131 WB 19 SHEET **169** OF **175**

DIRECTION	MILEPOINT	LOCATION CODE (SHEET 2)	SIGN CODE	WIDTH (IN)	HEIGHT (IN)	SHEETING REMARKS	SIGN LEGEND	NEW SIGNS "A"	NEW SIGNS "B"	EXISTING SIGNS RETAIN	EXISTING SIGNS SALVAGE FROM	EXISTING SIGNS SALVAGE TO	EXISTING SIGNS REMOVE	EXIST POST RETAIN	EXIST POST REMOVE	NUMBER OF NEW POSTS	SQUARE STEEL (IN) 1.75 / 2.00 / 2.50 (LB / FT) 1.88 / 2.42 / 3.35	TUBULAR STEEL Ø (IN) 3.00 / 3.50 / 4.00 / 5.00 (LB / FT) 7.60 / 9.00 / 10.80 / 14.60	FOUNDATION	SIGN FRAME REQUIRED	REMARKS	SIGN DETAIL: DETAIL IN SHS	SIGN DETAIL: DETAIL ON SHEET NUMBER	SIGN DETAIL: DETAIL ON STD SHEET NUMBER
WEATHERSFIELD WB							FY-FLUORESCENT YELLOW FYG-FLUORESCENT YELLOW GREEN														"SHS"-STANDARD HIGHWAY SIGNS			
		F	M3-1	24	12								1											
		F	M1-5	24	24								1											
		F	M6-1	21	15								1											
		F	M3-3	24	12		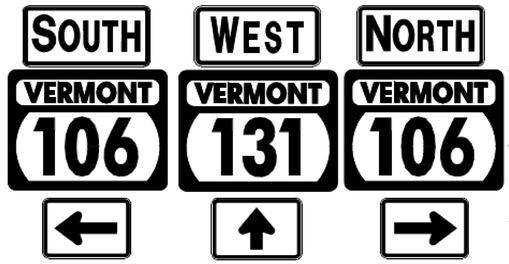	2.00						X						GREEN ON WHITE	X		
		F	M1-5	30	24			5.00																E-136B
		F	M6-1	21	15			2.19														GREEN ON WHITE	X		
		F	M3-4	24	12			2.00														GREEN ON WHITE	X		
		F	M1-5	30	24			5.00																E-136B
		F	M6-3	21	15			2.19														GREEN ON WHITE	X		
		F	M3-1	24	12			2.00														GREEN ON WHITE	X		
		F	M1-5	30	24			5.00																E-136B
		F	M6-1	21	15			2.19														GREEN ON WHITE	X		
WB	1.324	F	R1-1	36	36		1060 1420 0431						1		X									
		F	R1-1	36	36			9.00								2	13.75' 13.75' X						X	
WB	1.300	E	R1-1	48	48								1		X									
							SHEET TOTALS	36.57	0.00	0	0	0	5	0	0	2	~~27.5'~~ ~~30~~							
								SF	SF	EA	EA	EA	EA	EA	EA	EA	FT							
							TOWN DIRECTIONAL TOTALS	644.2	0.0	17.0	1.0	1.0	153	0.0	0.0	78	1170.0							

SIGN SUMMARY SHEET

VERMONT AGENCY OF TRANSPORTATION

PROJECT NAME: STATEWIDE SOUTHEAST REGION
PROJECT NUMBER: STPG SIGN (31)

FILE NAME: WEATHERSFIELD WESTBOUND
PROJECT MANAGER: A. GAMBLE
DESIGNED BY: M. MILLER
WEATHERSFIELD VT-131 WB 20

PLOT DATE: 8/19/2010
DRAWN BY: M. MILLER
CHECKED BY: A. GAMBLE

DIRECTION	MILEPOINT	LOCATION CODE (SHEET 2)	SIGN CODE	WIDTH (IN)	HEIGHT (IN)	SHEETING REMARKS	SIGN LEGEND	NEW SIGNS "A"	NEW SIGNS "B"	EXISTING SIGNS RETAIN	EXISTING SIGNS SALVAGE FROM	EXISTING SIGNS SALVAGE TO	EXISTING SIGNS REMOVE	EXIST POST RETAIN	EXIST POST REMOVE	NUMBER OF NEW POSTS	SQUARE STEEL (IN) 1.75 (LB / FT) 1.88	SQUARE STEEL (IN) 2.00 (LB / FT) 2.42	SQUARE STEEL (IN) 2.50 (LB / FT) 3.35	TUBULAR STEEL Ø (IN) FOUNDATION	TUBULAR STEEL Ø (IN) 3.00 (LB / FT) 7.60	TUBULAR STEEL Ø (IN) 3.50 (LB / FT) 9.00	TUBULAR STEEL Ø (IN) 4.00 (LB / FT) 10.80	TUBULAR STEEL Ø (IN) 5.00 (LB / FT) 14.60	SIGN FRAME REQUIRED	REMARKS	SIGN DETAIL: DETAIL IN SHS	SIGN DETAIL: DETAIL ON SHEET NUMBER	SIGN DETAIL: DETAIL ON STD SHEET NUMBER
WEATHERSFIELD WB							FY-FLUORESCENT YELLOW FYG-FLUORESCENT YELLOW GREEN																			"SHS"-STANDARD HIGHWAY SIGNS			
		E	R1-1	48	48			16.00								2		14.5' 14.75' X								FACES EASTBOUND TRAFFIC; NOTE LARGE SIZE OF THIS SIGN	X		
WB	1.278	F	R2-1	24	30		SPEED LIMIT 40						1		X													
		F	VR-041	24	24		THROUGH WAY BEGINS HERE						1													WILL NOT BE REPLACED			
		E	VR-040	24	24		THROUGH WAY ENDS HERE (ON BACK)						1													WILL NOT BE REPLACED			
		F	M3-4	24	12			2.00								1		14.0' X								**GREEN ON WHITE**	X		
		F	M1-5	30	24			5.00																					E-136B
WB	1.243	F	M3-4	24	12		WEST						1		X													
		F	M1-5	24	24		VT 131						1															
		F	R2-1	24	30			5.00								1		14.0' X									X		
WB	1.188	E	W3-1	36	36		STOP AHEAD (SYMBOL)						1		X											FACES EASTBOUND TRAFFIC			
		E	W16-2	24	18		600 FEET (PLAQUE)						1															
WB	1.100	F	D2-1	72	10								1		X													
		F	D2-1	72	10								1															
		F	D2-1	72	12		Cavendish 7	6.00								2		13.5' 14.75' X										4	
		F	D2-1	72	12		Ludlow 12	6.00																				4	
SIGN SUMMARY SHEET							SHEET TOTALS	40.00	0.00	0	0	0	9	0	0	6		85.5' ~~90~~										
								SF	SF	EA	EA	EA	EA	EA	EA	EA		FT										
VERMONT AGENCY OF TRANSPORTATION							TOWN DIRECTIONAL TOTALS	644.2	0.0	17.0	1.0	1.0	153	0.0	0.0	78		1170.0										

PROJECT NAME: **STATEWIDE SOUTHEAST REGION**
PROJECT NUMBER: **STPG SIGN (31)**

FILE NAME: **WEATHERSFIELD WESTBOUND** PLOT DATE: **8/19/2010**
PROJECT MANAGER: **A. GAMBLE** DRAWN BY: **M. MILLER**
DESIGNED BY: **M. MILLER** CHECKED BY: **A. GAMBLE**
WEATHERSFIELD VT-131 WB 21 SHEET **171** OF **175**

DIRECTION	MILEPOINT	LOCATION CODE (SHEET 2)	SIGN CODE	WIDTH (IN)	HEIGHT (IN)	SHEETING REMARKS	SIGN LEGEND	NEW SIGNS "A"	NEW SIGNS "B"	EXISTING SIGNS RETAIN	EXISTING SIGNS SALVAGE FROM	EXISTING SIGNS SALVAGE TO	EXISTING SIGNS REMOVE	EXIST POST RETAIN	EXIST POST REMOVE	NUMBER OF NEW POSTS	SQUARE STEEL (IN) (LB / FT) 1.75 / 1.88	SQUARE STEEL (IN) (LB / FT) 2.00 / 2.42	SQUARE STEEL (IN) (LB / FT) 2.50 / 3.35	TUBULAR STEEL Ø (IN) FOUNDATION	TUBULAR STEEL Ø (IN) (LB / FT) 3.00 / 7.60	TUBULAR STEEL Ø (IN) (LB / FT) 3.50 / 9.00	TUBULAR STEEL Ø (IN) (LB / FT) 4.00 / 10.80	TUBULAR STEEL Ø (IN) (LB / FT) 5.00 / 14.60	SIGN FRAME REQUIRED	REMARKS	SIGN DETAIL: DETAIL IN SHS	SIGN DETAIL: DETAIL ON SHEET NUMBER	SIGN DETAIL: DETAIL ON STD SHEET NUMBER
WEATHERSFIELD WB							FY-FLUORESCENT YELLOW FYG-FLUORESCENT YELLOW GREEN																			"SHS"-STANDARD HIGHWAY SIGNS			
WB	1.047	F	R2-1	24	30								1		X													
		F	R2-1	24	30			5.00								1		14.0' X								X		
WB	1.036	G	VR-017	24	30								1		X											GROUT RD (TH-18)			
		G	VR-017	24	30			5.00								1		13.25' X									6	
WB	1.028	H	R1-1	30	30		1310 1420 0105						1		X													
		H	R1-1	30	30			6.25								1		11.5' X								X		
WB	0.000	G	VD-024	60	7.5		CAVENDISH I WEATHERSFIELD						1		X											REMOVE ONLY IF THE NEW SIGN WAS INSTALLED ACROSS THE ROAD			
WB	7.510	F	VW16-18P	24	12			2.00																	This set of 3 signs replaced the sign originally at this location. See e-mail from A. Gamble on 4/4/11. See sheet #161.			
WB	7.510	F	R2 - 1	24	30			5.00																				
WB	7.510	F	R2 - 5P	24	18			3.00								1		13.5' x											
WB	5.460	F	W11 - 6H	24	24		Paid for on sheet #148.	4.00								1		15.5' x		Snow mobile crossing-folded sign						Sign added at request of District #2 Maintenance crew.			
WB	8.640																		This new sign was installed onto the old post to face WB Traffic. These 3 signs were salvaged onto the old post. 2 signs face EB. 1 sign faces WB (Pay for removal)							
WB	8.640																											
							SHEET TOTALS	30.25 16.25	0.00	0	3 0	3 0	7 4	0	0	3		85.5' 45										
								SF	SF	EA	EA	EA	EA	EA	EA	EA		FT										
							TOWN DIRECTIONAL TOTALS	644.2	0.0	17.0	1.0	1.0	153	0.0	0.0	78		1170.0										

SIGN SUMMARY SHEET

VERMONT AGENCY OF TRANSPORTATION

PROJECT NAME: STATEWIDE SOUTHEAST REGION
PROJECT NUMBER: STPG SIGN (31)

FILE NAME: WEATHERSFIELD WESTBOUND
PROJECT MANAGER: A. GAMBLE
DESIGNED BY: M. MILLER
WEATHERSFIELD VT-131 WB 22

PLOT DATE: 8/19/2010
DRAWN BY: M. MILLER
CHECKED BY: A. GAMBLE
SHEET 172 OF 175

TOWN TOTAL SIGN SUMMARY SHEET

STATEWIDE - SOUTHEAST REGION STPG SIGN (31)

Townname-Route	County	Town Mileage	NEW SIGNS (SF)		EXISTING SIGNS (EA)				EXIST POST (EA)		NUMBER OF NEW POSTS (EA)				SQUARE STEEL (IN)			TUBULAR STEEL Ø (IN)				
															1.75	2.00	2.50		3.00	3.50	4.00	5.00
											1.75"	2"	2.5"		(LB / FT)			FOUNDATION	(LB / FT)			
			TYPE A	TYPE B	RETAIN	SALVAGE FROM	SALVAGE TO	REMOVE	RETAIN	REMOVE	(LB / FT)			TOTAL POSTS	1.88	2.42	3.35		7.60	9.00	10.80	14.60
											1.88	2.42	3.35									
Brattleboro VT-9 EB	Windham	4.190	305.3	0	4	1	1	66	0	0	0	53	0	53	0	795	0					
Brattleboro VT-9 WB	Windham	4.190	268.5	0	2	1	1	64	0	0	0	47	0	47	0	705	0					
Newfane VT-30 NB	Windham	5.662	261.0	0	27	0	0	52	0	0	0	47	0	47	0	705	0					
Newfane VT-30 SB	Windham	5.662	284.2	0	23	2	2	55	0	0	0	50	0	50	0	750	0					
Townshend VT-30 NB	Windham	7.357	334.0	0	25	0	0	81	0	0	0	54	0	54	0	810	0					
Townshend VT-30 SB	Windham	7.357	304.7	0	25	2	2	68	0	0	0	55	0	55	0	825	0					
Rockingham US-5 NB	Windham	7.360	506.0	0	9	6	7	93	0	0	0	76	0	76	0	1140	0					
Rockingham US-5 SB	Windham	7.360	442.6	0	9	3	3	78	0	0	0	73	0	73	0	1095	0					
Chester VT-10 EB	Windsor	3.540	163.5	0	1	0	0	33	0	0	0	30	0	30	0	450	0					
Chester VT-10 WB	Windsor	3.540	275.0	0	0	0	0	53	0	0	1	47	0	48	15	705	0					
Springfield VT-10 EB	Windsor	0.833	146.7	0	7	0	0	35	0	0	0	22	0	22	0	330	0					
Springfield VT-10 WB	Windsor	0.833	66.9	0	3	0	0	13	0	0	0	11	0	11	0	165	0					
Weathersfield VT-131 EB	Windsor	8.647	778.3	0	47	9	9	180	0	0	0	108	0	108	0	1620	0					
Weathersfield VT-131 WB	Windsor	8.647	644.2	0	17	1	1	153	0	0	0	78	0	78	0	1170	0					
				Sub-Total		25	26	1024					**Sub-Total**		15	11265	0					
Estimated Salvaged Street Name Signs to be erected onto new posts =							5															
Salvaged From signs to be added to Remove total =								25														
		TOTAL =	4780.9	0	199	25	31	1049	0	0	1	751	0	752	11280			0	0	0	0	0

PROJECT NAME: STATEWIDE - SOUTHEAST REGION

PROJECT NUMBER: STPG SIGN (31)

FILE NAME: 10B010.SS
PROJECT LEADER: A. GAMBLE
DESIGNED BY: M. MILLER
TOWN TOTAL SIGN SUMMARY SHEET

PLOT DATE: 07-OCT-2010
DRAWN BY: M. MILLER
CHECKED BY: A. GAMBLE

Table 6H-2. Meaning of Symbols on Typical Application Diagrams

- Arrow panel
- Arrow panel support or trailer (shown facing down)
- Changeable message sign or support trailer
- Channelizing device
- Crash Cushion
- Direction of temporary traffic detour
- Direction of traffic
- Flagger
- High level warning device (Flag tree)
- Luminaire
- Pavement markings that should be removed for a long term project
- Sign (shown facing left)
- Surveyor
- Temporary barrier
- Temporary barrier with warning lights
- Traffic or Pedestrian signal
- Truck mounted attenuator
- Type III Barricade
- Warning lights
- Work space
- Work vehicle

Figure 6E-1. Use of Hand-Signaling Devices by Flaggers

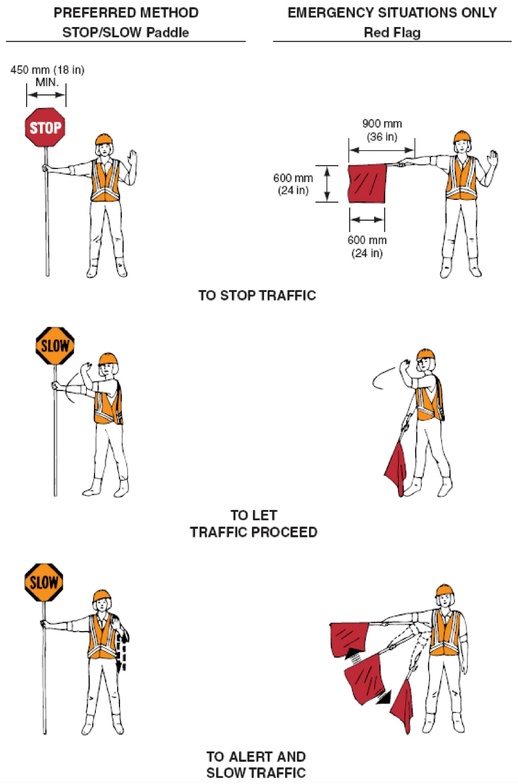

Figure 6C-2. Types of Tapers and Buffer Spaces

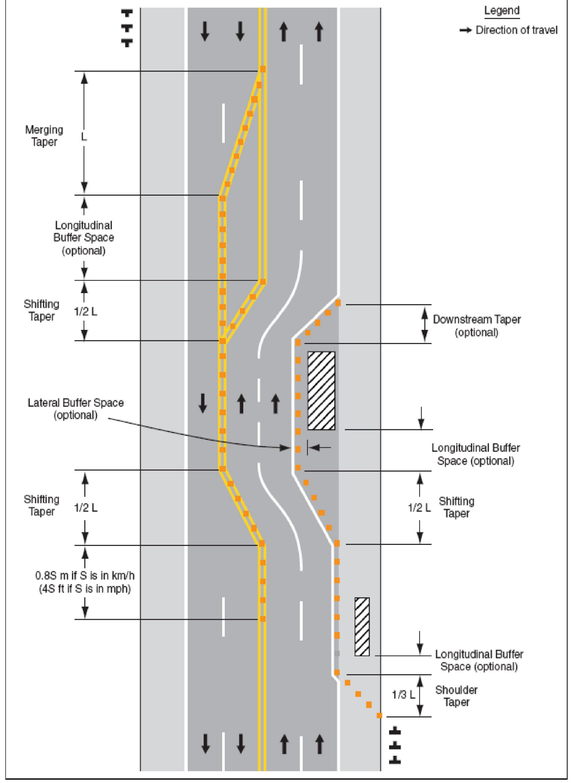

Figure 6H-1. Work Beyond the Shoulder (TA-1)

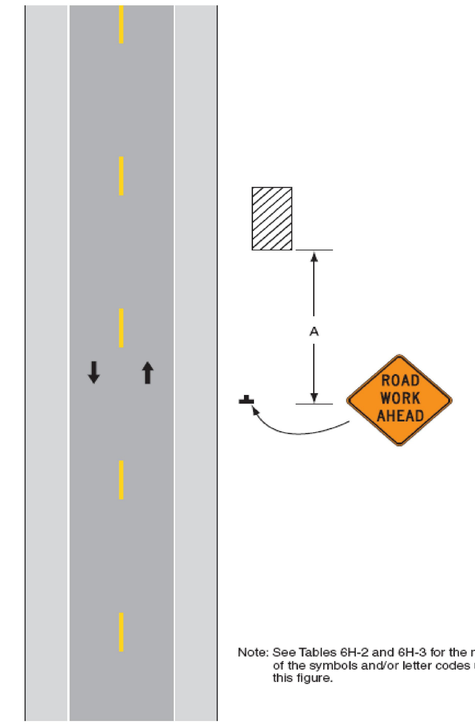

Note: See Tables 6H-2 and 6H-3 for the meaning of the symbols and/or letter codes used in this figure.

Typical Application 1

Table 6C-3. Taper Length Criteria for Temporary Traffic Control Zones

Type of Taper	Taper Length (L)*
Merging Taper	at least L
Shifting Taper	at least 0.5L
Shoulder Taper	at least 0.33L
One-Lane, Two-Way Traffic Taper	30 m (100 ft) maximum
Downstream Taper	30 m (100 ft) per lane

Table 6C-4. Formulas for Determining Taper Lengths

Speed Limit (S)	Taper Length (L) Meters
60 km/h or less	$L = \frac{WS^2}{155}$
70 km/h or more	$L = \frac{WS}{1.6}$

Speed Limit (S)	Taper Length (L) Feet
40 mph or less	$L = \frac{WS^2}{60}$
45 mph or more	L = WS

Where: L = taper length in meters (feet)
W = width of offset in meters (feet)
S = posted speed limit, or off-peak 85th-percentile speed prior to work starting, or the anticipated operating speed in km/h (mph)

Table 6H-3. Meaning of Letter Codes on Typical Application Diagrams

Road Type	Distance Between Signs•• A	B	C
Urban (low speed)•	100 feet	100 feet	100 feet
Urban (high speed)•	350 feet	350 feet	350 feet
Rural	500 feet	500 feet	500 feet
Expressway / Freeway	1,000 feet	1,500 feet	2,640 feet

• Speed category to be determined by highway agency

•• The column headings A, B, and C are the dimensions shown in Figures 6H-1 through 6H-46 in the 2009 MUTCD. The A dimension is the distance from the transition or point of restriction to the first sign. The B dimension is the distance between the first and second signs. The C dimension is the distance between the second and third signs. (The "first sign" is the sign in a three-sign series that is closest to the TTC zone. The "third sign" is the sign that is furthest upstream from the TTC zone.)

Figure 6F-7. Channelizing Devices (Sheet 1 of 2)

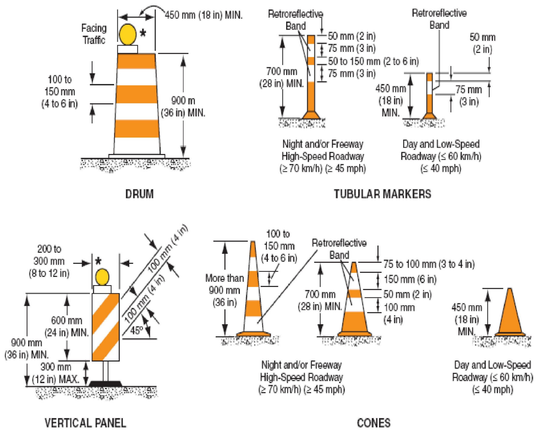

* Warning lights (optional)

Note: If drums, cones, or tubular markers are used to channelize pedestrians, they shall be located such that there are no gaps between the bases of the devices, in order to create a continuous bottom, and the height of each individual drum, cone, or tubular marker shall be no less than 900 mm (36 in) to be detectable to users of long canes.

TEMPORARY TRAFFIC CONTROL NOTES

1. ALL TEMPORARY TRAFFIC CONTROL SHALL BE IN ACCORDANCE WITH THESE PROJECT PLANS, APPLICABLE VTRANS E-SERIES STANDARD DRAWINGS, AND THE MANUAL ON UNIFORM TRAFFIC CONTROL DEVICES (MUTCD), DATED 2009, AND ITS LATEST REVISIONS, OR AS DIRECTED BY THE RESIDENT ENGINEER. IF THE CONTRACTOR DOES NOT WISH TO FOLLOW THE TEMPORARY TRAFFIC CONTROL PROVIDED, HE/SHE MAY SUBMIT AN ALTERNATE PROPOSAL AT THE PRE-CONSTRUCTION MEETING IMPLEMENTING THE PROPOSED CHANGES FOR REVIEW AND APPROVAL BY THE RESIDENT ENGINEER.
2. THE CONTRACTOR MUST PROVIDE ACCESS THROUGH THE WORK ZONE FOR EMERGENCY VEHICLES AT ALL TIMES.
3. THE CONTRACTOR SHALL CONDUCT THE WORK AT ALL TIMES IN SUCH A MANNER AND IN SUCH SEQUENCE SO AS TO ENSURE THE LEAST INTERFERENCE WITH TRAFFIC OCCURS.
4. SIGNS SHALL ONLY BE VISIBLE TO MOTORISTS AT THE TIMES WHEN THE MESSAGE IS PERTINENT, I.E. A "FLAGGER AHEAD" SIGN SHALL ONLY BE VISIBLE TO MOTORISTS WHEN THE FLAGGER IS ACTUALLY PRESENT PERFORMING THEIR DUTIES.
5. PAYMENT FOR CONSTRUCTION SIGNING WILL BE MADE UNDER CONTRACT ITEM 641.10.

PROJECT NAME: STATEWIDE - SOUTHEAST REGION

PROJECT NUMBER: STPG SIGN (31)

FILE NAME: 10B010.TC_1
PROJECT LEADER: A. GAMBLE
DESIGNED BY: M. MILLER
TRAFFIC CONTROL 1

PLOT DATE: 18-OCT-2010
DRAWN BY: M. MILLER
CHECKED BY: A. GAMBLE
SHEET 174 OF 175

Figure 6H-3. Work on Shoulders (TA-3)

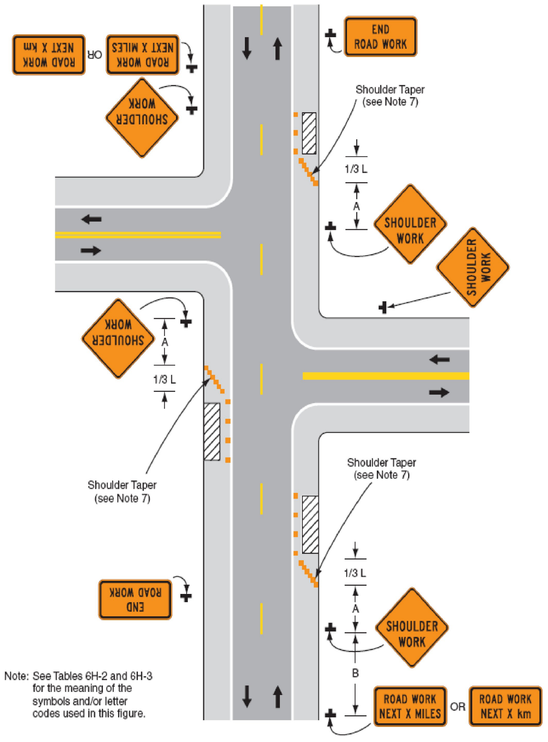

Typical Application 3

Figure 6H-4. Short-Duration or Mobile Operation on Shoulder (TA-4)

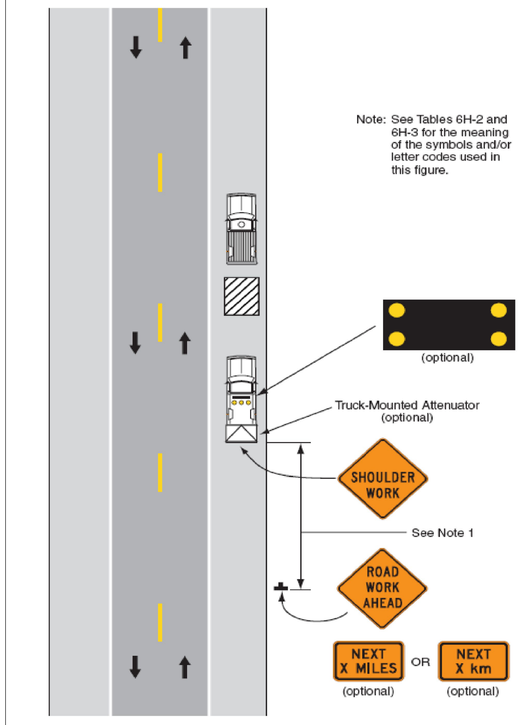

Typical Application 4

Figure 6H-6. Shoulder Work with Minor Encroachment (TA-6)

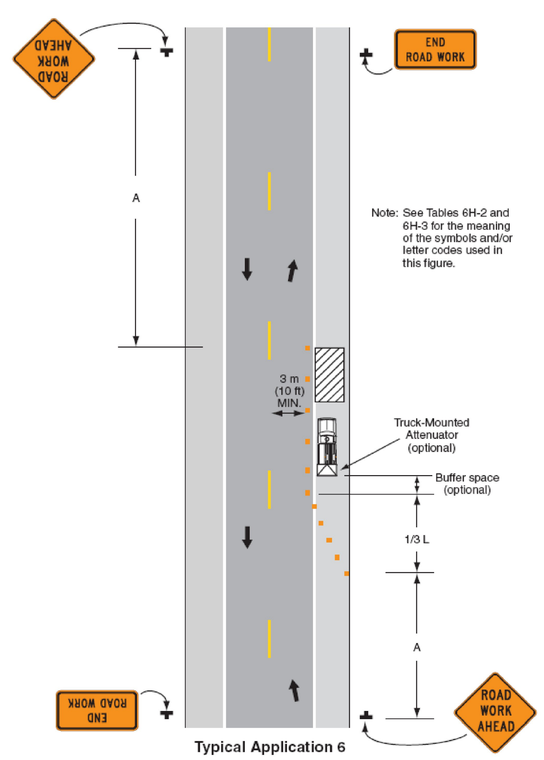

Typical Application 6

Figure 6H-10. Lane Closure on Two-Lane Road Using Flaggers (TA-10)

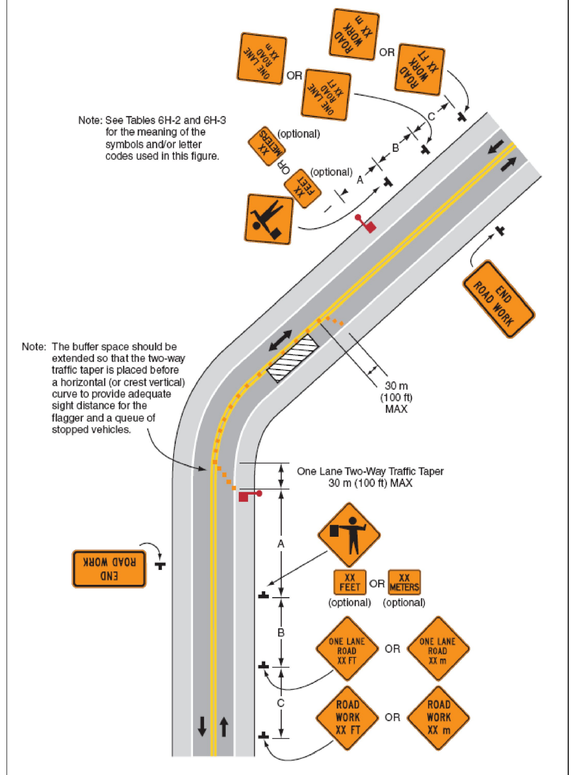

Typical Application 10

PROJECT NAME: STATEWIDE - SOUTHEAST REGION	
PROJECT NUMBER: STPG SIGN (31)	
FILE NAME: 10B010.TC_2	PLOT DATE: 07-OCT-2010
PROJECT LEADER: A. GAMBLE	DRAWN BY: M. MILLER
DESIGNED BY: M. MILLER	CHECKED BY: A. GAMBLE
TRAFFIC CONTROL 2	SHEET 175 OF 175