
STATE OF VERMONT
AGENCY OF TRANSPORTATION

INDEX OF SHEETS
SEE SHEET 2

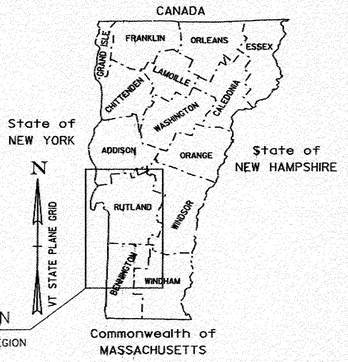


PROPOSED IMPROVEMENT

TOWNS OF DORSET, MOUNT TABOR, DANBY, SHAFTSBURY, WINHALL, AND STOCKBRIDGE
COUNTIES OF BENNINGTON, RUTLAND, AND WINDSOR
VERMONT ROUTES 7A, 30, 107
US ROUTE 7

SOUTHWEST REGION SIGN REPLACEMENT - 32.878 MILES:
US 7 DORSET MP 1.750-DANBY MP 2.473, VT 7A SHAFTSBURY MP 0.000-6.895,
VT 30 WINHALL MP 0.000-7.659, VT 107 STOCKBRIDGE MP 0.000-6.700

LENGTH OF ROADWAY = 32.878 MILES
LENGTH OF PROJECT = 32.878 MILES

WORK TO BE PERFORMED UNDER THIS PROJECT INCLUDES THE REMOVAL OF EXISTING SIGNS AND POSTS AND THE INSTALLATION OF NEW SIGNS AND SIGN POSTS AND INCIDENTAL ITEMS.

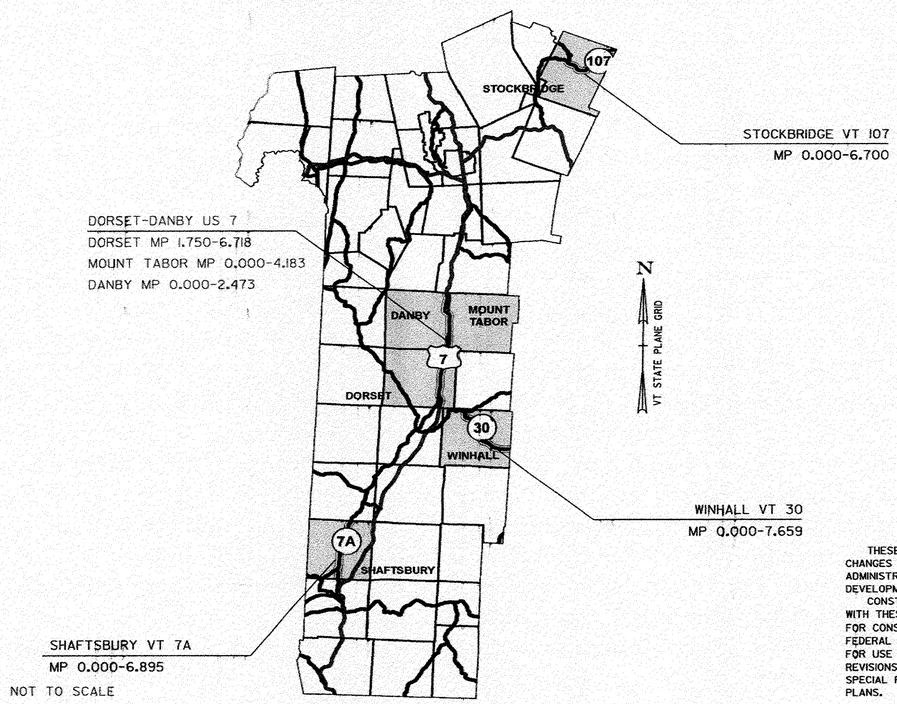

NOT TO SCALE

RECORD PLANS

CONTRACTOR: F. R. LAFAYETTE, INC.- ESSEX JUNCTION, VT

RESIDENT ENGINEER: JOSH HULETT

CONSTRUCTION BEGAN: JUNE 14, 2011

CONSTRUCTION COMPLETE: JULY 7, 2011

RECORD PLANS BY: JOSH HULETT & C. PIERCE

I HEREBY CERTIFY THAT ALL THE CONSTUCTION REQUIRED BY THIS SET OF DRAWINGS HAS BEEN ACCOMPLISHED AS INDICATED HEREIN.

BY _____ RESIDENT ENGINEER

DATE 5/27/12

NOTE: Any further information concerning final quantities, amounts or other details relative to this project may be found at Central Files in the electronic archives.

CONVENTIONAL SYMBOLS

COUNTY LINE	COUNTY LINE
TOWN LINE	TOWN LINE
LIMITS OF ACCESS	
POINT OF ACCESS	X
FENCE LINE	
STONE WALL	
TRAVELED WAY	
GUARD RAIL	
RAILROAD	
SURVEY LINE	
CULVERT	
POWER POLE	
TELEPHONE POLE	
TREES	
CONTROL OF ACCESS	
PROPERTY LINE	
R.O.W. TAKING LINE	
SLOPE RIGHTS	SR SR SR
TOP OF CUT	
TOE OF SLOPE	

SURVEYED BY : N/A
SURVEYED DATE : N/A

DATUM
VERTICAL N/A
HORIZONTAL N/A

THESE PLANS ARE SUBJECT TO SUCH ENGINEERING CHANGES AS MAY BE REQUIRED BY THE FEDERAL HIGHWAY ADMINISTRATION OR THE DIRECTOR OF PROGRAM DEVELOPMENT.
CONSTRUCTION IS TO BE CARRIED ON IN ACCORDANCE WITH THESE PLANS AND THE STANDARD SPECIFICATIONS FOR CONSTRUCTION DATED 2006, AS APPROVED BY THE FEDERAL HIGHWAY ADMINISTRATION ON JUNE 15, 2006 FOR USE ON THIS PROJECT, INCLUDING ALL SUBSEQUENT REVISIONS AND SUCH REVISED SPECIFICATIONS AND SPECIAL PROVISIONS AS ARE INCORPORATED IN THESE PLANS.

DIRECTOR OF PROGRAM DEVELOPMENT
APPROVED _____ DATE 8-31-10

PROJECT MANAGER : AMY GAMBLE

PROJECT NAME : STATEWIDE - SOUTHWEST REGION
PROJECT NUMBER : STPG SIGN (32)

SHEET 1 OF 90 SHEETS

INDEX SHEETS

1	TITLE SHEET
2	GENERAL NOTES
3	QUANTITY SHEET
4-6	SIGN DETAILS
7	ROUTE MARKER SIGN ASSEMBLY
8-17	SHAFTSBURY NB VT-7A TRAFFIC SIGN SUMMARY SHEETS 1-10
18-26	SHAFTSBURY SB VT-7A TRAFFIC SIGN SUMMARY SHEETS 1-9
27-38	WINHALL NB VT-30 TRAFFIC SIGN SUMMARY SHEETS 1-12
39-50	WINHALL SB VT-30 TRAFFIC SIGN SUMMARY SHEETS 1-12
51-55	DORSET NB US-7 TRAFFIC SIGN SUMMARY SHEETS 1-5
56-62	DORSET SB US-7 TRAFFIC SIGN SUMMARY SHEETS 1-7
63-67	MOUNT TABOR NB US-7 TRAFFIC SIGN SUMMARY SHEETS 1-5
68-72	MOUNT TABOR SB US-7 TRAFFIC SIGN SUMMARY SHEETS 1-5
73-74	DANBY NB US-7 TRAFFIC SIGN SUMMARY SHEETS 1-2
75-76	DANBY SB US-7 TRAFFIC SIGN SUMMARY SHEETS 1-2
77-81	STOCKBRIDGE EB VT-107 TRAFFIC SIGN SUMMARY SHEETS 1-5
82-87	STOCKBRIDGE WB VT-107 TRAFFIC SIGN SUMMARY SHEETS 1-6
88	TOWN TOTAL SIGN SUMMARY SHEET
89-90	TRAFFIC CONTROL SHEETS

STANDARDS

E-121	STANDARD SIGN PLACEMENT CONVENTIONAL ROAD	08/08/1995
E-136B	STATE ROUTE MARKER SIGN DETAILS	08/08/1995
E-138	MILEMARKER DETAILS STATE AND TOWN HIGHWAYS	05/30/2003
E-145A	REGULATORY SIGN DETAILS LANE USE CONTROL SIGNS	12/23/1994
E-164	SQUARE STEEL SIGN POST	06/08/09

GENERAL NOTES

SIGN DESIGN AND FABRICATION:

1. ALL SIGNS SHALL BE DESIGNED IN ACCORDANCE WITH THE LATEST REVISION OF THE 2009 MUTCD AND THE 2004 STANDARD HIGHWAY SIGN AND MARKINGS BOOK (SHS), VAOT STANDARDS OR AS DETAILED ON THE PLANS.
2. ALL LETTERS AND NUMBERS USED FOR ALL SIGNS SHALL CONFORM TO THE APPLICABLE FONT AS DEFINED AND DETAILED IN THE 2004 SHS.
3. ALL ARROWS AND SYMBOLS SHALL CONFORM WITH THE 2004 SHS UNLESS OTHERWISE DETAILED ON THE PLANS.
4. COLORS USED ON ALL SIGNS SHALL CONFORM WITH THE REQUIREMENTS OF SECTION 1A.12 OF THE MUTCD. FY = FLUORESCENT YELLOW, FYG = FLUORESCENT YELLOW GREEN.
5. SIGN SHEETING FOR FLUORESCENT YELLOW AND FLUORESCENT YELLOW GREEN SHALL BE ASTM D4956 TYPE VII, VIII OR IX. ALL OTHER SIGN SHEETING SHALL BE TYPE III OR IV.
6. SHEETING TYPES AND MANUFACTURERS SHALL NOT BE MIXED ON A SINGLE SIGN ASSEMBLY. SHEETING COLOR/TYPE SHOULD BE BY THE SAME MANUFACTURER AND BE CONSISTENT THROUGHOUT THE PROJECT.
7. SIGN BASE MATERIAL FOR DELINEATORS AND MILE MARKER PLAQUES (VD-700) SHALL BE 0.063" THICK FLAT SHEET ALUMINUM. UNLESS OTHERWISE NOTED ON THE PLANS, ALL OTHER SIGNS SHALL BE FLAT SHEET ALUMINUM WITH THE FOLLOWING MINIMUM THICKNESSES:


SIGN SIZE	9" X 12"		
	12" X 12"		
	18" X 18"		
	21" X 15"		
	24" X 10"		48" X 18"
	24" X 12"	36" X 12"	48" X 24"
	24" X 18"	36" X 15"	48" X 30"
	24" X 24"	36" X 18"	48" X 42"
	24" X 30"	36" X 24"	48" X 48"
	30" X 15"	30" X 42"	48" X 60"
	30" X 18"	36" X 36"	72" X 10"
	30" X 30"	36" X 48"	72" X 12"
	30" X 42"	36" X 54"	72" X 20"
THICKNESS	0.080"	0.100"	0.125"

SIGN POSTS:

1. ALL SIGN POSTS SHALL BE INSTALLED IN A NEW ANCHOR. ALL SIGNS INSTALLED IN PAVED OR CONCRETE ISLANDS OR SIDEWALKS SHALL ALSO BE INSTALLED WITH AN 18" SLEEVE.
2. 1.75" SQUARE STEEL POSTS SHALL BE 14 GAUGE STEEL. 2" AND 2.5" SQUARE STEEL POSTS SHALL BE 12 GAUGE STEEL.

SIGN INSTALLATION:

1. THE CONTRACTOR SHALL BE RESPONSIBLE FOR REPAIRING ANY DAMAGE TO PRIVATE OR PUBLIC PROPERTY CAUSED BY THE CONTRACTOR, AT THEIR EXPENSE.
2. ALL SIGNS WITHIN THE PROJECT LIMITS ARE TO BE REPLACED UNLESS OTHERWISE NOTED OR AS DIRECTED BY THE RESIDENT ENGINEER. SIGN LOCATIONS AS SHOWN ON THE PLANS ARE APPROXIMATE. EXACT LOCATIONS TO BE DETERMINED BY THE ENGINEER IN THE FIELD.
3. ALL SIGN PLACEMENT SHALL BE IN CONFORMANCE WITH VAOT STANDARD E-121 STANDARD SIGN PLACEMENT CONVENTIONAL ROADS.

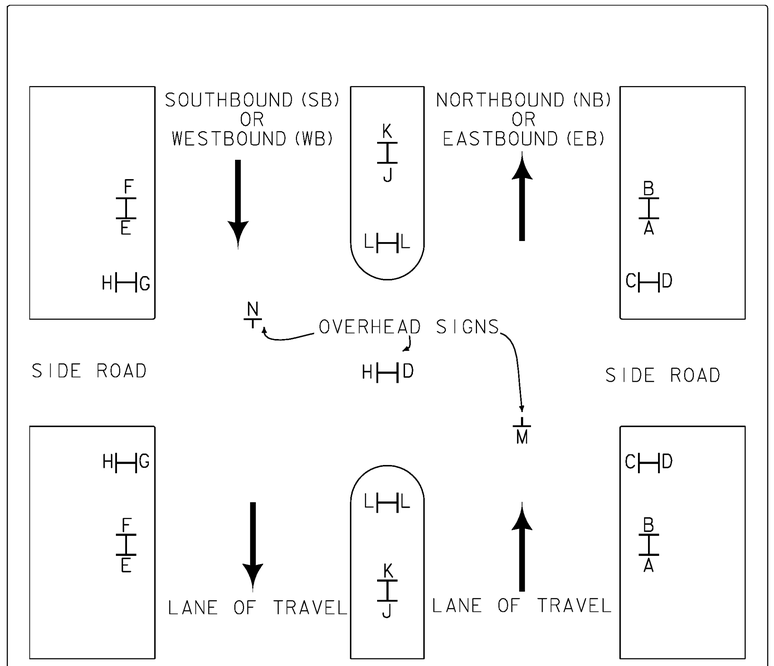

THE TRAFFIC SIGN LOCATION CODES ARE TO BE USED INCONJUNCTION WITH THE SIGN SUMMARY SHEETS TO ESTABLISH PROPER SIGN INSTALLATION IN THE FILED.

TRAFFIC SIGN LOCATION CODES

NOT TO SCALE

GENERAL NOTES:

1. ALL EXISTING MILE MARKER PLAQUES ATTACHED TO A DELINEATOR POST OR ATTACHED TO A RETAINED STAND ALONE SIGN POST ASSEMBLY SHALL BE RETAINED. IF AN EXISTING MILE MARKER PLAQUE IS ATTACHED TO A SIGN POST THAT IS TO BE REMOVED AND REPLACED IN THE SAME LOCATION, THE MILE MARKER PLAQUE SHALL BE REMOVED, SALVAGED AND INSTALLED ONTO THE NEW SIGN POST. IF AN EXISTING MILE MARKER PLAQUE IS ATTACHED TO A SIGN POST THAT IS TO BE RELOCATED TO A DIFFERENT LOCATION, THE MILE MARKER PLAQUE SHALL BE REMOVED, UNLESS OTHERWISE DIRECTED BY THE ENGINEER. PAYMENT FOR THIS WORK SHALL BE INCIDENTAL TO ITEM 675.341 SQUARE TUBE SIGN POST AND ANCHOR. PAYMENT FOR NEW MILE MARKERS AS SHOWN ON THESE PLANS SHALL BE PAID FOR AS ITEM 675.20 TRAFFIC SIGNS, TYPE A.
2. SALVAGED SIGN TOTALS HAVE BEEN ADDED TO THE TOTAL SIGN REMOVAL COLUMN ON THE TOWN TOTAL SIGN SUMMARY SHEET.
3. EXISTING STREET NAME SIGNS ATTACHED TO SIGN POSTS THAT ARE TO BE REPLACED SHALL BE REMOVED AND INSTALLED ONTO NEW POST. ALL WORK AND MATERIALS NECESSARY TO REMOVE AND INSTALL THE STREET NAME SIGNS SHALL BE PAID UNDER ITEM 675.60 ERECTING SALVAGED SIGNS. AN ESTIMATED QUANTITY HAS BEEN ADDED TO ITEM 675.60 TO PAY FOR THIS WORK.
4. ALL EXISTING STREET NAME OR BUS STOP SIGNS INSTALLED ON STAND ALONE SIGN POSTS SHALL BE RETAINED UNLESS OTHERWISE NOTED.
5. SELECTIVE CUTTING OF TREES OR TREE BRANCHES MAY BE NECESSARY TO PROVIDE FULL VISIBILITY FOR ANY EXISTING (RETAINED) OR NEW SIGN LOCATIONS FOR A DISTANCE OF 200 FEET. THIS WORK WILL BE PERFORMED AT THE DIRECTION OF THE RESIDENT ENGINEER IN ACCORDANCE WITH 201.05 THINNING AND TRIMMING PART (b); AND SHALL BE INCIDENTAL TO ITEM 675.20 TRAFFIC SIGNS, TYPE A. UNLESS OTHERWISE DIRECTED BY THE RESIDENT ENGINEER ALL CUT MATERIAL SHALL BE DISPOSED OF IN COMPLIANCE WITH APPLICABLE LAWS OF THE STATE OF VERMONT.

PROJECT NAME: STATEWIDE - SOUTHWEST REGION

PROJECT NUMBER: STPG SIGN (32)

FILE NAME: 10b012_TS.DGN	PLOT DATE: 03-SEP-2010
PROJECT LEADER: A. GAMBLE	DRAWN BY: J. KELLY
DESIGNED BY: J. KELLY	CHECKED BY: A. GAMBLE
GENERAL NOTES	SHEET 2 OF 90

STATE OF VERMONT
AGENCY OF TRANSPORTATION

QUANTITY SHEET 1


SUMMARY OF ESTIMATED QUANTITIES	TOTALS		DESCRIPTIONS				DETAILED SUMMARY OF QUANTITIES		
ROADWAY	GRAND TOTAL	FINAL	UNIT	ITEMS	ITEM NUMBER	ROUND	QUANTITIES	UNIT	ITEMS
1	1		CY	TRENCH EXCAVATION OF EARTH, EXPLORATORY (N.A.B.I.)	204.22				
30	30		HR	UNIFORMED TRAFFIC OFFICERS	630.10				
500	500		HR	FLAGGERS	630.15				
1	1		LS	MOBILIZATION/DEMOBILIZATION	635.11				
1	1		LS	TRAFFIC CONTROL	641.10				
2477.2	2477.2		SF	TRAFFIC SIGNS, TYPE A	675.20				
5070	5070		LF	SQUARE TUBE SIGN POST AND ANCHOR	675.341				
504	504		EACH	REMOVING SIGNS	675.50				
25	25		EACH	ERECTING SALVAGED SIGNS	675.60				

PROJECT NAME: STATEWIDE - SOUTHWEST REGION

PROJECT NUMBER: STPG SIGN (32)


FILE NAME: 10B012_TS.DGN
PROJECT LEADER: A. GAMBLE
DESIGNED BY: J. KELLY
QUNATITY SHEET

PLOT DATE: 26-AUG-2010
DRAWN BY: J. KELLY
CHECKED BY: A. GAMBLE
SHEET 3 OF 90

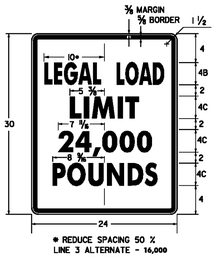

* REDUCE SPACING 50 %
LINE 3 ALTERNATE - 16,000

VR-017

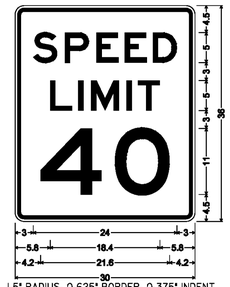

1.5" RADIUS, 0.625" BORDER, 0.375" INDENT
COLORS: LEGEND - BLACK
BACKGROUND - WHITE
TEXT STYLE: "SPEED" E; "LIMIT" E; "40" E

R2-1




1.5" RADIUS, 0.625" BORDER, 0.375" INDENT
COLORS: LEGEND - RED
BACKGROUND - WHITE
TEXT STYLE: "BEGIN" C

VR-644p




COLORS
LEGEND - RED (REFL.)
BACKGROUND - WHITE (REFL.)


VR - 020

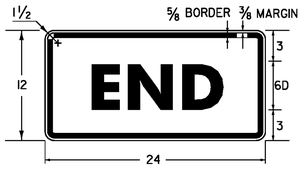


M4-6

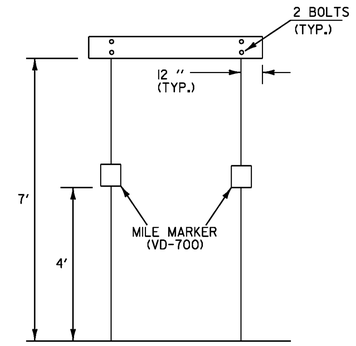


WHEN CROSSING COUNTY BOUNDARIES AN ADDITIONAL COUNTY LINE SIGN (VD-025) SHALL BE MOUNTED BELOW THE TOWN LINE SIGN MAINTAINING A SEVEN FOOT CLEARANCE.

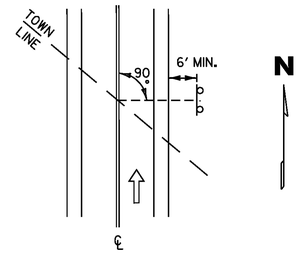

THE SIGN SHALL BE MOUNTED PARALLEL WITH THE ROADWAY. NORMALLY ON RIGHT SIDE TRAVELING WEST TO EAST OR SOUTH TO NORTH.

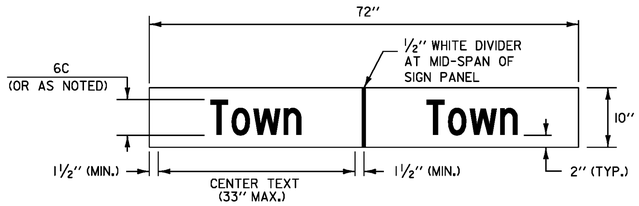

VD-024

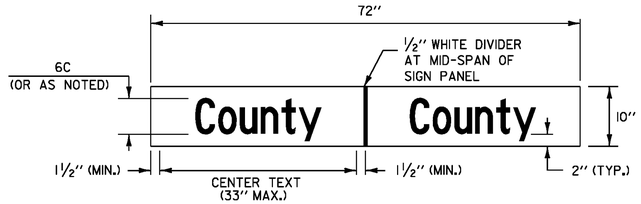

VD-025

TOWN NAMES


TEXT	SERIES	DIMENSIONS
Bennington	B (5")	32.50
Danby	C (6")	22.00
Dorset	C (6")	22.25
Mount Tabor	B (5")	32.50
Shaftsbury	B (5")	29.00
Winhall	C (6")	26.25

COUNTY NAMES

TEXT	SERIES	DIMENSIONS
Bennington Co.	B (5")	32.50
Windham Co.	B (5")	32.50

NOTES:

1. WORD TO WORD SPACING FOR MULTIPLE TEXT TOWN NAMES IS ADJUSTABLE TO ACCOMMODATE DIMENSION REQUIREMENTS.
2. DIMENSIONS SHOWN ARE APPROXIMATE AND MAY BE ADJUSTED SLIGHTLY TO ACCOMMODATE VARIOUS MANUFACTURER'S LETTER WIDTHS.
3. ALL DIMENSIONS ARE IN INCHES UNLESS OTHERWISE NOTED

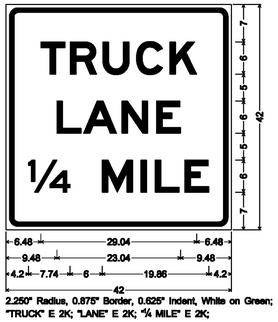

2.250" Radius, 0.875" Border, 0.625" Indent, White on Green;
"TRUCK" E 2K; "LANE" E 2K; "¼ MILE" E 2K;

D17-2

TOWN/COUNTY LINE SIGN NOTES:


1. THE SIGN BASE MATERIAL SHALL BE HIGH DENSITY OVERLAID PLYWOOD ⅝ INCH THICK OR ALUMINUM SHEETING 0.125" MINIMUM THICKNESS. THE RETROREFLECTIVE MATERIAL SHALL BE SHEETING APPLIED TO THE ENTIRE BACKGROUND OF THE SIGN. THE LEGEND SHALL BE CUT-OUT RETROREFLECTIVE LEGEND. ALL RETROREFLECTIVE MATERIAL SHALL BE EQUAL TO OR EXCEEDING THE "THE AMERICAN SOCIETY OF TESTING AND MATERIALS" (ASTM) TYPE III.
2. SIGNS SHALL HAVE A MINIMUM ASTM TYPE III SHEETING WITH A WHITE LEGEND ON A GREEN BACKGROUND.
3. LEGEND SHALL CONFORM WITH THE STANDARD ALPHABETS FOR HIGHWAY SIGNS APPROVED BY THE NATIONAL JOINT COMMITTEE ON UNIFORM TRAFFIC CONTROL DEVICES. SIGNS SHALL BE FABRICATED IN UPPER/LOWER CASE TEXT AS SHOWN IN SIGN DETAIL.
4. ALL SIGNS SHALL BE IN ACCORDANCE WITH "THE MANUAL ON UNIFORM TRAFFIC CONTROL DEVICES" (2009 MUTCD) AND THE "STANDARD HIGHWAY SIGNS" BOOK (2004 SHS) PUBLISHED BY THE FEDERAL HIGHWAY ADMINISTRATION (FHWA).

PROJECT NAME: STATEWIDE - SOUTHWEST REGION


PROJECT NUMBER: STPG SIGN (32)

FILE NAME: 10b012_TS.DGN
PROJECT LEADER: A. GAMBLE
DESIGNED BY: J. KELLY
SIGN DETAILS (I)


PLOT DATE: 26-AUG-2010
DRAWN BY: J. KELLY
CHECKED BY: A. GAMBLE
SHEET 4 OF 90

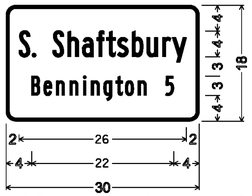


1.5" Radius, 0.5" Border, White on Green;
"S. Shaftsbury" B, 26"
"Bennington 5" B, 22"

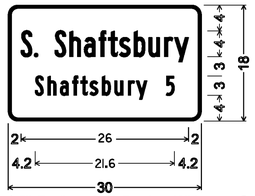


1.5" Radius, 0.5" Border, White on Green;
"S. Shaftsbury" B, 26"
"Shaftsbury 5" B, 21.6"

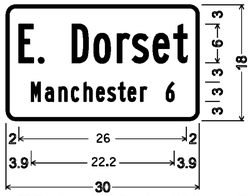


1.5" Radius, 0.5" Border, White on Green;
"E. Dorset" B, 26"
"Manchester 6" B, 22.2"

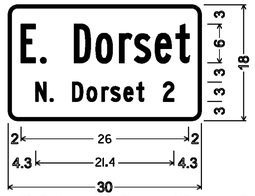


1.5" Radius, 0.5" Border, White on Green;
"E. Dorset" B, 26"
"N. Dorset 2" C, 21.4"

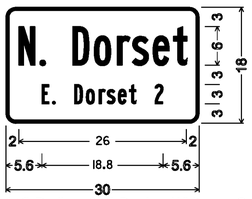


1.5" Radius, 0.5" Border, White on Green;
"N. Dorset" B, 26"
"E. Dorset 2" B, 18.8"

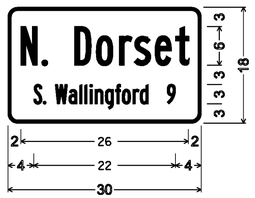


1.5" Radius, 0.5" Border, White on Green;
"N. Dorset" B, 26"
"S. Wallingford 9" B, 22"

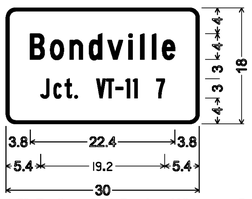

1.5" Radius, 0.5" Border, White on Green;
"Bondville" C, 22.4"
"Jct. VT-11 7" B, 19.2"

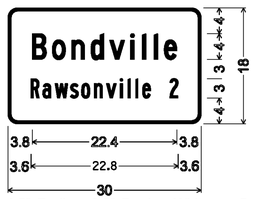


1.5" Radius, 0.5" Border, White on Green;
"Bondville" C, 22.4"
"Rawsonville 2" B, 22.8"

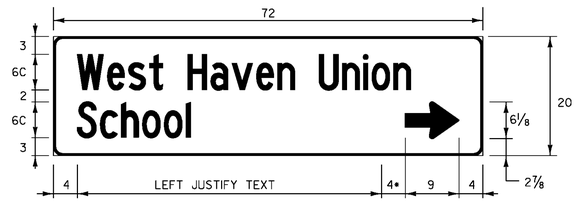


VD1-2 (R)

• MINIMUM DISTANCE BETWEEN ARROW AND TEXT

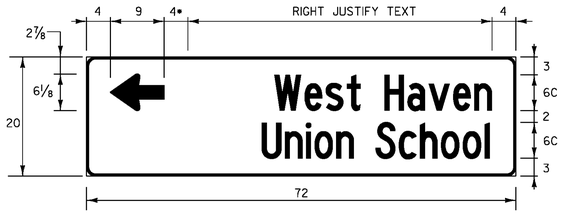


VD1-2 (L)


• MINIMUM DISTANCE BETWEEN ARROW AND TEXT

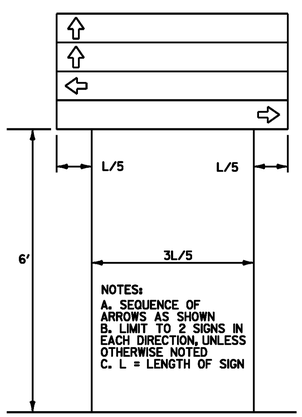

DESTINATION ASSEMBLY

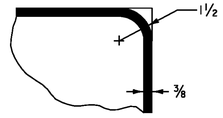

BORDER DETAIL

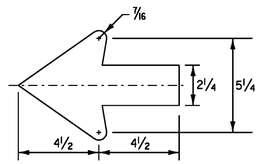

STANDARD 2.25" ARROW




VD1-1




VD1-1a




VD1-1a

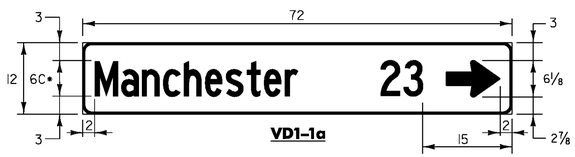


VD1-1a

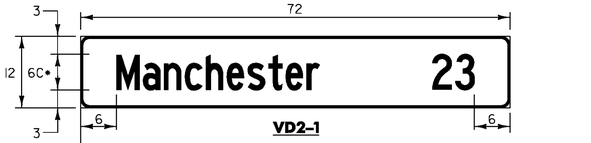

VD2-1

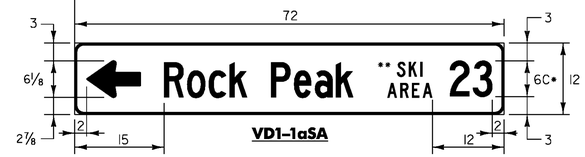

VD1-1aSA

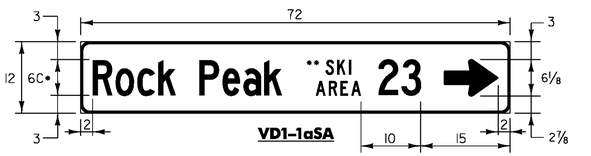

VD1-1aSA


* USE B FONT FOR LONGER DESTINATIONS.
** "SKI AREA" TEXT IS 2.5" HIGH WITH 1" BETWEEN LINES.

STANDARD DESTINATION SIGN NOTES
D1-1, D1-1A, D1-2, D2-1

THE DESTINATION SIGNS SHOWN ON THIS SHEET SHALL HAVE WHITE RETROREFLECTIVE ASTM TYPE III TEXT, ARROWS AND BORDERS ON A GREEN RETROREFLECTIVE ASTM TYPE III BACKGROUND. THE COLORS SHALL CONFORM WITH THE COLORS ADOPTED BY AASHTO AND APPROVED BY THE FHWA.

ALL DIMENSIONS SHOWN IN INCHES UNLESS OTHERWISE NOTED.


PROJECT NAME: STATEWIDE - SOUTHWEST REGION	
PROJECT NUMBER: STPG SIGN (32)	
FILE NAME: 10b012_TS.DGN	PLOT DATE: 26-AUG-2010
PROJECT LEADER: A. GAMBLE	DRAWN BY: J. KELLY
DESIGNED BY: J. KELLY	CHECKED BY: A. GAMBLE
SIGN DETAILS (2)	SHEET 5 OF 90

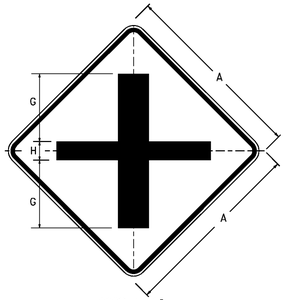

W2-1Mb

DIMENSIONS NOT SHOWN
FOR THIS DETAIL SHALL CONFORM
TO THE LATEST EDITION OF THE 2003 MUTCD
FOR SIGN DETAIL W2-1.
UNLESS OTHERWISE NOTED FOR THIS DETAIL

SIGN	DIMENSIONS (IN)		
	A	G	H
MIN & STD.	30	11	3
SPECIAL	36	13	4

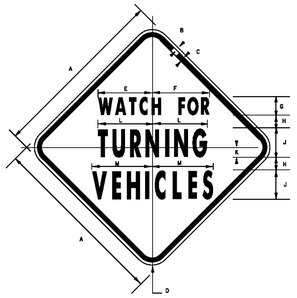

VW-205


SIGN	DIMENSIONS (INCHES)											
	A	B	C	D	E	F	G	H	J	K	L	M
MIN.	30	½	¾	1⅛	9⅝	9¾	4B	2	5B	2	9¼	10¼
STD.	36	⅝	⅞	2¼	8¾	12	4C	2½	5C	2	11½	12¾
EXPWY.	48	¾	1¼	3	14¾	15⅜	5C	3⅜	8B	2⅝	4⅝	16⅞



VW-544


• LETTER SPACING REDUCED 50%

SIGN	DIMENSIONS (INCHES)								
	A	B	C	D	E	F	G	H	J
MIN.	30	½	¾	1⅞	12¾	9⅛	4C•	3⅜	⅛
STD.	36	⅝	⅞	2¼	14¾	11⅝	5C•	4	1
EXPWY.	48	¾	1¼	3	19¼	15⅞	6C	5⅜	1⅜

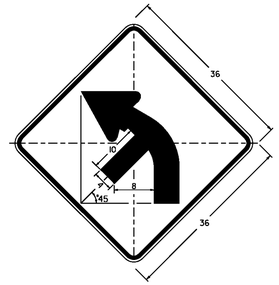


W1-2Mb L(R)

DIMENSIONS NOT SHOWN
FOR THIS DETAIL SHALL CONFORM
TO THE LATEST EDITION OF THE 2004
STANDARD HIGHWAY SIGN MANUAL
FOR SIGN DETAIL W1-2.
UNLESS OTHERWISE NOTED FOR THIS DETAIL

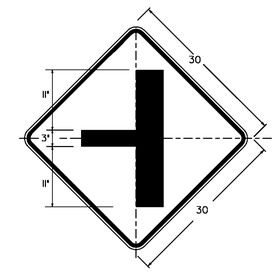


W2-2M L(R)

DIMENSIONS NOT SHOWN
FOR THIS DETAIL SHALL CONFORM
TO THE LATEST EDITION OF THE
2004 STANDARD HIGHWAY SIGN MANUAL
FOR SIGN DETAIL W2-2.
UNLESS OTHERWISE NOTED FOR THIS DETAIL

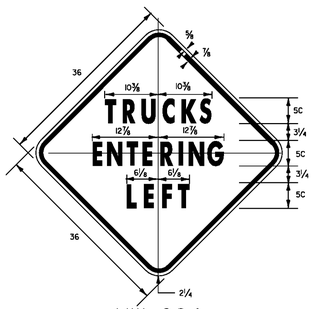


VW-084

1.875" RADIUS, 0.75" BORDER, 0.50" INDENT
COLORS: LEGEND - BLACK
BACKGROUND - YELLOW
TEXT STYLE: C

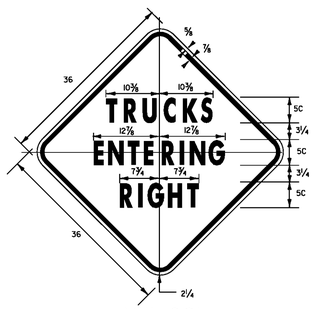


VW-081

1.875" RADIUS, 0.75" BORDER, 0.50" INDENT
COLORS: LEGEND - BLACK
BACKGROUND - YELLOW
TEXT STYLE: C

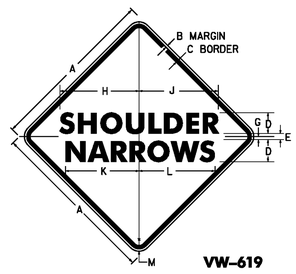


VW-619


SIGN	DIMENSIONS (INCHES)											
	A	B	C	D	E	F	G	H	J	K	L	M
MIN & STD.	36	⅝	⅞	5C	3	6D	I	13⅛	13 5/16	17⅝	18¼	2¼
EXPWY.	48	¾	1¼	7D	3½	7D	I	23⅛	23⅞	21½	21⅜	3

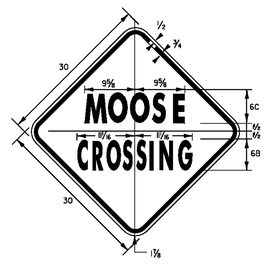


VW-000

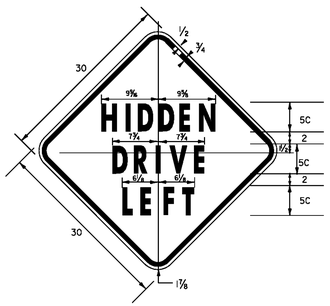

VW-133

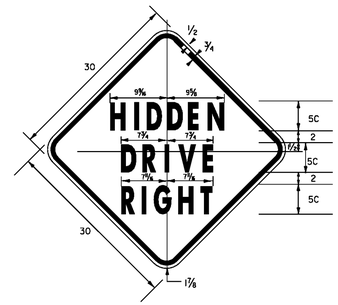


VW-054

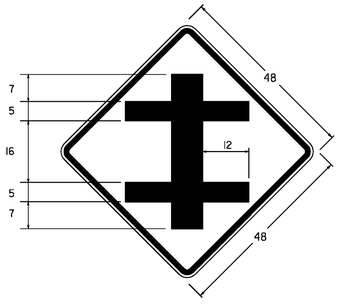


W2-1M

DIMENSIONS NOT SHOWN
FOR THIS DETAIL SHALL CONFORM
TO THE LATEST EDITION OF THE
2004 STANDARD HIGHWAY SIGN MANUAL
FOR SIGN DETAIL W2-1.
UNLESS OTHERWISE NOTED FOR THIS DETAIL

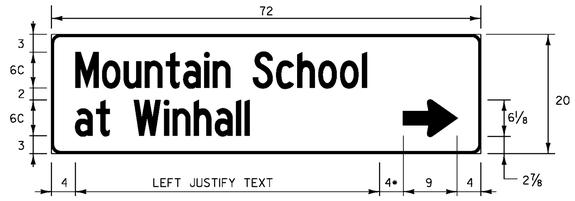


VD1-2 (R)

• MINIMUM DISTANCE BETWEEN ARROW AND TEXT

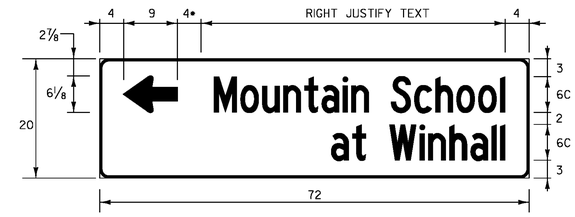


VD1-2 (L)

• MINIMUM DISTANCE BETWEEN ARROW AND TEXT

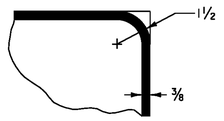

BORDER DETAIL

(FOR DESTINATION SIGN)

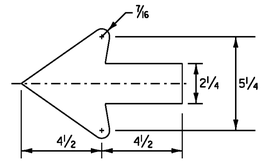


STANDARD 2.25" ARROW

(FOR DESTINATION SIGN)

PROJECT NAME: STATEWIDE - SOUTHWEST REGION	
PROJECT NUMBER: STPG SIGN (32)	
FILE NAME: 10B012_TS.DGN	PLOT DATE: 03-SEP-2010
PROJECT LEADER: A. GAMBLE	DRAWN BY: J. KELLY
DESIGNED BY: J. KELLY	CHECKED BY: A. GAMBLE
SIGN DETAILS (3)	SHEET 6 OF 90

ROUTE MARKER ASSEMBLY FRAMES

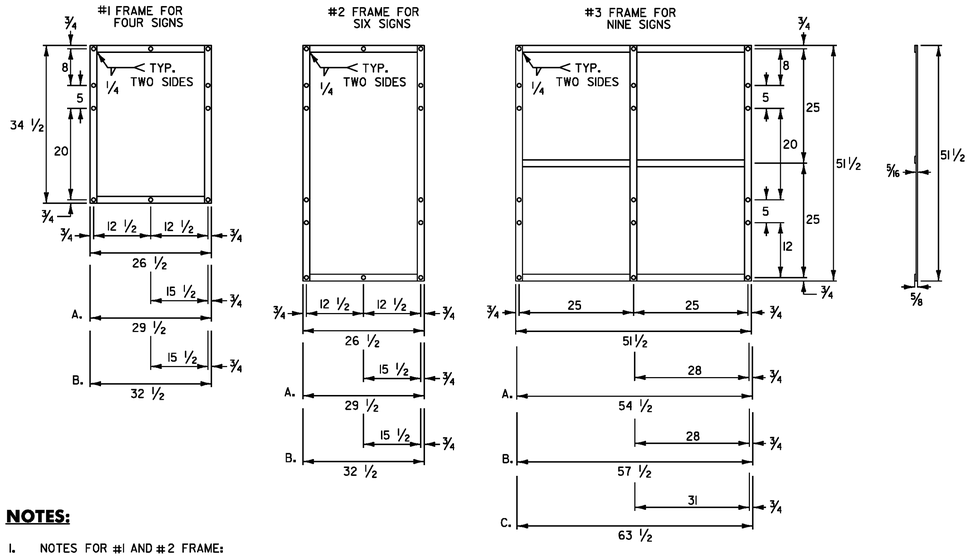

NOTES:

1. NOTES FOR #1 AND #2 FRAME:

   A. WITH ONE 30 INCH THREE DIGIT SIGN
   B. WITH TWO 30 INCH THREE DIGIT SIGNS

2. NOTES FOR #3 FRAME:


   A. WITH ONE 30 INCH THREE DIGIT SIGN IN AN OUTSIDE POSITION.
   B. WITH ONE 30 INCH THREE DIGIT SIGN IN THE CENTER POSITION OR TWO SUCH SIGNS IN THE OUTSIDE POSITIONS.
   C. WITH THREE 30 INCH THREE DIGIT SIGNS.

3. ALL HOLES SHALL BE 7/16 INCH DIAMETER. FOR OTHER SIGN COMBINATIONS. THAN ABOVE, THE FRAME DIMENSIONS AND HOLE SPACING SHALL BE MODIFIED AS NECESSARY. THE FRAME SHALL BE PAINTED WITH ONE COAT OF PRIMER AND A SECOND COAT OF BLACK PAINT. THE PAINT SHALL BE OF THE TYPE USED ON EXTERIOR METAL SURFACES TO PREVENT METAL CORROSION.

4. STANDARD FRAMES SHALL BE 5/16 INCH x 1 1/2 INCH WELDED A-36 STEEL.

5. ALL DIMENSIONS SHOWN IN INCHES UNLESS OTHERWISE NOTED.

STANDARD MOUNTING OF ROUTE MARKER ASSEMBLIES

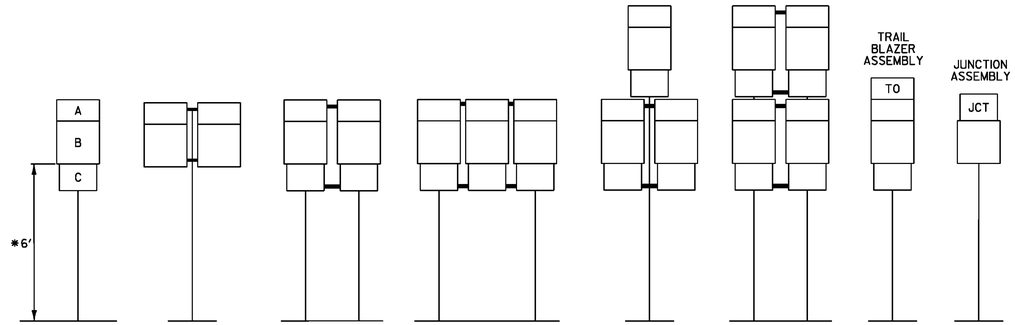

A - CARDINAL DIRECTION MARKER
B - ROUTE NUMBER
C - ADVANCE TURN ARROW OR DIRECTIONAL ARROW

* WHERE PARKING OR PEDESTRIAN TRAFFIC WILL OCCUR IN THE IMMEDIATE VICINITY OF THESE SIGNS MINIMUM VERTICAL CLEARANCE SHALL BE INCREASED TO SEVEN FEET

INSTALLATION SEQUENCE:

IN MULTIPLE HORIZONTAL MOUNTINGS PLACE A ROUTE MARKER ASSEMBLY INDICATING A LEFT TURN ON THE LEFT SIDE OF THE ASSEMBLY; RIGHT TURN ON THE RIGHT SIDE. FOR VERTICALLY STACKED MOUNTINGS PLACE THE STRAIGHT THROUGH MOVE INDICATION ON TOP, THE LEFT OR RIGHT TURNS AS APPROPRIATE BENEATH.

NOTES:

1. ALL DIMENSIONS SHOWN IN INCHES UNLESS OTHERWISE NOTED.

2. VERTICAL FRAME MEMBERS SHALL LINE UP WITH SIGN POST ON WHICH THEY ARE MOUNTED.

PROJECT NAME: STATEWIDE - SOUTHWEST REGION

PROJECT NUMBER: STPG SIGN (32)

FILE NAME: 10B012_TS.DGN	PLOT DATE: 26-AUG-2010
PROJECT LEADER: A. GAMBLE	DRAWN BY: J. KELLY
DESIGNED BY: J. KELLY	CHECKED BY: A. GAMBLE
ROUTE MARKER ASSEMBLY	SHEET 7 OF 90

DIRECTION	MILEPOINT	LOCATION CODE (SHEET 2)	SIGN CODE	WIDTH (IN)	HEIGHT (IN)	SHEETING REMARKS	SIGN LEGEND	NEW SIGNS "A"	NEW SIGNS "B"	EXISTING SIGNS RETAIN	EXISTING SIGNS SALVAGE FROM	EXISTING SIGNS SALVAGE TO	EXISTING SIGNS REMOVE	EXIST POST RETAIN	EXIST POST REMOVE	NUMBER OF NEW POSTS	SQUARE STEEL (IN) 1.75 (LB/FT) 1.88	SQUARE STEEL (IN) 2.00 (LB/FT) 2.42	SQUARE STEEL (IN) 2.50 (LB/FT) 3.35	TUBULAR STEEL Ø (IN) FOUNDATION	TUBULAR STEEL Ø (IN) 3.00 (LB/FT) 7.60	TUBULAR STEEL Ø (IN) 3.50 (LB/FT) 9.00	TUBULAR STEEL Ø (IN) 4.00 (LB/FT) 10.80	TUBULAR STEEL Ø (IN) 5.00 (LB/FT) 14.60	SIGN FRAME REQUIRED	REMARKS	SIGN DETAIL: DETAIL IN SHS	SIGN DETAIL: DETAIL ON SHEET NUMBER	SIGN DETAIL: DETAIL ON STD SHEET NUMBER
SHAFTSBURY VT-7A							FY-FLUORESCENT YELLOW FYG-FLUORESCENT YELLOW GREEN																			"SHS"-STANDARD HIGHWAY SIGNS			
NB	0.001	C	VR-017	24	30		LEGAL LOAD LIMIT 24,000 POUNDS						1		X											TOWN LINE RD. (TH-35)			
		C	VR-017	24	30			5.00								1		13.25 X										4	
NB	0.007	D	R1-1	30	30		STOP						1		X											TOWN LINE RD. (TH-35)			
		D	R1-1	30	30			6.25								1		13.25 X										X	
NB	0.163	A	R2-1	24	30		SPEED LIMIT 40			1				X															
NB	0.305	A	VD-018	30	18		S. Shaftsbury Shaftsbury 5						1		X															
		A	VD-018	30	18			3.75								1		13.5 X										5	
NB	0.355	A	R2-1	24	30		SPEED LIMIT 40						1		X															
		A	R2-1	24	30			5.00								1		13.25 X										X	
NB	0.608	A	R2-1	24	30		SPEED LIMIT 35						1		X															
		A	R2-1	30	36			7.50								1		15.0 X										5	
NB	0.693	A	W11-2FYG	30	30		PEDESTRIAN			1				X															
		A	W16-9FYG	24	12		AHEAD			1				X															
NB	0.751	C	VR-017	24	30		LEGAL LOAD LIMIT 24,000 POUNDS						1		X											LEDGELY DR. (TH-63)			
		C	VR-017	24	30			5.00								1		13.75 X										4	
SIGN SUMMARY SHEET							SHEET TOTALS	32.50 SF	0.00 SF	3 EA	0 EA	0 EA	6 EA	0 EA	0 EA	6 EA		~~90~~ 82.00 FT											
VERMONT AGENCY OF TRANSPORTATION							TOWN DIRECTIONAL TOTALS	269.1	0.0	15.0	5.0	5.0	62	0.0	0.0	44		660.0											

PROJECT NAME: STATEWIDE - SOUTHWEST REGION
PROJECT NUMBER: STPG SIGN(32)

FILE NAME: SHAFTSBURY NB.XLS
PROJECT MANAGER: A. GAMBLE
DESIGNED BY: J. KELLY
PLOT DATE: 7/13/2010
DRAWN BY: J. KELLY
CHECKED BY: A. GAMBLE

DIRECTION	MILEPOINT	LOCATION CODE (SHEET 2)	SIGN CODE	WIDTH (IN)	HEIGHT (IN)	SHEETING REMARKS	SIGN LEGEND	NEW SIGNS "A"	NEW SIGNS "B"	EXISTING SIGNS RETAIN	EXISTING SIGNS SALVAGE FROM	EXISTING SIGNS SALVAGE TO	EXISTING SIGNS REMOVE	EXIST POST RETAIN	EXIST POST REMOVE	NUMBER OF NEW POSTS	SQUARE STEEL (IN) 1.75 (LB/FT) 1.88	SQUARE STEEL (IN) 2.00 (LB/FT) 2.42	SQUARE STEEL (IN) 2.50 (LB/FT) 3.35	TUBULAR STEEL Ø (IN) FOUNDATION	TUBULAR STEEL Ø (IN) 3.00 (LB/FT) 7.60	TUBULAR STEEL Ø (IN) 3.50 (LB/FT) 9.00	TUBULAR STEEL Ø (IN) 4.00 (LB/FT) 10.80	TUBULAR STEEL Ø (IN) 5.00 (LB/FT) 14.60	SIGN FRAME REQUIRED	REMARKS	SIGN DETAIL: DETAIL IN SHS	SIGN DETAIL: DETAIL ON SHEET NUMBER	SIGN DETAIL: DETAIL ON STD SHEET NUMBER
SHAFTSBURY VT-7A							FY-FLUORESCENT YELLOW FYG-FLUORESCENT YELLOW GREEN																			"SHS"-STANDARD HIGHWAY SIGNS			
NB	0.757	D	R1-1	30	30						2	2	~~3~~ 1		X											LEDGELY DR. (TH-63) 2 STREET SIGNS			
		D	R1-1	30	30			6.25								1		13.75 X								REINSTALL STREET NAME SIGNS ABOVE NEW SIGN (2)	X		
NB	0.756	A	W11-2FYG	30	30		PEDESTRIAN			1				X															
		A	W16-7FYG	24	12		DIAGONAL DOWN ARROW			1				X															
NB	0.899	A	S1-1FYG	30	30		SCHOOL			1				X															
		A	W16-9FYG	24	12		AHEAD			1				X															
NB	0.946	A	S1-1FYG	30	30		SCHOOL				1	1	1		X	1		14.25 X								RETAIN SIGNS AND REPLACE POST.			
		A	W16-7FYG	24	12		DIAGONAL DOWN ARROW				1	1	1																
NB	0.951	C	VR-017	24	30								1		X											BUCK HILL RD. (TH-6)			
		C	VR-017	24	30			5.00								1		13.25 X										4	
NB	0.958	D	R1-1	30	30								1		X											BUCK HILL RD. (TH-6)			
		D	R1-1	30	30			6.25								1		13.25 X									X		
NB	1.044	A	M2-1S	21	15								1	X															
		A	M1-5	24	24								1																
		A	M2-1	21	15			2.19																		GREEN ON WHITE ROUTE MARKERS			E-136B
SIGN SUMMARY SHEET							SHEET TOTALS	19.69	0.00	4	~~4~~ 2	~~4~~ 2	~~9~~ 5	0	0	4		~~60~~ 54.5										
								SF	SF	EA	EA	EA	EA	EA	EA	EA		FT										
VERMONT AGENCY OF TRANSPORTATION							TOWN DIRECTIONAL TOTALS	269.1	0.0	15.0	5.0	5.0	62	0.0	0.0	44		660.0										

PROJECT NAME: **STATEWIDE - SOUTHWEST REGION**
PROJECT NUMBER: **STPG SIGN(32)**

FILE NAME: **SHAFTSBURY NB.XLS** PLOT DATE: **7/13/2010**
PROJECT MANAGER: **A. GAMBLE** DRAWN BY: **J. KELLY**
DESIGNED BY: **J. KELLY** CHECKED BY: **A. GAMBLE**
SHAFTSBURY NORTHBOUND SHEET 2 SHEET **9** OF **90**

DIRECTION	MILEPOINT	LOCATION CODE (SHEET 2)	SIGN CODE	WIDTH (IN)	HEIGHT (IN)	SHEETING REMARKS	SIGN LEGEND	NEW SIGNS "A"	NEW SIGNS "B"	EXISTING SIGNS RETAIN	EXISTING SIGNS SALVAGE FROM	EXISTING SIGNS SALVAGE TO	EXISTING SIGNS REMOVE	EXIST POST RETAIN	EXIST POST REMOVE	NUMBER OF NEW POSTS	SQUARE STEEL (IN) 1.75 (LB / FT) 1.88	SQUARE STEEL (IN) 2.00 (LB / FT) 2.42	SQUARE STEEL (IN) 2.50 (LB / FT) 3.35	TUBULAR STEEL Ø (IN) FOUNDATION	TUBULAR STEEL Ø (IN) 3.00 (LB / FT) 7.60	TUBULAR STEEL Ø (IN) 3.50 (LB / FT) 9.00	TUBULAR STEEL Ø (IN) 4.00 (LB / FT) 10.80	TUBULAR STEEL Ø (IN) 5.00 (LB / FT) 14.60	SIGN FRAME REQUIRED	REMARKS	SIGN DETAIL: DETAIL IN SHS	SIGN DETAIL: DETAIL ON SHEET NUMBER	SIGN DETAIL: DETAIL ON STD SHEET NUMBER
SHAFTSBURY VT-7A							FY-FLUORESCENT YELLOW FYG-FLUORESCENT YELLOW GREEN																			"SHS"-STANDARD HIGHWAY SIGNS			
		A	M1-5	24	24			4.00																					E-136B
NB	1.157	A	D1-1A	72	10								1		X														
		A	D1-1A	72	10								1																
		A	D1-1A	72	10								1																
		A	D1-1M	72	10								1																
		A	D1-1A	72	12		Shaftsbury Ctr 2	6.00								2		15.0 15.75 X											5
		A	D1-1A	72	12		Arlington 10	6.00																					5
		A	D1-1A	72	12		N. Bennington 2	6.00																					5
		A	D1-1M	72	12		N. Hoosick NY 8	6.00																					5
NB	1.176	A	M3-4S	24	12								1		X														
		A	M1-5	24	24								1																
		A	M6-1S	21	15								1																
		A	M3-1S	24	12								1																
		A	VM-078S	24	12								1																
		A	M1-5	24	24								1																
							SHEET TOTALS	28.00	0.00	0	0	0	10	0	0	2		~~30~~ 30.75											
								SF	SF	EA	EA	EA	EA	EA	EA	EA		FT											
							TOWN DIRECTIONAL TOTALS	269.1	0.0	15.0	5.0	5.0	62	0.0	0.0	44		660.0											

SIGN SUMMARY SHEET

VERMONT AGENCY OF TRANSPORTATION

PROJECT NAME: **STATEWIDE - SOUTHWEST REGION**
PROJECT NUMBER: **STPG SIGN(32)**

FILE NAME: **SHAFTSBURY NB.XLS** PLOT DATE: **7/13/2010**
PROJECT MANAGER: **A. GAMBLE** DRAWN BY: **J. KELLY**
DESIGNED BY: **J. KELLY** CHECKED BY: **A. GAMBLE**
SHAFTSBURY NORTHBOUND SHEET 3 SHEET **10** OF **90**

DIRECTION	MILEPOINT	LOCATION CODE (SHEET 2)	SIGN CODE	WIDTH (IN)	HEIGHT (IN)	SHEETING REMARKS	SIGN LEGEND	NEW SIGNS "A"	NEW SIGNS "B"	EXISTING SIGNS RETAIN	EXISTING SIGNS SALVAGE FROM	EXISTING SIGNS SALVAGE TO	EXISTING SIGNS REMOVE	EXIST POST RETAIN	EXIST POST REMOVE	NUMBER OF NEW POSTS	SQUARE STEEL (IN) 1.75 (LB / FT) 1.88	SQUARE STEEL (IN) 2.00 (LB / FT) 2.42	SQUARE STEEL (IN) 2.50 (LB / FT) 3.35	FOUNDATION	TUBULAR STEEL Ø (IN) 3.00 (LB / FT) 7.60	TUBULAR STEEL Ø (IN) 3.50 (LB / FT) 9.00	TUBULAR STEEL Ø (IN) 4.00 (LB / FT) 10.80	TUBULAR STEEL Ø (IN) 5.00 (LB / FT) 14.60	SIGN FRAME REQUIRED	REMARKS	SIGN DETAIL: DETAIL IN SHS	SIGN DETAIL: DETAIL ON SHEET NUMBER	SIGN DETAIL: DETAIL ON STD SHEET NUMBER
SHAFTSBURY VT-7A							FY-FLUORESCENT YELLOW FYG-FLUORESCENT YELLOW GREEN																			"SHS"-STANDARD HIGHWAY SIGNS			
		A	M6-3S	21	15								1																
		A	M3-4	24	12			2.00								2		14.5 15.75 X							#2	GREEN ON WHITE ROUTE MARKERS		7	E-136B
		A	M1-5	24	24			4.00																					E-136B
		A	M6-1	21	15			2.19																					E-136B
		A	M3-1	24	12			2.00																					E-136B
		A	VM-078	24	12			2.00																					E-136B
		A	M1-5	24	24			4.00																					E-136B
		A	M6-3	21	15			2.19																					E-136B
NB	1.206	A	R2-1	24	30		SPEED LIMIT 35						1		X														
NB	1.225	A	D2-1	72	10								1		X														
		A	D2-1	72	10								1																
		A	M3-1S	24	12								1																
		A	VM-078S	24	12								1																
		A	M1-5	24	24								1																
		A	D2-1	72	12			6.00								2		16.0 17.0 X										5	




SIGN SUMMARY SHEET

VERMONT AGENCY OF TRANSPORTATION

	NEW SIGNS "A"	NEW SIGNS "B"	EXISTING SIGNS RETAIN	EXISTING SIGNS SALVAGE FROM	EXISTING SIGNS SALVAGE TO	EXISTING SIGNS REMOVE	EXIST POST RETAIN	EXIST POST REMOVE	NUMBER OF NEW POSTS	SQUARE STEEL (IN)	TUBULAR STEEL Ø (IN)
SHEET TOTALS	24.38	0.00	0	0	0	7	0	0	4	~~60~~ 63.25	
	SF	SF	EA	EA	EA	EA	EA	EA	EA	FT	
TOWN DIRECTIONAL TOTALS	269.1	0.0	15.0	5.0	5.0	62	0.0	0.0	44	660.0	

PROJECT NAME: **STATEWIDE - SOUTHWEST REGION**
PROJECT NUMBER: **STPG SIGN(32)**

FILE NAME: **SHAFTSBURY NB.XLS** PLOT DATE: **7/13/2010**
PROJECT MANAGER: **A. GAMBLE** DRAWN BY: **J. KELLY**
DESIGNED BY: **J. KELLY** CHECKED BY: **A. GAMBLE**
SHAFTSBURY NORTHBOUND SHEET 4 SHEET **11** OF **90**

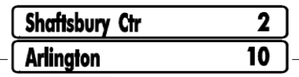DIRECTION	MILEPOINT	LOCATION CODE (SHEET 2)	SIGN CODE	WIDTH (IN)	HEIGHT (IN)	SHEETING REMARKS	SIGN LEGEND	NEW SIGNS "A"	NEW SIGNS "B"	EXISTING SIGNS RETAIN	EXISTING SIGNS SALVAGE FROM	EXISTING SIGNS SALVAGE TO	EXISTING SIGNS REMOVE	EXIST POST RETAIN	EXIST POST REMOVE	NUMBER OF NEW POSTS	SQUARE STEEL (IN) 1.75 (LB / FT) 1.88	SQUARE STEEL (IN) 2.00 (LB / FT) 2.42	SQUARE STEEL (IN) 2.50 (LB / FT) 3.35	TUBULAR STEEL Ø (IN) FOUNDATION	TUBULAR STEEL Ø (IN) 3.00 (LB / FT) 7.60	TUBULAR STEEL Ø (IN) 3.50 (LB / FT) 9.00	TUBULAR STEEL Ø (IN) 4.00 (LB / FT) 10.80	TUBULAR STEEL Ø (IN) 5.00 (LB / FT) 14.60	SIGN FRAME REQUIRED	REMARKS	SIGN DETAIL: DETAIL IN SHS	SIGN DETAIL: DETAIL ON SHEET NUMBER	SIGN DETAIL: DETAIL ON STD SHEET NUMBER
SHAFTSBURY VT-7A							FY-FLUORESCENT YELLOW FYG-FLUORESCENT YELLOW GREEN																			"SHS"-STANDARD HIGHWAY SIGNS			
		A	D2-1	72	12			6.00																				5	
		A	M3-1	24	12			2.00																		GREEN ON WHITE ROUTE MARKERS			E-136B
		A	VM-078	24	12			2.00																					E-136B
		A	M1-5	24	24			4.00																					E-136B
NB	1.377	A	R2-1	24	30								1		X														
		A	R2-1	24	30			5.00								1		13.25 X									X		
NB	1.466	C	VR-017	24	30								1		X												AIRPORT RD. (TH-7)			
		C	VR-017	24	30			5.00								1		13.25 X										4	
NB	1.474	D	R1-1	30	30								1		X												AIRPORT RD. (TH-7)			
		D	R1-1	30	30			6.25								1		13.25 X									X		
NB	1.482	A	R2-1	24	30								1		X															
		A	R2-1	24	30			5.00								1		14.0 X									X		
NB	1.710	A	R2-1	24	30								1		X												SPEED TRANSITION POINT. INSTALL SIGN DIRECTLY ACROSS FROM SOUTHBOUND SL 40 SIGN.			
		A	R2-1	24	30			5.00								1		13.25 X									X		
NB	1.871	C	VM-607	24	36		KOREAN WAR MEMORIAL HIGHWAY				1	1	1		X	1		15.5 X									RETAIN SIGN AND REPLACE POST.			
							SHEET TOTALS	40.25	0.00	0	1	1	~~6~~ 5	0	0	6		~~90~~ 82.50											
								SF	SF	EA	EA	EA	EA	EA	EA	EA		FT											
							TOWN DIRECTIONAL TOTALS	269.1	0.0	15.0	5.0	5.0	62	0.0	0.0	44		660.0											

SIGN SUMMARY SHEET

VERMONT AGENCY OF TRANSPORTATION

PROJECT NAME: **STATEWIDE - SOUTHWEST REGION**
PROJECT NUMBER: **STPG SIGN(32)**

FILE NAME: **SHAFTSBURY NB.XLS** PLOT DATE: **7/13/2010**
PROJECT MANAGER: **A. GAMBLE** DRAWN BY: **J. KELLY**
DESIGNED BY: **J. KELLY** CHECKED BY: **A. GAMBLE**
SHAFTSBURY NORTHBOUND SHEET 5 SHEET **12** OF **90**

DIRECTION	MILEPOINT	LOCATION CODE (SHEET 2)	SIGN CODE	WIDTH (IN)	HEIGHT (IN)	SHEETING REMARKS	SIGN LEGEND	NEW SIGNS "A"	NEW SIGNS "B"	EXISTING SIGNS RETAIN	EXISTING SIGNS SALVAGE FROM	EXISTING SIGNS SALVAGE TO	EXISTING SIGNS REMOVE	EXIST POST RETAIN	EXIST POST REMOVE	NUMBER OF NEW POSTS	SQUARE STEEL (IN) 1.75 (LB / FT) 1.88	SQUARE STEEL (IN) 2.00 (LB / FT) 2.42	SQUARE STEEL (IN) 2.50 (LB / FT) 3.35	FOUNDATION	TUBULAR STEEL Ø (IN) 3.00 (LB / FT) 7.60	TUBULAR STEEL Ø (IN) 3.50 (LB / FT) 9.00	TUBULAR STEEL Ø (IN) 4.00 (LB / FT) 10.80	TUBULAR STEEL Ø (IN) 5.00 (LB / FT) 14.60	SIGN FRAME REQUIRED	REMARKS	SIGN DETAIL: DETAIL IN SHS	SIGN DETAIL: DETAIL ON SHEET NUMBER	SIGN DETAIL: DETAIL ON STD SHEET NUMBER
SHAFTSBURY VT-7A							FY-FLUORESCENT YELLOW FYG-FLUORESCENT YELLOW GREEN																			"SHS"-STANDARD HIGHWAY SIGNS			
NB	1.949	C	VR-017	24	30								1		X												BAHARAN RD. (TH-31)			
		C	VR-017	24	30			5.00								1		15.0 X									4		
NB	1.956	D	R1-1	30	30								1		X												BAHARAN RD. (TH-31)			
		D	R1-1	30	30			6.25								1		13.25 X								REMOVE 1.80 MM.	X		
NB	2.273	A	VD-062AS	72	16		BUSINESS SIGN			1				X															
		A	VD-062B	72	16		BUSINESS SIGN			1																NORTH RD. (TH-30)			
NB	2.385	C	VR-017	24	30								1		X															
		C	VR-017	24	30			5.00								1		14.0 X									4		
NB	2.407	D	R1-1	30	30								1		X												NORTH RD. (TH-30)			
		D	R1-1	30	30			6.25								1		13.25 X									X		
NB	2.519	A	W2-3MaL	30	30		LEFT SIDE ROAD (DOWN 45 DEG)			1				X															
		A	W16-8	20	8		MYERS RD			1				X															
NB	3.233	A	R2-1	24	30								1	X												REPLACE SIGN AND RETAIN POST.			
		A	R2-1	24	30			5.00																			X		
NB	3.390	A	W2-1M	30	30		MODIFIED CROSSROAD				1		~~6~~ 5		X														
							SHEET TOTALS	27.50	0.00	4	1	0	~~6~~ 5	0	0	4		~~60~~ 55.5											
								SF	SF	EA	EA	EA	EA	EA	EA	EA		FT											
							TOWN DIRECTIONAL TOTALS	269.1	0.0	15.0	5.0	5.0	62	0.0	0.0	44		660.0											

SIGN SUMMARY SHEET

VERMONT AGENCY OF TRANSPORTATION

PROJECT NAME: **STATEWIDE - SOUTHWEST REGION**
PROJECT NUMBER: **STPG SIGN(32)**

FILE NAME: **SHAFTSBURY NB.XLS** PLOT DATE: **7/13/2010**
PROJECT MANAGER: **A. GAMBLE** DRAWN BY: **J. KELLY**
DESIGNED BY: **J. KELLY** CHECKED BY: **A. GAMBLE**
SHAFTSBURY NORTHBOUND SHEET 6 SHEET **13** OF **90**

DIRECTION	MILEPOINT	LOCATION CODE (SHEET 2)	SIGN CODE	WIDTH (IN)	HEIGHT (IN)	SHEETING REMARKS	SIGN LEGEND	NEW SIGNS "A"	NEW SIGNS "B"	EXISTING SIGNS RETAIN	EXISTING SIGNS SALVAGE FROM	EXISTING SIGNS SALVAGE TO	EXISTING SIGNS REMOVE	EXIST POST RETAIN	EXIST POST REMOVE	NUMBER OF NEW POSTS	SQUARE STEEL (IN) (LB / FT) 1.75 / 1.88	SQUARE STEEL (IN) (LB / FT) 2.00 / 2.42	SQUARE STEEL (IN) (LB / FT) 2.50 / 3.35	TUBULAR STEEL Ø (IN) FOUNDATION	TUBULAR STEEL Ø (IN) (LB / FT) 3.00 / 7.60	TUBULAR STEEL Ø (IN) (LB / FT) 3.50 / 9.00	TUBULAR STEEL Ø (IN) (LB / FT) 4.00 / 10.80	TUBULAR STEEL Ø (IN) (LB / FT) 5.00 / 14.60	SIGN FRAME REQUIRED	REMARKS	SIGN DETAIL: DETAIL IN SHS	SIGN DETAIL: DETAIL ON SHEET NUMBER	SIGN DETAIL: DETAIL ON STD SHEET NUMBER
SHAFTSBURY VT-7A							FY-FLUORESCENT YELLOW FYG-FLUORESCENT YELLOW GREEN																			"SHS"-STANDARD HIGHWAY SIGNS			
NB	3.440	A	W2-1M	30	30		MODIFIED CROSSROAD					1				1		14.75 X								RELOCATE SIGN ASSEMBLY 250 FEET NORTH.			
NB	3.530	C	VR-017	24	30								1		X												TUNIC RD. (TH-56)			
		C	VR-017	24	30			5.00								1		13.25 X										4	
NB	3.534	D	R1-1	30	30								1		X												TUNIC RD. (TH-56)			
		D	R1-1	30	30			6.25								1		13.25 X									X		
NB	4.101	A	W11-7	30	30		EQUESTRIAN						1		X														
NB	4.604	A	S3-1	30	30		SCHOOL BUS STOP AHEAD						1		X														
NB	4.733	A	VD-062AL	72	16		BUSINESS SIGN			1				X															
		A	VD-062B	72	16		BUSINESS SIGN			1																			
NB	5.004	A	W1-2L	30	30		LEFT CURVE						1		X														
		A	W13-1	18	18		40 MPH ADVISORY						1																
NB	5.019	C	VR-017	24	30								1		X												HIDDEN VALLEY RD. (TH-67)			
		C	VR-017	24	30			5.00								1		13.25 X										4	
NB	5.026	D	R1-1	30	30								1		X												HIDDEN VALLEY RD. (TH-67)			
		D	R1-1	30	30			6.25								1		13.25 X									X		
							SHEET TOTALS	22.50	0.00	2	0	1	8	0	0	5		~~75~~ 67.75											
								SF	SF	EA	EA	EA	EA	EA	EA	EA		FT											
							TOWN DIRECTIONAL TOTALS	269.1	0.0	15.0	5.0	5.0	62	0.0	0.0	44		660.0											

SIGN SUMMARY SHEET

VERMONT AGENCY OF TRANSPORTATION

PROJECT NAME: **STATEWIDE - SOUTHWEST REGION**
PROJECT NUMBER: **STPG SIGN(32)**

FILE NAME: **SHAFTSBURY NB.XLS** PLOT DATE: **7/13/2010**
PROJECT MANAGER: **A. GAMBLE** DRAWN BY: **J. KELLY**
DESIGNED BY: **J. KELLY** CHECKED BY: **A. GAMBLE**
SHAFTSBURY NORTHBOUND SHEET 7 SHEET **14** OF **90**

DIRECTION	MILEPOINT	LOCATION CODE (SHEET 2)	SIGN CODE	WIDTH (IN)	HEIGHT (IN)	SHEETING REMARKS	SIGN LEGEND	NEW SIGNS "A"	NEW SIGNS "B"	EXISTING SIGNS RETAIN	EXISTING SIGNS SALVAGE FROM	EXISTING SIGNS SALVAGE TO	EXISTING SIGNS REMOVE	EXIST POST RETAIN	EXIST POST REMOVE	NUMBER OF NEW POSTS	SQUARE STEEL (IN) 1.75 (LB / FT) 1.88	SQUARE STEEL (IN) 2.00 (LB / FT) 2.42	SQUARE STEEL (IN) 2.50 (LB / FT) 3.35	TUBULAR STEEL Ø (IN) FOUNDATION	TUBULAR STEEL Ø (IN) 3.00 (LB / FT) 7.60	TUBULAR STEEL Ø (IN) 3.50 (LB / FT) 9.00	TUBULAR STEEL Ø (IN) 4.00 (LB / FT) 10.80	TUBULAR STEEL Ø (IN) 5.00 (LB / FT) 14.60	SIGN FRAME REQUIRED	REMARKS	SIGN DETAIL: DETAIL IN SHS	SIGN DETAIL: DETAIL ON SHEET NUMBER	SIGN DETAIL: DETAIL ON STD SHEET NUMBER
SHAFTSBURY VT-7A							FY-FLUORESCENT YELLOW FYG-FLUORESCENT YELLOW GREEN																				"SHS"-STANDARD HIGHWAY SIGNS			
NB	5.146	A	W1-2L	30	30			6.25							X	1		15.5 X								INSTALL AT SOUTH END OF GUARDRAIL SECTION. SOUTH OF POLE #173T/280/67/105.	X		
		A	W13-1	18	18			2.25																			X		
NB	5.186	A	W1-8	18	24		CHEVRON						1		X											REINSTALL BR-7 PLAQUE. REMOVE AND DISCARD 5.20 MM.			
		A	N/A				BRIDGE 7 PLAQUE 				1	1	1																
		A	W2-2RM	30	30			6.25								1		14.0 X										6	
NB	5.235	A	W1-8	18	24		CHEVRON						1		X														
NB	5.256	A	W1-8	18	24		CHEVRON 						1		X														
		A	W11-8	30	30			6.25								1		15.0 X									INSTALL 475 FEET IN ADVANCE OF OLD DEPOT RD.	X		
NB	5.306	A	W1-8	18	24		CHEVRON						1		X														
NB	5.311	A	VR-928R	30	30								1		X														
		A	VR-928R	30	30			6.25								1		14.75 X											E-145A
NB	5.336	C	VR-017	24	30								1		X												OLD DEPOT RD. (TH-1)			
		C	N/A	18	24		TOWN' SPEED ZONE AHEAD 						1																
		C	VR-017	24	30			5.00								1		13.5 X										4	
NB	5.345	D	R1-1	30	30								1		X												OLD DEPOT RD. (TH-1)			
							SHEET TOTALS	32.25	0.00	0	1	1	~~9~~ 8	0	0	5		~~75~~ 72.75											
								SF	SF	EA	EA	EA	EA	EA	EA	EA		FT											
							TOWN DIRECTIONAL TOTALS	269.1	0.0	15.0	5.0	5.0	62	0.0	0.0	44		660.0											

SIGN SUMMARY SHEET

VERMONT AGENCY OF TRANSPORTATION

PROJECT NAME: **STATEWIDE - SOUTHWEST REGION**
PROJECT NUMBER: **STPG SIGN(32)**

FILE NAME: **SHAFTSBURY NB.XLS** PLOT DATE: **7/13/2010**
PROJECT MANAGER: **A. GAMBLE** DRAWN BY: **J. KELLY**
DESIGNED BY: **J. KELLY** CHECKED BY: **A. GAMBLE**
SHAFTSBURY NORTHBOUND SHEET 8 SHEET **15** OF **90**

DIRECTION	MILEPOINT	LOCATION CODE (SHEET 2)	SIGN CODE	WIDTH (IN)	HEIGHT (IN)	SHEETING REMARKS	SIGN LEGEND	NEW SIGNS "A"	NEW SIGNS "B"	EXISTING SIGNS RETAIN	EXISTING SIGNS SALVAGE FROM	EXISTING SIGNS SALVAGE TO	EXISTING SIGNS REMOVE	EXIST POST RETAIN	EXIST POST REMOVE	NUMBER OF NEW POSTS	SQUARE STEEL (IN) 1.75 (LB / FT) 1.88	SQUARE STEEL (IN) 2.00 (LB / FT) 2.42	SQUARE STEEL (IN) 2.50 (LB / FT) 3.35	TUBULAR STEEL Ø (IN) FOUNDATION	TUBULAR STEEL Ø (IN) 3.00 (LB / FT) 7.60	TUBULAR STEEL Ø (IN) 3.50 (LB / FT) 9.00	TUBULAR STEEL Ø (IN) 4.00 (LB / FT) 10.80	TUBULAR STEEL Ø (IN) 5.00 (LB / FT) 14.60	SIGN FRAME REQUIRED	REMARKS	SIGN DETAIL: DETAIL IN SHS	SIGN DETAIL: DETAIL ON SHEET NUMBER	SIGN DETAIL: DETAIL ON STD SHEET NUMBER
SHAFTSBURY VT-7A							FY-FLUORESCENT YELLOW FYG-FLUORESCENT YELLOW GREEN																			"SHS"-STANDARD HIGHWAY SIGNS			
		D	R1-1	30	30			6.25								1		13.25 X									X		
NB	5.905	A	W1-2L	30	30		LEFT CURVE						1		X														
		A	W13-1	18	18		40 MPH						1																
NB	5.960	A	W1-2L	30	30			6.25								1		15.5 X									INSTALL AT SOUTH END OF PULL-OFF	X		
		A	W13-1	18	18			2.25																			X		
	6.020	A	W1-6	48	24			8.00								2		13.0 14.25 X									INSTALL 75 FEET NORTH OF BEGINNING OF RAIL	X		
NB	6.075	B	W1-6	48	24								1		X														
		B	OM1-1	18	18								1																	
		B	W1-6	48	24			8.00								2		13.0 13.5 X										X		
NB	6.171	B	W1-2R	30	30		RIGHT CURVE						1		X														
		B	W13-1	24	24		40 MPH ADVISORY						1																
NB	6.569	C	VR-017	24	30								1		X												STATE PARK RD. (TH-15)			
		C	VR-017	24	30			5.00								1		13.25 X											4	
NB	6.579	D	R1-1	30	30								1		X												STATE PARK RD. (TH-15)			
		D	R1-1	30	30			6.25								1		13.25 X										X		
SIGN SUMMARY SHEET							SHEET TOTALS	42.00 SF	0.00 SF	0 EA	0 EA	0 EA	8 EA	0 EA	0 EA	8 EA		~~120~~ 109.0 FT												
VERMONT AGENCY OF TRANSPORTATION							TOWN DIRECTIONAL TOTALS	269.1	0.0	15.0	5.0	5.0	62	0.0	0.0	44		660.0												

PROJECT NAME: **STATEWIDE - SOUTHWEST REGION**
PROJECT NUMBER: **STPG SIGN(32)**
FILE NAME: **SHAFTSBURY NB.XLS** PLOT DATE: **7/13/2010**
PROJECT MANAGER: **A. GAMBLE** DRAWN BY: **J. KELLY**
DESIGNED BY: **J. KELLY** CHECKED BY: **A. GAMBLE**
SHAFTSBURY NORTHBOUND SHEET 9 SHEET **16** OF **90**

DIRECTION	MILEPOINT	LOCATION CODE (SHEET 2)	SIGN CODE	WIDTH (IN)	HEIGHT (IN)	SHEETING REMARKS	SIGN LEGEND	NEW SIGNS "A"	NEW SIGNS "B"	EXISTING SIGNS RETAIN	EXISTING SIGNS SALVAGE FROM	EXISTING SIGNS SALVAGE TO	EXISTING SIGNS REMOVE	EXIST POST RETAIN	EXIST POST REMOVE	NUMBER OF NEW POSTS	SQUARE STEEL (IN) 1.75 (LB / FT) 1.88	SQUARE STEEL (IN) 2.00 (LB / FT) 2.42	SQUARE STEEL (IN) 2.50 (LB / FT) 3.35	TUBULAR STEEL Ø (IN) FOUNDATION	TUBULAR STEEL Ø (IN) 3.00 (LB / FT) 7.60	TUBULAR STEEL Ø (IN) 3.50 (LB / FT) 9.00	TUBULAR STEEL Ø (IN) 4.00 (LB / FT) 10.80	TUBULAR STEEL Ø (IN) 5.00 (LB / FT) 14.60	SIGN FRAME REQUIRED	REMARKS	SIGN DETAIL: DETAIL IN SHS	SIGN DETAIL: DETAIL ON SHEET NUMBER	SIGN DETAIL: DETAIL ON STD SHEET NUMBER
SHAFTSBURY VT-7A							FY-FLUORESCENT YELLOW FYG-FLUORESCENT YELLOW GREEN																			"SHS"-STANDARD HIGHWAY SIGNS			
NB	6.637	A	W11-2	30	30	FYG	PEDESTRIAN			1				X															
		A	W16-4	30	24	FYG	NEXT 1000 FEET			1																			

DIRECTION	MILEPOINT	LOCATION CODE (SHEET 2)	SIGN CODE	WIDTH (IN)	HEIGHT (IN)	SHEETING REMARKS	SIGN LEGEND	NEW SIGNS "A"	NEW SIGNS "B"	EXISTING SIGNS RETAIN	EXISTING SIGNS SALVAGE FROM	EXISTING SIGNS SALVAGE TO	EXISTING SIGNS REMOVE	EXIST POST RETAIN	EXIST POST REMOVE	NUMBER OF NEW POSTS	SQUARE STEEL (IN) 1.75 (LB/FT) 1.88	SQUARE STEEL (IN) 2.00 (LB/FT) 2.42	SQUARE STEEL (IN) 2.50 (LB/FT) 3.35	TUBULAR STEEL Ø (IN) FOUNDATION	TUBULAR STEEL Ø (IN) 3.00 (LB/FT) 7.60	TUBULAR STEEL Ø (IN) 3.50 (LB/FT) 9.00	TUBULAR STEEL Ø (IN) 4.00 (LB/FT) 10.80	TUBULAR STEEL Ø (IN) 5.00 (LB/FT) 14.60	SIGN FRAME REQUIRED	REMARKS	SIGN DETAIL: DETAIL IN SHS	SIGN DETAIL: DETAIL ON SHEET NUMBER	SIGN DETAIL: DETAIL ON STD SHEET NUMBER
SHAFTSBURY VT-7A							FY-FLUORESCENT YELLOW FYG-FLUORESCENT YELLOW GREEN																			"SHS"-STANDARD HIGHWAY SIGNS			
SB	6.485	G	VR-017	24	30								1		X												TIMBER TRAIL RD (TH-14)			
		G	VR-017	24	30			5.00								1		13.25 X										4	
SB	6.481	H	R1-1	30	30								1		X												TIMBER TRAIL RD (TH-14)			
		H	R1-1	30	30			6.25								1		13.25 X										X	
SB	6.172	F	W1-2R	30	30		RIGHT CURVE						1		X											REMOVE 6.70 MM.			
		F	W13-1	18	18		40 MPH ADVISORY						1																
SB	6.123	F	W1-2R	30	30			6.25								1		15.5 X								INSTALL 360 FEET SOUTH OF EXISTING RIGHT CURVE SIGN			
		F	W13-1	18	18			2.25																			X		
SB	5.566	F	VW-054L	30	30		HIDDEN DRIVE LEFT						1		X														
		F	VW-407P				SCHOOL BUS ENTERING						1																
SB	5.504	F	W11-8	30	30		FIRE ENGINE SYMBOL 						1	X															
		F	VW-054L	30	30			6.25																				6	
SB	5.400	F	W1-2R	30	30		RIGHT CURVE 						1		X														
		F	W11-8	30	30			6.25								1		16.25 X										X	
SB	5.338	F	W1-2R	30	30			6.25								1		15.5 X								INSTALL ACROSS FROM OLD DEPOT RD INTERSECTION.			
							SHEET TOTALS	38.50	0.00	0	0	0	8	0	0	5		~~75~~ 73.75											
								SF	SF	EA	EA	EA	EA	EA	EA	EA		FT											
							TOWN DIRECTIONAL TOTALS	217.7	0.0	26.0	5.0	5.0	46	0.0	0.0	38		570.0											

SIGN SUMMARY SHEET

VERMONT AGENCY OF TRANSPORTATION

PROJECT NAME: **STATEWIDE - SOUTHWEST REGION**
PROJECT NUMBER: **STPG SIGN(32)**

FILE NAME: **SHAFTSBURY SB.XLS** PLOT DATE: **7/13/2010**
PROJECT MANAGER: **A. GAMBLE** DRAWN BY: **J. KELLY**
DESIGNED BY: **J. KELLY** CHECKED BY: **A. GAMBLE**
SHAFTSBURY SOUTHBOUND SHEET 1 SHEET **18** OF **90**

DIRECTION	MILEPOINT	LOCATION CODE (SHEET 2)	SIGN CODE	WIDTH (IN)	HEIGHT (IN)	SHEETING REMARKS	SIGN LEGEND	NEW SIGNS "A"	NEW SIGNS "B"	EXISTING SIGNS RETAIN	EXISTING SIGNS SALVAGE FROM	EXISTING SIGNS SALVAGE TO	EXISTING SIGNS REMOVE	EXIST POST RETAIN	EXIST POST REMOVE	NUMBER OF NEW POSTS	SQUARE STEEL (IN) 1.75 (LB/FT) 1.88	SQUARE STEEL (IN) 2.00 (LB/FT) 2.42	SQUARE STEEL (IN) 2.50 (LB/FT) 3.35	TUBULAR STEEL Ø (IN) FOUNDATION	TUBULAR STEEL Ø (IN) 3.00 (LB/FT) 7.60	TUBULAR STEEL Ø (IN) 3.50 (LB/FT) 9.00	TUBULAR STEEL Ø (IN) 4.00 (LB/FT) 10.80	TUBULAR STEEL Ø (IN) 5.00 (LB/FT) 14.60	SIGN FRAME REQUIRED	REMARKS	SIGN DETAIL: DETAIL IN SHS	SIGN DETAIL: DETAIL ON SHEET NUMBER	SIGN DETAIL: DETAIL ON STD SHEET NUMBER
SHAFTSBURY VT-7A							FY-FLUORESCENT YELLOW FYG-FLUORESCENT YELLOW GREEN																			"SHS"-STANDARD HIGHWAY SIGNS			
		F	W13-1	18	18			2.25																			X		
SB	5.282	F	VD-062AL	72	16		BUSINESS SIGN			1																			
		F	VD-062B	72	16		BUSINESS SIGN			1																			
SB	5.220	G	VR-017	24	30								1		X												BIRCH HILL RD. (TH-96)			
		G	VR-017	24	30			5.00								1		12.5 X										4	
SB	5.214	H	R1-1	30	30								1		X												BIRCH HILL RD. (TH-96)			
		H	R1-1	30	30			6.25								1		13.25 X										X	
SB	4.870	F	OM-3R	12	36		DELINEATOR REMOVED	3.00					1			1		11.0 X									INSTALL AT 4 FT AND IN PLACE OF DELINEATOR POST AT NORTH END OF CURBING	X		
SB	4.477	G	VR-017	24	30								1		X												HIGHLAND WOODS DR (TH-99)			
		G	VR-017	24	30			5.00								1		13.25 X										4	
SB	4.471	H	R1-1	30	30								1		X												HIGHLAND WOODS DR (TH-99)			
		H	R1-1	30	30			6.25								1		14.25 X										X	
SB	4.329	F	OM-3R	12	36		DELINEATOR REMOVED	3.00					1			1		11.0 X									INSTALL AT 4 FT AND IN PLACE OF DELINEATOR POST AT GOVERNORS ROCK MOTEL	X		
SB	3.854	F	VW-059	30	30		HIDDEN DRIVE						1		X															
SB	3.741	F	R2-1	24	30								1		X															
							SHEET TOTALS	30.75	0.00	2	0	0	~~8~~ 6	0	0	6		~~90~~ 75.25											
								SF	SF	EA	EA	EA	EA	EA	EA	EA		FT											
							TOWN DIRECTIONAL TOTALS	217.7	0.0	26.0	5.0	5.0	46	0.0	0.0	38		570.0											

SIGN SUMMARY SHEET

VERMONT AGENCY OF TRANSPORTATION

PROJECT NAME: **STATEWIDE - SOUTHWEST REGION**
PROJECT NUMBER: **STPG SIGN(32)**

FILE NAME: **SHAFTSBURY SB.XLS** PLOT DATE: **7/13/2010**
PROJECT MANAGER: **A. GAMBLE** DRAWN BY: **J. KELLY**
DESIGNED BY: **J. KELLY** CHECKED BY: **A. GAMBLE**
SHAFTSBURY SOUTHBOUND SHEET 2 SHEET **19** OF **90**

DIRECTION	MILEPOINT	LOCATION CODE (SHEET 2)	SIGN CODE	WIDTH (IN)	HEIGHT (IN)	SHEETING REMARKS	SIGN LEGEND	NEW SIGNS "A"	NEW SIGNS "B"	EXISTING SIGNS RETAIN	EXISTING SIGNS SALVAGE FROM	EXISTING SIGNS SALVAGE TO	EXISTING SIGNS REMOVE	EXIST POST RETAIN	EXIST POST REMOVE	NUMBER OF NEW POSTS	SQUARE STEEL (IN) 1.75 (LB/FT) 1.88	SQUARE STEEL (IN) 2.00 (LB/FT) 2.42	SQUARE STEEL (IN) 2.50 (LB/FT) 3.35	TUBULAR STEEL Ø (IN) FOUNDATION	TUBULAR STEEL Ø (IN) 3.00 (LB/FT) 7.60	TUBULAR STEEL Ø (IN) 3.50 (LB/FT) 9.00	TUBULAR STEEL Ø (IN) 4.00 (LB/FT) 10.80	TUBULAR STEEL Ø (IN) 5.00 (LB/FT) 14.60	SIGN FRAME REQUIRED	REMARKS	SIGN DETAIL: DETAIL IN SHS	SIGN DETAIL: DETAIL ON SHEET NUMBER	SIGN DETAIL: DETAIL ON STD SHEET NUMBER
SHAFTSBURY VT-7A							FY-FLUORESCENT YELLOW FYG-FLUORESCENT YELLOW GREEN																			"SHS"-STANDARD HIGHWAY SIGNS			
		F	R2-1	24	30		SPEED LIMIT 50	5.00								1		13.25 X										
SB	3.619	F	W2-1M	30	30		MODIFIED CROSSROAD			1				X												W. MOUNTAIN RD. (TH-54)			
SB	3.502	G	VR-017	24	30		LEGAL LOAD LIMIT 24,000 POUNDS						1		X														
		G	VR-017	24	30			5.00								1		14.0 X										4	
SB	3.494	H	R1-1	30	30		STOP						1		X														
		H	R1-1	30	30			6.25								1		13.25 X								W. MOUNTAIN RD. (TH-54)	X		
SB	2.944	F	VD-062AS	72	16		BUSINESS SIGN			1				X															
		F	VD-062B	72	16		BUSINESS SIGN			1																			
SB	2.672	F	W2-2MR	30	30		RIGHT SIDE ROAD (UP 45 DEG)			1				X															
		F	W16-8	20	8		MYERS RD			1																			
SB	2.589	G	VR-017	24	30		LEGAL LOAD LIMIT 24,000 POUNDS						1		X												MYERS RD (TH-7)			
		G	VR-017	24	30			5.00								1		13.5 X										4	
SB	2.587	H	R1-1	30	30		STOP						1		X												MYERS RD (TH-7)			
		H	R1-1	30	30			6.25								1		15.25 X									X		
SB	1.800	F	W3-5	36	36		SPEED REDUCTION (40)			1				X															
							SHEET TOTALS	27.50	0.00	6	0	0	4	0	0	5		~~75~~ 69.25										
								SF	SF	EA	EA	EA	EA	EA	EA	EA		FT										
							TOWN DIRECTIONAL TOTALS	217.7	0.0	26.0	5.0	5.0	46	0.0	0.0	38		570.0										

SIGN SUMMARY SHEET

VERMONT AGENCY OF TRANSPORTATION

PROJECT NAME: **STATEWIDE - SOUTHWEST REGION**
PROJECT NUMBER: **STPG SIGN(32)**

FILE NAME: **SHAFTSBURY SB.XLS** PLOT DATE: **7/13/2010**
PROJECT MANAGER: **A. GAMBLE** DRAWN BY: **J. KELLY**
DESIGNED BY: **J. KELLY** CHECKED BY: **A. GAMBLE**
SHAFTSBURY SOUTHBOUND SHEET 3 SHEET **20** OF **90**

DIRECTION	MILEPOINT	LOCATION CODE (SHEET 2)	SIGN CODE	WIDTH (IN)	HEIGHT (IN)	SHEETING REMARKS	SIGN LEGEND	NEW SIGNS "A"	NEW SIGNS "B"	EXISTING SIGNS RETAIN	EXISTING SIGNS SALVAGE FROM	EXISTING SIGNS SALVAGE TO	EXISTING SIGNS REMOVE	EXIST POST RETAIN	EXIST POST REMOVE	NUMBER OF NEW POSTS	SQUARE STEEL (IN) 1.75 (LB/FT) 1.88	SQUARE STEEL (IN) 2.00 (LB/FT) 2.42	SQUARE STEEL (IN) 2.50 (LB/FT) 3.35	TUBULAR STEEL Ø (IN) FOUNDATION	TUBULAR STEEL Ø (IN) 3.00 (LB/FT) 7.60	TUBULAR STEEL Ø (IN) 3.50 (LB/FT) 9.00	TUBULAR STEEL Ø (IN) 4.00 (LB/FT) 10.80	TUBULAR STEEL Ø (IN) 5.00 (LB/FT) 14.60	SIGN FRAME REQUIRED	REMARKS	SIGN DETAIL: DETAIL IN SHS	SIGN DETAIL: DETAIL ON SHEET NUMBER	SIGN DETAIL: DETAIL ON STD SHEET NUMBER
SHAFTSBURY VT-7A							FY-FLUORESCENT YELLOW FYG-FLUORESCENT YELLOW GREEN																			"SHS"-STANDARD HIGHWAY SIGNS			
SB	1.757	F	VD-018	30	18								1		X														
		F	VD-018	30	18			3.75								1		13.25 X									5	
SB	1.713	F	R2-1	30	36		SPEED LIMIT 40			1				X														
SB	1.608	F	VD-062B	72	16		BUSINESS SIGN			1				X														
		F	VD-062B	72	16		BUSINESS SIGN			1																		
		F	VD-062B	72	16		BUSINESS SIGN			1																		
SB	1.527	F	VW-205	30	30								1		X														
		F	VW-205	36	36			9.00								2		14.5 13.5 X									INSTALL NEW SIGN ON TWO POSTS.	6	
SB	1.452	F	R2-1	30	36		SPEED LIMIT 35				1	1	1		X	1		14.5 X									RETAIN SIGN AND REPLACE POST.		
SB	1.371	F	VD-062B	72	16		BUSINESS SIGN			1				X														
SB	1.328	F	M2-1S	21	15								1		X														
		F	M1-5	24	24								1																
		F	M2-1	21	15			2.19								1		14.5 X									GREEN ON WHITE ROUTE MARKERS.		E-136B
		F	M1-5	24	24			4.00																				E-136B
SB	1.255	G	VR-017	24	30		LEGAL LOAD 24,000 LBS			1				X													DANIELS RD (TH-44)			
							SHEET TOTALS	18.94	0.00	6	1	1	~~4~~ 5	0	0	5		~~75~~ 70.25								
								SF	SF	EA	EA	EA	EA	EA	EA	EA		FT								
							TOWN DIRECTIONAL TOTALS	217.7	0.0	26.0	5.0	5.0	46	0.0	0.0	38		570.0								

SIGN SUMMARY SHEET

VERMONT AGENCY OF TRANSPORTATION

PROJECT NAME: **STATEWIDE - SOUTHWEST REGION**
PROJECT NUMBER: **STPG SIGN(32)**

FILE NAME: **SHAFTSBURY SB.XLS** PLOT DATE: **7/13/2010**
PROJECT MANAGER: **A. GAMBLE** DRAWN BY: **J. KELLY**
DESIGNED BY: **J. KELLY** CHECKED BY: **A. GAMBLE**
SHAFTSBURY SOUTHBOUND SHEET 4 SHEET **21** OF **90**


DIRECTION	MILEPOINT	LOCATION CODE (SHEET 2)	SIGN CODE	WIDTH (IN)	HEIGHT (IN)	SHEETING REMARKS	SIGN LEGEND	NEW SIGNS "A"	NEW SIGNS "B"	EXISTING SIGNS RETAIN	EXISTING SIGNS SALVAGE FROM	EXISTING SIGNS SALVAGE TO	EXISTING SIGNS REMOVE	EXIST POST RETAIN	EXIST POST REMOVE	NUMBER OF NEW POSTS	SQUARE STEEL (IN) 1.75 (LB / FT) 1.88	SQUARE STEEL (IN) 2.00 (LB / FT) 2.42	SQUARE STEEL (IN) 2.50 (LB / FT) 3.35	TUBULAR STEEL Ø (IN) FOUNDATION	TUBULAR STEEL Ø (IN) 3.00 (LB / FT) 7.60	TUBULAR STEEL Ø (IN) 3.50 (LB / FT) 9.00	TUBULAR STEEL Ø (IN) 4.00 (LB / FT) 10.80	TUBULAR STEEL Ø (IN) 5.00 (LB / FT) 14.60	SIGN FRAME REQUIRED	REMARKS	SIGN DETAIL: DETAIL IN SHS	SIGN DETAIL: DETAIL ON SHEET NUMBER	SIGN DETAIL: DETAIL ON STD SHEET NUMBER
SHAFTSBURY VT-7A							FY-FLUORESCENT YELLOW FYG-FLUORESCENT YELLOW GREEN																			"SHS"-STANDARD HIGHWAY SIGNS			
SB	1.249	H	R1-1	30	30										X											DANIELS RD (TH-44)			
		H	R1-1	30	30			6.25					I			1		14.25 X									X		
SB	1.241	F	D1-1A	72	12		DESTINATION SIGN			~~1~~		I	I		X	2		13.75 14.0 X											
		F	D1-1A	72	12		DESTINATION SIGN			~~1~~		I	I																
		F	D1-1M	72	12		DESTINATION SIGN			~~1~~		I	I																
SB	1.215	F	M3-3S	24	12								1		X														
		F	VM-078S	24	12								1																
		F	M1-5	24	24								1																
		F	M6-3S	21	15								1																
		F	M3-4S	24	12								1																
		F	M1-5	24	24								1																
		F	M6-1S	21	15								1																
		F	M3-3	24	12			2.00								2		15.75 15.0 X								#2	GREEN ON WHITE ROUTE MARKERS.		7	E-136B
		F	VM-078	24	12			2.00																					E-136B
		F	M1-5	24	24			4.00																					E-136B
							SHEET TOTALS	14.25	0.00	3	0	~~3~~ 0	~~11~~ 7	0	0	5		~~75~~ 72.75											
								SF	SF	EA	EA	EA	EA	EA	EA	EA		FT											
							TOWN DIRECTIONAL TOTALS	217.7	0.0	26.0	5.0	5.0	46	0.0	0.0	38		570.0											

SIGN SUMMARY SHEET

VERMONT AGENCY OF TRANSPORTATION

PROJECT NAME: **STATEWIDE - SOUTHWEST REGION**
PROJECT NUMBER: **STPG SIGN(32)**

FILE NAME: **SHAFTSBURY SB.XLS** PLOT DATE: **7/13/2010**
PROJECT MANAGER: **A. GAMBLE** DRAWN BY: **J. KELLY**
DESIGNED BY: **J. KELLY** CHECKED BY: **A. GAMBLE**
SHAFTSBURY SOUTHBOUND SHEET 5 SHEET **22** OF **90**

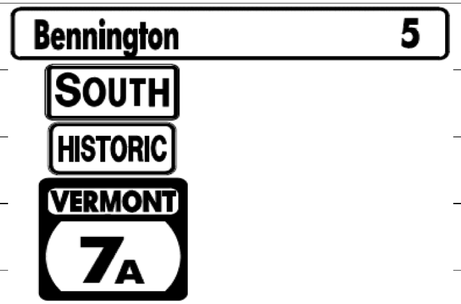DIRECTION	MILEPOINT	LOCATION CODE (SHEET 2)	SIGN CODE	WIDTH (IN)	HEIGHT (IN)	SHEETING REMARKS	SIGN LEGEND	NEW SIGNS "A"	NEW SIGNS "B"	EXISTING SIGNS RETAIN	EXISTING SIGNS SALVAGE FROM	EXISTING SIGNS SALVAGE TO	EXISTING SIGNS REMOVE	EXIST POST RETAIN	EXIST POST REMOVE	NUMBER OF NEW POSTS	SQUARE STEEL (IN) 1.75 (LB / FT) 1.88	SQUARE STEEL (IN) 2.00 (LB / FT) 2.42	SQUARE STEEL (IN) 2.50 (LB / FT) 3.35	FOUNDATION	TUBULAR STEEL Ø (IN) 3.00 (LB / FT) 7.60	TUBULAR STEEL Ø (IN) 3.50 (LB / FT) 9.00	TUBULAR STEEL Ø (IN) 4.00 (LB / FT) 10.80	TUBULAR STEEL Ø (IN) 5.00 (LB / FT) 14.60	SIGN FRAME REQUIRED	REMARKS	SIGN DETAIL: DETAIL IN SHS	SIGN DETAIL: DETAIL ON SHEET NUMBER	SIGN DETAIL: DETAIL ON STD SHEET NUMBER
SHAFTSBURY VT-7A							FY-FLUORESCENT YELLOW FYG-FLUORESCENT YELLOW GREEN																			"SHS"-STANDARD HIGHWAY SIGNS			
		F	M6-3	21	15			2.19																				E-136B
		F	M3-4S	24	12			2.00																				E-136B
		F	M1-5	24	24			4.00																				E-136B
		F	M6-1	21	15			2.19																				E-136B
SB	1.159	F	D2-1	72	10								1		X													
		F	M3-3S	24	12								1															
		F	VM-078S	24	12								1															
		F	M1-5	24	24								1															
		F	D2-1	72	12			6.00								2		16.25 17.75 X								GREEN ON WHITE ROUTE MARKERS.		5	
		F	M3-3	24	12			2.00																				E-136B
		F	VM-078	24	12			2.00																				E-136B
		F	M1-5	24	24			4.00																				E-136B
SB	1.133	F	R2-1	24	30								1	X														
		F	R2-1	30	36			7.50																		REPLACE SIGN AND INSTALL ON EXISTING POST.		4	
SB	1.094	F	D9-1	24	30		PHONE						1		X													
							SHEET TOTALS	31.88	0.00	0	0	0	6	0	0	2		~~30~~ 34.0										
								SF	SF	EA	EA	EA	EA	EA	EA	EA		FT										
							TOWN DIRECTIONAL TOTALS	217.7	0.0	26.0	5.0	5.0	46	0.0	0.0	38		570.0										

SIGN SUMMARY SHEET

VERMONT AGENCY OF TRANSPORTATION

PROJECT NAME: **STATEWIDE - SOUTHWEST REGION**
PROJECT NUMBER: **STPG SIGN(32)**
FILE NAME: **SHAFTSBURY SB.XLS** PLOT DATE: **7/13/2010**
PROJECT MANAGER: **A. GAMBLE** DRAWN BY: **J. KELLY**
DESIGNED BY: **J. KELLY** CHECKED BY: **A. GAMBLE**
SHAFTSBURY SOUTHBOUND SHEET 6 SHEET **23** OF **90**

DIRECTION	MILEPOINT	LOCATION CODE (SHEET 2)	SIGN CODE	WIDTH (IN)	HEIGHT (IN)	SHEETING REMARKS	SIGN LEGEND	NEW SIGNS "A"	NEW SIGNS "B"	EXISTING SIGNS RETAIN	EXISTING SIGNS SALVAGE FROM	EXISTING SIGNS SALVAGE TO	EXISTING SIGNS REMOVE	EXIST POST RETAIN	EXIST POST REMOVE	NUMBER OF NEW POSTS	SQUARE STEEL (IN) (LB / FT) 1.88	2.42	3.35	TUBULAR STEEL Ø (IN) FOUNDATION	(LB / FT) 7.60	9.00	10.80	14.60	SIGN FRAME REQUIRED	REMARKS	SIGN DETAIL DETAIL IN SHS	DETAIL ON SHEET NUMBER	DETAIL ON STD SHEET NUMBER
SHAFTSBURY VT-7A							FY-FLUORESCENT YELLOW FYG-FLUORESCENT YELLOW GREEN																			"SHS"-STANDARD HIGHWAY SIGNS			
		F	VD-058	24	8		AHEAD						1																
SB	1.047	F	S1-1FYG	36	36		SCHOOL			1				X															
		F	W16-9FYG	24	12		AHEAD			1																			
SB	1.006	G	VR-017	24	30		LEGAL LOAD LIMIT 24,000 POUNDS						1	X												UNDERPASS RD. (TH-59)			
		G	VR-017	24	30			5.00																		REPLACE SIGN AND RETAIN POST.		4	
SB	0.997	H	R1-1	30	30		STOP						1		X											UNDERPASS RD. (TH-59)			
		H	R1-1	30	30			6.25								1		13.25 X									X		
SB	0.966	G	VR-017	24	30		LEGAL LOAD LIMIT 24,000 POUNDS						1		X											CHURCH ST. (TH-2)			
		G	VR-017	24	30			5.00								1		15.75 X										4	
		G					TOWN'S SPEED LIMIT 25				1	1	1													REINSTALL TOWN SIGNS BELOW NEW LEGAL LOAD 24 K			
		G					TOWN'S NO PARKING				1	1	1															
SB	0.956	H	R1-1	30	30		STOP						1		X											CHURCH ST. (TH-2)			
		H	R1-1	30	30			6.25								1		13.25 X									X		
SB	0.955	F	S1-1FYG	30	30		SCHOOL			1				X															
		F	W16-9FYG	24	12		AHEAD			1																			
SIGN SUMMARY SHEET							SHEET TOTALS	22.50	0.00	4	2	2	~~5~~ 7	0	0	3		-~~45~~ 42.25 FT										
								SF	SF	EA	EA	EA	EA	EA	EA	EA													
VERMONT AGENCY OF TRANSPORTATION							TOWN DIRECTIONAL TOTALS	217.7	0.0	26.0	5.0	5.0	46	0.0	0.0	38		570.0										

PROJECT NAME: **STATEWIDE - SOUTHWEST REGION**
PROJECT NUMBER: **STPG SIGN(32)**

FILE NAME: **SHAFTSBURY SB.XLS** PLOT DATE: **7/13/2010**
PROJECT MANAGER: **A. GAMBLE** DRAWN BY: **J. KELLY**
DESIGNED BY: **J. KELLY** CHECKED BY: **A. GAMBLE**
SHAFTSBURY SOUTHBOUND SHEET 7 SHEET **24** OF **90**

DIRECTION	MILEPOINT	LOCATION CODE (SHEET 2)	SIGN CODE	WIDTH (IN)	HEIGHT (IN)	SHEETING REMARKS	SIGN LEGEND	NEW SIGNS "A"	NEW SIGNS "B"	EXISTING SIGNS RETAIN	EXISTING SIGNS SALVAGE FROM	EXISTING SIGNS SALVAGE TO	EXISTING SIGNS REMOVE	EXIST POST RETAIN	EXIST POST REMOVE	NUMBER OF NEW POSTS	SQUARE STEEL (IN) 1.75 (LB/FT) 1.88	SQUARE STEEL (IN) 2.00 (LB/FT) 2.42	SQUARE STEEL (IN) 2.50 (LB/FT) 3.35	FOUNDATION	TUBULAR STEEL Ø (IN) 3.00 (LB/FT) 7.60	TUBULAR STEEL Ø (IN) 3.50 (LB/FT) 9.00	TUBULAR STEEL Ø (IN) 4.00 (LB/FT) 10.80	TUBULAR STEEL Ø (IN) 5.00 (LB/FT) 14.60	SIGN FRAME REQUIRED	REMARKS	SIGN DETAIL: DETAIL IN SHS	SIGN DETAIL: DETAIL ON SHEET NUMBER	SIGN DETAIL: DETAIL ON STD SHEET NUMBER
SHAFTSBURY VT-7A							FY-FLUORESCENT YELLOW FYG-FLUORESCENT YELLOW GREEN																				"SHS"-STANDARD HIGHWAY SIGNS			
SB	0.872	F	R2-1	24	30								1	X																
		F	R2-1	24	30			5.00																			REPLACE SIGN AND RETAIN SIGN POST.	X		
SB	0.759	F	W11-2FYG	30	30		PEDESTRIAN			1				X																
		F	W16-7FYG	24	12		DIAGONAL ARROW			1																				
SB	0.603	G	VR-017	24	30								1		X													CLEVELAND AV. (TH-4)			
		G	VR-017	24	30			5.00								1		13.25 X											4	
SB	0.597	H	R1-1	30	30								1		X													CLEVELAND AV. (TH-4)			
		H	R1-1	30	30			6.25								1		13.25 X										X		
SB	0.594	F	R2-1	24	30								1		X																
		F	R2-1	24	30			5.00								1		13.25 X										X		
SB	0.357	F	R2-1	24	30		SPEED LIMIT 40			1				X																
SB	0.319	F	VD-062B	72	16		BUSINESS SIGN			1				X																
SB	0.220	F	VW-054R	30	30								1	X																	
		F	VW-054R	30	30			6.25																			REPLACE SIGN AND RETAIN SIGN POST.		6	
SB	0.108	F	S1-1FYG	36	36		SCHOOL				1	1	~~1~~ 6		X															
							SHEET TOTALS	27.50	0.00	4	1	1	~~5~~ 6	0	0	3		~~45~~ 39.75												
								SF	SF	EA	EA	EA	EA	EA	EA	EA		FT												
							TOWN DIRECTIONAL TOTALS	217.7	0.0	26.0	5.0	5.0	46	0.0	0.0	38		570.0												

SIGN SUMMARY SHEET

VERMONT AGENCY OF TRANSPORTATION

PROJECT NAME: **STATEWIDE - SOUTHWEST REGION**
PROJECT NUMBER: **STPG SIGN(32)**

FILE NAME: **SHAFTSBURY SB.XLS** PLOT DATE: **7/13/2010**
PROJECT MANAGER: **A. GAMBLE** DRAWN BY: **J. KELLY**
DESIGNED BY: **J. KELLY** CHECKED BY: **A. GAMBLE**
SHAFTSBURY SOUTHBOUND SHEET 8 SHEET **25** OF **90**

DIRECTION	MILEPOINT	LOCATION CODE (SHEET 2)	SIGN CODE	WIDTH (IN)	HEIGHT (IN)	SHEETING REMARKS	SIGN LEGEND	NEW SIGNS "A"	NEW SIGNS "B"	EXISTING SIGNS RETAIN	EXISTING SIGNS SALVAGE FROM	EXISTING SIGNS SALVAGE TO	EXISTING SIGNS REMOVE	EXIST POST RETAIN	EXIST POST REMOVE	NUMBER OF NEW POSTS	SQUARE STEEL (IN) 1.75 (LB / FT) 1.88	SQUARE STEEL (IN) 2.00 (LB / FT) 2.42	SQUARE STEEL (IN) 2.50 (LB / FT) 3.35	TUBULAR STEEL Ø (IN) FOUNDATION	TUBULAR STEEL Ø (IN) 3.00 (LB / FT) 7.60	TUBULAR STEEL Ø (IN) 3.50 (LB / FT) 9.00	TUBULAR STEEL Ø (IN) 4.00 (LB / FT) 10.80	TUBULAR STEEL Ø (IN) 5.00 (LB / FT) 14.60	SIGN FRAME REQUIRED	REMARKS	SIGN DETAIL: DETAIL IN SHS	SIGN DETAIL: DETAIL ON SHEET NUMBER	SIGN DETAIL: DETAIL ON STD SHEET NUMBER
SHAFTSBURY VT-7A							FY-FLUORESCENT YELLOW FYG-FLUORESCENT YELLOW GREEN																			"SHS"-STANDARD HIGHWAY SIGNS			
		F	W16-9FYG	24	10		AHEAD				1	1	I			2		14.25 14.75 X								RETAIN SIGNS AND REPLACE SIGN POSTS.			
SB	0.042	F	D1-1E	72	20		HILAND HALL SCHOOL			1				X															
SB	0.006	G	VD-024	60	7.5		BENNINGTON / SHAFTSBURY TOWN LINE ASSEMBLY						1		X															
SB	0.000	G	VD-024	72	10		Bennington | Shaftsbury	5.00								2		11.75 11.75 X									INSTALL DIRECTLY ACROSS ROAD FROM STONE WALL ALONG TH-35.		4	
		G	VD-700	6	10		0071 0202 0302 | 0071 0213 0000	0.42																			INSTALL ON LH POST BELOW BENNINGTON			E-138
		G	VD-700	6	10			0.42																			INSTALL ON RH POST BELOW SHAFTSBURY			E-138
							SHEET TOTALS	5.84	0.00	1	1	1	2 ~~1~~	0	0	4		~~60~~ 52.5											
								SF	SF	EA	EA	EA	EA	EA	EA	EA		FT											
							TOWN DIRECTIONAL TOTALS	217.7	0.0	26.0	5.0	8.0 ~~5.0~~	57 ~~46~~	0.0	0.0	38		529.75 ~~570.0~~											


SIGN SUMMARY SHEET

VERMONT AGENCY OF TRANSPORTATION

PROJECT NAME: **STATEWIDE - SOUTHWEST REGION**
PROJECT NUMBER: **STPG SIGN(32)**

FILE NAME: **SHAFTSBURY SB.XLS** PLOT DATE: **7/13/2010**
PROJECT MANAGER: **A. GAMBLE** DRAWN BY: **J. KELLY**
DESIGNED BY: **J. KELLY** CHECKED BY: **A. GAMBLE**
SHAFTSBURY SOUTHBOUND SHEET 9 SHEET **26** OF **90**

DIRECTION	MILEPOINT	LOCATION CODE (SHEET 2)	SIGN CODE	WIDTH (IN)	HEIGHT (IN)	SHEETING REMARKS	SIGN LEGEND	NEW SIGNS "A"	NEW SIGNS "B"	EXISTING SIGNS RETAIN	EXISTING SIGNS SALVAGE FROM	EXISTING SIGNS SALVAGE TO	EXISTING SIGNS REMOVE	EXIST POST RETAIN	EXIST POST REMOVE	NUMBER OF NEW POSTS	SQUARE STEEL (IN) 1.75 (LB/FT) 1.88	SQUARE STEEL (IN) 2.00 (LB/FT) 2.42	SQUARE STEEL (IN) 2.50 (LB/FT) 3.35	TUBULAR STEEL Ø (IN) FOUNDATION	TUBULAR STEEL Ø (IN) 3.00 (LB/FT) 7.60	TUBULAR STEEL Ø (IN) 3.50 (LB/FT) 9.00	TUBULAR STEEL Ø (IN) 4.00 (LB/FT) 10.80	TUBULAR STEEL Ø (IN) 5.00 (LB/FT) 14.60	SIGN FRAME REQUIRED	REMARKS	SIGN DETAIL: DETAIL IN SHS	SIGN DETAIL: DETAIL ON SHEET NUMBER	SIGN DETAIL: DETAIL ON STD SHEET NUMBER
WINHALL VT-30							FY-FLUORESCENT YELLOW FYG-FLUORESCENT YELLOW GREEN																			"SHS"-STANDARD HIGHWAY SIGNS			
NB	10.086	A	VD-018	30	18		BONDVILLE / JCT VT-11 7						1		X											REMOVE BOTH OF THESE SIGN ASSEMBLIES FROM NORTH END OF JAMAICA.			
NB	10.106	A	R2-5A	24	30		REDUCED SPEED AHEAD						1		X														
WINHALL VT-30																													
NB	0.000	C	VD-024	60	7.5								~~1~~ 2		X											2 ADDITIONAL MM REMOVED @ 0.000			
		C	VD-025	60	7.5								~~1~~ 2		X														
		C	VD-024	72	10			5.00								2		12.75 12.75 X										4		
		C	VD-025	72	10			5.00																				4		
		C	VD-700	6	10			0.42																			INSTALL ON LH POST BELOW WINHALL			E-138
		C	VD-700	6	10			0.42																			INSTALL ON RH POST BELOW JAMAICA			E-138
NB	0.015	A	W3-5	36	36			9.00								2		14.75 14.25 X									INSTALL 25 FEET NORTH OF TOWN'S WELCOME TO WINHALL SIGN.	X		
NB	0.065	A	VD-018	30	18			3.75								1		15.75 X									INSTALL ACROSS FROM SB BUSINESS SIGN		5	
NB	0.130	A	R2-1	24	30								1		X														
		A	R2-1	30	36			7.50								1		16.75 X										X		
NB	0.160	C	VR-017	24	30								1	X		1		13.25 X									AMEDEN RD. (TH-22) EXISTING POST DAMAGED			
		C	VR-017	24	30			5.00																			REPLACE SIGN AND RETAIN POST.		4	
							SHEET TOTALS	36.09	0.00	0	0	0	~~8~~ 6	0	0	~~7~~ 6		~~90~~ 101.25									
								SF	SF	EA	EA	EA	EA	EA	EA	EA		FT												
							TOWN DIRECTIONAL TOTALS	456.7	0.0	5.0	3.0	3.0	79	0.0	0.0	51		765.0												

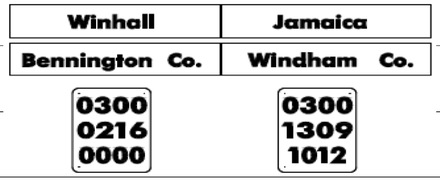









SIGN SUMMARY SHEET

VERMONT AGENCY OF TRANSPORTATION

PROJECT NAME: STATEWIDE - SOUTHWEST REGION
PROJECT NUMBER: STPG SIGN(32)

FILE NAME: WINHALL NB.XLS
PROJECT MANAGER: A. GAMBLE
DESIGNED BY: J. KELLY
WINHALL NORTHBOUND SHEET 1

PLOT DATE: 8/26/2010
DRAWN BY: J. KELLY
CHECKED BY: A. GAMBLE

DIRECTION	MILEPOINT	LOCATION CODE (SHEET 2)	SIGN CODE	WIDTH (IN)	HEIGHT (IN)	SHEETING REMARKS	SIGN LEGEND	NEW SIGNS "A"	NEW SIGNS "B"	EXISTING SIGNS RETAIN	EXISTING SIGNS SALVAGE FROM	EXISTING SIGNS SALVAGE TO	EXISTING SIGNS REMOVE	EXIST POST RETAIN	EXIST POST REMOVE	NUMBER OF NEW POSTS	SQUARE STEEL (IN) 1.75 (LB / FT) 1.88	SQUARE STEEL (IN) 2.00 (LB / FT) 2.42	SQUARE STEEL (IN) 2.50 (LB / FT) 3.35	TUBULAR STEEL Ø (IN) FOUNDATION	TUBULAR STEEL Ø (IN) 3.00 (LB / FT) 7.60	TUBULAR STEEL Ø (IN) 3.50 (LB / FT) 9.00	TUBULAR STEEL Ø (IN) 4.00 (LB / FT) 10.80	TUBULAR STEEL Ø (IN) 5.00 (LB / FT) 14.60	SIGN FRAME REQUIRED	REMARKS	SIGN DETAIL: DETAIL IN SHS	SIGN DETAIL: DETAIL ON SHEET NUMBER	SIGN DETAIL: DETAIL ON STD SHEET NUMBER
WINHALL VT-30							FY-FLUORESCENT YELLOW FYG-FLUORESCENT YELLOW GREEN																			"SHS"-STANDARD HIGHWAY SIGNS			
NB	0.165	D	R1-1	30	30			6.25								1		13.25 X								AMEDEN RD. (TH-22)	X		
NB	0.238	A	S3-4A	30	30		SCHOOL BUS TURN AROUND			1				X															
NB	0.275	A	VR-020	24	30								1	X															
		A	VR-020	24	30			5.00																		REPLACE SIGN AND RETAIN SIGN POST.		4	
NB	0.300	A	VD-062M	72	16		BUSINESS SIGN			1				X															
		A	VD-062M	72	16		BUSINESS SIGN			1																			
		A	VD-062BM	72	16		BUSINESS SIGN			1																			
NB	0.314	A	D1-1S	72	10								1		X														
		A	D1-1S	72	12			6.00								2		12.0 12.0 X									5	
NB	0.330	A	W11-2YG	30	30								1		X														
		A	W16-9FYG	24	12								1																
		A	W11-2	30	30	FYG		6.25								1		15.0 X									X	
		A	W16-9	24	12	FYG		2.00																			X		
NB	0.368	A	M3-1S	24	12		NORTH						1		X														
		A	M1-5	24	24		VT-30						1																
SIGN SUMMARY SHEET							SHEET TOTALS	25.50	0.00	4	0	0	6	0	0	4		~~60~~ 52.25										
								SF	SF	EA	EA	EA	EA	EA	EA	EA		FT										
VERMONT AGENCY OF TRANSPORTATION							TOWN DIRECTIONAL TOTALS	456.7	0.0	5.0	3.0	3.0	79	0.0	0.0	51		765.0										

PROJECT NAME: **STATEWIDE - SOUTHWEST REGION**
PROJECT NUMBER: **STPG SIGN(32)**

FILE NAME: **WINHALL NB.XLS** PLOT DATE: **8/26/2010**
PROJECT MANAGER: **A. GAMBLE** DRAWN BY: **J. KELLY**
DESIGNED BY: **J. KELLY** CHECKED BY: **A. GAMBLE**
WINHALL NORTHBOUND SHEET 2 SHEET **28** OF **90**

DIRECTION	MILEPOINT	LOCATION CODE (SHEET 2)	SIGN CODE	WIDTH (IN)	HEIGHT (IN)	SHEETING REMARKS	SIGN LEGEND	NEW SIGNS "A"	NEW SIGNS "B"	EXISTING SIGNS RETAIN	EXISTING SIGNS SALVAGE FROM	EXISTING SIGNS SALVAGE TO	EXISTING SIGNS REMOVE	EXIST POST RETAIN	EXIST POST REMOVE	NUMBER OF NEW POSTS	SQUARE STEEL (IN) 1.75 (LB / FT) 1.88	SQUARE STEEL (IN) 2.00 (LB / FT) 2.42	SQUARE STEEL (IN) 2.50 (LB / FT) 3.35	TUBULAR STEEL Ø (IN) FOUNDATION	TUBULAR STEEL Ø (IN) 3.00 (LB / FT) 7.60	TUBULAR STEEL Ø (IN) 3.50 (LB / FT) 9.00	TUBULAR STEEL Ø (IN) 4.00 (LB / FT) 10.80	TUBULAR STEEL Ø (IN) 5.00 (LB / FT) 14.60	SIGN FRAME REQUIRED	REMARKS	SIGN DETAIL: DETAIL IN SHS	SIGN DETAIL: DETAIL ON SHEET NUMBER	SIGN DETAIL: DETAIL ON STD SHEET NUMBER
WINHALL VT-30							FY-FLUORESCENT YELLOW FYG-FLUORESCENT YELLOW GREEN																				"SHS"-STANDARD HIGHWAY SIGNS			
		A	R2-1	24	30			5.00								1		13.25 X									X		
NB	0.397	A	R2-1	24	30		SPEED LIMIT 30						1		X														
		A	M3-1	24	12			2.00								1		14.0 X								GREEN ON WHITE ROUTE MARKERS.			E-136B
		A	M1-5	24	24			4.00																					E-136B
NB	0.463	A	VD-062AS	72	16		BUSINESS SIGN			1				X															
NB	0.509	A	R2-1	24	30								1		X															
		A	R2-1	24	30			5.00								1		13.25 X									X		
NB	0.516	C	VR-017	24	30								1	X													RIVER RD. (TH-13)			
		C	VR-017	24	30			5.00																			REPLACE SIGN AND RETAIN SIGN POST.		4	
NB	0.522	D	R1-1	30	30								1	X													RIVER RD. (TH-13)			
		D	R1-1	30	30			6.25																			REPLACE SIGN AND RETAIN SIGN POST.	X		
NB	0.610	C	VR-017	24	30								1	X													WINHALL HOLLOW RD. (TH-2)			
		C	VR-017	24	30			5.00																					4	
		C	N/A				TOWN'S BUCKLE-UP SIGN						1														REMOVE BUCKLE-UP SIGN AND RETURN TO TOWN.			
NB	0.617	D	R1-1	30	30								1	X													WINHALL HOLLOW RD. (TH-2)			
							SHEET TOTALS	32.25	0.00	1	0	0	7	0	0	3		-45- 40.5											
								SF	SF	EA	EA	EA	EA	EA	EA	EA		FT											
							TOWN DIRECTIONAL TOTALS	456.7	0.0	5.0	3.0	3.0	79	0.0	0.0	51		765.0											

SIGN SUMMARY SHEET

VERMONT AGENCY OF TRANSPORTATION

PROJECT NAME: **STATEWIDE - SOUTHWEST REGION**
PROJECT NUMBER: **STPG SIGN(32)**

FILE NAME: **WINHALL NB.XLS** PLOT DATE: **8/26/2010**
PROJECT MANAGER: **A. GAMBLE** DRAWN BY: **J. KELLY**
DESIGNED BY: **J. KELLY** CHECKED BY: **A. GAMBLE**
WINHALL NORTHBOUND SHEET 3 SHEET **29** OF **90**

DIRECTION	MILEPOINT	LOCATION CODE (SHEET 2)	SIGN CODE	WIDTH (IN)	HEIGHT (IN)	SHEETING REMARKS	SIGN LEGEND	NEW SIGNS "A"	NEW SIGNS "B"	EXISTING SIGNS RETAIN	EXISTING SIGNS SALVAGE FROM	EXISTING SIGNS SALVAGE TO	EXISTING SIGNS REMOVE	EXIST POST RETAIN	EXIST POST REMOVE	NUMBER OF NEW POSTS	SQUARE STEEL (IN) 1.75 (LB/FT) 1.88	SQUARE STEEL (IN) 2.00 (LB/FT) 2.42	SQUARE STEEL (IN) 2.50 (LB/FT) 3.35	TUBULAR STEEL Ø (IN) FOUNDATION	TUBULAR STEEL Ø (IN) 3.00 (LB/FT) 7.60	TUBULAR STEEL Ø (IN) 3.50 (LB/FT) 9.00	TUBULAR STEEL Ø (IN) 4.00 (LB/FT) 10.80	TUBULAR STEEL Ø (IN) 5.00 (LB/FT) 14.60	SIGN FRAME REQUIRED	REMARKS	SIGN DETAIL: DETAIL IN SHS	SIGN DETAIL: DETAIL ON SHEET NUMBER	SIGN DETAIL: DETAIL ON STD SHEET NUMBER
WINHALL VT-30							FY-FLUORESCENT YELLOW FYG-FLUORESCENT YELLOW GREEN																			"SHS"-STANDARD HIGHWAY SIGNS			
		D	R1-1	30	30			6.25																		REPLACE SIGN AND RETAIN SIGN POST.	X		
NB	0.700	A	R2-1	24	30			5.00								1		14.5 X								INSTALL 50 FEET SOUTH OF EXISTING SPEED LIMIT 40 SIGN ASSEMBLY.	X		
NB	0.710	A	R2-1	24	30		SPEED LIMIT 40						1		X														
NB	0.855	A	VW-544	30	30		EMERGENCY VEHICLES						1		X														
NB	0.955	A	R2-1	24	30		SPEED LIMIT 40						1		X														
		A	VW-544	30	30			6.25								1		14.5 X										6	
NB	1.000	A	W2-2R	30	30								1		X														
		A	W2-2MR	30	30			6.25								1		14.0 X										6	
NB	1.057	A	S1-1	36	36								1		X														
		A	W16-9FYG	24	10								1																
		A	S1-1	36	36	FYG		9.00								1		14.0 X									X		
		A	S4-3P	24	8	FYG		1.33																			X		
NB	1.113	A	D1-1E	72	20								~~1~~		X														
		A	D1-1E	72	20			10.00					2			2		14.5 15.75 X									1 ADDITIONAL SIGN REMOVED		6	
NB	1.147	C	VR-017	24	30			5.00								1		13.5 X									SCHOOL RD. (TH-37)		4	
							SHEET TOTALS	49.08	0.00	0	0	0	~~8~~ 7	0	0	7		~~105~~ 100.75											
								SF	SF	EA	EA	EA	EA	EA	EA	EA		FT											
							TOWN DIRECTIONAL TOTALS	456.7	0.0	5.0	3.0	3.0	79	0.0	0.0	51		765.0											

SIGN SUMMARY SHEET

VERMONT AGENCY OF TRANSPORTATION

PROJECT NAME: STATEWIDE - SOUTHWEST REGION
PROJECT NUMBER: STPG SIGN(32)

FILE NAME: WINHALL NB.XLS
PROJECT MANAGER: A. GAMBLE
DESIGNED BY: J. KELLY
WINHALL NORTHBOUND SHEET 4

PLOT DATE: 8/26/2010
DRAWN BY: J. KELLY
CHECKED BY: A. GAMBLE
SHEET 30 OF 90

DIRECTION	MILEPOINT	LOCATION CODE (SHEET 2)	SIGN CODE	WIDTH (IN)	HEIGHT (IN)	SHEETING REMARKS	SIGN LEGEND	NEW SIGNS "A"	NEW SIGNS "B"	EXISTING SIGNS RETAIN	EXISTING SIGNS SALVAGE FROM	EXISTING SIGNS SALVAGE TO	EXISTING SIGNS REMOVE	EXIST POST RETAIN	EXIST POST REMOVE	NUMBER OF NEW POSTS	SQUARE STEEL (IN) 1.75 (LB / FT) 1.88	SQUARE STEEL (IN) 2.00 (LB / FT) 2.42	SQUARE STEEL (IN) 2.50 (LB / FT) 3.35	TUBULAR STEEL Ø (IN) FOUNDATION	TUBULAR STEEL Ø (IN) 3.00 (LB / FT) 7.60	TUBULAR STEEL Ø (IN) 3.50 (LB / FT) 9.00	TUBULAR STEEL Ø (IN) 4.00 (LB / FT) 10.80	TUBULAR STEEL Ø (IN) 5.00 (LB / FT) 14.60	SIGN FRAME REQUIRED	REMARKS	SIGN DETAIL: DETAIL IN SHS	SIGN DETAIL: DETAIL ON SHEET NUMBER	SIGN DETAIL: DETAIL ON STD SHEET NUMBER
WINHALL VT-30							FY-FLUORESCENT YELLOW FYG-FLUORESCENT YELLOW GREEN																				"SHS"-STANDARD HIGHWAY SIGNS			
NB	1.157	D	R1-1	30	30								1	X													SCHOOL RD. (TH-37)			
		D	R1-1	30	30			6.25																	REPLACE SIGN AND RETAIN SIGN POST.	X		
NB	1.299	C	VR-017	24	30			5.00								1		13.25 X								SHORT RD. (TH-26)		4	
NB	1.306	D	R1-1	30	30								1	X													SHORT RD. (TH-26)			
		D	R1-1	30	30			6.25																		REPLACE SIGN AND RETAIN SIGN POST.	X		
NB	1.370	C	VR-017	24	30								1		X											SHORT RD. (TH-26)			
		D	R1-1	30	30								1																	
		C	VR-017	24	30			5.00								1		13.25 X										4	
		D	R1-1	30	30			6.25								1		13.25 X								INSTALL ON EASTERLY SIDE OF SHORT RD ON SEPARATE POST.	X		
NB	1.400	A	R2-1	24	30								1		X															
		A	R2-1	24	30			5.00								1		14.0 X									X		
NB	1.750	A	VW-000	30	30			6.25								1		15.5 X								INSTALL 175 FEET NORTH OF STRATTON VIEW ACCESS. SOUTH SIDE OF POLE #82X/50T/148/475		6	
		A	W7-3A	24	18			3.00																			X		
NB	2.335	C	VR-017	24	30								1	X													STONEY HILL RD. (TH-12)			
		C	VR-017	24	30			5.00																		REPLACE SIGN AND RETAIN SIGN POST.		4	
SIGN SUMMARY SHEET							SHEET TOTALS	48.00	0.00	0	0	0	6	0	0	5		~~75~~ 69.25											
								SF	SF	EA	EA	EA	EA	EA	EA	EA		FT											
VERMONT AGENCY OF TRANSPORTATION							TOWN DIRECTIONAL TOTALS	456.7	0.0	5.0	3.0	3.0	79	0.0	0.0	51		765.0											

PROJECT NAME: **STATEWIDE - SOUTHWEST REGION**
PROJECT NUMBER: **STPG SIGN(32)**

FILENAME: **WINHALL NB.XLS** PLOT DATE: **8/26/2010**
PROJECT MANAGER: **A. GAMBLE** DRAWN BY: **J. KELLY**
DESIGNED BY: **J. KELLY** CHECKED BY: **A. GAMBLE**
WINHALL NORTHBOUND SHEET 5 SHEET **31** OF **90**

DIRECTION	MILEPOINT	LOCATION CODE (SHEET 2)	SIGN CODE	WIDTH (IN)	HEIGHT (IN)	SHEETING REMARKS	SIGN LEGEND	NEW SIGNS "A"	NEW SIGNS "B"	EXISTING SIGNS RETAIN	EXISTING SIGNS SALVAGE FROM	EXISTING SIGNS SALVAGE TO	EXISTING SIGNS REMOVE	EXIST POST RETAIN	EXIST POST REMOVE	NUMBER OF NEW POSTS	SQUARE STEEL (IN) 1.75 (LB / FT) 1.88	SQUARE STEEL (IN) 2.00 (LB / FT) 2.42	SQUARE STEEL (IN) 2.50 (LB / FT) 3.35	TUBULAR STEEL Ø (IN) FOUNDATION	TUBULAR STEEL Ø (IN) 3.00 (LB / FT) 7.60	TUBULAR STEEL Ø (IN) 3.50 (LB / FT) 9.00	TUBULAR STEEL Ø (IN) 4.00 (LB / FT) 10.80	TUBULAR STEEL Ø (IN) 5.00 (LB / FT) 14.60	SIGN FRAME REQUIRED	REMARKS	SIGN DETAIL: DETAIL IN SHS	SIGN DETAIL: DETAIL ON SHEET NUMBER	SIGN DETAIL: DETAIL ON STD SHEET NUMBER
WINHALL VT-30							FY-FLUORESCENT YELLOW FYG-FLUORESCENT YELLOW GREEN																				"SHS"-STANDARD HIGHWAY SIGNS			
NB	2.343	D	R1-1	30	30								1	X													STONEY HILL RD. (TH-12)			
		D	R1-1	30	30			6.25																			REPLACE SIGN AND RETAIN SIGN POST.	X		
NB	2.710	C	VR-017	24	30								1	X													LOWER STRATTON VALLEY RD. (TH-29)			
		C	VR-017	24	30			5.00																			REPLACE SIGN AND RETAIN SIGN POST.		4	
		C	N/A				TOWN'S NO PARKING SIGN				~~1~~	~~1~~															INSTALL BELOW NEW LL24 K SIGN.			
NB	2.717	D	R1-1	30	30								1		X												LOWER STRATTON VALLEY RD. (TH-29)			
		D	R1-1	30	30			6.25								1	15.5 X											X		
NB	3.158	A	W1-5R	30	30			6.25								1	15.5 X										INSTALL 200 FEET SOUTH OF EXISTING WINDING ROAD SIGN.	X		
		A		24	18			3.00																						
NB	3.196	A	W1-5L	30	30		LEFT WINDING ROAD						1	X																
		A	W1-2R	30	30			6.25																			INSTALL NEW SIGN ON EXISTING POST.	X		
NB	3.256	A	VW-060	30	30		HIDDEN DRIVES 						1		X															
		A	VW-054R	30	30			6.25								1	15.25 X												6	
NB	4.000	A	W1-2L	30	30								1	X																
		A	W1-2L	30	30			6.25																			REPLACE SIGN AND RETAIN SIGN POST.	X		
SIGN SUMMARY SHEET							SHEET TOTALS	~~45.50~~ ~~42.50~~	0.00	0	~~1~~	~~1~~	6	0	0	3		~~45~~ 46.25											
								SF	SF	EA	EA	EA	EA	EA	EA	EA		FT											
VERMONT AGENCY OF TRANSPORTATION							TOWN DIRECTIONAL TOTALS	456.7	0.0	5.0	~~3.0~~ 2.0	~~3.0~~ 2.0	79	0.0	0.0	51		765.0											

PROJECT NAME: **STATEWIDE - SOUTHWEST REGION**
PROJECT NUMBER: **STPG SIGN(32)**

FILE NAME: WINHALL NB.XLS
PROJECT MANAGER: A. GAMBLE
DESIGNED BY: J. KELLY
WINHALL NORTHBOUND SHEET 6

PLOT DATE: 8/26/2010
DRAWN BY: J. KELLY
CHECKED BY: A. GAMBLE
SHEET 32 OF 90

* REF SHEET 38 OF 90 FOR UPDATE

DIRECTION	MILEPOINT	LOCATION CODE (SHEET 2)	SIGN CODE	WIDTH (IN)	HEIGHT (IN)	SHEETING REMARKS	SIGN LEGEND	NEW SIGNS "A"	NEW SIGNS "B"	EXISTING SIGNS RETAIN	EXISTING SIGNS SALVAGE FROM	EXISTING SIGNS SALVAGE TO	EXISTING SIGNS REMOVE	EXIST POST RETAIN	EXIST POST REMOVE	NUMBER OF NEW POSTS	SQUARE STEEL (IN) 1.75 (LB / FT) 1.88	SQUARE STEEL (IN) 2.00 (LB / FT) 2.42	SQUARE STEEL (IN) 2.50 (LB / FT) 3.35	TUBULAR STEEL Ø (IN) FOUNDATION	TUBULAR STEEL Ø (IN) 3.00 (LB / FT) 7.60	TUBULAR STEEL Ø (IN) 3.50 (LB / FT) 9.00	TUBULAR STEEL Ø (IN) 4.00 (LB / FT) 10.80	TUBULAR STEEL Ø (IN) 5.00 (LB / FT) 14.60	SIGN FRAME REQUIRED	REMARKS	SIGN DETAIL: DETAIL IN SHS	SIGN DETAIL: DETAIL ON SHEET NUMBER	SIGN DETAIL: DETAIL ON STD SHEET NUMBER
WINHALL VT-30							FY-FLUORESCENT YELLOW FYG-FLUORESCENT YELLOW GREEN																				"SHS"-STANDARD HIGHWAY SIGNS			
NB	4.110	A	VW-054L	30	30								1		X														
		A	VW-054L	30	30		HIDDEN DRIVE LEFT	6.25								1		14.0 X										6	
NB	4.120	C	VR-017	24	30								1	X													OLD TOWN RD. (TH-4)			
		C	VR-017	24	30		LEGAL LOAD LIMIT 24,000 POUNDS	5.00																			REPLACE SIGN AND RETAIN SIGN POST.		4	
		C	N/A				TOWN'S SPEED LIMIT 35				1	1	1													INSTALL BELOW NEW LEGAL LOAD SIGN.			
NB	4.135	D	R1-1	30	30								1		X												OLD TOWN RD. (TH-4)			
		D	R1-1	30	30		STOP	6.25								1		14.0 X										X	
NB	4.282	C	VR-017	24	30								1	X													BEAVER ST. (TH-55)			
		C	VR-017	24	30		LEGAL LOAD LIMIT 24,000 POUNDS	5.00																			REPLACE SIGN AND RETAIN SIGN POST.		4	
NB	4.290	D	R1-1	30	30								1		X												BEAVER ST. (TH-55)			
		D	R1-1	30	30		STOP	6.25								1		X										X	
NB	4.360	A	VW-054R	30	30		HIDDEN DRIVE RIGHT						1		X															
NB	5.152	A	VW-054R	30	30		HIDDEN DRIVE RIGHT						1		X															
NB	5.305	A	S3-1	30	30		* SCHOOL BUS STOP AHEAD						1		X															
		A	S3-1	36	36	FYG		9.00								2		14.75 15.75 X										X	
							SHEET TOTALS	37.75	0.00	0	1	1	~~9~~ 8	0	0	5		~~75~~ 71.75											
								SF	SF	EA	EA	EA	EA	EA	EA	EA		FT											
							TOWN DIRECTIONAL TOTALS	456.7	0.0	5.0	3.0	3.0	79	0.0	0.0	51		765.0											

SIGN SUMMARY SHEET

VERMONT AGENCY OF TRANSPORTATION

PROJECT NAME: **STATEWIDE - SOUTHWEST REGION**
PROJECT NUMBER: **STPG SIGN(32)**

FILE NAME: **WINHALL NB.XLS** PLOT DATE: **8/26/2010**
PROJECT MANAGER: **A. GAMBLE** DRAWN BY: **J. KELLY**
DESIGNED BY: **J. KELLY** CHECKED BY: **A. GAMBLE**
WINHALL NORTHBOUND SHEET 7 SHEET **33** OF **90**

DIRECTION	MILEPOINT	LOCATION CODE (SHEET 2)	SIGN CODE	WIDTH (IN)	HEIGHT (IN)	SHEETING REMARKS	• REF SHEET 38 OF 90 FOR UPDATE SIGN LEGEND	NEW SIGNS "A"	NEW SIGNS "B"	EXISTING SIGNS RETAIN	EXISTING SIGNS SALVAGE FROM	EXISTING SIGNS SALVAGE TO	EXISTING SIGNS REMOVE	EXIST POST RETAIN	EXIST POST REMOVE	NUMBER OF NEW POSTS	SQUARE STEEL (IN) 1.75 (LB / FT) 1.88	SQUARE STEEL (IN) 2.00 (LB / FT) 2.42	SQUARE STEEL (IN) 2.50 (LB / FT) 3.35	TUBULAR STEEL Ø (IN) FOUNDATION	TUBULAR STEEL Ø (IN) 3.00 (LB / FT) 7.60	TUBULAR STEEL Ø (IN) 3.50 (LB / FT) 9.00	TUBULAR STEEL Ø (IN) 4.00 (LB / FT) 10.80	TUBULAR STEEL Ø (IN) 5.00 (LB / FT) 14.60	SIGN FRAME REQUIRED	REMARKS	SIGN DETAIL: DETAIL IN SHS	SIGN DETAIL: DETAIL ON SHEET NUMBER	SIGN DETAIL: DETAIL ON STD SHEET NUMBER
WINHALL VT-30							FY-FLUORESCENT YELLOW FYG-FLUORESCENT YELLOW GREEN																			"SHS"-STANDARD HIGHWAY SIGNS			
NB	5.404	C	VR-017	24	30								1	X												OLD ROUTE 30. (TH-23)			
		C	VR-017	24	30		LEGAL LOAD LIMIT 24,000 POUNDS	5.00																		REPLACE SIGN AND RETAIN SIGN POST.		4	
NB	5.411	D	R1-1	30	30								1		X											OLD ROUTE 30. (TH-23)			
		D	R1-1	30	30		STOP	6.25								1		13.25 X									X		
NB	5.685	C	VR-017	24	30								1		X											OLD ROUTE 30. (TH-23)			
		C	VR-017	24	30		LEGAL LOAD LIMIT 24,000 POUNDS	5.00								1		13.25 X										4	
NB	5.702	D	R1-1	30	30								1		X											OLD ROUTE 30. (TH-23)			
		D	R1-1	30	30		STOP	6.25								1		13.25 X											
NB	5.790	A	S3-1	30	30		* SCHOOL BUS STOP AHEAD						1		X														
NB	5.800	A	S3-1	36	36	FYG	SCHOOL BUS STOP AHEAD	9.00								2 ~~1~~		14.5 15.0 X								INSTALL 50 FEET NORTH OF EXISTING. PLACED ON 2 POSTS	X		
NB	5.840	A	W2-2R	30	30								1		X														
		A	W2-2RM	30	30			6.25								1		14.0 X										6	
NB	5.907	C	VR-017	24	30		LEGAL LOAD LIMIT 24,000 POUNDS						1	X												FRENCH HOLLOW RD. (TH-6)			
		C	VR-017	24	30			5.00																		REPLACE SIGN AND RETAIN SIGN POST.		4	
NB	5.921	D	R1-1	30	30		STOP						1	X												FRENCH HOLLOW RD. (TH-6)			
							SHEET TOTALS	42.75	0.00	0	0	0	8	0	0	6 ~~5~~		~~75~~ 83.25										
								SF	SF	EA	EA	EA	EA	EA	EA	EA		FT										
							TOWN DIRECTIONAL TOTALS	456.7	0.0	5.0	3.0	3.0	79	0.0	0.0	51		765.0										

SIGN SUMMARY SHEET

VERMONT AGENCY OF TRANSPORTATION

PROJECT NAME: STATEWIDE - SOUTHWEST REGION
PROJECT NUMBER: STPG SIGN(32)

FILE NAME: WINHALL NB.XLS
PROJECT MANAGER: A. GAMBLE
DESIGNED BY: J. KELLY
WINHALL NORTHBOUND SHEET 8

PLOT DATE: 8/26/2010
DRAWN BY: J. KELLY
CHECKED BY: A. GAMBLE
SHEET 34 OF 90

DIRECTION	MILEPOINT	LOCATION CODE (SHEET 2)	SIGN CODE	WIDTH (IN)	HEIGHT (IN)	SHEETING REMARKS	SIGN LEGEND	NEW SIGNS "A"	NEW SIGNS "B"	EXISTING SIGNS RETAIN	EXISTING SIGNS SALVAGE FROM	EXISTING SIGNS SALVAGE TO	EXISTING SIGNS REMOVE	EXIST POST RETAIN	EXIST POST REMOVE	NUMBER OF NEW POSTS	SQUARE STEEL (IN) (LB / FT) 1.88	SQUARE STEEL (IN) (LB / FT) 2.42	SQUARE STEEL (IN) (LB / FT) 3.35	TUBULAR STEEL Ø (IN) FOUNDATION	TUBULAR STEEL Ø (IN) (LB / FT) 7.60	TUBULAR STEEL Ø (IN) (LB / FT) 9.00	TUBULAR STEEL Ø (IN) (LB / FT) 10.80	TUBULAR STEEL Ø (IN) (LB / FT) 14.60	SIGN FRAME REQUIRED	REMARKS	SIGN DETAIL: DETAIL IN SHS	SIGN DETAIL: DETAIL ON SHEET NUMBER	SIGN DETAIL: DETAIL ON STD SHEET NUMBER
WINHALL VT-30							FY-FLUORESCENT YELLOW FYG-FLUORESCENT YELLOW GREEN																				"SHS"-STANDARD HIGHWAY SIGNS			
		D	R1-1	30	30		TRUCK LANE ¼ MILE	6.25																		REPLACE SIGN AND RETAIN SIGN POST.	X		
NB	6.735	A	D17-2	42	42			12.25								2		14.25 14.25 X								INSTALL 200 FEET NORTH OF EXISTING RIGHT CURVE SIGN ASSEMBLY		4	
NB	6.773	A	W1-2MR	30	30		MODIFIED RIGHT CURVE						1		X														
		A	W13-1	18	18		35 MPH						1																
		A	N/A				BRIDGE #48 MARKER				1	1	1			1	X	6.00 X								REINSTALL BRIDGE PLAQUE ON NEW POST. INSTALL AT 4 FT. ABOVE ROADWAY.			
NB	6.875	A	R4-6	24	30		TRUCK LANE 500 FEET						1		X														
NB	6.890	A	W1-10R	36	36		40 M.P.H.	9.00								2		15.0 15.75 X								INSTALL 650 FEET NORTH OF EXISTING RH CURVE ASSEMBLY - SOUTH OF POLE #30S.	X		
		A	W13-1	18	18			2.25																			X		
NB	6.985	A	R4-3	24	30		SLOWER TRAFFIC KEEP RIGHT						1		X														
		A	R4-3	24	30			5.00								1		13.25 X									X		
NB	7.143	A	W9-1	36	36		RIGHT LANE ENDS	9.00								2		14.5 15.0 X								INSTALL 300 FEET SOUTH OF LANE REDUCTION SYMBOL SIGN.	X		
NB	7.193	A	W4-2R	36	36								1		X														
		A	W4-2R	36	36			9.00								2 ~~1~~		14.75 15.0 X								PLACED ON TWO POSTS	X		
NB	7.377	A	W2-4	30	30		T 1500 FEET						1																
		A	W16-2	24	18								1																
							SHEET TOTALS	52.75	0.00	0	1	1	~~8~~ 7	0	0	~~10~~ 9		~~135~~ 137.75											
								SF	SF	EA	EA	EA	EA	EA	EA	EA		FT											
							TOWN DIRECTIONAL TOTALS	456.7	0.0	5.0	3.0	3.0	79	0.0	0.0	51		765.0											


SIGN SUMMARY SHEET

VERMONT AGENCY OF TRANSPORTATION

PROJECT NAME: STATEWIDE - SOUTHWEST REGION
PROJECT NUMBER: STPG SIGN(32)

FILE NAME: WINHALL NB.XLS
PROJECT MANAGER: A. GAMBLE
DESIGNED BY: J. KELLY
WINHALL NORTHBOUND SHEET 9

PLOT DATE: 8/26/2010
DRAWN BY: J. KELLY
CHECKED BY: A. GAMBLE

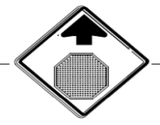DIRECTION	MILEPOINT	LOCATION CODE (SHEET 2)	SIGN CODE	WIDTH (IN)	HEIGHT (IN)	SHEETING REMARKS	SIGN LEGEND	NEW SIGNS "A"	NEW SIGNS "B"	EXISTING SIGNS RETAIN	EXISTING SIGNS SALVAGE FROM	EXISTING SIGNS SALVAGE TO	EXISTING SIGNS REMOVE	EXIST POST RETAIN	EXIST POST REMOVE	NUMBER OF NEW POSTS	SQUARE STEEL (IN) (LB / FT) 1.75 / 1.88	SQUARE STEEL (IN) (LB / FT) 2.00 / 2.42	SQUARE STEEL (IN) (LB / FT) 2.50 / 3.35	TUBULAR STEEL Ø (IN) FOUNDATION	TUBULAR STEEL Ø (IN) (LB / FT) 3.00 / 7.60	TUBULAR STEEL Ø (IN) (LB / FT) 3.50 / 9.00	TUBULAR STEEL Ø (IN) (LB / FT) 4.00 / 10.80	TUBULAR STEEL Ø (IN) (LB / FT) 5.00 / 14.60	SIGN FRAME REQUIRED	REMARKS	SIGN DETAIL: DETAIL IN SHS	SIGN DETAIL: DETAIL ON SHEET NUMBER	SIGN DETAIL: DETAIL ON STD SHEET NUMBER
WINHALL VT-30							FY-FLUORESCENT YELLOW FYG-FLUORESCENT YELLOW GREEN																			"SHS"-STANDARD HIGHWAY SIGNS			
		A	W2-4	30	30			6.25																		RETAIN FLASHING BEACON, POST AND WIRING.	X		
		A	W16-2	24	18			3.00																			X		
NB	7.447	A	M2-1	21	15								1	X															
		A	M1-5A	24	24								1																
		A	M2-1	21	15			2.19																		INSTALL GREEN ON WHITE ROUTE MARKERS ON EXISTING POST.			E-136B
		A	M1-5	24	24			4.00																					E-136B
NB	7.520	A	W3-1	36	36								1		X														
		A	W3-1	36	36			9.00								2		I5.5 I5.75 X									X		
NB	7.560	A	D1-1A	72	10								1	X															
		A	D1-1S	72	10								1																
		A	D1-1A	72	10								1																
		A	D1-1A	72	10								1																
		A	D1-1S	72	10								1																
		A	D1-1A	72	12			6.00																		RETAIN EXISTING 3.50" DIAMETER STEEL POSTS. REUSE MOUNTING HARDWARE IF POSSIBLE.		5	
		A	D1-1S	72	12			6.00																				5	
							SHEET TOTALS	36.44	0.00	0	0	0	8	0	0	2		~~30~~ 31.25										
								SF	SF	EA	EA	EA	EA	EA	EA	EA		FT										
							TOWN DIRECTIONAL TOTALS	456.7	0.0	5.0	3.0	3.0	79	0.0	0.0	51		765.0										

SIGN SUMMARY SHEET

VERMONT AGENCY OF TRANSPORTATION

PROJECT NAME: **STATEWIDE - SOUTHWEST REGION**
PROJECT NUMBER: **STPG SIGN(32)**

FILE NAME: **WINHALL NB.XLS** PLOT DATE: **8/26/2010**
PROJECT MANAGER: **A. GAMBLE** DRAWN BY: **J. KELLY**
DESIGNED BY: **J. KELLY** CHECKED BY: **A. GAMBLE**
WINHALL NORTHBOUND SHEET 10 SHEET **36** OF **90**

DIRECTION	MILEPOINT	LOCATION CODE (SHEET 2)	SIGN CODE	WIDTH (IN)	HEIGHT (IN)	SHEETING REMARKS	SIGN LEGEND	NEW SIGNS		EXISTING SIGNS				EXIST POST		NUMBER OF NEW POSTS	SQUARE STEEL (IN)			TUBULAR STEEL Ø (IN)				SIGN FRAME REQUIRED	REMARKS	SIGN DETAIL		
																	1.75	2.00	2.50	3.00	3.50	4.00	5.00					
																	(LB / FT)			(LB / FT)							
								"A"	"B"	RETAIN	SALVAGE FROM	SALVAGE TO	REMOVE	RETAIN	REMOVE		1.88	2.42	3.35	FOUNDATION	7.60	9.00	10.80	14.60			DETAIL IN SHS	DETAIL ON SHEET NUMBER	DETAIL ON STD SHEET NUMBER
WINHALL VT-30							FY-FLUORESCENT YELLOW FYG-FLUORESCENT YELLOW GREEN																		"SHS"-STANDARD HIGHWAY SIGNS			
		A	D1-1A	72	12			6.00																			5	
		A	D1-1A	72	12			6.00																			5	
		A	D1-1S	72	12			6.00																			5	
NB	7.601	A	M3-1	24	12								1	X														
		A	M1-5A	24	24								1															
		A	M6-1	21	15								1															
		A	M3-4	24	12								1															
		A	M1-5A	24	24								1															
		A	M6-1	21	15								1															
		A	M3-2	24	12								1															
		A	M1-5A	24	24								1															
		A	M6-1	21	15								1															
		A	M3-4	24	12			2.00																	#3	GREEN ON WHITE ROUTE MARKERS.	7	E-136B
		A	M1-5	24	24			4.00																				E-136B
		A	M6-1	21	15			2.19																				E-136B
SIGN SUMMARY SHEET							SHEET TOTALS	26.19	0.00	0	0	0	9	0	0	0	0											
								SF	SF	EA	EA	EA	EA	EA	EA	EA	FT											
VERMONT AGENCY OF TRANSPORTATION							TOWN DIRECTIONAL TOTALS	456.7	0.0	5.0	3.0	3.0	79	0.0	0.0	51	765.0											

PROJECT NAME: **STATEWIDE - SOUTHWEST REGION**
PROJECT NUMBER: **STPG SIGN(32)**

FILE NAME: **WINHALL NB.XLS** PLOT DATE: **8/26/2010**
PROJECT MANAGER: **A. GAMBLE** DRAWN BY: **J. KELLY**
DESIGNED BY: **J. KELLY** CHECKED BY: **A. GAMBLE**
WINHALL NORTHBOUND SHEET 11 SHEET **37** OF **90**


DIRECTION	MILEPOINT	LOCATION CODE (SHEET 2)	SIGN CODE	WIDTH (IN)	HEIGHT (IN)	SHEETING REMARKS	SIGN LEGEND	NEW SIGNS "A"	NEW SIGNS "B"	EXISTING SIGNS RETAIN	EXISTING SIGNS SALVAGE FROM	EXISTING SIGNS SALVAGE TO	EXISTING SIGNS REMOVE	EXIST POST RETAIN	EXIST POST REMOVE	NUMBER OF NEW POSTS	SQUARE STEEL (IN) 1.75 (LB / FT) 1.88	SQUARE STEEL (IN) 2.00 (LB / FT) 2.42	SQUARE STEEL (IN) 2.50 (LB / FT) 3.35	TUBULAR STEEL Ø (IN) FOUNDATION	TUBULAR STEEL Ø (IN) 3.00 (LB / FT) 7.60	TUBULAR STEEL Ø (IN) 3.50 (LB / FT) 9.00	TUBULAR STEEL Ø (IN) 4.00 (LB / FT) 10.80	TUBULAR STEEL Ø (IN) 5.00 (LB / FT) 14.60	SIGN FRAME REQUIRED	REMARKS	SIGN DETAIL: DETAIL IN SHS	SIGN DETAIL: DETAIL ON SHEET NUMBER	SIGN DETAIL: DETAIL ON STD SHEET NUMBER
WINHALL VT-30							FY-FLUORESCENT YELLOW FYG-FLUORESCENT YELLOW GREEN																			"SHS"-STANDARD HIGHWAY SIGNS			
		A	M4-5	24	12			2.00																				E-136B
		A	M3-1	24	12			2.00																			E-136B
		A	M1-5	24	24			4.00																				E-136B
		A	M6-1	21	15			2.19																				E-136B
		A	M3-2	24	12			2.00																				E-136B
		A	M1-5	24	24			4.00																				E-136B
		A	M6-1	21	15			2.19																				E-136B
NB	7.650	A	R1-1	36	36								1		X												INTERSECTION WITH VT-11			
		A	R1-1	36	36			9.00								2		13.25 13.25 X								X			
NB	5.305	A	S3-1	30	30		SBSA						1	1															
NB	5.305	A		36	36		SBSA SYMBOLS	9.00																			REF SHEET 33 OF 90 FOR ADDITIONAL INFO			
NB	5.800	A	S3-1	30	30		SBSA						1	1															
NB	5.800	A		36	36		SBSA SYMBOLS	9.00																			REF SHEET 34 OF 90 FOR ADDITIONAL INFO			
							SHEET TOTALS	45.38 ~~27.38~~	0.00	0	0	0	3 ~~1~~	0	0	2		~~30~~ 26.5								
								SF	SF	EA	EA	EA	EA	EA	EA	EA		FT											
							TOWN DIRECTIONAL TOTALS	477.7 ~~456.7~~	0.0	5.0	~~2.0~~ ~~3.0~~	~~2.0~~ ~~3.0~~	~~86~~ ~~79~~	0.0	0.0	~~53~~ ~~51~~		760.75 ~~765.0~~											

SIGN SUMMARY SHEET

VERMONT AGENCY OF TRANSPORTATION

PROJECT NAME: **STATEWIDE - SOUTHWEST REGION**
PROJECT NUMBER: **STPG SIGN(32)**

FILE NAME: **WINHALL NB.XLS** PLOT DATE: **8/26/2010**
PROJECT MANAGER: **A. GAMBLE** DRAWN BY: **J. KELLY**
DESIGNED BY: **J. KELLY** CHECKED BY: **A. GAMBLE**
WINHALL NORTHBOUND SHEET 12 SHEET **38** OF **90**


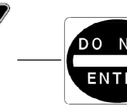
DIRECTION	MILEPOINT	LOCATION CODE (SHEET 2)	SIGN CODE	WIDTH (IN)	HEIGHT (IN)	SHEETING REMARKS	SIGN LEGEND	NEW SIGNS "A"	NEW SIGNS "B"	EXISTING SIGNS RETAIN	EXISTING SIGNS SALVAGE FROM	EXISTING SIGNS SALVAGE TO	EXISTING SIGNS REMOVE	EXIST POST RETAIN	EXIST POST REMOVE	NUMBER OF NEW POSTS	SQUARE STEEL (IN) (LB / FT) 1.75 / 1.88	SQUARE STEEL (IN) (LB / FT) 2.00 / 2.42	SQUARE STEEL (IN) (LB / FT) 2.50 / 3.35	TUBULAR STEEL Ø (IN) FOUNDATION	TUBULAR STEEL Ø (IN) (LB / FT) 3.00 / 7.60	TUBULAR STEEL Ø (IN) (LB / FT) 3.50 / 9.00	TUBULAR STEEL Ø (IN) (LB / FT) 4.00 / 10.80	TUBULAR STEEL Ø (IN) (LB / FT) 5.00 / 14.60	SIGN FRAME REQUIRED	REMARKS	SIGN DETAIL: DETAIL IN SHS	SIGN DETAIL: DETAIL ON SHEET NUMBER	SIGN DETAIL: DETAIL ON STD SHEET NUMBER
WINHALL VT-30							FY-FLUORESCENT YELLOW FYG-FLUORESCENT YELLOW GREEN																			"SHS"-STANDARD HIGHWAY SIGNS			
SB	7.650	E	R1-1	36	36								1		X											INTERSECTION WITH VT-11			
		E	R1-1	36	36			9.00								2		13.25 13.25 X									X		
SB	7.637	K	R1-2	30	30								1		X											SIGNS ARE ON SOUTH BOUND SLIP-RAMP			
		J	R5-1	30	30								1															
		L	R6-1L	36	12								1															
		L	R6-1R	36	12								1															
		K	R1-2	36	36			3.89								1		13.25 X									X		
		J	R5-1	30	30			6.25																			X		
		L	R6-1L	36	12			3.00																			X		
		L	R6-1R	36	12			3.00																			X		
SB	7.634	F	R1-2	30	30								1													SIGNS ARE ON SOUTH BOUND SLIP-RAMP			
		E	R5-1	30	30								1															
		G	R6-1L	36	12								1															
		F	R1-2	36	36			3.89								1		13.25 X									X		
		E	R5-1	30	30			6.25																			X		
							SHEET TOTALS	35.28	0.00	0	0	0	8	0	0	4		~~60~~ 53											
								SF	SF	EA	EA	EA	EA	EA	EA	EA		FT											
							TOWN DIRECTIONAL TOTALS	457.6	0.0	6.0	0.0	0.0	81	0.0	0.0	65		975.0											

SIGN SUMMARY SHEET

VERMONT AGENCY OF TRANSPORTATION

PROJECT NAME: **STATEWIDE - SOUTHWEST REGION**
PROJECT NUMBER: **STPG SIGN(32)**

FILE NAME: **WINHALL SB.XLS** PLOT DATE: **7/13/2010**
PROJECT MANAGER: **A. GAMBLE** DRAWN BY: **J. KELLY**
DESIGNED BY: **J. KELLY** CHECKED BY: **A. GAMBLE**
WINHALL SOUTHBOUND SHEET 1 SHEET **39** OF **90**

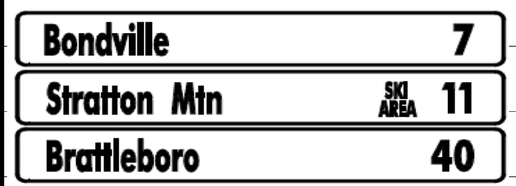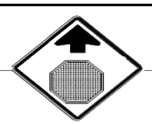
DIRECTION	MILEPOINT	LOCATION CODE (SHEET 2)	SIGN CODE	WIDTH (IN)	HEIGHT (IN)	SHEETING REMARKS	SIGN LEGEND	NEW SIGNS "A"	NEW SIGNS "B"	EXISTING SIGNS RETAIN	EXISTING SIGNS SALVAGE FROM	EXISTING SIGNS SALVAGE TO	EXISTING SIGNS REMOVE	EXIST POST RETAIN	EXIST POST REMOVE	NUMBER OF NEW POSTS	SQUARE STEEL (IN) 1.75 (LB / FT) 1.88	SQUARE STEEL (IN) 2.00 (LB / FT) 2.42	SQUARE STEEL (IN) 2.50 (LB / FT) 3.35	TUBULAR STEEL Ø (IN) FOUNDATION	TUBULAR STEEL Ø (IN) 3.00 (LB / FT) 7.60	TUBULAR STEEL Ø (IN) 3.50 (LB / FT) 9.00	TUBULAR STEEL Ø (IN) 4.00 (LB / FT) 10.80	TUBULAR STEEL Ø (IN) 5.00 (LB / FT) 14.60	SIGN FRAME REQUIRED	REMARKS	SIGN DETAIL: DETAIL IN SHS	SIGN DETAIL: DETAIL ON SHEET NUMBER	SIGN DETAIL: DETAIL ON STD SHEET NUMBER
WINHALL VT-30							FY-FLUORESCENT YELLOW FYG-FLUORESCENT YELLOW GREEN																				"SHS"-STANDARD HIGHWAY SIGNS			
		G	R6-1L	36	12			3.00																				X		
SB	7.595	F	VR-041	24	24		THROUGH WAY BEGINS HERE						1		X															
		F	R2-1	24	30								1																	
		F	R2-1	24	30			5.00								1		13.25 X										X		
		E	VR-040	24	24		THROUGH WAY ENDS HERE						1																	
SB	7.555	F	D2-1	72	10								1		X															
		F	D2-1S	72	10								1																	
		F	D2-1	72	10								1																	
		F	D2-1	72	12			6.00								2		16.75 18.75 X										5		
		F	D2-1S	72	12			6.00																				5		
		F	D2-1	72	12			6.00																				5		
		F	M3-3	24	12			2.00																			INSTALL GREEN ON WHITE ROUTE MARKERS ON LH POST			E-136B
		F	M1-5	24	24			4.00																						E-136B
SB	7.513	E	W3-1	36	36								1		X															
		E	W3-1	36	36			9.00								2		15.25 16.75 X										X		
							SHEET TOTALS	41.00	0.00	0	0	0	7	0	0	5		~~75~~ 80.75												
								SF	SF	EA	EA	EA	EA	EA	EA	EA		FT												
							TOWN DIRECTIONAL TOTALS	457.6	0.0	6.0	0.0	0.0	81	0.0	0.0	65		975.0												

SIGN SUMMARY SHEET

VERMONT AGENCY OF TRANSPORTATION

PROJECT NAME: **STATEWIDE - SOUTHWEST REGION**
PROJECT NUMBER: **STPG SIGN(32)**

FILE NAME: **WINHALL SB.XLS** PLOT DATE: **7/13/2010**
PROJECT MANAGER: **A. GAMBLE** DRAWN BY: **J. KELLY**
DESIGNED BY: **J. KELLY** CHECKED BY: **A. GAMBLE**
WINHALL SOUTHBOUND SHEET 2 SHEET **40** OF **90**

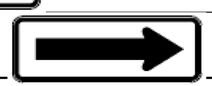DIRECTION	MILEPOINT	LOCATION CODE (SHEET 2)	SIGN CODE	WIDTH (IN)	HEIGHT (IN)	SHEETING REMARKS	SIGN LEGEND	NEW SIGNS "A"	NEW SIGNS "B"	EXISTING SIGNS RETAIN	EXISTING SIGNS SALVAGE FROM	EXISTING SIGNS SALVAGE TO	EXISTING SIGNS REMOVE	EXIST POST RETAIN	EXIST POST REMOVE	NUMBER OF NEW POSTS	SQUARE STEEL (IN) 1.75 (LB / FT) 1.88	SQUARE STEEL (IN) 2.00 (LB / FT) 2.42	SQUARE STEEL (IN) 2.50 (LB / FT) 3.35	TUBULAR STEEL Ø (IN) FOUNDATION	TUBULAR STEEL Ø (IN) 3.00 (LB / FT) 7.60	TUBULAR STEEL Ø (IN) 3.50 (LB / FT) 9.00	TUBULAR STEEL Ø (IN) 4.00 (LB / FT) 10.80	TUBULAR STEEL Ø (IN) 5.00 (LB / FT) 14.60	SIGN FRAME REQUIRED	REMARKS	SIGN DETAIL: DETAIL IN SHS	SIGN DETAIL: DETAIL ON SHEET NUMBER	SIGN DETAIL: DETAIL ON STD SHEET NUMBER
WINHALL VT-30							FY-FLUORESCENT YELLOW FYG-FLUORESCENT YELLOW GREEN																			"SHS"-STANDARD HIGHWAY SIGNS			
SB	7.465	F	M3-3	24	12		SOUTH						1		X														
		F	M1-5A	24	24		ROUTE 30						1																
SB	7.260	F	W7-1B	30	30			6.25								1		14.75 X								INSTALL AT TOP OF HILL ACROSS FROM DRIVEWAY.	X		
SB	7.140	F	W1-2ML	30	30		MODIFIED LEFT CURVE						1		X														
SB	7.074	A	W1-10L	36	36			9.00								2		15.0 15.75 X								INSTALL 350 FEET SOUTH OF EXISTING LH CURVE ASSEMBLY.	X		
		A	W13-1	18	18			2.25																			X		
SB	7.052	F	W1-8	18	24		CHEVRON						1		X														
		E	W1-8	18	24		CHEVRON						1																
SB	7.040	E	W1-6	48	24			8.00								2		13.0 13.0 X								INSTALL AT NORTH END OF GUARD RAIL SECTION	X		
SB	7.020	F	W1-8	18	24		CHEVRON						1		X														
		E	W1-8	18	24		CHEVRON						1																
SB	6.980	F	W1-6	48	24			8.00								2		13.25 14.5 X								INSTALL SIGNS AT NORTH SIDE OF TOWN HIGHWAY AND AIM EACH ASSEMBLY TOWARDS ON-COMING TRAFFIC.	X		
		E	W1-6	48	24			8.00								2		13.25 14.0 X									X		
SB	6.978	G	VR-017	24	30			5.00								1		13.25 X										4	
SB	6.937	H	R1-1	30	30								1		X												SNOW VALLEY RD. (TH-16)			
							SHEET TOTALS	46.50	0.00	0	0	0	8	0	0	10		~~150~~ 139.75											
								SF	SF	EA	EA	EA	EA	EA	EA	EA		FT											
							TOWN DIRECTIONAL TOTALS	457.6	0.0	6.0	0.0	0.0	81	0.0	0.0	65		975.0											

SIGN SUMMARY SHEET

VERMONT AGENCY OF TRANSPORTATION

PROJECT NAME: **STATEWIDE - SOUTHWEST REGION**
PROJECT NUMBER: **STPG SIGN(32)**

FILE NAME: **WINHALL SB.XLS** PLOT DATE: **7/13/2010**
PROJECT MANAGER: **A. GAMBLE** DRAWN BY: **J. KELLY**
DESIGNED BY: **J. KELLY** CHECKED BY: **A. GAMBLE**
WINHALL SOUTHBOUND SHEET 3 SHEET **41** OF **90**

DIRECTION	MILEPOINT	LOCATION CODE (SHEET 2)	SIGN CODE	WIDTH (IN)	HEIGHT (IN)	SHEETING REMARKS	SIGN LEGEND	NEW SIGNS "A"	NEW SIGNS "B"	EXISTING SIGNS RETAIN	EXISTING SIGNS SALVAGE FROM	EXISTING SIGNS SALVAGE TO	EXISTING SIGNS REMOVE	EXIST POST RETAIN	EXIST POST REMOVE	NUMBER OF NEW POSTS	SQUARE STEEL (IN) 1.75 (LB/FT) 1.88	SQUARE STEEL (IN) 2.00 (LB/FT) 2.42	SQUARE STEEL (IN) 2.50 (LB/FT) 3.35	TUBULAR STEEL Ø (IN) FOUNDATION	TUBULAR STEEL Ø (IN) 3.00 (LB/FT) 7.60	TUBULAR STEEL Ø (IN) 3.50 (LB/FT) 9.00	TUBULAR STEEL Ø (IN) 4.00 (LB/FT) 10.80	TUBULAR STEEL Ø (IN) 5.00 (LB/FT) 14.60	SIGN FRAME REQUIRED	REMARKS	SIGN DETAIL: DETAIL IN SHS	SIGN DETAIL: DETAIL ON SHEET NUMBER	SIGN DETAIL: DETAIL ON STD SHEET NUMBER
WINHALL VT-30							FY-FLUORESCENT YELLOW FYG-FLUORESCENT YELLOW GREEN																			"SHS"-STANDARD HIGHWAY SIGNS			
		H	R1-1	30	30			6.25								1		~~13.25~~ X									X		
SB	6.932	F	W1-6	48	24			8.00								2		~~12.75~~ ~~12.75~~ X								INSTALL 25 FEET SOUTH OF STOP SIGN.	X		
SB	6.930	F	W1-8	18	24		CHEVRON						1		X														
		E	W1-8	18	24		CHEVRON						1																
SB	6.907	F	W1-8	18	24		CHEVRON						1		X														
SB	6.857	G	VR-017	24	30								1		X															
		G	VR-017	24	30			5.00								1		~~13.25~~ X								WINHALL WOOD RD. (TH-30)		4	
SB	6.786	H	R1-1	30	30								1		X															
		H	R1-1	30	30			6.25								1		~~13.75~~ X								WINHALL WOOD RD. (TH-30)	X		
SB	6.800	F	VW-000	30	30		MOOSE CROSSING						1		X														
		F	W7-3A	24	18		NEXT 5 MILES						1																
SB	6.772	F	VW-000	30	30			6.25								1		~~15.0~~ X								INSTALL ASSEMBLY 150 FEET SOUTH OF CURRENT LOCATION - NORTH SIDE OF BR #48.		6	
		F	W7-3A	24	18			3.00																			X		
SB	6.640	G	VR-017	24	30								1		X												SIGNAL HILL RD. (TH-40)			
		G	VR-017	24	30			5.00								1		~~13.25~~ X										4	
SIGN SUMMARY SHEET							SHEET TOTALS	39.75	0.00	0	0	0	8	0	0	7		~~105~~ 94											
								SF	SF	EA	EA	EA	EA	EA	EA	EA		FT											
VERMONT AGENCY OF TRANSPORTATION							TOWN DIRECTIONAL TOTALS	457.6	0.0	6.0	0.0	0.0	81	0.0	0.0	65		975.0											

PROJECT NAME: **STATEWIDE - SOUTHWEST REGION**
PROJECT NUMBER: **STPG SIGN(32)**
FILE NAME: **WINHALL SB.XLS** PLOT DATE: **7/13/2010**
PROJECT MANAGER: **A. GAMBLE** DRAWN BY: **J. KELLY**
DESIGNED BY: **J. KELLY** CHECKED BY: **A. GAMBLE**
WINHALL SOUTHBOUND SHEET 4 SHEET **42** OF **90**

DIRECTION	MILEPOINT	LOCATION CODE (SHEET 2)	SIGN CODE	WIDTH (IN)	HEIGHT (IN)	SHEETING REMARKS	SIGN LEGEND	NEW SIGNS "A"	NEW SIGNS "B"	EXISTING SIGNS RETAIN	EXISTING SIGNS SALVAGE FROM	EXISTING SIGNS SALVAGE TO	EXISTING SIGNS REMOVE	EXIST POST RETAIN	EXIST POST REMOVE	NUMBER OF NEW POSTS	SQUARE STEEL (IN) 1.75 (LB/FT) 1.88	SQUARE STEEL (IN) 2.00 (LB/FT) 2.42	SQUARE STEEL (IN) 2.50 (LB/FT) 3.35	TUBULAR STEEL Ø (IN) FOUNDATION	TUBULAR STEEL Ø (IN) 3.00 (LB/FT) 7.60	TUBULAR STEEL Ø (IN) 3.50 (LB/FT) 9.00	TUBULAR STEEL Ø (IN) 4.00 (LB/FT) 10.80	TUBULAR STEEL Ø (IN) 5.00 (LB/FT) 14.60	SIGN FRAME REQUIRED	REMARKS	SIGN DETAIL: DETAIL IN SHS	SIGN DETAIL: DETAIL ON SHEET NUMBER	SIGN DETAIL: DETAIL ON STD SHEET NUMBER
WINHALL VT-30							FY-FLUORESCENT YELLOW FYG-FLUORESCENT YELLOW GREEN																				"SHS"-STANDARD HIGHWAY SIGNS			
SB	6.630	H	R1-1	30	30								1		X												SIGNAL HILL RD. (TH-40)			
		H	R1-1	30	30			6.25								1		13.25 X									REMOVE 0665 MILE POINT SIGN.	X		
SB	6.091	F	S3-1	30	30		SCHOOL BUS STOP AHEAD						1		X														
SB	6.039	F	W2-2L	30	30		LEFT SIDE ROAD						1		X														
SB	6.018	F	S3-1	36	36	FYG		9.00								2		15.0 14.5 X								INSTALL 375 FEET SOUTH OF EXISTING SCHOOL BUS STOP AHEAD SIGN ASSEMBLY.	X		
SB	5.980	F	W2-2LM	30	30			6.25								1		15.5 X								INSTALL 300 FEET SOUTH OF EXISTING SIDE ROAD WARNING SIGN ASSEMBLY.		4	
SB	5.691	F	S3-1	30	30		SCHOOL BUS STOP AHEAD						1		X														
SB	5.542	G	VR-017	24	30								1		X												HIGHWOOD RD. (TH-10)			
		G	VR-017	24	30			5.00								1		13.25 X										4	
SB	5.536	H	R1-1	30	30								1		X												HIGHWOOD RD. (TH-10)			
		H	R1-1	30	30			6.25								1		13.25 X										X	
SB	5.205	G	W2-2R	30	30		RIGHT SIDE ROAD						1		X														
SB	5.140	G	W2-2RM	30	30			6.25								1		14.0 X								INSTALL 350 FEET SOUTH OF EXISTING SIDE ROAD SIGN ASSEMBLY.		4	
SB	5.059	G	VR-017	24	30								1	X													CAPEN RD. (TH-24)			
		G	VR-017	24	30			5.00																			REPLACE SIGN AND RETAIN SIGN POST.		4	
							SHEET TOTALS	44.00	0.00	0	0	0	8	0	0	7		~~105~~ 98.75										
								SF	SF	EA	EA	EA	EA	EA	EA	EA		FT										
							TOWN DIRECTIONAL TOTALS	457.6	0.0	6.0	0.0	0.0	81	0.0	0.0	65		975.0										

SIGN SUMMARY SHEET

VERMONT AGENCY OF TRANSPORTATION

PROJECT NAME: **STATEWIDE - SOUTHWEST REGION**
PROJECT NUMBER: **STPG SIGN(32)**

FILE NAME: **WINHALL SB.XLS**
PROJECT MANAGER: **A. GAMBLE**
DESIGNED BY: **J. KELLY**
WINHALL SOUTHBOUND SHEET 5

PLOT DATE: **7/13/2010**
DRAWN BY: **J. KELLY**
CHECKED BY: **A. GAMBLE**

DIRECTION	MILEPOINT	LOCATION CODE (SHEET 2)	SIGN CODE	WIDTH (IN)	HEIGHT (IN)	SHEETING REMARKS	SIGN LEGEND	NEW SIGNS "A"	NEW SIGNS "B"	EXISTING SIGNS RETAIN	EXISTING SIGNS SALVAGE FROM	EXISTING SIGNS SALVAGE TO	EXISTING SIGNS REMOVE	EXIST POST RETAIN	EXIST POST REMOVE	NUMBER OF NEW POSTS	SQUARE STEEL (IN) (LB / FT) 1.75 / 1.88	SQUARE STEEL (IN) (LB / FT) 2.00 / 2.42	SQUARE STEEL (IN) (LB / FT) 2.50 / 3.35	TUBULAR STEEL Ø (IN) FOUNDATION	TUBULAR STEEL Ø (IN) (LB / FT) 3.00 / 7.60	TUBULAR STEEL Ø (IN) (LB / FT) 3.50 / 9.00	TUBULAR STEEL Ø (IN) (LB / FT) 4.00 / 10.80	TUBULAR STEEL Ø (IN) (LB / FT) 5.00 / 14.60	SIGN FRAME REQUIRED	REMARKS	SIGN DETAIL: DETAIL IN SHS	SIGN DETAIL: DETAIL ON SHEET NUMBER	SIGN DETAIL: DETAIL ON STD SHEET NUMBER
WINHALL VT-30							FY-FLUORESCENT YELLOW FYG-FLUORESCENT YELLOW GREEN																				"SHS"-STANDARD HIGHWAY SIGNS			
SB	5.051	H	R1-1	30	30								1		X												CAPEN RD. (TH-24)			
		H	R1-1	30	30			6.25								1		13.25 X									X		
SB	4.769	G	VR-017	24	30								1	X													CAPEN RD. (TH-24)			
		G	VR-017	24	30			5.00																			REPLACE SIGN AND RETAIN SIGN POST.		4	
SB	4.758	H	R1-1	30	30								1		X															
		H	R1-1	30	30			6.25								1		13.25 X									CAPEN RD. (TH-24)	X		
SB	4.353	F	W1-2R	30	30		RIGHT CURVE 						1		X															
SB	4.282	F	W1-2R	30	30			6.25								1		14.0 X									INSTALL 375 FEET SOUTH OF EXISTING SIGN AND ACROSS FROM BEAVER ST. (TH-55).	X		
SB	4.007	F	W7-1B	30	30								1	X																
		F	W7-1B	30	30			6.25																			REPLACE SIGN AND RETAIN SIGN POST.	X		
		F	W7-3A	24	18			3.00																						
SB	3.955	F	W1-5L	30	30								1	X																
		F	W1-5L	30	30			6.25																			REPLACE SIGN AND RETAIN SIGN POST.	X		
		F	W7-3A	24	18			3.00																						
SB	3.905	F	W1-2L	30	30																						INSTALL BEHIND NORTH END OF RAIL AND SOUTH OF COREY RD.			
								6.25								1		14.0 X										X		
							SHEET TOTALS	48.50 SF	0.00 SF	0 EA	0 EA	0 EA	6 EA	0 EA	0 EA	4 EA		~~60~~ 54.5 FT												
							TOWN DIRECTIONAL TOTALS	457.6	0.0	6.0	0.0	0.0	81	0.0	0.0	65		975.0												


SIGN SUMMARY SHEET

VERMONT AGENCY OF TRANSPORTATION

PROJECT NAME: **STATEWIDE - SOUTHWEST REGION**
PROJECT NUMBER: **STPG SIGN(32)**

FILE NAME: **WINHALL SB.XLS**
PROJECT MANAGER: **A. GAMBLE**
DESIGNED BY: **J. KELLY**
WINHALL SOUTHBOUND SHEET 6

PLOT DATE: **7/13/2010**
DRAWN BY: **J. KELLY**
CHECKED BY: **A. GAMBLE**
SHEET **44** OF **90**

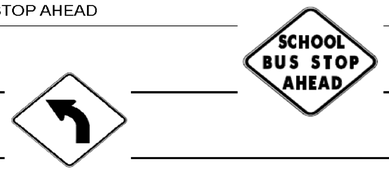
DIRECTION	MILEPOINT	LOCATION CODE (SHEET 2)	SIGN CODE	WIDTH (IN)	HEIGHT (IN)	SHEETING REMARKS	SIGN LEGEND	NEW SIGNS "A"	NEW SIGNS "B"	EXISTING SIGNS RETAIN	EXISTING SIGNS SALVAGE FROM	EXISTING SIGNS SALVAGE TO	EXISTING SIGNS REMOVE	EXIST POST RETAIN	EXIST POST REMOVE	NUMBER OF NEW POSTS	SQUARE STEEL (IN) 1.75 (LB/FT) 1.88	SQUARE STEEL (IN) 2.00 (LB/FT) 2.42	SQUARE STEEL (IN) 2.50 (LB/FT) 3.35	TUBULAR STEEL Ø (IN) FOUNDATION	TUBULAR STEEL Ø (IN) 3.00 (LB/FT) 7.60	TUBULAR STEEL Ø (IN) 3.50 (LB/FT) 9.00	TUBULAR STEEL Ø (IN) 4.00 (LB/FT) 10.80	TUBULAR STEEL Ø (IN) 5.00 (LB/FT) 14.60	SIGN FRAME REQUIRED	REMARKS	SIGN DETAIL: DETAIL IN SHS	SIGN DETAIL: DETAIL ON SHEET NUMBER	SIGN DETAIL: DETAIL ON STD SHEET NUMBER
WINHALL VT-30							FY-FLUORESCENT YELLOW FYG-FLUORESCENT YELLOW GREEN																				"SHS"-STANDARD HIGHWAY SIGNS			
SB	3.454	F	VW-054R	30	30		HIDDEN DRIVE RIGHT						1		X														
		F	S3-1	30	30		SCHOOL BUS STOP AHEAD						1																
		F	S3-1	36	36	FYG		9.00								2		14.25 15.75 X									X		
SB	3.416	F	W1-2L	30	30			6.25								1		14.5 X								INSTALL 200 FEET SOUTH OF EXISTING HIDDEN DRIVE RIGHT SIGN ASSEMBLY.	X		
SB	3.398	F	W1-8	18	24		CHEVRON						1		X														
SB	3.385	F	W1-6	48	24			8.00								2		13.0 13.0 X								INSTALL 75 FEET SOUTH OF THE NORTHERN MOST CHEVRON.	X		
SB	3.341	F	W1-8	18	24		CHEVRON						1		X														
SB	1.610	G	VR-017	24	30								1	X													KENDALL FARM RD. (TH-15)			
		G	VR-017	24	30			5.00																		REPLACE SIGN AND RETAIN SIGN POST.		4	
SB	1.589	H	R1-1	30	30								1	X													KENDALL FARM RD.(TH-15)			
		H	R1-1	30	30			6.25																		REPLACE SIGN AND RETAIN SIGN POST.	X		
SB	1.584	G	VR-017	24	30								1		X												LOWER TAYLOR RD. (TH-3)			
		G	VR-017	24	30			5.00								1		13.25 X								INSTALL AT 20 FEET FROM VT-30 PER STANDARD		4	
SB	1.575	H	R1-1	30	30								1	X													LOWER TAYLOR RD. (TH-3)			
		H	R1-1	30	30			6.25																		REPLACE SIGN AND RETAIN SIGN POST.	X		
							SHEET TOTALS	45.75	0.00	0	0	0	8	0	0	6		~~90~~ 83.75											
								SF	SF	EA	EA	EA	EA	EA	EA	EA		FT											
							TOWN DIRECTIONAL TOTALS	457.6	0.0	6.0	0.0	0.0	81	0.0	0.0	65		975.0											

SIGN SUMMARY SHEET

VERMONT AGENCY OF TRANSPORTATION

PROJECT NAME: **STATEWIDE - SOUTHWEST REGION**
PROJECT NUMBER: **STPG SIGN(32)**

FILE NAME: **WINHALL SB.XLS** PLOT DATE: **7/13/2010**
PROJECT MANAGER: **A. GAMBLE** DRAWN BY: **J. KELLY**
DESIGNED BY: **J. KELLY** CHECKED BY: **A. GAMBLE**
WINHALL SOUTHBOUND SHEET 7 SHEET **45** OF **90**

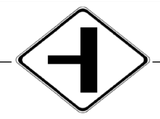DIRECTION	MILEPOINT	LOCATION CODE (SHEET 2)	SIGN CODE	WIDTH (IN)	HEIGHT (IN)	SHEETING REMARKS	SIGN LEGEND	NEW SIGNS "A"	NEW SIGNS "B"	EXISTING SIGNS RETAIN	EXISTING SIGNS SALVAGE FROM	EXISTING SIGNS SALVAGE TO	EXISTING SIGNS REMOVE	EXIST POST RETAIN	EXIST POST REMOVE	NUMBER OF NEW POSTS	SQUARE STEEL (IN) (LB / FT) 1.75 / 1.88	SQUARE STEEL (IN) (LB / FT) 2.00 / 2.42	SQUARE STEEL (IN) (LB / FT) 2.50 / 3.35	TUBULAR STEEL Ø (IN) FOUNDATION	TUBULAR STEEL Ø (IN) (LB / FT) 3.00 / 7.60	TUBULAR STEEL Ø (IN) (LB / FT) 3.50 / 9.00	TUBULAR STEEL Ø (IN) (LB / FT) 4.00 / 10.80	TUBULAR STEEL Ø (IN) (LB / FT) 5.00 / 14.60	SIGN FRAME REQUIRED	REMARKS	SIGN DETAIL: DETAIL IN SHS	SIGN DETAIL: DETAIL ON SHEET NUMBER	SIGN DETAIL: DETAIL ON STD SHEET NUMBER
WINHALL VT-30							FY-FLUORESCENT YELLOW FYG-FLUORESCENT YELLOW GREEN																			"SHS"-STANDARD HIGHWAY SIGNS			
SB	1.540	F	R2-5A	24	30		REDUCED SPEED AHEAD 						1		X														
SB	1.500	F	W3-5	36	36			9.00								2		15.0 15.75 X									INSTALL 200 FEET SOUTH OF EXISTING REDUCED SPEED AHEAD ASSEMBLY.	X		
SB	1.400	F	R2-1	24	30								1		X															
		F	R2-1	30	36			7.50								1		15.75 X											4	
SB	1.350	F	W2-2L	30	30								1		X														
		F	W2-2LM	30	30			6.25								1		14.25 X											6	
SB	1.243	F	S1-1	36	36								1		X														
		F	W16-9FYG	24	10								1																
		F	S1-1	36	36	FYG		9.00								2		13.75 13.75 X										X		
		F	S4-3P	24	8	FYG		1.33																				X		
SB	1.190	F	D1-1E	72	20								2 ~~1~~		X															
		F	D1-1E	72	20			10.00								2		12.5 13.75 X									EXISTING SIGN WAS TWO SIGNS PLACED TO MAKE ONE		6	
SB	1.140	F	VW-544	30	30								1		X														
		F	VW-544	30	30			6.25								1		14.0 X											6	
SB	1.000	F	R2-1	24	30								1		X															
							SHEET TOTALS	49.33	0.00	0	0	0	~~9~~ 8	0	0	9		~~135~~ 128.5											
								SF	SF	EA	EA	EA	EA	EA	EA	EA		FT											
							TOWN DIRECTIONAL TOTALS	457.6	0.0	6.0	0.0	0.0	81	0.0	0.0	65		975.0											

SIGN SUMMARY SHEET

VERMONT AGENCY OF TRANSPORTATION


PROJECT NAME: STATEWIDE - SOUTHWEST REGION
PROJECT NUMBER: STPG SIGN(32)

FILE NAME: WINHALL SB.XLS
PROJECT MANAGER: A. GAMBLE
DESIGNED BY: J. KELLY
WINHALL SOUTHBOUND SHEET 8

PLOT DATE: 7/13/2010
DRAWN BY: J. KELLY
CHECKED BY: A. GAMBLE
SHEET 46 OF 90

DIRECTION	MILEPOINT	LOCATION CODE (SHEET 2)	SIGN CODE	WIDTH (IN)	HEIGHT (IN)	SHEETING REMARKS	SIGN LEGEND	NEW SIGNS "A"	NEW SIGNS "B"	EXISTING SIGNS RETAIN	EXISTING SIGNS SALVAGE FROM	EXISTING SIGNS SALVAGE TO	EXISTING SIGNS REMOVE	EXIST POST RETAIN	EXIST POST REMOVE	NUMBER OF NEW POSTS	SQUARE STEEL (IN) 1.75 (LB/FT) 1.88	SQUARE STEEL (IN) 2.00 (LB/FT) 2.42	SQUARE STEEL (IN) 2.50 (LB/FT) 3.35	FOUNDATION	TUBULAR STEEL Ø (IN) 3.00 (LB/FT) 7.60	TUBULAR STEEL Ø (IN) 3.50 (LB/FT) 9.00	TUBULAR STEEL Ø (IN) 4.00 (LB/FT) 10.80	TUBULAR STEEL Ø (IN) 5.00 (LB/FT) 14.60	SIGN FRAME REQUIRED	REMARKS	SIGN DETAIL: DETAIL IN SHS	SIGN DETAIL: DETAIL ON SHEET NUMBER	SIGN DETAIL: DETAIL ON STD SHEET NUMBER
WINHALL VT-30							FY-FLUORESCENT YELLOW FYG-FLUORESCENT YELLOW GREEN																			"SHS"-STANDARD HIGHWAY SIGNS			
		F	R2-1	24	30			5.00								1		13.25 X									X		
SB	0.910	F	VD-062BM	72	16		BUSINESS SIGN			1				X															
SB	0.910	F	VD-062M	72	16		BUSINESS SIGN			1																			
SB	0.910	F	VD-062M	72	16		BUSINESS SIGN			1																			
SB	0.857	F	R2-5A	24	30		REDUCED SPEED AHEAD 						1		X															
		F	W3-5	36	36			9.00								2		14.0 14.5 X									X		
SB	0.810	F	VD-018	30	18								1	X															
		F	VD-018	30	18			3.75																			REPLACE SIGN AND RETAIN SIGN POST.		5	
SB	0.760	F	VD-062AS	72	16		BUSINESS SIGN			1				X															
SB	0.711	F	R2-1	24	30								1		X														
SB	0.700	F	R2-1	30	36			7.50								1		15.0 X									INSTALL DIRECTLY ACROSS FROM NEW NB SPEED LIMIT 40 SIGN.		4	
SB	0.566	F	W11-2YG	30	30								1		X														
		F	W16-9FYG	24	12								1																
		F	W11-2	30	30	FYG		6.25								1		15.0 X									X		
		F	W16-9	24	12	FYG		2.00																			X		
SIGN SUMMARY SHEET							SHEET TOTALS	33.50	0.00	4	0	0	5	0	0	5		~~75~~ 71.75										
								SF	SF	EA	EA	EA	EA	EA	EA	EA		FT										
VERMONT AGENCY OF TRANSPORTATION							TOWN DIRECTIONAL TOTALS	457.6	0.0	6.0	0.0	0.0	81	0.0	0.0	65		975.0										

PROJECT NAME: **STATEWIDE - SOUTHWEST REGION**
PROJECT NUMBER: **STPG SIGN(32)**
FILE NAME: **WINHALL SB.XLS** PLOT DATE: **7/13/2010**
PROJECT MANAGER: **A. GAMBLE** DRAWN BY: **J. KELLY**
DESIGNED BY: **J. KELLY** CHECKED BY: **A. GAMBLE**
WINHALL SOUTHBOUND SHEET 9 SHEET **47** OF **90**

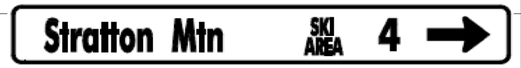DIRECTION	MILEPOINT	LOCATION CODE (SHEET 2)	SIGN CODE	WIDTH (IN)	HEIGHT (IN)	SHEETING REMARKS	SIGN LEGEND	NEW SIGNS "A"	NEW SIGNS "B"	EXISTING SIGNS RETAIN	EXISTING SIGNS SALVAGE FROM	EXISTING SIGNS SALVAGE TO	EXISTING SIGNS REMOVE	EXIST POST RETAIN	EXIST POST REMOVE	NUMBER OF NEW POSTS	SQUARE STEEL (IN) 1.75 (LB / FT) 1.88	SQUARE STEEL (IN) 2.00 (LB / FT) 2.42	SQUARE STEEL (IN) 2.50 (LB / FT) 3.35	TUBULAR STEEL Ø (IN) FOUNDATION	TUBULAR STEEL Ø (IN) 3.00 (LB / FT) 7.60	TUBULAR STEEL Ø (IN) 3.50 (LB / FT) 9.00	TUBULAR STEEL Ø (IN) 4.00 (LB / FT) 10.80	TUBULAR STEEL Ø (IN) 5.00 (LB / FT) 14.60	SIGN FRAME REQUIRED	REMARKS	SIGN DETAIL: DETAIL IN SHS	SIGN DETAIL: DETAIL ON SHEET NUMBER	SIGN DETAIL: DETAIL ON STD SHEET NUMBER
WINHALL VT-30							FY-FLUORESCENT YELLOW FYG-FLUORESCENT YELLOW GREEN																			"SHS"-STANDARD HIGHWAY SIGNS			
SB	0.521	F	R2-1	24	30								1	X														
		F	R2-1	24	30			5.00																		REPLACE SIGN AND RETAIN SIGN POST.	X		
SB	0.480	F	S3-4A	30	30		SCHOOL BUS TURN AROUND			1				X														
SB	0.445	F	W11-2YG	30	30								1		X													
		F	W16-7FYG	24	12								1															
		E	W11-2YG	30	30								1															
		E	W16-7FYG	24	12								1															
		F	W11-2	30	30	FYG		6.25								1		15.0 X								INSTALL SIGNS BACK TO BACK AS EXISTING.	X		
		F	W16-7pL	24	12	FYG		2.00																			X		
		E	W11-2	30	30	FYG		6.25																			X		
		E	W16-7pR	24	12	FYG		2.00																			X		
SB	0.390	F	D1-1S	72	10								1		X														
		F	D1-1S	72	12			6.00								2		12.0 12.25 X									5	
SB	0.373	G	VR-017	24	30								1	X													STRATTON MTN ACCESS RD. (TH-1)			
		G	VR-017	24	30			5.00																		REPLACE SIGN AND RETAIN SIGN POST.		4	
							SHEET TOTALS	32.50	0.00	1	0	0	7	0	0	3													
								SF	SF	EA	EA	EA	EA	EA	EA	EA													
							TOWN DIRECTIONAL TOTALS	457.6	0.0	6.0	0.0	0.0	81	0.0	0.0	65														

DIRECTION	MILEPOINT	LOCATION CODE (SHEET 2)	SIGN CODE	WIDTH (IN)	HEIGHT (IN)	SHEETING REMARKS	SIGN LEGEND	NEW SIGNS "A"	NEW SIGNS "B"	EXISTING SIGNS RETAIN	EXISTING SIGNS SALVAGE FROM	EXISTING SIGNS SALVAGE TO	EXISTING SIGNS REMOVE	EXIST POST RETAIN	EXIST POST REMOVE	NUMBER OF NEW POSTS	SQUARE STEEL (IN) (LB / FT) 1.75 1.88	SQUARE STEEL (IN) (LB / FT) 2.00 2.42	SQUARE STEEL (IN) (LB / FT) 2.50 3.35	TUBULAR STEEL Ø (IN) FOUNDATION	TUBULAR STEEL Ø (IN) (LB / FT) 3.00 7.60	TUBULAR STEEL Ø (IN) (LB / FT) 3.50 9.00	TUBULAR STEEL Ø (IN) (LB / FT) 4.00 10.80	TUBULAR STEEL Ø (IN) (LB / FT) 5.00 14.60	SIGN FRAME REQUIRED	REMARKS	SIGN DETAIL: DETAIL IN SHS	SIGN DETAIL: DETAIL ON SHEET NUMBER	SIGN DETAIL: DETAIL ON STD SHEET NUMBER
WINHALL VT-30							FY-FLUORESCENT YELLOW FYG-FLUORESCENT YELLOW GREEN																			"SHS"-STANDARD HIGHWAY SIGNS			
SB	0.360	H	R1-1	30	30								1		X											STRATTON MTN ACCESS RD. (TH-1)			
		H	R1-1	30	30			6.25								1		13.25 X									X		
SB	0.355	F	M3-3S	24	12								1	X															
		F	M1-5	24	24								1																
		F	M3-3	24	12			2.00																		GREEN ON WHITE ROUTE MARKERS.			E-136B
		F	M1-5	24	24			4.00																					E-136B
SB	0.340	F	VR-020	24	30								1		X														
		F	VR-020	24	30			5.00								1		13.25 X										4	
SB	0.270	F	R2-1	24	30								1		X														
		F	R2-1	24	30			5.00								1		13.5 X									X		
SB	0.265	F	OM-3R	12	36			3.00								1		11.0 X								INSTALL AT CORNER OF STONE WALL.	X		
SB	0.152	G	VR-017	24	30								1	X												W. HILL RD. (TH-14)			
		G	VR-017	24	30			5.00																		REPLACE SIGN AND RETAIN SIGN POST.		4	
SB	0.145	H	R1-1	30	30								1	X												W. HILL RD. (TH-14)			
		H	R1-1	30	30			6.25																		REPLACE SIGN AND RETAIN SIGN POST.	X		
							SHEET TOTALS	36.50	0.00	0	0	0	7	0	0	4		~~60~~ 51											
								SF	SF	EA	EA	EA	EA	EA	EA	EA		FT											
							TOWN DIRECTIONAL TOTALS	457.6	0.0	6.0	0.0	0.0	81	0.0	0.0	65		975.0											

SIGN SUMMARY SHEET

VERMONT AGENCY OF TRANSPORTATION

PROJECT NAME: **STATEWIDE - SOUTHWEST REGION**
PROJECT NUMBER: **STPG SIGN(32)**

FILE NAME: **WINHALL SB.XLS** PLOT DATE: **7/13/2010**
PROJECT MANAGER: **A. GAMBLE** DRAWN BY: **J. KELLY**
DESIGNED BY: **J. KELLY** CHECKED BY: **A. GAMBLE**
WINHALL SOUTHBOUND SHEET 11 SHEET **49** OF **90**

DIRECTION	MILEPOINT	LOCATION CODE (SHEET 2)	SIGN CODE	WIDTH (IN)	HEIGHT (IN)	SHEETING REMARKS	SIGN LEGEND	NEW SIGNS "A"	NEW SIGNS "B"	EXISTING SIGNS RETAIN	EXISTING SIGNS SALVAGE FROM	EXISTING SIGNS SALVAGE TO	EXISTING SIGNS REMOVE	EXIST POST RETAIN	EXIST POST REMOVE	NUMBER OF NEW POSTS	SQUARE STEEL (IN) 1.75 (LB/FT) 1.88	SQUARE STEEL (IN) 2.00 (LB/FT) 2.42	SQUARE STEEL (IN) 2.50 (LB/FT) 3.35	TUBULAR STEEL Ø (IN) FOUNDATION	TUBULAR STEEL Ø (IN) 3.00 (LB/FT) 7.60	TUBULAR STEEL Ø (IN) 3.50 (LB/FT) 9.00	TUBULAR STEEL Ø (IN) 4.00 (LB/FT) 10.80	TUBULAR STEEL Ø (IN) 5.00 (LB/FT) 14.60	SIGN FRAME REQUIRED	REMARKS	SIGN DETAIL: DETAIL IN SHS	SIGN DETAIL: DETAIL ON SHEET NUMBER	SIGN DETAIL: DETAIL ON STD SHEET NUMBER
WINHALL VT-30							FY-FLUORESCENT YELLOW FYG-FLUORESCENT YELLOW GREEN																				"SHS"-STANDARD HIGHWAY SIGNS			
SB	0.130	F	R2-1	24	30								1		X														
		F	R2-1	24	30			5.00								1		13.75 X										X		
SB	0.065	F	VD-062AS	72	16		BUSINESS SIGN			1				X															
SB	4.140	F	VW-054R	30	30			6.25								1		14.5 X								SIGN AFTER PROJECT LET			

DIRECTION	MILEPOINT	LOCATION CODE (SHEET 2)	SIGN CODE	WIDTH (IN)	HEIGHT (IN)	SHEETING REMARKS	SIGN LEGEND	NEW SIGNS "A"	NEW SIGNS "B"	EXISTING SIGNS RETAIN	EXISTING SIGNS SALVAGE FROM	EXISTING SIGNS SALVAGE TO	EXISTING SIGNS REMOVE	EXIST POST RETAIN	EXIST POST REMOVE	NUMBER OF NEW POSTS	SQUARE STEEL (IN) 1.75 (LB/FT) 1.88	SQUARE STEEL (IN) 2.00 (LB/FT) 2.42	SQUARE STEEL (IN) 2.50 (LB/FT) 3.35	TUBULAR STEEL Ø (IN) FOUNDATION	TUBULAR STEEL Ø (IN) 3.00 (LB/FT) 7.60	TUBULAR STEEL Ø (IN) 3.50 (LB/FT) 9.00	TUBULAR STEEL Ø (IN) 4.00 (LB/FT) 10.80	TUBULAR STEEL Ø (IN) 5.00 (LB/FT) 14.60	SIGN FRAME REQUIRED	REMARKS	SIGN DETAIL: DETAIL IN SHS	SIGN DETAIL: DETAIL ON SHEET NUMBER	SIGN DETAIL: DETAIL ON STD SHEET NUMBER
DORSET US-7							FY-FLUORESCENT YELLOW FYG-FLUORESCENT YELLOW GREEN																				"SHS"-STANDARD HIGHWAY SIGNS			
NB	1.765	A	VD-018	30	18								1	X															
		A	VD-018	30	18			3.75																			REPLACE SIGN AND RETAIN SIGN POST.		5	
NB	1.867	A	W11-2	30	30								1		X														
		A	W11-2	30	30	FYG		6.25								1		14.25 X									X		
		A	W16-9P	24	12	FYG		2.00																			X		
NB	1.954	A	W2-1M	30	30								1		X														
			W2-1M	36	36			9.00								2		14.5 14.75 X										6	
NB	1.995	A	D1-1	72	10		POST OFFICE ==>			1				X															
NB	2.054	A	R8-3A	24	24								1																
		A	VR-644P	24	12								1		X														
		A	VR-644P	24	12			2.00								~~2~~ 1		15.0 X									BLACK ON WHITE ONLY ONE POST		4	
		A	R8-3	24	24			4.00																				X		
NB	2.094	A	R8-3A	24	24								1		X														
		B	R8-3A	24	24								1																
		A	R8-3	24	24			4.00								1		13.0 X									INSTALL BACK TO BACK AS EXISTING.	X		
							SHEET TOTALS	31.00	0.00	1	0	0	7	0	0	~~6~~ 5		~~90~~ 71.5										
								SF	SF	EA	EA	EA	EA	EA	EA	EA		FT										
							TOWN DIRECTIONAL TOTALS	163.8	0.0	1.0	1.0	1.0	32	0.0	0.0	24		360.0										


SIGN SUMMARY SHEET

VERMONT AGENCY OF TRANSPORTATION

PROJECT NAME: STATEWIDE - SOUTHWEST REGION
PROJECT NUMBER: STPG SIGN(32)

FILE NAME: DORSET NB.XLS
PROJECT MANAGER: A. GAMBLE
DESIGNED BY: J. KELLY
DORSET NORTHBOUND SHEET 1

PLOT DATE: 7/13/2010
DRAWN BY: J. KELLY
CHECKED BY: A. GAMBLE
SHEET 51 OF 90

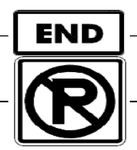DIRECTION	MILEPOINT	LOCATION CODE (SHEET 2)	SIGN CODE	WIDTH (IN)	HEIGHT (IN)	SHEETING REMARKS	SIGN LEGEND	NEW SIGNS "A"	NEW SIGNS "B"	EXISTING SIGNS RETAIN	EXISTING SIGNS SALVAGE FROM	EXISTING SIGNS SALVAGE TO	EXISTING SIGNS REMOVE	EXIST POST RETAIN	EXIST POST REMOVE	NUMBER OF NEW POSTS	SQUARE STEEL (IN) 1.75 (LB / FT) 1.88	SQUARE STEEL (IN) 2.00 (LB / FT) 2.42	SQUARE STEEL (IN) 2.50 (LB / FT) 3.35	FOUNDATION	TUBULAR STEEL Ø (IN) 3.00 (LB / FT) 7.60	TUBULAR STEEL Ø (IN) 3.50 (LB / FT) 9.00	TUBULAR STEEL Ø (IN) 4.00 (LB / FT) 10.80	TUBULAR STEEL Ø (IN) 5.00 (LB / FT) 14.60	SIGN FRAME REQUIRED	REMARKS	SIGN DETAIL: DETAIL IN SHS	SIGN DETAIL: DETAIL ON SHEET NUMBER	SIGN DETAIL: DETAIL ON STD SHEET NUMBER
DORSET US-7							FY-FLUORESCENT YELLOW FYG-FLUORESCENT YELLOW GREEN																				"SHS"-STANDARD HIGHWAY SIGNS			
		B	R8-3	24	24			4.00																				X		
NB	2.103	C	VR-017	24	30								1	X													MAD TOM RD. (TH-5)			
		C	VR-017	24	30			5.00																			REPLACE SIGN AND RETAIN SIGN POST.		4	
NB	2.111	D	R1-1	30	30								1	X													MAD TOM RD. (TH-5)			
		D	R1-1	30	30			6.25																			REPLACE SIGN AND RETAIN SIGN POST.	X		
			N/A				TOWN'S STREET NAME SIGN			X																				
NB	2.121	A	R8-3A	24	24								1		X															
		A	M4-6P	24	12								1																	
		A	M4-6	24	12			2.00								1		14.25 X								BLACK ON WHITE		4	
		A	R8-3	24	24			4.00																				X		
NB	2.148	A	M3-1	24	12								1	X																
		A	M1-4	24	24								1																	
		A	M3-1	24	12			2.00																		REPLACE THE BLACK ON WHITE ROUTE MARKERS AND RETAIN THE SIGN POST.	X		
		A	M1-4	24	24			4.00																				X		
NB	2.268	A	R2-1	24	30								1		X															
							SHEET TOTALS	27.25	0.00	0	0	0	7	0	0	1		~~15~~ 14.25											
								SF	SF	EA	EA	EA	EA	EA	EA	EA		FT											
							TOWN DIRECTIONAL TOTALS	163.8	0.0	1.0	1.0	1.0	32	0.0	0.0	24		360.0											

SIGN SUMMARY SHEET

VERMONT AGENCY OF TRANSPORTATION

PROJECT NAME: STATEWIDE - SOUTHWEST REGION
PROJECT NUMBER: STPG SIGN(32)

FILE NAME: DORSET NB.XLS
PROJECT MANAGER: A. GAMBLE
DESIGNED BY: J. KELLY
DORSET NORTHBOUND SHEET 2

PLOT DATE: 7/13/2010
DRAWN BY: J. KELLY
CHECKED BY: A. GAMBLE
SHEET 52 OF 90

DIRECTION	MILEPOINT	LOCATION CODE (SHEET 2)	SIGN CODE	WIDTH (IN)	HEIGHT (IN)	SHEETING REMARKS	SIGN LEGEND	NEW SIGNS "A"	NEW SIGNS "B"	EXISTING SIGNS RETAIN	EXISTING SIGNS SALVAGE FROM	EXISTING SIGNS SALVAGE TO	EXISTING SIGNS REMOVE	EXIST POST RETAIN	EXIST POST REMOVE	NUMBER OF NEW POSTS	SQUARE STEEL (IN) 1.75 (LB / FT) 1.88	SQUARE STEEL (IN) 2.00 (LB / FT) 2.42	SQUARE STEEL (IN) 2.50 (LB / FT) 3.35	TUBULAR STEEL Ø (IN) FOUNDATION	TUBULAR STEEL Ø (IN) 3.00 (LB / FT) 7.60	TUBULAR STEEL Ø (IN) 3.50 (LB / FT) 9.00	TUBULAR STEEL Ø (IN) 4.00 (LB / FT) 10.80	TUBULAR STEEL Ø (IN) 5.00 (LB / FT) 14.60	SIGN FRAME REQUIRED	REMARKS	SIGN DETAIL: DETAIL IN SHS	SIGN DETAIL: DETAIL ON SHEET NUMBER	SIGN DETAIL: DETAIL ON STD SHEET NUMBER
DORSET US-7							FY-FLUORESCENT YELLOW FYG-FLUORESCENT YELLOW GREEN																			"SHS"-STANDARD HIGHWAY SIGNS			
		A	R2-1	24	30			5.00								1		13.75 X								X		
NB	2.635	A	N/A	30	30		(HORSE SHOW - SEASONAL SIGN)			X				X														
NB	2.796	C	VR-023B	24	30		$500 FINE FOR THROWING TRASH ON HIGHWAYS.						1		X													
NB	3.484	A	OM-3R	12	36								1		X													
		A	OM-3R	12	36			3.00								1		11.0 X								X		
NB	3.514	B	OM-3L	12	36								1		X													
		B	OM-3L	12	36			3.00								1		11.0 X								X		
NB	3.630	A	W11-3	30	30			6.25								1		16.5 X								INSTALL 350 FEET SOUTH OF BOWEN RD. (TH-17).	X		
		A	W7-3A	24	18			3.00																		X		
NB	3.693	C	VR-017	24	30								1		X												BOWEN HILL RD. (TH-17)			
		C	VR-017	24	30			5.00								1		14.75 X										4
NB	3.701	D	R1-1	30	30								1		X												BOWEN HILL RD. (TH-17)			
		D	R1-1	30	30			6.25								1		13.75 X								X		
			N/A				TOWN'S STREET NAME SIGN				1	1	1												REINSTALL SIGN ABOVE STOP SIGN.			
NB	3.716	A	M3-1	24	12			2.00								1		15.75 X								INSTALL BLACK ON WHITE ROUTE MARKERS 100 FEET NORTH OF BOWEN RD. (TH-17).	X		
							SHEET TOTALS	33.50	0.00	0	1	1	~~6~~ 5	0	0	7								~~105~~ 96.5					
								SF	SF	EA	EA	EA	EA	EA	EA	EA								FT				
							TOWN DIRECTIONAL TOTALS	163.8	0.0	1.0	1.0	1.0	32	0.0	0.0	24								360.0				

SIGN SUMMARY SHEET

VERMONT AGENCY OF TRANSPORTATION

PROJECT NAME: **STATEWIDE - SOUTHWEST REGION**
PROJECT NUMBER: **STPG SIGN(32)**

FILE NAME: **DORSET NB.XLS** PLOT DATE: **7/13/2010**
PROJECT MANAGER: **A. GAMBLE** DRAWN BY: **J. KELLY**
DESIGNED BY: **J. KELLY** CHECKED BY: **A. GAMBLE**
DORSET NORTHBOUND SHEET 3 SHEET **53** OF **90**

DIRECTION	MILEPOINT	LOCATION CODE (SHEET 2)	SIGN CODE	WIDTH (IN)	HEIGHT (IN)	SHEETING REMARKS	SIGN LEGEND	NEW SIGNS "A"	NEW SIGNS "B"	EXISTING SIGNS RETAIN	EXISTING SIGNS SALVAGE FROM	EXISTING SIGNS SALVAGE TO	EXISTING SIGNS REMOVE	EXIST POST RETAIN	EXIST POST REMOVE	NUMBER OF NEW POSTS	SQUARE STEEL (IN) (LB / FT) 1.75 / 1.88	SQUARE STEEL (IN) (LB / FT) 2.00 / 2.42	SQUARE STEEL (IN) (LB / FT) 2.50 / 3.35	TUBULAR STEEL Ø (IN) FOUNDATION	TUBULAR STEEL Ø (IN) (LB / FT) 3.00 / 7.60	TUBULAR STEEL Ø (IN) (LB / FT) 3.50 / 9.00	TUBULAR STEEL Ø (IN) (LB / FT) 4.00 / 10.80	TUBULAR STEEL Ø (IN) (LB / FT) 5.00 / 14.60	SIGN FRAME REQUIRED	REMARKS	SIGN DETAIL: DETAIL IN SHS	SIGN DETAIL: DETAIL ON SHEET NUMBER	SIGN DETAIL: DETAIL ON STD SHEET NUMBER
DORSET US-7							FY-FLUORESCENT YELLOW FYG-FLUORESCENT YELLOW GREEN																				"SHS"-STANDARD HIGHWAY SIGNS			
		A	M1-4	24	24		NORTH 7	4.00																			X		
NB	3.754	A	R2-1	24	30		SPEED LIMIT 50	5.00								1		14.75 X								INSTALL 300 FEET NORTH OF BOWEN RD. (TH-17).	X		
NB	4.615	A	VD-018	30	18		N. Dorset S. Wallingford 9						1	X															
		A	VD-018	30	18			3.75																		REPLACE SIGN AND RETAIN SIGN POST.		5	
NB	4.693	A	R2-1	24	30		SPEED LIMIT 45						1		X														
NB	4.700	A	R2-1	30	36			7.50								1		15.5 X								INSTALL 35 FEET NORTH OF EXISTING SPEED LIMIT 45 SIGN ASSEMBLY.		4	
NB	4.877	A	VW-619	30	30		SHOULDER NARROWS	6.25								1		15.25 X								INSTALL 200 FEET SOUTH OF SHOULDER TAPER.		6	
NB	4.916	A	R2-1	24	30		SPEED LIMIT 45						1		X														
		A	R2-1	24	30			5.00								1		13.25 X									X		
NB	4.968	A	OM-3R	12	36								1		X														
		A	OM-3R	12	36			3.00								1		11.0 X									X		
NB	5.020	B	OM-3L	12	36								1		X														
		B	OM-3L	12	36			3.00								1		11.0 X								REMOVE 5.00 MILE MARKER.	X		
NB	5.067	A	W2-2LM	30	30								1	X															
		A	W2-2LM	30	30			6.25																		REPLACE SIGN AND RETAIN SIGN POST.		6	
							SHEET TOTALS	43.75 SF	0.00 SF	0 EA	0 EA	0 EA	6 EA	0 EA	0 EA	6 EA		~~90~~ 80.75 FT									
							TOWN DIRECTIONAL TOTALS	163.8	0.0	1.0	1.0	1.0	32	0.0	0.0	24		360.0											

SIGN SUMMARY SHEET

VERMONT AGENCY OF TRANSPORTATION

PROJECT NAME: STATEWIDE - SOUTHWEST REGION
PROJECT NUMBER: STPG SIGN(32)

FILE NAME: DORSET NB.XLS
PROJECT MANAGER: A. GAMBLE
DESIGNED BY: J. KELLY
DORSET NORTHBOUND SHEET 4

PLOT DATE: 7/13/2010
DRAWN BY: J. KELLY
CHECKED BY: A. GAMBLE
SHEET 54 OF 90

DIRECTION	MILEPOINT	LOCATION CODE (SHEET 2)	SIGN CODE	WIDTH (IN)	HEIGHT (IN)	SHEETING REMARKS	SIGN LEGEND	NEW SIGNS "A"	NEW SIGNS "B"	EXISTING SIGNS RETAIN	EXISTING SIGNS SALVAGE FROM	EXISTING SIGNS SALVAGE TO	EXISTING SIGNS REMOVE	EXIST POST RETAIN	EXIST POST REMOVE	NUMBER OF NEW POSTS	SQUARE STEEL (IN) 1.75 (LB/FT) 1.88	SQUARE STEEL (IN) 2.00 (LB/FT) 2.42	SQUARE STEEL (IN) 2.50 (LB/FT) 3.35	TUBULAR STEEL Ø (IN) FOUNDATION	TUBULAR STEEL Ø (IN) 3.00 (LB/FT) 7.60	TUBULAR STEEL Ø (IN) 3.50 (LB/FT) 9.00	TUBULAR STEEL Ø (IN) 4.00 (LB/FT) 10.80	TUBULAR STEEL Ø (IN) 5.00 (LB/FT) 14.60	SIGN FRAME REQUIRED	REMARKS	SIGN DETAIL: DETAIL IN SHS	SIGN DETAIL: DETAIL ON SHEET NUMBER	SIGN DETAIL: DETAIL ON STD SHEET NUMBER
DORSET US-7							FY-FLUORESCENT YELLOW FYG-FLUORESCENT YELLOW GREEN				I	I	I			I		13.25 X								"SHS"-STANDARD HIGHWAY SIGNS			
NB	5.148	A	VR-921L	30	30								1		X														
		A	VR-921L	30	30			6.25								1		13.25 X								• SIGN WAS INSTALLED THEN MOVED FURTHER OFF ROAD			E-145A
NB	5.243	A	M3-1	24	12								1	X															
		A	M1-4	24	24								1																
		A	M3-1	24	12			2.00																	REPLACE BLACK ON WHITE ROUTE MARKERS AND RETAIN SIGN POST.	X		
		A	M1-4	24	24			4.00																			X		
NB	5.520	A	R2-1	24	30								1		X														
NB	5.530	A	R2-1	24	30			5.00								1		14.0 X								INSTALL 50 FEET NORTH OF EXISTING SL50 SIGN ASSEMBLY.	X		
NB	6.615	A	R2-1	24	30								1		X														
		A	R2-1	24	30			5.00								1		13.25 X									X		
NB	6.646	A	M3-1	24	12		NORTH						1		X														
		A	M1-4	24	24		US-7						1																
NB	6.656	A	M3-1	24	12			2.00								1		15.0 X								INSTALL 50 FEET NORTH OF EXISTING ROUTE MARKER ASSEMBLY	X		
		A	M1-4	24	24			4.00																			X		
SIGN SUMMARY SHEET							SHEET TOTALS	28.25	0.00	0	~~0~~ 1	~~0~~ 1	~~7~~ 8	0	0	~~4~~ 5		~~60~~ 68.75											
								SF	SF	EA	EA	EA	EA	EA	EA	EA		FT											
VERMONT AGENCY OF TRANSPORTATION							TOWN DIRECTIONAL TOTALS	163.8	0.0	1.0	~~1.0~~ 2.0	~~1.0~~ 2.0	~~32~~ 34	0.0	0.0	24		~~360.0~~ 331.75											

PROJECT NAME: STATEWIDE - SOUTHWEST REGION
PROJECT NUMBER: STPG SIGN(32)

FILE NAME: DORSET NB.XLS
PROJECT MANAGER: A. GAMBLE
DESIGNED BY: J. KELLY
DORSET NORTHBOUND SHEET 5

PLOT DATE: 7/13/2010
DRAWN BY: J. KELLY
CHECKED BY: A. GAMBLE
SHEET 55 OF 90

DIRECTION	MILEPOINT	LOCATION CODE (SHEET 2)	SIGN CODE	WIDTH (IN)	HEIGHT (IN)	SHEETING REMARKS	SIGN LEGEND	NEW SIGNS "A"	NEW SIGNS "B"	EXISTING SIGNS RETAIN	EXISTING SIGNS SALVAGE FROM	EXISTING SIGNS SALVAGE TO	EXISTING SIGNS REMOVE	EXIST POST RETAIN	EXIST POST REMOVE	NUMBER OF NEW POSTS	SQUARE STEEL (IN) (LB / FT) 1.75 / 1.88	SQUARE STEEL (IN) (LB / FT) 2.00 / 2.42	SQUARE STEEL (IN) (LB / FT) 2.50 / 3.35	TUBULAR STEEL Ø (IN) FOUNDATION	TUBULAR STEEL Ø (IN) (LB / FT) 3.00 / 7.60	TUBULAR STEEL Ø (IN) (LB / FT) 3.50 / 9.00	TUBULAR STEEL Ø (IN) (LB / FT) 4.00 / 10.80	TUBULAR STEEL Ø (IN) (LB / FT) 5.00 / 14.60	SIGN FRAME REQUIRED	REMARKS	SIGN DETAIL: DETAIL IN SHS	SIGN DETAIL: DETAIL ON SHEET NUMBER	SIGN DETAIL: DETAIL ON STD SHEET NUMBER
DORSET US-7							FY-FLUORESCENT YELLOW FYG-FLUORESCENT YELLOW GREEN																			"SHS"-STANDARD HIGHWAY SIGNS			
SB	6.690	G	VR-023B	24	30		$500 FINE FOR THROWING TRASH ON HIGHWAYS						1		X													
SB	6.578	F	R2-1	24	30								1	X														
		F	R2-1	24	30			5.00																		REPLACE SIGN AND RETAIN SIGN POST.	X		
SB	6.545	F	M3-3	24	12								1	X														
		F	M1-4	24	24								1															
		F	M3-3	24	12			2.00																	REPLACE BLACK ON WHITE ROUTE MARKERS AND RETAIN SIGN POST.	X		
		F	M1-4	24	24			4.00																			X		
SB	5.589	F	VD-018	30	18								1	X														
		F	VD-018	30	18			3.75																		REPLACE SIGN AND RETAIN SIGN POST.		5	
SB	5.530	F	R2-1	30	36			7.50								1		15.0 X								INSTALL 50 FEET NORTH OF EXISTING AND ACROSS FROM NEW NB SL50.		4	
SB	5.520	F	R2-1	24	30		SPEED LIMIT 45						1		X													
SB	5.367	F	W2-2MR	30	30								1	X														
		F	W2-2MR	30	30			6.25																		REPLACE SIGN AND RETAIN SIGN POST.		6	
SB	5.319	F	R2-1	24	30		SPEED LIMIT 45			1				X														
SB	5.270	F	VR-921R	30	30								1	X														
							SHEET TOTALS	28.50	0.00	1	0	0	8	0	0	1		15										
								SF	SF	EA	EA	EA	EA	EA	EA	EA		FT										
							TOWN DIRECTIONAL TOTALS	206.7	0.0	5.0	1.0	1.0	47	0.0	0.0	21		315.0										

SIGN SUMMARY SHEET

VERMONT AGENCY OF TRANSPORTATION

PROJECT NAME: **STATEWIDE - SOUTHWEST REGION**
PROJECT NUMBER: **STPG SIGN(32)**

FILE NAME: **DORSET SB.XLS** PLOT DATE: **7/13/2010**
PROJECT MANAGER: **A. GAMBLE** DRAWN BY: **J. KELLY**
DESIGNED BY: **J. KELLY** CHECKED BY: **A. GAMBLE**
DORSET SOUTHBOUND SHEET 1 SHEET **56** OF **90**

DIRECTION	MILEPOINT	LOCATION CODE (SHEET 2)	SIGN CODE	WIDTH (IN)	HEIGHT (IN)	SHEETING REMARKS	SIGN LEGEND	NEW SIGNS "A"	NEW SIGNS "B"	EXISTING SIGNS RETAIN	EXISTING SIGNS SALVAGE FROM	EXISTING SIGNS SALVAGE TO	EXISTING SIGNS REMOVE	EXIST POST RETAIN	EXIST POST REMOVE	NUMBER OF NEW POSTS	SQUARE STEEL (IN) 1.75 (LB / FT) 1.88	SQUARE STEEL (IN) 2.00 (LB / FT) 2.42	SQUARE STEEL (IN) 2.50 (LB / FT) 3.35	TUBULAR STEEL Ø (IN) FOUNDATION	TUBULAR STEEL Ø (IN) 3.00 (LB / FT) 7.60	TUBULAR STEEL Ø (IN) 3.50 (LB / FT) 9.00	TUBULAR STEEL Ø (IN) 4.00 (LB / FT) 10.80	TUBULAR STEEL Ø (IN) 5.00 (LB / FT) 14.60	SIGN FRAME REQUIRED	REMARKS	SIGN DETAIL DETAIL IN SHS	SIGN DETAIL DETAIL ON SHEET NUMBER	SIGN DETAIL DETAIL ON STD SHEET NUMBER
DORSET US-7							FY-FLUORESCENT YELLOW FYG-FLUORESCENT YELLOW GREEN																				"SHS"-STANDARD HIGHWAY SIGNS			
		F	VR-921R	30	30			6.25																		REPLACE SIGN AND RETAIN SIGN POST.			E-145A
SB	5.212	G	VR-017	24	30								1	X												SWEENEY LN (TH-15)			
		G	VR-017	24	30			5.00																		REPLACE SIGN AND RETAIN SIGN POST.		4	
	5.201	H	R1-1	30	30								1	X												SWEENEY LN (TH-15)			
		H	R1-1	30	30			6.25																		REPLACE SIGN AND RETAIN SIGN POST.	X		
SB	5.167	F	M3-3	24	12								1	X															
		F	M1-4	24	12								1																
		F	M3-3	24	12			2.00																	REPLACE BLACK ON WHITE ROUTE MARKERS AND RETAIN SIGN POST.	X		
		F	M1-4	24	12			4.00																			X		
SB	5.125	F	R2-1	24	30								1	X																
		F	R2-1	24	30			5.00																		REPLACE SIGN AND RETAIN SIGN POST.	X		
SB	5.028	F	W11-3	30	30								1		X														
		F	W7-3A	24	18								1																
		F	W11-3	30	30			6.25								1		~~15~~ 15.5 X								X		
		F	W7-3A	24	18			3.00																			X		
SIGN SUMMARY SHEET							SHEET TOTALS	37.75	0.00	0	0	0	7	0	0	1		~~15~~ 15.5											
VERMONT AGENCY OF TRANSPORTATION								SF	SF	EA	EA	EA	EA	EA	EA	EA		FT											
							TOWN DIRECTIONAL TOTALS	206.7	0.0	5.0	1.0	1.0	47	0.0	0.0	21		315.0											

PROJECT NAME: **STATEWIDE - SOUTHWEST REGION**
PROJECT NUMBER: **STPG SIGN(32)**

FILENAME: **DORSET SB.XLS** PLOT DATE: **7/13/2010**
PROJECT MANAGER: **A. GAMBLE** DRAWN BY: **J. KELLY**
DESIGNED BY: **J. KELLY** CHECKED BY: **A. GAMBLE**
DORSET SOUTHBOUND SHEET 2 SHEET **57** OF **90**

DIRECTION	MILEPOINT	LOCATION CODE (SHEET 2)	SIGN CODE	WIDTH (IN)	HEIGHT (IN)	SHEETING REMARKS	SIGN LEGEND	NEW SIGNS "A"	NEW SIGNS "B"	EXISTING SIGNS RETAIN	EXISTING SIGNS SALVAGE FROM	EXISTING SIGNS SALVAGE TO	EXISTING SIGNS REMOVE	EXIST POST RETAIN	EXIST POST REMOVE	NUMBER OF NEW POSTS	SQUARE STEEL (IN) 1.75 (LB/FT) 1.88	SQUARE STEEL (IN) 2.00 (LB/FT) 2.42	SQUARE STEEL (IN) 2.50 (LB/FT) 3.35	TUBULAR STEEL Ø (IN) FOUNDATION	TUBULAR STEEL Ø (IN) 3.00 (LB/FT) 7.60	TUBULAR STEEL Ø (IN) 3.50 (LB/FT) 9.00	TUBULAR STEEL Ø (IN) 4.00 (LB/FT) 10.80	TUBULAR STEEL Ø (IN) 5.00 (LB/FT) 14.60	SIGN FRAME REQUIRED	REMARKS	SIGN DETAIL: DETAIL IN SHS	SIGN DETAIL: DETAIL ON SHEET NUMBER	SIGN DETAIL: DETAIL ON STD SHEET NUMBER
DORSET US-7							FY-FLUORESCENT YELLOW FYG-FLUORESCENT YELLOW GREEN																			"SHS"-STANDARD HIGHWAY SIGNS			
SB	5.019	F	OM-3R	12	36								1		X														
		F	OM-3R	12	36			3.00								1		11.0 X										X		
SB	4.967	E	OM-3L	12	36								1		X														
		E	OM-3L	12	36			3.00								1		11.0 X										X		
SB	4.755	G	VR-023B	24	30		$500 FINE						1		X														
SB	4.700	F	R2-1	24	30			5.00								1		13.75 X									INSTALL 65 FEET NORTH OF EXISTING AND ACROSS FROM THE NB SPEED LIMIT 45.	X		
SB	4.687	F	R2-1	24	30		SPEED LIMIT 50						1		X														
SB	3.968	F	VD-062AS	72	16		BUSINESS SIGN			1				X															
SB	3.655	F	M3-3	24	12								1																
		F	M1-4	24	24								1																
		F	M3-3	24	12			2.00								1		15.5 X									BLACK ON WHITE ROUTE MARKERS.	X		
		F	M1-4	24	24			4.00																				X		
SB	3.521	F	OM-3R	12	36								1		X														
		F	OM-3R	12	36			3.00								1		11.0 X										X		
SB	3.491	E	OM-3L	12	36								1		X														
							SHEET TOTALS	20.00	0.00	1	0	0	8	0	0	5		~~75~~ 62.25										
								SF	SF	EA	EA	EA	EA	EA	EA	EA		FT										
							TOWN DIRECTIONAL TOTALS	206.7	0.0	5.0	1.0	1.0	47	0.0	0.0	21		315.0										


SIGN SUMMARY SHEET

VERMONT AGENCY OF TRANSPORTATION

PROJECT NAME: STATEWIDE - SOUTHWEST REGION
PROJECT NUMBER: STPG SIGN(32)

FILE NAME: DORSET SB.XLS
PROJECT MANAGER: A. GAMBLE
DESIGNED BY: J. KELLY
DORSET SOUTHBOUND SHEET 3

PLOT DATE: 7/13/2010
DRAWN BY: J. KELLY
CHECKED BY: A. GAMBLE

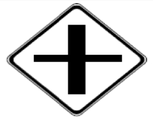DIRECTION	MILEPOINT	LOCATION CODE (SHEET 2)	SIGN CODE	WIDTH (IN)	HEIGHT (IN)	SHEETING REMARKS	SIGN LEGEND	NEW SIGNS "A"	NEW SIGNS "B"	EXISTING SIGNS RETAIN	EXISTING SIGNS SALVAGE FROM	EXISTING SIGNS SALVAGE TO	EXISTING SIGNS REMOVE	EXIST POST RETAIN	EXIST POST REMOVE	NUMBER OF NEW POSTS	SQUARE STEEL (IN) (LB / FT) 1.75 / 1.88	SQUARE STEEL (IN) (LB / FT) 2.00 / 2.42	SQUARE STEEL (IN) (LB / FT) 2.50 / 3.35	TUBULAR STEEL Ø (IN) FOUNDATION	TUBULAR STEEL Ø (IN) (LB / FT) 3.00 / 7.60	TUBULAR STEEL Ø (IN) (LB / FT) 3.50 / 9.00	TUBULAR STEEL Ø (IN) (LB / FT) 4.00 / 10.80	TUBULAR STEEL Ø (IN) (LB / FT) 5.00 / 14.60	SIGN FRAME REQUIRED	REMARKS	SIGN DETAIL: DETAIL IN SHS	SIGN DETAIL: DETAIL ON SHEET NUMBER	SIGN DETAIL: DETAIL ON STD SHEET NUMBER
DORSET US-7							FY-FLUORESCENT YELLOW FYG-FLUORESCENT YELLOW GREEN																			"SHS"-STANDARD HIGHWAY SIGNS			
		E	OM-3L	12	36			3.00								1		11.0 X									X		
SB	3.345	F	N/A	30	30		(HORSE SHOW - SEASONAL SIGN)			1				X														
SB	3.261	F	R2-1	24	30								1		X														
		F	R2-1	24	30			5.00								1		14.5 X									X		
SB	2.402	F	W3-5	36	36		SPEED REDUCTION (40)			1				X														
SB	2.330	F	VD-018	30	18								1	X															
		F	VD-018	30	18			3.75																			REPLACE SIGN AND RETAIN SIGN POST.		5	
SB	2.279	G	VR-017	24	30								1	X													COOK RD. (TH-40)			
		G	VR-017	24	30			5.00																			REPLACE SIGN AND RETAIN SIGN POST.		4	
SB	2.272	H	R1-1	30	30								1		X													COOK RD. (TH-40)			
		H	R1-1	30	30			6.25								1		13.25 X									X		
SB	2.265	F	R2-1	24	30								1	X															
		F	R2-1	30	36			7.50																			REPLACE SIGN AND RETAIN SIGN POST.		4	
SB	2.219	F	W2-1Mb	30	30								1		X														
		F	W2-1Mb	36	36			9.00								2		15.5 15.75 X										6	
SIGN SUMMARY SHEET							SHEET TOTALS	39.50	0.00	2	0	0	6	0	0	5		~~75~~ 70										
								SF	SF	EA	EA	EA	EA	EA	EA	EA		FT										
VERMONT AGENCY OF TRANSPORTATION							TOWN DIRECTIONAL TOTALS	206.7	0.0	5.0	1.0	1.0	47	0.0	0.0	21		315.0										

PROJECT NAME: STATEWIDE - SOUTHWEST REGION
PROJECT NUMBER: STPG SIGN(32)

FILE NAME: DORSET SB.XLS
PROJECT MANAGER: A. GAMBLE
DESIGNED BY: J. KELLY
DORSET SOUTHBOUND SHEET 4

PLOT DATE: 7/13/2010
DRAWN BY: J. KELLY
CHECKED BY: A. GAMBLE
SHEET 59 OF 90

DIRECTION	MILEPOINT	LOCATION CODE (SHEET 2)	SIGN CODE	WIDTH (IN)	HEIGHT (IN)	SHEETING REMARKS	SIGN LEGEND	NEW SIGNS "A"	NEW SIGNS "B"	EXISTING SIGNS RETAIN	EXISTING SIGNS SALVAGE FROM	EXISTING SIGNS SALVAGE TO	EXISTING SIGNS REMOVE	EXIST POST RETAIN	EXIST POST REMOVE	NUMBER OF NEW POSTS	SQUARE STEEL (IN) 1.75 (LB / FT) 1.88	SQUARE STEEL (IN) 2.00 (LB / FT) 2.42	SQUARE STEEL (IN) 2.50 (LB / FT) 3.35	FOUNDATION	TUBULAR STEEL Ø (IN) 3.00 (LB / FT) 7.60	TUBULAR STEEL Ø (IN) 3.50 (LB / FT) 9.00	TUBULAR STEEL Ø (IN) 4.00 (LB / FT) 10.80	TUBULAR STEEL Ø (IN) 5.00 (LB / FT) 14.60	SIGN FRAME REQUIRED	REMARKS	SIGN DETAIL: DETAIL IN SHS	SIGN DETAIL: DETAIL ON SHEET NUMBER	SIGN DETAIL: DETAIL ON STD SHEET NUMBER
DORSET US-7							FY-FLUORESCENT YELLOW FYG-FLUORESCENT YELLOW GREEN																				"SHS"-STANDARD HIGHWAY SIGNS			
SB	2.175	F	W11-2	30	30	FYG		6.25								1		15.5 X								INSTALL IN-LINE WITH MARBLEDGE MOTEL SIGN.	X		
		F	W16-9P	24	12	FYG		2.00																			X		
SB	2.116	F	R8-3A	24	24								1																
		F	VR-644P	24	12								1		X														
		F	VR-644P	24	12			2.00								1		14.25 X								BLACK ON WHITE		4	
		F	R8-3	24	24			4.00																			X		
SB	2.111	G	VR-017	24	30								1														SQUIRREL HOLLOW RD. (TH-22)			
		H	R1-1	30	30								1																
			N/A				TOWN'S STREET NAME SIGN				1	1	I														REINSTALL TOWN'S STREET NAME SIGN ON TOP OF POST.			
		G	VR-017	24	30		 	5.00								1		13.75 X								INSTALL BACK-TO-BACK AS EXISTING.		4	
		H	R1-1	30	30			6.25																			X		
SB	2.104	H	R1-1	30	30								1														SQUIRREL HOLLOW RD. (TH-22)			
		H	R1-1	30	30			6.25								1		13.25 X									X		
SB	2.051	F	R8-3A	24	24								1																
		F	M4-6P	24	12								1		X														
							SHEET TOTALS	31.75 SF	0.00 SF	0 EA	1 EA	1 EA	~~8~~ 7 EA	0 EA	0 EA	4 EA		~~60~~ 56.75 FT										
							TOWN DIRECTIONAL TOTALS	206.7	0.0	5.0	1.0	1.0	47	0.0	0.0	21		315.0										

SIGN SUMMARY SHEET

VERMONT AGENCY OF TRANSPORTATION

PROJECT NAME: **STATEWIDE - SOUTHWEST REGION**
PROJECT NUMBER: **STPG SIGN(32)**

FILE NAME: **DORSET SB.XLS**
PROJECT MANAGER: **A. GAMBLE**
DESIGNED BY: **J. KELLY**
DORSET SOUTHBOUND SHEET 5

PLOT DATE: **7/13/2010**
DRAWN BY: **J. KELLY**
CHECKED BY: **A. GAMBLE**
SHEET **60** OF **90**

DIRECTION	MILEPOINT	LOCATION CODE (SHEET 2)	SIGN CODE	WIDTH (IN)	HEIGHT (IN)	SHEETING REMARKS	SIGN LEGEND	NEW SIGNS "A"	NEW SIGNS "B"	EXISTING SIGNS RETAIN	EXISTING SIGNS SALVAGE FROM	EXISTING SIGNS SALVAGE TO	EXISTING SIGNS REMOVE	EXIST POST RETAIN	EXIST POST REMOVE	NUMBER OF NEW POSTS	SQUARE STEEL (IN) 1.75 (LB / FT) 1.88	SQUARE STEEL (IN) 2.00 (LB / FT) 2.42	SQUARE STEEL (IN) 2.50 (LB / FT) 3.35	TUBULAR STEEL Ø (IN) FOUNDATION	TUBULAR STEEL Ø (IN) 3.00 (LB / FT) 7.60	TUBULAR STEEL Ø (IN) 3.50 (LB / FT) 9.00	TUBULAR STEEL Ø (IN) 4.00 (LB / FT) 10.80	TUBULAR STEEL Ø (IN) 5.00 (LB / FT) 14.60	SIGN FRAME REQUIRED	REMARKS	SIGN DETAIL: DETAIL IN SHS	SIGN DETAIL: DETAIL ON SHEET NUMBER	SIGN DETAIL: DETAIL ON STD SHEET NUMBER
DORSET US-7							FY-FLUORESCENT YELLOW FYG-FLUORESCENT YELLOW GREEN																				"SHS"-STANDARD HIGHWAY SIGNS			
		F	M4-6	24	12			2.00								1		14.0 X								BLACK ON WHITE		4	
		F	R8-3	24	24			4.00																				X		
SB	2.026	F	M3-3	24	12								1		X															
		F	M1-4	24	24								1																	
		F	M3-3	24	12			2.00								1		14.25 X								BLACK ON WHITE ROUTE MARKERS.	X		
		F	M1-4	24	24			4.00																				X		
SB	2.000	F	R2-1	24	30								1		X																
		F	R2-1	24	30			5.00								1		14.5 X										X		
SB	1.960	F	?	36	36		LIMITED ACCESS BEGINS						1		X															
		F	?	24	12		1/2 MILE						1																	
SB	1.850	F	W10-3L	36	36		LEFT SIDE ROAD WITH RR CROSSING			1				X																
SB	1.815	F	M2-1	21	15								1	X																
			M1-5	24	24								1																	
			M2-1	21	15			2.19																			REPLACE GREEN ON WHITE ROUTE MARKERS AND RETAIN SIGN POST.			E-136B
			VM-078	24	12			2.00																						E-136B
SIGN SUMMARY SHEET							SHEET TOTALS	21.19	0.00	1	0	0	7	0	0	3		~~45~~ 42.75											
								SF	SF	EA	EA	EA	EA	EA	EA	EA		FT											
VERMONT AGENCY OF TRANSPORTATION							TOWN DIRECTIONAL TOTALS	206.7	0.0	5.0	1.0	1.0	47	0.0	0.0	21		315.0											

PROJECT NAME: **STATEWIDE - SOUTHWEST REGION**
PROJECT NUMBER: **STPG SIGN(32)**

FILE NAME: **DORSET SB.XLS** PLOT DATE: **7/13/2010**
PROJECT MANAGER: **A. GAMBLE** DRAWN BY: **J. KELLY**
DESIGNED BY: **J. KELLY** CHECKED BY: **A. GAMBLE**
DORSET SOUTHBOUND SHEET 6 SHEET **61** OF **90**

DIRECTION	MILEPOINT	LOCATION CODE (SHEET 2)	SIGN CODE	WIDTH (IN)	HEIGHT (IN)	SHEETING REMARKS	SIGN LEGEND	NEW SIGNS "A"	NEW SIGNS "B"	EXISTING SIGNS RETAIN	EXISTING SIGNS SALVAGE FROM	EXISTING SIGNS SALVAGE TO	EXISTING SIGNS REMOVE	EXIST POST RETAIN	EXIST POST REMOVE	NUMBER OF NEW POSTS	SQUARE STEEL (IN) 1.75 (LB / FT) 1.88	SQUARE STEEL (IN) 2.00 (LB / FT) 2.42	SQUARE STEEL (IN) 2.50 (LB / FT) 3.35	TUBULAR STEEL Ø (IN) FOUNDATION	TUBULAR STEEL Ø (IN) 3.00 (LB / FT) 7.60	TUBULAR STEEL Ø (IN) 3.50 (LB / FT) 9.00	TUBULAR STEEL Ø (IN) 4.00 (LB / FT) 10.80	TUBULAR STEEL Ø (IN) 5.00 (LB / FT) 14.60	SIGN FRAME REQUIRED	REMARKS	SIGN DETAIL: DETAIL IN SHS	SIGN DETAIL: DETAIL ON SHEET NUMBER	SIGN DETAIL: DETAIL ON STD SHEET NUMBER
DORSET US-7							FY-FLUORESCENT YELLOW FYG-FLUORESCENT YELLOW GREEN																			"SHS"-STANDARD HIGHWAY SIGNS			
			M1-5	24	24			4.00																					E-136B
SB	1.779	F	D1-1A	72	10								1		X														
		F	D1-1A	72	10								1																
		F	D1-1A	72	10								1																
		F	D1-1A	72	10								1																
		F	D1-1A	72	10								1																
		F	D1-1A	72	12		Arlington 17	6.00								2		15.5 16.75	X										5
		F	D1-1A	72	12		Bennington 29	6.00																					5
		F	D1-1A	72	12		Manchester Ctr 5	6.00																					5
		F	D1-1A	72	12		Manchester 6	6.00																					5
							SHEET TOTALS	28.00	0.00	0	0	0	4	0	0	2		~~30~~ 32.25											
								SF	SF	EA	EA	EA	EA	EA	EA	EA		FT											
							TOWN DIRECTIONAL TOTALS	206.7	0.0	5.0	1.0	1.0	~~47~~ 48	0.0	0.0	21		~~315.0~~ 294.5											

SIGN SUMMARY SHEET

VERMONT AGENCY OF TRANSPORTATION

PROJECT NAME: **STATEWIDE - SOUTHWEST REGION**
PROJECT NUMBER: **STPG SIGN(32)**

FILE NAME: **DORSET SB.XLS** PLOT DATE: **7/13/2010**
PROJECT MANAGER: **A. GAMBLE** DRAWN BY: **J. KELLY**
DESIGNED BY: **J. KELLY** CHECKED BY: **A. GAMBLE**
DORSET SOUTHBOUND SHEET 7 SHEET **62** OF **90**

DIRECTION	MILEPOINT	LOCATION CODE (SHEET 2)	SIGN CODE	WIDTH (IN)	HEIGHT (IN)	SHEETING REMARKS	SIGN LEGEND	NEW SIGNS "A"	NEW SIGNS "B"	EXISTING SIGNS RETAIN	EXISTING SIGNS SALVAGE FROM	EXISTING SIGNS SALVAGE TO	EXISTING SIGNS REMOVE	EXIST POST RETAIN	EXIST POST REMOVE	NUMBER OF NEW POSTS	SQUARE STEEL (IN) 1.75 (LB / FT) 1.88	SQUARE STEEL (IN) 2.00 (LB / FT) 2.42	SQUARE STEEL (IN) 2.50 (LB / FT) 3.35	TUBULAR STEEL Ø (IN) FOUNDATION	TUBULAR STEEL Ø (IN) 3.00 (LB / FT) 7.60	TUBULAR STEEL Ø (IN) 3.50 (LB / FT) 9.00	TUBULAR STEEL Ø (IN) 4.00 (LB / FT) 10.80	TUBULAR STEEL Ø (IN) 5.00 (LB / FT) 14.60	SIGN FRAME REQUIRED	REMARKS	SIGN DETAIL: DETAIL IN SHS	SIGN DETAIL: DETAIL ON SHEET NUMBER	SIGN DETAIL: DETAIL ON STD SHEET NUMBER
MOUNT TABOR US-7							FY-FLUORESCENT YELLOW FYG-FLUORESCENT YELLOW GREEN																			"SHS"-STANDARD HIGHWAY SIGNS			
NB	0.000	C	VD-024	60	7.5								1		X														
		C	VD-025	60	7.5								1																
		C	VD-024	72	10		Mt. Tabor / Dorset	5.00								2		13.5 13.5 X										4	
		C	VD-025	72	10		Rutland Co. / Bennington Co.	5.00																				4	
		C	VD-700	6	10		0070 1113 0000 / 0070 0203 0672	0.42					1														INSTALL ON LH POST BELOW MT. TABOR.			E-138
		C	VD-700	6	10			0.42					1														INSTALL ON RH POST BELOW DORSET.			E-138
NB	0.103	C	VR-023B	24	30		$500 FINE FOR THROWING TRASH ON HIGHWAYS						1		X														
NB	0.691	A	W10-2R	36	36		CROSSROAD W/TRACKS ON RIGHT			1				X															
NB	0.747	A	VD-062B	72	16		BUSINESS SIGN			1				X															
NB	0.830	C	VR-017	24	30		LEGAL LOAD LIMIT 24,000 POUNDS						1		X												SOUTH END RD. (TH-5)		
		C	VR-017	24	30			5.00								1		13.75 X									EAST OF RR TRACKS.		4	
NB	0.834	D	R1-1	30	30		STOP						1		X												SOUTH END RD. (TH-5)		
		D	R1-1	30	30			6.25								1		14.75 X										X	
NB	1.359	A	W10-3R	36	36		RIGHT SIDE ROAD W/TRACKS			1				X															
NB	1.523	C	VR-023B	24	30		$500 FINE FOR THROWING TRASH ON HIGHWAYS						1		X														
SIGN SUMMARY SHEET							SHEET TOTALS	22.09	0.00	3	0	0	~~8~~ 6	0	0	4		~~60~~ 55.5										
								SF	SF	EA	EA	EA	EA	EA	EA	EA		FT										
VERMONT AGENCY OF TRANSPORTATION							TOWN DIRECTIONAL TOTALS	134.1	0.0	7.0	2.0	2.0	29	0.0	0.0	18		270.0										

PROJECT NAME: STATEWIDE - SOUTHWEST REGION
PROJECT NUMBER: STPG SIGN(32)

FILE NAME: MOUNT TABOR NB.XLS
PROJECT MANAGER: A. GAMBLE
DESIGNED BY: J. KELLY
MOUNT TABOR NORTHBOUND SHEET 1

PLOT DATE: 8/26/2010
DRAWN BY: J. KELLY
CHECKED BY: A. GAMBLE
SHEET 63 OF 90

DIRECTION	MILEPOINT	LOCATION CODE (SHEET 2)	SIGN CODE	WIDTH (IN)	HEIGHT (IN)	SHEETING REMARKS	SIGN LEGEND	NEW SIGNS "A"	NEW SIGNS "B"	EXISTING SIGNS RETAIN	EXISTING SIGNS SALVAGE FROM	EXISTING SIGNS SALVAGE TO	EXISTING SIGNS REMOVE	EXIST POST RETAIN	EXIST POST REMOVE	NUMBER OF NEW POSTS	SQUARE STEEL (IN) 1.75 (LB / FT) 1.88	SQUARE STEEL (IN) 2.00 (LB / FT) 2.42	SQUARE STEEL (IN) 2.50 (LB / FT) 3.35	FOUNDATION	TUBULAR STEEL Ø (IN) 3.00 (LB / FT) 7.60	TUBULAR STEEL Ø (IN) 3.50 (LB / FT) 9.00	TUBULAR STEEL Ø (IN) 4.00 (LB / FT) 10.80	TUBULAR STEEL Ø (IN) 5.00 (LB / FT) 14.60	SIGN FRAME REQUIRED	REMARKS	SIGN DETAIL: DETAIL IN SHS	SIGN DETAIL: DETAIL ON SHEET NUMBER	SIGN DETAIL: DETAIL ON STD SHEET NUMBER
MOUNT TABOR US-7							FY-FLUORESCENT YELLOW FYG-FLUORESCENT YELLOW GREEN																				"SHS"-STANDARD HIGHWAY SIGNS			
NB	1.579	A	M3-1	24	12								1	X															
		A	M1-4	24	24								1																
		A	M3-1	24	12			2.00																		INSTALL NEW BLACK ON WHITE ROUTE MARKERS AND RETAIN SIGN POST.	X		
		A	M1-4	24	24			4.00																			X		
NB	1.627	A	R2-1	24	30								1	X																
		A	R2-1	24	30			5.00																			REPLACE SIGN AND RETAIN SIGN POST.	X		
NB	1.838	A	W2-2ML	30	30		LEFT SIDE ROAD W/SMALL SIDE						1		X														
	1.915	A	W2-2ML	30	30			6.25								1		15.0 X								INSTALL 300 FEET SOUTH OF GRIFFITH HILL RD(TH-7).		6	
NB	2.021	A	M3-1	24	12		NORTH						1		X														
		A	M1-4	24	24		US 7						1																
NB	2.062	A	R2-1	24	30		SPEED LIMIT 50						1		X														
NB	2.440	A	R2-5A	24	30		REDUCED SPEED AHEAD						1		X														
NB	2.478	A	VD-062B	72	16		BUSINESS SIGN			1				X															
NB	2.525	A	VD-062B	72	16		BUSINESS SIGN			1				X															
NB	2.572	A	VD-062AS	72	16		BUSINESS SIGN			1				X															
							SHEET TOTALS	17.25 SF	0.00 SF	3 EA	0 EA	0 EA	8 EA	0 EA	0 EA	1 EA		15 FT											
							TOWN DIRECTIONAL TOTALS	134.1	0.0	7.0	2.0	2.0	29	0.0	0.0	18		270.0											

SIGN SUMMARY SHEET

VERMONT AGENCY OF TRANSPORTATION

PROJECT NAME: **STATEWIDE - SOUTHWEST REGION**
PROJECT NUMBER: **STPG SIGN(32)**

FILE NAME: **MOUNT TABOR NB.XLS** PLOT DATE: **8/26/2010**
PROJECT MANAGER: **A. GAMBLE** DRAWN BY: **J. KELLY**
DESIGNED BY: **J. KELLY** CHECKED BY: **A. GAMBLE**
MOUNT TABOR NORTHBOUND SHEET 2 SHEET **64** OF **90**



DIRECTION	MILEPOINT	LOCATION CODE (SHEET 2)	SIGN CODE	WIDTH (IN)	HEIGHT (IN)	SHEETING REMARKS	SIGN LEGEND	NEW SIGNS "A"	NEW SIGNS "B"	EXISTING SIGNS RETAIN	EXISTING SIGNS SALVAGE FROM	EXISTING SIGNS SALVAGE TO	EXISTING SIGNS REMOVE	EXIST POST RETAIN	EXIST POST REMOVE	NUMBER OF NEW POSTS	SQUARE STEEL (IN) (LB / FT) 1.75 / 1.88	SQUARE STEEL (IN) (LB / FT) 2.00 / 2.42	SQUARE STEEL (IN) (LB / FT) 2.50 / 3.35	TUBULAR STEEL Ø (IN) FOUNDATION	TUBULAR STEEL Ø (IN) (LB / FT) 3.00 / 7.60	TUBULAR STEEL Ø (IN) (LB / FT) 3.50 / 9.00	TUBULAR STEEL Ø (IN) (LB / FT) 4.00 / 10.80	TUBULAR STEEL Ø (IN) (LB / FT) 5.00 / 14.60	SIGN FRAME REQUIRED	REMARKS	SIGN DETAIL: DETAIL IN SHS	SIGN DETAIL: DETAIL ON SHEET NUMBER	SIGN DETAIL: DETAIL ON STD SHEET NUMBER
MOUNT TABOR US-7							FY-FLUORESCENT YELLOW FYG-FLUORESCENT YELLOW GREEN																			"SHS"-STANDARD HIGHWAY SIGNS			
		A	VD-062AS	72	16		BUSINESS SIGN			1																		
NB	2.612	A	R2-1	24	30								1		X													
NB	2.620	A	R2-1	30	36			7.50								1		15.5 X									INSTALL 40 FEET NORTH OF EXISTING SL45 SIGN ASSEMBLY.		4	
NB	2.653	A	W11-2	30	30								1		X													
		A	VW-113	24	18		HANDICAPPED PERSON						1															
NB	2.660	A	W11-2	30	30	FYG		6.25								1		15.25 X									INSTALL 35 FEET NORTH OF EXISTING PEDESTRIAN ASSEMBLY.	X		
		A	W16-9P	24	12	FYG		2.00																				X		
NB	2.700	A	W2-1M	48	48								1		X													
		A	W13-1	24	24								1															
		A	W2-1M	48	48			16.00								2		17.0 17.25 X										6	
		A	W13-1	24	24			4.00																				X		
NB	2.822	D	R1-1	30	30								1		X												DEPOT RD. EXT. (TH-6)			
		D	R1-1	30	30			6.25								1		13.75 X										X		
		C	VR-017	24	30			5.00								~~1~~		~~X~~									INSTALL BACK TO BACK WITH STOP SIGN.		4	
			N/A				TOWN'S STREET NAME SIGN				1	1	1														REINSTALL TOWN'S STREET NAME SIGN ON TOP OF POST.			
							SHEET TOTALS	47.00	0.00	1	1	1	~~6~~ 7	0	0	~~6~~ 5		~~90~~ 78.75											
								SF	SF	EA	EA	EA	EA	EA	EA	EA		FT											
							TOWN DIRECTIONAL TOTALS	134.1	0.0	7.0	2.0	2.0	29	0.0	0.0	18		270.0											

SIGN SUMMARY SHEET

VERMONT AGENCY OF TRANSPORTATION

PROJECT NAME: **STATEWIDE - SOUTHWEST REGION**
PROJECT NUMBER: **STPG SIGN(32)**

FILE NAME: **MOUNT TABOR NB.XLS** PLOT DATE: **8/26/2010**
PROJECT MANAGER: **A. GAMBLE** DRAWN BY: **J. KELLY**
DESIGNED BY: **J. KELLY** CHECKED BY: **A. GAMBLE**
MOUNT TABOR NORTHBOUND SHEET 3 SHEET **65** OF **90**

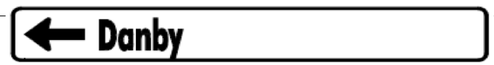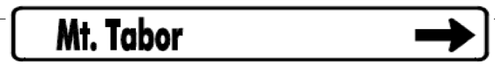DIRECTION	MILEPOINT	LOCATION CODE (SHEET 2)	SIGN CODE	WIDTH (IN)	HEIGHT (IN)	SHEETING REMARKS	SIGN LEGEND	NEW SIGNS "A"	NEW SIGNS "B"	EXISTING SIGNS RETAIN	EXISTING SIGNS SALVAGE FROM	EXISTING SIGNS SALVAGE TO	EXISTING SIGNS REMOVE	EXIST POST RETAIN	EXIST POST REMOVE	NUMBER OF NEW POSTS	SQUARE STEEL (IN) 1.75 (LB / FT) 1.88	SQUARE STEEL (IN) 2.00 (LB / FT) 2.42	SQUARE STEEL (IN) 2.50 (LB / FT) 3.35	TUBULAR STEEL Ø (IN) FOUNDATION	TUBULAR STEEL Ø (IN) 3.00 (LB / FT) 7.60	TUBULAR STEEL Ø (IN) 3.50 (LB / FT) 9.00	TUBULAR STEEL Ø (IN) 4.00 (LB / FT) 10.80	TUBULAR STEEL Ø (IN) 5.00 (LB / FT) 14.60	SIGN FRAME REQUIRED	REMARKS	SIGN DETAIL: DETAIL IN SHS	SIGN DETAIL: DETAIL ON SHEET NUMBER	SIGN DETAIL: DETAIL ON STD SHEET NUMBER
MOUNT TABOR US-7							FY-FLUORESCENT YELLOW FYG-FLUORESCENT YELLOW GREEN																			"SHS"-STANDARD HIGHWAY SIGNS			
NB	2.863	A	D1-1	72	10								1		X														
		A	D1-1	72	10								1																
		A	D1-1	72	12			6.00								2		14.5 15.0 X									5	
		A	D1-1	72	12			6.00																					
NB	2.931	C	VR-017	24	30								1		X												BROOKLYN ST. (TH-1)			
		C	VR-017	24	30			5.00								1		13.25 X									4	
NB	2.938	D	R1-1	30	30								1		X												BROOKLYN ST. (TH-1)			
		D	R1-1	30	30			6.25								1		13.5 X									X	
			N/A				TOWN'S STREET NAME SIGN				1	1	1													INSTALL TOWN'S STREET NAME SIGN ON TOP OF POST.			
NB	2.986	A	M3-1	24	12								1	X															
		A	M1-4	24	24								1																
		A	M3-1	24	12			2.00																		REPLACE BLACK ON WHITE ROUTE MARKERS AND RETAIN SIGN POST.	X		
		A	M1-4	24	24			4.00																			X		
NB	2.992	A	OM-3R	12	36								1		X															
		A	OM-3R	12	36			3.00								1		11.0 X									X		
SIGN SUMMARY SHEET							SHEET TOTALS	32.25	0.00	0	1	1	~~8~~ 7	0	0	5		~~75~~ 67.25											
								SF	SF	EA	EA	EA	EA	EA	EA	EA		FT											
VERMONT AGENCY OF TRANSPORTATION							TOWN DIRECTIONAL TOTALS	134.1	0.0	7.0	2.0	2.0	29	0.0	0.0	18		270.0											

PROJECT NAME: **STATEWIDE - SOUTHWEST REGION**
PROJECT NUMBER: **STPG SIGN(32)**

FILE NAME: **MOUNT TABOR NB.XLS** PLOT DATE: **8/26/2010**
PROJECT MANAGER: **A. GAMBLE** DRAWN BY: **J. KELLY**
DESIGNED BY: **J. KELLY** CHECKED BY: **A. GAMBLE**
MOUNT TABOR NORTHBOUND SHEET 4 SHEET **66** OF **90**

DIRECTION	MILEPOINT	LOCATION CODE (SHEET 2)	SIGN CODE	WIDTH (IN)	HEIGHT (IN)	SHEETING REMARKS	SIGN LEGEND	NEW SIGNS "A"	NEW SIGNS "B"	EXISTING SIGNS RETAIN	EXISTING SIGNS SALVAGE FROM	EXISTING SIGNS SALVAGE TO	EXISTING SIGNS REMOVE	EXIST POST RETAIN	EXIST POST REMOVE	NUMBER OF NEW POSTS	SQUARE STEEL (IN) 1.75 (LB/FT) 1.88	SQUARE STEEL (IN) 2.00 (LB/FT) 2.42	SQUARE STEEL (IN) 2.50 (LB/FT) 3.35	TUBULAR STEEL Ø (IN) FOUNDATION	TUBULAR STEEL Ø (IN) 3.00 (LB/FT) 7.60	TUBULAR STEEL Ø (IN) 3.50 (LB/FT) 9.00	TUBULAR STEEL Ø (IN) 4.00 (LB/FT) 10.80	TUBULAR STEEL Ø (IN) 5.00 (LB/FT) 14.60	SIGN FRAME REQUIRED	REMARKS	SIGN DETAIL: DETAIL IN SHS	SIGN DETAIL: DETAIL ON SHEET NUMBER	SIGN DETAIL: DETAIL ON STD SHEET NUMBER
MOUNT TABOR US-7							FY-FLUORESCENT YELLOW FYG-FLUORESCENT YELLOW GREEN																			"SHS"-STANDARD HIGHWAY SIGNS			
NB	3.009	B	OM-3L	12	36								1		X														
		B	OM-3L	12	36			3.00								1		11.0 X										X		
NB	3.155	A	R2-1	24	30		SPEED LIMIT 50						1		X														
NB	3.180	A	R2-1	24	30		 	5.00								1		15.5 X									INSTALL BACK TO BACK 130 FEET NORTH OF EXISTING SPEED LIMIT 50 SIGN.	X		
		B	R2-1	30	36			7.50																					4	
NB	3.180	A	R2-1	24	30						1		2		X												NEW SIGNS HAD TO BE MOVED AFTER INSTALLATION			
		B	R2-1	30	36						1																		
NB	3.190	A	R2-1	24	30							1				1		15.5 X												
		B	R2-1	30	36							1																		
SB	3.180	F	R2-1	30	36						1		1		X												NEW SIGNS HAD TO BE MOVED AFTER INSTALLATION			
SB	3.190	F	R2-1	30	36							1				1		15.5 X												
							SHEET TOTALS	15.50	0.00	0	~~3~~ 0	~~3~~ 0	~~5~~ 2	0	0	~~4~~ 2		~~30~~ 57.5												
								SF	SF	EA	EA	EA	EA	EA	EA	EA		FT												
							TOWN DIRECTIONAL TOTALS	134.1	0.0	7.0	~~5.0~~ 2.0	~~5.0~~ 2.0	~~37~~ 29	0.0	0.0	~~19~~ 18		~~274.0~~ 270.0												

SIGN SUMMARY SHEET

VERMONT AGENCY OF TRANSPORTATION

PROJECT NAME: STATEWIDE - SOUTHWEST REGION
PROJECT NUMBER: STPG SIGN(32)

FILE NAME: MOUNT TABOR NB.XLS
PROJECT MANAGER: A. GAMBLE
DESIGNED BY: J. KELLY
MOUNT TABOR NORTHBOUND SHEET 5

PLOT DATE: 8/26/2010
DRAWN BY: J. KELLY
CHECKED BY: A. GAMBLE
SHEET 67 OF 90



DIRECTION	MILEPOINT	LOCATION CODE (SHEET 2)	SIGN CODE	WIDTH (IN)	HEIGHT (IN)	SHEETING REMARKS	SIGN LEGEND	NEW SIGNS "A"	NEW SIGNS "B"	EXISTING SIGNS RETAIN	EXISTING SIGNS SALVAGE FROM	EXISTING SIGNS SALVAGE TO	EXISTING SIGNS REMOVE	EXIST POST RETAIN	EXIST POST REMOVE	NUMBER OF NEW POSTS	SQUARE STEEL (IN) 1.75 (LB / FT) 1.88	SQUARE STEEL (IN) 2.00 (LB / FT) 2.42	SQUARE STEEL (IN) 2.50 (LB / FT) 3.35	FOUNDATION	TUBULAR STEEL Ø (IN) 3.00 (LB / FT) 7.60	TUBULAR STEEL Ø (IN) 3.50 (LB / FT) 9.00	TUBULAR STEEL Ø (IN) 4.00 (LB / FT) 10.80	TUBULAR STEEL Ø (IN) 5.00 (LB / FT) 14.60	SIGN FRAME REQUIRED	REMARKS	SIGN DETAIL: DETAIL IN SHS	SIGN DETAIL: DETAIL ON SHEET NUMBER	SIGN DETAIL: DETAIL ON STD SHEET NUMBER
MOUNT TABOR US-7							FY-FLUORESCENT YELLOW FYG-FLUORESCENT YELLOW GREEN																				"SHS"-STANDARD HIGHWAY SIGNS			
SB	3.360	F	R2-5A	24	30		REDUCED SPEED AHEAD						1		X														
SB	3.310	F	VD-062AS	72	16		BUSINESS SIGN			1				X															
		F	VD-062AS	72	16		BUSINESS SIGN			1																			
SB	3.270	F	VD-062B	72	16		BUSINESS SIGN			1				X															
SB	3.230	F	VD-062B	72	16		BUSINESS SIGN			1				X															
* SB	3.180	F	R2-1	30	36		SPEED LIMIT 45	7.50								1		15.5 X									INSTALL 60 FEET NORTH OF EXISTING AND DIRECTLY ACROSS FROM NB SL-50. *		4	
SB	3.163	F	R2-1	24	30		SPEED LIMIT 45						1		X												REFER TO SHEET 67 OF 90			
SB	3.105	F	W11-2	30	30								1																
		F	VW-113	24	18		HANDICAPPED PERSON AHEAD						1																
		F	W11-2	30	30	FYG		6.25								1		15.0 X										X	
		F	W16-9P	24	12	FYG		2.00																				X	
SB	3.057	F	W2-1M	48	48								1		X														
		F	W13-1	24	24								1																
		F	W2-1M	48	48		40 M.P.H.	16.00								2		17.0 17.25 X										6	
		F	W13-1	24	24			4.00																				X	
							SHEET TOTALS	35.75 SF	0.00 SF	4 EA	0 EA	0 EA	6 EA	0 EA	0 EA	4 EA		~~60~~ 64.75 FT											
							TOWN DIRECTIONAL TOTALS	173.3	0.0	7.0	2.0	2.0	32	0.0	0.0	17		255.0											

SIGN SUMMARY SHEET

VERMONT AGENCY OF TRANSPORTATION

PROJECT NAME: **STATEWIDE - SOUTHWEST REGION**
PROJECT NUMBER: **STPG SIGN(32)**

FILE NAME: **MOUNT TABOR SB.XLS** PLOT DATE: **8/26/2010**
PROJECT MANAGER: **A. GAMBLE** DRAWN BY: **J. KELLY**
DESIGNED BY: **J. KELLY** CHECKED BY: **A. GAMBLE**
MOUNT TABOR SOUTHBOUND SHEET 1 SHEET **68** OF **90**

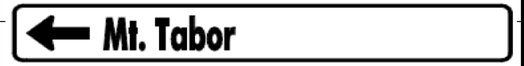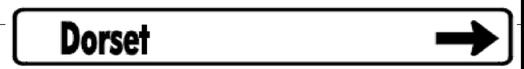DIRECTION	MILEPOINT	LOCATION CODE (SHEET 2)	SIGN CODE	WIDTH (IN)	HEIGHT (IN)	SHEETING REMARKS	SIGN LEGEND	NEW SIGNS "A"	NEW SIGNS "B"	EXISTING SIGNS RETAIN	EXISTING SIGNS SALVAGE FROM	EXISTING SIGNS SALVAGE TO	EXISTING SIGNS REMOVE	EXIST POST RETAIN	EXIST POST REMOVE	NUMBER OF NEW POSTS	SQUARE STEEL (IN) 1.75 (LB/FT) 1.88	SQUARE STEEL (IN) 2.00 (LB/FT) 2.42	SQUARE STEEL (IN) 2.50 (LB/FT) 3.35	TUBULAR STEEL Ø (IN) FOUNDATION	TUBULAR STEEL Ø (IN) 3.00 (LB/FT) 7.60	TUBULAR STEEL Ø (IN) 3.50 (LB/FT) 9.00	TUBULAR STEEL Ø (IN) 4.00 (LB/FT) 10.80	TUBULAR STEEL Ø (IN) 5.00 (LB/FT) 14.60	SIGN FRAME REQUIRED	REMARKS	SIGN DETAIL: DETAIL IN SHS	SIGN DETAIL: DETAIL ON SHEET NUMBER	SIGN DETAIL: DETAIL ON STD SHEET NUMBER
MOUNT TABOR US-7							FY-FLUORESCENT YELLOW FYG-FLUORESCENT YELLOW GREEN																			"SHS"-STANDARD HIGHWAY SIGNS			
SB	3.025	F	D1-1	72	10								1		X													
		F	D1-1	72	10								1															
		F	D1-1	72	12			6.00								2		13.5 14.25 X								5	
		F	D1-1	72	12			6.00																		SIGN SHOULD READ DANBY		5	
SB	3.003	F	OM-3R	12	36								1		X													
		F	OM-3R	12	36			3.00								1		11.0 X									X	
SB	2.985	E	OM-3L	12	36								1		X													
		E	OM-3L	12	36			3.00								1		11.0 X									X	
SB	2.929	G	VR-017	24	30								1	X												MT. TABOR AVE. (TH-1)			
		G	VR-017	24	30			5.00																		REPLACE SIGN AND RETAIN SIGN POST.		4	
SB	2.921	H	R1-1	30	30								2 ~~1~~													MT. TABOR AVE. (TH-1)			
		H	R1-1	30	30			6.25			1	1		X	1		13.5 X								REPLACE SIGN AND RETAIN SIGN POST. NEW POST WAS INSTALLED	X		
SB	2.817	G	VR-017	24	30			5.00								1		14.5 X										4	
SB	2.810	H	R1-1	30	30						1	1	2 ~~1~~		X											DEPOT RD. (TH-6)			
		H	R1-1	30	30			6.25								1		13.5 X								DEPOT RD SIGN WAS SALVAGED	X		
SIGN SUMMARY SHEET							SHEET TOTALS	40.50	0.00	0	~~2 0~~	~~2 0~~	~~9 7~~	0	0	~~7 6~~		~~90~~ 91.25											
								SF	SF	EA	EA	EA	EA	EA	EA	EA		FT											
VERMONT AGENCY OF TRANSPORTATION							TOWN DIRECTIONAL TOTALS	173.3	0.0	7.0	2.0	2.0	32	0.0	0.0	17		255.0											

PROJECT NAME: STATEWIDE - SOUTHWEST REGION
PROJECT NUMBER: STPG SIGN(32)
FILE NAME: MOUNT TABOR SB.XLS
PROJECT MANAGER: A. GAMBLE
DESIGNED BY: J. KELLY
PLOT DATE: 8/26/2010
DRAWN BY: J. KELLY
CHECKED BY: A. GAMBLE
MOUNT TABOR SOUTHBOUND SHEET 2

DIRECTION	MILEPOINT	LOCATION CODE (SHEET 2)	SIGN CODE	WIDTH (IN)	HEIGHT (IN)	SHEETING REMARKS	SIGN LEGEND	NEW SIGNS "A"	NEW SIGNS "B"	EXISTING SIGNS RETAIN	EXISTING SIGNS SALVAGE FROM	EXISTING SIGNS SALVAGE TO	EXISTING SIGNS REMOVE	EXIST POST RETAIN	EXIST POST REMOVE	NUMBER OF NEW POSTS	SQUARE STEEL (IN) 1.75 (LB / FT) 1.88	SQUARE STEEL (IN) 2.00 (LB / FT) 2.42	SQUARE STEEL (IN) 2.50 (LB / FT) 3.35	FOUNDATION	TUBULAR STEEL Ø (IN) 3.00 (LB / FT) 7.60	TUBULAR STEEL Ø (IN) 3.50 (LB / FT) 9.00	TUBULAR STEEL Ø (IN) 4.00 (LB / FT) 10.80	TUBULAR STEEL Ø (IN) 5.00 (LB / FT) 14.60	SIGN FRAME REQUIRED	REMARKS	SIGN DETAIL: DETAIL IN SHS	SIGN DETAIL: DETAIL ON SHEET NUMBER	SIGN DETAIL: DETAIL ON STD SHEET NUMBER
MOUNT TABOR US-7							FY-FLUORESCENT YELLOW FYG-FLUORESCENT YELLOW GREEN																				"SHS"-STANDARD HIGHWAY SIGNS			
SB	2.733	F	M3-3	24	12								1		X														
		F	M1-4	24	24								1																
		F	M3-3	24	12		SOUTH 7	2.00								1		15.5 X								BLACK ON WHITE ROUTE MARKERS.	X		
		F	M1-4	24	24			4.00																			X		
SB	2.620	F	R2-1	24	30		SPEED LIMIT 50 / SPEED LIMIT 45	5.00								1		15.0 X								INSTALL 60 FEET NORTH OF EXISTING AND DIRECTLY ACROSS FROM THE NEW NB SL-45 SIGN ASSEMBLY.	X		
		E	R2-1	30	36			7.50																				4	
SB	2.609	F	R2-1	24	30								1		X												REMOVE 2.60 MM SIGN.			
SB	2.102	F	W2-2RM	30	30		RIGHT SIDE ROAD W/SMALL SIDE						1		X														
	2.032	F	W2-2RM	30	30			6.25								1		15.5 X								INSTALL 300 FEET NORTH OF GRIFFITH HILL RD. (TH-7).		6	
SB	1.977	G	VR-017	24	30		LEGAL LOAD LIMIT 24,000 POUNDS	5.00								1		14.75 X								GRIFFITH HILL RD. (TH-7)		4	
SB	1.966	H	R1-1	30	30								1		X												GRIFFITH HILL RD. (TH-7)			
		H	R1-1	30	30		STOP	6.25								1		14.0 X									X		
			N/A				TOWN'S STREET NAME SIGN				1	1	1														REINSTALL TOWN'S STREET NAME SIGN ON TOP OF NEW POST.			
SB	1.850	G	VR-023B	24	30		$500 FINE FOR THROWING TRASH ON HIGHWAYS						1		X														
SB	1.642	F	W10-3L	36	36		LEFT SIDE ROAD W/TRACKS			1				X															
							SHEET TOTALS	36.00	0.00	1	1	1	~~6~~ 7	0	0	5		~~75~~ 74.75 FT											
								SF	SF	EA	EA	EA	EA	EA	EA	EA													
							TOWN DIRECTIONAL TOTALS	173.3	0.0	7.0	2.0	2.0	32	0.0	0.0	17		255.0											

SIGN SUMMARY SHEET

VERMONT AGENCY OF TRANSPORTATION

PROJECT NAME: **STATEWIDE - SOUTHWEST REGION**
PROJECT NUMBER: **STPG SIGN(32)**

FILE NAME: **MOUNT TABOR SB.XLS** PLOT DATE: **8/26/2010**
PROJECT MANAGER: **A. GAMBLE** DRAWN BY: **J. KELLY**
DESIGNED BY: **J. KELLY** CHECKED BY: **A. GAMBLE**
MOUNT TABOR SOUTHBOUND SHEET 3 SHEET **70** OF **90**

DIRECTION	MILEPOINT	LOCATION CODE (SHEET 2)	SIGN CODE	WIDTH (IN)	HEIGHT (IN)	SHEETING REMARKS	SIGN LEGEND	NEW SIGNS "A"	NEW SIGNS "B"	EXISTING SIGNS RETAIN	EXISTING SIGNS SALVAGE FROM	EXISTING SIGNS SALVAGE TO	EXISTING SIGNS REMOVE	EXIST POST RETAIN	EXIST POST REMOVE	NUMBER OF NEW POSTS	SQUARE STEEL (IN) 1.75 (LB / FT) 1.88	SQUARE STEEL (IN) 2.00 (LB / FT) 2.42	SQUARE STEEL (IN) 2.50 (LB / FT) 3.35	TUBULAR STEEL Ø (IN) FOUNDATION	TUBULAR STEEL Ø (IN) 3.00 (LB / FT) 7.60	TUBULAR STEEL Ø (IN) 3.50 (LB / FT) 9.00	TUBULAR STEEL Ø (IN) 4.00 (LB / FT) 10.80	TUBULAR STEEL Ø (IN) 5.00 (LB / FT) 14.60	SIGN FRAME REQUIRED	REMARKS	SIGN DETAIL: DETAIL IN SHS	SIGN DETAIL: DETAIL ON SHEET NUMBER	SIGN DETAIL: DETAIL ON STD SHEET NUMBER
MOUNT TABOR US-7							FY-FLUORESCENT YELLOW FYG-FLUORESCENT YELLOW GREEN																				"SHS"-STANDARD HIGHWAY SIGNS			
SB	1.283	G	VR-017	24	30								1	X													TROLL HILL RD. (TH-8)			
		G	VR-017	24	30			5.00																			REPLACE SIGN AND RETAIN SIGN POST.		4	
SB	1.286	H	R1-1	30	30								1	X													TROLL HILL RD. (TH-8)			
		H	R1-1	30	30			6.25																			REPLACE SIGN AND RETAIN SIGN POST.	X		
SB	1.224	G	VR-017	24	30								1	X													MARBLE SWITCH RD. (TH-10)			
		G	VR-017	24	30			5.00																			REPLACE SIGN AND RETAIN SIGN POST.		4	
SB	1.215	H	R1-1	30	30								1	X													MARBLE SWITCH RD. (TH-10)			
		H	R1-1	30	30			6.25																			REPLACE SIGN AND RETAIN SIGN POST.	X		
SB	1.206	F	M3-3	24	12		SOUTH						1		X															
SB	1.157	F	R2-1	24	30								1	X																
		F	R2-1	24	30			5.00																			REPLACE SIGN AND RETAIN SIGN POST.	X		
SB	0.970	F	W10-2L	36	36		CROSSROAD W/TRACKS LEFT			1				X															
SB	0.901	F	VD-062B	72	16		BUSINESS SIGN			1				X															
SB	0.834	G	VR-017	24	30								1	X													SOUTH END RD. EXT. (TH-9)			
		G	VR-017	24	30			5.00																			REPLACE SIGN AND RETAIN SIGN POST. TRIM BRUSH.		4	
							SHEET TOTALS	32.50	0.00	2	0	0	7	0	0	0	0												
								SF	SF	EA	EA	EA	EA	EA	EA	EA	FT												
							TOWN DIRECTIONAL TOTALS	173.3	0.0	7.0	2.0	2.0	32	0.0	0.0	17	255.0												

SIGN SUMMARY SHEET

VERMONT AGENCY OF TRANSPORTATION

PROJECT NAME: **STATEWIDE - SOUTHWEST REGION**
PROJECT NUMBER: **STPG SIGN(32)**

FILE NAME: **MOUNT TABOR SB.XLS** PLOT DATE: **8/26/2010**
PROJECT MANAGER: **A. GAMBLE** DRAWN BY: **J. KELLY**
DESIGNED BY: **J. KELLY** CHECKED BY: **A. GAMBLE**
MOUNT TABOR SOUTHBOUND SHEET 4 SHEET **71** OF **90**

DIRECTION	MILEPOINT	LOCATION CODE (SHEET 2)	SIGN CODE	WIDTH (IN)	HEIGHT (IN)	SHEETING REMARKS	SIGN LEGEND	NEW SIGNS "A"	NEW SIGNS "B"	EXISTING SIGNS RETAIN	EXISTING SIGNS SALVAGE FROM	EXISTING SIGNS SALVAGE TO	EXISTING SIGNS REMOVE	EXIST POST RETAIN	EXIST POST REMOVE	NUMBER OF NEW POSTS	SQUARE STEEL (IN) 1.75 (LB/FT) 1.88	SQUARE STEEL (IN) 2.00 (LB/FT) 2.42	SQUARE STEEL (IN) 2.50 (LB/FT) 3.35	TUBULAR STEEL Ø (IN) FOUNDATION	TUBULAR STEEL Ø (IN) 3.00 (LB/FT) 7.60	TUBULAR STEEL Ø (IN) 3.50 (LB/FT) 9.00	TUBULAR STEEL Ø (IN) 4.00 (LB/FT) 10.80	TUBULAR STEEL Ø (IN) 5.00 (LB/FT) 14.60	SIGN FRAME REQUIRED	REMARKS	SIGN DETAIL: DETAIL IN SHS	SIGN DETAIL: DETAIL ON SHEET NUMBER	SIGN DETAIL: DETAIL ON STD SHEET NUMBER
MOUNT TABOR US-7							FY-FLUORESCENT YELLOW FYG-FLUORESCENT YELLOW GREEN																				"SHS"-STANDARD HIGHWAY SIGNS			
SB	0.826	H	R1-1	30	30								1	X													SOUTH END RD. EXT. (TH-9)			
		H	R1-1	30	30			6.25																			REPLACE SIGN AND RETAIN SIGN POST. TRIM BRUSH.	X		
SB	0.719	G	VR-017	24	30								1		X												TROLL HILL RD. (TH-8)			
		G	VR-017	24	30			5.00								1		15.5 X											4	
		G	N/A	18	24		TOWN'S SPEED LIMIT 30 SIGN				1	1	1														REINSTALL TOWN'S SPEED LIMIT 30 SIGN BELOW NEW LL24K SIGN.			
SB	0.713	H	R1-1	30	30								1		X												TROLL HILL RD. (TH-8)			
		H	R1-1	30	30			6.25								1		13.5 X										X	
SB	0.677	F	M3-3	24	12								1	X																
		F	M1-4	24	24								1																	
		F	M3-3	24	12			2.00																		REPLACE BLACK ON WHITE ROUTE MARKERS AND RETAIN SIGN POST.	X		
		F	M1-4	24	24			4.00																				X		
SB	0.633	F	R2-1	24	30								1	X																
		F	R2-1	24	30			5.00																			REPLACE SIGN AND RETAIN SIGN POST.	X		
SB	3.025	F	DI-1	72	12		DANBY ⟶	6.00					1																	
SB	1.224	G	VR-017	24	30		LLL	—			1	1	1			1		14.25 X									SIGN WAS INSTALLED ON 7-20-11 BUT POST WAS DAMAGED.			
							SHEET TOTALS	34.50 ~~28.50~~ SF	0.00 SF	0 EA	2 ~~1~~ EA	2 ~~1~~ EA	9 ~~6~~ EA	0 EA	0 EA	3 ~~2~~ EA		~~30~~ 43.25 FT										
							TOWN DIRECTIONAL TOTALS	179.25 ~~173.3~~ SF	0.0 SF	7.0 EA	5.0 ~~2.0~~ EA	5.0 ~~2.0~~ EA	38 ~~32~~ EA	0.0 EA	0.0 EA	19 ~~17~~ EA		274.0 ~~255.0~~ FT										

SIGN SUMMARY SHEET

VERMONT AGENCY OF TRANSPORTATION

PROJECT NAME: **STATEWIDE - SOUTHWEST REGION**
PROJECT NUMBER: **STPG SIGN(32)**

FILE NAME: **MOUNT TABOR SB.XLS** PLOT DATE: **8/26/2010**
PROJECT MANAGER: **A. GAMBLE** DRAWN BY: **J. KELLY**
DESIGNED BY: **J. KELLY** CHECKED BY: **A. GAMBLE**
MOUNT TABOR SOUTHBOUND SHEET 5 SHEET **72** OF **90**

DIRECTION	MILEPOINT	LOCATION CODE (SHEET 2)	SIGN CODE	WIDTH (IN)	HEIGHT (IN)	SHEETING REMARKS	SIGN LEGEND	NEW SIGNS "A"	NEW SIGNS "B"	EXISTING SIGNS RETAIN	EXISTING SIGNS SALVAGE FROM	EXISTING SIGNS SALVAGE TO	EXISTING SIGNS REMOVE	EXIST POST RETAIN	EXIST POST REMOVE	NUMBER OF NEW POSTS	SQUARE STEEL (IN) 1.75 (LB / FT) 1.88	SQUARE STEEL (IN) 2.00 (LB / FT) 2.42	SQUARE STEEL (IN) 2.50 (LB / FT) 3.35	FOUNDATION	TUBULAR STEEL Ø (IN) 3.00 (LB / FT) 7.60	TUBULAR STEEL Ø (IN) 3.50 (LB / FT) 9.00	TUBULAR STEEL Ø (IN) 4.00 (LB / FT) 10.80	TUBULAR STEEL Ø (IN) 5.00 (LB / FT) 14.60	SIGN FRAME REQUIRED	REMARKS	SIGN DETAIL: DETAIL IN SHS	SIGN DETAIL: DETAIL ON SHEET NUMBER	SIGN DETAIL: DETAIL ON STD SHEET NUMBER
DANBY US-7							FY-FLUORESCENT YELLOW FYG-FLUORESCENT YELLOW GREEN																			"SHS"-STANDARD HIGHWAY SIGNS			
NB	0.000	C	VD-024	60	7.5								3 ~~1~~		X														
		C	VD-024	72	10		Danby / Mt. Tabor	5.00								2		12.75 12.75 X										4	
		C	VD-700	6	10		0070 1106 0000 / 0070 1113 0418	0.42																		INSTALL ON LH POST BELOW DANBY			E-138
		C	VD-700	6	10			0.42																		INSTALL ON RH POST BELOW MT. TABOR			E-138
NB	0.600	A	VW-619	36	36		SHOULDER NARROWS	9.00								2		15.0 15.25 X								INSTALL AT 0.60 MILE MARKER.		6	
NB	0.700	A	VW-205	36	36		WATCH FOR TURNING VEHICLES	9.00								2		15.0 16.0 X								INSTALL 525 FEET NORTH OF NEW SHOULDER NARROWS SIGN		6	
NB	1.260	B	VW-205	48	48		WATCH FOR TURNING VEHICLES						1		X											REMOVE 0125 MILE MARKER			
NB	1.577	A	M3-1	24	12								1	X															
		A	M1-4	18	18								1																
		A	M3-1	24	12		NORTH 7	2.00																		REPLACE BLACK ON WHITE ROUTE MARKERS AND RETAIN SIGN POST.	X		
		A	M1-4	18	18			4.00																			X		
NB	1.663	A	R2-1	24	30		SPEED LIMIT 50						1	X															
		A	R2-1	24	30			5.00																		REPLACE SIGN AND RETAIN SIGN POST.	X		
NB	2.088	A	VW-081L	30	30		TRUCKS ENTERING LEFT						1		X														
		A	VW-081L	30	30			6.25								1		14.0 X										6	
							SHEET TOTALS	41.09	0.00	0	0	0	~~8~~ ~~6~~	0	0	7		~~105~~ 100.75											
								SF	SF	EA	EA	EA	EA	EA	EA	EA		FT											
							TOWN DIRECTIONAL TOTALS	50.1	0.0	0.0	0.0	0.0	7	0.0	0.0	9		135.0											

SIGN SUMMARY SHEET

VERMONT AGENCY OF TRANSPORTATION

PROJECT NAME: STATEWIDE - SOUTHWEST REGION
PROJECT NUMBER: STPG SIGN(32)

FILE NAME: DANBY NB.XLS
PROJECT MANAGER: A. GAMBLE
DESIGNED BY: J. KELLY
DANBY NORTHBOUND SHEET 1

PLOT DATE: 7/13/2010
DRAWN BY: J. KELLY
CHECKED BY: A. GAMBLE
SHEET 73 OF 90

DIRECTION	MILEPOINT	LOCATION CODE (SHEET 2)	SIGN CODE	WIDTH (IN)	HEIGHT (IN)	SHEETING REMARKS	SIGN LEGEND	NEW SIGNS "A"	NEW SIGNS "B"	EXISTING SIGNS RETAIN	EXISTING SIGNS SALVAGE FROM	EXISTING SIGNS SALVAGE TO	EXISTING SIGNS REMOVE	EXIST POST RETAIN	EXIST POST REMOVE	NUMBER OF NEW POSTS	SQUARE STEEL (IN) 1.75 (LB/FT) 1.88	SQUARE STEEL (IN) 2.00 (LB/FT) 2.42	SQUARE STEEL (IN) 2.50 (LB/FT) 3.35	TUBULAR STEEL Ø (IN) FOUNDATION	TUBULAR STEEL Ø (IN) 3.00 (LB/FT) 7.60	TUBULAR STEEL Ø (IN) 3.50 (LB/FT) 9.00	TUBULAR STEEL Ø (IN) 4.00 (LB/FT) 10.80	TUBULAR STEEL Ø (IN) 5.00 (LB/FT) 14.60	SIGN FRAME REQUIRED	REMARKS	SIGN DETAIL: DETAIL IN SHS	SIGN DETAIL: DETAIL ON SHEET NUMBER	SIGN DETAIL: DETAIL ON STD SHEET NUMBER
DANBY US-7							FY-FLUORESCENT YELLOW FYG-FLUORESCENT YELLOW GREEN																				"SHS"-STANDARD HIGHWAY SIGNS			
NB	2.407	A	VW-619	36	36		SHOULDER NARROWS						1		X														
		A	VW-619	36	36			9.00								2		~~15.5~~ 16.5 X											6	

DIRECTION	MILEPOINT	LOCATION CODE (SHEET 2)	SIGN CODE	WIDTH (IN)	HEIGHT (IN)	SHEETING REMARKS	SIGN LEGEND	NEW SIGNS "A"	NEW SIGNS "B"	EXISTING SIGNS RETAIN	EXISTING SIGNS SALVAGE FROM	EXISTING SIGNS SALVAGE TO	EXISTING SIGNS REMOVE	EXIST POST RETAIN	EXIST POST REMOVE	NUMBER OF NEW POSTS	SQUARE STEEL (IN) 1.75 (LB / FT) 1.88	SQUARE STEEL (IN) 2.00 (LB / FT) 2.42	SQUARE STEEL (IN) 2.50 (LB / FT) 3.35	TUBULAR STEEL Ø (IN) FOUNDATION	TUBULAR STEEL Ø (IN) 3.00 (LB / FT) 7.60	TUBULAR STEEL Ø (IN) 3.50 (LB / FT) 9.00	TUBULAR STEEL Ø (IN) 4.00 (LB / FT) 10.80	TUBULAR STEEL Ø (IN) 5.00 (LB / FT) 14.60	SIGN FRAME REQUIRED	REMARKS	SIGN DETAIL: DETAIL IN SHS	SIGN DETAIL: DETAIL ON SHEET NUMBER	SIGN DETAIL: DETAIL ON STD SHEET NUMBER
DANBY US-7							FY-FLUORESCENT YELLOW FYG-FLUORESCENT YELLOW GREEN																			"SHS"-STANDARD HIGHWAY SIGNS			
SB	2.355	F	VW-081R	30	30		TRUCKS ENTERING RIGHT						1		X														
		F	VW-081R	30	30		SPEED LIMIT 50	6.25								1		14.75 X										6	
SB	1.785	F	R2-1	24	30			5.00								1		14.0 X								INSTALL AT 1.80 MILE MARKER.	X		
SB	1.445	G	VR-017	24	30		LEGAL LOAD LIMIT 24,000 POUNDS						1		X											SCOTTSVILLE RD. (TH-3)			
		G	VR-017	24	30			5.00								1		13.25 X										4	
SB	1.437	H	R1-1	30	30		STOP						1		X											SCOTTSVILLE RD. (TH-3)			
		H	R1-1	30	30			6.25								1		14.0 X									X		
SB	1.253	F	VW-205	48	48		WATCH FOR TURNING VEHICLES						1		X														
		F	VW-205	36	36			9.00								2		14.0 14.0 X										6	
SB	1.044	G	VR-017	24	30		LEGAL LOAD LIMIT 24,000 POUNDS						1		X											CASCADE RD (TH-19)			
		G	VR-017	24	30			5.00								1		13.25 X										4	
SB	1.025	H	R1-1	30	30		STOP						1		X											CASCADE RD (TH-19)			
		H	R1-1	30	30			6.25								1		13.25 X									X		
SB	1.014	F	M3-3	24	12								1		X														
			M1-4	24	24								1																
							SHEET TOTALS	42.75 SF	0.00 SF	0 EA	0 EA	0 EA	8 EA	0 EA	0 EA	8 EA		~~120~~ 110.5 FT											
							TOWN DIRECTIONAL TOTALS	65.0	0.0	0.0	0.0	0.0	11	0.0	0.0	12		180.0											

SIGN SUMMARY SHEET

VERMONT AGENCY OF TRANSPORTATION

PROJECT NAME: STATEWIDE - SOUTHWEST REGION
PROJECT NUMBER: STPG SIGN(32)

FILE NAME: DANBY SB.XLS
PROJECT MANAGER: A. GAMBLE
DESIGNED BY: J. KELLY
DANBY SOUTHBOUND SHEET 1

PLOT DATE: 7/13/2010
DRAWN BY: J. KELLY
CHECKED BY: A. GAMBLE
SHEET 75 OF 90

DIRECTION	MILEPOINT	LOCATION CODE (SHEET 2)	SIGN CODE	WIDTH (IN)	HEIGHT (IN)	SHEETING REMARKS	SIGN LEGEND	NEW SIGNS "A"	NEW SIGNS "B"	EXISTING SIGNS RETAIN	EXISTING SIGNS SALVAGE FROM	EXISTING SIGNS SALVAGE TO	EXISTING SIGNS REMOVE	EXIST POST RETAIN	EXIST POST REMOVE	NUMBER OF NEW POSTS	SQUARE STEEL (IN) 1.75 (LB / FT) 1.88	SQUARE STEEL (IN) 2.00 (LB / FT) 2.42	SQUARE STEEL (IN) 2.50 (LB / FT) 3.35	TUBULAR STEEL Ø (IN) FOUNDATION	TUBULAR STEEL Ø (IN) 3.00 (LB / FT) 7.60	TUBULAR STEEL Ø (IN) 3.50 (LB / FT) 9.00	TUBULAR STEEL Ø (IN) 4.00 (LB / FT) 10.80	TUBULAR STEEL Ø (IN) 5.00 (LB / FT) 14.60	SIGN FRAME REQUIRED	REMARKS	SIGN DETAIL: DETAIL IN SHS	SIGN DETAIL: DETAIL ON SHEET NUMBER	SIGN DETAIL: DETAIL ON STD SHEET NUMBER
DANBY US-7							FY-FLUORESCENT YELLOW FYG-FLUORESCENT YELLOW GREEN																				"SHS"-STANDARD HIGHWAY SIGNS			
			M3-3	24	12			2.00								1		14.0 X								BLACK ON WHITE ROUTE MARKERS	X		
			M1-4	24	24			4.00																				X		
SB	0.942	F	R2-1	24	30								1		X															
SB	0.910	F	R2-1	24	30			5.00								1		14.25 X								INSTALL 160 FEET SOUTH OF EXISTING SPEED LIMIT 50 SIGN.	X		
SB	0.432	G	VR-017	24	30								1		X												RAYMOND RD. (TH-21)			
		G	VR-017	24	30			5.00								1		13.25 X										4	
SB	0.422	H	R1-1	30	30								1		X												RAYMOND RD. (TH-21)			
		H	R1-1	30	30			6.25								1		13.25 X									X		
							SHEET TOTALS	22.25	0.00	0	0	0	3	0	0	4		~~60~~ 54.75											
								SF	SF	EA	EA	EA	EA	EA	EA	EA		FT											
							TOWN DIRECTIONAL TOTALS	65.0	0.0	0.0	0.0	0.0	11	0.0	0.0	12		~~180.0~~ 165.25											

SIGN SUMMARY SHEET

VERMONT AGENCY OF TRANSPORTATION

PROJECT NAME: **STATEWIDE - SOUTHWEST REGION**
PROJECT NUMBER: **STPG SIGN(32)**

FILE NAME: **DANBY SB.XLS** PLOT DATE: **7/13/2010**
PROJECT MANAGER: **A. GAMBLE** DRAWN BY: **J. KELLY**
DESIGNED BY: **J. KELLY** CHECKED BY: **A. GAMBLE**
DANBY SOUTHBOUND SHEET 2 SHEET **76** OF **90**

DIRECTION	MILEPOINT	LOCATION CODE (SHEET 2)	SIGN CODE	WIDTH (IN)	HEIGHT (IN)	SHEETING REMARKS	SIGN LEGEND	NEW SIGNS "A"	NEW SIGNS "B"	EXISTING SIGNS RETAIN	EXISTING SIGNS SALVAGE FROM	EXISTING SIGNS SALVAGE TO	EXISTING SIGNS REMOVE	EXIST POST RETAIN	EXIST POST REMOVE	NUMBER OF NEW POSTS	SQUARE STEEL (IN) (LB / FT) 1.75 / 1.88	SQUARE STEEL (IN) (LB / FT) 2.00 / 2.42	SQUARE STEEL (IN) (LB / FT) 2.50 / 3.35	TUBULAR STEEL Ø (IN) FOUNDATION	TUBULAR STEEL Ø (IN) (LB / FT) 3.00 / 7.60	TUBULAR STEEL Ø (IN) (LB / FT) 3.50 / 9.00	TUBULAR STEEL Ø (IN) (LB / FT) 4.00 / 10.80	TUBULAR STEEL Ø (IN) (LB / FT) 5.00 / 14.60	SIGN FRAME REQUIRED	REMARKS	SIGN DETAIL: DETAIL IN SHS	SIGN DETAIL: DETAIL ON SHEET NUMBER	SIGN DETAIL: DETAIL ON STD SHEET NUMBER
STOCKBRIDGE VT-107							FY-FLUORESCENT YELLOW FYG-FLUORESCENT YELLOW GREEN																			"SHS"-STANDARD HIGHWAY SIGNS			
EB	0.055	A	D2-1	72	10								1		X													
			M3-2	24	12								1															
			M1-5A	30	24								1															
			M4-5I	24	12								1															
			M1-1	24	24								1															
			D2-1	72	12			6.00								2		16.5 17.25 X									5	
			M3-2	24	12		Bethel 10 EAST TO VERMONT 107 INTERSTATE 89	2.00																		GREEN/WHITE ROUTE MARKER			E-136B
			M1-5	30	24			5.00																		GREEN/WHITE ROUTE MARKER			E-136B
			M4-5	24	12			2.00																		WHITE ON BLUE	X		
			M1-1	24	24			4.00																		WHITE/BLUE/RED	X		
EB	0.110	A	R2-1	24	30		SPEED LIMIT 50						1		X													
		A	R2-1	24	30			5.00								1		14.0 X									X	
EB	0.207	A	VW-619	30	30		SHOULDER NARROWS						1		X													
		A	VW-619	36	36			9.00								2		14.75 15.75 X									6	
EB	0.265	A	VD-062B	72	16		BUSINESS SIGN			1				X														
							SHEET TOTALS	33.00	0.00	1	0	0	7	0	0	5		-75-78.25										
								SF	SF	EA	EA	EA	EA	EA	EA	EA		FT										
							TOWN DIRECTIONAL TOTALS	131.8	0.0	24.0	1.0	1.0	23	0.0	0.0	19		285.0										

SIGN SUMMARY SHEET

VERMONT AGENCY OF TRANSPORTATION

PROJECT NAME: STATEWIDE - SOUTHWEST REGION
PROJECT NUMBER: STPG SIGN(32)

FILE NAME: STOCKBRIDGE EB.XLS
PROJECT MANAGER: A. GAMBLE
DESIGNED BY: J. KELLY
STOCKBRIDGE EASTBOUND SHEET 1

PLOT DATE: 7/13/2010
DRAWN BY: J. KELLY
CHECKED BY: A. GAMBLE
SHEET 77 OF 90

DIRECTION	MILEPOINT	LOCATION CODE (SHEET 2)	SIGN CODE	WIDTH (IN)	HEIGHT (IN)	SHEETING REMARKS	SIGN LEGEND	NEW SIGNS "A"	NEW SIGNS "B"	EXISTING SIGNS RETAIN	EXISTING SIGNS SALVAGE FROM	EXISTING SIGNS SALVAGE TO	EXISTING SIGNS REMOVE	EXIST POST RETAIN	EXIST POST REMOVE	NUMBER OF NEW POSTS	SQUARE STEEL (IN) 1.75 (LB/FT) 1.88	SQUARE STEEL (IN) 2.00 (LB/FT) 2.42	SQUARE STEEL (IN) 2.50 (LB/FT) 3.35	TUBULAR STEEL Ø (IN) FOUNDATION	TUBULAR STEEL Ø (IN) 3.00 (LB/FT) 7.60	TUBULAR STEEL Ø (IN) 3.50 (LB/FT) 9.00	TUBULAR STEEL Ø (IN) 4.00 (LB/FT) 10.80	TUBULAR STEEL Ø (IN) 5.00 (LB/FT) 14.60	SIGN FRAME REQUIRED	REMARKS	SIGN DETAIL: DETAIL IN SHS	SIGN DETAIL: DETAIL ON SHEET NUMBER	SIGN DETAIL: DETAIL ON STD SHEET NUMBER
STOCKBRIDGE VT-107							FY-FLUORESCENT YELLOW FYG-FLUORESCENT YELLOW GREEN																			"SHS"-STANDARD HIGHWAY SIGNS			
EB	0.400	A	VW-054R	30	30								1		X														
		A	VW-054R	30	30			6.25								1		14.0 X										6	
EB	0.682	A	W1-5R	30	30								1		X														
EB	0.864	A	W8-5	30	30								1	X															
		A	W7-3A	24	18								1																
		A	W8-5	30	30			6.25																	REPLACE SIGNS AND RETAIN SIGN POSTS.	X		
		A	W7-3A	24	18			3.00																			X		
EB	0.944	A	W1-2R	30	30			6.25								1		15.0 X									INSTALL 425 FEET EAST OF PREVIOUS ASSEMBLY.	X		
EB	2.335	A	W1-2L	30	30		LEFT CURVE						1		X														
		A	W13-1	18	18		40 MPH ADVISORY						1																
EB	2.434	A	W1-2L	30	30			6.25								1		15.5 X									INSTALL 550 FEET EAST OF EXISTING LEFT CURVE ASSEMBLY.	X		
		A	W13-1	18	18			2.25																			X		
EB	2.530	C	VR-017	24	30								1		X													RANNY RD. (TH-18)			
		C	VR-017	24	30			5.00								1		13.25 X										4	
EB	2.540	D	R1-1	30	30								1		X												RANNY RD. (TH-18)			
							SHEET TOTALS	35.25	0.00	0	0	0	8	0	0	4		-60- 57.75											
								SF	SF	EA	EA	EA	EA	EA	EA	EA		FT											
							TOWN DIRECTIONAL TOTALS	131.8	0.0	24.0	1.0	1.0	23	0.0	0.0	19		285.0											

SIGN SUMMARY SHEET

VERMONT AGENCY OF TRANSPORTATION

PROJECT NAME: **STATEWIDE - SOUTHWEST REGION**
PROJECT NUMBER: **STPG SIGN(32)**

FILE NAME: **STOCKBRIDGE EB.XLS** PLOT DATE: **7/13/2010**
PROJECT MANAGER: **A. GAMBLE** DRAWN BY: **J. KELLY**
DESIGNED BY: **J. KELLY** CHECKED BY: **A. GAMBLE**
STOCKBRIDGE EASTBOUND SHEET 2 SHEET **78** OF **90**

DIRECTION	MILEPOINT	LOCATION CODE (SHEET 2)	SIGN CODE	WIDTH (IN)	HEIGHT (IN)	SHEETING REMARKS	SIGN LEGEND	NEW SIGNS "A"	NEW SIGNS "B"	EXISTING SIGNS RETAIN	EXISTING SIGNS SALVAGE FROM	EXISTING SIGNS SALVAGE TO	EXISTING SIGNS REMOVE	EXIST POST RETAIN	EXIST POST REMOVE	NUMBER OF NEW POSTS	SQUARE STEEL (IN) 1.75 (LB / FT) 1.88	SQUARE STEEL (IN) 2.00 (LB / FT) 2.42	SQUARE STEEL (IN) 2.50 (LB / FT) 3.35	TUBULAR STEEL Ø (IN) FOUNDATION	TUBULAR STEEL Ø (IN) 3.00 (LB / FT) 7.60	TUBULAR STEEL Ø (IN) 3.50 (LB / FT) 9.00	TUBULAR STEEL Ø (IN) 4.00 (LB / FT) 10.80	TUBULAR STEEL Ø (IN) 5.00 (LB / FT) 14.60	SIGN FRAME REQUIRED	REMARKS	SIGN DETAIL: DETAIL IN SHS	SIGN DETAIL: DETAIL ON SHEET NUMBER	SIGN DETAIL: DETAIL ON STD SHEET NUMBER
STOCKBRIDGE VT-107							FY-FLUORESCENT YELLOW FYG-FLUORESCENT YELLOW GREEN																			"SHS"-STANDARD HIGHWAY SIGNS			
		D	R1-1	30	30			6.25								1		13.25 X									X		
EB	2.694	A	M3-2	24	12		EAST			1																		
		A	M1-5A	30	24		ROUTE 107			1																		
EB	2.732	A	S4-3	24	8		SCHOOL			1				X														
EB	2.732	A	R2-1	24	30		SPEED LIMIT 35			1																		
EB	2.732	A	S4-4	24	10		WHEN FLASHING			1																		
EB	2.805	A	S1-1	30	30		SCHOOL SYMBOL PENTAGONAL SIGN			1				X														
EB	3.050	A	W1-4R	30	30		RIGHT REVERSE CURVE			1				X														
		A	W13-1	18	18		40 MPH ADVISORY			1																		
EB	3.125	A	W2-2R	30	30		RIGHT SIDE ROAD			1				X														
		A	W8-5	30	30		SLIPPERY WHEN WET SYMBOL			1																		
EB	3.150	A	S5-2	24	30		END SCHOOL ZONE			1				X														
EB	3.225	B	W1-6	48	24		RIGHT LARGE ARROW			1				X														
EB	3.230	C	VR-017	24	24		LLL 24,000 LBS			1				X														
EB	3.235	D	R1-1	24	24		STOP			1				X														
SIGN SUMMARY SHEET							SHEET TOTALS	6.25	0.00	14	0	0	0	0	0	1		~~15~~ 13.25										
								SF	SF	EA	EA	EA	EA	EA	EA	EA		FT										
VERMONT AGENCY OF TRANSPORTATION							TOWN DIRECTIONAL TOTALS	131.8	0.0	24.0	1.0	1.0	23	0.0	0.0	19		285.0										

PROJECT NAME: **STATEWIDE - SOUTHWEST REGION**
PROJECT NUMBER: **STPG SIGN(32)**

FILE NAME: **STOCKBRIDGE EB.XLS** PLOT DATE: **7/13/2010**
PROJECT MANAGER: **A. GAMBLE** DRAWN BY: **J. KELLY**
DESIGNED BY: **J. KELLY** CHECKED BY: **A. GAMBLE**
STOCKBRIDGE EASTBOUND SHEET 3 SHEET **79** OF **90**

DIRECTION	MILEPOINT	LOCATION CODE (SHEET 2)	SIGN CODE	WIDTH (IN)	HEIGHT (IN)	SHEETING REMARKS	SIGN LEGEND	NEW SIGNS "A"	NEW SIGNS "B"	EXISTING SIGNS RETAIN	EXISTING SIGNS SALVAGE FROM	EXISTING SIGNS SALVAGE TO	EXISTING SIGNS REMOVE	EXIST POST RETAIN	EXIST POST REMOVE	NUMBER OF NEW POSTS	SQUARE STEEL (IN) (LB / FT) 1.75 / 1.88	SQUARE STEEL (IN) (LB / FT) 2.00 / 2.42	SQUARE STEEL (IN) (LB / FT) 2.50 / 3.35	TUBULAR STEEL Ø (IN) FOUNDATION	TUBULAR STEEL Ø (IN) (LB / FT) 3.00 / 7.60	TUBULAR STEEL Ø (IN) (LB / FT) 3.50 / 9.00	TUBULAR STEEL Ø (IN) (LB / FT) 4.00 / 10.80	TUBULAR STEEL Ø (IN) (LB / FT) 5.00 / 14.60	SIGN FRAME REQUIRED	REMARKS	SIGN DETAIL: DETAIL IN SHS	SIGN DETAIL: DETAIL ON SHEET NUMBER	SIGN DETAIL: DETAIL ON STD SHEET NUMBER
STOCKBRIDGE VT-107							FY-FLUORESCENT YELLOW FYG-FLUORESCENT YELLOW GREEN																			"SHS"-STANDARD HIGHWAY SIGNS			
EB	3.240	A	W1-6	48	24		LEFT LARGE ARROW			1				X														
EB	3.245	A	OM-3R	12	36		RIGHT OBJECT MARKER			1				X														
EB	3.280	B	OM-3L	12	36		LEFT OBJECT MARKER			1				X														
EB	3.298	B	W1-6	48	24		LEFT LARGE ARROW			1				X														
EB	3.320	A	R2-1	24	30		SPEED LIMIT 50			1				X														
EB	3.980	A	W1-10R	36	36		MODIFIED RIGHT CURVE			1				X														
		A	W13-1	24	24		35 MPH ADVISORY			1																		
EB	4.110	C	VR-017	24	30								1		X												MT. HUNGER RD. (TH-15)			
		C	VR-017	24	30			5.00								1		15.0 X									4	
EB	4.125	D	R1-1	30	30								1		X											MT. HUNGER RD. (TH-15)			
		D	N/A	24	18		NO LEFT TURN				1		1															
		D	R1-1	30	30			6.25								1		14.0 X								X	
		D	N/A	24	18		NO LEFT TURN					1														REINSTALL SIGN BELOW NEW STOP SIGN.			
EB	4.209	A	VD-062B	72	16		BUSINESS SIGN			1				X														
		A	VD-062AS	72	16		BUSINESS SIGN			1																		
							SHEET TOTALS	11.25	0.00	9	1	1	~~2~~ 3	0	0	2			~~30~~ 29.0									
								SF	SF	EA	EA	EA	EA	EA	EA	EA			FT									
							TOWN DIRECTIONAL TOTALS	131.8	0.0	24.0	1.0	1.0	23	0.0	0.0	19			285.0									


SIGN SUMMARY SHEET

VERMONT AGENCY OF TRANSPORTATION

PROJECT NAME: STATEWIDE - SOUTHWEST REGION
PROJECT NUMBER: STPG SIGN(32)

FILE NAME: STOCKBRIDGE EB.XLS
PROJECT MANAGER: A. GAMBLE
DESIGNED BY: J. KELLY
STOCKBRIDGE EASTBOUND SHEET 4

PLOT DATE: 7/13/2010
DRAWN BY: J. KELLY
CHECKED BY: A. GAMBLE
SHEET 80 OF 90

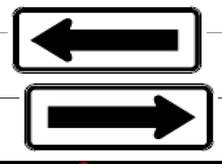DIRECTION	MILEPOINT	LOCATION CODE (SHEET 2)	SIGN CODE	WIDTH (IN)	HEIGHT (IN)	SHEETING REMARKS	SIGN LEGEND	NEW SIGNS "A"	NEW SIGNS "B"	EXISTING SIGNS RETAIN	EXISTING SIGNS SALVAGE FROM	EXISTING SIGNS SALVAGE TO	EXISTING SIGNS REMOVE	EXIST POST RETAIN	EXIST POST REMOVE	NUMBER OF NEW POSTS	SQUARE STEEL (IN) 1.75 (LB / FT) 1.88	SQUARE STEEL (IN) 2.00 (LB / FT) 2.42	SQUARE STEEL (IN) 2.50 (LB / FT) 3.35	TUBULAR STEEL Ø (IN) FOUNDATION	TUBULAR STEEL Ø (IN) 3.00 (LB / FT) 7.60	TUBULAR STEEL Ø (IN) 3.50 (LB / FT) 9.00	TUBULAR STEEL Ø (IN) 4.00 (LB / FT) 10.80	TUBULAR STEEL Ø (IN) 5.00 (LB / FT) 14.60	SIGN FRAME REQUIRED	REMARKS	SIGN DETAIL: DETAIL IN SHS	SIGN DETAIL: DETAIL ON SHEET NUMBER	SIGN DETAIL: DETAIL ON STD SHEET NUMBER
STOCKBRIDGE VT-107							FY-FLUORESCENT YELLOW FYG-FLUORESCENT YELLOW GREEN																			"SHS"-STANDARD HIGHWAY SIGNS			
EB	4.240	A	S3-1	30	30		SCHOOL BUS STOP AHEAD						1		X														
EB	5.085	A	VW-619	30	30								1		X															
		A	VW-619	36	36			9.00								2		15.0 15.5 X										6	
EB	5.148	A	VW-054R	30	30								1		X															
		A	VW-054R	30	30			6.25								1		15.0 X										6	
EB	5.426	A	W1-4L	30	30		LEFT REVERSE CURVE						1		X														
EB	5.485	A	W1-4L	30	30			6.25								1		15.0 X									INSTALL 300 FEET EAST OF EXISTING REVERSE CURVE SIGN ASSEMBLY - POLE #140-S	X	
EB	6.460	A	W1-2L	30	30	FY		6.25								1		15.5 X									INSTALL NEXT TO THE "TROTTING LIBRARY" SIGN.	X	
		A	W13-1	18	18	FY		2.25																				X	
EB	6.524	A	W1-6	48	24								1		X														
		B	W1-6	48	24								1																
		A	W1-6	48	24	FY		8.00								2		13.25 13.0 X									INSTALL BACK TO BACK AS EXISTING	X	
		B	W1-6	48	24	FY		8.00																				X	
WB	0.490	F	VW-054R	30	30			6.25								1		14.5 X											
							SHEET TOTALS	52.25 ~~46.00~~	0.00	0	0	0	6	0	0	8 ~~7~~		~~105~~ 116.75										
								SF	SF	EA	EA	EA	EA	EA	EA	EA		FT										
							TOWN DIRECTIONAL TOTALS	138 ~~131.8~~	0.0	24.0	1.0	1.0	24 ~~23~~	0.0	0.0	20 ~~19~~		295.0 ~~285.0~~										

SIGN SUMMARY SHEET

VERMONT AGENCY OF TRANSPORTATION

PROJECT NAME: **STATEWIDE - SOUTHWEST REGION**
PROJECT NUMBER: **STPG SIGN(32)**

FILE NAME: **STOCKBRIDGE EB.XLS** PLOT DATE: **7/13/2010**
PROJECT MANAGER: **A. GAMBLE** DRAWN BY: **J. KELLY**
DESIGNED BY: **J. KELLY** CHECKED BY: **A. GAMBLE**
STOCKBRIDGE EASTBOUND SHEET 5 SHEET **81** OF **90**

DIRECTION	MILEPOINT	LOCATION CODE (SHEET 2)	SIGN CODE	WIDTH (IN)	HEIGHT (IN)	SHEETING REMARKS	SIGN LEGEND	NEW SIGNS "A"	NEW SIGNS "B"	EXISTING SIGNS RETAIN	EXISTING SIGNS SALVAGE FROM	EXISTING SIGNS SALVAGE TO	EXISTING SIGNS REMOVE	EXIST POST RETAIN	EXIST POST REMOVE	NUMBER OF NEW POSTS	SQUARE STEEL (IN) 1.75 (LB / FT) 1.88	SQUARE STEEL (IN) 2.00 (LB / FT) 2.42	SQUARE STEEL (IN) 2.50 (LB / FT) 3.35	TUBULAR STEEL Ø (IN) FOUNDATION	TUBULAR STEEL Ø (IN) 3.00 (LB / FT) 7.60	TUBULAR STEEL Ø (IN) 3.50 (LB / FT) 9.00	TUBULAR STEEL Ø (IN) 4.00 (LB / FT) 10.80	TUBULAR STEEL Ø (IN) 5.00 (LB / FT) 14.60	SIGN FRAME REQUIRED	REMARKS	SIGN DETAIL: DETAIL IN SHS	SIGN DETAIL: DETAIL ON SHEET NUMBER	SIGN DETAIL: DETAIL ON STD SHEET NUMBER
STOCKBRIDGE VT-107							FY-FLUORESCENT YELLOW FYG-FLUORESCENT YELLOW GREEN																			"SHS"-STANDARD HIGHWAY SIGNS			
WB	6.625	F	W1-2R	30	30								1																
		F	W13-1	18	18								1																
		F	W1-2R	30	30	FY		6.25								1		17.5 X									X		
		F	W13-1	18	18	FY		2.25																			X		
WB	6.050	F	W1-4L	30	30		LEFT REVERSE CURVE						1		X														
WB	5.955	F	W1-4L	30	30			6.25								1		15.25 X									INSTALL 500 FEET WEST OF EXISTING REVERSE CURVE SIGN ASSEMBLY.	X		
WB	4.563	F	S3-1	30	30		SCHOOL BUS STOP AHEAD						1		X														
WB	4.490	F	VD-062B	72	16		BUSINESS SIGN			1				X															
		F	VD-062AS	72	16		BUSINESS SIGN			1																			
WB	4.407	G	VR-017	24	30								1	X													BRIDGE ST. (TH-2)			
		G	VR-017	24	30			5.00																			REPLACE SIGN AND RETAIN SIGN POST.		4	
WB	4.396	H	R1-1	30	30								1	X													BRIDGE ST. (TH-2)			
		H	R1-1	30	30			6.25																			REPLACE SIGN AND RETAIN SIGN POST.	X		
WB	4.320	F	VW-619	30	30		SHOULDER NARROWS						1		X														
WB	4.203	F	W1-2L	30	30		MODIFIED LEFT CURVE						1		X														
							SHEET TOTALS	26.00	0.00	2	0	0	8	0	0	2		~~30~~ 32.75											
								SF	SF	EA	EA	EA	EA	EA	EA	EA		FT											
							TOWN DIRECTIONAL TOTALS	151.3	0.0	22.0	0.0	0.0	35	0.0	0.0	20		300.0											

SIGN SUMMARY SHEET

VERMONT AGENCY OF TRANSPORTATION

PROJECT NAME: **STATEWIDE - SOUTHWEST REGION**
PROJECT NUMBER: **STPG SIGN(32)**

FILE NAME: **STOCKBRIDGE WB.XLS** PLOT DATE: **7/13/2010**
PROJECT MANAGER: **A. GAMBLE** DRAWN BY: **J. KELLY**
DESIGNED BY: **J. KELLY** CHECKED BY: **A. GAMBLE**
STOCKBRIDGE WESTBOUND SHEET 1 SHEET **82** OF **90**

DIRECTION	MILEPOINT	LOCATION CODE (SHEET 2)	SIGN CODE	WIDTH (IN)	HEIGHT (IN)	SHEETING REMARKS	SIGN LEGEND	NEW SIGNS "A"	NEW SIGNS "B"	EXISTING SIGNS RETAIN	EXISTING SIGNS SALVAGE FROM	EXISTING SIGNS SALVAGE TO	EXISTING SIGNS REMOVE	EXIST POST RETAIN	EXIST POST REMOVE	NUMBER OF NEW POSTS	SQUARE STEEL (IN) 1.75 (LB / FT) 1.88	SQUARE STEEL (IN) 2.00 (LB / FT) 2.42	SQUARE STEEL (IN) 2.50 (LB / FT) 3.35	TUBULAR STEEL Ø (IN) FOUNDATION	TUBULAR STEEL Ø (IN) 3.00 (LB / FT) 7.60	TUBULAR STEEL Ø (IN) 3.50 (LB / FT) 9.00	TUBULAR STEEL Ø (IN) 4.00 (LB / FT) 10.80	TUBULAR STEEL Ø (IN) 5.00 (LB / FT) 14.60	SIGN FRAME REQUIRED	REMARKS	SIGN DETAIL: DETAIL IN SHS	SIGN DETAIL: DETAIL ON SHEET NUMBER	SIGN DETAIL: DETAIL ON STD SHEET NUMBER
STOCKBRIDGE VT-107							FY-FLUORESCENT YELLOW FYG-FLUORESCENT YELLOW GREEN																			"SHS"-STANDARD HIGHWAY SIGNS			
		F	W13-1	18	18		35 MPH ADVISORY 						1															
		F	W-619	36	36			9.00								2		15.0 ~~15.75~~ X										6	
WB	4.160	F	W1-2LM	36	36	FY		9.00								2		~~15.25~~ 16.25 X									INSTALL 200 FEET WEST OF EXISTING LEFT CURVE SIGN ASSEMBLY.		6	
		F	W13-1	18	18	FY		2.25																				X		
WB	4.102	F	W1-6	48	24		LEFT LARGE ARROW			1				X															
		E	W1-6	48	24		RIGHT LARGE ARROW			1																			
WB	4.042	F	W1-6	48	24		LEFT LARGE ARROW			1				X															
		E	W1-6	48	24		RIGHT LARGE ARROW			1																			
WB	3.460	F	W1-4L	30	30		LEFT REVERSE CURVE			1				X															
		F	W13-1	18	18		40 MPH ADVISORY			1																			
WB	3.371	F	W2-2L	30	30		LEFT SIDE ROAD			1				X															
WB	3.370	F	W8-5	30	30		SLIPPERY WHEN WET			1																			
WB	3.275	F	OM-3R	12	36		RIGHT OBJECT MARKER			1				X															
WB	3.240	E	OM-3L	12	36		LEFT OBJECT MARKER			1				X															
WB	3.150	F	S4-3	24	8		SCHOOL			1				X															
							SHEET TOTALS	20.25	0.00	11	0	0	1	0	0	4		~~60~~ 62.25											
								SF	SF	EA	EA	EA	EA	EA	EA	EA		FT											
							TOWN DIRECTIONAL TOTALS	151.3	0.0	22.0	0.0	0.0	35	0.0	0.0	20		300.0											

SIGN SUMMARY SHEET

VERMONT AGENCY OF TRANSPORTATION

PROJECT NAME: STATEWIDE - SOUTHWEST REGION
PROJECT NUMBER: STPG SIGN(32)

FILE NAME: STOCKBRIDGE WB.XLS
PROJECT MANAGER: A. GAMBLE
DESIGNED BY: J. KELLY
STOCKBRIDGE WESTBOUND SHEET 2

PLOT DATE: 7/13/2010
DRAWN BY: J. KELLY
CHECKED BY: A. GAMBLE
SHEET 83 OF 90

DIRECTION	MILEPOINT	LOCATION CODE (SHEET 2)	SIGN CODE	WIDTH (IN)	HEIGHT (IN)	SHEETING REMARKS	SIGN LEGEND	NEW SIGNS "A"	NEW SIGNS "B"	EXISTING SIGNS RETAIN	EXISTING SIGNS SALVAGE FROM	EXISTING SIGNS SALVAGE TO	EXISTING SIGNS REMOVE	EXIST POST RETAIN	EXIST POST REMOVE	NUMBER OF NEW POSTS	SQUARE STEEL (IN) 1.75 (LB / FT) 1.88	SQUARE STEEL (IN) 2.00 (LB / FT) 2.42	SQUARE STEEL (IN) 2.50 (LB / FT) 3.35	TUBULAR STEEL Ø (IN) FOUNDATION	TUBULAR STEEL Ø (IN) 3.00 (LB / FT) 7.60	TUBULAR STEEL Ø (IN) 3.50 (LB / FT) 9.00	TUBULAR STEEL Ø (IN) 4.00 (LB / FT) 10.80	TUBULAR STEEL Ø (IN) 5.00 (LB / FT) 14.60	SIGN FRAME REQUIRED	REMARKS	SIGN DETAIL: DETAIL IN SHS	SIGN DETAIL: DETAIL ON SHEET NUMBER	SIGN DETAIL: DETAIL ON STD SHEET NUMBER
STOCKBRIDGE VT-107							FY-FLUORESCENT YELLOW FYG-FLUORESCENT YELLOW GREEN																				"SHS"-STANDARD HIGHWAY SIGNS			
WB	3.150	F	R2-1	24	30		SPEED LIMIT 35			1																			
WB	3.150	F	S4-4	24	10		WHEN FLASHING			1																			
WB	3.095	F	S1-1	30	30		SCHOOL			1				X															
WB	2.960	G	VR-017	24	30								1		X												SCHOOL DRIVE			
		G	VR-017	24	30			5.00								1		13.25 X										4	
WB	2.950	H	R1-1	30	30								1		X												SCHOOL DRIVE			
		H	R1-1	30	30			6.25								1		13.0 X										X	
WB	2.930	G	VR-017	24	30								1		X												SCHOOL DRIVE			
		G	VR-017	24	30			5.00								1		13.25 X										4	
WB	2.920	H	R1-1	30	30								1		X												SCHOOL DRIVE			
		H	R1-1	30	30			6.25								1		13.25 X										X	
WB	2.725	F	S5-2	24	30		END SCHOOL ZONE			1				X															
WB	2.655	G	VR-017	24	30								1		X												BLACKMORE BLVD. (TH-1)			
		G	N/A	24	30		NO THRU TRUCKS 						1														RETURN SIGN TO TOWN			
		G	VR-017	24	30			5.00								1		14.0 X										4	
SIGN SUMMARY SHEET							SHEET TOTALS	27.50	0.00	4	0	0	6	0	0	5		~~75~~ 66.75											
								SF	SF	EA	EA	EA	EA	EA	EA	EA		FT											
VERMONT AGENCY OF TRANSPORTATION							TOWN DIRECTIONAL TOTALS	151.3	0.0	22.0	0.0	0.0	35	0.0	0.0	20		300.0											

PROJECT NAME: STATEWIDE - SOUTHWEST REGION
PROJECT NUMBER: STPG SIGN(32)

FILE NAME: STOCKBRIDGEWB.XLS
PROJECT MANAGER: A. GAMBLE
DESIGNED BY: J. KELLY
STOCKBRIDGE WESTBOUND SHEET 3

PLOT DATE: 7/13/2010
DRAWN BY: J. KELLY
CHECKED BY: A. GAMBLE
SHEET 84 OF 90


DIRECTION	MILEPOINT	LOCATION CODE (SHEET 2)	SIGN CODE	WIDTH (IN)	HEIGHT (IN)	SHEETING REMARKS	SIGN LEGEND	NEW SIGNS "A"	NEW SIGNS "B"	EXISTING SIGNS RETAIN	EXISTING SIGNS SALVAGE FROM	EXISTING SIGNS SALVAGE TO	EXISTING SIGNS REMOVE	EXIST POST RETAIN	EXIST POST REMOVE	NUMBER OF NEW POSTS	SQUARE STEEL (IN) 1.75 (LB / FT) 1.88	SQUARE STEEL (IN) 2.00 (LB / FT) 2.42	SQUARE STEEL (IN) 2.50 (LB / FT) 3.35	TUBULAR STEEL Ø (IN) FOUNDATION	TUBULAR STEEL Ø (IN) 3.00 (LB / FT) 7.60	TUBULAR STEEL Ø (IN) 3.50 (LB / FT) 9.00	TUBULAR STEEL Ø (IN) 4.00 (LB / FT) 10.80	TUBULAR STEEL Ø (IN) 5.00 (LB / FT) 14.60	SIGN FRAME REQUIRED	REMARKS	SIGN DETAIL: DETAIL IN SHS	SIGN DETAIL: DETAIL ON SHEET NUMBER	SIGN DETAIL: DETAIL ON STD SHEET NUMBER
STOCKBRIDGE VT-107							FY-FLUORESCENT YELLOW FYG-FLUORESCENT YELLOW GREEN																			"SHS"-STANDARD HIGHWAY SIGNS			
WB	2.650	H	R1-1	30	30								1		X											BLACKMORE BLVD. (TH-1)			
		H	R1-1	30	30			6.25								1		13.25 X									X		
WB	2.646	F	W1-2MR	30	30		MODIFIED RIGHT CURVE						1		X														
		F	W13-1	18	18		40 MPH ADVISORY						1																
WB	2.635	F	W8-5	30	30			6.25								1		17.5 X									X		
		F	W7-3A	24	18			3.00																			X		
WB	2.570	F	W8-5	30	30		SLIPPERY WHEN WET SYMBOL						1		X														
		F	W7-3A	24	18		NEXT 2 MILES						1																
		F	W1-10R	36	36			9.00								2		15.25 15.75 X									X		
		F	W13-1	18	18			2.25																			X		
WB	2.542	F	M3-4	24	12		WEST						1		X														
		F	M1-5A	30	24		ROUTE 107						1																
WB	2.483	F	M3-4	24	12			2.00								1		14.0 X									INSTALL ASSEMBLY 275 FEET WEST OF EXISTING ROUTE MARKER ASSEMBLY			E-136B
		F	M1-5A	30	24			5.00																			GREEN ON WHITE ROUTE MARKER ASSEMBLY			E-136B
WB	2.450	F	R2-1	24	30								1		X														
							SHEET TOTALS	33.75	0.00	0	0	0	8	0	0	5		~~75~~ 75.75											
								SF	SF	EA	EA	EA	EA	EA	EA	EA		FT											
							TOWN DIRECTIONAL TOTALS	151.3	0.0	22.0	0.0	0.0	35	0.0	0.0	20		300.0											

SIGN SUMMARY SHEET

VERMONT AGENCY OF TRANSPORTATION

PROJECT NAME: **STATEWIDE - SOUTHWEST REGION**
PROJECT NUMBER: **STPG SIGN(32)**

FILE NAME: **STOCKBRIDGE WB.XLS** PLOT DATE: **7/13/2010**
PROJECT MANAGER: **A. GAMBLE** DRAWN BY: **J. KELLY**
DESIGNED BY: **J. KELLY** CHECKED BY: **A. GAMBLE**
STOCKBRIDGE WESTBOUND SHEET 4 SHEET **85** OF **90**

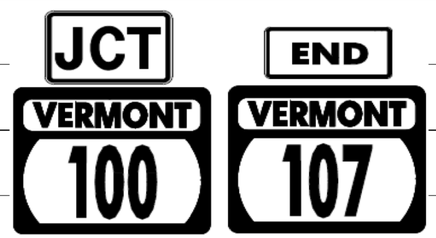DIRECTION	MILEPOINT	LOCATION CODE (SHEET 2)	SIGN CODE	WIDTH (IN)	HEIGHT (IN)	SHEETING REMARKS	SIGN LEGEND	NEW SIGNS "A"	NEW SIGNS "B"	EXISTING SIGNS RETAIN	EXISTING SIGNS SALVAGE FROM	EXISTING SIGNS SALVAGE TO	EXISTING SIGNS REMOVE	EXIST POST RETAIN	EXIST POST REMOVE	NUMBER OF NEW POSTS	SQUARE STEEL (IN) 1.75 (LB / FT) 1.88	SQUARE STEEL (IN) 2.00 (LB / FT) 2.42	SQUARE STEEL (IN) 2.50 (LB / FT) 3.35	TUBULAR STEEL Ø (IN) FOUNDATION	TUBULAR STEEL Ø (IN) 3.00 (LB / FT) 7.60	TUBULAR STEEL Ø (IN) 3.50 (LB / FT) 9.00	TUBULAR STEEL Ø (IN) 4.00 (LB / FT) 10.80	TUBULAR STEEL Ø (IN) 5.00 (LB / FT) 14.60	SIGN FRAME REQUIRED	REMARKS	SIGN DETAIL: DETAIL IN SHS	SIGN DETAIL: DETAIL ON SHEET NUMBER	SIGN DETAIL: DETAIL ON STD SHEET NUMBER
STOCKBRIDGE VT-107							FY-FLUORESCENT YELLOW FYG-FLUORESCENT YELLOW GREEN																			"SHS"-STANDARD HIGHWAY SIGNS			
		F	R2-1	24	30			5.00								1		13.25 X									X		
WB	1.330	F	W1-5L	30	30								1		X														
WB	1.235	F	W1-2L	30	30			6.25								1		14.75 X									INSTALL 500 FEET WEST OF WINDING ROAD SIGN ASSEMBLY.	X		
WB	0.963	F	W1-4R	30	30		RIGHT REVERSE CURVE						1		X														
WB	0.834	F	VD-062B	72	16		BUSINESS SIGN			1																			
WB	0.161	F	M2-1	21	15								1	X															
		F	M1-5A	30	24								1																
		F	M4-6	24	12								1																
		F	M1-5A	30	24								1																
		F	M2-1	21	15			2.19																#1B	INSTALL NEW GREEN ON WHITE ROUTE MARKERS ON NEW FRAME AND RETAIN SIGN POSTS.		7	E-136B
		F	M1-5	30	24			5.00																					E-136B
		F	M4-6	24	12			2.00																				X	
		F	M1-5	30	24			5.00																					E-136B
WB	0.112	F	D1-1A	72	10		<--- (45 DEG) PITTSFIELD 3			1					X														
		F	D1-1A	72	10		<--- (45 DEG) KILLINGTON 11			1																			
							SHEET TOTALS	25.44	0.00	3	0	0	6	0	0	2		-30-28.0											
								SF	SF	EA	EA	EA	EA	EA	EA	EA		FT											
							TOWN DIRECTIONAL TOTALS	151.3	0.0	22.0	0.0	0.0	35	0.0	0.0	20		300.0											


SIGN SUMMARY SHEET

VERMONT AGENCY OF TRANSPORTATION

PROJECT NAME: STATEWIDE - SOUTHWEST REGION
PROJECT NUMBER: STPG SIGN(32)

FILE NAME: STOCKBRIDGE WB.XLS
PROJECT MANAGER: A. GAMBLE
DESIGNED BY: J. KELLY
STOCKBRIDGE WESTBOUND SHEET 5

PLOT DATE: 7/13/2010
DRAWN BY: J. KELLY
CHECKED BY: A. GAMBLE
SHEET 86 OF 90

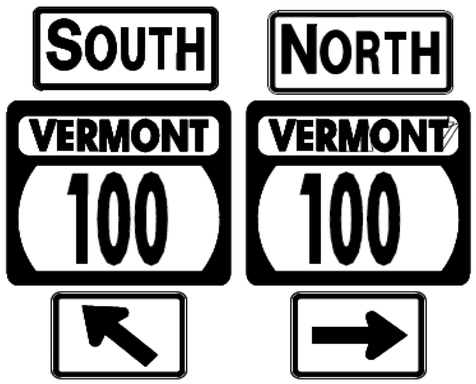DIRECTION	MILEPOINT	LOCATION CODE (SHEET 2)	SIGN CODE	WIDTH (IN)	HEIGHT (IN)	SHEETING REMARKS	SIGN LEGEND	NEW SIGNS "A"	NEW SIGNS "B"	EXISTING SIGNS RETAIN	EXISTING SIGNS SALVAGE FROM	EXISTING SIGNS SALVAGE TO	EXISTING SIGNS REMOVE	EXIST POST RETAIN	EXIST POST REMOVE	NUMBER OF NEW POSTS	SQUARE STEEL (IN) (LB / FT) 1.75 / 1.88	SQUARE STEEL (IN) (LB / FT) 2.00 / 2.42	SQUARE STEEL (IN) (LB / FT) 2.50 / 3.35	TUBULAR STEEL Ø (IN) FOUNDATION	TUBULAR STEEL Ø (IN) (LB / FT) 3.00 / 7.60	TUBULAR STEEL Ø (IN) (LB / FT) 3.50 / 9.00	TUBULAR STEEL Ø (IN) (LB / FT) 4.00 / 10.80	TUBULAR STEEL Ø (IN) (LB / FT) 5.00 / 14.60	SIGN FRAME REQUIRED	REMARKS	SIGN DETAIL: DETAIL IN SHS	SIGN DETAIL: DETAIL ON SHEET NUMBER	SIGN DETAIL: DETAIL ON STD SHEET NUMBER
STOCKBRIDGE VT-107							FY-FLUORESCENT YELLOW FYG-FLUORESCENT YELLOW GREEN																			"SHS"-STANDARD HIGHWAY SIGNS			
		F	D1-1A	72	10		<--- (45 DEG) RUTLAND 22			1																		
		F	D1-1A	72	10		ROCHESTER 9 --->			1																		
WB	0.059	F	M3-3	24	12								1		X													
		F	M1-5A	30	24								1															
		F	M6-3	21	15		UP ARROW						1															
		F	M3-1	24	12								1															
		F	M1-5A	30	24								1															
		F	M6-1	21	15								1															
		F	M3-3	24	12			2.00								2		17.0 17.25 X						#2B	GREEN ON WHITE ROUTE MARKERS.		7	E-136B
		F	M1-5	30	24			5.00																				E-136B
		F	M6-2L	21	15			2.19																				E-136B
		F	M3-1	24	12			2.00																				E-136B
		F	M1-5	30	24			5.00																				E-136B
		F	M6-1	21	15			2.19																				E-136B
							SHEET TOTALS	18.38	0.00	2	0	0	6	0	0	2			~~30~~ 34.25									
								SF	SF	EA	EA	EA	EA	EA	EA	EA			FT									
							TOWN DIRECTIONAL TOTALS	151.3	0.0	22.0	0.0	0.0	35	0.0	0.0	20			299.75 ~~300.0~~									

SIGN SUMMARY SHEET

VERMONT AGENCY OF TRANSPORTATION

PROJECT NAME: **STATEWIDE - SOUTHWEST REGION**
PROJECT NUMBER: **STPG SIGN(32)**

FILE NAME: **STOCKBRIDGE WB.XLS** PLOT DATE: **7/13/2010**
PROJECT MANAGER: **A. GAMBLE** DRAWN BY: **J. KELLY**
DESIGNED BY: **J. KELLY** CHECKED BY: **A. GAMBLE**
STOCKBRIDGE WESTBOUND SHEET 6 SHEET **87** OF **90**

TOWN TOTAL SIGN SUMMARY SHEET

STATEWIDE - SOUTHWEST REGION STPG SIGN

Townname-Route	County	Town Mileage	NEW SIGNS (SF)		EXISTING SIGNS (EA)				EXIST POST (EA)		NUMBER OF NEW POSTS (EA)				SQUARE STEEL (IN)			TUBULAR STEEL Ø (IN)				
											1.75"	2"	2.5"		1.75	2.00	2.50		3.00	3.50	4.00	5.00
											(LB / FT)				(LB / FT)				(LB / FT)			
			TYPE A	TYPE B	RETAIN	SALVAGE FROM	SALVAGE TO	REMOVE	RETAIN	REMOVE	1.88	2.42	3.35	TOTAL POSTS	1.88	2.42	3.35	FOUNDATION	7.60	9.00	10.80	14.60
Shaftsbury VT-7A NB	Bennington	6.895	269.1	0	15	~~7~~5	~~7~~5	69~~62~~	0	0	0	44	0	44	0	~~660~~ 618.00	0					
Shaftsbury VT-7A SB	Bennington	6.895	217.7	0	26	~~8~~5	~~8~~5	57~~46~~	0	0	0	38	0	38	0	~~570~~ 529.75	0					
Winhall VT-30 NB	Bennington	7.659	~~456.7~~	477.7 0	5	~~2~~3	~~2~~3	~~86~~79	0	0	1	50	0	~~53~~ 51	15	~~750~~ 760.75	0					
Winhall VT-30 SB	Bennington	7.659	~~457.6~~	463.85 0	6	0	0	82~~81~~	0	0	0	65	0	~~66~~ 65	0	~~975~~ 923.25	0					
Dorset US-7 NB	Bennington	4.968	163.8	0	1	~~2~~1	~~2~~1	34~~32~~	0	0	0	24	0	24	0	~~360~~ 331.75	0					
Dorset US-7 SB	Bennington	4.968	206.7	0	5	1	1	48~~47~~	0	0	0	21	0	21	0	~~315~~ 294.5	0					
Mount Tabor US-7 NB	Rutland	4.183	134.1	0	7	5~~2~~	5~~2~~	37~~29~~	0	0	0	18	0	19 ~~18~~	0	~~270~~ 274.00	0					
Mount Tabor US-7 SB	Rutland	4.183	~~173.3~~	179.25 0	7	5~~2~~	5~~2~~	38~~32~~	0	0	0	17	0	19 ~~17~~	0	~~255~~ 274.00	0					
Danby US-7 NB	Rutland	2.473	50.1	0	0	0	0	9 ~~7~~	0	0	0	9	0	9	0	~~135~~ 132.75	0					
Danby US-7 SB	Rutland	2.473	65.0	0	0	0	0	11	0	0	0	12	0	12	0	~~180~~ 165.25	0					
Stockbridge VT-107 EB	Windsor	6.700	~~131.8~~	138.0 0	24	1	1	24~~23~~	0	0	0	19	0	20~~19~~	0	~~285~~ 295.00	0					
Stockbridge VT-107 WB	Windsor	6.700	151.3	0	22	0	0	35	0	0	0	20	0	20	0	~~300~~ 299.75	0					
				Sub-Total		~~20~~	~~20~~	~~484~~						**Sub-Total**	15	5055	0					
							31	530														
Estimated Salvaged Street Name Signs to be erected onto new posts =							~~5~~															
Salvaged From signs to be added to Remove total =								~~20~~														
		TOTAL =	~~2477.2~~	0	118	~~20~~	~~25~~	~~504~~	0	0	1	337	0	~~338~~	~~5070~~			0	0	0	0	0
			2516.6			31	31	530						245	4898.75							

PROJECT NAME:	STATEWIDE - SOUTHWEST REGION
PROJECT NUMBER:	STPG SIGN (32)
FILE NAME: 10B012_TS.DGN	PLOT DATE: 26-AUG-2010
PROJECT LEADER: A. GAMBLE	DRAWN BY: J. KELLY
DESIGNED BY: J. KELLY	CHECKED BY: A. GAMBLE
TOWN TOTAL SIGN SUMMARY SHEET	SHEET 88 OF 90

Table 6H-2. Meaning of Symbols on Typical Application Diagrams

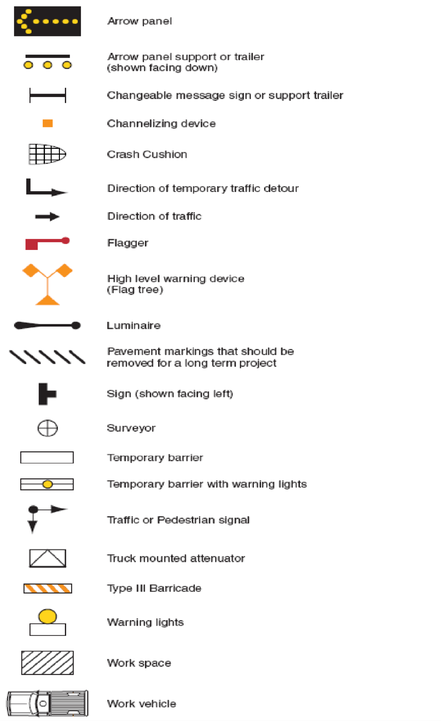


Figure 6E-1. Use of Hand-Signaling Devices by Flaggers

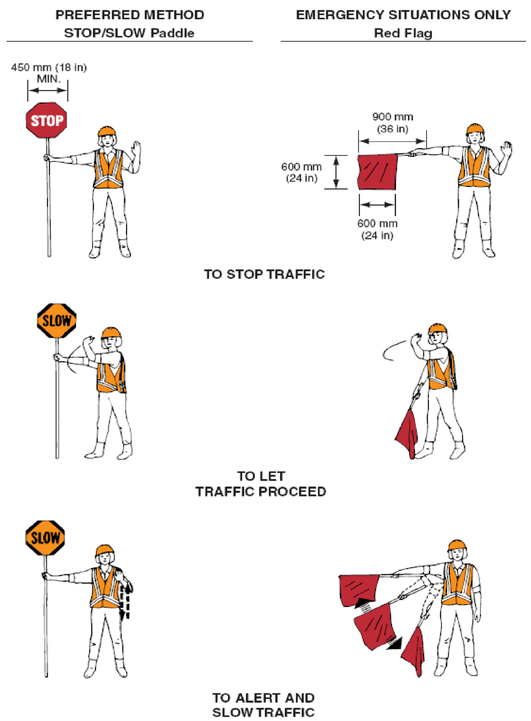


Figure 6C-2. Types of Tapers and Buffer Spaces


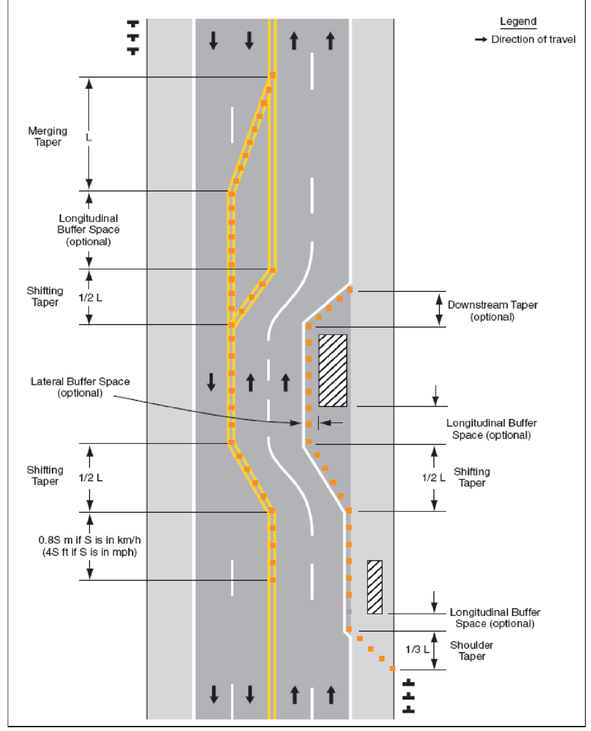


Figure 6H-1. Work Beyond the Shoulder (TA-1)

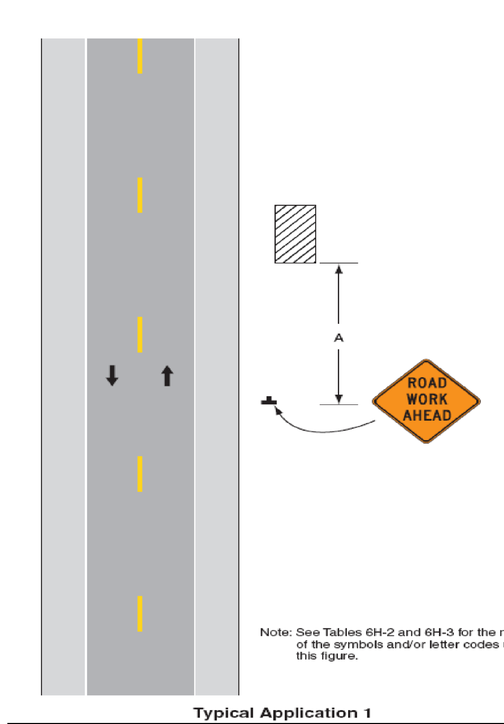

Note: See Tables 6H-2 and 6H-3 for the meaning of the symbols and/or letter codes used in this figure.

Typical Application 1

Table 6C-3. Taper Length Criteria for Temporary Traffic Control Zones

Type of Taper	Taper Length (L)*
Merging Taper	at least L
Shifting Taper	at least 0.5L
Shoulder Taper	at least 0.33L
One-Lane, Two-Way Traffic Taper	30 m (100 ft) maximum
Downstream Taper	30 m (100 ft) per lane

Table 6C-4. Formulas for Determining Taper Lengths

Speed Limit (S)	Taper Length (L) Meters
60 km/h or less	$L = \frac{WS^2}{155}$
70 km/h or more	$L = \frac{WS}{1.6}$

Speed Limit (S)	Taper Length (L) Feet
40 mph or less	$L = \frac{WS^2}{60}$
45 mph or more	L = WS


Where: L = taper length in meters (feet)
W = width of offset in meters (feet)
S = posted speed limit, or off-peak 85th-percentile speed prior to work starting, or the anticipated operating speed in km/h (mph)

Table 6C-1. Recommended Advance Warning Sign Minimum Spacing

Road Type	Distance Between Signs**		
	A	B	C
Urban (low speed)*	100 feet	100 feet	100 feet
Urban (high speed)*	350 feet	350 feet	350 feet
Rural	500 feet	500 feet	500 feet
Expressway / Freeway	1,000 feet	1,500 feet	2,640 feet

* Speed category to be determined by the highway agency
** The column headings A, B, and C are the dimensions shown in Figures 6H-1 through 6H-46. The A dimension is the distance from the transition or point of restriction to the first sign. The B dimension is the distance between the first and second signs. The C dimension is the distance between the second and third signs. (The "first sign" is the sign in a three-sign series that is closest to the TTC zone. The "third sign" is the sign that is furthest upstream from the TTC zone.)

Figure 6F-7. Channelizing Devices (Sheet 1 of 2)

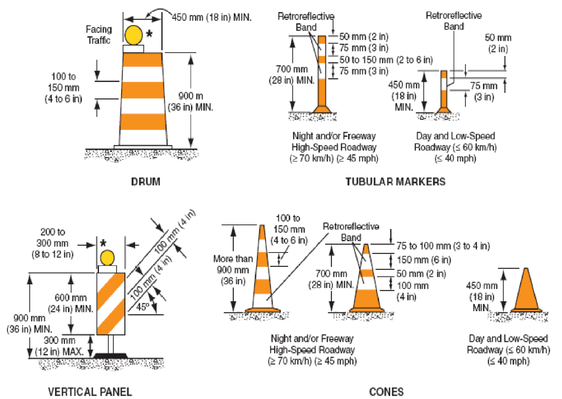

* Warning lights (optional)

Note: If drums, cones, or tubular markers are used to channelize pedestrians, they shall be located such that there are no gaps between the bases of the devices, in order to create a continuous bottom, and the height of each individual drum, cone, or tubular marker shall be no less than 900 mm (36 in) to be detectable to users of long canes.

TEMPORARY TRAFFIC CONTROL NOTES

1. ALL TEMPORARY TRAFFIC CONTROL SHALL BE IN ACCORDANCE WITH THESE PROJECT PLANS, APPLICABLE VTRANS E-SERIES STANDARD DRAWINGS, AND THE MANUAL ON UNIFORM TRAFFIC CONTROL DEVICES (MUTCD),DATED 2009, AND ITS LATEST REVISIONS, OR AS DIRECTED BY THE RESIDENT ENGINEER. IF THE CONTRACTOR DOES NOT WISH TO FOLLOW THE TEMPORARY TRAFFIC CONTROL PROVIDED, HE/SHE MAY SUBMIT AN ALTERNATE PROPOSAL AT THE PRE-CONSTRUCTION MEETING IMPLEMENTING THE PROPOSED CHANGES FOR REVIEW AND APPROVAL BY THE RESIDENT ENGINEER.
2. THE CONTRACTOR MUST PROVIDE ACCESS THROUGH THE WORK ZONE FOR EMERGENCY VEHICLES AT ALL TIMES.
3. THE CONTRACTOR SHALL CONDUCT THE WORK AT ALL TIMES IN SUCH A MANNER AND IN SUCH SEQUENCE SO AS TO ENSURE THE LEAST INTERFERENCE WITH TRAFFIC OCCURS.
4. SIGNS SHALL ONLY BE VISIBLE TO MOTORIST AT THE TIMES WHEN THE MESSAGE IS PERTINENT, I.E. A "FLAGGER AHEAD" SIGN SHALL ONLY BE VISIBLE TO MOTORIST WHEN THE FLAGGER IS ACTUALLY PRESENT PERFORMING THEIR DUTIES.
5. PAYMENT FOR CONSTRUCTION SIGNING WILL BE MADE UNDER CONTRACT ITEM 641.10 TRAFFIC CONTROL.


PROJECT NAME: STATEWIDE - SOUTHWEST REGION

PROJECT NUMBER: STPG SIGN (32)

FILE NAME: 10B012_TS.DGN
PROJECT LEADER: A. GAMBLE
DESIGNED BY: J. KELLY
TRAFFIC CONTROL I


PLOT DATE: 03-SEP-2010
DRAWN BY: J. KELLY
CHECKED BY: A. GAMBLE
SHEET 89 OF 90

Figure 6H-3. Work on Shoulders (TA-3)

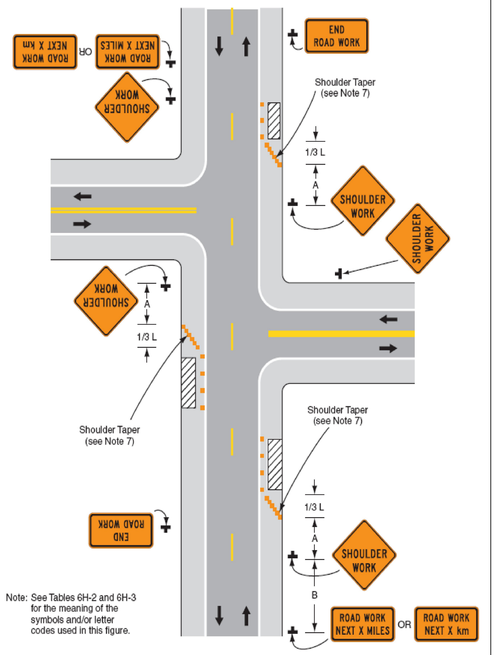


Typical Application 3

Figure 6H-4. Short-Duration or Mobile Operation on Shoulder (TA-4)

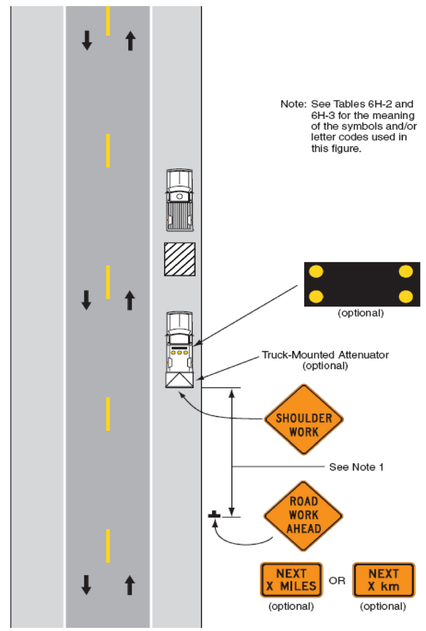


Typical Application 4

Figure 6H-6. Shoulder Work with Minor Encroachment (TA-6)

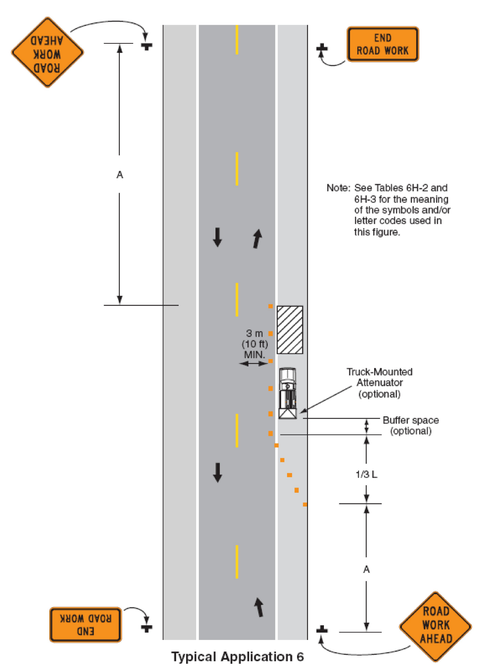

Typical Application 6

Figure 6H-10. Lane Closure on Two-Lane Road Using Flaggers (TA-10)

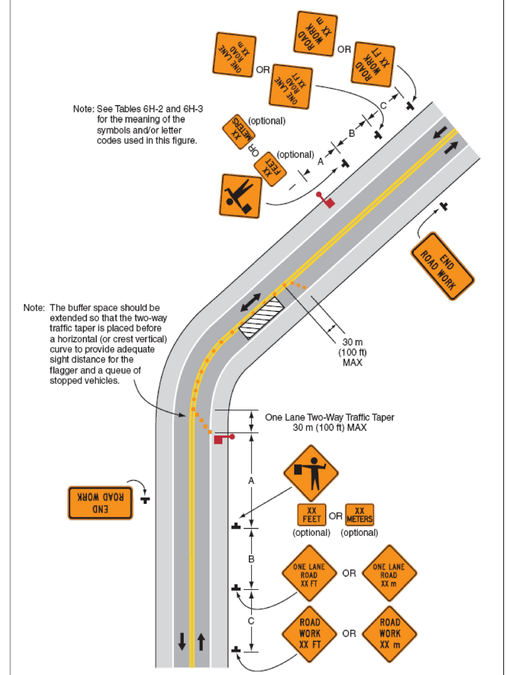

Typical Application 10

PROJECT NAME:	STATEWIDE - SOUTHWEST REGION
PROJECT NUMBER:	STPG SIGN (32)
FILE NAME: 10B012_TS.DGN	PLOT DATE: 14-JUL-2010
PROJECT LEADER: A. GAMBLE	DRAWN BY: J. KELLY
DESIGNED BY: J. KELLY	CHECKED BY: A. GAMBLE
TRAFFIC CONTROL 2	SHEET 90 OF 90