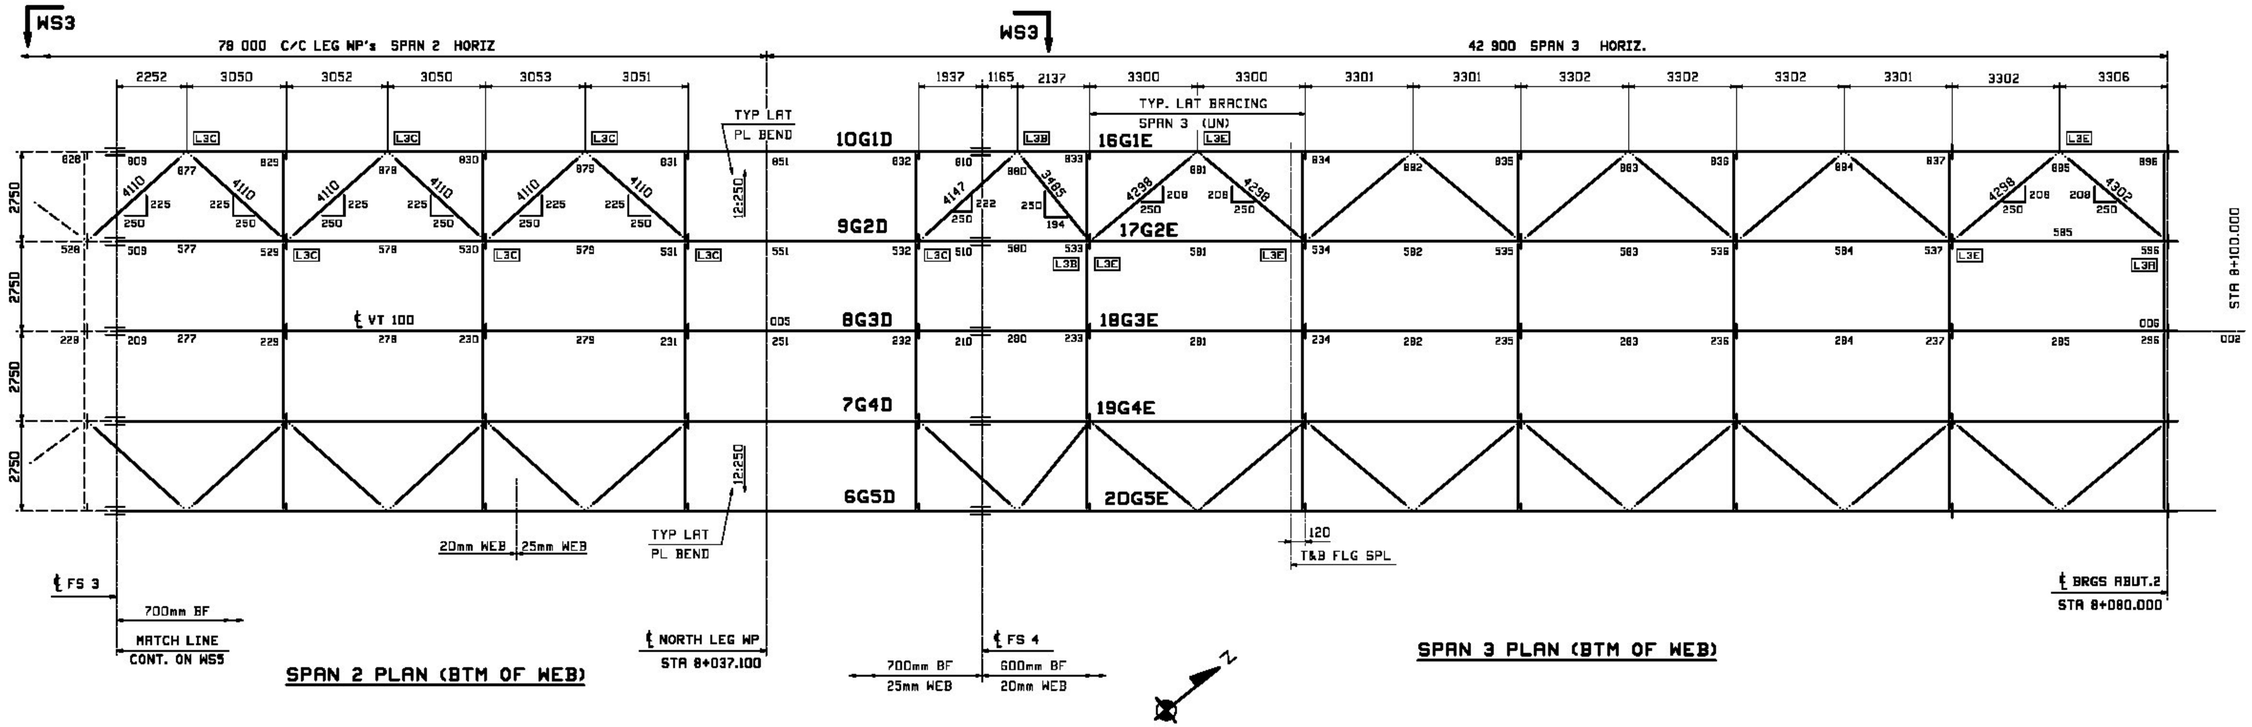

NOTE
THE PURPOSE OF THIS DRAWING IS TO COORDINATE GEOMETRIC CONTROL INFORMATION. THIS DWG IS SUBMITTED FOR INFORMATION ONLY AND IS NOT INTENDED FOR SHOP FABRICATION.

NOTES

1. LONGITUDINAL DIMENSIONS ARE SLOPING ALONG BTM OF WEB WITH CORRECTIONS MADE FOR GEOMETRIC CAMBER,GRADE & DL CAMBER (UN).
2. TRANSVERSE DIMENSIONS ARE IN A HORIZ. PLANE (UN).
3. DROP ARROW POINTS TOWARDS LOW END OF MEMBER.
4. ENDS OF GIRDERS & BRG. STIFF'S ARE VERT.AFTER DL ROTATION.
5. CF STIFF, INT STIFF & FIELD SPLICES ARE NORMAL TO GRADE.
6. FOR LAYOUTS SEE "TD" SHEETS.

WORK THIS SHEET WITH SHEETS WS1 - WS5

REV.	DATE	REMARKS	DWN	CHK	APVL	SHOP
0						

MATERIAL:	SURFACE PREP. & PAINT:	HOLES:	SHOP BOLTS:

DESCRIPTION: CALCULATION PLAN ~ SPANS 2 & 3 (BTM OF WEB)

CASCO BAY STEEL STRUCTURES, INC.
1 WALLACE AVE. PHONE (207) 780-6722
SOUTH PORTLAND, ME 04106 FAX. (207) 780-6726

STRUCTURE: VT 100 OVER LAMOILLE RIVER MORRISTOWN, VT LAMOILLE COUNTY STP F 029-1 (2) C/1		DRAWN: EEO	DATE: 10/03
		CHKD: PCP	DATE: 10/03
LOCATION: MORRISTOWN, VT		JOB NO.	DWG NO.
PROJ NO. STP F 029-1(2)C/1		521	WS6
CUSTOMER: WINTERSET, INC.			REV. △

VERMONT
Agency of Transportation
X Approved
Furnish as Corrected
Douglas E. Bonneau 12/10/12
Douglas E Bonneau, P.E. Date
Structures Project Manager
Rejected
Revise & Resubmit

X Reviewed
Rejected
Furnish As Corrected
Revise and Resubmit

This review is only for general conformance with the design concept and the information given in the Construction Documents. Corrections or comments made on the shop drawings during the review do not relieve the Contractor from compliance with the requirements of the Plans and Specifications. Review of a specific item shall not include review of an assembly of which an item is a component. The Contractor is responsible for dimensions to be confirmed and corrected at the job site; information that pertains solely to the fabrication process or to the means, methods, techniques, sequences and procedures of construction; coordination of the Work with that of other trades and performing all Work in a safe and satisfactory manner.

McFarland Johnson
Date October 24, 2012
By D. Kull