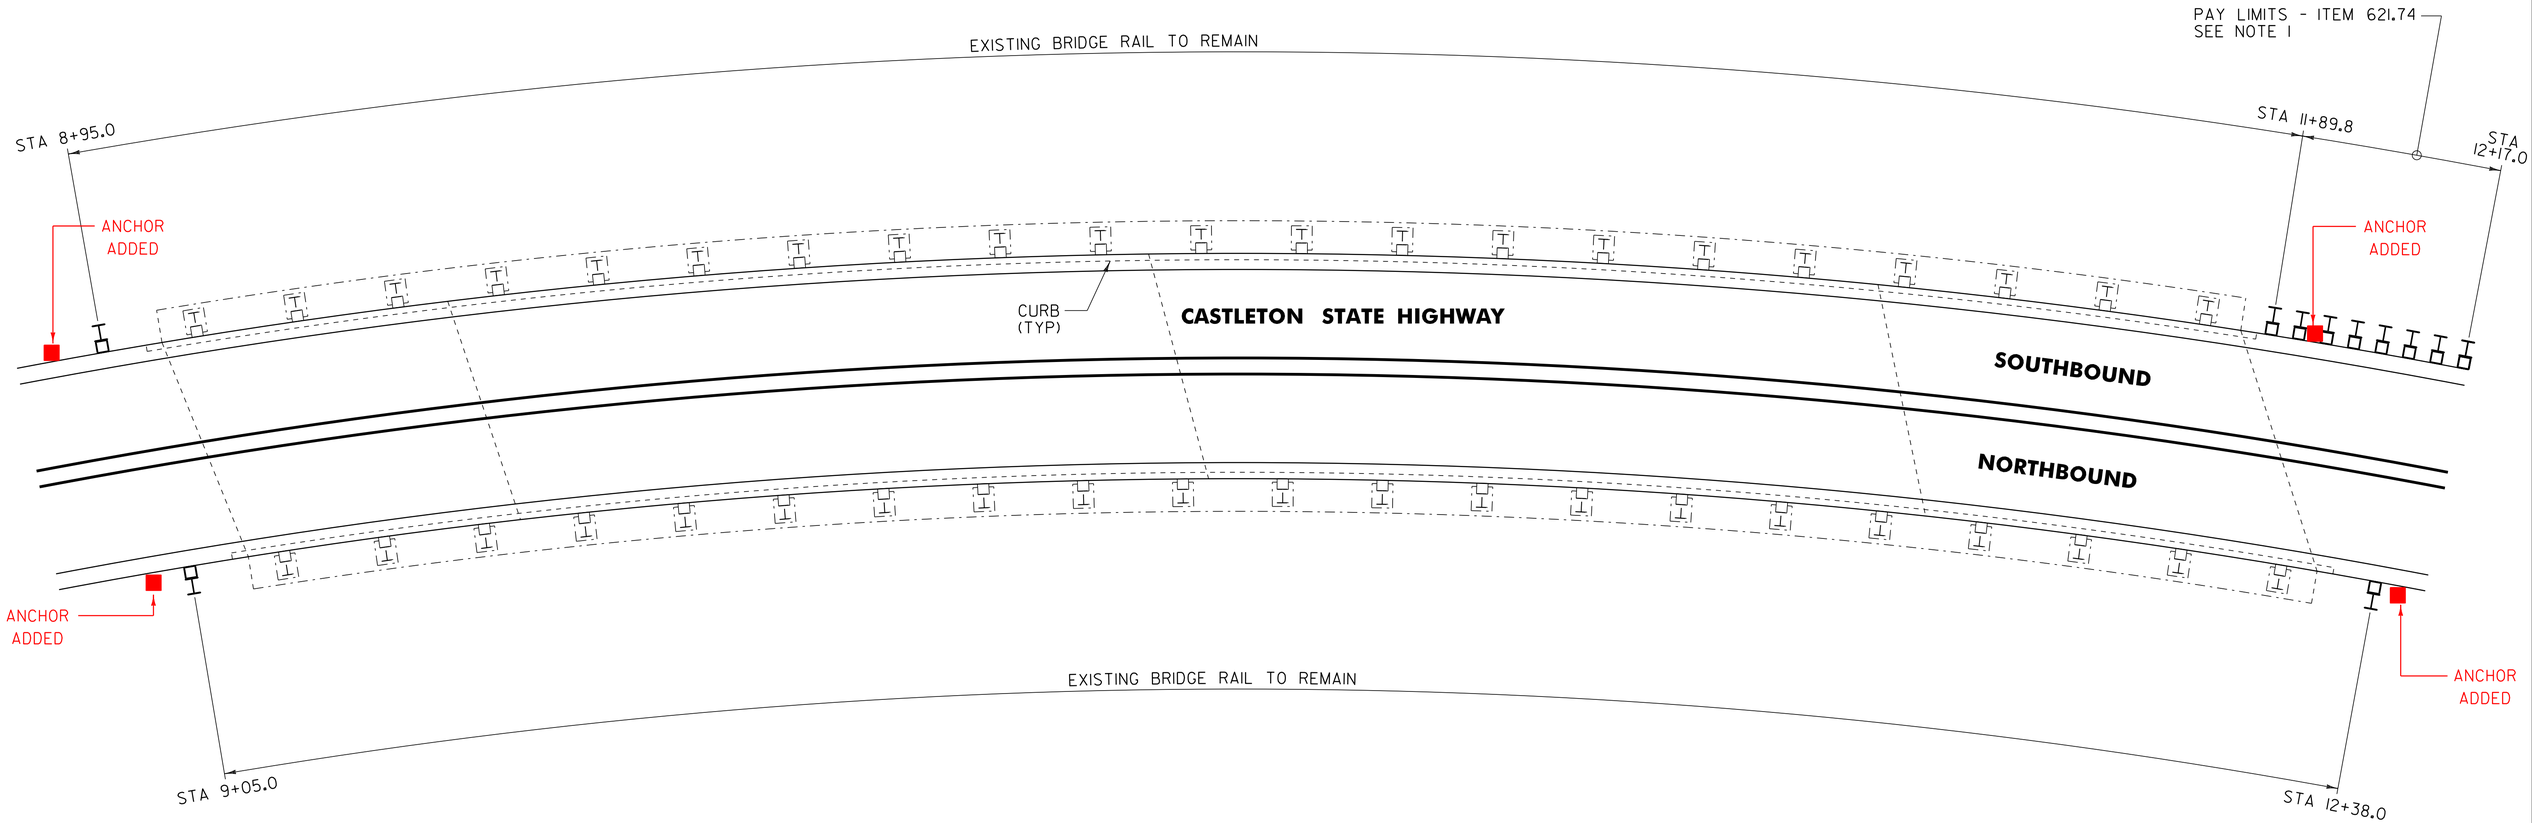

BR 2 CASTLETON STATE HIGHWAY MM 0.201 = STA 10+61.28

NOTE:

1. REFERENCE THIS SHEET ALONG WITH SHEETS 76 THRU 78 FOR ALUMINUM APPROACH RAILING CONNECTION DETAILS.

NOT TO SCALE

BRIDGE DETAIL SHEET #6

PROJECT NAME: CASTLETON - WEST RUTLAND

PROJECT NUMBER: STP 2705(1)

FILE NAME: p07c168.dgn	PLOT DATE: 04-JUN-2013 09:2
PROJECT LEADER: D.E.G.	DRAWN BY: W.G.P.
DESIGNED BY: M.J.M.	CHECKED BY: D.E.G.
IPARM FILE: p07c168bd6.i	SHEET 86 OF 152