3" SPECIAL PROVISION (BITUMINOUS CONCRETE PAVEMENT, SMALL QUANTITY) (2-1 1/2" LIFTS) (TYPE IVS)
5" SPECIAL PROVISION (BITUMINOUS CONCRETE PAVEMENT, SMALL QUANTITY) (2-2 1/2" LIFTS) (TYPE IIS)
36" SUBBASE OF DENSE GRADED CRUSHED STONE

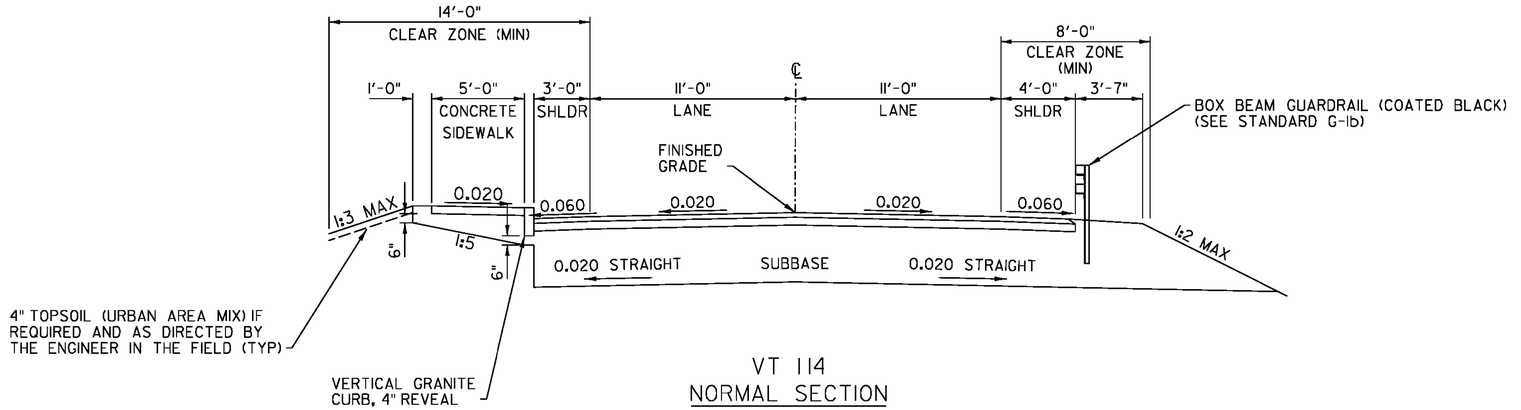

VT 114
NORMAL SECTION

SCALE: 1/4" = 1'-0"

MATERIAL TOLERANCES
(IF USED ON PROJECT)

SURFACE	
- PAVEMENT (TOTAL THICKNESS)	+/- 1/4"
- AGGREGATE SURFACE COURSE	+/- 1/2"
SUBBASE	+/- 1"
SAND BORROW	+/- 1"

NOTE

1. EMULSIFIED ASPHALT SHALL BE APPLIED TO ALL COLD PLANED SURFACES AT A RATE OF 0.080 GAL/SY AND BETWEEN EACH LIFT OF PAVEMENT AT A RATE OF 0.040 GAL/SY.

3" SPECIAL PROVISION (BITUMINOUS CONCRETE PAVEMENT, SMALL QUANTITY) (2-1 1/2" LIFTS) (TYPE IVS)
5" SPECIAL PROVISION (BITUMINOUS CONCRETE PAVEMENT, SMALL QUANTITY) (2-2 1/2" LIFTS) (TYPE IIS)
36" SUBBASE OF DENSE GRADED CRUSHED STONE

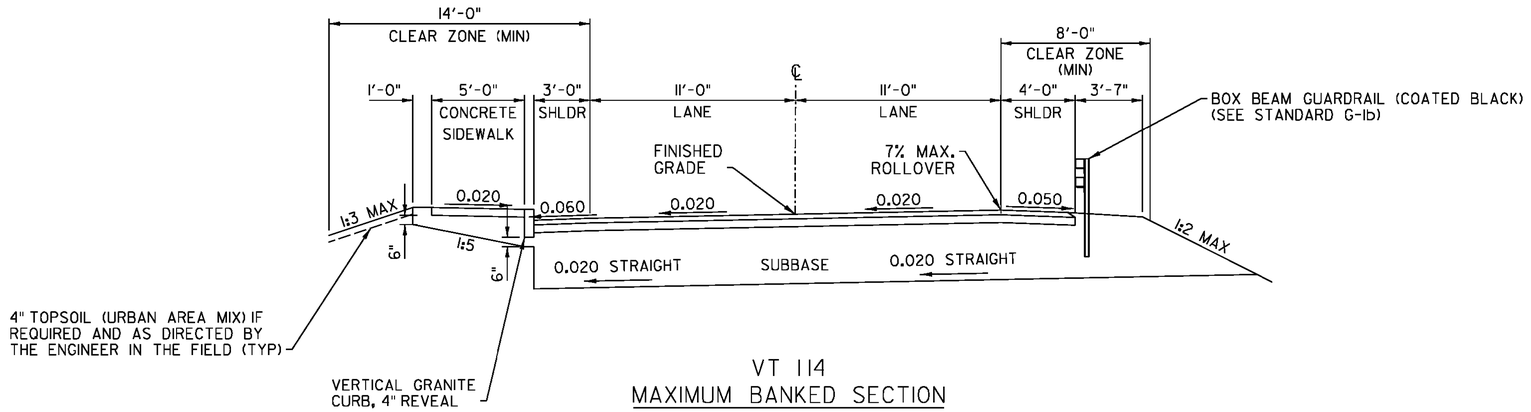

VT 114
MAXIMUM BANKED SECTION

SCALE: 1/4" = 1'-0"

3" SPECIAL PROVISION (BITUMINOUS CONCRETE PAVEMENT, SMALL QUANTITY) (2-1 1/2" LIFTS) (TYPE IVS)
18" SUBBASE OF DENSE GRADED CRUSHED STONE

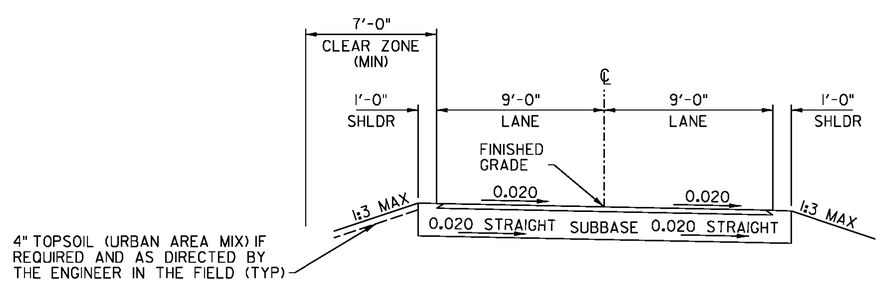

TH 52 (BELDEN HILL ROAD)
MAXIMUM BANKED SECTION

SCALE: 1/4" = 1'-0"

BUILT AS DESIGNED

PROJECT NAME: BURKE
PROJECT NUMBER: BRF 0269(13)

FILE NAME: 10c412/cos/z10c412frm.dgn
PROJECT LEADER: J. BYATT
DESIGNED BY: M. HALEY
TYPICAL ROADWAY SECTIONS SHEET 1

PLOT DATE: 10/14/2014
DRAWN BY: W. GORDON
CHECKED BY: P. SHEDD
SHEET 4 OF 73

CLD 12-0121 MODEL: TYP01