STATE OF VERMONT
AGENCY OF TRANSPORTATION

TRAFFIC SIGN SUMMARY SHEET 03

MILEMARKER, STATION, OR SIGN NUMBER	SIGN LEGEND	SIGN DIMENSIONS EA	SIGN DIMENSIONS WIDTH (in)	SIGN DIMENSIONS HEIGHT (in)	NEW & SALVAGED SIGNS "A"	NEW & SALVAGED SIGNS "B"	NEW & SALVAGED SIGNS SALV SIGN	NEW & SALVAGED SIGNS SALV TIS	EXIST POST RETAIN	EXIST POST SALVAGE	NO. OF POSTS	FLANGED CHANNEL lb/ft 1.12	FLANGED CHANNEL lb/ft 2.0	FLANGED CHANNEL lb/ft 3.0	SQUARE STEEL (in) lb/ft 1.75 1.88	SQUARE STEEL (in) lb/ft 2.0 2.42	SQUARE STEEL (in) lb/ft 2.5 3.35	ANCHOR	SLEEVE	TUBULAR ALUMINUM Ø (in) lb/ft 3.0 1.3	TUBULAR ALUMINUM Ø (in) lb/ft 4.0 1.7	TUBULAR ALUMINUM Ø (in) lb/ft 4.0 MOD 1.7	TUBULAR STEEL Ø (in) FOUND-ATION	TUBULAR STEEL Ø (in) lb/ft 3.0 7.6	TUBULAR STEEL Ø (in) lb/ft 3.5 9.0	TUBULAR STEEL Ø (in) lb/ft 4.0 10.8	TUBULAR STEEL Ø (in) lb/ft 5.0 14.6	W-SHAPE STEEL FTG. SIZE 24"	W-SHAPE STEEL FTG. SIZE 30"	W-SHAPE STEEL WEIGHT	W-SHAPE STEEL POST SIZE	SIGN FRAME REQUIRED	REMARKS	SIGN DETAIL DETAIL IN SHSM * BOOK	SIGN DETAIL DETAIL ON SHEET NUMBER	SIGN DETAIL STD. SHEET NUMBER
VT ROUTE 105 ENOSBURG (CONT.)																																				
47+99, RT	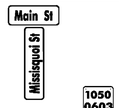	1 1 1	24 36 6	8 8 10	1.34 2.01 0.42				 1 																									D3-1 MOUNT NEW STREET SIGNS ON TOP OF EXISTING POST USING NEW 12 INCH BRACKETS D3-1 VD-700 MOUNT NEW MM PLAQUE BELOW & BACK-TO-BACK WITH EXISTING STOP SIGN ON EXISTING POST		105 105 	 E-138
48+12, RT		1 1	30 24	30 12	6.25 2.00						15 1					X		X																W11-2 (FLUORESCENT YELLOW-GREEN) W16-7P (FLUORESCENT YELLOW-GREEN)	X X		
48+18, LT		1 1	30 24	30 12	6.25 2.00						15 1					X		X	1															W11-2 (FLUORESCENT YELLOW-GREEN) SLEEVE TO BE INSTALLED IN EXISTING SIDEWALK PER VAOT STANDARD T-45 W16-7P (FLUORESCENT YELLOW-GREEN)	X X		
49+79, RT		1 1	30 24	30 12	6.25 2.00						15 1					X		X																W11-2 (FLUORESCENT YELLOW-GREEN) W16-7P (FLUORESCENT YELLOW-GREEN)	X X		
49+81, LT		1	6	10	0.42				1																									VD-700 MOUNT NEW MM PLAQUE BELOW & BACK-TO-BACK WITH RETAINED R3-2 SIGN ON RETAINED POST			E-138
50+83, RT		1	24	12	2.00		1 ~~1~~				15.5 1					X		X																			
											FT	FT	FT	FT	FT 58	FT		EA 1	LB	LB	LB		LB	LB	LB	LB								
				TOTALS	SF 30.94 ~~28.94~~	SF	EA. 1 ~~2~~	SF				FT			FT 58				LB			EA.	LB				EA.	EA.	LB					

* "SHSM"-STANDARD HIGHWAY SIGNS AND MARKINGS

FINAL POST LENGTHS ARE TO BE DETERMINED IN THE FIELD. POST SIZES ARE COMPUTED BASED ON INFORMATION FURNISHED ON THE STANDARD SHEETS AND THE VTRANS "SIGN POST DESIGN GUIDELINE."

TRAFFIC SIGN SUMMARY SHEET #3

PROJECT NAME: ENOSBURG-RICHFORD
PROJECT NUMBER: STP 2939(1)

FILE NAME: p11b312.dgn
PROJECT LEADER: J. LITTLE
DESIGNED BY: J. LITTLE
IPARM FILE: p11b312tss03.i

PLOT DATE: 3/19/2014
DRAWN BY: D. DRAPER
CHECKED BY: J. LITTLE
SHEET 75 OF 115