
STATE OF VERMONT
AGENCY OF TRANSPORTATION

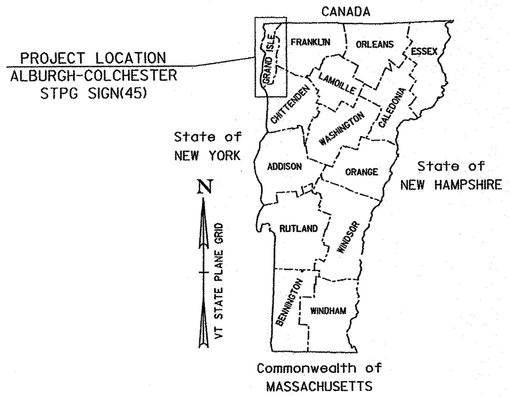

NOT TO SCALE


PROPOSED IMPROVEMENT

TOWNS OF ALBURGH, NORTH HERO, GRAND ISLE, SOUTH HERO, MILTON, AND COLCHESTER
COUNTIES OF GRAND ISLE AND CHITTENDEN
US RTE 2

ALBURGH TO COLCHESTER SIGN REPLACEMENT - 38.993 MILES:
ALBURGH (US-2) MP 0.000-11.803, NORTH HERO (US-2) MP 0.000-9.289
GRAND ISLE (US-2) MP 0.000-6.262, SOUTH HERO (US-2) MP 0.000-5.772
MILTON (US-2) MP 0.000-3.684, COLCHESTER (US-2) MP 0.000-2.183

LENGTH OF ROADWAY = 38.993 MI
LENGTH OF PROJECT = 38.993 MI

WORK TO BE PERFORMED INCLUDES THE REMOVAL OF EXISTING SIGNS AND POSTS AND THE INSTALLATION OF NEW SIGNS AND POSTS AND OTHER RELATED HIGHWAY ITEMS.

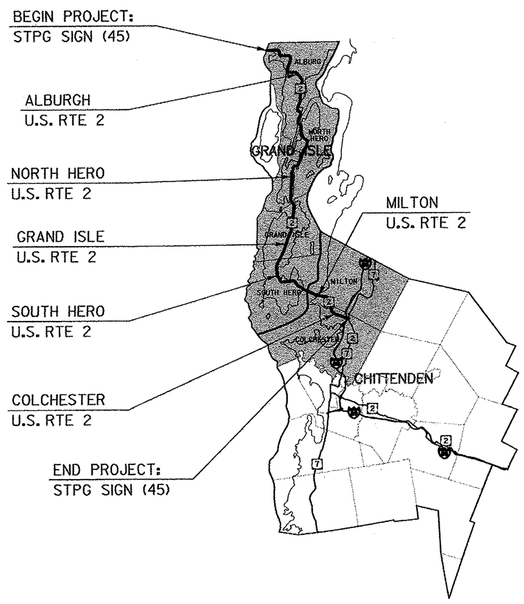

NOT TO SCALE

RECORD PLANS

CONTRACTOR: F. R. LAFAYETTE, INC. - ESSEX JUNCTION, VT

RESIDENT ENGINEER: JEFF COTA

CONSTRUCTION BEGAN: OCTOBER 30, 2014

CONSTRUCTION COMPLETE: MAY 04, 2015

RECORD PLANS BY: JEFF COTA & JESSE IVES

I HEREBY CERTIFY THAT ALL THE CONSTRUCTION REQUIRED BY THIS SET OF DRAWINGS HAS BEEN ACCOMPLISHED AS INDICATED HEREIN.

BY _____ RESIDENT ENGINEER

DATE 7/5/18

NOTE: Any further information concerning final quantities, amounts or other details relative to this project may be found by contacting Vtrans Records Management.

THESE PLANS ARE SUBJECT TO SUCH ENGINEERING CHANGES AS MAY BE REQUIRED BY THE FEDERAL HIGHWAY ADMINISTRATION OR THE DIRECTOR OF PROGRAM DEVELOPMENT.

CONSTRUCTION IS TO BE CARRIED ON IN ACCORDANCE WITH THESE PLANS AND THE STANDARD SPECIFICATIONS FOR CONSTRUCTION DATED 2011, AS APPROVED BY THE FEDERAL HIGHWAY ADMINISTRATION ON JULY 20, 2011 FOR USE ON THIS PROJECT, INCLUDING ALL SUBSEQUENT REVISIONS AND SUCH REVISED SPECIFICATIONS AND SPECIAL PROVISIONS AS ARE INCORPORATED IN THESE PLANS.

QUALITY ASSURANCE PROGRAM : LEVEL 3

SURVEYED BY :
SURVEYED DATE :

DATUM
VERTICAL
HORIZONTAL

STATE OF VERMONT
DARIN W. BRYANT
No. 6102
PROFESSIONAL ENGINEER
4-16-2014

T.Y.LIN INTERNATIONAL

DIRECTOR OF PROGRAM DEVELOPMENT
APPROVED _____ DATE 4-30-14

PROJECT MANAGER : DEREK LYMAN, P.E.

PROJECT NAME : ALBURGH-COLCHESTER
PROJECT NUMBER : STPG SIGN (45)

SHEET 1 OF 167 SHEETS

INDEX OF SHEETS:

1	TITLE SHEET
2	PROJECT NOTES
3	QUANTITY SHEET
4-14	SIGN DETAILS 1-11
15-41	ALBURGH US-2 EASTBOUND TRAFFIC SIGN SUMMARY SHEETS
42-66	ALBURGH US-2 WESTBOUND TRAFFIC SIGN SUMMARY SHEETS
67-75	NORTH HERO US-2 EASTBOUND TRAFFIC SIGN SUMMARY SHEETS
76-85	NORTH HERO US-2 WESTBOUND TRAFFIC SIGN SUMMARY SHEETS
86-95	GRAND ISLE US-2 EASTBOUND TRAFFIC SIGN SUMMARY SHEETS
96-106	GRAND ISLE US-2 WESTBOUND TRAFFIC SIGN SUMMARY SHEETS
107-117	SOUTH HERO US-2 EASTBOUND TRAFFIC SIGN SUMMARY SHEETS
118-129	SOUTH HERO US-2 WESTBOUND TRAFFIC SIGN SUMMARY SHEETS
130-136	MILTON US-2 EASTBOUND TRAFFIC SIGN SUMMARY SHEETS
137-143	MILTON US-2 WESTBOUND TRAFFIC SIGN SUMMARY SHEETS
144-156	COLCHESTER US-2 EASTBOUND TRAFFIC SIGN SUMMARY SHEETS
157-166	COLCHESTER US-2 WESTBOUND TRAFFIC SIGN SUMMARY SHEETS
167	TOWN TOTAL SIGN SUMMARY SHEET

STANDARDS:

E-121	STANDARD SIGN PLACEMENT - CONVENTIONAL ROAD	08/08/1995
E-138	MILEMARKER DETAILS - STATE & TOWN HIGHWAYS	05/30/2003
E-154	WARNING SIGNS DETAIL	05/01/2004
T-40	DELINEATORS AND MILEPOSTS	01/02/2013
T-45	SQUARE TUBE SIGN POST AND ANCHOR	01/02/2013

2-1/2" SOIL BEARING SLIP BASE LOCATIONS(ITEM 900.620 SPECIAL PROVISION):

TOWN	DIRECTION	MILE POINT	NO. REQ.	SHEET
ALBURGH	EB	2.499	2	18
ALBURGH	EB	6.178	2	32
GRAND ISLE	EB	4.406	2	92
GRAND ISLE	WB	4.558	2	98
MILTON	EB	2.696	2	133
MILTON	EB	3.200	2	134
COLCHESTER	EB	0.225	2	145
COLCHESTER	EB	1.667	2	150
COLCHESTER	WB	0.142	2	165

1. THE LOCATIONS SHOWN IN THE TABLE ABOVE WILL REQUIRE THAT EACH 2-1/2" SQUARE STEEL SIGN POST, AS SPECIFIED ON THE APPLICABLE SIGN SUMMARY SHEET, BE INSTALLED USING A SOIL BEARING SLIP BASE WITH ANCHOR SLEEVE. AT THESE SPECIFIED LOCATIONS THE 2-1/2" POSTS ARE NOT PROTECTED BY GUARDRAIL OR CURBING, THUS REQUIRING THE USE OF SOIL BEARING SLIP BASES FOR THE SIZE POST.
2. PAYMENT FOR SOIL BEARING SLIP BASE (EACH) WILL BE MADE UNDER CONTRACT ITEM 900.620 SPECIAL PROVISTION (SOIL BEARING SLIP BASE) (2-1/2").

TEMPORARY TRAFFIC CONTROL NOTES:

1. THE CONTRACTOR SHALL SUBMIT A SITE-SPECIFIC TRAFFIC CONTROL PLAN CONFORMING TO THE MANUAL ON UNIFORM TRAFFIC CONTROL DEVICES (MUTCD), DATED 2009, AND ITS LATEST REVISIONS, TO THE ENGINEER AT THE PRE-CONSTRUCTION MEETING, FOR REVIEW AND APPROVAL BY THE ENGINEER.
2. WHEN WORKING IN THE VICINITY OF EXISTING PEDESTRIAN FACILITIES, AMERICANS WITH DISIBILITIES ACT (A.D.A.) ACCESSIBLE PEDESTRIAN ACCOMMODATIONS SHALL BE MAINTAINED AT ALL TIMES. PAYMENT SHALL BE INCLUDED IN THE UNIT BID PRICE FOR CONTRACT ITEM 641.10 TRAFFIC CONTROL.
3. THE CONTRACTOR SHALL PROVIDE ACCESS THROUGH THE WORK ZONE FOR EMERGENCY VEHICLES AT ALL TIMES.
4. THE CONTRACTOR SHALL CONDUCT THE WORK AT ALL TIMES IN SUCH A MANNER AND IN SUCH SEQUENCE SO AS TO ENSURE THE LEAST INTERFERENCE WITH TRAFFIC OCCURS.
5. TEMPORARY TRAFFIC CONTROL SIGNS SHALL ONLY BE VISIBLE TO MOTORISTS AT THE TIMES WHEN THE MESSAGE IS PERTINENT, E.G. A "FLAGGER AHEAD" SIGN SHALL ONLY BE VISIBLE TO MOTORISTS WHEN THE FLAGGER IS ACTUALLY PRESENT PERFORMING THEIR DUTIES.
6. PAYMENT FOR CONSTRUCTION SIGNING WILL BE MADE UNDER CONTRACT ITEM 641.10 TRAFFIC CONTROL.
7. TEMPORARY TRAFFIC CONTROL SIGNS SHALL BE MOVED AS WORK AREA MOVES. AT NO TIME SHALL THE FLAGGER SIGN BE GREATER THAN 1000 FEET IN ADVANCE OF THE FLAGGER STATION.

SIGN DESIGN AND FABRICATION:

1. THE MANUAL ON UNIFORM TRAFFIC CONTROL DEVICES (MUTCD) SIGN CODES PROVIDED IN THESE PLANS REFER TO THE 2009 MUTCD WITH ITS LATEST REVISIONS. DESIGN DETAILS FOR SIGNS INDICATED ON THE PLANS, AS FOUND IN THE STANDARD HIGHWAY SIGNS AND MARKINGS BOOK (SHSM), SHALL BE PER THE 2004 SHSM AND THE 2012 SUPPLEMENT TO THE 2004 EDITION.
2. SIGN SHEETING FOR FLUORESCENT YELLOW (FY) AND FLUORESCENT YELLOW-GREEN (FYG) SHALL BE ASTM D4956 TYPE VII, VIII, OR IX. ALL OTHER SIGN SHEETING SHALL BE TYPE III OR IV.
3. SHEETING TYPES AND SHEETING FABRICATED BY DIFFERENT MANUFACTURERS SHALL NOT BE MIXED ON A SINGLE SIGN ASSEMBLY. SHEETING COLOR/TYPE SHOULD BE BY THE SAME MANUFACTURER AND SHOULD BE CONSISTENT THROUGHOUT THE PROJECT.
4. SIGN BASE MATERIAL FOR ALL STREET NAME SIGNS SHALL BE EITHER 0.125 INCH THICK FLAT SHEET ALUMINUM OR EXTRUDED ALUMINUM WITH A 0.250 INCH THICK FLANGE AND 0.090 INCH MINIMUM WEB THICKNESS.
5. UNLESS OTHERWWISE NOTED ON THE PLANS, ALL SIGNS SHALL BE FLAT SHEET ALUMINUM WITH THE FOLLOWING MINIMUM THICKNESSES:

SIGN SIZE	12" X 12"		
	18" X 18"		
	21" X 15"		
	24" X 8"		
	24" X 10"		48" X 18"
	24" X 12"	36" X 12"	48" X 24"
	24" X 18"	36" X 15"	48" X 30"
	24" X 24"	36" X 18"	48" X 42"
	24" X 30"	36" X 24"	48" X 48"
	30" X 15"	36" X 36"	48" X 60"
	30" X 18"	36" X 42"	72" X 10"
	30" X 30"	36" X 48"	72 X 12"
	30" X 42"	36" X 54"	72" X 20"
THICKNESS	0.080"	0.100"	0.125"

SIGN POSTS:

1. ALL SQUARE STEEL SIGN POSTS SHALL BE INSTALLED IN A NEW ANCHOR. ALL SIGNS INSTALLED IN PAVED OR CONCRETE ISLANDS OR SIDEWALKS SHALL ALSO BE INSTALLED WITH AN 18" SLEEVE. PAYMENT FOR SLEEVE SHALL BE INCIDENTAL TO CONTRACT ITEM 675.341 SQUARE TUBE SIGN POST AND ANCHOR.

1. THE 1.75" SQUARE STEEL POSTS SHALL BE 14 GAGE STEEL. THE 2.0" AND 2.5" SQUARE STEEL POSTS SHALL BE 12 GAGE STEEL.
2. DIAMOND-SHAPED ADVANCE WARNING SIGNS 36" AND LARGER WILL REQUIRE TWO POSTS. ASSEMBLIES WITH TWO 30" DIAMOND-SHAPED SIGNS WILL REQUIRE TWO POSTS. POST SPACING SHALL BE AS FOLLOWS:

30" SIGN	15-20"
36" SIGN	18-24"
48" SIGN	24-32"

SIGN INSTALLATION:

1. THE CONTRACTOR SHALL BE RESPONSIBLE FOR REPAIRING ANY DAMAGE TO PRIVATE OR PUBLIC PROPERTY CAUSED BY THE CONTRACTOR, AT THE CONTRACTOR'S EXPENSE AND AT NO EXPENSE TO THE STATE.
2. ALL SIGNS WITHIN THE PROJECT LIMITS ARE TO BE REPLACED, UNLESS OTHERWISE NOTED ON THE PLANS OR AS DIRECTED BY THE ENGINEER. SIGN LOCATIONS AS SHOWN ON THE PLANS ARE APPROXIMATE; EXACT LOCATIONS TO BE DETERMINED IN THE FIELD
3. ALL SIGN PLACEMENT SHALL BE IN CONFORMANCE WITH VAOT STANDARD E-121 STANDARD SIGN PLACEMENT CONVENTIONAL ROADS, UNLESS OTHERWISE NOTED.
4. ALL SIGNS, FRAMES, MOUNTING HARDWARE, POSTS, AND ANCHORS FOR ANY SIGN ASSEMBLY SHALL BE REPLACED AT THE SAME TIME. MIXING OF OLD AND NEW SIGNS ON THE SAME ASSEMBLY WILL NOT BE ALLOWED.
5. NEW SIGNS, WITH THEIR GREATER NIGHTTIME RETROREFLECTIVITY, CAN OBSCURE OLDER SIGNS MOUNTED IN CLOSE PROXIMITY TO THEM. TO AVOID CONFUSION OF ROAD USERS, WORK SHALL BE COORDINATED SUCH THAT ALL SIGNS ASSOCIATED WITH A CURVE, INTERSECTION OR SPEED LIMIT CHANGE SHALL BE REPLACED ON THE SAME DAY AND NOT LEFT INCOMPLETE OR WITH A MIXTURE OF OLD AND NEW SIGNS WITHIN A GROUP OF ASSOCIATED SIGNS.
6. ALL NEW SIGNS INSTALLATIONS, IF NEAR A UTILITY POLE, SHALL BE NO CLOSER THAN 10 FEET FROM THE UTILITY POLE.

STREET NAME SIGN INSTALLATION:

1. SIDE ROAD STREET NAME SIGNS, COMMONLY INSTALLED PERPENDICULAR TO APPROACHING MAINLINE TRAFFIC, SHALL BE POSITIONED IN SUCH A WAY AS TO ENSURE THE BEST POSSIBLE VISIBILITY TO APPROACHING MAINLINE TRAFFIC FROM EACH DIRECTION. IN MOST CASES, STREET NAME SIGNS MAY BE INSTALLED ABOVE THE SIDE ROAD STOP SIGN. IN CASES WHERE THE SIDE ROAD STOP SIGN POSITION WOULD NOT BE SUITABLE FOR A TOP-MOUNTED STREET NAME SIGN, OR DUE TO OTHER SITE-SPECIFIC CONSTRAINTS, THE STREET NAME SIGN MAY BE INSTALLED A MINIMUM OF SIX FEET FROM THE EDGE OF PAVEMENT OF THE MAINLINE ROUTE TO THE NEAREST EDGE OF THE SIGN.
2. STREET NAME SIGNS WITH A LENGTH EXCEEDING 42-INCHES SHALL BE INSTALLED ON TWO POSTS. UNLESS PROTECTED BY BARRIER, THIS TWO POST ASSEMBLY SHALL BE LATERALLY OFFSET A MINIMUM OF TWO FEEET (IN THE DIRECTION OF MAINLINE TRAFFIC) FROM ANY OTHER SIGN POST; NO MORE THAN TWO POSTS SHALL OCCUPY AN EIGHT FOOT TRAVEL PATH, UNLESS PROTECTED BY BARRIER.
3. TOP-MOUNTED STREET NAME SIGNS SHALL REQUIRE 12-INCH MOUNTING BRACKETS. MOUNTING BRACKET AND ALL MOUNTING HARDWARE IS INCIDENTAL TO PAY ITEM 675.20 (TRAFFIC SIGNS, TYPE A).
4. IF EXISTING STREET SIGNS ARE SALVAGED, THEY SHALL BE RE-INSTALLED PER THE ABOVE NOTES OR AS DIRECTED BY THE ENGINEER.
5. STREET NAME SIGNS FOR PRIVATE ROADS SHALL BE RETAINED, UNLESS OTHERWISE NOTED OR AS DIRECTED BY THE ENGINEER.

GENERAL NOTES:

1. EXISTING STAND-ALONE MILE MARKER SIGNS OR CHAMPLAIN BIKEWAY SIGNS, OR MILE MARKER SIGNS OR CHAMPLAIN BIKEWAYS SIGNS ATTACHED TO A RETAINED SIGN POST ASSEMBLY, SHALL BE RETAINED.
2. EXISTING MILE MARKER SIGNS OR CHAMPLAIN BIKEWAYS SIGNS ON SIGN POST BEING REPLACED SHALL BE REMOVED AND SALVAGED ONTO THE NEW SIGN POST, UNLESS OTHERWISE NOTED ON THE APPLICABLE SIGN SUMMARY SHEET OR AS DIRECTED BY THE ENGINEER.
3. EXISTING MILE MARKER SIGNS OR CHAMPLAIN BIKEWAY SIGNS ATTACHED TO A SIGN ASSEMBLY THAT IS TO BE REMOVED OR RELOCATED SHALL BE REMOVED AND DISPOSED OF, UNLESS OTHERWISE NOTED ON THE APPLICABLE SIGN SUMMARY SHEET OR AS DIRECTED BY THE ENGINEER.
4. ESTIMATED QUANTITIES OF CONTRACT ITEMS 675.50 REMOVING SIGNS AND 675.60 ERECTING SALVAGED SIGNS HAVE BEEN INCLUDED FOR MILE MARKER AND STREET NAME SIGNS.
5. SELECTIVE CUTTING OF BRUSH OR TREE BRANCHES IN THE IMMEDIATE VICINITY OF A SIGN MAY BE NECESSARY TO PROVIDE FULL VISIBILITY FOR ANY EXISTING (RETAINED) OR NEW SIGN LOCATION. THIS WORK WILL BE PERFORMED AT THE DIRECTION OF THE ENGINEER AND PAID FOR UNDER CONTRACT ITEM 201.31 THINNING AND TRIMMING FOR SIGNS. THIS WORK SHALL BE DONE AT THE SAME TIME THE SIGN IS INSTALLED, OR AS DIRECTED BY THE ENGINEER. ALL SIGNS SHALL BE FULLY VISIBLE FROM THE APPROACHING TRAVEL LANE FOR A MINIMUM DISTANCE OF 250 FEET.

STATE OF VERMONT
AGENCY OF TRANSPORTATION

QUANTITY SHEET 1


SUMMARY OF ESTIMATED QUANTITIES	TOTALS		DESCRIPTIONS				DETAILED SUMMARY OF QUANTITIES		
ROADWAY	GRAND TOTAL	FINAL	UNIT	ITEMS	ITEM NUMBER	ROUND	QUANTITIES	UNIT	ITEMS
26	26		EACH	THINNING AND TRIMMING FOR SIGNS	201.31	EST			
1	1		CY	TRENCH EXCAVATION OF EARTH, EXPLORATORY (N.A.B.I.)	204.22	EST			
80	80		HR	UNIFORMED TRAFFIC OFFICERS	630.10	EST			
240	240		HR	FLAGGERS	630.15	EST			
1	1		LS	MOBILIZATION/DEMOBILIZATION	635.11	-			
1	1		LS	TRAFFIC CONTROL	641.10	-			
5323	5323		SF	TRAFFIC SIGNS, TYPE A	675.20	-			
8010	8010		LF	SQUARE TUBE SIGN POST AND ANCHOR	675.341	-			
886	886		EACH	REMOVING SIGNS	675.50	EST			
13	13		EACH	ERECTING SALVAGED SIGNS	675.60	EST			
196	196		EACH	DELINEATOR WITH STEEL POST	676.10	-			
18	18		EACH	SPECIAL PROVISION (SOIL BEARING SLIP BASE)(2 1/2")	900.620	-			

PROJECT NAME: ALBURGH-COLCHESTER
PROJECT NUMBER: STPG SIGN(45)


TYLIN INTERNATIONAL

FILE NAME: z12b530qty.dgn
PROJECT LEADER: D. BRYANT
DESIGNED BY: B. TOOTHAKER
QUANTITY SHEET

PLOT DATE: 4/28/2014
DRAWN BY: J. BLANCHARD
CHECKED BY: K. KERN
SHEET 3 OF 167

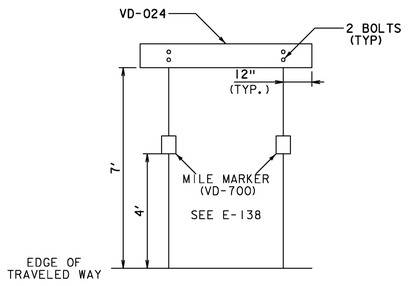


WHEN CROSSING COUNTY BONDARIES, AN ADDITIONAL COUNTY LINE SIGN (VD-025) SHALL BE MOUNTED BELOW THE TOWN LINE SIGN (VD-024), MAINTAINING A SEVEN FOOT CLEARANCE.

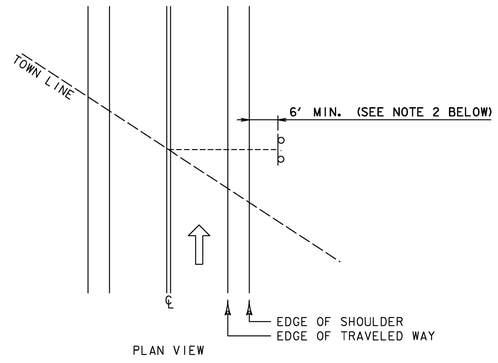


TOWN / COUNTY LINE (VD-024 / VD-025) INSTALLATION:

1. THE SIGN SHALL BE MOUNTED PARALLEL WITH THE ROADWAY, NORMALLY ON THE RIGHT SIDE TRAVELLING WEST TO EAST OR SOUTH TO NORTH.
2. FOR POST-MOUNTED SIGNS, THE MINIMUM LATERAL OFFSET SHOULD BE TWELVE FEET FROM THE EDGE OF THE TRAVELED WAY. IF A SHOULDER WIDER THAN SIX FEET EXISTS, THE MINIMUM LATERAL OFFSET FOR POST MOUNTED SIGNS SHOULD BE SIX FEET FROM THE EDGE OF SHOULDER.

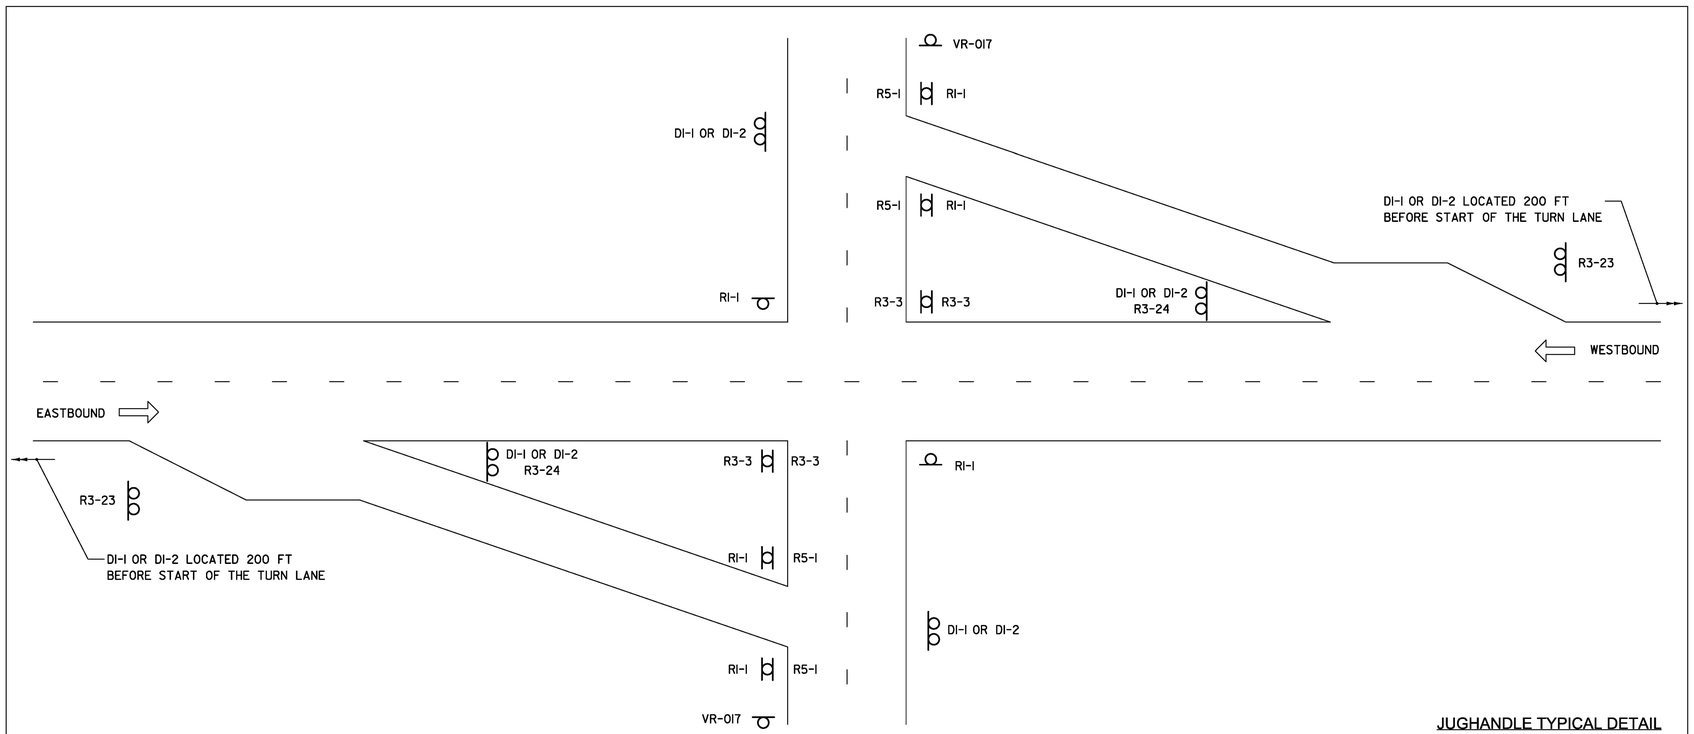

JUGHANDLE TYPICAL DETAIL

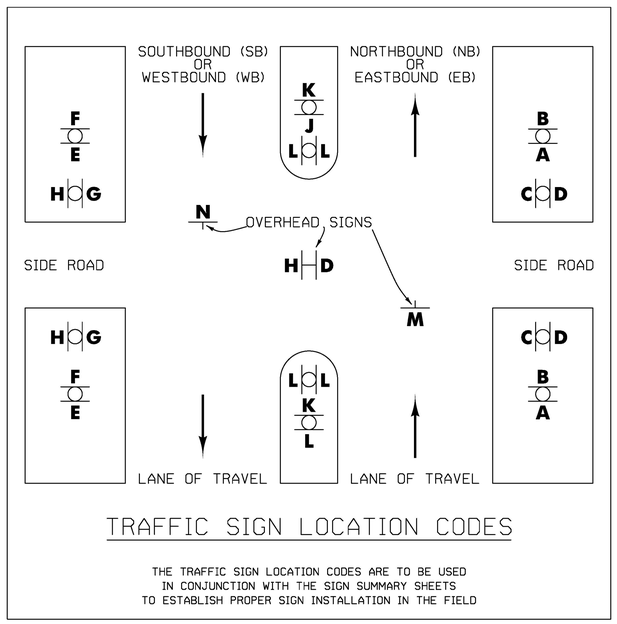

TRAFFIC SIGN LOCATION CODES

THE TRAFFIC SIGN LOCATION CODES ARE TO BE USED IN CONJUNCTION WITH THE SIGN SUMMARY SHEETS TO ESTABLISH PROPER SIGN INSTALLATION IN THE FIELD

DELINEATOR LOCATIONS:

TOWN:	DIRECTION:	MILE POINT:	NO. OF NEW TYPE II DELINEATORS (POSTS):	NO. OF REMOVALS:	POST SPACING:	SHEET:
ALBURGH	EB	8.291 - 8.400	20 (10)	-	60	36
ALBURGH	WB	8.119 - 7.989	16 (8)	-	100	45
ALBURGH	WB	6.872 - 6.679	26 (13)	-	85	45
ALBURGH	WB	5.824 - 5.625	30 (15)	-	75	50
ALBURGH	WB	3.049 - 2.830	22 (11)	-	100	63
NORTH HERO	EB	2.404 - 2.511	16 (8)	-	80	68
NORTH HERO	EB	5.154 - 5.268	12 (6)	-	120	70
NORTH HERO	WB	5.071 - 5.019	12 (6)	-	55	80
NORTH HERO	WB	2.804 - 2.709	10 (5)	-	130	81
NORTH HERO	WB	2.639 - 2.497	14 (7)	-	125	81
NORTH HERO	WB	2.183 - 2.033	18 (9)	-	100	82

NOTE: ALL DELINEATOR PLACEMENT SHALL BE IN CONFORMANCE WITH VAOT STANDARD T-40 DELINEATORS AND MILEPOSTS, UNLESS OTHERWISE NOTED.

ALL DELINEATORS WILL BE PLACED BACK TO BACK.

ALL DIMENSIONS SHOWN IN INCHES, EXCEPT WHERE NOTED.
NOT TO SCALE


PROJECT NAME:	ALBURGH-COLCHESTER
PROJECT NUMBER:	STPG SIGN(45)

NOT TO SCALE

TYLIN INTERNATIONAL


FILE NAME: z12b530_SD01.dgn	PLOT DATE: 4/15/2014
PROJECT LEADER: D. BRYANT	DRAWN BY: J. BLANCHARD
DESIGNED BY: B. TOOTHAKER	CHECKED BY: K. KERN
SIGN DETAILS I	SHEET 4 OF 167

TYPE 1

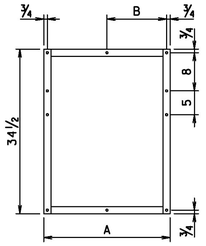


FRAME TYPE	A	B
1A	26 1/2	12 1/2
1B	29 1/2	15 1/2
1C	32 1/2	15 1/2

TYPE 2

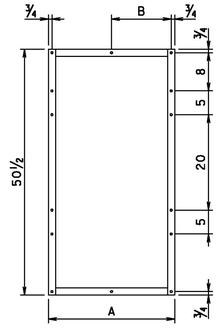


FRAME TYPE	A	B
2A	26 1/2	12 1/2
2B	29 1/2	15 1/2
2C	32 1/2	15 1/2


TYPE 3

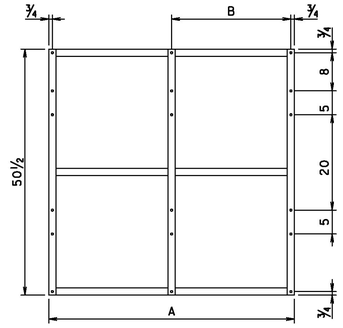


FRAME TYPE	A	B
3A	51 1/2	25
3B	54 1/2	28
3C	57 1/2	28
3D	63 1/2	31

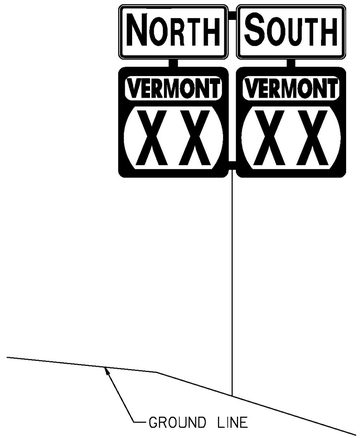

ROUTE MARKER ASSEMBLY TYPE 1

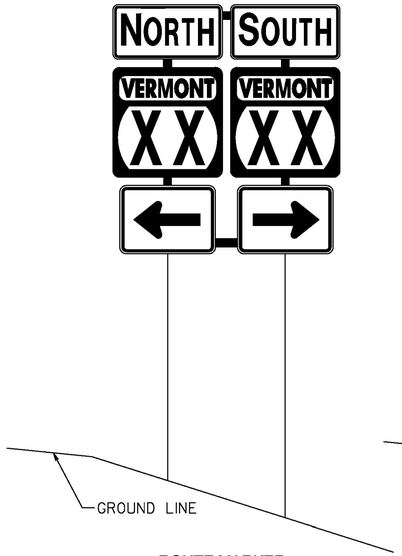



ROUTE MARKER ASSEMBLY TYPE 2

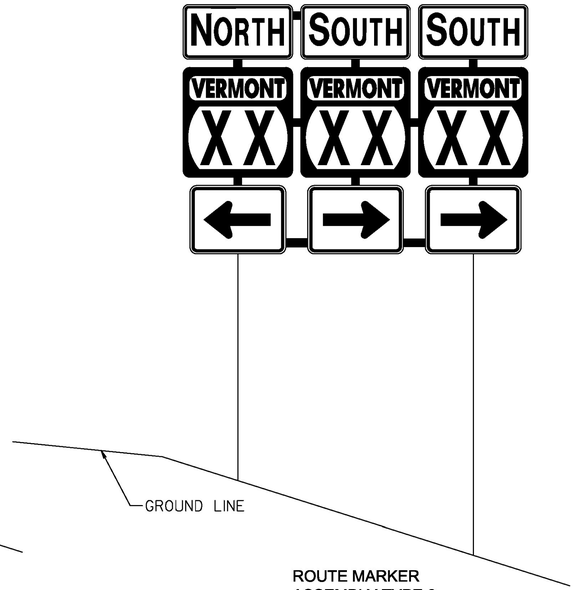

ROUTE MARKER ASSEMBLY TYPE 3

ROUTE MARKER ASSEMBLY FRAMES

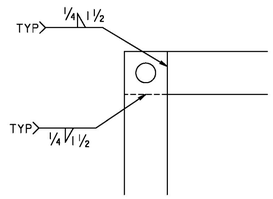

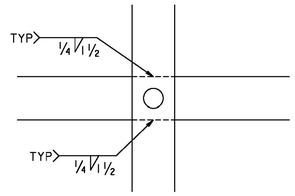

WELDING DETAILS

GENERAL NOTES:

1. TYPE 1A FRAME ASSEMBLY TO BE USED WITH TWO 24 INCH WIDE SIGN COLUMNS.
2. TYPE 1B FRAME ASSEMBLY TO BE USED WITH ONE 24 INCH WIDE SIGN COLUMN AND ONE 30 INCH WIDE SIGN COLUMN.
3. TYPE 1C FRAME ASSEMBLY TO BE USED WITH TWO 30 INCH WIDE SIGN COLUMNS.
4. TYPE 2A FRAME ASSEMBLY TO BE USED WITH TWO 24 INCH WIDE SIGN COLUMNS.
5. TYPE 2B FRAME ASSEMBLY TO BE USED WITH ONE 24 INCH COLUMN AND ONE 30 INCH WIDE SIGN COLUMN.
6. TYPE 2C FRAME ASSEMBLY TO BE USED WITH TWO 30 INCH WIDE COLUMNS.
7. TYPE 3A FRAME ASSEMBLY TO BE USED WITH THREE 24 INCH WIDE SIGN COLUMNS.
8. TYPE 3B FRAME ASSEMBLY TO BE USED WITH TWO 24 INCH SIGN COLUMNS AND ONE 30 INCH WIDE SIGN COLUMN, WITH THE 30 INCH SIGN COLUMN IN AN OUTSIDE POSITION.
9. TYPE 3C FRAME ASSEMBLY TO BE USED WITH ONE 24 INCH WIDE SIGN COLUMN IN THE CENTER AND TWO 30 INCH SIGN COLUMNS ON THE OUTSIDE OR ONE 30 INCH SIGN COLUMN IN TEH CENTER AND TWO 24 INCH COLUMNS ON THE OUTSIDE.
10. TYPE 3D FRAME ASSEMBLY TO BE USED WITH THREE 30 INCH WIDE SIGN COLUMNS.
11. ALL HOLES SHALL BE 7/16 INCH DIAMATER.
12. FOR SIGN COMBINATIONS OTHER THAN ABOVE, THE FRAME DIMENSIONS AND HOLE SPACING SHALL BE MODIFIED AS NECESSARY.
13. STANDARD FRAMES SHALL BE CONSTRUCTED OF 5/16 INCH X 1½ INCH A-36 STEEL.
14. SEE THE MANUAL ON UNIFORM TRAFFIC CONTROL DEVICES (MUTCD) SECTION 2D.29 FOR INSTALLATION SEQUENCE.
15. ALL DIMENSIONS SHOWN IN INCHES, UNLESS OTHERWISE NOTED.

STDS. REQUIRED: E-121 REPLACEMENT STD


ALL DIMENSIONS SHOWN IN INCHES, EXCEPT WHERE NOTED.
NOT TO SCALE

PROJECT NAME: ALBURGH-COLCHESTER
PROJECT NUMBER: STPG SIGN(45)


TYLIN INTERNATIONAL

FILE NAME: z12b530_SD01.dgn
PROJECT LEADER: D. BRYANT
DESIGNED BY: B. TOOTHAKER
SIGN DETAILS 2


PLOT DATE: 4/15/2014
DRAWN BY: J. BLANCHARD
CHECKED BY: K. KERN
SHEET 5 OF 167

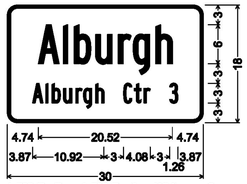


1.50" Radius, 0.50" Border, White on Green;
"Alburgh" B specified length;
"Alburgh Ctr" B specified length; "3" B;

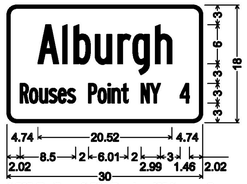


1.50" Radius, 0.50" Border, White on Green;
"Alburgh" B specified length;
"Rouses Point NY" B specified length; "4" B;

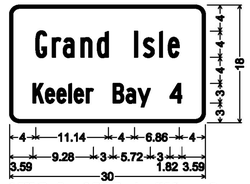


1.50" Radius, 0.50" Border, White on Green;
"Grand Isle" B specified length;
"Keeler Bay" C specified length; "4" C;

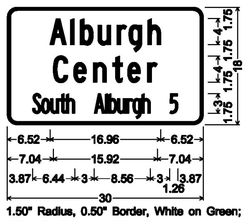


1.50" Radius, 0.50" Border, White on Green;
"Alburgh" C specified length;
"Center" C specified length;
"South Alburgh" B specified length; "5" B;

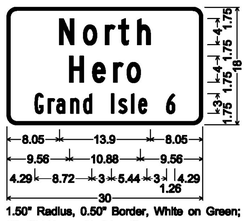


1.50" Radius, 0.50" Border, White on Green;
"North" C specified length;
"Hero" C specified length;
"Grand Isle" B specified length; "6" B;

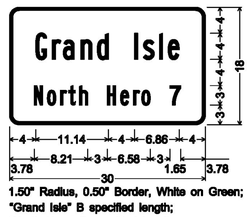


1.50" Radius, 0.50" Border, White on Green;
"Grand Isle" B specified length;
"North Hero" B specified length;
"7" C;

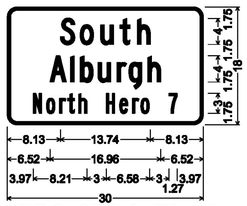


1.50" Radius, 0.50" Border, White on Green;
"South" C specified length;
"Alburgh" C specified length;
"North Hero" B specified length; "7" B;

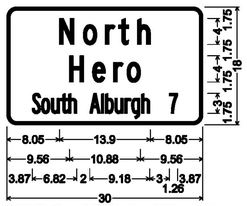


1.50" Radius, 0.50" Border, White on Green;
"North" C specified length;
"Hero" C specified length;
"South Alburgh" B specified length; "7" B;

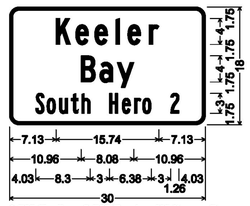

1.50" Radius, 0.50" Border, White on Green;
"Keeler" C specified length;
"Bay" C specified length;
"South Hero" B specified length; "2" B;

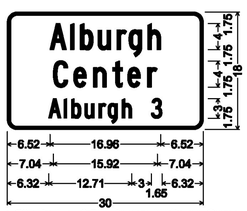


1.50" Radius, 0.50" Border, White on Green;
"Alburgh" C specified length;
"Center" C specified length;
"Alburgh" C specified length; "3" C;

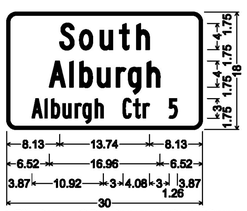

1.50" Radius, 0.50" Border, White on Green;
"South" C specified length;
"Alburgh" C specified length;
"Alburgh Ctr" B specified length; "5" B;


ALL SIGNS IN THIS SECTION ARE SIGN CODE VD–018

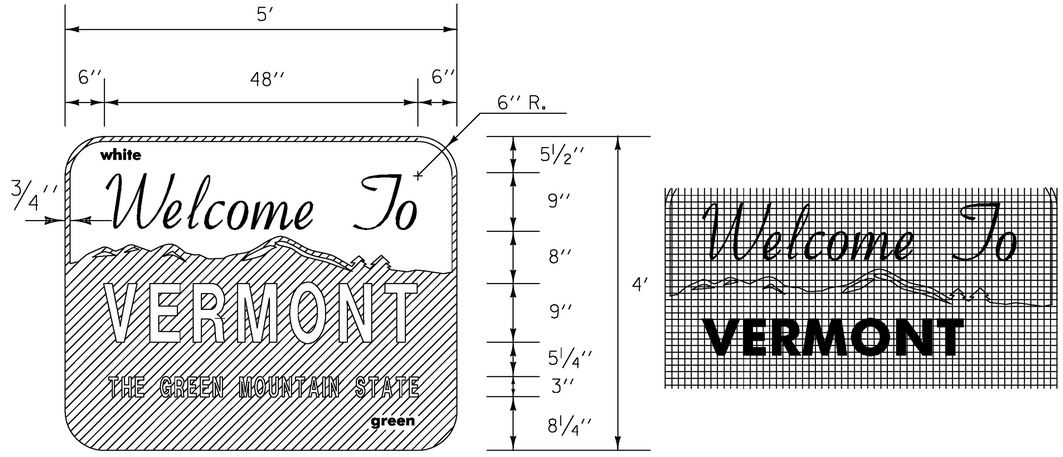


VD–421

NOTE:
FOR THE WORDS "WELCOME TO" USE GERBER FONT MURRAY HILL BOLD OR EQUIVALENT. TEXT COLOR IS GREEN. ALL OTHER TEXT USE GERBER FONT SOUVENIR DEMIBOLD OR EQUIVALENT. TEXT COLOR IS WHITE. ALL SHEETING SHALL BE MIN. ASTM D 4956 TYPE III RETROREFLECTIVE.

MATERIALS:
THE SIGN BASE MATERIAL USED FOR THIS SIGN SHALL BE FLAT SHEET ALUMINUM 0.125" MIN.

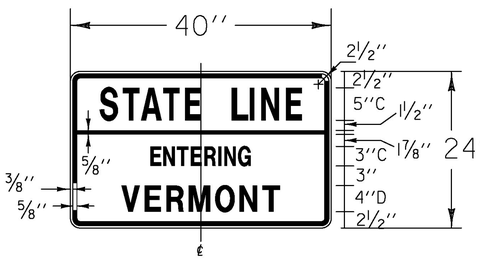

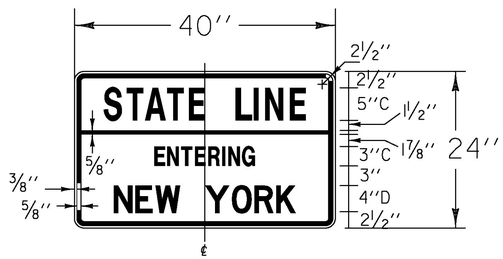

ALL SIGNS IN THIS SECTION ARE SIGN CODE VD–450


ALL DIMENSIONS SHOWN IN INCHES, EXCEPT WHERE NOTED.
NOT TO SCALE

PROJECT NAME: ALBURGH-COLCHESTER
PROJECT NUMBER: STPG SIGN(45)


T.Y. LIN INTERNATIONAL

FILE NAME: z12b530_SD02.dgn
PROJECT LEADER: D. BRYANT
DESIGNED BY: B. TOOTHAKER
SIGN DETAILS 3


PLOT DATE: 4/15/2014
DRAWN BY: J. BLANCHARD
CHECKED BY: K. KERN
SHEET 6 OF 167

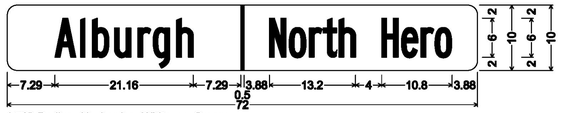


1.50" Radius, No border, White on Green;
"Alburgh" B specified length; "North Hero" B specified length;

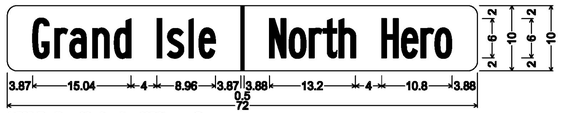


1.50" Radius, No border, White on Green;
"Grand Isle" B specified length; "North Hero" B specified length;

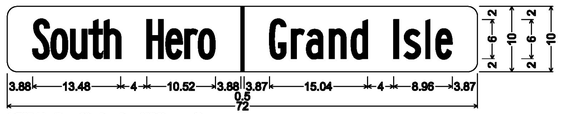

1.50" Radius, No border, White on Green;
"South Hero" B specified length; "Grand Isle" B specified length;

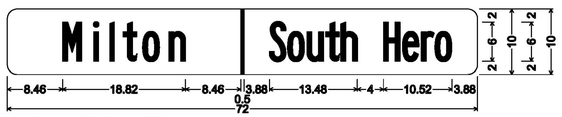


1.50" Radius, No border, White on Green;
"Milton" B specified length; "South Hero" B specified length;

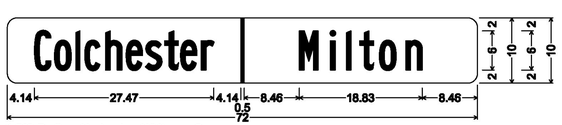

1.50" Radius, No border, White on Green;
"Colchester" B specified length; "Milton" B specified length;

ALL SIGNS IN THIS SECTION ARE SIGN CODE VD-024

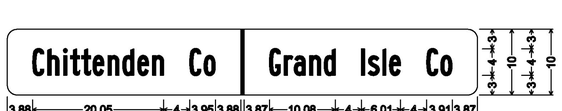


1.50" Radius, No border, White on Green;
"Chittenden Co" B specified length; "Grand Isle Co" B specified length;


ALL SIGNS IN THIS SECTION ARE SIGN CODE VD-025




0.75" Inner border Black, 3.00" Radius, 0.50" Outer border, Yellow on Yellow;
Arrow Custom - 6.00" 180° Black; "E Shore Rd" Black D;
"Hyde Rd" Black D; Arrow Custom - 6.00" 0° Black;

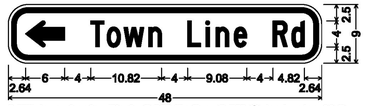

0.75" Inner border Black, 3.00" Radius, 0.50" Outer border, Yellow on Yellow;
Arrow Custom - 6.00" 180° Black;
"Town Line Rd" Black C 80% spacing;

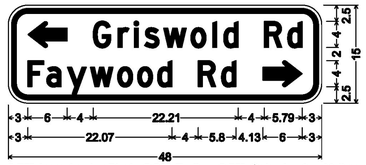

0.75" Inner border Black, 3.00" Radius, 0.50" Outer border, Yellow on Yellow;
Arrow Custom - 6.00" 180° Black; "Griswold Rd" Black D;
"Faywood Rd" Black D; Arrow Custom - 6.00" 0° Black;

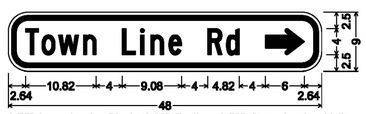

0.75" Inner border Black, 3.00" Radius, 0.50" Outer border, Yellow on Yellow;
"Town Line Rd" Black C 80% spacing;
Arrow Custom - 6.00" 0° Black;


ALL SIGNS IN THIS SECTION ARE SIGN CODE W16-8A




1.50" Radius, 0.38" Border, White on Green;
Standard Arrow Custom 9.00" X 6.13" 180"; "Noyan Quebec" C;




1.50" Radius, 0.38" Border, White on Green;
"Swanton" C; "13" C; Standard Arrow Custom 9.00" X 6.13" 45";

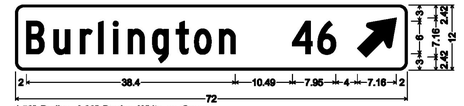


1.50" Radius, 0.38" Border, White on Green;
"Burlington" C; "46" C; Standard Arrow Custom 9.00" X 6.13" 45";

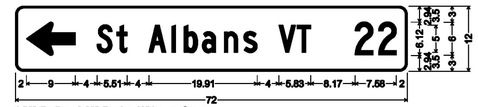


1.50" Radius, 0.38" Border, White on Green;
Standard Arrow Custom 9.00" X 6.13" 180"; "St Albans VT" C; "22" C;

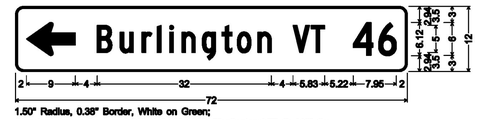

1.50" Radius, 0.38" Border, White on Green;
Standard Arrow Custom 9.00" X 6.13" 180"; "Burlington VT" C; "46" C;

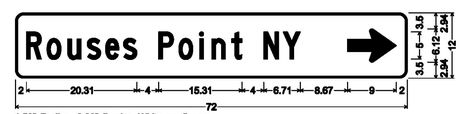

1.50" Radius, 0.38" Border, White on Green;
"Rouses Point NY" C; Standard Arrow Custom 9.00" X 6.13" 0";

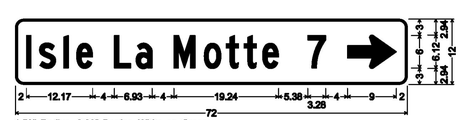

1.50" Radius, 0.38" Border, White on Green;
"Isle La Motte" C; "7" C; Standard Arrow Custom 9.00" X 6.13" 0";

ALL SIGNS IN THIS SECTION ARE SIGN CODE D1-1

ALL DIMENSIONS SHOWN IN INCHES, EXCEPT WHERE NOTED.
NOT TO SCALE

PROJECT NAME:	ALBURGH-COLCHESTER
PROJECT NUMBER:	STPG SIGN(45)

TYLIN INTERNATIONAL

FILE NAME: z12b530_SD02.dgn	PLOT DATE: 4/15/2014
PROJECT LEADER: D. BRYANT	DRAWN BY: J. BLANCHARD
DESIGNED BY: B. TOOTHAKER	CHECKED BY: K. KERN
SIGN DETAILS 4	SHEET 7 OF 167




1.50" Radius, 0.38" Border, White on Green;
Standard Arrow Custom 9.00" X 6.13" 90"; "Burlington" C;



1.50" Radius, 0.38" Border, White on Green;
Standard Arrow Custom 9.00" X 6.13" 90"; "Alburgh Ctr" C; "5" C;




1.50" Radius, 0.38" Border, White on Green;
Standard Arrow Custom 9.00" X 6.13" 135"; "Montreal Quebec" C 80% spacing;

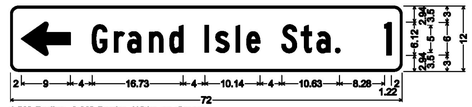


1.50" Radius, 0.38" Border, White on Green;
Standard Arrow Custom 9.00" X 6.13" 180"; "Grand Isle Sta." C; "1" C 80% spacing;



1.50" Radius, 0.38" Border, White on Green;
Standard Arrow Custom 9.00" X 6.13" 90"; "Champlain Islands" C; "11" C;

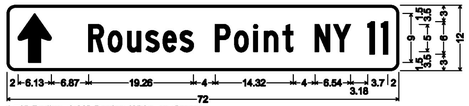

1.50" Radius, 0.38" Border, White on Green;
Standard Arrow Custom 9.00" X 6.13" 90"; "Rouses Point NY" C 80% spacing; "11" C;

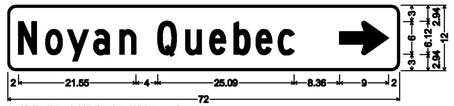


1.50" Radius, 0.38" Border, White on Green;
"Noyan Quebec" C; Standard Arrow Custom 9.00" X 6.13" 0";



1.50" Radius, 0.38" Border, White on Green;
Standard Arrow Custom 9.00" X 6.13" 180"; "NY via Ferry" C; "5" C;




1.50" Radius, 0.38" Border, White on Green;
Standard Arrow Custom 9.00" X 6.13" 180"; "Swanton" C; "10" C;

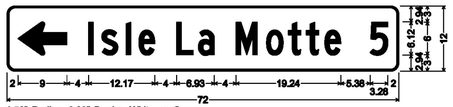

1.50" Radius, 0.38" Border, White on Green;
Standard Arrow Custom 9.00" X 6.13" 180"; "Isle La Motte" C; "5" C;



1.50" Radius, 0.38" Border, White on Green;
Standard Arrow Custom 9.00" X 6.13" 90"; "South Hero" C; "3" C;

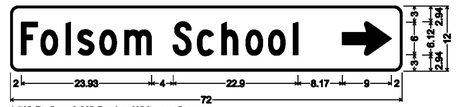


1.50" Radius, 0.38" Border, White on Green;
"Folsom School" C; Standard Arrow Custom 9.00" X 6.13" 0";



1.50" Radius, 0.38" Border, White on Green;
Standard Arrow Custom 9.00" X 6.13" 90"; "S Alburgh" C; "5" C;



1.50" Radius, 0.38" Border, White on Green;
Standard Arrow Custom 9.00" X 6.13" 90"; "Alburgh" C; "2" C;

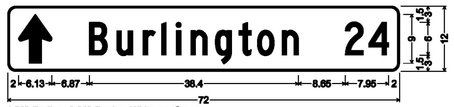


1.50" Radius, 0.38" Border, White on Green;
Standard Arrow Custom 9.00" X 6.13" 90"; "Burlington" C; "24" C;




1.50" Radius, 0.38" Border, White on Green;
Standard Arrow Custom 9.00" X 6.13" 180"; "Folsom School" C;




1.50" Radius, 0.38" Border, White on Green;
Standard Arrow Custom 9.00" X 6.13" 90"; "Grand Isle" C; "18" C;

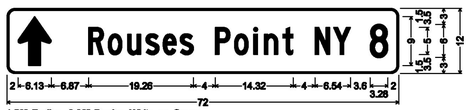

1.50" Radius, 0.38" Border, White on Green;
Standard Arrow Custom 9.00" X 6.13" 90"; "Rouses Point NY" C 80% spacing; "8" C;

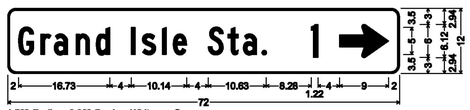


1.50" Radius, 0.38" Border, White on Green;
"Grand Isle Sta." C; "1" C 80% spacing; Standard Arrow Custom 9.00" X 6.13" 0";

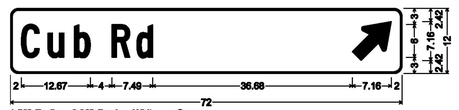


1.50" Radius, 0.38" Border, White on Green;
"Cub Rd" C; Standard Arrow Custom 9.00" X 6.13" 45";




1.50" Radius, 0.38" Border, White on Green;
Standard Arrow Custom 9.00" X 6.13" 90"; "North Hero" C; "7" C;

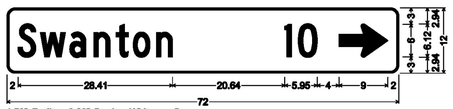

1.50" Radius, 0.38" Border, White on Green;
"Swanton" C 80% spacing; "10" C; Standard Arrow Custom 9.00" X 6.13" 0";

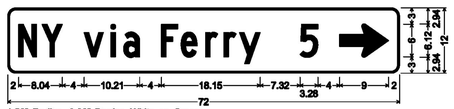


1.50" Radius, 0.38" Border, White on Green;
"NY via Ferry" C; "5" C; Standard Arrow Custom 9.00" X 6.13" 0";

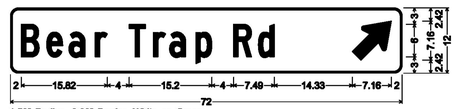

1.50" Radius, 0.38" Border, White on Green;
"Bear Trap Rd" C; Standard Arrow Custom 9.00" X 6.13" 45";



1.50" Radius, 0.38" Border, White on Green;
Standard Arrow Custom 9.00" X 6.13" 90"; "Burlington" C; "38" C;

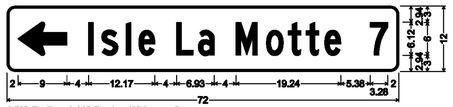

1.50" Radius, 0.38" Border, White on Green;
Standard Arrow Custom 9.00" X 6.13" 180"; "Isle La Motte" C; "7" C;




1.50" Radius, 0.38" Border, White on Green;
Standard Arrow Custom 9.00" X 6.13" 90"; "Grand Isle" C; "1" C;




1.50" Radius, 0.38" Border, White on Green;
Standard Arrow Custom 9.00" X 6.13" 180"; "Bear Trap Rd" C;



1.50" Radius, 0.38" Border, White on Green;
"Isle La Motte" C; "5" C; Standard Arrow Custom 9.00" X 6.13" 0";

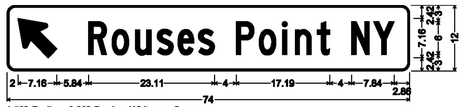

1.50" Radius, 0.38" Border, White on Green;
Standard Arrow Custom 9.00" X 6.13" 135"; "Rouses Point NY" C 80% spacing;

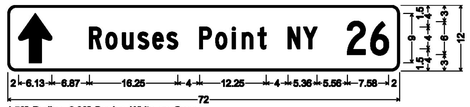


1.50" Radius, 0.38" Border, White on Green;
Standard Arrow Custom 9.00" X 6.13" 90"; "Rouses Point NY" C; "26" C;

ALL DIMENSIONS SHOWN IN INCHES, EXCEPT WHERE NOTED.
NOT TO SCALE

ALL SIGNS IN THIS SECTION ARE SIGN CODE VD1-1


TYLIN INTERNATIONAL	PROJECT NAME: ALBURGH-COLCHESTER PROJECT NUMBER: STPG SIGN(45)	
	FILE NAME: zl2b530_SD02.dgn PROJECT LEADER: D. BRYANT DESIGNED BY: B. TOOTHAKER SIGN DETAILS 5	PLOT DATE: 4/15/2014 DRAWN BY: J. BLANCHARD CHECKED BY: K. KERN SHEET 8 OF 167

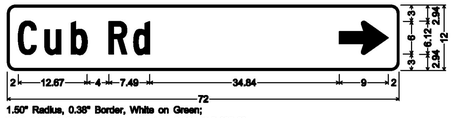


1.50" Radius, 0.38" Border, White on Green;
"Cub Rd" C; Standard Arrow Custom 9.00" X 6.13" 0";




1.50" Radius, 0.38" Border, White on Green;
Standard Arrow Custom 9.00" X 6.13" 180"; "Cub Rd" C;

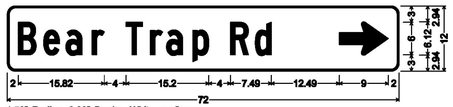


1.50" Radius, 0.38" Border, White on Green;
"Bear Trap Rd" C; Standard Arrow Custom 9.00" X 6.13" 0";

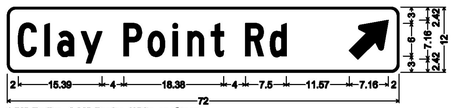


1.50" Radius, 0.38" Border, White on Green;
"Clay Point Rd" C; Standard Arrow Custom 9.00" X 6.13" 45";

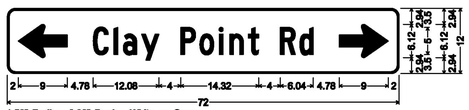

1.50" Radius, 0.38" Border, White on Green;
Standard Arrow Custom 9.00" X 6.13" 180"; "Clay Point Rd" C 80% spacing;
Standard Arrow Custom 9.00" X 6.13" 0";

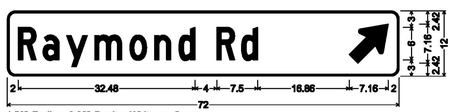


1.50" Radius, 0.38" Border, White on Green;
"Raymond Rd" C; Standard Arrow Custom 9.00" X 6.13" 45";

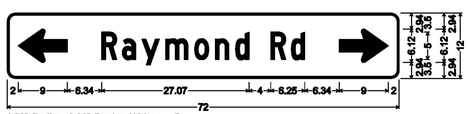

1.50" Radius, 0.38" Border, White on Green;
Standard Arrow Custom 9.00" X 6.13" 180"; "Raymond Rd" C;
Standard Arrow Custom 9.00" X 6.13" 0";




1.50" Radius, 0.38" Border, White on Green;
"Niquette Bay Rd" C 80% spacing; Standard Arrow Custom 9.00" X 6.13" 45";

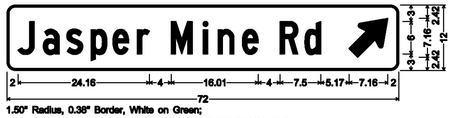

1.50" Radius, 0.38" Border, White on Green;
"Jasper Mine Rd" C; Standard Arrow Custom 9.00" X 6.13" 45";




1.50" Radius, 0.38" Border, White on Green;
Standard Arrow Custom 9.00" X 6.13" 180"; "Jasper Mine Rd" C 80% spacing;

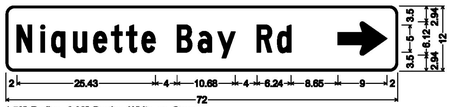


1.50" Radius, 0.38" Border, White on Green;
"Niquette Bay Rd" C; Standard Arrow Custom 9.00" X 6.13" 0";



1.50" Radius, 0.38" Border, White on Green;
Standard Arrow Custom 9.00" X 6.13" 90"; "Canada via US 2" C;

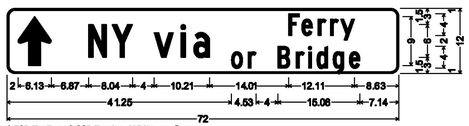

1.50" Radius, 0.38" Border, White on Green;
Standard Arrow Custom 9.00" X 6.13" 90"; "NY via" C; "Ferry" C; "or Bridge" C;

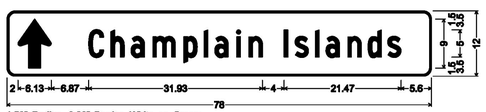

1.50" Radius, 0.38" Border, White on Green;
Standard Arrow Custom 9.00" X 6.13" 90"; "Champlain Islands" C;



1.50" Radius, 0.38" Border, White on Green;
Standard Arrow Custom 9.00" X 6.13" 180"; "Niquette Bay Rd" C;




1.50" Radius, 0.38" Border, White on Green;
"Jasper Mine Rd" C 80% spacing; Standard Arrow Custom 9.00" X 6.13" 0";

ALL SIGNS IN THIS SECTION ARE SIGN CODE VD1-1



1.50" Radius, 0.38" Border, White on Green;
"North Hero" C 80% spacing; "Elementary School" C 80% spacing;
Standard Arrow Custom 9.00" X 6.13" 0";

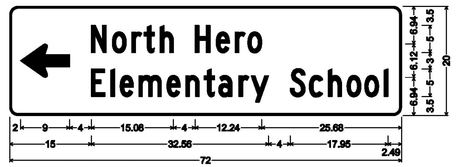

1.50" Radius, 0.38" Border, White on Green;
Standard Arrow Custom 9.00" X 6.13" 180"; "North Hero" C 80% spacing;
"Elementary School" C 80% spacing;

ALL SIGNS IN THIS SECTION ARE SIGN CODE VD2-1


ALL DIMENSIONS SHOWN IN INCHES, EXCEPT WHERE NOTED.
NOT TO SCALE

PROJECT NAME: ALBURGH-COLCHESTER
PROJECT NUMBER: STPG SIGN(45)

TYLIN INTERNATIONAL


FILE NAME: zl2b530_SD02.dgn
PROJECT LEADER: D. BRYANT
DESIGNED BY: B. TOOTHAKER
SIGN DETAILS 6

PLOT DATE: 4/28/2014
DRAWN BY: J. BLANCHARD
CHECKED BY: K. KERN
SHEET 9 OF 167

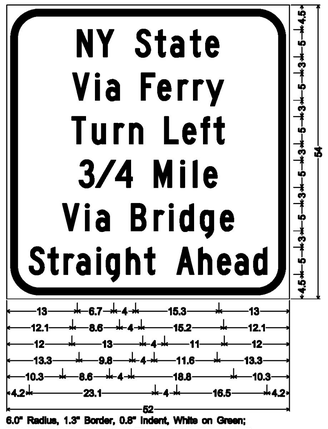

6.0" Radius, 1.3" Border, 0.8" Indent, White on Green;
"NY State" C; "Via Ferry" C; "Turn Left" C; "3/4 Mile" C;
"Via Bridge" C; "Straight Ahead" C 80% spacing;

VD–131

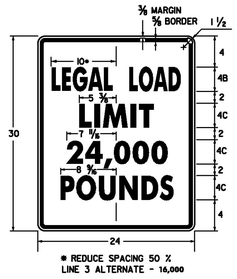


* REDUCE SPACING 50 %
LINE 3 ALTERNATE - 16,000

VR–017




COLORS:
SYMBOL AND BORDER - BLACK
CIRCLE AND DIAGONAL - RED (RETROREFLECTIVE)
BACKGROUND - WHITE (RETROREFLECTIVE)

VR–142A

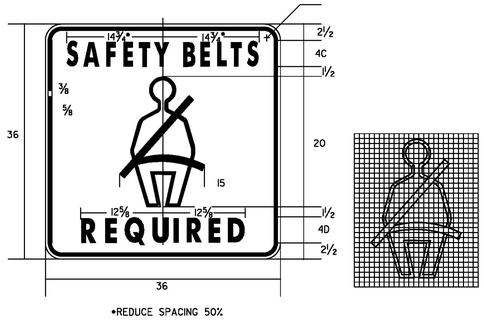


*REDUCE SPACING 50%

VR–601

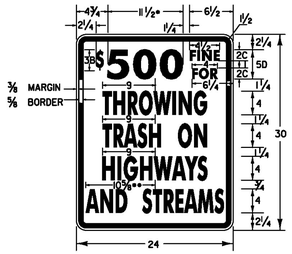


* REDUCE SPACING 40%
** REDUCE SPACING 60%

VR–023b

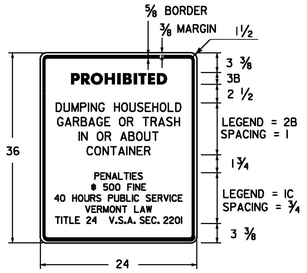


VR–278

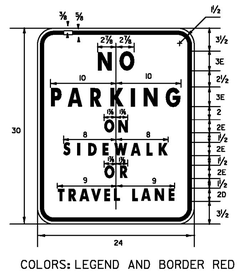

COLORS: LEGEND AND BORDER RED
BACKGROUND WHITE


VR–660

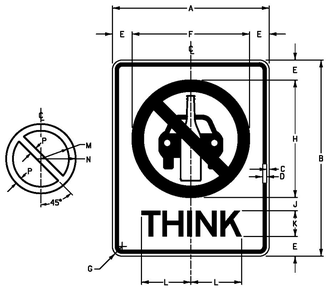

SIGN	DIMENSIONS (INCHES)														
	A	B	C	D	E	F	G	H	J	K	L	M	N	P
STD.	24	30	3/8	5/8	3	18	6 1/2	18	2	4E	7 5/8	11/4	9	1 3/4

COLORS
TEXT - BLACK (NON-REFL.)
CAR & BOTTLE SYMBOL - BLACK (NON-REFL.)
PROHIBITED SYMBOL - RED (NON-REFL.)
BACKGROUND - WHITE (REFL.)

VR–072

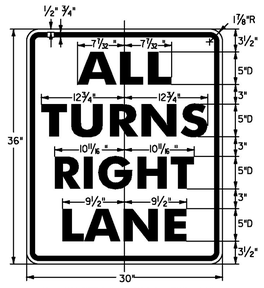

BLACK TEXT & BORDER (NON-REFL)
WITH WHITE BACKGROUND (REFL)


VR–428

ALL DIMENSIONS SHOWN IN INCHES, EXCEPT WHERE NOTED.
NOT TO SCALE

PROJECT NAME:	ALBURGH-COLCHESTER
PROJECT NUMBER:	STPG SIGN(45)


TYLIN INTERNATIONAL

FILE NAME: z12b530_SD02.dgn	PLOT DATE: 4/15/2014
PROJECT LEADER: D. BRYANT	DRAWN BY: J. BLANCHARD
DESIGNED BY: B. TOOTHAKER	CHECKED BY: K. KERN
SIGN DETAILS 7	SHEET 10 OF 167

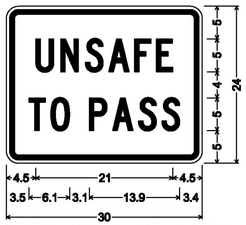


1.9" Radius, 0.8" Border, 0.5" Indent, Black on Yellow;
"UNSAFE" C; "TO PASS" C;

VW-092

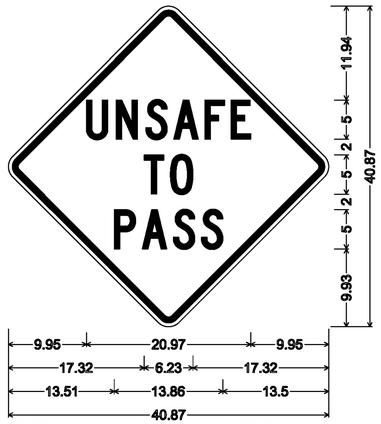


30.00" across sides 1.88" Radius, 0.75" Border,
0.50" Indent, Black on Yellow;
"UNSAFE" C; "TO" C; "PASS" C;

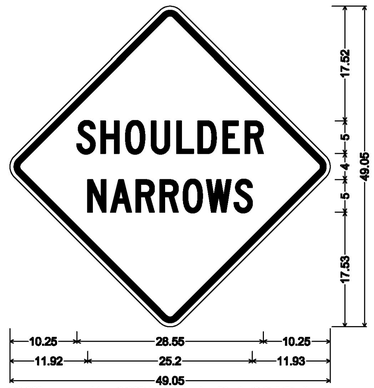


36.00" across sides 0.86" Inner border Black, 2.25" Radius,
0.63" Outer border, Yellow on Yellow;
"SHOULDER" Black C; "NARROWS" Black C;

VW-619

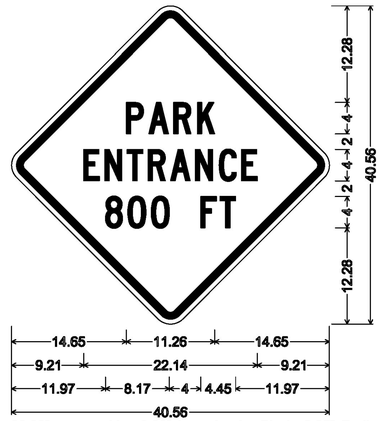

30.00" across sides 0.88" Inner border Black, 2.25" Radius,
0.63" Outer border, Yellow on Yellow;
"PARK" Black C; "ENTRANCE" Black C;
"800 FT" Black C;

VW-730

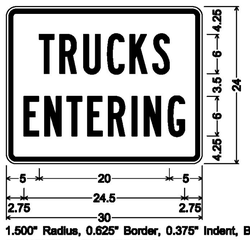

1.500" Radius, 0.625" Border, 0.375" Indent, Black on Yellow;
"TRUCKS" B; "ENTERING" B;


VW-202P

ALL DIMENSIONS SHOWN IN INCHES, EXCEPT WHERE NOTED.
NOT TO SCALE


PROJECT NAME:	ALBURGH-COLCHESTER
PROJECT NUMBER:	STPG SIGN(45)

TYLIN INTERNATIONAL


FILE NAME: z12b530_SD02.dgn	PLOT DATE: 4/15/2014
PROJECT LEADER: D. BRYANT	DRAWN BY: J. BLANCHARD
DESIGNED BY: B. TOOTHAKER	CHECKED BY: K. KERN
SIGN DETAILS 8	SHEET 11 OF 167

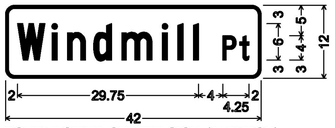


DOUBLE-SIDED STREET SIGN (ALBURGH);
1.500" Radius, 0.500" Border, White on Green;
"Windmill" C 90% spacing;
"Pt" C 90% spacing;

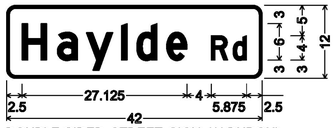


DOUBLE-SIDED STREET SIGN (ALBURGH);
1.500" Radius, 0.500" Border, White on Green;
"Haylde" D; "Rd" D;

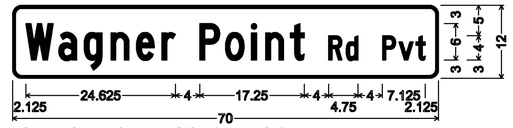

DOUBLE-SIDED STREET SIGN (ALBURGH);
1.500" Radius, 0.500" Border, White on Green;
"Wagner Point" C 80% spacing; "Rd Pvt" C 80% spacing;

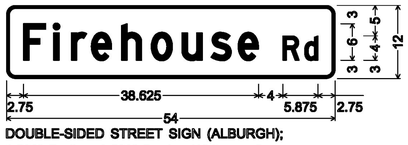


DOUBLE-SIDED STREET SIGN (ALBURGH);
1.500" Radius, 0.500" Border, White on Green;
"Firehouse" D; "Rd" D;

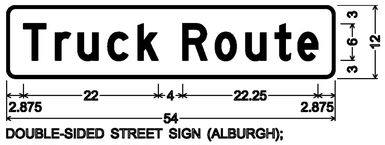


DOUBLE-SIDED STREET SIGN (ALBURGH);
1.500" Radius, 0.500" Border, White on Green;
"Truck Route" D;




DOUBLE-SIDED STREET SIGN (ALBURGH);
1.500" Radius, 0.500" Border, White on Green;
"Carpenter" D; "Ln" D;

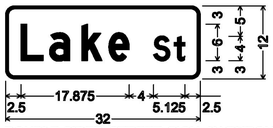

DOUBLE-SIDED STREET SIGN (ALBURGH);
1.500" Radius, 0.500" Border, White on Green;
"Lake" D; "St" D;

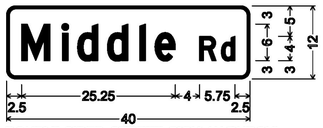


DOUBLE-SIDED STREET SIGN (ALBURGH);
1.500" Radius, 0.500" Border, White on Green;
"Middle" D; "Rd" D;

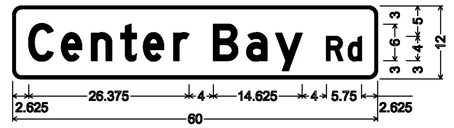


DOUBLE-SIDED STREET SIGN (ALBURGH);
1.500" Radius, 0.500" Border, White on Green;
"Center Bay" D; "Rd" D;




DOUBLE-SIDED STREET SIGN (ALBURGH);
1.500" Radius, 0.500" Border, White on Green;
"Horican" D; "Ave Pvt" D;

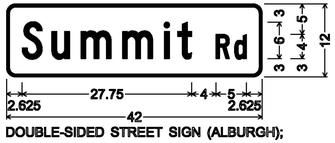


DOUBLE-SIDED STREET SIGN (ALBURGH);
1.500" Radius, 0.500" Border, White on Green;
"Summit" C; "Rd" C;

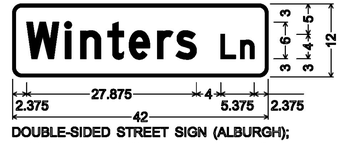


DOUBLE-SIDED STREET SIGN (ALBURGH);
1.500" Radius, 0.500" Border, White on Green;
"Winters" D 80% spacing;
"Ln" D 80% spacing;

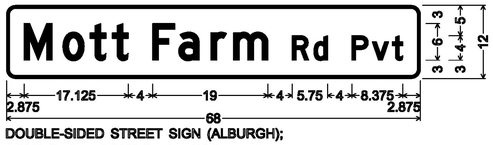


DOUBLE-SIDED STREET SIGN (ALBURGH);
1.500" Radius, 0.500" Border, White on Green;
"Mott Farm" D; "Rd Pvt" D;

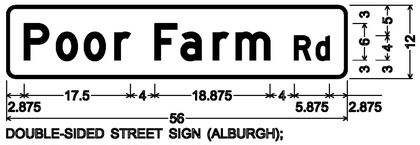


DOUBLE-SIDED STREET SIGN (ALBURGH);
1.500" Radius, 0.500" Border, White on Green;
"Poor Farm" D; "Rd" D;

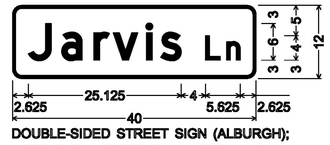


DOUBLE-SIDED STREET SIGN (ALBURGH);
1.500" Radius, 0.500" Border, White on Green;
"Jarvis" D; "Ln" D;

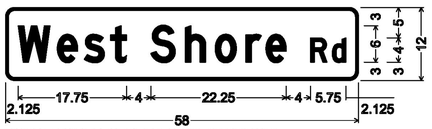

DOUBLE-SIDED STREET SIGN (ALBURGH);
1.500" Radius, 0.500" Border, White on Green;
"West Shore" D; "Rd" D;

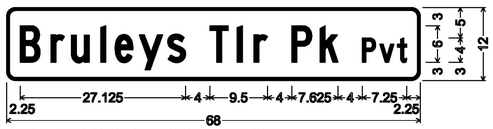

DOUBLE-SIDED STREET SIGN (ALBURGH);
1.500" Radius, 0.500" Border, White on Green;
"Bruleys Tlr Pk" C; "Pvt" C;

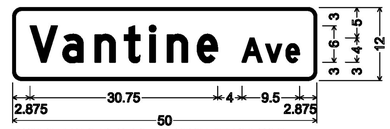

DOUBLE-SIDED STREET SIGN (ALBURGH);
1.500" Radius, 0.500" Border, White on Green;
"Vantine" D; "Ave" D;

ALL SIGNS ON THIS PAGE ARE SIGN CODE D3-1
(ALL SIGNS ARE DOUBLE – SIDED)

ALL DIMENSIONS SHOWN IN INCHES, EXCEPT WHERE NOTED.
NOT TO SCALE


PROJECT NAME:	ALBURGH-COLCHESTER
PROJECT NUMBER:	STPG SIGN(45)

TYLIN INTERNATIONAL

FILE NAME: z12b530_SD03.dgn	PLOT DATE: 4/15/2014
PROJECT LEADER: D. BRYANT	DRAWN BY: J. BLANCHARD
DESIGNED BY: B. TOOTHAKER	CHECKED BY: K. KERN
SIGNS DETAILS 9	SHEET 12 OF 167




DOUBLE-SIDED STREET SIGN (ALBURGH);
1.500" Radius, 0.500" Border, White on Green;
"Peterson" C 80% spacing;
"Pl" C 80% spacing;

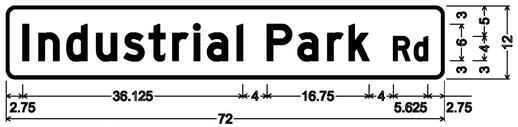


DOUBLE-SIDED STREET SIGN (ALBURGH);
1.500" Radius, 0.500" Border, White on Green;
"Industrial Park" D 80% spacing; "Rd" D 80% spacing;




DOUBLE-SIDED STREET SIGN (ALBURGH);
1.500" Radius, 0.500" Border, White on Green;
"Milk" D; "St" D;

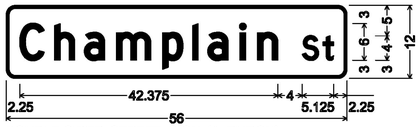

DOUBLE-SIDED STREET SIGN (ALBURGH);
1.500" Radius, 0.500" Border, White on Green;
"Champlain" D; "St" D;

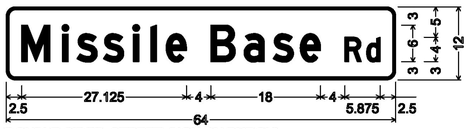


DOUBLE-SIDED STREET SIGN (ALBURGH);
1.500" Radius, 0.500" Border, White on Green;
"Missile Base" D; "Rd" D;

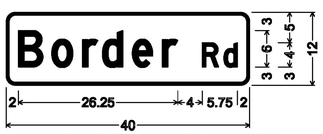

DOUBLE-SIDED STREET SIGN (ALBURGH);
1.500" Radius, 0.500" Border, White on Green;
"Border" D; "Rd" D;




DOUBLE-SIDED STREET SIGN (ALBURGH);
1.500" Radius, 0.500" Border, White on Green;
"Hunters Farm" D; "Rd" D;

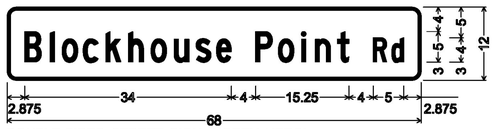


DOUBLE-SIDED STREET SIGN (NORTH HERO);
1.500" Radius, 0.500" Border, White on Green;
"Blockhouse Point" C; "Rd" C;




DOUBLE-SIDED STREET SIGN (NORTH HERO);
1.500" Radius, 0.500" Border, White on Green;
"Station" D 80% spacing; "Rd" D;

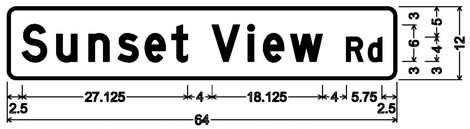


DOUBLE-SIDED STREET SIGN (NORTH HERO);
1.500" Radius, 0.500" Border, White on Green;
"Sunset View" D; "Rd" D;

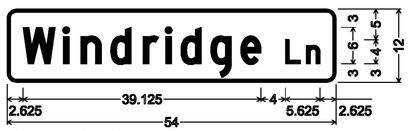

DOUBLE-SIDED STREET SIGN (NORTH HERO);
1.500" Radius, 0.500" Border, White on Green;
"Windridge" D; "Ln" D;

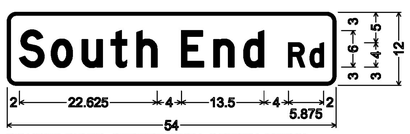


DOUBLE-SIDED STREET SIGN (NORTH HERO);
1.500" Radius, 0.500" Border, White on Green;
"South End" D; "Rd" D;

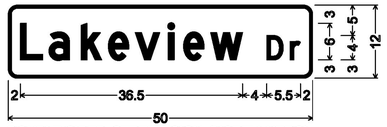


DOUBLE-SIDED STREET SIGN (NORTH HERO);
1.500" Radius, 0.500" Border, White on Green;
"Lakeview" D; "Dr" D;




DOUBLE-SIDED STREET SIGN (NORTH HERO);
1.500" Radius, 0.500" Border, White on Green;
"Jerusalem" D; "Pl" D;

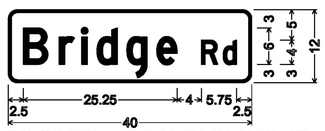


DOUBLE-SIDED STREET SIGN (NORTH HERO);
1.500" Radius, 0.500" Border, White on Green;
"Bridge" D; "Rd" D;

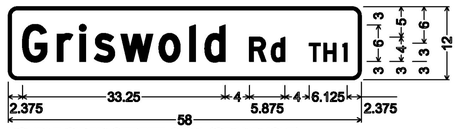

DOUBLE-SIDED STREET SIGN (GRAND ISLE);
1.500" Radius, 0.500" Border, White on Green;
"Griswold" D; "Rd" D; "TH1" D;

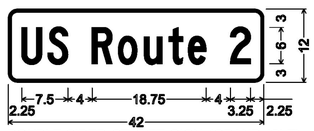

DOUBLE-SIDED STREET SIGN (GRAND ISLE);
1.500" Radius, 0.500" Border, White on Green;
"US Route 2" C 80% spacing;

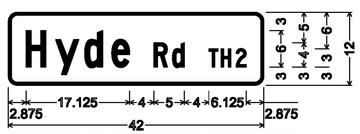

DOUBLE-SIDED STREET SIGN (GRAND ISLE);
1.500" Radius, 0.500" Border, White on Green;
"Hyde" C; "Rd" C; "TH2" C;


ALL DIMENSIONS SHOWN IN INCHES, EXCEPT WHERE NOTED.
NOT TO SCALE

ALL SIGNS ON THIS PAGE ARE SIGN CODE D3-1
(ALL SIGNS ARE DOUBLE – SIDED)

PROJECT NAME:	ALBURGH-COLCHESTER
PROJECT NUMBER:	STPG SIGN(45)

TYLIN INTERNATIONAL


FILE NAME: zl2b530_SD03.dgn	PLOT DATE: 4/15/2014
PROJECT LEADER: D. BRYANT	DRAWN BY: J. BLANCHARD
DESIGNED BY: B. TOOTHAKER	CHECKED BY: K. KERN
SIGN DETAILS 10	SHEET 13 OF 167

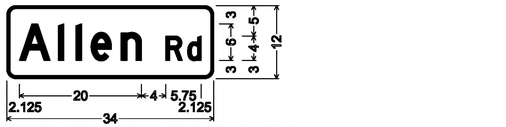


DOUBLE-SIDED STREET SIGN (GRAND ISLE);
1.500" Radius, 0.500" Border, White on Green;
"Allen" D; "Rd" D;




DOUBLE-SIDED STREET SIGN (GRAND ISLE);
1.500" Radius, 0.500" Border, White on Green;
"Faywood" D; "Rd" D; "TH9" D;

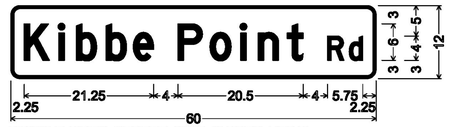


DOUBLE-SIDED STREET SIGN (SOUTH HERO);
1.500" Radius, 0.500" Border, White on Green;
"Kibbe Point" D; "Rd" D;

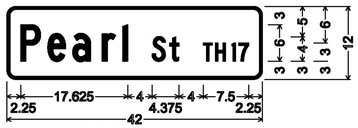


DOUBLE-SIDED STREET SIGN (GRAND ISLE);
1.500" Radius, 0.500" Border, White on Green;
"Pearl" C; "St" C; "TH17" C;

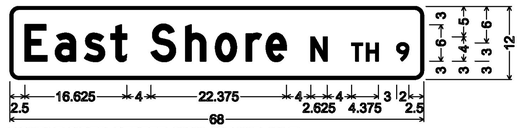


DOUBLE-SIDED STREET SIGN (GRAND ISLE);
1.500" Radius, 0.500" Border, White on Green;
"East Shore" D; "N" D; "TH 9" D;

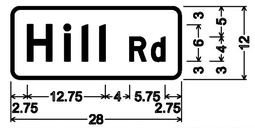

DOUBLE-SIDED STREET SIGN (SOUTH HERO);
1.500" Radius, 0.500" Border, White on Green;
"Hill" D; "Rd" D;

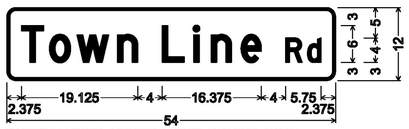


DOUBLE-SIDED STREET SIGN (GRAND ISLE);
1.500" Radius, 0.500" Border, White on Green;
"Town Line" D; "Rd" D;

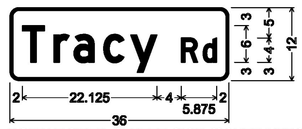


DOUBLE-SIDED STREET SIGN (SOUTH HERO);
1.500" Radius, 0.500" Border, White on Green;
"Tracy" D; "Rd" D;




DOUBLE-SIDED STREET SIGN (SOUTH HERO);
1.500" Radius, 0.500" Border, White on Green;
"Lavigne" C; "Rd" C;

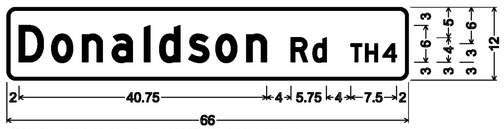

DOUBLE-SIDED STREET SIGN (GRAND ISLE);
1.500" Radius, 0.500" Border, White on Green;
"Donaldson" D; "Rd" D; "TH4" D;

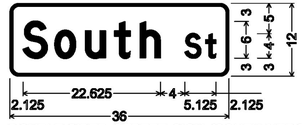


DOUBLE-SIDED STREET SIGN (SOUTH HERO);
1.500" Radius, 0.500" Border, White on Green;
"South" D; "St" D;

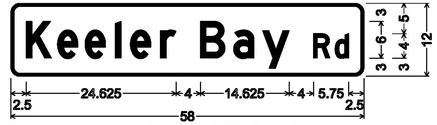


DOUBLE-SIDED STREET SIGN (SOUTH HERO);
1.500" Radius, 0.500" Border, White on Green;
"Keeler Bay" D; "Rd" D;




DOUBLE-SIDED STREET SIGN (GRAND ISLE);
1.500" Radius, 0.500" Border, White on Green;
"E" D; "Shore" D; "S" D; "TH3" D;

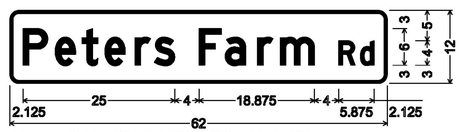

DOUBLE-SIDED STREET SIGN (SOUTH HERO);
1.500" Radius, 0.500" Border, White on Green;
"Peters Farm" D; "Rd" D;

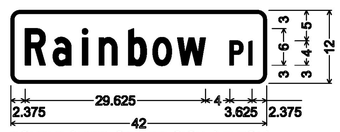

DOUBLE-SIDED STREET SIGN (MILTON);
1.500" Radius, 0.500" Border, White on Green;
"Rainbow" C; "Pl" C;

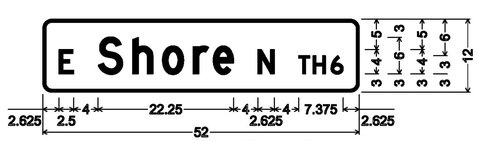

DOUBLE-SIDED STREET SIGN (GRAND ISLE);
1.500" Radius, 0.500" Border, White on Green;
"E" D; "Shore" D; "N" D; "TH6" D;



DOUBLE-SIDED STREET SIGN (SOUTH HERO);
1.500" Radius, 0.500" Border, White on Green;
"Landon" D; "Rd" D;

ALL SIGNS ON THIS PAGE ARE SIGN CODE D3-1
(ALL SIGNS ARE DOUBLE – SIDED)

ALL DIMENSIONS SHOWN IN INCHES, EXCEPT WHERE NOTED.
NOT TO SCALE

PROJECT NAME: ALBURGH-COLCHESTER
PROJECT NUMBER: STPG SIGN(45)

TYLIN INTERNATIONAL

FILE NAME: z12b530_SD03.dgn
PROJECT LEADER: D. BRYANT
DESIGNED BY: B. TOOTHAKER
SIGN DETAILS II

PLOT DATE: 4/15/2014
DRAWN BY: J. BLANCHARD
CHECKED BY: K. KERN
SHEET 14 OF 167

DIRECTION	MILEPOINT	LOCATION CODE (SHEET 2)	SIGN CODE	WIDTH (IN)	HEIGHT (IN)	SHEETING REMARKS	SIGN LEGEND	NEW SIGNS "A"	NEW SIGNS "B"	EXISTING SIGNS RETAIN	EXISTING SIGNS SALVAGE FROM	EXISTING SIGNS SALVAGE TO	EXISTING SIGNS REMOVE	EXIST POST RETAIN	EXIST POST REMOVE	NUMBER OF NEW POSTS	SQUARE STEEL (IN) 1.75 (LB/FT) 1.88	SQUARE STEEL (IN) 2.00 (LB/FT) 2.42	SQUARE STEEL (IN) 2.50 (LB/FT) 3.35	TUBULAR STEEL Ø (IN) FOUNDATION	TUBULAR STEEL Ø (IN) 3.00 (LB/FT) 7.60	TUBULAR STEEL Ø (IN) 3.50 (LB/FT) 9.00	TUBULAR STEEL Ø (IN) 4.00 (LB/FT) 10.80	TUBULAR STEEL Ø (IN) 5.00 (LB/FT) 14.60	SIGN FRAME REQUIRED	REMARKS	SIGN DETAIL LOCATION SHSM	SIGN DETAIL LOCATION PROJECT SHEET #	SIGN DETAIL LOCATION STANDARD SHEET #
ALBURGH US-2 EB							FY-FLUORESCENT YELLOW FYG-FLUORESCENT YELLOW GREEN																				"SHSM"-STANDARD HIGHWAY SIGNS AND MARKINGS			
EB	0.000	A	VD-450	24	24								1	X															
		A	VD-450	40	24		STATE LINE ENTERING VERMONT	6.67																				6	
		C	VD-700	6	10		0020 0701 0000	0.42																					E-138
EB	0.203	B	W14-3	48	36								1	X				16.0											
		B	W14-3	48	36		NO PASSING ZONE	12.00																			X		
EB	0.727	A	R8-3A	24	24		4/15/15						1	X				16.0											
		A	R8-3	24	24			4.00																			X		
EB	0.935	A	R8-3A	24	24		NO PARKING			1				X															
		A	M4-6P	24	12		END			1																			
EB	0.969	A	VD-421A	60	48		WELCOME TO VERMONT THE GREEN MOUNTAIN STATE			1				X															
		A	VD-066	60	24		WELCOME CENTER 2 MILES AHEAD			1																			
EB	0.980	A	VR-020	24	30		NO PARKING ON TRAVELED LANE			1				X															
EB	1.002	A	VR-020	24	30		NO PARKING ON TRAVELED LANE			1				X															
EB	1.050	A	VR-114F	48	60		STATE OF VT SL VITESSE MAXIMUM 50 UNLESS OTHERWISE POSTED			1				X															
EB	1.115	A	M3-2	24	12		ROUTE MARKER ASSEMBLY 11/8/14						1		X														
							SHEET TOTALS	23.08	0.00	7	0	0	4	0	0	0		32.0 ~~0.0~~			0	0.0	0.0	0.0	0.0					
								SF	SF	EA	EA	EA	EA	EA	EA	EA		FT			EA	LB	LB	LB	LB					
							TOWN DIRECTIONAL TOTALS	897.8	0.0	37	1	1	165	0	0	92		1380.0			0			0.0					

SIGN SUMMARY SHEET

VERMONT AGENCY OF TRANSPORTATION

PROJECT NAME: ALBURGH-COLCHESTER
PROJECT NUMBER: STPG SIGN(45)

FILE NAME: 1 Alburgh US2 EB TSS.xls
PROJECT MANAGER: D. BRYANT
DESIGNED BY: B. TOOTHAKER
ALBURGH EB SHEET 1

PLOT DATE: 4/15/2014
DRAWN BY: J. BLANCHARD
CHECKED K. KERN
SHEET 15 OF 167

DIRECTION	MILEPOINT	LOCATION CODE (SHEET 2)	SIGN CODE	WIDTH (IN)	HEIGHT (IN)	SHEETING REMARKS	SIGN LEGEND	NEW SIGNS "A"	NEW SIGNS "B"	EXISTING SIGNS RETAIN	EXISTING SIGNS SALVAGE FROM	EXISTING SIGNS SALVAGE TO	EXISTING SIGNS REMOVE	EXIST POST RETAIN	EXIST POST REMOVE	NUMBER OF NEW POSTS	SQUARE STEEL (IN) 1.75 (LB / FT) 1.88	SQUARE STEEL (IN) 2.00 (LB / FT) 2.42	SQUARE STEEL (IN) 2.50 (LB / FT) 3.35	TUBULAR STEEL Ø (IN) FOUNDATION	TUBULAR STEEL Ø (IN) 3.00 (LB / FT) 7.60	TUBULAR STEEL Ø (IN) 3.50 (LB / FT) 9.00	TUBULAR STEEL Ø (IN) 4.00 (LB / FT) 10.80	TUBULAR STEEL Ø (IN) 5.00 (LB / FT) 14.60	SIGN FRAME REQUIRED	REMARKS	SIGN DETAIL LOCATION SHSM	SIGN DETAIL LOCATION PROJECT SHEET #	SIGN DETAIL LOCATION STANDARD SHEET #
ALBURGH US-2 EB							FY-FLUORESCENT YELLOW FYG-FLUORESCENT YELLOW GREEN																			"SHSM"-STANDARD HIGHWAY SIGNS AND MARKINGS			
		A	M1-4	24	24								1					15.25											
		A	M3-2	24	12	BLK/ WHT	EAST 11/8/14	2.00								1		X										X		
		A	M1-4	24	24	BLK/ WHT	2	4.00																				X		
EB	1.164	A	VR-048F	24	30		ARRET OBLIGATOIRE SUR FEU ROUGE D'AUTOBUS D'ECOLIERS						1	X																
		A	VR-048	24	30		STATE LAW STOP FOR SCHOOL BUS FLASHING RED LIGHTS						1																
EB	1.297	A	VR-023B	24	30								1	X				13.75											
		A	VR-023B	24	30		$500 MAX FINE THROWING TRASH ON HIGHWAYS AND STREAMS 11/8/14	5.00								1												10	
EB	1.400	A	VR-128B	48	36								1	~~X~~															
		A	VR-601	36	36		SAFETY BELTS REQUIRED 11/8/14	9.00																				10	
EB	1.746	A	W13-1	18	18		45 MPH 11/8/14						1		X														
		A	W1-2ML	30	30		MODIFIED LEFT CURVE						1																
EB	1.782	A	W1-10cL	36	36		11/8/14	9.00								2		16.75 X 16.75									INSTALL 100 FT WEST OF BEGINNING OF CURVE (190 FT EAST OF EXISTING)	X		
EB	1.834	A	W1-8L	18	24		11/8/14	3.00								1		14.75 X									INSTALL 90 FT WEST OF LEFT LARGE ARROW	X		
		B	W1-8R	18	24			3.00																				X		
EB	1.851	A	W1-6	48	24		<=== LEFT LARGE ARROW						1		X														
SIGN SUMMARY SHEET							SHEET TOTALS	35.00	0.00	0	0	0	8	0	0	4		77.25 ~~60.0~~		0	0.0	0.0	0.0	0.0					
								SF	SF	EA	EA	EA	EA	EA	EA	EA		FT		EA	LB	LB	LB	LB					
VERMONT AGENCY OF TRANSPORTATION							TOWN DIRECTIONAL TOTALS	897.8	0.0	37	1	1	165	0	0	92		1380.0		0		0.0							

PROJECT NAME: ALBURGH-COLCHESTER
PROJECT NUMBER: STPG SIGN(45)
FILE NAME: 1 Alburgh US2 EB TSS.xls
PROJECT MANAGER: D. BRYANT
DESIGNED BY: B. TOOTHAKER
ALBURGH EB SHEET 2
PLOT DATE: 4/15/2014
DRAWN BY: J. BLANCHARD
CHECKED K. KERN
SHEET 16 OF 167

DIRECTION	MILEPOINT	LOCATION CODE (SHEET 2)	SIGN CODE	WIDTH (IN)	HEIGHT (IN)	SHEETING REMARKS	SIGN LEGEND	NEW SIGNS "A"	NEW SIGNS "B"	EXISTING SIGNS RETAIN	EXISTING SIGNS SALVAGE FROM	EXISTING SIGNS SALVAGE TO	EXISTING SIGNS REMOVE	EXIST POST RETAIN	EXIST POST REMOVE	NUMBER OF NEW POSTS	SQUARE STEEL (IN) 1.75 (LB/FT) 1.88	SQUARE STEEL (IN) 2.00 (LB/FT) 2.42	SQUARE STEEL (IN) 2.50 (LB/FT) 3.35	TUBULAR STEEL Ø (IN) FOUNDATION	TUBULAR STEEL Ø (IN) 3.00 (LB/FT) 7.60	TUBULAR STEEL Ø (IN) 3.50 (LB/FT) 9.00	TUBULAR STEEL Ø (IN) 4.00 (LB/FT) 10.80	TUBULAR STEEL Ø (IN) 5.00 (LB/FT) 14.60	SIGN FRAME REQUIRED	REMARKS	SIGN DETAIL LOCATION SHSM	SIGN DETAIL LOCATION PROJECT SHEET #	SIGN DETAIL LOCATION STANDARD SHEET #
ALBURGH US-2 EB							FY-FLUORESCENT YELLOW FYG-FLUORESCENT YELLOW GREEN																			"SHSM"-STANDARD HIGHWAY SIGNS AND MARKINGS			
EB	1.869	A	W1-8L	18	24		 11/8/14	3.00								1		X 15.75								INSTALL 95 FT EAST OF LEFT LARGE ARROW	X		
		B	W1-8R	18	24			3.00																		X		
EB	1.900	A	W1-8L	18	24		 11/8/14	3.00								1		X 15.25								INSTALL 164 FT EAST OF PREVIOUS CHEVRON	X		
		B	W1-8R	18	24			3.00																		X		
EB	1.930	A	W1-8L	18	24		 11/8/14	3.00								1		X 14.50								INSTALL 158 FT EAST OF PREVIOUS CHEVRON	X		
		B	W1-8R	18	24			3.00																		X		
EB	1.960	A	W1-8L	18	24		 11/8/14	3.00								1		X 14.25								INSTALL 158 FT EAST OF PREVIOUS CHEVRON	X		
		B	W1-8R	18	24			3.00																		X		
EB	1.974	A	D3-1	UNK.	UNK..								1		X			12.00											
		A/B	D3-1	42	12		 11/8/14	3.50								1		X								WINDMILL POINT RD (TH-20); FIELD LOCATE FOR VISIBILITY FROM ROUTE 2		12	
EB	1.974	C	VR-017	24	30								1	~~X~~															
		C	VR-017	24	30		 11/8/14	5.00										16.00								WINDMILL POINT RD (TH-20)		10	
EB	1.981	D	R1-1	30	30		11/8/14						1	~~X~~															
		D	R1-1	30	30			6.25										15.75								WINDMILL POINT RD (TH-20)	X		
EB	1.991	C	VR-017	24	30								1	X															
							SHEET TOTALS	38.75	0.00	0	0	0	4	0	0	5		~~103.50~~ ~~75.0~~		0	0.0	0.0	0.0	0.0					
								SF	SF	EA	EA	EA	EA	EA	EA	EA		FT		EA	LB	LB	LB	LB					
							TOWN DIRECTIONAL TOTALS	897.8	0.0	37	1	1	165	0	0	92		1380.0		0		0.0							


SIGN SUMMARY SHEET

VERMONT AGENCY OF TRANSPORTATION

PROJECT NAME: **ALBURGH-COLCHESTER**
PROJECT NUMBER: **STPG SIGN(45)**
FILE NAME: **1 Alburgh US2 EB TSS.xls** PLOT DATE: **4/15/2014**
PROJECT MANAGER: **D. BRYANT** DRAWN BY: **J. BLANCHARD**
DESIGNED BY: **B. TOOTHAKER** CHECKED **K. KERN**
ALBURGH EB SHEET 3 SHEET **17** OF **167**

DIRECTION	MILEPOINT	LOCATION CODE (SHEET 2)	SIGN CODE	WIDTH (IN)	HEIGHT (IN)	SHEETING REMARKS	SIGN LEGEND	NEW SIGNS "A"	NEW SIGNS "B"	EXISTING SIGNS RETAIN	EXISTING SIGNS SALVAGE FROM	EXISTING SIGNS SALVAGE TO	EXISTING SIGNS REMOVE	EXIST POST RETAIN	EXIST POST REMOVE	NUMBER OF NEW POSTS	SQUARE STEEL (IN) 1.75 (LB/FT) 1.88	SQUARE STEEL (IN) 2.00 (LB/FT) 2.42	SQUARE STEEL (IN) 2.50 (LB/FT) 3.35	TUBULAR STEEL Ø (IN) FOUNDATION	TUBULAR STEEL Ø (IN) 3.00 (LB/FT) 7.60	TUBULAR STEEL Ø (IN) 3.50 (LB/FT) 9.00	TUBULAR STEEL Ø (IN) 4.00 (LB/FT) 10.80	TUBULAR STEEL Ø (IN) 5.00 (LB/FT) 14.60	SIGN FRAME REQUIRED	REMARKS	SIGN DETAIL LOCATION SHSM	SIGN DETAIL LOCATION PROJECT SHEET #	SIGN DETAIL LOCATION STANDARD SHEET #
ALBURGH US-2 EB							FY-FLUORESCENT YELLOW FYG-FLUORESCENT YELLOW GREEN																				"SHSM"-STANDARD HIGHWAY SIGNS AND MARKINGS			
		C	VR-017	24	30		 11/8/14	5.00																			WINDMILL POINT RD (TH-20)		10	
EB	1.995	A	W1-8L	18	24		 11/8/14	3.00								1		X 13.25									INSTALL 10 FT CLOSER TO ROAD THAN STREET SIGN	X		
		B	W1-8R	18	24			3.00																				X		
EB	1.995	A	D3-1	UNK.	UNK..		11/8/14						1		X			12.00												
		A/B	D3-1	42	12			3.50								1		X									WINDMILL POINT RD (TH-20); FIELD LOCATE FOR VISIBILITY FROM ROUTE 2		12	
EB	2.004	D	R1-1	30	30								1	X				14.00											
		D	R1-1	30	30		 11/8/14	6.25																			WINDMILL POINT RD (TH-20)	X		
EB	2.016	B	W1-6	48	24		RIGHT ===> LARGE ARROW 11/8/14						1		X														
EB	2.031	A	W1-8L	18	24		 11/8/14	3.00								1		14.25 X									INSTALL 80 FT EAST OF RIGHT LARGE ARROW	X		
		B	W1-8R	18	24		 11/8/14	3.00																				X		
EB	2.499	A	VD-123	UNK.	12		511 TRAVEL INFO PHONE SYMBOL						1		X														
		A	D12-5	48	60			20.00								2		13.25 13.25	X								SLIP BASES	X		
EB	2.741	A	W1-2R	30	30		RIGHT CURVE 11/8/14						1		X														
EB	2.803	A	W1-10R	36	36		 11/8/14	9.00								2		16.00 X 16.25									INSTALL 200 FT WEST OF BEGINNING OF CURVE (250 FT WEST OF SHARE THE ROAD ASSEMBLY)	X		
EB	2.850	A	W16-1	18	24		11/8/14						1		X														
SIGN SUMMARY SHEET							SHEET TOTALS	55.75	0.00	0	0	0	6	0	0	7		~~112.75~~ ~~105.0~~		0	0.0	0.0	0.0	0.0					
								SF	SF	EA	EA	EA	EA	EA	EA	EA		FT		EA	LB	LB	LB	LB					
VERMONT AGENCY OF TRANSPORTATION							TOWN DIRECTIONAL TOTALS	897.8	0.0	37	1	1	165	0	0	92		1380.0		0		0.0							

PROJECT NAME: **ALBURGH-COLCHESTER**
PROJECT NUMBER: **STPG SIGN(45)**
FILE NAME: **1 Alburgh US2 EB TSS.xls** PLOT DATE: **4/15/2014**
PROJECT MANAGER: **D. BRYANT** DRAWN BY: **J. BLANCHARD**
DESIGNED BY: **B. TOOTHAKER** CHECKED **K. KERN**
ALBURGH EB SHEET 4 SHEET **18** OF **167**

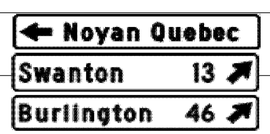DIRECTION	MILEPOINT	LOCATION CODE (SHEET 2)	SIGN CODE	WIDTH (IN)	HEIGHT (IN)	SHEETING REMARKS	SIGN LEGEND	NEW SIGNS "A"	NEW SIGNS "B"	EXISTING SIGNS RETAIN	EXISTING SIGNS SALVAGE FROM	EXISTING SIGNS SALVAGE TO	EXISTING SIGNS REMOVE	EXIST POST RETAIN	EXIST POST REMOVE	NUMBER OF NEW POSTS	SQUARE STEEL (IN) 1.75 (LB / FT) 1.88	SQUARE STEEL (IN) 2.00 (LB / FT) 2.42	SQUARE STEEL (IN) 2.50 (LB / FT) 3.35	TUBULAR STEEL Ø (IN) FOUNDATION	TUBULAR STEEL Ø (IN) 3.00 (LB / FT) 7.60	TUBULAR STEEL Ø (IN) 3.50 (LB / FT) 9.00	TUBULAR STEEL Ø (IN) 4.00 (LB / FT) 10.80	TUBULAR STEEL Ø (IN) 5.00 (LB / FT) 14.60	SIGN FRAME REQUIRED	REMARKS	SIGN DETAIL LOCATION SHSM	SIGN DETAIL LOCATION PROJECT SHEET #	SIGN DETAIL LOCATION STANDARD SHEET #
ALBURGH US-2 EB							FY-FLUORESCENT YELLOW FYG-FLUORESCENT YELLOW GREEN																			"SHSM"-STANDARD HIGHWAY SIGNS AND MARKINGS			
		A	W11-1	30	30								1																
		A	W11-1	30	30		 11/10/14	6.25								1			16.75 X								X		
		A	W16-1P	18	24		 04/15/15	3.00																			X		
EB	2.974	A	M2-1	21	15								1		X														
		A	M1-5A	24	24		11/10/14						1					13.25											
		A	M2-1	21	15	BLK/ WHT		2.19								1		X									X		
		A	M1-5	30	24	BLK/ WHT		5.00																			X		
EB	3.015	A	UNK.	UNK.	UNK.		EMPTY POST								X														
EB	3.045	A	VD-062BC	74.75	16		TRAVEL INFORMATION ^UP WELCOME CNTR. ON LEFT 3/10			1				X															
		A	VD-062C	74.75	16		C BOARD			1																			
EB	3.099	A	D1-1	72	10		D-BOARD ASSEMBLY						1		X														
		A	D1-1A	72	10		11/10/14						1																
		A	D1-1A	72	10								1					14.25 15.25											
		A	VD1-1	72	12			6.00								2		X									SLIP BASES		7	
		A	VD1-1	72	12			6.00																					7	
SIGN SUMMARY SHEET							SHEET TOTALS	28.44	0.00	2	0	0	6	0	0	4		59.5 60.0		0	0.0	0.0	0.0	0.0					
								SF	SF	EA	EA	EA	EA	EA	EA	EA		FT		EA	LB	LB	LB	LB					
VERMONT AGENCY OF TRANSPORTATION							TOWN DIRECTIONAL TOTALS	897.8	0.0	37	1	1	165	0	0	92		1380.0		0		0.0							

PROJECT NAME: ALBURGH-COLCHESTER
PROJECT NUMBER: STPG SIGN(45)
FILE NAME: 1 Alburgh US2 EB TSS.xls
PROJECT MANAGER: D. BRYANT
DESIGNED BY: B. TOOTHAKER
ALBURGH EB SHEET 5
PLOT DATE: 4/15/2014
DRAWN BY: J. BLANCHARD
CHECKED K. KERN
SHEET 19 OF 167

DIRECTION	MILEPOINT	LOCATION CODE (SHEET 2)	SIGN CODE	WIDTH (IN)	HEIGHT (IN)	SHEETING REMARKS	SIGN LEGEND	NEW SIGNS "A"	NEW SIGNS "B"	EXISTING SIGNS RETAIN	EXISTING SIGNS SALVAGE FROM	EXISTING SIGNS SALVAGE TO	EXISTING SIGNS REMOVE	EXIST POST RETAIN	EXIST POST REMOVE	NUMBER OF NEW POSTS	SQUARE STEEL (IN) 1.75 (LB / FT) 1.88	SQUARE STEEL (IN) 2.00 (LB / FT) 2.42	SQUARE STEEL (IN) 2.50 (LB / FT) 3.35	TUBULAR STEEL Ø (IN) FOUNDATION	TUBULAR STEEL Ø (IN) 3.00 (LB / FT) 7.60	TUBULAR STEEL Ø (IN) 3.50 (LB / FT) 9.00	TUBULAR STEEL Ø (IN) 4.00 (LB / FT) 10.80	TUBULAR STEEL Ø (IN) 5.00 (LB / FT) 14.60	SIGN FRAME REQUIRED	REMARKS	SIGN DETAIL LOCATION SHSM	SIGN DETAIL LOCATION PROJECT SHEET #	SIGN DETAIL LOCATION STANDARD SHEET #
ALBURGH US-2 EB							FY-FLUORESCENT YELLOW FYG-FLUORESCENT YELLOW GREEN																			"SHSM"-STANDARD HIGHWAY SIGNS AND MARKINGS			
		A	VD1-1	72	12			6.00																				7	
EB	3.139	A	M3-1	24	12		ROUTE MARKER ASSEMBLY 12/15/14						1	X															
		A	M1-5	24	24								1																
		A	M6-1	21	15								1																
		A	M3-2	24	12								1																
		A	M1-4	24	24								1																
		A	M6-2	21	15								1																
		A	M4-5	24	12								1																
		A	M1-5A	24	24								1																
		A	M6-2	21	15								1																
		A	M3-1	24	12	BLK/ WHT		2.00																		#3		X	
		A	M1-5	30	24	BLK/ WHT		5.00																				X	
		A	M6-1L	21	15	BLK/ WHT		2.19																				X	
		A	M3-2	24	12	BLK/ WHT		2.00																			X	
		A	M1-4	24	24	BLK/ WHT		4.00																				X	
SIGN SUMMARY SHEET							SHEET TOTALS	21.19 SF	0.00 SF	0 EA	0 EA	0 EA	9 EA	0 EA	0 EA	0 EA		0.0 FT		0 EA	0.0 LB	0.0 LB	0.0 LB	0.0 LB					
VERMONT AGENCY OF TRANSPORTATION							TOWN DIRECTIONAL TOTALS	897.8	0.0	37	1	1	165	0	0	92		1380.0		0	0.0								

PROJECT NAME: **ALBURGH-COLCHESTER**
PROJECT NUMBER: **STPG SIGN(45)**
FILE NAME: **1 Alburah US2 EB TSS.xls** PLOT DATE: **4/15/2014**
PROJECT MANAGER: **D. BRYANT** DRAWN BY: **J. BLANCHARD**
DESIGNED BY: **B. TOOTHAKER** CHECKED **K. KERN**
ALBURGH EB SHEET 6 SHEET **20** OF **167**

DIRECTION	MILEPOINT	LOCATION CODE (SHEET 2)	SIGN CODE	WIDTH (IN)	HEIGHT (IN)	SHEETING REMARKS	SIGN LEGEND	NEW SIGNS "A"	NEW SIGNS "B"	EXISTING SIGNS RETAIN	EXISTING SIGNS SALVAGE FROM	EXISTING SIGNS SALVAGE TO	EXISTING SIGNS REMOVE	EXIST POST RETAIN	EXIST POST REMOVE	NUMBER OF NEW POSTS	SQUARE STEEL (IN) 1.75 (LB / FT) 1.88	SQUARE STEEL (IN) 2.00 (LB / FT) 2.42	SQUARE STEEL (IN) 2.50 (LB / FT) 3.35	TUBULAR STEEL Ø (IN) FOUNDATION	TUBULAR STEEL Ø (IN) 3.00 (LB / FT) 7.60	TUBULAR STEEL Ø (IN) 3.50 (LB / FT) 9.00	TUBULAR STEEL Ø (IN) 4.00 (LB / FT) 10.80	TUBULAR STEEL Ø (IN) 5.00 (LB / FT) 14.60	SIGN FRAME REQUIRED	REMARKS	SIGN DETAIL LOCATION SHSM	SIGN DETAIL LOCATION PROJECT SHEET #	SIGN DETAIL LOCATION STANDARD SHEET #
ALBURGH US-2 EB							FY-FLUORESCENT YELLOW FYG-FLUORESCENT YELLOW GREEN																			"SHSM"-STANDARD HIGHWAY SIGNS AND MARKINGS			
		A	M6-2R	21	15	BLK/ WHT		2.19																			X		
		A	M4-5	24	12	GRN/ WHT		2.00										12.00 11.25									X		
		A	M1-5	24	24	GRN/ WHT		4.00																			X		
		A	M6-2R	21	15	GRN/ WHT		2.19																			X		
EB	3.151	C	D1-1A	72	10		ROUTE MARKER AND D-BOARD ASSEMBLY						1																
		C	D1-1A	72	10								1																
		C	D1-1	72	10								1																
		C	M3-2	24	12								1																
		C	M1-4	24	24								1																
		C	M6-1	21	15								1	X															
		C	M3-4	24	12								1																
		C	M1-4	24	24								1																
		C	M6-1	21	15								1																
		C	VD1-1	72	12			6.00																				7	
		C	VD1-1	72	12			6.00																				7	
SIGN SUMMARY SHEET							SHEET TOTALS	22.38	0.00	0	0	0	9	0	0	0		23.25 0.0		0	0.0	0.0	0.0	0.0					
								SF	SF	EA	EA	EA	EA	EA	EA	EA		FT		EA	LB	LB	LB	LB					
VERMONT AGENCY OF TRANSPORTATION							TOWN DIRECTIONAL TOTALS	897.8	0.0	37	1	1	165	0	0	92		1380.0		0		0.0							

PROJECT NAME: ALBURGH-COLCHESTER
PROJECT NUMBER: STPG SIGN(45)
FILE NAME: 1 Alburgh US2 EB TSS.xls
PROJECT MANAGER: D. BRYANT
DESIGNED BY: B. TOOTHAKER
ALBURGH EB SHEET 7
PLOT DATE: 4/15/2014
DRAWN BY: J. BLANCHARD
CHECKED K. KERN
SHEET 21 OF 167

DIRECTION	MILEPOINT	LOCATION CODE (SHEET 2)	SIGN CODE	WIDTH (IN)	HEIGHT (IN)	SHEETING REMARKS	SIGN LEGEND	NEW SIGNS "A"	NEW SIGNS "B"	EXISTING SIGNS RETAIN	EXISTING SIGNS SALVAGE FROM	EXISTING SIGNS SALVAGE TO	EXISTING SIGNS REMOVE	EXIST POST RETAIN	EXIST POST REMOVE	NUMBER OF NEW POSTS	SQUARE STEEL (IN) 1.75 (LB/FT) 1.88	SQUARE STEEL (IN) 2.00 (LB/FT) 2.42	SQUARE STEEL (IN) 2.50 (LB/FT) 3.35	TUBULAR STEEL Ø (IN) FOUNDATION	TUBULAR STEEL Ø (IN) 3.00 (LB/FT) 7.60	TUBULAR STEEL Ø (IN) 3.50 (LB/FT) 9.00	TUBULAR STEEL Ø (IN) 4.00 (LB/FT) 10.80	TUBULAR STEEL Ø (IN) 5.00 (LB/FT) 14.60	SIGN FRAME REQUIRED	REMARKS	SIGN DETAIL LOCATION SHSM	SIGN DETAIL LOCATION PROJECT SHEET #	SIGN DETAIL LOCATION STANDARD SHEET #
ALBURGH US-2 EB							FY-FLUORESCENT YELLOW FYG-FLUORESCENT YELLOW GREEN																				"SHSM"-STANDARD HIGHWAY SIGNS AND MARKINGS			
		C	VD1-1	72	12			6.00																				7	
		C	M3-2	24	12	BLK/WHT		2.00																				X		
		C	M1-4	24	24	BLK/WHT		4.00																				X		
		C	M6-1L	21	15	BLK/WHT		2.19																				X		
		C	M3-4	24	12	BLK/WHT		2.00																				X		
		C	M1-4	24	24	BLK/WHT	12/15/14	4.00																				X		
		C	M6-1R	21	15	BLK/WHT		2.19										14.00 15.50									SLIP BASES	X		
EB	3.195	A	W3-5	48	48								1		X			13.00 13.75												
		A	W3-5	36	36			9.00								2	X											X		
EB	3.265	A	VD-018	30	18								1		X			13.00												
		A	VD-018	30	18		 11/10/14	3.75								1	X												6	
EB	3.319	A	R2-1	36	48								1		X			14.75												
		A	R2-1	30	36		 11/10/14	7.50								1	X											X		
EB	3.394	A	VR-142	24	36		NO PARKING DEC. 1 - APR. 1 MIDNIGHT TO 7AM			1				X																
		A	M4-6P	24	12		BEGIN PARKING			1																				
SIGN SUMMARY SHEET							SHEET TOTALS	42.63	0.00	2	0	0	3	0	0	4		~~84.00~~ 60.0		0	0.0	0.0	0.0	0.0					
								SF	SF	EA	EA	EA	EA	EA	EA	EA		FT		EA	LB	LB	LB	LB					
VERMONT AGENCY OF TRANSPORTATION							TOWN DIRECTIONAL TOTALS	897.8	0.0	37	1	1	165	0	0	92		1380.0		0		0.0							

PROJECT NAME: ALBURGH-COLCHESTER
PROJECT NUMBER: STPG SIGN(45)

FILE NAME: 1 Alburgh US2 EB TSS.xls
PROJECT MANAGER: D. BRYANT
DESIGNED BY: B. TOOTHAKER
ALBURGH EB SHEET 8

PLOT DATE: 4/15/2014
DRAWN BY: J. BLANCHARD
CHECKED K. KERN
SHEET 22 OF 167

DIRECTION	MILEPOINT	LOCATION CODE (SHEET 2)	SIGN CODE	WIDTH (IN)	HEIGHT (IN)	SHEETING REMARKS	SIGN LEGEND	NEW SIGNS "A"	NEW SIGNS "B"	EXISTING SIGNS RETAIN	EXISTING SIGNS SALVAGE FROM	EXISTING SIGNS SALVAGE TO	EXISTING SIGNS REMOVE	EXIST POST RETAIN	EXIST POST REMOVE	NUMBER OF NEW POSTS	SQUARE STEEL (IN) 1.75 (LB/FT) 1.88	SQUARE STEEL (IN) 2.00 (LB/FT) 2.42	SQUARE STEEL (IN) 2.50 (LB/FT) 3.35	TUBULAR STEEL Ø (IN) FOUNDATION	TUBULAR STEEL Ø (IN) 3.00 (LB/FT) 7.60	TUBULAR STEEL Ø (IN) 3.50 (LB/FT) 9.00	TUBULAR STEEL Ø (IN) 4.00 (LB/FT) 10.80	TUBULAR STEEL Ø (IN) 5.00 (LB/FT) 14.60	SIGN FRAME REQUIRED	REMARKS	SIGN DETAIL LOCATION SHSM	SIGN DETAIL LOCATION PROJECT SHEET #	SIGN DETAIL LOCATION STANDARD SHEET #
ALBURGH US-2 EB							FY-FLUORESCENT YELLOW FYG-FLUORESCENT YELLOW GREEN																				"SHSM"-STANDARD HIGHWAY SIGNS AND MARKINGS			
EB	3.556	A	W3-5	36	36								1	X															
		A	W3-5	36	36		 11/10/14	9.00																			X		
EB	3.651	A	R2-1	24	30								1		X														
		A	R2-1	30	36		 11/10/14	7.50								1		13.75 X									X		
EB	3.696	A	W16-9	24	10		AHEAD						1		X														
		A	S1-1	30	30								1																
		A	S1-1	36	36	FYG	 11/14/14	9.00								1			14.00 X								X		
		A	S4-3	24	8	FYG		1.33																			X		
EB	3.719	A	R2-1	24	30		SPEED LIMIT 25						1	X															
		A	S4-3	24	8		SCHOOL						1																
		A	S4-4	24	10		WHEN FLASHING 11/14/14						1																
		A	S5-1	24	48			8.00																			RETAIN FLASHING BEACON	X		
EB	3.752	A	VR-142	24	36		11/14/14						1	X															
		A	VR-142A	24	18			3.00																				10		
EB	3.892	A	S1-1	30	30		11/14/14						1		X														
SIGN SUMMARY SHEET							SHEET TOTALS	37.83	0.00	0	0	0	9	0	0	2		~~27.75~~ 30.0		0	0.0	0.0	0.0	0.0					
								SF	SF	EA	EA	EA	EA	EA	EA	EA		FT		EA	LB	LB	LB	LB					
VERMONT AGENCY OF TRANSPORTATION							TOWN DIRECTIONAL TOTALS	897.8	0.0	37	1	1	165	0	0	92		1380.0		0		0.0							

PROJECT NAME: ALBURGH-COLCHESTER
PROJECT NUMBER: STPG SIGN(45)
FILE NAME: 1 Alburgh US2 EB TSS.xls
PROJECT MANAGER: D. BRYANT
DESIGNED BY: B. TOOTHAKER
ALBURGH EB SHEET 9
PLOT DATE: 4/15/2014
DRAWN BY: J. BLANCHARD
CHECKED K. KERN
SHEET 23 OF 167

DIRECTION	MILEPOINT	LOCATION CODE (SHEET 2)	SIGN CODE	WIDTH (IN)	HEIGHT (IN)	SHEETING REMARKS	SIGN LEGEND	NEW SIGNS "A"	NEW SIGNS "B"	EXISTING SIGNS RETAIN	EXISTING SIGNS SALVAGE FROM	EXISTING SIGNS SALVAGE TO	EXISTING SIGNS REMOVE	EXIST POST RETAIN	EXIST POST REMOVE	NUMBER OF NEW POSTS	SQUARE STEEL (IN) 1.75 (LB/FT) 1.88	SQUARE STEEL (IN) 2.00 (LB/FT) 2.42	SQUARE STEEL (IN) 2.50 (LB/FT) 3.35	TUBULAR STEEL Ø (IN) FOUNDATION	TUBULAR STEEL Ø (IN) 3.00 (LB/FT) 7.60	TUBULAR STEEL Ø (IN) 3.50 (LB/FT) 9.00	TUBULAR STEEL Ø (IN) 4.00 (LB/FT) 10.80	TUBULAR STEEL Ø (IN) 5.00 (LB/FT) 14.60	SIGN FRAME REQUIRED	REMARKS	SIGN DETAIL LOCATION SHSM	SIGN DETAIL LOCATION PROJECT SHEET #	SIGN DETAIL LOCATION STANDARD SHEET #
ALBURGH US-2 EB							FY-FLUORESCENT YELLOW FYG-FLUORESCENT YELLOW GREEN																				"SHSM"-STANDARD HIGHWAY SIGNS AND MARKINGS			
		A	W16-7	24	12								1																
		A	S1-1	36	36	FYG	 11/14/14	9.00								1			14.00 X							REQUIRES VEGETATION CLEARING	X		
		A	W16-7PL	24	12	FYG		2.00																				X		
EB	3.912	A	W11-8	30	30		11/10/14						1		X			13.75												
		A	W11-8	30	30			6.25								1		X											X		
EB	3.955	A	S5-2	24	30								1		X															
		A	R2-1	24	30		11/14/14						1						15.50											
		A	R2-1	24	30			5.00								1			X										X		
		A	S5-2	24	30			5.00																				X		
EB	4.022	D	VR-017	24	30		11/10/14						1	X				13.00												
		C	VR-017	24	30			5.00																			FIREHOUSE RD (TH-24)		10	
EB	4.030	D	R1-1	30	30								1	~~X~~																
		D	R1-1	30	30		 11/10/14	6.25										16.00									FIREHOUSE RD (TH-24)	X		
EB	4.030	A/B	D3-1	54	12		 11/10/14	4.50								2		11.50 X 12.00									FIREHOUSE RD (TH-24); FIELD LOCATE FOR VISIBILITY FROM ROUTE 2		12	
EB	4.062	A	W11-2	30	30		11/10/14						1	X																
SIGN SUMMARY SHEET							SHEET TOTALS	43.00	0.00	0	0	0	7	0	0	5		~~111.50~~ ~~75.0~~			0	0.0	0.0	0.0	0.0				
								SF	SF	EA	EA	EA	EA	EA	EA	EA		FT			EA	LB	LB	LB	LB				
VERMONT AGENCY OF TRANSPORTATION							TOWN DIRECTIONAL TOTALS	897.8	0.0	37	1	1	165	0	0	92		1380.0			0		0.0						

PROJECT NAME: **ALBURGH-COLCHESTER**
PROJECT NUMBER: **STPG SIGN(45)**
FILE NAME: **1 Alburgh US2 EB TSS.xls** PLOT DATE: **4/15/2014**
PROJECT MANAGER: **D. BRYANT** DRAWN BY: **J. BLANCHARD**
DESIGNED BY: **B. TOOTHAKER** CHECKED **K. KERN**
ALBURGH EB SHEET 10 SHEET **24** OF **167**

DIRECTION	MILEPOINT	LOCATION CODE (SHEET 2)	SIGN CODE	WIDTH (IN)	HEIGHT (IN)	SHEETING REMARKS	SIGN LEGEND	NEW SIGNS "A"	NEW SIGNS "B"	EXISTING SIGNS RETAIN	EXISTING SIGNS SALVAGE FROM	EXISTING SIGNS SALVAGE TO	EXISTING SIGNS REMOVE	EXIST POST RETAIN	EXIST POST REMOVE	NUMBER OF NEW POSTS	SQUARE STEEL (IN) 1.75 (LB / FT) 1.88	SQUARE STEEL (IN) 2.00 (LB / FT) 2.42	SQUARE STEEL (IN) 2.50 (LB / FT) 3.35	TUBULAR STEEL Ø (IN) FOUNDATION	TUBULAR STEEL Ø (IN) 3.00 (LB / FT) 7.60	TUBULAR STEEL Ø (IN) 3.50 (LB / FT) 9.00	TUBULAR STEEL Ø (IN) 4.00 (LB / FT) 10.80	TUBULAR STEEL Ø (IN) 5.00 (LB / FT) 14.60	SIGN FRAME REQUIRED	REMARKS	SIGN DETAIL LOCATION SHSM	SIGN DETAIL LOCATION PROJECT SHEET #	SIGN DETAIL LOCATION STANDARD SHEET #
ALBURGH US-2 EB							FY-FLUORESCENT YELLOW FYG-FLUORESCENT YELLOW GREEN																			"SHSM"-STANDARD HIGHWAY SIGNS AND MARKINGS			
		A	W11-2	30	30	FYG		6.25										11.50									X		
		A	W16-4P	30	24	FYG	 11/10/14	5.00																		X		
EB	4.160	A	M4-6P	24	12		BEGIN PARKING			1				X															
		A	R8-3A	24	24		NO PARKING SYMBOL			1																			
EB	4.165	A/B	D3-1	UNK.	UNK..		LAKE ST 11/10/14						1	X				12.00											
		C	R2-1	24	30		SPEED LIMIT 25 11/10/14	5.0		1								12.75											
		C	R8-3A	24	30		NO PARKING 11/10/14	5.0		1								12.00											
		C	UNK..	UNK.	UNK..		NO PARKING THIS SIDE OF STREET			1																			
EB	4.168	C	VR-017	24	30								1	X															
		C	VR-017	24	30		 11/10/14	5.00																		LAKE ST (TH-24)		10	
EB	4.172	D	R1-1	24	24								1	X															
		A/B	D3-1	32	12		 11/10/14	2.67										12.00									LAKE ST (TH-24); MOUNT TO STOP SIGN WITH BRACKET		12	
		D	R1-1	30	30			6.25																			LAKE ST (TH-24)	X		
EB	4.299	A	R8-3A	24	24		NO PARKING SYMBOL				1	1	1		X												SALVAGE AND REMOUNT ON NEW STREET NAME SIGN POST			
		A	D3-1	UNK.	UNK..								1																
SIGN SUMMARY SHEET							SHEET TOTALS	~~35.17~~ 25.17	0.00	5	1	1	5	0	0	0		~~60.25~~ 0.0		0	0.0	0.0	0.0	0.0					
								SF	SF	EA	EA	EA	EA	EA	EA	EA		FT		EA	LB	LB	LB	LB					
VERMONT AGENCY OF TRANSPORTATION							TOWN DIRECTIONAL TOTALS	897.8	0.0	37	1	1	165	0	0	92		1380.0		0	0.0								

PROJECT NAME: **ALBURGH-COLCHESTER**
PROJECT NUMBER: **STPG SIGN(45)**
FILE NAME: **1 Alburgh US2 EB TSS.xls** PLOT DATE: **4/15/2014**
PROJECT MANAGER: **D. BRYANT** DRAWN BY: **J. BLANCHARD**
DESIGNED BY: **B. TOOTHAKER** CHECKED **K. KERN**
ALBURGH EB SHEET 11 SHEET **25** OF **167**

DIRECTION	MILEPOINT	LOCATION CODE (SHEET 2)	SIGN CODE	WIDTH (IN)	HEIGHT (IN)	SHEETING REMARKS	SIGN LEGEND	NEW SIGNS "A"	NEW SIGNS "B"	EXISTING SIGNS RETAIN	EXISTING SIGNS SALVAGE FROM	EXISTING SIGNS SALVAGE TO	EXISTING SIGNS REMOVE	EXIST POST RETAIN	EXIST POST REMOVE	NUMBER OF NEW POSTS	SQUARE STEEL (IN) 1.75 (LB/FT) 1.88	SQUARE STEEL (IN) 2.00 (LB/FT) 2.42	SQUARE STEEL (IN) 2.50 (LB/FT) 3.35	TUBULAR STEEL Ø (IN) FOUNDATION	TUBULAR STEEL Ø (IN) 3.00 (LB/FT) 7.60	TUBULAR STEEL Ø (IN) 3.50 (LB/FT) 9.00	TUBULAR STEEL Ø (IN) 4.00 (LB/FT) 10.80	TUBULAR STEEL Ø (IN) 5.00 (LB/FT) 14.60	SIGN FRAME REQUIRED	REMARKS	SIGN DETAIL LOCATION SHSM	SIGN DETAIL LOCATION PROJECT SHEET #	SIGN DETAIL LOCATION STANDARD SHEET #
ALBURGH US-2 EB							FY-FLUORESCENT YELLOW FYG-FLUORESCENT YELLOW GREEN																						
		A/B	D3-1	60	12		Horican Ave Pvt 11/10/14	5.00								2		12.75 X 12.75									HORICAN AVE (PVT); FIELD LOCATE FOR VISIBILITY FROM ROUTE 2		12	
EB	4.359	A	R2-1	24	30								1	X														
		A	R8-3A	24	24								1															
		A	R2-1	24	30		SPEED LIMIT 30 11/10/14	5.00																			REQUIRES VEGETATION CLEARING	X		
		C	R8-3	24	24			4.00																				X		
EB	4.423	A	R8-3A	24	24		NO PARKING SYMBOL 11/10/14	4.00		1				X				12.75											
EB	4.458	A	D3-1	UNK.	UNK..		11/10/14						1		X			11.00 10.75											
		A/B	D3-1	68	12		Mott Farm Rd Pvt	5.67								2		X									MOTT FARM RD (PVT); FIELD LOCATE FOR VISIBILITY FROM ROUTE 2		12	
EB	4.628	A	VR-644P	24	12								1	X														
		A	R8-3A	24	24								1					11.75										
		A	R3-9dP	30	12	BLK/WHT	END 11/10/14	2.50								1		X										X		
		A	R8-3	24	24			4.00																				X		
EB	4.651	C	VR-142	24	36		NO PARKING DEC. 1 - APR. 1 MIDNIGHT TO 7AM			1				X															
EB	4.695	A	W13-1	18	18		40 MPH						1		X														
		A	W1-10L	30	30								1																
							SHEET TOTALS	~~26.17~~	0.00	2	0	0	7	0	0	5		~~71.75~~ 75.0		0	0.0	0.0	0.0	0.0					
								SF	SF	EA	EA	EA	EA	EA	EA	EA		FT		EA	LB	LB	LB	LB					
							TOWN DIRECTIONAL TOTALS	897.8	0.0	37	1	1	165	0	0	92		1380.0		0		0.0							


SIGN SUMMARY SHEET

VERMONT AGENCY OF TRANSPORTATION

PROJECT NAME: ALBURGH-COLCHESTER
PROJECT NUMBER: STPG SIGN(45)

FILE NAME: 1 Alburgh US2 EB TSS.xls
PROJECT MANAGER: D. BRYANT
DESIGNED BY: B. TOOTHAKER
ALBURGH EB SHEET 12


PLOT DATE: 4/15/2014
DRAWN BY: J. BLANCHARD
CHECKED K. KERN
SHEET 26 OF 167

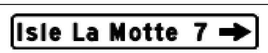DIRECTION	MILEPOINT	LOCATION CODE (SHEET 2)	SIGN CODE	WIDTH (IN)	HEIGHT (IN)	SHEETING REMARKS	SIGN LEGEND	NEW SIGNS "A"	NEW SIGNS "B"	EXISTING SIGNS RETAIN	EXISTING SIGNS SALVAGE FROM	EXISTING SIGNS SALVAGE TO	EXISTING SIGNS REMOVE	EXIST POST RETAIN	EXIST POST REMOVE	NUMBER OF NEW POSTS	SQUARE STEEL (IN) 1.75 (LB/FT) 1.88	SQUARE STEEL (IN) 2.00 (LB/FT) 2.42	SQUARE STEEL (IN) 2.50 (LB/FT) 3.35	FOUNDATION	TUBULAR STEEL Ø (IN) 3.00 (LB/FT) 7.60	TUBULAR STEEL Ø (IN) 3.50 (LB/FT) 9.00	TUBULAR STEEL Ø (IN) 4.00 (LB/FT) 10.80	TUBULAR STEEL Ø (IN) 5.00 (LB/FT) 14.60	SIGN FRAME REQUIRED	REMARKS	SIGN DETAIL LOCATION SHSM	SIGN DETAIL LOCATION PROJECT SHEET #	SIGN DETAIL LOCATION STANDARD SHEET #
ALBURGH US-2 EB							FY-FLUORESCENT YELLOW FYG-FLUORESCENT YELLOW GREEN																				"SHSM"-STANDARD HIGHWAY SIGNS AND MARKINGS			
		A	W1-10L	36	36			9.00								2		13.00 X								RETAIN EXISTING FLASHING BEACON	X		
EB	4.728	A	R2-1	24	30								1	~~X~~														
		A	R2-1	24	30		 11/11/14	5.00																			X		
EB	4.744	B	W1-8	18	24								1		X													
		A	W1-8	18	24								1					12.50										
		A	W1-8L	18	24		 11/11/14	3.00								1		X									X		
		B	W1-8R	18	24			3.00																			X		
EB	4.776	A	W1-8	18	24		CHEVRON			1				X														
		B	W1-8	18	24		CHEVRON			1																		
EB	4.788	A	D1-1M	72	10		ST ANNE SHRINE 6 --->						1	~~X~~														
		A	D1-1A	72	10		11/11/14						1															
		A	VD1-1	72	12			6.00																				7	
EB	4.799	D	R1-1	30	30								1	X				14.00										
		D	R1-1	30	30		 11/11/14	6.25																					
		C	VR-017	24	30			5.00																			WEST SHORE RD (TH-3)		10	
SIGN SUMMARY SHEET							SHEET TOTALS	37.25	0.00	2	0	0	6	0	0	3		~~39.50~~ 45.0		0	0.0	0.0	0.0	0.0					
								SF	SF	EA	EA	EA	EA	EA	EA	EA		FT		EA	LB	LB	LB	LB					
VERMONT AGENCY OF TRANSPORTATION							TOWN DIRECTIONAL TOTALS	897.8	0.0	37	1	1	165	0	0	92		1380.0		0		0.0							

PROJECT NAME: **ALBURGH-COLCHESTER**
PROJECT NUMBER: **STPG SIGN(45)**
FILE NAME: **1 Alburgh US2 EB TSS.xls** PLOT DATE: **4/15/2014**
PROJECT MANAGER: **D. BRYANT** DRAWN BY: **J. BLANCHARD**
DESIGNED BY: **B. TOOTHAKER** CHECKED **K. KERN**
ALBURGH EB SHEET 13 SHEET **27** OF **167**

DIRECTION	MILEPOINT	LOCATION CODE (SHEET 2)	SIGN CODE	WIDTH (IN)	HEIGHT (IN)	SHEETING REMARKS	SIGN LEGEND	NEW SIGNS "A"	NEW SIGNS "B"	EXISTING SIGNS RETAIN	EXISTING SIGNS SALVAGE FROM	EXISTING SIGNS SALVAGE TO	EXISTING SIGNS REMOVE	EXIST POST RETAIN	EXIST POST REMOVE	NUMBER OF NEW POSTS	SQUARE STEEL (IN) 1.75 (LB/FT) 1.88	SQUARE STEEL (IN) 2.00 (LB/FT) 2.42	SQUARE STEEL (IN) 2.50 (LB/FT) 3.35	TUBULAR STEEL Ø (IN) FOUNDATION	TUBULAR STEEL Ø (IN) 3.00 (LB/FT) 7.60	TUBULAR STEEL Ø (IN) 3.50 (LB/FT) 9.00	TUBULAR STEEL Ø (IN) 4.00 (LB/FT) 10.80	TUBULAR STEEL Ø (IN) 5.00 (LB/FT) 14.60	SIGN FRAME REQUIRED	REMARKS	SIGN DETAIL LOCATION SHSM	SIGN DETAIL LOCATION PROJECT SHEET #	SIGN DETAIL LOCATION STANDARD SHEET #
ALBURGH US-2 EB							FY-FLUORESCENT YELLOW FYG-FLUORESCENT YELLOW GREEN																			"SHSM"-STANDARD HIGHWAY SIGNS AND MARKINGS			
EB	4.808	D	R1-1	30	30								1	X															
		A/B	D3-1	UNK.	UNK..		WEST SHORE RD						1																
		D	R1-1	30	30		STOP 11/11/14	6.25																			WEST SHORE RD (TH-3)	X		
EB	4.808	A/B	D3-1	58	12		West Shore Rd 11/11/14	4.83								2		11.00 X 11.25									WEST SHORE RD (TH-3); FIELD LOCATE FOR VISIBILITY FROM ROUTE 2		12	
EB	4.810	A	W1-8	18	24		CHEVRON			1				X															
		B	W1-8	18	24		CHEVRON			1																			
EB	4.818	A	M3-2	24	12		ROUTE MARKER ASSEMBLY 11/11/14						1	X															
		A	M1-4	24	24								1																
		A	M3-2	24	12	BLK/WHT	EAST 2	2.00																				X		
		A	M1-4	24	24	BLK/WHT		4.00																				X		
EB	4.828	B	W1-8	18	24		CHEVRON 04/17/15			1				X															
		A	W1-8	18	24		CHEVRON			1																			
EB	4.852	A	W1-8	18	24		CHEVRON			1				X															
		B	W1-8	18	24		CHEVRON			1																			
EB	4.873	A	VR-644P	24	12		END PARKING			1				X															
SIGN SUMMARY SHEET							SHEET TOTALS	17.08	0.00	7	0	0	4	0	0	2		22.25 ~~30.0~~		0	0.0	0.0	0.0	0.0					
								SF	SF	EA	EA	EA	EA	EA	EA	EA		FT		EA	LB	LB	LB	LB					
VERMONT AGENCY OF TRANSPORTATION							TOWN DIRECTIONAL TOTALS	897.8	0.0	37	1	1	165	0	0	92		1380.0		0		0.0							

PROJECT NAME: **ALBURGH-COLCHESTER**
PROJECT NUMBER: **STPG SIGN(45)**
FILE NAME: **1 Alburgh US2 EB TSS.xls** PLOT DATE: **4/15/2014**
PROJECT MANAGER: **D. BRYANT** DRAWN BY: **J. BLANCHARD**
DESIGNED BY: **B. TOOTHAKER** CHECKED **K. KERN**
ALBURGH EB SHEET 14 SHEET **28** OF **167**

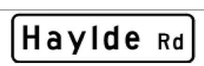DIRECTION	MILEPOINT	LOCATION CODE (SHEET 2)	SIGN CODE	WIDTH (IN)	HEIGHT (IN)	SHEETING REMARKS	SIGN LEGEND	NEW SIGNS "A"	NEW SIGNS "B"	EXISTING SIGNS RETAIN	EXISTING SIGNS SALVAGE FROM	EXISTING SIGNS SALVAGE TO	EXISTING SIGNS REMOVE	EXIST POST RETAIN	EXIST POST REMOVE	NUMBER OF NEW POSTS	SQUARE STEEL (IN) 1.75 (LB/FT) 1.88	SQUARE STEEL (IN) 2.00 (LB/FT) 2.42	SQUARE STEEL (IN) 2.50 (LB/FT) 3.35	TUBULAR STEEL Ø (IN) FOUNDATION	TUBULAR STEEL Ø (IN) 3.00 (LB/FT) 7.60	TUBULAR STEEL Ø (IN) 3.50 (LB/FT) 9.00	TUBULAR STEEL Ø (IN) 4.00 (LB/FT) 10.80	TUBULAR STEEL Ø (IN) 5.00 (LB/FT) 14.60	SIGN FRAME REQUIRED	REMARKS	SIGN DETAIL LOCATION SHSM	SIGN DETAIL LOCATION PROJECT SHEET #	SIGN DETAIL LOCATION STANDARD SHEET #
ALBURGH US-2 EB							FY-FLUORESCENT YELLOW FYG-FLUORESCENT YELLOW GREEN																			"SHSM"-STANDARD HIGHWAY SIGNS AND MARKINGS			
		A	R8-3A	24	30		NO PARKING DEC. 1 - APR. 1 MIDNIGHT TO 7AM			1																			
EB	4.891	A	W1-8L	18	24		 11/11/14	3.00								1		13.00 X								INSTALL 95 FT EAST OF END NO PARKING SIGN	X		
		B	W1-8R	18	24			3.00																			X		
EB	5.018	A	R2-1	24	30								1	~~X~~															
		A	R2-1	24	30		 11/11/14	5.00																			X		
EB	5.171	A	R2-1	24	30								1	~~X~~															
		A	R2-1	24	30		 11/11/14	5.00										16.00									X		
EB	5.313	A	R2-1	24	30								1	~~X~~															
		A	R2-1	24	30		 11/11/14	5.00																			X		
EB	5.574	A	W1-2R	30	30		 04/11/15	6.25								1		17.25 X								INSTALL 100 FT WEST OF BEGINNING OF CURVE (500 FT WEST OF CENTERLINE OF HAYLDE RD)	X		
EB	5.661	C	VR-017	24	30								1	~~X~~															
		C	R2-1	24	30		SPEED LIMIT 25			1																			
		C	VR-017	24	30		 11/11/14	5.00										15.00								HAYLDE RD (TH-27)		10	
EB	5.667	D	R1-1	30	30								1		X			14.25											
		A/B	D3-1	42	12		 11/11/14	3.50								1		X								HAYLDE RD (TH-27); MOUNT TO STOP SIGN WITH BRACKETS		12	
							SHEET TOTALS	35.75 SF	0.00 SF	2 EA	0 EA	0 EA	5 EA	0 EA	0 EA	3 EA		~~75.50~~ 45.0 FT		0 EA	0.0 LB	0.0 LB	0.0 LB	0.0 LB				
							TOWN DIRECTIONAL TOTALS	897.8	0.0	37	1	1	165	0	0	92		1380.0		0	0.0								

SIGN SUMMARY SHEET

VERMONT AGENCY OF TRANSPORTATION

PROJECT NAME: **ALBURGH-COLCHESTER**
PROJECT NUMBER: **STPG SIGN(45)**
FILE NAME: **1 Alburgh US2 EB TSS.xls**
PROJECT MANAGER: **D. BRYANT**
DESIGNED BY: **B. TOOTHAKER**
ALBURGH EB SHEET 15
PLOT DATE: **4/15/2014**
DRAWN BY: **J. BLANCHARD**
CHECKED **K. KERN**
SHEET **29** OF **167**

DIRECTION	MILEPOINT	LOCATION CODE (SHEET 2)	SIGN CODE	WIDTH (IN)	HEIGHT (IN)	SHEETING REMARKS	SIGN LEGEND	NEW SIGNS "A"	NEW SIGNS "B"	EXISTING SIGNS RETAIN	EXISTING SIGNS SALVAGE FROM	EXISTING SIGNS SALVAGE TO	EXISTING SIGNS REMOVE	EXIST POST RETAIN	EXIST POST REMOVE	NUMBER OF NEW POSTS	SQUARE STEEL (IN) 1.75 (LB / FT) 1.88	SQUARE STEEL (IN) 2.00 (LB / FT) 2.42	SQUARE STEEL (IN) 2.50 (LB / FT) 3.35	TUBULAR STEEL Ø (IN) FOUNDATION	TUBULAR STEEL Ø (IN) 3.00 (LB / FT) 7.60	TUBULAR STEEL Ø (IN) 3.50 (LB / FT) 9.00	TUBULAR STEEL Ø (IN) 4.00 (LB / FT) 10.80	TUBULAR STEEL Ø (IN) 5.00 (LB / FT) 14.60	SIGN FRAME REQUIRED	REMARKS	SIGN DETAIL LOCATION SHSM	SIGN DETAIL LOCATION PROJECT SHEET #	SIGN DETAIL LOCATION STANDARD SHEET #
ALBURGH US-2 EB							FY-FLUORESCENT YELLOW FYG-FLUORESCENT YELLOW GREEN																			"SHSM"-STANDARD HIGHWAY SIGNS AND MARKINGS			
		D	R1-1	30	30		STOP 11/11/14	6.25										14.00								HAYLDE RD (TH-27)	X		
EB	5.668	A/B	D3-1	UNK.	UNK..		HAYLDE RD 11/11/14						1		X													
EB	5.861	A	W3-5	36	36								1		X			17.75 16.75										
		A	W3-5	36	36		START 40 11/11/14	9.00								2		X									X		
EB	5.930	A	M3-2	24	12		ROUTE MARKER ASSEMBLY						1		X													
		A	M1-4	24	24		11/11/14						1					16.00										
		A	M3-2	24	12	BLK/ WHT	EAST	2.00								1		X									X		
		A	M1-4	24	24	BLK/ WHT	2	4.00																			X		
EB	5.961	C	VR-017	24	30								1	X														
		C	R2-1	24	30		SPEED LIMIT 25 11/11/14			1								17.25								HAYLDE RD (TH-27)			
		C	VR-017	24	30		LEGAL LOAD LIMIT 24,000 POUNDS	5.00																		REQUIRES VEGETATION CLEARING		10	
EB	5.971	D	R1-1	30	30								1	~~X~~														
		A/B	D3-1	UNK.	UNK..								1															
		A/B	D3-1	42	12		Haylde Rd 11/11/14	3.50										16.25								MOUNT TO STOP SIGN WITH BRACKET		12	
		D	R1-1	30	30		STOP	6.25																		HAYLDE RD (TH-27)	X		
SIGN SUMMARY SHEET							SHEET TOTALS	36.00	0.00	1	0	0	7	0	0	3		~~98.00~~ ~~45.0~~		0	0.0	0.0	0.0	0.0				
								SF	SF	EA	EA	EA	EA	EA	EA	EA		FT		EA	LB	LB	LB	LB				
VERMONT AGENCY OF TRANSPORTATION							TOWN DIRECTIONAL TOTALS	897.8	0.0	37	1	1	165	0	0	92		1380.0		0			0.0					

PROJECT NAME: ALBURGH-COLCHESTER
PROJECT NUMBER: STPG SIGN(45)
FILE NAME: 1 Alburgh US2 EB TSS.xls
PROJECT MANAGER: D. BRYANT
DESIGNED BY: B. TOOTHAKER
ALBURGH EB SHEET 16
PLOT DATE: 4/15/2014
DRAWN BY: J. BLANCHARD
CHECKED K. KERN
SHEET 30 OF 167

DIRECTION	MILEPOINT	LOCATION CODE (SHEET 2)	SIGN CODE	WIDTH (IN)	HEIGHT (IN)	SHEETING REMARKS	SIGN LEGEND	NEW SIGNS "A"	NEW SIGNS "B"	EXISTING SIGNS RETAIN	EXISTING SIGNS SALVAGE FROM	EXISTING SIGNS SALVAGE TO	EXISTING SIGNS REMOVE	EXIST POST RETAIN	EXIST POST REMOVE	NUMBER OF NEW POSTS	SQUARE STEEL (IN) 1.75 (LB/FT) 1.88	SQUARE STEEL (IN) 2.00 (LB/FT) 2.42	SQUARE STEEL (IN) 2.50 (LB/FT) 3.35	TUBULAR STEEL Ø (IN) FOUNDATION	TUBULAR STEEL Ø (IN) 3.00 (LB/FT) 7.60	TUBULAR STEEL Ø (IN) 3.50 (LB/FT) 9.00	TUBULAR STEEL Ø (IN) 4.00 (LB/FT) 10.80	TUBULAR STEEL Ø (IN) 5.00 (LB/FT) 14.60	SIGN FRAME REQUIRED	REMARKS	SIGN DETAIL LOCATION SHSM	SIGN DETAIL LOCATION PROJECT SHEET #	SIGN DETAIL LOCATION STANDARD SHEET #
ALBURGH US-2 EB							FY-FLUORESCENT YELLOW FYG-FLUORESCENT YELLOW GREEN																			"SHSM"-STANDARD HIGHWAY SIGNS AND MARKINGS			
EB	5.987	A	R4-1	24	30								1		X														
		A	R2-1	24	30								1					17.50											
		A	R2-1	30	36		SPEED LIMIT 40 12/15/14	7.50								1			X									X		
		A	R4-1	24	30		DO NOT PASS	5.00																			SLIP BASES	X		
EB	6.016	A	W2-1	30	30			6.25								1		16.25 X									INSTALL 26 FT WEST OF EXISTING JCT ASSEMBLY	X		
		A	W16-2P	24	18		1000 FEET 11/11/14	3.00																				X		
EB	6.021	A	M2-1	21	15		JCT STATE 11/11/14						1		X															
		A	M1-5	24	24		VERMONT 78						1																	
EB	6.058	A	W16-2	24	12		800 FEET 11/11/14						1		X															
		A	W2-1	36	36		CROSSROAD						1					17.00											
		A	M2-1	21	15	GRN/WHT	JCT	2.19								1		X										X		
		A	M1-5	24	24	GRN/WHT	VERMONT 78	4.00																				X		
EB	6.093	A	VD-062AS	72	16		BUSINESS SIGN			1				X																
		A	VD-062AS	72	16		BUSINESS SIGN			1				X																
EB	6.130	A	D1-1	72	10		D-BOARD ASSEMBLY 04/15/15						1		X															
							SHEET TOTALS	27.94	0.00	2	0	0	7	0	0	3		~~50.75~~ ~~45.0~~ FT		0	0.0	0.0	0.0	0.0					
								SF	SF	EA	EA	EA	EA	EA	EA	EA				EA	LB	LB	LB	LB					
							TOWN DIRECTIONAL TOTALS	897.8	0.0	37	1	1	165	0	0	92		1380.0		0		0.0							

SIGN SUMMARY SHEET

VERMONT AGENCY OF TRANSPORTATION

PROJECT NAME: ALBURGH-COLCHESTER
PROJECT NUMBER: STPG SIGN(45)
FILE NAME: 1 Alburah US2 EB TSS.xls
PROJECT MANAGER: D. BRYANT
DESIGNED BY: B. TOOTHAKER
ALBURGH EB SHEET 17
PLOT DATE: 4/15/2014
DRAWN BY: J. BLANCHARD
CHECKED K. KERN
SHEET 31 OF 167

DIRECTION	MILEPOINT	LOCATION CODE (SHEET 2)	SIGN CODE	WIDTH (IN)	HEIGHT (IN)	SHEETING REMARKS	SIGN LEGEND	NEW SIGNS "A"	NEW SIGNS "B"	EXISTING SIGNS RETAIN	EXISTING SIGNS SALVAGE FROM	EXISTING SIGNS SALVAGE TO	EXISTING SIGNS REMOVE	EXIST POST RETAIN	EXIST POST REMOVE	NUMBER OF NEW POSTS	SQUARE STEEL (IN) 1.75 (LB/FT) 1.88	SQUARE STEEL (IN) 2.00 (LB/FT) 2.42	SQUARE STEEL (IN) 2.50 (LB/FT) 3.35	TUBULAR STEEL Ø (IN) FOUNDATION	TUBULAR STEEL Ø (IN) 3.00 (LB/FT) 7.60	TUBULAR STEEL Ø (IN) 3.50 (LB/FT) 9.00	TUBULAR STEEL Ø (IN) 4.00 (LB/FT) 10.80	TUBULAR STEEL Ø (IN) 5.00 (LB/FT) 14.60	SIGN FRAME REQUIRED	REMARKS	SIGN DETAIL LOCATION SHSM	SIGN DETAIL LOCATION PROJECT SHEET #	SIGN DETAIL LOCATION STANDARD SHEET #
ALBURGH US-2 EB							FY-FLUORESCENT YELLOW FYG-FLUORESCENT YELLOW GREEN																				"SHSM"-STANDARD HIGHWAY SIGNS AND MARKINGS			
		A	D1-1G	72	10		04/15/15						1																
		A	D1-1A	72	10								1					17.25 14.25											
		A	VD1-1	72	12			6.00								2		X								SLIP BASES		8	
		A	VD1-1	72	12			6.00																					8	
		A	VD1-1	72	12			6.00																					8	
EB	6.178	A	M4-5	24	12		ROUTE MARKER ASSEMBLY						1		X														
		A	M1-1	24	24								1																
		A	M6-1	21	15								1																
		A	M3-2	24	12		12/15/14						1																
		A	M1-5	24	24								1																
		A	M6-1	21	15								1																
		A	M3-2	24	12								1																
		A	M1-4	24	24								1																
		A	M6-3	21	15								1					11.50 11.25											
		A	M4-5	24	12	WHT/BLU		2.00								2			X							#3	SLIP BASES	X		
SIGN SUMMARY SHEET							SHEET TOTALS	20.00	0.00	0	0	0	11	0	0	4		54.25 ~~60.0~~		0	0.0	0.0	0.0	0.0					
								SF	SF	EA	EA	EA	EA	EA	EA	EA		FT		EA	LB	LB	LB	LB					
VERMONT AGENCY OF TRANSPORTATION							TOWN DIRECTIONAL TOTALS	897.8	0.0	37	1	1	165	0	0	92		1380.0		0		0.0							

PROJECT NAME: ALBURGH-COLCHESTER
PROJECT NUMBER: STPG SIGN(45)
FILE NAME: 1 Alburgh US2 EB TSS.xls
PROJECT MANAGER: D. BRYANT
DESIGNED BY: B. TOOTHAKER
ALBURGH EB SHEET 18
PLOT DATE: 4/15/2014
DRAWN BY: J. BLANCHARD
CHECKED K. KERN
SHEET 32 OF 167

DIRECTION	MILEPOINT	LOCATION CODE (SHEET 2)	SIGN CODE	WIDTH (IN)	HEIGHT (IN)	SHEETING REMARKS	SIGN LEGEND	NEW SIGNS "A"	NEW SIGNS "B"	EXISTING SIGNS RETAIN	EXISTING SIGNS SALVAGE FROM	EXISTING SIGNS SALVAGE TO	EXISTING SIGNS REMOVE	EXIST POST RETAIN	EXIST POST REMOVE	NUMBER OF NEW POSTS	SQUARE STEEL (IN) 1.75 (LB/FT) 1.88	SQUARE STEEL (IN) 2.00 (LB/FT) 2.42	SQUARE STEEL (IN) 2.50 (LB/FT) 3.35	TUBULAR STEEL Ø (IN) FOUNDATION	TUBULAR STEEL Ø (IN) 3.00 (LB/FT) 7.60	TUBULAR STEEL Ø (IN) 3.50 (LB/FT) 9.00	TUBULAR STEEL Ø (IN) 4.00 (LB/FT) 10.80	TUBULAR STEEL Ø (IN) 5.00 (LB/FT) 14.60	SIGN FRAME REQUIRED	REMARKS	SIGN DETAIL LOCATION SHSM	SIGN DETAIL LOCATION PROJECT SHEET #	SIGN DETAIL LOCATION STANDARD SHEET #
ALBURGH US-2 EB							FY-FLUORESCENT YELLOW FYG-FLUORESCENT YELLOW GREEN																				"SHSM"-STANDARD HIGHWAY SIGNS AND MARKINGS			
		A	M1-1	24	24	WHT/ BLU		4.00																			X		
		A	M6-1L	21	15	WHT/ BLU		2.19																			X		
		A	M3-2	24	12	GRN/ WHT		2.00																			X		
		A	M1-5	24	24	GRN/ WHT		4.00																			X		
		A	M6-1L	21	15	GRN/ WHT		2.19																			X		
		A	M3-2	24	12	BLK/ WHT		2.00																			X		
		A	M1-4	24	24	BLK/ WHT		4.00																			X		
		A	M6-3	21	15	BLK/ WHT		2.19																			X		
EB	6.232	D	R1-1	30	30								1	~~X~~													TRUCK ROUTE (TH-4)			
		D	R1-1	30	30		 11/11/14	6.25											14.50								INSTALL WEST OF INTERSECTION; TRUCK ROUTE (TH-4)	X		
		C	VR-017	24	30			5.00																			INSTALL ON REVERSE OF STOP SIGN; TRUCK ROUTE (TH-4)		10	
EB	6.236	D	R1-1	30	30		11/11/14						1	X																
		A/B	D3-1	UNK.	UNK..		TRUCK ROUTE (STREET SIGN)						1																	
		D	R1-1	30	30			6.25																			TRUCK ROUTE (TH-4)	X		
EB	6.236	A/B	D3-1	54	12			4.50								2		~~11.00~~ X 11.00									TRUCK ROUTE (TH-4); FIELD LOCATE FOR VISIBILITY FROM ROUTE 2		12	
SIGN SUMMARY SHEET							SHEET TOTALS	44.56	0.00	0	0	0	3	0	0	2		~~30.0~~ 36.50		0	0.0	0.0	0.0	0.0					
								SF	SF	EA	EA	EA	EA	EA	EA	EA		FT		EA	LB	LB	LB	LB					
VERMONT AGENCY OF TRANSPORTATION							TOWN DIRECTIONAL TOTALS	897.8	0.0	37	1	1	165	0	0	92		1380.0		0			0.0					

PROJECT NAME: ALBURGH-COLCHESTER
PROJECT NUMBER: STPG SIGN(45)
FILE NAME: 1 Alburgh US2 EB TSS.xls
PROJECT MANAGER: D. BRYANT
DESIGNED BY: B. TOOTHAKER
ALBURGH EB SHEET 19
PLOT DATE: 4/15/2014
DRAWN BY: J. BLANCHARD
CHECKED K. KERN
SHEET 33 OF 167

DIRECTION	MILEPOINT	LOCATION CODE (SHEET 2)	SIGN CODE	WIDTH (IN)	HEIGHT (IN)	SHEETING REMARKS	SIGN LEGEND	NEW SIGNS "A"	NEW SIGNS "B"	EXISTING SIGNS RETAIN	EXISTING SIGNS SALVAGE FROM	EXISTING SIGNS SALVAGE TO	EXISTING SIGNS REMOVE	EXIST POST RETAIN	EXIST POST REMOVE	NUMBER OF NEW POSTS	SQUARE STEEL (IN) 1.75 (LB/FT) 1.88	SQUARE STEEL (IN) 2.00 (LB/FT) 2.42	SQUARE STEEL (IN) 2.50 (LB/FT) 3.35	TUBULAR STEEL Ø (IN) FOUNDATION	TUBULAR STEEL Ø (IN) 3.00 (LB/FT) 7.60	TUBULAR STEEL Ø (IN) 3.50 (LB/FT) 9.00	TUBULAR STEEL Ø (IN) 4.00 (LB/FT) 10.80	TUBULAR STEEL Ø (IN) 5.00 (LB/FT) 14.60	SIGN FRAME REQUIRED	REMARKS	SIGN DETAIL LOCATION SHSM	SIGN DETAIL LOCATION PROJECT SHEET #	SIGN DETAIL LOCATION STANDARD SHEET #
ALBURGH US-2 EB							FY-FLUORESCENT YELLOW FYG-FLUORESCENT YELLOW GREEN																			"SHSM"-STANDARD HIGHWAY SIGNS AND MARKINGS			
EB	6.259	A	M3-2	24	12		ROUTE MARKER ASSEMBLY						1		X														
		A	M1-4	24	24								1																
		A	M3-2	24	12	BLK/ WHT	EAST 11/20/14	2.00								1		14.50 X								EXISTING POST STRAIGHTENED	X		
		A	M1-4	24	24	BLK/ WHT	2	4.00																			X		
EB	6.308	A	R4-1	24	30								1	X															
		A	R2-1	24	30		11/20/14						1																
		A	R2-1	24	30		SPEED LIMIT 40	5.00										15.25									X		
		A	R4-1	24	30		DO NOT PASS	5.00																			X		
EB	6.402	A	D1-1A	72	12		D-BOARD ASSEMBLY						1																
		A	D1-1A	72	12		11/20/14						1					14.75 13.25											
		A	VD1-1	72	12		S Alburgh 5	6.00								2		X										8	
		A	VD1-1	72	12		Grand Isle 18	6.00																				8	
EB	6.421	B	D4-2	30	36		PARK AND RIDE			1				X															
EB	6.430	B	W14-3	24	36		04/15/15						1		X														
		A	VR-417	24	30		END NO PASSING 11/20/14						1																
SIGN SUMMARY SHEET							SHEET TOTALS	28.00	0.00	1	0	0	8	0	0	3		57.75 ~~45.0~~		0	0.0	0.0	0.0	0.0					
								SF	SF	EA	EA	EA	EA	EA	EA	EA		FT		EA	LB	LB	LB	LB					
VERMONT AGENCY OF TRANSPORTATION							TOWN DIRECTIONAL TOTALS	897.8	0.0	37	1	1	165	0	0	92		1380.0		0		0.0							

PROJECT NAME: ALBURGH-COLCHESTER
PROJECT NUMBER: STPG SIGN(45)
FILE NAME: 1 Alburgh US2 EB TSS.xls
PROJECT MANAGER: D. BRYANT
DESIGNED BY: B. TOOTHAKER
ALBURGH EB SHEET 20
PLOT DATE: 4/15/2014
DRAWN BY: J. BLANCHARD
CHECKED K. KERN
SHEET 34 OF 167

DIRECTION	MILEPOINT	LOCATION CODE (SHEET 2)	SIGN CODE	WIDTH (IN)	HEIGHT (IN)	SHEETING REMARKS	SIGN LEGEND	NEW SIGNS "A"	NEW SIGNS "B"	EXISTING SIGNS RETAIN	EXISTING SIGNS SALVAGE FROM	EXISTING SIGNS SALVAGE TO	EXISTING SIGNS REMOVE	EXIST POST RETAIN	EXIST POST REMOVE	NUMBER OF NEW POSTS	SQUARE STEEL (IN) 1.75 (LB/FT) 1.88	SQUARE STEEL (IN) 2.00 (LB/FT) 2.42	SQUARE STEEL (IN) 2.50 (LB/FT) 3.35	TUBULAR STEEL Ø (IN) FOUNDATION	TUBULAR STEEL Ø (IN) 3.00 (LB/FT) 7.60	TUBULAR STEEL Ø (IN) 3.50 (LB/FT) 9.00	TUBULAR STEEL Ø (IN) 4.00 (LB/FT) 10.80	TUBULAR STEEL Ø (IN) 5.00 (LB/FT) 14.60	SIGN FRAME REQUIRED	REMARKS	SIGN DETAIL LOCATION SHSM	SIGN DETAIL LOCATION PROJECT SHEET #	SIGN DETAIL LOCATION STANDARD SHEET #
ALBURGH US-2 EB							FY-FLUORESCENT YELLOW FYG-FLUORESCENT YELLOW GREEN																			"SHSM"-STANDARD HIGHWAY SIGNS AND MARKINGS			
		A	R4-2	24	30		PASS WITH CARE 04/15/15	5.00								1		X 15.50											
		B	W14-3	48	36		NO PASSING ZONE 11/20/14	6.00 ~~6.41~~																				X	
EB	6.466	A	VD-018	30	18		11/20/14						1	X															
		A	VD-018	30	18		Alburgh Center South Alburgh 5	3.75																				6	
EB	6.567	A	R2-1	24	30								1	X															
		A	R2-1	24	30		SPEED LIMIT 40 11/20/14	5.00																				X	
EB	6.675	A	W1-10R	36	36		11/20/14	9.00								2		14.50 X 14.75									INSTALL 100 FT WEST OF BEGINNING OF CURVE (500 FT WEST OF SPEED LIMIT SIGN)	X		
EB	6.770	A	R2-1	24	30		11/21/14						1	X															
		A	R2-1	24	30		SPEED LIMIT 40	5.00																				X	
EB	6.869	A	R2-1	24	30		11/21/14						1		X														
		A	R2-1	24	30		SPEED LIMIT 50	5.00								1		14.00 X										X	
EB	7.180	A	W11-4	30	30		CATTLE SYMBOL 11/21/14						1		X														
EB	7.763	C	VR-017	24	30								1	X															
		C	R2-1	24	30		SPEED LIMIT 35			1																	MIDDLE RD (TH-33)			
		C	VR-017	24	30		LEGAL LOAD LIMIT 24,000 POUNDS	5.00										13.00									MIDDLE RD (TH-33)		10	
SIGN SUMMARY SHEET							SHEET TOTALS	~~43.75~~ ~~44.16~~	0.00	1	0	0	6	0	0	4		~~71.75~~ ~~60.0~~		0	0.0	0.0	0.0	0.0					
								SF	SF	EA	EA	EA	EA	EA	EA	EA		FT		EA	LB	LB	LB	LB					
VERMONT AGENCY OF TRANSPORTATION							TOWN DIRECTIONAL TOTALS	897.8	0.0	37	1	1	165	0	0	92		1380.0		0			0.0					

PROJECT NAME: ALBURGH-COLCHESTER
PROJECT NUMBER: STPG SIGN(45)
FILE NAME: 1 Alburgh US2 EB TSS.xls
PROJECT MANAGER: D. BRYANT
DESIGNED BY: B. TOOTHAKER
ALBURGH EB SHEET 21
PLOT DATE: 4/15/2014
DRAWN BY: J. BLANCHARD
CHECKED K. KERN
SHEET 35 OF 167

DIRECTION	MILEPOINT	LOCATION CODE (SHEET 2)	SIGN CODE	WIDTH (IN)	HEIGHT (IN)	SHEETING REMARKS	SIGN LEGEND	NEW SIGNS "A"	NEW SIGNS "B"	EXISTING SIGNS RETAIN	EXISTING SIGNS SALVAGE FROM	EXISTING SIGNS SALVAGE TO	EXISTING SIGNS REMOVE	EXIST POST RETAIN	EXIST POST REMOVE	NUMBER OF NEW POSTS	SQUARE STEEL (IN) 1.75 (LB/FT) 1.88	SQUARE STEEL (IN) 2.00 (LB/FT) 2.42	SQUARE STEEL (IN) 2.50 (LB/FT) 3.35	TUBULAR STEEL Ø (IN) FOUNDATION	TUBULAR STEEL Ø (IN) 3.00 (LB/FT) 7.60	TUBULAR STEEL Ø (IN) 3.50 (LB/FT) 9.00	TUBULAR STEEL Ø (IN) 4.00 (LB/FT) 10.80	TUBULAR STEEL Ø (IN) 5.00 (LB/FT) 14.60	SIGN FRAME REQUIRED	REMARKS	SIGN DETAIL LOCATION SHSM	SIGN DETAIL LOCATION PROJECT SHEET #	SIGN DETAIL LOCATION STANDARD SHEET #
ALBURGH US-2 EB							FY-FLUORESCENT YELLOW FYG-FLUORESCENT YELLOW GREEN																			"SHSM"-STANDARD HIGHWAY SIGNS AND MARKINGS			
EB	7.772	D	R1-1	30	30		11/24/14						1	~~X~~															
		A/B	D3-1	UNK.	UNK..								1					14.00											
		A/B	D3-1	40	12		Middle Rd	3.33																		MIDDLE RD (TH-33); MOUNT ON STOP SIGN WITH BRACKET		12	
		D	R1-1	30	30		STOP	6.25																		MIDDLE RD (TH-33)	X		
EB	7.906	A	W1-2R	30	30		RIGHT CURVE 11/24/14						1		X														
EB	7.970	A	W1-2R	30	30		11/24/14	6.25					1			1		15.75 X								INSTALL 100 FT WEST OF BEGINNING OF CURVE (338 FT EAST OF EXISTING)	X		
EB	8.291 - 8.400	A/B	N/A	6	8		INSTALL (10) NEW DELINEATOR ASSEMBLIES 11/24/14																			INSTALL 10 BACK TO BACK DELINEATOR ASSEMBLIES AT 60 FT SPACINGS. SEE SHEET 4			
EB	9.657	A	W11-1	30	30								1		X			15.75											
		A	W11-1	30	30		11/24/14	6.25								1		X									X		
EB	9.661	A	W11-3A	30	30								1		X				15.50										
		A	W11-3	30	30		11/24/14	6.25								1			X								X		
		A	W16-4P	30	24		NEXT 1½ MILES	5.00																			X		
EB	9.736	A	S3-1T	30	30		SCHOOL BUS STOP AHEAD 11/24/14						1		X														
EB	9.752	A	W1-2L	30	30		11/24/14	6.25								1		14.00 X								INSTALL 100 FT WEST OF BEGINNING OF CURVE (84 FT EAST OF EXISTING SBSA)	X		
EB	9.802	C	VR-017	24	30		11/24/14						1	X															
							SHEET TOTALS	39.58	0.00	0	0	0	8	0	0	4		~~75.00~~ ~~60.0~~ FT		0	0.0	0.0	0.0	0.0					
								SF	SF	EA	EA	EA	EA	EA	EA	EA				EA	LB	LB	LB	LB					
							TOWN DIRECTIONAL TOTALS	897.8	0.0	37	1	1	165	0	0	92		1380.0		0		0.0							

SIGN SUMMARY SHEET

VERMONT AGENCY OF TRANSPORTATION


PROJECT NAME: **ALBURGH-COLCHESTER**
PROJECT NUMBER: **STPG SIGN(45)**
FILE NAME: **1 Alburgh US2 EB TSS.xls** PLOT DATE: **4/15/2014**
PROJECT MANAGER: **D. BRYANT** DRAWN BY: **J. BLANCHARD**
DESIGNED BY: **B. TOOTHAKER** CHECKED **K. KERN**
ALBURGH EB SHEET 22 SHEET **36** OF **167**

DIRECTION	MILEPOINT	LOCATION CODE (SHEET 2)	SIGN CODE	WIDTH (IN)	HEIGHT (IN)	SHEETING REMARKS	SIGN LEGEND	NEW SIGNS "A"	NEW SIGNS "B"	EXISTING SIGNS RETAIN	EXISTING SIGNS SALVAGE FROM	EXISTING SIGNS SALVAGE TO	EXISTING SIGNS REMOVE	EXIST POST RETAIN	EXIST POST REMOVE	NUMBER OF NEW POSTS	SQUARE STEEL (IN) 1.75 (LB/FT) 1.88	SQUARE STEEL (IN) 2.00 (LB/FT) 2.42	SQUARE STEEL (IN) 2.50 (LB/FT) 3.35	TUBULAR STEEL Ø (IN) FOUNDATION	TUBULAR STEEL Ø (IN) 3.00 (LB/FT) 7.60	TUBULAR STEEL Ø (IN) 3.50 (LB/FT) 9.00	TUBULAR STEEL Ø (IN) 4.00 (LB/FT) 10.80	TUBULAR STEEL Ø (IN) 5.00 (LB/FT) 14.60	SIGN FRAME REQUIRED	REMARKS	SIGN DETAIL LOCATION SHSM	SIGN DETAIL LOCATION PROJECT SHEET #	SIGN DETAIL LOCATION STANDARD SHEET #
ALBURGH US-2 EB							FY-FLUORESCENT YELLOW FYG-FLUORESCENT YELLOW GREEN																			"SHSM"-STANDARD HIGHWAY SIGNS AND MARKINGS			
		C	R2-1	24	30		SPEED LIMIT 35			1																SUMMIT RD (TH-35)			
		C	VR-017	24	30			5.00								1		15.25								SUMMIT RD (TH-35) - REPOSITION IN FRONT OF UTILITY POLE		10	
EB	9.805	D	R1-1	30	30		11/24/14						1	X															
		A/B	D3-1	UNK.	UNK..		SUMMIT RD						1																
		D	R1-1	30	30			6.25																	SUMMIT RD (TH-35)	X		
EB	9.805	A/B	D3-1	42	12		11/24/14	3.50								1		12.50 X								SUMMIT RD (TH-35); FIELD LOCATE FOR VISIBILITY FROM ROUTE 2		12	
EB	9.806	A	W1-6	48	24								1	~~X~~															
		A	W1-6L	48	24		 11/24/14	8.00										16.00									X		
EB	9.980	A	W1-2L	30	30								1	X															
		A	W1-2L	30	30		 11/24/14	6.25																			X		
EB	10.005	A	W1-8L	18	24		 11/24/14	3.00								1		16.00 X								INSTALL 132 FT EAST OF LEFT CURVE WARNING	X		
		B	W1-8R	18	24			3.00																			X		
EB	10.034	A	W1-8L	18	24		 11/24/14	3.00								1		15.25 X								INSTALL 153 FT EAST OF PREVIOUS CHEVRON	X		
		B	W1-8R	18	24			3.00																			X		
EB	10.065	A	W1-8L	18	24		 11/24/14	3.00								1		15.25 X								INSTALL 164 FT EAST OF PREVIOUS CHEVRON	X		
SIGN SUMMARY SHEET							SHEET TOTALS	44.00	0.00	1	0	0	4	0	0	4		~~90.25~~ ~~60.0~~		0	0.0	0.0	0.0	0.0				
								SF	SF	EA	EA	EA	EA	EA	EA	EA		FT		EA	LB	LB	LB	LB				
VERMONT AGENCY OF TRANSPORTATION							TOWN DIRECTIONAL TOTALS	897.8	0.0	37	1	1	165	0	0	92		1380.0		0		0.0						

PROJECT NAME: **ALBURGH-COLCHESTER**
PROJECT NUMBER: **STPG SIGN(45)**
FILE NAME: **1 Alburgh US2 EB TSS.xls** PLOT DATE: **4/15/2014**
PROJECT MANAGER: **D. BRYANT** DRAWN BY: **J. BLANCHARD**
DESIGNED BY: **B. TOOTHAKER** CHECKED **K. KERN**
ALBURGH EB SHEET 23 SHEET **37** OF **167**

DIRECTION	MILEPOINT	LOCATION CODE (SHEET 2)	SIGN CODE	WIDTH (IN)	HEIGHT (IN)	SHEETING REMARKS	SIGN LEGEND	NEW SIGNS "A"	NEW SIGNS "B"	EXISTING SIGNS RETAIN	EXISTING SIGNS SALVAGE FROM	EXISTING SIGNS SALVAGE TO	EXISTING SIGNS REMOVE	EXIST POST RETAIN	EXIST POST REMOVE	NUMBER OF NEW POSTS	SQUARE STEEL (IN) 1.75 / 2.00 / 2.50 (LB / FT) 1.88 / 2.42 / 3.35	TUBULAR STEEL Ø (IN) FOUNDATION	TUBULAR STEEL Ø (IN) 3.00 / 3.50 / 4.00 / 5.00 (LB / FT) 7.60 / 9.00 / 10.80 / 14.60	SIGN FRAME REQUIRED	REMARKS	SIGN DETAIL LOCATION SHSM	SIGN DETAIL LOCATION PROJECT SHEET #	SIGN DETAIL LOCATION STANDARD SHEET #
ALBURGH US-2 EB							FY-FLUORESCENT YELLOW FYG-FLUORESCENT YELLOW GREEN														"SHSM"-STANDARD HIGHWAY SIGNS AND MARKINGS			
		B	W1-8R	18	24			3.00														X		
EB	10.095	A	W1-8L	18	24		 11/24/14	3.00								1	14.75 X				INSTALL 158 FT EAST OF PREVIOUS CHEVRON	X		
		B	W1-8R	18	24			3.00														X		
EB	10.125	A	W1-8L	18	24		 11/24/14	3.00								1	12.75 X				INSTALL 158 FT EAST OF PREVIOUS CHEVRON	X		
		B	W1-8R	18	24			3.00														X		
EB	10.155	A	W1-8L	18	24		 11/24/14	3.00								1	13.75 X				INSTALL 158 FT EAST OF PREVIOUS CHEVRON	X		
		B	W1-8R	18	24			3.00														X		
EB	10.340	A	W1-2R	30	30		 11/24/14	6.25								1	14.25 X				INSTALL 227 FT WEST OF BUSINESS SIGNS	X		
EB	10.383	A	VD-062BRN	72	16		BUSINESS SIGN			1				X										
		A	VD-062AL	72	16		BUSINESS SIGN			1				X										
EB	11.095	A	W3-5	48	48		SPEED REDUCTION SPEED LIMIT 40 11/25/14						1		X									
EB	11.160	A	W3-5	36	36			9.00								2	16.75 X 15.50				INSTALL 500 FT WEST OF SPEED LIMIT SIGN (105 FT WEST OF EXISTING VILLAGE SIGN)	X		
EB	11.180	A	VD-018	30	18		SOUTH ALBURGH NORTH HERO 7						1		X									
EB	11.208	A	VD-018	30	18			3.75								1	13.25 X				INSTALL 250 FT WEST OF SPEED LIMIT SIGN		6	
EB	11.255	A	R2-1	36	48								1		X									
SIGN SUMMARY SHEET							SHEET TOTALS	40.00	0.00	2	0	0	3	0	0	7	101.00 ~~105.0~~	0	0.0	0.0	0.0	0.0				
								SF	SF	EA	EA	EA	EA	EA	EA	EA	FT	EA	LB	LB	LB	LB				
VERMONT AGENCY OF TRANSPORTATION							TOWN DIRECTIONAL TOTALS	897.8	0.0	37	1	1	165	0	0	92	1380.0	0	0.0							

PROJECT NAME: ALBURGH-COLCHESTER
PROJECT NUMBER: STPG SIGN(45)
FILE NAME: 1 Alburgh US2 EB TSS.xls
PROJECT MANAGER: D. BRYANT
DESIGNED BY: B. TOOTHAKER
ALBURGH EB SHEET 24
PLOT DATE: 4/15/2014
DRAWN BY: J. BLANCHARD
CHECKED K. KERN
SHEET 38 OF 167

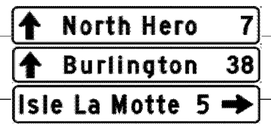DIRECTION	MILEPOINT	LOCATION CODE (SHEET 2)	SIGN CODE	WIDTH (IN)	HEIGHT (IN)	SHEETING REMARKS	SIGN LEGEND	NEW SIGNS "A"	NEW SIGNS "B"	EXISTING SIGNS RETAIN	EXISTING SIGNS SALVAGE FROM	EXISTING SIGNS SALVAGE TO	EXISTING SIGNS REMOVE	EXIST POST RETAIN	EXIST POST REMOVE	NUMBER OF NEW POSTS	SQUARE STEEL (IN) 1.75 (LB/FT) 1.88	SQUARE STEEL (IN) 2.00 (LB/FT) 2.42	SQUARE STEEL (IN) 2.50 (LB/FT) 3.35	TUBULAR STEEL Ø (IN) FOUNDATION	TUBULAR STEEL Ø (IN) 3.00 (LB/FT) 7.60	TUBULAR STEEL Ø (IN) 3.50 (LB/FT) 9.00	TUBULAR STEEL Ø (IN) 4.00 (LB/FT) 10.80	TUBULAR STEEL Ø (IN) 5.00 (LB/FT) 14.60	SIGN FRAME REQUIRED	REMARKS	SIGN DETAIL LOCATION SHSM	SIGN DETAIL LOCATION PROJECT SHEET #	SIGN DETAIL LOCATION STANDARD SHEET #
ALBURGH US-2 EB							FY-FLUORESCENT YELLOW FYG-FLUORESCENT YELLOW GREEN																				"SHSM"-STANDARD HIGHWAY SIGNS AND MARKINGS			
		A	R2-1	30	36			7.50								1		11.50 X									X		
EB	11.457	A	S3-1	36	36	FYG		9.00								2		14.75 X 15.00								INSTALL 250' WEST OF MODIFIED LEFT CURVE	X		
EB	11.504	A	W1-2ML	30	30								1		X			15.75 16.00											
		A	W1-10L	36	36			9.00								2		X									X		
EB	11.550	A	D1-1A	72	10		D-BOARD ASSEMBLY						1		X														
		A	D1-1A	72	10								1																
		A	D1-1A	72	10								1					12.25 11.50											
		A	VD1-1	72	12		 4/16/15	6.00								2		X										8	
		A	VD1-1	72	12			6.00																				8	
		A	VD1-1	72	12			6.00																				8	
EB	11.595	A	M3-2	24	12		ROUTE MARKER ASSEMBLY						1		X														
		A	M1-4	24	24								1																
		A	M6-3	21	15								1																
		A	M3-4	24	12								1																
		A	M1-5	30	24								1																
SIGN SUMMARY SHEET							SHEET TOTALS	43.50	0.00	0	0	0	9	0	0	7		~~96.75~~ ~~105.0~~ FT		0	0.0	0.0	0.0	0.0					
								SF	SF	EA	EA	EA	EA	EA	EA	EA				EA	LB	LB	LB	LB					
VERMONT AGENCY OF TRANSPORTATION							TOWN DIRECTIONAL TOTALS	897.8	0.0	37	1	1	165	0	0	92		1380.0		0		0.0							

PROJECT NAME: **ALBURGH-COLCHESTER**
PROJECT NUMBER: **STPG SIGN(45)**
FILE NAME: **1 Alburgh US2 EB TSS.xls** PLOT DATE: **4/15/2014**
PROJECT MANAGER: **D. BRYANT** DRAWN BY: **J. BLANCHARD**
DESIGNED BY: **B. TOOTHAKER** CHECKED **K. KERN**
ALBURGH EB SHEET 25 SHEET **39** OF **167**

DIRECTION	MILEPOINT	LOCATION CODE (SHEET 2)	SIGN CODE	WIDTH (IN)	HEIGHT (IN)	SHEETING REMARKS	SIGN LEGEND	NEW SIGNS "A"	NEW SIGNS "B"	EXISTING SIGNS RETAIN	EXISTING SIGNS SALVAGE FROM	EXISTING SIGNS SALVAGE TO	EXISTING SIGNS REMOVE	EXIST POST RETAIN	EXIST POST REMOVE	NUMBER OF NEW POSTS	SQUARE STEEL (IN) 1.75 (LB/FT) 1.88	SQUARE STEEL (IN) 2.00 (LB/FT) 2.42	SQUARE STEEL (IN) 2.50 (LB/FT) 3.35	TUBULAR STEEL Ø (IN) FOUNDATION	TUBULAR STEEL Ø (IN) 3.00 (LB/FT) 7.60	TUBULAR STEEL Ø (IN) 3.50 (LB/FT) 9.00	TUBULAR STEEL Ø (IN) 4.00 (LB/FT) 10.80	TUBULAR STEEL Ø (IN) 5.00 (LB/FT) 14.60	SIGN FRAME REQUIRED	REMARKS	SIGN DETAIL LOCATION SHSM	SIGN DETAIL LOCATION PROJECT SHEET #	SIGN DETAIL LOCATION STANDARD SHEET #
ALBURGH US-2 EB							FY-FLUORESCENT YELLOW FYG-FLUORESCENT YELLOW GREEN																			"SHSM"-STANDARD HIGHWAY SIGNS AND MARKINGS			
		A	M6-1	21	15								1																
		A	M3-2	24	12	BLK/WHT		2.00								2		12.50 X 12.50								#2	SLIP BASES	X		
		A	M1-4	24	24	BLK/WHT		4.00																				X		
		A	M6-3	21	15	BLK/WHT		2.19																				X		
		A	M3-4	24	12	GRN/WHT		2.00																				X		
		A	M1-5	30	24	GRN/WHT		5.00																				X		
		A	M6-1R	21	15	GRN/WHT		2.19																				X		
EB	11.632	A	M1-5	30	24		ROUTE 129 11/25/14						1		X														
EB	11.660	A	M3-2	24	12		ROUTE MARKER ASSEMBLY						1		X														
		A	M1-4	24	24		11/25/14						1					16.50											
		A	M3-2	24	12	BLK/WHT		2.00								1		X										X		
		A	M1-4	24	24	BLK/WHT		4.00																				X		
EB	11.672	A	W2-2MR	30	30								1		X			15.75											
		A	W2-2R	30	30		 11/25/14	6.25								1		X										X		
EB	11.719	A	D3-1	56	12		Poor Farm Rd 04/17/15	4.67								2		11.25 X 11.50									POOR FARM RD (TH-38); INSTALL AT CORNER OF RED HOUSE FOR VISIBILITY FROM ROUTE 2		12	
							SHEET TOTALS	34.30	0.00	0	0	0	5	0	0	6		80.00 ~~90.0~~		0	0.0	0.0	0.0	0.0				
								SF	SF	EA	EA	EA	EA	EA	EA	EA		FT		EA	LB	LB	LB	LB				
							TOWN DIRECTIONAL TOTALS	897.8	0.0	37	1	1	165	0	0	92		1380.0		0		0.0						

SIGN SUMMARY SHEET

VERMONT AGENCY OF TRANSPORTATION

PROJECT NAME: **ALBURGH-COLCHESTER**
PROJECT NUMBER: **STPG SIGN(45)**

FILE NAME: **1 Alburgh US2 EB TSS.xls**
PROJECT MANAGER: **D. BRYANT**
DESIGNED BY: **B. TOOTHAKER**
ALBURGH EB SHEET 26

PLOT DATE: **4/15/2014**
DRAWN BY: **J. BLANCHARD**
CHECKED **K. KERN**
SHEET **40** OF **167**


DIRECTION	MILEPOINT	LOCATION CODE (SHEET 2)	SIGN CODE	WIDTH (IN)	HEIGHT (IN)	SHEETING REMARKS	SIGN LEGEND	NEW SIGNS "A"	NEW SIGNS "B"	EXISTING SIGNS RETAIN	EXISTING SIGNS SALVAGE FROM	EXISTING SIGNS SALVAGE TO	EXISTING SIGNS REMOVE	EXIST POST RETAIN	EXIST POST REMOVE	NUMBER OF NEW POSTS	SQUARE STEEL (IN) 1.75 (LB/FT) 1.88	SQUARE STEEL (IN) 2.00 (LB/FT) 2.42	SQUARE STEEL (IN) 2.50 (LB/FT) 3.35	TUBULAR STEEL Ø (IN) FOUNDATION	TUBULAR STEEL Ø (IN) 3.00 (LB/FT) 7.60	TUBULAR STEEL Ø (IN) 3.50 (LB/FT) 9.00	TUBULAR STEEL Ø (IN) 4.00 (LB/FT) 10.80	TUBULAR STEEL Ø (IN) 5.00 (LB/FT) 14.60	SIGN FRAME REQUIRED	REMARKS	SIGN DETAIL LOCATION SHSM	SIGN DETAIL LOCATION PROJECT SHEET #	SIGN DETAIL LOCATION STANDARD SHEET #
ALBURGH US-2 EB							FY-FLUORESCENT YELLOW FYG-FLUORESCENT YELLOW GREEN																				"SHSM"-STANDARD HIGHWAY SIGNS AND MARKINGS			
EB	11.724	C	VR-017	24	30		LEGAL LOAD LIMIT 24,000 POUNDS 11/25/14									1		15.00 X								POOR FARM RD (TH-38)		10	
EB	11.732	D	R1-1	30	30								1	X															
		A	D3-1	UNK.	UNK..		POOR FARM RD						1																
		D	R1-1	30	30		STOP 11/25/14	6.25									1	15.00								POOR FARM RD (TH-38)	X		

DIRECTION	MILEPOINT	LOCATION CODE (SHEET 2)	SIGN CODE	WIDTH (IN)	HEIGHT (IN)	SHEETING REMARKS	SIGN LEGEND	NEW SIGNS "A"	NEW SIGNS "B"	EXISTING SIGNS RETAIN	EXISTING SIGNS SALVAGE FROM	EXISTING SIGNS SALVAGE TO	EXISTING SIGNS REMOVE	EXIST POST RETAIN	EXIST POST REMOVE	NUMBER OF NEW POSTS	SQUARE STEEL (IN) 1.75 (LB/FT) 1.88	SQUARE STEEL (IN) 2.00 (LB/FT) 2.42	SQUARE STEEL (IN) 2.50 (LB/FT) 3.35	TUBULAR STEEL Ø (IN) FOUNDATION	TUBULAR STEEL Ø (IN) 3.00 (LB/FT) 7.60	TUBULAR STEEL Ø (IN) 3.50 (LB/FT) 9.00	TUBULAR STEEL Ø (IN) 4.00 (LB/FT) 10.80	TUBULAR STEEL Ø (IN) 5.00 (LB/FT) 14.60	SIGN FRAME REQUIRED	REMARKS	SIGN DETAIL LOCATION SHSM	SIGN DETAIL LOCATION PROJECT SHEET #	SIGN DETAIL LOCATION STANDARD SHEET #
ALBURGH US-2 WB							FY-FLUORESCENT YELLOW FYG-FLUORESCENT YELLOW GREEN																			"SHSM"-STANDARD HIGHWAY SIGNS AND MARKINGS			
WB	11.711	F	M2-1	21	15		ROUTE MARKER ASSEMBLY 11/25/14						1		X														
		F	M1-5	30	24								1																
		F	M2-1	21	15	GRN/ WHT	JCT	2.19								1		15.00 X										X		
		F	M1-5	30	24	GRN/ WHT	VERMONT 129	5.00																				X		
WB	11.685	F	VD1-1	72	12		Alburgh Ctr 5 04/16/15	6.00								~~2~~ 1		9.00 ~~9.00~~	X								INSTALL 75 FT EAST OF EXISTING		8	
		F	VD1-1	72	12		Rouses Point NY 11	6.00																					8	
		F	VD1-1	72	12		Isle La Motte 5	6.00																			SLIP BASES		8	
WB	11.671	F	D1-1A	72	12		^UP ALBURGH CTR 5						1		X														
		F	D1-1A	72	12		^UP ROUSES POINT NY 11 04/16/15						1																		
		F	D1-1A	72	12		<--- ISLE LAMOTTE 5						1																		
WB	11.645	F	M3-4	24	12		ROUTE MARKER ASSEMBLY						1		X														
		F	M1-5	30	24								1																
		F	M6-1	21	15								1																
		F	M3-4	24	12								1																
		F	M1-4	30	24								1																
SIGN SUMMARY SHEET							SHEET TOTALS	25.19	0.00	0	0	0	10	0	0	2		~~33.00~~ ~~30.0~~		0	0.0	0.0	0.0	0.0					
								SF	SF	EA	EA	EA	EA	EA	EA	EA		FT		EA	LB	LB	LB	LB					
VERMONT AGENCY OF TRANSPORTATION							TOWN DIRECTIONAL TOTALS	870.8	0.0	23	3	2	157	0	0	80		1200.0		0		0.0							


PROJECT NAME: **ALBURGH-COLCHESTER**
PROJECT NUMBER: **STPG SIGN(45)**
FILE NAME: **2 Alburgh US2 WB TSS.xls** PLOT DATE: **4/15/2014**
PROJECT MANAGER: **D. BRYANT** DRAWN BY: **J. BLANCHARD**
DESIGNED BY: **B. TOOTHAKER** CHECKED **K. KERN**
ALBURGH WB SHEET 1 SHEET **42** OF **167**

DIRECTION	MILEPOINT	LOCATION CODE (SHEET 2)	SIGN CODE	WIDTH (IN)	HEIGHT (IN)	SHEETING REMARKS	SIGN LEGEND	NEW SIGNS "A"	NEW SIGNS "B"	EXISTING SIGNS RETAIN	EXISTING SIGNS SALVAGE FROM	EXISTING SIGNS SALVAGE TO	EXISTING SIGNS REMOVE	EXIST POST RETAIN	EXIST POST REMOVE	NUMBER OF NEW POSTS	SQUARE STEEL (IN) 1.75 (LB/FT) 1.88	SQUARE STEEL (IN) 2.00 (LB/FT) 2.42	SQUARE STEEL (IN) 2.50 (LB/FT) 3.35	TUBULAR STEEL Ø (IN) FOUNDATION	TUBULAR STEEL Ø (IN) 3.00 (LB/FT) 7.60	TUBULAR STEEL Ø (IN) 3.50 (LB/FT) 9.00	TUBULAR STEEL Ø (IN) 4.00 (LB/FT) 10.80	TUBULAR STEEL Ø (IN) 5.00 (LB/FT) 14.60	SIGN FRAME REQUIRED	REMARKS	SIGN DETAIL LOCATION SHSM	SIGN DETAIL LOCATION PROJECT SHEET #	SIGN DETAIL LOCATION STANDARD SHEET #
ALBURGH US-2 WB							FY-FLUORESCENT YELLOW FYG-FLUORESCENT YELLOW GREEN																			"SHSM"-STANDARD HIGHWAY SIGNS AND MARKINGS			
		F	M6-3	21	15								1																
		F	M3-4	24	12	GRN/WHT		2.00								2		13.25 X 13.50								#2	SLIP BASES	X		
		F	M1-5	30	24	GRN/WHT		5.00																				X		
		F	M6-1L	21	15	GRN/WHT	04/16/15	2.19																				X		
		F	M3-4	24	12	BLK/WHT		2.00																				X		
		F	M1-4	24	24	BLK/WHT	WEST VERMONT 129 WEST 2	4.00																				X		
		F	M6-3	21	15	BLK/WHT		2.19																				X		
WB	11.634	G	W1-7	48	24								1	~~X~~				14.00												
		G	W1-7	48	24		11/25/14	8.00																				X		
WB	11.595	F	M3-4	24	12		ROUTE MARKER ASSEMBLY						1	X																
		F	M1-4	24	24								1																	
		F	M3-4	24	12	BLK/WHT	11/25/14	2.00										14.00										X		
		F	M1-4	24	24	BLK/WHT	WEST 2	4.00																				X		
WB	11.364	F	W11-1	30	30		11/25/14						1		X			14.00												
		F	W11-1	30	30			6.25								1		X										X		
SIGN SUMMARY SHEET							SHEET TOTALS	37.63	0.00	0	0	0	5	0	0	3		~~68.75~~ 45.0		0	0.0	0.0	0.0	0.0					
								SF	SF	EA	EA	EA	EA	EA	EA	EA		FT		EA	LB	LB	LB	LB					
VERMONT AGENCY OF TRANSPORTATION							TOWN DIRECTIONAL TOTALS	870.8	0.0	23	3	2	157	0	0	80		1200.0		0		0.0							

PROJECT NAME: ALBURGH-COLCHESTER
PROJECT NUMBER: STPG SIGN(45)
FILE NAME: 2 Alburgh US2 WB TSS.xls
PROJECT MANAGER: D. BRYANT
DESIGNED BY: B. TOOTHAKER
ALBURGH WB SHEET 2
PLOT DATE: 4/15/2014
DRAWN BY: J. BLANCHARD
CHECKED K. KERN
SHEET 43 OF 167

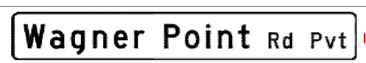DIRECTION	MILEPOINT	LOCATION CODE (SHEET 2)	SIGN CODE	WIDTH (IN)	HEIGHT (IN)	SHEETING REMARKS	SIGN LEGEND	NEW SIGNS "A"	NEW SIGNS "B"	EXISTING SIGNS RETAIN	EXISTING SIGNS SALVAGE FROM	EXISTING SIGNS SALVAGE TO	EXISTING SIGNS REMOVE	EXIST POST RETAIN	EXIST POST REMOVE	NUMBER OF NEW POSTS	SQUARE STEEL (IN) 1.75 (LB / FT) 1.88	SQUARE STEEL (IN) 2.00 (LB / FT) 2.42	SQUARE STEEL (IN) 2.50 (LB / FT) 3.35	TUBULAR STEEL Ø (IN) FOUNDATION	TUBULAR STEEL Ø (IN) 3.00 (LB / FT) 7.60	TUBULAR STEEL Ø (IN) 3.50 (LB / FT) 9.00	TUBULAR STEEL Ø (IN) 4.00 (LB / FT) 10.80	TUBULAR STEEL Ø (IN) 5.00 (LB / FT) 14.60	SIGN FRAME REQUIRED	REMARKS	SIGN DETAIL LOCATION SHSM	SIGN DETAIL LOCATION PROJECT SHEET #	SIGN DETAIL LOCATION STANDARD SHEET #
ALBURGH US-2 WB							FY-FLUORESCENT YELLOW FYG-FLUORESCENT YELLOW GREEN																			"SHSM"-STANDARD HIGHWAY SIGNS AND MARKINGS			
WB	11.321	F	R2-1	24	30		11/25/14						1		X			14.75											
		F	R2-1	24	30			5.00								1		X									X		
WB	11.205	F	W11-3A	30	30								1		X			15.25											
		F	W11-3	30	30		 11/25/14	6.25								1			X								X		
		F	W7-3A	18	24			3.00																		X		
WB	10.661	F	W13-1	24	24		40 MPH 11/25/14						1		X														
		F	W1-2L	30	30		LEFT CURVE						1																
WB	10.625	E/F	D3-1	UNK.	UNK.								1		X			12.00 11.75											
		E/F	D3-1	68	12		 11/24/14	5.67								2		X									BRULEYS TLR PK (PVT); FIELD LOCATE FOR VISIBILITY FROM ROUTE 2		12	
WB	10.589	F	W1-2L	30	30		 11/25/14	6.25								1		16.75 X									INSTALL 100 FT EAST OF BEGINNING OF CURVE (190 FT WEST OF BRULEYS TLR PK)	X		
WB	10.365	E/F	D3-1	UNK.	12								1		X			12.00 12.50											
		E/F	D3-1	70	12		 11/24/14	5.83								2		X									WAGNER POINT RD (PVT); FIELD LOCATE FOR VISIBILITY FROM ROUTE 2		12	
WB	10.197	F	W1-2R	30	30		 11/24/14	6.25								1		12.25 X									INSTALL 100 FT EAST OF BEGINNING OF CURVE (887 FT WEST OF WAGNER POINT RD)	X		
WB	9.115	F	W1-2L	30	30		 04/24/15	6.25								1		15.50 X									INSTALL 100 FT EAST OF BEGINNING OF CURVE (1320 FT EAST OF HIDDEN DRIVES)	X		
WB	8.865	F	VW-133R	30	30		HIDDEN DRIVES RIGHT			1				X															
SIGN SUMMARY SHEET							SHEET TOTALS	44.50	0.00	1	0	0	6	0	0	9		~~106.00~~ ~~135.0~~		0	0.0	0.0	0.0	0.0				
								SF	SF	EA	EA	EA	EA	EA	EA	EA		FT		EA	LB	LB	LB	LB				
VERMONT AGENCY OF TRANSPORTATION							TOWN DIRECTIONAL TOTALS	870.8	0.0	23	3	2	157	0	0	80		1200.0		0			0.0					

PROJECT NAME: ALBURGH-COLCHESTER
PROJECT NUMBER: STPG SIGN(45)
FILE NAME: 2 Alburgh US2 WB TSS.xls
PROJECT MANAGER: D. BRYANT
DESIGNED BY: B. TOOTHAKER
ALBURGH WB SHEET 3
PLOT DATE: 4/15/2014
DRAWN BY: J. BLANCHARD
CHECKED K. KERN
SHEET 44 OF 167

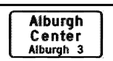DIRECTION	MILEPOINT	LOCATION CODE (SHEET 2)	SIGN CODE	WIDTH (IN)	HEIGHT (IN)	SHEETING REMARKS	SIGN LEGEND	NEW SIGNS "A"	NEW SIGNS "B"	EXISTING SIGNS RETAIN	EXISTING SIGNS SALVAGE FROM	EXISTING SIGNS SALVAGE TO	EXISTING SIGNS REMOVE	EXIST POST RETAIN	EXIST POST REMOVE	NUMBER OF NEW POSTS	SQUARE STEEL (IN) 1.75 (LB/FT) 1.88	SQUARE STEEL (IN) 2.00 (LB/FT) 2.42	SQUARE STEEL (IN) 2.50 (LB/FT) 3.35	TUBULAR STEEL Ø (IN) FOUNDATION	TUBULAR STEEL Ø (IN) 3.00 (LB/FT) 7.60	TUBULAR STEEL Ø (IN) 3.50 (LB/FT) 9.00	TUBULAR STEEL Ø (IN) 4.00 (LB/FT) 10.80	TUBULAR STEEL Ø (IN) 5.00 (LB/FT) 14.60	SIGN FRAME REQUIRED	REMARKS	SIGN DETAIL LOCATION SHSM	SIGN DETAIL LOCATION PROJECT SHEET #	SIGN DETAIL LOCATION STANDARD SHEET #
ALBURGH US-2 WB							FY-FLUORESCENT YELLOW FYG-FLUORESCENT YELLOW GREEN																			"SHSM"-STANDARD HIGHWAY SIGNS AND MARKINGS			
WB	8.447	F	W1-2R	30	30		 II/24/14	6.25								1		16.25 X								INSTALL 100 FT EAST OF BEGINNING OF CURVE (1394 FT EAST OF NEXT EXISTING SIGN)	X		
WB	8.183	F	W1-2L	30	30		LEFT CURVE II/24/14						1		X														
WB	8.161	F	VR-072	24	30								1		X														
		E	VR-072	24	30		 II/24/14	5.00										16.25										10	
		F	VR-072	24	30			5.00								1		X										10	
WB	8.119	F	W1-2L	30	30		 II/24/14	6.25								1		X 14.25								INSTALL 100 FT EAST OF BEGINNING OF CURVE (221 FT WEST OF ENCARE SIGNS)	X		
WB	8.119 - 7.989	F/G	N/A	6	8		INSTALL (8) NEW DELINEATOR ASSEMBLIES II/24/14																			INSTALL 8 BACK TO BACK DELINEATOR ASSEMBLIES AT 100 FT SPACINGS. SEE SHEET 4			
WB	7.054	F	W3-5	36	36		SPEED REDUCTION SPEED LIMIT 40 II/21/14						1		X														
WB	7.005	F	VD-018	30	18		ALBURGH CENTER ALBURGH 3 II/21/14						1		X														
WB	6.983	F	W3-5	36	36		 II/21/14	9.00								2		14.50 X 15.00								INSTALL 200 FT EAST OF VILLAGE SIGN	X		
WB	6.945	F	VD-018	30	18		 II/21/14	3.75								1		14.25 X								INSTALL 200 FT EAST OF CURVE WARNING		6	
WB	6.907	F	W1-10bL	36	36		 II/21/14	9.00								2		14.00 X 14.25								INSTALL 200 FT EAST OF SPEED LIMIT SIGN	X		
WB	6.872 - 6.679	F/G	N/A	6	8		INSTALL (13) NEW DELINEATOR ASSEMBLIES																			INSTALL 13 BACK TO BACK DELINEATOR ASSEMBLIES AT 85 FT SPACINGS. SEE SHEET 4			
WB	6.869	F	R2-1	24	30		II/21/14						1	X				14.00											
		F	R2-1	30	36			7.50																			X		
							SHEET TOTALS	51.75	0.00	0	0	0	5	0	0	8		132.75 ~~120.0~~		0	0.0	0.0	0.0	0.0					
								SF	SF	EA	EA	EA	EA	EA	EA	EA		FT		EA	LB	LB	LB	LB					
							TOWN DIRECTIONAL TOTALS	870.8	0.0	23	3	2	157	0	0	80		1200.0		0			0.0						

SIGN SUMMARY SHEET

VERMONT AGENCY OF TRANSPORTATION

PROJECT NAME: ALBURGH-COLCHESTER
PROJECT NUMBER: STPG SIGN(45)

FILE NAME: 2 Alburgh US2 WB TSS.xls
PROJECT MANAGER: D. BRYANT
DESIGNED BY: B. TOOTHAKER
ALBURGH WB SHEET 4

PLOT DATE: 4/15/2014
DRAWN BY: J. BLANCHARD
CHECKED K. KERN
SHEET 45 OF 167

DIRECTION	MILEPOINT	LOCATION CODE (SHEET 2)	SIGN CODE	WIDTH (IN)	HEIGHT (IN)	SHEETING REMARKS	SIGN LEGEND	NEW SIGNS "A"	NEW SIGNS "B"	EXISTING SIGNS RETAIN	EXISTING SIGNS SALVAGE FROM	EXISTING SIGNS SALVAGE TO	EXISTING SIGNS REMOVE	EXIST POST RETAIN	EXIST POST REMOVE	NUMBER OF NEW POSTS	SQUARE STEEL (IN) 1.75 (LB/FT) 1.88	SQUARE STEEL (IN) 2.00 (LB/FT) 2.42	SQUARE STEEL (IN) 2.50 (LB/FT) 3.35	TUBULAR STEEL Ø (IN) FOUNDATION	TUBULAR STEEL Ø (IN) 3.00 (LB/FT) 7.60	TUBULAR STEEL Ø (IN) 3.50 (LB/FT) 9.00	TUBULAR STEEL Ø (IN) 4.00 (LB/FT) 10.80	TUBULAR STEEL Ø (IN) 5.00 (LB/FT) 14.60	SIGN FRAME REQUIRED	REMARKS	SIGN DETAIL LOCATION SHSM	SIGN DETAIL LOCATION PROJECT SHEET #	SIGN DETAIL LOCATION STANDARD SHEET #
ALBURGH US-2 WB							FY-FLUORESCENT YELLOW FYG-FLUORESCENT YELLOW GREEN																				"SHSM"-STANDARD HIGHWAY SIGNS AND MARKINGS			
WB	6.823	G	R2-1	24	30		SPEED LIMIT 25 11/20/14				1	1	1													CARPENTER LN (TH-32); SALVAGE AND MOUNT BENEATH LLL			
		G	VR-017	24	30			5.00								1		15.75										10	
WB	6.823	F	D3-1	UNK.	UNK.								1		X			12.75				13.00				CARPENTER LN (TH-32)			
		F	D3-1	54	12		 11/20/14	4.50								2		X								INSTALL WEST OF INTERSECTION SITE LOCATE TO NOT INTERFERE WITH ARROW		12	
WB	6.823	F	W1-6	48	24								1	X				14.00											
		F	W1-6L	48	24		 11/20/14	8.00																			X		
WB	6.822	H	R1-1	30	30								1	X				13.25											
		H	R1-1	30	30		 11/20/14	6.25																			X		
WB	6.751	E	W1-6	48	24								1	~~X~~				14.00											
		E	W1-6R	48	24		 11/20/14	8.00																			X		
WB	6.739	G	VR-017	24	30								1	X															
		G	R2-1	24	30		SPEED LIMIT 35			1																CENTER BAY RD (TH-31)			
		G	VR-017	24	30		 11/20/14	5.00										12.50								CENTER BAY RD (TH-31); REQUIRES VEGETATION CLEARING		10	
WB	6.729	H	R1-1	30	30		11/21/14						1	X															
		F	D3-1	UNK.	UNK.		CENTER BAY RD						1																
SIGN SUMMARY SHEET							SHEET TOTALS	36.75	0.00	1	1	1	8	0	0	2		~~82.25~~ 80.0		0	0.0	0.0	0.0	0.0					
								SF	SF	EA	EA	EA	EA	EA	EA	EA		FT		EA	LB	LB	LB	LB					
VERMONT AGENCY OF TRANSPORTATION							TOWN DIRECTIONAL TOTALS	870.8	0.0	23	3	2	157	0	0	80		1200.0		0			0.0					

PROJECT NAME: ALBURGH-COLCHESTER
PROJECT NUMBER: STPG SIGN(45)
FILE NAME: 2 Alburah US2 WB TSS.xls
PROJECT MANAGER: D. BRYANT
DESIGNED BY: B. TOOTHAKER
ALBURGH WB SHEET 5
PLOT DATE: 4/15/2014
DRAWN BY: J. BLANCHARD
CHECKED K. KERN
SHEET 46 OF 167

DIRECTION	MILEPOINT	LOCATION CODE (SHEET 2)	SIGN CODE	WIDTH (IN)	HEIGHT (IN)	SHEETING REMARKS	SIGN LEGEND	NEW SIGNS "A"	NEW SIGNS "B"	EXISTING SIGNS RETAIN	EXISTING SIGNS SALVAGE FROM	EXISTING SIGNS SALVAGE TO	EXISTING SIGNS REMOVE	EXIST POST RETAIN	EXIST POST REMOVE	NUMBER OF NEW POSTS	SQUARE STEEL (IN) 1.75 (LB/FT) 1.88	SQUARE STEEL (IN) 2.00 (LB/FT) 2.42	SQUARE STEEL (IN) 2.50 (LB/FT) 3.35	TUBULAR STEEL Ø (IN) FOUNDATION	TUBULAR STEEL Ø (IN) 3.00 (LB/FT) 7.60	TUBULAR STEEL Ø (IN) 3.50 (LB/FT) 9.00	TUBULAR STEEL Ø (IN) 4.00 (LB/FT) 10.80	TUBULAR STEEL Ø (IN) 5.00 (LB/FT) 14.60	SIGN FRAME REQUIRED	REMARKS	SIGN DETAIL LOCATION SHSM	SIGN DETAIL LOCATION PROJECT SHEET #	SIGN DETAIL LOCATION STANDARD SHEET #
ALBURGH US-2 WB							FY-FLUORESCENT YELLOW FYG-FLUORESCENT YELLOW GREEN																				"SHSM"-STANDARD HIGHWAY SIGNS AND MARKINGS			
		H	R1-1	30	30		STOP 11/21/14	6.25																			CENTER BAY RD (TH-31)	X		
WB	6.729	F	D3-1	60	12		Center Bay Rd 11/20/14	5.00								2		12.50 X								CENTER BAY RD (TH-31); FIELD LOCATE FOR VISIBILITY FROM ROUTE 2		12	
WB	6.684	F	R2-1	24	30								1	~~X~~															
		F	R2-1	24	30		SPEED LIMIT 40 11/20/14	5.00										12.50										X		
WB	6.553	F	R2-1	24	30								1	~~X~~															
		F	R2-1	24	30		SPEED LIMIT 40 11/20/14	5.00										14.00										X		
WB	6.491	F	VD-062AS	72	16		BUSINESS SIGN			1				X															
WB	6.439	F	R4-1	24	30								1		X														
		E	W14-3	48	36		NO PASSING ZONE PENNANT						1					14.25												
		F	R4-1	24	30		DO NOT PASS 11/20/14	5.00								1		X										X		
WB	6.412	F	W2-1	48	48								1	~~X~~															
		F	W16-2	24	12								1																
		F	W2-1	30	30		11/20/14	6.25										14.00										X		
		F	W16-2P	24	18		800 FEET 11/21/14	3.00																				X		
WB	6.373	F	M2-1	21	15		ROUTE MARKER ASSEMBLY 11/20/14						1	X																
							SHEET TOTALS	35.50 SF	0.00 SF	1 EA	0 EA	0 EA	7 EA	0 EA	0 EA	3 EA		67.25 ~~45.0~~ FT		0 EA	0.0 LB	0.0 LB	0.0 LB	0.0 LB					
							TOWN DIRECTIONAL TOTALS	870.8	0.0	23	3	2	157	0	0	80		1200.0		0	0.0									

SIGN SUMMARY SHEET

VERMONT AGENCY OF TRANSPORTATION

PROJECT NAME: ALBURGH-COLCHESTER
PROJECT NUMBER: STPG SIGN(45)
FILE NAME: 2 Alburgh US2 WB TSS.xls
PROJECT MANAGER: D. BRYANT
DESIGNED BY: B. TOOTHAKER
ALBURGH WB SHEET 6
PLOT DATE: 4/15/2014
DRAWN BY: J. BLANCHARD
CHECKED K. KERN

DIRECTION	MILEPOINT	LOCATION CODE (SHEET 2)	SIGN CODE	WIDTH (IN)	HEIGHT (IN)	SHEETING REMARKS	SIGN LEGEND	NEW SIGNS "A"	NEW SIGNS "B"	EXISTING SIGNS RETAIN	EXISTING SIGNS SALVAGE FROM	EXISTING SIGNS SALVAGE TO	EXISTING SIGNS REMOVE	EXIST POST RETAIN	EXIST POST REMOVE	NUMBER OF NEW POSTS	SQUARE STEEL (IN) 1.75 (LB/FT) 1.88	SQUARE STEEL (IN) 2.00 (LB/FT) 2.42	SQUARE STEEL (IN) 2.50 (LB/FT) 3.35	TUBULAR STEEL Ø (IN) FOUNDATION	TUBULAR STEEL Ø (IN) 3.00 (LB/FT) 7.60	TUBULAR STEEL Ø (IN) 3.50 (LB/FT) 9.00	TUBULAR STEEL Ø (IN) 4.00 (LB/FT) 10.80	TUBULAR STEEL Ø (IN) 5.00 (LB/FT) 14.60	SIGN FRAME REQUIRED	REMARKS	SIGN DETAIL LOCATION SHSM	SIGN DETAIL LOCATION PROJECT SHEET #	SIGN DETAIL LOCATION STANDARD SHEET #
ALBURGH US-2 WB							FY-FLUORESCENT YELLOW FYG-FLUORESCENT YELLOW GREEN																				"SHSM"-STANDARD HIGHWAY SIGNS AND MARKINGS			
		F	M1-5	24	24								1																
		F	M2-1	21	15	GRN/WHT	JCT 11/20/14	2.19																				X		
		F	M1-5	24	24	GRN/WHT	VERMONT 78	4.00																				X		
WB	6.336	F	R4-1	24	30								1		X			14.25											
		F	R4-1	24	30		DO NOT PASS 11/20/14	5.00								1		X											
WB	6.292	F	D1-1A	72	10		D-BOARD ASSEMBLY 11/21/14						1		X														
		F	D1-1A	72	10								1																
		F	D1-1A	72	10								1					9.75 10.25											
		F	VD1-1	72	12		Alburgh 2	6.00								2		X								SLIP BASES		8	
		F	VD1-1	72	12		Rouses Point NY 8	6.00																				8	
		F	VD1-1	72	12		Swanton 10 →	6.00																				8	
WB	6.253	F	M3-4	24	12		ROUTE MARKER ASSEMBLY						1	X															
		F	M1-4	24	24		04/16/15						1																
		F	M6-3	21	15								1																
		F	M4-5	24	12								1																
SIGN SUMMARY SHEET							SHEET TOTALS	29.19	0.00	0	0	0	9	0	0	3		34.25 ~~45.0~~		0	0.0	0.0	0.0	0.0					
								SF	SF	EA	EA	EA	EA	EA	EA	EA		FT		EA	LB	LB	LB	LB					
VERMONT AGENCY OF TRANSPORTATION							TOWN DIRECTIONAL TOTALS	870.8	0.0	23	3	2	157	0	0	80		1200.0		0		0.0							

PROJECT NAME: ALBURGH-COLCHESTER
PROJECT NUMBER: STPG SIGN(45)

FILE NAME: 2 Alburgh US2 WB TSS.xls
PROJECT MANAGER: D. BRYANT
DESIGNED BY: B. TOOTHAKER
ALBURGH WB SHEET 7

PLOT DATE: 4/15/2014
DRAWN BY: J. BLANCHARD
CHECKED K. KERN
SHEET 48 OF 167

DIRECTION	MILEPOINT	LOCATION CODE (SHEET 2)	SIGN CODE	WIDTH (IN)	HEIGHT (IN)	SHEETING REMARKS	SIGN LEGEND	NEW SIGNS "A"	NEW SIGNS "B"	EXISTING SIGNS RETAIN	EXISTING SIGNS SALVAGE FROM	EXISTING SIGNS SALVAGE TO	EXISTING SIGNS REMOVE	EXIST POST RETAIN	EXIST POST REMOVE	NUMBER OF NEW POSTS	SQUARE STEEL (IN) 1.75 (LB/FT) 1.88	SQUARE STEEL (IN) 2.00 (LB/FT) 2.42	SQUARE STEEL (IN) 2.50 (LB/FT) 3.35	TUBULAR STEEL Ø (IN) FOUNDATION	TUBULAR STEEL Ø (IN) 3.00 (LB/FT) 7.60	TUBULAR STEEL Ø (IN) 3.50 (LB/FT) 9.00	TUBULAR STEEL Ø (IN) 4.00 (LB/FT) 10.80	TUBULAR STEEL Ø (IN) 5.00 (LB/FT) 14.60	SIGN FRAME REQUIRED	REMARKS	SIGN DETAIL LOCATION SHSM	SIGN DETAIL LOCATION PROJECT SHEET #	SIGN DETAIL LOCATION STANDARD SHEET #
ALBURGH US-2 WB							FY-FLUORESCENT YELLOW FYG-FLUORESCENT YELLOW GREEN																				"SHSM"-STANDARD HIGHWAY SIGNS AND MARKINGS			
		F	M1-1	24	24								1																
		F	M6-1	21	15								1																
		F	M3-2	24	12								1										12.75 11.25						
		F	M1-5	24	24								1																
		F	M6-1	21	15								1																
		F	M3-4	24	12	BLK/ WHT		2.00																#3	SLIP BASES	X		
		F	M1-4	24	24	BLK/ WHT		4.00																				X		
		F	M6-3	21	15	BLK/ WHT		2.19																				X		
		F	M4-5	24	12	WHT/ BLU		2.00																				X		
		F	M1-1	24	24	WHT/ BLU		4.00																				X		
		F	M6-1R	21	15	WHT/ BLU		2.19																				X		
		F	M3-2	24	12	GRN/ WHT		2.00																				X		
		F	M1-5	24	24	GRN/ WHT		4.00																				X		
		F	M6-1R	21	15	GRN/ WHT		2.19																				X		
WB	6.218	F	M3-4	24	12		ROUTE MARKER ASSEMBLY 04/15/15						1	~~X~~																
SIGN SUMMARY SHEET							SHEET TOTALS	24.56 SF	0.00 SF	0 EA	0 EA	0 EA	6 EA	0 EA	0 EA	0 EA		24.00 ~~0.0~~ FT		0 EA	0.0 LB	0.0 LB	0.0 LB	0.0 LB					
VERMONT AGENCY OF TRANSPORTATION							TOWN DIRECTIONAL TOTALS	870.8	0.0	23	3	2	157	0	0	80		1200.0		0	0.0								

PROJECT NAME: ALBURGH-COLCHESTER
PROJECT NUMBER: STPG SIGN(45)
FILE NAME: 2 Alburgh US2 WB TSS.xls
PROJECT MANAGER: D. BRYANT
DESIGNED BY: B. TOOTHAKER
ALBURGH WB SHEET 8
PLOT DATE: 4/15/2014
DRAWN BY: J. BLANCHARD
CHECKED K. KERN
SHEET 49 OF 167

DIRECTION	MILEPOINT	LOCATION CODE (SHEET 2)	SIGN CODE	WIDTH (IN)	HEIGHT (IN)	SHEETING REMARKS	SIGN LEGEND	NEW SIGNS "A"	NEW SIGNS "B"	EXISTING SIGNS RETAIN	EXISTING SIGNS SALVAGE FROM	EXISTING SIGNS SALVAGE TO	EXISTING SIGNS REMOVE	EXIST POST RETAIN	EXIST POST REMOVE	NUMBER OF NEW POSTS	SQUARE STEEL (IN) 1.75 (LB / FT) 1.88	SQUARE STEEL (IN) 2.00 (LB / FT) 2.42	SQUARE STEEL (IN) 2.50 (LB / FT) 3.35	TUBULAR STEEL Ø (IN) FOUNDATION	TUBULAR STEEL Ø (IN) 3.00 (LB / FT) 7.60	TUBULAR STEEL Ø (IN) 3.50 (LB / FT) 9.00	TUBULAR STEEL Ø (IN) 4.00 (LB / FT) 10.80	TUBULAR STEEL Ø (IN) 5.00 (LB / FT) 14.60	SIGN FRAME REQUIRED	REMARKS	SIGN DETAIL LOCATION SHSM	SIGN DETAIL LOCATION PROJECT SHEET #	SIGN DETAIL LOCATION STANDARD SHEET #
ALBURGH US-2 WB							FY-FLUORESCENT YELLOW FYG-FLUORESCENT YELLOW GREEN																			"SHSM"-STANDARD HIGHWAY SIGNS AND MARKINGS			
		F	M1-4	24	24								1			2		14.25 14.25										
		F	M4-5	24	12								1															
		F	M1-5A	24	24								1															
		F	M3-4	24	12	BLK/ WHT	04/15/15	2.00																	#1		X		
		F	M1-4	24	24	BLK/ WHT		4.00																			X		
		F	M4-5	24	12	BLK/ WHT	WEST TO 2 11	2.00																			X		
		F	M1-4	24	24	BLK/ WHT		4.00																			X		
WB	5.997	F	R2-1	24	30								1	~~X~~				12.75										
		F	VR-417	30	30		END NO PASSING						1															
		E	W14-3	48	36								1															
		F	R2-1	24	30		SPEED LIMIT 50 11/13/14	5.00																			X		
		F	R4-2	24	30		PASS WITH CARE	5.00																			MOUNT BELOW SPEED LIMIT	X		
		E	W14-3	48	36		NO PASSING ZONE	12.00																			MOUNT ON REVERSE OF SPEED LIMIT	X		
WB	5.824 - 5.625	F/G	N/A	6	8		INSTALL (15) NEW DELINEATOR ASSEMBLIES																				INSTALL 15 BACK TO BACK DELINEATOR ASSEMBLIES AT 75 FT SPACINGS. SEE SHEET 4			
WB	5.796	F	W1-2L	30	30		11/13/14						1	X															
							SHEET TOTALS	34.00	0.00	0	0	0	7	0	0	0		41.25 0.0			0	0.0	0.0	0.0	0.0					
								SF	SF	EA	EA	EA	EA	EA	EA	EA		FT			EA	LB	LB	LB	LB					
							TOWN DIRECTIONAL TOTALS	870.8	0.0	23	3	2	157	0	0	80		1200.0			0	0.0								

SIGN SUMMARY SHEET

VERMONT AGENCY OF TRANSPORTATION

PROJECT NAME: **ALBURGH-COLCHESTER**
PROJECT NUMBER: **STPG SIGN(45)**

FILE NAME: **2 Alburgh US2 WB TSS.xls** PLOT DATE: **4/15/2014**
PROJECT MANAGER: **D. BRYANT** DRAWN BY: **J. BLANCHARD**
DESIGNED BY: **B. TOOTHAKER** CHECKED **K. KERN**
ALBURGH WB SHEET 9 SHEET **50** OF **167**

DIRECTION	MILEPOINT	LOCATION CODE (SHEET 2)	SIGN CODE	WIDTH (IN)	HEIGHT (IN)	SHEETING REMARKS	SIGN LEGEND	NEW SIGNS "A"	NEW SIGNS "B"	EXISTING SIGNS RETAIN	EXISTING SIGNS SALVAGE FROM	EXISTING SIGNS SALVAGE TO	EXISTING SIGNS REMOVE	EXIST POST RETAIN	EXIST POST REMOVE	NUMBER OF NEW POSTS	SQUARE STEEL (IN) 1.75 (LB/FT) 1.88	SQUARE STEEL (IN) 2.00 (LB/FT) 2.42	SQUARE STEEL (IN) 2.50 (LB/FT) 3.35	TUBULAR STEEL Ø (IN) FOUNDATION	TUBULAR STEEL Ø (IN) 3.00 (LB/FT) 7.60	TUBULAR STEEL Ø (IN) 3.50 (LB/FT) 9.00	TUBULAR STEEL Ø (IN) 4.00 (LB/FT) 10.80	TUBULAR STEEL Ø (IN) 5.00 (LB/FT) 14.60	SIGN FRAME REQUIRED	REMARKS	SIGN DETAIL LOCATION SHSM	SIGN DETAIL LOCATION PROJECT SHEET #	SIGN DETAIL LOCATION STANDARD SHEET #
ALBURGH US-2 WB							FY-FLUORESCENT YELLOW FYG-FLUORESCENT YELLOW GREEN																			"SHSM"-STANDARD HIGHWAY SIGNS AND MARKINGS			
		F	W13-1	18	18		45 MPH						1																
		F	W1-2L	30	30			6.25																			X		
WB	5.422	F	W3-5	48	48		11/13/14						1		X														
		F	W3-5	36	36			9.00								2		15.00 X 15.50								X		
WB	5.368	F	VD-018	30	18		 11/13/14	3.75								1		15.00 X								INSTALL 250 FT EAST OF SPEED LIMIT SIGN		6	
WB	5.321	F	R2-1	36	48		11/13/14						1		X			15.75											
		F	R2-1	30	36			7.50								1		X									X		
WB	5.198	F	R2-1	24	30		SPEED LIMIT 40 11/13/14						1		X														
WB	5.180	F	VD-018	30	18		ALBURGH ROUSES POINT 4 11/13/14						1		X														
WB	5.048	F	R2-1	24	30								1		X			15.50											
		F	R2-1	24	30		 11/13/14	5.00								1		X									X		
WB	4.931	F	W1-10R	30	30								1	X				15.00											
		F	W13-1	18	18		40 MPH 11/13/14						1																
		F	W1-10R	36	36			9.00																			RETAIN EXISTING FLASHING BEACON	X		
WB	4.878	F	M4-6P	24	12		BEGIN PARKING			1				X															
SIGN SUMMARY SHEET							SHEET TOTALS	40.50	0.00	1	0	0	8	0	0	5		91.75 ~~75.0~~		0	0.0	0.0	0.0	0.0					
								SF	SF	EA	EA	EA	EA	EA	EA	EA		FT		EA	LB	LB	LB	LB					
VERMONT AGENCY OF TRANSPORTATION							TOWN DIRECTIONAL TOTALS	870.8	0.0	23	3	2	157	0	0	80		1200.0		0		0.0							

PROJECT NAME: **ALBURGH-COLCHESTER**
PROJECT NUMBER: **STPG SIGN(45)**
FILE NAME: **2 Alburgh US2 WB TSS.xls** PLOT DATE: **4/15/2014**
PROJECT MANAGER: **D. BRYANT** DRAWN BY: **J. BLANCHARD**
DESIGNED BY: **B. TOOTHAKER** CHECKED **K. KERN**
ALBURGH WB SHEET 10 SHEET **51** OF **167**

DIRECTION	MILEPOINT	LOCATION CODE (SHEET 2)	SIGN CODE	WIDTH (IN)	HEIGHT (IN)	SHEETING REMARKS	SIGN LEGEND	NEW SIGNS "A"	NEW SIGNS "B"	EXISTING SIGNS RETAIN	EXISTING SIGNS SALVAGE FROM	EXISTING SIGNS SALVAGE TO	EXISTING SIGNS REMOVE	EXIST POST RETAIN	EXIST POST REMOVE	NUMBER OF NEW POSTS	SQUARE STEEL (IN) 1.75 (LB/FT) 1.88	SQUARE STEEL (IN) 2.00 (LB/FT) 2.42	SQUARE STEEL (IN) 2.50 (LB/FT) 3.35	TUBULAR STEEL Ø (IN) FOUNDATION	TUBULAR STEEL Ø (IN) 3.00 (LB/FT) 7.60	TUBULAR STEEL Ø (IN) 3.50 (LB/FT) 9.00	TUBULAR STEEL Ø (IN) 4.00 (LB/FT) 10.80	TUBULAR STEEL Ø (IN) 5.00 (LB/FT) 14.60	SIGN FRAME REQUIRED	REMARKS	SIGN DETAIL LOCATION SHSM	SIGN DETAIL LOCATION PROJECT SHEET #	SIGN DETAIL LOCATION STANDARD SHEET #
ALBURGH US-2 WB							FY-FLUORESCENT YELLOW FYG-FLUORESCENT YELLOW GREEN																				"SHSM"-STANDARD HIGHWAY SIGNS AND MARKINGS			
		F	VR-142	24	36		NO PARKING DEC. 1 - APR. 1 MIDNIGHT TO 7AM			1																			
WB	4.838	F	D1-1A	72	10								1	X															
		F	D1-1M	72	10		<--- ST ANNE SHRINE 6 11/13/14						1																
		F	VD1-1	72	12			6.00																			
WB	4.817	G	M3-2	24	12		ROUTE MARKER ASSEMBLY 04/15/15						1		X														
		G	M1-4	24	24								1																
		G	M6-1	21	15								1																
		G	M3-4	24	12								1																
		G	M1-4	24	24								1																
		G	M6-1	21	15								1																
		G	M3-2	24	12	BLK/WHT		~~2.00~~								1			13.00 X						#2	SLIP BASES	X		
		G	M1-4	24	24	BLK/WHT		4.00																			X		
		G	M6-1L	21	15	BLK/WHT		2.19																	X		
		G	M3-4	24	12	BLK/WHT		2.00																	X		
		G	M1-4	24	24	BLK/WHT		4.00																	X		
SIGN SUMMARY SHEET							SHEET TOTALS	20.19	0.00	1	0	0	8	0	0	1		~~15.0~~ 13.00		0	0.0	0.0	0.0	0.0					
								SF	SF	EA	EA	EA	EA	EA	EA	EA		FT		EA	LB	LB	LB	LB					
VERMONT AGENCY OF TRANSPORTATION							TOWN DIRECTIONAL TOTALS	870.8	0.0	23	3	2	157	0	0	80		1200.0		0		0.0							

PROJECT NAME: ALBURGH-COLCHESTER
PROJECT NUMBER: STPG SIGN(45)
FILE NAME: 2 Alburgh US2 WB TSS.xls
PROJECT MANAGER: D. BRYANT
DESIGNED BY: B. TOOTHAKER
ALBURGH WB SHEET 11
PLOT DATE: 4/15/2014
DRAWN BY: J. BLANCHARD
CHECKED K. KERN
SHEET 52 OF 167

DIRECTION	MILEPOINT	LOCATION CODE (SHEET 2)	SIGN CODE	WIDTH (IN)	HEIGHT (IN)	SHEETING REMARKS	SIGN LEGEND	NEW SIGNS "A"	NEW SIGNS "B"	EXISTING SIGNS RETAIN	EXISTING SIGNS SALVAGE FROM	EXISTING SIGNS SALVAGE TO	EXISTING SIGNS REMOVE	EXIST POST RETAIN	EXIST POST REMOVE	NUMBER OF NEW POSTS	SQUARE STEEL (IN) 1.75 (LB/FT) 1.88	SQUARE STEEL (IN) 2.00 (LB/FT) 2.42	SQUARE STEEL (IN) 2.50 (LB/FT) 3.35	TUBULAR STEEL Ø (IN) FOUNDATION	TUBULAR STEEL Ø (IN) 3.00 (LB/FT) 7.60	TUBULAR STEEL Ø (IN) 3.50 (LB/FT) 9.00	TUBULAR STEEL Ø (IN) 4.00 (LB/FT) 10.80	TUBULAR STEEL Ø (IN) 5.00 (LB/FT) 14.60	SIGN FRAME REQUIRED	REMARKS	SIGN DETAIL LOCATION SHSM	SIGN DETAIL LOCATION PROJECT SHEET #	SIGN DETAIL LOCATION STANDARD SHEET #
ALBURGH US-2 WB							FY-FLUORESCENT YELLOW FYG-FLUORESCENT YELLOW GREEN																				"SHSM"-STANDARD HIGHWAY SIGNS AND MARKINGS			
		G	M6-1R	21	15	BLK/WHT		2.19																			X		
WB	4.799	F	M3-4	24	12		ROUTE MARKER ASSEMBLY						1	X															
		F	M1-4	24	24								1					15.25											
		F	M3-4	24	12	BLK/WHT	 11/13/14	2.00								1		X									X		
		F	M1-4	24	24	BLK/WHT		4.00																			X		
WB	4.776	F	W3-5	36	36								1		X			15.00 14.25											
		F	W3-5	36	36		 11/13/14	9.00								2		X									X		
WB	4.733	F	R2-1	24	30								1		X			14.50											
		F	R2-1	30	36		 11/13/14	7.50								1		X									X		
WB	4.653	G	VR-017	24	30								1	X															
		G	R2-1	24	30		SPEED LIMIT 25	5.00		1								14.00									WINTERS LN (TH-53)		
		G	VR-017	24	30		 11/13/14	5.00																			WINTERS LN (TH-53)		10	
WB	4.649	H	R1-1	30	30								1	X															
		H	R1-1	30	30		 11/13/14	6.25																			WINTERS LN (TH-53)	X		
WB	4.649	F	D3-1	42	12		 11/13/14	3.50								1		11.25 X									WINTERS LN (TH-53); FIELD LOCATE FOR VISIBILITY FROM ROUTE 2		12	
SIGN SUMMARY SHEET							SHEET TOTALS	~~44.44~~ ~~39.44~~ SF	0.00 SF	1 EA	0 EA	0 EA	6 EA	0 EA	0 EA	5 EA		~~84.25~~ ~~75.0~~ FT		0 EA	0.0 LB	0.0 LB	0.0 LB	0.0 LB					
VERMONT AGENCY OF TRANSPORTATION							TOWN DIRECTIONAL TOTALS	870.8	0.0	23	3	2	157	0	0	80		1200.0		0	0.0								

PROJECT NAME: ALBURGH-COLCHESTER
PROJECT NUMBER: STPG SIGN(45)

FILE NAME: 2 Alburgh US2 WB TSS.xls
PROJECT MANAGER: D. BRYANT
DESIGNED BY: B. TOOTHAKER
ALBURGH WB SHEET 12

PLOT DATE: 4/15/2014
DRAWN BY: J. BLANCHARD
CHECKED K. KERN
SHEET 53 OF 167

DIRECTION	MILEPOINT	LOCATION CODE (SHEET 2)	SIGN CODE	WIDTH (IN)	HEIGHT (IN)	SHEETING REMARKS	SIGN LEGEND	NEW SIGNS "A"	NEW SIGNS "B"	EXISTING SIGNS RETAIN	EXISTING SIGNS SALVAGE FROM	EXISTING SIGNS SALVAGE TO	EXISTING SIGNS REMOVE	EXIST POST RETAIN	EXIST POST REMOVE	NUMBER OF NEW POSTS	SQUARE STEEL (IN) 1.75 (LB/FT) 1.88	SQUARE STEEL (IN) 2.00 (LB/FT) 2.42	SQUARE STEEL (IN) 2.50 (LB/FT) 3.35	TUBULAR STEEL Ø (IN) FOUNDATION	TUBULAR STEEL Ø (IN) 3.00 (LB/FT) 7.60	TUBULAR STEEL Ø (IN) 3.50 (LB/FT) 9.00	TUBULAR STEEL Ø (IN) 4.00 (LB/FT) 10.80	TUBULAR STEEL Ø (IN) 5.00 (LB/FT) 14.60	SIGN FRAME REQUIRED	REMARKS	SIGN DETAIL LOCATION SHSM	SIGN DETAIL LOCATION PROJECT SHEET #	SIGN DETAIL LOCATION STANDARD SHEET #
ALBURGH US-2 WB							FY-FLUORESCENT YELLOW FYG-FLUORESCENT YELLOW GREEN																				"SHSM"-STANDARD HIGHWAY SIGNS AND MARKINGS			
WB	4.493	F	R2-1	24	30								1		X			15.00											
		F	R2-1	24	30		 11/14/14	5.00								1		X									REQUIRES VEGETATION CLEARING	X		
WB	4.468	F	VR-142	24	36		NO PARKING DEC. 1 - APR. 1 MIDNIGHT TO 7AM			1				X															
WB	4.437	G	VR-017	24	30								1	X															
		G	R2-1	24	30		SPEED LIMIT 25			1																	JARVIS LN (TH-53)			
		G	VR-017	24	30		 11/13/14	5.00																			JARVIS LN (TH-53)		10	
WB	4.430	H	R1-1	30	30								1	X															
		F	D3-1	UNK.	UNK.								1																
		F	D3-1	40	12		 11/13/14	3.33																			JARVIS LN (TH-53); MOUNT TO STOP SIGN WITH BRACKET		12	
		H	R1-1	30	30			6.25																			JARVIS LN (TH-53)	X		
WB	4.429	F	R2-1	24	30		SPEED LIMIT 30 11/13/14	5.00		1				X				15.00											
WB	4.372	F	R2-1	24	30		SPEED LIMIT 30 11/14/14						1		X														
WB	4.274	F	VR-660	24	30		NO PARKING ON SIDEWALK OR TRAVEL LANE			1				X															
WB	4.240	F	VR-142	24	36		NO PARKING DEC. 1 - APR. 1 MIDNIGHT TO 7AM			1				X															
		F	R2-1	24	30		SPEED LIMIT 30			1																			
SIGN SUMMARY SHEET							SHEET TOTALS	~~24.58~~ ~~10.58~~ SF	0.00 SF	6 EA	0 EA	0 EA	5 EA	0 EA	0 EA	1 EA		~~30.00~~ ~~15.0~~ FT		0 EA	0.0 LB	0.0 LB	0.0 LB	0.0 LB					
VERMONT AGENCY OF TRANSPORTATION							TOWN DIRECTIONAL TOTALS	870.8	0.0	23	3	2	157	0	0	80		1200.0		0	0.0								

PROJECT NAME: ALBURGH-COLCHESTER
PROJECT NUMBER: STPG SIGN(45)
FILE NAME: 2 Alburgh US2 WB TSS.xls
PROJECT MANAGER: D. BRYANT
DESIGNED BY: B. TOOTHAKER
ALBURGH WB SHEET 13
PLOT DATE: 4/15/2014
DRAWN BY: J. BLANCHARD
CHECKED K. KERN
SHEET 54 OF 167

DIRECTION	MILEPOINT	LOCATION CODE (SHEET 2)	SIGN CODE	WIDTH (IN)	HEIGHT (IN)	SHEETING REMARKS	SIGN LEGEND	NEW SIGNS "A"	NEW SIGNS "B"	EXISTING SIGNS RETAIN	EXISTING SIGNS SALVAGE FROM	EXISTING SIGNS SALVAGE TO	EXISTING SIGNS REMOVE	EXIST POST RETAIN	EXIST POST REMOVE	NUMBER OF NEW POSTS	SQUARE STEEL (IN) 1.75 (LB/FT) 1.88	SQUARE STEEL (IN) 2.00 (LB/FT) 2.42	SQUARE STEEL (IN) 2.50 (LB/FT) 3.35	TUBULAR STEEL Ø (IN) FOUNDATION	TUBULAR STEEL Ø (IN) 3.00 (LB/FT) 7.60	TUBULAR STEEL Ø (IN) 3.50 (LB/FT) 9.00	TUBULAR STEEL Ø (IN) 4.00 (LB/FT) 10.80	TUBULAR STEEL Ø (IN) 5.00 (LB/FT) 14.60	SIGN FRAME REQUIRED	REMARKS	SIGN DETAIL LOCATION SHSM	SIGN DETAIL LOCATION PROJECT SHEET #	SIGN DETAIL LOCATION STANDARD SHEET #
ALBURGH US-2 WB							FY-FLUORESCENT YELLOW FYG-FLUORESCENT YELLOW GREEN																				"SHSM"-STANDARD HIGHWAY SIGNS AND MARKINGS			
WB	4.218	G	VR-017	24	30								1	X															
		G	R2-1	24	30		SPEED LIMIT 25			1																	VANTINE AVE (TH-25)			
		G	VR-017	24	30		LEGAL LOAD LIMIT 24,000 POUNDS 11/13/14	5.00										16.00										10	
WB	4.212	H	R1-1	30	30								1		X														
		F	D3-1	UNK.	UNK.		VANTINE AVE						1					14.50											
		H	R1-1	30	30		STOP 11/13/14	6.25								1		X									VANTINE AVE (TH-25)	X		
WB	4.212	G	UNK.	UNK.	UNK.		DEAD END						1		X														
WB	4.212	F	D3-1	50	12		Vantine Ave 11/14/14	4.17								2		11.25 X 10.50									VANTINE AVE (TH-25); FIELD LOCATE FOR VISIBILITY FROM ROUTE 2		12	
WB	4.191	F	W11-2	30	30								1		X														
		F	W11-2	30	30	FYG	11/14/14	6.25								1			15.75 X									X		
		F	W16-4P	30	24	FYG	NEXT 500 FT	5.00																				X		
WB	4.140	G	VR-017	24	30		LEGAL LOAD LIMIT 24,000 POUNDS 11/14/14	5.00								1		13.00 X									PETERSON PL (TH-48); INSTALL AT EDGE OF GAS STATION PARKING LOT		10	
WB	4.144	H	R1-1	30	30																								
		H	R1-1	30	30		STOP 11/14/14	6.25								1		13.00 X									PETERSON PL (TH-48)	X		
WB	4.144	F	D3-1	42	12		Peterson Pl 11/14/14	3.50								1		10.75 X									PETERSON PL (TH-48); FIELD LOCATE FOR VISIBILITY FROM ROUTE 2		13	
							SHEET TOTALS	41.42	0.00	1	0	0	5	0	0	7		104.75 ~~105.0~~		0	0.0	0.0	0.0	0.0				
								SF	SF	EA	EA	EA	EA	EA	EA	EA		FT		EA	LB	LB	LB	LB				
							TOWN DIRECTIONAL TOTALS	870.8	0.0	23	3	2	157	0	0	80		1200.0		0		0.0						

SIGN SUMMARY SHEET

VERMONT AGENCY OF TRANSPORTATION

PROJECT NAME: **ALBURGH-COLCHESTER**
PROJECT NUMBER: **STPG SIGN(45)**
FILE NAME: **2 Alburgh US2 WB TSS.xls** PLOT DATE: **4/15/2014**
PROJECT MANAGER: **D. BRYANT** DRAWN BY: **J. BLANCHARD**
DESIGNED BY: **B. TOOTHAKER** CHECKED **K. KERN**
ALBURGH WB SHEET 14 SHEET **55** OF **167**

DIRECTION	MILEPOINT	LOCATION CODE (SHEET 2)	SIGN CODE	WIDTH (IN)	HEIGHT (IN)	SHEETING REMARKS	SIGN LEGEND	NEW SIGNS "A"	NEW SIGNS "B"	EXISTING SIGNS RETAIN	EXISTING SIGNS SALVAGE FROM	EXISTING SIGNS SALVAGE TO	EXISTING SIGNS REMOVE	EXIST POST RETAIN	EXIST POST REMOVE	NUMBER OF NEW POSTS	SQUARE STEEL (IN) 1.75 (LB/FT) 1.88	SQUARE STEEL (IN) 2.00 (LB/FT) 2.42	SQUARE STEEL (IN) 2.50 (LB/FT) 3.35	TUBULAR STEEL Ø (IN) FOUNDATION	TUBULAR STEEL Ø (IN) 3.00 (LB/FT) 7.60	TUBULAR STEEL Ø (IN) 3.50 (LB/FT) 9.00	TUBULAR STEEL Ø (IN) 4.00 (LB/FT) 10.80	TUBULAR STEEL Ø (IN) 5.00 (LB/FT) 14.60	SIGN FRAME REQUIRED	REMARKS	SIGN DETAIL LOCATION SHSM	SIGN DETAIL LOCATION PROJECT SHEET #	SIGN DETAIL LOCATION STANDARD SHEET #
ALBURGH US-2 WB							FY-FLUORESCENT YELLOW FYG-FLUORESCENT YELLOW GREEN																				"SHSM"-STANDARD HIGHWAY SIGNS AND MARKINGS			
WB	4.137	F	W11-8	30	30								1		X														
		F	W11-8	30	30		 11/14/14	6.25								1		13.75 X									X		
WB	4.092	F	R2-1	24	30		 11/14/14	5.00								1		13.00 X								INSTALL 237 FT WEST OF FIRE ENGINE SYMBOL	X		
WB	4.048	F	W16-9	24	10		AHEAD						1	X															
		F	S1-1	30	30								1																
		F	UNK.	UNK.	UNK.		VAST TRAIL ACCESS PARKING				1		1													SALVAGE SIGN AND RETURN TO TOWN			
		F	S1-1	36	36	FYG	 11/14/14	9.00																			X		
		F	S3-4	12	8	FYG		0.67																			X		
WB	4.043	F	D3-1	UNK.	UNK.		INDUSTRIAL PARK RD 11/14/14						1		X														
WB	4.041	G	R2-1	24	30		SPEED LIMIT 25				1	1	1	X													INDUSTRIAL PARK RD (TH-59); SALVAGE AND REMOUNT BELOW LLL			
		G	VR-017	24	30		 11/14/14	5.00																			INDUSTRIAL PARK RD (TH-59)		10	
WB	4.035	H	R1-1	30	30								1	X															
		H	R1-1	30	30		 11/14/14	6.25																			INDUSTRIAL PARK RD (TH-59)	X		
WB	4.035	F	D3-1	72	12		 11/14/14	6.00								2		11.00 X 10.75									INDUSTRIAL PARK RD (TH-59); FIELD LOCATE FOR VISIBILITY FROM ROUTE 2		13	
WB	4.020	H	R1-1	30	30		11/14/14						1	X															
SIGN SUMMARY SHEET							SHEET TOTALS	38.17	0.00	0	2	1	8	0	0	4		48.50 ~~60.0~~		0	0.0	0.0	0.0	0.0					
								SF	SF	EA	EA	EA	EA	EA	EA	EA		FT		EA	LB	LB	LB	LB					
VERMONT AGENCY OF TRANSPORTATION							TOWN DIRECTIONAL TOTALS	870.8	0.0	23	3	2	157	0	0	80		1200.0		0			0.0					

PROJECT NAME: ALBURGH-COLCHESTER
PROJECT NUMBER: STPG SIGN(45)
FILE NAME: 2 Alburgh US2 WB TSS.xls
PROJECT MANAGER: D. BRYANT
DESIGNED BY: B. TOOTHAKER
ALBURGH WB SHEET 15
PLOT DATE: 4/15/2014
DRAWN BY: J. BLANCHARD
CHECKED K. KERN
SHEET 56 OF 167

DIRECTION	MILEPOINT	LOCATION CODE (SHEET 2)	SIGN CODE	WIDTH (IN)	HEIGHT (IN)	SHEETING REMARKS	SIGN LEGEND	NEW SIGNS "A"	NEW SIGNS "B"	EXISTING SIGNS RETAIN	EXISTING SIGNS SALVAGE FROM	EXISTING SIGNS SALVAGE TO	EXISTING SIGNS REMOVE	EXIST POST RETAIN	EXIST POST REMOVE	NUMBER OF NEW POSTS	SQUARE STEEL (IN) 1.75 (LB/FT) 1.88	SQUARE STEEL (IN) 2.00 (LB/FT) 2.42	SQUARE STEEL (IN) 2.50 (LB/FT) 3.35	TUBULAR STEEL Ø (IN) FOUNDATION	TUBULAR STEEL Ø (IN) 3.00 (LB/FT) 7.60	TUBULAR STEEL Ø (IN) 3.50 (LB/FT) 9.00	TUBULAR STEEL Ø (IN) 4.00 (LB/FT) 10.80	TUBULAR STEEL Ø (IN) 5.00 (LB/FT) 14.60	SIGN FRAME REQUIRED	REMARKS	SIGN DETAIL LOCATION SHSM	SIGN DETAIL LOCATION PROJECT SHEET #	SIGN DETAIL LOCATION STANDARD SHEET #
ALBURGH US-2 WB							FY-FLUORESCENT YELLOW FYG-FLUORESCENT YELLOW GREEN																				"SHSM"-STANDARD HIGHWAY SIGNS AND MARKINGS			
		F	D3-1	UNK.	UNK.								1																
		F	D3-1	30	12		Milk St	2.50																			MILK ST (TH-57); MOUNT TO STOP SIGN WITH BRACKET		13	
		H	R1-1	30	30		STOP 11/14/14	6.25																			MILK ST (TH-57); INSTALL ON SOUTH SIDE OF INTERSECTION	X		
		G	VR-017	24	30		LEGAL LOAD LIMIT 24,000 POUNDS	5.00																			MILK ST (TH-57); MOUNT ON REVERSE OF STOP SIGN		10	
WB	3.966	F	R2-1	24	30		SPEED LIMIT 25						1	X															
		F	S4-4	24	10		WHEN FLASHING						1																
		F	S4-3	24	10		SCHOOL 11/14/14						1																
		F	S5-1	24	48		SCHOOL SPEED LIMIT 25 WHEN FLASHING	8.00																			RETAIN FLASHING BEACON	X		
WB	3.940	G	VR-660	24	36								1	X															
		G	VR-142	24	36								1																
		G	VR-660	24	30		NO PARKING ON SIDEWALK OR TRAVEL LANE 11/14/14	5.00																			REQUIRES VEGETATION CLEARING		10	
		G	VR-142A	24	36		R TEAR TO TALK DEC 1 - APR 1	6.00																					10	
WB	3.920	F	W16-7	24	12								1	X															
		F	S1-1	30	30		11/14/14						1																
		F	S1-1	36	36	FYG		9.00																				X		
SIGN SUMMARY SHEET							SHEET TOTALS	41.75	0.00	0	0	0	8	0	0	0	0.0			0	0.0	0.0	0.0	0.0					
								SF	SF	EA	EA	EA	EA	EA	EA	EA	FT			EA	LB	LB	LB	LB					
VERMONT AGENCY OF TRANSPORTATION							TOWN DIRECTIONAL TOTALS	870.8	0.0	23	3	2	157	0	0	80	1200.0			0	0.0								

PROJECT NAME: ALBURGH-COLCHESTER
PROJECT NUMBER: STPG SIGN(45)
FILE NAME: 2 Alburgh US2 WB TSS.xls
PROJECT MANAGER: D. BRYANT
DESIGNED BY: B. TOOTHAKER
ALBURGH WB SHEET 16
PLOT DATE: 4/15/2014
DRAWN BY: J. BLANCHARD
CHECKED K. KERN
SHEET 57 OF 167

DIRECTION	MILEPOINT	LOCATION CODE (SHEET 2)	SIGN CODE	WIDTH (IN)	HEIGHT (IN)	SHEETING REMARKS	SIGN LEGEND	NEW SIGNS "A"	NEW SIGNS "B"	EXISTING SIGNS RETAIN	EXISTING SIGNS SALVAGE FROM	EXISTING SIGNS SALVAGE TO	EXISTING SIGNS REMOVE	EXIST POST RETAIN	EXIST POST REMOVE	NUMBER OF NEW POSTS	SQUARE STEEL (IN) 1.75 (LB/FT) 1.88	SQUARE STEEL (IN) 2.00 (LB/FT) 2.42	SQUARE STEEL (IN) 2.50 (LB/FT) 3.35	TUBULAR STEEL Ø (IN) FOUNDATION	TUBULAR STEEL Ø (IN) 3.00 (LB/FT) 7.60	TUBULAR STEEL Ø (IN) 3.50 (LB/FT) 9.00	TUBULAR STEEL Ø (IN) 4.00 (LB/FT) 10.80	TUBULAR STEEL Ø (IN) 5.00 (LB/FT) 14.60	SIGN FRAME REQUIRED	REMARKS	SIGN DETAIL LOCATION SHSM	SIGN DETAIL LOCATION PROJECT SHEET #	SIGN DETAIL LOCATION STANDARD SHEET #
ALBURGH US-2 WB							FY-FLUORESCENT YELLOW FYG-FLUORESCENT YELLOW GREEN																				"SHSM"-STANDARD HIGHWAY SIGNS AND MARKINGS			
		F	W16-7P	24	12	FYG	II/14/14	2.00																			X		
WB	3.912	G	VR-017	24	30								1	X															
		G	R2-1	24	30		SPEED LIMIT 25			1																			
		G	VR-017	24	30		 II/14/14	5.00																		CHAMPLAIN ST (TH-21)		10	
WB	3.906	H	R1-1	30	30								1	X															
		F	D3-1	UNK.	UNK.		CHAMPLAIN ST						1																
		H	R1-1	30	30		 II/14/14	6.25																		CHAMPLAIN ST (TH-21)	X		
WB	3.906	F	D3-1	56	12		 II/14/14	4.67								2	10.75 X 10.75									CHAMPLAIN ST (TH-21); FIELD LOCATE FOR VISIBILITY FROM ROUTE 2		13	
WB	3.800	F	VR-142	24	36								1		X		14.75												
		F	VR-142A	24	36		 II/14/14	6.00								1	X											10	
WB	3.738	F	R2-1	24	30								1		X														
		F	S5-2	24	30								1																
		F	R2-1	24	30		 II/14/14	5.00								1			X								X		
		F	S5-2	24	30			5.00																			X		
WB	3.677	F	R2-1	24	30		II/14/14						1	X															
SIGN SUMMARY SHEET							SHEET TOTALS	33.92	0.00	1	0	0	7	0	0	4	36.25 ~~60.0~~			0	0.0	0.0	0.0	0.0					
								SF	SF	EA	EA	EA	EA	EA	EA	EA	FT			EA	LB	LB	LB	LB					
VERMONT AGENCY OF TRANSPORTATION							TOWN DIRECTIONAL TOTALS	870.8	0.0	23	3	2	157	0	0	80	1200.0			0	0.0								

PROJECT NAME: ALBURGH-COLCHESTER
PROJECT NUMBER: STPG SIGN(45)
FILE NAME: 2 Alburgh US2 WB TSS.xls
PROJECT MANAGER: D. BRYANT
DESIGNED BY: B. TOOTHAKER
ALBURGH WB SHEET 17
PLOT DATE: 4/15/2014
DRAWN BY: J. BLANCHARD
CHECKED K. KERN
SHEET 58 OF 167

DIRECTION	MILEPOINT	LOCATION CODE (SHEET 2)	SIGN CODE	WIDTH (IN)	HEIGHT (IN)	SHEETING REMARKS	SIGN LEGEND	NEW SIGNS "A"	NEW SIGNS "B"	EXISTING SIGNS RETAIN	EXISTING SIGNS SALVAGE FROM	EXISTING SIGNS SALVAGE TO	EXISTING SIGNS REMOVE	EXIST POST RETAIN	EXIST POST REMOVE	NUMBER OF NEW POSTS	SQUARE STEEL (IN) 1.75 (LB/FT) 1.88	SQUARE STEEL (IN) 2.00 (LB/FT) 2.42	SQUARE STEEL (IN) 2.50 (LB/FT) 3.35	TUBULAR STEEL Ø (IN) FOUNDATION	TUBULAR STEEL Ø (IN) 3.00 (LB/FT) 7.60	TUBULAR STEEL Ø (IN) 3.50 (LB/FT) 9.00	TUBULAR STEEL Ø (IN) 4.00 (LB/FT) 10.80	TUBULAR STEEL Ø (IN) 5.00 (LB/FT) 14.60	SIGN FRAME REQUIRED	REMARKS	SIGN DETAIL LOCATION SHSM	SIGN DETAIL LOCATION PROJECT SHEET #	SIGN DETAIL LOCATION STANDARD SHEET #
ALBURGH US-2 WB							FY-FLUORESCENT YELLOW FYG-FLUORESCENT YELLOW GREEN																				"SHSM"-STANDARD HIGHWAY SIGNS AND MARKINGS			
		F	R2-1	24	30		SPEED LIMIT 40 11/14/14	5.00																			X		
WB	3.653	F	VD-062BC	74.75	16		TRAVEL INFORMATION ^UP WELCOME CNTR. ON RIGHT 2/10			1				X															
		F	VD-062C	74.75	16		C BOARD			1																			
WB	3.512	F	M2-1	21	15		ROUTE MARKER ASSEMBLY						1		X														
		F	M1-5A	24	24								1																
		F	M2-1	21	15	BLK/WHT	JCT 11/14/14	2.19								1		15.00 X									X		
		F	M1-5	30	24	BLK/WHT	225	5.00																			X		
WB	3.444	F	W1-2L	30	30		LEFT CURVE 11/15/14						1		X														
WB	3.407	F	VR-644P	24	12		END PARKING						1	X															
		F	R8-3	24	24								1																
		F	R9-3dP	30	12	BLK/WHT	END 11/15/14	2.50																			X		
		F	R8-3	24	30		R	5.00																			X		
		F	R2-1	24	30		SPEED LIMIT 50	5.00								1			17.75 X								X		
WB	3.358	E	VD-102	24	24								1	X															
		F	VD-102	24	24								1																
SIGN SUMMARY SHEET							SHEET TOTALS	24.69	0.00	2	0	0	7	0	0	2		32.75 ~~36.0~~		0	0.0	0.0	0.0	0.0					
								SF	SF	EA	EA	EA	EA	EA	EA	EA		FT		EA	LB	LB	LB	LB					
VERMONT AGENCY OF TRANSPORTATION							TOWN DIRECTIONAL TOTALS	870.8	0.0	23	3	2	157	0	0	80		1200.0		0		0.0							

PROJECT NAME: ALBURGH-COLCHESTER
PROJECT NUMBER: STPG SIGN(45)
FILE NAME: 2 Alburgh US2 WB TSS.xls
PROJECT MANAGER: D. BRYANT
DESIGNED BY: B. TOOTHAKER
ALBURGH WB SHEET 18
PLOT DATE: 4/15/2014
DRAWN BY: J. BLANCHARD
CHECKED K. KERN
SHEET 59 OF 167

DIRECTION	MILEPOINT	LOCATION CODE (SHEET 2)	SIGN CODE	WIDTH (IN)	HEIGHT (IN)	SHEETING REMARKS	SIGN LEGEND	NEW SIGNS "A"	NEW SIGNS "B"	EXISTING SIGNS RETAIN	EXISTING SIGNS SALVAGE FROM	EXISTING SIGNS SALVAGE TO	EXISTING SIGNS REMOVE	EXIST POST RETAIN	EXIST POST REMOVE	NUMBER OF NEW POSTS	SQUARE STEEL (IN) 1.75 (LB/FT) 1.88	SQUARE STEEL (IN) 2.00 (LB/FT) 2.42	SQUARE STEEL (IN) 2.50 (LB/FT) 3.35	TUBULAR STEEL Ø (IN) FOUNDATION	TUBULAR STEEL Ø (IN) 3.00 (LB/FT) 7.60	TUBULAR STEEL Ø (IN) 3.50 (LB/FT) 9.00	TUBULAR STEEL Ø (IN) 4.00 (LB/FT) 10.80	TUBULAR STEEL Ø (IN) 5.00 (LB/FT) 14.60	SIGN FRAME REQUIRED	REMARKS	SIGN DETAIL LOCATION SHSM	SIGN DETAIL LOCATION PROJECT SHEET #	SIGN DETAIL LOCATION STANDARD SHEET #
ALBURGH US-2 WB							FY-FLUORESCENT YELLOW FYG-FLUORESCENT YELLOW GREEN																				"SHSM"-STANDARD HIGHWAY SIGNS AND MARKINGS			
		F	D9-22	24	24		Wi-Fi	4.00																				X		
		E	D9-22	24	24		Wi-Fi 11/15/14	4.00																				X		
WB	3.327	F	R2-1	24	30		SPEED LIMIT 50 11/15/14						1		X			14.00 14.25											
		F	W1-10L	36	36			9.00								2		X									INSTALL AT LOCATION OF EXISTING SPEED LIMIT SIGN	X		
WB	3.292	F	D3-1	UNK.	UNK.		11/15/14						1		X			13.25 14.25											
		F	D3-1	64	12		Missile Base Rd	5.33								2		X									MISSILE BASE RD (TH-56); FIELD LOCATE FOR VISIBILITY FROM ROUTE 2		13	
WB	3.292	G	VR-017	24	30								1	X															
		G	R2-1	24	30		SPEED LIMIT 35 SIDE ROAD	5.00		+																			
		G	VR-017	24	30		LEGAL LOAD LIMIT 24,000 POUNDS 11/15/14	5.00																			MISSILE BASE RD (TH-56)		10	
WB	3.285	H	R1-1	30	30								1	X															
		H	R1-1	30	30		STOP 11/15/14	6.25																			MISSILE BASE RD (TH-56)	X		
WB	3.232	F	D1-1	72	10		D-BOARD ASSEMBLY 11/18/14						1	X													SLIP BASES			
		F	D1-1	72	10								1					10.75 10.75											
		F	D1-1A	72	20								1																
		F	VD1-1	72	12			6.00								2												8	
							SHEET TOTALS	~~44.58~~ ~~39.58~~ SF	0.00 SF	1 EA	0 EA	0 EA	7 EA	0 EA	0 EA	4 EA		~~77.25~~ ~~60.0~~ FT		0 EA	0.0 LB	0.0 LB	0.0 LB	0.0 LB					
							TOWN DIRECTIONAL TOTALS	870.8	0.0	23	3	2	157	0	0	80		1200.0		0	0.0									


SIGN SUMMARY SHEET

VERMONT AGENCY OF TRANSPORTATION

PROJECT NAME: ALBURGH-COLCHESTER
PROJECT NUMBER: STPG SIGN(45)

FILE NAME: 2 Alburgh US2 WB TSS.xls
PROJECT MANAGER: D. BRYANT
DESIGNED BY: B. TOOTHAKER
ALBURGH WB SHEET 19

PLOT DATE: 4/15/2014
DRAWN BY: J. BLANCHARD
CHECKED K. KERN
SHEET 60 OF 167

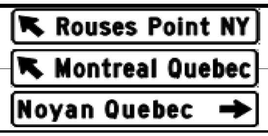DIRECTION	MILEPOINT	LOCATION CODE (SHEET 2)	SIGN CODE	WIDTH (IN)	HEIGHT (IN)	SHEETING REMARKS	SIGN LEGEND	NEW SIGNS "A"	NEW SIGNS "B"	EXISTING SIGNS RETAIN	EXISTING SIGNS SALVAGE FROM	EXISTING SIGNS SALVAGE TO	EXISTING SIGNS REMOVE	EXIST POST RETAIN	EXIST POST REMOVE	NUMBER OF NEW POSTS	SQUARE STEEL (IN) 1.75 (LB/FT) 1.88	SQUARE STEEL (IN) 2.00 (LB/FT) 2.42	SQUARE STEEL (IN) 2.50 (LB/FT) 3.35	TUBULAR STEEL Ø (IN) FOUNDATION	TUBULAR STEEL Ø (IN) 3.00 (LB/FT) 7.60	TUBULAR STEEL Ø (IN) 3.50 (LB/FT) 9.00	TUBULAR STEEL Ø (IN) 4.00 (LB/FT) 10.80	TUBULAR STEEL Ø (IN) 5.00 (LB/FT) 14.60	SIGN FRAME REQUIRED	REMARKS	SIGN DETAIL LOCATION SHSM	SIGN DETAIL LOCATION PROJECT SHEET #	SIGN DETAIL LOCATION STANDARD SHEET #
ALBURGH US-2 WB							FY-FLUORESCENT YELLOW FYG-FLUORESCENT YELLOW GREEN																			"SHSM"-STANDARD HIGHWAY SIGNS AND MARKINGS			
		F	VD1-1	72	12		 11/18/14	6.00																			8	
		F	VD1-1	72	12			6.00																			8	
WB	3.203	F	VR-921R	30	30		THRU/RIGHT "ONLY"						1		X			14.25										
		F	R3-7R	30	30		 11/15/14	6.25								1		X							X		
WB	3.178	F	M3-4	24	12		ROUTE MARKER ASSEMBLY						1	X														
		F	M1-4	24	24		01/15/15						1															
		F	M6-2	21	15								1															
		F	M3-1	24	12								1															
		F	M1-5A	24	24		01/15/15						1															
		F	M6-1	21	15								1															
		F	M3-4	24	12	BLK/WHT		2.00																		#2	SLIP BASES	X		
		F	M1-4	24	24	BLK/WHT		4.00																				X		
		F	M6-2L	21	15	BLK/WHT		2.19																			X		
		F	M3-1	24	12	BLK/WHT		2.00																			X		
		F	M1-5A	30	24	BLK/WHT		5.00																			X		
SIGN SUMMARY SHEET							SHEET TOTALS	33.44	0.00	0	0	0	7	0	0	1		14.25 15.0		0	0.0	0.0	0.0	0.0					
								SF	SF	EA	EA	EA	EA	EA	EA	EA		FT		EA	LB	LB	LB	LB					
VERMONT AGENCY OF TRANSPORTATION							TOWN DIRECTIONAL TOTALS	870.8	0.0	23	3	2	157	0	0	80		1200.0		0		0.0							

PROJECT NAME: ALBURGH-COLCHESTER
PROJECT NUMBER: STPG SIGN(45)
FILE NAME: 2 Alburgh US2 WB TSS.xls
PROJECT MANAGER: D. BRYANT
DESIGNED BY: B. TOOTHAKER
ALBURGH WB SHEET 20
PLOT DATE: 4/15/2014
DRAWN BY: J. BLANCHARD
CHECKED K. KERN
SHEET 61 OF 167

DIRECTION	MILEPOINT	LOCATION CODE (SHEET 2)	SIGN CODE	WIDTH (IN)	HEIGHT (IN)	SHEETING REMARKS	SIGN LEGEND	NEW SIGNS "A"	NEW SIGNS "B"	EXISTING SIGNS RETAIN	EXISTING SIGNS SALVAGE FROM	EXISTING SIGNS SALVAGE TO	EXISTING SIGNS REMOVE	EXIST POST RETAIN	EXIST POST REMOVE	NUMBER OF NEW POSTS	SQUARE STEEL (IN) 1.75 (LB/FT) 1.88	SQUARE STEEL (IN) 2.00 (LB/FT) 2.42	SQUARE STEEL (IN) 2.50 (LB/FT) 3.35	TUBULAR STEEL Ø (IN) FOUNDATION	TUBULAR STEEL Ø (IN) 3.00 (LB/FT) 7.60	TUBULAR STEEL Ø (IN) 3.50 (LB/FT) 9.00	TUBULAR STEEL Ø (IN) 4.00 (LB/FT) 10.80	TUBULAR STEEL Ø (IN) 5.00 (LB/FT) 14.60	SIGN FRAME REQUIRED	REMARKS	SIGN DETAIL LOCATION SHSM	SIGN DETAIL LOCATION PROJECT SHEET #	SIGN DETAIL LOCATION STANDARD SHEET #
ALBURGH US-2 WB							FY-FLUORESCENT YELLOW FYG-FLUORESCENT YELLOW GREEN																				"SHSM"-STANDARD HIGHWAY SIGNS AND MARKINGS			
		F	M6-1R	21	15	BLK/WHT		2.19																			X		
WB	3.155	H	VR-017	24	30		11/15/14																						
		F	VR-017	24	30		LEGAL LOAD LIMIT 24,000 POUNDS	5.00																			BORDER RD (STATE NUMBERED TOWN HIGHWAY)			
WB	3.164	F	D3-1	UNK.	UNK.								1	X												BORDER RD (STATE NUMBERED TOWN HIGHWAY)			
		H	R1-1	30	30																								
		G	R4-7	24	30																								
		F	D3-1	40	12		Border Rd 11/15/14	3.33																			MOUNT TO STOP SIGN WITH BRACKETS		13	
		H	R1-1	30	30		STOP	6.25																					
		G	R4-7	24	30			5.00																					
WB	3.172	H	R1-1	30	30		11/15/14								X			14.25								BORDER RD (STATE NUMBERED TOWN HIGHWAY)			
		H	R1-1	30	30		STOP	6.25								1		X											
WB	3.126	F	M3-4	24	12		ROUTE MARKER ASSEMBLY 11/15/14						1	X															
		F	M1-4	24	30								1																
		F	M3-4	24	12	BLK/WHT	WEST 2	2.00																			X		
		F	M1-4	24	24	BLK/WHT		4.00																			X		
SIGN SUMMARY SHEET							SHEET TOTALS	34.02	0.00	0	0	0	3	0	0	1		14.25 ~~15.0~~		0	0.0	0.0	0.0	0.0					
								SF	SF	EA	EA	EA	EA	EA	EA	EA		FT		EA	LB	LB	LB	LB					
VERMONT AGENCY OF TRANSPORTATION							TOWN DIRECTIONAL TOTALS	870.8	0.0	23	3	2	157	0	0	80		1200.0		0		0.0							

PROJECT NAME: ALBURGH-COLCHESTER
PROJECT NUMBER: STPG SIGN(45)
FILE NAME: 2 Alburgh US2 WB TSS.xls
PROJECT MANAGER: D. BRYANT
DESIGNED BY: B. TOOTHAKER
ALBURGH WB SHEET 21
PLOT DATE: 4/15/2014
DRAWN BY: J. BLANCHARD
CHECKED K. KERN
SHEET 62 OF 167

DIRECTION	MILEPOINT	LOCATION CODE (SHEET 2)	SIGN CODE	WIDTH (IN)	HEIGHT (IN)	SHEETING REMARKS	SIGN LEGEND	NEW SIGNS "A"	NEW SIGNS "B"	EXISTING SIGNS RETAIN	EXISTING SIGNS SALVAGE FROM	EXISTING SIGNS SALVAGE TO	EXISTING SIGNS REMOVE	EXIST POST RETAIN	EXIST POST REMOVE	NUMBER OF NEW POSTS	SQUARE STEEL (IN) 1.75 (LB/FT) 1.88	SQUARE STEEL (IN) 2.00 (LB/FT) 2.42	SQUARE STEEL (IN) 2.50 (LB/FT) 3.35	TUBULAR STEEL Ø (IN) FOUNDATION	TUBULAR STEEL Ø (IN) 3.00 (LB/FT) 7.60	TUBULAR STEEL Ø (IN) 3.50 (LB/FT) 9.00	TUBULAR STEEL Ø (IN) 4.00 (LB/FT) 10.80	TUBULAR STEEL Ø (IN) 5.00 (LB/FT) 14.60	SIGN FRAME REQUIRED	REMARKS	SIGN DETAIL LOCATION SHSM	SIGN DETAIL LOCATION PROJECT SHEET #	SIGN DETAIL LOCATION STANDARD SHEET #
ALBURGH US-2 WB							FY-FLUORESCENT YELLOW FYG-FLUORESCENT YELLOW GREEN																				"SHSM"-STANDARD HIGHWAY SIGNS AND MARKINGS			
WB	3.049 - 2.830	F/G	N/A	6	8		INSTALL (11) NEW DELINEATOR ASSEMBLIES 11/18/14																				INSTALL 11 BACK TO BACK DELINEATOR ASSEMBLIES AT 100 FT SPACINGS. SEE SHEET 4			
WB	2.862	F	VW-619	36	36								1	X				14.75				15.50							
		F	VW-619	36	36		 11/18/14	9.00										X										11	
WB	2.159	F	W13-1	18	18		45 MPH 11/18/14						1		X														
		F	W1-2MR	30	30		MODIFIED RIGHT CURVE						1																
WB	2.085	F	W1-10bR	36	36		 11/18/14	9.00								2		13.75 X 13.75									INSTALL 100 FT EAST OF BEGINNING OF CURVE (391 FT WEST OF EXISTING)	X		
WB	1.609	F	W13-1	18	18		45 MPH						1		X														
		F	W1-2L	30	30								1					14.50											
		F	W1-2L	30	30		 11/18/14	6.25								1		X										X		
WB	1.522	F	W1-8L	18	24		 11/18/14	3								1		X 13.50								X	INSTALL 58 FT EAST OF LEFT LARGE ARROW	X		
		E	W1-8R	18	24			3																		X		X	
WB	1.511	F	W1-6	48	24		<=== LEFT LARGE ARROW 11/18/14						1		X														
WB	1.492	F	W1-8L	18	24		 11/18/14	3								1		X 13.25								X	INSTALL 100 FT WEST OF LEFT LARGE ARROW	X		
		E	W1-8R	18	24			3																		X		X	
WB	1.462	F	W1-8L	18	24		 11/18/14	3								1		14.50 X								X	INSTALL 158 FT WEST OF PREVIOUS CHEVRON	X		
							SHEET TOTALS	39.25	0.00	0	0	0	6	0	0	6		98.00 ~~98.0~~		0	0.0	0.0	0.0	0.0					
								SF	SF	EA	EA	EA	EA	EA	EA	EA		FT		EA	LB	LB	LB	LB					
							TOWN DIRECTIONAL TOTALS	870.8	0.0	23	3	2	157	0	0	80		1200.0		0		0.0							

SIGN SUMMARY SHEET

VERMONT AGENCY OF TRANSPORTATION

PROJECT NAME: **ALBURGH-COLCHESTER**
PROJECT NUMBER: **STPG SIGN(45)**

FILE NAME: **2 Alburgh US2 WB TSS.xls** PLOT DATE: **4/15/2014**
PROJECT MANAGER: **D. BRYANT** DRAWN BY: **J. BLANCHARD**
DESIGNED BY: **B. TOOTHAKER** CHECKED **K. KERN**
ALBURGH WB SHEET 22 SHEET **63** OF **167**

DIRECTION	MILEPOINT	LOCATION CODE (SHEET 2)	SIGN CODE	WIDTH (IN)	HEIGHT (IN)	SHEETING REMARKS	SIGN LEGEND	NEW SIGNS "A"	NEW SIGNS "B"	EXISTING SIGNS RETAIN	EXISTING SIGNS SALVAGE FROM	EXISTING SIGNS SALVAGE TO	EXISTING SIGNS REMOVE	EXIST POST RETAIN	EXIST POST REMOVE	NUMBER OF NEW POSTS	SQUARE STEEL (IN) 1.75 (LB / FT) 1.88	SQUARE STEEL (IN) 2.00 (LB / FT) 2.42	SQUARE STEEL (IN) 2.50 (LB / FT) 3.35	TUBULAR STEEL Ø (IN) FOUNDATION	TUBULAR STEEL Ø (IN) 3.00 (LB / FT) 7.60	TUBULAR STEEL Ø (IN) 3.50 (LB / FT) 9.00	TUBULAR STEEL Ø (IN) 4.00 (LB / FT) 10.80	TUBULAR STEEL Ø (IN) 5.00 (LB / FT) 14.60	SIGN FRAME REQUIRED	REMARKS	SIGN DETAIL LOCATION SHSM	SIGN DETAIL LOCATION PROJECT SHEET #	SIGN DETAIL LOCATION STANDARD SHEET #
ALBURGH US-2 WB							FY-FLUORESCENT YELLOW FYG-FLUORESCENT YELLOW GREEN																			"SHSM"-STANDARD HIGHWAY SIGNS AND MARKINGS			
		E	W1-8R	18	24			3																	X		X		
WB	1.431	F	W1-8L	18	24		 11/18/14	3								1		X 16.50							X	INSTALL 164 FT WEST OF PREVIOUS CHEVRON	X		
		E	W1-8R	18	24			3																	X		X		
WB	1.402	F	W1-8L	18	24			3								1		X							X	INSTALL 153 FT WEST OF PREVIOUS CHEVRON	X		
		E	W1-8R	18	24			3										15.50							X		X		
WB	1.372	F	W1-8L	18	24		 11/18/14	3								1		X 15.50							X	INSTALL 158 FT WEST OF PREVIOUS CHEVRON	X		
		E	W1-8R	18	24			3																	X		X		
WB	1.346	F	W1-8L	18	24			3								1		X 15.25							X	INSTALL 138 FT WEST OF PREVIOUS CHEVRON	X		
		E	W1-8R	18	24			3																	X		X		
WB	1.343	F	D3-1	UNK.	UNK.		HUNTERS FARM RD 11/18/14						1		X															
WB	1.343	G	VR-017	24	30		11/18/14						1	X				14.25												
		G	VR-017	24	30			5.00																			HUNTERS FARM RD (TH-12)		10	
WB	1.339	H	R1-1	30	30		11/18/14							X																
		H	R1-1	30	30			6.25																			HUNTERS FARM RD (TH-12)	X		
WB	1.339	F	D3-1	70	12		 11/18/14	5.83								2		14.00 X 13.50								HUNTERS FARM RD (TH-12); FIELD LOCATE FOR VISIBILITY FROM ROUTE 2		13	
							SHEET TOTALS	44.08	0.00	0	0	0	2	0	0	6		104.50 ~~90.0~~		0	0.0	0.0	0.0	0.0				
								SF	SF	EA	EA	EA	EA	EA	EA	EA		FT		EA	LB	LB	LB	LB				
							TOWN DIRECTIONAL TOTALS	870.8	0.0	23	3	2	157	0	0	80		1200.0		0			0.0					

SIGN SUMMARY SHEET

VERMONT AGENCY OF TRANSPORTATION

PROJECT NAME: **ALBURGH-COLCHESTER**
PROJECT NUMBER: **STPG SIGN(45)**

FILE NAME: **2 Alburgh US2 WB TSS.xls** PLOT DATE: **4/15/2014**
PROJECT MANAGER: **D. BRYANT** DRAWN BY: **J. BLANCHARD**
DESIGNED BY: **B. TOOTHAKER** CHECKED **K. KERN**
ALBURGH WB SHEET 23 SHEET **64** OF **167**

DIRECTION	MILEPOINT	LOCATION CODE (SHEET 2)	SIGN CODE	WIDTH (IN)	HEIGHT (IN)	SHEETING REMARKS	SIGN LEGEND	NEW SIGNS "A"	NEW SIGNS "B"	EXISTING SIGNS RETAIN	EXISTING SIGNS SALVAGE FROM	EXISTING SIGNS SALVAGE TO	EXISTING SIGNS REMOVE	EXIST POST RETAIN	EXIST POST REMOVE	NUMBER OF NEW POSTS	SQUARE STEEL (IN) 1.75 (LB/FT) 1.88	SQUARE STEEL (IN) 2.00 (LB/FT) 2.42	SQUARE STEEL (IN) 2.50 (LB/FT) 3.35	TUBULAR STEEL Ø (IN) FOUNDATION	TUBULAR STEEL Ø (IN) 3.00 (LB/FT) 7.60	TUBULAR STEEL Ø (IN) 3.50 (LB/FT) 9.00	TUBULAR STEEL Ø (IN) 4.00 (LB/FT) 10.80	TUBULAR STEEL Ø (IN) 5.00 (LB/FT) 14.60	SIGN FRAME REQUIRED	REMARKS	SIGN DETAIL LOCATION SHSM	SIGN DETAIL LOCATION PROJECT SHEET #	SIGN DETAIL LOCATION STANDARD SHEET #
ALBURGH US-2 WB							FY-FLUORESCENT YELLOW FYG-FLUORESCENT YELLOW GREEN																				"SHSM"-STANDARD HIGHWAY SIGNS AND MARKINGS			
WB	1.344	E	W1-6	48	24								1	X															
		F	W1-6	48	24								1																
		F	W1-6L	48	24		 11/18/14	8.00																			X		
		E	W1-6R	48	24			8.00																			X		
WB	1.300	H	R1-1	30	30								1	X				15.50											
		H	R1-1	30	30		 11/18/14	6.25																			HUNTERS FARM RD (TH-12)	X		
		G	VR-017	30	24			5.00																			HUNTERS FART RD (TH-12); MOUNT ON REVERSE OF STOP SIGN		10	
WB	1.300	H	D3-1	70	12			5.83								2		11.00 X 11.75									HUNTERS FARM RD (TH-12); FIELD LOCATE FOR VISIBILITY FROM ROUTE 2		13	
WB	1.050	F	D3-1	UNK.	UNK.		BAY RD			1				X															
WB	1.066	G	VR-017	24	30		LLL 24,000 LBS NEW 11/18/14	5.00		1				X															
		H	R1-1	30	30		STOP NEW 11/18/14	6.25		1																			
WB	0.977	E	R2-1	24	30		SPEED LIMIT 50			1				X															
WB	0.945	F	R8-3A	24	24		NO PARKING			1				X															
		F	VR-644P	24	12		BEGIN			1																			
WB	0.829	F	UNK.	UNK.	UNK.		EMPTY POST 04/15/15								X														
							SHEET TOTALS	~~44.33~~ ~~33.00~~	0.00	6	0	0	3	0	0	2		~~38.25~~ ~~30.0~~			0	0.0	0.0	0.0	0.0					
								SF	SF	EA	EA	EA	EA	EA	EA	EA		FT			EA	LB	LB	LB	LB					
							TOWN DIRECTIONAL TOTALS	870.8	0.0	23	3	2	157	0	0	80		1200.0			0			0.0					

SIGN SUMMARY SHEET

VERMONT AGENCY OF TRANSPORTATION

PROJECT NAME: ALBURGH-COLCHESTER
PROJECT NUMBER: STPG SIGN(45)
FILE NAME: 2 Alburgh US2 WB TSS.xls
PROJECT MANAGER: D. BRYANT
DESIGNED BY: B. TOOTHAKER
ALBURGH WB SHEET 24
PLOT DATE: 4/15/2014
DRAWN BY: J. BLANCHARD
CHECKED K. KERN
SHEET 65 OF 167

DIRECTION	MILEPOINT	LOCATION CODE (SHEET 2)	SIGN CODE	WIDTH (IN)	HEIGHT (IN)	SHEETING REMARKS	SIGN LEGEND	NEW SIGNS "A"	NEW SIGNS "B"	EXISTING SIGNS RETAIN	EXISTING SIGNS SALVAGE FROM	EXISTING SIGNS SALVAGE TO	EXISTING SIGNS REMOVE	EXIST POST RETAIN	EXIST POST REMOVE	NUMBER OF NEW POSTS	SQUARE STEEL (IN) 1.75 (LB/FT) 1.88	SQUARE STEEL (IN) 2.00 (LB/FT) 2.42	SQUARE STEEL (IN) 2.50 (LB/FT) 3.35	TUBULAR STEEL Ø (IN) FOUNDATION	TUBULAR STEEL Ø (IN) 3.00 (LB/FT) 7.60	TUBULAR STEEL Ø (IN) 3.50 (LB/FT) 9.00	TUBULAR STEEL Ø (IN) 4.00 (LB/FT) 10.80	TUBULAR STEEL Ø (IN) 5.00 (LB/FT) 14.60	SIGN FRAME REQUIRED	REMARKS	SIGN DETAIL LOCATION SHSM	SIGN DETAIL LOCATION PROJECT SHEET #	SIGN DETAIL LOCATION STANDARD SHEET #
ALBURGH US-2 WB							FY-FLUORESCENT YELLOW FYG-FLUORESCENT YELLOW GREEN																				"SHSM"-STANDARD HIGHWAY SIGNS AND MARKINGS			
		F	R8-3	24	24		 04/15/15	4.00								1		13.25 X									X		
WB	0.573	F	VW-005	36	36		04/15/15						1	X															
		F	W8-13	36	36			9.00																			X		
WB	0.525	F	R8-3A	24	24		04/15/15						1	X															
		F	R8-3	24	24			4.00																			X		
WB	0.212	F	R4-1	24	30								1	X															
		F	R4-1	24	30		 04/23/15	5.00																			X		
WB	0.000	F	VD-450	24	24		04/23/15						1	X															
		F	VD-450	40	24			6.67																				6	
				6	10		MM	0.42																					
				6	10		MM	0.42																					
SIGN SUMMARY SHEET							SHEET TOTALS	~~29.51~~ ~~28.67~~ SF	0.00 SF	0 EA	0 EA	0 EA	4 EA	0 EA	0 EA	1 EA		~~13.25~~ ~~15.0~~ FT		0 EA	0.0 LB	0.0 LB	0.0 LB	0.0 LB					
VERMONT AGENCY OF TRANSPORTATION							TOWN DIRECTIONAL TOTALS	~~897.94~~ ~~870.0~~	0.0	23	3	2	157	0	0	80		~~1391.00~~ ~~1200.0~~		0	0.0							

PROJECT NAME: ALBURGH-COLCHESTER
PROJECT NUMBER: STPG SIGN(45)

FILE NAME: 2 Alburgh US2 WB TSS.xls
PROJECT MANAGER: D. BRYANT
DESIGNED BY: B. TOOTHAKER
ALBURGH WB SHEET 25

PLOT DATE: 4/15/2014
DRAWN BY: J. BLANCHARD
CHECKED K. KERN
SHEET 66 OF 167

DIRECTION	MILEPOINT	LOCATION CODE (SHEET 2)	SIGN CODE	WIDTH (IN)	HEIGHT (IN)	SHEETING REMARKS	SIGN LEGEND	NEW SIGNS "A"	NEW SIGNS "B"	EXISTING SIGNS RETAIN	EXISTING SIGNS SALVAGE FROM	EXISTING SIGNS SALVAGE TO	EXISTING SIGNS REMOVE	EXIST POST RETAIN	EXIST POST REMOVE	NUMBER OF NEW POSTS	SQUARE STEEL (IN) 1.75 (LB/FT) 1.88	SQUARE STEEL (IN) 2.00 (LB/FT) 2.42	SQUARE STEEL (IN) 2.50 (LB/FT) 3.35	TUBULAR STEEL Ø (IN) FOUNDATION	TUBULAR STEEL Ø (IN) 3.00 (LB/FT) 7.60	TUBULAR STEEL Ø (IN) 3.50 (LB/FT) 9.00	TUBULAR STEEL Ø (IN) 4.00 (LB/FT) 10.80	TUBULAR STEEL Ø (IN) 5.00 (LB/FT) 14.60	SIGN FRAME REQUIRED	REMARKS	SIGN DETAIL LOCATION SHSM	SIGN DETAIL LOCATION PROJECT SHEET #	SIGN DETAIL LOCATION STANDARD SHEET #
NORTH HERO US-2 EB							FY-FLUORESCENT YELLOW FYG-FLUORESCENT YELLOW GREEN																			"SHSM"-STANDARD HIGHWAY SIGNS AND MARKINGS			
EB	0.024	A	R2-1	24	30		11/26/14						1		X														
		A	R2-1	24	30		SPEED LIMIT 40	5.00								1		13.25 X									X		
EB	0.281	A	W11-2	30	30								1		X														
		A	W11-2	30	30	FYG	11/26/14	6.25								1			16.50 X									X		
		A	W16-4P	30	24	FYG	NEXT 1 MILE	5.00																				X		
EB	0.413	A	R2-1	24	30								1	X				14.00											
		A	R2-1	24	30		SPEED LIMIT 40 11/26/14	5.00																			X		
EB	0.554	A	R2-1	24	30		11/26/14						1		X			14.00											
		A	R2-1	24	30		SPEED LIMIT 40	5.00								1		X									X		
EB	0.760	A	R2-1	24	30		11/26/14						1		X			14.75											
		A	R2-1	24	30		SPEED LIMIT 40	5.00								1		X									X		
EB	1.015	A	R2-1	24	30		11/26/14						1		X			13.00											
		A	R2-1	24	30		SPEED LIMIT 50	5.00								1		X									X		
EB	1.818	A	W11-8	30	30		12/01/14						1		X			14.75											
		A	W11-8	30	30			6.25								1		X									X		
SIGN SUMMARY SHEET							SHEET TOTALS	42.50 SF	0.00 SF	0 EA	0 EA	0 EA	7 EA	0 EA	0 EA	6 EA		100.25 ~~90.5~~ FT		0 EA	0.0 LB	0.0 LB	0.0 LB	0.0 LB					
VERMONT AGENCY OF TRANSPORTATION							TOWN DIRECTIONAL TOTALS	320.7	0.0	8	1	0	57	0	0	30		450.0		0		0.0						

PROJECT NAME: ALBURGH-COLCHESTER
PROJECT NUMBER: STPG SIGN(45)
FILE NAME: 3 NORTH HERO US2 EB TSS.xls PLOT DATE: 3/14/2014
PROJECT MANAGER: D. BRYANT DRAWN BY: J. BLANCHARD
DESIGNED BY: B. TOOTHAKER CHECKED K. KERN
NORTH HERO EB SHEET 1 SHEET 67 OF 167

DIRECTION	MILEPOINT	LOCATION CODE (SHEET 2)	SIGN CODE	WIDTH (IN)	HEIGHT (IN)	SHEETING REMARKS	SIGN LEGEND	NEW SIGNS "A"	NEW SIGNS "B"	EXISTING SIGNS RETAIN	EXISTING SIGNS SALVAGE FROM	EXISTING SIGNS SALVAGE TO	EXISTING SIGNS REMOVE	EXIST POST RETAIN	EXIST POST REMOVE	NUMBER OF NEW POSTS	SQUARE STEEL (IN) 1.75 (LB/FT) 1.88	SQUARE STEEL (IN) 2.00 (LB/FT) 2.42	SQUARE STEEL (IN) 2.50 (LB/FT) 3.35	TUBULAR STEEL Ø (IN) FOUNDATION	TUBULAR STEEL Ø (IN) 3.00 (LB/FT) 7.60	TUBULAR STEEL Ø (IN) 3.50 (LB/FT) 9.00	TUBULAR STEEL Ø (IN) 4.00 (LB/FT) 10.80	TUBULAR STEEL Ø (IN) 5.00 (LB/FT) 14.60	SIGN FRAME REQUIRED	REMARKS	SIGN DETAIL LOCATION SHSM	SIGN DETAIL LOCATION PROJECT SHEET #	SIGN DETAIL LOCATION STANDARD SHEET #
NORTH HERO US-2 EB							FY-FLUORESCENT YELLOW FYG-FLUORESCENT YELLOW GREEN																			"SHSM"-STANDARD HIGHWAY SIGNS AND MARKINGS			
EB	1.872	A	W13-1	18	18		45 MPH 12/01/14						1		X														
		A	W1-2MR	30	30		MODIFIED RIGHT CURVE						1																
EB	1.932	A	VD-062BRN	72	16		BUSINESS SIGN			1				X															
EB	1.977	A	W1-10b	36	36		 12/01/14	9.00								2		14.75 X 15.50								INSTALL 100 FT WEST OF BEGINNING OF CURVE (238 FT EAST OF BUSINESS SIGN)	X		
EB	2.141	A	W1-2MR	30	30		MODIFIED RIGHT CURVE						1		X														
EB	2.235	A	W1-10cR	36	36		 12/01/14	9.00								2		14.75 X 15.25								INSTALL 140 FT WEST OF BEGINNING OF CURVE (500 FT EAST OF EXISTING)	X		
EB	2.274	A	W11-7	30	30		 12/01/14	6.25								1		16.00 X								INSTALL 1 MILE WEST OF CORRESPONDING WB SIGN (206 FT EAST OF MODIFIED RIGHT CURVE)	X		
		A	W7-3aP	24	18		NEXT 1 MILE	3.00																			X		
EB	2.404 - 2.511	A/B	N/A	6	8		INSTALL (8) NEW DELINEATOR ASSEMBLIES 12/01/14																			INSTALL 8 BACK TO BACK DELINEATOR ASSEMBLIES AT 80 FT SPACINGS. SEE SHEET 4.			
EB	2.553	A	W11-1	30	30		12/01/14						1	~~X~~															
		A	W11-1	30	30			6.25									1	16.00									X		
EB	2.779	A	W16-9	24	12		12/02/14						1	~~X~~				16.00											
		A	S1-1	36	36								1														RETAIN FLASHING BEACON			
		A	S1-1	36	36	FYG		9.00																			X		
		A	W16-9P	24	12	FYG	AHEAD	2.00																			X		
SIGN SUMMARY SHEET							SHEET TOTALS	44.50	0.00	1	0	0	6	0	0	5		~~108.25~~ 75.0		0	0.0	0.0	0.0	0.0					
								SF	SF	EA	EA	EA	EA	EA	EA	EA		FT		EA	LB	LB	LB	LB					
VERMONT AGENCY OF TRANSPORTATION							TOWN DIRECTIONAL TOTALS	320.7	0.0	8	1	0	57	0	0	30		450.0		0	0.0								

PROJECT NAME: **ALBURGH-COLCHESTER**
PROJECT NUMBER: **STPG SIGN(45)**
FILE NAME: **3 NORTH HERO US2 EB TSS.xls** PLOT DATE: **3/14/2014**
PROJECT MANAGER: **D. BRYANT** DRAWN BY: **J. BLANCHARD**
DESIGNED BY: **B. TOOTHAKER** CHECKED **K. KERN**
NORTH HERO EB SHEET 2 SHEET **68** OF **167**

DIRECTION	MILEPOINT	LOCATION CODE (SHEET 2)	SIGN CODE	WIDTH (IN)	HEIGHT (IN)	SHEETING REMARKS	SIGN LEGEND	NEW SIGNS "A"	NEW SIGNS "B"	EXISTING SIGNS RETAIN	EXISTING SIGNS SALVAGE FROM	EXISTING SIGNS SALVAGE TO	EXISTING SIGNS REMOVE	EXIST POST RETAIN	EXIST POST REMOVE	NUMBER OF NEW POSTS	SQUARE STEEL (IN) 1.75 (LB/FT) 1.88	SQUARE STEEL (IN) 2.00 (LB/FT) 2.42	SQUARE STEEL (IN) 2.50 (LB/FT) 3.35	TUBULAR STEEL Ø (IN) FOUNDATION	TUBULAR STEEL Ø (IN) 3.00 (LB/FT) 7.60	TUBULAR STEEL Ø (IN) 3.50 (LB/FT) 9.00	TUBULAR STEEL Ø (IN) 4.00 (LB/FT) 10.80	TUBULAR STEEL Ø (IN) 5.00 (LB/FT) 14.60	SIGN FRAME REQUIRED	REMARKS	SIGN DETAIL LOCATION SHSM	SIGN DETAIL LOCATION PROJECT SHEET #	SIGN DETAIL LOCATION STANDARD SHEET #
NORTH HERO US-2 EB							FY-FLUORESCENT YELLOW FYG-FLUORESCENT YELLOW GREEN																			"SHSM"-STANDARD HIGHWAY SIGNS AND MARKINGS			
EB	2.853	A	D1-1E	72	20		12/02/14						1	X				11.75											
		A	VD2-1	72	20		North Hero Elementary School → 12/02/14	10.00																				9	
EB	2.924	D	R1-1	30	30								1	X															
		D	R1-1	30	30		STOP 12/02/14	6.25																			LOCATED ON SCHOOL ENTRANCE	X		
EB	3.090	A	W2-2MR	30	30		RIGHT SIDE ROAD						1		X														
EB	3.221	A	W2-2	30	30		12/02/14	6.25								1		17.00 X									INSTALL 250 FT WEST OF INTERSECTION	X		
EB	3.228	A/B	D3-1	68	12		Blockhouse Point Rd 12/02/14	5.67								2		12.50 X 13.25									BLOCKHOUSE POINT RD (TH-7); FIELD LOCATE FOR VISIBILITY FROM ROUTE 2		13	
EB	3.229	C	VR-017	24	30								1	X				13.50											
		C	VR-017	24	30		LEGAL LOAD LIMIT 24,000 POUNDS 12/02/14	5.00																			BLOCKHOUSE POINT RD (TH-7)		10	
EB	3.239	D	R1-1	30	30								1	X				12.00											
		D	R1-1	30	30		STOP 12/02/14	6.25																			BLOCKHOUSE POINT RD (TH-7)	X		
EB	3.240	A/B	D3-1	UNK	12		BLOCKHOUSE POINT RD						1		X														
EB	3.793	A	R2-1	24	30								1	X															
		A	R2-1	24	30		SPEED LIMIT 50 12/02/14	5.00																				X		
EB	3.862	A	VW-205	36	36								1	X															
							SHEET TOTALS	44.42 SF	0.00 SF	0 EA	0 EA	0 EA	8 EA	0 EA	0 EA	3 EA		80.00 45.0 FT		0 EA	0.0 LB	0.0 LB	0.0 LB	0.0 LB					
							TOWN DIRECTIONAL TOTALS	320.7	0.0	8	1	0	57	0	0	30		450.0		0	0.0									

SIGN SUMMARY SHEET

VERMONT AGENCY OF TRANSPORTATION

PROJECT NAME: ALBURGH-COLCHESTER
PROJECT NUMBER: STPG SIGN(45)

FILE NAME: 3 NORTH HERO US2 EB TSS.xls PLOT DATE: 3/14/2014
PROJECT MANAGER: D. BRYANT DRAWN BY: J. BLANCHARD
DESIGNED BY: B. TOOTHAKER CHECKED K. KERN
NORTH HERO EB SHEET 3 SHEET 69 OF 167


DIRECTION	MILEPOINT	LOCATION CODE (SHEET 2)	SIGN CODE	WIDTH (IN)	HEIGHT (IN)	SHEETING REMARKS	SIGN LEGEND	NEW SIGNS "A"	NEW SIGNS "B"	EXISTING SIGNS RETAIN	EXISTING SIGNS SALVAGE FROM	EXISTING SIGNS SALVAGE TO	EXISTING SIGNS REMOVE	EXIST POST RETAIN	EXIST POST REMOVE	NUMBER OF NEW POSTS	SQUARE STEEL (IN) 1.75 (LB/FT) 1.88	SQUARE STEEL (IN) 2.00 (LB/FT) 2.42	SQUARE STEEL (IN) 2.50 (LB/FT) 3.35	TUBULAR STEEL Ø (IN) FOUNDATION	TUBULAR STEEL Ø (IN) 3.00 (LB/FT) 7.60	TUBULAR STEEL Ø (IN) 3.50 (LB/FT) 9.00	TUBULAR STEEL Ø (IN) 4.00 (LB/FT) 10.80	TUBULAR STEEL Ø (IN) 5.00 (LB/FT) 14.60	SIGN FRAME REQUIRED	REMARKS	SIGN DETAIL LOCATION SHSM	SIGN DETAIL LOCATION PROJECT SHEET #	SIGN DETAIL LOCATION STANDARD SHEET #
NORTH HERO US-2 EB							FY-FLUORESCENT YELLOW FYG-FLUORESCENT YELLOW GREEN																				"SHSM"-STANDARD HIGHWAY SIGNS AND MARKINGS			
		A	VW-205	36	36		 12/02/14	9.00																			REQUIRES VEGETATION CLEARING			E-154
EB	4.832	A	W3-5	48	48		12/03/14						1		X														
		A	W3-5	36	36			9.00								2		16.25 X 15.75										X		
EB	4.894	A	R2-1	36	48		SPEED LIMIT 45						1		X			15.75											
EB	4.920	A	R2-1	30	36		 12/03/14	7.50								1		X									INSTALL 137 FT EAST OF EXISTING	X		
EB	4.947	A	W13-1	18	18		40 MPH						1		X														
		A	W1-2R	30	30		RIGHT CURVE						1																
EB	5.022	A	W1-10	36	36		 12/03/14	9.00								2		14.75 X 16.00									INSTALL 100 FT WEST OF BEGINNING OF CURVE (396 FT EAST OF EXISTING)	X		
EB	5.154 - 5.268	A/B	N/A	6	8		INSTALL (6) NEW DELINEATOR ASSEMBLIES 12/03/14																				INSTALL 6 BACK TO BACK DELINEATOR ASSEMBLIES AT 120 FT SPACINGS. SEE SHEET 4.			
EB	5.178	A	VD-062AL	72	16		BUSINESS SIGN			1				X															
EB	5.237	A	VD-062C	74.75	16		C BOARD			1				X															
		A	VD-062BC	74.75	16		TRAVEL INFORMATION UP^ CHAMBER OFC. ON RT. 5/10			1				X																
EB	5.294	A	W3-5	48	48		SPEED REDUCTION SPEED LIMIT 35 12/03/14						1		X																
EB	5.326	A	W3-5	36	36		 12/03/14	9.00								2		15.75 X 16.25									INSTALL 169 FT EAST OF EXISTING	X		
EB	5.363	A	VD-018	30	18								1		X														
SIGN SUMMARY SHEET							SHEET TOTALS	43.50	0.00	3	0	0	6	0	0	7		~~110.00~~ ~~105.0~~		0	0.0	0.0	0.0	0.0					
								SF	SF	EA	EA	EA	EA	EA	EA	EA		FT		EA	LB	LB	LB	LB					
VERMONT AGENCY OF TRANSPORTATION							TOWN DIRECTIONAL TOTALS	320.7	0.0	8	1	0	57	0	0	30		450.0		0		0.0							

PROJECT NAME: **ALBURGH-COLCHESTER**
PROJECT NUMBER: **STPG SIGN(45)**

FILE NAME: **3 NORTH HERO US2 EB TSS.xls** PLOT DATE: **3/14/2014**
PROJECT MANAGER: **D. BRYANT** DRAWN BY: **J. BLANCHARD**
DESIGNED BY: **B. TOOTHAKER** CHECKED **K. KERN**
NORTH HERO EB SHEET 4 SHEET **70** OF **167**

DIRECTION	MILEPOINT	LOCATION CODE (SHEET 2)	SIGN CODE	WIDTH (IN)	HEIGHT (IN)	SHEETING REMARKS	SIGN LEGEND	NEW SIGNS "A"	NEW SIGNS "B"	EXISTING SIGNS RETAIN	EXISTING SIGNS SALVAGE FROM	EXISTING SIGNS SALVAGE TO	EXISTING SIGNS REMOVE	EXIST POST RETAIN	EXIST POST REMOVE	NUMBER OF NEW POSTS	SQUARE STEEL (IN) 1.75 (LB/FT) 1.88	SQUARE STEEL (IN) 2.00 (LB/FT) 2.42	SQUARE STEEL (IN) 2.50 (LB/FT) 3.35	TUBULAR STEEL Ø (IN) FOUNDATION	TUBULAR STEEL Ø (IN) 3.00 (LB/FT) 7.60	TUBULAR STEEL Ø (IN) 3.50 (LB/FT) 9.00	TUBULAR STEEL Ø (IN) 4.00 (LB/FT) 10.80	TUBULAR STEEL Ø (IN) 5.00 (LB/FT) 14.60	SIGN FRAME REQUIRED	REMARKS	SIGN DETAIL LOCATION SHSM	SIGN DETAIL LOCATION PROJECT SHEET #	SIGN DETAIL LOCATION STANDARD SHEET #
NORTH HERO US-2 EB							FY-FLUORESCENT YELLOW FYG-FLUORESCENT YELLOW GREEN																			"SHSM"-STANDARD HIGHWAY SIGNS AND MARKINGS			
		A	VD-018	30	18		North Hero / Grand Isle 6 12/03/14	3.75								1		13.75 X											
EB	5.421	A	R2-1	36	48								1	X															
		A	R2-1	30	36		SPEED LIMIT 35 12/03/14	7.50																				X		
EB	5.434	A	W16-9	24	10		AHEAD 12/03/14						1		X														
		A	W11-2	30	30		PEDESTRIAN SYMBOL						1																
EB	5.459	A	W11-2	30	30	FYG		6.25								1		15.25 X									INSTALL 132 FT EAST OF EXISTING	X		
		A	W16-9P	24	10	FYG	AHEAD 12/03/14	1.67																				X		
EB	5.603	A	R2-1	24	30								1	X															
		A	R2-1	24	30		SPEED LIMIT 35 12/03/14	5.00																				X		
EB	5.648	A	W16-7	24	12								1	X															
		A	W11-2	30	30								1																
		A	W11-2	30	30	FYG	12/03/14	6.25																				X		
		A	W16-7P	24	12	FYG		2.00																				X		
EB	5.726	A	W11-8	30	30								1	X															
		A	W11-8	30	30		12/03/14	6.25																				X		
SIGN SUMMARY SHEET							SHEET TOTALS	38.67	0.00	0	0	0	7	0	0	2		29.00 ~~30.0~~		0	0.0	0.0	0.0	0.0					
								SF	SF	EA	EA	EA	EA	EA	EA	EA		FT		EA	LB	LB	LB	LB					
VERMONT AGENCY OF TRANSPORTATION							TOWN DIRECTIONAL TOTALS	320.7	0.0	8	1	0	57	0	0	30		450.0		0		0.0							

PROJECT NAME: ALBURGH-COLCHESTER
PROJECT NUMBER: STPG SIGN(45)
FILE NAME: 3 NORTH HERO US2 EB TSS.xls PLOT DATE: 3/14/2014
PROJECT MANAGER: D. BRYANT DRAWN BY: J. BLANCHARD
DESIGNED BY: B. TOOTHAKER CHECKED K. KERN
NORTH HERO EB SHEET 5 SHEET 71 OF 167

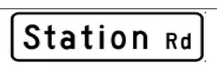DIRECTION	MILEPOINT	LOCATION CODE (SHEET 2)	SIGN CODE	WIDTH (IN)	HEIGHT (IN)	SHEETING REMARKS	SIGN LEGEND	NEW SIGNS "A"	NEW SIGNS "B"	EXISTING SIGNS RETAIN	EXISTING SIGNS SALVAGE FROM	EXISTING SIGNS SALVAGE TO	EXISTING SIGNS REMOVE	EXIST POST RETAIN	EXIST POST REMOVE	NUMBER OF NEW POSTS	SQUARE STEEL (IN) 1.75 (LB/FT) 1.88	SQUARE STEEL (IN) 2.00 (LB/FT) 2.42	SQUARE STEEL (IN) 2.50 (LB/FT) 3.35	TUBULAR STEEL Ø (IN) FOUNDATION	TUBULAR STEEL Ø (IN) 3.00 (LB/FT) 7.60	TUBULAR STEEL Ø (IN) 3.50 (LB/FT) 9.00	TUBULAR STEEL Ø (IN) 4.00 (LB/FT) 10.80	TUBULAR STEEL Ø (IN) 5.00 (LB/FT) 14.60	SIGN FRAME REQUIRED	REMARKS	SIGN DETAIL LOCATION SHSM	SIGN DETAIL LOCATION PROJECT SHEET #	SIGN DETAIL LOCATION STANDARD SHEET #
NORTH HERO US-2 EB							FY-FLUORESCENT YELLOW FYG-FLUORESCENT YELLOW GREEN																				"SHSM"-STANDARD HIGHWAY SIGNS AND MARKINGS			
EB	5.788	A	W16-7	24	12								1	X															
		A	W11-2	30	30								1																
		A	R1-6	12	36		YIELD TO PEDESTRIANS IN CROSSWALK 12/03/14				1		1														SALVAGE AND RETURN TO TOWN			
		A	W11-2	30	30	FYG		6.25																				X		
		A	W16-7P	24	12	FYG		2.00																				X		
EB	5.944	A	R2-1	24	30								1	X															
		A	R2-1	24	30		 12/03/14	5.00																				X		
EB	6.115	A	R2-1	24	30		12/04/14						1	X															
		A	R2-1	24	30			5.00																				X		
EB	6.183	A	VD-062AS	72	16		BUSINESS SIGN 12/04/14			1				X															
EB	6.221	C	VR-017	24	30		12/04/14						1	X															
		C	VR-017	24	30			5.00																				STATION RD (TH-2)		10	
EB	6.228	D	R1-1	30	30		12/04/14						1	X															
		A/B	D3-1	UNK	12								1																	
		A/B	D3-1	42	12			3.50																				STATION RD (TH-2); MOUNT ON STOP SIGN WITH BRACKET		13	
SIGN SUMMARY SHEET							SHEET TOTALS	26.75	0.00	1	1	0	8	0	0	0		0.0		0	0.0	0.0	0.0	0.0					
								SF	SF	EA	EA	EA	EA	EA	EA	EA		FT		EA	LB	LB	LB	LB					
VERMONT AGENCY OF TRANSPORTATION							TOWN DIRECTIONAL TOTALS	320.7	0.0	8	1	0	57	0	0	30		450.0		0		0.0							

PROJECT NAME: **ALBURGH-COLCHESTER**
PROJECT NUMBER: **STPG SIGN(45)**
FILE NAME: **3 NORTH HERO US2 EB TSS.xls** PLOT DATE: **3/14/2014**
PROJECT MANAGER: **D. BRYANT** DRAWN BY: **J. BLANCHARD**
DESIGNED BY: **B. TOOTHAKER** CHECKED **K. KERN**
NORTH HERO EB SHEET 6 SHEET **72** OF **167**

DIRECTION	MILEPOINT	LOCATION CODE (SHEET 2)	SIGN CODE	WIDTH (IN)	HEIGHT (IN)	SHEETING REMARKS	SIGN LEGEND	NEW SIGNS "A"	NEW SIGNS "B"	EXISTING SIGNS RETAIN	EXISTING SIGNS SALVAGE FROM	EXISTING SIGNS SALVAGE TO	EXISTING SIGNS REMOVE	EXIST POST RETAIN	EXIST POST REMOVE	NUMBER OF NEW POSTS	SQUARE STEEL (IN) 1.75 (LB/FT) 1.88	SQUARE STEEL (IN) 2.00 (LB/FT) 2.42	SQUARE STEEL (IN) 2.50 (LB/FT) 3.35	TUBULAR STEEL Ø (IN) FOUNDATION	TUBULAR STEEL Ø (IN) 3.00 (LB/FT) 7.60	TUBULAR STEEL Ø (IN) 3.50 (LB/FT) 9.00	TUBULAR STEEL Ø (IN) 4.00 (LB/FT) 10.80	TUBULAR STEEL Ø (IN) 5.00 (LB/FT) 14.60	SIGN FRAME REQUIRED	REMARKS	SIGN DETAIL LOCATION SHSM	SIGN DETAIL LOCATION PROJECT SHEET #	SIGN DETAIL LOCATION STANDARD SHEET #
NORTH HERO US-2 EB							FY-FLUORESCENT YELLOW FYG-FLUORESCENT YELLOW GREEN																				"SHSM"-STANDARD HIGHWAY SIGNS AND MARKINGS			
		D	R1-1	30	30			6.25																		STATION RD (TH-2)	X		
EB	6.269	A	R2-1	24	30								1	X															
		A	R2-1	24	30		 12/04/14	5.00								1		X										X		
EB	7.290	C	VR-017	24	30		12/05/14						1	X															
		C	VR-017	24	30			5.00																		SUNSET VIEW RD (TH-9)		10	
EB	7.296	D	R1-1	30	30		12/05/14						1	X															
		D	R1-1	30	30			6.25																		SUNSET VIEW RD (TH-9)	X		
EB	7.273	A/B	D3-1	UNK	12		12/05/14						1		X		11.75 12.50												
		A/B	D3-1	64	12			5.33								2		X								SUNSET VIEW RD (TH-9); FIELD LOCATE FOR VISIBILITY FROM ROUTE 2		13	
EB	7.531	C	VR-017	24	30								1	X															
		C	VR-017	24	30		 12/05/14	5.00																		WINDRIDGE LN (TH-12)		10	
EB	7.539	D	R1-1	30	30								1	X															
		A/B	D3-1	UNK	12		WINDRIDGE LN 12/05/14						1																	
		D	R1-1	30	30			6.25																		WINDRIDGE LN (TH-12)	X		
EB	7.544	A/B	D3-1	54	12		 12/05/14	4.50								2		11.50 X 11.75								WINDRIDGE LN (TH-12)		13	
							SHEET TOTALS	43.58	0.00	0	0	0	7	0	0	5		~~47.50~~ 75.0		0	0.0	0.0	0.0	0.0				
								SF	SF	EA	EA	EA	EA	EA	EA	EA		FT		EA	LB	LB	LB	LB				
							TOWN DIRECTIONAL TOTALS	320.7	0.0	8	1	0	57	0	0	30		450.0		0		0.0						

SIGN SUMMARY SHEET

VERMONT AGENCY OF TRANSPORTATION

PROJECT NAME: **ALBURGH-COLCHESTER**
PROJECT NUMBER: **STPG SIGN(45)**
FILE NAME: **3 NORTH HERO US2 EB TSS.xls** PLOT DATE: **3/14/2014**
PROJECT MANAGER: **D. BRYANT** DRAWN BY: **J. BLANCHARD**
DESIGNED BY: **B. TOOTHAKER** CHECKED **K. KERN**
NORTH HERO EB SHEET 7 SHEET **73** OF **167**

DIRECTION	MILEPOINT	LOCATION CODE (SHEET 2)	SIGN CODE	WIDTH (IN)	HEIGHT (IN)	SHEETING REMARKS	SIGN LEGEND	NEW SIGNS "A"	NEW SIGNS "B"	EXISTING SIGNS RETAIN	EXISTING SIGNS SALVAGE FROM	EXISTING SIGNS SALVAGE TO	EXISTING SIGNS REMOVE	EXIST POST RETAIN	EXIST POST REMOVE	NUMBER OF NEW POSTS	SQUARE STEEL (IN) 1.75 / 2.00 / 2.50 (LB / FT) 1.88 / 2.42 / 3.35	TUBULAR STEEL Ø (IN) FOUNDATION	TUBULAR STEEL Ø (IN) 3.00 / 3.50 / 4.00 / 5.00 (LB / FT) 7.60 / 9.00 / 10.80 / 14.60	SIGN FRAME REQUIRED	REMARKS	SIGN DETAIL LOCATION SHSM	SIGN DETAIL LOCATION PROJECT SHEET #	SIGN DETAIL LOCATION STANDARD SHEET #
NORTH HERO US-2 EB							FY-FLUORESCENT YELLOW FYG-FLUORESCENT YELLOW GREEN														"SHSM"-STANDARD HIGHWAY SIGNS AND MARKINGS			
EB	8.259	C	VR-017	24	30								1	X										
		C	VR-017	24	30		LEGAL LOAD LIMIT 24,000 POUNDS 12/05/14	5.00													SOUTH END RD (TH-2); REQUIRES VEGETATION CLEARING		10	
EB	8.266	D	R1-1	30	30								1	X										
		A	D3-1	UNK	UNK		SOUTH END RD						1											
		C	D3-1	UNK	UNK		U.S. ROUTE 2 12/05/14						1											
		D	R1-1	30	30		STOP	6.25													SOUTH END RD (TH-2)	X		
EB	8.266	A/B	D3-1	54	12		South End Rd 12/05/14	4.50								2	11.50 X 11.25				SOUTH END RD (TH-2); FIELD LOCATE FOR VISIBILITY FROM ROUTE 2		13	
EB	8.305	A	M3-2	24	12		ROUTE MARKER ASSEMBLY 12/05/14						1	X										
		A	M1-4	24	24								1											
		A	M3-2	24	12	BLK/WHT	EAST	2.00									15.75					X		
		A	M1-4	24	24	BLK/WHT	2	4.00									X					X		
EB	8.817	A	VW-205	30	30								1	X										
		A	VW-205	36	36		WATCH FOR TURNING VEHICLES 12/05/14	9.00																E-154
EB	9.130	A	W3-6	36	36		DRAWBRIDGE AHEAD 12/05/14			1				X										
EB	9.212	A	W3-3	36	36		SIGNAL AHEAD SYMBOL 12/05/14			1				X										
							SHEET TOTALS	30.75	0.00	2	0	0	7	0	0	2	~~38.50~~ ~~36.0~~	0	0.0	0.0	0.0	0.0			
								SF	SF	EA	EA	EA	EA	EA	EA	EA	FT	EA	LB	LB	LB	LB			
							TOWN DIRECTIONAL TOTALS	320.7	0.0	8	1	0	57	0	0	30	450.0	0	0.0						

SIGN SUMMARY SHEET

VERMONT AGENCY OF TRANSPORTATION

PROJECT NAME: ALBURGH-COLCHESTER
PROJECT NUMBER: STPG SIGN(45)

FILE NAME: 3 NORTH HERO US2 EB TSS.xls
PROJECT MANAGER: D. BRYANT
DESIGNED BY: B. TOOTHAKER
NORTH HERO EB SHEET 8

PLOT DATE: 3/14/2014
DRAWN BY: J. BLANCHARD
CHECKED K. KERN
SHEET 74 OF 167

DIRECTION	MILEPOINT	LOCATION CODE (SHEET 2)	SIGN CODE	WIDTH (IN)	HEIGHT (IN)	SHEETING REMARKS	SIGN LEGEND	NEW SIGNS "A"	NEW SIGNS "B"	EXISTING SIGNS RETAIN	EXISTING SIGNS SALVAGE FROM	EXISTING SIGNS SALVAGE TO	EXISTING SIGNS REMOVE	EXIST POST RETAIN	EXIST POST REMOVE	NUMBER OF NEW POSTS	SQUARE STEEL (IN) 1.75 (LB/FT) 1.88	SQUARE STEEL (IN) 2.00 (LB/FT) 2.42	SQUARE STEEL (IN) 2.50 (LB/FT) 3.35	TUBULAR STEEL Ø (IN) FOUNDATION	TUBULAR STEEL Ø (IN) 3.00 (LB/FT) 7.60	TUBULAR STEEL Ø (IN) 3.50 (LB/FT) 9.00	TUBULAR STEEL Ø (IN) 4.00 (LB/FT) 10.80	TUBULAR STEEL Ø (IN) 5.00 (LB/FT) 14.60	SIGN FRAME REQUIRED	REMARKS	SIGN DETAIL LOCATION SHSM	SIGN DETAIL LOCATION PROJECT SHEET #	SIGN DETAIL LOCATION STANDARD SHEET #
NORTH HERO US-2 EB							FY-FLUORESCENT YELLOW FYG-FLUORESCENT YELLOW GREEN																				"SHSM"-STANDARD HIGHWAY SIGNS AND MARKINGS			
EB	9.246	A	VW-666	30	30		BICYCLES USE CAUTION 12/05/14			1				X															
EB	9.306	A	R10-6	24	36								1	X															
		A	R10-6	24	36		 12/05/14	6.00																SALVAGE AND REMOUNT EXISTING FLAGS	X		
SIGN SUMMARY SHEET							SHEET TOTALS	6.00	0.00	1	0	0	1	0	0	0		0.0		0	0.0	0.0	0.0	0.0					
								SF	SF	EA	EA	EA	EA	EA	EA	EA		FT		EA	LB	LB	LB	LB					
VERMONT AGENCY OF TRANSPORTATION							TOWN DIRECTIONAL TOTALS	~~320.67~~ 320.7	0.0	8	1	0	57	0	0	30		~~513.75~~ 450.0		0	0.0								

PROJECT NAME: **ALBURGH-COLCHESTER**
PROJECT NUMBER: **STPG SIGN(45)**
FILE NAME: **3 NORTH HERO US2 EB TSS.xls** PLOT DATE: **3/14/2014**
PROJECT MANAGER: **D. BRYANT** DRAWN BY: **J. BLANCHARD**
DESIGNED BY: **B. TOOTHAKER** CHECKED **K. KERN**
NORTH HERO EB SHEET 9 SHEET **75** OF **167**

DIRECTION	MILEPOINT	LOCATION CODE (SHEET 2)	SIGN CODE	WIDTH (IN)	HEIGHT (IN)	SHEETING REMARKS	SIGN LEGEND	NEW SIGNS "A"	NEW SIGNS "B"	EXISTING SIGNS RETAIN	EXISTING SIGNS SALVAGE FROM	EXISTING SIGNS SALVAGE TO	EXISTING SIGNS REMOVE	EXIST POST RETAIN	EXIST POST REMOVE	NUMBER OF NEW POSTS	SQUARE STEEL (IN) 1.75 (LB/FT) 1.88	SQUARE STEEL (IN) 2.00 (LB/FT) 2.42	SQUARE STEEL (IN) 2.50 (LB/FT) 3.35	TUBULAR STEEL Ø (IN) FOUNDATION	TUBULAR STEEL Ø (IN) 3.00 (LB/FT) 7.60	TUBULAR STEEL Ø (IN) 3.50 (LB/FT) 9.00	TUBULAR STEEL Ø (IN) 4.00 (LB/FT) 10.80	TUBULAR STEEL Ø (IN) 5.00 (LB/FT) 14.60	SIGN FRAME REQUIRED	REMARKS	SIGN DETAIL LOCATION SHSM	SIGN DETAIL LOCATION PROJECT SHEET #	SIGN DETAIL LOCATION STANDARD SHEET #
NORTH HERO US-2 WB							FY-FLUORESCENT YELLOW FYG-FLUORESCENT YELLOW GREEN																				"SHSM"-STANDARD HIGHWAY SIGNS AND MARKINGS			
WB	9.212	E	W3-3	36	36		SIGNAL AHEAD			1				X															
WB	9.165	E	W3-6	36	36		DRAWBRIDGE AHEAD			1				X															
WB	9.060	G	VR-278	24	36		12/05/14						1	X															
		G	VR-278	24	36			6.00										16.00								10	
WB	9.025	F	VW-205	30	30		WATCH FOR TURNING VEHICLES 12/05/14						1		X														
WB	8.971	F	VW-205	36	36		 12/05/14	9.00								~~1~~ 2		16.25 X								INSTALL 250 FT EASTT OF SPEED LIMIT 50 SIGN			E-154
WB	8.924	F	R2-1	24	30								1	X															
		F	R2-1	24	30		 12/05/14	5.00										16.00									X		
WB	8.319	F	VD-062B	72	16		BUSINESS SIGN			1				X															
WB	8.159	F	M3-4	24	12		ROUTE MARKER ASSEMBLY						1	X					10.50										
		F	M1-4	24	24		12/05/14						1																
		F	M3-4	24	12	BLK/WHT		2.00										16.00									X		
		F	M1-4	24	24	BLK/WHT		4.00																			X		
WB	6.532	F	S3-1T	30	30		SCHOOL BUS STOP AHEAD 12/04/14						1		X														
WB	6.402	F	W3-5	48	48		12/04/14						1		X														
SIGN SUMMARY SHEET							SHEET TOTALS	26.00	0.00	3	0	0	7	0	0	2		~~74.75~~ ~~30.0~~		0	0.0	0.0	0.0	0.0					
								SF	SF	EA	EA	EA	EA	EA	EA	EA		FT		EA	LB	LB	LB	LB					
VERMONT AGENCY OF TRANSPORTATION							TOWN DIRECTIONAL TOTALS	363.5	0.0	10	1	0	67	0	0	37		555.0		0	0.0								

PROJECT NAME: ALBURGH-COLCHESTER
PROJECT NUMBER: STPG SIGN(45)
FILE NAME: 4 NORTH HERO US2 WB TSS.xl
PROJECT MANAGER: D. BRYANT
DESIGNED BY: B. TOOTHAKER
NORTH HERO WB SHEET 1
PLOT DATE: 3/14/2014
DRAWN BY: J. BLANCHARD
CHECKED K. KERN
SHEET 76 OF 167

DIRECTION	MILEPOINT	LOCATION CODE (SHEET 2)	SIGN CODE	WIDTH (IN)	HEIGHT (IN)	SHEETING REMARKS	SIGN LEGEND	NEW SIGNS "A"	NEW SIGNS "B"	EXISTING SIGNS RETAIN	EXISTING SIGNS SALVAGE FROM	EXISTING SIGNS SALVAGE TO	EXISTING SIGNS REMOVE	EXIST POST RETAIN	EXIST POST REMOVE	NUMBER OF NEW POSTS	SQUARE STEEL (IN) 1.75 (LB/FT) 1.88	SQUARE STEEL (IN) 2.00 (LB/FT) 2.42	SQUARE STEEL (IN) 2.50 (LB/FT) 3.35	TUBULAR STEEL Ø (IN) FOUNDATION	TUBULAR STEEL Ø (IN) 3.00 (LB/FT) 7.60	TUBULAR STEEL Ø (IN) 3.50 (LB/FT) 9.00	TUBULAR STEEL Ø (IN) 4.00 (LB/FT) 10.80	TUBULAR STEEL Ø (IN) 5.00 (LB/FT) 14.60	SIGN FRAME REQUIRED	REMARKS	SIGN DETAIL LOCATION SHSM	SIGN DETAIL LOCATION PROJECT SHEET #	SIGN DETAIL LOCATION STANDARD SHEET #
NORTH HERO US-2 WB							FY-FLUORESCENT YELLOW FYG-FLUORESCENT YELLOW GREEN																				"SHSM"-STANDARD HIGHWAY SIGNS AND MARKINGS			
		F	W3-5	36	36		 12/04/14	9.00								2		15.25 X 15.00									X		
WB	6.360	F	VD-062AS	72	16		BUSINESS SIGN			1				X															
		F	VD-062AS	72	16		BUSINESS SIGN			1																			
WB	6.322	F	VD-018	30	18								1	X															
		F	VD-018	30	18		 12/04/14	3.75																			6	
WB	6.272	F	R2-1	36	48								1		X			17.25											
		F	R2-1	30	36		 12/04/14	7.50								1		X									X		
WB	6.139	F	VD-062C	74.75	16		C BOARD			1				X															
		F	VD-062BC	74.75	16		TRAVEL INFORMATION ^UP AT C OF C ON LEFT 2/10			1																			
WB	6.070	F	R2-1	24	30		12/04/14						1		X														
		F	R2-1	24	30			5.00								1		16.00 X									X		
WB	5.943	F	R2-1	24	30								1		X														
		F	R2-1	24	30		 12/03/14	5.00								1		16.00 X									X		
WB	5.913	F	W16-2	24	18		700 FEET 12/03/14						1		X														
		F	W11-8	30	30								1																
SIGN SUMMARY SHEET							SHEET TOTALS	30.25	0.00	4	0	0	6	0	0	5		79.50 ~~75.0~~		0	0.0	0.0	0.0	0.0					
								SF	SF	EA	EA	EA	EA	EA	EA	EA		FT		EA	LB	LB	LB	LB					
VERMONT AGENCY OF TRANSPORTATION							TOWN DIRECTIONAL TOTALS	363.5	0.0	10	1	0	67	0	0	37		555.0		0		0.0							

PROJECT NAME: ALBURGH-COLCHESTER
PROJECT NUMBER: STPG SIGN(45)

FILE NAME: 4 NORTH HERO US2 WB TSS.xl
PROJECT MANAGER: D. BRYANT
DESIGNED BY: B. TOOTHAKER
NORTH HERO WB SHEET 2

PLOT DATE: 3/14/2014
DRAWN BY: J. BLANCHARD
CHECKED K. KERN
SHEET 77 OF 167

DIRECTION	MILEPOINT	LOCATION CODE (SHEET 2)	SIGN CODE	WIDTH (IN)	HEIGHT (IN)	SHEETING REMARKS	SIGN LEGEND	NEW SIGNS "A"	NEW SIGNS "B"	EXISTING SIGNS RETAIN	EXISTING SIGNS SALVAGE FROM	EXISTING SIGNS SALVAGE TO	EXISTING SIGNS REMOVE	EXIST POST RETAIN	EXIST POST REMOVE	NUMBER OF NEW POSTS	SQUARE STEEL (IN) 1.75 (LB/FT) 1.88	SQUARE STEEL (IN) 2.00 (LB/FT) 2.42	SQUARE STEEL (IN) 2.50 (LB/FT) 3.35	TUBULAR STEEL Ø (IN) FOUNDATION	TUBULAR STEEL Ø (IN) 3.00 (LB/FT) 7.60	TUBULAR STEEL Ø (IN) 3.50 (LB/FT) 9.00	TUBULAR STEEL Ø (IN) 4.00 (LB/FT) 10.80	TUBULAR STEEL Ø (IN) 5.00 (LB/FT) 14.60	SIGN FRAME REQUIRED	REMARKS	SIGN DETAIL LOCATION SHSM	SIGN DETAIL LOCATION PROJECT SHEET #	SIGN DETAIL LOCATION STANDARD SHEET #
NORTH HERO US-2 WB							FY-FLUORESCENT YELLOW FYG-FLUORESCENT YELLOW GREEN																			"SHSM"-STANDARD HIGHWAY SIGNS AND MARKINGS			
		F	W11-8	30	30		 12/03/14	6.25								1		X 17.50									X		
		F	W16-2P	24	18			3.00																			X		
WB	5.887	F	W11-2	30	30								1		X														
		F	W16-9	24	10		12/03/14						1																
		F	W11-2	30	30	FYG		6.25								1		X 17.25									X		
		F	W16-9P	24	12	FYG		2.00																			X		
WB	5.813	F	W11-2	30	30								1	X															
		F	R6-1	12	36		STATE LAW YIELD TO PEDESTRIANS IN CROSSWALK				1		1													SALVAGE AND RETURN SIGN TO TOWN			
		F	W16-7	24	12								1																
		F	W11-2	30	30	FYG	 12/03/14	6.25																			X		
		F	W16-7P	24	12	FYG		2.00																			X		
WB	5.772	F	R2-1	24	30								1		X														
		F	R2-1	24	30		 12/03/14	5.00								1		X 13.00									X		
WB	5.724	F	UNK.	UNK.	UNK.		NO PARKING BETWEEN SIGNS <== 12/03/14						1		X														
WB	5.701	F	UNK.	UNK.	UNK.		NO PARKING BETWEEN SIGNS <== 12/03/14						1		X														
SIGN SUMMARY SHEET							SHEET TOTALS	30.75	0.00	0	1	0	8	0	0	3		47.75 ~~45.0~~		0	0.0	0.0	0.0	0.0					
								SF	SF	EA	EA	EA	EA	EA	EA	EA		FT		EA	LB	LB	LB	LB					
VERMONT AGENCY OF TRANSPORTATION							TOWN DIRECTIONAL TOTALS	363.5	0.0	10	1	0	67	0	0	37		555.0		0		0.0							

PROJECT NAME: ALBURGH-COLCHESTER
PROJECT NUMBER: STPG SIGN(45)

FILE NAME: 4 NORTH HERO US2 WB TSS.x | PLOT DATE: 3/14/2014
PROJECT MANAGER: D. BRYANT | DRAWN BY: J. BLANCHARD
DESIGNED BY: B. TOOTHAKER | CHECKED K. KERN
NORTH HERO WB SHEET 3 | SHEET 78 OF 167

DIRECTION	MILEPOINT	LOCATION CODE (SHEET 2)	SIGN CODE	WIDTH (IN)	HEIGHT (IN)	SHEETING REMARKS	SIGN LEGEND	NEW SIGNS "A"	NEW SIGNS "B"	EXISTING SIGNS RETAIN	EXISTING SIGNS SALVAGE FROM	EXISTING SIGNS SALVAGE TO	EXISTING SIGNS REMOVE	EXIST POST RETAIN	EXIST POST REMOVE	NUMBER OF NEW POSTS	SQUARE STEEL (IN) 1.75 (LB/FT) 1.88	SQUARE STEEL (IN) 2.00 (LB/FT) 2.42	SQUARE STEEL (IN) 2.50 (LB/FT) 3.35	TUBULAR STEEL Ø (IN) FOUNDATION	TUBULAR STEEL Ø (IN) 3.00 (LB/FT) 7.60	TUBULAR STEEL Ø (IN) 3.50 (LB/FT) 9.00	TUBULAR STEEL Ø (IN) 4.00 (LB/FT) 10.80	TUBULAR STEEL Ø (IN) 5.00 (LB/FT) 14.60	SIGN FRAME REQUIRED	REMARKS	SIGN DETAIL LOCATION SHSM	SIGN DETAIL LOCATION PROJECT SHEET #	SIGN DETAIL LOCATION STANDARD SHEET #
NORTH HERO US-2 WB							FY-FLUORESCENT YELLOW FYG-FLUORESCENT YELLOW GREEN																			"SHSM"-STANDARD HIGHWAY SIGNS AND MARKINGS			
WB	5.680	F	W16-7	24	12								1	X															
		F	W11-2	30	30		12/04/14						1																
		F	W11-2	30	30	FYG		6.25																			X		
		F	W16-7P	24	12	FYG		2.00								1		15.75									X		
WB	5.622	F	R2-1	24	30		12/04/14						1		X			14.75											
		F	R2-1	24	30			5.00								1		X								X		
WB	5.425	F	R2-1	24	30								1	X															
		F	R2-1	24	30		 12/04/14	5.00																			X		
WB	5.168	F	W13-1	18	18		40 MPH						1	X															
		F	W1-2L	30	30		LEFT CURVE 12/04/14						1																
		F	W1-10L	36	36			9.00																			X		
WB	5.108	F	W1-6	48	24								1	X															
		F	W1-6	48	24		 12/04/14	8.00																			X		
WB	5.085	E	W1-6	48	24		12/04/14						1	X															
		E	W1-6	48	24			8.00																			X		
SIGN SUMMARY SHEET							SHEET TOTALS	43.25	0.00	0	0	0	8	0	0	1		30.50 15.0		0	0.0	0.0	0.0	0.0					
								SF	SF	EA	EA	EA	EA	EA	EA	EA		FT		EA	LB	LB	LB	LB					
VERMONT AGENCY OF TRANSPORTATION							TOWN DIRECTIONAL TOTALS	363.5	0.0	10	1	0	67	0	0	37		555.0		0		0.0							

PROJECT NAME: ALBURGH-COLCHESTER
PROJECT NUMBER: STPG SIGN(45)
FILE NAME: 4 NORTH HERO US2 WB TSS.x | PLOT DATE: 3/14/2014
PROJECT MANAGER: D. BRYANT | DRAWN BY: J. BLANCHARD
DESIGNED BY: B. TOOTHAKER | CHECKED K. KERN
NORTH HERO WB SHEET 4 | SHEET 79 OF 167

DIRECTION	MILEPOINT	LOCATION CODE (SHEET 2)	SIGN CODE	WIDTH (IN)	HEIGHT (IN)	SHEETING REMARKS	SIGN LEGEND	NEW SIGNS "A"	NEW SIGNS "B"	EXISTING SIGNS RETAIN	EXISTING SIGNS SALVAGE FROM	EXISTING SIGNS SALVAGE TO	EXISTING SIGNS REMOVE	EXIST POST RETAIN	EXIST POST REMOVE	NUMBER OF NEW POSTS	SQUARE STEEL (IN) 1.75 (LB/FT) 1.88	SQUARE STEEL (IN) 2.00 (LB/FT) 2.42	SQUARE STEEL (IN) 2.50 (LB/FT) 3.35	TUBULAR STEEL Ø (IN) FOUNDATION	TUBULAR STEEL Ø (IN) 3.00 (LB/FT) 7.60	TUBULAR STEEL Ø (IN) 3.50 (LB/FT) 9.00	TUBULAR STEEL Ø (IN) 4.00 (LB/FT) 10.80	TUBULAR STEEL Ø (IN) 5.00 (LB/FT) 14.60	SIGN FRAME REQUIRED	REMARKS	SIGN DETAIL LOCATION SHSM	SIGN DETAIL LOCATION PROJECT SHEET #	SIGN DETAIL LOCATION STANDARD SHEET #
NORTH HERO US-2 WB							FY-FLUORESCENT YELLOW FYG-FLUORESCENT YELLOW GREEN																				"SHSM"-STANDARD HIGHWAY SIGNS AND MARKINGS			
WB	5.073	F	W1-6	48	24		12/04/14						1	X															
		F	W1-6	48	24			8.00																			X		
WB	5.071 - 5.019	E/F	N/A	6	8		INSTALL (6) NEW DELINEATOR ASSEMBLIES 12/04/14																				INSTALL 6 BACK TO BACK DELINEATOR ASSEMBLIES AT 55 FT SPACINGS SEE SHEET 4.			
WB	5.068	E	W1-6	48	24								1	X															
		E	W1-6	48	24		 12/04/14	8.00																			X		
WB	4.935	G	VR-278	24	36								1		X			13.75								REQUIRES VEGETATION CLEARING			
		G	VR-278	24	36		 12/04/14	6.00								1		X										10	
WB	4.896	F	R2-1	24	30								1	X															
		F	R2-1	24	30		 12/04/14	5.00																			X		
WB	3.793	F	R2-1	24	30		12/02/14						1	X				13.75											
		F	R2-1	24	30			5.00																			X		
WB	3.389	F	W11-1	30	30		12/02/14						1		X			15.25											
		F	W11-1	30	30			6.25								1		X										X		
WB	3.325	F	W11-7	30	30		12/02/14						1		X														
		F	W7-3A	24	18								1																
							SHEET TOTALS	38.25	0.00	0	0	0	8	0	0	2		42.75 ~~30.0~~		0	0.0	0.0	0.0	0.0					
								SF	SF	EA	EA	EA	EA	EA	EA	EA		FT		EA	LB	LB	LB	LB					
							TOWN DIRECTIONAL TOTALS	363.5	0.0	10	1	0	67	0	0	37		555.0		0	0.0								

SIGN SUMMARY SHEET

VERMONT AGENCY OF TRANSPORTATION

PROJECT NAME: ALBURGH-COLCHESTER
PROJECT NUMBER: STPG SIGN(45)

FILE NAME: 4 NORTH HERO US2 WB TSS.x | PLOT DATE: 3/14/2014
PROJECT MANAGER: D. BRYANT | DRAWN BY: J. BLANCHARD
DESIGNED BY: B. TOOTHAKER | CHECKED K. KERN
NORTH HERO WB SHEET 5 | SHEET 80 OF 167

DIRECTION	MILEPOINT	LOCATION CODE (SHEET 2)	SIGN CODE	WIDTH (IN)	HEIGHT (IN)	SHEETING REMARKS	SIGN LEGEND	NEW SIGNS "A"	NEW SIGNS "B"	EXISTING SIGNS RETAIN	EXISTING SIGNS SALVAGE FROM	EXISTING SIGNS SALVAGE TO	EXISTING SIGNS REMOVE	EXIST POST RETAIN	EXIST POST REMOVE	NUMBER OF NEW POSTS	SQUARE STEEL (IN) 1.75 (LB/FT) 1.88	SQUARE STEEL (IN) 2.00 (LB/FT) 2.42	SQUARE STEEL (IN) 2.50 (LB/FT) 3.35	TUBULAR STEEL Ø (IN) FOUNDATION	TUBULAR STEEL Ø (IN) 3.00 (LB/FT) 7.60	TUBULAR STEEL Ø (IN) 3.50 (LB/FT) 9.00	TUBULAR STEEL Ø (IN) 4.00 (LB/FT) 10.80	TUBULAR STEEL Ø (IN) 5.00 (LB/FT) 14.60	SIGN FRAME REQUIRED	REMARKS	SIGN DETAIL LOCATION SHSM	SIGN DETAIL LOCATION PROJECT SHEET #	SIGN DETAIL LOCATION STANDARD SHEET #
NORTH HERO US-2 WB							FY-FLUORESCENT YELLOW FYG-FLUORESCENT YELLOW GREEN																				"SHSM"-STANDARD HIGHWAY SIGNS AND MARKINGS			
		F	W11-7	30	30		 12/02/14	6.25								1		X 15.50									X		
		F	W7-3aP	24	18			3.00																			X		
WB	3.034	F	W16-9	24	12								1	X																
		F	S1-1	36	36								1																	
		F	S1-1	36	36	FYG	 12/02/14	9.00																			RETAIN FLASHING BEACON	X		
		F	W16-9P	24	12	FYG		2.00																			STRAIGHTEN EXISTING POSTS	X		
WB	2.937	F	D1-1E	72	20								1	X																
		F	VD2-1	72	20		 12/02/14	10.00																					9	
WB	2.804 - 2.709	E/F	N/A	6	8		INSTALL (5) NEW DELINEATOR ASSEMBLIES																				INSTALL 5 BACK TO BACK DELINEATOR ASSEMBLIES AT 130 FT SPACINGS. SEE SHEET 4.			
WB	2.639 - 2.497	E/F	N/A	6	8		INSTALL (7) NEW DELINEATOR ASSEMBLIES																				INSTALL 7 BACK TO BACK DELINEATOR ASSEMBLIES AT 125 FT SPACINGS. SEE SHEET 4.			
WB	2.417	F	W1-2ML	30	30		12/01/14						1		X															
		F	W1-10bL	36	36			9.00								2		18.00 X 16.75									X		
WB	2.390	F	VD-062BRN	72	16		BUSINESS SIGN			1				X																
WB	2.327	G	VR-017	24	30								1	X																
		G	VR-017	24	30		 12/01/14	5.00																			LAKEVIEW DR (TH-1); REQUIRES VEGETATION CLEARING		10	
SIGN SUMMARY SHEET							SHEET TOTALS	44.25	0.00	1	0	0	5	0	0	3		~~50.25~~ 45.0		0	0.0	0.0	0.0	0.0					
								SF	SF	EA	EA	EA	EA	EA	EA	EA		FT		EA	LB	LB	LB	LB					
VERMONT AGENCY OF TRANSPORTATION							TOWN DIRECTIONAL TOTALS	363.5	0.0	10	1	0	67	0	0	37		555.0		0		0.0							

PROJECT NAME: **ALBURGH-COLCHESTER**
PROJECT NUMBER: **STPG SIGN(45)**

FILE NAME: **4 NORTH HERO US2 WB TSS.xl** PLOT DATE: **3/14/2014**
PROJECT MANAGER: **D. BRYANT** DRAWN BY: **J. BLANCHARD**
DESIGNED BY: **B. TOOTHAKER** CHECKED **K. KERN**
NORTH HERO WB SHEET 6 SHEET **81** OF **167**

DIRECTION	MILEPOINT	LOCATION CODE (SHEET 2)	SIGN CODE	WIDTH (IN)	HEIGHT (IN)	SHEETING REMARKS	SIGN LEGEND	NEW SIGNS "A"	NEW SIGNS "B"	EXISTING SIGNS RETAIN	EXISTING SIGNS SALVAGE FROM	EXISTING SIGNS SALVAGE TO	EXISTING SIGNS REMOVE	EXIST POST RETAIN	EXIST POST REMOVE	NUMBER OF NEW POSTS	SQUARE STEEL (IN) 1.75 / 2.00 / 2.50 (LB / FT) 1.88 / 2.42 / 3.35	TUBULAR STEEL Ø (IN) FOUNDATION	TUBULAR STEEL Ø (IN) 3.00 / 3.50 / 4.00 / 5.00 (LB / FT) 7.60 / 9.00 / 10.80 / 14.60	SIGN FRAME REQUIRED	REMARKS	SIGN DETAIL LOCATION SHSM	SIGN DETAIL LOCATION PROJECT SHEET #	SIGN DETAIL LOCATION STANDARD SHEET #
NORTH HERO US-2 WB							FY-FLUORESCENT YELLOW FYG-FLUORESCENT YELLOW GREEN														"SHSM"-STANDARD HIGHWAY SIGNS AND MARKINGS			
WB	2.345	H	R1-1	30	30								1	X										
		E/F	D3-1	UNK.	UNK.		LAKEVIEW DR						1											
		H	R1-1	30	30		STOP 12/01/14	6.25													LAKEVIEW DR (TH-1)	X		
WB	2.345	E/F	D3-1	50	12		Lakeview Dr 12/01/14	4.17								2	11.00 X				LAKEVIEW DR (TH-1); FIELD LOCATE FOR VISIBILITY FROM ROUTE 2		13	
WB	2.183 - 2.033	E/F	N/A	6	8		INSTALL (9) NEW DELINEATOR ASSEMBLIES														INSTALL 9 BACK TO BACK DELINEATOR ASSEMBLIES AT 100 FT SPACINGS. SEE SHEET 4.			
WB	2.034	G	VR-017	24	30								1	X			X							
		G	VR-017	24	30		LEGAL LOAD LIMIT 24,000 POUNDS 12/01/14	5.00								1	15.25				JERUSALEM PL (TH-6)		10	
WB	2.030	E	M3-2	24	12		ROUTE MARKER ASSEMBLY						1		X									
		E	M1-4	24	24		12/01/14						1											
		E	M6-2	21	15								1											
		E	M3-2	24	12	BLK/ WHT	EAST	2.00								1	12.00 X					X		
		E	M1-4	24	24	BLK/ WHT	2	4.00														X		
		E	M6-2	21	15	BLK/ WHT		2.19														X		
WB	2.018	H	R1-1	30	30								1	X										
		E/F	D3-1	UNK.	UNK.		JERUSALEM PL 12/01/14						1											
SIGN SUMMARY SHEET							SHEET TOTALS	23.61	0.00	0	0	0	8	0	0	3	~~38.25~~ 45.0	0	0.0	0.0	0.0	0.0			
								SF	SF	EA	EA	EA	EA	EA	EA	EA	FT	EA	LB	LB	LB	LB			
VERMONT AGENCY OF TRANSPORTATION							TOWN DIRECTIONAL TOTALS	363.5	0.0	10	1	0	67	0	0	37	555.0	0	0.0						

PROJECT NAME: ALBURGH-COLCHESTER
PROJECT NUMBER: STPG SIGN(45)


FILE NAME: 4 NORTH HERO US2 WB TSS.x
PROJECT MANAGER: D. BRYANT
DESIGNED BY: B. TOOTHAKER
NORTH HERO WB SHEET 7

PLOT DATE: 3/14/2014
DRAWN BY: J. BLANCHARD
CHECKED K. KERN
SHEET 82 OF 167

DIRECTION	MILEPOINT	LOCATION CODE (SHEET 2)	SIGN CODE	WIDTH (IN)	HEIGHT (IN)	SHEETING REMARKS	SIGN LEGEND	NEW SIGNS "A"	NEW SIGNS "B"	EXISTING SIGNS RETAIN	EXISTING SIGNS SALVAGE FROM	EXISTING SIGNS SALVAGE TO	EXISTING SIGNS REMOVE	EXIST POST RETAIN	EXIST POST REMOVE	NUMBER OF NEW POSTS	SQUARE STEEL (IN) 1.75 (LB / FT) 1.88	SQUARE STEEL (IN) 2.00 (LB / FT) 2.42	SQUARE STEEL (IN) 2.50 (LB / FT) 3.35	TUBULAR STEEL Ø (IN) FOUNDATION	TUBULAR STEEL Ø (IN) 3.00 (LB / FT) 7.60	TUBULAR STEEL Ø (IN) 3.50 (LB / FT) 9.00	TUBULAR STEEL Ø (IN) 4.00 (LB / FT) 10.80	TUBULAR STEEL Ø (IN) 5.00 (LB / FT) 14.60	SIGN FRAME REQUIRED	REMARKS	SIGN DETAIL LOCATION SHSM	SIGN DETAIL LOCATION PROJECT SHEET #	SIGN DETAIL LOCATION STANDARD SHEET #
NORTH HERO US-2 WB							FY-FLUORESCENT YELLOW FYG-FLUORESCENT YELLOW GREEN																			"SHSM"-STANDARD HIGHWAY SIGNS AND MARKINGS			
		H	R1-1	30	30		STOP 12/01/14	6.25																		JERUSALEM PL (TH-6)	X		
WB	2.058	E/F	D3-1	54	12		Jerusalem Pl	4.50								2		12.00 X 12.50								JERUSALEM PL (TH-6); FIELD LOCATE FOR VISIBILITY FROM ROUTE 2		13	
WB	1.964	F	W11-8	30	30								1		X														
		F	W11-8	30	30		12/01/14	6.25								1		15.50 X										X		
WB	1.159	F	W11-2	30	30	FYG	11/26/14	6.25								1			14.00 X								INSTALL 250 FT EAST OF SPEED REDUCTION WARNING	X		
		F	W16-4	30	24	FYG	NEXT 1 MILE	5.00																				X		
WB	1.112	F	W3-5	48	48		11/26/14						1		X			14.75 15.00												
		F	W3-5	36	36		SPEED LIMIT 40	9.00								2		X										X		
WB	1.060	F	W11-2	30	30		PEDESTRIAN SYMBOL 11/26/14						1		X																
WB	1.000	F	R2-1	36	48		11/26/14						1		X																
		F	R2-1	30	36		SPEED LIMIT 40	7.50								1		13.25 X										X		
WB	0.759	F	R2-1	24	30		11/26/14						1		X				14.25												
		F	R2-1	24	30		SPEED LIMIT 40	5.00								1		X										X		
WB	0.607	F	VD-062AS	72	16		BUSINESS SIGN 11/26/14			1				X																
		F	VD-062BRN	72	16		BUSINESS SIGN			1																				
SIGN SUMMARY SHEET							SHEET TOTALS	49.75	0.00	2	0	0	5	0	0	8		111.25 120.0		0	0.0	0.0	0.0	0.0						
								SF	SF	EA	EA	EA	EA	EA	EA	EA		FT		EA	LB	LB	LB	LB						
VERMONT AGENCY OF TRANSPORTATION							TOWN DIRECTIONAL TOTALS	363.5	0.0	10	1	0	67	0	0	37		555.0		0	0.0									

PROJECT NAME: ALBURGH-COLCHESTER
PROJECT NUMBER: STPG SIGN(45)

FILE NAME: 4 NORTH HERO US2 WB TSS.x | PLOT DATE: 3/14/2014
PROJECT MANAGER: D. BRYANT | DRAWN BY: J. BLANCHARD
DESIGNED BY: B. TOOTHAKER | CHECKED K. KERN
NORTH HERO WB SHEET 8 | SHEET 83 OF 167

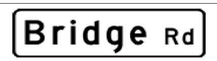DIRECTION	MILEPOINT	LOCATION CODE (SHEET 2)	SIGN CODE	WIDTH (IN)	HEIGHT (IN)	SHEETING REMARKS	SIGN LEGEND	NEW SIGNS "A"	NEW SIGNS "B"	EXISTING SIGNS RETAIN	EXISTING SIGNS SALVAGE FROM	EXISTING SIGNS SALVAGE TO	EXISTING SIGNS REMOVE	EXIST POST RETAIN	EXIST POST REMOVE	NUMBER OF NEW POSTS	SQUARE STEEL (IN) 1.75 (LB/FT) 1.88	SQUARE STEEL (IN) 2.00 (LB/FT) 2.42	SQUARE STEEL (IN) 2.50 (LB/FT) 3.35	TUBULAR STEEL Ø (IN) FOUNDATION	TUBULAR STEEL Ø (IN) 3.00 (LB/FT) 7.60	TUBULAR STEEL Ø (IN) 3.50 (LB/FT) 9.00	TUBULAR STEEL Ø (IN) 4.00 (LB/FT) 10.80	TUBULAR STEEL Ø (IN) 5.00 (LB/FT) 14.60	SIGN FRAME REQUIRED	REMARKS	SIGN DETAIL LOCATION SHSM	SIGN DETAIL LOCATION PROJECT SHEET #	SIGN DETAIL LOCATION STANDARD SHEET #
NORTH HERO US-2 WB							FY-FLUORESCENT YELLOW FYG-FLUORESCENT YELLOW GREEN																				"SHSM"-STANDARD HIGHWAY SIGNS AND MARKINGS			
WB	0.552	F	R2-1	24	30		11/26/14						1		X														
		F	R2-1	24	30			5.00								1		13.25 X								X		
WB	0.469	F	W1-10L	30	30		11/26/14						1		X			13.50 13.75											
		F	W1-10bL	36	36			9.00								2		X										X		
WB	0.336	F	W1-6	48	24		11/26/14						1		X			13.00 12.75											
		F	W1-6	48	24			8.00								2		X										X		
WB	0.320	H	VR-017	24	30								1	X				13.50											
		G	VR-017	24	30		 11/26/14	5.00								1		X									BRIDGE RD (TH-1)		10	
WB	0.310	H	R1-1	30	30		11/26/14						1	X															
		E/F	D3-1	UNK.	12								1																
		E/F	D3-1	40	12			3.33																		BRIDGE RD (TH-1); MOUNT ON STOP SIGN WITH BRACKET		13	
		H	R1-1	30	30			6.25																		BRIDGE RD (TH-1); REQUIRES VEGETATION CLEARING	X		
WB	0.302	F	M3-4	24	12		ROUTE MARKER ASSEMBLY 11/26/14						1	X															
		F	M1-4	24	24								1																
		F	M3-4	24	12	BLK/WHT		2.00																		REQUIRES VEGETATION CLEARING	X		
SIGN SUMMARY SHEET							SHEET TOTALS	38.58	0.00	0	0	0	8	0	0	5		79.75 75.0		0	0.0	0.0	0.0	0.0					
								SF	SF	EA	EA	EA	EA	EA	EA	EA		FT		EA	LB	LB	LB	LB					
VERMONT AGENCY OF TRANSPORTATION							TOWN DIRECTIONAL TOTALS	363.5	0.0	10	1	0	67	0	0	37		555.0		0	0.0								

PROJECT NAME: ALBURGH-COLCHESTER
PROJECT NUMBER: STPG SIGN(45)

FILE NAME: 4 NORTH HERO US2 WB TSS.xl | PLOT DATE: 3/14/2014
PROJECT MANAGER: D. BRYANT | DRAWN BY: J. BLANCHARD
DESIGNED BY: B. TOOTHAKER | CHECKED K. KERN
NORTH HERO WB SHEET 9 | SHEET 84 OF 167

DIRECTION	MILEPOINT	LOCATION CODE (SHEET 2)	SIGN CODE	WIDTH (IN)	HEIGHT (IN)	SHEETING REMARKS	SIGN LEGEND	NEW SIGNS "A"	NEW SIGNS "B"	EXISTING SIGNS RETAIN	EXISTING SIGNS SALVAGE FROM	EXISTING SIGNS SALVAGE TO	EXISTING SIGNS REMOVE	EXIST POST RETAIN	EXIST POST REMOVE	NUMBER OF NEW POSTS	SQUARE STEEL (IN) 1.75 (LB/FT) 1.88	SQUARE STEEL (IN) 2.00 (LB/FT) 2.42	SQUARE STEEL (IN) 2.50 (LB/FT) 3.35	TUBULAR STEEL Ø (IN) FOUNDATION	TUBULAR STEEL Ø (IN) 3.00 (LB/FT) 7.60	TUBULAR STEEL Ø (IN) 3.50 (LB/FT) 9.00	TUBULAR STEEL Ø (IN) 4.00 (LB/FT) 10.80	TUBULAR STEEL Ø (IN) 5.00 (LB/FT) 14.60	SIGN FRAME REQUIRED	REMARKS	SIGN DETAIL LOCATION SHSM	SIGN DETAIL LOCATION PROJECT SHEET #	SIGN DETAIL LOCATION STANDARD SHEET #
NORTH HERO US-2 WB							FY-FLUORESCENT YELLOW FYG-FLUORESCENT YELLOW GREEN																				"SHSM"-STANDARD HIGHWAY SIGNS AND MARKINGS			
		F	M1-4	24	24	BLK/WHT	11/26/14	4.00																			X		
WB	0.258	F	R2-1	24	30								1		X			14.75											
		F	R2-1	24	30		 11/26/14	5.00								1		X									X		
WB	0.046	F	W1-2	30	30								1		X			14.50											
		F	W1-2R	30	30		 11/26/14	6.25								1		X									X		
WB	0.034	F	VD-018	30	18		 11/26/14	3.75								1		X									INSTALL 63 FT WEST OF RIGHT CURVE WARNING		6	
WB	0.018	F	S3-1T	30	30								1		X			14.00 13.50											
		F	S3-1	36	36	FYG	 11/26/14	9.00								2		X									X		
WB	0.000	G	VD-024	72	10		11/26/14						1	X															
		G	VD-024	72	10			5.00																			7	
		F	R2-1	24	30			5.00																		X		
		G	VD-700	6	10		 	0.42																				E-138
		G	VD-700	6	10			0.42																					E-138
SIGN SUMMARY SHEET							SHEET TOTALS	38.83	0.00	0	0	0	4	0	0	5		68.75 ~~75.0~~		0	0.0	0.0	0.0	0.0					
								SF	SF	EA	EA	EA	EA	EA	EA	EA		FT		EA	LB	LB	LB	LB					
VERMONT AGENCY OF TRANSPORTATION							TOWN DIRECTIONAL TOTALS	363.52	0.0	10	1	0	67	0	0	37		623.50 ~~555.0~~		0	0.0								

PROJECT NAME: ALBURGH-COLCHESTER
PROJECT NUMBER: STPG SIGN(45)

FILE NAME: 4 NORTH HERO US2 WB TSS.xl
PROJECT MANAGER: D. BRYANT
DESIGNED BY: B. TOOTHAKER
NORTH HERO WB SHEET 10

PLOT DATE: 3/14/2014
DRAWN BY: J. BLANCHARD
CHECKED K. KERN
SHEET 85 OF 167

DIRECTION	MILEPOINT	LOCATION CODE (SHEET 2)	SIGN CODE	WIDTH (IN)	HEIGHT (IN)	SHEETING REMARKS	SIGN LEGEND	NEW SIGNS "A"	NEW SIGNS "B"	EXISTING SIGNS RETAIN	EXISTING SIGNS SALVAGE FROM	EXISTING SIGNS SALVAGE TO	EXISTING SIGNS REMOVE	EXIST POST RETAIN	EXIST POST REMOVE	NUMBER OF NEW POSTS	SQUARE STEEL (IN) 1.75 (LB/FT) 1.88	SQUARE STEEL (IN) 2.00 (LB/FT) 2.42	SQUARE STEEL (IN) 2.50 (LB/FT) 3.35	TUBULAR STEEL Ø (IN) FOUNDATION	TUBULAR STEEL Ø (IN) 3.00 (LB/FT) 7.60	TUBULAR STEEL Ø (IN) 3.50 (LB/FT) 9.00	TUBULAR STEEL Ø (IN) 4.00 (LB/FT) 10.80	TUBULAR STEEL Ø (IN) 5.00 (LB/FT) 14.60	SIGN FRAME REQUIRED	REMARKS	SIGN DETAIL LOCATION SHSM	SIGN DETAIL LOCATION PROJECT SHEET #	SIGN DETAIL LOCATION STANDARD SHEET #
GRAND ISLE US-2 EB							FY-FLUORESCENT YELLOW FYG-FLUORESCENT YELLOW GREEN																				"SHSM"-STANDARD HIGHWAY SIGNS AND MARKINGS			
EB	-0.016	C	VD-024	60	7.5								1	X															
		C	VD-024	72	10		Grand Isle | North Hero 11/21/14	5.00																				7	
		C	VD-700	6	10		0020 0702 0000 — 0020 0704 0934	0.42																					E-138
		C	VD-700	6	10			0.42																					E-138
EB	0.126	B	W3-3	30	30		SIGNAL AHEAD 11/21/14			1				X															
EB	0.185	B	VW-170A	48	48		DRAW BRIDGE AHEAD 11/21/14			1				X															
EB	0.262	A	W11-1	30	30		11/21/14						1		X														
		A	W11-1	30	30			6.25								1		15.00 X										X		
EB	0.375	A	R2-1	24	30		11/21/14						1	X															
		A	R2-1	24	30			5.00																			X		
EB	0.433	A	VW-205	30	30		11/21/14						1	X															
		A	VW-205	36	36			9.00																					E-154
EB	0.605	A	W7-3A	24	18		11/21/14						1	X															
		A	W11-5	30	30								1																	
		A	W11-5	30	30			6.25																			X		
SIGN SUMMARY SHEET							SHEET TOTALS	32.33	0.00	2	0	0	6	0	0	1		15.0		0	0.0	0.0	0.0	0.0					
								SF	SF	EA	EA	EA	EA	EA	EA	EA		FT		EA	LB	LB	LB	LB					
VERMONT AGENCY OF TRANSPORTATION																		15.00											
							TOWN DIRECTIONAL TOTALS	319.6	0.0	19	2	0	61	0	0	33		495.0		0	0.0								

PROJECT NAME: ALBURGH-COLCHESTER
PROJECT NUMBER: STPG SIGN(45)

FILE NAME: 5 GRAND ISLE US2 EB TSS.xls PLOT DATE: 3/14/2014
PROJECT MANAGER: D. BRYANT DRAWN BY: J. BLANCHARD
DESIGNED BY: B. TOOTHAKER CHECKED K. KERN
GRAND ISLE EB SHEET 1 SHEET 86 OF 167

DIRECTION	MILEPOINT	LOCATION CODE (SHEET 2)	SIGN CODE	WIDTH (IN)	HEIGHT (IN)	SHEETING REMARKS	SIGN LEGEND	NEW SIGNS "A"	NEW SIGNS "B"	EXISTING SIGNS RETAIN	EXISTING SIGNS SALVAGE FROM	EXISTING SIGNS SALVAGE TO	EXISTING SIGNS REMOVE	EXIST POST RETAIN	EXIST POST REMOVE	NUMBER OF NEW POSTS	SQUARE STEEL (IN) 1.75 (LB / FT) 1.88	SQUARE STEEL (IN) 2.00 (LB / FT) 2.42	SQUARE STEEL (IN) 2.50 (LB / FT) 3.35	TUBULAR STEEL Ø (IN) FOUNDATION	TUBULAR STEEL Ø (IN) 3.00 (LB / FT) 7.60	TUBULAR STEEL Ø (IN) 3.50 (LB / FT) 9.00	TUBULAR STEEL Ø (IN) 4.00 (LB / FT) 10.80	TUBULAR STEEL Ø (IN) 5.00 (LB / FT) 14.60	SIGN FRAME REQUIRED	REMARKS	SIGN DETAIL LOCATION SHSM	SIGN DETAIL LOCATION PROJECT SHEET #	SIGN DETAIL LOCATION STANDARD SHEET #
GRAND ISLE US-2 EB							FY-FLUORESCENT YELLOW FYG-FLUORESCENT YELLOW GREEN																			"SHSM"-STANDARD HIGHWAY SIGNS AND MARKINGS			
		A	W7-3aP	24	18			3.00																		X		
EB	1.613	A	VD-062B	72	16		BUSINESS SIGN			1				X														
		A	VD-062B	72	16		BUSINESS SIGN			1																		
		A	VD-062B	72	16		BUSINESS SIGN			1																		
EB	1.658	A	W2-1M	36	36		MODIFIED CROSSROAD			1				X														
		A	W16-8A	48	15		<--- FAYWOOD RD GRISWOLD RD --->			1																		
EB	1.728	A	VW-544	36	36		EMERGENCY VEHICLES			1				X														
		A	W13-1	24	24		40 MPH			1																		
EB	1.775	D	R1-1	30	30								1	X														
		C	VR-017	24	30		 11/21/14	5.00																	GRISWOLD RD (TH-1); MOUNT ON REVERSE OF STOP SIGN		10	
		D	R1-1	30	30			6.25																	GRISWOLD RD (TH-1)	X		
EB	1.782	D	R1-1	30	30								1	X														
		A/B	D3-1	UNK.	UNK.		GRISWOLD RD TH1 11/21/14						1															
		C/D	D3-1	UNK.	UNK.		U.S. ROUTE 2						1															
		D	R1-1	30	30			6.25																	GRISWOLD RD (TH-1)	X		
SIGN SUMMARY SHEET							SHEET TOTALS	20.50	0.00	7	0	0	4	0	0	0		0.0		0	0.0	0.0	0.0	0.0					
								SF	SF	EA	EA	EA	EA	EA	EA	EA		FT		EA	LB	LB	LB	LB					
VERMONT AGENCY OF TRANSPORTATION							TOWN DIRECTIONAL TOTALS	319.6	0.0	19	2	0	61	0	0	33		495.0		0		0.0							

PROJECT NAME: **ALBURGH-COLCHESTER**
PROJECT NUMBER: **STPG SIGN(45)**
FILE NAME: **5 GRAND ISLE US2 EB TSS.xls** PLOT DATE: **3/14/2014**
PROJECT MANAGER: **D. BRYANT** DRAWN BY: **J. BLANCHARD**
DESIGNED BY: **B. TOOTHAKER** CHECKED **K. KERN**
GRAND ISLE EB SHEET 2 SHEET **87** OF **167**

DIRECTION	MILEPOINT	LOCATION CODE (SHEET 2)	SIGN CODE	WIDTH (IN)	HEIGHT (IN)	SHEETING REMARKS	SIGN LEGEND	NEW SIGNS "A"	NEW SIGNS "B"	EXISTING SIGNS RETAIN	EXISTING SIGNS SALVAGE FROM	EXISTING SIGNS SALVAGE TO	EXISTING SIGNS REMOVE	EXIST POST RETAIN	EXIST POST REMOVE	NUMBER OF NEW POSTS	SQUARE STEEL (IN) 1.75 (LB/FT) 1.88	SQUARE STEEL (IN) 2.00 (LB/FT) 2.42	SQUARE STEEL (IN) 2.50 (LB/FT) 3.35	TUBULAR STEEL Ø (IN) FOUNDATION	TUBULAR STEEL Ø (IN) 3.00 (LB/FT) 7.60	TUBULAR STEEL Ø (IN) 3.50 (LB/FT) 9.00	TUBULAR STEEL Ø (IN) 4.00 (LB/FT) 10.80	TUBULAR STEEL Ø (IN) 5.00 (LB/FT) 14.60	SIGN FRAME REQUIRED	REMARKS	SIGN DETAIL LOCATION SHSM	SIGN DETAIL LOCATION PROJECT SHEET #	SIGN DETAIL LOCATION STANDARD SHEET #
GRAND ISLE US-2 EB							FY-FLUORESCENT YELLOW FYG-FLUORESCENT YELLOW GREEN																			"SHSM"-STANDARD HIGHWAY SIGNS AND MARKINGS			
EB	1.782	C/D	D3-1	42	12		US Route 2 II/21/14	3.50								2		12.25 X 12.00								GRISWOLD RD (TH-1); MOUNT TO STREET NAME SIGN WITH BRACKET		13	
		A/B	D3-1	58	12		Griswold Rd TH1	4.83																		GRISWOLD RD (TH-1); FIELD LOCATE FOR VISIBILITY FROM ROUTE 2		13	
EB	2.465	A	W3-5	48	48		II/21/14						1		X			15.25 15.50											
		A	W3-5	36	36			9.00								2		X									X		
EB	2.526	A	VD-018	30	18		 II/21/14	3.75								1		13.75 X								INSTALL 250 FT WEST OF SPEED LIMIT SIGN		6	
EB	2.573	A	R2-1	36	48								1		X			14.75											
		A	R2-1	30	36		 II/21/14	7.50								1		X									X		
EB	2.668	A	UNK.	UNK.	UNK.		HISTORIC SITE MARKER AHEAD II/21/14				1		1		X											SALVAGE AND RETURN TO TOWN			
		A	UNK.	UNK.	UNK.		400TH ANNIVERSARY				1		1													SALVAGE AND RETURN TO TOWN			
EB	2.745	A	W16-9	36	20		AHEAD						1	X															
		A	S1-1	36	36		II/21/14						1																
		A	S1-1	36	36	FYG		9.00																			X		
		A	S4-3	24	8	FYG		1.33																			X		
EB	2.959	A	S4-3	24	8		SCHOOL II/24/14						1	X															
		A	R2-1	24	30		SPEED LIMIT 35						1																
SIGN SUMMARY SHEET							SHEET TOTALS	38.91 SF	0.00 SF	0 EA	2 EA	0 EA	8 EA	0 EA	0 EA	6 EA		83.50 ~~96.0~~ FT		0 EA	0.0 LB	0.0 LB	0.0 LB	0.0 LB					
VERMONT AGENCY OF TRANSPORTATION							TOWN DIRECTIONAL TOTALS	319.6	0.0	19	2	0	61	0	0	33		495.0		0	0.0								

PROJECT NAME: ALBURGH-COLCHESTER
PROJECT NUMBER: STPG SIGN(45)

FILE NAME: 5 GRAND ISLE US2 EB TSS.xls PLOT DATE: 3/14/2014
PROJECT MANAGER: D. BRYANT DRAWN BY: J. BLANCHARD
DESIGNED BY: B. TOOTHAKER CHECKED K. KERN
GRAND ISLE EB SHEET 3 SHEET 88 OF 167

DIRECTION	MILEPOINT	LOCATION CODE (SHEET 2)	SIGN CODE	WIDTH (IN)	HEIGHT (IN)	SHEETING REMARKS	SIGN LEGEND	NEW SIGNS "A"	NEW SIGNS "B"	EXISTING SIGNS RETAIN	EXISTING SIGNS SALVAGE FROM	EXISTING SIGNS SALVAGE TO	EXISTING SIGNS REMOVE	EXIST POST RETAIN	EXIST POST REMOVE	NUMBER OF NEW POSTS	SQUARE STEEL (IN) 1.75 (LB / FT) 1.88	SQUARE STEEL (IN) 2.00 (LB / FT) 2.42	SQUARE STEEL (IN) 2.50 (LB / FT) 3.35	TUBULAR STEEL Ø (IN) FOUNDATION	TUBULAR STEEL Ø (IN) 3.00 (LB / FT) 7.60	TUBULAR STEEL Ø (IN) 3.50 (LB / FT) 9.00	TUBULAR STEEL Ø (IN) 4.00 (LB / FT) 10.80	TUBULAR STEEL Ø (IN) 5.00 (LB / FT) 14.60	SIGN FRAME REQUIRED	REMARKS	SIGN DETAIL LOCATION SHSM	SIGN DETAIL LOCATION PROJECT SHEET #	SIGN DETAIL LOCATION STANDARD SHEET #
GRAND ISLE US-2 EB							FY-FLUORESCENT YELLOW FYG-FLUORESCENT YELLOW GREEN																			"SHSM"-STANDARD HIGHWAY SIGNS AND MARKINGS			
		A	S4-4	24	10		WHEN FLASHING						1																
		A	S5-1	24	48			8.00																		RETAIN EXISTING FLASHING BEACONS	X		
EB	2.906	A	VD-018	30	18		GRAND ISLE KEELERS BAY 4			1				X															
EB	2.952	A	S5-2	24	30		11/24/14						1	X															
		A	S5-2	24	30			5.00								1		X								X	
EB	2.986	A	VD-026BC	74.75	16		BUSINESS SIGN			1				X															
EB	3.072	A	W16-8A	36	20								1		X														
		A	W2-1M	36	36								1					15.25 16.00											
		A	W2-1	30	30		 11/24/14	6.25								2		X									X		
		A	W16-8aP	48	15			5.00																			7	
EB	3.054	A	R2-1	30	36								1	X															
		A	R2-1	30	36		 11/24/14	7.50																			X		
EB	3.104	C	VR-017	24	30		11/24/14						1	X															
		C	VR-017	24	30			5.00								1		X	14.25								HYDE RD (TH-2)		10	
EB	3.110	D	R1-1	30	30		11/24/14						1	X															
SIGN SUMMARY SHEET							SHEET TOTALS	36.75	0.00	2	0	0	7	0	0	3		45.50 45.0		0	0.0	0.0	0.0	0.0					
								SF	SF	EA	EA	EA	EA	EA	EA	EA		FT		EA	LB	LB	LB	LB					
VERMONT AGENCY OF TRANSPORTATION							TOWN DIRECTIONAL TOTALS	319.6	0.0	19	2	0	61	0	0	33		495.0		0	0.0								

PROJECT NAME: ALBURGH-COLCHESTER
PROJECT NUMBER: STPG SIGN(45)
FILE NAME: 5 GRAND ISLE US2 EB TSS.xls PLOT DATE: 3/14/2014
PROJECT MANAGER: D. BRYANT DRAWN BY: J. BLANCHARD
DESIGNED BY: B. TOOTHAKER CHECKED K. KERN
GRAND ISLE EB SHEET 4 SHEET 89 OF 167

DIRECTION	MILEPOINT	LOCATION CODE (SHEET 2)	SIGN CODE	WIDTH (IN)	HEIGHT (IN)	SHEETING REMARKS	SIGN LEGEND	NEW SIGNS "A"	NEW SIGNS "B"	EXISTING SIGNS RETAIN	EXISTING SIGNS SALVAGE FROM	EXISTING SIGNS SALVAGE TO	EXISTING SIGNS REMOVE	EXIST POST RETAIN	EXIST POST REMOVE	NUMBER OF NEW POSTS	SQUARE STEEL (IN) 1.75 (LB/FT) 1.88	SQUARE STEEL (IN) 2.00 (LB/FT) 2.42	SQUARE STEEL (IN) 2.50 (LB/FT) 3.35	TUBULAR STEEL Ø (IN) FOUNDATION	TUBULAR STEEL Ø (IN) 3.00 (LB/FT) 7.60	TUBULAR STEEL Ø (IN) 3.50 (LB/FT) 9.00	TUBULAR STEEL Ø (IN) 4.00 (LB/FT) 10.80	TUBULAR STEEL Ø (IN) 5.00 (LB/FT) 14.60	SIGN FRAME REQUIRED	REMARKS	SIGN DETAIL LOCATION SHSM	SIGN DETAIL LOCATION PROJECT SHEET #	SIGN DETAIL LOCATION STANDARD SHEET #
GRAND ISLE US-2 EB							FY-FLUORESCENT YELLOW FYG-FLUORESCENT YELLOW GREEN																				"SHSM"-STANDARD HIGHWAY SIGNS AND MARKINGS			
		A	D3-1	UNK.	UNK.		HYDE RD TH2						1					13.25											
		A	R1-1	30	30		STOP 12/01/14	6.25										X									HYDE RD (TH-2); REQUIRES VEGETATION CLEARING	X		
EB	3.110	A	D3-1	42	12		US Route 2 11/24/14	3.50								1		11.75 X									HYDE RD (TH-2); MOUNT TO STREET NAME SIGN WITH BRACKET		13	
		D	D3-1	42	12		Hyde Rd TH2	3.50																			HYDE RD (TH-2); FIELD LOCATE FOR VISIBILITY FROM ROUTE 2		13	
EB	3.107	D	R1-1	30	30		11/24/14						1		X														
		D	R1-1	30	30		STOP	6.25								1		13.75 X									HYDE RD (TH-2)	X		
EB	3.138	A	M3-2	24	12		ROUTE MARKER ASSEMBLY						1	X															
		A	M1-4	24	24		11/24/14						1																
		A	M3-2	24	12	BLK/WHT	EAST	2.00																				X		
		A	M1-4	24	24	BLK/WHT	2	4.00																				X		
EB	3.233	B	W2-1	30	30								1	X															
		B	W13-1	18	18		35 MPH 11/24/14						1																
		B	W2-1	30	30			6.25																				X		
EB	3.443	A	R2-1	24	30								1	X															
		A	R2-1	24	30		SPEED LIMIT 40 11/24/14	5.00																				X		
SIGN SUMMARY SHEET							SHEET TOTALS	36.75	0.00	0	0	0	7	0	0	2		~~38.75~~ ~~30.0~~		0	0.0	0.0	0.0	0.0					
								SF	SF	EA	EA	EA	EA	EA	EA	EA		FT		EA	LB	LB	LB	LB					
VERMONT AGENCY OF TRANSPORTATION							TOWN DIRECTIONAL TOTALS	319.6	0.0	19	2	0	61	0	0	33		495.0		0		0.0							

PROJECT NAME: ALBURGH-COLCHESTER
PROJECT NUMBER: STPG SIGN(45)

FILE NAME: 5 GRAND ISLE US2 EB TSS.xls PLOT DATE: 3/14/2014
PROJECT MANAGER: D. BRYANT DRAWN BY: J. BLANCHARD
DESIGNED BY: B. TOOTHAKER CHECKED K. KERN
GRAND ISLE EB SHEET 5 SHEET 90 OF 167

DIRECTION	MILEPOINT	LOCATION CODE (SHEET 2)	SIGN CODE	WIDTH (IN)	HEIGHT (IN)	SHEETING REMARKS	SIGN LEGEND	NEW SIGNS "A"	NEW SIGNS "B"	EXISTING SIGNS RETAIN	EXISTING SIGNS SALVAGE FROM	EXISTING SIGNS SALVAGE TO	EXISTING SIGNS REMOVE	EXIST POST RETAIN	EXIST POST REMOVE	NUMBER OF NEW POSTS	SQUARE STEEL (IN) 1.75 (LB/FT) 1.88	SQUARE STEEL (IN) 2.00 (LB/FT) 2.42	SQUARE STEEL (IN) 2.50 (LB/FT) 3.35	TUBULAR STEEL Ø (IN) FOUNDATION	TUBULAR STEEL Ø (IN) 3.00 (LB/FT) 7.60	TUBULAR STEEL Ø (IN) 3.50 (LB/FT) 9.00	TUBULAR STEEL Ø (IN) 4.00 (LB/FT) 10.80	TUBULAR STEEL Ø (IN) 5.00 (LB/FT) 14.60	SIGN FRAME REQUIRED	REMARKS	SIGN DETAIL LOCATION SHSM	SIGN DETAIL LOCATION PROJECT SHEET #	SIGN DETAIL LOCATION STANDARD SHEET #
GRAND ISLE US-2 EB							FY-FLUORESCENT YELLOW FYG-FLUORESCENT YELLOW GREEN																				"SHSM"-STANDARD HIGHWAY SIGNS AND MARKINGS			
EB	3.631	A	W11-5	30	30								1		X														
		A	W7-3A	24	18		11/24/14						1																
		A	W11-5	30	30			6.25								1		17.75 X									X		
		A	W7-3aP	24	18			3.00																		X		
EB	3.875	A	R2-1	24	30								1		X														
		A	R2-1	24	30		 11/24/14	5.00								1		14.50 X									X		
EB	4.230	A	VD-062AL	72	16		BUSINESS SIGN			1				X															
EB	4.239	A	VD-062B	72	16		BUSINESS SIGN			1				X															
		A	VD-062AL	72	16		BUSINESS SIGN			1																			
		A	VD-062AL	72	16		BUSINESS SIGN			1																			
EB	4.331	A	VD-062AL	72	16		BUSINESS SIGN			1				X															
		A	VD-062AS	72	16		BUSINESS SIGN			1																			
EB	4.368	A	M1-5	30	24		11/24/14						1		X														
		A	M2-1	21	15								1																
		A	M2-1	21	15	GRN/ WHT		2.19								1		15.25 X									X		
SIGN SUMMARY SHEET							SHEET TOTALS	16.44	0.00	6	0	0	5	0	0	3		47.50 ~~45.0~~		0	0.0	0.0	0.0	0.0					
								SF	SF	EA	EA	EA	EA	EA	EA	EA		FT		EA	LB	LB	LB	LB					
VERMONT AGENCY OF TRANSPORTATION							TOWN DIRECTIONAL TOTALS	319.6	0.0	19	2	0	61	0	0	33		495.0		0	0.0								

PROJECT NAME: ALBURGH-COLCHESTER
PROJECT NUMBER: STPG SIGN(45)
FILE NAME: 5 GRAND ISLE US2 EB TSS.xls PLOT DATE: 3/14/2014
PROJECT MANAGER: D. BRYANT DRAWN BY: J. BLANCHARD
DESIGNED BY: B. TOOTHAKER CHECKED K. KERN
GRAND ISLE EB SHEET 6 SHEET 91 OF 167

DIRECTION	MILEPOINT	LOCATION CODE (SHEET 2)	SIGN CODE	WIDTH (IN)	HEIGHT (IN)	SHEETING REMARKS	SIGN LEGEND	NEW SIGNS "A"	NEW SIGNS "B"	EXISTING SIGNS RETAIN	EXISTING SIGNS SALVAGE FROM	EXISTING SIGNS SALVAGE TO	EXISTING SIGNS REMOVE	EXIST POST RETAIN	EXIST POST REMOVE	NUMBER OF NEW POSTS	SQUARE STEEL (IN) 1.75 (LB/FT) 1.88	SQUARE STEEL (IN) 2.00 (LB/FT) 2.42	SQUARE STEEL (IN) 2.50 (LB/FT) 3.35	TUBULAR STEEL Ø (IN) FOUNDATION	TUBULAR STEEL Ø (IN) 3.00 (LB/FT) 7.60	TUBULAR STEEL Ø (IN) 3.50 (LB/FT) 9.00	TUBULAR STEEL Ø (IN) 4.00 (LB/FT) 10.80	TUBULAR STEEL Ø (IN) 5.00 (LB/FT) 14.60	SIGN FRAME REQUIRED	REMARKS	SIGN DETAIL LOCATION SHSM	SIGN DETAIL LOCATION PROJECT SHEET #	SIGN DETAIL LOCATION STANDARD SHEET #
GRAND ISLE US-2 EB							FY-FLUORESCENT YELLOW FYG-FLUORESCENT YELLOW GREEN																				"SHSM"-STANDARD HIGHWAY SIGNS AND MARKINGS			
		A	M1-5	30	24	GRN/WHT		5.00																			X		
EB	4.406	A	D1-1M	72	10								1		X														
		A	D1-1A	72	10								1																
		A	D1-1A	72	10		11/24/14						1																
		A	D1-1A	72	10								1																
		A	VD1-1	72	12			6.00								2			12.25 X 11.50								SLIP BASES		8	
		A	VD1-1	72	12		South Hero 3	6.00																					8	
		A	VD1-1	72	12		Burlington 24	6.00																					8	
		A	VD1-1	72	12		Grand Isle Sta. 1	6.00																					8	
		A	VD1-1	72	12		NY via Ferry 5	6.00																					8	
EB	4.453	A	M3-2	24	12		ROUTE MARKER ASSEMBLY						1		X														
		A	M6-3	21	15								1																
		A	M1-4	24	24								1																
		A	M3-3	24	12								1																
		A	M1-5	30	24								1																
		A	M6-1	21	15								1																
							SHEET TOTALS	29.00	0.00	0	0	0	10	0	0	2		23.75 ~~38.0~~		0	0.0	0.0	0.0	0.0					
								SF	SF	EA	EA	EA	EA	EA	EA	EA		FT		EA	LB	LB	LB	LB					
							TOWN DIRECTIONAL TOTALS	319.6	0.0	19	2	0	61	0	0	33		495.0		0	0.0								

SIGN SUMMARY SHEET

VERMONT AGENCY OF TRANSPORTATION

PROJECT NAME: ALBURGH-COLCHESTER
PROJECT NUMBER: STPG SIGN(45)
FILE NAME: 5 GRAND ISLE US2 EB TSS.xls PLOT DATE: 3/14/2014
PROJECT MANAGER: D. BRYANT DRAWN BY: J. BLANCHARD
DESIGNED BY: B. TOOTHAKER CHECKED K. KERN
GRAND ISLE EB SHEET 7 SHEET 92 OF 167

DIRECTION	MILEPOINT	LOCATION CODE (SHEET 2)	SIGN CODE	WIDTH (IN)	HEIGHT (IN)	SHEETING REMARKS	SIGN LEGEND	NEW SIGNS "A"	NEW SIGNS "B"	EXISTING SIGNS RETAIN	EXISTING SIGNS SALVAGE FROM	EXISTING SIGNS SALVAGE TO	EXISTING SIGNS REMOVE	EXIST POST RETAIN	EXIST POST REMOVE	NUMBER OF NEW POSTS	SQUARE STEEL (IN) 1.75 (LB/FT) 1.88	SQUARE STEEL (IN) 2.00 (LB/FT) 2.42	SQUARE STEEL (IN) 2.50 (LB/FT) 3.35	FOUNDATION	TUBULAR STEEL Ø (IN) 3.00 (LB/FT) 7.60	TUBULAR STEEL Ø (IN) 3.50 (LB/FT) 9.00	TUBULAR STEEL Ø (IN) 4.00 (LB/FT) 10.80	TUBULAR STEEL Ø (IN) 5.00 (LB/FT) 14.60	SIGN FRAME REQUIRED	REMARKS	SIGN DETAIL LOCATION SHSM	SIGN DETAIL LOCATION PROJECT SHEET #	SIGN DETAIL LOCATION STANDARD SHEET #
GRAND ISLE US-2 EB							FY-FLUORESCENT YELLOW FYG-FLUORESCENT YELLOW GREEN																			"SHSM"-STANDARD HIGHWAY SIGNS AND MARKINGS			
		A	M3-3	24	12	BLK/WHT		2.00								2		12.00 X 12.25							#2	SLIP BASES	X		
		A	M1-5	24	24	BLK/WHT		4.00																			X		
		A	M6-1R	21	15	BLK/WHT		2.19																			X		
		A	M3-2	24	12	GRN/WHT	EAST SOUTH	2.00																			X		
		A	M1-4	30	24	GRN/WHT	2 VERMONT 314	5.00																			X		
		A	M6-3	21	15	GRN/WHT		2.19																			X		
EB	4.519	A/B	D3-1	UNK.	UNK.		II/24/14						1		X														
		C/D	D3-1	42	12		US Route 2	3.50								1		11.50 X								ALLEN RD (VT314); MOUNT TO STREET NAME SIGN WITH BRACKET		13	
		A/B	D3-1	34	12		Allen Rd	2.83																		ALLEN RD (VT314); FIELD LOCATE FOR VISIBILITY FROM ROUTE 2		14	
EB	4.531	A	M3-2	24	12								1		X														
		A	M1-4	24	24		II/24/14						1																
		A	M3-2	24	12	BLK/WHT	EAST	2.00								1		14.25 X									X		
		A	M1-4	24	24	BLK/WHT	2	4.00																			X		
EB	4.572	A	D1-1A	72	10		D-BOARD ASSEMBLY II/24/14						1		X														
		A	D1-1A	72	10								1																
SIGN SUMMARY SHEET							SHEET TOTALS	29.71	0.00	0	0	0	5	0	0	4		50.00 ~~60.0~~		0	0.0	0.0	0.0	0.0					
								SF	SF	EA	EA	EA	EA	EA	EA	EA		FT		EA	LB	LB	LB	LB					
VERMONT AGENCY OF TRANSPORTATION							TOWN DIRECTIONAL TOTALS	319.6	0.0	19	2	0	61	0	0	33		495.0		0		0.0							

PROJECT NAME: ALBURGH-COLCHESTER
PROJECT NUMBER: STPG SIGN(45)

FILE NAME: 5 GRAND ISLE US2 EB TSS.xls PLOT DATE: 3/14/2014
PROJECT MANAGER: D. BRYANT DRAWN BY: J. BLANCHARD
DESIGNED BY: B. TOOTHAKER CHECKED K. KERN
GRAND ISLE EB SHEET 8 SHEET 93 OF 167

DIRECTION	MILEPOINT	LOCATION CODE (SHEET 2)	SIGN CODE	WIDTH (IN)	HEIGHT (IN)	SHEETING REMARKS	SIGN LEGEND	NEW SIGNS "A"	NEW SIGNS "B"	EXISTING SIGNS RETAIN	EXISTING SIGNS SALVAGE FROM	EXISTING SIGNS SALVAGE TO	EXISTING SIGNS REMOVE	EXIST POST RETAIN	EXIST POST REMOVE	NUMBER OF NEW POSTS	SQUARE STEEL (IN) 1.75 (LB/FT) 1.88	SQUARE STEEL (IN) 2.00 (LB/FT) 2.42	SQUARE STEEL (IN) 2.50 (LB/FT) 3.35	TUBULAR STEEL Ø (IN) FOUNDATION	TUBULAR STEEL Ø (IN) 3.00 (LB/FT) 7.60	TUBULAR STEEL Ø (IN) 3.50 (LB/FT) 9.00	TUBULAR STEEL Ø (IN) 4.00 (LB/FT) 10.80	TUBULAR STEEL Ø (IN) 5.00 (LB/FT) 14.60	SIGN FRAME REQUIRED	REMARKS	SIGN DETAIL LOCATION SHSM	SIGN DETAIL LOCATION PROJECT SHEET #	SIGN DETAIL LOCATION STANDARD SHEET #
GRAND ISLE US-2 EB							FY-FLUORESCENT YELLOW FYG-FLUORESCENT YELLOW GREEN																				"SHSM"-STANDARD HIGHWAY SIGNS AND MARKINGS			
		A	VD1-1	72	12			6.00								2		14.25 X 14.00										
		A	VD1-1	72	12		 11/24/14	6.00																				
EB	4.598	A	W11-3	30	30		11/25/14						1		X														
		A	W11-3	30	30			6.25								1		15.00 X								REQUIRES VEGETATION CLEARING	X		
EB	4.624	A	R2-1	24	30		11/25/14						1		X														
		A	R2-1	24	30			5.00								1		14.50 X									X		
EB	5.338	A	VR-072	24	24		 11/25/14	4.00								1		14.50 X								INSTALL 115 FT WEST OF BUSINESS SIGN		10	
		B	VR-072	24	24		 11/25/14	4.00																				10	
EB	5.360	A	VD-062BRN	72	16		BUSINESS SIGN			1				X															
EB	5.429	A	W2-2L	30	30		11/25/14						1		X														
		A	W2-2	30	30			6.25								1		16.25 X									X		
EB	5.466	A	VW-060	30	30		11/25/14						1		X														
		A	VW-060	30	30			6.25								1		13.50 X											E-154
EB	5.537	C	W1-7	60	30								1		X														
		C	W1-7	48	24			8.00								2		13.75 X 13.75								INSTALL CENTERED ACROSS FROM INTERSECTION	X		
SIGN SUMMARY SHEET							SHEET TOTALS	51.75	0.00	1	0	0	5	0	0	9		~~129.50~~ 135.0		0	0.0	0.0	0.0	0.0					
								SF	SF	EA	EA	EA	EA	EA	EA	EA		FT		EA	LB	LB	LB	LB					
VERMONT AGENCY OF TRANSPORTATION							TOWN DIRECTIONAL TOTALS	319.6	0.0	19	2	0	61	0	0	33		495.0		0		0.0							

PROJECT NAME: **ALBURGH-COLCHESTER**
PROJECT NUMBER: **STPG SIGN(45)**

FILE NAME: **5 GRAND ISLE US2 EB TSS.xls** PLOT DATE: **3/14/2014**
PROJECT MANAGER: **D. BRYANT** DRAWN BY: **J. BLANCHARD**
DESIGNED BY: **B. TOOTHAKER** CHECKED **K. KERN**
GRAND ISLE EB SHEET 9 SHEET **94** OF **167**

DIRECTION	MILEPOINT	LOCATION CODE (SHEET 2)	SIGN CODE	WIDTH (IN)	HEIGHT (IN)	SHEETING REMARKS	SIGN LEGEND	NEW SIGNS "A"	NEW SIGNS "B"	EXISTING SIGNS RETAIN	EXISTING SIGNS SALVAGE FROM	EXISTING SIGNS SALVAGE TO	EXISTING SIGNS REMOVE	EXIST POST RETAIN	EXIST POST REMOVE	NUMBER OF NEW POSTS	SQUARE STEEL (IN) 1.75 (LB/FT) 1.88	SQUARE STEEL (IN) 2.00 (LB/FT) 2.42	SQUARE STEEL (IN) 2.50 (LB/FT) 3.35	TUBULAR STEEL Ø (IN) FOUNDATION	TUBULAR STEEL Ø (IN) 3.00 (LB/FT) 7.60	TUBULAR STEEL Ø (IN) 3.50 (LB/FT) 9.00	TUBULAR STEEL Ø (IN) 4.00 (LB/FT) 10.80	TUBULAR STEEL Ø (IN) 5.00 (LB/FT) 14.60	SIGN FRAME REQUIRED	REMARKS	SIGN DETAIL LOCATION SHSM	SIGN DETAIL LOCATION PROJECT SHEET #	SIGN DETAIL LOCATION STANDARD SHEET #
GRAND ISLE US-2 EB							FY-FLUORESCENT YELLOW FYG-FLUORESCENT YELLOW GREEN																				"SHSM"-STANDARD HIGHWAY SIGNS AND MARKINGS			
EB	5.666	C	VR-017	24	30		 11/25/14	5.00								1		13.25 X								PEARL ST (TH-17)		10	
EB	5.666	A/B	D3-1	UNK.	UNK.		PEARL ST TH17 11/25/14						1	X															
		C/D	D3-1	UNK.	UNK.		U.S. ROUTE 2						1																
		D	R1-1	30	30		STOP	6.25		1																	PEARL ST (TH-17)			
EB	5.666	A/B	D3-1	42	12		 11/25/14	3.50								1		12.00 X								PEARL ST (TH-17); MOUNT TO STREET NAME SIGN WITH BRACKET		13	
		C/D	D3-1	42	12			3.50																		PEARL ST (TH-17); FIELD LOCATE FOR VISIBILITY FROM ROUTE 2		14	
EB	5.785	A	W11-1	30	30								1	X															
		A	W11-1	30	30		 11/25/14	6.25																				X		
EB	6.161	A	W2-2L	30	30		LEFT SIDE ROAD						1		X														
EB	6.200	A	W2-2L	30	30		 11/25/14	6.25								1		17.00 X								INSTALL 200 FT EAST OF EXISTING	X		
		A	W16-8A	9	48			3.00																				7	
							SHEET TOTALS	~~33.75~~ ~~27.50~~ SF	0.00 SF	1 EA	0 EA	0 EA	4 EA	0 EA	0 EA	3 EA		~~42.25~~ ~~45.0~~ FT		0 EA	0.0 LB	0.0 LB	0.0 LB	0.0 LB				
							TOWN DIRECTIONAL TOTALS	~~325.89~~ ~~349.6~~	0.0	19	2	0	61	0	0	33		~~475.75~~ ~~495.0~~		0	0.0							

SIGN SUMMARY SHEET

VERMONT AGENCY OF TRANSPORTATION

PROJECT NAME: ALBURGH-COLCHESTER
PROJECT NUMBER: STPG SIGN(45)

FILE NAME: 5 GRAND ISLE US2 EB TSS.xls
PROJECT MANAGER: D. BRYANT
DESIGNED BY: B. TOOTHAKER
GRAND ISLE EB SHEET 10

PLOT DATE: 3/14/2014
DRAWN BY: J. BLANCHARD
CHECKED K. KERN
SHEET 95 OF 167

DIRECTION	MILEPOINT	LOCATION CODE (SHEET 2)	SIGN CODE	WIDTH (IN)	HEIGHT (IN)	SHEETING REMARKS	SIGN LEGEND	NEW SIGNS "A"	NEW SIGNS "B"	EXISTING SIGNS RETAIN	EXISTING SIGNS SALVAGE FROM	EXISTING SIGNS SALVAGE TO	EXISTING SIGNS REMOVE	EXIST POST RETAIN	EXIST POST REMOVE	NUMBER OF NEW POSTS	SQUARE STEEL (IN) 1.75 (LB/FT) 1.88	SQUARE STEEL (IN) 2.00 (LB/FT) 2.42	SQUARE STEEL (IN) 2.50 (LB/FT) 3.35	TUBULAR STEEL Ø (IN) FOUNDATION	TUBULAR STEEL Ø (IN) 3.00 (LB/FT) 7.60	TUBULAR STEEL Ø (IN) 3.50 (LB/FT) 9.00	TUBULAR STEEL Ø (IN) 4.00 (LB/FT) 10.80	TUBULAR STEEL Ø (IN) 5.00 (LB/FT) 14.60	SIGN FRAME REQUIRED	REMARKS	SIGN DETAIL LOCATION SHSM	SIGN DETAIL LOCATION PROJECT SHEET #	SIGN DETAIL LOCATION STANDARD SHEET #
GRAND ISLE US-2 WB							FY-FLUORESCENT YELLOW FYG-FLUORESCENT YELLOW GREEN																				"SHSM"-STANDARD HIGHWAY SIGNS AND MARKINGS			
WB	6.248	G	VR-017	24	30								1	X															
		G	VR-017	24	30		 11/25/14	5.00																		TOWN LINE RD (TH-3/SOUTH HERO)		10	
WB	6.248	H	R1-1	30	30								1	X															
		H	R1-1	30	30		 12/02/14	6.25																		TOWN LINE RD (TH-3/SOUTH HERO)	X		
WB	6.237	H	R1-1	30	30								1	X															
		H	R1-1	30	30		 12/02/14	6.25																		TOWN LINE RD (TH-3/SOUTH HERO)	X		
WB	6.236	E/F	D3-1	UNK.	UNK.		11/25/14						1		X														
		E/F	D3-1	42	12			3.50										11.50 11.75								TOWN LINE RD (TH-3/SOUTH HERO); MOUNT TO STREET NAME SIGN WITH BRACKET		13	
		E/F	D3-1	54	12			4.50								2		X								TOWN LINE RD (TH-3/SOUTH HERO); FIELD LOCATE FOR VISIBILITY FROM ROUTE 2		14	
WB	5.780	F	VD-062BRN	72	16		BUSINESS SIGN			1				X															
WB	5.641	F	W2-2R	30	30		11/25/14						1		X														
		F	W2-2R	30	30			6.25								1		15.00 X										X		
WB	5.342	G	VR-017	24	30								1	X															
		G	VR-017	24	30		 11/25/14	5.00																		DONALDSON RD (TH-4); REQUIRES VEGETATION CLEARING		10	
WB	5.342	H	R1-1	30	30		STOP						1		X														
							SHEET TOTALS	36.75	0.00	1	0	0	7	0	0	3		38.25 45.0		0	0.0	0.0	0.0	0.0					
								SF	SF	EA	EA	EA	EA	EA	EA	EA		FT		EA	LB	LB	LB	LB					
							TOWN DIRECTIONAL TOTALS	409.7	0.0	14	0	0	69	0	0	51		765.0		0			0.0						

SIGN SUMMARY SHEET

VERMONT AGENCY OF TRANSPORTATION

PROJECT NAME: **ALBURGH-COLCHESTER**
PROJECT NUMBER: **STPG SIGN(45)**


FILE NAME: **6 GRAND ISLE US2 WB TSS.xls** PLOT DATE: **4/28/2014**
PROJECT MANAGER: **D. BRYANT** DRAWN BY: **J. BLANCHARD**
DESIGNED BY: **B. TOOTHAKER** CHECKED **K. KERN**
GRAND ISLE WB SHEET 1 SHEET **96** OF **167**

DIRECTION	MILEPOINT	LOCATION CODE (SHEET 2)	SIGN CODE	WIDTH (IN)	HEIGHT (IN)	SHEETING REMARKS	SIGN LEGEND	NEW SIGNS "A"	NEW SIGNS "B"	EXISTING SIGNS RETAIN	EXISTING SIGNS SALVAGE FROM	EXISTING SIGNS SALVAGE TO	EXISTING SIGNS REMOVE	EXIST POST RETAIN	EXIST POST REMOVE	NUMBER OF NEW POSTS	SQUARE STEEL (IN) 1.75 / 2.00 / 2.50 (LB / FT) 1.88 / 2.42 / 3.35	TUBULAR STEEL Ø (IN) FOUNDATION	TUBULAR STEEL Ø (IN) 3.00 / 3.50 / 4.00 / 5.00 (LB / FT) 7.60 / 9.00 / 10.80 / 14.60	SIGN FRAME REQUIRED	REMARKS	SIGN DETAIL LOCATION SHSM	SIGN DETAIL LOCATION PROJECT SHEET #	SIGN DETAIL LOCATION STANDARD SHEET #
GRAND ISLE US-2 WB							FY-FLUORESCENT YELLOW FYG-FLUORESCENT YELLOW GREEN														"SHSM"-STANDARD HIGHWAY SIGNS AND MARKINGS			
		E/F	D3-1	UNK.	UNK.		DONALDSON RD TH4						1											
WB	5.335	H	R1-1	30	30		STOP 12/02/14	6.25								1	15.00 X				DONALDSON RD (TH-4); REQUIRES VEGETATION CLEARING	X		
WB	5.335	G/H	D3-1	42	12		US Route 2 11/25/14	3.50								2	11.75 X 12.00				DONALDSON RD (TH-4); MOUNT TO STREET NAME SIGN WITH BRACKET		13	
		E/F	D3-1	66	12		Donaldson Rd TH4 11/25/14	5.50													DONALDSON RD (TH-4); FIELD LOCATE FOR VISIBILITY FROM ROUTE 2		14	
WB	5.016	F	S3-1T	30	30								1		X		15.50 15.75							
		F	S3-1	36	36	FYG	11/25/14	9.00								2	X					X		
WB	4.807	F	VW-092	30	30								1		X		14.50 14.75							
		F	VW-092	36	36		UNSAFE TO PASS 11/25/14	9.00								2	X						11	
WB	4.788	F	VD-062AL	72	16		BUSINESS SIGN			1				X										
		F	VD-062B	72	16		BUSINESS SIGN			1														
		F	VD-062AL	72	16		BUSINESS SIGN			1														
WB	4.615	F	M2-1	21	15	GRN/ WHT	JCT 11/26/14	2.19								1	X 15.00					X		
		F	M1-5	30	24	GRN/ WHT	VERMONT 314	5.00													INSTALL 300 FT EAST OF DESTINATION ASSEMBLY	X		
WB	4.558	F	D1-1A	72	10		D-BOARD ASSEMBLY						1		X									
		F	D1-1M	72	10								1											
							SHEET TOTALS	40.44	0.00	3	0	0	5	0	0	8	114.25 ~~126.0~~	0	0.0	0.0	0.0	0.0			
								SF	SF	EA	EA	EA	EA	EA	EA	EA	FT	EA	LB	LB	LB	LB			
							TOWN DIRECTIONAL TOTALS	409.7	0.0	14	0	0	69	0	0	51	765.0	0	0.0						

SIGN SUMMARY SHEET



VERMONT AGENCY OF TRANSPORTATION

PROJECT NAME: ALBURGH-COLCHESTER
PROJECT NUMBER: STPG SIGN(45)
FILE NAME: 6 GRAND ISLE US2 WB TSS.xls
PROJECT MANAGER: D. BRYANT
DESIGNED BY: B. TOOTHAKER
GRAND ISLE WB SHEET 2
PLOT DATE: 4/28/2014
DRAWN BY: J. BLANCHARD
CHECKED K. KERN
SHEET 97 OF 167

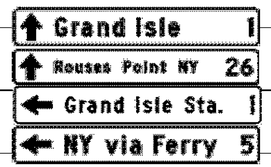DIRECTION	MILEPOINT	LOCATION CODE (SHEET 2)	SIGN CODE	WIDTH (IN)	HEIGHT (IN)	SHEETING REMARKS	SIGN LEGEND	NEW SIGNS "A"	NEW SIGNS "B"	EXISTING SIGNS RETAIN	EXISTING SIGNS SALVAGE FROM	EXISTING SIGNS SALVAGE TO	EXISTING SIGNS REMOVE	EXIST POST RETAIN	EXIST POST REMOVE	NUMBER OF NEW POSTS	SQUARE STEEL (IN) 1.75 (LB/FT) 1.88	SQUARE STEEL (IN) 2.00 (LB/FT) 2.42	SQUARE STEEL (IN) 2.50 (LB/FT) 3.35	TUBULAR STEEL Ø (IN) FOUNDATION	TUBULAR STEEL Ø (IN) 3.00 (LB/FT) 7.60	TUBULAR STEEL Ø (IN) 3.50 (LB/FT) 9.00	TUBULAR STEEL Ø (IN) 4.00 (LB/FT) 10.80	TUBULAR STEEL Ø (IN) 5.00 (LB/FT) 14.60	SIGN FRAME REQUIRED	REMARKS	SIGN DETAIL LOCATION SHSM	SIGN DETAIL LOCATION PROJECT SHEET #	SIGN DETAIL LOCATION STANDARD SHEET #
GRAND ISLE US-2 WB							FY-FLUORESCENT YELLOW FYG-FLUORESCENT YELLOW GREEN																				"SHSM"-STANDARD HIGHWAY SIGNS AND MARKINGS			
		F	D1-1A	72	10								1																
		F	D1-1A	72	10								1																
		F	VD1-1	72	12			6.00								2			11.75 X 12.00							SLIP BASES		8	
		F	VD1-1	72	12			6.00																				8	
		F	VD1-1	72	12			6.00																				8	
		F	VD1-1	72	12		04/24/15	6.00																				8	
WB	4.516	F	M3-3	24	12		ROUTE MARKER ASSEMBLY						1		X														
		F	M1-5	30	24								1																
		F	M6-1	21	15								1																
		F	M3-4	24	12								1																
		F	M1-4	24	24								1																
		F	M6-3	21	15								1																
		F	M3-3	24	12	GRN/WHT		2.00								2			11.50 X 11.50						#2	SLIP BASES	X		
		F	M1-5	24	30	GRN/WHT		5.00																			X		
		F	M6-1L	21	15	GRN/WHT		2.19																			X		
SIGN SUMMARY SHEET							SHEET TOTALS	33.19	0.00	0	0	0	8	0	0	4		46.75 ~~30.0~~		0	0.0	0.0	0.0	0.0					
								SF	SF	EA	EA	EA	EA	EA	EA	EA		FT		EA	LB	LB	LB	LB					
VERMONT AGENCY OF TRANSPORTATION							TOWN DIRECTIONAL TOTALS	409.7	0.0	14	0	0	69	0	0	51		765.0		0	0.0								

PROJECT NAME: ALBURGH-COLCHESTER
PROJECT NUMBER: STPG SIGN(45)

FILE NAME: 6 GRAND ISLE US2 WB TSS.xls PLOT DATE: 4/28/2014
PROJECT MANAGER: D. BRYANT DRAWN BY: J. BLANCHARD
DESIGNED BY: B. TOOTHAKER CHECKED K. KERN
GRAND ISLE WB SHEET 3 SHEET 98 OF 167

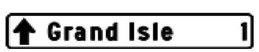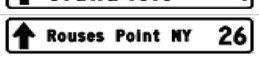DIRECTION	MILEPOINT	LOCATION CODE (SHEET 2)	SIGN CODE	WIDTH (IN)	HEIGHT (IN)	SHEETING REMARKS	SIGN LEGEND	NEW SIGNS "A"	NEW SIGNS "B"	EXISTING SIGNS RETAIN	EXISTING SIGNS SALVAGE FROM	EXISTING SIGNS SALVAGE TO	EXISTING SIGNS REMOVE	EXIST POST RETAIN	EXIST POST REMOVE	NUMBER OF NEW POSTS	SQUARE STEEL (IN) 1.75 (LB/FT) 1.88	SQUARE STEEL (IN) 2.00 (LB/FT) 2.42	SQUARE STEEL (IN) 2.50 (LB/FT) 3.35	TUBULAR STEEL Ø (IN) FOUNDATION	TUBULAR STEEL Ø (IN) 3.00 (LB/FT) 7.60	TUBULAR STEEL Ø (IN) 3.50 (LB/FT) 9.00	TUBULAR STEEL Ø (IN) 4.00 (LB/FT) 10.80	TUBULAR STEEL Ø (IN) 5.00 (LB/FT) 14.60	SIGN FRAME REQUIRED	REMARKS	SIGN DETAIL LOCATION SHSM	SIGN DETAIL LOCATION PROJECT SHEET #	SIGN DETAIL LOCATION STANDARD SHEET #
GRAND ISLE US-2 WB							FY-FLUORESCENT YELLOW FYG-FLUORESCENT YELLOW GREEN																				"SHSM"-STANDARD HIGHWAY SIGNS AND MARKINGS			
		F	M3-4	24	12	BLK/WHT		2.00																			X		
		F	M1-4	24	24	BLK/WHT		4.00																			X		
		F	M6-3	21	15	BLK/WHT		2.19																			X		
WB	4.512	G	W1-7	48	24		11/26/14						1		X			13.50 13.50											
		G	W1-7	48	24			8.00									2		X								INSTALL CENTERED ACROSS FROM INTERSECTION	X		
WB	4.491	F	M3-4	24	12		ROUTE MARKER ASSEMBLY						1		X														
		F	M1-4	24	24								1																
		F	M3-4	24	12	BLK/WHT	11/26/14 & 04/24/15 DAMAGED OVER WINTER 	2.00	2.00							1		X 16.75							X		
		F	M1-4	24	24	BLK/WHT		4.00	4.00																		X		
WB	4.457	F	D1-1A	72	10		D-BOARD ASSEMBLY						1		X														
		F	D2-1	72	10		11/26/14						1					13.50 13.75											
		F	VD1-1	72	12			6.00									2		X									8	
		F	VD1-1	72	12			6.00																				8	
WB	4.393	F	R2-1	24	30		11/26/14						1		X			13.50											
		F	R2-1	24	30			5.00									1		X									X		
SIGN SUMMARY SHEET							SHEET TOTALS	~~45.19~~ ~~39.19~~	0.00	0	0	0	6	0	0	6		~~84.50~~ ~~96.0~~			0	0.0	0.0	0.0	0.0					
								SF	SF	EA	EA	EA	EA	EA	EA	EA		FT			EA	LB	LB	LB	LB					
VERMONT AGENCY OF TRANSPORTATION							TOWN DIRECTIONAL TOTALS	409.7	0.0	14	0	0	69	0	0	51		765.0			0	0.0								

PROJECT NAME: ALBURGH-COLCHESTER
PROJECT NUMBER: STPG SIGN(45)

FILE NAME: 6 GRAND ISLE US2 WB TSS.xls PLOT DATE: 4/28/2014
PROJECT MANAGER: D. BRYANT DRAWN BY: J. BLANCHARD
DESIGNED BY: B. TOOTHAKER CHECKED K. KERN
GRAND ISLE WB SHEET 4 SHEET 99 OF 167

DIRECTION	MILEPOINT	LOCATION CODE (SHEET 2)	SIGN CODE	WIDTH (IN)	HEIGHT (IN)	SHEETING REMARKS	SIGN LEGEND	NEW SIGNS "A"	NEW SIGNS "B"	EXISTING SIGNS RETAIN	EXISTING SIGNS SALVAGE FROM	EXISTING SIGNS SALVAGE TO	EXISTING SIGNS REMOVE	EXIST POST RETAIN	EXIST POST REMOVE	NUMBER OF NEW POSTS	SQUARE STEEL (IN) 1.75 (LB/FT) 1.88	SQUARE STEEL (IN) 2.00 (LB/FT) 2.42	SQUARE STEEL (IN) 2.50 (LB/FT) 3.35	TUBULAR STEEL Ø (IN) FOUNDATION	TUBULAR STEEL Ø (IN) 3.00 (LB/FT) 7.60	TUBULAR STEEL Ø (IN) 3.50 (LB/FT) 9.00	TUBULAR STEEL Ø (IN) 4.00 (LB/FT) 10.80	TUBULAR STEEL Ø (IN) 5.00 (LB/FT) 14.60	SIGN FRAME REQUIRED	REMARKS	SIGN DETAIL LOCATION SHSM	SIGN DETAIL LOCATION PROJECT SHEET #	SIGN DETAIL LOCATION STANDARD SHEET #
GRAND ISLE US-2 WB							FY-FLUORESCENT YELLOW FYG-FLUORESCENT YELLOW GREEN																				"SHSM"-STANDARD HIGHWAY SIGNS AND MARKINGS			
WB	4.065	F	VD-062BC	74.75	16		BUSINESS SIGN			1				X															
WB	4.006	F	W3-5	48	48								1		X			15.50 16.25											
		F	W3-5	36	36		 11/26/14	9.00								2	X									X		
WB	3.876	F	R2-1	36	48								1		X			15.25											
		F	R2-1	30	36		 11/26/14	7.50								1	X									X		
WB	3.783	F	UNK.	UNK.	UNK.		EMPTY POST								X			14.75 15.00											
		F	S3-1	36	36	FYG	 11/26/14	9.00								2	X									X		
WB	3.731	G	VR-017	24	30								1	X															
		G	VR-017	24	30		 11/26/14	5.00																		E SHORE S (TH-3)		10	
WB	3.731	E/F	D3-1	UNK.	UNK.		EAST SHORE SOUTH TH3						1		X												E SHORE S (TH-3)			
WB	3.723	H	R1-1	30	30								1	X															
		H	R1-1	30	30			6.25																		E SHORE S (TH-3)	X		
WB	3.737	G/H	D3-1	42	12		 11/26/14	3.50								2	15.25 X 15.00										E SHORE S (TH-3); MOUNT TO STREET NAME SIGN WITH BRACKET		13	
		E/F	D3-1	52	12			4.33																		E SHORE S (TH-3); FIELD LOCATE FOR VISIBILITY FROM ROUTE 2		14	
WB	3.649	F	W7-3A	24	18		11/26/14						1		X														
							SHEET TOTALS	44.58	0.00	1	0	0	6	0	0	7		107.00 ~~105.0~~		0	0.0	0.0	0.0	0.0					
								SF	SF	EA	EA	EA	EA	EA	EA	EA		FT		EA	LB	LB	LB	LB					
							TOWN DIRECTIONAL TOTALS	409.7	0.0	14	0	0	69	0	0	51		765.0		0			0.0						

SIGN SUMMARY SHEET

VERMONT AGENCY OF TRANSPORTATION

PROJECT NAME: ALBURGH-COLCHESTER
PROJECT NUMBER: STPG SIGN(45)

FILE NAME: 6 GRAND ISLE US2 WB TSS.xls
PROJECT MANAGER: D. BRYANT
DESIGNED BY: B. TOOTHAKER
GRAND ISLE WB SHEET 5

PLOT DATE: 4/28/2014
DRAWN BY: J. BLANCHARD
CHECKED K. KERN

DIRECTION	MILEPOINT	LOCATION CODE (SHEET 2)	SIGN CODE	WIDTH (IN)	HEIGHT (IN)	SHEETING REMARKS	SIGN LEGEND	NEW SIGNS "A"	NEW SIGNS "B"	EXISTING SIGNS RETAIN	EXISTING SIGNS SALVAGE FROM	EXISTING SIGNS SALVAGE TO	EXISTING SIGNS REMOVE	EXIST POST RETAIN	EXIST POST REMOVE	NUMBER OF NEW POSTS	SQUARE STEEL (IN) 1.75 (LB/FT) 1.88	SQUARE STEEL (IN) 2.00 (LB/FT) 2.42	SQUARE STEEL (IN) 2.50 (LB/FT) 3.35	TUBULAR STEEL Ø (IN) FOUNDATION	TUBULAR STEEL Ø (IN) 3.00 (LB/FT) 7.60	TUBULAR STEEL Ø (IN) 3.50 (LB/FT) 9.00	TUBULAR STEEL Ø (IN) 4.00 (LB/FT) 10.80	TUBULAR STEEL Ø (IN) 5.00 (LB/FT) 14.60	SIGN FRAME REQUIRED	REMARKS	SIGN DETAIL LOCATION SHSM	SIGN DETAIL LOCATION PROJECT SHEET #	SIGN DETAIL LOCATION STANDARD SHEET #
GRAND ISLE US-2 WB							FY-FLUORESCENT YELLOW FYG-FLUORESCENT YELLOW GREEN																			"SHSM"-STANDARD HIGHWAY SIGNS AND MARKINGS			
		F	W11-5	30	30		11/26/14						~~1~~																
		F	W11-5	30	30			6.25								1		17.50 X								X		
		F	W7-3aP	24	18			3.00																		X		
WB	3.569	F	VD-018	30	18		11/26/14						1		X														
		F	VD-018	30	18			3.75								1		13.75 X									6	
WB	3.537	F	W3-5	36	36		11/26/14	9.00								~~1~~ 2		17.00 X								INSTALL 500 FT EAST OF NEW SPEED LIMIT SIGN	X		
WB	3.442	F	R2-1	24	30		12/01/14						1	X															
		F	R2-1	30	36			7.50																		X		
WB	3.394	F	VD-062AL	72	16		BUSINESS SIGN 12/01/14			1				X															
WB	3.276	F	VW-205	30	30								1		X														
		F	VW-205	36	36		 12/01/14	9.00								~~1~~ 2		14.75 X										E-154
WB	3.233	F	W13-1	18	18		35 MPH						1		X														
		F	W2-1	30	30		12/01/14						1																
		F	W2-1	30	30			6.25								1		16.00 X								X		
WB	3.167	F	R2-1	24	30		12/01/14						1	X															
SIGN SUMMARY SHEET							SHEET TOTALS	44.75	0.00	1	0	0	~~6~~ 7	0	0	7		~~79.00~~ 105.0		0	0.0	0.0	0.0	0.0					
								SF	SF	EA	EA	EA	EA	EA	EA	EA		FT		EA	LB	LB	LB	LB					
VERMONT AGENCY OF TRANSPORTATION							TOWN DIRECTIONAL TOTALS	409.7	0.0	14	0	0	69	0	0	51		765.0		0	0.0								

PROJECT NAME: ALBURGH-COLCHESTER
PROJECT NUMBER: STPG SIGN(45)
FILE NAME: 6 GRAND ISLE US2 WB TSS.xls PLOT DATE: 4/28/2014
PROJECT MANAGER: D. BRYANT DRAWN BY: J. BLANCHARD
DESIGNED BY: B. TOOTHAKER CHECKED K. KERN
GRAND ISLE WB SHEET 6 SHEET 101 OF 167

DIRECTION	MILEPOINT	LOCATION CODE (SHEET 2)	SIGN CODE	WIDTH (IN)	HEIGHT (IN)	SHEETING REMARKS	SIGN LEGEND	NEW SIGNS "A"	NEW SIGNS "B"	EXISTING SIGNS RETAIN	EXISTING SIGNS SALVAGE FROM	EXISTING SIGNS SALVAGE TO	EXISTING SIGNS REMOVE	EXIST POST RETAIN	EXIST POST REMOVE	NUMBER OF NEW POSTS	SQUARE STEEL (IN) 1.75 (LB/FT) 1.88	SQUARE STEEL (IN) 2.00 (LB/FT) 2.42	SQUARE STEEL (IN) 2.50 (LB/FT) 3.35	TUBULAR STEEL Ø (IN) FOUNDATION	TUBULAR STEEL Ø (IN) 3.00 (LB/FT) 7.60	TUBULAR STEEL Ø (IN) 3.50 (LB/FT) 9.00	TUBULAR STEEL Ø (IN) 4.00 (LB/FT) 10.80	TUBULAR STEEL Ø (IN) 5.00 (LB/FT) 14.60	SIGN FRAME REQUIRED	REMARKS	SIGN DETAIL LOCATION SHSM	SIGN DETAIL LOCATION PROJECT SHEET #	SIGN DETAIL LOCATION STANDARD SHEET #
GRAND ISLE US-2 WB							FY-FLUORESCENT YELLOW FYG-FLUORESCENT YELLOW GREEN																				"SHSM"-STANDARD HIGHWAY SIGNS AND MARKINGS			
		F	R2-1	24	30		SPEED LIMIT 35 12/01/14	5.00																			X		
WB	3.120	F	D3-1	UNK.	UNK.		EAST SHORE NORTH TH9 12/01/14						1		X														
		G	D3-1	UNK.	UNK.		U.S. ROUTE 2						1																
WB	3.120	G	VR-017	24	30								1	X															
		H	R1-1	30	30								1																
		G	VR-017	24	30		LEGAL LOAD LIMIT 24,000 POUNDS 12/01/14	5.00																		E SHORE N (TH-6)		10	
		H	R1-1	30	30		STOP	6.25																		E SHORE N (TH-6)	X		
WB	3.120	G	D3-1	42	12		US Route 2 12/01/14	3.50								2	13.00 X 13.25									E SHORE N (TH-6): MOUNT TO STREET NAME SIGN WITH BRACKET		13	
		F	D3-1	52	12		E Shore N TH6	4.33																		E SHORE N (TH-6): FIELD LOCATE FOR VISIBILITY FROM ROUTE 2		14	
WB	3.113	H	R1-1	30	30								1	X															
		H	R1-1	30	30		STOP 12/01/14	6.25																		E SHORE N (TH-6)	X		
WB	3.056	F	R2-1	24	30		12/01/14						1	X															
		F	R2-1	24	30		SPEED LIMIT 40	5.00																			X		
WB	3.030	F	W16-9	36	20		AHEAD 12/01/14						1		X														
		F	S1-1	36	36								1																
SIGN SUMMARY SHEET							SHEET TOTALS	35.33	0.00	0	0	0	8	0	0	2	26.25 ~~30.0~~			0	0.0	0.0	0.0	0.0					
								SF	SF	EA	EA	EA	EA	EA	EA	EA	FT			EA	LB	LB	LB	LB					
VERMONT AGENCY OF TRANSPORTATION							TOWN DIRECTIONAL TOTALS	409.7	0.0	14	0	0	69	0	0	51	765.0			0	0.0								


PROJECT NAME: ALBURGH-COLCHESTER
PROJECT NUMBER: STPG SIGN(45)

FILE NAME: 6 GRAND ISLE US2 WB TSS.xls PLOT DATE: 4/28/2014
PROJECT MANAGER: D. BRYANT DRAWN BY: J. BLANCHARD
DESIGNED BY: B. TOOTHAKER CHECKED K. KERN
GRAND ISLE WB SHEET 7 SHEET 102 OF 167

DIRECTION	MILEPOINT	LOCATION CODE (SHEET 2)	SIGN CODE	WIDTH (IN)	HEIGHT (IN)	SHEETING REMARKS	SIGN LEGEND	NEW SIGNS "A"	NEW SIGNS "B"	EXISTING SIGNS RETAIN	EXISTING SIGNS SALVAGE FROM	EXISTING SIGNS SALVAGE TO	EXISTING SIGNS REMOVE	EXIST POST RETAIN	EXIST POST REMOVE	NUMBER OF NEW POSTS	SQUARE STEEL (IN) 1.75 (LB/FT) 1.88	SQUARE STEEL (IN) 2.00 (LB/FT) 2.42	SQUARE STEEL (IN) 2.50 (LB/FT) 3.35	TUBULAR STEEL Ø (IN) FOUNDATION	TUBULAR STEEL Ø (IN) 3.00 (LB/FT) 7.60	TUBULAR STEEL Ø (IN) 3.50 (LB/FT) 9.00	TUBULAR STEEL Ø (IN) 4.00 (LB/FT) 10.80	TUBULAR STEEL Ø (IN) 5.00 (LB/FT) 14.60	SIGN FRAME REQUIRED	REMARKS	SIGN DETAIL LOCATION SHSM	SIGN DETAIL LOCATION PROJECT SHEET #	SIGN DETAIL LOCATION STANDARD SHEET #
GRAND ISLE US-2 WB							FY-FLUORESCENT YELLOW FYG-FLUORESCENT YELLOW GREEN																			"SHSM"-STANDARD HIGHWAY SIGNS AND MARKINGS			
		F	S1-1	36	36	FYG		9.00								1			16.25 X								X		
		F	S4-3	24	8	FYG		1.33																			X		
WB	2.952	F	S4-3	24	8		SCHOOL						1	X															
		F	S4-4	24	10		WHEN FLASHING						1																
		F	R2-1	24	30		SPEED LIMIT 35						1														REQUIRES VEGETATION CLEARING;			
		F	S5-1	24	48		 12/01/14	8.00																RETAIN EXISTING FLASHING BEACONS; STRAIGHTEN POST	X		
WB	2.859	F	R2-1	24	30								1		X														
		F	R2-1	24	30			5.00								1			18.25 X								X		
		F	S5-2	24	30		 12/01/14	5.00																			X		
WB	2.650	F	R2-1	24	30		 12/01/14	5.00								1		14.75 X								INSTALL 407 FT EAST OF EXISTING	X		
WB	2.573	F	R2-1	24	30		SPEED LIMIT 50 12/01/14						1		X														
WB	1.905	F	W16-8A	48	15		12/01/14						1		X														
		F	W2-1M	36	36								1																
		F	W2-1	30	30			6.25								2		16.75 X 16.75								REQUIRES VEGETATION CLEARING	X		
		F	W16-8aP	48	15			5.00																				7	
SIGN SUMMARY SHEET							SHEET TOTALS	44.58	0.00	0	0	0	7	0	0	5		82.75 ~~75.0~~		0	0.0	0.0	0.0	0.0					
								SF	SF	EA	EA	EA	EA	EA	EA	EA		FT		EA	LB	LB	LB	LB					
VERMONT AGENCY OF TRANSPORTATION							TOWN DIRECTIONAL TOTALS	409.7	0.0	14	0	0	69	0	0	51		765.0		0	0.0								

PROJECT NAME: ALBURGH-COLCHESTER
PROJECT NUMBER: STPG SIGN(45)

FILE NAME: 6 GRAND ISLE US2 WB TSS.xls PLOT DATE: 4/28/2014
PROJECT MANAGER: D. BRYANT DRAWN BY: J. BLANCHARD
DESIGNED BY: B. TOOTHAKER CHECKED K. KERN
GRAND ISLE WB SHEET 8 SHEET 103 OF 167

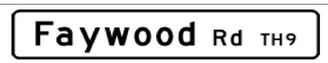DIRECTION	MILEPOINT	LOCATION CODE (SHEET 2)	SIGN CODE	WIDTH (IN)	HEIGHT (IN)	SHEETING REMARKS	SIGN LEGEND	NEW SIGNS "A"	NEW SIGNS "B"	EXISTING SIGNS RETAIN	EXISTING SIGNS SALVAGE FROM	EXISTING SIGNS SALVAGE TO	EXISTING SIGNS REMOVE	EXIST POST RETAIN	EXIST POST REMOVE	NUMBER OF NEW POSTS	SQUARE STEEL (IN) 1.75 (LB/FT) 1.88	SQUARE STEEL (IN) 2.00 (LB/FT) 2.42	SQUARE STEEL (IN) 2.50 (LB/FT) 3.35	TUBULAR STEEL Ø (IN) FOUNDATION	TUBULAR STEEL Ø (IN) 3.00 (LB/FT) 7.60	TUBULAR STEEL Ø (IN) 3.50 (LB/FT) 9.00	TUBULAR STEEL Ø (IN) 4.00 (LB/FT) 10.80	TUBULAR STEEL Ø (IN) 5.00 (LB/FT) 14.60	SIGN FRAME REQUIRED	REMARKS	SIGN DETAIL LOCATION SHSM	SIGN DETAIL LOCATION PROJECT SHEET #	SIGN DETAIL LOCATION STANDARD SHEET #
GRAND ISLE US-2 WB							FY-FLUORESCENT YELLOW FYG-FLUORESCENT YELLOW GREEN																			"SHSM"-STANDARD HIGHWAY SIGNS AND MARKINGS			
WB	1.873	F	VD-062B	72	16		BUSINESS SIGN			1				X															
		F	VD-062B	72	16		BUSINESS SIGN			1																			
		F	VD-062B	72	16		BUSINESS SIGN			1																			
WB	1.850	F	VW-544	36	36								1		X			12.75											
		F	W13-1	24	24								1					12.75											
		F	VW-544	36	36		 04/21/15	9.00								2		X								SLIP BASES			E-154
		F	W13-1P	24	24			4.00																				X		
WB	1.796	E/F	D3-1	UNK.	UNK.		12/01/14						1		X			14.00									FAYWOOD RD (TH-9)			
		G/H	D3-1	42	12			3.50								2		14.00 X									FAYWOOD RD (TH-9); MOUNT TO STREET NAME SIGN WITH BRACKET		13	
		E/F	D3-1	60	12			5.00																			FAYWOOD RD (TH-9); FIELD LOCATE FOR VISIBILITY FROM ROUTE 2		14	
WB	1.795	G	VR-017	24	30			5.00																			FAYWOOD RD (TH-9)		10	
WB	1.795	H	R1-1	30	30		12/01/14						1	X															
		H	R1-1	30	30			6.25																			FAYWOOD RD (TH-9); INSTALL RED REFLECTIVE SHEETING ON POST (SEE MUTCD 2A.15 & 2A.21)	X		
WB	1.788	H	R1-1	30	30		12/01/14						1	X													REQUIRES VEGETATION CLEARING			
		H	R1-1	30	30			6.25																			FAYWOOD RD (TH-9); INSTALL REFLECTIVE SHEETING ON POST (SEE MUTCD 2A.15 & 2A.21)	X		
SIGN SUMMARY SHEET							SHEET TOTALS	39.00	0.00	3	0	0	5	0	0	4		53.50 ~~60.0~~		0	0.0	0.0	0.0	0.0					
								SF	SF	EA	EA	EA	EA	EA	EA	EA		FT		EA	LB	LB	LB	LB					
VERMONT AGENCY OF TRANSPORTATION							TOWN DIRECTIONAL TOTALS	409.7	0.0	14	0	0	69	0	0	51		765.0		0	0.0								

PROJECT NAME: ALBURGH-COLCHESTER
PROJECT NUMBER: STPG SIGN(45)

FILE NAME: 6 GRAND ISLE US2 WB TSS.xls
PROJECT MANAGER: D. BRYANT
DESIGNED BY: B. TOOTHAKER
GRAND ISLE WB SHEET 9

PLOT DATE: 4/28/2014
DRAWN BY: J. BLANCHARD
CHECKED K. KERN

DIRECTION	MILEPOINT	LOCATION CODE (SHEET 2)	SIGN CODE	WIDTH (IN)	HEIGHT (IN)	SHEETING REMARKS	SIGN LEGEND	NEW SIGNS "A"	NEW SIGNS "B"	EXISTING SIGNS RETAIN	EXISTING SIGNS SALVAGE FROM	EXISTING SIGNS SALVAGE TO	EXISTING SIGNS REMOVE	EXIST POST RETAIN	EXIST POST REMOVE	NUMBER OF NEW POSTS	SQUARE STEEL (IN) 1.75 (LB/FT) 1.88	SQUARE STEEL (IN) 2.00 (LB/FT) 2.42	SQUARE STEEL (IN) 2.50 (LB/FT) 3.35	TUBULAR STEEL Ø (IN) FOUNDATION	TUBULAR STEEL Ø (IN) 3.00 (LB/FT) 7.60	TUBULAR STEEL Ø (IN) 3.50 (LB/FT) 9.00	TUBULAR STEEL Ø (IN) 4.00 (LB/FT) 10.80	TUBULAR STEEL Ø (IN) 5.00 (LB/FT) 14.60	SIGN FRAME REQUIRED	REMARKS	SIGN DETAIL LOCATION SHSM	SIGN DETAIL LOCATION PROJECT SHEET #	SIGN DETAIL LOCATION STANDARD SHEET #
GRAND ISLE US-2 WB							FY-FLUORESCENT YELLOW FYG-FLUORESCENT YELLOW GREEN																				"SHSM"-STANDARD HIGHWAY SIGNS AND MARKINGS			
WB	0.874	F	W11-1	30	30								1	X															
		F	W11-1	30	30		 12/01/14	6.25																			X		
WB	0.514	F	W1-2L	30	30		LEFT CURVE 12/01/14						1		X														
WB	0.456	F	W1-2L	30	30		 12/01/14	6.25								1		X 14.25									INSTALL 305 FT WEST OF EXISTING	X		
WB	0.421	G	VR-017	24	30								1	X															
		G	VR-017	24	30		 12/01/14	5.00																			E SHORE N (TH-6)		10	
WB	0.414	H	R1-1	30	30								1	X															
		H	R1-1	30	30		 12/01/14	6.25																			E SHORE N (TH-6)	X		
WB	0.412	G/H	D3-1	UNK.	UNK.								1		X														
		E/F	D3-1	UNK.	UNK.								1				11.75												
		G/H	D3-1	42	12		 12/01/14	3.50								2		12.00 X									E SHORE N (TH-6); MOUNT TO STREET NAME SIGN WITH BRACKET		13	
		E/F	D3-1	68	12			5.67																			E SHORE N (TH-6); FIELD LOCATE FOR VISIBILITY FROM ROUTE 2		14	
WB	0.364	F	W1-6L	48	24		 12/02/14	8.00								2		14.00 X 14.50									INSTALL 147 FT EAST OF ROUTE MARKER ASSEMBLY	X		
WB	0.336	F	M3-4	24	12		WEST			1				X															
		F	M1-4	24	24		US 2			1																			
SIGN SUMMARY SHEET							SHEET TOTALS	40.92	0.00	2	0	0	6	0	0	5		66.50 ~~75.0~~		0	0.0	0.0	0.0	0.0					
								SF	SF	EA	EA	EA	EA	EA	EA	EA		FT		EA	LB	LB	LB	LB					
VERMONT AGENCY OF TRANSPORTATION							TOWN DIRECTIONAL TOTALS	409.7	0.0	14	0	0	69	0	0	51		765.0		0		0.0							

PROJECT NAME: **ALBURGH-COLCHESTER**
PROJECT NUMBER: **STPG SIGN(45)**
FILE NAME: **6 GRAND ISLE US2 WB TSS.xls** PLOT DATE: **4/28/2014**
PROJECT MANAGER: **D. BRYANT** DRAWN BY: **J. BLANCHARD**
DESIGNED BY: **B. TOOTHAKER** CHECKED **K. KERN**
GRAND ISLE WB SHEET 10 SHEET **105** OF **167**

DIRECTION	MILEPOINT	LOCATION CODE (SHEET 2)	SIGN CODE	WIDTH (IN)	HEIGHT (IN)	SHEETING REMARKS	SIGN LEGEND	NEW SIGNS "A"	NEW SIGNS "B"	EXISTING SIGNS RETAIN	EXISTING SIGNS SALVAGE FROM	EXISTING SIGNS SALVAGE TO	EXISTING SIGNS REMOVE	EXIST POST RETAIN	EXIST POST REMOVE	NUMBER OF NEW POSTS	SQUARE STEEL (IN) 1.75 (LB/FT) 1.88	SQUARE STEEL (IN) 2.00 (LB/FT) 2.42	SQUARE STEEL (IN) 2.50 (LB/FT) 3.35	TUBULAR STEEL Ø (IN) FOUNDATION	TUBULAR STEEL Ø (IN) 3.00 (LB/FT) 7.60	TUBULAR STEEL Ø (IN) 3.50 (LB/FT) 9.00	TUBULAR STEEL Ø (IN) 4.00 (LB/FT) 10.80	TUBULAR STEEL Ø (IN) 5.00 (LB/FT) 14.60	SIGN FRAME REQUIRED	REMARKS	SIGN DETAIL LOCATION SHSM	SIGN DETAIL LOCATION PROJECT SHEET #	SIGN DETAIL LOCATION STANDARD SHEET #
GRAND ISLE US-2 WB							FY-FLUORESCENT YELLOW FYG-FLUORESCENT YELLOW GREEN																				"SHSM"-STANDARD HIGHWAY SIGNS AND MARKINGS			
WB	0.185	F	VW-170A	48	48		DRAW BRIDGE AHEAD			1				X															
WB	0.125	F	W3-3	30	30		SIGNAL AHEAD SYMBOL			1				X															
WB	0.071	F	VW-666	30	30		BICYCLES USE CAUTION			1				X															
WB	0.050	F	R10-6	24	36		12/02/14						1	X															
		F	R10-6	24	36			6.00																	SALVAGE AND REMOUNT EXISTING ORANGE FLAGS	X		
WB	0.046	G	VR-070P	21	15		<===> DOUBLE ARROW 12/02/14						1	X															
		G	R8-3A	24	24		NO PARKING SYMBOL						1																
		G	VP-136	24	12		ANYTIME						1																
		G	R7-1	24	30			5.00																		X		
	0.047			48	9		TOWN LINE RD	3.00																					

SIGN SUMMARY SHEET	SHEET TOTALS	~~14.00~~ ~~11.00~~	0.00	3	0	0	4	0	0	0	0.0			0	0.0	0.0	0.0	0.0										
		SF	SF	EA	EA	EA	EA	EA	EA	EA	FT			EA	LB	LB	LB	LB										
VERMONT AGENCY OF TRANSPORTATION	TOWN DIRECTIONAL TOTALS	~~412.73~~ ~~409.7~~	0.0	14	0	0	~~68~~ ~~69~~	0	0	51	~~698.75~~ ~~765.0~~			0	0.0														

PROJECT NAME: **ALBURGH-COLCHESTER**
PROJECT NUMBER: **STPG SIGN(45)**

FILENAME: **6 GRAND ISLE US2 WB TSS.xls** PLOT DATE: **4/28/2014**
PROJECT MANAGER: **D. BRYANT** DRAWN BY: **J. BLANCHARD**
DESIGNED BY: **B. TOOTHAKER** CHECKED **K. KERN**
GRAND ISLE WB SHEET 11 SHEET **106** OF **167**

DIRECTION	MILEPOINT	LOCATION CODE (SHEET 2)	SIGN CODE	WIDTH (IN)	HEIGHT (IN)	SHEETING REMARKS	SIGN LEGEND	NEW SIGNS "A"	NEW SIGNS "B"	EXISTING SIGNS RETAIN	EXISTING SIGNS SALVAGE FROM	EXISTING SIGNS SALVAGE TO	EXISTING SIGNS REMOVE	EXIST POST RETAIN	EXIST POST REMOVE	NUMBER OF NEW POSTS	SQUARE STEEL (IN) 1.75 (LB/FT) 1.88	SQUARE STEEL (IN) 2.00 (LB/FT) 2.42	SQUARE STEEL (IN) 2.50 (LB/FT) 3.35	TUBULAR STEEL Ø (IN) FOUNDATION	TUBULAR STEEL Ø (IN) 3.00 (LB/FT) 7.60	TUBULAR STEEL Ø (IN) 3.50 (LB/FT) 9.00	TUBULAR STEEL Ø (IN) 4.00 (LB/FT) 10.80	TUBULAR STEEL Ø (IN) 5.00 (LB/FT) 14.60	SIGN FRAME REQUIRED	REMARKS	SIGN DETAIL LOCATION SHSM	SIGN DETAIL LOCATION PROJECT SHEET #	SIGN DETAIL LOCATION STANDARD SHEET #
SOUTH HERO US-2 EB							FY-FLUORESCENT YELLOW FYG-FLUORESCENT YELLOW GREEN																				"SHSM"-STANDARD HIGHWAY SIGNS AND MARKINGS			
EB	0.000	C	VD-024	60	7.5		11/18/14						1		X			10.25 12.50											
		C	VD-024	72	10		South Hero | Grand Isle	5.00								2		X										7	
		C	VD-700	6	10		0020 0705 0000 / 0020 0702 0627	0.42																					E-138
		C	VD-700	6	10			0.42																					E-138
EB	0.755	A	W3-5	48	48								1		X			15.25 15.75											
		A	W3-5	36	36		SPEED LIMIT 40 11/18/14	9.00								2		X										X	
EB	0.797	A	W1-2L	30	30								1		X			15.25											
		A	W1-2L	30	30		11/18/14	6.25								1		X										X	
EB	0.866	A	VD-018	30	18		Keeler Bay South Hero 2 11/18/14	3.75								1		11.75 X									INSTALL 250 FT WEST OF SPEED LIMIT SIGN		6	
EB	0.913	A	R2-1	36	48								1	~~X~~				15.00											
		A	R2-1	30	36		SPEED LIMIT 40 11/18/14	7.50																				X	
EB	0.972	A	M2-1	21	15		JCT STATE			1				X															
		A	M1-5	30	24		VERMONT 314			1																			
EB	1.010	A	VD-062AL	72	16		BUSINESS SIGN			1				X															
		A	VD-062B	72	16		BUSINESS SIGN			1				X															
							SHEET TOTALS	32.33	0.00	4	0	0	4	0	0	6		~~95.75~~ 98.0		0	0.0	0.0	0.0	0.0					
								SF	SF	EA	EA	EA	EA	EA	EA	EA		FT		EA	LB	LB	LB	LB					
							TOWN DIRECTIONAL TOTALS	257.0	0.0	48	9	9	57	0	0	29		435.0		0		0.0							

SIGN SUMMARY SHEET

VERMONT AGENCY OF TRANSPORTATION

PROJECT NAME: ALBURGH-COLCHESTER
PROJECT NUMBER: STPG SIGN(45)

FILE NAME: 7 SOUTH HERO US2 EB TSS.xls PLOT DATE: 3/14/2014
PROJECT MANAGER: D. BRYANT DRAWN BY: J. BLANCHARD
DESIGNED BY: B. TOOTHAKER CHECKED K. KERN
SOUTH HERO EB SHEET 1 SHEET 107 OF 167

DIRECTION	MILEPOINT	LOCATION CODE (SHEET 2)	SIGN CODE	WIDTH (IN)	HEIGHT (IN)	SHEETING REMARKS	SIGN LEGEND	NEW SIGNS		EXISTING SIGNS				EXIST POST		NUMBER OF NEW POSTS	SQUARE STEEL (IN)			TUBULAR STEEL Ø (IN)				SIGN FRAME REQUIRED	REMARKS	SIGN DETAIL LOCATION		
								"A"	"B"	RETAIN	SALVAGE FROM	SALVAGE TO	REMOVE	RETAIN	REMOVE		1.75 (LB / FT) 1.88	2.00 (LB / FT) 2.42	2.50 (LB / FT) 3.35	FOUNDATION	3.00 (LB / FT) 7.60	3.50 (LB / FT) 9.00	4.00 (LB / FT) 10.80	5.00 (LB / FT) 14.60			SHSM	PROJECT SHEET #	STANDARD SHEET #
SOUTH HERO US-2 EB							FY-FLUORESCENT YELLOW FYG-FLUORESCENT YELLOW GREEN																		"SHSM"-STANDARD HIGHWAY SIGNS AND MARKINGS			
EB	1.042	A	R2-1	30	36		SPEED LIMIT 35			1				X														
EB	1.074	A	VD1-1M	72	12		NY STATE VIA FERRY 2 --->			1				X														
		A	D1-1A	72	12		^UP SOUTH HERO 1			1																		
		A	D1-1A	72	12		^UP BURLINGTON 21			1																		
EB	1.114	A	M4-5	24	12		TO INTERSTATE				1	1	1	X											#3	SALVAGE AND MOUNT ON NEW FRAME			
		A	M1-1	24	24		INTERSTATE 89				1	1	1													SALVAGE AND MOUNT ON NEW FRAME			
		A	M6-3	24	12		^UP ARROW INTERSTATE				1	1	1													SALVAGE AND MOUNT ON NEW FRAME			
		A	M3-2	24	12		EAST US				1	1	1													SALVAGE AND MOUNT ON NEW FRAME			
		A	M1-4	24	24		US 2				1	1	1													SALVAGE AND MOUNT ON NEW FRAME			
		A	M6-3	21	15		^UP ARROW US				1	1	1													SALVAGE AND MOUNT ON NEW FRAME			
		A	M3-1	24	12		NORTH STATE				1	1	1													SALVAGE AND MOUNT ON NEW FRAME			
		A	M1-5	30	24		VERMONT 314				1	1	1													SALVAGE AND MOUNT ON NEW FRAME			
		A	M6-1	21	15		RIGHT ---> STATE				1	1	1													SALVAGE AND MOUNT ON NEW FRAME			
EB	1.205	A	D2-1	72	12		SOUTH HERO 1			1				X														
		A	D2-1	72	12		BURLINGTON 21			1																		
							SHEET TOTALS	0.00 SF	0.00 SF	6 EA	9 EA	9 EA	9 EA	0 EA	0 EA	0 EA	0.0 FT			0 EA	0.0 LB	0.0 LB	0.0 LB	0.0 LB					
							TOWN DIRECTIONAL TOTALS	257.0	0.0	48	9	9	57	0	0	29	435.0			0	0.0										

SIGN SUMMARY SHEET

VERMONT AGENCY OF TRANSPORTATION

PROJECT NAME: ALBURGH-COLCHESTER
PROJECT NUMBER: STPG SIGN(45)

FILE NAME: 7 SOUTH HERO US2 EB TSS.xls PLOT DATE: 3/14/2014
PROJECT MANAGER: D. BRYANT DRAWN BY: J. BLANCHARD
DESIGNED BY: B. TOOTHAKER CHECKED K. KERN
SOUTH HERO EB SHEET 2 SHEET 108 OF 167

DIRECTION	MILEPOINT	LOCATION CODE (SHEET 2)	SIGN CODE	WIDTH (IN)	HEIGHT (IN)	SHEETING REMARKS	SIGN LEGEND	NEW SIGNS "A"	NEW SIGNS "B"	EXISTING SIGNS RETAIN	EXISTING SIGNS SALVAGE FROM	EXISTING SIGNS SALVAGE TO	EXISTING SIGNS REMOVE	EXIST POST RETAIN	EXIST POST REMOVE	NUMBER OF NEW POSTS	SQUARE STEEL (IN) 1.75 (LB/FT) 1.88	SQUARE STEEL (IN) 2.00 (LB/FT) 2.42	SQUARE STEEL (IN) 2.50 (LB/FT) 3.35	TUBULAR STEEL Ø (IN) FOUNDATION	TUBULAR STEEL Ø (IN) 3.00 (LB/FT) 7.60	TUBULAR STEEL Ø (IN) 3.50 (LB/FT) 9.00	TUBULAR STEEL Ø (IN) 4.00 (LB/FT) 10.80	TUBULAR STEEL Ø (IN) 5.00 (LB/FT) 14.60	SIGN FRAME REQUIRED	REMARKS	SIGN DETAIL LOCATION SHSM	SIGN DETAIL LOCATION PROJECT SHEET #	SIGN DETAIL LOCATION STANDARD SHEET #
SOUTH HERO US-2 EB							FY-FLUORESCENT YELLOW FYG-FLUORESCENT YELLOW GREEN																			"SHSM"-STANDARD HIGHWAY SIGNS AND MARKINGS			
		A	M4-5	24	12		TO INTERSTATE			1																			
		A	M1-1	24	24		INTERSTATE 89			1																			
		A	M1-4	24	24		US 2			1																			
		A	M3-2	24	12		EAST US			1																			
EB	1.230	A	R2-1	24	30		SPEED LIMIT 35 11/18/14	5.00		1				X															
EB	1.266	A	W11-2	30	30								1		X														
		A	VW-258	24	18								1																
		A	W11-2	30	30	FYG	 11/18/14	6.25								1		16.75 X								X			
		A	VW-258	24	18	FYG		3.00																					E-154
EB	1.429	A	R2-1	24	30								1	~~X~~				13.00											
		A	R2-1	24	30		 11/18/14	5.00																		X			
EB	1.680	A	R2-1	24	30		SPEED LIMIT 45 11/18/14	5.00		1				X															
EB	2.045	C	VR-017	24	30								1	~~X~~															
		C	R2-1	24	30		SPEED LIMIT 25 11/18/14			1								15.25											
		C	VR-017	24	30			5.00																			SUNSET VIEW RD (TH-8)		10	
SIGN SUMMARY SHEET							SHEET TOTALS	~~29.25~~ 19.25	0.00	7	0	0	4	0	0	1		~~45.00~~ 16.0			0	0.0	0.0	0.0	0.0				
								SF	SF	EA	EA	EA	EA	EA	EA	EA		FT			EA	LB	LB	LB	LB				
VERMONT AGENCY OF TRANSPORTATION							TOWN DIRECTIONAL TOTALS	257.0	0.0	48	9	9	57	0	0	29		435.0			0	0.0							

PROJECT NAME: ALBURGH-COLCHESTER
PROJECT NUMBER: STPG SIGN(45)

FILE NAME: 7 SOUTH HERO US2 EB TSS.xls PLOT DATE: 3/14/2014
PROJECT MANAGER: D. BRYANT DRAWN BY: J. BLANCHARD
DESIGNED BY: B. TOOTHAKER CHECKED K. KERN
SOUTH HERO EB SHEET 3 SHEET 109 OF 167

DIRECTION	MILEPOINT	LOCATION CODE (SHEET 2)	SIGN CODE	WIDTH (IN)	HEIGHT (IN)	SHEETING REMARKS	SIGN LEGEND	NEW SIGNS "A"	NEW SIGNS "B"	EXISTING SIGNS RETAIN	EXISTING SIGNS SALVAGE FROM	EXISTING SIGNS SALVAGE TO	EXISTING SIGNS REMOVE	EXIST POST RETAIN	EXIST POST REMOVE	NUMBER OF NEW POSTS	SQUARE STEEL (IN) 1.75 (LB/FT) 1.88	SQUARE STEEL (IN) 2.00 (LB/FT) 2.42	SQUARE STEEL (IN) 2.50 (LB/FT) 3.35	TUBULAR STEEL Ø (IN) FOUNDATION	TUBULAR STEEL Ø (IN) 3.00 (LB/FT) 7.60	TUBULAR STEEL Ø (IN) 3.50 (LB/FT) 9.00	TUBULAR STEEL Ø (IN) 4.00 (LB/FT) 10.80	TUBULAR STEEL Ø (IN) 5.00 (LB/FT) 14.60	SIGN FRAME REQUIRED	REMARKS	SIGN DETAIL LOCATION SHSM	SIGN DETAIL LOCATION PROJECT SHEET #	SIGN DETAIL LOCATION STANDARD SHEET #
SOUTH HERO US-2 EB							FY-FLUORESCENT YELLOW FYG-FLUORESCENT YELLOW GREEN																			"SHSM"-STANDARD HIGHWAY SIGNS AND MARKINGS			
EB	2.045	A/B	D3-1	UNK.	UNK.		SUNSET VIEW RD			1				X															
EB	2.056	D	R1-1	30	30								1	X				12.00											
		D	R1-1	30	30		STOP 11/18/14	6.25								1											SUNSET VIEW RD (TH-8)	X		
EB	2.075	A	R2-1	24	30		SPEED LIMIT 45 11/18/14	5.00								1		14.00 X									INSTALL 100 FT EAST OF INTERSECTION	X		
EB	2.287	A/B	D3-1	UNK.	UNK.		TRACY RD 11/18/14						1		X														
EB	2.289	C	VR-017	24	30								1		X														
		C	VR-017	24	30		LEGAL LOAD LIMIT 24,000 POUNDS 11/18/14	5.00								1		13.25 X									TRACY RD (TH-1)		10	
EB	2.299	D	R1-1	30	30								1		X			12.50											
		A/B	D3-1	36	12		Tracy Rd	3.00								1		X									TRACY RD (TH-1); MOUNT TO STOP SIGN WITH BRACKET		14	
		D	R1-1	30	30		STOP	6.25																			TRACY RD (TH-1)	X		
EB	2.343	A	R2-1	24	30		SPEED LIMIT 45	5.00		1				X															
EB	2.440	A	VD-062AL	72	16		BUSINESS SIGN			1				X															
		A	VD-062B	72	16		BUSINESS SIGN			1																			
EB	2.559	A	W3-5	36	36		SPEED REDUCTION SPEED LIMIT 35			1				X															
EB	2.597	A	VD-018	30	18		SOUTH HERO I-8911			1				X															
							SHEET TOTALS	~~30.50~~ 25.50	0.00	6	0	0	4	0	0	3		~~51.75~~ 45.0		0	0.0	0.0	0.0	0.0					
								SF	SF	EA	EA	EA	EA	EA	EA	EA		FT		EA	LB	LB	LB	LB					
							TOWN DIRECTIONAL TOTALS	257.0	0.0	48	9	9	57	0	0	29		435.0		0	0.0								

SIGN SUMMARY SHEET

VERMONT AGENCY OF TRANSPORTATION

PROJECT NAME: ALBURGH-COLCHESTER
PROJECT NUMBER: STPG SIGN(45)

FILE NAME: 7 SOUTH HERO US2 EB TSS.xls
PROJECT MANAGER: D. BRYANT
DESIGNED BY: B. TOOTHAKER
SOUTH HERO EB SHEET 4

PLOT DATE: 3/14/2014
DRAWN BY: J. BLANCHARD
CHECKED K. KERN
SHEET 110 OF 167

DIRECTION	MILEPOINT	LOCATION CODE (SHEET 2)	SIGN CODE	WIDTH (IN)	HEIGHT (IN)	SHEETING REMARKS	SIGN LEGEND	NEW SIGNS "A"	NEW SIGNS "B"	EXISTING SIGNS RETAIN	EXISTING SIGNS SALVAGE FROM	EXISTING SIGNS SALVAGE TO	EXISTING SIGNS REMOVE	EXIST POST RETAIN	EXIST POST REMOVE	NUMBER OF NEW POSTS	SQUARE STEEL (IN) 1.75 (LB/FT) 1.88	SQUARE STEEL (IN) 2.00 (LB/FT) 2.42	SQUARE STEEL (IN) 2.50 (LB/FT) 3.35	TUBULAR STEEL Ø (IN) FOUNDATION	TUBULAR STEEL Ø (IN) 3.00 (LB/FT) 7.60	TUBULAR STEEL Ø (IN) 3.50 (LB/FT) 9.00	TUBULAR STEEL Ø (IN) 4.00 (LB/FT) 10.80	TUBULAR STEEL Ø (IN) 5.00 (LB/FT) 14.60	SIGN FRAME REQUIRED	REMARKS	SIGN DETAIL LOCATION SHSM	SIGN DETAIL LOCATION PROJECT SHEET #	SIGN DETAIL LOCATION STANDARD SHEET #
SOUTH HERO US-2 EB							FY-FLUORESCENT YELLOW FYG-FLUORESCENT YELLOW GREEN																				"SHSM"-STANDARD HIGHWAY SIGNS AND MARKINGS			
EB	2.633	C	VR-017	24	30								1		X														
		C	VR-017	24	30		 11/18/14	5.00								1		13.75 X								TRACY RD (TH-4)		10	
EB	2.634	A/B	D3-1	UNK.	UNK.		TRACY RD 11/18/14						1		X														
EB	2.643	D	R1-1	30	30								1	X															
		A/B	D3-1	36	12		 11/18/14	3.00										13.75								TRACY RD (TH-4); MOUNT TO STOP SIGN WITH BRACKET		14	
		D	R1-1	30	30			6.25								1										TRACY RD (TH-4)	X		
EB	2.659	A	R2-1	24	30		SPEED LIMIT 35	5.00		1				X															
EB	2.711	A	VD-062B	72	16		BUSINESS SIGN			1				X															
		A	VD-062B	72	16		BUSINESS SIGN			1																			
		A	VD-062AL	72	16		BUSINESS SIGN			1																			
EB	2.912	A	W11-8	30	30		11/18/14						1		X			13.75											
		A	W11-8	30	30			6.25								1		X									X		
EB	2.934	A	R2-1	24	30		11/18/14						1		X			13.00											
		A	R2-1	24	30			5.00								1		X									X		
EB	2.984	A	W11-2	30	30								1	X															
SIGN SUMMARY SHEET							SHEET TOTALS	~~30.50~~ 25.50 SF	0.00 SF	4 EA	0 EA	0 EA	6 EA	0 EA	0 EA	3 EA		~~54.25~~ 45.0 FT		0 EA	0.0 LB	0.0 LB	0.0 LB	0.0 LB					
VERMONT AGENCY OF TRANSPORTATION							TOWN DIRECTIONAL TOTALS	257.0	0.0	48	9	9	57	0	0	29		435.0		0	0.0								

PROJECT NAME: ALBURGH-COLCHESTER
PROJECT NUMBER: STPG SIGN(45)
FILE NAME: 7 SOUTH HERO US2 EB TSS.xls
PROJECT MANAGER: D. BRYANT
DESIGNED BY: B. TOOTHAKER
SOUTH HERO EB SHEET 5
PLOT DATE: 3/14/2014
DRAWN BY: J. BLANCHARD
CHECKED K. KERN
SHEET 111 OF 167

DIRECTION	MILEPOINT	LOCATION CODE (SHEET 2)	SIGN CODE	WIDTH (IN)	HEIGHT (IN)	SHEETING REMARKS	SIGN LEGEND	NEW SIGNS "A"	NEW SIGNS "B"	EXISTING SIGNS RETAIN	EXISTING SIGNS SALVAGE FROM	EXISTING SIGNS SALVAGE TO	EXISTING SIGNS REMOVE	EXIST POST RETAIN	EXIST POST REMOVE	NUMBER OF NEW POSTS	SQUARE STEEL (IN) 1.75 (LB/FT) 1.88	SQUARE STEEL (IN) 2.00 (LB/FT) 2.42	SQUARE STEEL (IN) 2.50 (LB/FT) 3.35	TUBULAR STEEL Ø (IN) FOUNDATION	TUBULAR STEEL Ø (IN) 3.00 (LB/FT) 7.60	TUBULAR STEEL Ø (IN) 3.50 (LB/FT) 9.00	TUBULAR STEEL Ø (IN) 4.00 (LB/FT) 10.80	TUBULAR STEEL Ø (IN) 5.00 (LB/FT) 14.60	SIGN FRAME REQUIRED	REMARKS	SIGN DETAIL LOCATION SHSM	SIGN DETAIL LOCATION PROJECT SHEET #	SIGN DETAIL LOCATION STANDARD SHEET #
SOUTH HERO US-2 EB							FY-FLUORESCENT YELLOW FYG-FLUORESCENT YELLOW GREEN																				"SHSM"-STANDARD HIGHWAY SIGNS AND MARKINGS			
		A	W16-9P	24	12								1																
		A	W11-2	30	30	FYG	 11/18/14	6.25								1		14.50									X		
		A	W16-9P	24	12	FYG		2.00																			X		
EB	3.036	A	D1-1E	72	10		11/18/14						1	X				10.50 10.50											
		A	VD1-1	72	12			6.00								2												8	
EB	3.053	A	R8-3A	24	24		NO PARKING SYMBOL			1				X															
		A	VR-644P	24	12		BEGIN PARKING			1																			
EB	3.070	A	W16-7	24	12								1	X															
		A	W11-2	30	30		PEDESTRIAN SYMBOL 11/18/14						1																	
		A	S2-1	30	30	FYG		6.25																			X		
		A	W16-7PL	24	12	FYG		2.00																			X		
EB	3.075	C	VR-017	24	30		11/18/14						1		X			12.50											
		C	VR-017	24	30			5.00								1		X									SOUTH ST (TH-2)		10	
EB	3.085	D	R1-1	30	30		11/18/14						1	~~X~~				13.00											
		A/B	D3-1	UNK.	UNK.								1																
SIGN SUMMARY SHEET							SHEET TOTALS	27.50	0.00	2	0	0	7	0	0	1		~~15.0~~ 61.00		0	0.0	0.0	0.0	0.0					
								SF	SF	EA	EA	EA	EA	EA	EA	EA		FT		EA	LB	LB	LB	LB					
VERMONT AGENCY OF TRANSPORTATION							TOWN DIRECTIONAL TOTALS	257.0	0.0	48	9	9	57	0	0	29		435.0		0	0.0								

PROJECT NAME: ALBURGH-COLCHESTER
PROJECT NUMBER: STPG SIGN(45)

FILE NAME: 7 SOUTH HERO US2 EB TSS.xls PLOT DATE: 3/14/2014
PROJECT MANAGER: D. BRYANT DRAWN BY: J. BLANCHARD
DESIGNED BY: B. TOOTHAKER CHECKED K. KERN
SOUTH HERO EB SHEET 6 SHEET 112 OF 167

DIRECTION	MILEPOINT	LOCATION CODE (SHEET 2)	SIGN CODE	WIDTH (IN)	HEIGHT (IN)	SHEETING REMARKS	SIGN LEGEND	NEW SIGNS "A"	NEW SIGNS "B"	EXISTING SIGNS RETAIN	EXISTING SIGNS SALVAGE FROM	EXISTING SIGNS SALVAGE TO	EXISTING SIGNS REMOVE	EXIST POST RETAIN	EXIST POST REMOVE	NUMBER OF NEW POSTS	SQUARE STEEL (IN) 1.75 (LB/FT) 1.88	SQUARE STEEL (IN) 2.00 (LB/FT) 2.42	SQUARE STEEL (IN) 2.50 (LB/FT) 3.35	TUBULAR STEEL Ø (IN) FOUNDATION	TUBULAR STEEL Ø (IN) 3.00 (LB/FT) 7.60	TUBULAR STEEL Ø (IN) 3.50 (LB/FT) 9.00	TUBULAR STEEL Ø (IN) 4.00 (LB/FT) 10.80	TUBULAR STEEL Ø (IN) 5.00 (LB/FT) 14.60	SIGN FRAME REQUIRED	REMARKS	SIGN DETAIL LOCATION SHSM	SIGN DETAIL LOCATION PROJECT SHEET #	SIGN DETAIL LOCATION STANDARD SHEET #
SOUTH HERO US-2 EB							FY-FLUORESCENT YELLOW FYG-FLUORESCENT YELLOW GREEN																				"SHSM"-STANDARD HIGHWAY SIGNS AND MARKINGS			
		A/B	D3-1	36	12		South St 11/18/14	3.00																			SOUTH ST (TH-2); MOUNT TO STOP SIGN WITH BRACKET		14	
		D	R1-1	30	30		STOP	6.25																			SOUTH ST (TH-2)	X		
EB	3.089	A	R8-3A	24	24		NO PARKING SYMBOL			1				X															
		A	M4-6P	24	12		END PARKING			1																			
EB	3.099	A	M3-2	24	12								1		X														
		A	M1-4	18	18								1					13.50											
		A	M3-2	24	12	BLK/WHT	EAST 2	2.00								1		X										X		
		A	M1-4	24	24	BLK/WHT	11/18/14	4.00																				X		
EB	3.167	A	R2-1	24	30		11/18/14						1		X														
		A	R2-1	24	30		SPEED LIMIT 40	5.00								1		X										X		
EB	3.239	A	UNK.	UNK.	UNK.		ROAD TEST 501004			1				X															
EB	3.306	A	R2-1	24	30								1		X														
		A	R2-1	24	30		11/18/14 SPEED LIMIT 50	5.00								1		X										X		
EB	3.722	A	R4-6	24	30		TRUCK LANE 500 FEET			1				X															
EB	3.800	A	VD-062B	72	16		BUSINESS SIGN			1				X															
SIGN SUMMARY SHEET							SHEET TOTALS	25.25	0.00	5	0	0	4	0	0	3		41.50 ~~45.0~~		0	0.0	0.0	0.0	0.0					
								SF	SF	EA	EA	EA	EA	EA	EA	EA		FT		EA	LB	LB	LB	LB					
VERMONT AGENCY OF TRANSPORTATION							TOWN DIRECTIONAL TOTALS	257.0	0.0	48	9	9	57	0	0	29		435.0		0		0.0							

PROJECT NAME: ALBURGH-COLCHESTER
PROJECT NUMBER: STPG SIGN(45)
FILE NAME: 7 SOUTH HERO US2 EB TSS.xls PLOT DATE: 3/14/2014
PROJECT MANAGER: D. BRYANT DRAWN BY: J. BLANCHARD
DESIGNED BY: B. TOOTHAKER CHECKED K. KERN
SOUTH HERO EB SHEET 7 SHEET 113 OF 167

DIRECTION	MILEPOINT	LOCATION CODE (SHEET 2)	SIGN CODE	WIDTH (IN)	HEIGHT (IN)	SHEETING REMARKS	SIGN LEGEND •ADDED SIGNS FOR TURN LANE	NEW SIGNS "A"	NEW SIGNS "B"	EXISTING SIGNS RETAIN	EXISTING SIGNS SALVAGE FROM	EXISTING SIGNS SALVAGE TO	EXISTING SIGNS REMOVE	EXIST POST RETAIN	EXIST POST REMOVE	NUMBER OF NEW POSTS	SQUARE STEEL (IN) 1.75 (LB/FT) 1.88	SQUARE STEEL (IN) 2.00 (LB/FT) 2.42	SQUARE STEEL (IN) 2.50 (LB/FT) 3.35	FOUNDATION	TUBULAR STEEL Ø (IN) 3.00 (LB/FT) 7.60	TUBULAR STEEL Ø (IN) 3.50 (LB/FT) 9.00	TUBULAR STEEL Ø (IN) 4.00 (LB/FT) 10.80	TUBULAR STEEL Ø (IN) 5.00 (LB/FT) 14.60	SIGN FRAME REQUIRED	REMARKS	SIGN DETAIL LOCATION SHSM	SIGN DETAIL LOCATION PROJECT SHEET #	SIGN DETAIL LOCATION STANDARD SHEET #
SOUTH HERO US-2 EB							FY-FLUORESCENT YELLOW EB 3.404 TRUCK LANE FYG-FLUORESCENT YELLOW GREEN 42X42 ½MILE	12.25					1					15.75 16.25									"SHSM"-STANDARD HIGHWAY SIGNS AND MARKINGS			
EB	3.865	A	R4-3	24	30		SLOWER TRAFFIC KEEP RIGHT EB 3.865 SLOWER TRAFFIC 24X30 KEEP RIGHT	5.00		1			1 2	X				16.00											
EB	3.893	A	W16-1	18	18		NEW SHARE THE ROAD EB 3.963 36X36 36X36 KIBBE POINT	9.00 9.00		1			2	X				17.00 15.75											
		A	W11-1	24	24		NEW BICYCLE SYMBOL EB 3.983 48X30	10.00		1			1					17.75 17.00											
EB	3.965	A	W2-2L	30	30		LEFT SIDE ROAD EB 4.129 30X30 24X18	6.25 3.00		1			2	X				17.00											
	+ STOP & LLL	A	W16-8A	36	12		KIBBE POINT RD EB 4.259 NEW 36X36	9.00		1			2 1					15.00 15.75											
EB	4.093	A	W4-2R	36	36		RIGHT LANE REDUCTION WB 4.418 36X36	9.00		1				X				16.00 15.50											
EB	4.121	A	W7-3A	24	18		NEXT 1/2 MILE WB 4.251 36X36 36X8 KIBBE POINT	9.00 2.00		1			2	X				15.25 16.00											
		A	W11-3A	30	30		DEER CROSSING 24X30	5.00		1								16.00											
EB	4.253	A	W16-1	18	18		SHARE THE ROAD			1				X															
		A	W11-1	24	24		BICYCLE SYMBOL			1																			
EB	4.362	A	VR-186E	24	30		TRUCK LANE ENDS			1				X															
EB	4.600	A	VD-062AS	72	16		BUSINESS SIGN			1				X															
EB	4.614	C	VR-017	24	30		11/19/14						1		X			13.75											
		C	VR-017	24	30		LEGAL LOAD LIMIT 24,000 POUNDS	5.00								1		X									PETERS FARM RD (TH-23)		10	
EB	4.622	D	R1-1	30	30		11/19/14						1	X															
SIGN SUMMARY SHEET							SHEET TOTALS	~~93.50~~ 5.00	0.00	12	0	0	~~16~~ 2	0	0	1		~~255.75~~ 15.0		0	0.0	0.0	0.0	0.0					
								SF	SF	EA	EA	EA	EA	EA	EA	EA		FT		EA	LB	LB	LB	LB					
VERMONT AGENCY OF TRANSPORTATION							TOWN DIRECTIONAL TOTALS	257.0	0.0	48	9	9	57	0	0	29		435.0		0	0.0								

PROJECT NAME: ALBURGH-COLCHESTER
PROJECT NUMBER: STPG SIGN(45)

FILE NAME: 7 SOUTH HERO US2 EB TSS.xls PLOT DATE: 3/14/2014
PROJECT MANAGER: D. BRYANT DRAWN BY: J. BLANCHARD
DESIGNED BY: B. TOOTHAKER CHECKED K. KERN
SOUTH HERO EB SHEET 8 SHEET 114 OF 167

DIRECTION	MILEPOINT	LOCATION CODE (SHEET 2)	SIGN CODE	WIDTH (IN)	HEIGHT (IN)	SHEETING REMARKS	SIGN LEGEND	NEW SIGNS "A"	NEW SIGNS "B"	EXISTING SIGNS RETAIN	EXISTING SIGNS SALVAGE FROM	EXISTING SIGNS SALVAGE TO	EXISTING SIGNS REMOVE	EXIST POST RETAIN	EXIST POST REMOVE	NUMBER OF NEW POSTS	SQUARE STEEL (IN) 1.75 (LB/FT) 1.88	SQUARE STEEL (IN) 2.00 (LB/FT) 2.42	SQUARE STEEL (IN) 2.50 (LB/FT) 3.35	TUBULAR STEEL Ø (IN) FOUNDATION	TUBULAR STEEL Ø (IN) 3.00 (LB/FT) 7.60	TUBULAR STEEL Ø (IN) 3.50 (LB/FT) 9.00	TUBULAR STEEL Ø (IN) 4.00 (LB/FT) 10.80	TUBULAR STEEL Ø (IN) 5.00 (LB/FT) 14.60	SIGN FRAME REQUIRED	REMARKS	SIGN DETAIL LOCATION SHSM	SIGN DETAIL LOCATION PROJECT SHEET #	SIGN DETAIL LOCATION STANDARD SHEET #
SOUTH HERO US-2 EB							FY-FLUORESCENT YELLOW FYG-FLUORESCENT YELLOW GREEN																				"SHSM"-STANDARD HIGHWAY SIGNS AND MARKINGS			
		D	R1-1	30	30		STOP 11/19/14	6.25																			PETERS FARM RD (TH-23)	X		
EB	4.622	A/B	D3-1	62	12		Peters Farm Rd	5.17								2		12.00 X 11.25									PETERS FARM RD (TH-23); FIELD LOCATE FOR VISIBILITY FROM ROUTE 2		14	
EB	4.700	A/B	D3-1	UNK.	UNK.		LANDON RD 11/19/14						1		X														
EB	4.703	C	VR-017	24	30								1	X															
		C	VW-258	24	18		DEAF PERSON 11/19/14						1					13.75									LANDON RD (TH-5);			
		C	VR-017	24	30		LEGAL LOAD LIMIT 24,000 POUNDS 11/19/14	5.00																			LANDON RD (TH-5)		10	
EB	4.711	D	R1-1	30	30								1		X			13.50											
		A/B	D3-1	42	12		Landon Rd 11/19/14	3.50								1		X									LANDON RD (TH-5)		14	
		D	R1-1	30	30		STOP	6.25																			LANDON RD (TH-5)	X		
EB	4.763	A	W3-5	48	48		SPEED REDUCTION SPEED LIMIT 40						1		X														
EB	4.801	A	W3-5	36	36		SPEED LIMIT 40	9.00								2		15.75 X 15.25									INSTALL 500 FT WEST OF SPEED LIMIT SIGN	X		
EB	4.896	A	R2-1	36	48								1	X															
		A	R2-1	30	36		SPEED LIMIT 40 11/19/14	7.50																				X		
EB	5.015	A	W7-3A	24	18		12/02/14						1		X														
		A	W11-2	30	30								1																
							SHEET TOTALS	42.67	0.00	0	0	0	8	0	0	5		81.50 ~~75.0~~		0	0.0	0.0	0.0	0.0					
								SF	SF	EA	EA	EA	EA	EA	EA	EA		FT		EA	LB	LB	LB	LB					
							TOWN DIRECTIONAL TOTALS	257.0	0.0	48	9	9	57	0	0	29		203.00 ~~435.0~~		0	0.0								

SIGN SUMMARY SHEET

VERMONT AGENCY OF TRANSPORTATION

PROJECT NAME: ALBURGH-COLCHESTER
PROJECT NUMBER: STPG SIGN(45)

FILE NAME: 7 SOUTH HERO US2 EB TSS.xls
PROJECT MANAGER: D. BRYANT
DESIGNED BY: B. TOOTHAKER
SOUTH HERO EB SHEET 9

PLOT DATE: 3/14/2014
DRAWN BY: J. BLANCHARD
CHECKED K. KERN
SHEET 115 OF 167

DIRECTION	MILEPOINT	LOCATION CODE (SHEET 2)	SIGN CODE	WIDTH (IN)	HEIGHT (IN)	SHEETING REMARKS	SIGN LEGEND	NEW SIGNS "A"	NEW SIGNS "B"	EXISTING SIGNS RETAIN	EXISTING SIGNS SALVAGE FROM	EXISTING SIGNS SALVAGE TO	EXISTING SIGNS REMOVE	EXIST POST RETAIN	EXIST POST REMOVE	NUMBER OF NEW POSTS	SQUARE STEEL (IN) 1.75 (LB/FT) 1.88	SQUARE STEEL (IN) 2.00 (LB/FT) 2.42	SQUARE STEEL (IN) 2.50 (LB/FT) 3.35	TUBULAR STEEL Ø (IN) FOUNDATION	TUBULAR STEEL Ø (IN) 3.00 (LB/FT) 7.60	TUBULAR STEEL Ø (IN) 3.50 (LB/FT) 9.00	TUBULAR STEEL Ø (IN) 4.00 (LB/FT) 10.80	TUBULAR STEEL Ø (IN) 5.00 (LB/FT) 14.60	SIGN FRAME REQUIRED	REMARKS	SIGN DETAIL LOCATION SHSM	SIGN DETAIL LOCATION PROJECT SHEET #	SIGN DETAIL LOCATION STANDARD SHEET #
SOUTH HERO US-2 EB							FY-FLUORESCENT YELLOW FYG-FLUORESCENT YELLOW GREEN																				"SHSM"-STANDARD HIGHWAY SIGNS AND MARKINGS			
		A	W11-2	30	30	FYG		6.25								1		16.00 X								RETAIN FLASHING BEACON SIGN	X		
		A	W7-3aP	24	18	FYG	04/21/15	3.00																			X		
EB	5.049	A	VW-205	30	30		WATCH FOR TURNING VEHICLES			1				X															
EB	5.088	A	W7-3A	24	18								1		X														
		A	W8-5	30	30								1					17.75											
		A	W8-5	30	30		11/20/14	6.25								1		X									X		
		A	W8-5aP	24	12			2.00																					
		A	W7-3aP	24	18			3.00																			X		
EB	5.135	A	R2-1	24	30		11/19/14						1		X			14.00											
		A	R2-1	24	30			5.00								1		X									X		
EB	5.271	A	R2-1	24	30		11/19/14						1	X				14.25											
		A	R2-1	24	30			5.00																			X		
EB	5.381	A	UNK.	UNK.	UNK.		LAKE CHAMPLAIN			1				X															
EB	5.413	A	R2-1	24	30		11/19/14						1		X			17.00											
		A	R3-9cP	30	12	BLK/WHT		2.50								1		X									X		
SIGN SUMMARY SHEET							SHEET TOTALS	33.00	0.00	2	0	0	5	0	0	4		79.00 ~~60.0~~		0	0.0	0.0	0.0	0.0					
								SF	SF	EA	EA	EA	EA	EA	EA	EA		FT		EA	LB	LB	LB	LB					
VERMONT AGENCY OF TRANSPORTATION							TOWN DIRECTIONAL TOTALS	257.0	0.0	48	9	9	57	0	0	29		435.0		0		0.0							

PROJECT NAME: ALBURGH-COLCHESTER
PROJECT NUMBER: STPG SIGN(45)

FILE NAME: 7 SOUTH HERO US2 EB TSS.xls PLOT DATE: 3/14/2014
PROJECT MANAGER: D. BRYANT DRAWN BY: J. BLANCHARD
DESIGNED BY: B. TOOTHAKER CHECKED K. KERN
SOUTH HERO EB SHEET 10 SHEET 116 OF 167

DIRECTION	MILEPOINT	LOCATION CODE (SHEET 2)	SIGN CODE	WIDTH (IN)	HEIGHT (IN)	SHEETING REMARKS	SIGN LEGEND	NEW SIGNS "A"	NEW SIGNS "B"	EXISTING SIGNS RETAIN	EXISTING SIGNS SALVAGE FROM	EXISTING SIGNS SALVAGE TO	EXISTING SIGNS REMOVE	EXIST POST RETAIN	EXIST POST REMOVE	NUMBER OF NEW POSTS	SQUARE STEEL (IN) 1.75 (LB/FT) 1.88	SQUARE STEEL (IN) 2.00 (LB/FT) 2.42	SQUARE STEEL (IN) 2.50 (LB/FT) 3.35	TUBULAR STEEL Ø (IN) FOUNDATION	TUBULAR STEEL Ø (IN) 3.00 (LB/FT) 7.60	TUBULAR STEEL Ø (IN) 3.50 (LB/FT) 9.00	TUBULAR STEEL Ø (IN) 4.00 (LB/FT) 10.80	TUBULAR STEEL Ø (IN) 5.00 (LB/FT) 14.60	SIGN FRAME REQUIRED	REMARKS	SIGN DETAIL LOCATION SHSM	SIGN DETAIL LOCATION PROJECT SHEET #	SIGN DETAIL LOCATION STANDARD SHEET #
SOUTH HERO US-2 EB							FY-FLUORESCENT YELLOW FYG-FLUORESCENT YELLOW GREEN																				"SHSM"-STANDARD HIGHWAY SIGNS AND MARKINGS			
		A	R8-3	24	24		BEGIN (R) 11/19/14	4.00																				X		
		A	R2-1	24	30		SPEED LIMIT 50	5.00																				X		
EB	5.429	A	VR-644P	24	12		BEGIN PARKING 11/19/14						1		X															
		A	R8-3A	24	24		NO PARKING SYMBOL						1																	
EB	5.497	A	R8-3A	24	24								1		X			13.75												
		A	R8-3	24	24		(R) 11/19/14	4.00								1		X										X		
EB	5.628	A	R8-3	24	24		(R) 11/19/14	4.00								1		13.75 X									INSTALL 700 FT WEST OF PREVIOUS SIGN	X		
EB	5.759	A	R8-3A	24	24		11/19/14						1	X																
		A	R8-3	24	24		(R)	4.00																				X		

SIGN SUMMARY SHEET

VERMONT AGENCY OF TRANSPORTATION

SHEET TOTALS	21.00	0.00	0	0	0	4	0	0	2	27.50 ~~30.0~~		0	0.0	0.0	0.0	0.0													
	SF	SF	EA	EA	EA	EA	EA	EA	EA	FT		EA	LB	LB	LB	LB													
TOWN DIRECTIONAL TOTALS	~~365.50~~ ~~257.0~~	0.0	48	9	9	71 ~~57~~	0	0	29	793.00 ~~435.0~~		0	0.0																

PROJECT NAME: ALBURGH-COLCHESTER
PROJECT NUMBER: STPG SIGN(45)
FILE NAME: 7 SOUTH HERO US2 EB TSS.xls
PROJECT MANAGER: D. BRYANT
DESIGNED BY: B. TOOTHAKER
SOUTH HERO EB SHEET 11
PLOT DATE: 3/14/2014
DRAWN BY: J. BLANCHARD
CHECKED K. KERN
SHEET 117 OF 167

DIRECTION	MILEPOINT	LOCATION CODE (SHEET 2)	SIGN CODE	WIDTH (IN)	HEIGHT (IN)	SHEETING REMARKS	SIGN LEGEND	NEW SIGNS "A"	NEW SIGNS "B"	EXISTING SIGNS RETAIN	EXISTING SIGNS SALVAGE FROM	EXISTING SIGNS SALVAGE TO	EXISTING SIGNS REMOVE	EXIST POST RETAIN	EXIST POST REMOVE	NUMBER OF NEW POSTS	SQUARE STEEL (IN) 1.75 (LB/FT) 1.88	SQUARE STEEL (IN) 2.00 (LB/FT) 2.42	SQUARE STEEL (IN) 2.50 (LB/FT) 3.35	TUBULAR STEEL Ø (IN) FOUNDATION	TUBULAR STEEL Ø (IN) 3.00 (LB/FT) 7.60	TUBULAR STEEL Ø (IN) 3.50 (LB/FT) 9.00	TUBULAR STEEL Ø (IN) 4.00 (LB/FT) 10.80	TUBULAR STEEL Ø (IN) 5.00 (LB/FT) 14.60	SIGN FRAME REQUIRED	REMARKS	SIGN DETAIL LOCATION SHSM	SIGN DETAIL LOCATION PROJECT SHEET #	SIGN DETAIL LOCATION STANDARD SHEET #
SOUTH HERO US-2 WB							FY-FLUORESCENT YELLOW FYG-FLUORESCENT YELLOW GREEN																			"SHSM"-STANDARD HIGHWAY SIGNS AND MARKINGS			
WB	5.564	F	W3-5	48	48								1	~~X~~				16.00											
		F	W3-5	36	36		 11/19/14	9.00																			X		
WB	5.515	F	W11-2	30	30	FYG	 11/19/14	6.25								1		X 16.00											
		F	W7-3aP	24	18	FYG		3.00																			X		
WB	5.428	F	R2-1	36	48								1	~~X~~				16.00											
		F	R2-1	30	36		 11/19/14	7.50																			X		
WB	5.312	F	R2-1	24	30								1		X														
		F	R2-1	24	30		 11/19/14	5.00								1		13.50 X											
WB	5.246	F	W11-2	30	30		PEDESTRIAN SYMBOL						1		X														
		F	W16-4	24	18		NEXT 600 FT						1																
WB	5.186	F	VW-054R	30	30								1		X														
		F	VW-054R	30	30		 11/19/14	6.25								1		14.25 X											
WB	5.153	F	R8-3A	24	24								1	~~X~~				16.00											
		F	VR-644P	24	12		BEGIN  11/19/14						1																	
		F	R3-9cP	30	12	BLK/WHT		2.50																			X		
SIGN SUMMARY SHEET							SHEET TOTALS	39.50	0.00	0	0	0	8	0	0	3		91.75 45.0		0	0.0	0.0	0.0	0.0					
								SF	SF	EA	EA	EA	EA	EA	EA	EA		FT		EA	LB	LB	LB	LB					
VERMONT AGENCY OF TRANSPORTATION							TOWN DIRECTIONAL TOTALS	317.9	0.0	56	1	1	56	0	0	39		585.0		0	0.0								

PROJECT NAME: ALBURGH-COLCHESTER
PROJECT NUMBER: STPG SIGN(45)
FILE NAME: 8 SOUTH HERO US2 WB TSS.x | PLOT DATE: 3/14/2014
PROJECT MANAGER: D. BRYANT | DRAWN BY: J. BLANCHARD
DESIGNED BY: B. TOOTHAKER | CHECKED K. KERN
SOUTH HERO WB SHEET 1 | SHEET 118 OF 167

DIRECTION	MILEPOINT	LOCATION CODE (SHEET 2)	SIGN CODE	WIDTH (IN)	HEIGHT (IN)	SHEETING REMARKS	SIGN LEGEND	NEW SIGNS "A"	NEW SIGNS "B"	EXISTING SIGNS RETAIN	EXISTING SIGNS SALVAGE FROM	EXISTING SIGNS SALVAGE TO	EXISTING SIGNS REMOVE	EXIST POST RETAIN	EXIST POST REMOVE	NUMBER OF NEW POSTS	SQUARE STEEL (IN) 1.75 (LB/FT) 1.88	SQUARE STEEL (IN) 2.00 (LB/FT) 2.42	SQUARE STEEL (IN) 2.50 (LB/FT) 3.35	TUBULAR STEEL Ø (IN) FOUNDATION	TUBULAR STEEL Ø (IN) 3.00 (LB/FT) 7.60	TUBULAR STEEL Ø (IN) 3.50 (LB/FT) 9.00	TUBULAR STEEL Ø (IN) 4.00 (LB/FT) 10.80	TUBULAR STEEL Ø (IN) 5.00 (LB/FT) 14.60	SIGN FRAME REQUIRED	REMARKS	SIGN DETAIL LOCATION SHSM	SIGN DETAIL LOCATION PROJECT SHEET #	SIGN DETAIL LOCATION STANDARD SHEET #
SOUTH HERO US-2 WB							FY-FLUORESCENT YELLOW FYG-FLUORESCENT YELLOW GREEN																				"SHSM"-STANDARD HIGHWAY SIGNS AND MARKINGS			
		F	R8-3	24	24			4.00																			X		
WB	5.129	F	R2-1	24	30								1		X														
		F	UNK.	UNK.	UNK.		PRIVATE ROAD ACCESS						1					14.25											
		F	R2-1	24	30		SPEED LIMIT 40 11/19/14	5.00								1		X									X		
WB	5.087	F	R8-3A	24	24								1	~~X~~				14.00											
		F	R8-3	24	24		(R)	4.00																			X		
WB	5.009	F	M4-6P	24	12		END PARKING						1		X														
		F	R8-3A	24	24								1																
		F	R3-9dP	30	12	BLK/WHT	END	2.50								1		X 14.75									X		
		F	R8-3	24	24		(R)	4.00																			X		
WB	4.931	F	VD-062AL	72	16		BUSINESS SIGN			1				X															
		F	VD-062AS	72	16		BUSINESS SIGN			1																			
		F	VD-062AL	72	16		BUSINESS SIGN			1																			
WB	4.900	F	R2-1	24	30		11/19/14						1	X				14.50											
		F	R2-1	24	30		SPEED LIMIT 50	5.00																			STRAIGHTEN POST	X		
SIGN SUMMARY SHEET							SHEET TOTALS	24.50	0.00	3	0	0	6	0	0	2		~~30.0~~ 57.50		0	0.0	0.0	0.0	0.0					
								SF	SF	EA	EA	EA	EA	EA	EA	EA		FT		EA	LB	LB	LB	LB					
VERMONT AGENCY OF TRANSPORTATION							TOWN DIRECTIONAL TOTALS	317.9	0.0	56	1	1	56	0	0	39		585.0		0	0.0								

PROJECT NAME: ALBURGH-COLCHESTER
PROJECT NUMBER: STPG SIGN(45)
FILE NAME: 8 SOUTH HERO US2 WB TSS.x
PROJECT MANAGER: D. BRYANT
DESIGNED BY: B. TOOTHAKER
SOUTH HERO WB SHEET 2
PLOT DATE: 3/14/2014
DRAWN BY: J. BLANCHARD
CHECKED K. KERN
SHEET 119 OF 167

DIRECTION	MILEPOINT	LOCATION CODE (SHEET 2)	SIGN CODE	WIDTH (IN)	HEIGHT (IN)	SHEETING REMARKS	SIGN LEGEND	NEW SIGNS "A"	NEW SIGNS "B"	EXISTING SIGNS RETAIN	EXISTING SIGNS SALVAGE FROM	EXISTING SIGNS SALVAGE TO	EXISTING SIGNS REMOVE	EXIST POST RETAIN	EXIST POST REMOVE	NUMBER OF NEW POSTS	SQUARE STEEL (IN) 1.75 (LB / FT) 1.88	SQUARE STEEL (IN) 2.00 (LB / FT) 2.42	SQUARE STEEL (IN) 2.50 (LB / FT) 3.35	TUBULAR STEEL Ø (IN) FOUNDATION	TUBULAR STEEL Ø (IN) 3.00 (LB / FT) 7.60	TUBULAR STEEL Ø (IN) 3.50 (LB / FT) 9.00	TUBULAR STEEL Ø (IN) 4.00 (LB / FT) 10.80	TUBULAR STEEL Ø (IN) 5.00 (LB / FT) 14.60	SIGN FRAME REQUIRED	REMARKS	SIGN DETAIL LOCATION SHSM	SIGN DETAIL LOCATION PROJECT SHEET #	SIGN DETAIL LOCATION STANDARD SHEET #
SOUTH HERO US-2 WB							FY-FLUORESCENT YELLOW FYG-FLUORESCENT YELLOW GREEN																			"SHSM"-STANDARD HIGHWAY SIGNS AND MARKINGS			
WB	4.821	F	W16-1	18	18								1		X														
		F	W11-1	24	24								1																
		F	VD-503	12	18		CHAMPLAIN BIKEWAY						1																
		F	M6-1	12	9		GREEN ARROW						1																
		F	W11-1	30	30		 12/02/14	6.25								1			16.50 X							X		
		F	W16-1P	18	24		 12/02/14	3.00																		X		
WB	4.766	F	R4-6	24	30		TRUCK LANE 500 FEET			1				X														
WB	4.738	F	VR-921L	30	30		LEFT "ONLY"/THRU			1				X														
WB	4.721	F	R3-7L	30	30		LEFT LANE MUST TURN LEFT			1				X														
WB	4.656	F	R4-3	24	30		SLOWER TRAFFIC KEEP RIGHT			1				X														
WB	4.618	F	W11-3	30	30		 11/20/14	6.25								1		16.25 X									INSTALL 200 FT WEST OF SLOWER TRAFFIC KEEP RIGHT SIGN	X		
		F	W7-3aP	24	18			3.00																				X		
WB	4.368	F	W16-1	18	18		SHARE THE ROAD			1				X														
		F	W11-1	24	24		BICYCLE SYMBOL			1																		
WB	4.225	F	W2-2R	36	36		RIGHT SIDE ROAD			1				X														
SIGN SUMMARY SHEET							SHEET TOTALS	18.50	0.00	7	0	0	4	0	0	2		32.75 ~~30.0~~		0	0.0	0.0	0.0	0.0					
								SF	SF	EA	EA	EA	EA	EA	EA	EA		FT		EA	LB	LB	LB	LB					
VERMONT AGENCY OF TRANSPORTATION							TOWN DIRECTIONAL TOTALS	317.9	0.0	56	1	1	56	0	0	39		585.0		0	0.0								

PROJECT NAME: **ALBURGH-COLCHESTER**
PROJECT NUMBER: **STPG SIGN(45)**

FILE NAME: **8 SOUTH HERO US2 WB TSS.x** PLOT DATE: **3/14/2014**
PROJECT MANAGER: **D. BRYANT** DRAWN BY: **J. BLANCHARD**
DESIGNED BY: **B. TOOTHAKER** CHECKED **K. KERN**
SOUTH HERO WB SHEET 3 SHEET **120** OF **167**

DIRECTION	MILEPOINT	LOCATION CODE (SHEET 2)	SIGN CODE	WIDTH (IN)	HEIGHT (IN)	SHEETING REMARKS	SIGN LEGEND	NEW SIGNS "A"	NEW SIGNS "B"	EXISTING SIGNS RETAIN	EXISTING SIGNS SALVAGE FROM	EXISTING SIGNS SALVAGE TO	EXISTING SIGNS REMOVE	EXIST POST RETAIN	EXIST POST REMOVE	NUMBER OF NEW POSTS	SQUARE STEEL (IN) 1.75 (LB/FT) 1.88	SQUARE STEEL (IN) 2.00 (LB/FT) 2.42	SQUARE STEEL (IN) 2.50 (LB/FT) 3.35	TUBULAR STEEL Ø (IN) FOUNDATION	TUBULAR STEEL Ø (IN) 3.00 (LB/FT) 7.60	TUBULAR STEEL Ø (IN) 3.50 (LB/FT) 9.00	TUBULAR STEEL Ø (IN) 4.00 (LB/FT) 10.80	TUBULAR STEEL Ø (IN) 5.00 (LB/FT) 14.60	SIGN FRAME REQUIRED	REMARKS	SIGN DETAIL LOCATION SHSM	SIGN DETAIL LOCATION PROJECT SHEET #	SIGN DETAIL LOCATION STANDARD SHEET #
SOUTH HERO US-2 WB							FY-FLUORESCENT YELLOW FYG-FLUORESCENT YELLOW GREEN																				"SHSM"-STANDARD HIGHWAY SIGNS AND MARKINGS			
		F	W16-8A	36	12		KIBBE POINT RD			1																			
WB	4.180	F	VD-062B	72	16		BUSINESS SIGN			1				X															
		F	VD-062B	72	16		BUSINESS SIGN			1																			
WB	4.128	F	W4-2R	36	36		RIGHT LANE REDUCTION			1				X															
WB	4.066	G	VR-017	24	30		11/20/14						1		X			13.75											
		G	VR-017	24	30			5.00								1	X										KIBBE POINT RD (TH-12)		10	
WB	4.057	H	R1-1	30	30								1		X			13.75											
		H	R1-1	30	30		 11/20/14	6.25								1	X										KIBBE POINT RD (TH-12)	X		
WB	4.057	E/F	D3-1	60	12		 11/20/14	5.00								2	11.25 X 11.25										KIBBE POINT RD (TH-12); FIELD LOCATE FOR VISIBILITY FROM ROUTE 2		14	
WB	3.992	F	UNK.	UNK.	UNK.		TRUCK LANE ENDS			1				X															
WB	3.623	F	VD-062AS	72	16		BUSINESS SIGN			1				X															
WB	3.447	F	W3-5	36	36		SPEED REDUCTION SPEED LIMIT 40						1		X															
WB	3.410	F	VD-062B	72	16		BUSINESS SIGN			1				X															
		F	VD-062B	72	16		BUSINESS SIGN			1																			
		F	VD-062B	72	16		BUSINESS SIGN			1																			
							SHEET TOTALS	16.25	0.00	9	0	0	3	0	0	4		50.00 ~~60.0~~		0	0.0	0.0	0.0	0.0					
								SF	SF	EA	EA	EA	EA	EA	EA	EA		FT		EA	LB	LB	LB	LB					
							TOWN DIRECTIONAL TOTALS	317.9	0.0	56	1	1	56	0	0	39		585.0		0		0.0							

SIGN SUMMARY SHEET

VERMONT AGENCY OF TRANSPORTATION

PROJECT NAME: ALBURGH-COLCHESTER
PROJECT NUMBER: STPG SIGN(45)
FILE NAME: 8 SOUTH HERO US2 WB TSS.x
PROJECT MANAGER: D. BRYANT
DESIGNED BY: B. TOOTHAKER
SOUTH HERO WB SHEET 4
PLOT DATE: 3/14/2014
DRAWN BY: J. BLANCHARD
CHECKED K. KERN
SHEET 121 OF 167

DIRECTION	MILEPOINT	LOCATION CODE (SHEET 2)	SIGN CODE	WIDTH (IN)	HEIGHT (IN)	SHEETING REMARKS	SIGN LEGEND	NEW SIGNS "A"	NEW SIGNS "B"	EXISTING SIGNS RETAIN	EXISTING SIGNS SALVAGE FROM	EXISTING SIGNS SALVAGE TO	EXISTING SIGNS REMOVE	EXIST POST RETAIN	EXIST POST REMOVE	NUMBER OF NEW POSTS	SQUARE STEEL (IN) 1.75 (LB/FT) 1.88	SQUARE STEEL (IN) 2.00 (LB/FT) 2.42	SQUARE STEEL (IN) 2.50 (LB/FT) 3.35	TUBULAR STEEL Ø (IN) FOUNDATION	TUBULAR STEEL Ø (IN) 3.00 (LB/FT) 7.60	TUBULAR STEEL Ø (IN) 3.50 (LB/FT) 9.00	TUBULAR STEEL Ø (IN) 4.00 (LB/FT) 10.80	TUBULAR STEEL Ø (IN) 5.00 (LB/FT) 14.60	SIGN FRAME REQUIRED	REMARKS	SIGN DETAIL LOCATION SHSM	SIGN DETAIL LOCATION PROJECT SHEET #	SIGN DETAIL LOCATION STANDARD SHEET #
SOUTH HERO US-2 WB							FY-FLUORESCENT YELLOW FYG-FLUORESCENT YELLOW GREEN																				"SHSM"-STANDARD HIGHWAY SIGNS AND MARKINGS			
WB	3.380	F	W3-5	36	36		 11/20/14	9.00								2		15.00 X 15.75									INSTALL 158 FT WEST OF BUSINESS SIGN ASSEMBLY	X		
WB	3.312	F	R2-1	30	36		SPEED LIMIT 40			1				X															
WB	3.209	F	W16-2	24	18		700 FEET						1		X														
		F	W11-2	30	30		 30x30 24x18	6.25 3.00					1					16.75										
		F	W11-2	30	30	FYG	 11/20/14	6.25								1		15.00 X								REQUIRES VEGETATION CLEARING	X		
		F	W16-9P	24	12	FYG		2.00																				X		
WB	3.171	F	R2-1	30	36		11/20/14						1		X														
		F	R2-1	30	36			7.50								1		13.00 X										X		
WB	3.114	F	D1-1E	72	10		11/20/14						1		X														
		F	VD1-1	72	12			6.00								2		10.75 11.50 X											8	
WB	3.111	F	R3-9aP	30	12		BEGIN						1	X															
		F	R8-3	24	24		11/20/14						1																
		F	R3-9cP	30	12	BLK/ WHT		2.50																			REQUIRES VEGETATION CLEARING	X		
		F	R8-3	24	24			4.00																				X		
WB	3.091	F	R4-18	24	30		DO NOT PASS ON SHOULDER			1				X															
SIGN SUMMARY SHEET							SHEET TOTALS	~~46.50~~ ~~37.25~~	0.00	2	0	0	6	0	0	6		~~97.75~~ ~~90.0~~		0	0.0	0.0	0.0	0.0					
								SF	SF	EA	EA	EA	EA	EA	EA	EA		FT		EA	LB	LB	LB	LB					
VERMONT AGENCY OF TRANSPORTATION							TOWN DIRECTIONAL TOTALS	317.9	0.0	56	1	1	56	0	0	39		585.0		0	0.0								

PROJECT NAME: ALBURGH-COLCHESTER
PROJECT NUMBER: STPG SIGN(45)
FILE NAME: 8 SOUTH HERO US2 WB TSS.x| PLOT DATE: 3/14/2014
PROJECT MANAGER: D. BRYANT DRAWN BY: J. BLANCHARD
DESIGNED BY: B. TOOTHAKER CHECKED K. KERN
SOUTH HERO WB SHEET 5 SHEET 122 OF 167

DIRECTION	MILEPOINT	LOCATION CODE (SHEET 2)	SIGN CODE	WIDTH (IN)	HEIGHT (IN)	SHEETING REMARKS	SIGN LEGEND	NEW SIGNS "A"	NEW SIGNS "B"	EXISTING SIGNS RETAIN	EXISTING SIGNS SALVAGE FROM	EXISTING SIGNS SALVAGE TO	EXISTING SIGNS REMOVE	EXIST POST RETAIN	EXIST POST REMOVE	NUMBER OF NEW POSTS	SQUARE STEEL (IN) 1.75 (LB/FT) 1.88	SQUARE STEEL (IN) 2.00 (LB/FT) 2.42	SQUARE STEEL (IN) 2.50 (LB/FT) 3.35	TUBULAR STEEL Ø (IN) FOUNDATION	TUBULAR STEEL Ø (IN) 3.00 (LB/FT) 7.60	TUBULAR STEEL Ø (IN) 3.50 (LB/FT) 9.00	TUBULAR STEEL Ø (IN) 4.00 (LB/FT) 10.80	TUBULAR STEEL Ø (IN) 5.00 (LB/FT) 14.60	SIGN FRAME REQUIRED	REMARKS	SIGN DETAIL LOCATION SHSM	SIGN DETAIL LOCATION PROJECT SHEET #	SIGN DETAIL LOCATION STANDARD SHEET #
SOUTH HERO US-2 WB							FY-FLUORESCENT YELLOW FYG-FLUORESCENT YELLOW GREEN																			"SHSM"-STANDARD HIGHWAY SIGNS AND MARKINGS			
WB	3.088	G	VR-017	24	30								1		X														
		G	R1-1	24	30		SPEED LIMIT 25 11/20/14				1	1	1														HILL RD (TH-10); SALVAGE AND MOUNT BELOW LLL			
		G	VR-017	24	30			5.00								1										HILL RD (TH-10)		10	
WB	3.077	H	R1-1	30	30								1	X															
		E/F	D3-1	UNK.	UNK.		11/20/14						1																
		E/F	D3-1	28	12			2.33																		HILL RD (TH-10); MOUNT TO STOP SIGN WITH BRACKET		14	
		H	R1-1	30	30			6.25																		HILL RD (TH-10)	X		
WB	3.075	F	W11-2	30	30		PEDESTRIAN SYMBOL 11/20/14						1	X															
		F	W16-7	24	12								1																
		F	S1-1	36	36	FYG		9.00								1		14.25									X		
		F	W16-7P	24	12	FYG		2.00																			X		
WB	3.061	F	M4-6P	24	12		END PARKING			1				X															
		F	R8-3A	24	24		NO PARKING SYMBOL			1																			
WB	3.046	F	W11-8	30	30		11/20/14						1		X														
		F	W11-8	30	30			6.25								1		X									X		
SIGN SUMMARY SHEET							SHEET TOTALS	30.83	0.00	2	1	1	7	0	0	2		42.25 ~~30.0~~		0	0.0	0.0	0.0	0.0					
								SF	SF	EA	EA	EA	EA	EA	EA	EA		FT		EA	LB	LB	LB	LB					
VERMONT AGENCY OF TRANSPORTATION							TOWN DIRECTIONAL TOTALS	317.9	0.0	56	1	1	56	0	0	39		585.0		0		0.0							

PROJECT NAME: ALBURGH-COLCHESTER
PROJECT NUMBER: STPG SIGN(45)

FILE NAME: 8 SOUTH HERO US2 WB TSS.x | PLOT DATE: 3/14/2014
PROJECT MANAGER: D. BRYANT | DRAWN BY: J. BLANCHARD
DESIGNED BY: B. TOOTHAKER | CHECKED K. KERN
SOUTH HERO WB SHEET 6 | SHEET 123 OF 167

DIRECTION	MILEPOINT	LOCATION CODE (SHEET 2)	SIGN CODE	WIDTH (IN)	HEIGHT (IN)	SHEETING REMARKS	SIGN LEGEND	NEW SIGNS "A"	NEW SIGNS "B"	EXISTING SIGNS RETAIN	EXISTING SIGNS SALVAGE FROM	EXISTING SIGNS SALVAGE TO	EXISTING SIGNS REMOVE	EXIST POST RETAIN	EXIST POST REMOVE	NUMBER OF NEW POSTS	SQUARE STEEL (IN) 1.75 (LB / FT) 1.88	SQUARE STEEL (IN) 2.00 (LB / FT) 2.42	SQUARE STEEL (IN) 2.50 (LB / FT) 3.35	TUBULAR STEEL Ø (IN) FOUNDATION	TUBULAR STEEL Ø (IN) 3.00 (LB / FT) 7.60	TUBULAR STEEL Ø (IN) 3.50 (LB / FT) 9.00	TUBULAR STEEL Ø (IN) 4.00 (LB / FT) 10.80	TUBULAR STEEL Ø (IN) 5.00 (LB / FT) 14.60	SIGN FRAME REQUIRED	REMARKS	SIGN DETAIL LOCATION SHSM	SIGN DETAIL LOCATION PROJECT SHEET #	SIGN DETAIL LOCATION STANDARD SHEET #
SOUTH HERO US-2 WB							FY-FLUORESCENT YELLOW FYG-FLUORESCENT YELLOW GREEN																			"SHSM"-STANDARD HIGHWAY SIGNS AND MARKINGS			
WB	2.991	G	R7-1	24	30								1	X															
		G	R7-1	24	30		NO PARKING ANY TIME ← 11/20/14	5.00																			X		
WB	2.979	G	R7-1	24	30								1	X															
		G	R7-1	24	30		NO PARKING ANY TIME → 11/20/14	5.00																		REQUIRES VEGETATION CLEARING	X		
WB	2.957	F	UNK.	UNK.	UNK.		EMPTY POST IN THIS LOCATION 11/20/14								X			12.25										
		F	R2-1	24	30		SPEED LIMIT 35	5.00								1		X										X		
WB	2.929	F	M3-4	24	12	BLK/ WHT	WEST 11/20/14	2.00								1		X								INSTALL 150 FT WEST OF SPEED LIMIT SIGN	X		
		F	M1-4	24	24	BLK/ WHT	2	4.00										13.25									X		
WB	2.861	F	VD-062B	72	16		BUSINESS SIGN			1				X															
WB	2.598	F	R2-1	24	30								1		X														
		F	R2-1	24	30		SPEED LIMIT 45 11/20/14	5.00								1		13.50 X									X		
WB	2.200	F	W2-2ML	30	30								1		X														
		F	VW-092	30	30		11/20/14						1						13.50										
		F	W2-2L	30	30		12/02/14	6.25								1			X							INSTALL 250 FT EAST OF INTERSECTION	X		
		F	VW-092	30	24		UNSAFE TO PASS 12/02/14	5.00																			NEED INFO		
SIGN SUMMARY SHEET							SHEET TOTALS	37.25	0.00	1	0	0	5	0	0	4		52.50 ~~60.0~~		0	0.0	0.0	0.0	0.0					
								SF	SF	EA	EA	EA	EA	EA	EA	EA		FT		EA	LB	LB	LB	LB					
VERMONT AGENCY OF TRANSPORTATION							TOWN DIRECTIONAL TOTALS	317.9	0.0	56	1	1	56	0	0	39		585.0		0		0.0							

PROJECT NAME: ALBURGH-COLCHESTER
PROJECT NUMBER: STPG SIGN(45)

FILE NAME: 8 SOUTH HERO US2 WB TSS.x
PROJECT MANAGER: D. BRYANT
DESIGNED BY: B. TOOTHAKER
SOUTH HERO WB SHEET 7

PLOT DATE: 3/14/2014
DRAWN BY: J. BLANCHARD
CHECKED K. KERN
SHEET 124 OF 167


DIRECTION	MILEPOINT	LOCATION CODE (SHEET 2)	SIGN CODE	WIDTH (IN)	HEIGHT (IN)	SHEETING REMARKS	SIGN LEGEND	NEW SIGNS "A"	NEW SIGNS "B"	EXISTING SIGNS RETAIN	EXISTING SIGNS SALVAGE FROM	EXISTING SIGNS SALVAGE TO	EXISTING SIGNS REMOVE	EXIST POST RETAIN	EXIST POST REMOVE	NUMBER OF NEW POSTS	SQUARE STEEL (IN) 1.75 (LB/FT) 1.88	SQUARE STEEL (IN) 2.00 (LB/FT) 2.42	SQUARE STEEL (IN) 2.50 (LB/FT) 3.35	TUBULAR STEEL Ø (IN) FOUNDATION	TUBULAR STEEL Ø (IN) 3.00 (LB/FT) 7.60	TUBULAR STEEL Ø (IN) 3.50 (LB/FT) 9.00	TUBULAR STEEL Ø (IN) 4.00 (LB/FT) 10.80	TUBULAR STEEL Ø (IN) 5.00 (LB/FT) 14.60	SIGN FRAME REQUIRED	REMARKS	SIGN DETAIL LOCATION SHSM	SIGN DETAIL LOCATION PROJECT SHEET #	SIGN DETAIL LOCATION STANDARD SHEET #
SOUTH HERO US-2 WB							FY-FLUORESCENT YELLOW FYG-FLUORESCENT YELLOW GREEN																				"SHSM"-STANDARD HIGHWAY SIGNS AND MARKINGS			
WB	2.049	E/F	D3-1	UNK.	UNK.		LAVIGNE RD 11/21/14						1		X												LAVIGNE RD (TH-20)			
WB	2.049	G	VR-017	24	30								1		X															
		G	VR-017	24	30		 11/21/14	5.00								1		12.50 X								LAVIGNE RD (TH-20)		10	
WB	2.044	H	R1-1	30	30								1	X																
		E/F	D3-1	UNK.	UNK.		LAVINE RD						1																	
		G	R1-1	30	30		 11/21/14	6.25								~~1~~		~~X~~								LAVIGNE RD (TH-20)	X		
WB	2.044	F	D3-1	42	12		 11/21/14	3.50								1		10.50 X								LAVIGNE RD (TH-20); FIELD LOCATE FOR VISIBILITY FROM ROUTE 2		14	
WB	2.014	F	R2-1	36	48		11/21/14						1	X																
		F	R2-1	24	30			5.00																					X		
WB	1.821	F	VD-131	48	72								1		X															
		F	VD-131	52	54		 12/18/14	19.50								2		14.25 X 13.25								SLIP BASES		10	
WB	1.777	F	W3-5	36	36		SPEED REDUCTION SPEED LIMIT 35			1				X																
WB	1.682	F	R2-1	30	36		SPEED LIMIT 35			1				X																
WB	1.644	F	VW-619	30	30		 11/21/14	6.25								1		14.50 X								INSTALL 200 FT WEST OF SPEED LIMIT SIGN			
WB	1.610	F	VD-062AS	72	16		BUSINESS SIGN			1				X																
							SHEET TOTALS	45.50	0.00	3	0	0	6	0	0	6		65.00 90.0		0	0.0	0.0	0.0	0.0					
								SF	SF	EA	EA	EA	EA	EA	EA	EA		FT		EA	LB	LB	LB	LB					
							TOWN DIRECTIONAL TOTALS	317.9	0.0	56	1	1	56	0	0	39		585.0		0			0.0						

SIGN SUMMARY SHEET

VERMONT AGENCY OF TRANSPORTATION

PROJECT NAME: ALBURGH-COLCHESTER
PROJECT NUMBER: STPG SIGN(45)

FILE NAME: 8 SOUTH HERO US2 WB TSS.xl | PLOT DATE: 3/14/2014
PROJECT MANAGER: D. BRYANT | DRAWN BY: J. BLANCHARD
DESIGNED BY: B. TOOTHAKER | CHECKED K. KERN
SOUTH HERO WB SHEET 8 | SHEET 125 OF 167

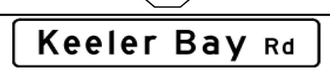DIRECTION	MILEPOINT	LOCATION CODE (SHEET 2)	SIGN CODE	WIDTH (IN)	HEIGHT (IN)	SHEETING REMARKS	SIGN LEGEND	NEW SIGNS "A"	NEW SIGNS "B"	EXISTING SIGNS RETAIN	EXISTING SIGNS SALVAGE FROM	EXISTING SIGNS SALVAGE TO	EXISTING SIGNS REMOVE	EXIST POST RETAIN	EXIST POST REMOVE	NUMBER OF NEW POSTS	SQUARE STEEL (IN) 1.75 (LB/FT) 1.88	SQUARE STEEL (IN) 2.00 (LB/FT) 2.42	SQUARE STEEL (IN) 2.50 (LB/FT) 3.35	TUBULAR STEEL Ø (IN) FOUNDATION	TUBULAR STEEL Ø (IN) 3.00 (LB/FT) 7.60	TUBULAR STEEL Ø (IN) 3.50 (LB/FT) 9.00	TUBULAR STEEL Ø (IN) 4.00 (LB/FT) 10.80	TUBULAR STEEL Ø (IN) 5.00 (LB/FT) 14.60	SIGN FRAME REQUIRED	REMARKS	SIGN DETAIL LOCATION SHSM	SIGN DETAIL LOCATION PROJECT SHEET #	SIGN DETAIL LOCATION STANDARD SHEET #
SOUTH HERO US-2 WB							FY-FLUORESCENT YELLOW FYG-FLUORESCENT YELLOW GREEN																				"SHSM"-STANDARD HIGHWAY SIGNS AND MARKINGS			
		F	VD-062B	72	16		BUSINESS SIGN			1																			
		F	VD-062AL	72	16		BUSINESS SIGN			1																			
WB	1.530	F	VD-062B	72	16		BUSINESS SIGN			1				X															
WB	1.510	F	VW-258	24	18								1		X														
		F	W11-2	30	30								1																
		F	W11-2	30	30	FYG		6.25								1			14.00 X								X		
		F	VW-258	24	18	FYG		3.00																					E-154
WB	1.484	G	VR-017	24	30								1		X														
		G	VR-017	24	30		 11/21/14	5.00								1		14.50 X								KEEELER BAY RD (TH-9)		10	
WB	1.481	F	R2-1	24	30								1	X															
		F	R2-1	24	30			5.00																				X		
WB	1.481	H	R1-1	24	24								1		X														
		E/F	D3-1	UNK.	UNK.		KEELER BAY RD 11/21/14						1																
		H	R1-1	30	30			6.25								1		13.00 X								KEELER BAY RD (TH-9)	X		
WB	1.481	F	D3-1	58	12		 11/21/14	4.83								2		12.00 X 12.75								KEELER BAY RD (TH-9); FIELD LOCATE FOR VISIBILITY FROM ROUTE 2		14	
							SHEET TOTALS	30.33	0.00	3	0	0	6	0	0	5		66.25 ~~75.0~~		0	0.0	0.0	0.0	0.0					
								SF	SF	EA	EA	EA	EA	EA	EA	EA		FT		EA	LB	LB	LB	LB					
							TOWN DIRECTIONAL TOTALS	317.9	0.0	56	1	1	56	0	0	39		585.0		0		0.0							

SIGN SUMMARY SHEET

VERMONT AGENCY OF TRANSPORTATION

PROJECT NAME: ALBURGH-COLCHESTER
PROJECT NUMBER: STPG SIGN(45)
FILE NAME: 8 SOUTH HERO US2 WB TSS.x
PROJECT MANAGER: D. BRYANT
DESIGNED BY: B. TOOTHAKER
SOUTH HERO WB SHEET 9
PLOT DATE: 3/14/2014
DRAWN BY: J. BLANCHARD
CHECKED K. KERN
SHEET 126 OF 167

DIRECTION	MILEPOINT	LOCATION CODE (SHEET 2)	SIGN CODE	WIDTH (IN)	HEIGHT (IN)	SHEETING REMARKS	SIGN LEGEND	NEW SIGNS "A"	NEW SIGNS "B"	EXISTING SIGNS RETAIN	EXISTING SIGNS SALVAGE FROM	EXISTING SIGNS SALVAGE TO	EXISTING SIGNS REMOVE	EXIST POST RETAIN	EXIST POST REMOVE	NUMBER OF NEW POSTS	SQUARE STEEL (IN) 1.75 (LB/FT) 1.88	SQUARE STEEL (IN) 2.00 (LB/FT) 2.42	SQUARE STEEL (IN) 2.50 (LB/FT) 3.35	TUBULAR STEEL Ø (IN) FOUNDATION	TUBULAR STEEL Ø (IN) 3.00 (LB/FT) 7.60	TUBULAR STEEL Ø (IN) 3.50 (LB/FT) 9.00	TUBULAR STEEL Ø (IN) 4.00 (LB/FT) 10.80	TUBULAR STEEL Ø (IN) 5.00 (LB/FT) 14.60	SIGN FRAME REQUIRED	REMARKS	SIGN DETAIL LOCATION SHSM	SIGN DETAIL LOCATION PROJECT SHEET #	SIGN DETAIL LOCATION STANDARD SHEET #
SOUTH HERO US-2 WB							FY-FLUORESCENT YELLOW FYG-FLUORESCENT YELLOW GREEN																				"SHSM"-STANDARD HIGHWAY SIGNS AND MARKINGS			
WB	1.477	H	R1-1	30	30								1		X														
		H	R1-1	30	30		STOP 11/21/14	6.25								1		14.00 X									KEELER BAY RD (TH-9); MOUNT IN CENTER ISLAND; REQUIRES VEGETATION CLEARING	X		
WB	1.390	F	VD-062AS	72	16		BUSINESS SIGN			1				X															
		F	VD-062AL	72	16		BUSINESS SIGN			1																				
WB	1.367	F	R2-1	24	30								1	~~X~~				14.00												
		F	R2-1	24	30		SPEED LIMIT 35 11/21/14	5.00																				X		
WB	1.285	F	VW-205	30	30		WATCH FOR TURNING VEHICLES			1				X																
WB	1.246	F	M2-1	21	15		JCT STATE			1				X																
		F	M1-5	30	24		VERMONT 314			1																				
WB	1.222	F	D1-1A	72	12		^UP CANADA 26			1				X																
		F	D1-1A	72	12		^UP ROUSE'S POINT NY 28			1																				
		F	VD1-1M	72	12		<--- NY STATE VIA FERRY 2			1																				
		F	VD1-1G	72	12		<--- L CHAMPLAIN ISLANDS			1																				
WB	1.206	F	VR-731	24	12		AT INTERSECTIONS			1				X																
		F	VW16-18P	24	12		STATE LAW PLAQUE			1																				
SIGN SUMMARY SHEET							SHEET TOTALS	11.25	0.00	11	0	0	2	0	0	1		~~28.00~~ 15.0		0	0.0	0.0	0.0	0.0					
								SF	SF	EA	EA	EA	EA	EA	EA	EA		FT		EA	LB	LB	LB	LB					
VERMONT AGENCY OF TRANSPORTATION							TOWN DIRECTIONAL TOTALS	317.9	0.0	56	1	1	56	0	0	39		585.0		0	0.0								

PROJECT NAME: ALBURGH-COLCHESTER
PROJECT NUMBER: STPG SIGN(45)
FILE NAME: 8 SOUTH HERO US2 WB TSS.xl PLOT DATE: 3/14/2014
PROJECT MANAGER: D. BRYANT DRAWN BY: J. BLANCHARD
DESIGNED BY: B. TOOTHAKER CHECKED K. KERN
SOUTH HERO WB SHEET 10 SHEET 127 OF 167


DIRECTION	MILEPOINT	LOCATION CODE (SHEET 2)	SIGN CODE	WIDTH (IN)	HEIGHT (IN)	SHEETING REMARKS	SIGN LEGEND	NEW SIGNS		EXISTING SIGNS				EXIST POST		NUMBER OF NEW POSTS	SQUARE STEEL (IN)			TUBULAR STEEL Ø (IN)				SIGN FRAME REQUIRED	REMARKS	SIGN DETAIL LOCATION		
								"A"	"B"	RETAIN	SALVAGE FROM	SALVAGE TO	REMOVE	RETAIN	REMOVE		1.75 (LB / FT) 1.88	2.00 (LB / FT) 2.42	2.50 (LB / FT) 3.35	FOUNDATION	3.00 (LB / FT) 7.60	3.50 (LB / FT) 9.00	4.00 (LB / FT) 10.80	5.00 (LB / FT) 14.60			SHSM	PROJECT SHEET #	STANDARD SHEET #
SOUTH HERO US-2 WB							FY-FLUORESCENT YELLOW FYG-FLUORESCENT YELLOW GREEN																		"SHSM"-STANDARD HIGHWAY SIGNS AND MARKINGS			
		F	R4-18	24	30		DO NOT PASS ON SHOULDER			1																	
WB	1.177	F	M3-1	24	12		NORTH STATE			1				X													
		F	M3-4	24	12		WEST US			1																	
		F	M1-4	24	24		US 2			1																	
		F	M1-5	30	24		VERMONT 314			1																	
		F	M6-3	21	15		^UP ARROW US			1																	
		F	M6-1	21	15		<--- LEFT STATE			1																	
WB	1.155	G	W1-7	48	24		<===> DOUBLE ARROW			1				X													
WB	1.114	F	M1-4	24	24		US 2			1				X													
		F	M3-4	24	12		WEST US			1																	
WB	1.080	F	D1-1a	72	12		^UP CANADA 26			1				X													
		F	D1-1a	72	12		^UP GRAND ISLE 3			1																	
		F	D1-1a	72	12		^UP ALBURGH 24			1																	
		F	D1-1a	72	12		^UP ROUSES POINT NY 28			1																	
WB	1.050	F	R2-1	24	30		SPEED LIMIT 40			1				X													
							SHEET TOTALS	0.00 SF	0.00 SF	15 EA	0 EA	0 EA	0 EA	0 EA	0 EA	0 EA	0.0 FT			0 EA	0.0 LB	0.0 LB	0.0 LB	0.0 LB					
							TOWN DIRECTIONAL TOTALS	317.9	0.0	56	1	1	56	0	0	39	585.0			0	0.0									

SIGN SUMMARY SHEET

VERMONT AGENCY OF TRANSPORTATION

PROJECT NAME: ALBURGH-COLCHESTER
PROJECT NUMBER: STPG SIGN(45)

FILE NAME: 8 SOUTH HERO US2 WB TSS.x| PLOT DATE: 3/14/2014
PROJECT MANAGER: D. BRYANT DRAWN BY: J. BLANCHARD
DESIGNED BY: B. TOOTHAKER CHECKED K. KERN
SOUTH HERO WB SHEET 11 SHEET 128 OF 167

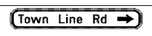DIRECTION	MILEPOINT	LOCATION CODE (SHEET 2)	SIGN CODE	WIDTH (IN)	HEIGHT (IN)	SHEETING REMARKS	SIGN LEGEND	NEW SIGNS "A"	NEW SIGNS "B"	EXISTING SIGNS RETAIN	EXISTING SIGNS SALVAGE FROM	EXISTING SIGNS SALVAGE TO	EXISTING SIGNS REMOVE	EXIST POST RETAIN	EXIST POST REMOVE	NUMBER OF NEW POSTS	SQUARE STEEL (IN) 1.75 (LB / FT) 1.88	SQUARE STEEL (IN) 2.00 (LB / FT) 2.42	SQUARE STEEL (IN) 2.50 (LB / FT) 3.35	TUBULAR STEEL Ø (IN) FOUNDATION	TUBULAR STEEL Ø (IN) 3.00 (LB / FT) 7.60	TUBULAR STEEL Ø (IN) 3.50 (LB / FT) 9.00	TUBULAR STEEL Ø (IN) 4.00 (LB / FT) 10.80	TUBULAR STEEL Ø (IN) 5.00 (LB / FT) 14.60	SIGN FRAME REQUIRED	REMARKS	SIGN DETAIL LOCATION SHSM	SIGN DETAIL LOCATION PROJECT SHEET #	SIGN DETAIL LOCATION STANDARD SHEET #
SOUTH HERO US-2 WB							FY-FLUORESCENT YELLOW FYG-FLUORESCENT YELLOW GREEN																				"SHSM"-STANDARD HIGHWAY SIGNS AND MARKINGS			
WB	0.917	F	R2-1	24	30								1		X			14.50											
		F	R2-1	24	30		 11/21/14	5.00								1		X										X		
WB	0.602	F	W11-1	30	30								1		X			16.50											
		F	W11-1	30	30		 11/21/14	6.25								1		X										X		
WB	0.134	F	VW-060	30	30								1	X				15.00											
		F	VW-060	30	30		 11/21/14	6.25																		REQUIRES VEGETATION CLEARING			E-154
WB	0.047	F	W2-2R	30	30		 11/21/14	6.25								2		15.50 X 15.75									INSTALL 250 FT EAST OF TOWN LINE RD	X		
		F	W16-8A	48	9			3.00																					7	
SIGN SUMMARY SHEET							SHEET TOTALS	26.75	0.00	0	0	0	3	0	0	4		77.25 ~~60.0~~		0	0.0	0.0	0.0	0.0					
								SF	SF	EA	EA	EA	EA	EA	EA	EA		FT		EA	LB	LB	LB	LB					
VERMONT AGENCY OF TRANSPORTATION							TOWN DIRECTIONAL TOTALS	~~327.16~~ 317.9	0.0	56	1	1	56	0	0	39		~~661.00~~ ~~585.0~~		0	0.0								

PROJECT NAME: **ALBURGH-COLCHESTER**
PROJECT NUMBER: **STPG SIGN(45)**
FILE NAME: **8 SOUTH HERO US2 WB TSS.x** PLOT DATE: **3/14/2014**
PROJECT MANAGER: **D. BRYANT** DRAWN BY: **J. BLANCHARD**
DESIGNED BY: **B. TOOTHAKER** CHECKED **K. KERN**
SOUTH HERO WB SHEET 12 SHEET **129** OF **167**

DIRECTION	MILEPOINT	LOCATION CODE (SHEET 2)	SIGN CODE	WIDTH (IN)	HEIGHT (IN)	SHEETING REMARKS	SIGN LEGEND	NEW SIGNS "A"	NEW SIGNS "B"	EXISTING SIGNS RETAIN	EXISTING SIGNS SALVAGE FROM	EXISTING SIGNS SALVAGE TO	EXISTING SIGNS REMOVE	EXIST POST RETAIN	EXIST POST REMOVE	NUMBER OF NEW POSTS	SQUARE STEEL (IN) 1.75 (LB/FT) 1.88	SQUARE STEEL (IN) 2.00 (LB/FT) 2.42	SQUARE STEEL (IN) 2.50 (LB/FT) 3.35	TUBULAR STEEL Ø (IN) FOUNDATION	TUBULAR STEEL Ø (IN) 3.00 (LB/FT) 7.60	TUBULAR STEEL Ø (IN) 3.50 (LB/FT) 9.00	TUBULAR STEEL Ø (IN) 4.00 (LB/FT) 10.80	TUBULAR STEEL Ø (IN) 5.00 (LB/FT) 14.60	SIGN FRAME REQUIRED	REMARKS	SIGN DETAIL LOCATION SHSM	SIGN DETAIL LOCATION PROJECT SHEET #	SIGN DETAIL LOCATION STANDARD SHEET #
MILTON US-2 EB							FY-FLUORESCENT YELLOW FYG-FLUORESCENT YELLOW GREEN																				"SHSM"-STANDARD HIGHWAY SIGNS AND MARKINGS			
EB	0.005	G	VD-024	72	10		Milton | South Hero Chittenden Co | Grand Isle Co	5.00																			INSTALL AT CENTER OF SPAN		7	
		G	VD-025	72	10			5.00								2		X										7	
		G	VD-700	6	10		0020 0410 0000 — 0020 0705 0578	0.42									7.00												E-138
		G	VD-700	6	10			0.42									7.00												E-138
EB	0.070	A	R8-3A	24	24		11/18/14						1		X			13.00											
		A	R8-3	24	24		(R)	4.00								1		X										X	
EB	0.201	A	R8-3A	24	24		11/18/14						1		X			13.50											
		A	R8-3	24	24		(R)	4.00								1		X										X	
EB	0.284	A	D4-1	30	24		11/18/14						1		X			13.25											
		A	D4-1	30	24		PARKING	5.00								1		X										X	
EB	0.374	A	R8-3A	24	24								1	X															
		A	M4-6P	24	12		END 11/18/14						1																
		A	R3-9dP	30	12	BLK/WHT	END	2.50																			STRAIGHTEN POST	X		
		A	R8-3	24	24		(R)	4.00																				X	
EB	0.440	A	R3-9cP	30	12	BLK/WHT	04/22/15	2.50								1		12.50 X									INSTALL 348 FT EAST OF PREVIOUS NO PARKING ASSEMBLY	X		
SIGN SUMMARY SHEET							SHEET TOTALS	32.83	0.00	0	0	0	5	0	0	6		66.25 ~~96.0~~		0	0.0	0.0	0.0	0.0					
								SF	SF	EA	EA	EA	EA	EA	EA	EA		FT		EA	LB	LB	LB	LB					
VERMONT AGENCY OF TRANSPORTATION							TOWN DIRECTIONAL TOTALS	332.1	0.0	2	0	0	42	0	0	32		480.0		0	0.0								

PROJECT NAME: ALBURGH-COLCHESTER
PROJECT NUMBER: STPG SIGN(45)
FILE NAME: 9 MILTON US2 EB TSS.xls
PROJECT MANAGER: D. BRYANT
DESIGNED BY: B. TOOTHAKER
MILTON EB SHEET 1
PLOT DATE: 3/14/2014
DRAWN BY: J. BLANCHARD
CHECKED K. KERN
SHEET 130 OF 167

DIRECTION	MILEPOINT	LOCATION CODE (SHEET 2)	SIGN CODE	WIDTH (IN)	HEIGHT (IN)	SHEETING REMARKS	SIGN LEGEND	NEW SIGNS "A"	NEW SIGNS "B"	EXISTING SIGNS RETAIN	EXISTING SIGNS SALVAGE FROM	EXISTING SIGNS SALVAGE TO	EXISTING SIGNS REMOVE	EXIST POST RETAIN	EXIST POST REMOVE	NUMBER OF NEW POSTS	SQUARE STEEL (IN) 1.75 (LB/FT) 1.88	SQUARE STEEL (IN) 2.00 (LB/FT) 2.42	SQUARE STEEL (IN) 2.50 (LB/FT) 3.35	TUBULAR STEEL Ø (IN) FOUNDATION	TUBULAR STEEL Ø (IN) 3.00 (LB/FT) 7.60	TUBULAR STEEL Ø (IN) 3.50 (LB/FT) 9.00	TUBULAR STEEL Ø (IN) 4.00 (LB/FT) 10.80	TUBULAR STEEL Ø (IN) 5.00 (LB/FT) 14.60	SIGN FRAME REQUIRED	REMARKS	SIGN DETAIL LOCATION SHSM	SIGN DETAIL LOCATION PROJECT SHEET #	SIGN DETAIL LOCATION STANDARD SHEET #
MILTON US-2 EB							FY-FLUORESCENT YELLOW FYG-FLUORESCENT YELLOW GREEN																				"SHSM"-STANDARD HIGHWAY SIGNS AND MARKINGS			
		A	R8-3	24	24		 04/20/14	4.00										14.25									X		
EB	0.522	A	W3-5	48	48								1		X														
		A	W3-5	36	36			9.00								2		X								X		
EB	0.657	A	R2-1	36	48								1	X															
		A	R2-1	30	36			7.50																		X		
EB	0.701	A	W11-2	30	30	FYG		6.25								1		16.00 X								INSTALL 232 FT EAST OF SPEED LIMIT SIGN	X		
		A	W16-9P	24	12	FYG		2.00																		X		
EB	0.773	A	R2-1	24	30								1	X															
		A	R8-3A	24	24								1																
		A	R2-1	24	30			5.00																		X		
		A	R8-3	24	24			4.00																		X		
EB	0.788	A	M4-14	12	6								1	X			17.00												
		A	D1-11	24	18								1																
		A	M4-14	24	12	WHT/GRN		2.00								1		X								X		
		A	D11-1	24	18			3.00																		X		
							SHEET TOTALS	42.75	0.00	0	0	0	6	0	0	4		47.25 ~~60.0~~		0	0.0	0.0	0.0	0.0					
								SF	SF	EA	EA	EA	EA	EA	EA	EA		FT		EA	LB	LB	LB	LB					
							TOWN DIRECTIONAL TOTALS	332.1	0.0	2	0	0	42	0	0	32		480.0		0	0.0								

SIGN SUMMARY SHEET

VERMONT AGENCY OF TRANSPORTATION

PROJECT NAME: ALBURGH-COLCHESTER
PROJECT NUMBER: STPG SIGN(45)

FILE NAME: 9 MILTON US2 EB TSS.xls
PROJECT MANAGER: D. BRYANT
DESIGNED BY: B. TOOTHAKER
MILTON EB SHEET 2

PLOT DATE: 3/14/2014
DRAWN BY: J. BLANCHARD
CHECKED K. KERN
SHEET 131 OF 167

DIRECTION	MILEPOINT	LOCATION CODE (SHEET 2)	SIGN CODE	WIDTH (IN)	HEIGHT (IN)	SHEETING REMARKS	SIGN LEGEND	NEW SIGNS "A"	NEW SIGNS "B"	EXISTING SIGNS RETAIN	EXISTING SIGNS SALVAGE FROM	EXISTING SIGNS SALVAGE TO	EXISTING SIGNS REMOVE	EXIST POST RETAIN	EXIST POST REMOVE	NUMBER OF NEW POSTS	SQUARE STEEL (IN) 1.75 (LB/FT) 1.88	SQUARE STEEL (IN) 2.00 (LB/FT) 2.42	SQUARE STEEL (IN) 2.50 (LB/FT) 3.35	TUBULAR STEEL Ø (IN) FOUNDATION	TUBULAR STEEL Ø (IN) 3.00 (LB/FT) 7.60	TUBULAR STEEL Ø (IN) 3.50 (LB/FT) 9.00	TUBULAR STEEL Ø (IN) 4.00 (LB/FT) 10.80	TUBULAR STEEL Ø (IN) 5.00 (LB/FT) 14.60	SIGN FRAME REQUIRED	REMARKS	SIGN DETAIL LOCATION SHSM	SIGN DETAIL LOCATION PROJECT SHEET #	SIGN DETAIL LOCATION STANDARD SHEET #
MILTON US-2 EB							FY-FLUORESCENT YELLOW FYG-FLUORESCENT YELLOW GREEN																				"SHSM"-STANDARD HIGHWAY SIGNS AND MARKINGS			
EB	0.811	A	W11-2	30	30								1	~~X~~				16.00											
		A	W16-4	24	18		NEXT 500 FT						1																
		A	W11-2	30	30	FYG		6.25																			X		
		A	W16-4	30	24	FYG		5.00																			X		
EB	0.850	A	R8-3A	24	24		11/14/14						1	~~X~~				13.00											
		A	R8-3	24	24			4.00																			X		
EB	0.914	A	R8-3A	24	24		11/14/14						1	~~X~~				13.00											
		A	R8-3	24	24			4.00																			X		
EB	0.946	A	R8-3A	24	24								1		X														
		A	M4-6P	24	12		END						1																
		A	R3-9cP	30	12	BLK/ WHT	END 11/14/14	2.50								1		X									X		
		A	R8-3	24	24			4.00																			X		
EB	0.990	A	W7-3A	24	18		NEXT 1 MILE			1				X															
		A	VW-318	30	30		WILDLIFE CROSSING			1																			
EB	1.164	A	R2-1	36	48								1		X														
SIGN SUMMARY SHEET							SHEET TOTALS	25.75	0.00	2	0	0	7	0	0	1		~~56.25~~ 15.0		0	0.0	0.0	0.0	0.0					
								SF	SF	EA	EA	EA	EA	EA	EA	EA		FT		EA	LB	LB	LB	LB					
VERMONT AGENCY OF TRANSPORTATION							TOWN DIRECTIONAL TOTALS	332.1	0.0	2	0	0	42	0	0	32		480.0		0	0.0								



PROJECT NAME: ALBURGH-COLCHESTER
PROJECT NUMBER: STPG SIGN(45)
FILE NAME: 9 MILTON US2 EB TSS.xls
PROJECT MANAGER: D. BRYANT
DESIGNED BY: B. TOOTHAKER
MILTON EB SHEET 3
PLOT DATE: 3/14/2014
DRAWN BY: J. BLANCHARD
CHECKED K. KERN
SHEET 132 OF 167

DIRECTION	MILEPOINT	LOCATION CODE (SHEET 2)	SIGN CODE	WIDTH (IN)	HEIGHT (IN)	SHEETING REMARKS	SIGN LEGEND	NEW SIGNS "A"	NEW SIGNS "B"	EXISTING SIGNS RETAIN	EXISTING SIGNS SALVAGE FROM	EXISTING SIGNS SALVAGE TO	EXISTING SIGNS REMOVE	EXIST POST RETAIN	EXIST POST REMOVE	NUMBER OF NEW POSTS	SQUARE STEEL (IN) 1.75 (LB/FT) 1.88	SQUARE STEEL (IN) 2.00 (LB/FT) 2.42	SQUARE STEEL (IN) 2.50 (LB/FT) 3.35	TUBULAR STEEL Ø (IN) FOUNDATION	TUBULAR STEEL Ø (IN) 3.00 (LB/FT) 7.60	TUBULAR STEEL Ø (IN) 3.50 (LB/FT) 9.00	TUBULAR STEEL Ø (IN) 4.00 (LB/FT) 10.80	TUBULAR STEEL Ø (IN) 5.00 (LB/FT) 14.60	SIGN FRAME REQUIRED	REMARKS	SIGN DETAIL LOCATION SHSM	SIGN DETAIL LOCATION PROJECT SHEET #	SIGN DETAIL LOCATION STANDARD SHEET #
MILTON US-2 EB							FY-FLUORESCENT YELLOW FYG-FLUORESCENT YELLOW GREEN																				"SHSM"-STANDARD HIGHWAY SIGNS AND MARKINGS			
		A	R2-1	24	30		SPEED LIMIT 55 11/18/14	5.00								1		16.00 X										X		
EB	1.796	A	R2-1	36	48								1	X															
		A	R2-1	30	36		SPEED LIMIT 55 11/18/14	7.50																				X		
EB	1.976	A	W1-2R	30	30		RIGHT CURVE						1		X														
EB	2.065	A	W1-2R	48	48		11/18/14	16.00								2		12.75 X 13.25									INSTALL 100 FT WEST OF BEGINNING OF CURVE (470 FT EAST OF EXISTING)	X		
EB	2.352	A	R8-7	30	24								1		X														
		A	R8-7	48	36		EMERGENCY STOPPING ONLY 11/18/14	12.00								2		15.50 X 12.50										X		
EB	2.445	A	R2-1	36	48								1	X															
		A	R2-1	30	36		SPEED LIMIT 55 11/18/14	7.50																				X		
EB	2.696	A	W11-3A	30	30								1		X														
		A	W11-3	48	48		11/18/14	16.00								2			13.25 X 13.00								SLIP BASES	X		
		A	W7-3aP	24	18		NEXT 1 MILE	3.00																				X		
EB	3.012	A	D1-1M	72	12		BEAR TRAP RD ---> (45 DEG) 11/18/14						1	~~X~~				14.00												
		A	VD1-1	72	12		Cub Rd	6.00																					8	
		A	VD1-1	72	12		Bear Trap Rd	6.00																					8	
SIGN SUMMARY SHEET							SHEET TOTALS	79.00	0.00	0	0	0	6	0	0	7		110.25 ~~105.0~~		0	0.0	0.0	0.0	0.0					
								SF	SF	EA	EA	EA	EA	EA	EA	EA		FT		EA	LB	LB	LB	LB					
VERMONT AGENCY OF TRANSPORTATION							TOWN DIRECTIONAL TOTALS	332.1	0.0	2	0	0	42	0	0	32		480.0		0	0.0								


PROJECT NAME: ALBURGH-COLCHESTER
PROJECT NUMBER: STPG SIGN(45)

FILE NAME: 9 MILTON US2 EB TSS.xls
PROJECT MANAGER: D. BRYANT
DESIGNED BY: B. TOOTHAKER
MILTON EB SHEET 4

PLOT DATE: 3/14/2014
DRAWN BY: J. BLANCHARD
CHECKED K. KERN
SHEET 133 OF 167

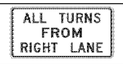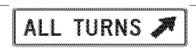DIRECTION	MILEPOINT	LOCATION CODE (SHEET 2)	SIGN CODE	WIDTH (IN)	HEIGHT (IN)	SHEETING REMARKS	SIGN LEGEND	NEW SIGNS "A"	NEW SIGNS "B"	EXISTING SIGNS RETAIN	EXISTING SIGNS SALVAGE FROM	EXISTING SIGNS SALVAGE TO	EXISTING SIGNS REMOVE	EXIST POST RETAIN	EXIST POST REMOVE	NUMBER OF NEW POSTS	SQUARE STEEL (IN) 1.75 (LB/FT) 1.88	SQUARE STEEL (IN) 2.00 (LB/FT) 2.42	SQUARE STEEL (IN) 2.50 (LB/FT) 3.35	TUBULAR STEEL Ø (IN) FOUNDATION	TUBULAR STEEL Ø (IN) 3.00 (LB/FT) 7.60	TUBULAR STEEL Ø (IN) 3.50 (LB/FT) 9.00	TUBULAR STEEL Ø (IN) 4.00 (LB/FT) 10.80	TUBULAR STEEL Ø (IN) 5.00 (LB/FT) 14.60	SIGN FRAME REQUIRED	REMARKS	SIGN DETAIL LOCATION SHSM	SIGN DETAIL LOCATION PROJECT SHEET #	SIGN DETAIL LOCATION STANDARD SHEET #
MILTON US-2 EB							FY-FLUORESCENT YELLOW FYG-FLUORESCENT YELLOW GREEN																			"SHSM"-STANDARD HIGHWAY SIGNS AND MARKINGS			
EB	3.044	A	VR-428	24	30		ALL TURNS RIGHT LANE 11/18/14						1		X			15.50 16.50											
		A	R3-23	60	36			15.00								2		X								SLIP BASES	X		
EB	3.092	A	VR-903R	36	30		THRU/RIGHT ALL TURNS 11/18/14						1		X														
EB	3.128	A	VR-284	30	36		ALL TURNS ===> (45 DEG) 11/18/14						1		X			13.50 14.25											
		A	R3-24	72	18			9.00								2		X									X		
EB	3.200	A	VR-284	30	36		ALL TURNS ===> (45 DEG)						1		X			X											
		A	R3-24	72	18			9.00								2		13.00 X 13.25									X		
EB	3.212	B	R3-2	24	24		NO LEFT TURN SYMBOL						1		X														
EB	3.217	B	R5-1	30	30		11/14/14						1		X			13.50											
		~~A~~	R1-1	30	30			6.25								1		X									IN MEDIAN AT INTERSECTION OF JUGHANDLE AND CUB RD (TH-40)	X		
		B	R5-1	30	30			6.25																			INSTALL ON REVERSE OF STOP SIGN	X		
EB	3.219	A	R1-1	30	30								1		X														
		B	R5-1	30	30		 11/14/14						1																	
		A	R1-1	30	30			6.25								1		14.25 X									WEST OF JUGHANDLE AT INTERSECTION WITH CUB RD (TH-40)	X		
		B	R5-1	30	30			6.25																			INSTALL ON REVERSE OF STOP SIGN	X		
SIGN SUMMARY SHEET							SHEET TOTALS	58.00	0.00	0	0	0	8	0	0	8		~~120.0~~ 113.75		0	0.0	0.0	0.0	0.0					
								SF	SF	EA	EA	EA	EA	EA	EA	EA		FT		EA	LB	LB	LB	LB					
VERMONT AGENCY OF TRANSPORTATION							TOWN DIRECTIONAL TOTALS	332.1	0.0	2	0	0	42	0	0	32		480.0		0	0.0								

PROJECT NAME: **ALBURGH-COLCHESTER**
PROJECT NUMBER: **STPG SIGN(45)**
FILE NAME: **9 MILTON US2 EB TSS.xls** PLOT DATE: **3/14/2014**
PROJECT MANAGER: **D. BRYANT** DRAWN BY: **J. BLANCHARD**
DESIGNED BY: **B. TOOTHAKER** CHECKED **K. KERN**
MILTON EB SHEET 5 SHEET **134** OF **167**

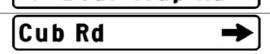DIRECTION	MILEPOINT	LOCATION CODE (SHEET 2)	SIGN CODE	WIDTH (IN)	HEIGHT (IN)	SHEETING REMARKS	SIGN LEGEND	NEW SIGNS "A"	NEW SIGNS "B"	EXISTING SIGNS RETAIN	EXISTING SIGNS SALVAGE FROM	EXISTING SIGNS SALVAGE TO	EXISTING SIGNS REMOVE	EXIST POST RETAIN	EXIST POST REMOVE	NUMBER OF NEW POSTS	SQUARE STEEL (IN) 1.75 (LB/FT) 1.88	SQUARE STEEL (IN) 2.00 (LB/FT) 2.42	SQUARE STEEL (IN) 2.50 (LB/FT) 3.35	TUBULAR STEEL Ø (IN) FOUNDATION	TUBULAR STEEL Ø (IN) 3.00 (LB/FT) 7.60	TUBULAR STEEL Ø (IN) 3.50 (LB/FT) 9.00	TUBULAR STEEL Ø (IN) 4.00 (LB/FT) 10.80	TUBULAR STEEL Ø (IN) 5.00 (LB/FT) 14.60	SIGN FRAME REQUIRED	REMARKS	SIGN DETAIL LOCATION SHSM	SIGN DETAIL LOCATION PROJECT SHEET #	SIGN DETAIL LOCATION STANDARD SHEET #
MILTON US-2 EB							FY-FLUORESCENT YELLOW FYG-FLUORESCENT YELLOW GREEN																				"SHSM"-STANDARD HIGHWAY SIGNS AND MARKINGS			
EB	3.221	C	VR-017	24	30		11/14/14						1	~~X~~				13.75											
		C	VR-017	24	30			5.00								1		X								CUB RD (TH-40); INSTALL WEST OF JUGHANDLE		10	
EB	3.223	A	R3-3	48	48		 11/18/14	16.00								2		12.00 X 12.25									INSTALL IN MEDIAN AT INTERSECTION WITH CUB RD (TH-40)	X		
		B	R3-3	48	48			16.00																			SLIP BASES	X		
EB	3.227	A/B	D3-1	UNK.	UNK.		CUB RD						1	~~X~~															
		D	R1-1	30	30		11/14/14						1																
		D	R1-1	30	30			6.25								1		14.00								CUB RD (TH-40)	X		
EB	3.227	A	W1-7	48	24								1	~~X~~															
		A	VD1-1	72	12		 11/14/14	6.00										14.00 13.75										8	
		A	VD1-1	72	12			6.00								2										CUB RD (TH-40); INSTALL CENTERED ACROSS FROM JUGHANDLE INTERSECTION		9	
EB	3.234	A	D11-1	24	18		11/14/14						1		X			13.75											
		A	D11-1	24	18			3.00								1		X										X		
EB	3.277	A	R8-7	30	24		11/18/14						1		X				14.75 15.25										
		A	R8-7	48	36			12.00								1			X									X		
EB	3.368	A	R2-1	24	30								1	X															
SIGN SUMMARY SHEET							SHEET TOTALS	70.25	0.00	0	0	0	7	0	0	4		~~60.0~~ 123.50		0	0.0	0.0	0.0	0.0					
								SF	SF	EA	EA	EA	EA	EA	EA	EA		FT		EA	LB	LB	LB	LB					
VERMONT AGENCY OF TRANSPORTATION							TOWN DIRECTIONAL TOTALS	332.1	0.0	2	0	0	42	0	0	32		480.0		0		0.0							

PROJECT NAME: ALBURGH-COLCHESTER
PROJECT NUMBER: STPG SIGN(45)
FILE NAME: 9 MILTON US2 EB TSS.xls
PROJECT MANAGER: D. BRYANT
DESIGNED BY: B. TOOTHAKER
MILTON EB SHEET 6
PLOT DATE: 3/14/2014
DRAWN BY: J. BLANCHARD
CHECKED K. KERN
SHEET 135 OF 167

DIRECTION	MILEPOINT	LOCATION CODE (SHEET 2)	SIGN CODE	WIDTH (IN)	HEIGHT (IN)	SHEETING REMARKS	SIGN LEGEND	NEW SIGNS "A"	NEW SIGNS "B"	EXISTING SIGNS RETAIN	EXISTING SIGNS SALVAGE FROM	EXISTING SIGNS SALVAGE TO	EXISTING SIGNS REMOVE	EXIST POST RETAIN	EXIST POST REMOVE	NUMBER OF NEW POSTS	SQUARE STEEL (IN) 1.75 (LB/FT) 1.88	SQUARE STEEL (IN) 2.00 (LB/FT) 2.42	SQUARE STEEL (IN) 2.50 (LB/FT) 3.35	TUBULAR STEEL Ø (IN) FOUNDATION	TUBULAR STEEL Ø (IN) 3.00 (LB/FT) 7.60	TUBULAR STEEL Ø (IN) 3.50 (LB/FT) 9.00	TUBULAR STEEL Ø (IN) 4.00 (LB/FT) 10.80	TUBULAR STEEL Ø (IN) 5.00 (LB/FT) 14.60	SIGN FRAME REQUIRED	REMARKS	SIGN DETAIL LOCATION SHSM	SIGN DETAIL LOCATION PROJECT SHEET #	SIGN DETAIL LOCATION STANDARD SHEET #
MILTON US-2 EB							FY-FLUORESCENT YELLOW FYG-FLUORESCENT YELLOW GREEN																				"SHSM"-STANDARD HIGHWAY SIGNS AND MARKINGS			
		A	R2-1	30	36		SPEED LIMIT 55 11/14/14	7.50										16.00										X		
EB	3.534	A	S3-1T	30	30								1		X											SLIP BASES			
		A	S3-1	48	48	FYG		16.00								2		17.75 X 16.25									X		
EB	3.618	A	W11-1P	24	18		BIKE XING						1		X														
		A	W11-1	30	30		BICYCLE SYMBOL						1																

DIRECTION	MILEPOINT	LOCATION CODE (SHEET 2)	SIGN CODE	WIDTH (IN)	HEIGHT (IN)	SHEETING REMARKS	SIGN LEGEND	NEW SIGNS "A"	NEW SIGNS "B"	EXISTING SIGNS RETAIN	EXISTING SIGNS SALVAGE FROM	EXISTING SIGNS SALVAGE TO	EXISTING SIGNS REMOVE	EXIST POST RETAIN	EXIST POST REMOVE	NUMBER OF NEW POSTS	SQUARE STEEL (IN) 1.75 (LB/FT) 1.88	SQUARE STEEL (IN) 2.00 (LB/FT) 2.42	SQUARE STEEL (IN) 2.50 (LB/FT) 3.35	TUBULAR STEEL Ø (IN) FOUNDATION	TUBULAR STEEL Ø (IN) 3.00 (LB/FT) 7.60	TUBULAR STEEL Ø (IN) 3.50 (LB/FT) 9.00	TUBULAR STEEL Ø (IN) 4.00 (LB/FT) 10.80	TUBULAR STEEL Ø (IN) 5.00 (LB/FT) 14.60	SIGN FRAME REQUIRED	REMARKS	SIGN DETAIL LOCATION SHSM	SIGN DETAIL LOCATION PROJECT SHEET #	SIGN DETAIL LOCATION STANDARD SHEET #
MILTON US-2 WB							FY-FLUORESCENT YELLOW FYG-FLUORESCENT YELLOW GREEN																				"SHSM"-STANDARD HIGHWAY SIGNS AND MARKINGS			
WB	3.595	G	VR-017	24	30								1	X															
		G	VR-017	24	30		LEGAL LOAD LIMIT 24,000 POUNDS 11/11/14	5.00										14.00									RAINBOW PL (TH-104)		10	
WB	3.586	H	R1-1	30	30								1	X															
		E/F	D3-1	UNK.	UNK.		RAINBOW PL						1																
		H	R1-1	30	30		STOP 11/11/14	6.25																			RAINBOW PL (TH-104)	X		
WB	3.586	E/F	D3-1	42	12		Rainbow Pl 11/11/14	3.50								1		10.00 X									RAINBOW PL (TH-104); FIELD LOCATE FOR VISIBILITY FROM ROUTE 2		14	
WB	3.550	F	D11-1	24	18		11/11/14						1	X															
		F	D11-1	24	18		BIKE ROUTE	3.00																				X		
WB	3.500	F	W11-3A	30	30								1	X				15.00											
		F	W11-3	48	48			16.00																				X		
		F	W7-3aP	24	18		NEXT 1 MILE	3.00																				X		
WB	3.448	F	VR-428	24	30		ALL TURNS RIGHT LANE 11/11/14						1		X			13.25 13.75									SLIP BASES			
		F	R3-23	60	36		ALL TURNS FROM RIGHT LANE	15.00								2		X										X		
WB	3.410	F	D1-1M	72	12		BEAR TRAP RD ---> (45 DEG) 11/11/14						1		X			13.25 14.75												
		F	VD1-1	72	12		Bear Trap Rd Cub Rd	6.00								2		X											8	
							SHEET TOTALS	57.75	0.00	0	0	0	7	0	0	5		94.00 ~~75.0~~		0	0.0	0.0	0.0	0.0					
								SF	SF	EA	EA	EA	EA	EA	EA	EA		FT		EA	LB	LB	LB	LB					
							TOWN DIRECTIONAL TOTALS	317.3	0.0	4	0	0	46	0	0	24		360.0		0	0.0								


SIGN SUMMARY SHEET

VERMONT AGENCY OF TRANSPORTATION

PROJECT NAME: ALBURGH-COLCHESTER
PROJECT NUMBER: STPG SIGN(45)

FILE NAME: 10 MILTON US2 WB TSS.xls
PROJECT MANAGER: D. BRYANT
DESIGNED BY: B. TOOTHAKER
MILTON WB SHEET 1

PLOT DATE: 3/14/2014
DRAWN BY: J. BLANCHARD
CHECKED K. KERN
SHEET 137 OF 167

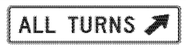DIRECTION	MILEPOINT	LOCATION CODE (SHEET 2)	SIGN CODE	WIDTH (IN)	HEIGHT (IN)	SHEETING REMARKS	SIGN LEGEND	NEW SIGNS "A"	NEW SIGNS "B"	EXISTING SIGNS RETAIN	EXISTING SIGNS SALVAGE FROM	EXISTING SIGNS SALVAGE TO	EXISTING SIGNS REMOVE	EXIST POST RETAIN	EXIST POST REMOVE	NUMBER OF NEW POSTS	SQUARE STEEL (IN) 1.75 (LB/FT) 1.88	SQUARE STEEL (IN) 2.00 (LB/FT) 2.42	SQUARE STEEL (IN) 2.50 (LB/FT) 3.35	TUBULAR STEEL Ø (IN) FOUNDATION	TUBULAR STEEL Ø (IN) 3.00 (LB/FT) 7.60	TUBULAR STEEL Ø (IN) 3.50 (LB/FT) 9.00	TUBULAR STEEL Ø (IN) 4.00 (LB/FT) 10.80	TUBULAR STEEL Ø (IN) 5.00 (LB/FT) 14.60	SIGN FRAME REQUIRED	REMARKS	SIGN DETAIL LOCATION SHSM	SIGN DETAIL LOCATION PROJECT SHEET #	SIGN DETAIL LOCATION STANDARD SHEET #
MILTON US-2 WB							FY-FLUORESCENT YELLOW FYG-FLUORESCENT YELLOW GREEN																				"SHSM"-STANDARD HIGHWAY SIGNS AND MARKINGS			
		F	VD1-1	72	12			6.00																				8	
WB	3.340	F	VR-903R	36	30		THRU/RIGHT "ONLY" ALL TURNS						1		X														
WB	3.308	F	VR-284	30	36		ALL TURNS ===> (45 DEG)						1		X			12.50 13.25											
		F	R3-23	72	18		 11/11/14	9.00								2		X										X		
WB	3.220	F	R3-2	24	24		NO LEFT TURN SYMBOL						1	X		2											SLIP BASES			
		F	R3-3	48	48			16.00										11.25 11.75										X		
		E	R3-3	48	48			16.00																				X		
WB	3.217	E	R5-1	30	30		11/11/14						1	~~X~~															
		F	R1-1	30	30								1					13.25											
		F	R1-1	30	30			6.25										X										X		
		E	R5-1	30	30			6.25								1												INSTALL ON REVERSE OF STOP SIGN	X		
WB	3.217	F	R1-1	30	30		 11/11/14	6.25								1		12.50 X										IN MEDIAN AT INTERSECTION OF JUGHANDLE AND BEAR TRAP RD (TH-7)	X		
		E	R5-1	30	30			6.25																				INSTALL ON REVERSE OF STOP SIGN	X		
WB	3.217	G	VR-017	24	30								1	X															
		G	UNK.	UNK.	UNK.		NO PARKING ALL TOWN HIGHWAYS NOV 15-MAR 15 VEHICLES TOWED AT OWNER'S EXPENSE			1																					
							SHEET TOTALS	72.00	0.00	1	0	0	6	0	0	3		74.50 45.0		0	0.0	0.0	0.0	0.0					
								SF	SF	EA	EA	EA	EA	EA	EA	EA		FT		EA	LB	LB	LB	LB					
							TOWN DIRECTIONAL TOTALS	317.3	0.0	4	0	0	46	0	0	24		360.0		0			0.0						

SIGN SUMMARY SHEET

VERMONT AGENCY OF TRANSPORTATION

PROJECT NAME: **ALBURGH-COLCHESTER**
PROJECT NUMBER: **STPG SIGN(45)**

FILE NAME: **10 MILTON US2 WB TSS.xls** PLOT DATE: **3/14/2014**
PROJECT MANAGER: **D. BRYANT** DRAWN BY: **J. BLANCHARD**
DESIGNED BY: **B. TOOTHAKER** CHECKED **K. KERN**
MILTON WB SHEET 2 SHEET **138** OF **167**

DIRECTION	MILEPOINT	LOCATION CODE (SHEET 2)	SIGN CODE	WIDTH (IN)	HEIGHT (IN)	SHEETING REMARKS	SIGN LEGEND	NEW SIGNS "A"	NEW SIGNS "B"	EXISTING SIGNS RETAIN	EXISTING SIGNS SALVAGE FROM	EXISTING SIGNS SALVAGE TO	EXISTING SIGNS REMOVE	EXIST POST RETAIN	EXIST POST REMOVE	NUMBER OF NEW POSTS	SQUARE STEEL (IN) 1.75 (LB/FT) 1.88	SQUARE STEEL (IN) 2.00 (LB/FT) 2.42	SQUARE STEEL (IN) 2.50 (LB/FT) 3.35	TUBULAR STEEL Ø (IN) FOUNDATION	TUBULAR STEEL Ø (IN) 3.00 (LB/FT) 7.60	TUBULAR STEEL Ø (IN) 3.50 (LB/FT) 9.00	TUBULAR STEEL Ø (IN) 4.00 (LB/FT) 10.80	TUBULAR STEEL Ø (IN) 5.00 (LB/FT) 14.60	SIGN FRAME REQUIRED	REMARKS	SIGN DETAIL LOCATION SHSM	SIGN DETAIL LOCATION PROJECT SHEET #	SIGN DETAIL LOCATION STANDARD SHEET #
MILTON US-2 WB							FY-FLUORESCENT YELLOW FYG-FLUORESCENT YELLOW GREEN																				"SHSM"-STANDARD HIGHWAY SIGNS AND MARKINGS			
		G	VR-017	24	30		LEGAL LOAD LIMIT 24,000 POUNDS 11/14/14	5.00										14.50									BEAR TRAP RD (TH-7); INSTALL EAST OF JUGHANDLE		10	
WB	3.208	H	R1-1	30	30								1	X															
		H	R1-1	30	30		STOP	6.25										14.50									BEAR TRAP RD (TH-7)	X		
WB	3.207	F	W1-7	48	24		<===> 11/14/14						1	X															
		F	VD1-1	72	12		Cub Rd	6.00										13.50 X 13.25											9	
		F	VD1-1	72	12		Bear Trap Rd →	6.00								2											BEAR TRAP RD (TH-7); INSTALL CENTERED ACROSS FROM JUGHANDLE INTERSECTION		9	
WB	3.199	F	D11-1	24	18								1	X															
		F	M6-3	12	6								1																
		F	D11-1	24	18		BIKE ROUTE 11/11/14	3.00																				X		
		F	M6-3	12	6	WHT/GRN	↑																					X		
WB	3.146	F	R8-7	30	24								1		X			14.00 14.50											
		F	R8-7	48	36		EMERGENCY STOPPING ONLY 11/11/14	12.00								2		X										X		
WB	3.057	F	R2-1	36	48		11/11/14						1	X				13.00											
		F	R2-1	30	36		SPEED LIMIT 55	7.50																				X		
WB	2.446	F	R2-1	36	48								1	X				14.00											
SIGN SUMMARY SHEET							SHEET TOTALS	45.75	0.00	0	0	0	7	0	0	2		~~30.0~~ 111.25		0	0.0	0.0	0.0	0.0					
								SF	SF	EA	EA	EA	EA	EA	EA	EA		FT		EA	LB	LB	LB	LB					
VERMONT AGENCY OF TRANSPORTATION							TOWN DIRECTIONAL TOTALS	317.3	0.0	4	0	0	46	0	0	24		360.0		0	0.0								

PROJECT NAME: ALBURGH-COLCHESTER
PROJECT NUMBER: STPG SIGN(45)
FILE NAME: 10 MILTON US2 WB TSS.xls
PROJECT MANAGER: D. BRYANT
DESIGNED BY: B. TOOTHAKER
MILTON WB SHEET 3
PLOT DATE: 3/14/2014
DRAWN BY: J. BLANCHARD
CHECKED K. KERN
SHEET 139 OF 167

DIRECTION	MILEPOINT	LOCATION CODE (SHEET 2)	SIGN CODE	WIDTH (IN)	HEIGHT (IN)	SHEETING REMARKS	SIGN LEGEND	NEW SIGNS "A"	NEW SIGNS "B"	EXISTING SIGNS RETAIN	EXISTING SIGNS SALVAGE FROM	EXISTING SIGNS SALVAGE TO	EXISTING SIGNS REMOVE	EXIST POST RETAIN	EXIST POST REMOVE	NUMBER OF NEW POSTS	SQUARE STEEL (IN) 1.75 (LB/FT) 1.88	SQUARE STEEL (IN) 2.00 (LB/FT) 2.42	SQUARE STEEL (IN) 2.50 (LB/FT) 3.35	TUBULAR STEEL Ø (IN) FOUNDATION	TUBULAR STEEL Ø (IN) 3.00 (LB/FT) 7.60	TUBULAR STEEL Ø (IN) 3.50 (LB/FT) 9.00	TUBULAR STEEL Ø (IN) 4.00 (LB/FT) 10.80	TUBULAR STEEL Ø (IN) 5.00 (LB/FT) 14.60	SIGN FRAME REQUIRED	REMARKS	SIGN DETAIL LOCATION SHSM	SIGN DETAIL LOCATION PROJECT SHEET #	SIGN DETAIL LOCATION STANDARD SHEET #
MILTON US-2 WB							FY-FLUORESCENT YELLOW FYG-FLUORESCENT YELLOW GREEN																				"SHSM"-STANDARD HIGHWAY SIGNS AND MARKINGS			
		F	R2-1	30	36		SPEED LIMIT 55 II/II/14	7.50																			REQUIRES VEGETATION CLEARING	X		
WB	2.367	F	VW-318	30	30		WILDLIFE CROSSING			1				X															
		F	W7-3A	24	18		NEXT 1 MILE			1				X															
WB	2.192	F	VR-644P	24	12		BEGIN						1	X															
		F	R8-3A	24	24		NO PARKING SYMBOL II/14/14						1																
		F	R3-9cP	30	12	BLK/WHT	BEGIN 04/24/15	2.50										14.00										X	
		F	R8-3	36	36		R 9.00																					X	
WB	2.083	F	M4-6P	24	12		END PARKING II/11/14						1		X														
		F	R8-3A	24	24		NO PARKING SYMBOL						1																
WB	2.050	F	R3-9dP	30	12	BLK/WHT	END II/11/14	2.50								1			X 14.50								INSTALL 1.17 MI WEST OF TH-40 (175 FT WEST OF EXISTING)	X		
		F	R8-3	36	36		R 04/24/15 9.00																					X	
WB	1.886	F	D11-1	24	18		II/11/14						1		X														
		F	D11-1	24	18		BIKE ROUTE 3.00									1		13.00 X										X	
WB	1.600	F	M4-6	12	6	WHT/GRN	END II/11/14	0.50								1		13.50 X								INSTALL 1510 FT FROM BIKE ROUTE SIGN	X		
		F	D11-1	24	18		BIKE ROUTE 3.00																					X	
SIGN SUMMARY SHEET							SHEET TOTALS	37.00	0.00	2	0	0	5	0	0	3		55.00 ~~45.0~~		0	0.0	0.0	0.0	0.0					
								SF	SF	EA	EA	EA	EA	EA	EA	EA		FT		EA	LB	LB	LB	LB					
VERMONT AGENCY OF TRANSPORTATION							TOWN DIRECTIONAL TOTALS	317.3	0.0	4	0	0	46	0	0	24		360.0		0	0.0								

PROJECT NAME: ALBURGH-COLCHESTER
PROJECT NUMBER: STPG SIGN(45)

FILE NAME: 10 MILTON US2 WB TSS.xls
PROJECT MANAGER: D. BRYANT
DESIGNED BY: B. TOOTHAKER
MILTON WB SHEET 4

PLOT DATE: 3/14/2014
DRAWN BY: J. BLANCHARD
CHECKED K. KERN
SHEET 140 OF 167

DIRECTION	MILEPOINT	LOCATION CODE (SHEET 2)	SIGN CODE	WIDTH (IN)	HEIGHT (IN)	SHEETING REMARKS	SIGN LEGEND	NEW SIGNS "A"	NEW SIGNS "B"	EXISTING SIGNS RETAIN	EXISTING SIGNS SALVAGE FROM	EXISTING SIGNS SALVAGE TO	EXISTING SIGNS REMOVE	EXIST POST RETAIN	EXIST POST REMOVE	NUMBER OF NEW POSTS	SQUARE STEEL (IN) 1.75 (LB/FT) 1.88	SQUARE STEEL (IN) 2.00 (LB/FT) 2.42	SQUARE STEEL (IN) 2.50 (LB/FT) 3.35	TUBULAR STEEL Ø (IN) FOUNDATION	TUBULAR STEEL Ø (IN) 3.00 (LB/FT) 7.60	TUBULAR STEEL Ø (IN) 3.50 (LB/FT) 9.00	TUBULAR STEEL Ø (IN) 4.00 (LB/FT) 10.80	TUBULAR STEEL Ø (IN) 5.00 (LB/FT) 14.60	SIGN FRAME REQUIRED	REMARKS	SIGN DETAIL LOCATION SHSM	SIGN DETAIL LOCATION PROJECT SHEET #	SIGN DETAIL LOCATION STANDARD SHEET #
MILTON US-2 WB							FY-FLUORESCENT YELLOW FYG-FLUORESCENT YELLOW GREEN																				"SHSM"-STANDARD HIGHWAY SIGNS AND MARKINGS			
WB	1.274	F	W3-5	48	48								1		X			14.25 15.00											
		F	W3-5	36	36		 11/11/14	9.00								2		X									X		
WB	1.158	F	R2-1	36	48		11/11/14						1		X														
		F	R2-1	30	36			7.50								1		14.00 X									X		
WB	1.127	F	W11-2	30	30								1		X														
		F	W16-9	24	10		11/11/14						1																
		F	W11-2	30	30	FYG		6.25								1		15.00 X									X		
		F	W16-9P	24	12	FYG		2.00																			X		
WB	1.115	F	W1-2R	30	30		 11/11/14	6.25								1		14.25 X									INSTALL 63 FT WEST OF PEDESTRIAN SIGN	X		
WB	1.077	F	VW-730	36	36		11/14/14						1	X													SALVAGE AND REMOUNT FLASHING BEACON ON NEW POST			
		F	VW-730	36	36			9.00																				11	
WB	1.035	F	R8-3A	24	24		11/11/14						1		X														
		F	VR-644P	24	12		BEGIN						1																
		F	R3-9cP	30	12	BLK/WHT		2.50								1		14.50 X									X		
		F	R8-3	24	24			4.00																			X		
SIGN SUMMARY SHEET							SHEET TOTALS	46.50	0.00	0	0	0	7	0	0	6		~~87.00~~ ~~90.0~~		0	0.0	0.0	0.0	0.0					
								SF	SF	EA	EA	EA	EA	EA	EA	EA		FT		EA	LB	LB	LB	LB					
VERMONT AGENCY OF TRANSPORTATION							TOWN DIRECTIONAL TOTALS	317.3	0.0	4	0	0	46	0	0	24		360.0		0		0.0							

PROJECT NAME: **ALBURGH-COLCHESTER**
PROJECT NUMBER: **STPG SIGN(45)**

FILE NAME: **10 MILTON US2 WB TSS.xls** PLOT DATE: **3/14/2014**
PROJECT MANAGER: **D. BRYANT** DRAWN BY: **J. BLANCHARD**
DESIGNED BY: **B. TOOTHAKER** CHECKED **K. KERN**
MILTON WB SHEET 5 SHEET **141** OF **167**

DIRECTION	MILEPOINT	LOCATION CODE (SHEET 2)	SIGN CODE	WIDTH (IN)	HEIGHT (IN)	SHEETING REMARKS	SIGN LEGEND	NEW SIGNS "A"	NEW SIGNS "B"	EXISTING SIGNS RETAIN	EXISTING SIGNS SALVAGE FROM	EXISTING SIGNS SALVAGE TO	EXISTING SIGNS REMOVE	EXIST POST RETAIN	EXIST POST REMOVE	NUMBER OF NEW POSTS	SQUARE STEEL (IN) 1.75 (LB / FT) 1.88	SQUARE STEEL (IN) 2.00 (LB / FT) 2.42	SQUARE STEEL (IN) 2.50 (LB / FT) 3.35	TUBULAR STEEL Ø (IN) FOUNDATION	TUBULAR STEEL Ø (IN) 3.00 (LB / FT) 7.60	TUBULAR STEEL Ø (IN) 3.50 (LB / FT) 9.00	TUBULAR STEEL Ø (IN) 4.00 (LB / FT) 10.80	TUBULAR STEEL Ø (IN) 5.00 (LB / FT) 14.60	SIGN FRAME REQUIRED	REMARKS	SIGN DETAIL LOCATION SHSM	SIGN DETAIL LOCATION PROJECT SHEET #	SIGN DETAIL LOCATION STANDARD SHEET #
MILTON US-2 WB							FY-FLUORESCENT YELLOW FYG-FLUORESCENT YELLOW GREEN																			"SHSM"-STANDARD HIGHWAY SIGNS AND MARKINGS			
WB	0.981	F	W16-4	24	18		NEXT 800 FT						1	~~X~~				17.75										
		F	W11-2	30	30		11/11/14						1															
		F	W11-2	30	30	FYG		6.25																			X		
		F	W16-4P	30	24	FYG		5.00																			X		
WB	0.943	F	W8-5A	24	18		ICE NEXT 2 MILES						1		X													
		F	W8-5	30	30								1															
		F	W8-5	30	30		11/18/14	6.25								1			18.25 X								X		
		F	W8-5aP	24	12			2.00																			X		
		F	W7-3aP	24	18		ICE NEXT 2 MILES	3.00																			X		
WB	0.888	H	R1-1	30	30								1		X											AT PARK ENTRANCE			
		H	R1-1	30	30		STOP 11/11/14	6.25								1		13.25 X								X		
WB	0.884	F	D11-1	24	18		BIKE ROUTE						1		X													
		F	M4-6	24	12		END						1															
WB	0.836	F	R2-1	24	30		11/11/14						1	X														
		F	R2-1	24	30		SPEED LIMIT 45	5.00																			X		
SIGN SUMMARY SHEET							SHEET TOTALS	33.75	0.00	0	0	0	8	0	0	2		~~49.25~~ ~~36.0~~		0	0.0	0.0	0.0	0.0					
								SF	SF	EA	EA	EA	EA	EA	EA	EA		FT		EA	LB	LB	LB	LB					
VERMONT AGENCY OF TRANSPORTATION							TOWN DIRECTIONAL TOTALS	317.3	0.0	4	0	0	46	0	0	24		360.0		0		0.0							

PROJECT NAME: ALBURGH-COLCHESTER
PROJECT NUMBER: STPG SIGN(45)

FILE NAME: 10 MILTON US2 WB TSS.xls
PROJECT MANAGER: D. BRYANT
DESIGNED BY: B. TOOTHAKER
MILTON WB SHEET 6

PLOT DATE: 3/14/2014
DRAWN BY: J. BLANCHARD
CHECKED K. KERN
SHEET 142 OF 167

DIRECTION	MILEPOINT	LOCATION CODE (SHEET 2)	SIGN CODE	WIDTH (IN)	HEIGHT (IN)	SHEETING REMARKS	SIGN LEGEND	NEW SIGNS "A"	NEW SIGNS "B"	EXISTING SIGNS RETAIN	EXISTING SIGNS SALVAGE FROM	EXISTING SIGNS SALVAGE TO	EXISTING SIGNS REMOVE	EXIST POST RETAIN	EXIST POST REMOVE	NUMBER OF NEW POSTS	SQUARE STEEL (IN) 1.75 (LB/FT) 1.88	SQUARE STEEL (IN) 2.00 (LB/FT) 2.42	SQUARE STEEL (IN) 2.50 (LB/FT) 3.35	TUBULAR STEEL Ø (IN) FOUNDATION	TUBULAR STEEL Ø (IN) 3.00 (LB/FT) 7.60	TUBULAR STEEL Ø (IN) 3.50 (LB/FT) 9.00	TUBULAR STEEL Ø (IN) 4.00 (LB/FT) 10.80	TUBULAR STEEL Ø (IN) 5.00 (LB/FT) 14.60	SIGN FRAME REQUIRED	REMARKS	SIGN DETAIL LOCATION SHSM	SIGN DETAIL LOCATION PROJECT SHEET #	SIGN DETAIL LOCATION STANDARD SHEET #
MILTON US-2 WB							FY-FLUORESCENT YELLOW FYG-FLUORESCENT YELLOW GREEN																				"SHSM"-STANDARD HIGHWAY SIGNS AND MARKINGS			
WB	0.797	F	R8-3A	24	24		11/11/14						1	X				13.00											
		F	R8-3	24	24		(R)	4.00																			X		
WB	0.720	F	R8-3A	24	24		11/11/14						1		X			12.50											
		F	R8-3	24	24		(R)	4.00								1		X									X		
WB	0.662	F	UNK.	UNK.	UNK.		LAKE CHAMPLAIN (WHITE ON GREEN)			1				X															
WB	0.647	F	R8-3A	24	24								1		X														
		F	R2-1	24	30								1						16.00										
		F	R3-9dP	30	12	BLK/ WHT	END 11/14/14	2.50								1			X								X		
		F	R8-3	24	24		(R)	4.00																			X		
		F	R2-1	24	30		SPEED LIMIT 50	5.00																			X		
WB	0.528	F	D4-1L	30	24		PARKING 11/11/14	5.00								1		12.50 X									INSTALL AT BEGINNING OF SCENIC PULL OFF ON SOUTH SIDE OF RTE 2	X		
WB	0.000	G	VD-025	60	7.5		GRAND ISLE CO/CHITTENDEN CO 11/18/14						1	X															
		G	VD-024	60	7.5		SOUTH HERO/MILTON						1																
SIGN SUMMARY SHEET							SHEET TOTALS	24.50	0.00	1	0	0	6	0	0	3		54.00 ~~45.0~~		0	0.0	0.0	0.0	0.0					
								SF	SF	EA	EA	EA	EA	EA	EA	EA		FT		EA	LB	LB	LB	LB					
VERMONT AGENCY OF TRANSPORTATION							TOWN DIRECTIONAL TOTALS	~~317.3~~ 317.25	0.0	4	0	0	~~46~~ 48	0	0	24		~~360.0~~ 525.00		0	0.0								

PROJECT NAME: ALBURGH-COLCHESTER
PROJECT NUMBER: STPG SIGN(45)

FILE NAME: 10 MILTON US2 WB TSS.xls
PROJECT MANAGER: D. BRYANT
DESIGNED BY: B. TOOTHAKER
MILTON WB SHEET 7

PLOT DATE: 3/14/2014
DRAWN BY: J. BLANCHARD
CHECKED K. KERN
SHEET 143 OF 167

DIRECTION	MILEPOINT	LOCATION CODE (SHEET 2)	SIGN CODE	WIDTH (IN)	HEIGHT (IN)	SHEETING REMARKS	SIGN LEGEND	NEW SIGNS "A"	NEW SIGNS "B"	EXISTING SIGNS RETAIN	EXISTING SIGNS SALVAGE FROM	EXISTING SIGNS SALVAGE TO	EXISTING SIGNS REMOVE	EXIST POST RETAIN	EXIST POST REMOVE	NUMBER OF NEW POSTS	SQUARE STEEL (IN) 1.75 (LB/FT) 1.88	SQUARE STEEL (IN) 2.00 (LB/FT) 2.42	SQUARE STEEL (IN) 2.50 (LB/FT) 3.35	TUBULAR STEEL Ø (IN) FOUNDATION	TUBULAR STEEL Ø (IN) 3.00 (LB/FT) 7.60	TUBULAR STEEL Ø (IN) 3.50 (LB/FT) 9.00	TUBULAR STEEL Ø (IN) 4.00 (LB/FT) 10.80	TUBULAR STEEL Ø (IN) 5.00 (LB/FT) 14.60	SIGN FRAME REQUIRED	REMARKS	SIGN DETAIL LOCATION SHSM	SIGN DETAIL LOCATION PROJECT SHEET #	SIGN DETAIL LOCATION STANDARD SHEET #
COLCHESTER US-2 EB							FY-FLUORESCENT YELLOW FYG-FLUORESCENT YELLOW GREEN																			"SHSM"-STANDARD HIGHWAY SIGNS AND MARKINGS			
EB	0.000	C	VD-024	60	7.5								1 I	X															
		C	VD-024	72	10		Colchester | Milton	5.00					I					I7.75										7	
		C	VD-700	6	10		0020 0405 0000 | 0200 0410 0369	0.42																					E-138
		C	VD-700	6	10		II/04/14	0.42																					E-138
EB	0.058	A	D1-11	24	18		BIKE ROUTE SYMBOL II/13/14						1 I		X				I7.75 I8.00										
		A	W11-1	48	48			16.00								2			X								SLIP BASES	X		
		A	W11-15P	36	30		TRAIL X-ING	7.50																				X		
EB	0.095	F	M4-6	24	12	WHT/ GRN	END II/04/14	2.00								1		X I3.00									INSTALL 200 FT EAST OF BIKE ROUTE SYMBOL	X		
		F	D11-1	24	18		BIKE ROUTE	3.00																				X		
EB	0.119	A	R2-1	36	48		II/04/14						1	X				I6.00												
		A	R2-1	30	36		SPEED LIMIT 55	7.50																			0.148 SLIP BASES	X		
EB	0.166	A	VD-062B	72	16		BUSINESS SIGN II/03/14			1				X																
EB	0.198	A	VR-428	24	30		ALL TURNS RIGHT LANE II/03/14						1		X												SLIP BASES			
		A	UNK.	24	30		NO PARKING ALL TOWN HIGHWAYS NOV 15-MAR15 VEHICLES TOWED AT OWNER'S EXPENSE				~~1~~		1					I3.75 I4.25								SALVAGE SIGN AND RETURN TO TOWN			
		A	R3-23	60	36		ALL TURNS FROM RIGHT LANE	15.00					I			2		X												
SIGN SUMMARY SHEET							SHEET TOTALS	~~56.84~~ ~~50.83~~	0.00	1	1	0	~~9~~ ~~5~~	0	0	5		~~110.50~~ ~~75.0~~		0	0.0	0.0	0.0	0.0						
								SF	SF	EA	EA	EA	EA	EA	EA	EA		FT		EA	LB	LB	LB	LB					
VERMONT AGENCY OF TRANSPORTATION							TOWN DIRECTIONAL TOTALS	451.3	0.0	68	1	0	57	0	0	44		660.0		0	0.0								




PROJECT NAME: ALBURGH-COLCHESTER
PROJECT NUMBER: STPG SIGN(45)
FILE NAME: 11 COLCHESTER US2 EB TSS.; PLOT DATE: 3/14/2014
PROJECT MANAGER: D. BRYANT; DRAWN BY: J. BLANCHARD
DESIGNED BY: B. TOOTHAKER; CHECKED K. KERN
COLCHESTER EB SHEET 1; SHEET 144 OF 167

DIRECTION	MILEPOINT	LOCATION CODE (SHEET 2)	SIGN CODE	WIDTH (IN)	HEIGHT (IN)	SHEETING REMARKS	SIGN LEGEND	NEW SIGNS "A"	NEW SIGNS "B"	EXISTING SIGNS RETAIN	EXISTING SIGNS SALVAGE FROM	EXISTING SIGNS SALVAGE TO	EXISTING SIGNS REMOVE	EXIST POST RETAIN	EXIST POST REMOVE	NUMBER OF NEW POSTS	SQUARE STEEL (IN) 1.75 (LB / FT) 1.88	SQUARE STEEL (IN) 2.00 (LB / FT) 2.42	SQUARE STEEL (IN) 2.50 (LB / FT) 3.35	TUBULAR STEEL Ø (IN) FOUNDATION	TUBULAR STEEL Ø (IN) 3.00 (LB / FT) 7.60	TUBULAR STEEL Ø (IN) 3.50 (LB / FT) 9.00	TUBULAR STEEL Ø (IN) 4.00 (LB / FT) 10.80	TUBULAR STEEL Ø (IN) 5.00 (LB / FT) 14.60	SIGN FRAME REQUIRED	REMARKS	SIGN DETAIL LOCATION SHSM	SIGN DETAIL LOCATION PROJECT SHEET #	SIGN DETAIL LOCATION STANDARD SHEET #
COLCHESTER US-2 EB							FY-FLUORESCENT YELLOW FYG-FLUORESCENT YELLOW GREEN																			"SHSM"-STANDARD HIGHWAY SIGNS AND MARKINGS			
EB	0.225	A	W2-1M	36	36								1		X														
		A	VW-202P	30	18								1						13.00 13.25										
		A	W2-1	48	48		 11/06/14	16.00								2			X								SLIP BASES	X		
		A	VW-202P	30	24			3.75																				NEED INFO		
EB	0.263	A	D1-1M	72	12		11/04/14						1	X															
		A	VD1-1	72	12			6.00																					9	
EB	0.293	A	VR-903R	36	30		THRU/RIGHT "ONLY" ALL TURNS 11/04/14						1 1		X														
EB	0.324	A	VR-284	30	36		ALL TURNS ===> (45 DEG) 11/03/14						1 1		X			12.25 13.25											
		A	R3-2	72	18											2		X											
EB	0.393	A	VR-284	36	30		ALL TURNS ===> (45 DEG) 11/04/14						1		X			11.75 12.00											
		A	R3-24	72	18			9.00									2		X									X		
EB	0.402	B	R3-2	24	24		NO LEFT TURN 11/04/14						1		X														
EB	0.408	B	R5-1	30	30								1	~~X~~													SLIP BASES			
		A	R1-1	30	30								1						12.25										
		A	R1-1	30	30			6.25									1		X								WEST OF JUGHANDLE AT INTERSECTION WITH CLAY POINT RD (TH-58)	X		
SIGN SUMMARY SHEET							SHEET TOTALS	41.00	0.00	0	0	0	~~11~~ 9	0	0	6			~~87.75~~ 99.0		0	0.0	0.0	0.0	0.0					
								SF	SF	EA	EA	EA	EA	EA	EA	EA			FT		EA	LB	LB	LB	LB					
VERMONT AGENCY OF TRANSPORTATION							TOWN DIRECTIONAL TOTALS	451.3	0.0	68	1	0	57	0	0	44			660.0		0		0.0						

PROJECT NAME: ALBURGH-COLCHESTER
PROJECT NUMBER: STPG SIGN(45)
FILE NAME: 11 COLCHESTER US2 EB TSS.dgn PLOT DATE: 3/14/2014
PROJECT MANAGER: D. BRYANT DRAWN BY: J. BLANCHARD
DESIGNED BY: B. TOOTHAKER CHECKED K. KERN
COLCHESTER EB SHEET 2 SHEET 145 OF 167

DIRECTION	MILEPOINT	LOCATION CODE (SHEET 2)	SIGN CODE	WIDTH (IN)	HEIGHT (IN)	SHEETING REMARKS	SIGN LEGEND	NEW SIGNS "A"	NEW SIGNS "B"	EXISTING SIGNS RETAIN	EXISTING SIGNS SALVAGE FROM	EXISTING SIGNS SALVAGE TO	EXISTING SIGNS REMOVE	EXIST POST RETAIN	EXIST POST REMOVE	NUMBER OF NEW POSTS	SQUARE STEEL (IN) 1.75 (LB/FT) 1.88	SQUARE STEEL (IN) 2.00 (LB/FT) 2.42	SQUARE STEEL (IN) 2.50 (LB/FT) 3.35	TUBULAR STEEL Ø (IN) FOUNDATION	TUBULAR STEEL Ø (IN) 3.00 (LB/FT) 7.60	TUBULAR STEEL Ø (IN) 3.50 (LB/FT) 9.00	TUBULAR STEEL Ø (IN) 4.00 (LB/FT) 10.80	TUBULAR STEEL Ø (IN) 5.00 (LB/FT) 14.60	SIGN FRAME REQUIRED	REMARKS	SIGN DETAIL LOCATION SHSM	SIGN DETAIL LOCATION PROJECT SHEET #	SIGN DETAIL LOCATION STANDARD SHEET #
COLCHESTER US-2 EB							FY-FLUORESCENT YELLOW FYG-FLUORESCENT YELLOW GREEN																				"SHSM"-STANDARD HIGHWAY SIGNS AND MARKINGS			
		B	R5-1	30	30			6.25																			INSTALL ON REVERSE OF STOP SIGN	X		
EB	0.408	A	R3-3	48	48		NO TURNS 11/06/14	16.00								2		10.25 X 10.75								IN MEDIAN AT INTERSECTION OF ROUTE 2 AND CLAY POINT RD (TH-58)	X		
		B	R3-3	48	48		NO TURNS	16.00																			X		
EB	0.409	A	D3-1	UNK.	12		CLAY POINT RD 11/04/14						1		X												CLAY POINT RD (TH-58)			
EB	0.409	B	R5-1	30	30		11/04/14						1	X	I			12.25												
		A	R1-1	30	30		STOP	6.25																			IN MEDIAN AT INTERSECTION OF JUGHANDLE AND CLAY POINT RD (TH-58)	X		
		B	R5-1	30	30		DO NOT ENTER	6.25																			INSTALL ON REVERSE OF STOP SIGN	X		
EB	0.409	C	VR-017	24	30								1	~~X~~	I			12.25												
		C	VR-017	24	30		LEGAL LOAD LIMIT 24,000 POUNDS 11/04/14	5.00																			CLAY POINT RD (TH-58); INSTALL WEST OF JUGHANDLE		10	
EB	0.416	D	R1-1	30	30		11/04/14						1	X	~~X~~															
		D	R1-1	30	30		STOP	6.25								~~1~~		~~X~~									CLAY POINT RD (TH-58)	X		
EB	0.417	A	W1-7	48	24		<===> 11/05/14						1		X			12.25 12.25												
		A	VD1-1	72	12		← Clay Point Rd →	6.00								2		X									CLAY POINT RD (TH-58); INSTALL CENTERED ACROSS FROM JUGHANDLE INTERSECTION		9	
EB	0.471	A	R8-7	30	24		11/13/14						1		X			15.00 15.50												
		A	R8-7	48	36		EMERGENCY STOPPING ONLY	12.00								2		X										X		
SIGN SUMMARY SHEET							SHEET TOTALS	80.00	0.00	0	0	0	6	0	0	7		~~100.50~~ 105.0		0	0.0	0.0	0.0	0.0					
								SF	SF	EA	EA	EA	EA	EA	EA	EA		FT		EA	LB	LB	LB	LB					
VERMONT AGENCY OF TRANSPORTATION							TOWN DIRECTIONAL TOTALS	451.3	0.0	68	1	0	57	0	0	44		660.0		0	0.0								

PROJECT NAME: **ALBURGH-COLCHESTER**
PROJECT NUMBER: **STPG SIGN(45)**
FILE NAME: **11 COLCHESTER US2 EB TSS.** PLOT DATE: **3/14/2014**
PROJECT MANAGER: **D. BRYANT** DRAWN BY: **J. BLANCHARD**
DESIGNED BY: **B. TOOTHAKER** CHECKED **K. KERN**
COLCHESTER EB SHEET 3 SHEET **146** OF **167**

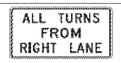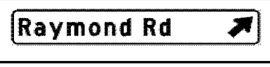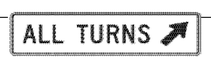DIRECTION	MILEPOINT	LOCATION CODE (SHEET 2)	SIGN CODE	WIDTH (IN)	HEIGHT (IN)	SHEETING REMARKS	SIGN LEGEND	NEW SIGNS "A"	NEW SIGNS "B"	EXISTING SIGNS RETAIN	EXISTING SIGNS SALVAGE FROM	EXISTING SIGNS SALVAGE TO	EXISTING SIGNS REMOVE	EXIST POST RETAIN	EXIST POST REMOVE	NUMBER OF NEW POSTS	SQUARE STEEL (IN) 1.75 (LB/FT) 1.88	SQUARE STEEL (IN) 2.00 (LB/FT) 2.42	SQUARE STEEL (IN) 2.50 (LB/FT) 3.35	TUBULAR STEEL Ø (IN) FOUNDATION	TUBULAR STEEL Ø (IN) 3.00 (LB/FT) 7.60	TUBULAR STEEL Ø (IN) 3.50 (LB/FT) 9.00	TUBULAR STEEL Ø (IN) 4.00 (LB/FT) 10.80	TUBULAR STEEL Ø (IN) 5.00 (LB/FT) 14.60	SIGN FRAME REQUIRED	REMARKS	SIGN DETAIL LOCATION SHSM	SIGN DETAIL LOCATION PROJECT SHEET #	SIGN DETAIL LOCATION STANDARD SHEET #
COLCHESTER US-2 EB							FY-FLUORESCENT YELLOW FYG-FLUORESCENT YELLOW GREEN																			"SHSM"-STANDARD HIGHWAY SIGNS AND MARKINGS			
EB	0.538	A	R2-1	36	48		11/04/14						1	X				14.00											
		A	R2-1	30	36			7.50																		X		
EB	0.640	A	VD-062AS	72	16		BUSINESS SIGN			1				X															
		A	VD-062AS	72	16		BUSINESS SIGN			1																			
EB	0.803	A	VR-428	24	30		ALL TURNS RIGHT LANE 11/04/14						1		X			14.00 14.50									SLIP BASES		
		A	R3-23	60	36			15.00								2	X											
EB	0.860	A	D1-1M	72	12								1	X															
		A	VD1-1	72	12		 11/04/14	6.00									14.00										9	
EB	0.906	A	VR-903R	36	30		THRU/RIGHT ALL TURNS 11/04/14						1		X														
EB	0.939	A	VR-284	36	48		ALL TURNS ===> (45 DEG) 11/04/14						1		X			12.75 13.75											
		A	R3-24	72	18			9.00								2	X										X	
EB	1.022	A	VR-284	30	36		ALL TURNS ===> (45 DEG)						1		X			12.00 12.00											
		A	R3-24	72	18			9.00								2	X										X	
EB	1.033	B	R3-2	24	24		NO LEFT TURN SYMBOL 11/04/14						1		X														
EB	1.037	A	R3-3	48	48			16.00								2	10.75 X 11.25										INSTALL IN MEDIAN AT INTERSECTION OF RTE 2 AND RAYMOND RD RD (TH-40)	X		
							SHEET TOTALS	62.50	0.00	2	0	0	~~8~~ 7	0	0	8	~~129.00~~ ~~120.0~~			0	0.0	0.0	0.0	0.0				
								SF	SF	EA	EA	EA	EA	EA	EA	EA	FT			EA	LB	LB	LB	LB				
							TOWN DIRECTIONAL TOTALS	451.3	0.0	68	1	0	57	0	0	44	660.0			0	0.0							

SIGN SUMMARY SHEET

VERMONT AGENCY OF TRANSPORTATION

PROJECT NAME: ALBURGH-COLCHESTER
PROJECT NUMBER: STPG SIGN(45)

FILE NAME: 11 COLCHESTER US2 EB TSS.
PROJECT MANAGER: D. BRYANT
DESIGNED BY: B. TOOTHAKER
COLCHESTER EB SHEET 4

PLOT DATE: 3/14/2014
DRAWN BY: J. BLANCHARD
CHECKED K. KERN
SHEET 147 OF 167

DIRECTION	MILEPOINT	LOCATION CODE (SHEET 2)	SIGN CODE	WIDTH (IN)	HEIGHT (IN)	SHEETING REMARKS	SIGN LEGEND	NEW SIGNS "A"	NEW SIGNS "B"	EXISTING SIGNS RETAIN	EXISTING SIGNS SALVAGE FROM	EXISTING SIGNS SALVAGE TO	EXISTING SIGNS REMOVE	EXIST POST RETAIN	EXIST POST REMOVE	NUMBER OF NEW POSTS	SQUARE STEEL (IN) 1.75 (LB/FT) 1.88	SQUARE STEEL (IN) 2.00 (LB/FT) 2.42	SQUARE STEEL (IN) 2.50 (LB/FT) 3.35	TUBULAR STEEL Ø (IN) FOUNDATION	TUBULAR STEEL Ø (IN) 3.00 (LB/FT) 7.60	TUBULAR STEEL Ø (IN) 3.50 (LB/FT) 9.00	TUBULAR STEEL Ø (IN) 4.00 (LB/FT) 10.80	TUBULAR STEEL Ø (IN) 5.00 (LB/FT) 14.60	SIGN FRAME REQUIRED	REMARKS	SIGN DETAIL LOCATION SHSM	SIGN DETAIL LOCATION PROJECT SHEET #	SIGN DETAIL LOCATION STANDARD SHEET #
COLCHESTER US-2 EB							FY-FLUORESCENT YELLOW FYG-FLUORESCENT YELLOW GREEN																				"SHSM"-STANDARD HIGHWAY SIGNS AND MARKINGS			
		B	R3-3	48	48		NO TURNS	16.00																				X		
EB	1.037	B	R5-1	30	30		11/04/14						1		X												SLIP BASES			
		A	R1-1	30	30								1																	
		A	R1-1	30	30		STOP	6.25								1		12.50 X									WEST OF JUGHANDLE AT INTERSECTION WITH RAYMOND RD (TH-40)	X		
		B	R5-1	30	30		DO NOT ENTER	6.25																			INSTALL ON REVERSE OF STOP SIGN	X		
EB	1.038	B	R5-1	30	30		11/04/14						1		X															
		A	R1-1	30	30		STOP	6.25								1		12.50 X									IN MEDIAN AT INTERSECTION OF JUGHANDLE AND RAYMOND RD (TH-40)	X		
		B	R5-1	30	30		DO NOT ENTER	6.25																			INSTALL ON REVERSE OF STOP SIGN	X		
EB	1.039	A	D3-1	UNK.	12		RAYMOND RD						1		X												RAYMOND RD (TH-40)			
EB	1.039	C	VR-017	24	30								1		X															
		C	UNK.	UNK.	UNK.		SLOW CHILDREN AT PLAY 11/04/14						1					13.50												
		C	VR-017	24	30		LEGAL LOAD LIMIT 24,000 POUNDS	5.00								1		X									RAYMOND RD (TH-40); INSTALL WEST OF JUGHANDLE		10	
EB	1.046	A	W1-6	48	24		<===> 11/05/14						1		X			12.00 12.00												
		A	VD1-1	72	12		← Raymond Rd →	6.00								2		X									RAYMOND RD (TH-40); INSTALL CENTERED ACROSS FROM JUGHANDLE INTERSECTION		9	
EB	1.047	D	R1-1	30	30		11/05/14						1 1		X															
							SHEET TOTALS	52.00	0.00	0	0	0	~~9~~ 8	0	0	5		~~75.0~~ 62.50			0	0.0	0.0	0.0	0.0					
								SF	SF	EA	EA	EA	EA	EA	EA	EA		FT			EA	LB	LB	LB	LB					
							TOWN DIRECTIONAL TOTALS	451.3	0.0	68	1	0	57	0	0	44		660.0			0			0.0						

SIGN SUMMARY SHEET

VERMONT AGENCY OF TRANSPORTATION

PROJECT NAME: **ALBURGH-COLCHESTER**
PROJECT NUMBER: **STPG SIGN(45)**
FILE NAME: **11 COLCHESTER US2 EB TSS.** PLOT DATE: **3/14/2014**
PROJECT MANAGER: **D. BRYANT** DRAWN BY: **J. BLANCHARD**
DESIGNED BY: **B. TOOTHAKER** CHECKED **K. KERN**
COLCHESTER EB SHEET 5 SHEET **148** OF **167**

DIRECTION	MILEPOINT	LOCATION CODE (SHEET 2)	SIGN CODE	WIDTH (IN)	HEIGHT (IN)	SHEETING REMARKS	SIGN LEGEND	NEW SIGNS "A"	NEW SIGNS "B"	EXISTING SIGNS RETAIN	EXISTING SIGNS SALVAGE FROM	EXISTING SIGNS SALVAGE TO	EXISTING SIGNS REMOVE	EXIST POST RETAIN	EXIST POST REMOVE	NUMBER OF NEW POSTS	SQUARE STEEL (IN) 1.75 / 2.00 / 2.50 (LB / FT) 1.88 / 2.42 / 3.35	TUBULAR STEEL Ø (IN) 3.00 / 3.50 / 4.00 / 5.00 (LB / FT) 7.60 / 9.00 / 10.80 / 14.60	FOUNDATION	SIGN FRAME REQUIRED	REMARKS	SIGN DETAIL LOCATION SHSM	PROJECT SHEET #	STANDARD SHEET #
COLCHESTER US-2 EB							FY-FLUORESCENT YELLOW FYG-FLUORESCENT YELLOW GREEN														"SHSM"-STANDARD HIGHWAY SIGNS AND MARKINGS			
		D	R1-1	30	30		STOP 11/05/14	6.25								1	13.00 X				RAYMOND RD (TH-40)	X		
EB	1.053	A	R2-1	30	36		SPEED LIMIT 55 11/05/14	7.50								1	14.00 X				INSTALL 50 FT EAST OF TH-40	X		
EB	1.096	A	R8-7	30	24		11/05/14						1	X										
		A	R8-7	30	24		EMERGENCY STOPPING ONLY	5.00															X		
EB	1.196	A	R2-1	36	48		11/05/14						1	X										
		A	R2-1	30	36		SPEED LIMIT 55	7.50															X		
EB	1.396	A	W3-5	48	48		11/05/14						1		X		14.00 15.00							
		A	W3-5	36	36		50	9.00								2	X					X		
EB	1.472	A	VR-428	24	30		ALL TURNS RIGHT LANE 11/05/14						1		X		14.00 14.75				SLIP BASES			
		A	R3-23	60	36		ALL TURNS FROM RIGHT LANE	15.00								2	X							
EB	1.505	A	D1-1M	72	12		JASPER MINE RD ---> (45 DEG)						1	X										
		A	VD1-1	72	12		Niquette Bay Rd 11/05/14	6.00																9	
		A	VD1-1	72	12		Jasper Mine Rd	6.00																9	
EB	1.543	A	VR-903R	36	30		THRU/RIGHT ALL TURNS 11/05/14						1		X									
EB	1.560	A	VD-062AS	72	16		BUSINESS SIGN			1				X										
							SHEET TOTALS	62.25	0.00	1	0	0	6	0	0	6	~~84.75~~ 98.0		0	0.0	0.0	0.0	0.0			
								SF	SF	EA	EA	EA	EA	EA	EA	EA	FT		EA	LB	LB	LB	LB			
							TOWN DIRECTIONAL TOTALS	451.3	0.0	68	1	0	57	0	0	44	660.0		0	0.0						

SIGN SUMMARY SHEET

VERMONT AGENCY OF TRANSPORTATION

PROJECT NAME: ALBURGH-COLCHESTER
PROJECT NUMBER: STPG SIGN(45)

FILE NAME: 11 COLCHESTER US2 EB TSS.: PLOT DATE: 3/14/2014
PROJECT MANAGER: D. BRYANT DRAWN BY: J. BLANCHARD
DESIGNED BY: B. TOOTHAKER CHECKED K. KERN
COLCHESTER EB SHEET 6 SHEET 149 OF 167

DIRECTION	MILEPOINT	LOCATION CODE (SHEET 2)	SIGN CODE	WIDTH (IN)	HEIGHT (IN)	SHEETING REMARKS	SIGN LEGEND	NEW SIGNS "A"	NEW SIGNS "B"	EXISTING SIGNS RETAIN	EXISTING SIGNS SALVAGE FROM	EXISTING SIGNS SALVAGE TO	EXISTING SIGNS REMOVE	EXIST POST RETAIN	EXIST POST REMOVE	NUMBER OF NEW POSTS	SQUARE STEEL (IN) 1.75 (LB/FT) 1.88	SQUARE STEEL (IN) 2.00 (LB/FT) 2.42	SQUARE STEEL (IN) 2.50 (LB/FT) 3.35	TUBULAR STEEL Ø (IN) FOUNDATION	TUBULAR STEEL Ø (IN) 3.00 (LB/FT) 7.60	TUBULAR STEEL Ø (IN) 3.50 (LB/FT) 9.00	TUBULAR STEEL Ø (IN) 4.00 (LB/FT) 10.80	TUBULAR STEEL Ø (IN) 5.00 (LB/FT) 14.60	SIGN FRAME REQUIRED	REMARKS	SIGN DETAIL LOCATION SHSM	SIGN DETAIL LOCATION PROJECT SHEET #	SIGN DETAIL LOCATION STANDARD SHEET #
COLCHESTER US-2 EB							FY-FLUORESCENT YELLOW FYG-FLUORESCENT YELLOW GREEN																				"SHSM"-STANDARD HIGHWAY SIGNS AND MARKINGS			
		A	VD-062AS	72	16		BUSINESS SIGN			1																			
EB	1.588	A	VR-284	30	36		ALL TURNS ===> (45 DEG)						1		X			13.75 13.00										
		A	R23-24	72	18		 11/05/14	9.00								2		X								X		
EB	1.627	A	R2-1	30	36																								
EB	1.667	A	VR-284	30	36		ALL TURNS ===> (45 DEG) 11/13/14						1		X			12.25 12.75										
		A	R23-24	72	18			9.00								2		X								X		
EB	1.675	B	R3-2	24	24		NO LEFT TURN SYMBOL						1	~~X~~														
		A	R3-3	24	24		 11/13/14	4.00																	X		
		B	R3-3	24	24			4.00								1		14.00 X							X		
EB	1.675	B	R5-1	30	30								1	~~X~~														
		A	R1-1	30	30		 11/13/14	6.25																	X	IN MEDIAN AT INTERSECTION OF JUGHANDLE AND NIQUETTE BAY RD (TH-8)		
		B	R5-1	30	30			6.25								1		15.50 X							X	INSTALL ON REVERSE OF STOP SIGN		
EB	1.675	A	R1-1	30	30								1	~~X~~														
		B	R5-1	30	30		 11/13/14						1																
		A	R1-1	30	30			6.25								1		14.50 X							X	WEST OF JUGHANDLE AT INTERSECTION WITH NIQUETTE BAY RD (TH-8)		
							SHEET TOTALS	44.75	0.00	1	0	0	6	0	0	4		~~95.75~~ 60.0		0	0.0	0.0	0.0	0.0				
								SF	SF	EA	EA	EA	EA	EA	EA	EA		FT		EA	LB	LB	LB	LB				
							TOWN DIRECTIONAL TOTALS	451.3	0.0	68	1	0	57	0	0	44		660.0		0		0.0						

SIGN SUMMARY SHEET

VERMONT AGENCY OF TRANSPORTATION

PROJECT NAME: ALBURGH-COLCHESTER
PROJECT NUMBER: STPG SIGN(45)
FILE NAME: 11 COLCHESTER US2 EB TSS.
PROJECT MANAGER: D. BRYANT
DESIGNED BY: B. TOOTHAKER
COLCHESTER EB SHEET 7
PLOT DATE: 3/14/2014
DRAWN BY: J. BLANCHARD
CHECKED K. KERN
SHEET 150 OF 167

DIRECTION	MILEPOINT	LOCATION CODE (SHEET 2)	SIGN CODE	WIDTH (IN)	HEIGHT (IN)	SHEETING REMARKS	SIGN LEGEND	NEW SIGNS "A"	NEW SIGNS "B"	EXISTING SIGNS RETAIN	EXISTING SIGNS SALVAGE FROM	EXISTING SIGNS SALVAGE TO	EXISTING SIGNS REMOVE	EXIST POST RETAIN	EXIST POST REMOVE	NUMBER OF NEW POSTS	SQUARE STEEL (IN) 1.75 (LB/FT) 1.88	SQUARE STEEL (IN) 2.00 (LB/FT) 2.42	SQUARE STEEL (IN) 2.50 (LB/FT) 3.35	TUBULAR STEEL Ø (IN) FOUNDATION	TUBULAR STEEL Ø (IN) 3.00 (LB/FT) 7.60	TUBULAR STEEL Ø (IN) 3.50 (LB/FT) 9.00	TUBULAR STEEL Ø (IN) 4.00 (LB/FT) 10.80	TUBULAR STEEL Ø (IN) 5.00 (LB/FT) 14.60	SIGN FRAME REQUIRED	REMARKS	SIGN DETAIL LOCATION SHSM	SIGN DETAIL LOCATION PROJECT SHEET #	SIGN DETAIL LOCATION STANDARD SHEET #
COLCHESTER US-2 EB							FY-FLUORESCENT YELLOW FYG-FLUORESCENT YELLOW GREEN																				"SHSM"-STANDARD HIGHWAY SIGNS AND MARKINGS			
		B	R5-1	30	30			6.25																			INSTALL ON REVERSE OF STOP SIGN	X		
EB	1.677	C	VR-017	24	30		11/13/14						1	X															
		C	VR-017	24	30		LEGAL LOAD LIMIT 24,000 POUNDS	5.00																			NIQUETTE BAY RD (TH-8); INSTALL WEST OF JUGHANDLE		10	
EB	1.683	A	W1-6	48	24		<===>						1		X														
		A	VD1-1	72	12		Jasper Mine Rd 11/13/14	6.00																					9	
		A	VD1-1	72	12		Niquette Bay Rd	6.00								2		14.75 X 14.75									NIQUETTE BAY RD (TH-8); INSTALL CENTERED ACROSS FROM JUGHANDLE INTERSECTION		9	
EB	1.683	D	R1-1	30	30		11/13/14						1	~~X~~															
		D	R1-1	30	30		STOP	6.25								1		14.25 X									NIQUETTE BAY RD (TH-8)	X		
EB	1.685	A	D1-1	72	18		ROOSEVELT HWY 11/13/14						1		X														
		A	D1-1	72	18		JASPER MINE RD --->						1																
		A	D1-1	72	18		<--- NIQUETTE'S BAY						1																
EB	1.711	A	R2-1	24	30								1	X															
		A	R2-1	24	30		SPEED LIMIT 50	5.00																				X		
EB	1.713	A	UNK.	UNK.	UNK.		I-89 SOUTH WINOOSKI BURLINGTON NEXT RIGHT			1				X																
EB	1.761	A	M3-1	24	12		NORTH INTERSTATE			1				X																
SIGN SUMMARY SHEET							SHEET TOTALS	34.50	0.00	2	0	0	7	0	0	2		~~43.75~~ ~~36.0~~ FT		0	0.0	0.0	0.0	0.0					
								SF	SF	EA	EA	EA	EA	EA	EA	EA				EA	LB	LB	LB	LB					
VERMONT AGENCY OF TRANSPORTATION							TOWN DIRECTIONAL TOTALS	451.3	0.0	68	1	0	57	0	0	44		660.0		0	0.0								

PROJECT NAME: **ALBURGH-COLCHESTER**
PROJECT NUMBER: **STPG SIGN(45)**
FILE NAME: **11 COLCHESTER US2 EB TSS.**
PROJECT MANAGER: **D. BRYANT**
DESIGNED BY: **B. TOOTHAKER**
COLCHESTER EB SHEET 8
PLOT DATE: **3/14/2014**
DRAWN BY: **J. BLANCHARD**
CHECKED **K. KERN**
SHEET **151** OF **167**

DIRECTION	MILEPOINT	LOCATION CODE (SHEET 2)	SIGN CODE	WIDTH (IN)	HEIGHT (IN)	SHEETING REMARKS	SIGN LEGEND	NEW SIGNS "A"	NEW SIGNS "B"	EXISTING SIGNS RETAIN	EXISTING SIGNS SALVAGE FROM	EXISTING SIGNS SALVAGE TO	EXISTING SIGNS REMOVE	EXIST POST RETAIN	EXIST POST REMOVE	NUMBER OF NEW POSTS	SQUARE STEEL (IN) 1.75 (LB / FT) 1.88	SQUARE STEEL (IN) 2.00 (LB / FT) 2.42	SQUARE STEEL (IN) 2.50 (LB / FT) 3.35	TUBULAR STEEL Ø (IN) FOUNDATION	TUBULAR STEEL Ø (IN) 3.00 (LB / FT) 7.60	TUBULAR STEEL Ø (IN) 3.50 (LB / FT) 9.00	TUBULAR STEEL Ø (IN) 4.00 (LB / FT) 10.80	TUBULAR STEEL Ø (IN) 5.00 (LB / FT) 14.60	SIGN FRAME REQUIRED	REMARKS	SIGN DETAIL LOCATION SHSM	SIGN DETAIL LOCATION PROJECT SHEET #	SIGN DETAIL LOCATION STANDARD SHEET #
COLCHESTER US-2 EB							FY-FLUORESCENT YELLOW FYG-FLUORESCENT YELLOW GREEN																				"SHSM"-STANDARD HIGHWAY SIGNS AND MARKINGS			
		A	M1-1	24	24		INTERSTATE 89			1																			
		A	M6-3	21	15		^UP ARROW INTERSTATE			1																			
		A	M3-2	24	12		EAST US			1																			
		A	M1-4	24	24		US 2			1																			
		A	M6-3	21	15		^UP ARROW US			1																			
		A	M3-3	24	12		SOUTH INTERSTATE			1																			
		A	M1-1	24	24		INTERSTATE 89			1																			
		A	M6-1	21	15		RIGHT ---> INTERSTATE			1																			
EB	1.806	A	W3-3	36	36		SIGNAL AHEAD SYMBOL	9.00		1				X															
EB	1.808	A	E6-1A	120	126		I89 SOUTH WINOOSKI BURLINGTON			1				X															
EB	1.852	A	W11-1	30	30			6.25								1	X ~~17.50~~										INSTALL 232 FT EAST OF LARGE INTERSTATE PANEL	X		
		A	W16-1P	18	24			3.00																				X		
EB	1.931	B	M3-3	24	12		SOUTH INTERSTATE			1				X															
		B	M1-1	24	24		INTERSTATE 89			1																			
		B	M6-1	21	15		<--- LEFT INTERSTATE			1																			
SIGN SUMMARY SHEET							SHEET TOTALS	~~18.25~~ 9.25 SF	0.00 SF	13 EA	0 EA	0 EA	0 EA	0 EA	0 EA	1 EA	~~17.50~~ 15.0 FT		0 EA	0.0 LB	0.0 LB	0.0 LB	0.0 LB				
VERMONT AGENCY OF TRANSPORTATION							TOWN DIRECTIONAL TOTALS	451.3	0.0	68	1	0	57	0	0	44	660.0		0	0.0								

PROJECT NAME: **ALBURGH-COLCHESTER**
PROJECT NUMBER: **STPG SIGN(45)**
FILE NAME: **11 COLCHESTER US2 EB TSS.**; PLOT DATE: **3/14/2014**
PROJECT MANAGER: **D. BRYANT**; DRAWN BY: **J. BLANCHARD**
DESIGNED BY: **B. TOOTHAKER**; CHECKED **K. KERN**
COLCHESTER EB SHEET 9
SHEET **152** OF **167**

DIRECTION	MILEPOINT	LOCATION CODE (SHEET 2)	SIGN CODE	WIDTH (IN)	HEIGHT (IN)	SHEETING REMARKS	SIGN LEGEND	NEW SIGNS "A"	NEW SIGNS "B"	EXISTING SIGNS RETAIN	EXISTING SIGNS SALVAGE FROM	EXISTING SIGNS SALVAGE TO	EXISTING SIGNS REMOVE	EXIST POST RETAIN	EXIST POST REMOVE	NUMBER OF NEW POSTS	SQUARE STEEL (IN) 1.75 (LB / FT) 1.88	SQUARE STEEL (IN) 2.00 (LB / FT) 2.42	SQUARE STEEL (IN) 2.50 (LB / FT) 3.35	TUBULAR STEEL Ø (IN) FOUNDATION	TUBULAR STEEL Ø (IN) 3.00 (LB / FT) 7.60	TUBULAR STEEL Ø (IN) 3.50 (LB / FT) 9.00	TUBULAR STEEL Ø (IN) 4.00 (LB / FT) 10.80	TUBULAR STEEL Ø (IN) 5.00 (LB / FT) 14.60	SIGN FRAME REQUIRED	REMARKS	SIGN DETAIL LOCATION SHSM	SIGN DETAIL LOCATION PROJECT SHEET #	SIGN DETAIL LOCATION STANDARD SHEET #
COLCHESTER US-2 EB							FY-FLUORESCENT YELLOW FYG-FLUORESCENT YELLOW GREEN																			"SHSM"-STANDARD HIGHWAY SIGNS AND MARKINGS			
EB	1.942	C	M3-2	24	12		EAST US			1				X															
		C	M1-4	24	24		US 2			1																			
		C	M6-1	21	15		<--- LEFT US			1																			
		C	M4-5	24	12		TO US			1																			
		C	M1-4	24	24		US 7			1																			
		C	M6-1	21	15		<--- LEFT US			1																			
		C	M3-4	24	12		WEST US			1																			
		C	M1-4	24	24		US 2			1																			
		C	M6-1	21	15		RIGHT ---> US			1																			
EB	1.952	A	M2-1	21	15		JCT US			1				X															
		A	M1-4	24	24		US 7			1																			
EB	1.979	A	W11-1	24	24		BICYCLE SYMBOL			1				X															
		A	W16-1	18	18		SHARE THE ROAD			1																			
EB	2.078	A	M3-1	24	12		ROUTE MARKER ASSEMBLY 11/05/14						1	X															
		A	M1-1	24	24								1																
							SHEET TOTALS	0.00	0.00	13	0	0	2	0	0	0	0.0			0	0.0	0.0	0.0	0.0					
								SF	SF	EA	EA	EA	EA	EA	EA	EA	FT			EA	LB	LB	LB	LB					
							TOWN DIRECTIONAL TOTALS	451.3	0.0	68	1	0	57	0	0	44	660.0			0	0.0								

SIGN SUMMARY SHEET

VERMONT AGENCY OF TRANSPORTATION

PROJECT NAME: ALBURGH-COLCHESTER
PROJECT NUMBER: STPG SIGN(45)

FILE NAME: 11 COLCHESTER US2 EB TSS.; PLOT DATE: 3/14/2014
PROJECT MANAGER: D. BRYANT; DRAWN BY: J. BLANCHARD
DESIGNED BY: B. TOOTHAKER; CHECKED K. KERN
COLCHESTER EB SHEET 10; SHEET 153 OF 167

DIRECTION	MILEPOINT	LOCATION CODE (SHEET 2)	SIGN CODE	WIDTH (IN)	HEIGHT (IN)	SHEETING REMARKS	SIGN LEGEND	NEW SIGNS "A"	NEW SIGNS "B"	EXISTING SIGNS RETAIN	EXISTING SIGNS SALVAGE FROM	EXISTING SIGNS SALVAGE TO	EXISTING SIGNS REMOVE	EXIST POST RETAIN	EXIST POST REMOVE	NUMBER OF NEW POSTS	SQUARE STEEL (IN) 1.75 (LB/FT) 1.88	SQUARE STEEL (IN) 2.00 (LB/FT) 2.42	SQUARE STEEL (IN) 2.50 (LB/FT) 3.35	TUBULAR STEEL Ø (IN) FOUNDATION	TUBULAR STEEL Ø (IN) 3.00 (LB/FT) 7.60	TUBULAR STEEL Ø (IN) 3.50 (LB/FT) 9.00	TUBULAR STEEL Ø (IN) 4.00 (LB/FT) 10.80	TUBULAR STEEL Ø (IN) 5.00 (LB/FT) 14.60	SIGN FRAME REQUIRED	REMARKS	SIGN DETAIL LOCATION SHSM	SIGN DETAIL LOCATION PROJECT SHEET #	SIGN DETAIL LOCATION STANDARD SHEET #
COLCHESTER US-2 EB							FY-FLUORESCENT YELLOW FYG-FLUORESCENT YELLOW GREEN																				"SHSM"-STANDARD HIGHWAY SIGNS AND MARKINGS			
		A	M5-1	21	15		11/05/14						1					16.00											
		A	M3-1	24	12	WHT/BLU		2.00																			X		
		A	M1-1	24	24	WHT/BLU		4.00																			X		
		A	M5-1L	21	15	WHT/BLU		2.19																			X		
EB	2.103	C	D4-2	30	36		<=== PARK AND RIDE			1				X															
		C	D1-1A	72	10		<--- COLCHESTER 4			1																			
		C	D1-1A	72	10		<--- MILTON 5			1																			
		C	D1-1A	72	10		SOUTH HERO 9 --->			1																			
		C	M3-2	24	12		EAST US			1																			
		C	M1-4	24	24		US 2			1																			
		C	M6-1	21	15		<--- LEFT US			1																			
		C	M4-5	24	12		TO US			1																			
		C	M1-4	24	24		US 7			1																			
		C	M6-1	21	15		<=== US			1																			
		C	M1-4	24	24		US 2			1																			
SIGN SUMMARY SHEET							SHEET TOTALS	8.19	0.00	11	0	0	1	0	0	0		16.00 0.0		0	0.0	0.0	0.0	0.0					
								SF	SF	EA	EA	EA	EA	EA	EA	EA		FT		EA	LB	LB	LB	LB					
VERMONT AGENCY OF TRANSPORTATION							TOWN DIRECTIONAL TOTALS	451.3	0.0	68	1	0	57	0	0	44		660.0		0		0.0							

PROJECT NAME: ALBURGH-COLCHESTER
PROJECT NUMBER: STPG SIGN(45)
FILE NAME: 11 COLCHESTER US2 EB TSS.; PLOT DATE: 3/14/2014
PROJECT MANAGER: D. BRYANT DRAWN BY: J. BLANCHARD
DESIGNED BY: B. TOOTHAKER CHECKED K. KERN
COLCHESTER EB SHEET 11 SHEET 154 OF 167

DIRECTION	MILEPOINT	LOCATION CODE (SHEET 2)	SIGN CODE	WIDTH (IN)	HEIGHT (IN)	SHEETING REMARKS	SIGN LEGEND	NEW SIGNS		EXISTING SIGNS				EXIST POST		NUMBER OF NEW POSTS	SQUARE STEEL (IN)			TUBULAR STEEL Ø (IN)				SIGN FRAME REQUIRED	REMARKS	SIGN DETAIL LOCATION		
								"A"	"B"	RETAIN	SALVAGE FROM	SALVAGE TO	REMOVE	RETAIN	REMOVE		1.75 (LB / FT) 1.88	2.00 (LB / FT) 2.42	2.50 (LB / FT) 3.35	FOUNDATION	3.00 (LB / FT) 7.60	3.50 (LB / FT) 9.00	4.00 (LB / FT) 10.80	5.00 (LB / FT) 14.60			SHSM	PROJECT SHEET #	STANDARD SHEET #
COLCHESTER US-2 EB							FY-FLUORESCENT YELLOW FYG-FLUORESCENT YELLOW GREEN																		"SHSM"-STANDARD HIGHWAY SIGNS AND MARKINGS			
		C	M3-4	24	12		WEST US			1																		
		C	M6-1	21	15		RIGHT ---> US			1																		
EB	2.120	A	E6-1A	120	126		<== (45 DEG UP) I89 NORTH GEORGIA ST ALBANS MONTREAL			1				X														
EB	2.137	A	VD-502C	54	7.5		CAMPING 4 --->			1				X														
		A	VD-502GD	54	7.5		GAS/DIESEL --->			1																		
		A	VD-502G2	54	7.5		<-- GAS 24 HRS			1																		
		A	VD-502F	54	7.5		<--- 3 FOOD			1																		
		A	D1-1M	72	10		<--- PARK & RIDE			1																		
		A	VD-502P	54	7.5		<--- PHONE			1																		
EB	2.150	J	OM1-1	18	18		YELLOW OBJECT MARKER			1				X														
		J	R4-7	24	30		RIGHT BULLNOSE			1																		
		K	OM1-1	18	18		YELLOW OBJECT MARKER			1																		
EB	2.154	A	VR-925	36	30		LEFT ONLY/ RIGHT ONLY			1				X														
EB	2.181	A	D1-1A	72	10		<-- MILTON 5			1				X														
		A	D1-1A	72	10		COLCHESTER 4 -->			1																		
							SHEET TOTALS	0.00 SF	0.00 SF	15 EA	0 EA	0 EA	0 EA	0 EA	0 EA	0 EA		0.0 FT		0 EA	0.0 LB	0.0 LB	0.0 LB	0.0 LB					
							TOWN DIRECTIONAL TOTALS	451.3	0.0	68	1	0	57	0	0	44		660.0		0		0.0									

SIGN SUMMARY SHEET

VERMONT AGENCY OF TRANSPORTATION

PROJECT NAME: ALBURGH-COLCHESTER
PROJECT NUMBER: STPG SIGN(45)

FILE NAME: 11 COLCHESTER US2 EB TSS.
PLOT DATE: 3/14/2014
PROJECT MANAGER: D. BRYANT
DRAWN BY: J. BLANCHARD
DESIGNED BY: B. TOOTHAKER
CHECKED K. KERN
COLCHESTER EB SHEET 12
SHEET 155 OF 167

DIRECTION	MILEPOINT	LOCATION CODE (SHEET 2)	SIGN CODE	WIDTH (IN)	HEIGHT (IN)	SHEETING REMARKS	SIGN LEGEND	NEW SIGNS "A"	NEW SIGNS "B"	EXISTING SIGNS RETAIN	EXISTING SIGNS SALVAGE FROM	EXISTING SIGNS SALVAGE TO	EXISTING SIGNS REMOVE	EXIST POST RETAIN	EXIST POST REMOVE	NUMBER OF NEW POSTS	SQUARE STEEL (IN) 1.75 (LB / FT) 1.88	SQUARE STEEL (IN) 2.00 (LB / FT) 2.42	SQUARE STEEL (IN) 2.50 (LB / FT) 3.35	TUBULAR STEEL Ø (IN) FOUNDATION	TUBULAR STEEL Ø (IN) 3.00 (LB / FT) 7.60	TUBULAR STEEL Ø (IN) 3.50 (LB / FT) 9.00	TUBULAR STEEL Ø (IN) 4.00 (LB / FT) 10.80	TUBULAR STEEL Ø (IN) 5.00 (LB / FT) 14.60	SIGN FRAME REQUIRED	REMARKS	SIGN DETAIL LOCATION SHSM	SIGN DETAIL LOCATION PROJECT SHEET #	SIGN DETAIL LOCATION STANDARD SHEET #
COLCHESTER US-2 EB							FY-FLUORESCENT YELLOW FYG-FLUORESCENT YELLOW GREEN																			"SHSM"-STANDARD HIGHWAY SIGNS AND MARKINGS			
		A	M3-1	24	12		NORTH US			1																		
		A	M1-4	24	24		US-7			1																		
		A	M6-1	21	15		<-- LEFT ARROW US			1																		
		A	M3-2	24	12		EAST US			1																		
		A	M1-4	24	24		US-2			1																		
		A	M6-1	21	15		RIGHT ARROW -->			1																		
		A	M3-3	24	12		SOUTH US			1																		
		A	M1-4	24	24		US-7			1																		
		A	M6-1	21	15		RIGHT ARROW -->			1																		
SIGN SUMMARY SHEET							SHEET TOTALS	0.00 SF	0.00 SF	9 EA	0 EA	0 EA	0 EA	0 EA	0 EA	0 EA	0.0 FT		0 EA	0.0 LB	0.0 LB	0.0 LB	0.0 LB					
VERMONT AGENCY OF TRANSPORTATION							TOWN DIRECTIONAL TOTALS	~~451.3~~ 403.44 SF	0.0 SF	68 EA	1 EA	0 EA	~~57~~ 65 EA	0 EA	0 EA	44 EA	~~660.0~~ 637.50 FT		0 EA	0.0								

PROJECT NAME: ALBURGH-COLCHESTER
PROJECT NUMBER: STPG SIGN(45)
FILE NAME: 11 COLCHESTER US2 EB TSS.; PLOT DATE: 3/14/2014
PROJECT MANAGER: D. BRYANT; DRAWN BY: J. BLANCHARD
DESIGNED BY: B. TOOTHAKER; CHECKED K. KERN
COLCHESTER EB SHEET 13; SHEET 156 OF 167


DIRECTION	MILEPOINT	LOCATION CODE (SHEET 2)	SIGN CODE	WIDTH (IN)	HEIGHT (IN)	SHEETING REMARKS	SIGN LEGEND	NEW SIGNS		EXISTING SIGNS				EXIST POST		NUMBER OF NEW POSTS	SQUARE STEEL (IN)			TUBULAR STEEL Ø (IN)				SIGN FRAME REQUIRED	REMARKS	SIGN DETAIL LOCATION		
								"A"	"B"	RETAIN	SALVAGE FROM	SALVAGE TO	REMOVE	RETAIN	REMOVE		1.75 (LB / FT) 1.88	2.00 (LB / FT) 2.42	2.50 (LB / FT) 3.35	FOUNDATION	3.00 (LB / FT) 7.60	3.50 (LB / FT) 9.00	4.00 (LB / FT) 10.80	5.00 (LB / FT) 14.60			SHSM	PROJECT SHEET #	STANDARD SHEET #
COLCHESTER US-2 WB							FY-FLUORESCENT YELLOW FYG-FLUORESCENT YELLOW GREEN																		"SHSM"-STANDARD HIGHWAY SIGNS AND MARKINGS			
WB	2.183	K	R4-7	24	30		RIGHT BULLNOSE			1				X													
		J	OM1-1	18	18		YELLOW MARKER			1																	
		K	OM1-1	18	18		YELLOW MARKER			1																	
WB	2.167	F	M3-4	24	12		JCT INTERSTATE			1				X													
		F	M1-4	24	24		I-89			1																	
		F	M2-1	21	15		WEST STATE			1																	
		F	M1-1	24	24		US-2			1																	
WB	2.130	F	E6-1A	120	126		I89 NORTH ===> GEORGIA ST ALBANS MONTREAL			1				X													
WB	2.087	F	W4-1R	36	36		MERGE RIGHT SYMBOL			1				X													
WB	2.047	F	W16-1	18	18		SHARE THE ROAD			1				X													
		F	W11-1	24	24		BICYCLE SYMBOL			1																	
WB	2.03	F	M3-4	24	12		WEST US			1				X													
		F	M1-4	24	24		US 2			1																	
WB	1.974	F	VR-921L	30	30		LEFT "ONLY"/THRU			1				X													
WB	1.961	F	R3-7L	30	30								1	X													
							SHEET TOTALS	0.00	0.00	14	0	0	1	0	0	0	0.0			0	0.0	0.0	0.0	0.0				
								SF	SF	EA	EA	EA	EA	EA	EA	EA		FT		EA	LB	LB	LB	LB				
							TOWN DIRECTIONAL TOTALS	464.5	0.0	22	0	0	52	0	0	43	645.0			0	0.0							

SIGN SUMMARY SHEET

VERMONT AGENCY OF TRANSPORTATION

PROJECT NAME: ALBURGH-COLCHESTER
PROJECT NUMBER: STPG SIGN(45)


FILE NAME: 12 COLCHESTER US2 WB TSS PLOT DATE: 3/14/2014
PROJECT MANAGER: D. BRYANT DRAWN BY: J. BLANCHARD
DESIGNED BY: B. TOOTHAKER CHECKED K. KERN
COLCHESTER WB SHEET 1 SHEET 157 OF 167

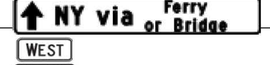DIRECTION	MILEPOINT	LOCATION CODE (SHEET 2)	SIGN CODE	WIDTH (IN)	HEIGHT (IN)	SHEETING REMARKS	SIGN LEGEND	NEW SIGNS "A"	NEW SIGNS "B"	EXISTING SIGNS RETAIN	EXISTING SIGNS SALVAGE FROM	EXISTING SIGNS SALVAGE TO	EXISTING SIGNS REMOVE	EXIST POST RETAIN	EXIST POST REMOVE	NUMBER OF NEW POSTS	SQUARE STEEL (IN) 1.75 (LB/FT) 1.88	SQUARE STEEL (IN) 2.00 (LB/FT) 2.42	SQUARE STEEL (IN) 2.50 (LB/FT) 3.35	TUBULAR STEEL Ø (IN) FOUNDATION	TUBULAR STEEL Ø (IN) 3.00 (LB/FT) 7.60	TUBULAR STEEL Ø (IN) 3.50 (LB/FT) 9.00	TUBULAR STEEL Ø (IN) 4.00 (LB/FT) 10.80	TUBULAR STEEL Ø (IN) 5.00 (LB/FT) 14.60	SIGN FRAME REQUIRED	REMARKS	SIGN DETAIL LOCATION SHSM	SIGN DETAIL LOCATION PROJECT SHEET #	SIGN DETAIL LOCATION STANDARD SHEET #
COLCHESTER US-2 WB							FY-FLUORESCENT YELLOW FYG-FLUORESCENT YELLOW GREEN																				"SHSM"-STANDARD HIGHWAY SIGNS AND MARKINGS			
		F	R3-7L	30	30		 12/18/14	6.25																			X		
WB	1.950	F	M3-3	24	12		SOUTH INTERSTATE			1				X															
		F	M1-1	24	24		I-89			1																			
		F	M6-1	21	15		<-- LEFT ARROW INTERSTATE			1																			
WB	1.950	N	R10-12	24	30		LEFT TURN YIELD ON GREEN LIGHT SYMBOL			1				X															
WB	1.947	F	E6-1A	120	98		<== I89 SOUTH WINOOSKI BURLINGTON			1				X															
WB	1.906	F	D1-1M	72	12		ROUTE MARKER AND D-BOARD ASSEMBLY 12/17/14						1	X															
		F	D1-1G	72	12								1																
		F	D1-1M	72	12								1																
		F	M3-4	24	12								1																
		F	M1-4	24	24								1																
		F	VD1-1	72	12			6.00																			9	
		F	VD1-1	72	12			6.00																			9	
		F	VD1-1	72	12			6.00																			9	
		F	M3-4	24	12	BLK/WHT		2.00																			X		
SIGN SUMMARY SHEET							SHEET TOTALS	26.25	0.00	5	0	0	5	0	0	0	0.0			0	0.0	0.0	0.0	0.0					
								SF	SF	EA	EA	EA	EA	EA	EA	EA	FT			EA	LB	LB	LB	LB					
VERMONT AGENCY OF TRANSPORTATION							TOWN DIRECTIONAL TOTALS	464.5	0.0	22	0	0	52	0	0	43	645.0			0	0.0								

PROJECT NAME: ALBURGH-COLCHESTER
PROJECT NUMBER: STPG SIGN(45)

FILE NAME: 12 COLCHESTER US2 WB TSS
PROJECT MANAGER: D. BRYANT
DESIGNED BY: B. TOOTHAKER
COLCHESTER WB SHEET 2


PLOT DATE: 3/14/2014
DRAWN BY: J. BLANCHARD
CHECKED K. KERN

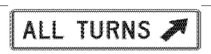DIRECTION	MILEPOINT	LOCATION CODE (SHEET 2)	SIGN CODE	WIDTH (IN)	HEIGHT (IN)	SHEETING REMARKS	SIGN LEGEND	NEW SIGNS "A"	NEW SIGNS "B"	EXISTING SIGNS RETAIN	EXISTING SIGNS SALVAGE FROM	EXISTING SIGNS SALVAGE TO	EXISTING SIGNS REMOVE	EXIST POST RETAIN	EXIST POST REMOVE	NUMBER OF NEW POSTS	SQUARE STEEL (IN) 1.75 / 2.00 / 2.50 (LB / FT) 1.88 / 2.42 / 3.35	TUBULAR STEEL Ø (IN) FOUNDATION	TUBULAR STEEL Ø (IN) 3.00 / 3.50 / 4.00 / 5.00 (LB / FT) 7.60 / 9.00 / 10.80 / 14.60	SIGN FRAME REQUIRED	REMARKS	SIGN DETAIL LOCATION SHSM	SIGN DETAIL LOCATION PROJECT SHEET #	SIGN DETAIL LOCATION STANDARD SHEET #
COLCHESTER US-2 WB							FY-FLUORESCENT YELLOW FYG-FLUORESCENT YELLOW GREEN														"SHSM"-STANDARD HIGHWAY SIGNS AND MARKINGS			
		F	M1-4	24	24	BLK/ WHT		4.00														X		
WB	1.855	F	VR-428	24	30		ALL TURNS RIGHT LANE 10/30/14						X 1		X		14.50 13.50				SLIP BASES			
		F	R3-23	60	36			15.00								2	X					X		
WB	1.807	F	D1-1M	72	12		JASPER MINE RD ---> (45 DEG)						1 1	X										
		F	VD1-1	72	12		 11/05/14	6.00														9	
		F	VD1-1	72	12			6.00														9	
WB	1.776	F	VR-903R	36	30		THRU/RIGHT ALL TURNS						1		X		12.50 13.50							
		F	R3-24	72	18			9.00								2	X					X		
WB	1.739	F	VR-284	30	36		ALL TURNS ===> (45 DEG)						1		X		13.50 12.75							
		F	R3-24	72	18			9.00								2	X					X		
WB	1.688	F	R3-3	24	24			4.00								1	12.50 X				INSTALL IN MEDIAN AT INTERSECTION RTE 2 AND JASPER MINE RD (TH-103)	X		
		E	R3-3	24	24			4.00														X		
WB	1.686	F	R1-1	30	30								1		X									
		E	R5-1	30	30								1				13.50							
		F	R1-1	30	30			6.25								1	X				EAST OF JUGHANDLE AT INTERSECTION WITH JASPER MINE RD (TH-103)	X		
SIGN SUMMARY SHEET							SHEET TOTALS	63.25	0.00	0	0	0	~~7~~ 5	0	0	8	~~106.25~~ 120.0	0	0.0	0.0	0.0	0.0			
								SF	SF	EA	EA	EA	EA	EA	EA	EA	FT	EA	LB	LB	LB	LB			
VERMONT AGENCY OF TRANSPORTATION							TOWN DIRECTIONAL TOTALS	464.5	0.0	22	0	0	52	0	0	43	645.0	0	0.0						

PROJECT NAME: ALBURGH-COLCHESTER
PROJECT NUMBER: STPG SIGN(45)

FILE NAME: 12 COLCHESTER US2 WB TSS
PROJECT MANAGER: D. BRYANT
DESIGNED BY: B. TOOTHAKER
COLCHESTER WB SHEET 3

PLOT DATE: 3/14/2014
DRAWN BY: J. BLANCHARD
CHECKED K. KERN
SHEET 159 OF 167

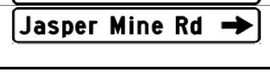DIRECTION	MILEPOINT	LOCATION CODE (SHEET 2)	SIGN CODE	WIDTH (IN)	HEIGHT (IN)	SHEETING REMARKS	SIGN LEGEND	NEW SIGNS "A"	NEW SIGNS "B"	EXISTING SIGNS RETAIN	EXISTING SIGNS SALVAGE FROM	EXISTING SIGNS SALVAGE TO	EXISTING SIGNS REMOVE	EXIST POST RETAIN	EXIST POST REMOVE	NUMBER OF NEW POSTS	SQUARE STEEL (IN) 1.75 (LB/FT) 1.88	SQUARE STEEL (IN) 2.00 (LB/FT) 2.42	SQUARE STEEL (IN) 2.50 (LB/FT) 3.35	TUBULAR STEEL Ø (IN) FOUNDATION	TUBULAR STEEL Ø (IN) 3.00 (LB/FT) 7.60	TUBULAR STEEL Ø (IN) 3.50 (LB/FT) 9.00	TUBULAR STEEL Ø (IN) 4.00 (LB/FT) 10.80	TUBULAR STEEL Ø (IN) 5.00 (LB/FT) 14.60	SIGN FRAME REQUIRED	REMARKS	SIGN DETAIL LOCATION SHSM	SIGN DETAIL LOCATION PROJECT SHEET #	SIGN DETAIL LOCATION STANDARD SHEET #
COLCHESTER US-2 WB							FY-FLUORESCENT YELLOW FYG-FLUORESCENT YELLOW GREEN																			"SHSM"-STANDARD HIGHWAY SIGNS AND MARKINGS			
		E	R5-1	30	30			6.25																		INSTALL ON REVERSE OF STOP SIGN	X		
WB	1.686	G	VR-017	24	30								1	X				13.00											
		G	VR-017	24	30			5.00																		JASPER MINE RD (TH-103); INSTALL EAST OF JUGHANDLE		10	
WB	1.686	E	R5-1	30	30								~~1~~ 3	~~X~~																
		F	R1-1	30	30			6.25										12.75								IN MEDIAN AT INTERSECTION OF JUGHANDLE AND JASPER MINE RD (TH-103)	X		
		E	R5-1	30	30			6.25																		INSTALL ON REVERSE OF STOP SIGN	X		
WB	1.674	F	W1-6	48	24		<====						1		X														
		F	VD1-1	72	12			6.00										12.25 12.25									9	
		F	VD1-1	72	12			6.00								2		X								JASPER MINE RD (TH-103); INSTALL CENTERED ACROSS FROM JUGHANDLE INTERSECTION		9	
WB	1.673	F	D1-1	72	18		NIQUETTE'S BAY <===						1		X														
		F	D1-1	72	18		JASPER MINE RD ===>						1																
		F	D1-1	72	18		ROOSEVELT						1																
WB	1.673	H	R1-1	30	30		LLL	5.00					1		X				13.00 13.25										
		H	R1-1	30	30			6.25								1		X								JASPER MINE RD (TH-103)	X		
WB	1.667	F	M4-14	24	12								1	X															
SIGN SUMMARY SHEET							SHEET TOTALS	~~47.00~~ 42.00	0.00	0	0	0	~~10~~ 8	0	0	3		~~76.50~~ 45.0		0	0.0	0.0	0.0	0.0					
								SF	SF	EA	EA	EA	EA	EA	EA	EA		FT		EA	LB	LB	LB	LB					
VERMONT AGENCY OF TRANSPORTATION							TOWN DIRECTIONAL TOTALS	464.5	0.0	22	0	0	52	0	0	43		645.0		0	0.0								

PROJECT NAME: ALBURGH-COLCHESTER
PROJECT NUMBER: STPG SIGN(45)

FILE NAME: 12 COLCHESTER US2 WB TSS PLOT DATE: 3/14/2014
PROJECT MANAGER: D. BRYANT DRAWN BY: J. BLANCHARD
DESIGNED BY: B. TOOTHAKER CHECKED K. KERN
COLCHESTER WB SHEET 4 SHEET 160 OF 167


DIRECTION	MILEPOINT	LOCATION CODE (SHEET 2)	SIGN CODE	WIDTH (IN)	HEIGHT (IN)	SHEETING REMARKS	SIGN LEGEND	NEW SIGNS "A"	NEW SIGNS "B"	EXISTING SIGNS RETAIN	EXISTING SIGNS SALVAGE FROM	EXISTING SIGNS SALVAGE TO	EXISTING SIGNS REMOVE	EXIST POST RETAIN	EXIST POST REMOVE	NUMBER OF NEW POSTS	SQUARE STEEL (IN) 1.75 (LB/FT) 1.88	SQUARE STEEL (IN) 2.00 (LB/FT) 2.42	SQUARE STEEL (IN) 2.50 (LB/FT) 3.35	TUBULAR STEEL Ø (IN) FOUNDATION	TUBULAR STEEL Ø (IN) 3.00 (LB/FT) 7.60	TUBULAR STEEL Ø (IN) 3.50 (LB/FT) 9.00	TUBULAR STEEL Ø (IN) 4.00 (LB/FT) 10.80	TUBULAR STEEL Ø (IN) 5.00 (LB/FT) 14.60	SIGN FRAME REQUIRED	REMARKS	SIGN DETAIL LOCATION SHSM	SIGN DETAIL LOCATION PROJECT SHEET #	SIGN DETAIL LOCATION STANDARD SHEET #
COLCHESTER US-2 WB							FY-FLUORESCENT YELLOW FYG-FLUORESCENT YELLOW GREEN																				"SHSM"-STANDARD HIGHWAY SIGNS AND MARKINGS			
		F	D11-1	24	18								1																
		F	M4-14	24	12	WHT/GRN	BEGIN	2.00										14.00										X		
		F	D11-1	24	18		BIKE ROUTE	3.00																				X		
WB	1.632	F	R2-1	36	48								1	X				14.00												
		F	R2-1	30	36		SPEED LIMIT 55	7.50																				X		
WB	1.330	F	VD-062AS	72	16		BUSINESS SIGN			1				X																
		F	VD-062AS	72	16		BUSINESS SIGN			1																				
WB	1.293	F	VR-428	24	30		ALL TURNS RIGHT LANE 10/31/14						1		X			13.25 14.25									SLIP BASES			
		F	R3-23	60	36		ALL TURNS FROM RIGHT LANE	15.00								2		X										X		
WB	1.236	F	D1-1M	72	12		10/31/14						1	X																
		F	VD1-1	72	12		Raymond Rd	6.00																					9	
WB	1.184	F	VR-903R	36	30		THRU/RIGHT ALL TURNS 10/31/14						1 1		X															
WB	1.139	F	VR-284	30	36		ALL TURNS ===> (45 DEG)						1 1		X			12.00 12.50												
		F	R3-24	72	18		ALL TURNS 11/13/14	9.00								2		X										X		
WB	1.069	F	VR-284	30	36		ALL TURNS ===> (45 DEG)						1 1		X															
SIGN SUMMARY SHEET							SHEET TOTALS	42.50	0.00	2	0	0	~~10~~ 7	0	0	4		~~50.00~~ ~~60.0~~		0	0.0	0.0	0.0	0.0					
								SF	SF	EA	EA	EA	EA	EA	EA	EA		FT		EA	LB	LB	LB	LB					
VERMONT AGENCY OF TRANSPORTATION							TOWN DIRECTIONAL TOTALS	464.5	0.0	22	0	0	52	0	0	43		645.0		0		0.0							

PROJECT NAME: ALBURGH-COLCHESTER
PROJECT NUMBER: STPG SIGN(45)

FILE NAME: 12 COLCHESTER US2 WB TSS PLOT DATE: 3/14/2014
PROJECT MANAGER: D. BRYANT DRAWN BY: J. BLANCHARD
DESIGNED BY: B. TOOTHAKER CHECKED K. KERN
COLCHESTER WB SHEET 5 SHEET 161 OF 167

DIRECTION	MILEPOINT	LOCATION CODE (SHEET 2)	SIGN CODE	WIDTH (IN)	HEIGHT (IN)	SHEETING REMARKS	SIGN LEGEND	NEW SIGNS "A"	NEW SIGNS "B"	EXISTING SIGNS RETAIN	EXISTING SIGNS SALVAGE FROM	EXISTING SIGNS SALVAGE TO	EXISTING SIGNS REMOVE	EXIST POST RETAIN	EXIST POST REMOVE	NUMBER OF NEW POSTS	SQUARE STEEL (IN) 1.75 (LB/FT) 1.88	SQUARE STEEL (IN) 2.00 (LB/FT) 2.42	SQUARE STEEL (IN) 2.50 (LB/FT) 3.35	TUBULAR STEEL Ø (IN) FOUNDATION	TUBULAR STEEL Ø (IN) 3.00 (LB/FT) 7.60	TUBULAR STEEL Ø (IN) 3.50 (LB/FT) 9.00	TUBULAR STEEL Ø (IN) 4.00 (LB/FT) 10.80	TUBULAR STEEL Ø (IN) 5.00 (LB/FT) 14.60	SIGN FRAME REQUIRED	REMARKS	SIGN DETAIL LOCATION SHSM	SIGN DETAIL LOCATION PROJECT SHEET #	SIGN DETAIL LOCATION STANDARD SHEET #
COLCHESTER US-2 WB							FY-FLUORESCENT YELLOW FYG-FLUORESCENT YELLOW GREEN																				"SHSM"-STANDARD HIGHWAY SIGNS AND MARKINGS			
		F	R3-24	72	18		ALL TURNS ↗ 10/31/14	9.00					1			2	12.75 X 12.75											X		
WB	1.059	F	R3-2	24	24		NO LEFT TURN SYMBOL 10/31/14						1 1		X														
WB	1.048	E	R3-3	48	48		NO TURNS 11/06/14	16.00								2	10.50 X 11.25										INSTALL IN MEDIAN AT INTERSECTION OF RTE 2 AND RAYMOND RD (TH-40)	X		
		F	R3-3	48	48		NO TURNS	16.00																		SLIP BASES	X		
WB	1.048	E	R5-1	30	30								1 1		X														
		E	R5-1	30	30		DO NOT ENTER 10/31/14	6.25								1	12.75 X										IN MEDIAN AT INTERSECTION OF JUGHANDLE AND RAYMOND RD (TH-40)	X		
		F	R1-1	30	30		STOP	6.25																		INSTALL ON REVERSE OF STOP SIGN	X		
WB	1.048	F	R1-1	30	30								1	~~X~~															
		E	R5-1	30	30								1				10.25												
		E	R5-1	30	30		DO NOT ENTER 10/31/14	6.25																		EAST OF JUGHANDLE AT INTERSECTION WITH RAYMOND RD (TH-40)	X		
		F	R1-1	30	30		STOP	6.25																		INSTALL ON REVERSE OF STOP SIGN	X		
WB	1.046	G	VR-017	24	30								1		X														
		G	VR-017	24	30		LEGAL LOAD LIMIT 24,000 POUNDS 10/31/14	5.00									13.25 X										RAYMOND RD (TH-40); INSTALL EAST OF JUGHANDLE		10	
WB	1.038	F	W1-6	48	24		<===>						1		X		13.50 13.25												
		F	VD1-1	72	12		← Raymond Rd → 10/31/14	6.00								2	X										RAYMOND RD (TH-40); INSTALL CENTERED ACROSS FROM JUGHANDLE INTERSECTION		9	
SIGN SUMMARY SHEET							SHEET TOTALS	77.00	0.00	0	0	0	~~9~~ 6	0	0	8	~~110.25~~ 120.0			0	0.0	0.0	0.0	0.0					
								SF	SF	EA	EA	EA	EA	EA	EA	EA	FT			EA	LB	LB	LB	LB					
VERMONT AGENCY OF TRANSPORTATION							TOWN DIRECTIONAL TOTALS	464.5	0.0	22	0	0	52	0	0	43	645.0			0	0.0								

PROJECT NAME: **ALBURGH-COLCHESTER**
PROJECT NUMBER: **STPG SIGN(45)**
FILE NAME: **12 COLCHESTER US2 WB TSS** PLOT DATE: **3/14/2014**
PROJECT MANAGER: **D. BRYANT** DRAWN BY: **J. BLANCHARD**
DESIGNED BY: **B. TOOTHAKER** CHECKED **K. KERN**
COLCHESTER WB SHEET 6 SHEET **162** OF **167**

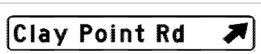DIRECTION	MILEPOINT	LOCATION CODE (SHEET 2)	SIGN CODE	WIDTH (IN)	HEIGHT (IN)	SHEETING REMARKS	SIGN LEGEND	NEW SIGNS "A"	NEW SIGNS "B"	EXISTING SIGNS RETAIN	EXISTING SIGNS SALVAGE FROM	EXISTING SIGNS SALVAGE TO	EXISTING SIGNS REMOVE	EXIST POST RETAIN	EXIST POST REMOVE	NUMBER OF NEW POSTS	SQUARE STEEL (IN) 1.75 (LB / FT) 1.88	SQUARE STEEL (IN) 2.00 (LB / FT) 2.42	SQUARE STEEL (IN) 2.50 (LB / FT) 3.35	TUBULAR STEEL Ø (IN) FOUNDATION	TUBULAR STEEL Ø (IN) 3.00 (LB / FT) 7.60	TUBULAR STEEL Ø (IN) 3.50 (LB / FT) 9.00	TUBULAR STEEL Ø (IN) 4.00 (LB / FT) 10.80	TUBULAR STEEL Ø (IN) 5.00 (LB / FT) 14.60	SIGN FRAME REQUIRED	REMARKS	SIGN DETAIL LOCATION SHSM	SIGN DETAIL LOCATION PROJECT SHEET #	SIGN DETAIL LOCATION STANDARD SHEET #
COLCHESTER US-2 WB							FY-FLUORESCENT YELLOW FYG-FLUORESCENT YELLOW GREEN																			"SHSM"-STANDARD HIGHWAY SIGNS AND MARKINGS			
WB	1.037	H	R1-1	30	30		11/03/14						1	X															
		H	R1-1	30	30			6.25																	RAYMOND RD (TH-40)	X		
WB	0.989	F	R8-7	30	24								1		X														
		F	R8-7	30	24			5.00					2			1		13.00 X								X		
WB	0.899	F	R2-1	24	30								1	X															
		F	R2-1	30	36			7.50					2													X		
WB	0.735	F	VD-062B	72	16		BUSINESS SIGN			1				X															
WB	0.680	F	W2-1M	36	36		MODIFIED CROSSROAD						1		X														
		F	VW-202P	30	18		TRUCKS ENTERING PLAQUE						1 1																
WB	0.634	F	W2-1	36	36			9.00								2		15.50 X 16.00									INSTALL 32 FT EAST OF EXISTING ALL TURNS RIGHT LANE SIGN	X		
		F	VW-202P	30	24			5.00																	SLIP BASES			
WB	0.628	F	VR-428	24	30		ALL TURNS RIGHT LANE						1 1		X												SLIP BASES			
		F	R3-23	60	36			15.00								2		X										X		
WB	0.596	F	D1-1M	72	12								1	X															
		F	VD1-1	72	12			6.00																				9	
SIGN SUMMARY SHEET							SHEET TOTALS	53.75	0.00	1	0	0	13 ~~7~~	0	0	5		72.50 ~~75.0~~		0	0.0	0.0	0.0	0.0					
								SF	SF	EA	EA	EA	EA	EA	EA	EA		FT		EA	LB	LB	LB	LB					
VERMONT AGENCY OF TRANSPORTATION							TOWN DIRECTIONAL TOTALS	464.5	0.0	22	0	0	52	0	0	43		645.0		0	0.0								

PROJECT NAME: ALBURGH-COLCHESTER
PROJECT NUMBER: STPG SIGN(45)
FILE NAME: 12 COLCHESTER US2 WB TSS
PROJECT MANAGER: D. BRYANT
DESIGNED BY: B. TOOTHAKER
COLCHESTER WB SHEET 7
PLOT DATE: 3/14/2014
DRAWN BY: J. BLANCHARD
CHECKED K. KERN
SHEET 163 OF 167

DIRECTION	MILEPOINT	LOCATION CODE (SHEET 2)	SIGN CODE	WIDTH (IN)	HEIGHT (IN)	SHEETING REMARKS	SIGN LEGEND	NEW SIGNS "A"	NEW SIGNS "B"	EXISTING SIGNS RETAIN	EXISTING SIGNS SALVAGE FROM	EXISTING SIGNS SALVAGE TO	EXISTING SIGNS REMOVE	EXIST POST RETAIN	EXIST POST REMOVE	NUMBER OF NEW POSTS	SQUARE STEEL (IN) 1.75 (LB/FT) 1.88	SQUARE STEEL (IN) 2.00 (LB/FT) 2.42	SQUARE STEEL (IN) 2.50 (LB/FT) 3.35	TUBULAR STEEL Ø (IN) FOUNDATION	TUBULAR STEEL Ø (IN) 3.00 (LB/FT) 7.60	TUBULAR STEEL Ø (IN) 3.50 (LB/FT) 9.00	TUBULAR STEEL Ø (IN) 4.00 (LB/FT) 10.80	TUBULAR STEEL Ø (IN) 5.00 (LB/FT) 14.60	SIGN FRAME REQUIRED	REMARKS	SIGN DETAIL LOCATION SHSM	SIGN DETAIL LOCATION PROJECT SHEET #	SIGN DETAIL LOCATION STANDARD SHEET #
COLCHESTER US-2 WB							FY-FLUORESCENT YELLOW FYG-FLUORESCENT YELLOW GREEN																			"SHSM"-STANDARD HIGHWAY SIGNS AND MARKINGS			
WB	0.559	F	VR-903R	36	30		THRU/RIGHT ALL TURNS						1		X														
WB	0.519	F	VR-284	30	36		ALL TURNS ===> (45 DEG)						1		X			14.00 13.25											
		F	R3-24	72	18			9.00								2		X								X		
WB	0.439	F	VR-284	30	36		ALL TURNS ===> (45 DEG)						1		X														
		F	R3-24	72	18			9.00								2		12.25 X 12.00								X		
WB	0.432	E	R3-2	24	24		NO LEFT TURN SYMBOL						1		X														
WB	0.427	E	R3-3	48	48		 11/06/14	16.00								2		14.25 X 14.00								X	INSTALL IN MEDIAN AT INTERSECTION OF RTE 2 AND CLAY POINT RD (TH-58)		
		F	R3-3	48	48			16.00																		X	SLIP BASES		
WB	0.427	F	R1-1	30	30		STOP						1	X				14.00											
		F	R1-1	30	30			6.25																		X	EAST OF JUGHANDLE AT INTERSECTION WITH CLAY POINT RD (TH-58)		
		E	R5-1	30	30			6.25																		X	INSTALL ON REVERSE OF STOP SIGN		
WB	0.427	G	VR-017	24	30								1	X	~~X~~			14.00											
		G	VR-017	24	30			5.00								1		~~X~~									CLAY POINT RD (TH-58); INSTALL EAST OF JUGHANDLE, WEST OF UTILITY POLE		10
WB	0.425	E	R5-1	30	30								1	X																
		F	R1-1	30	30			6.25																		X	IN MEDIAN AT INTERSECTION OF JUGHANDLE AND CLAY POINT RD (TH-58)		
SIGN SUMMARY SHEET							SHEET TOTALS	73.75	0.00	0	0	0	~~11~~ 7	0	0	7		~~107.75~~ 105.0		0	0.0	0.0	0.0	0.0					
								SF	SF	EA	EA	EA	EA	EA	EA	EA		FT		EA	LB	LB	LB	LB					
VERMONT AGENCY OF TRANSPORTATION							TOWN DIRECTIONAL TOTALS	464.5	0.0	22	0	0	52	0	0	43		645.0		0	0.0								

PROJECT NAME: **ALBURGH-COLCHESTER**
PROJECT NUMBER: **STPG SIGN(45)**

FILE NAME: **12 COLCHESTER US2 WB TSS** PLOT DATE: **3/14/2014**
PROJECT MANAGER: **D. BRYANT** DRAWN BY: **J. BLANCHARD**
DESIGNED BY: **B. TOOTHAKER** CHECKED **K. KERN**
COLCHESTER WB SHEET 8 SHEET **164** OF **167**

DIRECTION	MILEPOINT	LOCATION CODE (SHEET 2)	SIGN CODE	WIDTH (IN)	HEIGHT (IN)	SHEETING REMARKS	SIGN LEGEND	NEW SIGNS "A"	NEW SIGNS "B"	EXISTING SIGNS RETAIN	EXISTING SIGNS SALVAGE FROM	EXISTING SIGNS SALVAGE TO	EXISTING SIGNS REMOVE	EXIST POST RETAIN	EXIST POST REMOVE	NUMBER OF NEW POSTS	SQUARE STEEL (IN) 1.75 (LB/FT) 1.88	SQUARE STEEL (IN) 2.00 (LB/FT) 2.42	SQUARE STEEL (IN) 2.50 (LB/FT) 3.35	TUBULAR STEEL Ø (IN) FOUNDATION	TUBULAR STEEL Ø (IN) 3.00 (LB/FT) 7.60	TUBULAR STEEL Ø (IN) 3.50 (LB/FT) 9.00	TUBULAR STEEL Ø (IN) 4.00 (LB/FT) 10.80	TUBULAR STEEL Ø (IN) 5.00 (LB/FT) 14.60	SIGN FRAME REQUIRED	REMARKS	SIGN DETAIL LOCATION SHSM	SIGN DETAIL LOCATION PROJECT SHEET #	SIGN DETAIL LOCATION STANDARD SHEET #
COLCHESTER US-2 WB							FY-FLUORESCENT YELLOW FYG-FLUORESCENT YELLOW GREEN																			"SHSM"-STANDARD HIGHWAY SIGNS AND MARKINGS			
	0.408	E	R5-1	30	30		STOP DO NOT ENTER 6.25 6.25	6.25										14.00								INSTALL ON REVERSE OF STOP SIGN	X		
WB	0.416	F	W1-6	48	24		<===>						1 1		X			11.25 11.25											
		F	VD1-1	72	12		← Clay Point Rd →	6.00								2		X								CLAY POINT RD (TH-58); INSTALL CENTERED ACROSS FROM JUGHANDLE INTERSECTION		9	
WB	0.416	H	R1-1	30	30								1 1		X			12.25											
		H	R1-1	30	30		STOP	6.25								1		X								CLAY POINT RD (TH-58)	X		
WB	0.360	F	R2-1	36	48		11/06/14						1	~~X~~					13.75 14.25										
		F	R2-1	30	36		EMERGENCY STOPPING ONLY	12.00 ~~7.50~~								2			X									X		
WB	0.306	F	R8-7	30	24		11/13/14						1		X				13.00										
		F	R8-7	48	36		SPEED LIMIT 55 12/17/14	12.00								1			X									X		
WB	0.197	F	R8-7	30	24		11/06/14						1		X				14.00 14.25										
		F	R8-7	48	36		EMERGENCY STOPPING ONLY	12.00								2 ~~1~~			X									X		
EB	0.142	A	W11-1	48	48		11/06/14	16.00								2			13.75 X 14.00								INSTALL 10 FT EAST OF EXISTING SPEED LIMIT 55 SIGN	X		
		A	W11-15P	36	30		TRAIL X-ING	7.50																			SLIP BASES	X		
WB	0.140	F	R2-1	36	48		SPEED LIMIT 55						~~1~~ 3		X														
WB	0.104	F	R2-1	30	36		SPEED LIMIT 55	7.50								1		14.00 X									INSTALL 190 FT WEST OF EXISTING	X		
SIGN SUMMARY SHEET							SHEET TOTALS	~~98.00~~ ~~81.00~~	0.00	0	0	0	~~10~~ ~~6~~	0	0	8		~~159.75~~ ~~120.0~~		0	0.0	0.0	0.0	0.0					
								SF	SF	EA	EA	EA	EA	EA	EA	EA		FT		EA	LB	LB	LB	LB					
VERMONT AGENCY OF TRANSPORTATION							TOWN DIRECTIONAL TOTALS	464.5	0.0	22	0	0	52	0	0	43		645.0		0	0.0								

PROJECT NAME: ALBURGH-COLCHESTER
PROJECT NUMBER: STPG SIGN(45)

FILE NAME: 12 COLCHESTER US2 WB TSS PLOT DATE: 3/14/2014
PROJECT MANAGER: D. BRYANT DRAWN BY: J. BLANCHARD
DESIGNED BY: B. TOOTHAKER CHECKED K. KERN
COLCHESTER WB SHEET 9 SHEET 165 OF 167

DIRECTION	MILEPOINT	LOCATION CODE (SHEET 2)	SIGN CODE	WIDTH (IN)	HEIGHT (IN)	SHEETING REMARKS	SIGN LEGEND	NEW SIGNS "A"	NEW SIGNS "B"	EXISTING SIGNS RETAIN	EXISTING SIGNS SALVAGE FROM	EXISTING SIGNS SALVAGE TO	EXISTING SIGNS REMOVE	EXIST POST RETAIN	EXIST POST REMOVE	NUMBER OF NEW POSTS	SQUARE STEEL (IN) 1.75 (LB/FT) 1.88	SQUARE STEEL (IN) 2.00 (LB/FT) 2.42	SQUARE STEEL (IN) 2.50 (LB/FT) 3.35	TUBULAR STEEL Ø (IN) FOUNDATION	TUBULAR STEEL Ø (IN) 3.00 (LB/FT) 7.60	TUBULAR STEEL Ø (IN) 3.50 (LB/FT) 9.00	TUBULAR STEEL Ø (IN) 4.00 (LB/FT) 10.80	TUBULAR STEEL Ø (IN) 5.00 (LB/FT) 14.60	SIGN FRAME REQUIRED	REMARKS	SIGN DETAIL LOCATION SHSM	SIGN DETAIL LOCATION PROJECT SHEET #	SIGN DETAIL LOCATION STANDARD SHEET #
COLCHESTER US-2 WB							FY-FLUORESCENT YELLOW FYG-FLUORESCENT YELLOW GREEN																				"SHSM"-STANDARD HIGHWAY SIGNS AND MARKINGS			
WB	0.066	F	M4-14	24	12	WHT/ GRN	BEGIN 11/13/14	2.00																			INSTALL 200 FT WEST OF NEW SPEED LIMIT SIGN	X		
		F	D11-1	24	18		BIKE ROUTE	3.00																				X		

TOWN TOTAL SIGN SUMMARY SHEET

ALBURGH-COLCHESTER STPG SIGN (45)

Town Name - Route	County	Town Mileage	NEW SIGNS (SF)		EXISTING SIGNS (EA)				EXIST POST (EA)		SQUARE STEEL (IN)				SQUARE TUBE SIGN POST AND ANCHOR (LF)	TUBULAR STEEL Ø (IN)				
											1.75	2.00	2.50			FOUNDATION	3.00	3.50	4.00	5.00
											(LB / FT)						(LB / FT)			
			"A"	"B"	RETAIN	SALVAGE FROM	SALVAGE TO	REMOVE	RETAIN	REMOVE	1.88	2.42	3.35	TOTAL POSTS			7.60	9.00	10.80	14.60
Alburgh US-2 EB	Grand Isle	11.732	~~897.8~~ 911.35	0.0	37	1	1	~~165~~ 157	0	0	0	82	10	92	~~1380~~ 742.25	0	0	0	0	0
Alburgh US-2 WB	Grand Isle	11.732	~~870.8~~ 897.94	0.0	23	3	2	~~157~~ 142	0	0	0	74	6	80	~~1200~~ 351.00	0	0	0	0	0
North Hero US-2 EB	Grand Isle	9.340	~~320.7~~ 320.67	0.0	8	1	0	57	0	0	0	29	1	30	~~450~~ 515.75	0	0	0	0	0
North Hero US-2 WB	Grand Isle	9.340	~~363.5~~ 363.52	0.0	10	1	0	67	0	0	0	36	1	37	~~555~~ 623.50	0	0	0	0	0
Grand Isle US-2 EB	Grand Isle	6.274	~~319.6~~ 325.89	0.0	19	2	0	61	0	0	0	31	2	33	~~495~~ 476.75	0	0	0	0	0
Grand Isle US-2 WB	Grand Isle	6.274	~~409.8~~ 412.73	0.0	14	0	0	~~69~~ 68	0	0	0	47	4	51	~~765~~ 693.75	0	0	0	0	0
South Hero US-2 EB	Grand Isle	5.783	~~257.0~~ 365.50	0.0	48	9	9	~~57~~ 71	0	0	0	27	2	29	~~435~~ 793.00	0	0	0	0	0
South Hero US-2 WB	Grand Isle	5.783	~~317.9~~ 327.16	0.0	56	1	1	56	0	0	0	35	4	39	~~585~~ 661.00	0	0	0	0	0
Milton US-2 EB	Chittenden	3.686	~~332.1~~ 332.08	0.0	2	0	0	~~42~~ 36	0	0	0	29	3	32	~~480~~ 567.25	0	0	0	0	0
Milton US-2 WB	Chittenden	3.686	~~317.3~~ 317.25	0.0	4	0	0	~~46~~ 48	0	0	0	21	3	24	~~360~~ 526.00	0	0	0	0	0
Colchester US-2 EB	Chittenden	2.196	~~451.3~~ 403.44	0.0	68	1	0	~~57~~ 65	0	0	0	40	4	44	~~660~~ 637.50	0	0	0	0	0
Colchester US-2 WB	Chittenden	2.196	~~464.5~~ 486.50	0.0	22	0	0	~~52~~ 76	0	0	0	39	4	43	~~645~~ 718.00	0	0	0	0	0
TOTAL		78.022	~~5322.2~~ 5464.03	0.0	311	19	~~13~~ 59•	~~886~~ 904	0	0	0	490	44	534	~~8010~~ 9341.75	0	0	0	0	0

• NOTE, 59 SALVAGE TO SIGNS, 46 WERE MM VARIOUS LOC.

PROJECT NAME: ALBURGH-COLCHESTER
PROJECT NUMBER: STPG SIGN(45)

TYLIN INTERNATIONAL

FILE NAME: z12b530TownTotal.dgn
PROJECT LEADER: D. BRYANT
DESIGNED BY: B. TOOTHAKER
TOWN TOTAL SIGN SUMMARY SHEET

PLOT DATE: 4/28/2014
DRAWN BY: J. BLANCHARD
CHECKED BY: K. KERN
SHEET 167 OF 167