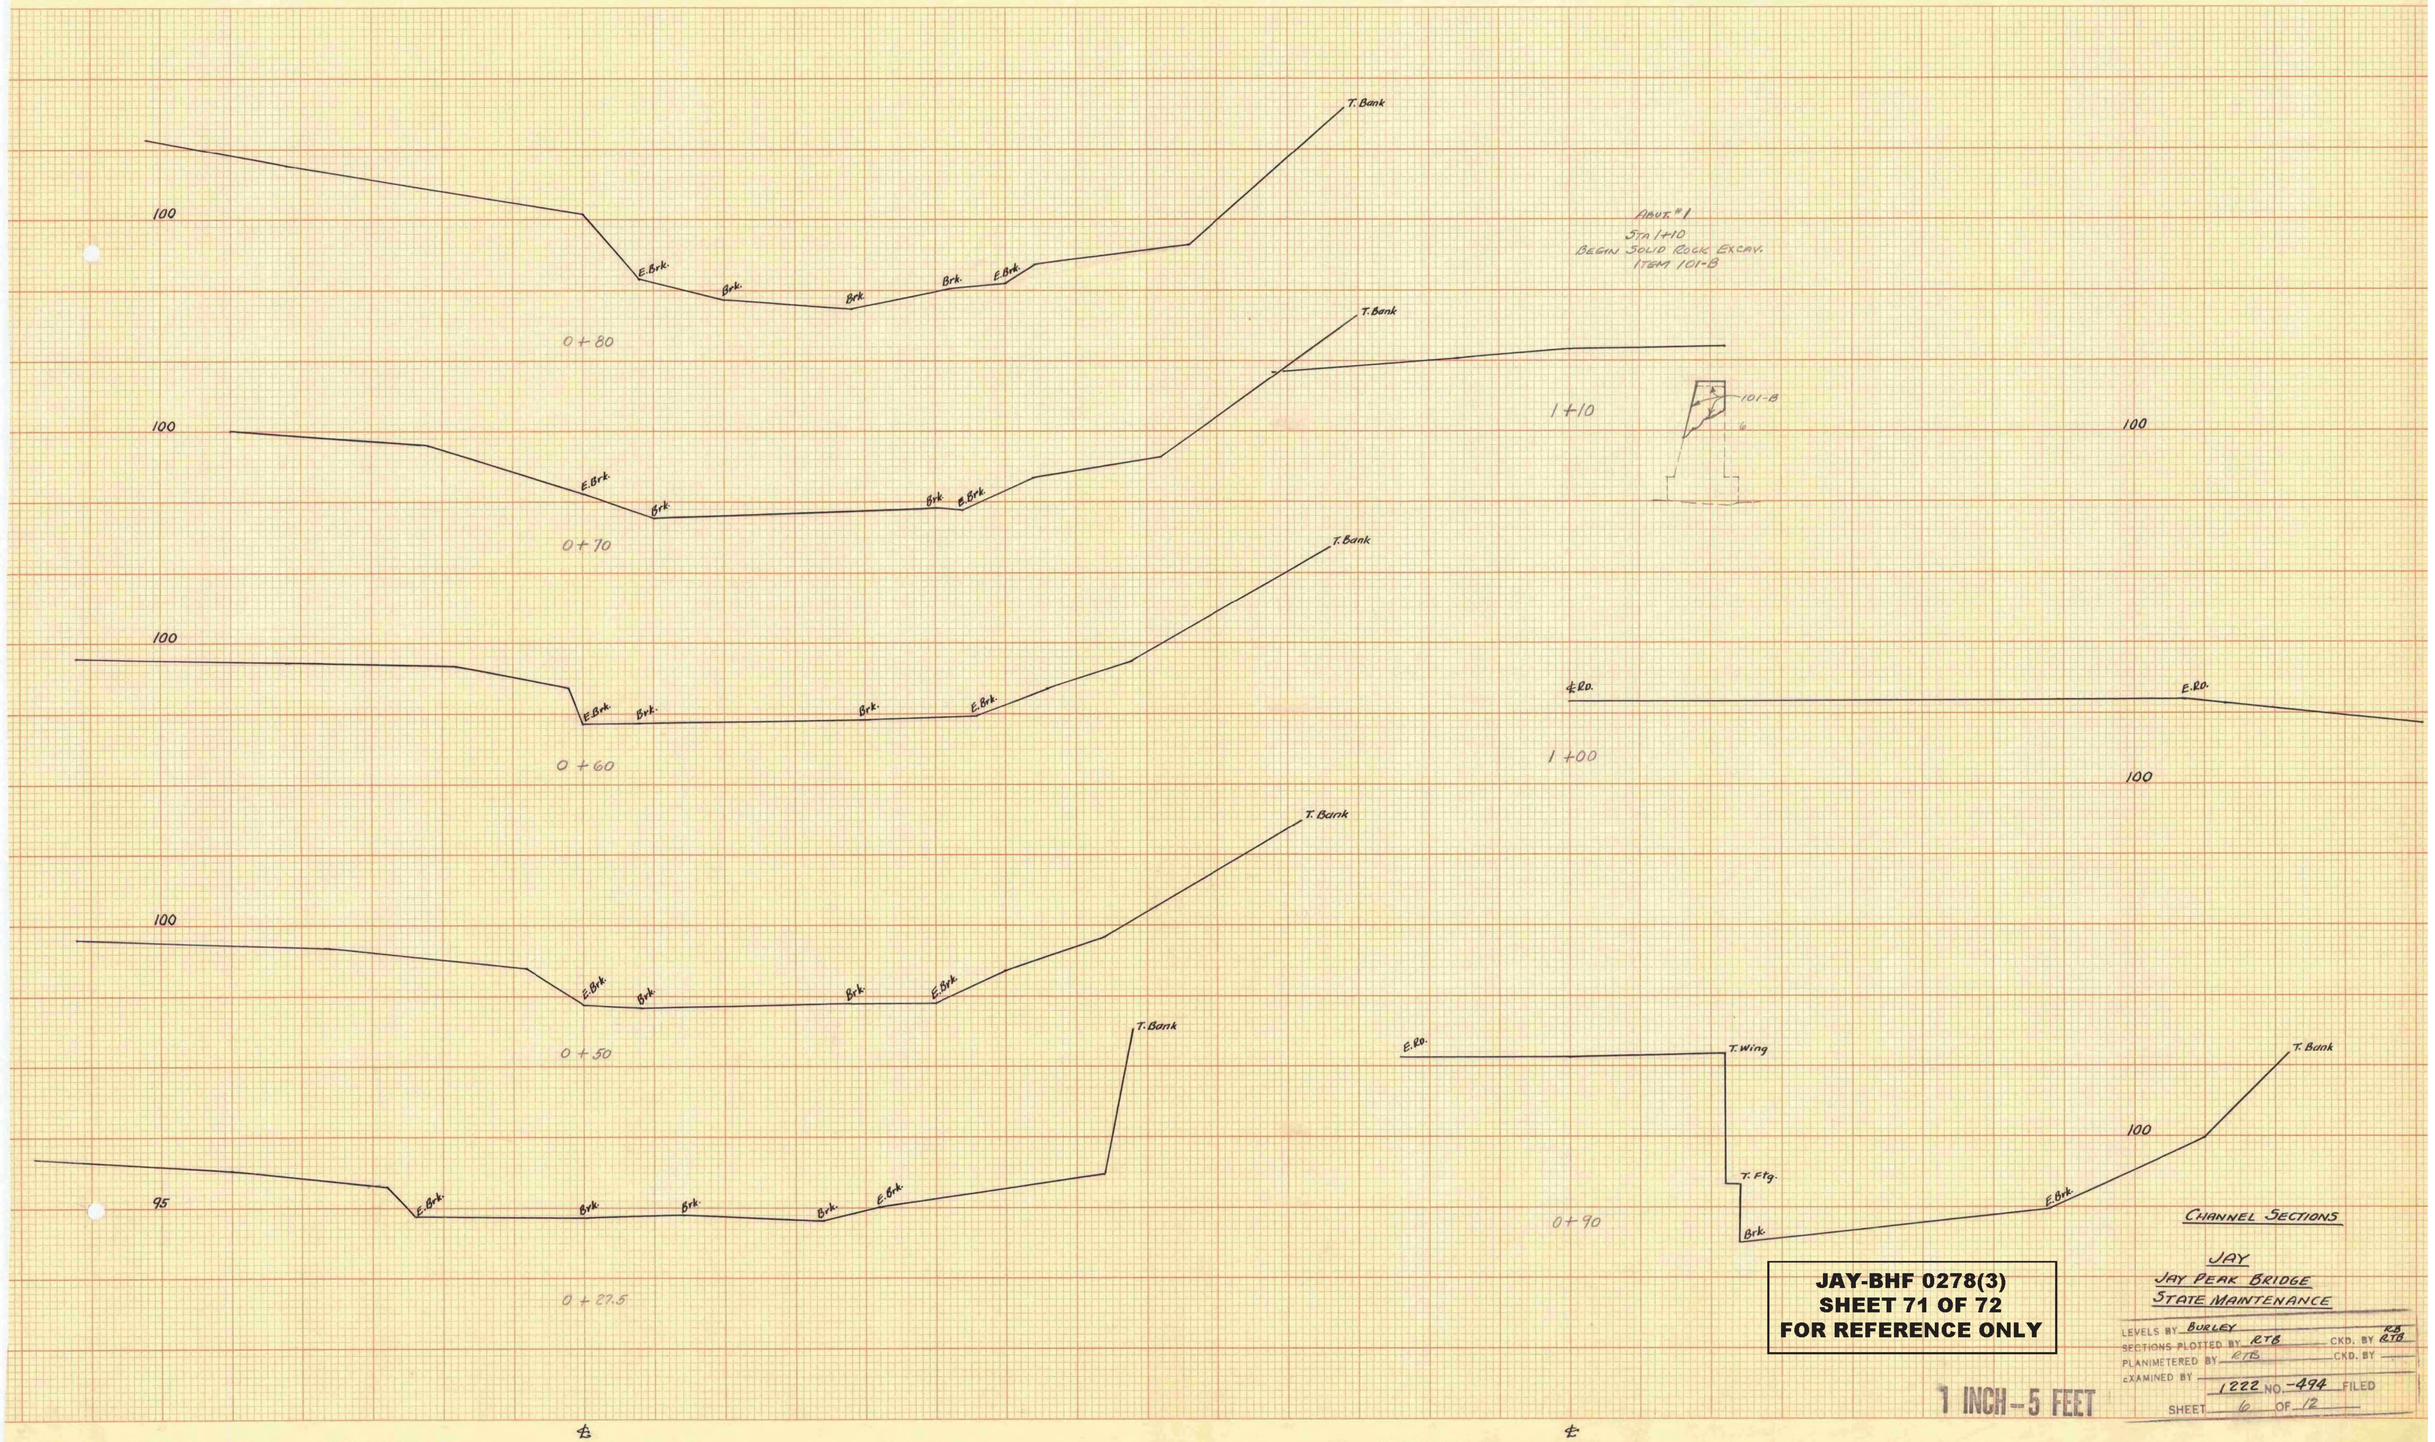

JAY-BHF 0278(3)
SHEET 71 OF 72
FOR REFERENCE ONLY

1 INCH = 5 FEET

CHANNEL SECTIONS

JAY
JAY PEAK BRIDGE
STATE MAINTENANCE

LEVELS BY BURLEY
SECTIONS PLOTTED BY RTB CKD. BY RB RTB
PLANIMETERED BY RTB CKD. BY
EXAMINED BY
1222 NO. -494 FILED
SHEET 6 OF 12

"PERFECT" CROSS SECTION 10 X 10 = ONE INCH EUGENE DIETZGEN CO.
PRINTED IN U.S.A. ON 100% RAG PAPER MADE IN U.S.A.
"PERFECT" CROSS SECTION 10 X 10 = ONE INCH EUGENE DIETZGEN CO.
PRINTED IN U.S.A. ON 100% RAG PAPER MADE IN U.S.A.