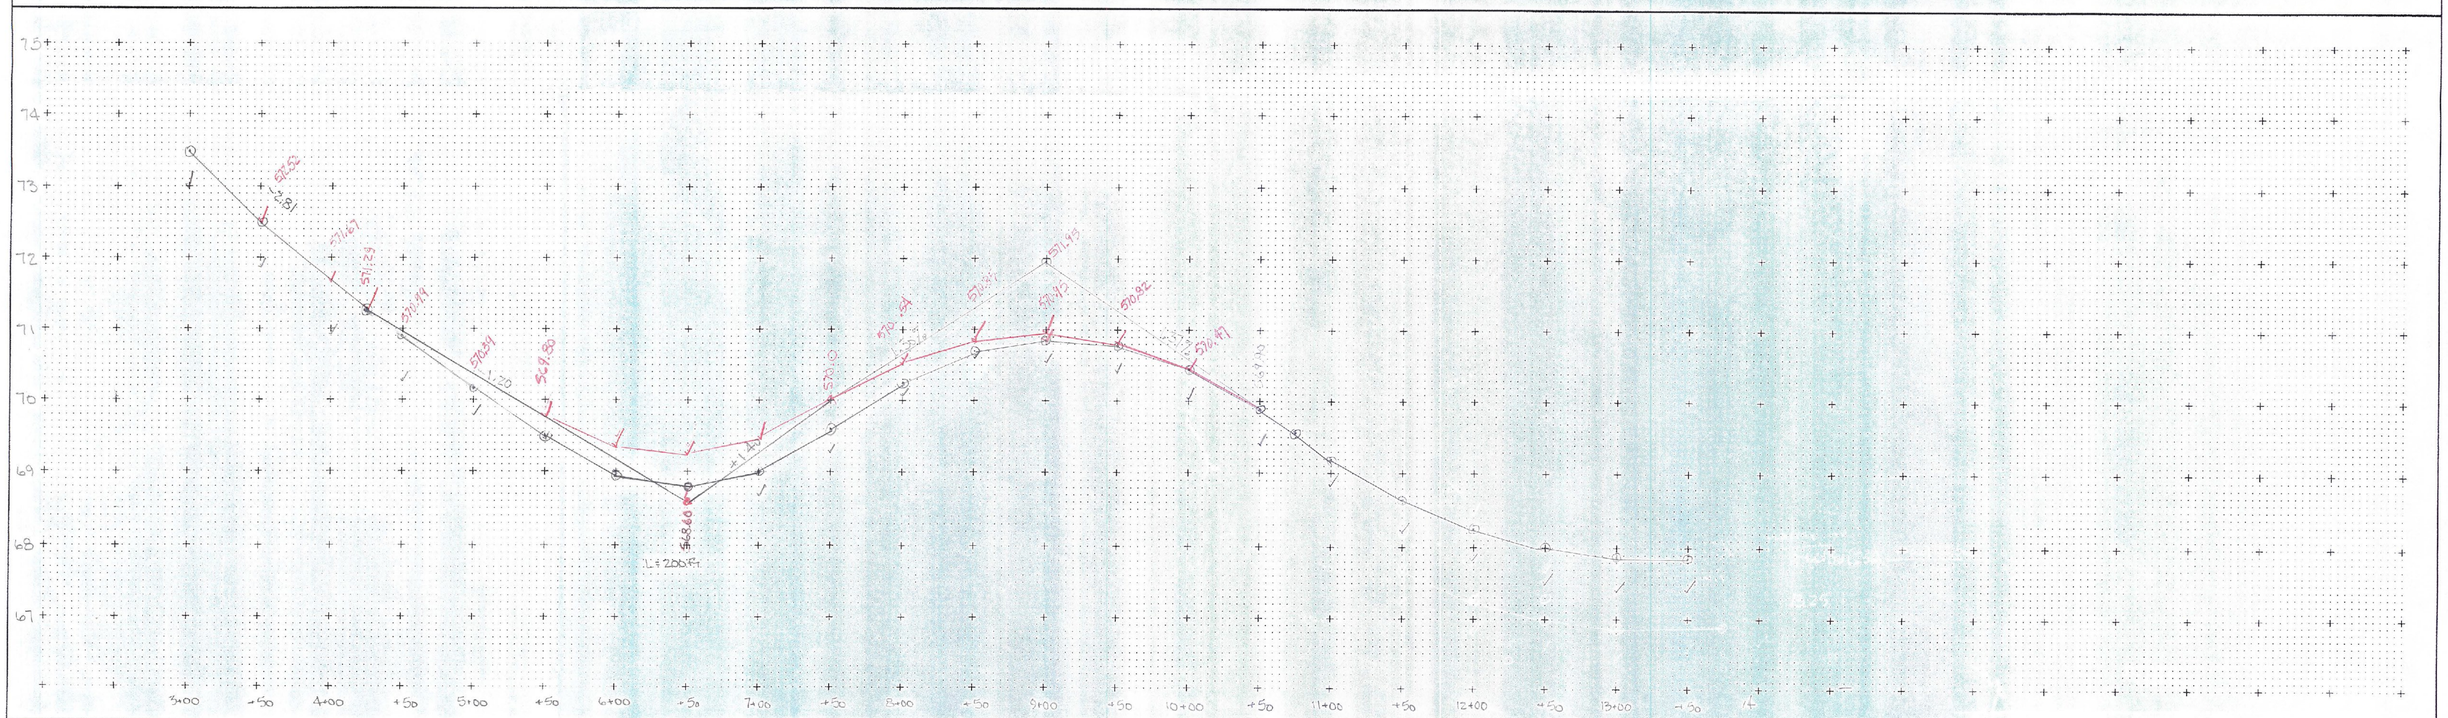

PLAN & PROFILE SHEET

PROJECT NAME: Morgetown ER STP 0167(15)

PROJECT NUMBER:

FILE NAME: [illegible]

PROJECT LEADER:

DESIGNED BY:

const: g:/common/cadd/e-xsection.dgn

PLOT DATE: 12-MAY-2005 16:0

DRAWN BY:

CHECKED BY:

SHEET ____ OF ____