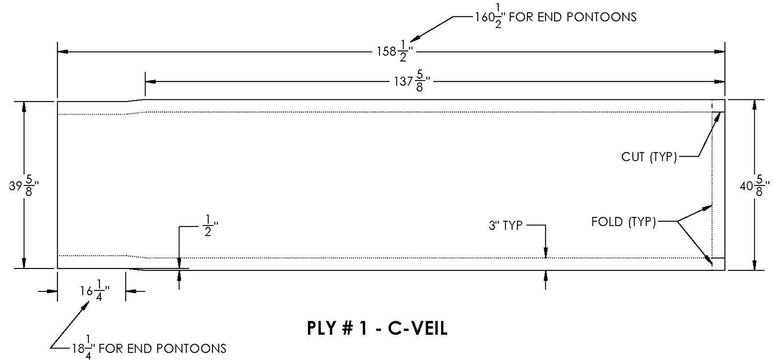

PLY # 1 - C-VEIL

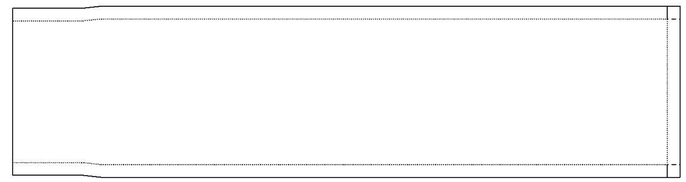

PLY # 2 - 4008

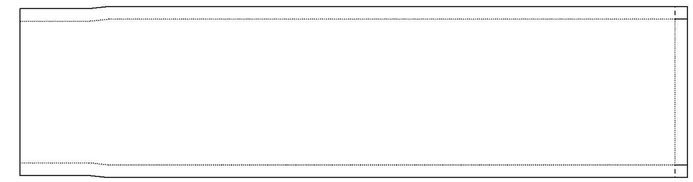

PLY # 3 - 54 oz

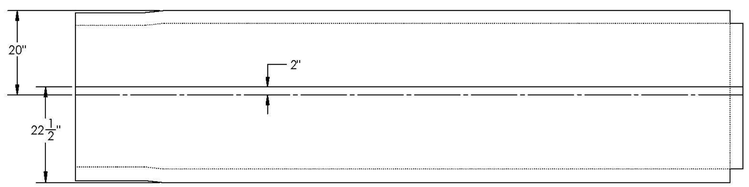

PLY # 4 - 54 oz

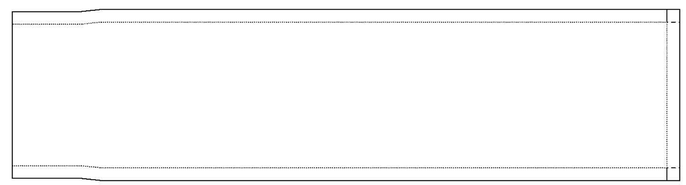

PLY # 5 - 54 oz

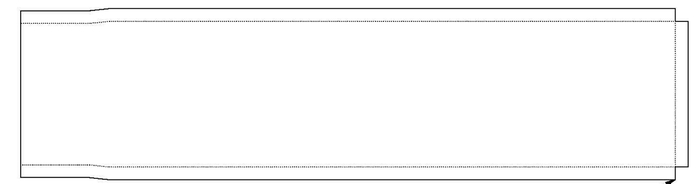

PLY # 6 - 54 oz

CUT OUT CORNERS FROM PLIES 4, 6 AND 8

1

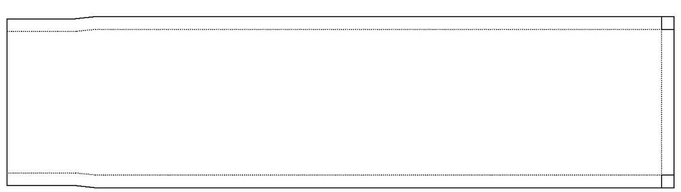

PLY # 7 - 54 oz

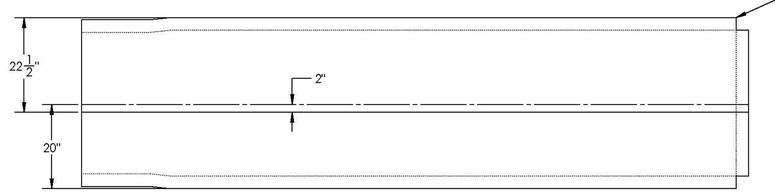

PLY #8 - 54 oz

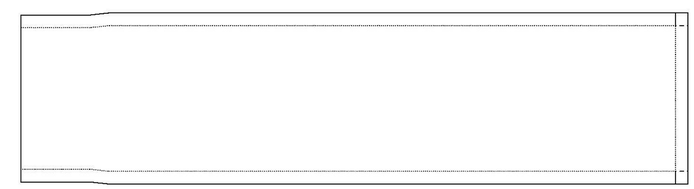

PLY # 9 - 54 oz

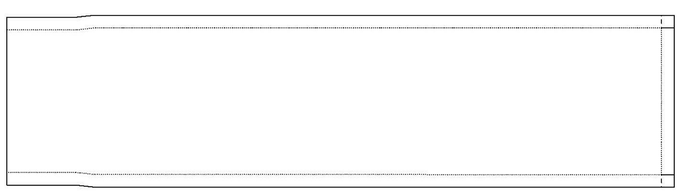

PLY # 10 - 4008

Vermont Agency of Transportation

RECEIVED

ON: June 30, 2014

and Checked for

CONFORMANCE

BY: Jennifer Fitch DATE: 07/07/2014

T.Y. LIN INTERNATIONAL

THE STAMPED DOCUMENTS ARE HEREBY:

_x_ APPROVED
___ APPROVED AS NOTED
___ REVISE AND RESUBMIT

SEE TRANSMITTAL FOR ADDITIONAL INFORMATION AS APPLICABLE.

THIS REVIEW IS FOR GENERAL CONFORMANCE WITH DESIGN CONCEPT ONLY. ANY DEVIATION FROM THE PLANS OR SPECIFICATIONS NOT CLEARLY NOTED BY THE CONTRACTOR HAS NOT BEEN REVIEWED. REVIEW BY THE ENGINEER SHALL NOT RELIEVE THE CONTRACTOR OF THE CONTRACTUAL RESPONSIBILITY FOR ANY ERRORS OR DEVIATION FROM THE CONTRACT REQUIREMENTS.

JOSH OLUND — REVIEWER
07/03/2014 — DATE

KENWAY CORP.

REV	DESCRIPTION	DATE
1	ADDED CORNER CUT OUT NOTE	6/26/14
1	ADDED 2" OVERLAP ON NOTED 54 OZ PLIES	6/26/14

SEAL

DIMENSIONS ARE IN INCHES
TOLERANCES: +0, -1/16"
FRACTIONAL ±
ANGULAR: MACH± BEND ±
TWO PLACE DECIMAL ±
THREE PLACE DECIMAL ±

DRAWN BY	DATE
ML	6/4/14
CHKD BY JM	DATE 6/4/14

PROJECT: BROOKFIELD FRP PONTOONS

CUSTOMER: MILLER CONST. / VTRANS

SHEET: END LONGITUDINAL BULKHEAD LAYUP SCHEDULE

WEIGHT: 223 lb

DESCRIPTION: FABRICATION

SCALE 1 : 18

WO NO. 8420

CONTRACT NO. 9185

DWG NO. 8420-6

SHEET 11 OF 16

PONTOON	PART NO.
1-10	4