
STATE OF VERMONT
AGENCY OF TRANSPORTATION

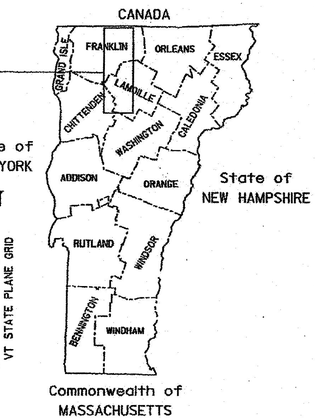


PROPOSED IMPROVEMENT

TOWNS OF STOWE, CAMBRIDGE, BAKERSFIELD, ENOSBURG, AND BERKSHIRE
COUNTIES OF LAMOILLE AND FRANKLIN
VT ROUTE 108
(MAJOR COLLECTORS/MINOR ARTERIAL)

STOWE TO BERKSHIRE SIGN REPLACEMENT - 33.626 MILES:
STOWE (VT RTE 108) MP 0.000-8.634, CAMBRIDGE (VT RTE 108) MP 0.000-9.005
BAKERSFIELD (VT RTE 108) MP 3.480-8.032, ENOSBURG (VT RTE 108) MP 0.000-4.530,
BERKSHIRE (VT RTE 108) MP 0.000-6.905

LENGTH OF ROADWAY = 38.834 MI
LENGTH OF PROJECT = 33.626 MI

WORK TO BE PERFORMED INCLUDES THE REMOVAL OF EXISTING SIGNS AND POSTS AND THE INSTALLATION OF NEW SIGNS AND POSTS AND OTHER RELATED HIGHWAY ITEMS.

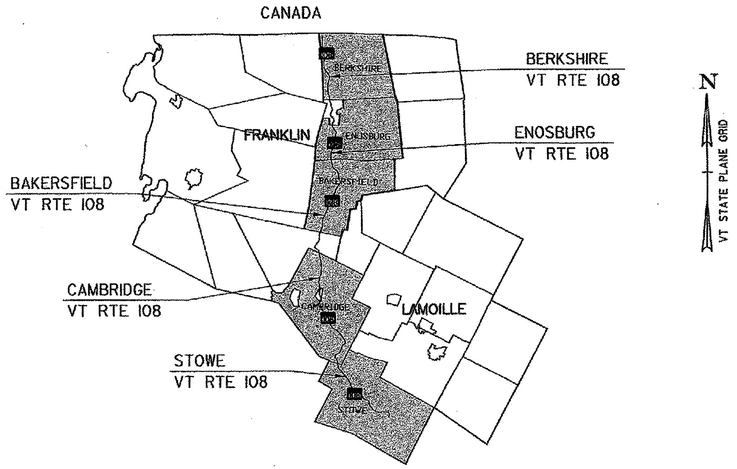

NOT TO SCALE

RECORD PLANS

CONTRACTOR: L&D SAFETY MARKINGS CORP. - BERLIN, VT

RESIDENT ENGINEER: JEFF COTA

CONSTRUCTION BEGAN: DECEMBER 16, 2015

CONSTRUCTION COMPLETE: OCTOBER 27, 2016

RECORD PLANS BY: JEFF COTA & JESSE IVES

I HEREBY CERTIFY THAT ALL THE CONSTRUCTION REQUIRED BY THIS SET OF DRAWINGS HAS BEEN ACCOMPLISHED AS INDICATED HEREIN.

BY _____ RESIDENT ENGINEER

DATE 8/3/17

NOTE: Any further information concerning final quantities, amounts or other details relative to this project may be found at Central Files in the electronic archives.

CONSTRUCTION IS TO BE CARRIED ON IN ACCORDANCE WITH THESE PLANS AND THE STANDARD SPECIFICATIONS FOR CONSTRUCTION DATED 2011, AS APPROVED BY THE FEDERAL HIGHWAY ADMINISTRATION ON JULY 20, 2011 FOR USE ON THIS PROJECT, INCLUDING ALL SUBSEQUENT REVISIONS AND SUCH REVISED SPECIFICATIONS AND SPECIAL PROVISIONS AS ARE INCORPORATED IN THESE PLANS.

QUALITY ASSURANCE PROGRAM : LEVEL 3

SURVEYED BY : N/A
SURVEYED DATE : N/A

DATUM
VERTICAL N/A
HORIZONTAL N/A

STATE OF VERMONT
DARIN W. BRYANT No. 6103 PROFESSIONAL ENGINEER

TYLIN INTERNATIONAL

DIRECTOR OF PROJECT DELIVERY
APPROVED _____ DATE 7/1/2015

PROJECT MANAGER : PATTI COBURN, P.E.

PROJECT NAME : STOWE-BERKSHIRE
PROJECT NUMBER : STPG SIGN(49)

SHEET 1 OF 131 SHEETS

INDEX OF SHEETS

1	TITLE SHEET
2	INDEX OF SHEETS AND PROJECT NOTES
3	QUANTITY SHEET
4-14	SIGN DETAILS (1-11)
15-28	STOWE VT-108 NORTHBOUND TRAFFIC SIGN SUMMARY SHEETS (1-14)
29-44	STOWE VT-108 SOUTHBOUND TRAFFIC SIGN SUMMARY SHEETS (1-16)
45-64	CAMBRIDGE VT-108 NORTHBOUND TRAFFIC SIGN SUMMARY SHEETS (1-20)
65-84	CAMBRIDGE VT-108 SOUTHBOUND TRAFFIC SIGN SUMMARY SHEETS (1-20)
85-91	BAKERSFIELD VT-108 NORTHBOUND TRAFFIC SIGN SUMMARY SHEETS (1-7)
92-99	BAKERSFIELD VT-108 SOUTHBOUND TRAFFIC SIGN SUMMARY SHEETS (1-8)
100-105	ENOSBURGH VT-108 NORTHBOUND TRAFFIC SIGN SUMMARY SHEETS (1-6)
106-110	ENOSBURGH VT-108 SOUTHBOUND TRAFFIC SIGN SUMMARY SHEETS (1-5)
111-120	BERKSHIRE VT-108 NORTHBOUND TRAFFIC SIGN SUMMARY SHEETS (1-10)
121-130	BERKSHIRE VT-108 SOUTHBOUND TRAFFIC SIGN SUMMARY SHEETS (1-10)
131	TOWN TOTAL SIGN SUMMARY SHEET

STANDARDS

E-121	STANDARD SIGN PLACEMENT CONVENTIONAL ROAD	08/08/1995
E-131	GUIDE SIGN DETAILS	08/08/1995
E-136b	STATE ROUTE MARKER SIGN DETIALS	08/08/1995
E-136c	STATE NUMBERED TOWN HIGHWAY SIGN DETAILS	08/08/1995
E-163	TUBULAR STEEL SIGN POST	05/20/1999
T-1	TRAFFIC CONTROL GENERAL NOTES	08/06/2012
T-40	DELINEATORS AND MILEPOSTS	01/02/2013
T-44	MILE MARKER DETAILS STATE AND TOWN HIGHWAYS	04/09/2014
T-45	SQUARE TUBE SIGN POST AND ANCHOR	01/02/2013

2-1/2" SOIL BEARING SLIP BASE LOCATIONS

TOWN	DIRECTION	MILE POINT	NO. REQ.	SHEET
CAMBRIDGE	NB	8.668	2	59
CAMBRIDGE	NB	8.955	2	62
BAKERSFIELD	SB	3.721	2	98
BERKSHIRE	NB	4.773	2	115
BERKSHIRE	SB	4.864	2	125
BERKSHIRE	SB	4.832	2	126

1. THE LOCATIONS SHOWN IN THE TABLE ABOVE WILL REQUIRE THAT EACH 2-1/2" SQUARE STEEL SIGN POST, AS SPECIFIED ON THE APPLICABLE SIGN SUMMARY SHEET, BE INSTALLED USING A SOIL BEARING SLIP BASE WITH ANCHOR SLEEVE. AT THESE SPECIFIED LOCATIONS THE 2-1/2" POSTS ARE NOT PROTECTED BY GUARDRAIL OR CURBING, THUS REQUIRING THE USE OF SOIL BEARING SLIP BASES FOR THE SIZE POST.
2. PAYMENT FOR SOIL BEARING SLIP BASE WILL BE MADE UNDER CONTRACT ITEM 900.620 SPECIAL PROVISION (SOIL BEARING SLIP BASE) (2-1/2").

GENERAL

1. EXISTING STAND-ALONE MILE MARKER SIGNS OR MILE MARKER SIGNS ATTACHED TO A RETAINED SIGN POST ASSEMBLY SHALL BE RETAINED.
2. EXISTING MILE MARKER SIGNS ON SIGN POSTS BEING REPLACED SHALL BE REMOVED AND SALVAGED ONTO THE NEW SIGN POST, UNLESS OTHERWISE NOTED ON THE APPLICABLE SIGN SUMMARY SHEET OR AS DIRECTED BY THE ENGINEER.
3. EXISTING MILE MARKER SIGNS ATTACHED TO A SIGN ASSEMBLY THAT IS TO BE REMOVED OR RELOCATED SHALL BE REMOVED AND DISPOSED OF, UNLESS OTHERWISE NOTED ON THE APPLICABLE SIGN SUMMARY SHEET OR AS DIRECTED BY THE ENGINEER.
4. SELECTIVE CUTTING OF BRUSH OR TREE BRANCHES IN THE IMMEDIATE VICINITY OF A SIGN MAY BE NECESSARY TO PROVIDE FULL VISIBILITY FOR ANY EXISTING (RETAINED) OR NEW SIGN LOCATION. THIS WORK SHALL BE PERFORMED AT THE DIRECTION OF THE ENGINEER AND WILL BE PAID FOR UNDER CONTRACT ITEM 201.31 THINNING AND TRIMMING FOR SIGNS. THIS WORK SHALL BE DONE AT THE SAME TIME THE SIGN IS INSTALLED, OR AS DIRECTED BY THE ENGINEER. ALL SIGNS SHALL BE FULLY VISIBLE FROM THE APPROACHING TRAVEL LANE FOR A MINIMUM DISTANCE OF 250 FEET.ANY SELECTIVE CUTTING OF BRUSH OR TREE BRANCHES WITHIN THE SMUGGLER'S NOTCH AREA (STOWE MILEPOINT 7.820 TO CAMBRIDGE MILEPOINT 2.166) SHALL BE COORDINATED WITH AND APPROVED BY THE NORTHEAST PARKS REGIONAL MANAGER.
5. SEE THE UTILITIES SPECIAL PROVISIONS REGARDING REQUIREMENTS FOR UTILITIES LOCATED WITHIN THE PROJECT AREA.
6. THE QUANTITIES FOR 675.20 TRAFFIC SIGNS TYPE A, 675.341 SQUARE TUBE SIGN POST AND ANCHOR, AND 675.50 REMOVING SIGNS HAVE BEEN INCREASED TO COVER REPLACEMENT OF ANY ADDITIONAL DAMAGED SIGNS AND/OR POSTS NOT PROPOSED FOR REPLACEMENT IN THIS PLAN SET (ASSUMING 10% OF RETAINED SIGNS ARE DAMAGED). SUCH SIGNS AND/OR POSTS SHALL BE REVIEWED AND AGREED UPON BY THE CONTRACTOR AND ENGINEER PRIOR TO THE CONTRACTOR ORDERING SIGN AND/OR POST MATERIALS.
7. SEE NOTES FOR TRAFFIC CONTROL DRUM ON SHEET 4.

TEMPORARY TRAFFIC CONTROL NOTES

1. ALL TRAFFIC CONTROL DEVICES SHALL BE IN COMPLIANCE WITH THE LATEST EDITION OF THE MANUAL ON UNIFORM TRAFFIC CONTROL DEVICES (MUTCD), VAOT "STANDARD DRAWINGS" AND THE SPECIAL PROVISIONS. ADDITIONAL TRAFFIC CONTROL DEVICES MAY BE REQUIRED AND SHALL BE INSTALLED AS DIRECTED BY THE ENGINEER. PAYMENT WILL BE INCIDENTAL TO CONTRACT ITEM 641.10 TRAFFIC CONTROL.
2. WHEN WORKING IN THE VICINITY OF EXISTING PEDESTRIAN FACILITIES, AMERICANS WITH DISIBILITIES ACT (A.D.A.) ACCESSIBLE PEDESTRIAN ACCOMMODATIONS SHALL BE MAINTAINED AT ALL TIMES. PAYMENT WILL BE INCLUDED IN THE UNIT BID PRICE FOR CONTRACT ITEM 641.10 TRAFFIC CONTROL.
3. THE CONTRACTOR SHALL PROVIDE ACCESS THROUGH THE WORK ZONE FOR EMERGENCY VEHICLES AT ALL TIMES.
4. THE CONTRACTOR SHALL CONDUCT THE WORK AT ALL TIMES IN SUCH A MANNER AND IN SUCH SEQUENCE SO AS TO ENSURE THE LEAST INTERFERENCE WITH TRAFFIC OCCURS.
5. TEMPORARY TRAFFIC CONTROL SIGNS SHALL ONLY BE VISIBLE TO MOTORISTS AT THE TIMES WHEN THE MESSAGE IS PERTINENT, E.G. A "FLAGGER AHEAD" SIGN SHALL ONLY BE VISIBLE TO MOTORISTS WHEN THE FLAGGER IS ACTUALLY PRESENT PERFORMING THEIR DUTIES.
6. PAYMENT FOR CONSTRUCTION SIGNING WILL BE MADE UNDER CONTRACT ITEM 641.10 TRAFFIC CONTROL.
7. TEMPORARY TRAFFIC CONTROL SIGNS SHALL BE MOVED AS WORK AREA MOVES. AT NO TIME SHALL THE FLAGGER SIGN BE GREATER THAN 1000 FEET IN ADVANCE OF THE FLAGGER STATION.
8. THE CONTRACTOR SHALL COORDINATE WITH THE TOWNS AND UTILITY COMPANIES WITHIN THE PROJECT LIMITS TO ENSURE THAT THE CONTRACTOR'S WORK SCHEDULE AND/OR TRAFFIC CONTROL SIGNS DO NOT CONFLICT WITH TRAFFIC CONTROL SIGNS FOR OTHER CONSTRUCTION PROJECTS, WORK BEING COMPLETED ON OTHER CONSTRUCTION PROJECTS, OR LOCAL EVENTS.

SIGN INSTALLATION

1. THE CONTRACTOR SHALL BE RESPONSIBLE FOR REPAIRING ANY DAMAGE TO PRIVATE OR PUBLIC PROPERTY CAUSED BY THE CONTRACTOR, AT THE CONTRACTOR'S EXPENSE AND AT NO COST TO THE STATE.
2. ALL SIGNS WITHIN THE PROJECT LIMITS ARE TO BE RETAINED, REMOVED OR REPLACED AS NOTED OR AS DIRECTED BY THE ENGINEER. SIGN LOCATIONS AS SHOWN ON THE PLANS ARE APPROXIMATE; EXACT LOCATIONS TO BE DETERMINED IN THE FIELD.
3. ALL SIGN PLACEMENT SHALL BE IN CONFORMANCE WITH VAOT STANDARD E-121 STANDARD SIGN PLACEMENT CONVENTIONAL ROADS, UNLESS OTHERWISE NOTED.
4. ALL SIGNS, FRAMES, MOUNTING HARDWARE, POSTS, AND ANCHORS FOR ANY SIGN ASSEMBLY SHALL BE REPLACED AT THE SAME TIME. MIXING OF OLD AND NEW SIGNS ON THE SAME ASSEMBLY WILL NOT BE ALLOWED EXCEPT AS NOTED ON THE PLANS.
5. NEW SIGNS, WITH THEIR GREATER NIGHTTIME RETROREFLECTIVITY, CAN OBSCURE OLDER SIGNS MOUNTED IN CLOSE PROXIMITY TO THEM. TO AVOID CONFUSION OF ROAD USERS, WORK SHALL BE COORDINATED SUCH THAT ALL SIGNS ASSOCIATED WITH A CURVE, INTERSECTION OR SPEED LIMIT CHANGE SHALL BE REPLACED ON THE SAME DAY AND NOT LEFT INCOMPLETE OR WITH A MIXTURE OF OLD AND NEW SIGNS WITHIN A GROUP OF ASSOCIATED SIGNS.
6. ALL NEW SIGNS INSTALLATIONS, IF NEAR A UTILITY POLE, SHALL BE NO CLOSER THAN 10 FEET FROM THE UTILITY POLE.

SIGN DESIGN AND FABRICATION

1. ALL SIGNS SHALL BE DESIGNED IN ACCORDANCE WITH THE LATEST REVISION OF THE MUTCD, THE 2004 STANDARD HIGHWAY SIGNS AND MARKINGS (SHSM), AND THE 2012 SUPPLEMENT TO THE 2004 EDITION (SHSM) DETAILS AS AVAILABLE, VAOT STANDARDS OR AS DETAILED IN THE PLANS.
2. UNLESS OTHERWWISE NOTED ON THE PLANS, ALL SIGNS SHALL BE FLAT SHEET ALUMINUM WITH THE FOLLOWING MINIMUM THICKNESSES:

SIGN SIZE	12" X 12"		
	18" X 18"		
	21" X 15"		
	24" X 8"		
	24" X 10"		48" X 18"
	24" X 12"	36" X 12"	48" X 24"
	24" X 18"	36" X 15"	48" X 30"
	24" X 24"	36" X 18"	48" X 42"
	24" X 30"	36" X 24"	48" X 48"
	30" X 15"	36" X 36"	48" X 60"
	30" X 18"	36" X 42"	72" X 10"
	30" X 30"	36" X 48"	72 X 12"
	30" X 42"	36" X 54"	72" X 20"
THICKNESS	0.080"	0.100"	0.125"

3. ALL LETTERS AND NUMBERS USED FOR ALL SIGNS SHALL CONFORM TO THE APPLICABLE FONT AS DEFINED AND DETAILED IN THE 2004 SHSM AND THE 2012 SUPPLEMENT UNLESS OTHERWISE DETAILED IN THE PLANS.
4. ALL ARROWS AND SYMBOLS SHALL CONFORM WITH THE 2004 SHSM AND THE 2012 SUPPLEMENT UNLESS OTHERWISE DETAILED IN THE PLANS.
5. COLORS USED ON ALL SIGNS SHALL CONFORM WITH THE REQUIREMENTS OF SECTION 1A.12 OF THE MUTCD.
6. SIGN SHEETING FOR FLUORESCENT YELLOW (FY) AND FLUORESCENT YELLOW-GREEN (FYG) SHALL BE AASHTO M268 (ASTM D4956) TYPE VII, VIII, OR IX. ALL OTHER SIGN SHEETING SHALL BE TYPE III OR IV.
7. SHEETING TYPES AND MANUFACTURERS SHALL NOT BE MIXED ON A SINGLE SIGN ASSEMBLY. SHEETING COLOR/TYPE SHALL BE BY THE SAME MANUFACTURER AND SHALL BE CONSISTENT THROUGHOUT THE PROJECT.
8. SIGN BASE MATERIAL FOR ALL STREET NAME SIGNS SHALL BE EITHER 0.125 INCH THICK FLAT SHEET ALUMINUM OR EXTRUDED ALUMINUM WITH A 0.250 INCH THICK FLANGE AND 0.090 INCH MINIMUM WEB THICKNESS.


SIGN POSTS

1. ALL SQUARE STEEL SIGN POSTS SHALL BE INSTALLED IN A NEW ANCHOR. ALL SIGNS INSTALLED IN PAVED OR CONCRETE ISLANDS OR SIDEWALKS SHALL ALSO BE INSTALLED WITH AN 18" SLEEVE. PAYMENT FOR SLEEVE SHALL BE INCIDENTAL TO CONTRACT ITEM 675.341 SQUARE TUBE SIGN POST AND ANCHOR.
2. 1.75" SQUARE STEEL POSTS SHALL BE 14 GAGE STEEL. 2.0" AND 2.5" SQUARE STEEL POSTS SHALL BE 12 GAGE STEEL.
3. DIAMOND-SHAPED ADVANCE WARNING SIGNS 36" AND LARGER WILL REQUIRE TWO POSTS. ASSEMBLIES WITH TWO 30" DIAMOND-SHAPED SIGNS WILL REQUIRE TWO POSTS. POST SPACING SHALL BE AS FOLLOWS:

30" SIGN	15-20"
36" SIGN	18-24"
48" SIGN	24-32"

STREET NAME SIGN INSTALLATION

1. SIDE ROAD STREET NAME SIGNS, COMMONLY INSTALLED PERPENDICULAR TO APPROACHING MAINLINE TRAFFIC, SHALL BE POSITIONED IN SUCH A WAY AS TO ENSURE THE BEST POSSIBLE VISIBILITY TO APPROACHING MAINLINE TRAFFIC FROM EACH DIRECTION. IN MANY CASES, STREET NAME SIGNS MAY BE INSTALLED ABOVE THE SIDE ROAD STOP SIGN. IN CASES WHERE THE SIDE ROAD STOP SIGN POSITION WOULD NOT BE SUITABLE FOR A TOP-MOUNTED STREET NAME SIGN, OR DUE TO OTHER SITE-SPECIFIC CONSTRAINTS, THE STREET NAME SIGN MAY BE INSTALLED A MINIMUM OF SIX FEET FROM THE EDGE OF PAVEMENT OF THE MAINLINE ROUTE TO THE NEAREST EDGE OF THE SIGN.
2. STREET NAME SIGNS WITH A LENGTH EXCEEDING 42-INCHES SHALL BE INSTALLED ON TWO POSTS. NO MORE THAN TWO POSTS SHALL OCCUPY AN EIGHT FOOT TRAVEL PATH, UNLESS PROTECTED BY BARRIER.
3. TOP-MOUNTED STREET NAME SIGNS REQUIRE 12-INCH MOUNTING BRACKETS. ALL MOUNTING HARDWARE WILL BE CONSIDERED INCIDENTAL TO PAY ITEM 675.20 TRAFFIC SIGNS, TYPE A.
4. IF EXISTING STREET NAME SIGNS ARE SALVAGED, THEY SHALL BE RE-INSTALLED PER THE ABOVE NOTES OR AS DIRECTED BY THE ENGINEER.
5. STREET NAME SIGNS FOR PRIVATE ROADS SHALL BE RETAINED. UNLESS OTHERWISE NOTED OR AS DIRECTED BY THE ENGINEER.

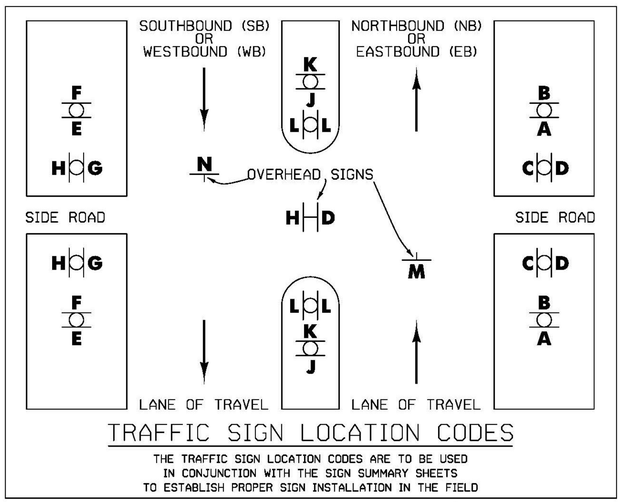

TRAFFIC SIGN LOCATION CODES

THE TRAFFIC SIGN LOCATION CODES ARE TO BE USED IN CONJUNCTION WITH THE SIGN SUMMARY SHEETS TO ESTABLISH PROPER SIGN INSTALLATION IN THE FIELD

PROJECT NAME: STOWE-BERKSHIRE
PROJECT NUMBER: STPG SIGN(49)

TYLIN INTERNATIONAL

FILE NAME: z13b620NOTES.dgn
PROJECT LEADER: D. BRYANT
DESIGNED BY: J. BLANCHARD
INDEX OF SHEETS AND PROJECT NOTES

PLOT DATE: 7/29/2015
DRAWN BY: J. BLANCHARD
CHECKED BY: K. KERN
SHEET 2 OF 131

STATE OF VERMONT
AGENCY OF TRANSPORTATION

QUANTITY SHEET 1

SUMMARY OF ESTIMATED QUANTITIES	TOTALS		DESCRIPTIONS				DETAILED SUMMARY OF QUANTITIES		
ROADWAY	GRAND TOTAL	FINAL	UNIT	ITEMS	ITEM NUMBER	ROUND	QUANTITIES	UNIT	ITEMS
40	40		EACH	THINNING AND TRIMMING FOR SIGNS	201.31	EST			
1	1		CY	TRENCH EXCAVATION OF EARTH, EXPLORATORY (N.A.B.I.)	204.22	EST			
70	70		HR	UNIFORMED TRAFFIC OFFICERS	630.10	EST			
570	570		HR	FLAGGERS	630.15	EST			
1	1		LS	MOBILIZATION/DEMOBILIZATION	635.11	-			
1	1		LS	TRAFFIC CONTROL	641.10	-			
3690	3690		SF	TRAFFIC SIGNS, TYPE A	675.20	11			
324	324		LB	TUBULAR STEEL SIGN POST	675.33	-			
9620	9620		LF	SQUARE TUBE SIGN POST AND ANCHOR	675.341	20			
2	2		EACH	FOUNDATION FOR TUBULAR STEEL POST	675.43	-			
810	810		EACH	REMOVING SIGNS	675.50	6			
63	63		EACH	ERECTING SALVAGED SIGNS	675.60	-			
24	24		EACH	DELINEATOR WITH STEEL POST	676.10	-			
14	14		EACH	SPECIAL PROVISION (SOIL BEARING SLIP BASE) (2 1/2")	900.620	2			

TYLIN INTERNATIONAL


PROJECT NAME: STOWE-BERKSHIRE
PROJECT NUMBER: STPG SIGN(49)

FILE NAME: zl3b620qty.dgn
PROJECT LEADER: D. BRYANT
DESIGNED BY: J. BLANCHARD
QUANTITY SHEET 1

PLOT DATE: 7/31/2015
DRAWN BY: J. BLANCHARD
CHECKED BY: K. KERN
SHEET 3 OF 131

TRAFFIC CONTROL DRUM NOTES:


1. THESE NOTES REFER TO THE ONE DRUM AND SIGN TO BE INSTALLED AT BAKERSFIELD SB MILEPOINT 3.884
2. FURNISHING, FABRICATING, TRANSPORTING, HANDLING, MODIFYING AND INSTALLING TRAFFIC CONTROL DRUM WILL BE CONSIDERED INCIDENTAL TO CONTRACT ITEM 675.341, INCLUDING ALL LABOR, TOOLS, EQUIPMENT, AND INCIDENTALS NECESSARY TO COMPLETE THE WORK. MATERIALS SHALL MEET THE REQUIREMENTS OF THE CONTRACT AND THE LATEST EDITION OF THE MUTCD.
3. DRUM SHALL BE OF PLASTIC OR OTHER YIELDING MATERIAL, AND SHALL BE APPROXIMATELY 36 INCHES HIGH AND A MINIMUM OF 18 INCHES IN DIAMETER.
4. THERE SHALL BE AT LEAST TWO RETRO-REFLECTORIZED ORANGE AND AT LEAST TWO RETRO-REFLECTORIZED WHITE STRIPES AT LEAST 4 INCHES WIDE ON THE DRUM.
5. DRUM MAY BE CONSTRUCTED FROM NEW OR RECYCLED PLASTIC. METAL DRUM SHALL NOT BE USED.
6. DRUM SHALL NOT BE WEIGHTED ON THE TOP. DRAIN HOLES SHALL BE PROVIDED TO PREVENT WATER FROM ACCUMULATING IN THE DRUM. DRUM MAY BE WEIGHTED WITH UP TO 6 INCHES OF LOOSE DRY SAND.
7. THE DRUM SHALL BE MODIFIED BY CUTTING A HOLE IN THE TOP AND BOTTOM SUCH THAT IT WILL FIT SNUGLY AROUND THE PROPOSED SIGN POST.
8. NO ADDITIONAL PAYMENT WILL BE MADE FOR A DRUM THAT REQUIRES REPLACEMENT DUE TO POOR CONDITION OR INADEQUATE RETROREFLECTIVITY.

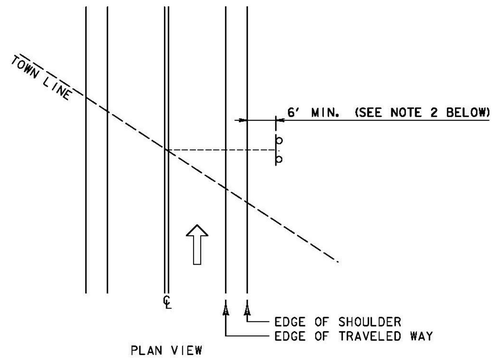

PLAN VIEW

TOWN / COUNTY LINE (VD-024 / VD-025) INSTALLATION:

1. THE SIGN SHALL BE MOUNTED PARALLEL WITH THE ROADWAY, NORMALLY ON THE RIGHT SIDE TRAVELING WEST TO EAST OR SOUTH TO NORTH.
2. THE MINIMUM LATERAL OFFSET SHOULD BE TWELVE FEET FROM THE EDGE OF THE TRAVELED WAY. IF A SHOULDER WIDER THAN SIX FEET EXISTS, THE MINIMUM LATERAL OFFSET FOR POST MOUNTED SIGNS SHOULD BE SIX FEET FROM THE EDGE OF SHOULDER.

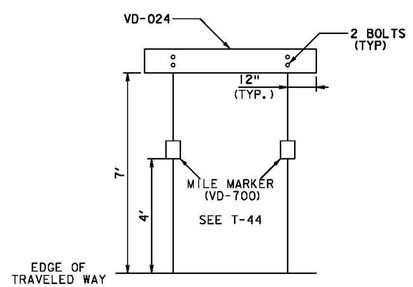

WHEN CROSSING COUNTY BOUNDARIES, AN ADDITIONAL COUNTY LINE SIGN (VD-025) SHALL BE MOUNTED BELOW THE TOWN LINE SIGN (VD-024), MAINTAINING A SEVEN FOOT CLEARANCE.

DELINEATOR LOCATIONS:

TOWN:	DIRECTION:	MILE POINT:	NO. OF NEW TYPE II DELINEATORS (POSTS):	NO. OF REMOVALS:	POST SPACING (FT):	SHEET:
STOWE	SB	2.388-2.320	16 (8)	-	60	35
STOWE	SB	0.124-0.107	8 (4)	-	30	42

NOTE: ALL DELINEATOR PLACEMENT SHALL BE IN CONFORMANCE WITH VAOT STANDARD T-40 DELINEATORS AND MILEPOSTS, UNLESS OTHERWISE NOTED.

ALL DELINEATORS SHALL BE PLACED BACK TO BACK.

ALL DIMENSIONS SHOWN IN INCHES, EXCEPT WHERE NOTED.
NOT TO SCALE


PROJECT NAME: STOWE-BERKSHIRE
PROJECT NUMBER: STPG SIGN(49)

NOT TO SCALE
TYLIN INTERNATIONAL

FILE NAME: z13b620_SD01.dgn
PROJECT LEADER: D. BRYANT
DESIGNED BY: J. BLANCHARD
SIGN DETAILS I


PLOT DATE: 7/29/2015
DRAWN BY: J. BLANCHARD
CHECKED BY: K. KERN
SHEET 4 OF 131

TYPE 1

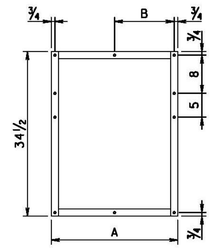


FRAME TYPE	A	B
1A	26 1/2	12 1/2
1B	29 1/2	15 1/2
1C	32 1/2	15 1/2

TYPE 2

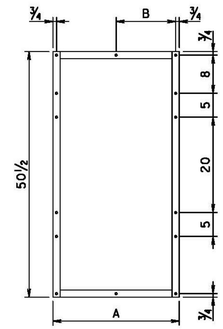


FRAME TYPE	A	B
2A	26 1/2	12 1/2
2B	29 1/2	15 1/2
2C	32 1/2	15 1/2


TYPE 3

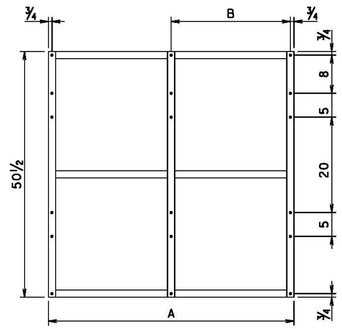


FRAME TYPE	A	B
3A	51 1/2	25
3B	54 1/2	28
3C	57 1/2	28
3D	63 1/2	31

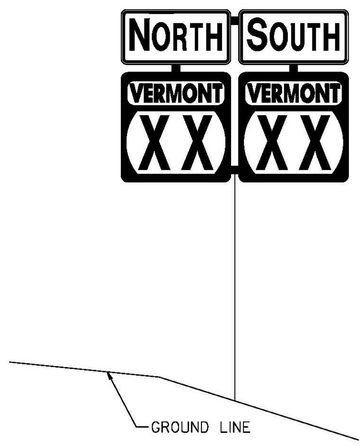

ROUTE MARKER ASSEMBLY TYPE 1

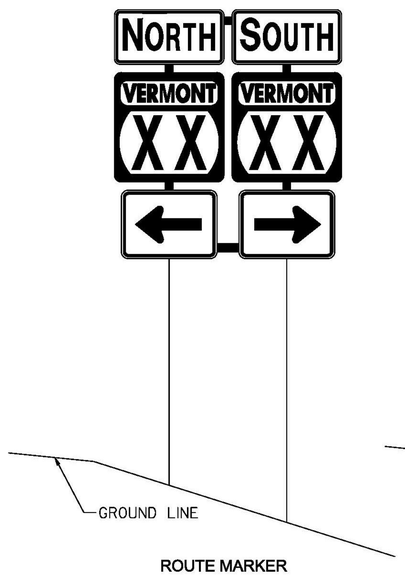



ROUTE MARKER ASSEMBLY TYPE 2

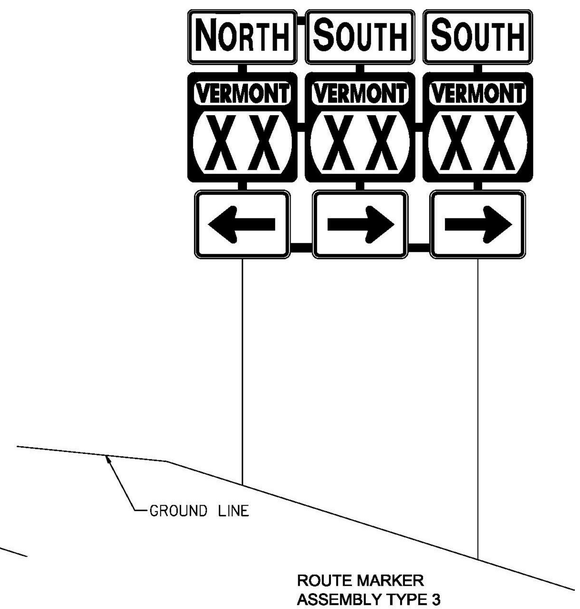

ROUTE MARKER ASSEMBLY TYPE 3

ROUTE MARKER ASSEMBLY FRAMES

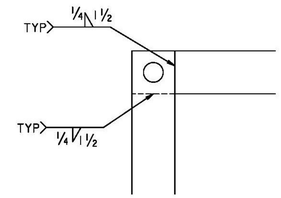

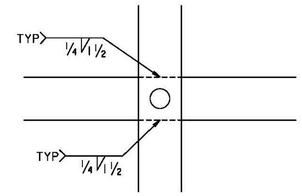

WELDING DETAILS

GENERAL NOTES:

1. TYPE 1A FRAME ASSEMBLY TO BE USED WITH TWO 24 INCH WIDE SIGN COLUMNS.
2. TYPE 1B FRAME ASSEMBLY TO BE USED WITH ONE 24 INCH WIDE SIGN COLUMN AND ONE 30 INCH WIDE SIGN COLUMN.
3. TYPE 1C FRAME ASSEMBLY TO BE USED WITH TWO 30 INCH WIDE SIGN COLUMNS.
4. TYPE 2A FRAME ASSEMBLY TO BE USED WITH TWO 24 INCH WIDE SIGN COLUMNS.
5. TYPE 2B FRAME ASSEMBLY TO BE USED WITH ONE 24 INCH COLUMN AND ONE 30 INCH WIDE SIGN COLUMN.
6. TYPE 2C FRAME ASSEMBLY TO BE USED WITH TWO 30 INCH WIDE COLUMNS.
7. TYPE 3A FRAME ASSEMBLY TO BE USED WITH THREE 24 INCH WIDE SIGN COLUMNS.
8. TYPE 3B FRAME ASSEMBLY TO BE USED WITH TWO 24 INCH SIGN COLUMNS AND ONE 30 INCH WIDE SIGN COLUMN, WITH THE 30 INCH SIGN COLUMN IN AN OUTSIDE POSITION.
9. TYPE 3C FRAME ASSEMBLY TO BE USED WITH ONE 24 INCH WIDE SIGN COLUMN IN THE CENTER AND TWO 30 INCH SIGN COLUMNS ON THE OUTSIDE OR ONE 30 INCH SIGN COLUMN IN THE CENTER AND TWO 24 INCH COLUMNS ON THE OUTSIDE.
10. TYPE 3D FRAME ASSEMBLY TO BE USED WITH THREE 30 INCH WIDE SIGN COLUMNS.
11. ALL HOLES SHALL BE 7/16 INCH DIAMETER.
12. FOR SIGN COMBINATIONS OTHER THAN ABOVE, THE FRAME DIMENSIONS AND HOLE SPACING SHALL BE MODIFIED AS NECESSARY.
13. STANDARD FRAMES SHALL BE CONSTRUCTED OF 5/16 INCH X 1½ INCH A-36 STEEL.
14. SEE THE MANUAL ON UNIFORM TRAFFIC CONTROL DEVICES (MUTCD) SECTION 2D.29 FOR INSTALLATION SEQUENCE.
15. ALL DIMENSIONS SHOWN IN INCHES, UNLESS OTHERWISE NOTED.


ALL DIMENSIONS SHOWN IN INCHES, EXCEPT WHERE NOTED.
NOT TO SCALE

PROJECT NAME: STOWE-BERKSHIRE
PROJECT NUMBER: STPG SIGN(49)


TYLININTERNATIONAL

FILE NAME: z13b620_SD01.dgn
PROJECT LEADER: D. BRYANT
DESIGNED BY: J. BLANCHARD
SIGN DETAILS 2

PLOT DATE: 6/25/2015
DRAWN BY: J. BLANCHARD
CHECKED BY: K. KERN
SHEET 5 OF 131

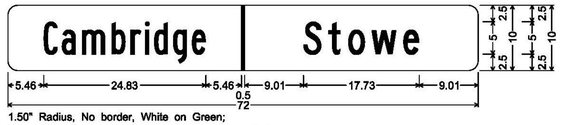


1.50" Radius, No border, White on Green;
[Cambridge] B specified length; [Stowe] C specified length;

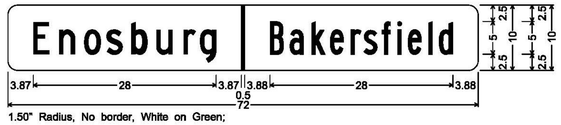


1.50" Radius, No border, White on Green;
[Enosburg] C specified length; [Bakersfield] B specified length;


ALL SIGNS IN THIS SECTION ARE SIGN CODE VD-024

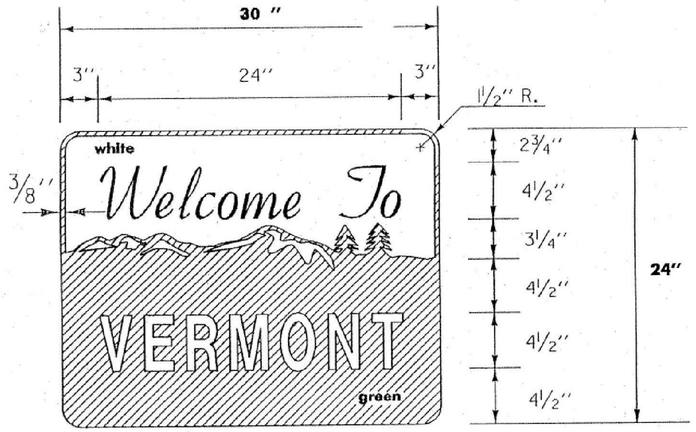

VD-421

NOTE:
FOR THE WORDS "WELCOME TO" USE GERBER FONT MURRAY HILL BOLD OR EQUIVALENT. TEXT COLOR IS GREEN.
ALL OTHER TEXT USE GERBER FONT SOUVENIR DEMI BOLD OR EQUIVALENT. TEXT COLOR IS WHITE.
REFER TO STD. E-131 FOR COLORS.

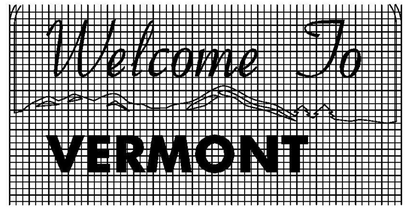


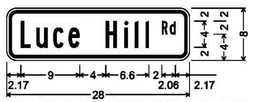

1.50" Radius, 0.38" Border, 0.38" Indent, Black on Yellow;
[Luce Hill] B; [Rd] B;




1.50" Radius, 0.38" Border, 0.38" Indent, Black on Yellow;
[Boston Post] B; [Rd] B;

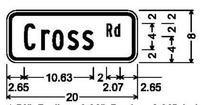


1.50" Radius, 0.38" Border, 0.38" Indent, Black on Yellow;
[Cross] B; [Rd] B;


ALL SIGNS IN THIS SECTION ARE SIGN CODE W16-8

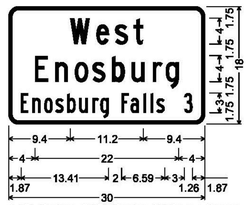


1.50" Radius, 0.50" Border, White on Green;
[West] C specified length;
[Enosburg] C specified length;
[Enosburg Falls] B specified length;
[3] B;

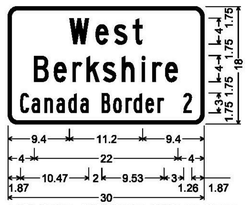

1.50" Radius, 0.50" Border, White on Green;
[West] C specified length;
[Berkshire] C specified length;
[Canada Border] B specified length;
[3] B;

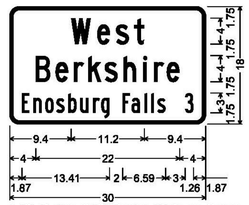

1.50" Radius, 0.50" Border, White on Green;
[West] C specified length;
[Berkshire] C specified length;
[Enosburg Falls] B specified length;
[3] B;

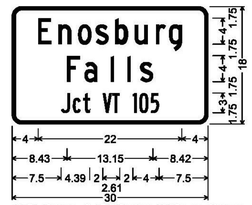

1.50" Radius, 0.50" Border, White on Green;
[Enosburg] C specified length;
[Falls] C specified length;
[Jct VT 105] B specified length;

ALL SIGNS IN THIS SECTION ARE SIGN CODE VD-018


ALL DIMENSIONS SHOWN IN INCHES, EXCEPT WHERE NOTED.
NOT TO SCALE

PROJECT NAME: STOWE-BERKSHIRE
PROJECT NUMBER: STPG SIGN(49)


TYLIN INTERNATIONAL

FILE NAME: z13b620_SD02.dgn
PROJECT LEADER: D. BRYANT
DESIGNED BY: J. BLANCHARD
SIGN DETAILS 3


PLOT DATE: 6/25/2015
DRAWN BY: J. BLANCHARD
CHECKED BY: K. KERN
SHEET 6 OF 131

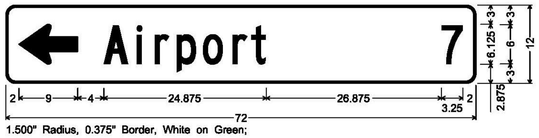

1.500" Radius, 0.375" Border, White on Green;
Standard Arrow Custom 9.000" X 6.125" 180°; [Airport] C; [7] C;

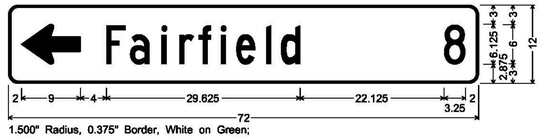


1.500" Radius, 0.375" Border, White on Green;
Standard Arrow Custom 9.000" X 6.125" 180°; [Fairfield] C; [8] C;

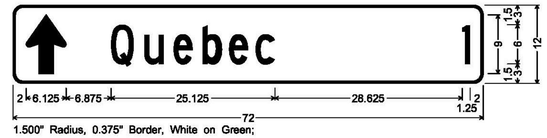

1.500" Radius, 0.375" Border, White on Green;
Standard Arrow Custom 9.000" X 6.125" 90°; [Quebec] C; [1] C;




1.500" Radius, 0.375" Border, White on Green;
Standard Arrow Custom 9.000" X 6.125" 180°; [Morrisville] C; [9] C;

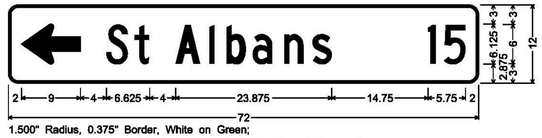

1.500" Radius, 0.375" Border, White on Green;
Standard Arrow Custom 9.000" X 6.125" 180°; [St Albans] C; [15] C;



1.500" Radius, 0.375" Border, White on Green;
Standard Arrow Custom 9.000" X 6.125" 180°; [Franklin] C; [6] C;

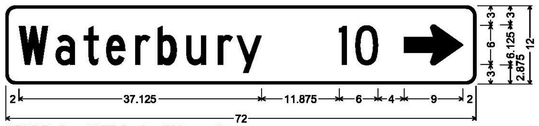


1.500" Radius, 0.375" Border, White on Green;
[Waterbury] C; [10] C; Standard Arrow Custom 9.000" X 6.125" 0°;




1.500" Radius, 0.375" Border, White on Green;
Standard Arrow Custom 9.000" X 6.125" 90°; [Jeffersonville] C 80% spacing; [11] C;



1.500" Radius, 0.375" Border, White on Green;
Standard Arrow Custom 9.000" X 6.125" 90°; [Enosburg Falls] B; [8] C;

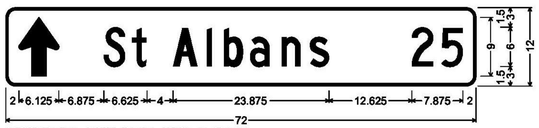


1.500" Radius, 0.375" Border, White on Green;
Standard Arrow Custom 9.000" X 6.125" 90°; [St Albans] C; [25] C;

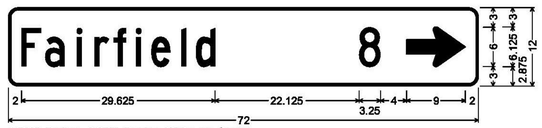

1.500" Radius, 0.375" Border, White on Green;
[Fairfield] C; [8] C; Standard Arrow Custom 9.000" X 6.125" 0°;



1.500" Radius, 0.375" Border, White on Green;
[Franklin] C; [6] C; Standard Arrow Custom 9.000" X 6.125" 0°;

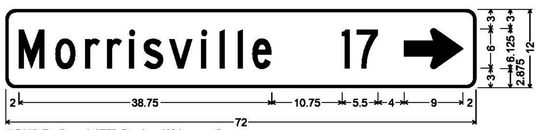

1.500" Radius, 0.375" Border, White on Green;
[Morrisville] C; [17] C; Standard Arrow Custom 9.000" X 6.125" 0°;



1.500" Radius, 0.375" Border, White on Green;
[St Albans] C; [15] C; Standard Arrow Custom 9.000" X 6.125" 0°;



1.500" Radius, 0.375" Border, White on Green;
Standard Arrow Custom 9.000" X 6.125" 90°; [Berkshire] C; [2] C;



1.500" Radius, 0.375" Border, White on Green;
[Enosburg] C; [20] C; Standard Arrow Custom 9.000" X 6.125" 0°;



1.500" Radius, 0.375" Border, White on Green;
[Berkshire] C; [2] C; Standard Arrow Custom 9.000" X 6.125" 0°;



1.500" Radius, 0.375" Border, White on Green;
Standard Arrow Custom 9.000" X 6.125" 90°; [E. Berkshire] C; [7] C;



1.500" Radius, 0.375" Border, White on Green;
Standard Arrow Custom 9.000" X 6.125" 90°; [Enosburg Falls] B; [9] C;



1.500" Radius, 0.375" Border, White on Green;
[E. Berkshire] C; [2] C; Standard Arrow Custom 9.000" X 6.125" 0°;

ALL SIGNS IN THIS SECTION ARE SIGN CODE VD1-1a


ALL DIMENSIONS SHOWN IN INCHES, EXCEPT WHERE NOTED.
NOT TO SCALE

PROJECT NAME: STOWE-BERKSHIRE
PROJECT NUMBER: STPG SIGN(49)

TYLIN INTERNATIONAL


FILE NAME: z13b620_SD02.dgn
PROJECT LEADER: D. BRYANT
DESIGNED BY: J. BLANCHARD
SIGN DETAILS 4

PLOT DATE: 6/25/2015
DRAWN BY: J. BLANCHARD
CHECKED BY: K. KERN
SHEET 7 OF 131

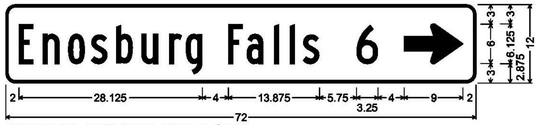


1.500" Radius, 0.375" Border, White on Green;
[Enosburg Falls] B; [6] C; Standard Arrow Custom 9.000" X 6.125" 0°;

ALL SIGNS IN THIS SECTION ARE SIGN CODE VD1-1a

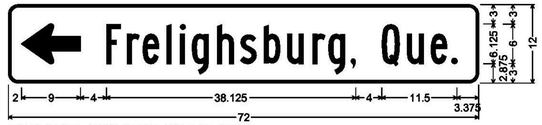

1.500" Radius, 0.375" Border, White on Green;
Standard Arrow Custom 9.000" X 6.125" 180°; [Frelighsburg, Que.] B 80% spacing;

ALL SIGNS IN THIS SECTION ARE SIGN CODE VD1-1

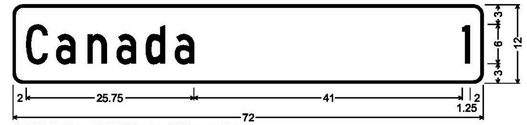

1.500" Radius, 0.375" Border, White on Green;
[Canada] C; [1] C;




1.500" Radius, 0.375" Border, White on Green;
[Enosburg] C [Falls] B; [6] C;

ALL SIGNS IN THIS SECTION ARE SIGN CODE VD2-1

ALL DIMENSIONS SHOWN IN INCHES, EXCEPT WHERE NOTED.
NOT TO SCALE

PROJECT NAME: STOWE-BERKSHIRE	
PROJECT NUMBER: STPG SIGN(49)	
TYLIN INTERNATIONAL	
FILE NAME: z13b620_SD02.dgn	PLOT DATE: 6/25/2015
PROJECT LEADER: D. BRYANT	DRAWN BY: J. BLANCHARD
DESIGNED BY: J. BLANCHARD	CHECKED BY: K. KERN
SIGN DETAILS 5	SHEET 8 OF 131

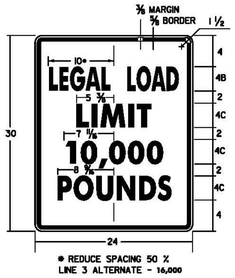


VR-017



VR-039




VR-038

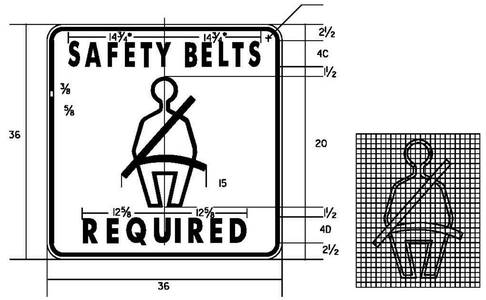


VR-601

*REDUCE SPACING 50%

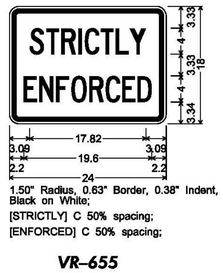


1.50" Radius, 0.63" Border, 0.38" Indent, Black on White;
[STRICTLY] C 50% spacing;
[ENFORCED] C 50% spacing;

VR-655

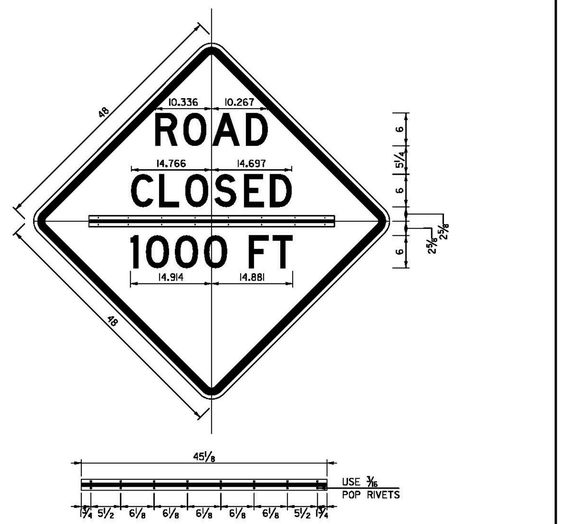


W20-3H


48.000" across sides 3.000" Radius, 1.250" Border, 0.750" Indent, Black on Fluorescent orange;
[ROAD] D; [CLOSED] D; [1000 FT] D;

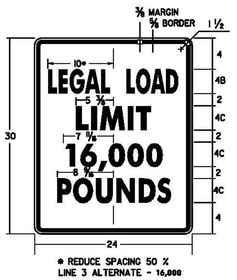

VR-017

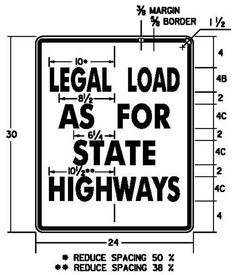


VR-079

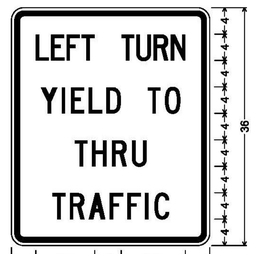


1.88" Radius, 0.75" Border, 0.50" Indent, Black on White;
[LEFT TURN] C 50% spacing;
[YIELD TO] C; [THRU] C;
[TRAFFIC] C;

VR-615

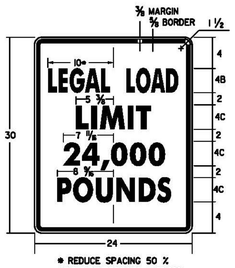

VR-017

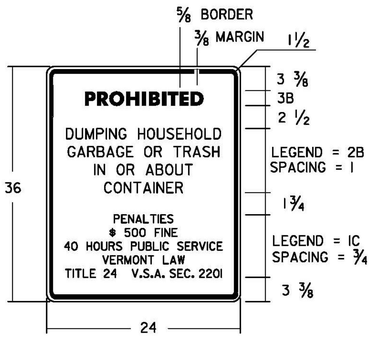


VR-278




COLORS
LEGEND - RED (REFL.)
BACKGROUND - WHITE (REFL.)

VR-020

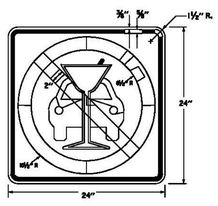


VR-654

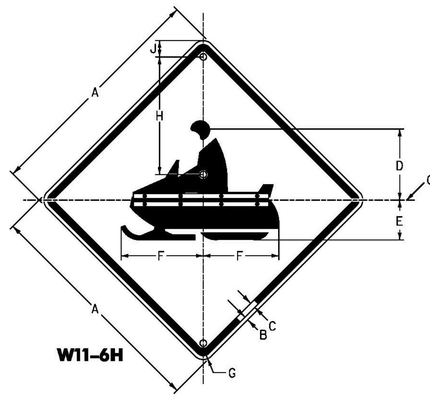

W11-6H

SIGN	DIMENSIONS (INCHES)								
	A	B	C	D	E	F	G	H	J
STD.	30	½	¾	11 7/16	5 5/16	12 11/16	1 7/8	14	2½
SPECIAL	36	⅝	⅞	14 1/8	6¾	15¼	2¼	19	2½

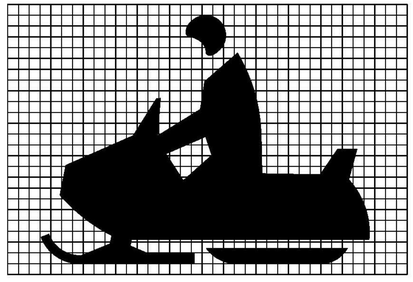

SPECIAL
1¾" 5½" 6⅛" 6⅛" 5½" 1¾"
USE 3/16" POP RIVETS
26¾"
USE STANDARD 2" (BLACK) PIANO HINGE

STD.
1¾" 5½" 5½" 1¾"
USE 3/16" POP RIVETS
20¾"
USE STANDARD 2" (BLACK) PIANO HINGE


ALL DIMENSIONS SHOWN IN INCHES, EXCEPT WHERE NOTED.
NOT TO SCALE

PROJECT NAME: STOWE-BERKSHIRE
PROJECT NUMBER: STPG SIGN(49)

TYLIN INTERNATIONAL

FILE NAME: z13b620_SD02.dgn
PROJECT LEADER: D. BRYANT
DESIGNED BY: J. BLANCHARD
SIGN DETAILS 6

PLOT DATE: 6/26/2015
DRAWN BY: J. BLANCHARD
CHECKED BY: K. KERN
SHEET 9 OF 131

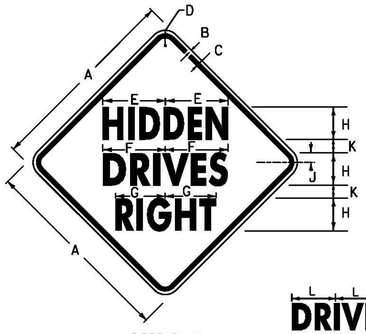


VW-054




VW-133

SIGN	DIMENSIONS (INCHES)											
	A	B	C	D	E	F	G	H	J	K	L	M
MIN	24	3/8	5/8	1 1/2	7 11/16	7 5/8	6 3/16	4C	1 3/16	2	6 3/16	4 7/8
STD	30	1/2	3/4	1 7/8	9 9/16	9 1/2	7 11/16	5C	1 1/2	2	7 3/4	6 1/8
EXPWY.	36	5/8	7/8	2 1/4	11 7/16	11 7/16	9 3/16	6C	1 13/16	2 3/8	9 5/16	7 3/8
SPECIAL	48	3/4	1 1/4	3	15 3/8	15 1/4	12 5/16	8C	2 3/8	3 3/16	12 3/8	9 13/16

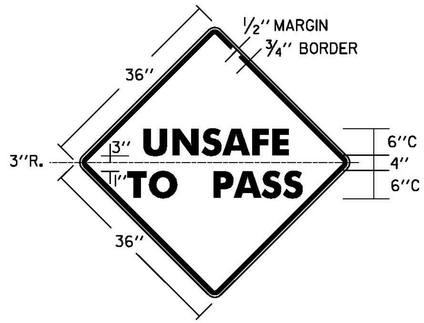


VW-092

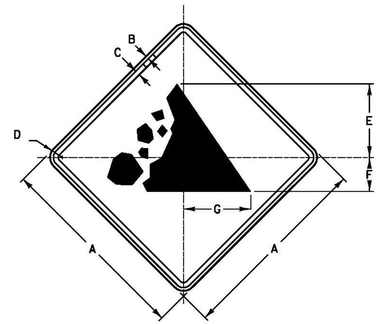


VW-285

COLORS
TEXT AND BORDER - BLACK (NON-REFL.)
BACKGROUND - YELLOW (REFL.)

SIGN	DIMENSIONS (INCHES)						
	A	B	C	D	E	F	G
STD.	30	1/2	3/4	1 1/2	11 1/4	5 1/4	10 5/8
SPECIAL	48	3/4	1 1/4	3	18	8 3/8	16 1/2

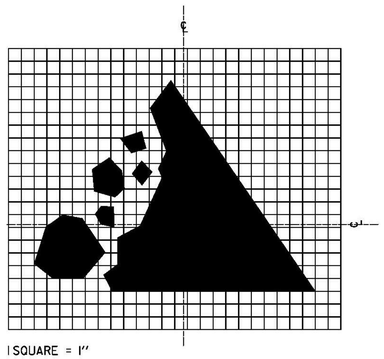


1 SQUARE = 1"

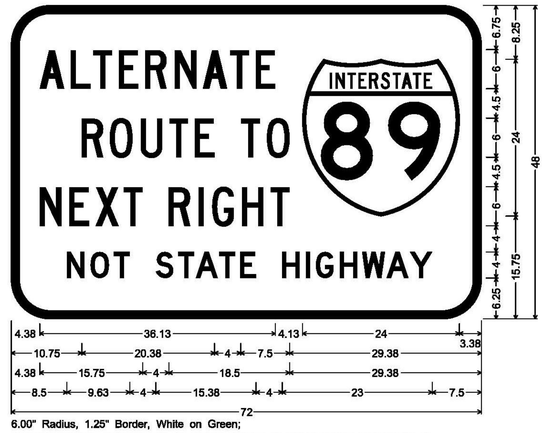


6.00" Radius, 1.25" Border, White on Green;
[ALTERNATE] C; [ROUTE TO] C; [NEXT RIGHT] C; [NOT STATE HIGHWAY] D;

VD-271

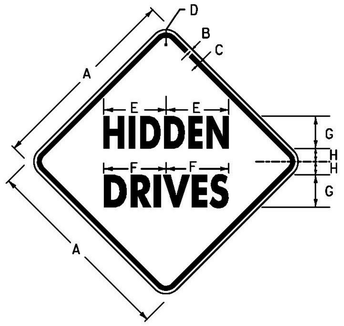

SIGN	DIMENSIONS (INCHES)							
	A	B	C	D	E	F	G	H
MIN	24	3/8	5/8	1 1/2	7 11/16	7 5/8	4C	2
STD	30	1/2	3/4	1 7/8	9 9/16	9 1/2	5C	2
EXPWY.	36	5/8	7/8	2 1/4	11 1/2	11 7/16	6C	2 3/8
SPECIAL	48	3/4	1 1/4	3	15 3/8	15 1/4	8C	3 3/16

VW-060

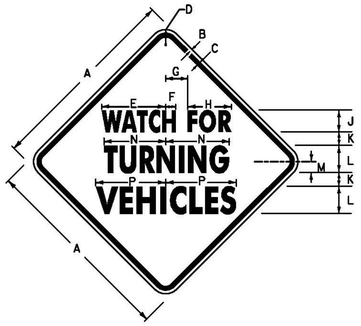

SIGN	DIMENSIONS (INCHES)													
	A	B	C	D	E	F	G	H	J	K	L	M	N	P
MIN	30	1/2	3/4	1 1/8	9 5/8	1 1/2	3 3/8	6 3/8	4B	2	5B	2	9 1/4	10 1/4
STD	36	5/8	7/8	2 1/4	11 3/4	1 7/8	4	8	4C	2 1/2	5C	2	11 1/2	12 7/8
SPECIAL	48	3/4	1 1/4	3	14 3/4	2 3/8	5 3/8	10	5C	3 3/8	8B	2 5/8	14 15/16	16 7/16

VW-205


ALL DIMENSIONS SHOWN IN INCHES, EXCEPT WHERE NOTED.
NOT TO SCALE

PROJECT NAME: STOWE-BERKSHIRE
PROJECT NUMBER: STPG SIGN(49)

TYLIN INTERNATIONAL

FILE NAME: z13b620_SD02.dgn
PROJECT LEADER: D. BRYANT
DESIGNED BY: J. BLANCHARD
SIGN DETAILS 7


PLOT DATE: 6/25/2015
DRAWN BY: J. BLANCHARD
CHECKED BY: K. KERN
SHEET 10 OF 131

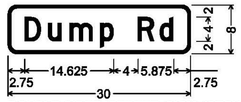


DOUBLE-SIDED STREET SIGN (STOWE);
1.500" Radius, 0.500" Border, White on Green;
[Dump Rd] D



DOUBLE-SIDED STREET SIGN (STOWE);
1.500" Radius, 0.500" Border, White on Green;
[Edson Hill] D; [Rd] D;

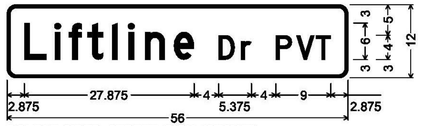


DOUBLE-SIDED STREET SIGN (STOWE);
1.500" Radius, 0.500" Border, White on Green;
[Liftline] D 90% spacing; [Dr PVT] D 90% spacing;

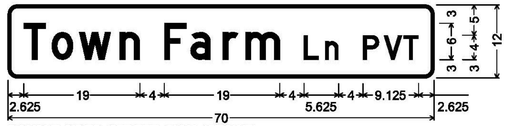


DOUBLE-SIDED STREET SIGN (STOWE);
1.500" Radius, 0.500" Border, White on Green;
[Town Farm] D; [Ln PVT] D;



DOUBLE-SIDED STREET SIGN (STOWE);
1.500" Radius, 0.500" Border, White on Green;
[Topnotch] D; [Dr PVT] D;

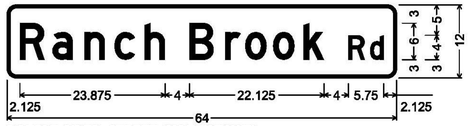


DOUBLE-SIDED STREET SIGN (STOWE);
1.500" Radius, 0.500" Border, White on Green;
[Ranch Brook] D; [Rd] D;

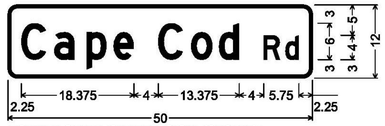


DOUBLE-SIDED STREET SIGN (STOWE);
1.500" Radius, 0.500" Border, White on Green;
[Cape Cod] D; [Rd] D;




DOUBLE-SIDED STREET SIGN (STOWE);
1.500" Radius, 0.500" Border, White on Green;
[Hartson] D; [Rd PVT] D;

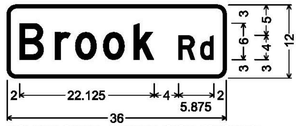


DOUBLE-SIDED STREET SIGN (STOWE);
1.500" Radius, 0.500" Border, White on Green;
[Brook] D; [Rd] D;

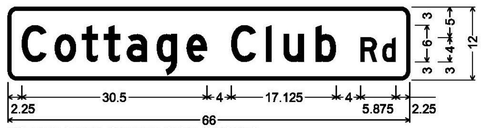


DOUBLE-SIDED STREET SIGN (STOWE);
1.500" Radius, 0.500" Border, White on Green;
[Cottage Club] D; [Rd] D;

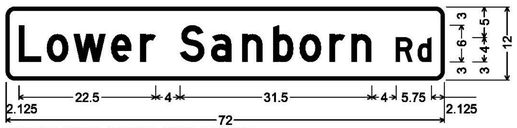


DOUBLE-SIDED STREET SIGN (STOWE);
1.500" Radius, 0.500" Border, White on Green;
[Lower Sanborn] D 90% spacing; [Rd] D;

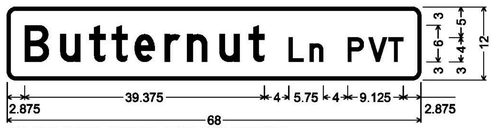


DOUBLE-SIDED STREET SIGN (CAMBRIDGE);
1.500" Radius, 0.500" Border, White on Green;
[Butternut] D; [Ln PVT] D;

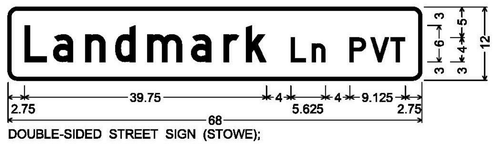


DOUBLE-SIDED STREET SIGN (STOWE);
1.500" Radius, 0.500" Border, White on Green;
[Landmark] D; [Ln PVT] D;

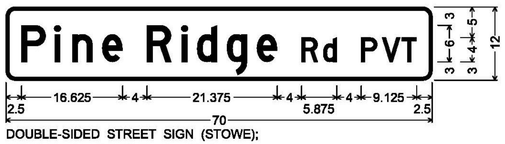


DOUBLE-SIDED STREET SIGN (STOWE);
1.500" Radius, 0.500" Border, White on Green;
[Pine Ridge] D; [Rd PVT] D;

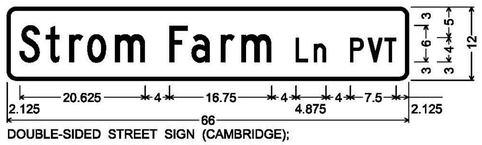

DOUBLE-SIDED STREET SIGN (CAMBRIDGE);
1.500" Radius, 0.500" Border, White on Green;
[Strom Farm] C; [Ln PVT] C;

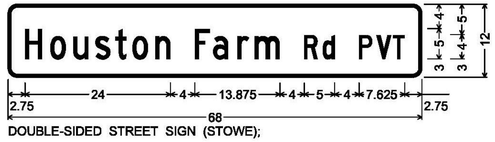

DOUBLE-SIDED STREET SIGN (STOWE);
1.500" Radius, 0.500" Border, White on Green;
[Houston Farm] C; [Rd PVT] C;

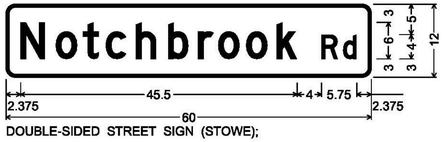

DOUBLE-SIDED STREET SIGN (STOWE);
1.500" Radius, 0.500" Border, White on Green;
[Notchbrook] D; [Rd] D;



DOUBLE-SIDED STREET SIGN (STOWE);
1.500" Radius, 0.500" Border, White on Green;
[Luce Hill] D; [Rd] D;

ALL SIGNS ON THIS PAGE ARE SIGN CODE D3-1
(ALL SIGNS ARE DOUBLE - SIDED)


ALL DIMENSIONS SHOWN IN INCHES, EXCEPT WHERE NOTED.
NOT TO SCALE

PROJECT NAME: STOWE-BERKSHIRE
PROJECT NUMBER: STPG SIGN(49)

TYLIN INTERNATIONAL

FILE NAME: z13b620_SD03.dgn
PROJECT LEADER: D. BRYANT
DESIGNED BY: J. BLANCHARD
SIGN DETAILS 8


PLOT DATE: 6/25/2015
DRAWN BY: J. BLANCHARD
CHECKED BY: K. KERN
SHEET II OF 131

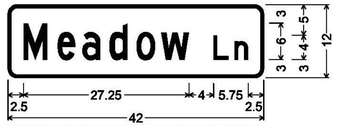


DOUBLE-SIDED STREET SIGN (STOWE);
1.500" Radius, 0.500" Border, White on Green;
[Meadow] C; [Ln] D;



DOUBLE-SIDED STREET SIGN (CAMBRIDGE);
1.500" Radius, 0.500" Border, White on Green;
[Brook Haven] C; [Dr PVT] D;

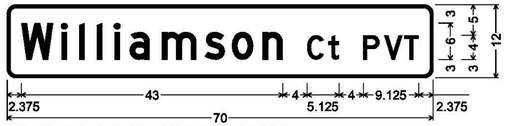

DOUBLE-SIDED STREET SIGN (CAMBRIDGE);
1.500" Radius, 0.500" Border, White on Green;
[Williamson] D; [Ct PVT] D;

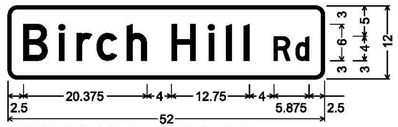


DOUBLE-SIDED STREET SIGN (STOWE);
1.500" Radius, 0.500" Border, White on Green;
[Birch Hill] D; [Rd] D;




DOUBLE-SIDED STREET SIGN (CAMBRIDGE);
1.500" Radius, 0.500" Border, White on Green;
[Notch Glen] D; [Dr PVT] D;




DOUBLE-SIDED STREET SIGN (CAMBRIDGE);
1.500" Radius, 0.500" Border, White on Green;
[Carlton] C 80% spacing; [Ave] D;

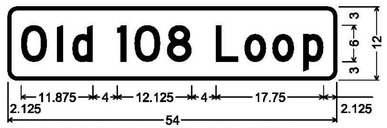


DOUBLE-SIDED STREET SIGN (CAMBRIDGE);
1.500" Radius, 0.500" Border, White on Green;
[Old 108 Loop] D;

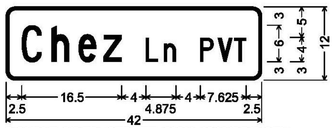


DOUBLE-SIDED STREET SIGN (CAMBRIDGE);
1.500" Radius, 0.500" Border, White on Green;
[Chez] C; [Ln PVT] C;

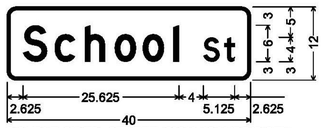


DOUBLE-SIDED STREET SIGN (CAMBRIDGE);
1.500" Radius, 0.500" Border, White on Green;
[School] D; [St] D;

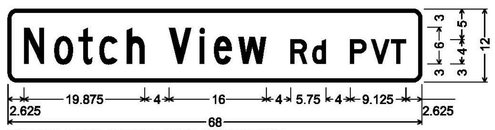


DOUBLE-SIDED STREET SIGN (CAMBRIDGE);
1.500" Radius, 0.500" Border, White on Green;
[Notch View] C; [Rd PVT] D;

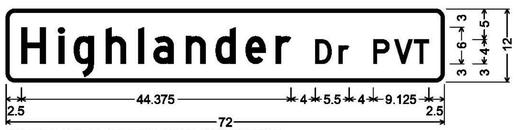

DOUBLE-SIDED STREET SIGN (CAMBRIDGE);
1.500" Radius, 0.500" Border, White on Green;
[Highlander] D; [Dr PVT] D;

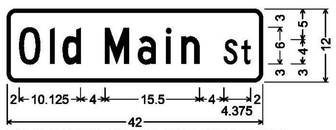


DOUBLE-SIDED STREET SIGN (CAMBRIDGE);
1.500" Radius, 0.500" Border, White on Green;
[Old Main] C 90% spacing; [St] C;

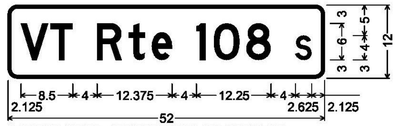

DOUBLE-SIDED STREET SIGN (CAMBRIDGE);
1.500" Radius, 0.500" Border, White on Green;
[VT Rte 108] D; [S] D;




DOUBLE-SIDED STREET SIGN (CAMBRIDGE);
1.500" Radius, 0.500" Border, White on Green;
[Forgan] D; [Ln PVT] D;

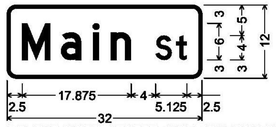


DOUBLE-SIDED STREET SIGN (CAMBRIDGE);
1.500" Radius, 0.500" Border, White on Green;
[Main] D; [St] D;



DOUBLE-SIDED STREET SIGN (CAMBRIDGE);
1.500" Radius, 0.500" Border, White on Green;
[Edwards] C 80% spacing; [Rd] D;

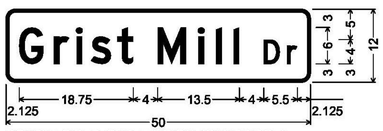

DOUBLE-SIDED STREET SIGN (CAMBRIDGE);
1.500" Radius, 0.500" Border, White on Green;
[Grist Mill] D; [Dr] D;

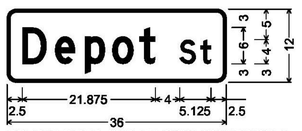

DOUBLE-SIDED STREET SIGN (CAMBRIDGE);
1.500" Radius, 0.500" Border, White on Green;
[Depot] D; [St] D;


ALL SIGNS ON THIS PAGE ARE SIGN CODE D3-1
(ALL SIGNS ARE DOUBLE - SIDED)

ALL DIMENSIONS SHOWN IN INCHES, EXCEPT WHERE NOTED.
NOT TO SCALE

PROJECT NAME: STOWE-BERKSHIRE
PROJECT NUMBER: STPG SIGN(49)

FILE NAME: zl3b620_SD03.dgn
PROJECT LEADER: D. BRYANT
DESIGNED BY: J. BLANCHARD
SIGN DETAILS 9

PLOT DATE: 6/25/2015
DRAWN BY: J. BLANCHARD
CHECKED BY: K. KERN
SHEET 12 OF 131

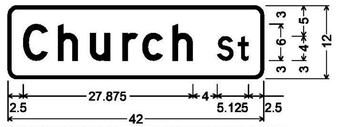


DOUBLE-SIDED STREET SIGN (CAMBRIDGE);
1.500" Radius, 0.500" Border, White on Green;
[Church] D; [St] D;




DOUBLE-SIDED STREET SIGN (CAMBRIDGE);
1.500" Radius, 0.500" Border, White on Green;
[Log Cabin] D; [Dr PVT] D;




DOUBLE-SIDED STREET SIGN (BAKERSFIELD);
1.500" Radius, 0.500" Border, White on Green;
[Pudvah Hill] D; [Rd] D;

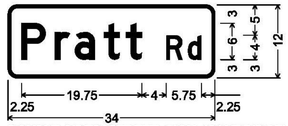


DOUBLE-SIDED STREET SIGN (CAMBRIDGE);
1.500" Radius, 0.500" Border, White on Green;
[Pratt] D; [Rd] D;

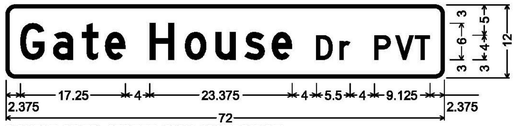


DOUBLE-SIDED STREET SIGN (CAMBRIDGE);
1.500" Radius, 0.500" Border, White on Green;
[Gate House] D; [Dr PVT] D;

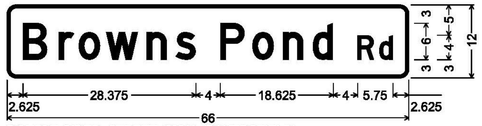


DOUBLE-SIDED STREET SIGN (BAKERSFIELD);
1.500" Radius, 0.500" Border, White on Green;
[Browns Pond] D; [Rd] D;

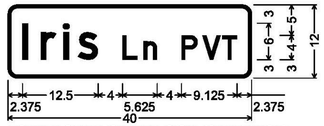


DOUBLE-SIDED STREET SIGN (CAMBRIDGE);
1.500" Radius, 0.500" Border, White on Green;
[Iris] D; [Ln PVT] D;

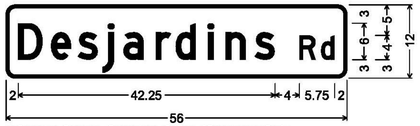


DOUBLE-SIDED STREET SIGN (CAMBRIDGE);
1.500" Radius, 0.500" Border, White on Green;
[Desjardins] D; [Rd] D;

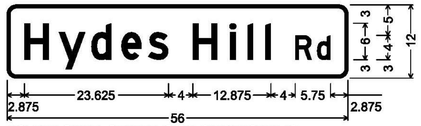


DOUBLE-SIDED STREET SIGN (BAKERSFIELD);
1.500" Radius, 0.500" Border, White on Green;
[Hydes Hill] D; [Rd] D;

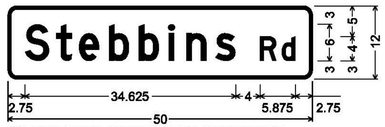


DOUBLE-SIDED STREET SIGN (CAMBRIDGE);
1.500" Radius, 0.500" Border, White on Green;
[Stebbins] D; [Rd] D;

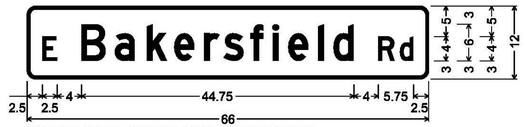


DOUBLE-SIDED STREET SIGN (BAKERSFIELD);
1.500" Radius, 0.500" Border, White on Green;
[E] D; [Bakersfield] D; [Rd] D;

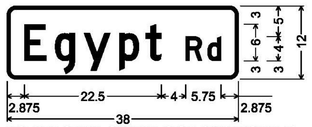

DOUBLE-SIDED STREET SIGN (BAKERSFIELD);
1.500" Radius, 0.500" Border, White on Green;
[Egypt] D; [Rd] D;

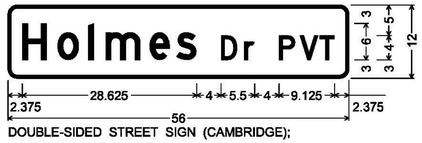


DOUBLE-SIDED STREET SIGN (CAMBRIDGE);
1.500" Radius, 0.500" Border, White on Green;
[Holmes] D; [Dr PVT] D;

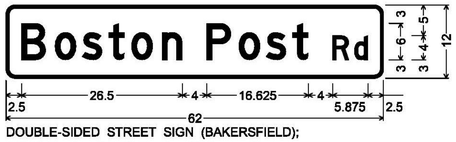


DOUBLE-SIDED STREET SIGN (BAKERSFIELD);
1.500" Radius, 0.500" Border, White on Green;
[Boston Post] D; [Rd] D;



DOUBLE-SIDED STREET SIGN (BAKERSFIELD);
1.500" Radius, 0.500" Border, White on Green;
[Avenue] C; [Rd] C;

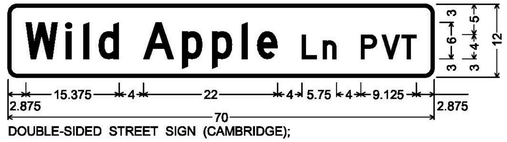

DOUBLE-SIDED STREET SIGN (CAMBRIDGE);
1.500" Radius, 0.500" Border, White on Green;
[Wild Apple] D; [Ln PVT] D;

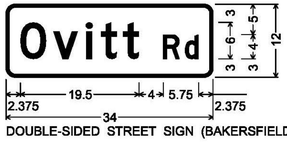

DOUBLE-SIDED STREET SIGN (BAKERSFIELD);
1.500" Radius, 0.500" Border, White on Green;
[Ovitt] D; [Rd] D;



DOUBLE-SIDED STREET SIGN (BAKERSFIELD);
1.500" Radius, 0.500" Border, White on Green;
[Academy] D; [Ln] D;


ALL SIGNS ON THIS PAGE ARE SIGN CODE D3-1
(ALL SIGNS ARE DOUBLE - SIDED)

ALL DIMENSIONS SHOWN IN INCHES, EXCEPT WHERE NOTED.
NOT TO SCALE


PROJECT NAME: STOWE-BERKSHIRE
PROJECT NUMBER: STPG SIGN(49)

FILE NAME: z13b620_SD03.dgn
PROJECT LEADER: D. BRYANT
DESIGNED BY: J. BLANCHARD
SIGN DETAILS 10


PLOT DATE: 6/25/2015
DRAWN BY: J. BLANCHARD
CHECKED BY: K. KERN
SHEET 13 OF 131

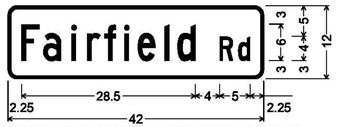


DOUBLE-SIDED STREET SIGN (BAKERSFIELD);
1.500" Radius, 0.500" Border, White on Green;
[Fairfield] C 90% spacing; [Rd] C;

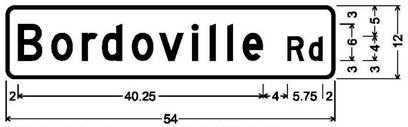


DOUBLE-SIDED STREET SIGN (ENOSBURGH);
1.500" Radius, 0.500" Border, White on Green;
[Bordoville] D; [Rd] D;

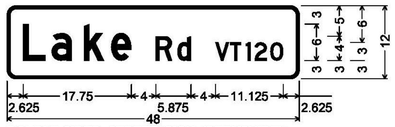

DOUBLE-SIDED STREET SIGN (BERKSHIRE);
1.500" Radius, 0.500" Border, White on Green;
[Lake] D; [Rd] D; [VT120] D;

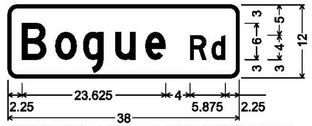


DOUBLE-SIDED STREET SIGN (ENOSBURGH);
1.500" Radius, 0.500" Border, White on Green;
[Bogue] D; [Rd] D;

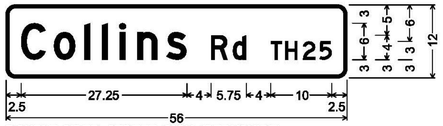

DOUBLE-SIDED STREET SIGN (BERKSHIRE);
1.500" Radius, 0.500" Border, White on Green;
[Collins] D; [Rd] D; [TH25] D;




DOUBLE-SIDED STREET SIGN (BERKSHIRE);
1.500" Radius, 0.500" Border, White on Green;
[Stanley Hill] D; [Rd] D; [TH1] D;

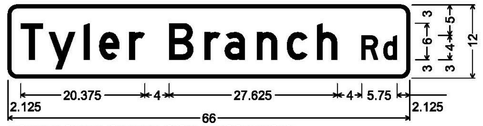


DOUBLE-SIDED STREET SIGN (ENOSBURGH);
1.500" Radius, 0.500" Border, White on Green;
[Tyler Branch] D; [Rd] D;




DOUBLE-SIDED STREET SIGN (BERKSHIRE);
1.500" Radius, 0.500" Border, White on Green;
[Berkshire Center] B 80% spacing; [Rd] B; [TH3] B;

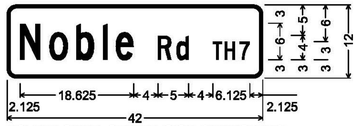


DOUBLE-SIDED STREET SIGN (BERKSHIRE);
1.500" Radius, 0.500" Border, White on Green;
[Noble] C 90% spacing; [Rd] C;
[TH7] C;

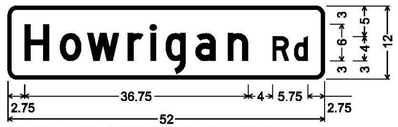

DOUBLE-SIDED STREET SIGN (ENOSBURGH);
1.500" Radius, 0.500" Border, White on Green;
[Howrigan] D; [Rd] D;

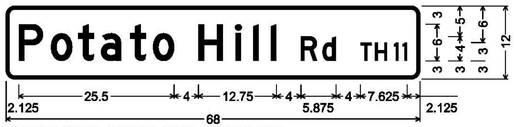


DOUBLE-SIDED STREET SIGN (BERKSHIRE);
1.500" Radius, 0.500" Border, White on Green;
[Potato Hill] D; [Rd] D; [TH11] D;

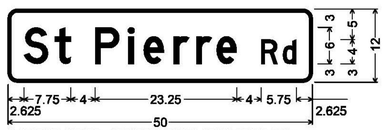


DOUBLE-SIDED STREET SIGN (ENOSBURGH);
1.500" Radius, 0.500" Border, White on Green;
[St Pierre] D; [Rd] D;



DOUBLE-SIDED STREET SIGN (BERKSHIRE);
1.500" Radius, 0.500" Border, White on Green;
[W] C; [Berkshire] C; [Rd] C; [VT108] C;

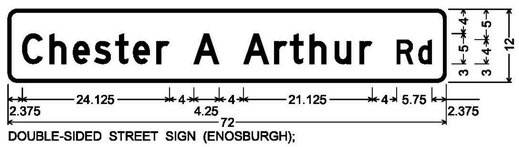

DOUBLE-SIDED STREET SIGN (ENOSBURGH);
1.500" Radius, 0.500" Border, White on Green;
[Chester A Arthur] D 80% spacing; [Rd] D;

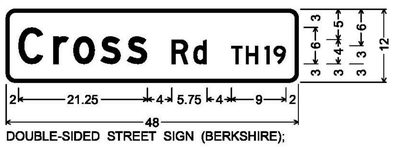

DOUBLE-SIDED STREET SIGN (BERKSHIRE);
1.500" Radius, 0.500" Border, White on Green;
[Cross] D; [Rd] D; [TH19] D;

ALL SIGNS ON THIS PAGE ARE SIGN CODE D3-1
(ALL SIGNS ARE DOUBLE - SIDED)

ALL DIMENSIONS SHOWN IN INCHES, EXCEPT WHERE NOTED.
NOT TO SCALE

PROJECT NAME: STOWE-BERKSHIRE
PROJECT NUMBER: STPG SIGN(49)

FILE NAME: z13b620_SD03.dgn
PROJECT LEADER: D. BRYANT
DESIGNED BY: J. BLANCHARD
SIGN DETAILS II

PLOT DATE: 6/25/2015
DRAWN BY: J. BLANCHARD
CHECKED BY: K. KERN
SHEET 14 OF 131

DIRECTION	MILEPOINT	LOCATION CODE (SHEET 2)	SIGN CODE	WIDTH (IN)	HEIGHT (IN)	SHEETING REMARKS	SIGN LEGEND	NEW SIGNS "A"	NEW SIGNS "B"	EXISTING SIGNS RETAIN	EXISTING SIGNS SALVAGE FROM	EXISTING SIGNS SALVAGE TO	EXISTING SIGNS REMOVE	EXIST POST RETAIN	EXIST POST REMOVE	NUMBER OF NEW POSTS	SQUARE STEEL (IN) 1.75 (LB/FT) 1.88	SQUARE STEEL (IN) 2.00 (LB/FT) 2.42	SQUARE STEEL (IN) 2.50 (LB/FT) 3.35	TUBULAR STEEL Ø (IN) FOUNDATION	TUBULAR STEEL Ø (IN) 3.00 (LB/FT) 7.60	TUBULAR STEEL Ø (IN) 3.50 (LB/FT) 9.00	TUBULAR STEEL Ø (IN) 4.00 (LB/FT) 10.80	TUBULAR STEEL Ø (IN) 5.00 (LB/FT) 14.60	SIGN FRAME REQUIRED	REMARKS	SIGN DETAIL LOCATION SHSM	SIGN DETAIL LOCATION PROJECT SHEET #	SIGN DETAIL LOCATION STANDARD SHEET #
STOWE VT-108 NB							FY-FLUORESCENT YELLOW FYG-FLUORESCENT YELLOW GREEN																				"SHSM"-STANDARD HIGHWAY SIGNS AND MARKINGS			
NB	0.000		BEGINNING OF CLASS 1 SECTION OF ROADWAY (NORTHBOUND) NOTE: STICKERS ON BACK OF SIGNS IN CLASS 1 SECTION OF STOWE SHALL HAVE "STOWE, DATE (MM/YY), TH-2"																									
NB	0.016	A	M3-1	24	12	GRN/WHT	✳ NORTH VERMONT 108 6/17	2.00								1		14.0 X									INSTALL AT SOUTHERN MOST EDGE OF GARDEN, ABUTTING ROCK WALL	X		
		A	M1-5	30	24	GRN/WHT	✳ 6/17	5.00																					E-136B
NB	0.032	A	R2-1	24	30		SPEED LIMIT 25 8/1						1		X														
		A	R2-1	24	30		✳ SPEED LIMIT 25 8/1	5.00								1		15.0 X										X		
NB	0.050	A	W11-2	30	30	FYG	PEDESTRIAN SYMBOL 6/17						1		X														
		A	W16-7P	21	15	FYG	DIAGONAL ARROW WARNING 6/17						1																
		A	W11-2	30	30	FYG	✳ TRIM 7/8 TRIM 6/17	6.25								1		16.5 X										X		
		A	W16-7PL	24	12	FYG	✳ 6/17	2.00																				X		
NB	0.124	A	W11-2	30	30	FYG	PEDESTRIAN SYMBOL TRIM 6/17						1		X														
		A	W16-7P	21	15	FYG	DIAGONAL ARROW WARNING 6/17						1																
		A	W11-2	30	30	FYG	6/17	6.25								1		15.25 X										X		
		A	W16-7PL	24	12	FYG	6/17	2.00																				X		
NB	0.157	A	R2-1	24	30		SPEED LIMIT 25 6/17						1		X														
		A	R2-1	24	30		SPEED LIMIT 25 6/17	5.00								1		14.0 X										X		
SIGN SUMMARY SHEET							SHEET TOTALS	33.50 SF	0.00 SF	0 EA	0 EA	0 EA	6 EA	0 EA	0 EA	5 EA		74.75 ~~75.0~~ FT		0 EA	0.0 LB	0.0 LB	0.0 LB	0.0 LB					
VERMONT AGENCY OF TRANSPORTATION							TOWN DIRECTIONAL TOTALS	418.6	0.0	36	15	6	85	0	0	79		1185.0		0	0.0								

✳ THESE 5 SIGNS MOVED 50' AHEAD AT REQUEST OF TOWN OF STOWE

PROJECT NAME: STOWE - BERKSHIRE
PROJECT NUMBER: STPG SIGN (49)
FILE NAME: 01 STOWE VT-108 NB TSS.xls
PROJECT MANAGER: D. BRYANT
DESIGNED BY: J. BLANCHARD
STOWE NB SHEET 1
PLOT DATE: 6/24/2015
DRAWN BY: J. BLANCHARD
CHECKED K. KERN
SHEET 15 OF 131

DIRECTION	MILEPOINT	LOCATION CODE (SHEET 2)	SIGN CODE	WIDTH (IN)	HEIGHT (IN)	SHEETING REMARKS	SIGN LEGEND	NEW SIGNS "A"	NEW SIGNS "B"	EXISTING SIGNS RETAIN	EXISTING SIGNS SALVAGE FROM	EXISTING SIGNS SALVAGE TO	EXISTING SIGNS REMOVE	EXIST POST RETAIN	EXIST POST REMOVE	NUMBER OF NEW POSTS	SQUARE STEEL (IN) 1.75 (LB/FT) 1.88	SQUARE STEEL (IN) 2.00 (LB/FT) 2.42	SQUARE STEEL (IN) 2.50 (LB/FT) 3.35	TUBULAR STEEL Ø (IN) FOUNDATION	TUBULAR STEEL Ø (IN) 3.00 (LB/FT) 7.60	TUBULAR STEEL Ø (IN) 3.50 (LB/FT) 9.00	TUBULAR STEEL Ø (IN) 4.00 (LB/FT) 10.80	TUBULAR STEEL Ø (IN) 5.00 (LB/FT) 14.60	SIGN FRAME REQUIRED	REMARKS	SIGN DETAIL LOCATION SHSM	SIGN DETAIL LOCATION PROJECT SHEET #	SIGN DETAIL LOCATION STANDARD SHEET #
STOWE VT-108 NB							FY-FLUORESCENT YELLOW FYG-FLUORESCENT YELLOW GREEN																				"SHSM"-STANDARD HIGHWAY SIGNS AND MARKINGS			
NB	0.369	D	R1-1	30	30		STOP 6/17						1		X														
		A/B	D3-1	30	8		 6/20	1.67								1		16.25 X								FORREST WAY (TH-100) / DUMP RD; MOUNT TO STOP SIGN WITH BRACKET		11	
		D	R1-1	30	30		 6/17	6.25																		FORREST WAY (TH-100) / DUMP RD	X		
NB	0.370	A/B	D3-1	UNK.	UNK.		DUMP RD 6/20						1	X												FORREST WAY (TH-100) / DUMP RD; REMOVE STREET NAME SIGN, RETAIN POST AND MIRROR			
NB	0.370	N/A	UNK.	UNK.	UNK.		UNKNOWN SIGN 6/20				1		1		X											FORREST WAY (TH-100) / DUMP RD; SALVAGE UNKNOWN SIGN AND RETURN TO TOWN			
		C	VD-700	6	10		MILE MARKER 6/20						1																
NB	0.381	A	W11-2	30	30	FYG	PEDESTRIAN SYMBOL 6/17						1		X														
		A	W16-7P	21	15	FYG	DIAGNOAL ARROW WARNING 6/17						1																
		A	W11-2	30	30	FYG	 6/17	6.25								1		15.25 X									X		
		A	W16-7PL	21	12 ~~15~~	FYG	 6/17	2.19																			X		
NB	0.486	A	VR-039	24	18		STATE HIGHWAY BEGINS 6/17						1		X														
		A	R2-1	24	30		SPEED LIMIT 30 6/17						1																
		B	VR-038	24	18		STATE HIGHWAY ENDS 6/17						1																
		A	VR-039	24	18		 6/17	3.00								1		15.00 X										9	
		A	R2-1	24	30		 6/17	5.00																			X		
SIGN SUMMARY SHEET							SHEET TOTALS	~~24.36~~ 24.35 SF	0.00 SF	0 EA	1 EA	0 EA	9 EA	0 EA	0 EA	3 EA		~~46.50~~ 45.0 FT		0 EA	0.0 LB	0.0 LB	0.0 LB	0.0 LB					
VERMONT AGENCY OF TRANSPORTATION							TOWN DIRECTIONAL TOTALS	418.6	0.0	36	15	6	85	0	0	79		1185.0		0	0.0								

PROJECT NAME: **STOWE - BERKSHIRE**
PROJECT NUMBER: **STPG SIGN (49)**
FILE NAME: **01 STOWE VT-108 NB TSS.xls** PLOT DATE: **6/24/2015**
PROJECT MANAGER: **D. BRYANT** DRAWN BY: **J. BLANCHARD**
DESIGNED BY: **J. BLANCHARD** CHECKED **K. KERN**
STOWE NB SHEET 2 SHEET **16** OF **131**

DIRECTION	MILEPOINT	LOCATION CODE (SHEET 2)	SIGN CODE	WIDTH (IN)	HEIGHT (IN)	SHEETING REMARKS	SIGN LEGEND	NEW SIGNS "A"	NEW SIGNS "B"	EXISTING SIGNS RETAIN	EXISTING SIGNS SALVAGE FROM	EXISTING SIGNS SALVAGE TO	EXISTING SIGNS REMOVE	EXIST POST RETAIN	EXIST POST REMOVE	NUMBER OF NEW POSTS	SQUARE STEEL (IN) 1.75 (LB/FT) 1.88	SQUARE STEEL (IN) 2.00 (LB/FT) 2.42	SQUARE STEEL (IN) 2.50 (LB/FT) 3.35	TUBULAR STEEL Ø (IN) FOUNDATION	TUBULAR STEEL Ø (IN) 3.00 (LB/FT) 7.60	TUBULAR STEEL Ø (IN) 3.50 (LB/FT) 9.00	TUBULAR STEEL Ø (IN) 4.00 (LB/FT) 10.80	TUBULAR STEEL Ø (IN) 5.00 (LB/FT) 14.60	SIGN FRAME REQUIRED	REMARKS	SIGN DETAIL LOCATION SHSM	SIGN DETAIL LOCATION PROJECT SHEET #	SIGN DETAIL LOCATION STANDARD SHEET #
STOWE VT-108 NB							FY-FLUORESCENT YELLOW FYG-FLUORESCENT YELLOW GREEN																				"SHSM"-STANDARD HIGHWAY SIGNS AND MARKINGS			
NB	0.507		END OF CLASS 1 AND BEGINNING OF STATE SECTION OF ROADWAY (NORTHBOUND).																										
NB	0.543	A	W16-18P	UNK.	UNK.		NOTICE TRIM 6/17			1				X															
		A	VR-493H	48	60		VT 108 NOT A THRU ROUTE FOR TRACTOR TRAILERS 6/17			1																			
NB	0.552	A	VD-062B	72	16		BUSINESS SIGN 6/17			1				X															
		A	VD-062B	72	16		BUSINESS SIGN 6/17			1																			
NB	0.593	C	VR-017	24	30		LLL 24,000 LBS SL 30 RETAINED 6/17						1		X														
		C	VR-017	24	30		 6/17	5.00			1	1	1			1		16.0 X								WEEKS HILL RD (TH-6)		9	
NB	0.602	D	R1-1	30	30		STOP 6/17						1		X														
		C	VD-700	6	10		MILE MARKER 6/17				1	1	1														SLAVAGE AND MOUNT ON NEW POST BELOW STOP SIGN			
		D	R1-1	30	30		 6/17	6.25								1		13.5 X								WEEKS HILL RD (TH-6); REQUIRES VEGETATION CLEARING; INSTALL NEW SIGN AT LEAST 10 FT FROM UTILITY POLE	X		
NB	0.602	A/B	D3-1	UNK.	UNK.		WEEKS HILL RD 6/17			1				X															
NB	0.651	A	R2-1	24	30		SPEED LIMIT 30 6/17						1		X														
		A	R2-1	24	30		 6/17	5.00								1		14.0 X									X		
NB	0.882	A	R2-1	24	30		SPEED LIMIT 30 6/17						1		X														
NB	1.067	A	W1-5L	30	30		LEFT WINDING ROAD 6/17						1		X														
SIGN SUMMARY SHEET							SHEET TOTALS	16.25	0.00	5	2 ~~1~~	2 ~~1~~	7 ~~6~~	0	0	3		~~45.0~~ 43.5		0	0.0	0.0	0.0	0.0					
								SF	SF	EA	EA	EA	EA	EA	EA	EA		FT		EA	LB	LB	LB	LB					
VERMONT AGENCY OF TRANSPORTATION							TOWN DIRECTIONAL TOTALS	418.6	0.0	36	15	6	85	0	0	79		1185.0		0		0.0							

PROJECT NAME: **STOWE - BERKSHIRE**
PROJECT NUMBER: **STPG SIGN (49)**
FILE NAME: **01 STOWE VT-108 NB TSS.xls** PLOT DATE: **6/24/2015**
PROJECT MANAGER: **D. BRYANT** DRAWN BY: **J. BLANCHARD**
DESIGNED BY: **J. BLANCHARD** CHECKED **K. KERN**
STOWE NB SHEET 3 SHEET **17** OF **131**

DIRECTION	MILEPOINT	LOCATION CODE (SHEET 2)	SIGN CODE	WIDTH (IN)	HEIGHT (IN)	SHEETING REMARKS	SIGN LEGEND	NEW SIGNS "A"	NEW SIGNS "B"	EXISTING SIGNS RETAIN	EXISTING SIGNS SALVAGE FROM	EXISTING SIGNS SALVAGE TO	EXISTING SIGNS REMOVE	EXIST POST RETAIN	EXIST POST REMOVE	NUMBER OF NEW POSTS	SQUARE STEEL (IN) 1.75 (LB/FT) 1.88	SQUARE STEEL (IN) 2.00 (LB/FT) 2.42	SQUARE STEEL (IN) 2.50 (LB/FT) 3.35	TUBULAR STEEL Ø (IN) FOUNDATION	TUBULAR STEEL Ø (IN) 3.00 (LB/FT) 7.60	TUBULAR STEEL Ø (IN) 3.50 (LB/FT) 9.00	TUBULAR STEEL Ø (IN) 4.00 (LB/FT) 10.80	TUBULAR STEEL Ø (IN) 5.00 (LB/FT) 14.60	SIGN FRAME REQUIRED	REMARKS	SIGN DETAIL LOCATION SHSM	SIGN DETAIL LOCATION PROJECT SHEET #	SIGN DETAIL LOCATION STANDARD SHEET #
STOWE VT-108 NB							FY-FLUORESCENT YELLOW FYG-FLUORESCENT YELLOW GREEN 6/17																				"SHSM"-STANDARD HIGHWAY SIGNS AND MARKINGS			
NB	1.108	A	R2-1	24	30		SPEED LIMIT 30 6/17						1		X														
		A	R2-1	24	30		 6/17	5.00								1		13.0 X									X		
NB	1.178	A	W1-6	48	24		<=== LEFT LARGE ARROW 6/17						1		X														
		A	W1-6L	48	24		 6/17	8.00								2		27.25 X									X		
NB	1.178	B	W1-6	48	24		RIGHT ===> LARGE ARROW 6/17						1		X														
		B	W1-6R	48	24		 6/17	8.00								2		26.0 X									X		
NB	1.188	A/B	D3-1	UNK.	UNK.		TOWN FARM LN 6/17						1		X														
		A/B	D3-1	70	12		 6/17	5.83								2		21.75 X									TOWN FARM LN (PVT)		11	
NB	1.198	A	W1-6	48	24		<=== LEFT LARGE ARROW 6/17						1		X														
		A	VD-700	6	10		MILE MARKER 6/17				1	1	1														SALVAGE AND MOUNT ON NEW POST BELOW ARROW			
		A	W1-6L	48	24		 6/17	8.00								2		26.25 X										X		
NB	1.200	B	W1-6R	48	24		 6/17	8.00								2		27.5 X									INSTALL 10 FT NORTH OF EXISTING LARGE LEFT ARROW AT M.P. 1.198	X		
NB	1.267	A	W1-8L	18	24		 TRIM 6/17	3.00								1		12.75 X									INSTALL 200 FT NORTH OF FIRE HYDRANT AT M.P. 1.229	X		
		B	W1-8R	18	24		 6/17	3.00																				X		
NB	1.272	B	W1-6	48	24		RIGHT ===> LARGE ARROW 6/17						1		X														
SIGN SUMMARY SHEET							SHEET TOTALS	48.83	0.00	0	1	1	7	0	0	12		~~180.0~~ 154.5 FT		0	0.0	0.0	0.0	0.0					
								SF	SF	EA	EA	EA	EA	EA	EA	EA				EA	LB	LB	LB	LB					
VERMONT AGENCY OF TRANSPORTATION							TOWN DIRECTIONAL TOTALS	418.6	0.0	36	15	6	85	0	0	79		1185.0		0	0.0								

PROJECT NAME: **STOWE - BERKSHIRE**
PROJECT NUMBER: **STPG SIGN (49)**
FILE NAME: **01 STOWE VT-108 NB TSS.xls** PLOT DATE: **6/24/2015**
PROJECT MANAGER: **D. BRYANT** DRAWN BY: **J. BLANCHARD**
DESIGNED BY: **J. BLANCHARD** CHECKED **K. KERN**
STOWE NB SHEET 4 SHEET **18** OF **131**

DIRECTION	MILEPOINT	LOCATION CODE (SHEET 2)	SIGN CODE	WIDTH (IN)	HEIGHT (IN)	SHEETING REMARKS	SIGN LEGEND	NEW SIGNS "A"	NEW SIGNS "B"	EXISTING SIGNS RETAIN	EXISTING SIGNS SALVAGE FROM	EXISTING SIGNS SALVAGE TO	EXISTING SIGNS REMOVE	EXIST POST RETAIN	EXIST POST REMOVE	NUMBER OF NEW POSTS	SQUARE STEEL (IN) 1.75 (LB/FT) 1.88	SQUARE STEEL (IN) 2.00 (LB/FT) 2.42	SQUARE STEEL (IN) 2.50 (LB/FT) 3.35	TUBULAR STEEL Ø (IN) FOUNDATION	TUBULAR STEEL Ø (IN) 3.00 (LB/FT) 7.60	TUBULAR STEEL Ø (IN) 3.50 (LB/FT) 9.00	TUBULAR STEEL Ø (IN) 4.00 (LB/FT) 10.80	TUBULAR STEEL Ø (IN) 5.00 (LB/FT) 14.60	SIGN FRAME REQUIRED	REMARKS	SIGN DETAIL LOCATION SHSM	SIGN DETAIL LOCATION PROJECT SHEET #	SIGN DETAIL LOCATION STANDARD SHEET #
STOWE VT-108 NB							FY-FLUORESCENT YELLOW FYG-FLUORESCENT YELLOW GREEN																				"SHSM"-STANDARD HIGHWAY SIGNS AND MARKINGS			
NB	1.282	A	W1-8L	18	24		 TRIM 6/17	3.00								1		12.25 X								INSTALL 53 FT NORTH OF EXISTING LARGE RIGHT ARROW AT M.P. 1.272	X		
		B	W1-8R	18	24		 6/17	3.00																			X		
NB	1.291	B	W1-6	48	24		RIGHT ===> LARGE ARROW 6/20						~~1~~ 2		X														
NB	1.297	A	W1-6L	18	24		 6/20	3.00								1		13.0 X								INSTALL 32 FT NORTH OF EXISTING LARGE RIGHT ARROW AT M.P. 1.297	X		
		B	W1-6R	18	24		 6/20	3.00																			X		
NB	1.362	A	W11-1	30	30		BICYCLE SYMBOL 6/20						1		X														
		A	W16-1P	18	24		SHARE THE ROAD 6/20						1																
		A	W11-1	30	30		 6/20	6.25								1			17.25 X							X		
		A	W16-1P	18	24		 6/20	3.00																		X		
NB	1.439	A	W11-2	30	30	FYG	 8/24	6.25								1			17.0 X							INSTALL 200 FT NORTH OF UTILITY POLE #83 AT M.P. 1.401	X		
		A	W16-4P	30	24	FYG	 8/24	5.00																		X		
NB	1.472	A	R2-1	24	30		SPEED LIMIT 30 8/24						1		X														
		A	R2-1	24	30		 8/24	5.00								1		14.0 X									X		
NB	1.572	A	VD-062AS	72	16		BUSINESS SIGN			1				X															
NB	1.609	A	W1-7	24	18		<===> DOUBLE ARROW			1				X															
SIGN SUMMARY SHEET							SHEET TOTALS	37.50	0.00	2	0	0	~~4~~ 5	0	0	5		~~75.0~~ 73.5		0	0.0	0.0	0.0	0.0					
								SF	SF	EA	EA	EA	EA	EA	EA	EA		FT		EA	LB	LB	LB	LB					
VERMONT AGENCY OF TRANSPORTATION							TOWN DIRECTIONAL TOTALS	418.6	0.0	36	15	6	85	0	0	79		1185.0		0	0.0								

PROJECT NAME: **STOWE - BERKSHIRE**
PROJECT NUMBER: **STPG SIGN (49)**
FILE NAME: **01 STOWE VT-108 NB TSS.xls** PLOT DATE: **6/24/2015**
PROJECT MANAGER: **D. BRYANT** DRAWN BY: **J. BLANCHARD**
DESIGNED BY: **J. BLANCHARD** CHECKED **K. KERN**
STOWE NB SHEET 5 SHEET **19** OF **131**

DIRECTION	MILEPOINT	LOCATION CODE (SHEET 2)	SIGN CODE	WIDTH (IN)	HEIGHT (IN)	SHEETING REMARKS	SIGN LEGEND	NEW SIGNS "A"	NEW SIGNS "B"	EXISTING SIGNS RETAIN	EXISTING SIGNS SALVAGE FROM	EXISTING SIGNS SALVAGE TO	EXISTING SIGNS REMOVE	EXIST POST RETAIN	EXIST POST REMOVE	NUMBER OF NEW POSTS	SQUARE STEEL (IN) 1.75 (LB/FT) 1.88	SQUARE STEEL (IN) 2.00 (LB/FT) 2.42	SQUARE STEEL (IN) 2.50 (LB/FT) 3.35	TUBULAR STEEL Ø (IN) FOUNDATION	TUBULAR STEEL Ø (IN) 3.00 (LB/FT) 7.60	TUBULAR STEEL Ø (IN) 3.50 (LB/FT) 9.00	TUBULAR STEEL Ø (IN) 4.00 (LB/FT) 10.80	TUBULAR STEEL Ø (IN) 5.00 (LB/FT) 14.60	SIGN FRAME REQUIRED	REMARKS	SIGN DETAIL LOCATION SHSM	SIGN DETAIL LOCATION PROJECT SHEET #	SIGN DETAIL LOCATION STANDARD SHEET #
STOWE VT-108 NB							FY-FLUORESCENT YELLOW FYG-FLUORESCENT YELLOW GREEN																				"SHSM"-STANDARD HIGHWAY SIGNS AND MARKINGS			
		A	VW-622A	36	36		RECREATION TRAIL 6/20			1																			
		A	VW11-1S	24	18		BICYCLE SYMBOL 6/20			1																			
NB	1.653	A	W11-2	30	30	FYG	PEDESTRIAN SYMBOL 6/20			1				X															
		A	W16-9P	24	10	FYG	AHEAD WARNING 6/20			1																			
NB	1.699	A	W11-2	30	30	FYG	PEDESTRIAN SYMBOL 6/20			1				X															
		A	W16-7P	24	12	FYG	DIAGONAL ARROW WARNING 6/20			1																			
NB	1.703	C	VR-017	24	30		LLL 24,000 LBS 6/20						1		X														
		C	VR-017	24	30		 6/20	5.00								1		13.5 X									CAPE COD RD (TH-31)		9	
NB	1.711	D	R1-1	30	30		STOP 6/20						~~1~~ 3		X														
		C	VD-700	6	10		MILE MARKER 6/20				~~1~~ 2	~~1~~ 2	~~1~~ 2														SALVAGE AND MOUNT ON NEW POST BELOW STOP SIGN			
		D	R1-1	30	30		 6/20	6.25								1		13.75 X									CAPE COD RD (TH-31)	X		
NB	1.711	A/B	D3-1	UNK.	UNK.		CAPE COD RD 6/20						1		X														
		A/B	D3-1	50	12		 6/20	4.17								2		22.0 X									CAPE COD RD (TH-31); FIELD LOCATE FOR VISIBILITY FROM VT 108		11	
NB	1.730	A	M3-1	24	12	GRN/WHT	 6/20	2.00					2			1		14.25 X									INSTALL 100 FT NORTH OF CAPE COD RD SIGN	X		
		A	M1-5	30	24	GRN/WHT	 6/20	5.00																					E-136B
SIGN SUMMARY SHEET							SHEET TOTALS	22.42	0.00	6	~~2~~ 2	~~2~~ 1	~~9~~ 4	0	0	5		~~63.5~~ 75.0		0	0.0	0.0	0.0	0.0					
								SF	SF	EA	EA	EA	EA	EA	EA	EA		FT		EA	LB	LB	LB	LB					
VERMONT AGENCY OF TRANSPORTATION							TOWN DIRECTIONAL TOTALS	418.6	0.0	36	15	6	85	0	0	79		1185.0		0	0.0								

PROJECT NAME: **STOWE - BERKSHIRE**
PROJECT NUMBER: **STPG SIGN (49)**

FILE NAME: **01 STOWE VT-108 NB TSS.xls** PLOT DATE: **6/24/2015**
PROJECT MANAGER: **D. BRYANT** DRAWN BY: **J. BLANCHARD**
DESIGNED BY: **J. BLANCHARD** CHECKED **K. KERN**
STOWE NB SHEET 6 SHEET **20** OF **131**

DIRECTION	MILEPOINT	LOCATION CODE (SHEET 2)	SIGN CODE	WIDTH (IN)	HEIGHT (IN)	SHEETING REMARKS	SIGN LEGEND	NEW SIGNS "A"	NEW SIGNS "B"	EXISTING SIGNS RETAIN	EXISTING SIGNS SALVAGE FROM	EXISTING SIGNS SALVAGE TO	EXISTING SIGNS REMOVE	EXIST POST RETAIN	EXIST POST REMOVE	NUMBER OF NEW POSTS	SQUARE STEEL (IN) 1.75 (LB/FT) 1.88	SQUARE STEEL (IN) 2.00 (LB/FT) 2.42	SQUARE STEEL (IN) 2.50 (LB/FT) 3.35	TUBULAR STEEL Ø (IN) FOUNDATION	TUBULAR STEEL Ø (IN) 3.00 (LB/FT) 7.60	TUBULAR STEEL Ø (IN) 3.50 (LB/FT) 9.00	TUBULAR STEEL Ø (IN) 4.00 (LB/FT) 10.80	TUBULAR STEEL Ø (IN) 5.00 (LB/FT) 14.60	SIGN FRAME REQUIRED	REMARKS	SIGN DETAIL LOCATION SHSM	SIGN DETAIL LOCATION PROJECT SHEET #	SIGN DETAIL LOCATION STANDARD SHEET #
STOWE VT-108 NB							FY-FLUORESCENT YELLOW FYG-FLUORESCENT YELLOW GREEN																				"SHSM"-STANDARD HIGHWAY SIGNS AND MARKINGS			
NB	1.895	A	VR-615	30	36		LEFT TURN YIELD TO THRU TRAFFIC CLOSER TO INTERSECTION						1		X														
		A	UNK.	UNK.	UNK.		BUS STOP 6/23				1		1														SALVAGE AND RETURN TO TOWN			
		A	UNK.	UNK.	UNK.		UNKNOWN SIGN 6/23				1		1														SALVAGE AND RETURN TO TOWN			
NB	1.925	A	VD-062B	72	16		BUSINESS SIGN 6/20			1				X															
NB	1.976	A	VR-615	30	36		 6/20	7.50								1		14.25 X								INSTALL 270 FT NORTH OF BUSINESS SIGN, IN FRONT OF UTILITY POLE #4/72/5-64		9	
NB	2.065	A	VD-062AS	72	16		BUSINESS SIGN 6/20			1				X															
		A	VD-062B	72	16		BUSINESS SIGN 6/20			1																			
		A	VD-062B	72	16		BUSINESS SIGN 6/20			1																			
NB	2.074	C	VR-017	24	30		LLL 24,000 LBS 6/20						1		X														
NB	2.074	C	VR-017	24	30		 6/20	5.00								1		13.50 X								COTTAGE CLUB RD (TH29)		9	
NB	2.082	D	R1-1	30	30		STOP 6/20						1		X														
		C	VD-700	6	10		MILE MARKER 6/20				1	1	1														SALVAGE AND MOUNT ON NEW POST BELOW STOP SIGN			
		D	R1-1	30	30		 6/20	6.25								1		13.75 X								COTTAGE CLUB RD (TH-29); REQUIRES VEGETATION CLEARING	X		
NB	2.082	A/B	D3-1	UNK.	UNK.		COTTAGE CLUB RD 6/20						1		X														
		A/B	D3-1	66	12		 6/20	5.50								2		23.00 X								COTTAGE CLUB RD (TH-29); FIELD LOCATE FOR VISIBILITY FROM VT 108		11	
SIGN SUMMARY SHEET							SHEET TOTALS	24.25	0.00	4	3	1	7	0	0	5		~~64.50~~ ~~75.0~~		0	0.0	0.0	0.0	0.0					
								SF	SF	EA	EA	EA	EA	EA	EA	EA		FT		EA	LB	LB	LB	LB					
VERMONT AGENCY OF TRANSPORTATION							TOWN DIRECTIONAL TOTALS	418.6	0.0	36	15	6	85	0	0	79		1185.0		0	0.0								

PROJECT NAME: **STOWE - BERKSHIRE**
PROJECT NUMBER: **STPG SIGN (49)**
FILE NAME: **01 STOWE VT-108 NB TSS.xls** PLOT DATE: **6/24/2015**
PROJECT MANAGER: **D. BRYANT** DRAWN BY: **J. BLANCHARD**
DESIGNED BY: **J. BLANCHARD** CHECKED **K. KERN**
STOWE NB SHEET 7 SHEET **21** OF **131**

DIRECTION	MILEPOINT	LOCATION CODE (SHEET 2)	SIGN CODE	WIDTH (IN)	HEIGHT (IN)	SHEETING REMARKS	SIGN LEGEND	NEW SIGNS "A"	NEW SIGNS "B"	EXISTING SIGNS RETAIN	EXISTING SIGNS SALVAGE FROM	EXISTING SIGNS SALVAGE TO	EXISTING SIGNS REMOVE	EXIST POST RETAIN	EXIST POST REMOVE	NUMBER OF NEW POSTS	SQUARE STEEL (IN) 1.75 (LB/FT) 1.88	SQUARE STEEL (IN) 2.00 (LB/FT) 2.42	SQUARE STEEL (IN) 2.50 (LB/FT) 3.35	TUBULAR STEEL Ø (IN) FOUNDATION	TUBULAR STEEL Ø (IN) 3.00 (LB/FT) 7.60	TUBULAR STEEL Ø (IN) 3.50 (LB/FT) 9.00	TUBULAR STEEL Ø (IN) 4.00 (LB/FT) 10.80	TUBULAR STEEL Ø (IN) 5.00 (LB/FT) 14.60	SIGN FRAME REQUIRED	REMARKS	SIGN DETAIL LOCATION SHSM	SIGN DETAIL LOCATION PROJECT SHEET #	SIGN DETAIL LOCATION STANDARD SHEET #
STOWE VT-108 NB							FY-FLUORESCENT YELLOW FYG-FLUORESCENT YELLOW GREEN																				"SHSM"-STANDARD HIGHWAY SIGNS AND MARKINGS			
NB	2.149	A	W1-4R	30	30		RIGHT REVERSE CURVE 6/20						1		X														
NB	2.173	A	R2-1	24	30		SPEED LIMIT 40 6/20						1		X														
NB	2.188	A	R2-1	24	30		 6/20	5.00								1		14.00 X									INSTALL 80 FT NORTH OF EXISTING, IN LINE WITH SB SPEED LIMIT 35 MPH SIGN	X		
NB	2.276	A	W1-4R	30	30		 6/20	6.25								1		13.50 X									INSTALL 543 FT NORTH OF EXISTING SPEED LIMIT SIGN AT M.P. 2.173	X		
NB	2.587	A	VD-062M	72	16		BUSINESS SIGN 6/22			1				X															
		A	VD-062M	72	16		BUSINESS SIGN 6/22			1																			
		A	VD-062BM	72	16		BUSINESS SIGN 6/22			1																			
NB	2.779	A	R2-1	24	30		SPEED LIMIT 40 6/22						1		X														
		A	R2-1	24	30		TRIM 7/7  6/22	5.00								1		13.50 X									REQUIRES VEGETATION CLEARING	X		
NB	2.822	A/B	D3-1	UNK.	UNK.		LANDMARK LN PVT 6/22						1		X														
		A/B	D3-1	68	12		 6/22	5.67								2		23.25 X									LANDMARK LN (PVT); FIELD LOCATE FOR VISIBILITY FROM VT 108		11	
NB	2.897	A/B	D3-1	UNK.	UNK.		HOUSTON FARM RD PVT 6/22						1		X														
		A/B	D3-1	68	12		 6/22	5.67								2		22.75 X									HOUSTON FARM RD (PVT); FIELD LOCATE FOR VISIBILITY FROM VT 108		11	
NB	2.958	A	VW-054R	30	30		HIDDEN DRIVES RIGHT 6/22			1				X															
NB	3.116	A	VD-062B	72	16		BUSINESS SIGN 6/22			1				X															
SIGN SUMMARY SHEET							SHEET TOTALS	~~27.59~~ 27.59 SF	0.00 SF	5 EA	0 EA	0 EA	5 EA	0 EA	0 EA	7 EA		~~87.00~~ 105.0 FT		0 EA	0.0 LB	0.0 LB	0.0 LB	0.0 LB					
VERMONT AGENCY OF TRANSPORTATION							TOWN DIRECTIONAL TOTALS	418.6	0.0	36	15	6	85	0	0	79		1185.0		0	0.0								

PROJECT NAME: **STOWE - BERKSHIRE**
PROJECT NUMBER: **STPG SIGN (49)**
FILE NAME: **01 STOWE VT-108 NB TSS.xls** PLOT DATE: **6/24/2015**
PROJECT MANAGER: **D. BRYANT** DRAWN BY: **J. BLANCHARD**
DESIGNED BY: **J. BLANCHARD** CHECKED **K. KERN**
STOWE NB SHEET 8 SHEET **22** OF **131**

DIRECTION	MILEPOINT	LOCATION CODE (SHEET 2)	SIGN CODE	WIDTH (IN)	HEIGHT (IN)	SHEETING REMARKS	SIGN LEGEND	NEW SIGNS "A"	NEW SIGNS "B"	EXISTING SIGNS RETAIN	EXISTING SIGNS SALVAGE FROM	EXISTING SIGNS SALVAGE TO	EXISTING SIGNS REMOVE	EXIST POST RETAIN	EXIST POST REMOVE	NUMBER OF NEW POSTS	SQUARE STEEL (IN) 1.75 (LB/FT) 1.88	SQUARE STEEL (IN) 2.00 (LB/FT) 2.42	SQUARE STEEL (IN) 2.50 (LB/FT) 3.35	TUBULAR STEEL Ø (IN) FOUNDATION	TUBULAR STEEL Ø (IN) 3.00 (LB/FT) 7.60	TUBULAR STEEL Ø (IN) 3.50 (LB/FT) 9.00	TUBULAR STEEL Ø (IN) 4.00 (LB/FT) 10.80	TUBULAR STEEL Ø (IN) 5.00 (LB/FT) 14.60	SIGN FRAME REQUIRED	REMARKS	SIGN DETAIL LOCATION SHSM	SIGN DETAIL LOCATION PROJECT SHEET #	SIGN DETAIL LOCATION STANDARD SHEET #
STOWE VT-108 NB							FY-FLUORESCENT YELLOW FYG-FLUORESCENT YELLOW GREEN																				"SHSM"-STANDARD HIGHWAY SIGNS AND MARKINGS			
NB	3.183	A	VR-493H	48	60		VT 108 OPEN TO MT. MANSFIELD AND SPRUCE PEAK CLOSED THROUGH SMUGGLERS NOTCH 6/22			1				X															
NB	3.251	C	VR-017	24	30		LLL 24,000 LBS 6/22						1		X														
		C	VR-017	24	30		TRIM 7/7  6/22	5.00								1		13.75 X								EDSON HILL RD (TH-23)		9	
NB	3.260	D	R1-1	30	30		STOP 6/22						1		X														
		C	VD-700	6	10		MILE MARKER 6/22				1	1	1														SALVAGE AND MOUNT ON NEW POST BELOW STOP SIGN			
		D	R1-1	30	30		 6/22	6.25								1		13.50 X								EDSON HILL RD (TH-23)	X		
NB	3.261	A/B	D3-1	UNK.	UNK.		EDSON HILL RD 6/22						1		X														
		A/B	D3-1	54	12		 6/22	4.50								2		22.50 X								EDSON HILL RD (TH-23); INSTALL NEW SIGN ON OPPOSITE SIDE OF STREET AS STOP SIGN		11	
NB	3.277	A	R2-1	24	30		SPEED LIMIT 40 6/22						1		X														
		A	R2-1	24	30		 6/22	5.00								1		13.50 X									X		
NB	3.874	A	R2-1	24	30		SPEED LIMIT 40 6/22						1		X														
NB	3.955	A	W11-2	30	30	FYG	PEDESTRIAN SYMBOL 6/22						1		X														
		A	W16-4P	24	18	FYG	NEXT 1000 FT 6/22						1																
		A	W11-2	30	30	FYG	 6/22	6.25								1			16.50 X								X		
		A	W16-4P	30	24	FYG	 6/22	5.00																			X		
SIGN SUMMARY SHEET							SHEET TOTALS	32.00 SF	0.00 SF	1 EA	1 EA	1 EA	8 EA	0 EA	0 EA	6 EA		79.75 ~~90.0~~ FT		0 EA	0.0 LB	0.0 LB	0.0 LB	0.0 LB					
VERMONT AGENCY OF TRANSPORTATION							TOWN DIRECTIONAL TOTALS	418.6	0.0	36	15	6	85	0	0	79		1185.0		0	0.0								

PROJECT NAME: **STOWE - BERKSHIRE**
PROJECT NUMBER: **STPG SIGN (49)**
FILE NAME: **01 STOWE VT-108 NB TSS.xls** PLOT DATE: **6/24/2015**
PROJECT MANAGER: **D. BRYANT** DRAWN BY: **J. BLANCHARD**
DESIGNED BY: **J. BLANCHARD** CHECKED **K. KERN**
STOWE NB SHEET 9 SHEET **23** OF **131**

DIRECTION	MILEPOINT	LOCATION CODE (SHEET 2)	SIGN CODE	WIDTH (IN)	HEIGHT (IN)	SHEETING REMARKS	SIGN LEGEND		NEW SIGNS "A"	NEW SIGNS "B"	EXISTING SIGNS RETAIN	EXISTING SIGNS SALVAGE FROM	EXISTING SIGNS SALVAGE TO	EXISTING SIGNS REMOVE	EXIST POST RETAIN	EXIST POST REMOVE	NUMBER OF NEW POSTS	SQUARE STEEL (IN) 1.75 (LB / FT) 1.88	SQUARE STEEL (IN) 2.00 (LB / FT) 2.42	SQUARE STEEL (IN) 2.50 (LB / FT) 3.35	TUBULAR STEEL Ø (IN) FOUNDATION	TUBULAR STEEL Ø (IN) 3.00 (LB / FT) 7.60	TUBULAR STEEL Ø (IN) 3.50 (LB / FT) 9.00	TUBULAR STEEL Ø (IN) 4.00 (LB / FT) 10.80	TUBULAR STEEL Ø (IN) 5.00 (LB / FT) 14.60	SIGN FRAME REQUIRED	REMARKS	SIGN DETAIL LOCATION SHSM	SIGN DETAIL LOCATION PROJECT SHEET #	SIGN DETAIL LOCATION STANDARD SHEET #
STOWE VT-108 NB							FY-FLUORESCENT YELLOW FYG-FLUORESCENT YELLOW GREEN																				"SHSM"-STANDARD HIGHWAY SIGNS AND MARKINGS			
NB	3.993	A	VW-054R	30	30		HIDDEN DRIVE RIGHT	6/22						1		X													
		A	UNK.	UNK.	UNK.		BUS STOP	6/22				1		1													SALVAGE AND RETURN TO TOWN			
		A	UNK.	UNK.	UNK.		UNKNOWN SIGN	6/22				1		1													SALVAGE UNKOWN SIGN AND RETURN TO TOWN			
		A	VW-133R	30	30		HIDDEN DRIVE RIGHT	6/22	6.25								1		14.75 X										10	
NB	4.020	A/B	D3-1	UNK.	UNK.		TOPNOTCH DRIVE PVT	6/22				1		1		X											SALVAGE AND RETURN TO TOWN			
		A/B	D3-1	64	12		Topnotch Dr PVT	6/22	5.33								2		23.00 X								TOPNOTCH DRIVE PVT		11	
NB	4.236	A/B	D3-1	UNK.	UNK.		HARTSON RD PVT	6/22						1		X													
		A/B	D3-1	58	12	TRIM 7/7	Hartson Rd PVT	6/22	4.83								2		21.25 X								HARTSON RD (PVT); FIELD LOCATE FOR VISIBILITY FROM VT 108		11	
NB	4.576	A/B	D3-1	UNK.	UNK.		LOWER SANBORN RD	6/22						1		X													
		A/B	D3-1	72	12		Lower Sanborn Rd	6/22	6.00								2		22.50 X								LOWER SANBORN RD (TH-21); FIELD LOCATE FOR VISIBILITY FROM VT 108		11	
NB	4.576	C	VR-017	24	30		LLL 24,000 LBS	6/22						1		X													
		C	VR-017	24	30		LEGAL LOAD LIMIT 24,000 POUNDS	6/22	5.00								1		14.00 X								LOWER SANBORN RD (TH-21)		9	
		D	R1-1	30	30		STOP	6/22	6.25																		LOWER SANBORN RD (TH-21)	X		
NB	4.584	D	R1-1	30	30		STOP	6/22	6.25								1		13.50 X								LOWER SANBORN RD (TH-21); INSTALL 25 FT FROM EXISTING ALONG TOWN HIGHWAY, IN GRAVEL BETWEEN PAVEMENT AND STONE WALL	X		
NB	4.586	D	R1-1	30	30		STOP	6/22						1		X													
							SHEET TOTALS		~~39.91~~ 39.92 SF	0.00 SF	0 EA	3 EA	0 EA	8 EA	0 EA	0 EA	9 EA		~~109.0~~ 135.0 FT		0 EA	0.0 LB	0.0 LB	0.0 LB	0.0 LB					
							TOWN DIRECTIONAL TOTALS		418.6	0.0	36	15	6	85	0	0	79		1185.0		0	0.0							

SIGN SUMMARY SHEET

VERMONT AGENCY OF TRANSPORTATION

PROJECT NAME: **STOWE - BERKSHIRE**
PROJECT NUMBER: **STPG SIGN (49)**
FILE NAME: **01 STOWE VT-108 NB TSS.xls** PLOT DATE: **6/24/2015**
PROJECT MANAGER: **D. BRYANT** DRAWN BY: **J. BLANCHARD**
DESIGNED BY: **J. BLANCHARD** CHECKED **K. KERN**
STOWE NB SHEET 10 SHEET **24** OF **131**

DIRECTION	MILEPOINT	LOCATION CODE (SHEET 2)	SIGN CODE	WIDTH (IN)	HEIGHT (IN)	SHEETING REMARKS	SIGN LEGEND	NEW SIGNS "A"	NEW SIGNS "B"	EXISTING SIGNS RETAIN	EXISTING SIGNS SALVAGE FROM	EXISTING SIGNS SALVAGE TO	EXISTING SIGNS REMOVE	EXIST POST RETAIN	EXIST POST REMOVE	NUMBER OF NEW POSTS	SQUARE STEEL (IN) 1.75 (LB/FT) 1.88	SQUARE STEEL (IN) 2.00 (LB/FT) 2.42	SQUARE STEEL (IN) 2.50 (LB/FT) 3.35	TUBULAR STEEL Ø (IN) FOUNDATION	TUBULAR STEEL Ø (IN) 3.00 (LB/FT) 7.60	TUBULAR STEEL Ø (IN) 3.50 (LB/FT) 9.00	TUBULAR STEEL Ø (IN) 4.00 (LB/FT) 10.80	TUBULAR STEEL Ø (IN) 5.00 (LB/FT) 14.60	SIGN FRAME REQUIRED	REMARKS	SIGN DETAIL LOCATION SHSM	SIGN DETAIL LOCATION PROJECT SHEET #	SIGN DETAIL LOCATION STANDARD SHEET #
STOWE VT-108 NB							FY-FLUORESCENT YELLOW FYG-FLUORESCENT YELLOW GREEN																				"SHSM"-STANDARD HIGHWAY SIGNS AND MARKINGS			
		C	VD-700	6	10		MILE MARKER 6/22						0 ~~1~~																
NB	4.599	A	R2-1	24	30		SPEED LIMIT 40 6/22						1		X														
NB	4.621	A	R2-1	24	30		 6/22	5.00								1		13.50 X									INSTALL 115 FT NORTH OF EXISTING	X		
NB	4.869	A/B	D3-1	UNK.	UNK.		PINE RIDGE RD PVT 6/24						1		X														
		A/B	D3-1	70	12		TRIM 7/7  6/24	5.83								2		24.75 X									PINE RIDGE RD (PVT); FIELD LOCATE FOR VISIBILITY FROM VT 108		11	
NB	4.884	A	VD-062B	72	16		BUSINESS SIGN 6/24			1				X															
NB	5.000	A/B	D3-1	UNK.	UNK.		STOWE FORKS PVT 6/24			1				X															
		A	UNK.	UNK.	UNK.		BUS SIGN				1		1														SALVAGE AND RETURN TO TOWN			
NB	5.024	C	VR-017	24	30		LLL 24,000 LBS 6/24						1		X														
		C	VR-017	24	30		 6/24	5.00								1		13.00 X									NOTCHBROOK RD (TH-19)		9	
NB	5.027	D	R1-1	30	30		STOP 6/24						1		X														
		C	VD-700	6	10		MILE MARKER 6/24				1	1	1														SALVAGE AND MOUNT ON NEW POST BELOW STOP SIGN			
		D	R1-1	30	30		 6/24	6.25								1		13.50 X									NOTCHBROOK RD (TH-19); INSTALL 10 FT FROM UTILITY POLE	X		
NB	5.027	A/B	D3-1	UNK.	UNK.		NOTCHBROOK RD 6/24				1		1		X												SALVAGE AND RETURN TO TOWN			
		A/B	D3-1	60	12		TRIM 7/7  6/24	5.00								2		22.50 X									NOTCHBROOK RD (TH-19); FIELD LOCATE FOR VISIBILITY FROM VT 108		11	
SIGN SUMMARY SHEET							SHEET TOTALS	27.08 SF	0.00 SF	2 EA	~~2~~ EA	1 EA	~~6~~ 8 EA	0 EA	0 EA	7 EA		~~87.25~~ 105.0 FT		0 EA	0.0 LB	0.0 LB	0.0 LB	0.0 LB					
VERMONT AGENCY OF TRANSPORTATION							TOWN DIRECTIONAL TOTALS	418.6	0.0	36	15	6	85	0	0	79		1185.0		0	0.0								

PROJECT NAME: **STOWE - BERKSHIRE**
PROJECT NUMBER: **STPG SIGN (49)**
FILE NAME: **01 STOWE VT-108 NB TSS.xls** PLOT DATE: **6/24/2015**
PROJECT MANAGER: **D. BRYANT** DRAWN BY: **J. BLANCHARD**
DESIGNED BY: **J. BLANCHARD** CHECKED **K. KERN**
STOWE NB SHEET 11 SHEET **25** OF **131**

DIRECTION	MILEPOINT	LOCATION CODE (SHEET 2)	SIGN CODE	WIDTH (IN)	HEIGHT (IN)	SHEETING REMARKS	SIGN LEGEND	NEW SIGNS "A"	NEW SIGNS "B"	EXISTING SIGNS RETAIN	EXISTING SIGNS SALVAGE FROM	EXISTING SIGNS SALVAGE TO	EXISTING SIGNS REMOVE	EXIST POST RETAIN	EXIST POST REMOVE	NUMBER OF NEW POSTS	SQUARE STEEL (IN) 1.75 (LB/FT) 1.88	SQUARE STEEL (IN) 2.00 (LB/FT) 2.42	SQUARE STEEL (IN) 2.50 (LB/FT) 3.35	TUBULAR STEEL Ø (IN) FOUNDATION	TUBULAR STEEL Ø (IN) 3.00 (LB/FT) 7.60	TUBULAR STEEL Ø (IN) 3.50 (LB/FT) 9.00	TUBULAR STEEL Ø (IN) 4.00 (LB/FT) 10.80	TUBULAR STEEL Ø (IN) 5.00 (LB/FT) 14.60	SIGN FRAME REQUIRED	REMARKS	SIGN DETAIL LOCATION SHSM	SIGN DETAIL LOCATION PROJECT SHEET #	SIGN DETAIL LOCATION STANDARD SHEET #
STOWE VT-108 NB							FY-FLUORESCENT YELLOW FYG-FLUORESCENT YELLOW GREEN																				"SHSM"-STANDARD HIGHWAY SIGNS AND MARKINGS			
NB	5.112	A	R2-1	24	30		SPEED LIMIT 50 6/24						0 ~~1~~		X														
		A	R2-1	24	30		 6/24	5.00								1		14.75 X									X		
NB	5.704	A	W11-2	30	30	FYG	PEDESTRIAN SYMBOL 6/24						1		X														
		A	W16-9P	24	12	FYG	AHEAD WARNING 6/24						1																
		A	W11-2	30	30	FYG	 6/24	6.25								1		15.75 X									X		
		A	W16-9P	24	12	FYG	AHEAD 6/24	2.00																			X		
NB	5.783	A	VW-205	36	36		 6/24	9.00								2		28.00 X								INSTALL 143 FT NORTH OF UTILITY POLE #59 AT M.P. 5.756		10	
NB	5.799	A	VW-205	30	30		WATCH FOR TURNING VEHICLES 6/24						1		X														
NB	5.819	A	W11-2	30	30		PEDESTRIAN SYMBOL 6/24						1		X														
		A	W16-7P	24	12		DIAGONAL ARROW WARNING 6/24						1																
		A	W11-2	30	30	FYG	 6/24	6.25								1		14.50 X									X		
		A	W16-7PL	24	12	FYG	6/24	2.00																			X		
NB	6.240	A	VD-062BRN	72	16		BUSINESS SIGN 6/24			1				X															
NB	7.386	A	W3-5	36	36		SPEED REDUCTION SPEED LIMIT 40 6/24			1				X															
NB	7.494	A/B	D3-1	UNK.	UNK.		LIFTLINE DRIVE PVT 6/24				0 ~~1~~		1		X												SALVAGE AND RETURN TO TOWN			
SIGN SUMMARY SHEET							SHEET TOTALS	30.50 SF	0.00 SF	2 EA	0 ~~1~~ EA	0 EA	7 EA	0 EA	0 EA	5 EA		73.00 ~~75.0~~ FT		0 EA	0.0 LB	0.0 LB	0.0 LB	0.0 LB					
VERMONT AGENCY OF TRANSPORTATION							TOWN DIRECTIONAL TOTALS	418.6	0.0	36	15	6	85	0	0	79		1185.0		0	0.0								

PROJECT NAME: **STOWE - BERKSHIRE**
PROJECT NUMBER: **STPG SIGN (49)**
FILE NAME: **01 STOWE VT-108 NB TSS.xls** PLOT DATE: **6/24/2015**
PROJECT MANAGER: **D. BRYANT** DRAWN BY: **J. BLANCHARD**
DESIGNED BY: **J. BLANCHARD** CHECKED **K. KERN**
STOWE NB SHEET 12 SHEET **26** OF **131**

DIRECTION	MILEPOINT	LOCATION CODE (SHEET 2)	SIGN CODE	WIDTH (IN)	HEIGHT (IN)	SHEETING REMARKS	SIGN LEGEND	NEW SIGNS "A"	NEW SIGNS "B"	EXISTING SIGNS RETAIN	EXISTING SIGNS SALVAGE FROM	EXISTING SIGNS SALVAGE TO	EXISTING SIGNS REMOVE	EXIST POST RETAIN	EXIST POST REMOVE	NUMBER OF NEW POSTS	SQUARE STEEL (IN) 1.75 (LB/FT) 1.88	SQUARE STEEL (IN) 2.00 (LB/FT) 2.42	SQUARE STEEL (IN) 2.50 (LB/FT) 3.35	TUBULAR STEEL Ø (IN) FOUNDATION	TUBULAR STEEL Ø (IN) 3.00 (LB/FT) 7.60	TUBULAR STEEL Ø (IN) 3.50 (LB/FT) 9.00	TUBULAR STEEL Ø (IN) 4.00 (LB/FT) 10.80	TUBULAR STEEL Ø (IN) 5.00 (LB/FT) 14.60	SIGN FRAME REQUIRED	REMARKS	SIGN DETAIL LOCATION SHSM	SIGN DETAIL LOCATION PROJECT SHEET #	SIGN DETAIL LOCATION STANDARD SHEET #
STOWE VT-108 NB							FY-FLUORESCENT YELLOW FYG-FLUORESCENT YELLOW GREEN																				"SHSM"-STANDARD HIGHWAY SIGNS AND MARKINGS			
		A/B	D3-1	56	12		Liftline Dr PVT 6/24	4.67					0 —			2		21.75 X								LIFTLINE DRIVE PVT		11	
NB	7.523	A	R2-1	30	36		SPEED LIMIT 40 6/24			1				X															
NB	7.578	A	VW-400	48	48	FY	SMUGGLERS NOTCH NOT RECOMMENDED FOR TRUCKS BUSES OR RVS TRIM 7/8			1				X																
NB	7.620	A	W11-2	30	30	FYG	TRIM 7/8  6/24	6.25								1		13.25 X								INSTALL 222 FT NORTH OF SMUGGLERS NOTCH VW-400 SIGN	X		
		A	W7-3aP	24	18	FYG	 6/24	3.00																				X		
NB	7.689	A	W20-3	48	48		HINGED ROAD CLOSED 1000 FT						1		X															
		A	W20-3H	48	48	ORG	 8/24	16.00								2		31.25 X										9	
NB	7.667	A	M4-5	24	12		BEGIN STATE TRIM 7/8 6/24			1				X															
		A	VM-064	24	12		SCENIC STATE 6/24			1																			
		A	M1-5A	30	24		VERMONT 108 6/24			1																			
NB	7.722	A	W16-18P	48	12		NOTICE 6/24			1				X															
		A	VR5-2M	48	48		NO TRACTOR TRAILER SYMBOL 6/24			1																			
		A	VR-472	48	48		TRACTOR TRAILERS PROHIBITED 6/24			1																			
NB	7.795	A	VM-607	24	30		*10TH MTN DIV WW II MEMORIAL HIGHWAY 6/24			1				X															
NB	7.810	A	OM4-1	18	18		RED CLUSTER TRIM 7/8 7/8				0		1														EXISTING SIGNS MOUNTED TO GATE			
SIGN SUMMARY SHEET							SHEET TOTALS	29.92	0.00	9	0	0	2	0	0	5		66.25 75.0		0	0.0	0.0	0.0	0.0					
								SF	SF	EA	EA	EA	EA	EA	EA	EA		FT		EA	LB	LB	LB	LB					
VERMONT AGENCY OF TRANSPORTATION							TOWN DIRECTIONAL TOTALS	418.6	0.0	36	15	6	85	0	0	79		1185.0		0		0.0							

PROJECT NAME: **STOWE - BERKSHIRE**
PROJECT NUMBER: **STPG SIGN (49)**
FILE NAME: **01 STOWE VT-108 NB TSS.xls** PLOT DATE: **6/24/2015**
PROJECT MANAGER: **D. BRYANT** DRAWN BY: **J. BLANCHARD**
DESIGNED BY: **J. BLANCHARD** CHECKED **K. KERN**
STOWE NB SHEET 13 SHEET **27** OF **131**

DIRECTION	MILEPOINT	LOCATION CODE (SHEET 2)	SIGN CODE	WIDTH (IN)	HEIGHT (IN)	SHEETING REMARKS	SIGN LEGEND	NEW SIGNS "A"	NEW SIGNS "B"	EXISTING SIGNS RETAIN	EXISTING SIGNS SALVAGE FROM	EXISTING SIGNS SALVAGE TO	EXISTING SIGNS REMOVE	EXIST POST RETAIN	EXIST POST REMOVE	NUMBER OF NEW POSTS	SQUARE STEEL (IN) 1.75 (LB / FT) 1.88	SQUARE STEEL (IN) 2.00 (LB / FT) 2.42	SQUARE STEEL (IN) 2.50 (LB / FT) 3.35	TUBULAR STEEL Ø (IN) FOUNDATION	TUBULAR STEEL Ø (IN) 3.00 (LB / FT) 7.60	TUBULAR STEEL Ø (IN) 3.50 (LB / FT) 9.00	TUBULAR STEEL Ø (IN) 4.00 (LB / FT) 10.80	TUBULAR STEEL Ø (IN) 5.00 (LB / FT) 14.60	SIGN FRAME REQUIRED	REMARKS	SIGN DETAIL LOCATION SHSM	SIGN DETAIL LOCATION PROJECT SHEET #	SIGN DETAIL LOCATION STANDARD SHEET #
STOWE VT-108 NB							FY-FLUORESCENT YELLOW FYG-FLUORESCENT YELLOW GREEN																				"SHSM"-STANDARD HIGHWAY SIGNS AND MARKINGS			
		A	R11-2	48	30		ROAD CLOSED 7/6	5.00					1																
		A	UNK.	UNK.	UNK.		EMERGENCY VEHICLE PARKING ONLY 7/8	2.25 CLUSTERS 2.25					1																
		A	OM4-2	18	18		 7/8	2.25																			MOUNT TO SWING GATE AT THIS LOCATION; INCIDENTAL TO SIGN ITEM	X		
		A	R11-2	48	30		7/8	10.00																			X		
		A	OM4-2	18	18		7/8	2.25																			X		
NB	7.829	A	R2-1	24	30		SPEED LIMIT 40 6/24						1		X														
		A	R2-1	24	30		 6/24	5.00								1		15.00 X									REQUIRES VEGETATION CLEARING (SEE GENERAL NOTE 5 ON SHEET 2)	X		
NB	8.377	A	R2-1	24	30		SPEED LIMIT 40 6/24						1		X														
		A	R2-1	24	30		 6/24	5.00								1		15.75 X										X		
SIGN SUMMARY SHEET							SHEET TOTALS	34.00 ~~24.50~~	0.00	0	0	0	4	0	0	2		~~30.0~~ 30.75		0	0.0	0.0	0.0	0.0					
								SF	SF	EA	EA	EA	EA	EA	EA	EA		FT		EA	LB	LB	LB	LB					
VERMONT AGENCY OF TRANSPORTATION							TOWN DIRECTIONAL TOTALS	418.6	0.0	36	15	6	85	0	0	79		1185.0		0	0.0								

PROJECT NAME: **STOWE - BERKSHIRE**
PROJECT NUMBER: **STPG SIGN (49)**
FILE NAME: **01 STOWE VT-108 NB TSS.xls** PLOT DATE: **6/24/2015**
PROJECT MANAGER: **D. BRYANT** DRAWN BY: **J. BLANCHARD**
DESIGNED BY: **J. BLANCHARD** CHECKED **K. KERN**
STOWE NB SHEET 14 SHEET **28** OF **131**

DIRECTION	MILEPOINT	LOCATION CODE (SHEET 2)	SIGN CODE	WIDTH (IN)	HEIGHT (IN)	SHEETING REMARKS	SIGN LEGEND	NEW SIGNS "A"	NEW SIGNS "B"	EXISTING SIGNS RETAIN	EXISTING SIGNS SALVAGE FROM	EXISTING SIGNS SALVAGE TO	EXISTING SIGNS REMOVE	EXIST POST RETAIN	EXIST POST REMOVE	NUMBER OF NEW POSTS	SQUARE STEEL (IN) 1.75 (LB/FT) 1.88	SQUARE STEEL (IN) 2.00 (LB/FT) 2.42	SQUARE STEEL (IN) 2.50 (LB/FT) 3.35	TUBULAR STEEL Ø (IN) FOUNDATION	TUBULAR STEEL Ø (IN) 3.00 (LB/FT) 7.60	TUBULAR STEEL Ø (IN) 3.50 (LB/FT) 9.00	TUBULAR STEEL Ø (IN) 4.00 (LB/FT) 10.80	TUBULAR STEEL Ø (IN) 5.00 (LB/FT) 14.60	SIGN FRAME REQUIRED	REMARKS	SIGN DETAIL LOCATION SHSM	SIGN DETAIL LOCATION PROJECT SHEET #	SIGN DETAIL LOCATION STANDARD SHEET #
STOWE VT-108 SB							FY-FLUORESCENT YELLOW FYG-FLUORESCENT YELLOW GREEN																				"SHSM"-STANDARD HIGHWAY SIGNS AND MARKINGS			
SB	8.377	F	R2-1	24	30		SPEED LIMIT 40 6/10						1		X														
		F	R2-1	24	30		TRIM 7/7  6/10	5.00								1		14.75 X									X		
SB	7.810	E	R11-2	48	30		ROAD CLOSED						1														EXISTING SIGNS MOUNTED TO GATE			
		E	OM4-1	18	18		RED CLUSTER						1																
		E	R8-3	24	24		NO PARKING SYMBOL						1																
		E	OM4-2	18	18			2.25																			MOUNT TO SWING GATE AT THIS LOCATION; INCIDENTAL TO SIGN ITEM	X		
		E	R8-4	30	24			5.00																			X		
		E	OM4-2	18	18			2.25																				X		
SB	7.712	G	UNK.	UNK.	UNK.		NO PARKING SYMBOL LEFT 7/7						1		X														
		G	R7-1L	12	18		 7/7	1.50								1		12.00 X									X		
SB	7.707	G	UNK.	UNK.	UNK.		NO PARKING SYMBOL RIGHT 7/7						1		X														
		G	R7-1R	12	18		 7/7	1.50								1		12.00 X									X		
SB	7.667	F	M4-6	24	12		END STATE 7/7			1				X															
		F	VM-064	24	12		SCENIC STATE 7/7			1																			
		F	M1-5A	30	24		VERMONT 108 7/7			1																			
SIGN SUMMARY SHEET							SHEET TOTALS	17.50	0.00	3	0	0	6	0	0	3		~~38.75~~ ~~45.0~~		0	0.0	0.0	0.0	0.0					
								SF	SF	EA	EA	EA	EA	EA	EA	EA		FT		EA	LB	LB	LB	LB					
VERMONT AGENCY OF TRANSPORTATION							TOWN DIRECTIONAL TOTALS	515.2	0.0	18	11	9	110	0	0	85		1275.0		0	0.0								

PROJECT NAME: **STOWE - BERKSHIRE**
PROJECT NUMBER: **STPG SIGN (49)**
FILE NAME: **02 STOWE VT-108 SB TSS.xls** PLOT DATE: **6/24/2015**
PROJECT MANAGER: **D. BRYANT** DRAWN BY: **J. BLANCHARD**
DESIGNED BY: **J. BLANCHARD** CHECKED **K. KERN**
STOWE SB SHEET 1 SHEET **29** OF **131**

DIRECTION	MILEPOINT	LOCATION CODE (SHEET 2)	SIGN CODE	WIDTH (IN)	HEIGHT (IN)	SHEETING REMARKS	SIGN LEGEND	NEW SIGNS "A"	NEW SIGNS "B"	EXISTING SIGNS RETAIN	EXISTING SIGNS SALVAGE FROM	EXISTING SIGNS SALVAGE TO	EXISTING SIGNS REMOVE	EXIST POST RETAIN	EXIST POST REMOVE	NUMBER OF NEW POSTS	SQUARE STEEL (IN) 1.75 (LB/FT) 1.88	SQUARE STEEL (IN) 2.00 (LB/FT) 2.42	SQUARE STEEL (IN) 2.50 (LB/FT) 3.35	TUBULAR STEEL Ø (IN) FOUNDATION	TUBULAR STEEL Ø (IN) 3.00 (LB/FT) 7.60	TUBULAR STEEL Ø (IN) 3.50 (LB/FT) 9.00	TUBULAR STEEL Ø (IN) 4.00 (LB/FT) 10.80	TUBULAR STEEL Ø (IN) 5.00 (LB/FT) 14.60	SIGN FRAME REQUIRED	REMARKS	SIGN DETAIL LOCATION SHSM	SIGN DETAIL LOCATION PROJECT SHEET #	SIGN DETAIL LOCATION STANDARD SHEET #
STOWE VT-108 SB							FY-FLUORESCENT YELLOW FYG-FLUORESCENT YELLOW GREEN																				"SHSM"-STANDARD HIGHWAY SIGNS AND MARKINGS			
SB	7.523	F	R2-1	24	30		SPEED LIMIT 50 7/7			1				X															
SB	6.876	F	UNK.	UNK.	UNK.		BUSINESS SIGN 7/7			1				X															
SB	6.640	F	VW-205	30	30		WATCH FOR TURNING VEHICLES 6/10						1		X														
		F	VW-205	36	36		TRIM 7/7  6/10	9.00								2		25.00 X									10	
SB	5.943	F	W11-2	30	30	FYG	PEDESTRIAN SYMBOL 6/10						1		X														
		F	W16-9P	24	12	FYG	AHEAD WARNING 6/10						1																
		F	W11-2	30	30	FYG	 6/10	6.25								1		15.50 X									X	
		F	W16-9P	24	12	FYG	AHEAD 6/10	2.00																			X	
SB	5.911	F	VW-205	30	30		WATCH FOR TURNING VEHICLES 6/10						1		X														
		F	VW-205	36	36		 6/10	9.00								2		28.00 X									10	
SB	5.859	F	W11-2	30	30	FYG	PEDESTRIAN SYMBOL 6/10						1		X														
		F	W16-7P	24	12	FYG	DOWNWARD DIAGONAL ARROW 6/10						1																
SB	5.833	F	W11-2	30	30	FYG	 6/10	6.25								1		29.25 X									INSTALL 137 FT SOUTH OF EXISTING	X	
		F	W16-7PL	24	12	FYG	6/10	2.00																			X	
SB	5.403	F	W7-1a	30	30		HILL WITH GRADE 6/10						1		X														
							SHEET TOTALS	34.50 SF	0.00 SF	2 EA	0 EA	0 EA	7 EA	0 EA	0 EA	6 EA		97.75 ~~90.0~~ FT		0 EA	0.0 LB	0.0 LB	0.0 LB	0.0 LB					
							TOWN DIRECTIONAL TOTALS	515.2	0.0	18	11	9	110	0	0	85		1275.0		0	0.0										

SIGN SUMMARY SHEET

VERMONT AGENCY OF TRANSPORTATION

PROJECT NAME: **STOWE - BERKSHIRE**
PROJECT NUMBER: **STPG SIGN (49)**
FILE NAME: **02 STOWE VT-108 SB TSS.xls** PLOT DATE: **6/24/2015**
PROJECT MANAGER: **D. BRYANT** DRAWN BY: **J. BLANCHARD**
DESIGNED BY: **J. BLANCHARD** CHECKED **K. KERN**
STOWE SB SHEET 2 SHEET **30** OF **131**

DIRECTION	MILEPOINT	LOCATION CODE (SHEET 2)	SIGN CODE	WIDTH (IN)	HEIGHT (IN)	SHEETING REMARKS	SIGN LEGEND	NEW SIGNS "A"	NEW SIGNS "B"	EXISTING SIGNS RETAIN	EXISTING SIGNS SALVAGE FROM	EXISTING SIGNS SALVAGE TO	EXISTING SIGNS REMOVE	EXIST POST RETAIN	EXIST POST REMOVE	NUMBER OF NEW POSTS	SQUARE STEEL (IN) 1.75 (LB/FT) 1.88	SQUARE STEEL (IN) 2.00 (LB/FT) 2.42	SQUARE STEEL (IN) 2.50 (LB/FT) 3.35	TUBULAR STEEL Ø (IN) FOUNDATION	TUBULAR STEEL Ø (IN) 3.00 (LB/FT) 7.60	TUBULAR STEEL Ø (IN) 3.50 (LB/FT) 9.00	TUBULAR STEEL Ø (IN) 4.00 (LB/FT) 10.80	TUBULAR STEEL Ø (IN) 5.00 (LB/FT) 14.60	SIGN FRAME REQUIRED	REMARKS	SIGN DETAIL LOCATION SHSM	SIGN DETAIL LOCATION PROJECT SHEET #	SIGN DETAIL LOCATION STANDARD SHEET #
STOWE VT-108 SB							FY-FLUORESCENT YELLOW FYG-FLUORESCENT YELLOW GREEN																				"SHSM"-STANDARD HIGHWAY SIGNS AND MARKINGS			
		F	W7-1a	30	30		 6/13	6.25								1		14.00 X								INSTALL 1070 FT NORTH OF SPEED REDUCTION WARNING	X		
SB	5.200	F	VR2-5A	24	30		REDUCED SPEED AHEAD 6/13						1		X														
		F	W3-5	36	36		 6/13	9.00								2		27.25 X									X		
SB	5.155	F	VD-062B	72	16		BUSINESS SIGN			1				X															
SB	5.112	F	R2-1	24	30		SPEED LIMIT 40 6/13						1		X														
		F	R2-1	30	36		TRIM 7/8  6/13	7.50								1		14.25 X									X		
SB	5.072	E/F	D3-1	UNK.	UNK.		RANCH BROOK RD						1		X														
		E/F	UNK.	UNK.	UNK.		ADAMS CAMP TRAILS				1		~~1~~ 0													SALVAGE AND REMOUNT IN NEW LOCATION			
SB	5.071	G	VR-017	24	30		LLL 16,000 LBS 6/10						~~1~~ 0		X														
		G	VR-017	24	30		 6/10	5.00								1		11.75 X								RANCH BROOK RD (TH-34)		9	
SB	5.060	H	R1-1	30	30		STOP 6/10						1		X														
		G	VD-700	6	10		MILE MARKER 6/10				1	1	1													SALVAGE AND MOUNT ON NEW POST BELOW STOP SIGN			
		E/F	D3-1	64	12		 6/10	5.33								2		23.25 X								RANCH BROOK RD (TH-34); FIELD LOCATE FOR VISIBILITY FROM VT-108		11	
		E/F	UNK.	UNK.	UNK.		ADAMS CAMP TRAILS 6/10					1														SALVAGE FROM OLD LOCATION; MOUNT BELOW STREET NAME SIGN			
SB	5.059	H	R1-1	30	30		 6/10	6.25								1		14.00 X								RANCH BROOK RD (TH-34); INSTALL 10 FT NORTH OF EXISTING, IN LINE WITH END OF WOODEN RAIL	X		
SIGN SUMMARY SHEET							SHEET TOTALS	39.33	0.00	1	2	2	~~7~~ 5	0	0	8		~~120.0~~ 104.50		0	0.0	0.0	0.0	0.0					
								SF	SF	EA	EA	EA	EA	EA	EA	EA		FT		EA	LB	LB	LB	LB					
VERMONT AGENCY OF TRANSPORTATION							TOWN DIRECTIONAL TOTALS	515.2	0.0	18	11	9	110	0	0	85		1275.0		0	0.0								

PROJECT NAME: **STOWE - BERKSHIRE**
PROJECT NUMBER: **STPG SIGN (49)**

FILE NAME: **02 STOWE VT-108 SB TSS.xls** PLOT DATE: **6/24/2015**
PROJECT MANAGER: **D. BRYANT** DRAWN BY: **J. BLANCHARD**
DESIGNED BY: **J. BLANCHARD** CHECKED **K. KERN**
STOWE SB SHEET 3 SHEET **31** OF **131**

DIRECTION	MILEPOINT	LOCATION CODE (SHEET 2)	SIGN CODE	WIDTH (IN)	HEIGHT (IN)	SHEETING REMARKS	SIGN LEGEND	NEW SIGNS "A"	NEW SIGNS "B"	EXISTING SIGNS RETAIN	EXISTING SIGNS SALVAGE FROM	EXISTING SIGNS SALVAGE TO	EXISTING SIGNS REMOVE	EXIST POST RETAIN	EXIST POST REMOVE	NUMBER OF NEW POSTS	SQUARE STEEL (IN) 1.75 (LB/FT) 1.88	SQUARE STEEL (IN) 2.00 (LB/FT) 2.42	SQUARE STEEL (IN) 2.50 (LB/FT) 3.35	TUBULAR STEEL Ø (IN) FOUNDATION	TUBULAR STEEL Ø (IN) 3.00 (LB/FT) 7.60	TUBULAR STEEL Ø (IN) 3.50 (LB/FT) 9.00	TUBULAR STEEL Ø (IN) 4.00 (LB/FT) 10.80	TUBULAR STEEL Ø (IN) 5.00 (LB/FT) 14.60	SIGN FRAME REQUIRED	REMARKS	SIGN DETAIL LOCATION SHSM	SIGN DETAIL LOCATION PROJECT SHEET #	SIGN DETAIL LOCATION STANDARD SHEET #
STOWE VT-108 SB							FY-FLUORESCENT YELLOW FYG-FLUORESCENT YELLOW GREEN																				"SHSM"-STANDARD HIGHWAY SIGNS AND MARKINGS			
SB	4.919	F	R2-1	24	30		SPEED LIMIT 40 6/13						1		X														
		F	R2-1	24	30		 6/13	5.00								1		13.50 X									X		
SB	4.497	F	R2-1	24	30		SPEED LIMIT 40 6/13						1		X														
		F	R2-1	24	30		 6/13	5.00								1		16.00 X									X		
SB	4.305	G	VR-017	24	30		LLL 16,000 LBS 6/13						1		X														
		G	VR-017	24	30		TRIM 7/7  6/13	5.00								1		13.50 X								BROOK RD (TH-36); REQUIRES VEGETATION CLEARING		9	
SB	4.300	H	R1-1	30	30		STOP 6/13						1		X														
		G	VD-700	6	10		MILE MARKER 6/13				1	1	1														SALVAGE AND MOUNT ON NEW POST BELOW STOP SIGN			
		H	D3-1	36	12		 6/13	3.00								1		14.25 X								BROOK RD (TH-36); MOUNT TO STOP SIGN WITH BRACKET		11	
		E/F	R1-1	30	30		 6/13	6.25																		BROOK RD (TH-36)	X		
SB	4.298	E/F	D3-1	UNK.	UNK.		BROOK RD 6/13						1		X														
SB	4.201	F	VW-060	30	30		HIDDEN DRIVES 6/13						1		X														
		F	VW-060	30	30		 6/13	6.25								1		15.00 X										10	
SB	4.149	F	W11-2	30	30	FYG	 6/13	6.25								1			18.00 X							INSTALL 10 FT NORTH OF UTILITY POLE 2/141	X		
		F	W16-4P	30	24	FYG	 6/13	5.00																			X		
SIGN SUMMARY SHEET							SHEET TOTALS	41.75 SF	0.00 SF	0 EA	1 EA	1 EA	7 EA	0 EA	0 EA	6 EA		90.25 ~~90.0~~ FT		0 EA	0.0 LB	0.0 LB	0.0 LB	0.0 LB					
VERMONT AGENCY OF TRANSPORTATION							TOWN DIRECTIONAL TOTALS	515.2	0.0	18	11	9	110	0	0	85		1275.0		0	0.0								

PROJECT NAME: **STOWE - BERKSHIRE**
PROJECT NUMBER: **STPG SIGN (49)**

FILE NAME: **02 STOWE VT-108 SB TSS.xls** PLOT DATE: **6/24/2015**
PROJECT MANAGER: **D. BRYANT** DRAWN BY: **J. BLANCHARD**
DESIGNED BY: **J. BLANCHARD** CHECKED **K. KERN**
STOWE SB SHEET 4 SHEET **32** OF **131**

DIRECTION	MILEPOINT	LOCATION CODE (SHEET 2)	SIGN CODE	WIDTH (IN)	HEIGHT (IN)	SHEETING REMARKS	SIGN LEGEND	NEW SIGNS		EXISTING SIGNS				EXIST POST		NUMBER OF NEW POSTS	SQUARE STEEL (IN)			TUBULAR STEEL Ø (IN)				SIGN FRAME REQUIRED	REMARKS	SIGN DETAIL LOCATION		
								"A"	"B"	RETAIN	SALVAGE FROM	SALVAGE TO	REMOVE	RETAIN	REMOVE		1.75 (LB / FT) 1.88	2.00 (LB / FT) 2.42	2.50 (LB / FT) 3.35	FOUNDATION	3.00 (LB / FT) 7.60	3.50 (LB / FT) 9.00	4.00 (LB / FT) 10.80	5.00 (LB / FT) 14.60			SHSM	PROJECT SHEET #	STANDARD SHEET #
STOWE VT-108 SB							FY-FLUORESCENT YELLOW FYG-FLUORESCENT YELLOW GREEN																		"SHSM"-STANDARD HIGHWAY SIGNS AND MARKINGS			
SB	4.151	F	W11-2	30	30	FYG	PEDESTRIAN SYMBOL						1		X													
		F	W16-4P	24	18	FYG	NEXT 1000 FT 6/13						1															
SB	3.961	F	W1-2L	30	30		LEFT CURVE						1		X													
		F	VD-700	6	10		MILE MARKER 6/13						1															
SB	3.899	F	W1-2L	30	30		 6/13	6.25								1		14.25 X								INSTALL 327 FT SOUTH OF EXISTING; REQUIRES VEGETATION CLEARING	X		
SB	3.860	F	W1-6	48	24		<=== LEFT LARGE ARROW						1		X													
		F	W1-6L	48	24		 6/13	8.00								2		27.25 X									X		
SB	3.845	E	W1-6	48	24		RIGHT ===> LARGE ARROW						1		X													
		E	W1-6R	48	24		 6/13	8.00								2		24.25 X									X		
SB	3.674	F	R2-1	24	30		SPEED LIMIT 40						1		X													
		F	R2-1	24	30		 6/13	5.00								1		14.50 X									X		
SB	3.501	F	VR-023B	24	30		$500 FINE FOR THROWING TRASH ON HIGHWAYS AND STREAMS						1		X													
SB	3.379	F	VD-062B	72	16		BUSINESS SIGN			1				X														
		F	VD-062B	72	16		BUSINESS SIGN			1																		
		F	VD-062B	72	16		BUSINESS SIGN 6/13			1																		
SIGN SUMMARY SHEET							SHEET TOTALS	27.25	0.00	3	0	0	8	0	0	6		~~80.0~~ 80.25		0	0.0	0.0	0.0	0.0					
								SF	SF	EA	EA	EA	EA	EA	EA	EA		FT		EA	LB	LB	LB	LB					
VERMONT AGENCY OF TRANSPORTATION							TOWN DIRECTIONAL TOTALS	515.2	0.0	18	11	9	110	0	0	85		1275.0		0			0.0						

PROJECT NAME: **STOWE - BERKSHIRE**
PROJECT NUMBER: **STPG SIGN (49)**
FILE NAME: **02 STOWE VT-108 SB TSS.xls** PLOT DATE: **6/24/2015**
PROJECT MANAGER: **D. BRYANT** DRAWN BY: **J. BLANCHARD**
DESIGNED BY: **J. BLANCHARD** CHECKED **K. KERN**
STOWE SB SHEET 5 SHEET **33** OF **131**

DIRECTION	MILEPOINT	LOCATION CODE (SHEET 2)	SIGN CODE	WIDTH (IN)	HEIGHT (IN)	SHEETING REMARKS	SIGN LEGEND	NEW SIGNS "A"	NEW SIGNS "B"	EXISTING SIGNS RETAIN	EXISTING SIGNS SALVAGE FROM	EXISTING SIGNS SALVAGE TO	EXISTING SIGNS REMOVE	EXIST POST RETAIN	EXIST POST REMOVE	NUMBER OF NEW POSTS	SQUARE STEEL (IN) 1.75 (LB/FT) 1.88	SQUARE STEEL (IN) 2.00 (LB/FT) 2.42	SQUARE STEEL (IN) 2.50 (LB/FT) 3.35	TUBULAR STEEL Ø (IN) FOUNDATION	TUBULAR STEEL Ø (IN) 3.00 (LB/FT) 7.60	TUBULAR STEEL Ø (IN) 3.50 (LB/FT) 9.00	TUBULAR STEEL Ø (IN) 4.00 (LB/FT) 10.80	TUBULAR STEEL Ø (IN) 5.00 (LB/FT) 14.60	SIGN FRAME REQUIRED	REMARKS	SIGN DETAIL LOCATION SHSM	SIGN DETAIL LOCATION PROJECT SHEET #	SIGN DETAIL LOCATION STANDARD SHEET #
STOWE VT-108 SB							FY-FLUORESCENT YELLOW FYG-FLUORESCENT YELLOW GREEN																				"SHSM"-STANDARD HIGHWAY SIGNS AND MARKINGS			
SB	3.180	F	UNK.	UNK.	UNK.		EMPTY POST 6/13								X											REMOVE EMPTY POSTS IN THIS LOCATION			
		F	R2-1	24	30		 6/13	5.00								1		14.75 X									X		
SB	2.779	F	R2-1	24	30		SPEED LIMIT 40 6/13						1		X														
		F	R2-1	24	30		 6/13	5.00								1		13.75 X								REQUIRES VEGETATION CLEARING	X		
SB	2.727	F	W1-6	48	24		<=== LEFT LARGE ARROW 6/13						1		X														
		F	W1-6L	48	24		TRIM 7/7  6/13	8.00								2		29.25 X									X		
SB	2.714	E	W1-6	48	24		RIGHT ===> LARGE ARROW 6/13						1		X														
		E	W1-6R	48	24		TRIM 7/7  6/13	8.00								2		30.00 X									X		
SB	2.576	F	W1-4R	30	30		RIGHT REVERSE CURVE 6/14						1		X														
		F	VD-700	6	10		MILE MARKER 6/14						1																
SB	2.505	F	W1-4R	30	30		 6/14	6.25								1		14.50 X								INSTALL 375 FT SOUTH OF EXISTING	X		
SB	2.476	F	R2-1	24	30		SPEED LIMIT 40 6/14						1		X														
SB	2.466	F	R2-1	24	30		 6/14	5.00								1		14.50 X								INSTALL 53 FT SOUTH OF EXISTING	X		
SB	2.380	F	W1-8	18	24		CHEVRON 6/14						1		X														
		F	VD-700	6	10		MILE MARKER 6/14						1																
SIGN SUMMARY SHEET							SHEET TOTALS	37.25	0.00	0	0	0	8	0	0	8		~~120.0~~ 116.75		0	0.0	0.0	0.0	0.0					
								SF	SF	EA	EA	EA	EA	EA	EA	EA		FT		EA	LB	LB	LB	LB					
VERMONT AGENCY OF TRANSPORTATION							TOWN DIRECTIONAL TOTALS	515.2	0.0	18	11	9	110	0	0	85		1275.0		0		0.0							

PROJECT NAME: **STOWE - BERKSHIRE**
PROJECT NUMBER: **STPG SIGN (49)**
FILE NAME: **02 STOWE VT-108 SB TSS.xls** PLOT DATE: **6/24/2015**
PROJECT MANAGER: **D. BRYANT** DRAWN BY: **J. BLANCHARD**
DESIGNED BY: **J. BLANCHARD** CHECKED **K. KERN**
STOWE SB SHEET 6 SHEET **34** OF **131**

DIRECTION	MILEPOINT	LOCATION CODE (SHEET 2)	SIGN CODE	WIDTH (IN)	HEIGHT (IN)	SHEETING REMARKS	SIGN LEGEND	NEW SIGNS "A"	NEW SIGNS "B"	EXISTING SIGNS RETAIN	EXISTING SIGNS SALVAGE FROM	EXISTING SIGNS SALVAGE TO	EXISTING SIGNS REMOVE	EXIST POST RETAIN	EXIST POST REMOVE	NUMBER OF NEW POSTS	SQUARE STEEL (IN) 1.75 (LB/FT) 1.88	SQUARE STEEL (IN) 2.00 (LB/FT) 2.42	SQUARE STEEL (IN) 2.50 (LB/FT) 3.35	TUBULAR STEEL Ø (IN) FOUNDATION	TUBULAR STEEL Ø (IN) 3.00 (LB/FT) 7.60	TUBULAR STEEL Ø (IN) 3.50 (LB/FT) 9.00	TUBULAR STEEL Ø (IN) 4.00 (LB/FT) 10.80	TUBULAR STEEL Ø (IN) 5.00 (LB/FT) 14.60	SIGN FRAME REQUIRED	REMARKS	SIGN DETAIL LOCATION SHSM	SIGN DETAIL LOCATION PROJECT SHEET #	SIGN DETAIL LOCATION STANDARD SHEET #
STOWE VT-108 SB							FY-FLUORESCENT YELLOW FYG-FLUORESCENT YELLOW GREEN																				"SHSM"-STANDARD HIGHWAY SIGNS AND MARKINGS			
SB	2.370	F	W1-8	18	24		CHEVRON 6/14						1		X														
SB	2.388- 2.320	E/F	N/A	6	8		INSTALL (8) NEW DELINEATOR ASSEMBLIES 6/14																				INSTALL 8 BACK TO BACK DELINEATOR ASSEMBLIES AT 60 FT SPACINGS. SEE SHEET 4			
SB	2.292	E/F	D3-1	UNK.	UNK.		BUTTERNUT LN (PVT)						1		X														
		E/F	D3-1	68	12		 6/14	5.67								2		22.00 X								BUTTERNUT LN (PVT)		11	
SB	2.277	F	VR2-5A	24	30		REDUCED SPEED AHEAD						1		X														
		F	W3-5	36	36		 6/14	9.00								2		29.25 X									X		
SB	2.218	E/F	D3-1	UNK.	UNK.		STROM FARM LN (PVT)						1		X														
		E/F	D3-1	66	12		 6/14	5.50								2		24.75 X								STROM FARM LN (PVT)		11	
SB	2.188	F	R2-1	24	30		SPEED LIMIT 30						1		X														
		F	R2-1	30	36		 6/14	7.50								1		14.75 X									X		
SB	2.174	F	W11-2	30	30		PEDESTRIAN SYMBOL						1		X														
		F	W16-4P	24	18		NEXT 4500 FT						1																
		F	W11-2	30	30	FYG		6.25								1		17.50 X									X		
		F	W16-4P	30	24	FYG	 6/14	5.00																			X		
SB	2.125	F	VD-062AS	72	16		BUSINESS SIGN			1				X															
SIGN SUMMARY SHEET							SHEET TOTALS	38.92	0.00	1	0	0	7	0	0	8		108.25 ~~120.0~~		0	0.0	0.0	0.0	0.0					
								SF	SF	EA	EA	EA	EA	EA	EA	EA		FT		EA	LB	LB	LB	LB					
VERMONT AGENCY OF TRANSPORTATION							TOWN DIRECTIONAL TOTALS	515.2	0.0	18	11	9	110	0	0	85		1275.0		0		0.0							

PROJECT NAME: **STOWE - BERKSHIRE**
PROJECT NUMBER: **STPG SIGN (49)**
FILE NAME: **02 STOWE VT-108 SB TSS.xls** PLOT DATE: **6/24/2015**
PROJECT MANAGER: **D. BRYANT** DRAWN BY: **J. BLANCHARD**
DESIGNED BY: **J. BLANCHARD** CHECKED **K. KERN**
STOWE SB SHEET 7 SHEET **35** OF **131**

DIRECTION	MILEPOINT	LOCATION CODE (SHEET 2)	SIGN CODE	WIDTH (IN)	HEIGHT (IN)	SHEETING REMARKS	SIGN LEGEND	NEW SIGNS "A"	NEW SIGNS "B"	EXISTING SIGNS RETAIN	EXISTING SIGNS SALVAGE FROM	EXISTING SIGNS SALVAGE TO	EXISTING SIGNS REMOVE	EXIST POST RETAIN	EXIST POST REMOVE	NUMBER OF NEW POSTS	SQUARE STEEL (IN) 1.75 (LB/FT) 1.88	SQUARE STEEL (IN) 2.00 (LB/FT) 2.42	SQUARE STEEL (IN) 2.50 (LB/FT) 3.35	TUBULAR STEEL Ø (IN) FOUNDATION	TUBULAR STEEL Ø (IN) 3.00 (LB/FT) 7.60	TUBULAR STEEL Ø (IN) 3.50 (LB/FT) 9.00	TUBULAR STEEL Ø (IN) 4.00 (LB/FT) 10.80	TUBULAR STEEL Ø (IN) 5.00 (LB/FT) 14.60	SIGN FRAME REQUIRED	REMARKS	SIGN DETAIL LOCATION SHSM	SIGN DETAIL LOCATION PROJECT SHEET #	SIGN DETAIL LOCATION STANDARD SHEET #
STOWE VT-108 SB							FY-FLUORESCENT YELLOW FYG-FLUORESCENT YELLOW GREEN																				"SHSM"-STANDARD HIGHWAY SIGNS AND MARKINGS			
		F	VD-062B	72	16		BUSINESS SIGN 6/14			1																			
		F	VD-062B	72	16		BUSINESS SIGN 6/14			1																			
SB	2.101	F	VD-271	72	48		LANE ASSIGNMENT SIGN ALTERNATE ROUTE TO I89 NEXT RIGHT 6/14						1	X				31.00											
		F	VD-271	72	48		TRIM 7/7 (2)  6/14	24.00																				10	
SB	2.061	F	VW1-2M	30	30		MODIFIED LEFT TURN 6/14						1		X														
		F	VW-205	30	30		WATCH FOR TURNING VEHICLES 6/14						1																
		F	W1-10cL	36	36		NEED THIS NB ALSO STOWE PROVIDE SIGN  6/14	9.00								2		30.00 X							X		
		F	W16-8P	28	8		6/14	1.56																				6	
SB	2.036	F	M4-5	24	12		TO INTERSTATE 6/14						1		X														
		F	M1-1	24	24		INTERSTATE 89 6/14						1																
		F	M6-1	21	15		RIGHT ---> INTERSTATE 6/14						1																
		F	M4-5	24	12	WHT/BLU	6/14	2.00								1		16.25 X									X		
		F	M1-1	24	24	WHT/BLU	TO 89  6/14	4.00																			X		
		F	M6-1	21	15	WHT/BLU	6/14	2.19																			X		
SB	2.026	F	VD-062B	72	16		BUSINESS SIGN 6/14			1				X															
							SHEET TOTALS	42.74	0.00	3	0	0	6	0	0	3		77.25 ~~45.0~~		0	0.0	0.0	0.0	0.0					
								SF	SF	EA	EA	EA	EA	EA	EA	EA		FT		EA	LB	LB	LB	LB					
							TOWN DIRECTIONAL TOTALS	515.2	0.0	18	11	9	110	0	0	85		1275.0		0	0.0								

SIGN SUMMARY SHEET

VERMONT AGENCY OF TRANSPORTATION

PROJECT NAME: STOWE - BERKSHIRE
PROJECT NUMBER: STPG SIGN (49)

FILE NAME: 02 STOWE VT-108 SB TSS.xls
PROJECT MANAGER: D. BRYANT
DESIGNED BY: J. BLANCHARD
STOWE SB SHEET 8

PLOT DATE: 6/24/2015
DRAWN BY: J. BLANCHARD
CHECKED K. KERN

DIRECTION	MILEPOINT	LOCATION CODE (SHEET 2)	SIGN CODE	WIDTH (IN)	HEIGHT (IN)	SHEETING REMARKS	SIGN LEGEND	NEW SIGNS "A"	NEW SIGNS "B"	EXISTING SIGNS RETAIN	EXISTING SIGNS SALVAGE FROM	EXISTING SIGNS SALVAGE TO	EXISTING SIGNS REMOVE	EXIST POST RETAIN	EXIST POST REMOVE	NUMBER OF NEW POSTS	SQUARE STEEL (IN) 1.75 (LB/FT) 1.88	SQUARE STEEL (IN) 2.00 (LB/FT) 2.42	SQUARE STEEL (IN) 2.50 (LB/FT) 3.35	TUBULAR STEEL Ø (IN) FOUNDATION	TUBULAR STEEL Ø (IN) 3.00 (LB/FT) 7.60	TUBULAR STEEL Ø (IN) 3.50 (LB/FT) 9.00	TUBULAR STEEL Ø (IN) 4.00 (LB/FT) 10.80	TUBULAR STEEL Ø (IN) 5.00 (LB/FT) 14.60	SIGN FRAME REQUIRED	REMARKS	SIGN DETAIL LOCATION SHSM	SIGN DETAIL LOCATION PROJECT SHEET #	SIGN DETAIL LOCATION STANDARD SHEET #
STOWE VT-108 SB							FY-FLUORESCENT YELLOW FYG-FLUORESCENT YELLOW GREEN																				"SHSM"-STANDARD HIGHWAY SIGNS AND MARKINGS			
SB	2.014	G	VR-017	24	30		LLL 24,000 LBS						1		X														
SB	1.997	G	VR-017	24	30		 6/14	5.00								1		14.50 X									LUCE HILL RD (TH-5); INSTALL 100 FT FROM STOP		9	
SB	1.993	G	R1-1	30	30		STOP						1		X														
		G	R1-1	30	30		 6/14	6.25								1		14.00 X									LUCE HILL RD (TH-5)	X		
SB	1.987	G	R1-1	30	30		STOP						1		X														
		G	R1-1	30	30		 6/14	6.25								1		13.50 X									LUCE HILL RD (TH-5)	X		
SB	1.986	E/F	D3-1	UNK.	UNK.		LUCE HILL RD TH5						1		X														
		E/F	D3-1	50	12		 6/14	4.17								2		21.50 X									LUCE HILL RD (TH-5)		11	
SB	1.981	G	R1-1	30	30		STOP						1		X														
		H	VD-700	6	10		MILE MARKER						1														SALVAGE AND MOUNT ON NEW POST BELOW STOP SIGN			
		G	R1-1	30	30		 6/14	6.25								1		14.00 X									LUCE HILL RD (TH-5)	X		
SB	1.848	F	R2-1	24	30		SPEED LIMIT 30						1		X														
		F	R2-1	24	30		 6/14	5.00								1		14.00 X										X		
SB	1.810	F	VW-622A	36	36		RECREATION TRAIL						1		X														
		F	W1-7	24	18		<===> DOUBLE ARROW						1																		
							SHEET TOTALS	32.92 SF	0.00 SF	0 EA	0 EA	0 EA	9 EA	0 EA	0 EA	7 EA		91.50 ~~105.0~~ FT		0 EA	0.0 LB	0.0 LB	0.0 LB	0.0 LB					
							TOWN DIRECTIONAL TOTALS	515.2	0.0	18	11	9	110	0	0	85		1275.0		0	0.0									


SIGN SUMMARY SHEET

VERMONT AGENCY OF TRANSPORTATION

PROJECT NAME: **STOWE - BERKSHIRE**
PROJECT NUMBER: **STPG SIGN (49)**
FILE NAME: **02 STOWE VT-108 SB TSS.xls** PLOT DATE: **6/24/2015**
PROJECT MANAGER: **D. BRYANT** DRAWN BY: **J. BLANCHARD**
DESIGNED BY: **J. BLANCHARD** CHECKED **K. KERN**
STOWE SB SHEET 9 SHEET **37** OF **131**

DIRECTION	MILEPOINT	LOCATION CODE (SHEET 2)	SIGN CODE	WIDTH (IN)	HEIGHT (IN)	SHEETING REMARKS	SIGN LEGEND	NEW SIGNS "A"	NEW SIGNS "B"	EXISTING SIGNS RETAIN	EXISTING SIGNS SALVAGE FROM	EXISTING SIGNS SALVAGE TO	EXISTING SIGNS REMOVE	EXIST POST RETAIN	EXIST POST REMOVE	NUMBER OF NEW POSTS	SQUARE STEEL (IN) 1.75 (LB/FT) 1.88	SQUARE STEEL (IN) 2.00 (LB/FT) 2.42	SQUARE STEEL (IN) 2.50 (LB/FT) 3.35	TUBULAR STEEL Ø (IN) FOUNDATION	TUBULAR STEEL Ø (IN) 3.00 (LB/FT) 7.60	TUBULAR STEEL Ø (IN) 3.50 (LB/FT) 9.00	TUBULAR STEEL Ø (IN) 4.00 (LB/FT) 10.80	TUBULAR STEEL Ø (IN) 5.00 (LB/FT) 14.60	SIGN FRAME REQUIRED	REMARKS	SIGN DETAIL LOCATION SHSM	SIGN DETAIL LOCATION PROJECT SHEET #	SIGN DETAIL LOCATION STANDARD SHEET #
STOWE VT-108 SB							FY-FLUORESCENT YELLOW FYG-FLUORESCENT YELLOW GREEN																				"SHSM"-STANDARD HIGHWAY SIGNS AND MARKINGS			
		F	VW11-1S	24	18		BICYCLE SYMBOL						1																
		F	W11-15	30	30	FYG		6.25								1		16.75 X									X		
		F	W11-15P	24	18	FYG	TRAIL X-ING 6/14	3.00																			X		
SB	1.777	F	W11-2	30	30		AHEAD WARNING			1				X															
		F	W16-9P	24	10		PEDESTRIAN SYMBOL			1																			
		F	UNK.	UNK.	UNK.		BUS STOP				1		1																
		F	UNK.	UNK.	UNK.		UNKNOWN SIGN 6/14				1		1														SALVAGE AND RETURN TO TOWN			
SB	1.756	F	VD-062AS	72	16		BUSINESS SIGN			1				X															
SB	1.715	F	W11-2	30	30		PEDESTRIAN SYMBOL			1				X															
		F	W16-7P	24	12		DIAGONAL ARROW WARNING			1																			
SB	1.659	F	W11-1	30	30		BICYCLE SYMBOL						1		X														
		F	W16-1P	18	24		SHARE THE ROAD						1																
		F	W11-1	30	30			6.25								1			16.00 X									X		
		F	W16-1P	18	24		SHARE THE ROAD 6/14	3.00																			X		
SB	1.582	F	R2-1	24	30		SPEED LIMIT 30						1		X														
SIGN SUMMARY SHEET							SHEET TOTALS	18.50	0.00	5	2	0	6	0	0	2		~~30.0~~ 32.75		0	0.0	0.0	0.0	0.0					
								SF	SF	EA	EA	EA	EA	EA	EA	EA		FT		EA	LB	LB	LB	LB					
VERMONT AGENCY OF TRANSPORTATION							TOWN DIRECTIONAL TOTALS	515.2	0.0	18	11	9	110	0	0	85		1275.0		0		0.0							

PROJECT NAME: **STOWE - BERKSHIRE**
PROJECT NUMBER: **STPG SIGN (49)**
FILE NAME: **02 STOWE VT-108 SB TSS.xls** PLOT DATE: **6/24/2015**
PROJECT MANAGER: **D. BRYANT** DRAWN BY: **J. BLANCHARD**
DESIGNED BY: **J. BLANCHARD** CHECKED **K. KERN**
STOWE SB SHEET 10 SHEET **38** OF **131**

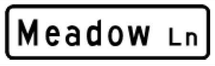DIRECTION	MILEPOINT	LOCATION CODE (SHEET 2)	SIGN CODE	WIDTH (IN)	HEIGHT (IN)	SHEETING REMARKS	SIGN LEGEND	NEW SIGNS "A"	NEW SIGNS "B"	EXISTING SIGNS RETAIN	EXISTING SIGNS SALVAGE FROM	EXISTING SIGNS SALVAGE TO	EXISTING SIGNS REMOVE	EXIST POST RETAIN	EXIST POST REMOVE	NUMBER OF NEW POSTS	SQUARE STEEL (IN) 1.75 (LB/FT) 1.88	SQUARE STEEL (IN) 2.00 (LB/FT) 2.42	SQUARE STEEL (IN) 2.50 (LB/FT) 3.35	TUBULAR STEEL Ø (IN) FOUNDATION	TUBULAR STEEL Ø (IN) 3.00 (LB/FT) 7.60	TUBULAR STEEL Ø (IN) 3.50 (LB/FT) 9.00	TUBULAR STEEL Ø (IN) 4.00 (LB/FT) 10.80	TUBULAR STEEL Ø (IN) 5.00 (LB/FT) 14.60	SIGN FRAME REQUIRED	REMARKS	SIGN DETAIL LOCATION SHSM	SIGN DETAIL LOCATION PROJECT SHEET #	SIGN DETAIL LOCATION STANDARD SHEET #
STOWE VT-108 SB							FY-FLUORESCENT YELLOW FYG-FLUORESCENT YELLOW GREEN																				"SHSM"-STANDARD HIGHWAY SIGNS AND MARKINGS			
		F	R2-1	24	30		 6/14	5.00								1		17.00 X									X		
SB	1.467	F	VR-023B	24	30		$500 FINE FOR THROWING TRASH ON HIGHWAYS AND STREAMS						1		X														
SB	1.462	G	VR-017	24	30		LLL 24,000 LBS						1		X														
SB	1.462	G	VR-017	24	30		 8/15	5.00								1		13.25 X									MEADOW LN (TH-38); INSTALL 50 FROM EXISTING ALONG TH-38		9	
SB	1.461	E/F	D3-1	UNK.	UNK.		MEADOW LN						1		X														
		E/F	D3-1	42	12		 8/15	3.50								1		12.50 X									MEADOW LN (TH-38); FIELD LOCATE FOR VISIBILITY FROM VT-108		12	
SB	1.450	H	R1-1	30	30		STOP						1		X														
		G	VD-700	6	10		MILE MARKER				1	1	1														SALVAGE AND MOUNT ON NEW POST BELOW STOP SIGN			
		H	R1-1	30	30		 8/15	6.25								1		13.50 X									MEADOW LN (TH-38)	X		
SB	1.433	F	W1-4L	30	30		LEFT REVERSE CURVE						1		X														
		F	W1-4L	30	30		 8/24	6.25								1		14.75 X										X		
SB	1.384	F	R2-1	24	30		SPEED LIMIT 30						1		X														
		F	R2-1	24	30		 6/14	5.00								1		15.25 X										X		
SB	1.207	F	VW-205	30	30		WATCH FOR TURNING VEHICLES						1		X														
		F	VW-205	36	36		 6/16	9.00								2		30.25 X											10	
SIGN SUMMARY SHEET							SHEET TOTALS	40.00	0.00	0	1	1	8	0	0	8		~~120.0~~ 116.50		0	0.0	0.0	0.0	0.0					
								SF	SF	EA	EA	EA	EA	EA	EA	EA		FT		EA	LB	LB	LB	LB					
VERMONT AGENCY OF TRANSPORTATION							TOWN DIRECTIONAL TOTALS	515.2	0.0	18	11	9	110	0	0	85		1275.0		0		0.0							

PROJECT NAME: **STOWE - BERKSHIRE**
PROJECT NUMBER: **STPG SIGN (49)**
FILE NAME: **02 STOWE VT-108 SB TSS.xls** PLOT DATE: **6/24/2015**
PROJECT MANAGER: **D. BRYANT** DRAWN BY: **J. BLANCHARD**
DESIGNED BY: **J. BLANCHARD** CHECKED **K. KERN**
STOWE SB SHEET 11 SHEET **39** OF **131**

DIRECTION	MILEPOINT	LOCATION CODE (SHEET 2)	SIGN CODE	WIDTH (IN)	HEIGHT (IN)	SHEETING REMARKS	SIGN LEGEND	NEW SIGNS "A"	NEW SIGNS "B"	EXISTING SIGNS RETAIN	EXISTING SIGNS SALVAGE FROM	EXISTING SIGNS SALVAGE TO	EXISTING SIGNS REMOVE	EXIST POST RETAIN	EXIST POST REMOVE	NUMBER OF NEW POSTS	SQUARE STEEL (IN) 1.75 (LB/FT) 1.88	SQUARE STEEL (IN) 2.00 (LB/FT) 2.42	SQUARE STEEL (IN) 2.50 (LB/FT) 3.35	TUBULAR STEEL Ø (IN) FOUNDATION	TUBULAR STEEL Ø (IN) 3.00 (LB/FT) 7.60	TUBULAR STEEL Ø (IN) 3.50 (LB/FT) 9.00	TUBULAR STEEL Ø (IN) 4.00 (LB/FT) 10.80	TUBULAR STEEL Ø (IN) 5.00 (LB/FT) 14.60	SIGN FRAME REQUIRED	REMARKS	SIGN DETAIL LOCATION SHSM	SIGN DETAIL LOCATION PROJECT SHEET #	SIGN DETAIL LOCATION STANDARD SHEET #
STOWE VT-108 SB							FY-FLUORESCENT YELLOW FYG-FLUORESCENT YELLOW GREEN																			"SHSM"-STANDARD HIGHWAY SIGNS AND MARKINGS			
SB	1.092	G	VR-017	24	30		LLL 24,000 LBS						1		X														
		G	VR-017	24	30		 6/16	5.00								1	13.75 X									BIRCH HILL RD (TH-72)		9	
SB	1.092	E/F	D3-1	52	12		 6/16	4.33									23.25									BIRCH HILL RD (TH-72); FIELD LOCATE FOR VISIBILITY FROM VT-108		12	
SB	1.084	H	R1-1	30	30		STOP						1		X														
		G	VD-700	6	10		MILE MARKER				1	1	1														SALVAGE AND MOUNT ON NEW POST BELOW STOP SIGN			
		H	R1-1	30	30		 6/16	6.25								1	13.50 X									BIRCH HILL RD (TH-72)	X		
SB	1.083	E/F	D3-1	UNK.	UNK.		BIRCH HILL RD						1		X														
SB	1.032	F	R2-1	24	30		SPEED LIMIT 30						1		X														
SB	0.738	F	R2-1	24	30		SPEED LIMIT 30						1		X														
		F	R2-1	24	30		 6/16	5.00								1	14.00 X										X		
SB	0.646	F	M4-1a	24	12		ALT STATE						1		X														
		F	M4-5	24	12		TO STATE						1																
		F	M3-1	24	12		NORTH STATE						1																
		F	M1-5a	30	24		VERMONT 100						1																
		F	M6-1	21	15		<--- LEFT STATE						1																
SIGN SUMMARY SHEET							SHEET TOTALS	20.58	0.00	0	1	1	11	0	0	3	~~45.0~~ 64.50			0	0.0	0.0	0.0	0.0					
								SF	SF	EA	EA	EA	EA	EA	EA	EA	FT			EA	LB	LB	LB	LB					
VERMONT AGENCY OF TRANSPORTATION							TOWN DIRECTIONAL TOTALS	515.2	0.0	18	11	9	110	0	0	85	1275.0			0	0.0								



PROJECT NAME: **STOWE - BERKSHIRE**
PROJECT NUMBER: **STPG SIGN (49)**
FILE NAME: **02 STOWE VT-108 SB TSS.xls** PLOT DATE: **6/24/2015**
PROJECT MANAGER: **D. BRYANT** DRAWN BY: **J. BLANCHARD**
DESIGNED BY: **J. BLANCHARD** CHECKED **K. KERN**
STOWE SB SHEET 12 SHEET **40** OF **131**

DIRECTION	MILEPOINT	LOCATION CODE (SHEET 2)	SIGN CODE	WIDTH (IN)	HEIGHT (IN)	SHEETING REMARKS	SIGN LEGEND	NEW SIGNS "A"	NEW SIGNS "B"	EXISTING SIGNS RETAIN	EXISTING SIGNS SALVAGE FROM	EXISTING SIGNS SALVAGE TO	EXISTING SIGNS REMOVE	EXIST POST RETAIN	EXIST POST REMOVE	NUMBER OF NEW POSTS	SQUARE STEEL (IN) 1.75 (LB/FT) 1.88	SQUARE STEEL (IN) 2.00 (LB/FT) 2.42	SQUARE STEEL (IN) 2.50 (LB/FT) 3.35	TUBULAR STEEL Ø (IN) FOUNDATION	TUBULAR STEEL Ø (IN) 3.00 (LB/FT) 7.60	TUBULAR STEEL Ø (IN) 3.50 (LB/FT) 9.00	TUBULAR STEEL Ø (IN) 4.00 (LB/FT) 10.80	TUBULAR STEEL Ø (IN) 5.00 (LB/FT) 14.60	SIGN FRAME REQUIRED	REMARKS	SIGN DETAIL LOCATION SHSM	SIGN DETAIL LOCATION PROJECT SHEET #	SIGN DETAIL LOCATION STANDARD SHEET #
STOWE VT-108 SB							FY-FLUORESCENT YELLOW FYG-FLUORESCENT YELLOW GREEN																				"SHSM"-STANDARD HIGHWAY SIGNS AND MARKINGS			
		F	M4-1a	24	12	GRN/WHT	6/16	2.00								1			17.00 X									X		
		F	M4-5	24	12	GRN/WHT	 6/16	2.00																			X		
		F	M3-1	24	12	GRN/WHT	 6/16	2.00																			X		
		F	M1-5	30	24	GRN/WHT	6/16	5.00																					E-136B
		F	M6-1	21	15	GRN/WHT	6/16	2.19																			X		
SB	0.589	F	W3-5	36	36		TRIM  6/16	9.00								2		25.50 X								INSTALL 300 FT SOUTH OF ROUTE MARKER ASSEMBLY	X		
SB	0.486	F	R2-1	24	30		SPEED LIMIT 25 6/16						1		X														
		F	R2-1	30	36		 6/16	7.50								1			14.00 X								X		
		F	VR-038	24	18		 6/16	3.00																				9	
SB	0.507		BEGINNING OF CLASS 1 SECTION OF ROADWAY (SOUTHBOUND) NOTE: STICKERS ON BACK OF SIGNS IN CLASS 1 SECTION OF STOWE SHALL HAVE "STOWE, DATE (MM/YY), TH-2"																										
SB	0.392	F	W11-2	30	30	FYG	PEDESTRIAN SYMBOL 6/16						1		X														
		F	W16-7P	24	12	FYG	DOWNWARD DIAGONAL ARROW 6/16						1																
SB	0.375	F	W11-2	30	30	FYG	 6/16	6.25								1		14.50 X								INSTALL ADJACENT TO CROSSWALK	X		
		F	W16-7PL	24	12	FYG	6/16	2.00																			X		
SB	0.146	F	M2-1	21	15	GRN/WHT	TRIM 7/8 6/16	2.19								1		X								INSTALL 68 FT NORTH OF PEDESTRIAN SYMBOL AT M.P. 0.133	X		
SIGN SUMMARY SHEET							SHEET TOTALS	43.13 SF	0.00 SF	0 EA	0 EA	0 EA	3 EA	0 EA	0 EA	6 EA		~~90.0~~ 71.00 FT		0 EA	0.0 LB	0.0 LB	0.0 LB	0.0 LB					
VERMONT AGENCY OF TRANSPORTATION							TOWN DIRECTIONAL TOTALS	515.2	0.0	18	11	9	110	0	0	85		1275.0		0	0.0								

PROJECT NAME: **STOWE - BERKSHIRE**
PROJECT NUMBER: **STPG SIGN (49)**
FILE NAME: **02 STOWE VT-108 SB TSS.xls** PLOT DATE: **6/24/2015**
PROJECT MANAGER: **D. BRYANT** DRAWN BY: **J. BLANCHARD**
DESIGNED BY: **J. BLANCHARD** CHECKED **K. KERN**
STOWE SB SHEET 13 SHEET **41** OF **131**

DIRECTION	MILEPOINT	LOCATION CODE (SHEET 2)	SIGN CODE	WIDTH (IN)	HEIGHT (IN)	SHEETING REMARKS	SIGN LEGEND	NEW SIGNS "A"	NEW SIGNS "B"	EXISTING SIGNS RETAIN	EXISTING SIGNS SALVAGE FROM	EXISTING SIGNS SALVAGE TO	EXISTING SIGNS REMOVE	EXIST POST RETAIN	EXIST POST REMOVE	NUMBER OF NEW POSTS	SQUARE STEEL (IN) 1.75 (LB/FT) 1.88	SQUARE STEEL (IN) 2.00 (LB/FT) 2.42	SQUARE STEEL (IN) 2.50 (LB/FT) 3.35	TUBULAR STEEL Ø (IN) FOUNDATION	TUBULAR STEEL Ø (IN) 3.00 (LB/FT) 7.60	TUBULAR STEEL Ø (IN) 3.50 (LB/FT) 9.00	TUBULAR STEEL Ø (IN) 4.00 (LB/FT) 10.80	TUBULAR STEEL Ø (IN) 5.00 (LB/FT) 14.60	SIGN FRAME REQUIRED	REMARKS	SIGN DETAIL LOCATION SHSM	SIGN DETAIL LOCATION PROJECT SHEET #	SIGN DETAIL LOCATION STANDARD SHEET #
STOWE VT-108 SB							FY-FLUORESCENT YELLOW FYG-FLUORESCENT YELLOW GREEN																			"SHSM"-STANDARD HIGHWAY SIGNS AND MARKINGS			
		F	M1-5	30	24	GRN/WHT	 6/16	5.00										7.25											E-136B
SB	0.133	F	W11-2	30	30	FYG	PEDESTRIAN SYMBOL 6/16						1		X														
		F	W16-7PL	24	12	FYG	DOWNWARD DIAGONAL ARROW 6/16						1																
SB	0.126	F	W1-6	48	24		LARGE LEFT ARROW TRIM 6/16						1		X														
		F	OM1-1	18	18		YELLOW CLUSTER 6/16						1																
		F	W1-6L	48	24		 6/16	8.00								2			22.25 X								X		
SB	0.124	E	W1-6L	48	24		LARGE RIGHT ARROW 6/16						1		X														
		E	OM1-1	18	18		YELLOW CLUSTER 6/16						1																
		E	VD-700	6	10		MILE MARKER 6/16				1	1	1														SALVAGE AND MOUNT ON NEW POST BELOW LARGE RIGHT ARROW			
		E	W1-6R	48	24			8.00								2		22.25 X									X		
SB	0.124 - 0.107	E/F	N/A	6	8		INSTALL (4) NEW DELINEATOR ASSEMBLIES 6/16																				INSTALL 4 BACK TO BACK DELINEATOR ASSEMBLIES AT 30 FT SPACINGS. SEE SHEET 4			
SB	0.122	F	W11-2	30	30	FYG	 6/16	6.25								1		13.25 X									INSTALL ADJACENT TO CROSSWALK	X		
		F	W16-7PL	24	12	FYG	6/16	2.00																				X		
SB	0.084	F	M3-1	24	12	GRN/WHT	TRIM 7/8	2.00								2		31.00 X								2C	INSTALL AT NORTH END OF BRIDGE; REQUIRES VEGETATION CLEARING	X		
		F	M1-5	30	24	GRN/WHT	7/8	5.00																					E-136B
SIGN SUMMARY SHEET							SHEET TOTALS	36.25	0.00	0	1	1	7	0	0	7		~~105.0~~ 96.00		0	0.0	0.0	0.0	0.0					
								SF	SF	EA	EA	EA	EA	EA	EA	EA		FT		EA	LB	LB	LB	LB					
VERMONT AGENCY OF TRANSPORTATION							TOWN DIRECTIONAL TOTALS	515.2	0.0	18	11	9	110	0	0	85		1275.0		0		0.0							

PROJECT NAME: **STOWE - BERKSHIRE**
PROJECT NUMBER: **STPG SIGN (49)**
FILE NAME: **02 STOWE VT-108 SB TSS.xls** PLOT DATE: **6/24/2015**
PROJECT MANAGER: **D. BRYANT** DRAWN BY: **J. BLANCHARD**
DESIGNED BY: **J. BLANCHARD** CHECKED **K. KERN**
STOWE SB SHEET 14 SHEET **42** OF **131**

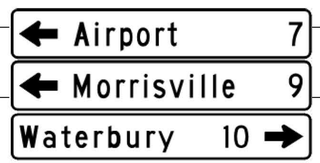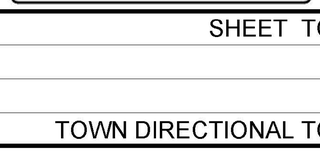DIRECTION	MILEPOINT	LOCATION CODE (SHEET 2)	SIGN CODE	WIDTH (IN)	HEIGHT (IN)	SHEETING REMARKS	SIGN LEGEND	NEW SIGNS "A"	NEW SIGNS "B"	EXISTING SIGNS RETAIN	EXISTING SIGNS SALVAGE FROM	EXISTING SIGNS SALVAGE TO	EXISTING SIGNS REMOVE	EXIST POST RETAIN	EXIST POST REMOVE	NUMBER OF NEW POSTS	SQUARE STEEL (IN) 1.75 (LB/FT) 1.88	SQUARE STEEL (IN) 2.00 (LB/FT) 2.42	SQUARE STEEL (IN) 2.50 (LB/FT) 3.35	TUBULAR STEEL Ø (IN) FOUNDATION	TUBULAR STEEL Ø (IN) 3.00 (LB/FT) 7.60	TUBULAR STEEL Ø (IN) 3.50 (LB/FT) 9.00	TUBULAR STEEL Ø (IN) 4.00 (LB/FT) 10.80	TUBULAR STEEL Ø (IN) 5.00 (LB/FT) 14.60	SIGN FRAME REQUIRED	REMARKS	SIGN DETAIL LOCATION SHSM	SIGN DETAIL LOCATION PROJECT SHEET #	SIGN DETAIL LOCATION STANDARD SHEET #
STOWE VT-108 SB							FY-FLUORESCENT YELLOW FYG-FLUORESCENT YELLOW GREEN																				"SHSM"-STANDARD HIGHWAY SIGNS AND MARKINGS			
		F	M6-1	21	15	GRN/WHT		2.19																			X		
		F	M3-3	24	12	GRN/WHT		2.00																			X		
		F	M1-5	30	24	GRN/WHT		5.00																					E-136B
		F	M6-1	21	15	GRN/WHT		2.19																			X		
SB	0.051	F	W11-2	30	30	FYG	 6/17	6.25								1		15.50 X									X		
		F	W16-7PL	24	12	FYG	6/17	2.00																			X		
SB	0.031	F	VD1-1	72	12		<-- AIRPORT 7 7/8						1		X														
		F	VD1-1	72	12		<-- MORRISVILLE 9 7/8						1																
		F	VD1-1	72	12		WATERBURY 10 --> 7/8						1																
		F	UNK.	UNK.	UNK.		NORTH 100 <-- (90 DEG) 7/8						1																
		F	UNK.	UNK.	UNK.		SOUTH 100 --> (90 DEG) 7/8						1																
		F	UNK.	UNK.	UNK.		TRAVEL INFORMATION <-- 7/8				1	1	1														SALVAGE AND MOUNT BELOW D-BOARD ASSEMBLY			
		F	VD-700	6	10		MILE MARKER 7/8				1	1	1														SALVAGE AND MOUNT TO NEW POST BELOW D-BOARD ASSEMBLY			
		F	VD1-1a	72	12		 7/8	6.00								2		29.25 X									7	
		F	VD1-1a	72	12		 7/8	6.00																			7	
							SHEET TOTALS	31.63 SF	0.00 SF	0 EA	2 EA	2 EA	7 EA	0 EA	0 EA	3 EA		44.75 ~~45.0~~ FT		0 EA	0.0 LB	0.0 LB	0.0 LB	0.0 LB					
							TOWN DIRECTIONAL TOTALS	515.2	0.0	18	11	9	110	0	0	85		1275.0		0	0.0									

SIGN SUMMARY SHEET

VERMONT AGENCY OF TRANSPORTATION

PROJECT NAME: **STOWE - BERKSHIRE**
PROJECT NUMBER: **STPG SIGN (49)**
FILE NAME: **02 STOWE VT-108 SB TSS.xls** PLOT DATE: **6/24/2015**
PROJECT MANAGER: **D. BRYANT** DRAWN BY: **J. BLANCHARD**
DESIGNED BY: **J. BLANCHARD** CHECKED **K. KERN**
STOWE SB SHEET 15 SHEET **43** OF **131**

DIRECTION	MILEPOINT	LOCATION CODE (SHEET 2)	SIGN CODE	WIDTH (IN)	HEIGHT (IN)	SHEETING REMARKS	SIGN LEGEND	NEW SIGNS		EXISTING SIGNS				EXIST POST		NUMBER OF NEW POSTS	SQUARE STEEL (IN)			TUBULAR STEEL Ø (IN)				SIGN FRAME REQUIRED	REMARKS	SIGN DETAIL LOCATION		
								"A"	"B"	RETAIN	SALVAGE FROM	SALVAGE TO	REMOVE	RETAIN	REMOVE		1.75	2.00	2.50	FOUNDATION	3.00	3.50	4.00	5.00			SHSM	PROJECT SHEET #	STANDARD SHEET #
																	(LB / FT)				(LB / FT)								
																	1.88	2.42	3.35		7.60	9.00	10.80	14.60					
STOWE VT-108 SB							FY-FLUORESCENT YELLOW FYG-FLUORESCENT YELLOW GREEN																			"SHSM"-STANDARD HIGHWAY SIGNS AND MARKINGS			
		F	VD1-1a	72	12			6.00																				7	
SB	0.000	F	R1-1	30	30		STOP 8/1						1		X											RETAIN FLASHING BEACON			
		F	UNK.	UNK.	UNK.		3-WAY 8/1						1																
		F	VD-700	6	10		MILE MARKER 8/1				1	1	1													SALVAGE AND MOUNT ON NEW POST BELOW ALL WAY SIGN			
		F	R1-1	30	30		STOP / ALL WAY 8/1	6.25								1		16.00 X									X		
		F	R1-3P	18	6		8/15	0.75																			X		
SB	0.000						END OF CLASS 1 AND BEGINNING OF STATE SECTION OF ROADWAY (SOUTHBOUND).																							
SIGN SUMMARY SHEET							SHEET TOTALS	13.00	0.00	0	1	1	3	0	0	1		~~16.00~~ 15.0		0	0.0	0.0	0.0	0.0					
								SF	SF	EA	EA	EA	EA	EA	EA	EA		FT		EA	LB	LB	LB	LB					
VERMONT AGENCY OF TRANSPORTATION							TOWN DIRECTIONAL TOTALS	515.2	0.0	18	11	9	110	0	0	85		1275.0		0		0.0							

PROJECT NAME: **STOWE - BERKSHIRE**
PROJECT NUMBER: **STPG SIGN (49)**
FILE NAME: **02 STOWE VT-108 SB TSS.xls** PLOT DATE: **6/24/2015**
PROJECT MANAGER: **D. BRYANT** DRAWN BY: **J. BLANCHARD**
DESIGNED BY: **J. BLANCHARD** CHECKED **K. KERN**
STOWE SB SHEET 16 SHEET **44** OF **131**

DIRECTION	MILEPOINT	LOCATION CODE (SHEET 2)	SIGN CODE	WIDTH (IN)	HEIGHT (IN)	SHEETING REMARKS	SIGN LEGEND	NEW SIGNS "A"	NEW SIGNS "B"	EXISTING SIGNS RETAIN	EXISTING SIGNS SALVAGE FROM	EXISTING SIGNS SALVAGE TO	EXISTING SIGNS REMOVE	EXIST POST RETAIN	EXIST POST REMOVE	NUMBER OF NEW POSTS	SQUARE STEEL (IN) 1.75 (LB/FT) 1.88	SQUARE STEEL (IN) 2.00 (LB/FT) 2.42	SQUARE STEEL (IN) 2.50 (LB/FT) 3.35	TUBULAR STEEL Ø (IN) FOUNDATION	TUBULAR STEEL Ø (IN) 3.00 (LB/FT) 7.60	TUBULAR STEEL Ø (IN) 3.50 (LB/FT) 9.00	TUBULAR STEEL Ø (IN) 4.00 (LB/FT) 10.80	TUBULAR STEEL Ø (IN) 5.00 (LB/FT) 14.60	SIGN FRAME REQUIRED	REMARKS	SIGN DETAIL LOCATION SHSM	SIGN DETAIL LOCATION PROJECT SHEET #	SIGN DETAIL LOCATION STANDARD SHEET #
CAMBRIDGE VT-108 NB							FY-FLUORESCENT YELLOW FYG-FLUORESCENT YELLOW GREEN																				"SHSM"-STANDARD HIGHWAY SIGNS AND MARKINGS			
NB	0.000	C	VD-024	60	7.5		CAMBRIDGE/STOWE						1		2 X														
		C	VD-024	72	10		Cambridge | Stowe 6/10	5.00								2		23.25 X										6	
		C	VD-700	6	10		1080 0802 0000 … 1080 0808 0863 6/10	0.42																					T-44
		C	VD-700	6	10		6/10	0.42																					T-44
NB	0.152	A	W11-	30	30	FYG	5/25	6.25								1			16.50 X							INSTALL 800 FT NORTH OF TOWN LINE SIGN	X		
		A	W16-4P	30	24	FYG	TRIM NEXT 1500 FT 5/25	5.00																			X		
NB	0.199	A	W5-1	30	30		ROAD NARROWS 5/25						1		X														
		A	W5-1	36	36		TRIM ROAD NARROWS 5/25	9.00								2		29.50 X									X		
NB	0.247	A	W7-3aP	24	18		NEXT 2 MILES 5/25						1		X														
		A	W1-5R	30	30		RIGHT WINDING CURVES 5/25						1																
		A	W1-5R	30	30	FY	TRIM 5/25	6.25								1			14.25 X								X		
		A	W7-3aP	24	18	FY	NEXT 2 MILES 5/25	3.00																			X		
NB	0.287	A	W8-12	30	30		NO CENTER STRIPE TRIM 7/6 5/25						1		X														
		A	W8-12	36	36	FY	NO CENTER LINE 5/25	9.00								2		28.00 X									X		
NB	0.432	A	VW-285	30	30	FY	FALLING ROCK SYMBOL 5/25			1				X															
SIGN SUMMARY SHEET							SHEET TOTALS	44.33	0.00	1	0	0	5	0	~~0~~ 2	8		~~120.0~~ 111.50		0	0.0	0.0	0.0	0.0					
								SF	SF	EA	EA	EA	EA	EA	EA	EA		FT		EA	LB	LB	LB	LB					
VERMONT AGENCY OF TRANSPORTATION							TOWN DIRECTIONAL TOTALS	611.0	0.0	29	13	10	140	0	0	110		1650.0		0		0.0							

PROJECT NAME: **STOWE - BERKSHIRE**
PROJECT NUMBER: **STPG SIGN (49)**
FILE NAME: **03 CAMBRIDGE VT-108 NB TS** PLOT DATE: **4/15/2015**
PROJECT MANAGER: **D. BRYANT** DRAWN BY: **J. BLANCHARD**
DESIGNED BY: **J. BLANCHARD** CHECKED **K. KERN**
CAMBRIDGE NB SHEET 1 SHEET **45** OF **131**

DIRECTION	MILEPOINT	LOCATION CODE (SHEET 2)	SIGN CODE	WIDTH (IN)	HEIGHT (IN)	SHEETING REMARKS	SIGN LEGEND	NEW SIGNS "A"	NEW SIGNS "B"	EXISTING SIGNS RETAIN	EXISTING SIGNS SALVAGE FROM	EXISTING SIGNS SALVAGE TO	EXISTING SIGNS REMOVE	EXIST POST RETAIN	EXIST POST REMOVE	NUMBER OF NEW POSTS	SQUARE STEEL (IN) 1.75 (LB/FT) 1.88	SQUARE STEEL (IN) 2.00 (LB/FT) 2.42	SQUARE STEEL (IN) 2.50 (LB/FT) 3.35	TUBULAR STEEL Ø (IN) FOUNDATION	TUBULAR STEEL Ø (IN) 3.00 (LB/FT) 7.60	TUBULAR STEEL Ø (IN) 3.50 (LB/FT) 9.00	TUBULAR STEEL Ø (IN) 4.00 (LB/FT) 10.80	TUBULAR STEEL Ø (IN) 5.00 (LB/FT) 14.60	SIGN FRAME REQUIRED	REMARKS	SIGN DETAIL LOCATION SHSM	SIGN DETAIL LOCATION PROJECT SHEET #	SIGN DETAIL LOCATION STANDARD SHEET #
CAMBRIDGE VT-108 NB							FY-FLUORESCENT YELLOW FYG-FLUORESCENT YELLOW GREEN																				"SHSM"-STANDARD HIGHWAY SIGNS AND MARKINGS			
		A	W7-3aP	24	18	FY	NEXT 1 MILE			1																			
NB	0.832	A	W11-2	30	30	FYG	PEDESTRIAN SYMBOL 5/25						1		X														
		A	W16-4P	24	18	FYG	NEXT 2000 FT 5/25						1																
		A	W11-2	30	30	FYG	 TRIM 5/25	6.25								1			13.75 X							X		
		A	W16-4P	30	24	FYG	5/25	5.00																		X		
NB	1.052	A	W7-1	30	30		HILL SYMBOL TRIM 7/6 5/25						1		X														
		A	W7-2a	24	18		USE LOW GEAR 5/25						1																
		A	W7-1a	30	30	FY	 TRIM 5/25	6.25								1			13.75 X							X		
		A	W7-3aP	24	18	FY	 5/25	3.00																		X		
NB	1.544	A	R2-1	24	30		SPEED LIMIT 40 TRIM 7/6 5/25						1		X														
		A	R2-1	24	30		 TRIM 5/25	5.00								1			12.25 X							REQUIRES VEGETATION CLEARING (SEE GENERAL NOTE 5 ON SHEET 2)	X		
NB	1.999	A	R2-1	24	30		SPEED LIMIT 40 5/25			1				X															
NB	2.128	A	W1-4R	36	36		RIGHT REVERSE CURVE 5/25						1		X														
		A	W13-1P	24	24		35 MPH TRIM 7/6 5/25						1																	
		A	W1-4R	30	30		5/25	6.25								1			14.75 X							REQUIRES VEGETATION CLEARING (SEE GENERAL NOTE 5 ON SHEET 2)	X		
SIGN SUMMARY SHEET							SHEET TOTALS	31.75	0.00	2	0	0	7	0	0	4			54.50 ~~60.0~~	0	0.0	0.0	0.0	0.0				
								SF	SF	EA	EA	EA	EA	EA	EA	EA			FT	EA	LB	LB	LB	LB				
VERMONT AGENCY OF TRANSPORTATION							TOWN DIRECTIONAL TOTALS	611.0	0.0	29	13	10	140	0	0	110			1650.0	0			0.0				

PROJECT NAME: **STOWE - BERKSHIRE**
PROJECT NUMBER: **STPG SIGN (49)**
FILE NAME: **03 CAMBRIDGE VT-108 NB TS** PLOT DATE: **4/15/2015**
PROJECT MANAGER: **D. BRYANT** DRAWN BY: **J. BLANCHARD**
DESIGNED BY: **J. BLANCHARD** CHECKED **K. KERN**
CAMBRIDGE NB SHEET 2 SHEET **46** OF **131**

DIRECTION	MILEPOINT	LOCATION CODE (SHEET 2)	SIGN CODE	WIDTH (IN)	HEIGHT (IN)	SHEETING REMARKS	SIGN LEGEND	NEW SIGNS "A"	NEW SIGNS "B"	EXISTING SIGNS RETAIN	EXISTING SIGNS SALVAGE FROM	EXISTING SIGNS SALVAGE TO	EXISTING SIGNS REMOVE	EXIST POST RETAIN	EXIST POST REMOVE	NUMBER OF NEW POSTS	SQUARE STEEL (IN) 1.75 (LB / FT) 1.88	SQUARE STEEL (IN) 2.00 (LB / FT) 2.42	SQUARE STEEL (IN) 2.50 (LB / FT) 3.35	TUBULAR STEEL Ø (IN) FOUNDATION	TUBULAR STEEL Ø (IN) 3.00 (LB / FT) 7.60	TUBULAR STEEL Ø (IN) 3.50 (LB / FT) 9.00	TUBULAR STEEL Ø (IN) 4.00 (LB / FT) 10.80	TUBULAR STEEL Ø (IN) 5.00 (LB / FT) 14.60	SIGN FRAME REQUIRED	REMARKS	SIGN DETAIL LOCATION SHSM	SIGN DETAIL LOCATION PROJECT SHEET #	SIGN DETAIL LOCATION STANDARD SHEET #
CAMBRIDGE VT-108 NB							FY-FLUORESCENT YELLOW FYG-FLUORESCENT YELLOW GREEN																				"SHSM"-STANDARD HIGHWAY SIGNS AND MARKINGS			
		A	W13-1P	18	18			2.25																			X		
NB	2.198	B	R11-2	48	30		ROAD CLOSED 7/6						1														EXISTING SIGNS MOUNTED TO GATE			
		B	OM4-1	18	18		RED CLUSTER 7/6						1																	
		B	OM4-2	18	18		7/6	2.25																			MOUNT TO SWING GATE AT THIS LOCATION; INCIDENTAL TO SIGN ITEM	X		
		B	R8-4	30	24		 7/6	5.00																			X		
		B	OM4-2	18	18		7/6	2.25																			X		
NB	2.206	A	VR-020	24	30		NO PARKING ON TRAVELED LANE TRIM 7/6 5/24						1		X															
		A	VR-020	24	30		 5/24	5.00								1		17.50 X											9	
NB	2.295	A	VR-020	24	30		NO PARKING ON TRAVELED LANE 5/24						1		X															
		A	VR-020	24	30		TRIM  5/24	5.00								1		14.25 X											9	
NB	2.340	A	R2-1	24	30		SPEED LIMIT 40						1		X															
		A	R2-1	24	30		 TRIM 7/6 5/24	5.00								1		10.75 X									REQUIRES VEGETATION CLEARING	X		
NB	2.381	A	VR-020	24	30		NO PARKING ON TRAVELED LANE 5/24						1		X															
		A	VR-020	24	30		 TRIM 7/6 5/24	5.00								1		15.25 X									REQUIRES VEGETATION CLEARING		9	
NB	2.427	A	VW-060	30	30		HIDDEN DRIVES 5/24						1		X															
SIGN SUMMARY SHEET							SHEET TOTALS	31.75	0.00	0	0	0	7	0	0	4		57.75 ~~60.0~~		0	0.0	0.0	0.0	0.0					
								SF	SF	EA	EA	EA	EA	EA	EA	EA		FT		EA	LB	LB	LB	LB					
VERMONT AGENCY OF TRANSPORTATION							TOWN DIRECTIONAL TOTALS	611.0	0.0	29	13	10	140	0	0	110		1650.0		0		0.0							

PROJECT NAME: **STOWE - BERKSHIRE**
PROJECT NUMBER: **STPG SIGN (49)**
FILE NAME: **03 CAMBRIDGE VT-108 NB TS** PLOT DATE: **4/15/2015**
PROJECT MANAGER: **D. BRYANT** DRAWN BY: **J. BLANCHARD**
DESIGNED BY: **J. BLANCHARD** CHECKED **K. KERN**
CAMBRIDGE NB SHEET 3 SHEET **47** OF **131**

DIRECTION	MILEPOINT	LOCATION CODE (SHEET 2)	SIGN CODE	WIDTH (IN)	HEIGHT (IN)	SHEETING REMARKS	SIGN LEGEND	NEW SIGNS "A"	NEW SIGNS "B"	EXISTING SIGNS RETAIN	EXISTING SIGNS SALVAGE FROM	EXISTING SIGNS SALVAGE TO	EXISTING SIGNS REMOVE	EXIST POST RETAIN	EXIST POST REMOVE	NUMBER OF NEW POSTS	SQUARE STEEL (IN) 1.75 (LB/FT) 1.88	SQUARE STEEL (IN) 2.00 (LB/FT) 2.42	SQUARE STEEL (IN) 2.50 (LB/FT) 3.35	TUBULAR STEEL Ø (IN) FOUNDATION	TUBULAR STEEL Ø (IN) 3.00 (LB/FT) 7.60	TUBULAR STEEL Ø (IN) 3.50 (LB/FT) 9.00	TUBULAR STEEL Ø (IN) 4.00 (LB/FT) 10.80	TUBULAR STEEL Ø (IN) 5.00 (LB/FT) 14.60	SIGN FRAME REQUIRED	REMARKS	SIGN DETAIL LOCATION SHSM	SIGN DETAIL LOCATION PROJECT SHEET #	SIGN DETAIL LOCATION STANDARD SHEET #
CAMBRIDGE VT-108 NB							FY-FLUORESCENT YELLOW FYG-FLUORESCENT YELLOW GREEN																				"SHSM"-STANDARD HIGHWAY SIGNS AND MARKINGS			
		A	W8-2	24	24		BUMP 5/24						2 ~~1~~																
		A	VW-060	30	30		TRIM 7/6 5/24	6.25								1		15.75 X									10	
NB	2.447	A	VR-020	24	30		NO PARKING ON TRAVELED LANE 5/24						1		X														
		A	VR-020	24	30		 5/24	5.00								1		14.00 X									9	
NB	2.519	A	VR-020	24	30		NO PARKING ON TRAVELED LANE 5/24						1		X														
		A	VR-020	24	30		 5/24	5.00								1		13.25 X									9	
NB	2.545	A	R2-1	24	30		SPEED LIMIT 50 5/24						1		X														
		A	R2-1	24	30		ALSO PED NEXT 500 FEET  5/24	5.00								1		13.50 X									X	
NB	2.573	A	VR-020	24	30		NO PARKING ON TRAVELED LANE 7/7						1		X														
		A	VR-020	24	30		TRIM  7/7	5.00								1		13.75 X									9	
NB	2.665	A	VR-020	24	30		NO PARKING ON TRAVELED LANE						1		X														
		A	VR-020	24	30		TRIM  5/24	5.00								1		X									9	
NB	2.698	B	W1-6	48	24		RIGHT ===> LARGE ARROW 5/24						1		X														
		B	UNK.	UNK.	UNK.		PARKING 5/24				1		1														SALVAGE AND RETURN TO TOWN		
		B	UNK.	UNK.	UNK.		RIGHT ARROW 5/24				1		1														SALVAGE AND RETURN TO TOWN		
SIGN SUMMARY SHEET							SHEET TOTALS	31.25	0.00	0	2	0	~~9~~ 10	0	0	6		~~90.0~~ 70.25		0	0.0	0.0	0.0	0.0					
								SF	SF	EA	EA	EA	EA	EA	EA	EA		FT		EA	LB	LB	LB	LB					
VERMONT AGENCY OF TRANSPORTATION							TOWN DIRECTIONAL TOTALS	611.0	0.0	29	13	10	140	0	0	110		1650.0		0		0.0							

PROJECT NAME: **STOWE - BERKSHIRE**
PROJECT NUMBER: **STPG SIGN (49)**
FILE NAME: **03 CAMBRIDGE VT-108 NB TS** PLOT DATE: **4/15/2015**
PROJECT MANAGER: **D. BRYANT** DRAWN BY: **J. BLANCHARD**
DESIGNED BY: **J. BLANCHARD** CHECKED **K. KERN**
CAMBRIDGE NB SHEET 4 SHEET **48** OF **131**

DIRECTION	MILEPOINT	LOCATION CODE (SHEET 2)	SIGN CODE	WIDTH (IN)	HEIGHT (IN)	SHEETING REMARKS	SIGN LEGEND	NEW SIGNS "A"	NEW SIGNS "B"	EXISTING SIGNS RETAIN	EXISTING SIGNS SALVAGE FROM	EXISTING SIGNS SALVAGE TO	EXISTING SIGNS REMOVE	EXIST POST RETAIN	EXIST POST REMOVE	NUMBER OF NEW POSTS	SQUARE STEEL (IN) 1.75 (LB/FT) 1.88	SQUARE STEEL (IN) 2.00 (LB/FT) 2.42	SQUARE STEEL (IN) 2.50 (LB/FT) 3.35	TUBULAR STEEL Ø (IN) FOUNDATION	TUBULAR STEEL Ø (IN) 3.00 (LB/FT) 7.60	TUBULAR STEEL Ø (IN) 3.50 (LB/FT) 9.00	TUBULAR STEEL Ø (IN) 4.00 (LB/FT) 10.80	TUBULAR STEEL Ø (IN) 5.00 (LB/FT) 14.60	SIGN FRAME REQUIRED	REMARKS	SIGN DETAIL LOCATION SHSM	SIGN DETAIL LOCATION PROJECT SHEET #	SIGN DETAIL LOCATION STANDARD SHEET #
CAMBRIDGE VT-108 NB							FY-FLUORESCENT YELLOW FYG-FLUORESCENT YELLOW GREEN																				"SHSM"-STANDARD HIGHWAY SIGNS AND MARKINGS			
		B	W1-6R	48	24		 5/24	8.00								2		21.50 X									INSTALL 10 FT CLOSER TO VT108	X		
NB	2.731	A	VR-020	24	30		NO PARKING ON TRAVELED LANE 5/24						1		X														
		A	VR-020	24	30		 TRIM 7/6 5/24	5.00								1		14.25 X										9	
NB	2.822	A	VR-020	24	30		NO PARKING ON TRAVELED LANE 5/24						1		X														
		A	VR-020	24	30		 5/24	5.00								1		14.00 X										9	
NB	3.470	A	W3-5	36	36		 5/24	9.00								2		26.75 X									INSTALL 127 FT SOUTH OF EXISTING	X		
NB	3.494	A	W3-5	36	36		SPEED REDUCTION SPEED LIMIT 40 5/24						1		X														
NB	3.565	A	R2-1	24	30		SPEED LIMIT 40 5/24						1		X														
		A	R2-1	30	36		TRIM  5/24	7.50								1		15.75 X										X	
NB	3.627	A	R2-1	24	30		SPEED LIMIT 40 5/24						1		X														
NB	3.684	A	W11-2	30	30	FYG	PEDESTRIAN SYMBOL 5/24						1		X														
		A	W7-3aP	24	18	FYG	NEXT 1/2 MILE 5/24						1																
		A	W11-2	30	30	FYG	TRIM  5/24	6.25								1			15.75 X									X	
		A	W7-3aP	24	18	FYG	 5/24	3.00																				X	
NB	3.725	A	VW-205	36	36		WATCH FOR TURNING VEHICLES 5/24						1		X														
SIGN SUMMARY SHEET							SHEET TOTALS	43.75	0.00	0	0	0	8	0	0	8		108.00 ~~120.0~~		0	0.0	0.0	0.0	0.0					
								SF	SF	EA	EA	EA	EA	EA	EA	EA		FT		EA	LB	LB	LB	LB					
VERMONT AGENCY OF TRANSPORTATION							TOWN DIRECTIONAL TOTALS	611.0	0.0	29	13	10	140	0	0	110		1650.0		0		0.0							

PROJECT NAME: **STOWE - BERKSHIRE**
PROJECT NUMBER: **STPG SIGN (49)**
FILE NAME: **03 CAMBRIDGE VT-108 NB TS** PLOT DATE: **4/15/2015**
PROJECT MANAGER: **D. BRYANT** DRAWN BY: **J. BLANCHARD**
DESIGNED BY: **J. BLANCHARD** CHECKED **K. KERN**
CAMBRIDGE NB SHEET 5 SHEET **49** OF **131**

DIRECTION	MILEPOINT	LOCATION CODE (SHEET 2)	SIGN CODE	WIDTH (IN)	HEIGHT (IN)	SHEETING REMARKS	SIGN LEGEND	NEW SIGNS "A"	NEW SIGNS "B"	EXISTING SIGNS RETAIN	EXISTING SIGNS SALVAGE FROM	EXISTING SIGNS SALVAGE TO	EXISTING SIGNS REMOVE	EXIST POST RETAIN	EXIST POST REMOVE	NUMBER OF NEW POSTS	SQUARE STEEL (IN) 1.75 (LB/FT) 1.88	SQUARE STEEL (IN) 2.00 (LB/FT) 2.42	SQUARE STEEL (IN) 2.50 (LB/FT) 3.35	TUBULAR STEEL Ø (IN) FOUNDATION	TUBULAR STEEL Ø (IN) 3.00 (LB/FT) 7.60	TUBULAR STEEL Ø (IN) 3.50 (LB/FT) 9.00	TUBULAR STEEL Ø (IN) 4.00 (LB/FT) 10.80	TUBULAR STEEL Ø (IN) 5.00 (LB/FT) 14.60	SIGN FRAME REQUIRED	REMARKS	SIGN DETAIL LOCATION SHSM	SIGN DETAIL LOCATION PROJECT SHEET #	SIGN DETAIL LOCATION STANDARD SHEET #
CAMBRIDGE VT-108 NB							FY-FLUORESCENT YELLOW FYG-FLUORESCENT YELLOW GREEN																			"SHSM"-STANDARD HIGHWAY SIGNS AND MARKINGS			
		A	W13-1P	18	18		40 MPH 5/16						1																
		A	VW-205	36	36		TRIM  5/26	9.00								2		31.25 X									10	
NB	3.764	A	W11-7	30	30		EQUESTRIAN SYMBOL						1		X														
		A	W16-4P	24	18		NEXT 2000 FT						1																
		A	W11-7	30	30		TRIM 7/6  8/16	6.25								1			19.00 X								X	
		A	W16-4P	30	24		8/16	5.00																				X	
NB	3.802	A	VD-062BM	72	16		BUSINESS SIGN			1				X															
		A	VD-062M	72	16		BUSINESS SIGN			1																			
		A	VD-062M	72	16		BUSINESS SIGN			1																			
NB	3.840	A	VD-062M	72	16		BUSINESS SIGN			1				X															
		A	VD-062M	72	16		BUSINESS SIGN			1																			
		A	VD-062BM	72	16		BUSINESS SIGN			1																			
NB	3.882	A	W11-2	30	30	FYG	PEDESTRIAN SYMBOL 5/26						1		X														
		A	W16-7P	24	12	FYG	DIAGONAL ARROW WARNING 5/26						1																
		A	W11-2	30	30	FYG	TRIM  5/26	6.25								1		16.75 X								REQUIRES VEGETATION CLEARING	X		
SIGN SUMMARY SHEET							SHEET TOTALS	26.50 SF	0.00 SF	6 EA	0 EA	0 EA	5 EA	0 EA	0 EA	4 EA		67.00 ~~60.0~~ FT		0 EA	0.0 LB	0.0 LB	0.0 LB	0.0 LB					
VERMONT AGENCY OF TRANSPORTATION							TOWN DIRECTIONAL TOTALS	611.0	0.0	29	13	10	140	0	0	110		1650.0		0	0.0							

PROJECT NAME: **STOWE - BERKSHIRE**
PROJECT NUMBER: **STPG SIGN (49)**
FILE NAME: **03 CAMBRIDGE VT-108 NB TS** PLOT DATE: **4/15/2015**
PROJECT MANAGER: **D. BRYANT** DRAWN BY: **J. BLANCHARD**
DESIGNED BY: **J. BLANCHARD** CHECKED **K. KERN**
CAMBRIDGE NB SHEET 6 SHEET **60** OF **131**

DIRECTION	MILEPOINT	LOCATION CODE (SHEET 2)	SIGN CODE	WIDTH (IN)	HEIGHT (IN)	SHEETING REMARKS	SIGN LEGEND	NEW SIGNS "A"	NEW SIGNS "B"	EXISTING SIGNS RETAIN	EXISTING SIGNS SALVAGE FROM	EXISTING SIGNS SALVAGE TO	EXISTING SIGNS REMOVE	EXIST POST RETAIN	EXIST POST REMOVE	NUMBER OF NEW POSTS	SQUARE STEEL (IN) 1.75 (LB/FT) 1.88	SQUARE STEEL (IN) 2.00 (LB/FT) 2.42	SQUARE STEEL (IN) 2.50 (LB/FT) 3.35	TUBULAR STEEL Ø (IN) FOUNDATION	TUBULAR STEEL Ø (IN) 3.00 (LB/FT) 7.60	TUBULAR STEEL Ø (IN) 3.50 (LB/FT) 9.00	TUBULAR STEEL Ø (IN) 4.00 (LB/FT) 10.80	TUBULAR STEEL Ø (IN) 5.00 (LB/FT) 14.60	SIGN FRAME REQUIRED	REMARKS	SIGN DETAIL LOCATION SHSM	SIGN DETAIL LOCATION PROJECT SHEET #	SIGN DETAIL LOCATION STANDARD SHEET #
CAMBRIDGE VT-108 NB							FY-FLUORESCENT YELLOW FYG-FLUORESCENT YELLOW GREEN																				"SHSM"-STANDARD HIGHWAY SIGNS AND MARKINGS			
		A	W16-7P	24	12	FYG	5/26	2.00																				X		
NB	4.058	C	VR-017	24	30		TRIM LEGAL LOAD LIMIT 24,000 POUNDS 5/26	5.00								1		13.50 X									OLD 108 LOOP (TH-76); INSTALL 10 FT FROM BUSINESS SIGN		9	
NB	4.063	A	R1-1	30	30		STOP 5/26						1		X															
		B	VD-700	6	10		MILE MARKER 5/26				1	1	1														SALVAGE AND MOUNT ON NEW POST BELOW STOP SIGN			
		A	R1-1	30	30		STOP 5/26	6.25								1		13.50 X									OLD 108 LOOP (TH-76)	X		
NB	4.063	A/B	D3-1	54	12		Old 108 Loop 5/26	4.50								2		22.25 X									OLD 108 LOOP (TH-76); FIELD LOCATE FOR VISIBILITY FROM VT 108		12	
NB	4.156	C	VR-017	24	30		LLL 24,000 LBS 5/26						1		X															
		C	VR-017	24	30		LEGAL LOAD LIMIT 24,000 POUNDS 5/26	5.00								1		14.50 X									OLD 108 LOOP (TH-76)		9	
NB	4.159	C/D	D3-1	UNK.	UNK.		VT RTE 108 S 5/26						1		X															
		A/B	D3-1	UNK.	UNK.		OLD 108 LOOP 5/26						1																		
		A/B	D3-1	54	12		Old 108 Loop 5/26	4.50								2		27.75 X									OLD 108 LOOP (TH-76)		12	
NB	4.163	D	R1-1	30	30		STOP 5/26	6.25								1		14.25 X									OLD 108 LOOP (TH-76); INSTALL 20 FT FROM STREET NAME SIGN	X		
NB	4.289	A/B	D3-1	UNK.	UNK.		NOTCH VIEW RD 5/26						1		X															
		A/B	D3-1	68	12		Notch View Rd PVT 5/26	5.67								2		26.50 X									NOTCH VIEW RD (PVT)		12	
NB	4.318	A	R2-1	24	30		SPEED LIMIT 50 5/26						1		X															
							SHEET TOTALS	39.17 SF	0.00 SF	0 EA	1 EA	1 EA	7 EA	0 EA	0 EA	10 EA		~~150.0~~ 132.25 FT		0 EA	0.0 LB	0.0 LB	0.0 LB	0.0 LB					
							TOWN DIRECTIONAL TOTALS	611.0	0.0	29	13	10	140	0	0	110		1650.0		0	0.0										

SIGN SUMMARY SHEET

VERMONT AGENCY OF TRANSPORTATION

PROJECT NAME: **STOWE - BERKSHIRE**
PROJECT NUMBER: **STPG SIGN (49)**
FILE NAME: **03 CAMBRIDGE VT-108 NB TS** PLOT DATE: **4/15/2015**
PROJECT MANAGER: **D. BRYANT** DRAWN BY: **J. BLANCHARD**
DESIGNED BY: **J. BLANCHARD** CHECKED **K. KERN**
CAMBRIDGE NB SHEET 7 SHEET **51** OF **131**

DIRECTION	MILEPOINT	LOCATION CODE (SHEET 2)	SIGN CODE	WIDTH (IN)	HEIGHT (IN)	SHEETING REMARKS	SIGN LEGEND	NEW SIGNS "A"	NEW SIGNS "B"	EXISTING SIGNS RETAIN	EXISTING SIGNS SALVAGE FROM	EXISTING SIGNS SALVAGE TO	EXISTING SIGNS REMOVE	EXIST POST RETAIN	EXIST POST REMOVE	NUMBER OF NEW POSTS	SQUARE STEEL (IN) 1.75 (LB/FT) 1.88	SQUARE STEEL (IN) 2.00 (LB/FT) 2.42	SQUARE STEEL (IN) 2.50 (LB/FT) 3.35	TUBULAR STEEL Ø (IN) FOUNDATION	TUBULAR STEEL Ø (IN) 3.00 (LB/FT) 7.60	TUBULAR STEEL Ø (IN) 3.50 (LB/FT) 9.00	TUBULAR STEEL Ø (IN) 4.00 (LB/FT) 10.80	TUBULAR STEEL Ø (IN) 5.00 (LB/FT) 14.60	SIGN FRAME REQUIRED	REMARKS	SIGN DETAIL LOCATION SHSM	SIGN DETAIL LOCATION PROJECT SHEET #	SIGN DETAIL LOCATION STANDARD SHEET #
CAMBRIDGE VT-108 NB							FY-FLUORESCENT YELLOW FYG-FLUORESCENT YELLOW GREEN																				"SHSM"-STANDARD HIGHWAY SIGNS AND MARKINGS			
		A	R2-1	24	30		TRIM  5/26	5.00								1		13.75 X									X		
NB	4.395	A	VD-062B	72	16		BUSINESS SIGN 5/26			1				X															
		A	VD-062B	72	16		BUSINESS SIGN 5/26			1																			
		A	VD-062B	72	16		BUSINESS SIGN 5/26			1																			
NB	4.510	C	VR-017	24	30		LLL 24,000 LBS 5/26						1		X														
		C	VR-017	24	30		 5/26	5.00								1		14.00 X									EDWARDS RD (TH-78)		9	
NB	4.518	D	R1-1	30	30		STOP 5/26						1		X														
		C	VD-700	6	10		MILE MARKER 5/26				1	1	1														SALVAGE AND MOUNT ON NEW POST BELOW STOP SIGN			
		D	R1-1	30	30		 5/26	6.25								1		14.25 X									EDWARDS RD (TH-78)	X		
NB	4.518	C/D	D3-1	52	12		 5/26	4.33								2		22.75 X									EDWARDS RD (TH-78); MOUNT TO STREET NAME SIGN WITH BRACKET		12	
		A/B	D3-1	42	12		 5/26	3.50																			EDWARDS RD (TH-78); FIELD LOCATE FOR VISIBILITY FROM VT-108		12	
NB	4.519	C/D	D3-1	UNK.	UNK.		VT RTE 108 S 5/26						1		X														
		A/B	D3-1	UNK.	UNK.		EDWARDS RD TH 78 5/26						1																	
NB	5.227	A/B	D3-1	UNK.	UNK.		BROOK HAVEN DR 5/26						1		X														
		A/B	D3-1	72	12		 5/26	6.00								2		25.00 X									BROOK HAVEN DR (PVT)		12	
SIGN SUMMARY SHEET							SHEET TOTALS	30.08 SF	0.00 SF	3 EA	1 EA	1 EA	6 EA	0 EA	0 EA	7 EA		~~105.0~~ 89.75 FT		0 EA	0.0 LB	0.0 LB	0.0 LB	0.0 LB					
VERMONT AGENCY OF TRANSPORTATION							TOWN DIRECTIONAL TOTALS	611.0	0.0	29	13	10	140	0	0	110		1650.0		0	0.0							

PROJECT NAME: **STOWE - BERKSHIRE**
PROJECT NUMBER: **STPG SIGN (49)**
FILE NAME: **03 CAMBRIDGE VT-108 NB TS** PLOT DATE: **4/15/2015**
PROJECT MANAGER: **D. BRYANT** DRAWN BY: **J. BLANCHARD**
DESIGNED BY: **J. BLANCHARD** CHECKED **K. KERN**
CAMBRIDGE NB SHEET 8 SHEET **52** OF **131**

DIRECTION	MILEPOINT	LOCATION CODE (SHEET 2)	SIGN CODE	WIDTH (IN)	HEIGHT (IN)	SHEETING REMARKS	SIGN LEGEND	NEW SIGNS "A"	NEW SIGNS "B"	EXISTING SIGNS RETAIN	EXISTING SIGNS SALVAGE FROM	EXISTING SIGNS SALVAGE TO	EXISTING SIGNS REMOVE	EXIST POST RETAIN	EXIST POST REMOVE	NUMBER OF NEW POSTS	SQUARE STEEL (IN) 1.75 (LB / FT) 1.88	SQUARE STEEL (IN) 2.00 (LB / FT) 2.42	SQUARE STEEL (IN) 2.50 (LB / FT) 3.35	TUBULAR STEEL Ø (IN) FOUNDATION	TUBULAR STEEL Ø (IN) 3.00 (LB / FT) 7.60	TUBULAR STEEL Ø (IN) 3.50 (LB / FT) 9.00	TUBULAR STEEL Ø (IN) 4.00 (LB / FT) 10.80	TUBULAR STEEL Ø (IN) 5.00 (LB / FT) 14.60	SIGN FRAME REQUIRED	REMARKS	SIGN DETAIL LOCATION SHSM	SIGN DETAIL LOCATION PROJECT SHEET #	SIGN DETAIL LOCATION STANDARD SHEET #
CAMBRIDGE VT-108 NB							FY-FLUORESCENT YELLOW FYG-FLUORESCENT YELLOW GREEN																				"SHSM"-STANDARD HIGHWAY SIGNS AND MARKINGS			
NB	5.440	A	D5-5a	24	24		PICNIC TABLE SYMBOL 5/26						1		X														
		A	VD9-2A	24	6		RIGHT ---> SERVICE 5/26						1																
		A	D5-5a	24	24	WHT/ BLU	 5/27	4.00								1		13.50 X								X		
		A	M6-1R	21	15	WHT/ BLU	 5/27	2.19																		X		
NB	5.808	A	VD-062B	72	16		BUSINESS SIGN 5/27			1				X															
NB	5.859	C/D	D3-1	UNK.	UNK.		VT RTE 108 S 5/27						1		X														
		A/B	D3-1	UNK.	UNK.		EDWARDS RD 5/27						1																
NB	5.860	C	VR-017	24	30		LLL 24,000 LBS 5/27						1		X														
		C	VR-017	24	30		 5/27	5.00								1		13.50 X									EDWARDS RD (TH-78); INSTALL ADJACENT TO NEW LOCATION FOR NARROW BRIDGE SIGN		9	
NB	5.860	C	W5-3	UNK.	UNK.		NARROW BRIDGE 5/27				1		1		X												SALVAGE AND MOUNT IN NEW LOCATION			
		C	UNK.	UNK.	UNK.		SLOW 5/27						1																
NB	5.860	C	W5-3	UNK.	UNK.		NARROW BRIDGE 5/27					1				1		13.25 X									EDWARDS RD (TH-78); INSTALL SAVAGED SIGN ON NEW POST AT END OF CONCRETE BARRIER			
NB	5.866	D	R1-1	30	30		STOP 5/27						1		X														
		C	VD-700	6	10		MILE MARKER 5/27				1	1	1														SALVAGE AND MOUNT ON NEW POST BELOW STOP SIGN			
		D	R1-1	30	30		TRIM 7/6  5/27	6.25								1		14.00 X									EDWARDS RD (TH-78)	X		
SIGN SUMMARY SHEET							SHEET TOTALS	17.44	0.00	1	2	2	9	0	0	4		~~54.25~~ ~~60.0~~		0	0.0	0.0	0.0	0.0					
								SF	SF	EA	EA	EA	EA	EA	EA	EA		FT		EA	LB	LB	LB	LB					
VERMONT AGENCY OF TRANSPORTATION							TOWN DIRECTIONAL TOTALS	611.0	0.0	29	13	10	140	0	0	110		1650.0		0	0.0								

PROJECT NAME: **STOWE - BERKSHIRE**
PROJECT NUMBER: **STPG SIGN (49)**
FILE NAME: **03 CAMBRIDGE VT-108 NB TS** PLOT DATE: **4/15/2015**
PROJECT MANAGER: **D. BRYANT** DRAWN BY: **J. BLANCHARD**
DESIGNED BY: **J. BLANCHARD** CHECKED **K. KERN**
CAMBRIDGE NB SHEET 9 SHEET **53** OF **131**

DIRECTION	MILEPOINT	LOCATION CODE (SHEET 2)	SIGN CODE	WIDTH (IN)	HEIGHT (IN)	SHEETING REMARKS	SIGN LEGEND	NEW SIGNS "A"	NEW SIGNS "B"	EXISTING SIGNS RETAIN	EXISTING SIGNS SALVAGE FROM	EXISTING SIGNS SALVAGE TO	EXISTING SIGNS REMOVE	EXIST POST RETAIN	EXIST POST REMOVE	NUMBER OF NEW POSTS	SQUARE STEEL (IN) 1.75 (LB/FT) 1.88	SQUARE STEEL (IN) 2.00 (LB/FT) 2.42	SQUARE STEEL (IN) 2.50 (LB/FT) 3.35	TUBULAR STEEL Ø (IN) FOUNDATION	TUBULAR STEEL Ø (IN) 3.00 (LB/FT) 7.60	TUBULAR STEEL Ø (IN) 3.50 (LB/FT) 9.00	TUBULAR STEEL Ø (IN) 4.00 (LB/FT) 10.80	TUBULAR STEEL Ø (IN) 5.00 (LB/FT) 14.60	SIGN FRAME REQUIRED	REMARKS	SIGN DETAIL LOCATION SHSM	SIGN DETAIL LOCATION PROJECT SHEET #	SIGN DETAIL LOCATION STANDARD SHEET #
CAMBRIDGE VT-108 NB							FY-FLUORESCENT YELLOW FYG-FLUORESCENT YELLOW GREEN																				"SHSM"-STANDARD HIGHWAY SIGNS AND MARKINGS			
NB	5.869	A/B	D3-1	52	12		VT Rte 108 S Edwards Rd 5/27	4.33								2		23.00 X								EDWARDS RD (TH-78); INSTALL 16 FT NORTH OF EXISTING STOP		12	
		A/B	D3-1	42	12			3.50																				12	
NB	5.968	A/B	D3-1	UNK.	UNK.		CAMPGROUND DRIVE PVT 5/27			1				X															
NB	7.149	A/B	D3-1	UNK.	UNK.		NOTCH GLEN DR						~~1~~ 2		X														
		A/B	D3-1	70	12		Notch Glen Dr PVT 5/27	5.83								2		24.25 X								NOTCH GLEN DR (PVT)		12	
NB	7.215	A/B	D3-1	UNK.	UNK.		CHEZ LN						1		X														
		A/B	D3-1	42	12		Chez Ln PVT 5/27	3.50								1		13.00 X								CHEZ LN (PVT)		12	
NB	7.288	A/B	D3-1	UNK.	UNK.		KINNEY DR PVT			1				X															
NB	7.310	A	W1-1R	30	30		RIGHT TURN						1		X														
		A	W13-1P	24	24		30 MPH						1																
		A	W1-1R	30	30			6.25								1		14.25 X									X		
		A	W13-1P	18	18		30 M.P.H. 5/27	2.25																			X		
NB	7.338	A/B	D3-1	UNK.	UNK.		HIGHLANDER DR						1		X														
		A/B	D3-1	72	12		Highlander Dr PVT 5/27	6.00								2		24.75 X								HIGHLANDER DR (PVT)		12	
NB	7.379	A/B	D3-1	UNK.	UNK.		FORGAN LN				1		1		X														
SIGN SUMMARY SHEET							SHEET TOTALS	31.67	0.00	2	1	0	~~6~~ 7	0	0	8		~~120.0~~ 99.25		0	0.0	0.0	0.0	0.0					
								SF	SF	EA	EA	EA	EA	EA	EA	EA		FT		EA	LB	LB	LB	LB					
VERMONT AGENCY OF TRANSPORTATION							TOWN DIRECTIONAL TOTALS	611.0	0.0	29	13	10	140	0	0	110		1650.0		0		0.0							

PROJECT NAME: **STOWE - BERKSHIRE**
PROJECT NUMBER: **STPG SIGN (49)**
FILE NAME: **03 CAMBRIDGE VT-108 NB TS** PLOT DATE: **4/15/2015**
PROJECT MANAGER: **D. BRYANT** DRAWN BY: **J. BLANCHARD**
DESIGNED BY: **J. BLANCHARD** CHECKED **K. KERN**
CAMBRIDGE NB SHEET 10 SHEET **54** OF **131**

DIRECTION	MILEPOINT	LOCATION CODE (SHEET 2)	SIGN CODE	WIDTH (IN)	HEIGHT (IN)	SHEETING REMARKS	SIGN LEGEND	NEW SIGNS "A"	NEW SIGNS "B"	EXISTING SIGNS RETAIN	EXISTING SIGNS SALVAGE FROM	EXISTING SIGNS SALVAGE TO	EXISTING SIGNS REMOVE	EXIST POST RETAIN	EXIST POST REMOVE	NUMBER OF NEW POSTS	SQUARE STEEL (IN) 1.75 (LB/FT) 1.88	SQUARE STEEL (IN) 2.00 (LB/FT) 2.42	SQUARE STEEL (IN) 2.50 (LB/FT) 3.35	TUBULAR STEEL Ø (IN) FOUNDATION	TUBULAR STEEL Ø (IN) 3.00 (LB/FT) 7.60	TUBULAR STEEL Ø (IN) 3.50 (LB/FT) 9.00	TUBULAR STEEL Ø (IN) 4.00 (LB/FT) 10.80	TUBULAR STEEL Ø (IN) 5.00 (LB/FT) 14.60	SIGN FRAME REQUIRED	REMARKS	SIGN DETAIL LOCATION SHSM	SIGN DETAIL LOCATION PROJECT SHEET #	SIGN DETAIL LOCATION STANDARD SHEET #
CAMBRIDGE VT-108 NB							FY-FLUORESCENT YELLOW FYG-FLUORESCENT YELLOW GREEN HIDDEN DRIVES																				"SHSM"-STANDARD HIGHWAY SIGNS AND MARKINGS			
		A/B	D3-1	54	12		Forgan Ln PVT 5/27	4.50								2		23.25 X								FORGAN LN (PVT)		12	
NB	7.607	B	W1-1L	30	30		LEFT TURN 5/27						1		X														
		B	W13-1P	24	24		30 MPH 5/27						1																
NB	7.633	A	VR2-5A	24	30		REDUCED SPEED AHEAD						~~1~~		X														
		A	VD-700	6	10		MILE MARKER						~~1~~																
NB	7.656	A	W3-5	36	36		SPEED LIMIT 40 6/6	9.00					2			2		36.00 X								INSTALL 120 FT NORTH OF EXISTING	X		
NB	7.751	A	R2-1	24	30		SPEED LIMIT 40 6/6						1		X														
		A	R2-1	30	36		SPEED LIMIT 40 6/6	7.50								1		14.00 X									X		
NB	7.878	A	W7-1	30	30		HILL SYMBOL 6/6						1		X														
		A	W7-1	30	30		6/6	6.25								1		14.00 X								REQUIRES VEGETATION CLEARING	X		
NB	7.981	A	R2-1	24	30		SPEED LIMIT 40 6/6						1		X														
		A	R2-1	24	30		TRIM 7/7 SPEED LIMIT 40 6/6	5.00								1		15.00 X								REQUIRES VEGETATION CLEARING; INSTALL 10 FT SOUTH OF UTILITY POLE #21	X		
NB	8.108	A	W3-5	36	36		SPEED REDUCTION SPEED LIMIT 35 6/6						1		X														
		A	W3-5	36	36		6/6	9.00								2		27.75 X									X		
NB	8.190	A	R2-1	36	48		SPEED LIMIT 35 6/6						1		X														
SIGN SUMMARY SHEET							SHEET TOTALS	41.25	0.00	0	0	0	9	0	0	9		~~135.0~~ 130.00		0	0.0	0.0	0.0	0.0					
								SF	SF	EA	EA	EA	EA	EA	EA	EA		FT		EA	LB	LB	LB	LB					
VERMONT AGENCY OF TRANSPORTATION							TOWN DIRECTIONAL TOTALS	611.0	0.0	29	13	10	140	0	0	110		1650.0		0	0.0								

PROJECT NAME: **STOWE - BERKSHIRE**
PROJECT NUMBER: **STPG SIGN (49)**
FILE NAME: **03 CAMBRIDGE VT-108 NB TS** PLOT DATE: **4/15/2015**
PROJECT MANAGER: **D. BRYANT** DRAWN BY: **J. BLANCHARD**
DESIGNED BY: **J. BLANCHARD** CHECKED **K. KERN**
CAMBRIDGE NB SHEET 11 SHEET **55** OF **131**

DIRECTION	MILEPOINT	LOCATION CODE (SHEET 2)	SIGN CODE	WIDTH (IN)	HEIGHT (IN)	SHEETING REMARKS	SIGN LEGEND		NEW SIGNS "A"	NEW SIGNS "B"	EXISTING SIGNS RETAIN	EXISTING SIGNS SALVAGE FROM	EXISTING SIGNS SALVAGE TO	EXISTING SIGNS REMOVE	EXIST POST RETAIN	EXIST POST REMOVE	NUMBER OF NEW POSTS	SQUARE STEEL (IN) 1.75 (LB/FT) 1.88	SQUARE STEEL (IN) 2.00 (LB/FT) 2.42	SQUARE STEEL (IN) 2.50 (LB/FT) 3.35	TUBULAR STEEL Ø (IN) FOUNDATION	TUBULAR STEEL Ø (IN) 3.00 (LB/FT) 7.60	TUBULAR STEEL Ø (IN) 3.50 (LB/FT) 9.00	TUBULAR STEEL Ø (IN) 4.00 (LB/FT) 10.80	TUBULAR STEEL Ø (IN) 5.00 (LB/FT) 14.60	SIGN FRAME REQUIRED	REMARKS	SIGN DETAIL LOCATION SHSM	SIGN DETAIL LOCATION PROJECT SHEET #	SIGN DETAIL LOCATION STANDARD SHEET #
CAMBRIDGE VT-108 NB							FY-FLUORESCENT YELLOW FYG-FLUORESCENT YELLOW GREEN																					"SHSM"-STANDARD HIGHWAY SIGNS AND MARKINGS			
		A	R2-1	30	36		SPEED LIMIT 35	6/6	7.50								1		14.00 X										X		
NB	8.246	A	W1-2L	36	36		LEFT CURVE	6/6			1				X															
		A	VD-700	6	10		MILE MARKER	6/6			1																			
NB	8.246	C	VR-017	24	30		LLL 16,000 LBS	6/6						1		X														
		C	VR-017	24	30		LEGAL LOAD LIMIT 10,000 POUNDS	6/6	5.00								1		12.50 X								GRIST MILL DR (TH-31)		9	
NB	8.248	A/B	D3-1	UNK.	UNK.		CANYON RD NEEDS TO BE THIS NOT ↓	6/6						1		X														
		C/D	D3-1	52	12		VT Rte 108 S	6/6	4.33								2		25.50 X								GRIST MILL DR (TH-31)		12	
		A/B	D3-1	50	12		Grist Mill Dr	6/6	4.17																		GRIST MILL DR (TH-31)		12	
NB	8.254	D	R1-1	30	30		STOP	6/6						1		X														
		C	VD-700	6	10		MILE MARKER	6/6				1	1	1													SALVAGE AND MOUNT ON NEW POST BELOW STOP SIGN			
		D	R1-1	30	30		STOP	6/6	6.25								1		14.25 X								GRIST MILL DR (TH-31)	X		
NB	8.267	A	S3-1	30	30		SCHOOL BUS STOP AHEAD	6/6						1		X														
		A	S3-1	36	36	FYG		6/6	9.00								2		29.00 X									X		
NB	8.268	A/B	D3-1	UNK.	UNK.		GRIST MILL DR NEEDS TO BE							1		X														
		A/B	D3-1	62	12		Grist Mill Dr	8/27	5.17								2		23.50 X								CANYON RD (PVT)		12	
SIGN SUMMARY SHEET							SHEET TOTALS		41.42	0.00	2	1	1	6	0	0	9		~~135.0~~ 118.75		0	0.0	0.0	0.0	0.0					
									SF	SF	EA	EA	EA	EA	EA	EA	EA		FT		EA	LB	LB	LB	LB					
VERMONT AGENCY OF TRANSPORTATION							TOWN DIRECTIONAL TOTALS		611.0	0.0	29	13	10	140	0	0	110		1650.0		0	0.0								

PROJECT NAME: **STOWE - BERKSHIRE**
PROJECT NUMBER: **STPG SIGN (49)**
FILE NAME: **03 CAMBRIDGE VT-108 NB TS** PLOT DATE: **4/15/2015**
PROJECT MANAGER: **D. BRYANT** DRAWN BY: **J. BLANCHARD**
DESIGNED BY: **J. BLANCHARD** CHECKED **K. KERN**
CAMBRIDGE NB SHEET 12 SHEET **56** OF **131**

DIRECTION	MILEPOINT	LOCATION CODE (SHEET 2)	SIGN CODE	WIDTH (IN)	HEIGHT (IN)	SHEETING REMARKS	SIGN LEGEND	NEW SIGNS "A"	NEW SIGNS "B"	EXISTING SIGNS RETAIN	EXISTING SIGNS SALVAGE FROM	EXISTING SIGNS SALVAGE TO	EXISTING SIGNS REMOVE	EXIST POST RETAIN	EXIST POST REMOVE	NUMBER OF NEW POSTS	SQUARE STEEL (IN) 1.75 (LB/FT) 1.88	SQUARE STEEL (IN) 2.00 (LB/FT) 2.42	SQUARE STEEL (IN) 2.50 (LB/FT) 3.35	TUBULAR STEEL Ø (IN) FOUNDATION	TUBULAR STEEL Ø (IN) 3.00 (LB/FT) 7.60	TUBULAR STEEL Ø (IN) 3.50 (LB/FT) 9.00	TUBULAR STEEL Ø (IN) 4.00 (LB/FT) 10.80	TUBULAR STEEL Ø (IN) 5.00 (LB/FT) 14.60	SIGN FRAME REQUIRED	REMARKS	SIGN DETAIL LOCATION SHSM	SIGN DETAIL LOCATION PROJECT SHEET #	SIGN DETAIL LOCATION STANDARD SHEET #
CAMBRIDGE VT-108 NB							FY-FLUORESCENT YELLOW FYG-FLUORESCENT YELLOW GREEN																			"SHSM"-STANDARD HIGHWAY SIGNS AND MARKINGS			
NB	8.300	A	VW-054L	30	30		HIDDEN DRIVE LEFT 6/6						1		X														
		A	VW-133L	30	30		 6/6	6.25								1		14.00 X										10	
NB	8.342	A	R2-1	24	30		SPEED LIMIT 35 6/6						1		X														
NB	8.347	A	W1-8L	18	24		TRIM 7/7  6/7	3.00								1		13.00 X								INSTALL 26 FT NORTH OF EXISTING SPEED LIMIT 35	X		
		B	W1-8R	18	24		 6/7	3.00																				X	
NB	8.356	A	W1-6	48	24		<=== LEFT LARGE ARROW 6/7						1		X														
NB	8.363	A	W1-8L	18	24		 6/7	3.00								1		13.25 X								INSTALL 37 FT NORTH OF FIRST EXISTING LARGE LEFT ARROW AT M.P. 8.356	X		
		B	W1-8R	18	24		 6/7	3.00																				X	
NB	8.364	A	W1-6	48	24		<=== LEFT LARGE ARROW 6/7						1		X														
NB	8.364	B	W1-6	48	24		RIGHT ===> LARGE ARROW 6/7						1		X														
NB	8.373	A	W1-6	48	24		<=== LEFT LARGE ARROW 6/7						1		X														
NB	8.373	B	W1-6	48	24		RIGHT ===> LARGE ARROW 6/7						1		X														
NB	8.376	A	W1-8L	18	24		 6/7	3.00					2			1		13.25 X								INSTALL AT END OF GUARDRAIL	X		
		B	W1-8R	18	24		 6/7	3.00																				X	
NB	8.392	A	W1-8L	18	24		TRIM 7/7  6/7	3.00								1		13.00 X								INSTALL 85 FT NORTH OF PREVIOUS CHEVRON AT M.P. 8.376 (NORTH OF DRIVEWAY)	X		
							SHEET TOTALS	27.25 SF	0.00 SF	0 EA	0 EA	0 EA	~~9~~ 7 EA	0 EA	0 EA	5 EA		~~66.50~~ ~~75.0~~ FT		0 EA	0.0 LB	0.0 LB	0.0 LB	0.0 LB				
							TOWN DIRECTIONAL TOTALS	611.0	0.0	29	13	10	140	0	0	110		1650.0		0	0.0							

SIGN SUMMARY SHEET


VERMONT AGENCY OF TRANSPORTATION

PROJECT NAME: **STOWE - BERKSHIRE**
PROJECT NUMBER: **STPG SIGN (49)**


FILE NAME: **03 CAMBRIDGE VT-108 NB TS** PLOT DATE: **4/15/2015**
PROJECT MANAGER: **D. BRYANT** DRAWN BY: **J. BLANCHARD**
DESIGNED BY: **J. BLANCHARD** CHECKED **K. KERN**
CAMBRIDGE NB SHEET 13 SHEET **57** OF **131**

DIRECTION	MILEPOINT	LOCATION CODE (SHEET 2)	SIGN CODE	WIDTH (IN)	HEIGHT (IN)	SHEETING REMARKS	SIGN LEGEND	NEW SIGNS "A"	NEW SIGNS "B"	EXISTING SIGNS RETAIN	EXISTING SIGNS SALVAGE FROM	EXISTING SIGNS SALVAGE TO	EXISTING SIGNS REMOVE	EXIST POST RETAIN	EXIST POST REMOVE	NUMBER OF NEW POSTS	SQUARE STEEL (IN) 1.75 (LB/FT) 1.88	SQUARE STEEL (IN) 2.00 (LB/FT) 2.42	SQUARE STEEL (IN) 2.50 (LB/FT) 3.35	TUBULAR STEEL Ø (IN) FOUNDATION	TUBULAR STEEL Ø (IN) 3.00 (LB/FT) 7.60	TUBULAR STEEL Ø (IN) 3.50 (LB/FT) 9.00	TUBULAR STEEL Ø (IN) 4.00 (LB/FT) 10.80	TUBULAR STEEL Ø (IN) 5.00 (LB/FT) 14.60	SIGN FRAME REQUIRED	REMARKS	SIGN DETAIL LOCATION SHSM	SIGN DETAIL LOCATION PROJECT SHEET #	SIGN DETAIL LOCATION STANDARD SHEET #
CAMBRIDGE VT-108 NB							FY-FLUORESCENT YELLOW FYG-FLUORESCENT YELLOW GREEN																				"SHSM"-STANDARD HIGHWAY SIGNS AND MARKINGS			
		B	W1-8R	18	24		 6/7	3.00																			X		
NB	8.422	A	VD-062B	72	16		BUSINESS SIGN 6/7			1				X															
		A	VD-062B	72	16		BUSINESS SIGN 6/7			1																			
		A	VD-700	6	10		MILE MARKER 6/7			1																			
NB	8.469	A	VD-062BC	74.75	16		TRAVEL INFORMATION ^UP VT 15 WEST AT MOBIL 5/10 6/7			1				X															
		A	VD-062C	74.75	16		C BOARD 6/7			1																			
		A	W8-1	30	30		BUMP NOT THERE						1																
NB	8.550	A	VW-544	UNK.	UNK.		EMERGENCY VEHICLES 6/7			1				X															
		A	UNK.	UNK.	UNK.		911 EMERGENCY CALL BOX AHEAD AT RESCUE STATION 6/7			1																			
NB	8.570	A	VR2-5A	24	30		REDUCED SPEED AHEAD 6/6						~~1~~ 0		X														
		A	W3-5	36	36		 6/6	9.00								2		~~28.75~~ X									X		
NB	8.607	A	W3-1	36	36		STOP AHEAD SYMBOL 6/6						1		X														
		A	W3-1A	36	36		 6/6	9.00								2		~~32.50~~ X									X		
NB	8.641	A	W11-2	30	30		PEDESTRIAN SYMBOL 6/6						1		X														
		A	VW-207BP	24	18		BLIND PERSON 6/6						1																
SIGN SUMMARY SHEET							SHEET TOTALS	21.00	0.00	7	0	0	~~5~~ 4	0	0	4			~~60.0~~ 61.25	0	0.0	0.0	0.0	0.0					
								SF	SF	EA	EA	EA	EA	EA	EA	EA			FT	EA	LB	LB	LB	LB					
VERMONT AGENCY OF TRANSPORTATION							TOWN DIRECTIONAL TOTALS	611.0	0.0	29	13	10	140	0	0	110			1650.0	0			0.0					


PROJECT NAME: **STOWE - BERKSHIRE**
PROJECT NUMBER: **STPG SIGN (49)**
FILE NAME: **03 CAMBRIDGE VT-108 NB TS** PLOT DATE: **4/15/2015**
PROJECT MANAGER: **D. BRYANT** DRAWN BY: **J. BLANCHARD**
DESIGNED BY: **J. BLANCHARD** CHECKED **K. KERN**
CAMBRIDGE NB SHEET 14 SHEET **58** OF **131**

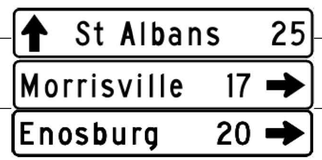DIRECTION	MILEPOINT	LOCATION CODE (SHEET 2)	SIGN CODE	WIDTH (IN)	HEIGHT (IN)	SHEETING REMARKS	SIGN LEGEND	NEW SIGNS "A"	NEW SIGNS "B"	EXISTING SIGNS RETAIN	EXISTING SIGNS SALVAGE FROM	EXISTING SIGNS SALVAGE TO	EXISTING SIGNS REMOVE	EXIST POST RETAIN	EXIST POST REMOVE	NUMBER OF NEW POSTS	SQUARE STEEL (IN) 1.75 (LB/FT) 1.88	SQUARE STEEL (IN) 2.00 (LB/FT) 2.42	SQUARE STEEL (IN) 2.50 (LB/FT) 3.35	TUBULAR STEEL Ø (IN) FOUNDATION	TUBULAR STEEL Ø (IN) 3.00 (LB/FT) 7.60	TUBULAR STEEL Ø (IN) 3.50 (LB/FT) 9.00	TUBULAR STEEL Ø (IN) 4.00 (LB/FT) 10.80	TUBULAR STEEL Ø (IN) 5.00 (LB/FT) 14.60	SIGN FRAME REQUIRED	REMARKS	SIGN DETAIL LOCATION SHSM	SIGN DETAIL LOCATION PROJECT SHEET #	SIGN DETAIL LOCATION STANDARD SHEET #
CAMBRIDGE VT-108 NB							FY-FLUORESCENT YELLOW FYG-FLUORESCENT YELLOW GREEN																				"SHSM"-STANDARD HIGHWAY SIGNS AND MARKINGS			
		A	W11-2	30	30	FYG	 6/6	6.25								1		15.25 X									X		
NB	8.655	A/B	D3-1	UNK.	UNK.		WILLIAMSON CT 6/7						1		X														
		A/B	D3-1	70	12		 6/7	5.83								2		24.75 X								WILLIAMSON CT (PVT)		12	
NB	8.660	A	W16-2aP	24	18		400 FEET 6/7						1		X														
		A	VW-054L	30	30		HIDDEN DRIVE LEFT 6/7						1																	
		B	UNK.	UNK.	UNK.		911 EMERGENCY CALL BOX AHEAD AT RESCUE STATION 6/7						1																	
		A	VW-133L	30	30		 TRIM 7/7 6/7	6.25								1		16.50 X										10	
		A	W16-2aP	24	12		TRIM 7/7 6/7	2.00																			X		
NB	8.668	A	D1-1A	72	10		MORRISVILLE 17 --->						1		X														
		A	D1-1A	72	10		ENOSBURG 20 --->						1																
		A	D1-1A	72	10		ST ALBANS 25 ^UP						1																
		B	VR-493H	48	60		VT 108 OPEN TO SKI AREA CLOSED THRU SMUG NOTCH VT 108 NOT A THRU ROUTE FOR TRACTOR TRAILERS						1																
		A	VD1-1a	72	12		TRIM 7/7 8/24	6.00								2			30.25 X							SLIP BASE REQUIRED - SEE SHEET 2 8/23		7	
		A	VD1-1a	72	12		 8/24	6.00																				7	
		A	VD1-1a	72	12		8/24	6.00																				7	
		A	VD1-1a	72	12		8/24	6.00																				7	
SIGN SUMMARY SHEET							SHEET TOTALS	38.33	0.00	0	0	0	8	0	0	6		86.75 ~~90.0~~		0	0.0	0.0	0.0	0.0					
VERMONT AGENCY OF TRANSPORTATION								SF	SF	EA	EA	EA	EA	EA	EA	EA		FT		EA	LB	LB	LB	LB					
							TOWN DIRECTIONAL TOTALS	611.0	0.0	29	13	10	140	0	0	110		1650.0		0		0.0							

PROJECT NAME: **STOWE - BERKSHIRE**
PROJECT NUMBER: **STPG SIGN (49)**
FILE NAME: **03 CAMBRIDGE VT-108 NB TS** PLOT DATE: **7/29/2015**
PROJECT MANAGER: **D. BRYANT** DRAWN BY: **J. BLANCHARD**
DESIGNED BY: **J. BLANCHARD** CHECKED **K. KERN**
CAMBRIDGE NB SHEET 15 SHEET **59** OF **131**

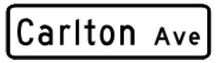
DIRECTION	MILEPOINT	LOCATION CODE (SHEET 2)	SIGN CODE	WIDTH (IN)	HEIGHT (IN)	SHEETING REMARKS	SIGN LEGEND	NEW SIGNS "A"	NEW SIGNS "B"	EXISTING SIGNS RETAIN	EXISTING SIGNS SALVAGE FROM	EXISTING SIGNS SALVAGE TO	EXISTING SIGNS REMOVE	EXIST POST RETAIN	EXIST POST REMOVE	NUMBER OF NEW POSTS	SQUARE STEEL (IN) 1.75 (LB/FT) 1.88	SQUARE STEEL (IN) 2.00 (LB/FT) 2.42	SQUARE STEEL (IN) 2.50 (LB/FT) 3.35	TUBULAR STEEL Ø (IN) FOUNDATION	TUBULAR STEEL Ø (IN) 3.00 (LB/FT) 7.60	TUBULAR STEEL Ø (IN) 3.50 (LB/FT) 9.00	TUBULAR STEEL Ø (IN) 4.00 (LB/FT) 10.80	TUBULAR STEEL Ø (IN) 5.00 (LB/FT) 14.60	SIGN FRAME REQUIRED	REMARKS	SIGN DETAIL LOCATION SHSM	SIGN DETAIL LOCATION PROJECT SHEET #	SIGN DETAIL LOCATION STANDARD SHEET #
CAMBRIDGE VT-108 NB							FY-FLUORESCENT YELLOW FYG-FLUORESCENT YELLOW GREEN																				"SHSM"-STANDARD HIGHWAY SIGNS AND MARKINGS			
NB	8.692	A	VR-040	24	24		THROUGH WAY ENDS HERE 6/7						1		X														
		A	R2-1	24	30		SPEED LIMIT 25 6/7						1																
		A	R2-1	30	36		TRIM 7/7  6/7	7.50								1		14.25 X								X		
NB	8.744	A	R1-1	30	30		STOP 6/7			1				X															
NB	8.764	D	R1-1	30	30		STOP 6/7						1		X														
		C	VR-017	24	30		LLL 24,000 LBS 6/7						1																
		C	VD-700	6	10		MILE MARKER 6/7				1	1	1														SALVAGE AND MOUNT ON NEW POST BELOW STOP SIGN			
		A/B	D3-1	42	12		TRIM 7/7  6/7	3.50			3	3				1		13.75 X								CARLTON AVE (TH-55); MOUNT ON STOP SIGN WITH BRACKET		12	
		D	R1-1	30	30		 6/7	6.25																			CARLTON AVE (TH-55)	X		
		C	VR-017	24	30		 6/7	5.00																			CARLTON AVE (TH-55); MOUNT ON BACK SIDE OF STOP SIGN		9	
NB	8.764	C/D	D3-1	UNK.	UNK.		MAIN ST 6/7						1		X														
		A/B	D3-1	UNK.	UNK.		CARLTON AVE 6/7						1																
NB	8.772	A	S1-1	36	36	FYG	SCHOOL SYMBOL 6/7						1		X														
		A	W16-9P	24	12	FYG	AHEAD 6/7						1																
		A	S1-1	36	36	FYG	 6/7	9.00								1			14.50 X								X		
SIGN SUMMARY SHEET							SHEET TOTALS	31.25	0.00	1	4 ~~1~~	4 ~~1~~	9	0	0	3		~~45.0~~ 42.50		0	0.0	0.0	0.0	0.0					
								SF	SF	EA	EA	EA	EA	EA	EA	EA		FT		EA	LB	LB	LB	LB					
VERMONT AGENCY OF TRANSPORTATION							TOWN DIRECTIONAL TOTALS	611.0	0.0	29	13	10	140	0	0	110		1650.0		0		0.0							

PROJECT NAME: **STOWE - BERKSHIRE**
PROJECT NUMBER: **STPG SIGN (49)**
FILE NAME: **03 CAMBRIDGE VT-108 NB TS** PLOT DATE: **4/15/2015**
PROJECT MANAGER: **D. BRYANT** DRAWN BY: **J. BLANCHARD**
DESIGNED BY: **J. BLANCHARD** CHECKED **K. KERN**
CAMBRIDGE NB SHEET 16 SHEET **60** OF **131**

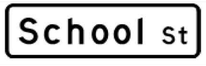DIRECTION	MILEPOINT	LOCATION CODE (SHEET 2)	SIGN CODE	WIDTH (IN)	HEIGHT (IN)	SHEETING REMARKS	SIGN LEGEND	NEW SIGNS "A"	NEW SIGNS "B"	EXISTING SIGNS RETAIN	EXISTING SIGNS SALVAGE FROM	EXISTING SIGNS SALVAGE TO	EXISTING SIGNS REMOVE	EXIST POST RETAIN	EXIST POST REMOVE	NUMBER OF NEW POSTS	SQUARE STEEL (IN) 1.75 (LB/FT) 1.88	SQUARE STEEL (IN) 2.00 (LB/FT) 2.42	SQUARE STEEL (IN) 2.50 (LB/FT) 3.35	TUBULAR STEEL Ø (IN) FOUNDATION	TUBULAR STEEL Ø (IN) 3.00 (LB/FT) 7.60	TUBULAR STEEL Ø (IN) 3.50 (LB/FT) 9.00	TUBULAR STEEL Ø (IN) 4.00 (LB/FT) 10.80	TUBULAR STEEL Ø (IN) 5.00 (LB/FT) 14.60	SIGN FRAME REQUIRED	REMARKS	SIGN DETAIL LOCATION SHSM	SIGN DETAIL LOCATION PROJECT SHEET #	SIGN DETAIL LOCATION STANDARD SHEET #
CAMBRIDGE VT-108 NB							FY-FLUORESCENT YELLOW FYG-FLUORESCENT YELLOW GREEN																				"SHSM"-STANDARD HIGHWAY SIGNS AND MARKINGS			
		A	W16-9P	24	12	FYG	6/7	2.00																				X		
NB	8.863	A	S1-1	30	30	FYG	SCHOOL SYMBOL 6/7						1		X														
		A	W16-7P	24	12	FYG	DIAGONAL ARROW WARNING 6/7						1																
		A	S1-1	36	36	FYG	 6/7	9.00								1			14.75 X								X		
		A	W16-7P	24	12	FYG	6/7	2.00																				X		
NB	8.869	A/B	D3-1	40	12		 6/7	3.33								1		11.00 X									SCHOOL ST (TH-55); INSTALL 10 FT SOUTH OF UTILITY POLE		12	
NB	8.870	A/B	D3-1	UNK.	UNK.		SCHOOL ST 6/7						1		X														
		C/D	D3-1	UNK.	UNK.		MAIN ST 6/7						1																
NB	8.871	C	VR-017	24	30		LLL 24,000 LBS 6/7						1		X														
		D	R1-1	30	30		STOP 6/7						1																
		C	VD-700	6	10		MILE MARKER 6/7				1	1	1														SALVAGE AND MOUNT ON NEW POST BELOW STOP SIGN			
		D	R1-1	30	30		 6/7	6.25								1		13.50 X								SCHOOL ST (TH-55)	X		
NB	8.871	C	R2-1	30	24		SPEED LIMIT 25 6/7				1	1	1		X												SCHOOL ST (TH-55); SALVAGE AND REMOUNT ON NEW POST BELOW LLL			
		C	VR-017	24	30		 6/7	5.00								1			16.00 X							SCHOOL ST (TH-55)		9	
NB	8.928	A	W1-1L	30	30		LEFT TURN 6/7						1		X														
SIGN SUMMARY SHEET							SHEET TOTALS	27.58	0.00	0	2	2	9	0	0	4		~~60.0~~ 55.25		0	0.0	0.0	0.0	0.0					
								SF	SF	EA	EA	EA	EA	EA	EA	EA		FT		EA	LB	LB	LB	LB					
VERMONT AGENCY OF TRANSPORTATION							TOWN DIRECTIONAL TOTALS	611.0	0.0	29	13	10	140	0	0	110		1650.0		0		0.0							

PROJECT NAME: **STOWE - BERKSHIRE**
PROJECT NUMBER: **STPG SIGN (49)**

FILE NAME: **03 CAMBRIDGE VT-108 NB TS** PLOT DATE: **4/15/2015**
PROJECT MANAGER: **D. BRYANT** DRAWN BY: **J. BLANCHARD**
DESIGNED BY: **J. BLANCHARD** CHECKED **K. KERN**
CAMBRIDGE NB SHEET 17 SHEET **61** OF **131**

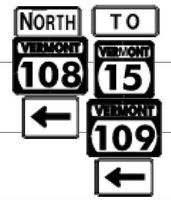DIRECTION	MILEPOINT	LOCATION CODE (SHEET 2)	SIGN CODE	WIDTH (IN)	HEIGHT (IN)	SHEETING REMARKS	SIGN LEGEND	NEW SIGNS "A"	NEW SIGNS "B"	EXISTING SIGNS RETAIN	EXISTING SIGNS SALVAGE FROM	EXISTING SIGNS SALVAGE TO	EXISTING SIGNS REMOVE	EXIST POST RETAIN	EXIST POST REMOVE	NUMBER OF NEW POSTS	SQUARE STEEL (IN) 1.75 (LB/FT) 1.88	SQUARE STEEL (IN) 2.00 (LB/FT) 2.42	SQUARE STEEL (IN) 2.50 (LB/FT) 3.35	TUBULAR STEEL Ø (IN) FOUNDATION	TUBULAR STEEL Ø (IN) 3.00 (LB/FT) 7.60	TUBULAR STEEL Ø (IN) 3.50 (LB/FT) 9.00	TUBULAR STEEL Ø (IN) 4.00 (LB/FT) 10.80	TUBULAR STEEL Ø (IN) 5.00 (LB/FT) 14.60	SIGN FRAME REQUIRED	REMARKS	SIGN DETAIL LOCATION SHSM	SIGN DETAIL LOCATION PROJECT SHEET #	SIGN DETAIL LOCATION STANDARD SHEET #
CAMBRIDGE VT-108 NB							FY-FLUORESCENT YELLOW FYG-FLUORESCENT YELLOW GREEN																			"SHSM"-STANDARD HIGHWAY SIGNS AND MARKINGS			
		A	W1-1ML	30	30		 6/2	6.25								1		13.25 X									X		
NB	8.955	A	M4-5	24	12		TO STATE 8/16						1		X														
		A	M1-5	24	24		VERMONT 15 8/16						1																
		A	M1-5	30	24		VERMONT 109 8/16						1																
		A	M6-1	21	15		<--- LEFT STATE 8/16						1																
		A	M3-1	24	12	GRN/ WHT	8/16	2.00								2			32.00 X						2C	SLIP BASE REQUIRED - SEE SHEET 2 8/16	X		
		A	M1-5	30	24	GRN/ WHT	 8/16	5.00																					E-136B
		A	M6-1L	21	15	GRN/ WHT	8/16	2.19																				X		
		A	M4-5	24	12	GRN/ WHT	8/16	2.00																				X		
		A	M1-5	24	24	GRN/ WHT	8/16	4.00																						E-136B
		A	M1-5	30	24	GRN/ WHT	8/16	5.00																						E-136B
		A	M6-1L	21	15	GRN/ WHT	8/16	2.19																				X		
NB	8.955	A	M3-1	24	12		NORTH STATE 6/7						1		X														
		A	M1-5	30	24		VERMONT 108 6/7						1																
		A	M6-1	21	15		<--- LEFT STATE 6/7						1																
SIGN SUMMARY SHEET							SHEET TOTALS	28.63	0.00	0	0	0	7	0	0	3		45.25 ~~45.0~~		0	0.0	0.0	0.0	0.0					
								SF	SF	EA	EA	EA	EA	EA	EA	EA		FT		EA	LB	LB	LB	LB					
VERMONT AGENCY OF TRANSPORTATION							TOWN DIRECTIONAL TOTALS	611.0	0.0	29	13	10	140	0	0	110		1650.0		0		0.0							

PROJECT NAME: **STOWE - BERKSHIRE**
PROJECT NUMBER: **STPG SIGN (49)**
FILE NAME: **03 CAMBRIDGE VT-108 NB TS** PLOT DATE: **7/29/2015**
PROJECT MANAGER: **D. BRYANT** DRAWN BY: **J. BLANCHARD**
DESIGNED BY: **J. BLANCHARD** CHECKED **K. KERN**
CAMBRIDGE NB SHEET 18 SHEET **62** OF **131**

DIRECTION	MILEPOINT	LOCATION CODE (SHEET 2)	SIGN CODE	WIDTH (IN)	HEIGHT (IN)	SHEETING REMARKS	SIGN LEGEND	NEW SIGNS "A"	NEW SIGNS "B"	EXISTING SIGNS RETAIN	EXISTING SIGNS SALVAGE FROM	EXISTING SIGNS SALVAGE TO	EXISTING SIGNS REMOVE	EXIST POST RETAIN	EXIST POST REMOVE	NUMBER OF NEW POSTS	SQUARE STEEL (IN) 1.75 (LB/FT) 1.88	SQUARE STEEL (IN) 2.00 (LB/FT) 2.42	SQUARE STEEL (IN) 2.50 (LB/FT) 3.35	TUBULAR STEEL Ø (IN) FOUNDATION	TUBULAR STEEL Ø (IN) 3.00 (LB/FT) 7.60	TUBULAR STEEL Ø (IN) 3.50 (LB/FT) 9.00	TUBULAR STEEL Ø (IN) 4.00 (LB/FT) 10.80	TUBULAR STEEL Ø (IN) 5.00 (LB/FT) 14.60	SIGN FRAME REQUIRED	REMARKS	SIGN DETAIL LOCATION SHSM	SIGN DETAIL LOCATION PROJECT SHEET #	SIGN DETAIL LOCATION STANDARD SHEET #
CAMBRIDGE VT-108 NB							FY-FLUORESCENT YELLOW FYG-FLUORESCENT YELLOW GREEN																				"SHSM"-STANDARD HIGHWAY SIGNS AND MARKINGS			
NB	8.955	C	M3-3	24	12		SOUTH STATE 6/7						1		X														
		C	M1-5A	30	24		VERMONT 108 6/7						1																
		C	M6-1R	21	15		RIGHT STATE ---> 6/7						1																
		C	D1-1A	72	10		JEFFERSONVILLE ---> 6/7						1																
		C	D1-1A	72	10		SMUGGLERS NOTCH SKI AREA 7 ---> 6/7						1																
		C	D1-1A	72	10		STOWE 18 ---> 6/7						1																
		C	M3-3	24	12	GRN/WHT	SOUTH VERMONT 108 6/7	2.00								1			15.25 X							X		
		C	M1-5	30	24	GRN/WHT	6/7	5.00																				E-136B
		C	M6-1R	21	15	GRN/WHT	6/7	2.19																		X		
NB	8.955	A/B	D3-1	UNK.	UNK.		OLD MAIN ST 6/7						1		X														
		C	UNK.	UNK.	UNK.		NO THRU TRAFFIC 6/7				1		1																
		A/B	D3-1	42	12		Old Main St 6/7																				OLD MAIN ST		12	
NB	8.955	N/A	UNK.	UNK.	UNK.		EMPTY POST 6/7								X												REMOVE EMPTY SIGN POST IN THIS LOCATION			
NB	8.955	C	VR-017	24	30		LLL 24,000 LBS 6/7						1		X														
		C	VR-017	24	30		LEGAL LOAD LIMIT 24,000 POUNDS 6/7	5.00								1		13.50 X									OLD MAIN ST; INSTALL 20 FT WEST OF EXISTING		9	
SIGN SUMMARY SHEET							SHEET TOTALS	14.19	0.00	0	1	0	9	0	0	2		~~30.0~~ 28.75		0	0.0	0.0	0.0	0.0					
								SF	SF	EA	EA	EA	EA	EA	EA	EA		FT		EA	LB	LB	LB	LB					
VERMONT AGENCY OF TRANSPORTATION							TOWN DIRECTIONAL TOTALS	611.0	0.0	29	13	10	140	0	0	110		1650.0		0		0.0							

PROJECT NAME: **STOWE - BERKSHIRE**
PROJECT NUMBER: **STPG SIGN (49)**
FILE NAME: **03 CAMBRIDGE VT-108 NB TS** PLOT DATE: **4/15/2015**
PROJECT MANAGER: **D. BRYANT** DRAWN BY: **J. BLANCHARD**
DESIGNED BY: **J. BLANCHARD** CHECKED **K. KERN**
CAMBRIDGE NB SHEET 19 SHEET **63** OF **131**

DIRECTION	MILEPOINT	LOCATION CODE (SHEET 2)	SIGN CODE	WIDTH (IN)	HEIGHT (IN)	SHEETING REMARKS	SIGN LEGEND	NEW SIGNS "A"	NEW SIGNS "B"	EXISTING SIGNS RETAIN	EXISTING SIGNS SALVAGE FROM	EXISTING SIGNS SALVAGE TO	EXISTING SIGNS REMOVE	EXIST POST RETAIN	EXIST POST REMOVE	NUMBER OF NEW POSTS	SQUARE STEEL (IN) 1.75 (LB / FT) 1.88	SQUARE STEEL (IN) 2.00 (LB / FT) 2.42	SQUARE STEEL (IN) 2.50 (LB / FT) 3.35	TUBULAR STEEL Ø (IN) FOUNDATION	TUBULAR STEEL Ø (IN) 3.00 (LB / FT) 7.60	TUBULAR STEEL Ø (IN) 3.50 (LB / FT) 9.00	TUBULAR STEEL Ø (IN) 4.00 (LB / FT) 10.80	TUBULAR STEEL Ø (IN) 5.00 (LB / FT) 14.60	SIGN FRAME REQUIRED	REMARKS	SIGN DETAIL LOCATION SHSM	SIGN DETAIL LOCATION PROJECT SHEET #	SIGN DETAIL LOCATION STANDARD SHEET #
CAMBRIDGE VT-108 NB							FY-FLUORESCENT YELLOW FYG-FLUORESCENT YELLOW GREEN																				"SHSM"-STANDARD HIGHWAY SIGNS AND MARKINGS			
NB	8.956	C	UNK.	UNK.	UNK.		NO THRU TRAFFIC 6/7					1				1		13.50 X								OLD MAIN ST; INSTALL 25 FT WEST OF LLL			
NB	8.961	D	R1-1	30	30		STOP 6/7						1		X														
		C	VD-700	6	10		MILE MARKER 6/7				1	1	1														SALVAGE AND MOUNT ON NEW POST BELOW STOP SIGN			
		C/D	D3-1	32	12		TRIM 7/7 Main St 6/7	2.67								1			13.50 X								OLD MAIN ST		12	
		A/B	D3-1	42	12		Old Main St 6/7	3.50																			OLD MAIN ST		12	
		D	R1-1	30	30		STOP 6/7	6.25																			OLD MAIN ST	X		
NB	8.964	A	W2-6	30	30		CIRCULAR INTERSECTION 6/7			1				X															
		A	W3-2	30	30		YIELD AHEAD 6/7			1																			
		A	W13-1P	18	18		20 MPH 6/7			1																			
NB	8.992	A	D1-5	UNK.	UNK.		CIRCULAR INTERSECTION GUIDE SIGN 6/7			1				X															

SIGN SUMMARY SHEET	SHEET TOTALS	12.42	0.00	4	1	2	2	0	0	2	~~30.0~~ 27.00		0	0.0	0.0	0.0	0.0	PROJECT NAME: STOWE - BERKSHIRE		
		SF	SF	EA	EA	EA	EA	EA	EA	EA	FT		EA	LB	LB	LB	LB	PROJECT NUMBER: STPG SIGN (49)		
VERMONT AGENCY OF TRANSPORTATION	TOWN DIRECTIONAL TOTALS	611.0	0.0	29	13	10	140	0	0	110	1650.0		0	0.0				FILE NAME: 03 CAMBRIDGE VT-108 NB TS PROJECT MANAGER: D. BRYANT DESIGNED BY: J. BLANCHARD CAMBRIDGE NB SHEET 20	PLOT DATE: 4/15/2015 DRAWN BY: J. BLANCHARD CHECKED K. KERN SHEET 64 OF 131	

DIRECTION	MILEPOINT	LOCATION CODE (SHEET 2)	SIGN CODE	WIDTH (IN)	HEIGHT (IN)	SHEETING REMARKS	SIGN LEGEND	NEW SIGNS "A"	NEW SIGNS "B"	EXISTING SIGNS RETAIN	EXISTING SIGNS SALVAGE FROM	EXISTING SIGNS SALVAGE TO	EXISTING SIGNS REMOVE	EXIST POST RETAIN	EXIST POST REMOVE	NUMBER OF NEW POSTS	SQUARE STEEL (IN) 1.75 (LB / FT) 1.88	SQUARE STEEL (IN) 2.00 (LB / FT) 2.42	SQUARE STEEL (IN) 2.50 (LB / FT) 3.35	TUBULAR STEEL Ø (IN) FOUNDATION	TUBULAR STEEL Ø (IN) 3.00 (LB / FT) 7.60	TUBULAR STEEL Ø (IN) 3.50 (LB / FT) 9.00	TUBULAR STEEL Ø (IN) 4.00 (LB / FT) 10.80	TUBULAR STEEL Ø (IN) 5.00 (LB / FT) 14.60	SIGN FRAME REQUIRED	REMARKS	SIGN DETAIL LOCATION SHSM	SIGN DETAIL LOCATION PROJECT SHEET #	SIGN DETAIL LOCATION STANDARD SHEET #
CAMBRIDGE VT-108 SB							FY-FLUORESCENT YELLOW FYG-FLUORESCENT YELLOW GREEN																				"SHSM"-STANDARD HIGHWAY SIGNS AND MARKINGS			
SB	8.991	F	R2-1	24	30		SPEED LIMIT 25			1				X															
SB	8.942	F	S1-1	30	30	FYG	SCHOOL SYMBOL 5/9						1		X														
		F	W16-9P	24	12	FYG	AHEAD WARNING 5/9						1																
		F	S1-1	36	36	FYG	TRIM  5/9	9.00								1			14.00 X							REQUIRES VEGETATION CLEARING	X		
		F	W16-9P	24	12	FYG	 5/9	2.00																				X	
SB	8.924	F	VW-207BP	24	18		BLIND PERSON 5/9						1		X														
		F	W11-2	30	30		PEDESTRIAN SYMBOL 5/9						1																
		F	W11-2	30	30	FYG	TRIM  5/9	6.25								1			15.25 X								X	
		F	W16-4P	24	18	FYG	 5/9	3.00																			X	
SB	8.891	F	R2-1	24	30		SPEED LIMIT 25 5/9						1		X														
		F	R2-1	24	30		 5/9	5.00								1			13.50 X								X	
SB	8.887	E/F	D3-1	UNK.	UNK		DEPOT ST 5/9						1		X														
		C/D	D3-1	32	12		 5/9	2.67								1			11.00 X							DEPOT ST (TH-53); FIELD LOCATE FOR VISIBILITY FROM VT-108		12	
		E/F	D3-1	36	12		 5/9	3.00																		DEPOT ST (TH-53)		12	
SB	8.887	G	VR-017	24	30		TRIM  5/9	5.00								1			14.00 X							DEPOT ST (TH-53); INSTALL IN LINE WITH SECOND CLUSTER OF TREES; REQUIRES VEGETATION CLEARING		9	
SIGN SUMMARY SHEET							SHEET TOTALS	35.92	0.00	1	0	0	6	0	0	5		~~67.75~~ ~~75.0~~		0	0.0	0.0	0.0	0.0					
								SF	SF	EA	EA	EA	EA	EA	EA	EA		FT		EA	LB	LB	LB	LB					
VERMONT AGENCY OF TRANSPORTATION							TOWN DIRECTIONAL TOTALS	624.4	0.0	23	7	7	134	0	0	99		1485.0		2			324.0						

PROJECT NAME: **STOWE - BERKSHIRE**
PROJECT NUMBER: **STPG SIGN (49)**
FILE NAME: **04 CAMBRIDGE VT-108 SB TS** PLOT DATE: **6/25/2015**
PROJECT MANAGER: **D. BRYANT** DRAWN BY: **J. BLANCHARD**
DESIGNED BY: **J. BLANCHARD** CHECKED **K. KERN**
CAMBRIDGE SB SHEET 1 SHEET **65** OF **131**


DIRECTION	MILEPOINT	LOCATION CODE (SHEET 2)	SIGN CODE	WIDTH (IN)	HEIGHT (IN)	SHEETING REMARKS	SIGN LEGEND		NEW SIGNS		EXISTING SIGNS				EXIST POST		NUMBER OF NEW POSTS	SQUARE STEEL (IN)			TUBULAR STEEL Ø (IN)				SIGN FRAME REQUIRED	REMARKS	SIGN DETAIL LOCATION		
									"A"	"B"	RETAIN	SALVAGE FROM	SALVAGE TO	REMOVE	RETAIN	REMOVE		1.75 (LB / FT) 1.88	2.00 (LB / FT) 2.42	2.50 (LB / FT) 3.35	FOUNDATION	3.00 (LB / FT) 7.60	3.50 (LB / FT) 9.00	4.00 (LB / FT) 10.80	5.00 (LB / FT) 14.60			SHSM	PROJECT SHEET #	STANDARD SHEET #
CAMBRIDGE VT-108 SB							FY-FLUORESCENT YELLOW FYG-FLUORESCENT YELLOW GREEN																			"SHSM"-STANDARD HIGHWAY SIGNS AND MARKINGS			
SB	8.881	H	R1-1	30	30		STOP	5/9						1		X													
		G	VR-017	24	30		LLL 24,000 LBS	5/9						1															
		G	VD-700	6	10		MILE MARKER	5/9				1	1	1												SALVAGE AND MOUNT ON NEW POST BELOW STOP SIGN			
		H	R1-1	30	30			5/9	6.25								1		13.50 X							DEPOT ST (TH-53); INSTALL 20 FT CLOSER TO VT 108 IN GRASS		X		
SB	8.870	F	S1-1	30	30	FYG	SCHOOL SYMBOL	5/9						1		X													
		F	W16-7P	21	15	FYG	DOWNWARD DIAGONAL ARROW	5/9						1															
		F	S1-1	36	36	FYG		5/9	9.00								1			14.00 X							X		
		F	W16-7P	24	12	FYG		5/9	2.00																		X		
SB	8.838	F	R2-1	24	30		SPEED LIMIT 25	5/9						1		X													
		F	R2-1	24	30			5/9	5.00								1		13.50 X								X		
SB	8.743	F	M3-3	24	12		SOUTH STATE	7/7						1		X													
		F	M1-5	30	24		VERMONT 108	7/7						1															
		F	M6-1	21	15		<--- LEFT STATE	7/7						1															
		F	M3-3	24	12	GRN/ WHT		7/7	2.00								2		29.00 X							2C		X		
		F	M1-5	30	24	GRN/ WHT		7/7	5.00																				E-136B
SIGN SUMMARY SHEET							SHEET TOTALS		29.25	0.00	0	1	1	9	0	0	5		~~75.0~~ 70.00		0	0.0	0.0	0.0	0.0				
									SF	SF	EA	EA	EA	EA	EA	EA	EA		FT		EA	LB	LB	LB	LB				
VERMONT AGENCY OF TRANSPORTATION							TOWN DIRECTIONAL TOTALS		624.4	0.0	23	7	7	134	0	0	99		1485.0		2		324.0						

PROJECT NAME: **STOWE - BERKSHIRE**
PROJECT NUMBER: **STPG SIGN (49)**
FILE NAME: **04 CAMBRIDGE VT-108 SB TS** PLOT DATE: **6/25/2015**
PROJECT MANAGER: **D. BRYANT** DRAWN BY: **J. BLANCHARD**
DESIGNED BY: **J. BLANCHARD** CHECKED **K. KERN**
CAMBRIDGE SB SHEET 2 SHEET **66** OF **131**

DIRECTION	MILEPOINT	LOCATION CODE (SHEET 2)	SIGN CODE	WIDTH (IN)	HEIGHT (IN)	SHEETING REMARKS	SIGN LEGEND	NEW SIGNS "A"	NEW SIGNS "B"	EXISTING SIGNS RETAIN	EXISTING SIGNS SALVAGE FROM	EXISTING SIGNS SALVAGE TO	EXISTING SIGNS REMOVE	EXIST POST RETAIN	EXIST POST REMOVE	NUMBER OF NEW POSTS	SQUARE STEEL (IN) 1.75 (LB/FT) 1.88	SQUARE STEEL (IN) 2.00 (LB/FT) 2.42	SQUARE STEEL (IN) 2.50 (LB/FT) 3.35	TUBULAR STEEL Ø (IN) FOUNDATION	TUBULAR STEEL Ø (IN) 3.00 (LB/FT) 7.60	TUBULAR STEEL Ø (IN) 3.50 (LB/FT) 9.00	TUBULAR STEEL Ø (IN) 4.00 (LB/FT) 10.80	TUBULAR STEEL Ø (IN) 5.00 (LB/FT) 14.60	SIGN FRAME REQUIRED	REMARKS	SIGN DETAIL LOCATION SHSM	SIGN DETAIL LOCATION PROJECT SHEET #	SIGN DETAIL LOCATION STANDARD SHEET #
CAMBRIDGE VT-108 SB							FY-FLUORESCENT YELLOW FYG-FLUORESCENT YELLOW GREEN																				"SHSM"-STANDARD HIGHWAY SIGNS AND MARKINGS			
		F	M6-2L	21	15	GRN/WHT	7/7	2.19																				X		
		F	M4-5	24	12	GRN/WHT	7/7	2.00																				X		
		F	M1-5	24	24	GRN/WHT	7/7	4.00																						E-136B
		F	M6-2R	21	15	GRN/WHT	7/7	2.19																				X		
SB	8.743	F	R1-1	30	30		STOP 5/9						1		X															
		H	R1-1	30	30		STOP 5/9	6.25								1		13.00 X								CHURCH ST	X		
SB	8.743	G	M3-4	24	12		WEST STATE 8/26						1		X															
		G	M1-5	24	24		VERMONT 15 8/26						1																	
		G	M6-2	21	15		<--- LEFT (45 DEG) STATE 8/26						1																	
		G	M3-2	24	12		EAST STATE 8/26						1																	
		G	M1-5	24	24		VERMONT 15 8/26						1																	
		G	M6-1	21	15		RIGHT ---> STATE 8/26						1																	
		G	M3-1	24	12		NORTH STATE 8/26						1																	
		G	M1-5	30	24		VERMONT 108 8/26						1																	
		G	M6-1	21	15		RIGHT ---> STATE 8/26						1																	
SIGN SUMMARY SHEET							SHEET TOTALS	16.63 SF	0.00 SF	0 EA	0 EA	0 EA	10 EA	0 EA	0 EA	1 EA		13.00 ~~15.0~~ FT		0 EA	0.0 LB	0.0 LB	0.0 LB	0.0 LB					
VERMONT AGENCY OF TRANSPORTATION							TOWN DIRECTIONAL TOTALS	624.4	0.0	23	7	7	134	0	0	99		1485.0		2	324.0								

PROJECT NAME: **STOWE - BERKSHIRE**
PROJECT NUMBER: **STPG SIGN (49)**
FILE NAME: **04 CAMBRIDGE VT-108 SB TS** PLOT DATE: **6/25/2015**
PROJECT MANAGER: **D. BRYANT** DRAWN BY: **J. BLANCHARD**
DESIGNED BY: **J. BLANCHARD** CHECKED **K. KERN**
CAMBRIDGE SB SHEET 3 SHEET **67** OF **131**

DIRECTION	MILEPOINT	LOCATION CODE (SHEET 2)	SIGN CODE	WIDTH (IN)	HEIGHT (IN)	SHEETING REMARKS	SIGN LEGEND	NEW SIGNS "A"	NEW SIGNS "B"	EXISTING SIGNS RETAIN	EXISTING SIGNS SALVAGE FROM	EXISTING SIGNS SALVAGE TO	EXISTING SIGNS REMOVE	EXIST POST RETAIN	EXIST POST REMOVE	NUMBER OF NEW POSTS	SQUARE STEEL (IN) 1.75 (LB/FT) 1.88	SQUARE STEEL (IN) 2.00 (LB/FT) 2.42	SQUARE STEEL (IN) 2.50 (LB/FT) 3.35	TUBULAR STEEL Ø (IN) FOUNDATION	TUBULAR STEEL Ø (IN) 3.00 (LB/FT) 7.60	TUBULAR STEEL Ø (IN) 3.50 (LB/FT) 9.00	TUBULAR STEEL Ø (IN) 4.00 (LB/FT) 10.80	TUBULAR STEEL Ø (IN) 5.00 (LB/FT) 14.60	SIGN FRAME REQUIRED	REMARKS	SIGN DETAIL LOCATION SHSM	SIGN DETAIL LOCATION PROJECT SHEET #	SIGN DETAIL LOCATION STANDARD SHEET #
CAMBRIDGE VT-108 SB							FY-FLUORESCENT YELLOW FYG-FLUORESCENT YELLOW GREEN																			"SHSM"-STANDARD HIGHWAY SIGNS AND MARKINGS			
		G	M4-5	24	12		TO STATE 8/26						1																
		G	M1-5	30	24		VERMONT 109 8/26						1																
		G	M6-1	21	15		RIGHT ---> STATE 8/26						1																
		H	M3-3	24	12		SOUTH STATE 7/7						1																
		H	M1-5	30	24		VERMONT 108 7/7						1																
		H	M6-2	21	15		RIGHT ---> (45 DEG) STATE 7/7						1																
		G	M4-5	24	12	GRN/WHT	8/16	2.00												2			29.0 X		2B	29.0 LF X 10.80 LB/LF =313.2 LBS	X		
		G	M3-4	24	12	GRN/WHT	8/16	2.00																			X		
		G	M1-5	24	24	GRN/WHT	8/16	4.00																					E-136B
		G	M6-2L	21	15	GRN/WHT	8/16	2.19																			X		
		G	M4-5	24	12	GRN/WHT	8/16	2.00																			X		
		G	M3-2	24	12	GRN/WHT	8/16	2.00																			X		
		G	M1-5	24	24	GRN/WHT	7/7	4.00																					E-136B
		G	M6-1R	21	15	GRN/WHT	7/7	2.19																			X		
		G	M3-1	24	12	GRN/WHT	7/7	2.00																		2C		X		

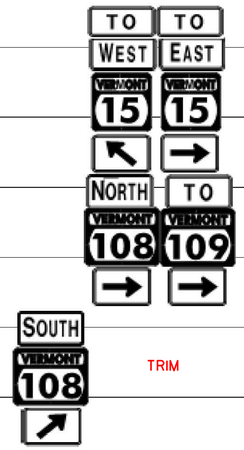

TRIM

SIGN SUMMARY SHEET	SHEET TOTALS	22.38	0.00	0	0	0	6	0	0	0		0.0		2	0.0	0.0	324.0	0.0											
		SF	SF	EA	EA	EA	EA	EA	EA	EA		FT		EA	LB	LB	LB	LB											
VERMONT AGENCY OF TRANSPORTATION	TOWN DIRECTIONAL TOTALS	624.4	0.0	23	7	7	134	0	0	99		1485.0		2			~~324.0~~ 313.2												

PROJECT NAME: **STOWE - BERKSHIRE**
PROJECT NUMBER: **STPG SIGN (49)**
FILE NAME: **04 CAMBRIDGE VT-108 SB TS** PLOT DATE: **6/25/2015**
PROJECT MANAGER: **D. BRYANT** DRAWN BY: **J. BLANCHARD**
DESIGNED BY: **J. BLANCHARD** CHECKED **K. KERN**
CAMBRIDGE SB SHEET 4 SHEET **68** OF **131**

DIRECTION	MILEPOINT	LOCATION CODE (SHEET 2)	SIGN CODE	WIDTH (IN)	HEIGHT (IN)	SHEETING REMARKS	SIGN LEGEND	NEW SIGNS "A"	NEW SIGNS "B"	EXISTING SIGNS RETAIN	EXISTING SIGNS SALVAGE FROM	EXISTING SIGNS SALVAGE TO	EXISTING SIGNS REMOVE	EXIST POST RETAIN	EXIST POST REMOVE	NUMBER OF NEW POSTS	SQUARE STEEL (IN) 1.75 (LB / FT) 1.88	SQUARE STEEL (IN) 2.00 (LB / FT) 2.42	SQUARE STEEL (IN) 2.50 (LB / FT) 3.35	TUBULAR STEEL Ø (IN) FOUNDATION	TUBULAR STEEL Ø (IN) 3.00 (LB / FT) 7.60	TUBULAR STEEL Ø (IN) 3.50 (LB / FT) 9.00	TUBULAR STEEL Ø (IN) 4.00 (LB / FT) 10.80	TUBULAR STEEL Ø (IN) 5.00 (LB / FT) 14.60	SIGN FRAME REQUIRED	REMARKS	SIGN DETAIL LOCATION SHSM	SIGN DETAIL LOCATION PROJECT SHEET #	SIGN DETAIL LOCATION STANDARD SHEET #
CAMBRIDGE VT-108 SB							FY-FLUORESCENT YELLOW FYG-FLUORESCENT YELLOW GREEN																			"SHSM"-STANDARD HIGHWAY SIGNS AND MARKINGS			
		G	M1-5	30	24	GRN/ WHT	7/7	5.00																			E-136B
		G	M6-1R	21	15	GRN/ WHT	7/7	2.19																		X		
		G	M4-5	24	12	GRN/ WHT	7/7	2.00																		X		
		G	M1-5	30	24	GRN/ WHT	8/26	5.00																			E-136B
		G	M6-1R	21	15	GRN/ WHT	8/26	2.19																		X		
		H	M3-3	24	12	GRN/ WHT	8/26	2.00																		X		
		H	M1-5	30	24	GRN/ WHT	8/26	5.00																			E-136B
		H	M6-2R	21	15	GRN/ WHT	8/26	2.19																		X		
SB	8.743	G	R1-1	30	30		STOP 5/9						1		X													
		G	R1-1	30	30		 5/9	6.25								1		13.0 X								CHURCH ST; INSTALL ADJACENT TO PAVEMENT MARKINGS	X		
SB	8.741	F	R1-1	30	30		STOP 5/9						1		X													
		C/D	D3-1	32	12		 5/9	2.67								1			13.0 X							CHURCH ST; MOUNT TO STREET NAME SIGN WITH BRACKET		12	
		E/F	D3-1	42	12		 5/9	3.50																		CHURCH ST; MOUNT TO STOP SIGN WITH BRACKET		13	
		F	R1-1	30	30		 5/9	6.25																		CHURCH ST	X		
SB	8.722	F	VW-133R	30	30		 5/9	6.25								1		14.0 X								INSTALL AT END OF WOOD POST FENCE		10	
SIGN SUMMARY SHEET							SHEET TOTALS	50.48 SF	0.00 SF	0 EA	0 EA	0 EA	2 EA	0 EA	0 EA	3 EA		~~40.0~~ ~~45.0~~ FT		0 EA	0.0 LB	0.0 LB	0.0 LB	0.0 LB					
VERMONT AGENCY OF TRANSPORTATION							TOWN DIRECTIONAL TOTALS	624.4	0.0	23	7	7	134	0	0	99		1485.0		2	324.0								

PROJECT NAME: **STOWE - BERKSHIRE**
PROJECT NUMBER: **STPG SIGN (49)**
FILE NAME: **04 CAMBRIDGE VT-108 SB TS** PLOT DATE: **6/25/2015**
PROJECT MANAGER: **D. BRYANT** DRAWN BY: **J. BLANCHARD**
DESIGNED BY: **J. BLANCHARD** CHECKED **K. KERN**
CAMBRIDGE SB SHEET 5 SHEET **69** OF **131**

DIRECTION	MILEPOINT	LOCATION CODE (SHEET 2)	SIGN CODE	WIDTH (IN)	HEIGHT (IN)	SHEETING REMARKS	SIGN LEGEND	NEW SIGNS "A"	NEW SIGNS "B"	EXISTING SIGNS RETAIN	EXISTING SIGNS SALVAGE FROM	EXISTING SIGNS SALVAGE TO	EXISTING SIGNS REMOVE	EXIST POST RETAIN	EXIST POST REMOVE	NUMBER OF NEW POSTS	SQUARE STEEL (IN) 1.75 (LB/FT) 1.88	SQUARE STEEL (IN) 2.00 (LB/FT) 2.42	SQUARE STEEL (IN) 2.50 (LB/FT) 3.35	TUBULAR STEEL Ø (IN) FOUNDATION	TUBULAR STEEL Ø (IN) 3.00 (LB/FT) 7.60	TUBULAR STEEL Ø (IN) 3.50 (LB/FT) 9.00	TUBULAR STEEL Ø (IN) 4.00 (LB/FT) 10.80	TUBULAR STEEL Ø (IN) 5.00 (LB/FT) 14.60	SIGN FRAME REQUIRED	REMARKS	SIGN DETAIL LOCATION SHSM	SIGN DETAIL LOCATION PROJECT SHEET #	SIGN DETAIL LOCATION STANDARD SHEET #
CAMBRIDGE VT-108 SB							FY-FLUORESCENT YELLOW FYG-FLUORESCENT YELLOW GREEN																				"SHSM"-STANDARD HIGHWAY SIGNS AND MARKINGS			
SB	8.714	F	VW-054R	30	30		HIDDEN DRIVE RIGHT 5/9						1		X														
SB	8.692	F	R2-1	24	30		SPEED LIMIT 35 5/9						1		X														
		F	VR-041	30	30		THROUGH WAY BEGINS HERE 5/9						1																
		F	R2-1	24	30		 TRIM 5/9	5.00								1		12.50 X								X		
SB	8.655	F	M3-3	24	12		SOUTH STATE 5/9						1		X														
		F	M1-5	30	24		VERMONT 108 5/9						1																
		F	W8-1	30	30		BUMP TRIM 5/9						1																
		F	M3-3	24	12	GRN/WHT	 5/9	2.00								1		14.75 X								X		
		F	M1-5	30	24	GRN/WHT	5/9	5.00																				E-136B
SB	8.629	F	VW-060	30	30		HIDDEN DRIVES 5/9						1		X														
		F	VD-700	6	10		MILE MARKER 5/9				1	1	1														SALVAGE AND MOUNT ON NEW POST BELOW HIDDEN DRIVES SIGN			
		F	VW-060	30	30		 5/9	6.25								1		14.00 X										10	
SB	8.555	F	VR-493H	48	60		VT 108 OPEN TO SKI AREA CLOSED THRU SMUGGLERS NOTCH (HINGED)			1				X																
SB	8.509	F	R2-1	24	30		SPEED LIMIT 35 5/9						1		X														
SB	8.451	F	W1-2R	30	30		RIGHT CURVE 5/9						1		X														
SIGN SUMMARY SHEET							SHEET TOTALS	18.25	0.00	1	1	1	10	0	0	3		~~45.0~~ 41.25		0	0.0	0.0	0.0	0.0					
								SF	SF	EA	EA	EA	EA	EA	EA	EA		FT		EA	LB	LB	LB	LB					
VERMONT AGENCY OF TRANSPORTATION							TOWN DIRECTIONAL TOTALS	624.4	0.0	23	7	7	134	0	0	99		1485.0		2		324.0							

PROJECT NAME: **STOWE - BERKSHIRE**
PROJECT NUMBER: **STPG SIGN (49)**
FILE NAME: **04 CAMBRIDGE VT-108 SB TS** PLOT DATE: **6/25/2015**
PROJECT MANAGER: **D. BRYANT** DRAWN BY: **J. BLANCHARD**
DESIGNED BY: **J. BLANCHARD** CHECKED **K. KERN**
CAMBRIDGE SB SHEET 6 SHEET **70** OF **131**

DIRECTION	MILEPOINT	LOCATION CODE (SHEET 2)	SIGN CODE	WIDTH (IN)	HEIGHT (IN)	SHEETING REMARKS	SIGN LEGEND		NEW SIGNS "A"	NEW SIGNS "B"	EXISTING SIGNS RETAIN	EXISTING SIGNS SALVAGE FROM	EXISTING SIGNS SALVAGE TO	EXISTING SIGNS REMOVE	EXIST POST RETAIN	EXIST POST REMOVE	NUMBER OF NEW POSTS	SQUARE STEEL (IN) 1.75 (LB/FT) 1.88	SQUARE STEEL (IN) 2.00 (LB/FT) 2.42	SQUARE STEEL (IN) 2.50 (LB/FT) 3.35	TUBULAR STEEL Ø (IN) FOUNDATION	TUBULAR STEEL Ø (IN) 3.00 (LB/FT) 7.60	TUBULAR STEEL Ø (IN) 3.50 (LB/FT) 9.00	TUBULAR STEEL Ø (IN) 4.00 (LB/FT) 10.80	TUBULAR STEEL Ø (IN) 5.00 (LB/FT) 14.60	SIGN FRAME REQUIRED	REMARKS	SIGN DETAIL LOCATION SHSM	SIGN DETAIL LOCATION PROJECT SHEET #	SIGN DETAIL LOCATION STANDARD SHEET #
CAMBRIDGE VT-108 SB							FY-FLUORESCENT YELLOW FYG-FLUORESCENT YELLOW GREEN																				"SHSM"-STANDARD HIGHWAY SIGNS AND MARKINGS			
		F	W1-2R	30	30			5/9	6.25								1		13.75 X									X		
SB	8.408	F	S3-1	30	30		SCHOOL BUS STOP AHEAD	5/9						1		X													
		F	S3-1	36	36	FYG		TRIM 5/9	9.00								2		27.25 X									X		
SB	8.250	E	W1-2L	36	36		LEFT CURVE	5/9						1		X													
SB	8.190	E	R2-1	36	48		SPEED LIMIT 35	5/9						1		X													
		F	R2-1	24	30		SPEED LIMIT 40	5/9						1															
		F	R2-1	24	30			TRIM 5/9	5.00								1		14.00 X									X		
SB	8.112	F	VW-054R	30	30	FY	HIDDEN DRIVE RIGHT	5/11						1		X													
		F	VW-133R	30	30	FY		TRIM 5/11	6.25								1		14.00 X										10	
SB	8.007	F	R2-1	24	30		SPEED LIMIT 40	5/11						1		X													
SB	7.751	F	R2-1	24	30		NEED TO CHANGE TO 7.757  40	5/11 8/15 RELOCATED	5.00								1		15.00 X									INSTALL ACROSS FROM NB 40 MPH AT SAME MILEPOINT	X		
SB	7.606	F	W1-1L	30	30		LEFT TURN	5/11						1		X													
		F	W13-1P	24	24		30 MPH	5/11						1															
SB	7.564	F	W1-1L	30	30			TRIM 5/11	6.25								1			16.00 X								INSTALL 222 FT SOUTH OF EXISTING	X		
		F	W13-1P	18	18			5/11	2.25																			X		
SIGN SUMMARY SHEET							SHEET TOTALS		40.00 SF	0.00 SF	0 EA	0 EA	0 EA	8 EA	0 EA	0 EA	7 EA		100.00 ~~105.0~~ FT		0 EA	0.0 LB	0.0 LB	0.0 LB	0.0 LB					
VERMONT AGENCY OF TRANSPORTATION							TOWN DIRECTIONAL TOTALS		624.4	0.0	23	7	7	134	0	0	99		1485.0		2	324.0								


PROJECT NAME: **STOWE - BERKSHIRE**
PROJECT NUMBER: **STPG SIGN (49)**
FILE NAME: **04 CAMBRIDGE VT-108 SB TS** PLOT DATE: **6/25/2015**
PROJECT MANAGER: **D. BRYANT** DRAWN BY: **J. BLANCHARD**
DESIGNED BY: **J. BLANCHARD** CHECKED **K. KERN**
CAMBRIDGE SB SHEET 7 SHEET **71** OF **131**

DIRECTION	MILEPOINT	LOCATION CODE (SHEET 2)	SIGN CODE	WIDTH (IN)	HEIGHT (IN)	SHEETING REMARKS	SIGN LEGEND	NEW SIGNS "A"	NEW SIGNS "B"	EXISTING SIGNS RETAIN	EXISTING SIGNS SALVAGE FROM	EXISTING SIGNS SALVAGE TO	EXISTING SIGNS REMOVE	EXIST POST RETAIN	EXIST POST REMOVE	NUMBER OF NEW POSTS	SQUARE STEEL (IN) 1.75 (LB/FT) 1.88	SQUARE STEEL (IN) 2.00 (LB/FT) 2.42	SQUARE STEEL (IN) 2.50 (LB/FT) 3.35	TUBULAR STEEL Ø (IN) FOUNDATION	TUBULAR STEEL Ø (IN) 3.00 (LB/FT) 7.60	TUBULAR STEEL Ø (IN) 3.50 (LB/FT) 9.00	TUBULAR STEEL Ø (IN) 4.00 (LB/FT) 10.80	TUBULAR STEEL Ø (IN) 5.00 (LB/FT) 14.60	SIGN FRAME REQUIRED	REMARKS	SIGN DETAIL LOCATION SHSM	SIGN DETAIL LOCATION PROJECT SHEET #	SIGN DETAIL LOCATION STANDARD SHEET #
CAMBRIDGE VT-108 SB							FY-FLUORESCENT YELLOW FYG-FLUORESCENT YELLOW GREEN																			"SHSM"-STANDARD HIGHWAY SIGNS AND MARKINGS			
SB	7.523	F	W1-6L	48	24		LEFT <=== LARGE ARROW 5/12						1		X														
SB	7.517	F	W1-8L	18	24		 5/12	3.00								1		14.00 X									INSTALL 32 FT SOUTH OF EXISTING LEFT ARROW AT M.P. 7.523	X		
		E	W1-8R	18	24		 5/12	3.00																			X		
SB	7.509	F	W1-8L	18	24		 TRIM 5/12	3.00								1		14.25 X									INSTALL 42 FT SOUTH OF PREVIOUS CHEVRON ASSEMBLY AT M.P. 7.517	X		
		E	W1-8R	18	24		 5/12	3.00																			X		
SB	7.501	F	W1-8L	18	24		 5/12	3.00								1		14.75 X									INSTALL NORTH OF INTERSECTION WITH PRATT RD (TH-42)	X		
		E	W1-8R	18	24		 5/12	3.00																			X		
SB	7.502	G	VR-017	18	24		LLL 24,000 LBS 5/11						1		X														
		G	VR-017	18	24		 5/11	5.00 ~~3.00~~								1		14.75 X									PRATT RD (TH-42)		9	
SB	7.502	E/F	D3-1	UNK.	UNK.		VT RTE 108 S 5/11						1		X														
		E/F	D3-1	UNK.	UNK.		PRATT RD 5/11						1																
		G/H	D3-1	52	12		 5/11	4.33								2		27.25 X									PRATT RD (TH-42); MOUNT TO STREET SIGN WITH BRACKET		12	
		E/F	D3-1	34	12		 5/11	2.83																			PRATT RD (TH-42)		13	
SB	7.496	H	R1-1	30	30		STOP 5/11						1		X														
		G	VD-700	6	10		MILE MARKER 5/11						1																
SIGN SUMMARY SHEET							SHEET TOTALS	~~30.17~~ 28.17 SF	0.00 SF	0 EA	0 EA	0 EA	6 EA	0 EA	0 EA	6 EA	~~85.00~~ 90.0 FT		0 EA	0.0 LB	0.0 LB	0.0 LB	0.0 LB				
VERMONT AGENCY OF TRANSPORTATION							TOWN DIRECTIONAL TOTALS	624.4	0.0	23	7	7	134	0	0	99	1485.0		2	324.0								

PROJECT NAME: **STOWE - BERKSHIRE**
PROJECT NUMBER: **STPG SIGN (49)**
FILE NAME: **04 CAMBRIDGE VT-108 SB TS** PLOT DATE: **6/25/2015**
PROJECT MANAGER: **D. BRYANT** DRAWN BY: **J. BLANCHARD**
DESIGNED BY: **J. BLANCHARD** CHECKED **K. KERN**
CAMBRIDGE SB SHEET 8 SHEET **72** OF **131**

DIRECTION	MILEPOINT	LOCATION CODE (SHEET 2)	SIGN CODE	WIDTH (IN)	HEIGHT (IN)	SHEETING REMARKS	SIGN LEGEND	NEW SIGNS "A"	NEW SIGNS "B"	EXISTING SIGNS RETAIN	EXISTING SIGNS SALVAGE FROM	EXISTING SIGNS SALVAGE TO	EXISTING SIGNS REMOVE	EXIST POST RETAIN	EXIST POST REMOVE	NUMBER OF NEW POSTS	SQUARE STEEL (IN) 1.75 (LB/FT) 1.88	SQUARE STEEL (IN) 2.00 (LB/FT) 2.42	SQUARE STEEL (IN) 2.50 (LB/FT) 3.35	TUBULAR STEEL Ø (IN) FOUNDATION	TUBULAR STEEL Ø (IN) 3.00 (LB/FT) 7.60	TUBULAR STEEL Ø (IN) 3.50 (LB/FT) 9.00	TUBULAR STEEL Ø (IN) 4.00 (LB/FT) 10.80	TUBULAR STEEL Ø (IN) 5.00 (LB/FT) 14.60	SIGN FRAME REQUIRED	REMARKS	SIGN DETAIL LOCATION SHSM	SIGN DETAIL LOCATION PROJECT SHEET #	SIGN DETAIL LOCATION STANDARD SHEET #
CAMBRIDGE VT-108 SB							FY-FLUORESCENT YELLOW FYG-FLUORESCENT YELLOW GREEN																			"SHSM"-STANDARD HIGHWAY SIGNS AND MARKINGS			
SB	7.492	H	R1-1	30	30		 5/11	6.25								1		14.25 X								PRATT RD (TH-42); INSTALL 20 FT CLOSER TO VT 108 THAN EXISTING	X		
SB	7.489	F	W1-8L	18	24		 5/12	3.00								1		13.00 X								INSTALL 42 FT NORTH OF LAST CHEVRON; IN GRASS BETWEEN DRIVE AND TH-42	X		
		E	W1-8R	18	24		 5/12	3.00																			X		
SB	7.481	E	W1-8L	18	24		CHEVRON 5/12						1		X														
		F	W1-8R	18	24		CHEVRON 5/12						1																
		F	W1-8L	18	24		 TRIM 5/12	3.00								1		12.50 X									X		
		E	W1-8R	18	24		 5/12	3.00																			X		
SB	7.473	E	W1-8L	18	24		CHEVRON 5/12						1		X														
		F	W1-8R	18	24		CHEVRON 5/12						1																
		F	W1-8L	18	24		 5/12	3.00								1		12.75 X									X		
		E	W1-8R	18	24		 5/12	3.00																			X		
SB	7.465	F	W1-8L	18	24		CHEVRON 5/12						1		X														
		E	W1-8R	18	24		CHEVRON 5/12						1																
		F	W1-8L	18	24		 5/12	3.00								1		12.75 X									X		
		E	W1-8R	18	24		 5/12	3.00																			X		
SIGN SUMMARY SHEET							SHEET TOTALS	30.25	0.00	0	0	0	6	0	0	5		65.25 ~~75.0~~		0	0.0	0.0	0.0	0.0					
								SF	SF	EA	EA	EA	EA	EA	EA	EA		FT		EA	LB	LB	LB	LB					
VERMONT AGENCY OF TRANSPORTATION							TOWN DIRECTIONAL TOTALS	624.4	0.0	23	7	7	134	0	0	99		1485.0		2	324.0								

PROJECT NAME: STOWE - BERKSHIRE
PROJECT NUMBER: STPG SIGN (49)
FILE NAME: 04 CAMBRIDGE VT-108 SB TS
PROJECT MANAGER: D. BRYANT
DESIGNED BY: J. BLANCHARD
CAMBRIDGE SB SHEET 9
PLOT DATE: 6/25/2015
DRAWN BY: J. BLANCHARD
CHECKED K. KERN
SHEET 73 OF 131

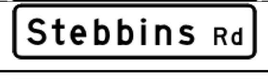DIRECTION	MILEPOINT	LOCATION CODE (SHEET 2)	SIGN CODE	WIDTH (IN)	HEIGHT (IN)	SHEETING REMARKS	SIGN LEGEND	NEW SIGNS "A"	NEW SIGNS "B"	EXISTING SIGNS RETAIN	EXISTING SIGNS SALVAGE FROM	EXISTING SIGNS SALVAGE TO	EXISTING SIGNS REMOVE	EXIST POST RETAIN	EXIST POST REMOVE	NUMBER OF NEW POSTS	SQUARE STEEL (IN) 1.75 (LB/FT) 1.88	SQUARE STEEL (IN) 2.00 (LB/FT) 2.42	SQUARE STEEL (IN) 2.50 (LB/FT) 3.35	TUBULAR STEEL Ø (IN) FOUNDATION	TUBULAR STEEL Ø (IN) 3.00 (LB/FT) 7.60	TUBULAR STEEL Ø (IN) 3.50 (LB/FT) 9.00	TUBULAR STEEL Ø (IN) 4.00 (LB/FT) 10.80	TUBULAR STEEL Ø (IN) 5.00 (LB/FT) 14.60	SIGN FRAME REQUIRED	REMARKS	SIGN DETAIL LOCATION SHSM	SIGN DETAIL LOCATION PROJECT SHEET #	SIGN DETAIL LOCATION STANDARD SHEET #
CAMBRIDGE VT-108 SB							FY-FLUORESCENT YELLOW FYG-FLUORESCENT YELLOW GREEN						2													"SHSM"-STANDARD HIGHWAY SIGNS AND MARKINGS			
SB	7.399	E	W1-6	48	24		RIGHT ===> LARGE ARROW						1		X														
SB	7.309	E	W1-1R	30	30		RIGHT TURN						1		X														
		E	W13-1P	24	24		30 MPH						1																
SB	7.264	E/F	D3-1	UNK.	UNK.		IRIS LANE 5/11						1		X														
		E/F	D3-1	40	12		 TRIM 5/11	3.33								1		11.25 X								IRIS LN (PVT)		13	
SB	7.226	E/F	D3-1	UNK.	UNK.		STEBBINS RD						1		X														
		G/H	D3-1	UNK.	UNK.		VT RTE 108						1																
		G	VD-700	6	10		MILE MARKER						1																
SB	7.226	G	VR-017	24	30		 TRIM 5/11	5.00								1		14.75 X								STEBBINS RD (TH-44); INSTALL 50 FT WEST OF UTILITY POLE		9	
SB	7.217	H	R1-1	30	30		STOP 5/11						1		X														
		G	VD-700	6	10		MILE MARKER 5/11				1	1	1														SALVAGE AND MOUNT ON NEW POST BELOW STOP SIGN			
		H	R1-1	30	30		 5/11	6.25								1		14.00 X								STEBBINS RD (TH-44)	X		
SB	7.217	C/D	D3-1	52	12		 5/11	4.33								2		25.00 X								STEBBINS RD (TH-44); FIELD LOCATE FOR VISIBILITY FROM VT-108		12	
		E/F	D3-1	50	12		 5/11	4.17																				13	
SB	6.880	E/F	D3-1	56	12		 6/30	4.67								2		20.75 X								HOLMES DR (PVT); FIELD LOCATE FOR VISIBILITY FROM VT-108		13	
SIGN SUMMARY SHEET							SHEET TOTALS	27.75	0.00	0	1	1	11 ~~9~~	0	0	7		85.75 ~~105.0~~		0	0.0	0.0	0.0	0.0					
								SF	SF	EA	EA	EA	EA	EA	EA	EA		FT		EA	LB	LB	LB	LB					
VERMONT AGENCY OF TRANSPORTATION							TOWN DIRECTIONAL TOTALS	624.4	0.0	23	7	7	134	0	0	99		1485.0		2	324.0								

PROJECT NAME: **STOWE - BERKSHIRE**
PROJECT NUMBER: **STPG SIGN (49)**
FILE NAME: **04 CAMBRIDGE VT-108 SB TS** PLOT DATE: **6/25/2015**
PROJECT MANAGER: **D. BRYANT** DRAWN BY: **J. BLANCHARD**
DESIGNED BY: **J. BLANCHARD** CHECKED **K. KERN**
CAMBRIDGE SB SHEET 10 SHEET **74** OF **131**

DIRECTION	MILEPOINT	LOCATION CODE (SHEET 2)	SIGN CODE	WIDTH (IN)	HEIGHT (IN)	SHEETING REMARKS	SIGN LEGEND		NEW SIGNS "A"	NEW SIGNS "B"	EXISTING SIGNS RETAIN	EXISTING SIGNS SALVAGE FROM	EXISTING SIGNS SALVAGE TO	EXISTING SIGNS REMOVE	EXIST POST RETAIN	EXIST POST REMOVE	NUMBER OF NEW POSTS	SQUARE STEEL (IN) 1.75 (LB/FT) 1.88	SQUARE STEEL (IN) 2.00 (LB/FT) 2.42	SQUARE STEEL (IN) 2.50 (LB/FT) 3.35	TUBULAR STEEL Ø (IN) FOUNDATION	TUBULAR STEEL Ø (IN) 3.00 (LB/FT) 7.60	TUBULAR STEEL Ø (IN) 3.50 (LB/FT) 9.00	TUBULAR STEEL Ø (IN) 4.00 (LB/FT) 10.80	TUBULAR STEEL Ø (IN) 5.00 (LB/FT) 14.60	SIGN FRAME REQUIRED	REMARKS	SIGN DETAIL LOCATION SHSM	SIGN DETAIL LOCATION PROJECT SHEET #	SIGN DETAIL LOCATION STANDARD SHEET #
CAMBRIDGE VT-108 SB							FY-FLUORESCENT YELLOW FYG-FLUORESCENT YELLOW GREEN																					"SHSM"-STANDARD HIGHWAY SIGNS AND MARKINGS			
SB	6.874	E/F	D3-1	UNK.	UNK.		HOLMES DR PVT	6/30						1		X														
SB	6.788	E/F	D3-1	UNK.	UNK.		WILD APPLE LN	6/30						1		X														
		E/F	D3-1	70	12			6/30	5.83						2	23.00 X									WILD APPLE LN (PVT)		13	
SB	6.249	F	VD-062B	72	16		BUSINESS SIGN				1				X														
SB	6.097	F	W1-2R	30	30		RIGHT CURVE	5/11						1		X														
SB	6.072	F	W1-2R	30	30			5/11	6.25								1	16.00 X									INSTALL 132 FT SOUTH OF EXISTING	X		
SB	5.989	G	VR-017	24	30		LLL 24,000 LBS	6/30						1		X														
		G	VR-017	24	30		 TRIM	6/30	5.00							1	11.00 X									BURNOR RD (TH-50); REQUIRES VEGETATION CLEARING		9	
SB	5.986	E/F	D3-1	42	12		BURNOR RD	6/30			1				X														
SB	5.986	H	R1-1	30	30		STOP	5/12						1		X														
		G	VD-700	6	10		MILE MARKER	5/12				1	1	1													SALVAGE AND MOUNT ON NEW POST BELOW STOP SIGN			
		H	R1-1	30	30		 TRIM	5/12	6.25								1	13.50 X									BURNOR RD (TH-50)	X		
SB	5.693	F	D5-5a	24	24		PICNIC TABLE SYMBOL	5/11						1		X														
		F	VD9-2A	24	6		<--- LEFT SERVICE 	5/11						1																
		F	D5-5a	24	24	WHT/ BLU		5/11	4.00								1	14.50 X										X		
SIGN SUMMARY SHEET							SHEET TOTALS		27.33 SF	0.00 SF	2 EA	1 EA	1 EA	8 EA	0 EA	0 EA	6 EA	78.00 ~~90.0~~ FT			0 EA	0.0 LB	0.0 LB	0.0 LB	0.0 LB					
VERMONT AGENCY OF TRANSPORTATION							TOWN DIRECTIONAL TOTALS		624.4	0.0	23	7	7	134	0	0	99	1485.0			2	324.0								

PROJECT NAME: **STOWE - BERKSHIRE**
PROJECT NUMBER: **STPG SIGN (49)**
FILE NAME: **04 CAMBRIDGE VT-108 SB TS** PLOT DATE: **6/25/2015**
PROJECT MANAGER: **D. BRYANT** DRAWN BY: **J. BLANCHARD**
DESIGNED BY: **J. BLANCHARD** CHECKED **K. KERN**
CAMBRIDGE SB SHEET 11 SHEET **75** OF **131**

DIRECTION	MILEPOINT	LOCATION CODE (SHEET 2)	SIGN CODE	WIDTH (IN)	HEIGHT (IN)	SHEETING REMARKS	SIGN LEGEND	NEW SIGNS "A"	NEW SIGNS "B"	EXISTING SIGNS RETAIN	EXISTING SIGNS SALVAGE FROM	EXISTING SIGNS SALVAGE TO	EXISTING SIGNS REMOVE	EXIST POST RETAIN	EXIST POST REMOVE	NUMBER OF NEW POSTS	SQUARE STEEL (IN) 1.75 (LB/FT) 1.88	SQUARE STEEL (IN) 2.00 (LB/FT) 2.42	SQUARE STEEL (IN) 2.50 (LB/FT) 3.35	TUBULAR STEEL Ø (IN) FOUNDATION	TUBULAR STEEL Ø (IN) 3.00 (LB/FT) 7.60	TUBULAR STEEL Ø (IN) 3.50 (LB/FT) 9.00	TUBULAR STEEL Ø (IN) 4.00 (LB/FT) 10.80	TUBULAR STEEL Ø (IN) 5.00 (LB/FT) 14.60	SIGN FRAME REQUIRED	REMARKS	SIGN DETAIL LOCATION SHSM	SIGN DETAIL LOCATION PROJECT SHEET #	SIGN DETAIL LOCATION STANDARD SHEET #
CAMBRIDGE VT-108 SB							FY-FLUORESCENT YELLOW FYG-FLUORESCENT YELLOW GREEN																				"SHSM"-STANDARD HIGHWAY SIGNS AND MARKINGS			
		F	M6-1L	21	15	WHT/BLU	5/11	2.19																			X		
SB	5.620	F	VW-054R	30	30		HIDDEN DRIVE RIGHT 5/11						1		X														
		F	VW-133R	30	30		 5/11	6.25								1		15.50 X										10	
SB	5.422	E/F	D3-1	UNK.	UNK.		LOG CABIN DR PVT 5/11						1		X														
		E/F	D3-1	66	12		 5/11	5.50								2		25.50 X								LOG CABIN DR (PVT)		13	
SB	4.625	F	VD-062B	72	16		BUSINESS SIGN 5/12			1				X															
		F	VD-062B	72	16		BUSINESS SIGN 5/12			1																			
		F	VD-062B	72	16		BUSINESS SIGN 5/12			1																			
		F	VD-700	6	10		MILE MARKER 5/12			1																			
SB	4.411	F	W3-5	36	36		 5/11	9.00								2		29.75 X								INSTALL 105 FT NORTH OF EXISTING	X		
SB	4.391	F	W3-5	36	36		SPEED REDUCTION SPEED LIMIT 40 5/11						1		X														
SB	4.318	F	R2-1	24	30		SPEED LIMIT 40 5/11						1		X														
		F	R2-1	30	36		 5/11	7.50								1		16.25 X									X		
SB	4.240	F	W11-2	30	30	FYG	PEDESTRIAN SYMBOL 5/11						1		X														
		F	W7-3aP	24	18	FYG	NEXT 1/2 MILE 5/11						1																
							SHEET TOTALS	30.44 SF	0.00 SF	4 EA	0 EA	0 EA	6 EA	0 EA	0 EA	6 EA			87.00 ~~90.0~~ FT		0 EA	0.0 LB	0.0 LB	0.0 LB	0.0 LB					
							TOWN DIRECTIONAL TOTALS	624.4	0.0	23	7	7	134	0	0	99			1485.0		2	324.0										

SIGN SUMMARY SHEET

VERMONT AGENCY OF TRANSPORTATION

PROJECT NAME: STOWE - BERKSHIRE
PROJECT NUMBER: STPG SIGN (49)
FILE NAME: 04 CAMBRIDGE VT-108 SB TS
PROJECT MANAGER: D. BRYANT
DESIGNED BY: J. BLANCHARD
CAMBRIDGE SB SHEET 12
PLOT DATE: 6/25/2015
DRAWN BY: J. BLANCHARD
CHECKED K. KERN
SHEET 76 OF 131

DIRECTION	MILEPOINT	LOCATION CODE (SHEET 2)	SIGN CODE	WIDTH (IN)	HEIGHT (IN)	SHEETING REMARKS	SIGN LEGEND	NEW SIGNS "A"	NEW SIGNS "B"	EXISTING SIGNS RETAIN	EXISTING SIGNS SALVAGE FROM	EXISTING SIGNS SALVAGE TO	EXISTING SIGNS REMOVE	EXIST POST RETAIN	EXIST POST REMOVE	NUMBER OF NEW POSTS	SQUARE STEEL (IN) 1.75 (LB/FT) 1.88	SQUARE STEEL (IN) 2.00 (LB/FT) 2.42	SQUARE STEEL (IN) 2.50 (LB/FT) 3.35	TUBULAR STEEL Ø (IN) FOUNDATION	TUBULAR STEEL Ø (IN) 3.00 (LB/FT) 7.60	TUBULAR STEEL Ø (IN) 3.50 (LB/FT) 9.00	TUBULAR STEEL Ø (IN) 4.00 (LB/FT) 10.80	TUBULAR STEEL Ø (IN) 5.00 (LB/FT) 14.60	SIGN FRAME REQUIRED	REMARKS	SIGN DETAIL LOCATION SHSM	SIGN DETAIL LOCATION PROJECT SHEET #	SIGN DETAIL LOCATION STANDARD SHEET #
CAMBRIDGE VT-108 SB							FY-FLUORESCENT YELLOW FYG-FLUORESCENT YELLOW GREEN																				"SHSM"-STANDARD HIGHWAY SIGNS AND MARKINGS			
		F	W11-2	30	30	FYG	 5/11	6.25								1		16.25 X									X		
		F	W7-3aP	24	18	FYG	 5/11	3.00																			X		
SB	4.199	F	VD-062BM	72	16		BUSINESS SIGN 5/12			1				X															
		F	VD-062M	72	16		BUSINESS SIGN 5/12			1																			
		F	VD-062BM	72	16		BUSINESS SIGN 5/12			1																			
SB	4.175	F	D3-1	UNK.	UNK.		GATE HOUSE DR PVT 6/30						1		X														
		F	D3-1	72	12		Gate House Dr PVT 6/30	6.00								2		23.50 X								GATE HOUSE DR (PVT)		13	
SB	4.157	F	W11-7	30	30		EQUESTRIAN SYMBOL 5/12						1		X														
		F	W16-4P	24	18		NEXT 2000 FT 5/12						1																
		F	W11-7	30	30		 TRIM 5/12	6.25								1		17.00 X								REQUIRES VEGETATION CLEARING	X		
		F	W16-4P	30	24		5/12	5.00																			X		
SB	4.128	F	VD-062BM	72	16		BUSINESS SIGN 5/12			1				X															
		F	VD-062M	72	16		BUSINESS SIGN 5/12			1																			
		F	VD-062M	72	16		BUSINESS SIGN 5/12			1																			
SB	4.09	F	VD-062BM	72	16		BUSINESS SIGN 5/12			1				X															
SIGN SUMMARY SHEET							SHEET TOTALS	26.50 SF	0.00 SF	7 EA	0 EA	0 EA	3 EA	0 EA	0 EA	4 EA		56.75 ~~60.0~~ FT		0 EA	0.0 LB	0.0 LB	0.0 LB	0.0 LB					
VERMONT AGENCY OF TRANSPORTATION							TOWN DIRECTIONAL TOTALS	624.4 SF	0.0 SF	23 EA	7 EA	7 EA	134 EA	0 EA	0 EA	99 EA		1485.0 FT		2 EA	324.0 LB							

PROJECT NAME: STOWE - BERKSHIRE
PROJECT NUMBER: STPG SIGN (49)
FILE NAME: 04 CAMBRIDGE VT-108 SB TS
PROJECT MANAGER: D. BRYANT
DESIGNED BY: J. BLANCHARD
CAMBRIDGE SB SHEET 13
PLOT DATE: 6/25/2015
DRAWN BY: J. BLANCHARD
CHECKED K. KERN
SHEET 77 OF 131

DIRECTION	MILEPOINT	LOCATION CODE (SHEET 2)	SIGN CODE	WIDTH (IN)	HEIGHT (IN)	SHEETING REMARKS	SIGN LEGEND	NEW SIGNS "A"	NEW SIGNS "B"	EXISTING SIGNS RETAIN	EXISTING SIGNS SALVAGE FROM	EXISTING SIGNS SALVAGE TO	EXISTING SIGNS REMOVE	EXIST POST RETAIN	EXIST POST REMOVE	NUMBER OF NEW POSTS	SQUARE STEEL (IN) 1.75 (LB / FT) 1.88	SQUARE STEEL (IN) 2.00 (LB / FT) 2.42	SQUARE STEEL (IN) 2.50 (LB / FT) 3.35	TUBULAR STEEL Ø (IN) FOUNDATION	TUBULAR STEEL Ø (IN) 3.00 (LB / FT) 7.60	TUBULAR STEEL Ø (IN) 3.50 (LB / FT) 9.00	TUBULAR STEEL Ø (IN) 4.00 (LB / FT) 10.80	TUBULAR STEEL Ø (IN) 5.00 (LB / FT) 14.60	SIGN FRAME REQUIRED	REMARKS	SIGN DETAIL LOCATION SHSM	SIGN DETAIL LOCATION PROJECT SHEET #	SIGN DETAIL LOCATION STANDARD SHEET #
CAMBRIDGE VT-108 SB							FY-FLUORESCENT YELLOW FYG-FLUORESCENT YELLOW GREEN																				"SHSM"-STANDARD HIGHWAY SIGNS AND MARKINGS			
		F	VD-062M	72	16		BUSINESS SIGN 5/12			1																			
		F	VD-062M	72	16		BUSINESS SIGN 5/12			1																			
SB	4.056	F	VW-092	36	36		UNSAFE TO PASS 5/12						1		X														
		F	VW-092	36	36		 5/12	9.00								2		28.75 X									10	
SB	4.032	G	VR-017	24	30		LLL 12,000 LBS 5/12						1		X														
		G	VR-017	24	30		 5/12	5.00								1		13.50 X								DESJARDINS RD (TH-75)		9	
SB	4.027	H	R1-1	30	30		STOP 5/12						1		X														
		G	VD-700	6	10		MILE MARKER 5/12				1	1	1														SALVAGE AND MOUNT ON NEW POST BELOW STOP SIGN			
		H	R1-1	30	30		 5/12	6.25								1		13.50 X								DESJARDINS RD (TH-75)	X		
SB	4.026	C/D	D3-1	UNK.	UNK.		VT RTE 108 S. 5/12						1		X														
		E/F	D3-1	UNK.	UNK.		DESJARDINS RD 5/12						1																
		E/F	D3-1	56	12		 5/12	4.67								2		21.75 X								DESJARDINS RD (TH-75); FIELD LOCATE FOR VISIBILITY FROM VT-108		13	
SB	3.906	F	W11-2	30	30	FYG	PEDESTRIAN SYMBOL 5/12						1		X														
		F	W16-7P	24	12	FYG	DIAGONAL ARROW WARNING 5/12						1																
		F	W11-2	30	30	FYG	 5/12	6.25								1		14.50 X									X		
							SHEET TOTALS	31.17	0.00	2	1	1	8	0	0	7		92.00 ~~105.0~~		0	0.0	0.0	0.0	0.0					
								SF	SF	EA	EA	EA	EA	EA	EA	EA		FT		EA	LB	LB	LB	LB					
							TOWN DIRECTIONAL TOTALS	624.4	0.0	23	7	7	134	0	0	99		1485.0		2			324.0						

SIGN SUMMARY SHEET

VERMONT AGENCY OF TRANSPORTATION

PROJECT NAME: **STOWE - BERKSHIRE**
PROJECT NUMBER: **STPG SIGN (49)**
FILE NAME: **04 CAMBRIDGE VT-108 SB TS** PLOT DATE: **6/25/2015**
PROJECT MANAGER: **D. BRYANT** DRAWN BY: **J. BLANCHARD**
DESIGNED BY: **J. BLANCHARD** CHECKED **K. KERN**
CAMBRIDGE SB SHEET 14 SHEET **78** OF **131**

DIRECTION	MILEPOINT	LOCATION CODE (SHEET 2)	SIGN CODE	WIDTH (IN)	HEIGHT (IN)	SHEETING REMARKS	SIGN LEGEND	NEW SIGNS "A"	NEW SIGNS "B"	EXISTING SIGNS RETAIN	EXISTING SIGNS SALVAGE FROM	EXISTING SIGNS SALVAGE TO	EXISTING SIGNS REMOVE	EXIST POST RETAIN	EXIST POST REMOVE	NUMBER OF NEW POSTS	SQUARE STEEL (IN) 1.75 (LB/FT) 1.88	SQUARE STEEL (IN) 2.00 (LB/FT) 2.42	SQUARE STEEL (IN) 2.50 (LB/FT) 3.35	TUBULAR STEEL Ø (IN) FOUNDATION	TUBULAR STEEL Ø (IN) 3.00 (LB/FT) 7.60	TUBULAR STEEL Ø (IN) 3.50 (LB/FT) 9.00	TUBULAR STEEL Ø (IN) 4.00 (LB/FT) 10.80	TUBULAR STEEL Ø (IN) 5.00 (LB/FT) 14.60	SIGN FRAME REQUIRED	REMARKS	SIGN DETAIL LOCATION SHSM	SIGN DETAIL LOCATION PROJECT SHEET #	SIGN DETAIL LOCATION STANDARD SHEET #
CAMBRIDGE VT-108 SB							FY-FLUORESCENT YELLOW FYG-FLUORESCENT YELLOW GREEN																				"SHSM"-STANDARD HIGHWAY SIGNS AND MARKINGS			
		F	W16-7P	24	12	FYG	5/12	2.00																			X		
SB	3.682	F	VW-205	30	30		WATCH FOR TURNING VEHICLES 5/12						1		X														
		F	VW-205	36	36		TRIM  5/12	9.00								2		29.25 X									10	
SB	3.565	F	R2-1	24	30		SPEED LIMIT 50 5/12						1		X														
		F	W8-1	30	30		~~BUMP~~						0 ~~1~~																
		F	R2-1	24	30		TRIM  5/12	5.00								1		15.50 X								X		
SB	3.256	G	VR-017	24	30		LLL 24,000 LBS 5/12						1		X														
		G	VR-017	24	30		 5/12	5.00								1		13.50 X									DESJARDINS RD (TH-75); REQUIRES VEGETATION CLEARING		9	
SB	3.256	E/F	D3-1	UNK.	UNK.		DESJARDINS RD 5/12						1		X														
SB	3.250	H	R1-1	30	30		STOP 5/12						1		X														
		H	R1-1	30	30		 5/12	6.25								1		13.50 X									DESJARDINS RD (TH-75)	X		
SB	3.250	E/F	D3-1	56	12		 5/12	4.67								2		24.25 X									DESJARDINS RD (TH-75); FIELD LOCATE FOR VISIBILITY FROM VT-108		13	
SB	3.208	H	R1-1	30	30		STOP 5/12						1		X														
		G	VD-700	6	10		MILE MARKER 5/12				1	1	1														SALVAGE AND MOUNT ON NEW POST BELOW STOP SIGN			
		H	R1-1	30	30		TRIM  5/12	6.25								1		13.50 X									DESJARDINS RD (TH-75); REQUIRES VEGETATION CLEARING	X		
SIGN SUMMARY SHEET							SHEET TOTALS	38.17	0.00	0	1	1	~~8~~ 7	0	0	8		~~120.0~~ 109.50		0	0.0	0.0	0.0	0.0					
								SF	SF	EA	EA	EA	EA	EA	EA	EA		FT		EA	LB	LB	LB	LB					
VERMONT AGENCY OF TRANSPORTATION							TOWN DIRECTIONAL TOTALS	624.4	0.0	23	7	7	134	0	0	99		1485.0		2		324.0							

PROJECT NAME: **STOWE - BERKSHIRE**
PROJECT NUMBER: **STPG SIGN (49)**
FILE NAME: **04 CAMBRIDGE VT-108 SB TS** PLOT DATE: **6/25/2015**
PROJECT MANAGER: **D. BRYANT** DRAWN BY: **J. BLANCHARD**
DESIGNED BY: **J. BLANCHARD** CHECKED **K. KERN**
CAMBRIDGE SB SHEET 15 SHEET **79** OF **131**

DIRECTION	MILEPOINT	LOCATION CODE (SHEET 2)	SIGN CODE	WIDTH (IN)	HEIGHT (IN)	SHEETING REMARKS	SIGN LEGEND	NEW SIGNS "A"	NEW SIGNS "B"	EXISTING SIGNS RETAIN	EXISTING SIGNS SALVAGE FROM	EXISTING SIGNS SALVAGE TO	EXISTING SIGNS REMOVE	EXIST POST RETAIN	EXIST POST REMOVE	NUMBER OF NEW POSTS	SQUARE STEEL (IN) 1.75 (LB/FT) 1.88	SQUARE STEEL (IN) 2.00 (LB/FT) 2.42	SQUARE STEEL (IN) 2.50 (LB/FT) 3.35	TUBULAR STEEL Ø (IN) FOUNDATION	TUBULAR STEEL Ø (IN) 3.00 (LB/FT) 7.60	TUBULAR STEEL Ø (IN) 3.50 (LB/FT) 9.00	TUBULAR STEEL Ø (IN) 4.00 (LB/FT) 10.80	TUBULAR STEEL Ø (IN) 5.00 (LB/FT) 14.60	SIGN FRAME REQUIRED	REMARKS	SIGN DETAIL LOCATION SHSM	SIGN DETAIL LOCATION PROJECT SHEET #	SIGN DETAIL LOCATION STANDARD SHEET #
CAMBRIDGE VT-108 SB							FY-FLUORESCENT YELLOW FYG-FLUORESCENT YELLOW GREEN																			"SHSM"-STANDARD HIGHWAY SIGNS AND MARKINGS			
SB	2.946	F	VR-020	24	30		NO PARKING ON TRAVELED LANE 5/12						1		X													
		F	VR-020	24	30		NO PARKING ON TRAVELED LANE 5/12	5.00								1		14.00 X										9
SB	2.732	F	VR-020	24	30		NO PARKING ON TRAVELED LANE 5/13						1		X													
		F	VR-020	24	30		NO PARKING ON TRAVELED LANE 5/13	5.00								1		14.75 X										9
SB	2.695	F	VW-060	30	30		HIDDEN DRIVES 5/13						1		X													
		F	VW-060	30	30		HIDDEN DRIVES 5/13	6.25								1		14.75 X										10
SB	2.661	F	VR2-5A	24	30		REDUCED SPEED AHEAD 5/13						1		X													
		F	W3-5	36	36		TRIM SPEED LIMIT 40 5/13	9.00								2		30.25 X									X	
SB	2.633	F	W8-1	UNK.	UNK.		BUMP 5/13						1		X													
		F	VD-700	6	10		MILE MARKER 5/13				1	1	1			1		14.25 X								SALVAGE AND MOUNT ON NEW POST BELOW NO PARKING SIGN		
		F	VR-020	24	30		NO PARKING ON TRAVELED LANE 5/13	5.00					1															9
SB	2.557	G	VM-607	24	30		*10TH MTN DIV WW II MEMORIAL HIGHWAY 5/13			1				X														
SB	2.545	F	R2-1	24	30		SPEED LIMIT 40 5/13						1		X													
		F	R2-1	30	36		SPEED LIMIT 40 5/13	7.50								1		14.50 X									X	
SB	2.447	F	VR-020	24	30		NO PARKING ON TRAVELED LANE 5/13						1		X													
							SHEET TOTALS	37.75 SF	0.00 SF	1 EA	1 EA	1 EA	~~9~~ 8 EA	0 EA	0 EA	7 EA		~~102.50~~ 105.0 FT		0 EA	0.0 LB	0.0 LB	0.0 LB	0.0 LB				
							TOWN DIRECTIONAL TOTALS	624.4	0.0	23	7	7	134	0	0	99		1485.0		2	324.0								

SIGN SUMMARY SHEET

VERMONT AGENCY OF TRANSPORTATION

PROJECT NAME: **STOWE - BERKSHIRE**
PROJECT NUMBER: **STPG SIGN (49)**
FILE NAME: **04 CAMBRIDGE VT-108 SB TS** PLOT DATE: **6/25/2015**
PROJECT MANAGER: **D. BRYANT** DRAWN BY: **J. BLANCHARD**
DESIGNED BY: **J. BLANCHARD** CHECKED **K. KERN**
CAMBRIDGE SB SHEET 16 SHEET **80** OF **131**

DIRECTION	MILEPOINT	LOCATION CODE (SHEET 2)	SIGN CODE	WIDTH (IN)	HEIGHT (IN)	SHEETING REMARKS	SIGN LEGEND	NEW SIGNS "A"	NEW SIGNS "B"	EXISTING SIGNS RETAIN	EXISTING SIGNS SALVAGE FROM	EXISTING SIGNS SALVAGE TO	EXISTING SIGNS REMOVE	EXIST POST RETAIN	EXIST POST REMOVE	NUMBER OF NEW POSTS	SQUARE STEEL (IN) 1.75 (LB/FT) 1.88	SQUARE STEEL (IN) 2.00 (LB/FT) 2.42	SQUARE STEEL (IN) 2.50 (LB/FT) 3.35	TUBULAR STEEL Ø (IN) FOUNDATION	TUBULAR STEEL Ø (IN) 3.00 (LB/FT) 7.60	TUBULAR STEEL Ø (IN) 3.50 (LB/FT) 9.00	TUBULAR STEEL Ø (IN) 4.00 (LB/FT) 10.80	TUBULAR STEEL Ø (IN) 5.00 (LB/FT) 14.60	SIGN FRAME REQUIRED	REMARKS	SIGN DETAIL LOCATION SHSM	SIGN DETAIL LOCATION PROJECT SHEET #	SIGN DETAIL LOCATION STANDARD SHEET #
CAMBRIDGE VT-108 SB							FY-FLUORESCENT YELLOW FYG-FLUORESCENT YELLOW GREEN																				"SHSM"-STANDARD HIGHWAY SIGNS AND MARKINGS			
		F	VR-020	24	30		TRIM NO PARKING ON TRAVELED LANE 5/13	5.00								1		15.00 X										9	
SB	2.429	E	VW-060	30	30		HIDDEN DRIVES TRIM 5/13						1		X														
SB	2.354	F	W1-10	36	36		MODIFIED LEFT CURVE						1		X														
		F	W13-1P	24	18		35 MPH						1																
		F	W1-10ML	36	36			9.00								2		30.75 X										X	
		F	W13-1P	18	18		35 M.P.H.	2.25																				X	
SB	2.315	F	VW-400	48	48		SMUGGLERS NOTCH NOT RECOMMENDED FOR TRUCKS BUSES OR RVS 8/24	16.00		1				X	X	2		31.50 X											
SB	2.278	F	W16-18P	48	12		NOTICE 5/13			1				X															
		F	VR-472	48	48		TRACTOR TRAILERS PROHIBITED 5/13			1																			
		F	VR5-2M	48	48		NO TRACTOR TRAILER SYMBOL 5/13			1																			
		F	VD-700	6	10		MILE MARKER 5/13			1																			
SB	2.274	F	R8-3	24	24		NO PARKING SYMBOL 5/13						1		X														
		F	R7-201P	12	6		TOW-AWAY SYMBOL 5/13						1																
		G	R8-3	24	24		5/13	4.00								1		13.50 X										X	
		G	R7-201P	12	6	BLK/WHT	5/13	0.50																				X	
SIGN SUMMARY SHEET							SHEET TOTALS	~~36.75~~ ~~20.75~~ SF	0.00 SF	5 EA	0 EA	0 EA	5 EA	0 EA	0 EA	~~6~~ ~~4~~ EA		~~90.75~~ ~~60.0~~ FT		0 EA	0.0 LB	0.0 LB	0.0 LB	0.0 LB					
VERMONT AGENCY OF TRANSPORTATION							TOWN DIRECTIONAL TOTALS	624.4	0.0	23	7	7	134	0	0	99		1485.0		2	324.0					

PROJECT NAME: **STOWE - BERKSHIRE**
PROJECT NUMBER: **STPG SIGN (49)**
FILE NAME: **04 CAMBRIDGE VT-108 SB TS** PLOT DATE: **6/25/2015**
PROJECT MANAGER: **D. BRYANT** DRAWN BY: **J. BLANCHARD**
DESIGNED BY: **J. BLANCHARD** CHECKED **K. KERN**
CAMBRIDGE SB SHEET 17 SHEET **81** OF **131**

DIRECTION	MILEPOINT	LOCATION CODE (SHEET 2)	SIGN CODE	WIDTH (IN)	HEIGHT (IN)	SHEETING REMARKS	SIGN LEGEND	NEW SIGNS "A"	NEW SIGNS "B"	EXISTING SIGNS RETAIN	EXISTING SIGNS SALVAGE FROM	EXISTING SIGNS SALVAGE TO	EXISTING SIGNS REMOVE	EXIST POST RETAIN	EXIST POST REMOVE	NUMBER OF NEW POSTS	SQUARE STEEL (IN) 1.75 (LB/FT) 1.88	SQUARE STEEL (IN) 2.00 (LB/FT) 2.42	SQUARE STEEL (IN) 2.50 (LB/FT) 3.35	TUBULAR STEEL Ø (IN) FOUNDATION	TUBULAR STEEL Ø (IN) 3.00 (LB/FT) 7.60	TUBULAR STEEL Ø (IN) 3.50 (LB/FT) 9.00	TUBULAR STEEL Ø (IN) 4.00 (LB/FT) 10.80	TUBULAR STEEL Ø (IN) 5.00 (LB/FT) 14.60	SIGN FRAME REQUIRED	REMARKS	SIGN DETAIL LOCATION SHSM	SIGN DETAIL LOCATION PROJECT SHEET #	SIGN DETAIL LOCATION STANDARD SHEET #
CAMBRIDGE VT-108 SB							FY-FLUORESCENT YELLOW FYG-FLUORESCENT YELLOW GREEN																			"SHSM"-STANDARD HIGHWAY SIGNS AND MARKINGS			
SB	2.252	F	R8-3	24	24		NO PARKING SYMBOL 5/13						1		X														
		F	R7-201P	12	6		TOW-AWAY SYMBOL 5/13						1																
		G	R8-3	24	24		 5/13	4.00								1		13.50 X									X		
		G	R7-201P	12	6	BLK/ WHT	 5/13	0.50																			X		
SB	2.230	F	R8-3	24	24		NO PARKING SYMBOL 5/13						1		X														
		F	R7-201P	12	6		TOW-AWAY SYMBOL 5/13						1																
		G	R8-3	24	24		 5/13	4.00								1		13.50 X									X		
		G	R7-201P	12	6	BLK/ WHT	 5/13	0.50																			X		
SB	2.210	F	R8-3	24	24		NO PARKING SYMBOL 5/13						1		X														
		F	R7-201P	12	6		TOW-AWAY SYMBOL 5/13						1																
		G	R8-3	24	24		 5/13	4.00								1		13.75 X									X		
		G	R7-201P	12	6	BLK/ WHT	 5/13	0.50																			X		
SB	2.199	F	W1-5L	36	36		LEFT WINDING CURVES 5/13						1		X														
		F	W1-5L	30	30		 5/13	6.25								1		15.25 X									X		
SB	2.198	F	R11-2	48	30		ROAD CLOSED 5/13						1														EXISTING SIGN MOUNTED TO GATE			
							SHEET TOTALS	19.75 SF	0.00 SF	0 EA	0 EA	0 EA	8 EA	0 EA	0 EA	4 EA		56.00 ~~60.0~~ FT		0 EA	0.0 LB	0.0 LB	0.0 LB	0.0 LB				
							TOWN DIRECTIONAL TOTALS	624.4	0.0	23	7	7	134	0	0	99		1485.0		2	324.0								

SIGN SUMMARY SHEET

VERMONT AGENCY OF TRANSPORTATION


PROJECT NAME: **STOWE - BERKSHIRE**
PROJECT NUMBER: **STPG SIGN (49)**
FILE NAME: **04 CAMBRIDGE VT-108 SB TS** PLOT DATE: **6/25/2015**
PROJECT MANAGER: **D. BRYANT** DRAWN BY: **J. BLANCHARD**
DESIGNED BY: **J. BLANCHARD** CHECKED **K. KERN**
CAMBRIDGE SB SHEET 18 SHEET **82** OF **131**

DIRECTION	MILEPOINT	LOCATION CODE (SHEET 2)	SIGN CODE	WIDTH (IN)	HEIGHT (IN)	SHEETING REMARKS	SIGN LEGEND	NEW SIGNS "A"	NEW SIGNS "B"	EXISTING SIGNS RETAIN	EXISTING SIGNS SALVAGE FROM	EXISTING SIGNS SALVAGE TO	EXISTING SIGNS REMOVE	EXIST POST RETAIN	EXIST POST REMOVE	NUMBER OF NEW POSTS	SQUARE STEEL (IN) 1.75 (LB/FT) 1.88	SQUARE STEEL (IN) 2.00 (LB/FT) 2.42	SQUARE STEEL (IN) 2.50 (LB/FT) 3.35	TUBULAR STEEL Ø (IN) FOUNDATION	TUBULAR STEEL Ø (IN) 3.00 (LB/FT) 7.60	TUBULAR STEEL Ø (IN) 3.50 (LB/FT) 9.00	TUBULAR STEEL Ø (IN) 4.00 (LB/FT) 10.80	TUBULAR STEEL Ø (IN) 5.00 (LB/FT) 14.60	SIGN FRAME REQUIRED	REMARKS	SIGN DETAIL LOCATION SHSM	SIGN DETAIL LOCATION PROJECT SHEET #	SIGN DETAIL LOCATION STANDARD SHEET #
CAMBRIDGE VT-108 SB							FY-FLUORESCENT YELLOW FYG-FLUORESCENT YELLOW GREEN																				"SHSM"-STANDARD HIGHWAY SIGNS AND MARKINGS			
		F	OM4-2	18	18		7/5	2.25																			MOUNT TO SWING GATE AT THIS LOCATION; INCIDENTAL TO SIGN ITEM	X		
		F	R11-2	48	30		 5/13	10.00																				X		
		F	OM4-2	18	18		7/5	2.25																				X		
SB	2.178	F	R2-1	24	30		SPEED LIMIT 40 5/13						1		X															
		F	R2-1	24	30		 5/13	5.00								1		14.25 X									X		
SB	1.308	F	VW-285	36	36		FALLING ROCKS 5/13						1		X															
		F	VW-285	24	18	FYG	NEXT 1 MILE 5/13						1																	
		F	VW-285	36	36	FY	TRIM  5/13	9.00								1			16.25 X									10	
		F	W7-3aP	24	18	FY	 5/13	3.00																				X		
SB	1.281	F	W1-5R	30	30		TRIM  5/13	6.25								1			15.50 X								INSTALL 142 FT SOUTH OF FALLING ROCK ASSEMBLY	X		
		F	W7-3aP	24	18		 5/13	3.00																				X		
SB	1.258	F	W11-2	30	30	FYG	PEDESTRIAN SYMBOL						1		X															
		F	W16-4P	24	18	FYG	NEXT 2000 FT						1																	
		F	W11-2	30	30	FYG	 8/24	6.25								1		15.25 X									X		
		F	W7-3aP	24	18	FYG	 8/24	3.00																				X		
SIGN SUMMARY SHEET							SHEET TOTALS	50.00	0.00	0	0	0	5	0	0	4		~~61.25~~ ~~60.0~~		0	0.0	0.0	0.0	0.0					
								SF	SF	EA	EA	EA	EA	EA	EA	EA		FT		EA	LB	LB	LB	LB					
VERMONT AGENCY OF TRANSPORTATION							TOWN DIRECTIONAL TOTALS	624.4	0.0	23	7	7	134	0	0	99		1485.0		2		324.0							

PROJECT NAME: **STOWE - BERKSHIRE**
PROJECT NUMBER: **STPG SIGN (49)**
FILE NAME: **04 CAMBRIDGE VT-108 SB TS** PLOT DATE: **6/25/2015**
PROJECT MANAGER: **D. BRYANT** DRAWN BY: **J. BLANCHARD**
DESIGNED BY: **J. BLANCHARD** CHECKED **K. KERN**
CAMBRIDGE SB SHEET 19 SHEET **83** OF **131**

DIRECTION	MILEPOINT	LOCATION CODE (SHEET 2)	SIGN CODE	WIDTH (IN)	HEIGHT (IN)	SHEETING REMARKS	SIGN LEGEND	NEW SIGNS "A"	NEW SIGNS "B"	EXISTING SIGNS RETAIN	EXISTING SIGNS SALVAGE FROM	EXISTING SIGNS SALVAGE TO	EXISTING SIGNS REMOVE	EXIST POST RETAIN	EXIST POST REMOVE	NUMBER OF NEW POSTS	SQUARE STEEL (IN) 1.75 (LB/FT) 1.88	SQUARE STEEL (IN) 2.00 (LB/FT) 2.42	SQUARE STEEL (IN) 2.50 (LB/FT) 3.35	TUBULAR STEEL Ø (IN) FOUNDATION	TUBULAR STEEL Ø (IN) 3.00 (LB/FT) 7.60	TUBULAR STEEL Ø (IN) 3.50 (LB/FT) 9.00	TUBULAR STEEL Ø (IN) 4.00 (LB/FT) 10.80	TUBULAR STEEL Ø (IN) 5.00 (LB/FT) 14.60	SIGN FRAME REQUIRED	REMARKS	SIGN DETAIL LOCATION SHSM	SIGN DETAIL LOCATION PROJECT SHEET #	SIGN DETAIL LOCATION STANDARD SHEET #
CAMBRIDGE VT-108 SB							FY-FLUORESCENT YELLOW FYG-FLUORESCENT YELLOW GREEN																				"SHSM"-STANDARD HIGHWAY SIGNS AND MARKINGS			
SB	1.203	F	W5-1	30	30		ROAD NARROWS						1		X														
		F	W5-1	36	36		TRIM  6/30	9.00								2		33.50 X									X		
SB	1.078	F	W8-12	36	36		 5/25	9.00								2		27.50 X								INSTALL 150 FT NORTH OF END OF CENTERLINE	X		
SB	0.898	F	W7-1	30	30		HILL SYMBOL						1		X														
		F	W7-1a	30	30	FY	TRIM  6/30	6.25								1		14.25 X								REQUIRES VEGETATION CLEARING (SEE GENERAL NOTE 5 ON SHEET 2)	X		
		F	W7-3aP	24	18	FY	 5/25	3.00																			X		
NB	0.436	A	W11-	30	30	FYG	TRIM 	6.25								1			15.00 X							INSTALL 623 FT NORTH OF SPEED LIMIT 40 MPH	X		
		A	W16-4P	30	24	FYG	 5/25	5.00																			X		
SB	0.318	F	R2-1	24	30		SPEED LIMIT 40						1		X														
		F	R2-1	24	30		TRIM  5/25	5.00								1		14.25 X								REQUIRES VEGETATION CLEARING (SEE GENERAL NOTE 5 ON SHEET 2)	X		
SIGN SUMMARY SHEET							SHEET TOTALS	43.50 SF	0.00 SF	0 EA	0 EA	0 EA	3 EA	0 EA	0 EA	7 EA		104.50 ~~105.0~~ FT		0 EA	0.0 LB	0.0 LB	0.0 LB	0.0 LB					
VERMONT AGENCY OF TRANSPORTATION							TOWN DIRECTIONAL TOTALS	624.4	0.0	23	7	7	134	0	0	99		1485.0		2	324.0							

PROJECT NAME: **STOWE - BERKSHIRE**
PROJECT NUMBER: **STPG SIGN (49)**
FILE NAME: **04 CAMBRIDGE VT-108 SB TS** PLOT DATE: **6/25/2015**
PROJECT MANAGER: **D. BRYANT** DRAWN BY: **J. BLANCHARD**
DESIGNED BY: **J. BLANCHARD** CHECKED **K. KERN**
CAMBRIDGE SB SHEET 20 SHEET **84** OF **131**

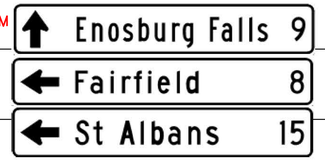DIRECTION	MILEPOINT	LOCATION CODE (SHEET 2)	SIGN CODE	WIDTH (IN)	HEIGHT (IN)	SHEETING REMARKS	SIGN LEGEND	NEW SIGNS "A"	NEW SIGNS "B"	EXISTING SIGNS RETAIN	EXISTING SIGNS SALVAGE FROM	EXISTING SIGNS SALVAGE TO	EXISTING SIGNS REMOVE	EXIST POST RETAIN	EXIST POST REMOVE	NUMBER OF NEW POSTS	SQUARE STEEL (IN) 1.75 (LB/FT) 1.88	SQUARE STEEL (IN) 2.00 (LB/FT) 2.42	SQUARE STEEL (IN) 2.50 (LB/FT) 3.35	TUBULAR STEEL Ø (IN) FOUNDATION	TUBULAR STEEL Ø (IN) 3.00 (LB/FT) 7.60	TUBULAR STEEL Ø (IN) 3.50 (LB/FT) 9.00	TUBULAR STEEL Ø (IN) 4.00 (LB/FT) 10.80	TUBULAR STEEL Ø (IN) 5.00 (LB/FT) 14.60	SIGN FRAME REQUIRED	REMARKS	SIGN DETAIL LOCATION SHSM	SIGN DETAIL LOCATION PROJECT SHEET #	SIGN DETAIL LOCATION STANDARD SHEET #
BAKERSFIELD VT-108 NB							FY-FLUORESCENT YELLOW FYG-FLUORESCENT YELLOW GREEN																			"SHSM"-STANDARD HIGHWAY SIGNS AND MARKINGS			
NB	3.487	A	R2-1	24	30		SPEED LIMIT 35			1				X															
NB	3.584	A	M1-5	24	24		JCT STATE 5/4						1		X														
		A	M2-1	21	15		VERMONT 36 5/4						1																
		A	M2-1	21	15	GRN/WHT	TRIM  5/4	2.19								1		14.25 X								X		
		A	M1-5	24	24	GRN/WHT	5/4	4.00																				E-136B
NB	3.625	A	D1-1a	72	10		^UP ENOSBURG FALLS 9 5/4						1		X														
		A	D1-1a	72	10		<--- FAIRFIELD 8 5/4						1																
		A	D1-1a	72	10		<--- ST ALBANS 15 5/4						1																
		A	VD1-1a	72	12		TRIM  5/4	6.00								2		28.00 X										7	
		A	VD1-1a	72	12		5/4	6.00																				7	
		A	VD1-1a	72	12		5/4	6.00																				7	
NB	3.658	A	M3-4	24	12		WEST STATE 6/30						1		X														
		A	M1-5	24	24		VERMONT 36 6/30						1																
		A	M6-1L	21	115		<-- LEFT ARROW STATE 6/30						1																
		A	M3-1	24	12		NORTH STATE 6/30						1																
SIGN SUMMARY SHEET							SHEET TOTALS	24.19	0.00	1	0	0	9	0	0	3		42.25 ~~45.0~~		0	0.0	0.0	0.0	0.0				
								SF	SF	EA	EA	EA	EA	EA	EA	EA		FT		EA	LB	LB	LB	LB				
VERMONT AGENCY OF TRANSPORTATION							TOWN DIRECTIONAL TOTALS	191.4	0.0	6	4	4	48	0	0	30		450.0		0	0.0							

PROJECT NAME: **STOWE - BERKSHIRE**
PROJECT NUMBER: **STPG SIGN (49)**
FILE NAME: **05 BAKERSFIELD VT-108 NB T** PLOT DATE: **4/15/2015**
PROJECT MANAGER: **D. BRYANT** DRAWN BY: **J. BLANCHARD**
DESIGNED BY: **J. BLANCHARD** CHECKED **K. KERN**
BAKERSFIELD NB SHEET 1 SHEET **85** OF **131**


DIRECTION	MILEPOINT	LOCATION CODE (SHEET 2)	SIGN CODE	WIDTH (IN)	HEIGHT (IN)	SHEETING REMARKS	SIGN LEGEND	NEW SIGNS "A"	NEW SIGNS "B"	EXISTING SIGNS RETAIN	EXISTING SIGNS SALVAGE FROM	EXISTING SIGNS SALVAGE TO	EXISTING SIGNS REMOVE	EXIST POST RETAIN	EXIST POST REMOVE	NUMBER OF NEW POSTS	SQUARE STEEL (IN) 1.75 (LB/FT) 1.88	SQUARE STEEL (IN) 2.00 (LB/FT) 2.42	SQUARE STEEL (IN) 2.50 (LB/FT) 3.35	TUBULAR STEEL Ø (IN) FOUNDATION	TUBULAR STEEL Ø (IN) 3.00 (LB/FT) 7.60	TUBULAR STEEL Ø (IN) 3.50 (LB/FT) 9.00	TUBULAR STEEL Ø (IN) 4.00 (LB/FT) 10.80	TUBULAR STEEL Ø (IN) 5.00 (LB/FT) 14.60	SIGN FRAME REQUIRED	REMARKS	SIGN DETAIL LOCATION SHSM	SIGN DETAIL LOCATION PROJECT SHEET #	SIGN DETAIL LOCATION STANDARD SHEET #
BAKERSFIELD VT-108 NB							FY-FLUORESCENT YELLOW FYG-FLUORESCENT YELLOW GREEN																			"SHSM"-STANDARD HIGHWAY SIGNS AND MARKINGS			
		A	M1-5	30	24		VERMONT 108						1																
		A	M6-3	21	15		^UP ARROW STATE 6/30						1																
		A	M3-4	24	12	GRN/WHT	6/30	2.00								2		31.00 X							2B		X		
		A	M1-5	24	24	GRN/WHT	6/30	4.00																					E-136B
		A	M6-1L	21	15	GRN/WHT	TRIM 6/30	2.19																				X	
		A	M3-1	24	12	GRN/WHT	6/30	2.00																				X	
		A	M1-5	30	24	GRN/WHT	6/30	5.00																					E-136B
		A	M6-3	21	15	GRN/WHT	6/30	2.19																				X	
NB	3.687	C	VR-017	24	30		LLL 24,000 LBS 5/4						1		X														
		C	VR-017	24	30		TRIM 5/4	5.00								1		13.50 X									E BAKERSFIELD RD (TH-2)		9	
NB	3.696	C	M3-1	24	12		NORTH STATE 6/30						1		X														
		C	M1-5	30	24		VERMONT 108 6/30						1																
		C	M6-1	21	15		<--- LEFT STATE 6/30						1																
		C	M3-3	24	12		SOUTH STATE 6/30						1																
		C	M1-5	30	24		VERMONT 108 6/30						1																
							SHEET TOTALS	22.38 SF	0.00 SF	0 EA	0 EA	0 EA	8 EA	0 EA	0 EA	3 EA		44.50 ~~45.0~~ FT		0 EA	0.0 LB	0.0 LB	0.0 LB	0.0 LB					
							TOWN DIRECTIONAL TOTALS	191.4	0.0	6	4	4	48	0	0	30		450.0		0	0.0									

SIGN SUMMARY SHEET

VERMONT AGENCY OF TRANSPORTATION

PROJECT NAME: **STOWE - BERKSHIRE**
PROJECT NUMBER: **STPG SIGN (49)**


FILE NAME: **05 BAKERSFIELD VT-108 NB T** PLOT DATE: **4/15/2015**
PROJECT MANAGER: **D. BRYANT** DRAWN BY: **J. BLANCHARD**
DESIGNED BY: **J. BLANCHARD** CHECKED **K. KERN**
BAKERSFIELD NB SHEET 2 SHEET **86** OF **131**

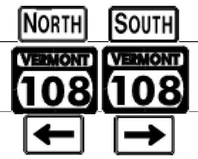DIRECTION	MILEPOINT	LOCATION CODE (SHEET 2)	SIGN CODE	WIDTH (IN)	HEIGHT (IN)	SHEETING REMARKS	SIGN LEGEND	NEW SIGNS "A"	NEW SIGNS "B"	EXISTING SIGNS RETAIN	EXISTING SIGNS SALVAGE FROM	EXISTING SIGNS SALVAGE TO	EXISTING SIGNS REMOVE	EXIST POST RETAIN	EXIST POST REMOVE	NUMBER OF NEW POSTS	SQUARE STEEL (IN) 1.75 (LB/FT) 1.88	SQUARE STEEL (IN) 2.00 (LB/FT) 2.42	SQUARE STEEL (IN) 2.50 (LB/FT) 3.35	TUBULAR STEEL Ø (IN) FOUNDATION	TUBULAR STEEL Ø (IN) 3.00 (LB/FT) 7.60	TUBULAR STEEL Ø (IN) 3.50 (LB/FT) 9.00	TUBULAR STEEL Ø (IN) 4.00 (LB/FT) 10.80	TUBULAR STEEL Ø (IN) 5.00 (LB/FT) 14.60	SIGN FRAME REQUIRED	REMARKS	SIGN DETAIL LOCATION SHSM	SIGN DETAIL LOCATION PROJECT SHEET #	SIGN DETAIL LOCATION STANDARD SHEET #
BAKERSFIELD VT-108 NB							FY-FLUORESCENT YELLOW FYG-FLUORESCENT YELLOW GREEN																				"SHSM"-STANDARD HIGHWAY SIGNS AND MARKINGS			
		C	M6-1	21	15		RIGHT ---> STATE 6/30						1																
		C	M3-1	24	12	GRN/ WHT	6/30	2.00								2		31.25 X							2C		X		
		C	M1-5	30	24	GRN/ WHT	6/30	5.00																				E-136B
		C	M6-1L	21	15	GRN/ WHT	 6/30	2.19																		X		
		C	M3-3	24	12	GRN/ WHT	6/30	2.00																		X		
		C	M1-5	30	24	GRN/ WHT	6/30	5.00																				E-136B
		C	M6-1R	21	15	GRN/ WHT	6/30	2.19																		X		
NB	3.695	D	R1-1	30	30		STOP 5/4						1		X													
		A/B	D3-1	UNK.	UNK.		E BAKERSFIELD RD TH 2 5/4						1															
		C	VD-700	6	10		MILE MARKER 5/4				1	1	1														SALVAGE AND MOUNT ON NEW POST BELOW STOP SIGN			
		D	R1-1	30	30		 5/4	6.25								1		13.50 X								E BAKERSFIELD RD (TH-2)	X		
NB	3.695	A/B	D3-1	66	12		 5/4	5.50								2		22.00 X								E BAKERSFIELD RD (TH-2); INSTALL 10 FT CLOSER TO VT 108 THAN STOP SIGN		13	
NB	3.706	C	UNK.	UNK.	UNK.		NO DOGS, HORSES, OR ATVS's			1				X															
NB	3.737	A	S1-1	36	36	FYG	SCHOOL SYMBOL 5/4						1		X														
		A	W16-9P	30	18	FYG	AHEAD WARNING 5/4						1																
SIGN SUMMARY SHEET							SHEET TOTALS	30.13 SF	0.00 SF	1 EA	1 EA	1 EA	6 EA	0 EA	0 EA	5 EA		66.75 ~~75.0~~ FT		0 EA	0.0 LB	0.0 LB	0.0 LB	0.0 LB					
VERMONT AGENCY OF TRANSPORTATION							TOWN DIRECTIONAL TOTALS	191.4	0.0	6	4	4	48	0	0	30		450.0		0	0.0								

PROJECT NAME: **STOWE - BERKSHIRE**
PROJECT NUMBER: **STPG SIGN (49)**
FILE NAME: **05 BAKERSFIELD VT-108 NB T** PLOT DATE: **4/15/2015**
PROJECT MANAGER: **D. BRYANT** DRAWN BY: **J. BLANCHARD**
DESIGNED BY: **J. BLANCHARD** CHECKED **K. KERN**
BAKERSFIELD NB SHEET 3 SHEET **87** OF **131**

DIRECTION	MILEPOINT	LOCATION CODE (SHEET 2)	SIGN CODE	WIDTH (IN)	HEIGHT (IN)	SHEETING REMARKS	SIGN LEGEND	NEW SIGNS "A"	NEW SIGNS "B"	EXISTING SIGNS RETAIN	EXISTING SIGNS SALVAGE FROM	EXISTING SIGNS SALVAGE TO	EXISTING SIGNS REMOVE	EXIST POST RETAIN	EXIST POST REMOVE	NUMBER OF NEW POSTS	SQUARE STEEL (IN) 1.75 (LB/FT) 1.88	SQUARE STEEL (IN) 2.00 (LB/FT) 2.42	SQUARE STEEL (IN) 2.50 (LB/FT) 3.35	TUBULAR STEEL Ø (IN) FOUNDATION	TUBULAR STEEL Ø (IN) 3.00 (LB/FT) 7.60	TUBULAR STEEL Ø (IN) 3.50 (LB/FT) 9.00	TUBULAR STEEL Ø (IN) 4.00 (LB/FT) 10.80	TUBULAR STEEL Ø (IN) 5.00 (LB/FT) 14.60	SIGN FRAME REQUIRED	REMARKS	SIGN DETAIL LOCATION SHSM	SIGN DETAIL LOCATION PROJECT SHEET #	SIGN DETAIL LOCATION STANDARD SHEET #
BAKERSFIELD VT-108 NB							FY-FLUORESCENT YELLOW FYG-FLUORESCENT YELLOW GREEN																			"SHSM"-STANDARD HIGHWAY SIGNS AND MARKINGS			
		A	S1-1	36	36	FYG	 5/4	9.00								1	14.75 X										X		
		A	W16-9P	24	12	FYG	 5/4	2.00																			X		
NB	3.780	A	R2-1	24	30		SPEED LIMIT 35 5/4						1		X														
		A	R2-1	24	30		 5/4	5.00								1	13.50 X										X		
NB	3.786	C	UNK.	UNK.	UNK.		RESERVED PARKING HANDICAP			1				X															
NB	3.789	A	W11-2	30	30	FYG	PEDESTRIAN SYMBOL 5/4						1		X														
		A	W16-7PL	24	12	FYG	DOWNWARD DIAGONAL ARROW 5/4						1																
		A	S1-1	36	36	FYG	 5/4	9.00								1	14.50 X										X		
		A	W16-7PL	24	12	FYG	5/4	2.00																			X		
NB	4.233	A	R2-1	24	30		SPEED LIMIT 40 5/4						1		X														
		A	R2-1	24	30		TRIM  5/4	5.00								1	13.50 X										X		
NB	4.421	A	R2-1	24	30		SPEED LIMIT 50 5/4						1		X														
		A	R2-1	24	30		TRIM  5/4	5.00								1	16.00 X										X		
NB	5.373	A	W1-10	30	30		MODIFIED LEFT CURVE 5/4						1		X														
		A	W16-8P	30	8		BOSTON POST RD 5/4						1																
SIGN SUMMARY SHEET							SHEET TOTALS	37.00	0.00	1	0	0	7	0	0	5	~~75.0~~ 72.25			0	0.0	0.0	0.0	0.0					
								SF	SF	EA	EA	EA	EA	EA	EA	EA	FT			EA	LB	LB	LB	LB					
VERMONT AGENCY OF TRANSPORTATION							TOWN DIRECTIONAL TOTALS	191.4	0.0	6	4	4	48	0	0	30	450.0			0	0.0								

PROJECT NAME: **STOWE - BERKSHIRE**
PROJECT NUMBER: **STPG SIGN (49)**
FILE NAME: **05 BAKERSFIELD VT-108 NB T** PLOT DATE: **4/15/2015**
PROJECT MANAGER: **D. BRYANT** DRAWN BY: **J. BLANCHARD**
DESIGNED BY: **J. BLANCHARD** CHECKED **K. KERN**
BAKERSFIELD NB SHEET 4 SHEET **88** OF **131**

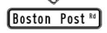DIRECTION	MILEPOINT	LOCATION CODE (SHEET 2)	SIGN CODE	WIDTH (IN)	HEIGHT (IN)	SHEETING REMARKS	SIGN LEGEND	NEW SIGNS "A"	NEW SIGNS "B"	EXISTING SIGNS RETAIN	EXISTING SIGNS SALVAGE FROM	EXISTING SIGNS SALVAGE TO	EXISTING SIGNS REMOVE	EXIST POST RETAIN	EXIST POST REMOVE	NUMBER OF NEW POSTS	SQUARE STEEL (IN) 1.75 (LB/FT) 1.88	SQUARE STEEL (IN) 2.00 (LB/FT) 2.42	SQUARE STEEL (IN) 2.50 (LB/FT) 3.35	TUBULAR STEEL Ø (IN) FOUNDATION	TUBULAR STEEL Ø (IN) 3.00 (LB/FT) 7.60	TUBULAR STEEL Ø (IN) 3.50 (LB/FT) 9.00	TUBULAR STEEL Ø (IN) 4.00 (LB/FT) 10.80	TUBULAR STEEL Ø (IN) 5.00 (LB/FT) 14.60	SIGN FRAME REQUIRED	REMARKS	SIGN DETAIL LOCATION SHSM	SIGN DETAIL LOCATION PROJECT SHEET #	SIGN DETAIL LOCATION STANDARD SHEET #
BAKERSFIELD VT-108 NB							FY-FLUORESCENT YELLOW FYG-FLUORESCENT YELLOW GREEN																				"SHSM"-STANDARD HIGHWAY SIGNS AND MARKINGS			
		A	W1-10L	36	36		 5/4	9.00								2		32.50 X										X		
		A	W16-8	34	8		 5/4	1.89																					6	
NB	5.397	A	VD-062AS	72	16		BUSINESS SIGN 5/4			1				X															
		A	VD-062AS	72	16		BUSINESS SIGN 5/4			1																			
NB	5.474	C	UNK	24	30		4 WHEELERS PROHIBITED ON TOWN HIGHWAY 5/4				1	1	1		X												BOSTON POST RD (TH-1); SALVAGE AND REMOUNT BELOW LLL			
		C	VR-017	24	30		TRIM  5/4	5.00								1			14.00 X							BOSTON POST RD (TH-1)		9	
NB	5.475	A/B	D3-1	UNK.	UNK.		BOSTON POST RD 5/4						1		X														
		A/B	D3-1	62	12		 5/4	5.17								2		22.25 X								BOSTON POST RD (TH-1); FIELD LOCATE FOR VISIBILITY FROM VT 108		13	
NB	5.475	A	M3-1	30	24		NORTH STATE 5/4						1		X														
		A	M1-5	30	24		VERMONT 108 5/4						1																
		A	VD-700	6	10		MILE MARKER 5/4						1																
NB	5.475	D	R1-1	30	30		STOP 5/4						1		X														
		D	R1-1	30	30		 5/4	6.25								1		13.50 X								BOSTON POST RD (TH-1)	X		
NB	5.513	A	M3-1	24	12	GRN/WHT	 5/4	2.00								1		14.75 X								INSTALL 200 FT NORTH OF EXISTING	X		
		A	M1-5	30	24	GRN/WHT	 5/4	5.00																					E-136B
							SHEET TOTALS	34.31 SF	0.00 SF	2 EA	1 EA	1 EA	6 EA	0 EA	0 EA	7 EA		97.00 ~~105.0~~ FT		0 EA	0.0 LB	0.0 LB	0.0 LB	0.0 LB					
							TOWN DIRECTIONAL TOTALS	191.4	0.0	6	4	4	48	0	0	30		450.0		0	0.0									

SIGN SUMMARY SHEET

VERMONT AGENCY OF TRANSPORTATION

PROJECT NAME: **STOWE - BERKSHIRE**
PROJECT NUMBER: **STPG SIGN (49)**

FILE NAME: **05 BAKERSFIELD VT-108 NB T** PLOT DATE: **4/15/2015**
PROJECT MANAGER: **D. BRYANT** DRAWN BY: **J. BLANCHARD**
DESIGNED BY: **J. BLANCHARD** CHECKED **K. KERN**
BAKERSFIELD NB SHEET 5 SHEET **89** OF **131**

DIRECTION	MILEPOINT	LOCATION CODE (SHEET 2)	SIGN CODE	WIDTH (IN)	HEIGHT (IN)	SHEETING REMARKS	SIGN LEGEND	NEW SIGNS "A"	NEW SIGNS "B"	EXISTING SIGNS RETAIN	EXISTING SIGNS SALVAGE FROM	EXISTING SIGNS SALVAGE TO	EXISTING SIGNS REMOVE	EXIST POST RETAIN	EXIST POST REMOVE	NUMBER OF NEW POSTS	SQUARE STEEL (IN) 1.75 (LB/FT) 1.88	SQUARE STEEL (IN) 2.00 (LB/FT) 2.42	SQUARE STEEL (IN) 2.50 (LB/FT) 3.35	TUBULAR STEEL Ø (IN) FOUNDATION	TUBULAR STEEL Ø (IN) 3.00 (LB/FT) 7.60	TUBULAR STEEL Ø (IN) 3.50 (LB/FT) 9.00	TUBULAR STEEL Ø (IN) 4.00 (LB/FT) 10.80	TUBULAR STEEL Ø (IN) 5.00 (LB/FT) 14.60	SIGN FRAME REQUIRED	REMARKS	SIGN DETAIL LOCATION SHSM	SIGN DETAIL LOCATION PROJECT SHEET #	SIGN DETAIL LOCATION STANDARD SHEET #
BAKERSFIELD VT-108 NB							FY-FLUORESCENT YELLOW FYG-FLUORESCENT YELLOW GREEN																				"SHSM"-STANDARD HIGHWAY SIGNS AND MARKINGS			
NB	7.040	A	OM-3R	12	36		RIGHT OBJECT MARKER 5/5						1		X														
NB	7.049	B	OM-3L	12	36		LEFT OBJECT MARKER 5/5						1		X														
NB	7.492	A	W1-10	30	30		MODIFIED LEFT CURVE 5/5						1		X														
NB	7.537	A	W1-10ML	36	36		 5/5	9.00								2		31.00 X								INSTALL AT EDGE OF FIELD (250 FT NORTH OF EXISTING)	X		
NB	7.636	C	VR-017	24	30		LEGAL LOAD LIMIT 24000 LBS 5/5						1		X														
		C	R2-1	24	30		SPEED LIMIT 25 5/5				1	1	1														OVITT RD (TH-6); SALVAGE AND MOUNT ON NEW POST BELOW LLL			
		C	VR-017	24	30		 5/5	5.00								1			14.50 X							OVITT RD (TH-6)		9	
NB	7.636	D	R1-1	30	30		STOP 5/5			1				X															
		A/B	D3-1	34	12		 5/5	2.83																			OVITT RD (TH-6); MOUNT ON STOP SIGN WITH BRACKET		13	
NB	7.952	A	W11-5	30	30		FARM MACHINERY SYMBOL 5/5						1		X														
		A	W11-5	30	30		 5/5	6.25								1		15.00 X									X		
NB	7.963	C	R2-1	24	30		SPEED LIMIT 25 5/5				1	1	1		X												OVITT RD (TH-42); SALVAGE AND MOUNT ON NEW POST BELOW LLL			
		A/B	D3-1	UNK.	UNK.		OVITT RD 5/5						1																
		C	VR-017	24	30		 5/5	5.00								1			13.25 X							OVITT RD (TH-42)		9	
NB	7.971	D	R1-1	30	30		STOP 5/5						1		X														
SIGN SUMMARY SHEET							SHEET TOTALS	28.08	0.00	1	2	2	9	0	0	5		~~75.0~~ 73.75		0	0.0	0.0	0.0	0.0					
								SF	SF	EA	EA	EA	EA	EA	EA	EA		FT		EA	LB	LB	LB	LB					
VERMONT AGENCY OF TRANSPORTATION							TOWN DIRECTIONAL TOTALS	191.4	0.0	6	4	4	48	0	0	30		450.0		0	0.0								

PROJECT NAME: **STOWE - BERKSHIRE**
PROJECT NUMBER: **STPG SIGN (49)**
FILE NAME: **05 BAKERSFIELD VT-108 NB T** PLOT DATE: **4/15/2015**
PROJECT MANAGER: **D. BRYANT** DRAWN BY: **J. BLANCHARD**
DESIGNED BY: **J. BLANCHARD** CHECKED **K. KERN**
BAKERSFIELD NB SHEET 6 SHEET **90** OF **131**

DIRECTION	MILEPOINT	LOCATION CODE (SHEET 2)	SIGN CODE	WIDTH (IN)	HEIGHT (IN)	SHEETING REMARKS	SIGN LEGEND	NEW SIGNS "A"	NEW SIGNS "B"	EXISTING SIGNS RETAIN	EXISTING SIGNS SALVAGE FROM	EXISTING SIGNS SALVAGE TO	EXISTING SIGNS REMOVE	EXIST POST RETAIN	EXIST POST REMOVE	NUMBER OF NEW POSTS	SQUARE STEEL (IN) 1.75 (LB / FT) 1.88	SQUARE STEEL (IN) 2.00 (LB / FT) 2.42	SQUARE STEEL (IN) 2.50 (LB / FT) 3.35	TUBULAR STEEL Ø (IN) FOUNDATION	TUBULAR STEEL Ø (IN) 3.00 (LB / FT) 7.60	TUBULAR STEEL Ø (IN) 3.50 (LB / FT) 9.00	TUBULAR STEEL Ø (IN) 4.00 (LB / FT) 10.80	TUBULAR STEEL Ø (IN) 5.00 (LB / FT) 14.60	SIGN FRAME REQUIRED	REMARKS	SIGN DETAIL LOCATION SHSM	SIGN DETAIL LOCATION PROJECT SHEET #	SIGN DETAIL LOCATION STANDARD SHEET #
BAKERSFIELD VT-108 NB							FY-FLUORESCENT YELLOW FYG-FLUORESCENT YELLOW GREEN																				"SHSM"-STANDARD HIGHWAY SIGNS AND MARKINGS			
		C	VR-017	24	30		LLL 24,000 LBS 5/5						1																
		C	VD-700	6	10		MILE MARKER 5/5						1																
NB	7.983	A/B	D3-1	34	12		 5/5	2.83								1		14.75 X								OVITT RD (TH-42); MOUNT TO STOP SIGN WITH BRACKET		13	
		D	R1-1	30	30		 5/5	6.25																		OVITT RD (TH-42); INSTALL 37 FT NORTH OF EXISTING	X		
NB	7.998	A	W11-4	30	30		CATTLE SYMBOL 5/5						1		X														
		A	W11-4	30	30		 5/5	6.25								1		15.50 X									X		

SIGN SUMMARY SHEET																						
VERMONT AGENCY OF TRANSPORTATION	SHEET TOTALS	15.33	0.00	0	0	0	3	0	0	2	30.25 ~~30.0~~		0	0.0	0.0	0.0	0.0					
		SF	SF	EA	EA	EA	EA	EA	EA	EA	FT		EA	LB	LB	LB	LB					
	TOWN DIRECTIONAL TOTALS	191.4	0.0	6	4	4	48	0	0	30	450.0		0	0.0								

PROJECT NAME: **STOWE - BERKSHIRE**
PROJECT NUMBER: **STPG SIGN (49)**
FILE NAME: **05 BAKERSFIELD VT-108 NB T** PLOT DATE: **4/15/2015**
PROJECT MANAGER: **D. BRYANT** DRAWN BY: **J. BLANCHARD**
DESIGNED BY: **J. BLANCHARD** CHECKED **K. KERN**
BAKERSFIELD NB SHEET 7 SHEET **91** OF **131**

DIRECTION	MILEPOINT	LOCATION CODE (SHEET 2)	SIGN CODE	WIDTH (IN)	HEIGHT (IN)	SHEETING REMARKS	SIGN LEGEND	NEW SIGNS "A"	NEW SIGNS "B"	EXISTING SIGNS RETAIN	EXISTING SIGNS SALVAGE FROM	EXISTING SIGNS SALVAGE TO	EXISTING SIGNS REMOVE	EXIST POST RETAIN	EXIST POST REMOVE	NUMBER OF NEW POSTS	SQUARE STEEL (IN) 1.75 (LB / FT) 1.88	SQUARE STEEL (IN) 2.00 (LB / FT) 2.42	SQUARE STEEL (IN) 2.50 (LB / FT) 3.35	TUBULAR STEEL Ø (IN) FOUNDATION	TUBULAR STEEL Ø (IN) 3.00 (LB / FT) 7.60	TUBULAR STEEL Ø (IN) 3.50 (LB / FT) 9.00	TUBULAR STEEL Ø (IN) 4.00 (LB / FT) 10.80	TUBULAR STEEL Ø (IN) 5.00 (LB / FT) 14.60	SIGN FRAME REQUIRED	REMARKS	SIGN DETAIL LOCATION SHSM	SIGN DETAIL LOCATION PROJECT SHEET #	SIGN DETAIL LOCATION STANDARD SHEET #
BAKERSFIELD VT-108 SB							FY-FLUORESCENT YELLOW FYG-FLUORESCENT YELLOW GREEN																			"SHSM"-STANDARD HIGHWAY SIGNS AND MARKINGS			
SB	7.689	F	W1-10	30	30		MODIFIED RIGHT CURVE						1		X														
		F	W1-10cR	36	36		 8/15	9.00								2		31.75 X										X		
SB	7.072	G	VR-017	24	30		LLL 24,000 LBS 5/5						1		X														
		G	W14-1	30	30		DEAD END 5/5				1		1														SALVAGE AND MOUNT IN NEW LOCATION			
		G	VR-017	24	30		 5/5	5.00								1		13.50 X									PUDVAH HILL RD (TH-15)		9	
SB	7.072	E/F	D3-1	60	12		 5/5	5.00								2		21.00 X									PUDVAH HILL RD (TH-15); FIELD LOCATE FOR VISIBILITY FROM VT-108		13	
SB	7.072	G	W14-1	30	30		DEAD END 5/5					1				1		11.50 X									PUDVAH HILL RD (TH-15); INSTALL SALVAGED SIGN ON NEW POST WEST OF LLL			
SB	7.060	H	R1-1	30	30		STOP 5/5			1				X															
		E/F	D3-1	UNK.	UNK.		PUDVAH HILL RD 5/5						1																	
SB	7.049	F	OM3R	12	36		RIGHT OBJECT MARKER 5/5						1		X														
SB	7.040	E	OM3L	12	36		LEFT OBJECT MARKER 5/5						1		X														
SB	5.999	G	VR-017	24	30		TRIM  5/5	5.00								1		13.75 X									BROWNS POND RD (TH-22); INSTALL EAST OF BRIDGE		9	
SB	5.995	A/B	D3-1	UNK.	UNK.		BROWNS POND RD 5/5						1		X														
		H	R1-1	30	30		STOP 5/5						1																
		G	VD-700	6	10		MILE MARKER 5/5				1	1	1														SALVAGE AND MOUNT ON NEW POST BELOW STOP SIGN			
SIGN SUMMARY SHEET							SHEET TOTALS	24.00	0.00	1	2	2	9	0	0	7		91.50 ~~105.0~~		0	0.0	0.0	0.0	0.0					
								SF	SF	EA	EA	EA	EA	EA	EA	EA		FT		EA	LB	LB	LB	LB					
VERMONT AGENCY OF TRANSPORTATION							TOWN DIRECTIONAL TOTALS	235.0	0.0	6	11	11	58	0	0	43		645.0		0	0.0								

PROJECT NAME: **STOWE - BERKSHIRE**
PROJECT NUMBER: **STPG SIGN (49)**
FILE NAME: **06 BAKERSFIELD VT-108 SB T** PLOT DATE: **6/25/2015**
PROJECT MANAGER: **D. BRYANT** DRAWN BY: **J. BLANCHARD**
DESIGNED BY: **J. BLANCHARD** CHECKED **K. KERN**
BAKERSFIELD SB SHEET 1 SHEET **92** OF **131**

DIRECTION	MILEPOINT	LOCATION CODE (SHEET 2)	SIGN CODE	WIDTH (IN)	HEIGHT (IN)	SHEETING REMARKS	SIGN LEGEND	NEW SIGNS "A"	NEW SIGNS "B"	EXISTING SIGNS RETAIN	EXISTING SIGNS SALVAGE FROM	EXISTING SIGNS SALVAGE TO	EXISTING SIGNS REMOVE	EXIST POST RETAIN	EXIST POST REMOVE	NUMBER OF NEW POSTS	SQUARE STEEL (IN) 1.75 (LB / FT) 1.88	SQUARE STEEL (IN) 2.00 (LB / FT) 2.42	SQUARE STEEL (IN) 2.50 (LB / FT) 3.35	TUBULAR STEEL Ø (IN) FOUNDATION	TUBULAR STEEL Ø (IN) 3.00 (LB / FT) 7.60	TUBULAR STEEL Ø (IN) 3.50 (LB / FT) 9.00	TUBULAR STEEL Ø (IN) 4.00 (LB / FT) 10.80	TUBULAR STEEL Ø (IN) 5.00 (LB / FT) 14.60	SIGN FRAME REQUIRED	REMARKS	SIGN DETAIL LOCATION SHSM	SIGN DETAIL LOCATION PROJECT SHEET #	SIGN DETAIL LOCATION STANDARD SHEET #
BAKERSFIELD VT-108 SB							FY-FLUORESCENT YELLOW FYG-FLUORESCENT YELLOW GREEN																				"SHSM"-STANDARD HIGHWAY SIGNS AND MARKINGS			
		H	R1-1	30	30			6.25								1		13.50 X								BROWNS POND RD (TH-22)	X		
SB	5.995	E/F	D3-1	66	12		TRIM  5/5	5.50								2		27.50 X								BROWNS POND RD (TH-22); FIELD LOCATE FOR VISIBILITY FROM VT-108		13	
SB	5.652	F	W11-7	30	30		EQUESTRIAN SYMBOL 5/5						1		X														
		F	W7-3aP	24	18		NEXT 2 MILES 5/5						1																
		F	W11-7	30	30		TRIM 6/30  5/5	6.25								1		15.00 X								REQUIRES VEGETATION CLEARING	X		
		F	W7-3aP	24	18		 5/5	3.00																		X		
SB	5.632	G	VR-278	24	36		PROHIBITED DUMPING 5/5						1		X														
		G	VR-278	24	36		 5/5	6.00								1		14.50 X										9	
SB	5.607	F	VD-062AS	72	16		BUSINESS SIGN 5/5			1				X															
		F	VD-700	6	10		MILE MARKER 5/5			1																			
SB	5.568	F	W1-10	30	30		MODIFIED RIGHT CURVE 5/5						1		X														
		F	W16-8P	30	8		BOSTON POST RD 5/5						1																
SB	5.534	F	W1-10MR	36	36		TRIM  5/5	9.00								2		28.50 X								INSTALL 180 FT SOUTH OF EXISTING	X		
		F	W16-8P	34	8		 5/5	1.89																				6	
SB	5.428	F	M3-3	24	12		SOUTH STATE 5/5						1		X														

SIGN SUMMARY SHEET	SHEET TOTALS	37.89	0.00	2	0	0	6	0	0	7	99.00 ~~105.0~~		0	0.0	0.0	0.0	0.0											
		SF	SF	EA	EA	EA	EA	EA	EA	EA	FT		EA	LB	LB	LB	LB											
VERMONT AGENCY OF TRANSPORTATION	TOWN DIRECTIONAL TOTALS	235.0	0.0	6	11	11	58	0	0	43	645.0		0	0.0														

PROJECT NAME: **STOWE - BERKSHIRE**
PROJECT NUMBER: **STPG SIGN (49)**
FILE NAME: **06 BAKERSFIELD VT-108 SB T** PLOT DATE: **6/25/2015**
PROJECT MANAGER: **D. BRYANT** DRAWN BY: **J. BLANCHARD**
DESIGNED BY: **J. BLANCHARD** CHECKED **K. KERN**
BAKERSFIELD SB SHEET 2 SHEET **93** OF **131**

DIRECTION	MILEPOINT	LOCATION CODE (SHEET 2)	SIGN CODE	WIDTH (IN)	HEIGHT (IN)	SHEETING REMARKS	SIGN LEGEND	NEW SIGNS "A"	NEW SIGNS "B"	EXISTING SIGNS RETAIN	EXISTING SIGNS SALVAGE FROM	EXISTING SIGNS SALVAGE TO	EXISTING SIGNS REMOVE	EXIST POST RETAIN	EXIST POST REMOVE	NUMBER OF NEW POSTS	SQUARE STEEL (IN) 1.75 (LB/FT) 1.88	SQUARE STEEL (IN) 2.00 (LB/FT) 2.42	SQUARE STEEL (IN) 2.50 (LB/FT) 3.35	TUBULAR STEEL Ø (IN) FOUNDATION	TUBULAR STEEL Ø (IN) 3.00 (LB/FT) 7.60	TUBULAR STEEL Ø (IN) 3.50 (LB/FT) 9.00	TUBULAR STEEL Ø (IN) 4.00 (LB/FT) 10.80	TUBULAR STEEL Ø (IN) 5.00 (LB/FT) 14.60	SIGN FRAME REQUIRED	REMARKS	SIGN DETAIL LOCATION SHSM	SIGN DETAIL LOCATION PROJECT SHEET #	SIGN DETAIL LOCATION STANDARD SHEET #
BAKERSFIELD VT-108 SB							FY-FLUORESCENT YELLOW FYG-FLUORESCENT YELLOW GREEN																			"SHSM"-STANDARD HIGHWAY SIGNS AND MARKINGS			
		F	M1-5	30	24		VERMONT 108						1																
		F	M3-3	24	12	GRN/WHT	TRIM  5/5	2.00								1		14.50 X									X		
		F	M1-5	30	24	GRN/WHT	5/5	5.00																					E-136B
SB	4.584	F	VR2-5A	24	30		REDUCED SPEED AHEAD 5/5						1		X														
SB	4.551	G	VR-017	24	30		LLL 24,000 LBS 5/5					1				1		X									HYDES HILL RD (TH-23); INSTALL SALVAGED SIGN IN NEW LOCATION			
		H	R1-1	30	30		STOP 5/5						1																
SB	4.548	G	W14-1	30	30		DEAD END 5/5					1				1		13.50 X									HYDES HILL RD (TH-23); INSTALL WEST OF LLL			
SB	4.548	G	VR-017	24	30		LLL 24,000 LBS 5/5				1		1		X			14.00									SALVAGE TO NEW LOCATION			
SB	4.548	H	R1-1	30	30		TRIM  5/5	6.25								1		14.25 X									HYDES HILL RD (TH-23)	X		
SB	4.548	E/F	D3-1	UNK.	UNK.		HYDES HILL RD 5/5						1		X														
		G	W14-1	30	30		DEAD END 5/5				0 ~~1~~		1														SALVAGE TO NEW LOCATION			
		E/F	D3-1	56	12		 5/5	4.67								2		22.00 X									HYDES HILL RD (TH-23); FIELD LOCATE FOR VISIBILITY FROM VT-108		13	
SB	4.516	F	W3-5	36	36		 5/5	9.00								2		28.50 X									INSTALL 168 FT SOUTH OF HYDES HILL RD (TH-23) STREET SIGN	X		
SB	4.421	F	R2-1	24	30		SPEED LIMIT 40 5/5						1		X														
		F	R2-1	30	36		TRIM  5/5	7.50								1		13.50 X									REQUIRES VEGETATION CLEARING	X		
SIGN SUMMARY SHEET							SHEET TOTALS	34.42	0.00	0	~~1~~ 2	2	7	0	0	9		~~135.0~~ 120.25		0	0.0	0.0	0.0	0.0					
								SF	SF	EA	EA	EA	EA	EA	EA	EA		FT		EA	LB	LB	LB	LB					
VERMONT AGENCY OF TRANSPORTATION							TOWN DIRECTIONAL TOTALS	235.0	0.0	6	11	11	58	0	0	43		645.0		0	0.0								

PROJECT NAME: **STOWE - BERKSHIRE**
PROJECT NUMBER: **STPG SIGN (49)**
FILE NAME: **06 BAKERSFIELD VT-108 SB T**
PROJECT MANAGER: **D. BRYANT**
DESIGNED BY: **J. BLANCHARD**
BAKERSFIELD SB SHEET 3
PLOT DATE: **6/25/2015**
DRAWN BY: **J. BLANCHARD**
CHECKED **K. KERN**
SHEET **94** OF **131**

DIRECTION	MILEPOINT	LOCATION CODE (SHEET 2)	SIGN CODE	WIDTH (IN)	HEIGHT (IN)	SHEETING REMARKS	SIGN LEGEND	NEW SIGNS "A"	NEW SIGNS "B"	EXISTING SIGNS RETAIN	EXISTING SIGNS SALVAGE FROM	EXISTING SIGNS SALVAGE TO	EXISTING SIGNS REMOVE	EXIST POST RETAIN	EXIST POST REMOVE	NUMBER OF NEW POSTS	SQUARE STEEL (IN) 1.75 (LB / FT) 1.88	SQUARE STEEL (IN) 2.00 (LB / FT) 2.42	SQUARE STEEL (IN) 2.50 (LB / FT) 3.35	TUBULAR STEEL Ø (IN) FOUNDATION	TUBULAR STEEL Ø (IN) 3.00 (LB / FT) 7.60	TUBULAR STEEL Ø (IN) 3.50 (LB / FT) 9.00	TUBULAR STEEL Ø (IN) 4.00 (LB / FT) 10.80	TUBULAR STEEL Ø (IN) 5.00 (LB / FT) 14.60	SIGN FRAME REQUIRED	REMARKS	SIGN DETAIL LOCATION SHSM	SIGN DETAIL LOCATION PROJECT SHEET #	SIGN DETAIL LOCATION STANDARD SHEET #
BAKERSFIELD VT-108 SB							FY-FLUORESCENT YELLOW FYG-FLUORESCENT YELLOW GREEN																				"SHSM"-STANDARD HIGHWAY SIGNS AND MARKINGS			
SB	4.328	F	W3-5	36	36		TRIM  5/5	9.00								2		30.00 X								INSTALL 32 FT SOUTH OF UTILITY POLE #32 AT M.P. 4.334	X		
SB	4.233	F	R2-1	30	36		 5/5	7.50								1		14.00 X								INSTALL 100 FT NORTH OF EXISTING, ACROSS FROM NB 40 MPH	X		
SB	4.224	F	R2-1	24	30		SPEED LIMIT 35 5/5						1		X														
		F	R3-1	24	24		NO RIGHT TURN SYMBOL 5/5						1																	
		F	VD-700	6	10		MILE MARKER 5/5				1	1	1														SALVAGE AND MOUNT ON NEW POST BELOW NO RIGHT TURN SYMBOL			
		F	R3-1	24	24		TRIM  5/5	4.00								1		13.00 X								REQUIRES VEGETATION CLEARING	X		
SB	4.098	G	VR-017	24	30		LLL 24,000 LBS 5/5						1		X														
		G	VD-700	6	10		MILE MARKER 5/5				1	1	1														SALVAGE AND MOUNT ON NEW POST BELOW FOUR WHEELER SIGN			
		G	VR-017	24	30		 5/5	5.00								1			15.50 X							EGYPT RD (TH-20)		9	
		G	UNK.	24	30		FOUR WHEELERS PROHIBITED ON TOWN HIGHWAYS 5/5					1														EGYPT RD (TH-20); MOUNT SALVAGED SIGN BELOW LLL			
SB	4.090	E/F	D3-1	UNK.	UNK.		EGYPT RD 5/5						1		X														
		G	UNK.	24	30		FOUR WHEELERS PROHIBITED ON TOWN HIGHWAYS 5/5				1		1														SALVAGE AND MOUNT IN NEW LOCATION			
		H	R1-1	30	30		STOP 5/5						1																
		G	VD-700	6	10		MILE MARKER  5/5				1	1	1														SALVAGE AND MOUNT ON NEW POST BELOW STOP SIGN			
		E/F	D3-1	38	12		 5/5	3.17								1		13.75 X								EGYPT RD (TH-20); MOUNT TO STOP SIGN WITH BRACKET		13	
SIGN SUMMARY SHEET							SHEET TOTALS	28.67	0.00	0	4	4	9	0	0	6		86.25 ~~90.0~~		0	0.0	0.0	0.0	0.0					
								SF	SF	EA	EA	EA	EA	EA	EA	EA		FT		EA	LB	LB	LB	LB					
VERMONT AGENCY OF TRANSPORTATION							TOWN DIRECTIONAL TOTALS	235.0	0.0	6	11	11	58	0	0	43		645.0		0		0.0							



PROJECT NAME: **STOWE - BERKSHIRE**
PROJECT NUMBER: **STPG SIGN (49)**
FILE NAME: **06 BAKERSFIELD VT-108 SB T** PLOT DATE: **6/25/2015**
PROJECT MANAGER: **D. BRYANT** DRAWN BY: **J. BLANCHARD**
DESIGNED BY: **J. BLANCHARD** CHECKED **K. KERN**
BAKERSFIELD SB SHEET 4 SHEET **95** OF **131**

DIRECTION	MILEPOINT	LOCATION CODE (SHEET 2)	SIGN CODE	WIDTH (IN)	HEIGHT (IN)	SHEETING REMARKS	SIGN LEGEND	NEW SIGNS "A"	NEW SIGNS "B"	EXISTING SIGNS RETAIN	EXISTING SIGNS SALVAGE FROM	EXISTING SIGNS SALVAGE TO	EXISTING SIGNS REMOVE	EXIST POST RETAIN	EXIST POST REMOVE	NUMBER OF NEW POSTS	SQUARE STEEL (IN) 1.75 (LB/FT) 1.88	SQUARE STEEL (IN) 2.00 (LB/FT) 2.42	SQUARE STEEL (IN) 2.50 (LB/FT) 3.35	TUBULAR STEEL Ø (IN) FOUNDATION	TUBULAR STEEL Ø (IN) 3.00 (LB/FT) 7.60	TUBULAR STEEL Ø (IN) 3.50 (LB/FT) 9.00	TUBULAR STEEL Ø (IN) 4.00 (LB/FT) 10.80	TUBULAR STEEL Ø (IN) 5.00 (LB/FT) 14.60	SIGN FRAME REQUIRED	REMARKS	SIGN DETAIL LOCATION SHSM	SIGN DETAIL LOCATION PROJECT SHEET #	SIGN DETAIL LOCATION STANDARD SHEET #
BAKERSFIELD VT-108 SB							FY-FLUORESCENT YELLOW FYG-FLUORESCENT YELLOW GREEN																				"SHSM"-STANDARD HIGHWAY SIGNS AND MARKINGS			
		H	R1-1	30	30		5/5	6.25																			EGYPT RD (TH-20)	X		
SB	3.898	F	S1-1	36	36	FYG	SCHOOL SYMBOL 5/5						1		X														
		F	W16-9P	30	18	FYG	AHEAD WARNING 5/5						1																
		F	VD-700	6	10		MILE MARKER 5/5				1	1	1														SALVAGE AND MOUNT ON NEW POST BELOW SCHOOL SIGN			
		F	S1-1	36	36	FYG	 5/5	9.00								1			13.50 X									
		F	S4-3P	24	8	FYG	5/5	1.33																				X		
SB	3.894	E/F	D3-1	UNK.	UNK.		AVENUE RD 5/5						1		X														
		G	VR-017	24	30		LLL 24,000 LBS 5/5						1																
		G	UNK.	UNK.	UNK.		SCHOOL ZONE 25 MPH 5/5				1		1														SALVAGE TO NEW LOCATION			
		H	R1-1	30	30		STOP 5/5						1																
SB	3.894	G	VR-017	24	30		TRIM  5/5	5.00								1			14.00 X							AVENUE RD (TH-31); INSTALL 30 FT BEYOND STOP SIGN ASSEMBLY		9	
		G	UNK.	UNK.	UNK.		SCHOOL ZONE 25 MPH 5/5					1														AVENUE RD (TH-31); SALVAGE AND REMOUNT BELOW LLL			
SB	3.884	E/F	D3-1	40	12		 5/5	3.33																			AVENUE RD (TH-31); MOUNT TO STOP SIGN WITH BRACKET		13	
		H	R1-1	30	30		 5/5	6.25								1		13.75 X							AVENUE RD (TH-31); INSTALL IN PAVEMENT WITH DRUM AROUND POST(SEE GENERAL NOTE 7, SHT 2)	X		
SB	3.831	F	M2-1	21	15	GRN/ WHT	5/5	2.19								1		14.25 X							INSTALL 111 FT NORTH OF EXISTING	X		
SIGN SUMMARY SHEET							SHEET TOTALS	33.35	0.00	0	2	2	7	0	0	4		~~60.0~~ 55.50		0	0.0	0.0	0.0	0.0					
								SF	SF	EA	EA	EA	EA	EA	EA	EA		FT		EA	LB	LB	LB	LB					
VERMONT AGENCY OF TRANSPORTATION							TOWN DIRECTIONAL TOTALS	235.0	0.0	6	11	11	58	0	0	43		645.0		0		0.0							

PROJECT NAME: **STOWE - BERKSHIRE**
PROJECT NUMBER: **STPG SIGN (49)**
FILE NAME: **06 BAKERSFIELD VT-108 SB T** PLOT DATE: **7/29/2015**
PROJECT MANAGER: **D. BRYANT** DRAWN BY: **J. BLANCHARD**
DESIGNED BY: **J. BLANCHARD** CHECKED **K. KERN**
BAKERSFIELD SB SHEET 5 SHEET **96** OF **131**

DIRECTION	MILEPOINT	LOCATION CODE (SHEET 2)	SIGN CODE	WIDTH (IN)	HEIGHT (IN)	SHEETING REMARKS	SIGN LEGEND		NEW SIGNS "A"	NEW SIGNS "B"	EXISTING SIGNS RETAIN	EXISTING SIGNS SALVAGE FROM	EXISTING SIGNS SALVAGE TO	EXISTING SIGNS REMOVE	EXIST POST RETAIN	EXIST POST REMOVE	NUMBER OF NEW POSTS	SQUARE STEEL (IN) 1.75 (LB / FT) 1.88	SQUARE STEEL (IN) 2.00 (LB / FT) 2.42	SQUARE STEEL (IN) 2.50 (LB / FT) 3.35	TUBULAR STEEL Ø (IN) FOUNDATION	TUBULAR STEEL Ø (IN) 3.00 (LB / FT) 7.60	TUBULAR STEEL Ø (IN) 3.50 (LB / FT) 9.00	TUBULAR STEEL Ø (IN) 4.00 (LB / FT) 10.80	TUBULAR STEEL Ø (IN) 5.00 (LB / FT) 14.60	SIGN FRAME REQUIRED	REMARKS	SIGN DETAIL LOCATION SHSM	SIGN DETAIL LOCATION PROJECT SHEET #	SIGN DETAIL LOCATION STANDARD SHEET #
BAKERSFIELD VT-108 SB							FY-FLUORESCENT YELLOW FYG-FLUORESCENT YELLOW GREEN																					"SHSM"-STANDARD HIGHWAY SIGNS AND MARKINGS			
		F	M1-5	24	24	GRN/WHT		5/5	4.00																					E-136B
SB	3.810	F	M2-1	21	15		JCT STATE	5/5						1		X														
		F	M1-5	24	24		VERMONT 36	5/5						1																
		F	VD-700	6	10		MILE MARKER	5/5						1																
SB	3.793	F	W11-2	30	30	FYG	PEDESTRIAN SYMBOL	5/6						1		X														
		F	W16-7P	21	15	FYG	DOWNWARD DIAGONAL ARROW	5/6						1																
		F	S1-1	36	36	FYG		5/6	9.00								1			14.75 X								X		
		F	W16-7P	21	15	FYG		5/6	2.19																				X		
SB	3.776	G	VR-017	24	30		LLL 24,000 LBS	5/6						1		X														
		E/F	D3-1	UNK.	UNK.		ACADEMY LN	5/6						~~1~~ 2																
		E/F	D3-1	52	12			5/6	4.33								2		23.25 X								ACADEMY LN (TH-21); FIELD LOCATE FOR VISIBILITY FROM VT-108		13	
SB	3.775	G	UNK.	UNK.	UNK.		SCHOOL ZONE 25 M.P.H.	5/6				1	1	1		X												ACADEMY LN (TH-21); SALVAGE AND REMOUNT BELOW LLL			
		G	VR-017	24	30			5/6	5.00								1			14.50 X								ACADEMNY LN (TH-21)		9	
SB	3.771	H	R1-1	30	30		STOP	5/6						1		X														
		H	R1-1	30	30			5/6	6.25								1		13.00 X								ACADEMY LN (TH-21)	X		
SIGN SUMMARY SHEET							SHEET TOTALS		30.77	0.00	0	1	1	~~9~~ 10	0	0	5		~~75.0~~ 65.50		0	0.0	0.0	0.0	0.0					
									SF	SF	EA	EA	EA	EA	EA	EA	EA		FT		EA	LB	LB	LB	LB					
VERMONT AGENCY OF TRANSPORTATION							TOWN DIRECTIONAL TOTALS		235.0	0.0	6	11	11	58	0	0	43		645.0		0		0.0							

PROJECT NAME: **STOWE - BERKSHIRE**
PROJECT NUMBER: **STPG SIGN (49)**
FILE NAME: **06 BAKERSFIELD VT-108 SB T** PLOT DATE: **6/25/2015**
PROJECT MANAGER: **D. BRYANT** DRAWN BY: **J. BLANCHARD**
DESIGNED BY: **J. BLANCHARD** CHECKED **K. KERN**
BAKERSFIELD SB SHEET 6 SHEET **97** OF **131**

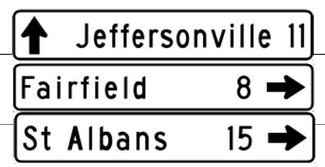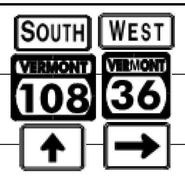DIRECTION	MILEPOINT	LOCATION CODE (SHEET 2)	SIGN CODE	WIDTH (IN)	HEIGHT (IN)	SHEETING REMARKS	SIGN LEGEND	NEW SIGNS "A"	NEW SIGNS "B"	EXISTING SIGNS RETAIN	EXISTING SIGNS SALVAGE FROM	EXISTING SIGNS SALVAGE TO	EXISTING SIGNS REMOVE	EXIST POST RETAIN	EXIST POST REMOVE	NUMBER OF NEW POSTS	SQUARE STEEL (IN) 1.75 (LB/FT) 1.88	SQUARE STEEL (IN) 2.00 (LB/FT) 2.42	SQUARE STEEL (IN) 2.50 (LB/FT) 3.35	TUBULAR STEEL Ø (IN) FOUNDATION	TUBULAR STEEL Ø (IN) 3.00 (LB/FT) 7.60	TUBULAR STEEL Ø (IN) 3.50 (LB/FT) 9.00	TUBULAR STEEL Ø (IN) 4.00 (LB/FT) 10.80	TUBULAR STEEL Ø (IN) 5.00 (LB/FT) 14.60	SIGN FRAME REQUIRED	REMARKS	SIGN DETAIL LOCATION SHSM	SIGN DETAIL LOCATION PROJECT SHEET #	SIGN DETAIL LOCATION STANDARD SHEET #
BAKERSFIELD VT-108 SB							FY-FLUORESCENT YELLOW FYG-FLUORESCENT YELLOW GREEN																			"SHSM"-STANDARD HIGHWAY SIGNS AND MARKINGS			
SB	3.721	F	D1-1a	72	10		^UP JEFFERSONVILLE 11 8/16						1		X														
		F	D1-1a	72	10		FAIRFIELD 8 ---> 8/16						1																
		F	D1-1a	72	10		ST ALBANS 15 ---> 8/16						1																
		F	M3-3	24	12		SOUTH STATE 8/16						1																
		F	M1-5	30	24		VERMONT 108 8/16						1																
		F	M6-3	21	15		^UP ARROW STATE 8/16						1																
		F	M3-4	24	12		WEST STATE 8/16						1																
		F	M1-5	24	24		VERMONT 36 8/16						1																
		F	M6-1	21	15		RIGHT ---> STATE 8/16						1																
		F	VD1-1a	72	12		 8/16	6.00								2		33.00 X							SLIP BASE REQUIRED - SEE SHEET 2		7	
		F	VD1-1a	72	12		8/16	6.00																				7	
		F	VD1-1a	72	12		8/16	6.00																				7	
SB	3.691	F	M3-3	24	12	GRN/WHT	 6/30	2.00								2		30.75 X							2B	INSTALL IN SOUTH CORNER OF VT-36 INTERSECTION, AT LEAST 10 FT FROM STOP SIGN	X		
		F	M1-5	30	24	GRN/WHT	6/30	5.00																					E-136B
		F	M6-3	21	15	GRN/WHT	6/30	2.19																				X		
SIGN SUMMARY SHEET							SHEET TOTALS	27.19	0.00	0	0	0	9	0	0	4		~~60.0~~ 63.75		0	0.0	0.0	0.0	0.0					
								SF	SF	EA	EA	EA	EA	EA	EA	EA		FT		EA	LB	LB	LB	LB					
VERMONT AGENCY OF TRANSPORTATION							TOWN DIRECTIONAL TOTALS	235.0	0.0	6	11	11	58	0	0	43		645.0		0		0.0							

PROJECT NAME: **STOWE - BERKSHIRE**
PROJECT NUMBER: **STPG SIGN (49)**
FILE NAME: **06 BAKERSFIELD VT-108 SB T** PLOT DATE: **7/29/2015**
PROJECT MANAGER: **D. BRYANT** DRAWN BY: **J. BLANCHARD**
DESIGNED BY: **J. BLANCHARD** CHECKED **K. KERN**
BAKERSFIELD SB SHEET 7 SHEET **98** OF **131**

DIRECTION	MILEPOINT	LOCATION CODE (SHEET 2)	SIGN CODE	WIDTH (IN)	HEIGHT (IN)	SHEETING REMARKS	SIGN LEGEND	NEW SIGNS "A"	NEW SIGNS "B"	EXISTING SIGNS RETAIN	EXISTING SIGNS SALVAGE FROM	EXISTING SIGNS SALVAGE TO	EXISTING SIGNS REMOVE	EXIST POST RETAIN	EXIST POST REMOVE	NUMBER OF NEW POSTS	SQUARE STEEL (IN) 1.75 (LB/FT) 1.88	SQUARE STEEL (IN) 2.00 (LB/FT) 2.42	SQUARE STEEL (IN) 2.50 (LB/FT) 3.35	TUBULAR STEEL Ø (IN) FOUNDATION	TUBULAR STEEL Ø (IN) 3.00 (LB/FT) 7.60	TUBULAR STEEL Ø (IN) 3.50 (LB/FT) 9.00	TUBULAR STEEL Ø (IN) 4.00 (LB/FT) 10.80	TUBULAR STEEL Ø (IN) 5.00 (LB/FT) 14.60	SIGN FRAME REQUIRED	REMARKS	SIGN DETAIL LOCATION SHSM	SIGN DETAIL LOCATION PROJECT SHEET #	SIGN DETAIL LOCATION STANDARD SHEET #
BAKERSFIELD VT-108 SB							FY-FLUORESCENT YELLOW FYG-FLUORESCENT YELLOW GREEN																			"SHSM"-STANDARD HIGHWAY SIGNS AND MARKINGS			
		F	M3-4	24	12	GRN/ WHT	6/30	2.00																			X		
		F	M1-5	24	24	GRN/ WHT	6/30	4.00																					E-136B
		F	M6-1R	21	15	GRN/ WHT	6/30	2.19																			X		
SB	3.691	H	R1-1	30	30		STOP 5/6			1				X															
		G	VD-700	6	10		MILE MARKER 5/6			1																			
		E/F	D3-1	42	12		Fairfield Rd 5/6	3.50																			FAIRFIELD RD (VT-36); MOUNT TO STOP SIGN WITH BRACKET		14	
SB	3.645	F	M3-3	24	12		SOUTH STATE 5/6						1		X														
		F	M1-5	30	24		VERMONT 108 5/6						1																
		F	M3-3	24	12	GRN/ WHT	SOUTH 5/6	2.00								1		14.00 X								X		
		F	M1-5	30	24	GRN/ WHT	VERMONT 108 5/6	5.00																				E-136B
SB	3.487	F	R2-1	24	30		SPEED LIMIT 40 5/6			1				X															

SIGN SUMMARY SHEET

VERMONT AGENCY OF TRANSPORTATION

	NEW SIGNS "A"	NEW SIGNS "B"	RETAIN	SALVAGE FROM	SALVAGE TO	REMOVE	RETAIN	REMOVE	NUMBER OF NEW POSTS	SQUARE STEEL (IN)	TUBULAR STEEL Ø (IN) FOUNDATION	TUBULAR STEEL Ø (IN) 3.00	TUBULAR STEEL Ø (IN) 3.50	TUBULAR STEEL Ø (IN) 4.00	TUBULAR STEEL Ø (IN) 5.00
SHEET TOTALS	18.69	0.00	3	0	0	2	0	0	1	~~15.0~~ 14.00	0	0.0	0.0	0.0	0.0
	SF	SF	EA	EA	EA	EA	EA	EA	EA	FT	EA	LB	LB	LB	LB
TOWN DIRECTIONAL TOTALS	235.0	0.0	6	11	11	58	0	0	43	645.0	0	0.0			

PROJECT NAME: **STOWE - BERKSHIRE**
PROJECT NUMBER: **STPG SIGN (49)**
FILE NAME: **06 BAKERSFIELD VT-108 SB T** PLOT DATE: **6/25/2015**
PROJECT MANAGER: **D. BRYANT** DRAWN BY: **J. BLANCHARD**
DESIGNED BY: **J. BLANCHARD** CHECKED **K. KERN**
BAKERSFIELD SB SHEET 8 SHEET **99** OF **131**

DIRECTION	MILEPOINT	LOCATION CODE (SHEET 2)	SIGN CODE	WIDTH (IN)	HEIGHT (IN)	SHEETING REMARKS	SIGN LEGEND		NEW SIGNS "A"	NEW SIGNS "B"	EXISTING SIGNS RETAIN	EXISTING SIGNS SALVAGE FROM	EXISTING SIGNS SALVAGE TO	EXISTING SIGNS REMOVE	EXIST POST RETAIN	EXIST POST REMOVE	NUMBER OF NEW POSTS	SQUARE STEEL (IN) 1.75 (LB / FT) 1.88	SQUARE STEEL (IN) 2.00 (LB / FT) 2.42	SQUARE STEEL (IN) 2.50 (LB / FT) 3.35	TUBULAR STEEL Ø (IN) FOUNDATION	TUBULAR STEEL Ø (IN) 3.00 (LB / FT) 7.60	TUBULAR STEEL Ø (IN) 3.50 (LB / FT) 9.00	TUBULAR STEEL Ø (IN) 4.00 (LB / FT) 10.80	TUBULAR STEEL Ø (IN) 5.00 (LB / FT) 14.60	SIGN FRAME REQUIRED	REMARKS	SIGN DETAIL LOCATION SHSM	SIGN DETAIL LOCATION PROJECT SHEET #	SIGN DETAIL LOCATION STANDARD SHEET #
ENOSBURG VT-108 NB							FY-FLUORESCENT YELLOW FYG-FLUORESCENT YELLOW GREEN																					"SHSM"-STANDARD HIGHWAY SIGNS AND MARKINGS			
NB	0.000	C	VD-024	72	10		Enosburg | Bakersfield	5/2	5.00								2		26.50 X										6	
		C	VD-700	6	10		1080 0603 0000 … 1080 0601 0803	5/2	0.42																				T-44
		C	VD-700	6	10			5/2	0.42																				T-44
NB	1.044	A	VD-062BRN	72	16		BUSINESS SIGN	5/2			1				X															
NB	1.879	C	VR-017	24	30		LEGAL LOAD LIMIT 24,000 POUNDS	4/28	5.00								1		13.25 X									BOGUE RD (TH-30)		9	
NB	1.889	C/D	D3-1	UNK.	UNK.		W ENOSBURGH RD							1		X														
		A/B	D3-1	UNK.	UNK.		BOGUE RD	5/2						1																
		D	R1-1	30	30		STOP	4/28						1																
		C	VD-700	6	10		MILE MARKER	4/28				1	1	1													SALVAGE AND MOUNT ON NEW POST BELOW STOP SIGN			
		A/B	D3-1	38	12		Bogue Rd	5/2	3.17								1		13.50 X									BOGUE RD (TH-30); MOUNT TO STOP SIGN WITH BRACKET		14	
		D	R1-1	30	30		STOP	4/28	6.25																			BOGUE RD (TH-30)	X		
NB	2.087	A	W3-5	36	36		SPEED REDUCTION SPEED LIMIT 40	5/2						1		X															
		A	W3-5	36	36		SPEED LIMIT 40	5/2	9.00								2		30.75 X										X		
NB	2.117	A	VD-018	30	18		WEST ENOSBURG ENOSBURG FALLS 3	5/2						1		X															
		A	VD-018	30	18		West Enosburg Enosburg Falls 3	5/2	3.75								1		12.50 X											6	
SIGN SUMMARY SHEET							SHEET TOTALS		33.00	0.00	1	1	1	6	0	0	7		~~96.50~~ ~~105.0~~		0	0.0	0.0	0.0	0.0					
									SF	SF	EA	EA	EA	EA	EA	EA	EA		FT		EA	LB	LB	LB	LB					
VERMONT AGENCY OF TRANSPORTATION							TOWN DIRECTIONAL TOTALS		198.6	0.0	2	5	5	42	0	0	38		570.0		0	0.0								


PROJECT NAME: **STOWE - BERKSHIRE**
PROJECT NUMBER: **STPG SIGN (49)**
FILE NAME: **07 ENOSBURG VT-108 NB TSS** PLOT DATE: **4/15/2015**
PROJECT MANAGER: **D. BRYANT** DRAWN BY: **J. BLANCHARD**
DESIGNED BY: **J. BLANCHARD** CHECKED **K. KERN**
ENOSBURG NB SHEET 1 SHEET **100** OF **131**

DIRECTION	MILEPOINT	LOCATION CODE (SHEET 2)	SIGN CODE	WIDTH (IN)	HEIGHT (IN)	SHEETING REMARKS	SIGN LEGEND	NEW SIGNS "A"	NEW SIGNS "B"	EXISTING SIGNS RETAIN	EXISTING SIGNS SALVAGE FROM	EXISTING SIGNS SALVAGE TO	EXISTING SIGNS REMOVE	EXIST POST RETAIN	EXIST POST REMOVE	NUMBER OF NEW POSTS	SQUARE STEEL (IN) 1.75 (LB/FT) 1.88	SQUARE STEEL (IN) 2.00 (LB/FT) 2.42	SQUARE STEEL (IN) 2.50 (LB/FT) 3.35	TUBULAR STEEL Ø (IN) FOUNDATION	TUBULAR STEEL Ø (IN) 3.00 (LB/FT) 7.60	TUBULAR STEEL Ø (IN) 3.50 (LB/FT) 9.00	TUBULAR STEEL Ø (IN) 4.00 (LB/FT) 10.80	TUBULAR STEEL Ø (IN) 5.00 (LB/FT) 14.60	SIGN FRAME REQUIRED	REMARKS	SIGN DETAIL LOCATION SHSM	SIGN DETAIL LOCATION PROJECT SHEET #	SIGN DETAIL LOCATION STANDARD SHEET #
ENOSBURG VT-108 NB							FY-FLUORESCENT YELLOW FYG-FLUORESCENT YELLOW GREEN																				"SHSM"-STANDARD HIGHWAY SIGNS AND MARKINGS			
NB	2.164	A	W7-1	30	30		HILL SYMBOL 5/2						1		X														
		A	W7-2b	24	18		TRUCKS USE LOWER GEAR 5/2						1																
		A	W7-1	30	30		 5/2	6.25								1		15.50 X									X		
		A	W7-2bP	24	18		 5/2	3.00																				X		
NB	2.207	A	R2-1	24	30		SPEED LIMIT 40 4/29						1		X														
		A	R2-1	30	36		 4/29	7.50								1		13.75 X									X		
NB	2.265	A	W2-1	30	30		CROSSROADS SYMBOL 5/2						1		X														
		A	W13-1P	24	24		30 MPH 5/2						1																
		A	W2-1	30	30		 5/2	6.25								1		13.50 X									X		
		A	W13-1P	18	18		 5/2	2.25																				X		
NB	2.370	A	W11-6H	30	30		SNOWMOBILE SYMBOL 5/2						1		X														
		A	W11-6H	30	30		TRIM  5/2	6.25								1		12.50 X										INSTALL IN CLOSED POSITION		9	
NB	2.376	C	VR-017	24	30		TRIM  4/28	5.00								1		14.00 X										TYLER BRANCH RD (TH-1); INSTALL 20 FT EAST OF END OF FENCE; REQUIRES VEGETATION CLEARING		9	
NB	2.387	C/D	D3-1	UNK.	UNK.		W ENOSBURG RD VT 108S 5/2						1		X														
		A/B	D3-1	UNK.	UNK.		TYLER BRANCH RD 5/2						1																
SIGN SUMMARY SHEET							SHEET TOTALS	36.50	0.00	0	0	0	8	0	0	5		69.25 ~~75.0~~		0	0.0	0.0	0.0	0.0					
								SF	SF	EA	EA	EA	EA	EA	EA	EA		FT		EA	LB	LB	LB	LB					
VERMONT AGENCY OF TRANSPORTATION							TOWN DIRECTIONAL TOTALS	198.6	0.0	2	5	5	42	0	0	38		570.0		0	0.0								


PROJECT NAME: **STOWE - BERKSHIRE**
PROJECT NUMBER: **STPG SIGN (49)**
FILE NAME: **07 ENOSBURG VT-108 NB TSS** PLOT DATE: **4/15/2015**
PROJECT MANAGER: **D. BRYANT** DRAWN BY: **J. BLANCHARD**
DESIGNED BY: **J. BLANCHARD** CHECKED **K. KERN**
ENOSBURG NB SHEET 2 SHEET **101** OF **131**

DIRECTION	MILEPOINT	LOCATION CODE (SHEET 2)	SIGN CODE	WIDTH (IN)	HEIGHT (IN)	SHEETING REMARKS	SIGN LEGEND		NEW SIGNS		EXISTING SIGNS				EXIST POST		NUMBER OF NEW POSTS	SQUARE STEEL (IN)			TUBULAR STEEL Ø (IN)					SIGN FRAME REQUIRED	REMARKS	SIGN DETAIL LOCATION		
									"A"	"B"	RETAIN	SALVAGE FROM	SALVAGE TO	REMOVE	RETAIN	REMOVE		1.75	2.00	2.50	FOUNDATION	3.00	3.50	4.00	5.00			SHSM	PROJECT SHEET #	STANDARD SHEET #
																		(LB / FT)				(LB / FT)							
																		1.88	2.42	3.35		7.60	9.00	10.80	14.60				
ENOSBURG VT-108 NB							FY-FLUORESCENT YELLOW FYG-FLUORESCENT YELLOW GREEN																				"SHSM"-STANDARD HIGHWAY SIGNS AND MARKINGS			
		D	R1-1	30	30		STOP	4/28						1																
		C	VR-017	24	30		LLL 24,000 LBS	4/28						1																
		D	R1-1	30	30		STOP	4/28	6.25								1		13.50 X								TYLER BRANCH RD (TH-1)	X		
NB	2.387	A/B	D3-1	66	12		Tyler Branch Rd	5/2	5.50								2		22.25 X								TYLER BRANCH RD (TH-1)		14	
NB	2.406	A	R2-1	24	30		SPEED LIMIT 40	4/29						1		X														
		A	VD-700	6	10		MILE MARKER	4/29				1	1	1													SALVAGE AND MOUNT ON NEW POST BELOW SPEED LIMIT SIGN			
		A	R2-1	24	30		SPEED LIMIT 40	4/29	5.00								1		13.75 X									X		
NB	2.444	A	M3-1	24	12		NORTH STATE	4/29						1		X														
		A	M1-5A	30	24		VERMONT 108	4/29						1																
		A	M3-1	24	12	GRN/ WHT	TRIM NORTH	4/29	2.00								1		15.50 X									X		
		A	M1-5	30	24	GRN/ WHT	VERMONT 108	4/29	5.00																					E-136B
NB	2.558	A	R2-1	24	30		SPEED LIMIT 50	4/29						1		X														
		A	R2-1	24	30		SPEED LIMIT 50	4/29	5.00								1		12.75 X									X		
NB	2.659	A	W1-10	30	30		MODIFIED LEFT CURVE	4/29						1		X														
		A	W13-1P	18	18		35 MPH	4/29						1																
SIGN SUMMARY SHEET							SHEET TOTALS		28.75	0.00	0	1	1	9	0	0	6		~~77.75~~ ~~90.0~~		0	0.0	0.0	0.0	0.0					
									SF	SF	EA	EA	EA	EA	EA	EA	EA		FT		EA	LB	LB	LB	LB					
VERMONT AGENCY OF TRANSPORTATION							TOWN DIRECTIONAL TOTALS		198.6	0.0	2	5	5	42	0	0	38		570.0		0	0.0								

PROJECT NAME: **STOWE - BERKSHIRE**
PROJECT NUMBER: **STPG SIGN (49)**
FILE NAME: **07 ENOSBURG VT-108 NB TSS** PLOT DATE: **4/15/2015**
PROJECT MANAGER: **D. BRYANT** DRAWN BY: **J. BLANCHARD**
DESIGNED BY: **J. BLANCHARD** CHECKED **K. KERN**
ENOSBURG NB SHEET 3 SHEET **102** OF **131**

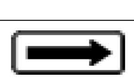DIRECTION	MILEPOINT	LOCATION CODE (SHEET 2)	SIGN CODE	WIDTH (IN)	HEIGHT (IN)	SHEETING REMARKS	SIGN LEGEND		NEW SIGNS "A"	NEW SIGNS "B"	EXISTING SIGNS RETAIN	EXISTING SIGNS SALVAGE FROM	EXISTING SIGNS SALVAGE TO	EXISTING SIGNS REMOVE	EXIST POST RETAIN	EXIST POST REMOVE	NUMBER OF NEW POSTS	SQUARE STEEL (IN) 1.75 (LB / FT) 1.88	SQUARE STEEL (IN) 2.00 (LB / FT) 2.42	SQUARE STEEL (IN) 2.50 (LB / FT) 3.35	TUBULAR STEEL Ø (IN) FOUNDATION	TUBULAR STEEL Ø (IN) 3.00 (LB / FT) 7.60	TUBULAR STEEL Ø (IN) 3.50 (LB / FT) 9.00	TUBULAR STEEL Ø (IN) 4.00 (LB / FT) 10.80	TUBULAR STEEL Ø (IN) 5.00 (LB / FT) 14.60	SIGN FRAME REQUIRED	REMARKS	SIGN DETAIL LOCATION SHSM	SIGN DETAIL LOCATION PROJECT SHEET #	SIGN DETAIL LOCATION STANDARD SHEET #
ENOSBURG VT-108 NB							FY-FLUORESCENT YELLOW FYG-FLUORESCENT YELLOW GREEN																				"SHSM"-STANDARD HIGHWAY SIGNS AND MARKINGS			
NB	2.704	A	W1-10L	36	36			4/29	9.00								2		31.25 X								INSTALL 238 FT NORTH OF EXISTING MODIFIED LEFT CURVE SIGN	X		
		A	W13-1P	18	18			4/29	2.25																			X		
NB	2.763	A	W1-6	48	24		<=== LEFT LARGE ARROW	4/29						1		X														
		A	W1-6L	48	24			4/29	8.00								2		29.00 X									X		
NB	2.785	B	W1-6	48	24		RIGHT ===> LARGE ARROW	4/29						1		X														
		B	VD-700	6	10		MILE MARKER	4/29				1	1	1													SALVAGE AND MOUNT ON NEW POST BELOW LARGE RIGHT ARROW			
		B	W1-6R	48	24			4/29	8.00								2		26.75 X									X		
NB	2.797	C	VR-017	24	30		LLL 24,000 LBS	4/28						1		X														
		C	VR-017	24	30			4/28	5.00								1		14.00 X								HOWRIGAN RD (TH-20)		9	
NB	2.802	D	R1-1	30	30		STOP	4/28						1		X														
		C/D	D3-1	UNK.	UNK.		W ENOSBURGH RD VT 108S	5/2						1																
		A/B	D3-1	UNK.	UNK.		HOWRIGAN RD	5/2						1																
		C	VD-700	6	10		MILE MARKER	4/28				1	1	1													SALVAGE AND MOUNT ON NEW POST BELOW STOP SIGN			
		D	R1-1	30	30			4/28	6.25								1		14.50 X								HOWRIGAN RD (TH-20)	X		
NB	2.802	A/B	D3-1	52	12			5/2	4.33								2		31.00 X								HOWRIGAN RD (TH-20)		14	
SIGN SUMMARY SHEET							SHEET TOTALS		42.83	0.00	0	2	2	8	0	0	10		~~150.0~~ 146.50		0	0.0	0.0	0.0	0.0					
									SF	SF	EA	EA	EA	EA	EA	EA	EA		FT		EA	LB	LB	LB	LB					
VERMONT AGENCY OF TRANSPORTATION							TOWN DIRECTIONAL TOTALS		198.6	0.0	2	5	5	42	0	0	38		570.0		0	0.0								

PROJECT NAME: **STOWE - BERKSHIRE**
PROJECT NUMBER: **STPG SIGN (49)**
FILE NAME: **07 ENOSBURG VT-108 NB TSS** PLOT DATE: **4/15/2015**
PROJECT MANAGER: **D. BRYANT** DRAWN BY: **J. BLANCHARD**
DESIGNED BY: **J. BLANCHARD** CHECKED **K. KERN**
ENOSBURG NB SHEET 4 SHEET **103** OF **131**

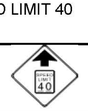DIRECTION	MILEPOINT	LOCATION CODE (SHEET 2)	SIGN CODE	WIDTH (IN)	HEIGHT (IN)	SHEETING REMARKS	SIGN LEGEND	NEW SIGNS "A"	NEW SIGNS "B"	EXISTING SIGNS RETAIN	EXISTING SIGNS SALVAGE FROM	EXISTING SIGNS SALVAGE TO	EXISTING SIGNS REMOVE	EXIST POST RETAIN	EXIST POST REMOVE	NUMBER OF NEW POSTS	SQUARE STEEL (IN) 1.75 (LB/FT) 1.88	SQUARE STEEL (IN) 2.00 (LB/FT) 2.42	SQUARE STEEL (IN) 2.50 (LB/FT) 3.35	TUBULAR STEEL Ø (IN) FOUNDATION	TUBULAR STEEL Ø (IN) 3.00 (LB/FT) 7.60	TUBULAR STEEL Ø (IN) 3.50 (LB/FT) 9.00	TUBULAR STEEL Ø (IN) 4.00 (LB/FT) 10.80	TUBULAR STEEL Ø (IN) 5.00 (LB/FT) 14.60	SIGN FRAME REQUIRED	REMARKS	SIGN DETAIL LOCATION SHSM	SIGN DETAIL LOCATION PROJECT SHEET #	SIGN DETAIL LOCATION STANDARD SHEET #
ENOSBURG VT-108 NB							FY-FLUORESCENT YELLOW FYG-FLUORESCENT YELLOW GREEN																				"SHSM"-STANDARD HIGHWAY SIGNS AND MARKINGS			
NB	3.542	A	S3-1	30	30		SCHOOL BUS STOP AHEAD 4/29						1		X														
		A	S3-1	36	36	FYG	 4/29	9.00								2		26.25 X								REQUIRES VEGETATION CLEARING	X		
NB	3.817	A	VW-054L	30	30		HIDDEN DRIVE LEFT 4/29						1		X														
		A	S3-1	30	30		SCHOOL BUS STOP AHEAD 4/29						1																
		A	VW-133L	30	30		 4/29	6.25								1		14.75 X										10	
NB	4.016	A	W3-5	36	36		SPEED REDUCTION SPEED LIMIT 40 5/2						1		X														
NB	4.056	A	W3-5	36	36		TRIM  5/2	9.00								2		29.25 X								INSTALL 210 FT NORTH OF EXISTING	X		
NB	4.153	A	R2-1	24	30		SPEED LIMIT 40 5/2						1		X														
		A	VD-700	6	10		MILE MARKER 5/2				1	1	1														SALVAGE AND MOUNT ON NEW POST BELOW SPEED LIMIT SIGN			
		A	R2-1	30	36		 5/2	7.50								1		14.75 X									X		
NB	4.371	A	R2-1	24	30		SPEED LIMIT 40 4/29						1		X														
NB	4.400	A	W11-7	30	30		EQUESTRIAN SYMBOL 4/29						1		X														
		A	W11-7	30	30		 4/29	6.25								1		15.00 X									X		
NB	4.462	A	W3-5	36	36		SPEED REDUCTION SPEED LIMIT 25 5/2						1		X														
		A	W3-5	36	36		 5/2	9.00								2		28.50 X									X		
SIGN SUMMARY SHEET							SHEET TOTALS	47.00 SF	0.00 SF	0 EA	1 EA	1 EA	9 EA	0 EA	0 EA	9 EA		~~135.0~~ 128.50 FT		0 EA	0.0 LB	0.0 LB	0.0 LB	0.0 LB					
VERMONT AGENCY OF TRANSPORTATION							TOWN DIRECTIONAL TOTALS	198.6	0.0	2	5	5	42	0	0	38		570.0		0	0.0								

PROJECT NAME: **STOWE - BERKSHIRE**
PROJECT NUMBER: **STPG SIGN (49)**
FILE NAME: **07 ENOSBURG VT-108 NB TSS** PLOT DATE: **4/15/2015**
PROJECT MANAGER: **D. BRYANT** DRAWN BY: **J. BLANCHARD**
DESIGNED BY: **J. BLANCHARD** CHECKED **K. KERN**
ENOSBURG NB SHEET 5 SHEET **104** OF **131**

DIRECTION	MILEPOINT	LOCATION CODE (SHEET 2)	SIGN CODE	WIDTH (IN)	HEIGHT (IN)	SHEETING REMARKS	SIGN LEGEND	NEW SIGNS "A"	NEW SIGNS "B"	EXISTING SIGNS RETAIN	EXISTING SIGNS SALVAGE FROM	EXISTING SIGNS SALVAGE TO	EXISTING SIGNS REMOVE	EXIST POST RETAIN	EXIST POST REMOVE	NUMBER OF NEW POSTS	SQUARE STEEL (IN) 1.75 (LB / FT) 1.88	SQUARE STEEL (IN) 2.00 (LB / FT) 2.42	SQUARE STEEL (IN) 2.50 (LB / FT) 3.35	TUBULAR STEEL Ø (IN) FOUNDATION	TUBULAR STEEL Ø (IN) 3.00 (LB / FT) 7.60	TUBULAR STEEL Ø (IN) 3.50 (LB / FT) 9.00	TUBULAR STEEL Ø (IN) 4.00 (LB / FT) 10.80	TUBULAR STEEL Ø (IN) 5.00 (LB / FT) 14.60	SIGN FRAME REQUIRED	REMARKS	SIGN DETAIL LOCATION SHSM	SIGN DETAIL LOCATION PROJECT SHEET #	SIGN DETAIL LOCATION STANDARD SHEET #
ENOSBURG VT-108 NB							FY-FLUORESCENT YELLOW FYG-FLUORESCENT YELLOW GREEN																				"SHSM"-STANDARD HIGHWAY SIGNS AND MARKINGS			
NB	4.493	A	VD-062AS	72	16		BUSINESS SIGN			1				X															
NB	4.519	A	VR-038	24	18		STATE HIGHWAY ENDS 4/29						1		X														
		A	R2-1	24	30		SPEED LIMIT 25 4/29						1																
		A	VR-038	24	18		 4/29	3.00								1			~~15.0~~ 17.75 X									9	
		A	R2-1	30	36		 4/29	7.50																			X		

SIGN SUMMARY SHEET																				
VERMONT AGENCY OF TRANSPORTATION	SHEET TOTALS	10.50	0.00	1	0	0	2	0	0	1	~~15.0~~ 17.75	0	0.0	0.0	0.0	0.0	PROJECT NAME: STOWE - BERKSHIRE PROJECT NUMBER: STPG SIGN (49)	
		SF	SF	EA	EA	EA	EA	EA	EA	EA	FT	EA	LB	LB	LB	LB		
	TOWN DIRECTIONAL TOTALS	198.6	0.0	2	5	5	42	0	0	38	570.0	0	0.0				FILE NAME: 07 ENOSBURG VT-108 NB TSS PROJECT MANAGER: D. BRYANT DESIGNED BY: J. BLANCHARD ENOSBURG NB SHEET 6	PLOT DATE: 4/15/2015 DRAWN BY: J. BLANCHARD CHECKED K. KERN SHEET 105 OF 131

DIRECTION	MILEPOINT	LOCATION CODE (SHEET 2)	SIGN CODE	WIDTH (IN)	HEIGHT (IN)	SHEETING REMARKS	SIGN LEGEND	NEW SIGNS "A"	NEW SIGNS "B"	EXISTING SIGNS RETAIN	EXISTING SIGNS SALVAGE FROM	EXISTING SIGNS SALVAGE TO	EXISTING SIGNS REMOVE	EXIST POST RETAIN	EXIST POST REMOVE	NUMBER OF NEW POSTS	SQUARE STEEL (IN) 1.75 (LB / FT) 1.88	SQUARE STEEL (IN) 2.00 (LB / FT) 2.42	SQUARE STEEL (IN) 2.50 (LB / FT) 3.35	TUBULAR STEEL Ø (IN) FOUNDATION	TUBULAR STEEL Ø (IN) 3.00 (LB / FT) 7.60	TUBULAR STEEL Ø (IN) 3.50 (LB / FT) 9.00	TUBULAR STEEL Ø (IN) 4.00 (LB / FT) 10.80	TUBULAR STEEL Ø (IN) 5.00 (LB / FT) 14.60	SIGN FRAME REQUIRED	REMARKS	SIGN DETAIL LOCATION SHSM	SIGN DETAIL LOCATION PROJECT SHEET #	SIGN DETAIL LOCATION STANDARD SHEET #
ENOSBURG VT-108 SB							FY-FLUORESCENT YELLOW FYG-FLUORESCENT YELLOW GREEN																				"SHSM"-STANDARD HIGHWAY SIGNS AND MARKINGS			
SB	4.519	F	R2-1	24	30		SPEED LIMIT 40 5/3						1		X														
		F	VR-039	24	18		STATE HIGHWAY BEGINS 5/3						1																
		F	VR-039	24	18		TRIM STATE HIGHWAY BEGINS 5/3	3.00								1		15.00 X									9	
		F	R2-1	24	30		SPEED LIMIT 40 5/3	5.00																		X		
SB	4.403	F	W7-3aP	24	18		NEXT 19 MILES 5/3						1		X														
		F	VD-700	6	10		MILE MARKER 5/3						1																
SB	4.341	F	R2-1	24	30		SPEED LIMIT 40 4/28						1		X														
SB	4.278	F	VW-054R	30	30		HIDDEN DRIVE RIGHT 4/28						1		X														
SB	4.153	F	R2-1	24	30		SPEED LIMIT 50 4/28						1		X														
		F	R2-1	24	30		SPEED LIMIT 50 4/28	5.00								1		15.00 X									INSTALL ACROSS FROM NB SPEED LIMIT 40; REQUIRES VEGETATION CLEARING	X		
SB	3.939	F	VW-054R	30	30		HIDDEN DRIVE RIGHT 4/28						1		X														
SB	2.910	F	W1-10	30	30		MODIFIED RIGHT CURVE 6/30						1		X														
		F	W13-1P	18	18		35 MPH 6/29						1																
SB	2.890	F	W1-10L	36	36		6/29	9.00								2		35.50 X								INSTALL 106 FT SOUTH OF EXISTING	X		
		F	W13-1P	18	18		35 M.P.H. 6/29	2.25																			X		
							SHEET TOTALS	24.25 SF	0.00 SF	0 EA	0 EA	0 EA	10 EA	0 EA	0 EA	4 EA		65.50 ~~60.0~~ FT		0 EA	0.0 LB	0.0 LB	0.0 LB	0.0 LB					
							TOWN DIRECTIONAL TOTALS	153.5	0.0	2	2	2	39	0	0	30		450.0		0	0.0									

SIGN SUMMARY SHEET

VERMONT AGENCY OF TRANSPORTATION

PROJECT NAME: **STOWE - BERKSHIRE**
PROJECT NUMBER: **STPG SIGN (49)**
FILE NAME: **08 ENOSBURG VT-108 SB TSS** PLOT DATE: **4/15/2015**
PROJECT MANAGER: **D. BRYANT** DRAWN BY: **J. BLANCHARD**
DESIGNED BY: **J. BLANCHARD** CHECKED **K. KERN**
ENOSBURG SB SHEET 1 SHEET **106** OF **131**

DIRECTION	MILEPOINT	LOCATION CODE (SHEET 2)	SIGN CODE	WIDTH (IN)	HEIGHT (IN)	SHEETING REMARKS	SIGN LEGEND	NEW SIGNS "A"	NEW SIGNS "B"	EXISTING SIGNS RETAIN	EXISTING SIGNS SALVAGE FROM	EXISTING SIGNS SALVAGE TO	EXISTING SIGNS REMOVE	EXIST POST RETAIN	EXIST POST REMOVE	NUMBER OF NEW POSTS	SQUARE STEEL (IN) 1.75 (LB/FT) 1.88	SQUARE STEEL (IN) 2.00 (LB/FT) 2.42	SQUARE STEEL (IN) 2.50 (LB/FT) 3.35	TUBULAR STEEL Ø (IN) FOUNDATION	TUBULAR STEEL Ø (IN) 3.00 (LB/FT) 7.60	TUBULAR STEEL Ø (IN) 3.50 (LB/FT) 9.00	TUBULAR STEEL Ø (IN) 4.00 (LB/FT) 10.80	TUBULAR STEEL Ø (IN) 5.00 (LB/FT) 14.60	SIGN FRAME REQUIRED	REMARKS	SIGN DETAIL LOCATION SHSM	SIGN DETAIL LOCATION PROJECT SHEET #	SIGN DETAIL LOCATION STANDARD SHEET #
ENOSBURG VT-108 SB							FY-FLUORESCENT YELLOW FYG-FLUORESCENT YELLOW GREEN																				"SHSM"-STANDARD HIGHWAY SIGNS AND MARKINGS			
SB	2.852	F	VD-062AS	72	16		BUSINESS SIGN 5/3			1				X															
SB	2.661	F	W3-5	36	36		SPEED REDUCTION SPEED LIMIT 40 5/3						1		X														
		F	W3-5	36	36		 5/3	9.00								2		27.50 X								X		
SB	2.607	F	W7-1	30	30		HILL SYMBOL 5/3						1		X														
		F	W7-2bP	24	18		TRUCKS USE LOWER GEAR 5/3						1																
		F	W7-1	30	30		 5/3	6.25								1		14.25 X								X		
		F	W7-2bP	24	18		5/3	3.00																			X		
SB	2.558	F	R2-1	24	30		SPEED LIMIT 40 4/28						1		X														
		F	R2-1	30	36		 4/28	7.50								1		13.50 X								X		
SB	2.509	F	W2-1	36	36		CROSSROAD 5/3						1		X														
		F	W13-1P	18	18		30 MPH 5/3						1																
		F	W2-1	30	30		TRIM  5/3	6.25								1		16.75 X								X		
		F	W13-1P	18	18		5/3	2.25																			X		
SB	2.389	F	VR-017	24	30		LLL 24000 LBS 4/28						1		X														
		F	VR-017	24	30		 4/28	5.00								1		13.50 X									TYLER BRANCH RD (TH-19)		9	
SIGN SUMMARY SHEET							SHEET TOTALS	39.25	0.00	1	0	0	7	0	0	6		85.50 ~~90.0~~		0	0.0	0.0	0.0	0.0					
								SF	SF	EA	EA	EA	EA	EA	EA	EA		FT		EA	LB	LB	LB	LB					
VERMONT AGENCY OF TRANSPORTATION							TOWN DIRECTIONAL TOTALS	153.5	0.0	2	2	2	39	0	0	30		450.0		0	0.0								

PROJECT NAME: **STOWE - BERKSHIRE**
PROJECT NUMBER: **STPG SIGN (49)**
FILE NAME: **08 ENOSBURG VT-108 SB TSS** PLOT DATE: **4/15/2015**
PROJECT MANAGER: **D. BRYANT** DRAWN BY: **J. BLANCHARD**
DESIGNED BY: **J. BLANCHARD** CHECKED **K. KERN**
ENOSBURG SB SHEET 2 SHEET **107** OF **131**

DIRECTION	MILEPOINT	LOCATION CODE (SHEET 2)	SIGN CODE	WIDTH (IN)	HEIGHT (IN)	SHEETING REMARKS	SIGN LEGEND	NEW SIGNS "A"	NEW SIGNS "B"	EXISTING SIGNS RETAIN	EXISTING SIGNS SALVAGE FROM	EXISTING SIGNS SALVAGE TO	EXISTING SIGNS REMOVE	EXIST POST RETAIN	EXIST POST REMOVE	NUMBER OF NEW POSTS	SQUARE STEEL (IN) 1.75 (LB / FT) 1.88	SQUARE STEEL (IN) 2.00 (LB / FT) 2.42	SQUARE STEEL (IN) 2.50 (LB / FT) 3.35	TUBULAR STEEL Ø (IN) FOUNDATION	TUBULAR STEEL Ø (IN) 3.00 (LB / FT) 7.60	TUBULAR STEEL Ø (IN) 3.50 (LB / FT) 9.00	TUBULAR STEEL Ø (IN) 4.00 (LB / FT) 10.80	TUBULAR STEEL Ø (IN) 5.00 (LB / FT) 14.60	SIGN FRAME REQUIRED	REMARKS	SIGN DETAIL LOCATION SHSM	SIGN DETAIL LOCATION PROJECT SHEET #	SIGN DETAIL LOCATION STANDARD SHEET #
ENOSBURG VT-108 SB							FY-FLUORESCENT YELLOW FYG-FLUORESCENT YELLOW GREEN																				"SHSM"-STANDARD HIGHWAY SIGNS AND MARKINGS			
SB	2.382	G/H	D3-1	UNK.	UNK.		W ENOSBURG RD 5/3						1		X														
		E/F	D3-1	UNK.	UNK.		TYLER BRANCH RD 5/3						1																
		H	R1-1	30	30		STOP 4/28						1																
		G	VD-700	6	10		5/3				1	1	1														SALVAGE AND MOUNT ON NEW POST BELOW STOP SIGN			
		H	R1-1	30	30		STOP 4/28	6.25								1		14.25 X								TYLER BRANCH RD (TH-19)	X		
SB	2.382	E/F	D3-1	66	12		Tyler Branch Rd 5/3	5.50								2		22.75 X								TYLER BRANCH RD (TH-19); FIELD LOCATE FOR VISIBILITY FROM VT 108		14	
SB	2.372	F	M3-3	24	14		SOUTH 4/28						1		X														
		F	M1-5A	30	24		VERMONT 108 4/28						1																
		F	M3-3	24	14	GRN/WHT	SOUTH 4/28	2.33								1		13.50 X									X		
		F	M1-5	30	24	GRN/WHT	VERMONT 108 4/28	5.00																					E-136B
SB	2.346	F	R2-1	24	30		SPEED LIMIT 40 4/28						1		X														
		F	R2-1	24	30		SPEED LIMIT 40 4/28	5.00								1		13.50 X									X		
SB	2.207	F	R2-1	24	30		SPEED LIMIT 50 4/28						~~1~~ 2		X														
		F	R2-1	24	30		SPEED LIMIT 50 4/28	5.00								1		13.50 X									X		
SB	1.618	G	VR-017	24	30		LEGAL LOAD LIMIT 24,000 POUNDS 4/28	5.00								1		14.25 X								ST. PIERRE RD (TH-29)		9	
							SHEET TOTALS	34.08	0.00	0	1	1	~~8~~ 9	0	0	7		~~105.0~~ 91.75		0	0.0	0.0	0.0	0.0				
								SF	SF	EA	EA	EA	EA	EA	EA	EA		FT		EA	LB	LB	LB	LB				
							TOWN DIRECTIONAL TOTALS	153.5	0.0	2	2	2	39	0	0	30		450.0		0	0.0							

SIGN SUMMARY SHEET

VERMONT AGENCY OF TRANSPORTATION

PROJECT NAME: **STOWE - BERKSHIRE**
PROJECT NUMBER: **STPG SIGN (49)**
FILE NAME: **08 ENOSBURG VT-108 SB TSS** PLOT DATE: **4/15/2015**
PROJECT MANAGER: **D. BRYANT** DRAWN BY: **J. BLANCHARD**
DESIGNED BY: **J. BLANCHARD** CHECKED **K. KERN**
ENOSBURG SB SHEET 3 SHEET **108** OF **131**

DIRECTION	MILEPOINT	LOCATION CODE (SHEET 2)	SIGN CODE	WIDTH (IN)	HEIGHT (IN)	SHEETING REMARKS	SIGN LEGEND		NEW SIGNS "A"	NEW SIGNS "B"	EXISTING SIGNS RETAIN	EXISTING SIGNS SALVAGE FROM	EXISTING SIGNS SALVAGE TO	EXISTING SIGNS REMOVE	EXIST POST RETAIN	EXIST POST REMOVE	NUMBER OF NEW POSTS	SQUARE STEEL (IN) 1.75 (LB / FT) 1.88	SQUARE STEEL (IN) 2.00 (LB / FT) 2.42	SQUARE STEEL (IN) 2.50 (LB / FT) 3.35	TUBULAR STEEL Ø (IN) FOUNDATION	TUBULAR STEEL Ø (IN) 3.00 (LB / FT) 7.60	TUBULAR STEEL Ø (IN) 3.50 (LB / FT) 9.00	TUBULAR STEEL Ø (IN) 4.00 (LB / FT) 10.80	TUBULAR STEEL Ø (IN) 5.00 (LB / FT) 14.60	SIGN FRAME REQUIRED	REMARKS	SIGN DETAIL LOCATION SHSM	SIGN DETAIL LOCATION PROJECT SHEET #	SIGN DETAIL LOCATION STANDARD SHEET #
ENOSBURG VT-108 SB							FY-FLUORESCENT YELLOW FYG-FLUORESCENT YELLOW GREEN																				"SHSM"-STANDARD HIGHWAY SIGNS AND MARKINGS			
SB	1.611	G/H	D3-1	UNK.	UNK.		ST. PIERRE RD	5/3						1		X														
		E/F	D3-1	UNK.	UNK.		W ENOSBURG RD	5/3						1																
		H	R1-1	30	30		STOP	4/28						1																
		G	VD-700	6	10		MILE MARKER	4/28				1	1	1													SALVAGE AND MOUNT ON NEW POST BELOW STOP SIGN			
		H	R1-1	30	30		STOP	4/28	6.25								1		15.25 X								ST. PIERRE RD (TH-29)	X		
SB	1.611	E/F	D3-1	50	12		St Pierre Rd	5/3	4.17								2		25.50 X								ST. PIERRE RD (TH-29); FIELD LOCATE FOR VISIBILITY FROM VT 108		14	
SB	1.163	F	VD-062BRN	72	16		BUSINESS SIGN	5/3			1				X															
SB	1.109	G	VR-017	24	30		LLL 24000 LBS	4/28						1		X														
		G	VR-017	24	30		LEGAL LOAD LIMIT 24,000 POUNDS	4/28	5.00								1		15.25 X								CHESTER A ARTHUR RD (TH-38)		9	
SB	1.099	G/H	D3-1	UNK.	UNK.		W ENOSBURG RD	5/3						1		X														
		E/F	D3-1	UNK.	UNK.		CHESTER A ARTHUR RD	5/3						1																
		H	R1-1	30	30		STOP	4/28						1																
		H	R1-1	30	30		STOP	4/28	6.25								1		15.00 X								CHESTER A ARTHUR RD (TH-38)	X		
SB	1.099	E/F	D3-1	72	12		Chester A Arthur Rd	5/3	6.00								2		26.00 X								CHESTER A ARTHUR RD (TH-38); FIELD LOCATE FOR VISIBILITY FROM VT 108		14	
SB	0.278	F	W11-5	30	30		FARM MACHINERY SYMBOL	5/3						1		X														
SIGN SUMMARY SHEET							SHEET TOTALS		27.67	0.00	1	1	1	9	0	0	7		~~105.0~~ 97.00			0	0.0	0.0	0.0	0.0					
									SF	SF	EA	EA	EA	EA	EA	EA	EA		FT			EA	LB	LB	LB	LB					
VERMONT AGENCY OF TRANSPORTATION							TOWN DIRECTIONAL TOTALS		153.5	0.0	2	2	2	39	0	0	30		450.0			0	0.0								

PROJECT NAME: **STOWE - BERKSHIRE**
PROJECT NUMBER: **STPG SIGN (49)**
FILE NAME: **08 ENOSBURG VT-108 SB TSS** PLOT DATE: **4/15/2015**
PROJECT MANAGER: **D. BRYANT** DRAWN BY: **J. BLANCHARD**
DESIGNED BY: **J. BLANCHARD** CHECKED **K. KERN**
ENOSBURG SB SHEET 4 SHEET **109** OF **131**

DIRECTION	MILEPOINT	LOCATION CODE (SHEET 2)	SIGN CODE	WIDTH (IN)	HEIGHT (IN)	SHEETING REMARKS	SIGN LEGEND	NEW SIGNS "A"	NEW SIGNS "B"	EXISTING SIGNS RETAIN	EXISTING SIGNS SALVAGE FROM	EXISTING SIGNS SALVAGE TO	EXISTING SIGNS REMOVE	EXIST POST RETAIN	EXIST POST REMOVE	NUMBER OF NEW POSTS	SQUARE STEEL (IN) 1.75 (LB / FT) 1.88	SQUARE STEEL (IN) 2.00 (LB / FT) 2.42	SQUARE STEEL (IN) 2.50 (LB / FT) 3.35	TUBULAR STEEL Ø (IN) FOUNDATION	TUBULAR STEEL Ø (IN) 3.00 (LB / FT) 7.60	TUBULAR STEEL Ø (IN) 3.50 (LB / FT) 9.00	TUBULAR STEEL Ø (IN) 4.00 (LB / FT) 10.80	TUBULAR STEEL Ø (IN) 5.00 (LB / FT) 14.60	SIGN FRAME REQUIRED	REMARKS	SIGN DETAIL LOCATION SHSM	SIGN DETAIL LOCATION PROJECT SHEET #	SIGN DETAIL LOCATION STANDARD SHEET #
ENOSBURG VT-108 SB							FY-FLUORESCENT YELLOW FYG-FLUORESCENT YELLOW GREEN																			"SHSM"-STANDARD HIGHWAY SIGNS AND MARKINGS			
		F	W11-5	30	30		 5/3	6.25								1		13.25 X									X		
SB	0.236	F	W11-4	30	30		CATTLE SYMBOL 4/28						1		X														
		F	W11-4	30	30		 4/28	6.25								1		13.75 X									X		
SB	0.186	G	VR-017	24	30		 4/28	5.00								1		14.00 X									BORDOVILLE RD (TH-39)		9	
SB	0.175	H	R1-1	30	30		 4/28	6.25								1		13.50 X									BORDOVILLE RD (TH-39); INSTALL WEST OF STREET NAME SIGNS	X		
SB	0.175	G/H	D3-1	UNK.	UNK.		W BERKSHIRE RD 5/3						1		X														
		E/F	D3-1	UNK.	UNK.		BORDOVILLE RD 5/3						1																
		H	R1-1	30	30		STOP 4/28						1																
		E/F	D3-1	54	12		 5/3	4.50								2		23.00 X									BORDOVILLE RD (TH-39); FIELD LOCATE FOR VISIBILITY FROM VT 108		14	
SB	0.000	G	VD-024	60	7.5		BAKERSFIELD/ENOSBURG						~~1~~ 0		X														

SIGN SUMMARY SHEET	SHEET TOTALS	28.25	0.00	0	0	0	~~4~~ 5	0	0	6		~~77.50~~ 90.0		0	0.0	0.0	0.0	0.0											
		SF	SF	EA	EA	EA	EA	EA	EA	EA		FT		EA	LB	LB	LB	LB											
VERMONT AGENCY OF TRANSPORTATION	TOWN DIRECTIONAL TOTALS	153.5	0.0	2	2	2	39	0	0	30		450.0		0	0.0														

PROJECT NAME: **STOWE - BERKSHIRE**
PROJECT NUMBER: **STPG SIGN (49)**
FILE NAME: **08 ENOSBURG VT-108 SB TSS** PLOT DATE: **4/15/2015**
PROJECT MANAGER: **D. BRYANT** DRAWN BY: **J. BLANCHARD**
DESIGNED BY: **J. BLANCHARD** CHECKED **K. KERN**
ENOSBURG SB SHEET 5 SHEET **110** OF **131**

DIRECTION	MILEPOINT	LOCATION CODE (SHEET 2)	SIGN CODE	WIDTH (IN)	HEIGHT (IN)	SHEETING REMARKS	SIGN LEGEND	NEW SIGNS		EXISTING SIGNS				EXIST POST		NUMBER OF NEW POSTS	SQUARE STEEL (IN)			TUBULAR STEEL Ø (IN)				SIGN FRAME REQUIRED	REMARKS	SIGN DETAIL LOCATION		
								"A"	"B"	RETAIN	SALVAGE FROM	SALVAGE TO	REMOVE	RETAIN	REMOVE		1.75	2.00	2.50	FOUNDATION	3.00	3.50	4.00	5.00			SHSM	PROJECT SHEET #	STANDARD SHEET #
																	(LB / FT)				(LB / FT)								
																	1.88	2.42	3.35		7.60	9.00	10.80	14.60					
BERKSHIRE VT-108 NB							FY-FLUORESCENT YELLOW FYG-FLUORESCENT YELLOW GREEN																			"SHSM"-STANDARD HIGHWAY SIGNS AND MARKINGS			
NB	0.000	C	VD-024	60	7.5		BERKSHIRE/ENOSBURG TRIM 6/28			1				X														
		A	VR-039	24	18		STATE HIGHWAY BEGINS 4/26				1		1													SALVAGE AND MOUNT TO NEW POST IN SAME LOCATION			
		A	R2-1	24	30		SPEED LIMIT 50 4/26				1		1													SALVAGE AND MOUNT TO NEW POST IN SAME LOCATION			
		C	VD-700	6	10		MILE MARKER 4/26			1																		
		C	VD-700	6	10		MILE MARKER 4/26			1																		
NB	0.000	A	VR-039	24	18		STATE HIGHWAY BEGINS 4/26					1				1		14.50 X								SALVAGE FROM EXISTING LOCATION			
		A	R2-1	24	30		SPEED LIMIT 50 4/26					1														SALVAGE FROM EXISTING LOCATION			
NB	0.201	A	M3-1	24	12		NORTH STATE 4/26						1		X														
		A	M1-5	30	24		VERMONT 108 4/26						1																
		A	M3-1	24	12	GRN/ WHT	 TRIM 4/26	2.00								1		14.25 X								X		
		A	M1-5	30	24	GRN/ WHT	4/26	5.00																				E-136B
NB	0.465	A	W1-10	30	30		MODIFIED RIGHT CURVE 4/26						1		X														
		A	W13-1P	18	18		35 MPH 4/26						1																
NB	0.520	A	W1-2R	30	30		 TRIM 6/28 4/26	6.25								1		16.00 X								INSTALL 290 FT NORTH OF EXISTING; REQUIRES VEGETATION CLEARING	X		
		A	W13-1P	18	18		 4/26	2.25																			X		
SIGN SUMMARY SHEET							SHEET TOTALS	15.50	0.00	3	2	2	6	0	0	3		44.75 45.0		0	0.0	0.0	0.0	0.0				
								SF	SF	EA	EA	EA	EA	EA	EA	EA		FT		EA	LB	LB	LB	LB				
VERMONT AGENCY OF TRANSPORTATION							TOWN DIRECTIONAL TOTALS	332.5	0.0	5	6	5	68	0	0	57		855.0		0	0.0							

PROJECT NAME: **STOWE - BERKSHIRE**
PROJECT NUMBER: **STPG SIGN (49)**
FILE NAME: **09 BERKSHIRE VT-108 NB TSS** PLOT DATE: **6/24/2015**
PROJECT MANAGER: **D. BRYANT** DRAWN BY: **J. BLANCHARD**
DESIGNED BY: **J. BLANCHARD** CHECKED **K. KERN**
BERKSHIRE NB SHEET 1 SHEET **111** OF **131**


DIRECTION	MILEPOINT	LOCATION CODE (SHEET 2)	SIGN CODE	WIDTH (IN)	HEIGHT (IN)	SHEETING REMARKS	SIGN LEGEND	NEW SIGNS "A"	NEW SIGNS "B"	EXISTING SIGNS RETAIN	EXISTING SIGNS SALVAGE FROM	EXISTING SIGNS SALVAGE TO	EXISTING SIGNS REMOVE	EXIST POST RETAIN	EXIST POST REMOVE	NUMBER OF NEW POSTS	SQUARE STEEL (IN) 1.75 (LB/FT) 1.88	SQUARE STEEL (IN) 2.00 (LB/FT) 2.42	SQUARE STEEL (IN) 2.50 (LB/FT) 3.35	TUBULAR STEEL Ø (IN) FOUNDATION	TUBULAR STEEL Ø (IN) 3.00 (LB/FT) 7.60	TUBULAR STEEL Ø (IN) 3.50 (LB/FT) 9.00	TUBULAR STEEL Ø (IN) 4.00 (LB/FT) 10.80	TUBULAR STEEL Ø (IN) 5.00 (LB/FT) 14.60	SIGN FRAME REQUIRED	REMARKS	SIGN DETAIL LOCATION SHSM	SIGN DETAIL LOCATION PROJECT SHEET #	SIGN DETAIL LOCATION STANDARD SHEET #
BERKSHIRE VT-108 NB							FY-FLUORESCENT YELLOW FYG-FLUORESCENT YELLOW GREEN																				"SHSM"-STANDARD HIGHWAY SIGNS AND MARKINGS			
NB	0.543	A	W11-4	30	30		CATTLE SYMBOL 4/26						1		X														
NB	0.558	A	W11-4	30	30		 TRIM 6/28 4/26	6.25								1		14.75 X									INSTALL 79 FT NORTH OF EXISTING; REQUIRES VEGETATION CLEARING	X		
NB	1.123	A	W1-2R	30	30		RIGHT CURVE 4/26						1		X														
		A	W13-1P	18	18		35 MPH 4/26						1																
NB	1.183	A	W1-2R	30	30		 TRIM 4/26	6.25								1		14.75 X									INSTALL 317 FT NORTH OF EXISTING; INSTALL 10 FT SOUTH OF MAILBOX NEAR THIS LOCATION	X		
		A	W13-1P	18	18		 4/26	2.25																				X	
NB	1.927	A	S3-1	30	30		SCHOOL BUS STOP AHEAD TRIM 6/28 4/26						1		X														
		A	S3-1	36	36	FYG	 4/26	9.00								2		27.25 X									REQUIRES VEGETATION CLEARING	X		
NB	2.022	A	VW-054L	30	30		HIDDEN DRIVE LEFT 4/27						1		X														
		A	VW-133L	30	30		 TRIM 4/27	6.25								1		15.25 X											10	
NB	2.301	A	W11-4	30	30		CATTLE SYMBOL 4/27						1		X														
		A	W11-4	30	30		 4/27	6.25								1		16.00 X										X		
NB	2.462	A	W1-2L	30	30		LEFT CURVE 4/27						1		X														
		A	W1-2L	30	30		 TRIM 4/27	6.25								1		17.00 X										X		
NB	3.220	C	VR-017	24	30		 4/27	5.00								1		14.75 X									COLLINS RD (TH-25)		9	
SIGN SUMMARY SHEET							SHEET TOTALS	47.50	0.00	0	0	0	7	0	0	8		~~119.75~~ 120.0		0	0.0	0.0	0.0	0.0					
								SF	SF	EA	EA	EA	EA	EA	EA	EA		FT		EA	LB	LB	LB	LB					
VERMONT AGENCY OF TRANSPORTATION							TOWN DIRECTIONAL TOTALS	332.5	0.0	5	6	5	68	0	0	57		855.0		0	0.0								

PROJECT NAME: **STOWE - BERKSHIRE**
PROJECT NUMBER: **STPG SIGN (49)**
FILE NAME: **09 BERKSHIRE VT-108 NB TSS** PLOT DATE: **6/24/2015**
PROJECT MANAGER: **D. BRYANT** DRAWN BY: **J. BLANCHARD**
DESIGNED BY: **J. BLANCHARD** CHECKED **K. KERN**
BERKSHIRE NB SHEET 2 SHEET **112** OF **131**

DIRECTION	MILEPOINT	LOCATION CODE (SHEET 2)	SIGN CODE	WIDTH (IN)	HEIGHT (IN)	SHEETING REMARKS	SIGN LEGEND	NEW SIGNS "A"	NEW SIGNS "B"	EXISTING SIGNS RETAIN	EXISTING SIGNS SALVAGE FROM	EXISTING SIGNS SALVAGE TO	EXISTING SIGNS REMOVE	EXIST POST RETAIN	EXIST POST REMOVE	NUMBER OF NEW POSTS	SQUARE STEEL (IN) 1.75 (LB/FT) 1.88	SQUARE STEEL (IN) 2.00 (LB/FT) 2.42	SQUARE STEEL (IN) 2.50 (LB/FT) 3.35	TUBULAR STEEL Ø (IN) FOUNDATION	TUBULAR STEEL Ø (IN) 3.00 (LB/FT) 7.60	TUBULAR STEEL Ø (IN) 3.50 (LB/FT) 9.00	TUBULAR STEEL Ø (IN) 4.00 (LB/FT) 10.80	TUBULAR STEEL Ø (IN) 5.00 (LB/FT) 14.60	SIGN FRAME REQUIRED	REMARKS	SIGN DETAIL LOCATION SHSM	SIGN DETAIL LOCATION PROJECT SHEET #	SIGN DETAIL LOCATION STANDARD SHEET #
BERKSHIRE VT-108 NB							FY-FLUORESCENT YELLOW FYG-FLUORESCENT YELLOW GREEN																				"SHSM"-STANDARD HIGHWAY SIGNS AND MARKINGS			
NB	3.220	C	W14-2	30	30		NO OUTLET			1				X															
NB	3.229	C	D3-1	UNK.	UNK.		WEST BERKSHIRE RD						~~1~~ 0		X														
		B	D3-1	UNK.	UNK.		COLLINS RD						~~1~~ 0																
		C	UNK.	UNK.	UNK.		CIDERBUCK FARM				1		~~1~~ 0														SALVAGE AND RETURN TO TOWN			
		D	R1-1	30	30		STOP 4/27						1																
		C	VD-700	6	10		MILE MARKER 4/27				1	1	1														SALVAGE AND MOUNT ON NEW POST BELOW STOP SIGN			
		D	R1-1	30	30		 TRIM 4/27	6.25								1	14.75 X									COLLINS RD (TH-25)	X		
NB	3.229	A/B	D3-1	56	12		 5/3	4.67								2	26.25 X									COLLINS RD (TH-25); FIELD LOCATE FOR VISIBILITY FROM VT 108		14	
NB	4.251	A	W3-5	36	36		 5/3	9.00								2	31.50 X									INSTALL 74 FT NORTH OF MAIL BOX #5281 AT M.P. 4.237	X		
NB	4.272	A	W3-5	36	36		SPEED REDUCTION SPEED LIMIT 40 5/3						1		X														
NB	4.344	A	R2-1	24	30		SPEED LIMIT 40 TRIM 6/28 4/27						1		X														
		A	R2-1	30	36		 TRIM 4/27	7.50								1	13.25 X										X		
NB	4.439	A	VD-018	30	18		WEST BERKSHIRE CANADA BORDER 2 5/3						1		X														
NB	4.446	A	W3-5	36	36		 TRIM 5/3	9.00								2	33.00 X									INSTALL 37 FT NORTH OF EXISTING VILLAGE SIGN	X		
NB	4.493	A	VD-018	30	18		 5/3	3.75								1	15.00 X									INSTALL 250 FT NORTH OF NEW SPEED REDUCTION SIGN AT M.P. 4.446; REQUIRES VEGETAION CLEARING		6	
SIGN SUMMARY SHEET							SHEET TOTALS	40.17	0.00	1	2	1	~~5~~ 8	0	0	9	~~133.75~~ 135.0			0	0.0	0.0	0.0	0.0					
								SF	SF	EA	EA	EA	EA	EA	EA	EA	FT			EA	LB	LB	LB	LB					
VERMONT AGENCY OF TRANSPORTATION							TOWN DIRECTIONAL TOTALS	332.5	0.0	5	6	5	68	0	0	57	855.0			0	0.0								

PROJECT NAME: **STOWE - BERKSHIRE**
PROJECT NUMBER: **STPG SIGN (49)**

FILE NAME: **09 BERKSHIRE VT-108 NB TSS** PLOT DATE: **6/24/2015**
PROJECT MANAGER: **D. BRYANT** DRAWN BY: **J. BLANCHARD**
DESIGNED BY: **J. BLANCHARD** CHECKED **K. KERN**
BERKSHIRE NB SHEET 3 SHEET **113** OF **131**

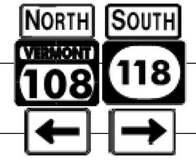DIRECTION	MILEPOINT	LOCATION CODE (SHEET 2)	SIGN CODE	WIDTH (IN)	HEIGHT (IN)	SHEETING REMARKS	SIGN LEGEND	NEW SIGNS "A"	NEW SIGNS "B"	EXISTING SIGNS RETAIN	EXISTING SIGNS SALVAGE FROM	EXISTING SIGNS SALVAGE TO	EXISTING SIGNS REMOVE	EXIST POST RETAIN	EXIST POST REMOVE	NUMBER OF NEW POSTS	SQUARE STEEL (IN) 1.75 (LB/FT) 1.88	SQUARE STEEL (IN) 2.00 (LB/FT) 2.42	SQUARE STEEL (IN) 2.50 (LB/FT) 3.35	TUBULAR STEEL Ø (IN) FOUNDATION	TUBULAR STEEL Ø (IN) 3.00 (LB/FT) 7.60	TUBULAR STEEL Ø (IN) 3.50 (LB/FT) 9.00	TUBULAR STEEL Ø (IN) 4.00 (LB/FT) 10.80	TUBULAR STEEL Ø (IN) 5.00 (LB/FT) 14.60	SIGN FRAME REQUIRED	REMARKS	SIGN DETAIL LOCATION SHSM	SIGN DETAIL LOCATION PROJECT SHEET #	SIGN DETAIL LOCATION STANDARD SHEET #
BERKSHIRE VT-108 NB							FY-FLUORESCENT YELLOW FYG-FLUORESCENT YELLOW GREEN																			"SHSM"-STANDARD HIGHWAY SIGNS AND MARKINGS			
NB	4.541	A	R2-1	30	36		 TRIM 6/28 4/27	7.50								1		14.50 X								INSTALL 250 FT NORTH OF NEW VILLAGE SIGN AT M.P. 4.493	X		
NB	4.620	A	W3-1	36	36		STOP AHEAD SYMBOL TRIM 6/28 4/27						1		X														
		A	W3-1	36	36		 TRIM 4/27	9.00								2		25.25 X								REQUIRES VEGETATION CLEARING	X		
NB	4.671	A	M2-1	21	15		JCT STATE 5/4						1		X														
		A	M1-5	30	24		VERMONT 118 5/4						1																
		A	M2-1	21	15	BLK/ WHT	 TRIM 5/4	2.19								1		13.75 X									X		
		A	M1-5	30	24	BLK/ WHT	5/4	5.00																					E-136C
NB	4.707	A	D1-1	72	12		BERKSHIRE 2 ---> 6/28						1		X														
		A	D1-1a	72	12		E. BERKSHIRE 7 ---> 6/28						1																
		A	D1-1a	72	12		<--- FRELIGHSBURG, QUE. 6/28						1																
		A	M3-1	24	12	GRN/ WHT	6/28	2.00								2		28.75 X								2C		X	
		A	M1-5	30	24	GRN/ WHT	6/28	5.00																					E-136B
		A	M6-1L	21	15	GRN/ WHT	 TRIM 6/28	2.19																			X		
		A	M3-3	24	12	BLK/ WHT	6/28	2.00																			X		
		A	M1-5	30	24	BLK/ WHT	6/28	5.00																					E-136C
SIGN SUMMARY SHEET							SHEET TOTALS	39.88 SF	0.00 SF	0 EA	0 EA	0 EA	6 EA	0 EA	0 EA	6 EA		82.25 ~~90.0~~ FT		0 EA	0.0 LB	0.0 LB	0.0 LB	0.0 LB					
VERMONT AGENCY OF TRANSPORTATION							TOWN DIRECTIONAL TOTALS	332.5	0.0	5	6	5	68	0	0	57		855.0		0	0.0							

PROJECT NAME: **STOWE - BERKSHIRE**
PROJECT NUMBER: **STPG SIGN (49)**
FILE NAME: **09 BERKSHIRE VT-108 NB TSS** PLOT DATE: **6/24/2015**
PROJECT MANAGER: **D. BRYANT** DRAWN BY: **J. BLANCHARD**
DESIGNED BY: **J. BLANCHARD** CHECKED **K. KERN**
BERKSHIRE NB SHEET 4 SHEET **114** OF **131**

DIRECTION	MILEPOINT	LOCATION CODE (SHEET 2)	SIGN CODE	WIDTH (IN)	HEIGHT (IN)	SHEETING REMARKS	SIGN LEGEND	NEW SIGNS "A"	NEW SIGNS "B"	EXISTING SIGNS RETAIN	EXISTING SIGNS SALVAGE FROM	EXISTING SIGNS SALVAGE TO	EXISTING SIGNS REMOVE	EXIST POST RETAIN	EXIST POST REMOVE	NUMBER OF NEW POSTS	SQUARE STEEL (IN) 1.75 (LB/FT) 1.88	SQUARE STEEL (IN) 2.00 (LB/FT) 2.42	SQUARE STEEL (IN) 2.50 (LB/FT) 3.35	TUBULAR STEEL Ø (IN) FOUNDATION	TUBULAR STEEL Ø (IN) 3.00 (LB/FT) 7.60	TUBULAR STEEL Ø (IN) 3.50 (LB/FT) 9.00	TUBULAR STEEL Ø (IN) 4.00 (LB/FT) 10.80	TUBULAR STEEL Ø (IN) 5.00 (LB/FT) 14.60	SIGN FRAME REQUIRED	REMARKS	SIGN DETAIL LOCATION SHSM	SIGN DETAIL LOCATION PROJECT SHEET #	SIGN DETAIL LOCATION STANDARD SHEET #
BERKSHIRE VT-108 NB							FY-FLUORESCENT YELLOW FYG-FLUORESCENT YELLOW GREEN																				"SHSM"-STANDARD HIGHWAY SIGNS AND MARKINGS			
		A	M6-1R	21	15	BLK/ WHT	6/28	2.19																			X		
NB	4.773	A	M3-1	24	12		SOUTH STATE 5/3						1		X														
		A	M1-5	30	24		VERMONT 108 5/3						1																
		A	M6-1	21	15		RIGHT DIRECTIONAL ARROW 5/3						1																
		A	M3-3	24	12		NORTH STATE 5/3						1																
		A	M6-1	21	15		LEFT DIRECTIONAL ARROW 5/3						1																
		A	M1-5A	30	24		VERMONT 108 5/3						1																
		A	VD1-1	72	12		 5/3	6.00								2			23.00 X							SLIP BASE REQUIRED - SEE SHEET 2 5/13/16		8	
		A	VD1-1a	72	12		5/3	6.00																				7	
		A	VD1-1a	72	12		5/3	6.00																				7	
NB	4.803	A	R1-1	48	48		STOP TRIM 6/28 5/3						1		X														
		A	VD-700	6	10		MILE MARKER 5/3				1	1	1														SALVAGE AND MOUNT ON NEW POST BELOW STOP SIGN			
		A	R1-1	48	48		 TRIM 5/3	16.00								2		28.75 X								X		
NB	4.806	C	VR-017	24	30		LEGAL LOAD AS FOR STATE HIGHWAYS 5/3						1		X														
		C	VR-079	24	30		 5/3	5.00								1		14.00 X								BERKSHIRE CENTER RD (TH-3)		9	
SIGN SUMMARY SHEET							SHEET TOTALS	41.19	0.00	0	1	1	9	0	0	5		65.75 ~~75.0~~		0	0.0	0.0	0.0	0.0					
								SF	SF	EA	EA	EA	EA	EA	EA	EA		FT		EA	LB	LB	LB	LB					
VERMONT AGENCY OF TRANSPORTATION							TOWN DIRECTIONAL TOTALS	332.5	0.0	5	6	5	68	0	0	57		855.0		0		0.0							

PROJECT NAME: **STOWE - BERKSHIRE**
PROJECT NUMBER: **STPG SIGN (49)**
FILE NAME: **09 BERKSHIRE VT-108 NB TSS** PLOT DATE: **7/29/2015**
PROJECT MANAGER: **D. BRYANT** DRAWN BY: **J. BLANCHARD**
DESIGNED BY: **J. BLANCHARD** CHECKED **K. KERN**
BERKSHIRE NB SHEET 5 SHEET **115** OF **131**

DIRECTION	MILEPOINT	LOCATION CODE (SHEET 2)	SIGN CODE	WIDTH (IN)	HEIGHT (IN)	SHEETING REMARKS	SIGN LEGEND	NEW SIGNS "A"	NEW SIGNS "B"	EXISTING SIGNS RETAIN	EXISTING SIGNS SALVAGE FROM	EXISTING SIGNS SALVAGE TO	EXISTING SIGNS REMOVE	EXIST POST RETAIN	EXIST POST REMOVE	NUMBER OF NEW POSTS	SQUARE STEEL (IN) 1.75 (LB/FT) 1.88	SQUARE STEEL (IN) 2.00 (LB/FT) 2.42	SQUARE STEEL (IN) 2.50 (LB/FT) 3.35	TUBULAR STEEL Ø (IN) FOUNDATION	TUBULAR STEEL Ø (IN) 3.00 (LB/FT) 7.60	TUBULAR STEEL Ø (IN) 3.50 (LB/FT) 9.00	TUBULAR STEEL Ø (IN) 4.00 (LB/FT) 10.80	TUBULAR STEEL Ø (IN) 5.00 (LB/FT) 14.60	SIGN FRAME REQUIRED	REMARKS	SIGN DETAIL LOCATION SHSM	SIGN DETAIL LOCATION PROJECT SHEET #	SIGN DETAIL LOCATION STANDARD SHEET #
BERKSHIRE VT-108 NB							FY-FLUORESCENT YELLOW FYG-FLUORESCENT YELLOW GREEN																				"SHSM"-STANDARD HIGHWAY SIGNS AND MARKINGS			
NB	4.816	A/B	D3-1	UNK.	UNK.		POTATO HILL RD 5/3						1		X														
		C/D	D3-1	72	12		Berkshire Center Rd TH3 5/3	6.00								2		23.25 X									BERKSHIRE CENTER RD (TH-3); MOUNT TO STREET NAME SIGN WITH BRACKET		14	
		A/B	D3-1	68	12		Potato Hill Rd TH11 5/3	5.67																			POTATO HILL RD(TH-11); FIELD LOCATE FOR VISIBILITY FROM VT 108		14	
NB	4.820	C	VR-017	24	30		LLL 24,000 LBS TRIM 4/27						1		X														
		C	VR-017	24	30		LEGAL LOAD LIMIT 24,000 POUNDS 4/27	5.00								1		14.25 X									POTATO HILL RD (TH-11); INSTALL NEW 80 FT CLOSER TO VT-108		9	
NB	4.825	D	R1-1	30	30		STOP 4/27						1		X														
		D	R1-1	30	30		STOP 4/27	6.25								1		13.50 X									POTATO HILL RD (TH-11)	X		
NB	4.830	A	M1-5	30	24		VERMONT 108 4/27						1		X														
		A	M3-1	24	12		NORTH STATE 4/27						1																
		A	M3-1	24	12	GRN/WHT	NORTH TRIM 4/27	2.00								1		13.50 X										X		
		A	M1-5	30	24	GRN/WHT	VERMONT 108 4/27	5.00																					E-136B
NB	4.851	A	W2-2	30	30		RIGHT SIDE ROAD 5/3						1		X														
NB	4.867	A	W2-2R	30	30		Cross Rd TRIM 5/3	6.25								1		13.00 X									INSTALL 85 FT NORTH OF EXISTING, IN LINE WITH UTILITY POLE	X		
		A	W16-8P	20	8		5/3	1.11																				6	
NB	4.898	C	VR-017	24	30		LLL 24,000 LBS 4/28						1		X														
SIGN SUMMARY SHEET							SHEET TOTALS	37.28	0.00	0	0	0	7	0	0	6		~~77.50~~ ~~90.0~~		0	0.0	0.0	0.0	0.0					
								SF	SF	EA	EA	EA	EA	EA	EA	EA		FT		EA	LB	LB	LB	LB					
VERMONT AGENCY OF TRANSPORTATION							TOWN DIRECTIONAL TOTALS	332.5	0.0	5	6	5	68	0	0	57		855.0		0	0.0								

PROJECT NAME: **STOWE - BERKSHIRE**
PROJECT NUMBER: **STPG SIGN (49)**
FILE NAME: **09 BERKSHIRE VT-108 NB TSS** PLOT DATE: **6/24/2015**
PROJECT MANAGER: **D. BRYANT** DRAWN BY: **J. BLANCHARD**
DESIGNED BY: **J. BLANCHARD** CHECKED **K. KERN**
BERKSHIRE NB SHEET 6 SHEET **116** OF **131**

DIRECTION	MILEPOINT	LOCATION CODE (SHEET 2)	SIGN CODE	WIDTH (IN)	HEIGHT (IN)	SHEETING REMARKS	SIGN LEGEND	NEW SIGNS "A"	NEW SIGNS "B"	EXISTING SIGNS RETAIN	EXISTING SIGNS SALVAGE FROM	EXISTING SIGNS SALVAGE TO	EXISTING SIGNS REMOVE	EXIST POST RETAIN	EXIST POST REMOVE	NUMBER OF NEW POSTS	SQUARE STEEL (IN) 1.75 (LB/FT) 1.88	SQUARE STEEL (IN) 2.00 (LB/FT) 2.42	SQUARE STEEL (IN) 2.50 (LB/FT) 3.35	TUBULAR STEEL Ø (IN) FOUNDATION	TUBULAR STEEL Ø (IN) 3.00 (LB/FT) 7.60	TUBULAR STEEL Ø (IN) 3.50 (LB/FT) 9.00	TUBULAR STEEL Ø (IN) 4.00 (LB/FT) 10.80	TUBULAR STEEL Ø (IN) 5.00 (LB/FT) 14.60	SIGN FRAME REQUIRED	REMARKS	SIGN DETAIL LOCATION SHSM	SIGN DETAIL LOCATION PROJECT SHEET #	SIGN DETAIL LOCATION STANDARD SHEET #
BERKSHIRE VT-108 NB							FY-FLUORESCENT YELLOW FYG-FLUORESCENT YELLOW GREEN																				"SHSM"-STANDARD HIGHWAY SIGNS AND MARKINGS			
		C	VR-017	24	30		LEGAL LOAD LIMIT 24,000 POUNDS 4/27	5.00								1		13.50 X									CROSS RD (TH-19)		9	
NB	4.906	C/D	D3-1	UNK.	UNK.		W BERKSHIRE RD 5/3						1		X														
		A/B	D3-1	UNK.	UNK.		CROSS RD TH-9 5/3						1																
		D	R1-1	30	30		STOP 4/27						1																
		D	R1-1	30	30		STOP 4/27	6.25								1		14.50 X									CROSS RD (TH-19)	X		
NB	4.906	C/D	D3-1	68	12		w Berkshire Rd VT108 5/3	5.67								2		22.50 X									CROSS RD (TH-19); MOUNT TO STREET NAME SIGN WITH BRACKET		14	
		A/B	D3-1	48	12		Cross Rd TH19 5/3	4.00																			CROSS RD (TH-19); FIELD LOCATE FOR VISIBILITY FROM VT 108		14	
NB	4.912	A	R2-1	24	30		SPEED LIMIT 40 4/27						1		X														
		A	R2-1	24	30		SPEED LIMIT 40 4/27	5.00								1		14.00 X										X		
NB	4.969	A	W1-2L	30	30		LEFT CURVE 4/27						1		X														
		A	W1-2L	30	30		4/27	6.25								1		15.50 X										X		
NB	5.099	A	R2-1	24	30		SPEED LIMIT 50 TRIM 6/28 4/27						1		X														
		A	R2-1	24	30		SPEED LIMIT 50 4/27	5.00								1		16.25 X										X		
NB	5.463	A	M2-1	21	15		JCT STATE 4/27						1		X														
		A	M1-5A	30	24		VERMONT 120 4/27						1																
SIGN SUMMARY SHEET							SHEET TOTALS	37.17	0.00	0	0	0	8	0	0	7		~~105.0~~ 96.25		0	0.0	0.0	0.0	0.0					
								SF	SF	EA	EA	EA	EA	EA	EA	EA		FT		EA	LB	LB	LB	LB					
VERMONT AGENCY OF TRANSPORTATION							TOWN DIRECTIONAL TOTALS	332.5	0.0	5	6	5	68	0	0	57		855.0		0	0.0								

PROJECT NAME: **STOWE - BERKSHIRE**
PROJECT NUMBER: **STPG SIGN (49)**
FILE NAME: **09 BERKSHIRE VT-108 NB TSS** PLOT DATE: **6/24/2015**
PROJECT MANAGER: **D. BRYANT** DRAWN BY: **J. BLANCHARD**
DESIGNED BY: **J. BLANCHARD** CHECKED **K. KERN**
BERKSHIRE NB SHEET 7 SHEET **117** OF **131**

DIRECTION	MILEPOINT	LOCATION CODE (SHEET 2)	SIGN CODE	WIDTH (IN)	HEIGHT (IN)	SHEETING REMARKS	SIGN LEGEND	NEW SIGNS "A"	NEW SIGNS "B"	EXISTING SIGNS RETAIN	EXISTING SIGNS SALVAGE FROM	EXISTING SIGNS SALVAGE TO	EXISTING SIGNS REMOVE	EXIST POST RETAIN	EXIST POST REMOVE	NUMBER OF NEW POSTS	SQUARE STEEL (IN) 1.75 (LB/FT) 1.88	SQUARE STEEL (IN) 2.00 (LB/FT) 2.42	SQUARE STEEL (IN) 2.50 (LB/FT) 3.35	TUBULAR STEEL Ø (IN) FOUNDATION	TUBULAR STEEL Ø (IN) 3.00 (LB/FT) 7.60	TUBULAR STEEL Ø (IN) 3.50 (LB/FT) 9.00	TUBULAR STEEL Ø (IN) 4.00 (LB/FT) 10.80	TUBULAR STEEL Ø (IN) 5.00 (LB/FT) 14.60	SIGN FRAME REQUIRED	REMARKS	SIGN DETAIL LOCATION SHSM	SIGN DETAIL LOCATION PROJECT SHEET #	SIGN DETAIL LOCATION STANDARD SHEET #
BERKSHIRE VT-108 NB							FY-FLUORESCENT YELLOW FYG-FLUORESCENT YELLOW GREEN																			"SHSM"-STANDARD HIGHWAY SIGNS AND MARKINGS			
		A	M2-1	21	15	GRN/WHT	JCT TRIM 4/27	2.19								1		15.00 X								REQUIRES VEGETATION CLEARING	X		
		A	M1-5	30	24	GRN/WHT	VERMONT 120 4/27	5.00																					E-136B
NB	5.528	A	D1-1a	72	10		^UP QUEBEC 1 5/3						1		X														
		A	D1-1a	72	10		<--- FRANKLIN 6 5/3						1																
		A	VD1-1a	72	12		Quebec 1 5/3	6.00								2		26.25 X										7	
		A	VD1-1a	72	12		Franklin 6 5/3	6.00																				7	
NB	5.553	A	M3-3	24	12		SOUTH STATE 6/28						1		X														
		A	M1-5	30	24		VERMONT 120 6/28						1																
		A	M6-1	21	15		<-- LEFT STATE 6/28						1																
		A	M3-1	24	12		NORTH STATE 6/28						1																
		A	M1-5	30	24		VERMONT 108 6/28						1																
		A	M6-3	21	15		^UP STATE 6/28						1																
		A	M3-3	24	12	GRN/WHT	6/28	2.00								2		32.00 X								2C		X	
		A	M1-5	30	24	GRN/WHT	SOUTH VERMONT 120 NORTH VERMONT 108 6/28	5.00																					E-136B
		A	M6-1L	21	15	GRN/WHT	6/28	2.19																				X	
							SHEET TOTALS	28.38 SF	0.00 SF	0 EA	0 EA	0 EA	8 EA	0 EA	0 EA	5 EA		73.25 ~~75.0~~ FT		0 EA	0.0 LB	0.0 LB	0.0 LB	0.0 LB					
							TOWN DIRECTIONAL TOTALS	332.5	0.0	5	6	5	68	0	0	57		855.0		0	0.0										

SIGN SUMMARY SHEET

VERMONT AGENCY OF TRANSPORTATION

PROJECT NAME: **STOWE - BERKSHIRE**
PROJECT NUMBER: **STPG SIGN (49)**
FILE NAME: **09 BERKSHIRE VT-108 NB TSS** PLOT DATE: **6/24/2015**
PROJECT MANAGER: **D. BRYANT** DRAWN BY: **J. BLANCHARD**
DESIGNED BY: **J. BLANCHARD** CHECKED **K. KERN**
BERKSHIRE NB SHEET 8 SHEET **118** OF **131**

DIRECTION	MILEPOINT	LOCATION CODE (SHEET 2)	SIGN CODE	WIDTH (IN)	HEIGHT (IN)	SHEETING REMARKS	SIGN LEGEND	NEW SIGNS "A"	NEW SIGNS "B"	EXISTING SIGNS RETAIN	EXISTING SIGNS SALVAGE FROM	EXISTING SIGNS SALVAGE TO	EXISTING SIGNS REMOVE	EXIST POST RETAIN	EXIST POST REMOVE	NUMBER OF NEW POSTS	SQUARE STEEL (IN) 1.75 (LB/FT) 1.88	SQUARE STEEL (IN) 2.00 (LB/FT) 2.42	SQUARE STEEL (IN) 2.50 (LB/FT) 3.35	TUBULAR STEEL Ø (IN) FOUNDATION	TUBULAR STEEL Ø (IN) 3.00 (LB/FT) 7.60	TUBULAR STEEL Ø (IN) 3.50 (LB/FT) 9.00	TUBULAR STEEL Ø (IN) 4.00 (LB/FT) 10.80	TUBULAR STEEL Ø (IN) 5.00 (LB/FT) 14.60	SIGN FRAME REQUIRED	REMARKS	SIGN DETAIL LOCATION SHSM	SIGN DETAIL LOCATION PROJECT SHEET #	SIGN DETAIL LOCATION STANDARD SHEET #
BERKSHIRE VT-108 NB							FY-FLUORESCENT YELLOW FYG-FLUORESCENT YELLOW GREEN																			"SHSM"-STANDARD HIGHWAY SIGNS AND MARKINGS			
		A	M3-1	24	12	GRN/WHT	6/28	2.00																			X		
		A	M1-5	30	24	GRN/WHT	6/28	5.00																					E-136B
		A	M6-3	21	15	GRN/WHT	6/28	2.19																			X		
NB	5.615	A	M3-1	24	12	GRN/WHT	NORTH VERMONT 108 TRIM 6/28 4/28	2.00								1		14.25 X									INSTALL 90 FT SOUTH OF UTILITY POLE 38 F-18-1	X		
		A	M1-5	30	24	GRN/WHT	4/28	5.00																					E-136B
NB	5.639	A	VW-290	36	36		SALT REDUCTION AREA 5/3						1		X														
		A	W7-3aP	24	18		NEXT 2 MILES 5/3						1																
NB	5.676	A	D2-1	72	12		CANADA 1 5/3						1		X														
		A	VD2-1	72	12		Canada 1 5/3	6.00								2		23.75 X										8	
NB	5.708	A	R2-1	24	30		SPEED LIMIT 50 TRIM 6/28 4/28						1		X														
		A	R2-1	24	30		SPEED LIMIT 50 4/28	5.00								1		15.75 X										X		
NB	6.124	C	VM-607	24	30		*10TH MTN DIV WW II MEMORIAL HIGHWAY 4/28			1				X															
NB	6.538	A	W11-4	30	30		CATTLE SYMBOL TRIM 6/28 4/28						1		X														
		A	W11-4	30	30		4/28	6.25								1		14.75 X										X		
NB	6.791	A	W3-1	30	30		STOP AHEAD SYMBOL TRIM 6/28 4/28						1		X														
SIGN SUMMARY SHEET							SHEET TOTALS	33.44	0.00	1	0	0	6	0	0	5		68.50 ~~75.0~~		0	0.0	0.0	0.0	0.0					
								SF	SF	EA	EA	EA	EA	EA	EA	EA		FT		EA	LB	LB	LB	LB					
VERMONT AGENCY OF TRANSPORTATION							TOWN DIRECTIONAL TOTALS	332.5	0.0	5	6	5	68	0	0	57		855.0		0	0.0								

PROJECT NAME: **STOWE - BERKSHIRE**
PROJECT NUMBER: **STPG SIGN (49)**
FILE NAME: **09 BERKSHIRE VT-108 NB TSS** PLOT DATE: **6/24/2015**
PROJECT MANAGER: **D. BRYANT** DRAWN BY: **J. BLANCHARD**
DESIGNED BY: **J. BLANCHARD** CHECKED **K. KERN**
BERKSHIRE NB SHEET 9 SHEET **119** OF **131**

DIRECTION	MILEPOINT	LOCATION CODE (SHEET 2)	SIGN CODE	WIDTH (IN)	HEIGHT (IN)	SHEETING REMARKS	SIGN LEGEND	NEW SIGNS "A"	NEW SIGNS "B"	EXISTING SIGNS RETAIN	EXISTING SIGNS SALVAGE FROM	EXISTING SIGNS SALVAGE TO	EXISTING SIGNS REMOVE	EXIST POST RETAIN	EXIST POST REMOVE	NUMBER OF NEW POSTS	SQUARE STEEL (IN) 1.75 (LB/FT) 1.88	SQUARE STEEL (IN) 2.00 (LB/FT) 2.42	SQUARE STEEL (IN) 2.50 (LB/FT) 3.35	TUBULAR STEEL Ø (IN) FOUNDATION	TUBULAR STEEL Ø (IN) 3.00 (LB/FT) 7.60	TUBULAR STEEL Ø (IN) 3.50 (LB/FT) 9.00	TUBULAR STEEL Ø (IN) 4.00 (LB/FT) 10.80	TUBULAR STEEL Ø (IN) 5.00 (LB/FT) 14.60	SIGN FRAME REQUIRED	REMARKS	SIGN DETAIL LOCATION SHSM	SIGN DETAIL LOCATION PROJECT SHEET #	SIGN DETAIL LOCATION STANDARD SHEET #
BERKSHIRE VT-108 NB							FY-FLUORESCENT YELLOW FYG-FLUORESCENT YELLOW GREEN																				"SHSM"-STANDARD HIGHWAY SIGNS AND MARKINGS			
		A	W3-1	36	36		 TRIM 6/28 4/28	9.00								2		29.00 X									X		
NB	6.818	B	VR-039	24	18		STATE HIGHWAY BEGINS 4/28						1		X														
		A	VR-040	24	24		THROUGH WAY ENDS HERE 4/28						1																
		A	VD-700	6	10		MILE MARKER 4/28				1	1	1														SALVAGE AND MOUNT ON NEW POST BELOW STATE HIGHWAY ENDS SIGN			
		A	VR-038	24	18		 TRIM 6/28 4/28	3.00								1		12.00 X									REQUIRES VEGETATION CLEARING		9	

DIRECTION	MILEPOINT	LOCATION CODE (SHEET 2)	SIGN CODE	WIDTH (IN)	HEIGHT (IN)	SHEETING REMARKS	SIGN LEGEND	NEW SIGNS "A"	NEW SIGNS "B"	EXISTING SIGNS RETAIN	EXISTING SIGNS SALVAGE FROM	EXISTING SIGNS SALVAGE TO	EXISTING SIGNS REMOVE	EXIST POST RETAIN	EXIST POST REMOVE	NUMBER OF NEW POSTS	SQUARE STEEL (IN) 1.75 (LB / FT) 1.88	SQUARE STEEL (IN) 2.00 (LB / FT) 2.42	SQUARE STEEL (IN) 2.50 (LB / FT) 3.35	TUBULAR STEEL Ø (IN) FOUNDATION	TUBULAR STEEL Ø (IN) 3.00 (LB / FT) 7.60	TUBULAR STEEL Ø (IN) 3.50 (LB / FT) 9.00	TUBULAR STEEL Ø (IN) 4.00 (LB / FT) 10.80	TUBULAR STEEL Ø (IN) 5.00 (LB / FT) 14.60	SIGN FRAME REQUIRED	REMARKS	SIGN DETAIL LOCATION SHSM	SIGN DETAIL LOCATION PROJECT SHEET #	SIGN DETAIL LOCATION STANDARD SHEET #
BERKSHIRE VT-108 SB							FY-FLUORESCENT YELLOW FYG-FLUORESCENT YELLOW GREEN																				"SHSM"-STANDARD HIGHWAY SIGNS AND MARKINGS			
SB	6.818	E	VR-038	24	18		STATE HIGHWAY ENDS 4/25						1		X														
		F	VR-041	24	24		THROUGH WAY BEGINS HERE 4/25						1																
		F	M3-3	24	12		SOUTH 4/25						1																
		F	VM1-5A	24	24		ROUTE 108 4/25						1																
		F	VR-039	24	18		 5/3	3.00									1		13.50 X								9	
SB	6.780	F	M3-3	24	12	GRN/ WHT	 TRIM 4/25	2.00								1		14.00 X								INSTALL 200 FT SOUTH OF EXISTING ROUTE MARKER ASSEMBLY	X		
		F	M1-5	30	24	GRN/ WHT	4/25	5.00																				E-136B
SB	6.740	F	VD-421A	60	48		WELCOME TO VERMONT THE GREEN MOUNTAIN STATE 5/3						1		X														
		F	VD-421	30	24		 TRIM 5/3	5.00									1		14.25 X								6	
SB	6.702	F	VR-114F	48	60		STATE OF VT SL VITESSE MAXIMUM 50 UNLESS OTHERWISE POSTED 5/3						1		X														
		F	W16-18P	24	12		 TRIM 5/3	2.00								1			15.75 X								X	
		F	R2-1	24	30		 5/3	5.00																				X	
		F	R2-5P	24	18		 5/3	3.00																				X	
SB	6.617	F	VR-128B	UNK.	UNK.		BUCKLE UP IT'S THE LAW/CENTURE DE SECURITE OBLIGATOIRE 5/3						1		X														
		F	VD-700	6	10		MILE MARKER 5/3				1	1	1														SALVAGE AND MOUNT ON NEW POST BELOW SEAT BELT SIGN			
SIGN SUMMARY SHEET							SHEET TOTALS	25.00	0.00	0	1	1	8	0	0	4		57.50 ~~60.0~~		0	0.0	0.0	0.0	0.0					
								SF	SF	EA	EA	EA	EA	EA	EA	EA		FT		EA	LB	LB	LB	LB					
VERMONT AGENCY OF TRANSPORTATION							TOWN DIRECTIONAL TOTALS	328.8	0.0	6	4	4	66	0	0	56		840.0		0	0.0								



PROJECT NAME: **STOWE - BERKSHIRE**
PROJECT NUMBER: **STPG SIGN (49)**
FILE NAME: **10 BERKSHIRE VT-108 SB TSS** PLOT DATE: **6/25/2015**
PROJECT MANAGER: **D. BRYANT** DRAWN BY: **J. BLANCHARD**
DESIGNED BY: **J. BLANCHARD** CHECKED **K. KERN**
BERKSHIRE SB SHEET 1 SHEET **121** OF **131**

DIRECTION	MILEPOINT	LOCATION CODE (SHEET 2)	SIGN CODE	WIDTH (IN)	HEIGHT (IN)	SHEETING REMARKS	SIGN LEGEND		NEW SIGNS "A"	NEW SIGNS "B"	EXISTING SIGNS RETAIN	EXISTING SIGNS SALVAGE FROM	EXISTING SIGNS SALVAGE TO	EXISTING SIGNS REMOVE	EXIST POST RETAIN	EXIST POST REMOVE	NUMBER OF NEW POSTS	SQUARE STEEL (IN) 1.75 (LB/FT) 1.88	SQUARE STEEL (IN) 2.00 (LB/FT) 2.42	SQUARE STEEL (IN) 2.50 (LB/FT) 3.35	TUBULAR STEEL Ø (IN) FOUNDATION	TUBULAR STEEL Ø (IN) 3.00 (LB/FT) 7.60	TUBULAR STEEL Ø (IN) 3.50 (LB/FT) 9.00	TUBULAR STEEL Ø (IN) 4.00 (LB/FT) 10.80	TUBULAR STEEL Ø (IN) 5.00 (LB/FT) 14.60	SIGN FRAME REQUIRED	REMARKS	SIGN DETAIL LOCATION SHSM	SIGN DETAIL LOCATION PROJECT SHEET #	SIGN DETAIL LOCATION STANDARD SHEET #
BERKSHIRE VT-108 SB							FY-FLUORESCENT YELLOW FYG-FLUORESCENT YELLOW GREEN																				"SHSM"-STANDARD HIGHWAY SIGNS AND MARKINGS			
		F	VR-601	36	36		SAFETY BELTS REQUIRED	TRIM 5/3	9.00								1			14.50 X								9	
SB	6.580	F	UNK.	UNK.	UNK.		STATE LAW	5/3			1				X														
		F	UNK.	UNK.	UNK.		DRIVERS HAND-HELD ELECTRONIC DEVICES PROHIBITED	5/3			1																		
SB	6.538	F	VR-654	24	18		NO DWI SYMBOL	5/3						1		X													
		F	VR-655	24	24		STRICTLY ENFORCED	5/3						1															
		F	VR-654	24	24			TRIM 5/3	4.00					1			1		15.50 X								9	
		F	VR-655	24	18		STRICTLY ENFORCED	5/3	3.00																		9	
SB	6.492	F	UNK.	UNK.	UNK.		EMPTY POST	4/25								X											REMOVE EMPTY SIGN POST IN THIS LOCATION		
		F	W11-4	30	30			4/25	6.25								1		15.00 X									X	
SB	5.655	F	M2-1	21	15		JCT STATE	4/25						1		X													
		F	M1-5	30	24		VERMONT 120	4/25						1															
SB	5.627	F	D1-1a	72	10		^UP ENOSBURG FALLS 8	4/25						1		X													
		F	D1-1a	72	10		FRANKLIN 6 --->	4/25						1															
		F	M2-1	21	15	GRN/WHT	JCT	TRIM 4/25	2.19					2			1		15.00 X								REQUIRES VEGETATION CLEARING	X	
		F	M1-5	30	24	GRN/WHT	VERMONT 120	TRIM 4/25	5.00																				E-136B
							SHEET TOTALS		29.44 SF	0.00 SF	2 EA	0 EA	0 EA	~~9~~ 6 EA	0 EA	0 EA	4 EA		60.0 FT		0 EA	0.0 LB	0.0 LB	0.0 LB	0.0 LB					
							TOWN DIRECTIONAL TOTALS		328.8	0.0	6	4	4	66	0	0	56		840.0		0	0.0							

SIGN SUMMARY SHEET

VERMONT AGENCY OF TRANSPORTATION

PROJECT NAME: **STOWE - BERKSHIRE**
PROJECT NUMBER: **STPG SIGN (49)**
FILE NAME: **10 BERKSHIRE VT-108 SB TSS**
PROJECT MANAGER: **D. BRYANT**
DESIGNED BY: **J. BLANCHARD**
PLOT DATE: **6/25/2015**
DRAWN BY: **J. BLANCHARD**
CHECKED **K. KERN**
BERKSHIRE SB SHEET 2
SHEET **122** OF **131**

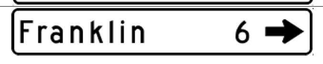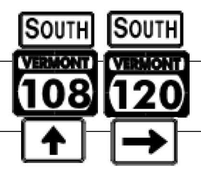DIRECTION	MILEPOINT	LOCATION CODE (SHEET 2)	SIGN CODE	WIDTH (IN)	HEIGHT (IN)	SHEETING REMARKS	SIGN LEGEND	NEW SIGNS		EXISTING SIGNS				EXIST POST		NUMBER OF NEW POSTS	SQUARE STEEL (IN)			TUBULAR STEEL Ø (IN)				SIGN FRAME REQUIRED	REMARKS	SIGN DETAIL LOCATION		
								"A"	"B"	RETAIN	SALVAGE FROM	SALVAGE TO	REMOVE	RETAIN	REMOVE		1.75 (LB / FT)	2.00 (LB / FT)	2.50 (LB / FT)	FOUNDATION	3.00 (LB / FT)	3.50 (LB / FT)	4.00 (LB / FT)	5.00 (LB / FT)			SHSM	PROJECT SHEET #	STANDARD SHEET #
																	1.88	2.42	3.35		7.60	9.00	10.80	14.60					
BERKSHIRE VT-108 SB							FY-FLUORESCENT YELLOW FYG-FLUORESCENT YELLOW GREEN																			"SHSM"-STANDARD HIGHWAY SIGNS AND MARKINGS			
SB	5.600	F	M3-3	24	12		SOUTH STATE 6/28						1		X														
		F	M1-5	30	24		VERMONT 108 6/28						1																
		F	M6-3	21	15		^UP ARROW STATE 6/28						1																
		F	M3-3	24	12		SOUTH STATE 6/28						1																
		F	M1-5	30	24		VERMONT 120 6/28						1																
		F	M6-1	21	15		RIGHT ---> STATE 6/28						1																
		F	VD-700	6	10		MILE MARKER 6/29				1	1	1													SALVAGE AND MOUNT ON NEW POST BELOW D-BOARD ASSEMBLY			
		F	VD1-1a	72	12		 6/29	6.00								2	28.00 X										7	
		F	VD1-1a	72	12		 6/29	6.00																			7	
SB	5.554	F	M3-3	24	12	GRN/ WHT	6/28	2.00								2	32.75 X								2C	INSTALL AT LEADING EDGE OF MEDIAN, AT LEAST 10 FT FROM EXISTING STOP SIGN	X		
		F	M1-5	30	24	GRN/ WHT	6/28	5.00																				E-136B
		F	M6-3	21	15	GRN/ WHT	6/28	2.19																			X		
		F	M3-3	24	12	GRN/ WHT	 TRIM 6/28	2.00																			X		
		F	M1-5	30	24	GRN/ WHT	6/28	5.00																					E-136B
		F	M6-1R	21	15	GRN/ WHT	6/28	2.19																			X		
SIGN SUMMARY SHEET							SHEET TOTALS	30.38	0.00	0	1	1	7	0	0	4	~~60.0~~ 60.75			0	0.0	0.0	0.0	0.0					
								SF	SF	EA	EA	EA	EA	EA	EA	EA	FT			EA	LB	LB	LB	LB					
VERMONT AGENCY OF TRANSPORTATION							TOWN DIRECTIONAL TOTALS	328.8	0.0	6	4	4	66	0	0	56	840.0			0	0.0								



PROJECT NAME: **STOWE - BERKSHIRE**
PROJECT NUMBER: **STPG SIGN (49)**
FILE NAME: **10 BERKSHIRE VT-108 SB TSS** PLOT DATE: **6/25/2015**
PROJECT MANAGER: **D. BRYANT** DRAWN BY: **J. BLANCHARD**
DESIGNED BY: **J. BLANCHARD** CHECKED **K. KERN**
BERKSHIRE SB SHEET 3 SHEET **123** OF **131**

DIRECTION	MILEPOINT	LOCATION CODE (SHEET 2)	SIGN CODE	WIDTH (IN)	HEIGHT (IN)	SHEETING REMARKS	SIGN LEGEND	NEW SIGNS "A"	NEW SIGNS "B"	EXISTING SIGNS RETAIN	EXISTING SIGNS SALVAGE FROM	EXISTING SIGNS SALVAGE TO	EXISTING SIGNS REMOVE	EXIST POST RETAIN	EXIST POST REMOVE	NUMBER OF NEW POSTS	SQUARE STEEL (IN) 1.75 (LB/FT) 1.88	SQUARE STEEL (IN) 2.00 (LB/FT) 2.42	SQUARE STEEL (IN) 2.50 (LB/FT) 3.35	TUBULAR STEEL Ø (IN) FOUNDATION	TUBULAR STEEL Ø (IN) 3.00 (LB/FT) 7.60	TUBULAR STEEL Ø (IN) 3.50 (LB/FT) 9.00	TUBULAR STEEL Ø (IN) 4.00 (LB/FT) 10.80	TUBULAR STEEL Ø (IN) 5.00 (LB/FT) 14.60	SIGN FRAME REQUIRED	REMARKS	SIGN DETAIL LOCATION SHSM	SIGN DETAIL LOCATION PROJECT SHEET #	SIGN DETAIL LOCATION STANDARD SHEET #
BERKSHIRE VT-108 SB							FY-FLUORESCENT YELLOW FYG-FLUORESCENT YELLOW GREEN																				"SHSM"-STANDARD HIGHWAY SIGNS AND MARKINGS			
SB	5.556	H	R1-1	30	30		STOP			1				X															
		G	VD-700	6	10		MILE MARKER			1																			
		E/F	D3-1	48	12		 5/4	4.00																		LAKE RD (VT-120); MOUNT TO STOP SIGN WITH BRACKET		14	
SB	5.500	F	M3-3	24	12		SOUTH STATE 4/25						1		X														
		F	M1-5	30	24		VERMONT 108 4/25						1																
		F	M3-3	24	12	GRN/WHT	 TRIM 4/25	2.00					2			1		15,25 X								X		
		F	M1-5	30	24	GRN/WHT		5.00																					E-136B
SB	5.461	F	D2-1	72	12		ENOSBURG FALLS 6 5/4						1		X														
		F	VD2-1	72	12		 TRIM 5/4	6.00								2		27,50 X								REQUIRES VEGETATION CLEARING		8	
SB	5.372	F	R2-1	24	30		SPEED LIMIT 50 4/25						1		X														
		F	R2-1	24	30		 4/25	5.00					1			1		15,50 X								X		
SB	5.202	F	W3-5	36	36		SPEED REDUCTION SPEED LIMIT 40 5/4						1		X														
		F	VD-700	6	10		MILE MARKER 5/4				1	1	1														SALVAGE AND MOUNT ON NEW POST BELOW SPEED REDUCTION WARNING			
		F	W3-5	36	36		 TRIM 5/4	9.00								2		25,50 X								X		
SB	5.099	F	R2-1	24	30		SPEED LIMIT 40 TRIM 6/28 4/25						1		X														
SIGN SUMMARY SHEET							SHEET TOTALS	31.00	0.00	2	1	1	~~10~~ 7	0	0	6		~~83.75~~ ~~90.0~~		0	0.0	0.0	0.0	0.0					
								SF	SF	EA	EA	EA	EA	EA	EA	EA		FT		EA	LB	LB	LB	LB					
VERMONT AGENCY OF TRANSPORTATION							TOWN DIRECTIONAL TOTALS	328.8	0.0	6	4	4	66	0	0	56		840.0		0	0.0								

PROJECT NAME: **STOWE - BERKSHIRE**
PROJECT NUMBER: **STPG SIGN (49)**
FILE NAME: **10 BERKSHIRE VT-108 SB TSS** PLOT DATE: **6/25/2015**
PROJECT MANAGER: **D. BRYANT** DRAWN BY: **J. BLANCHARD**
DESIGNED BY: **J. BLANCHARD** CHECKED **K. KERN**
BERKSHIRE SB SHEET 4 SHEET **124** OF **131**

DIRECTION	MILEPOINT	LOCATION CODE (SHEET 2)	SIGN CODE	WIDTH (IN)	HEIGHT (IN)	SHEETING REMARKS	SIGN LEGEND	NEW SIGNS "A"	NEW SIGNS "B"	EXISTING SIGNS RETAIN	EXISTING SIGNS SALVAGE FROM	EXISTING SIGNS SALVAGE TO	EXISTING SIGNS REMOVE	EXIST POST RETAIN	EXIST POST REMOVE	NUMBER OF NEW POSTS	SQUARE STEEL (IN) 1.75 (LB/FT) 1.88	SQUARE STEEL (IN) 2.00 (LB/FT) 2.42	SQUARE STEEL (IN) 2.50 (LB/FT) 3.35	TUBULAR STEEL Ø (IN) FOUNDATION	TUBULAR STEEL Ø (IN) 3.00 (LB/FT) 7.60	TUBULAR STEEL Ø (IN) 3.50 (LB/FT) 9.00	TUBULAR STEEL Ø (IN) 4.00 (LB/FT) 10.80	TUBULAR STEEL Ø (IN) 5.00 (LB/FT) 14.60	SIGN FRAME REQUIRED	REMARKS	SIGN DETAIL LOCATION SHSM	SIGN DETAIL LOCATION PROJECT SHEET #	SIGN DETAIL LOCATION STANDARD SHEET #
BERKSHIRE VT-108 SB							FY-FLUORESCENT YELLOW FYG-FLUORESCENT YELLOW GREEN																				"SHSM"-STANDARD HIGHWAY SIGNS AND MARKINGS			
		F	R2-1	30	36		SPEED LIMIT 40 4/25	7.50					I			1		15.00 X									X		
SB	5.028	F	W3-5	36	36		TRIM 6/28 5/4	9.00								2		30.50 X								INSTALL 200 FT NORTH OF VILLAGE SIGN	X		
SB	4.990	F	VD-018	30	18		WEST BERKSHIRE ENOSBURG FALLS 6 5/4						1		X														
		F	VD-018	30	18		West Berkshire Enosburg Falls 3 TRIM 6/28 5/4	3.75								1		13.75 X											6	
SB	4.962	F	M2-1	21	15		JCT STATE 5/4						1		X														
		F	M1-5	30	24		VERMONT 118 5/4						1																
		F	M2-1	21	15	BLK/WHT	JCT 118 5/4	2.19								1		15.25 X									X		
		F	M1-5	30	24	BLK/WHT	TRIM 5/4	5.00																					E-136C
SB	4.912	F	R2-1	24	30		SPEED LIMIT 35 4/25						1		X														
		F	R2-1	30	36		SPEED LIMIT 35 4/25	7.50								1		14.75 X									X		
SB	4.864	F	D1-1a	72	12		^UP BERKSHIRE 2 5/4						1		X														
		F	D1-1a	72	12		^UP EAST BERKSHIRE 7 5/4						1																	
		F	D1-1a	72	12		ENOSBURG FALLS 6 ---> TRIM 6/28 5/4						1																	
		F	VD1-1a	72	12		Berkshire 2 E. Berkshire 7 Enosburg Falls 6 5/4	6.00								2			31.50 X								SLIP BASE REQUIRED - SEE SHEET 2 8/16		7	
		F	VD1-1a	72	12		5/4	6.00																				8	
SIGN SUMMARY SHEET							SHEET TOTALS	46.94	0.00	0	0	0	~~8~~ 7	0	0	8		~~120.0~~ 120.75		0	0.0	0.0	0.0	0.0					
								SF	SF	EA	EA	EA	EA	EA	EA	EA		FT		EA	LB	LB	LB	LB					
VERMONT AGENCY OF TRANSPORTATION							TOWN DIRECTIONAL TOTALS	328.8	0.0	6	4	4	66	0	0	56		840.0		0	0.0								



PROJECT NAME: **STOWE - BERKSHIRE**
PROJECT NUMBER: **STPG SIGN (49)**
FILE NAME: **10 BERKSHIRE VT-108 SB TSS** PLOT DATE: **7/29/2015**
PROJECT MANAGER: **D. BRYANT** DRAWN BY: **J. BLANCHARD**
DESIGNED BY: **J. BLANCHARD** CHECKED **K. KERN**
BERKSHIRE SB SHEET 5 SHEET **125** OF **131**

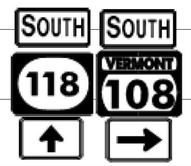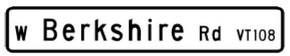DIRECTION	MILEPOINT	LOCATION CODE (SHEET 2)	SIGN CODE	WIDTH (IN)	HEIGHT (IN)	SHEETING REMARKS	SIGN LEGEND	NEW SIGNS		EXISTING SIGNS				EXIST POST		NUMBER OF NEW POSTS	SQUARE STEEL (IN)			TUBULAR STEEL Ø (IN)				SIGN FRAME REQUIRED	REMARKS	SIGN DETAIL LOCATION		
								"A"	"B"	RETAIN	SALVAGE FROM	SALVAGE TO	REMOVE	RETAIN	REMOVE		1.75 (LB / FT)	2.00 (LB / FT)	2.50 (LB / FT)	FOUNDATION	3.00 (LB / FT)	3.50 (LB / FT)	4.00 (LB / FT)	5.00 (LB / FT)			SHSM	PROJECT SHEET #	STANDARD SHEET #
																	1.88	2.42	3.35		7.60	9.00	10.80	14.60					
BERKSHIRE VT-108 SB							FY-FLUORESCENT YELLOW FYG-FLUORESCENT YELLOW GREEN																			"SHSM"-STANDARD HIGHWAY SIGNS AND MARKINGS			
		F	VD1-1a	72	12		5/4	6.00																				8	
SB	4.832	F	M3-3	24	12		SOUTH STATE 8/16						1		X														
		F	M1-5	30	24		VERMONT 118 8/16						1																
		F	M6-3	21	15		^UP ARROW STATE 8/16						1																
		F	M3-3	24	12		SOUTH STATE 8/16						1																
		F	M1-5	30	24		VERMONT 108 8/16						1																
		F	M6-1	21	15		RIGHT ---> STATE 8/16						1																
		F	M3-3	24	12	BLK/WHT	8/16	2.00								2			33.00 X	2					2C	SLIP BASE REQUIRED - SEE SHEET 2 8/16/16	X		
		F	M5-1	30	24	BLK/WHT	8/16	5.00																				E-136C
		F	M6-3	21	15	BLK/WHT	8/16	2.19																			X		
		F	M3-3	24	12	GRN/WHT	8/16	2.00																			X		
		F	M1-5	30	24	GRN/WHT	 8/16	5.00																				E-136B
		F	M6-1R	21	15	GRN/WHT	8/16	2.19																			X		
SB	4.821	C/D	D3-1	68	12		 5/4	5.67								2		23.00 X										14	
		A/B	D3-1	68	12		 5/4	5.67																				14	
SIGN SUMMARY SHEET							SHEET TOTALS	35.71	0.00	0	0	0	6	0	0	4		~~60.0~~ 56.00		~~0~~ 2	0.0	0.0	0.0	0.0				
								SF	SF	EA	EA	EA	EA	EA	EA	EA		FT		EA	LB	LB	LB	LB				
VERMONT AGENCY OF TRANSPORTATION							TOWN DIRECTIONAL TOTALS	328.8	0.0	6	4	4	66	0	0	56		840.0		0	0.0							

PROJECT NAME: **STOWE - BERKSHIRE**
PROJECT NUMBER: **STPG SIGN (49)**
FILE NAME: **10 BERKSHIRE VT-108 SB TSS** PLOT DATE: **7/29/2015**
PROJECT MANAGER: **D. BRYANT** DRAWN BY: **J. BLANCHARD**
DESIGNED BY: **J. BLANCHARD** CHECKED **K. KERN**
BERKSHIRE SB SHEET 6 SHEET **126** OF **131**

DIRECTION	MILEPOINT	LOCATION CODE (SHEET 2)	SIGN CODE	WIDTH (IN)	HEIGHT (IN)	SHEETING REMARKS	SIGN LEGEND	NEW SIGNS "A"	NEW SIGNS "B"	EXISTING SIGNS RETAIN	EXISTING SIGNS SALVAGE FROM	EXISTING SIGNS SALVAGE TO	EXISTING SIGNS REMOVE	EXIST POST RETAIN	EXIST POST REMOVE	NUMBER OF NEW POSTS	SQUARE STEEL (IN) 1.75 (LB/FT) 1.88	SQUARE STEEL (IN) 2.00 (LB/FT) 2.42	SQUARE STEEL (IN) 2.50 (LB/FT) 3.35	TUBULAR STEEL Ø (IN) FOUNDATION	TUBULAR STEEL Ø (IN) 3.00 (LB/FT) 7.60	TUBULAR STEEL Ø (IN) 3.50 (LB/FT) 9.00	TUBULAR STEEL Ø (IN) 4.00 (LB/FT) 10.80	TUBULAR STEEL Ø (IN) 5.00 (LB/FT) 14.60	SIGN FRAME REQUIRED	REMARKS	SIGN DETAIL LOCATION SHSM	SIGN DETAIL LOCATION PROJECT SHEET #	SIGN DETAIL LOCATION STANDARD SHEET #
BERKSHIRE VT-108 SB							FY-FLUORESCENT YELLOW FYG-FLUORESCENT YELLOW GREEN																				"SHSM"-STANDARD HIGHWAY SIGNS AND MARKINGS			
SB	4.737	F	R2-1	24	30		SPEED LIMIT 35 4/26						1		X														
		F	R2-1	24	30		 4/26	5.00								1		14.75 X									X		
SB	4.541	F	R2-1	24	30		SPEED LIMIT 40 TRIM 4/26						1		X														
		F	R2-1	24	30		 4/26	5.00								1		14.00 X									X		
SB	4.344	F	R2-1	24	30		SPEED LIMIT 50 4/26						1		X														
		F	R2-1	24	30		 4/26									1		13.50 X								REQUIRES VEGETATION CLEARING	X		
SB	4.142	G	VR-017	24	30		LLL 24,000 LBS 4/26						1		X														
		G	VR-017	24	30		 4/26	5.00								1		14.75 X								STANLEY HILL RD (TH-1)		9	
SB	4.135	H	R1-1	30	30		STOP 4/26						1		X														
		G	VD-700	6	10		MILE MARKER 4/26						1																
SB	4.133	H	R1-1	30	30		 TRIM 4/26	6.25								1		13.75 X								STANLEY HILL RD (TH-1); INSTALL 30 FT CLOSER TO VT 108 THAN EXISTING	X		
SB	4.132	C/D	D3-1	UNK.	UNK.		W BERKSHIRE RD 5/4						~~1~~ 2		X														
		E/F	D3-1	UNK.	UNK.		STANLEY HILL RD 5/4						~~1~~ 2																
		C/D	D3-1	68	12		 5/4	5.67								2		25.00 X								STANLEY HILL RD (TH-1); MOUNT TO STREET NAME SIGN WITH BRACKET		14	
		E/F	D3-1	72	12		 5/4	6.00																			STANLEY HILL RD (TH-1); FIELD LOCATE FOR VISIBILITY FROM VT-108		14	
SIGN SUMMARY SHEET							SHEET TOTALS	32.92	0.00	0	0	0	~~8~~ 10	0	0	7		~~105.0~~ 95.75		0	0.0	0.0	0.0	0.0					
								SF	SF	EA	EA	EA	EA	EA	EA	EA		FT		EA	LB	LB	LB	LB					
VERMONT AGENCY OF TRANSPORTATION							TOWN DIRECTIONAL TOTALS	328.8	0.0	6	4	4	66	0	0	56		840.0		0	0.0								

PROJECT NAME: **STOWE - BERKSHIRE**
PROJECT NUMBER: **STPG SIGN (49)**
FILE NAME: **10 BERKSHIRE VT-108 SB TSS** PLOT DATE: **6/25/2015**
PROJECT MANAGER: **D. BRYANT** DRAWN BY: **J. BLANCHARD**
DESIGNED BY: **J. BLANCHARD** CHECKED **K. KERN**
BERKSHIRE SB SHEET 7 SHEET **127** OF **131**

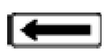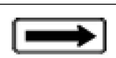DIRECTION	MILEPOINT	LOCATION CODE (SHEET 2)	SIGN CODE	WIDTH (IN)	HEIGHT (IN)	SHEETING REMARKS	SIGN LEGEND	NEW SIGNS "A"	NEW SIGNS "B"	EXISTING SIGNS RETAIN	EXISTING SIGNS SALVAGE FROM	EXISTING SIGNS SALVAGE TO	EXISTING SIGNS REMOVE	EXIST POST RETAIN	EXIST POST REMOVE	NUMBER OF NEW POSTS	SQUARE STEEL (IN) 1.75 (LB/FT) 1.88	SQUARE STEEL (IN) 2.00 (LB/FT) 2.42	SQUARE STEEL (IN) 2.50 (LB/FT) 3.35	TUBULAR STEEL Ø (IN) FOUNDATION	TUBULAR STEEL Ø (IN) 3.00 (LB/FT) 7.60	TUBULAR STEEL Ø (IN) 3.50 (LB/FT) 9.00	TUBULAR STEEL Ø (IN) 4.00 (LB/FT) 10.80	TUBULAR STEEL Ø (IN) 5.00 (LB/FT) 14.60	SIGN FRAME REQUIRED	REMARKS	SIGN DETAIL LOCATION SHSM	SIGN DETAIL LOCATION PROJECT SHEET #	SIGN DETAIL LOCATION STANDARD SHEET #
BERKSHIRE VT-108 SB							FY-FLUORESCENT YELLOW FYG-FLUORESCENT YELLOW GREEN																			"SHSM"-STANDARD HIGHWAY SIGNS AND MARKINGS			
SB	2.615	F	W1-2R	30	30		RIGHT CURVE 4/26						1		X														
SB	2.565	F	W11-4	30	30		CATTLE SYMBOL 4/26						1		X														
		F	W1-2R	30	30		 TRIM 6/28 4/26	6.25								1		16.25 X								X		
SB	2.527	F	W11-4	30	30		 4/26	6.25								1		16.00 X								INSTALL 200 FT SOUTH OF EXISTING	X		
SB	2.128	F	S3-1	30	30		SCHOOL BUS STOP AHEAD TRIM 6/28 4/26						1		X														
		F	S3-1	36	36	FYG	 TRIM 4/26	9.00								2		29.75 X								REQUIRES VEGETATION CLEARING	X		
SB	1.316	F	W1-2L	30	30		LEFT CURVE 4/26						1		X														
		F	W13-1P	18	18		35 MPH 4/26						1																
SB	1.261	F	W1-2L	30	30		 TRIM 6/28 4/26	6.25								1		15.50 X								INSTALL 290 FT SOUTH OF EXISTING; 10 FT NORTH OF UTILITY POLE R1-P68	X		
		F	W13-1P	18	18		 4/26	2.25																			X		
SB	1.227	F	W1-6	48	24		<=== LEFT LARGE ARROW TRIM 4/26						1		X														
		F	W1-6L	48	24		 4/26	8.00								2		27.00 X									X		
SB	1.222	E	W1-6	48	24		RIGHT ===> LARGE ARROW 4/26						1		X														
		E	W1-6R	48	24		 4/26	8.00								2		26.00 X									X		
SB	0.764	F	W11-4	30	30		CATTLE SYMBOL 4/26						1		X														
SIGN SUMMARY SHEET							SHEET TOTALS	46.00 SF	0.00 SF	0 EA	0 EA	0 EA	8 EA	0 EA	0 EA	9 EA		130.50 ~~135.0~~ FT		0 EA	0.0 LB	0.0 LB	0.0 LB	0.0 LB					
VERMONT AGENCY OF TRANSPORTATION							TOWN DIRECTIONAL TOTALS	328.8	0.0	6	4	4	66	0	0	56		840.0		0	0.0							

PROJECT NAME: **STOWE - BERKSHIRE**
PROJECT NUMBER: **STPG SIGN (49)**
FILE NAME: **10 BERKSHIRE VT-108 SB TSS** PLOT DATE: **6/25/2015**
PROJECT MANAGER: **D. BRYANT** DRAWN BY: **J. BLANCHARD**
DESIGNED BY: **J. BLANCHARD** CHECKED **K. KERN**
BERKSHIRE SB SHEET 8 SHEET **128** OF **131**

DIRECTION	MILEPOINT	LOCATION CODE (SHEET 2)	SIGN CODE	WIDTH (IN)	HEIGHT (IN)	SHEETING REMARKS	SIGN LEGEND		NEW SIGNS "A"	NEW SIGNS "B"	EXISTING SIGNS RETAIN	EXISTING SIGNS SALVAGE FROM	EXISTING SIGNS SALVAGE TO	EXISTING SIGNS REMOVE	EXIST POST RETAIN	EXIST POST REMOVE	NUMBER OF NEW POSTS	SQUARE STEEL (IN) 1.75 (LB/FT) 1.88	SQUARE STEEL (IN) 2.00 (LB/FT) 2.42	SQUARE STEEL (IN) 2.50 (LB/FT) 3.35	TUBULAR STEEL Ø (IN) FOUNDATION	TUBULAR STEEL Ø (IN) 3.00 (LB/FT) 7.60	TUBULAR STEEL Ø (IN) 3.50 (LB/FT) 9.00	TUBULAR STEEL Ø (IN) 4.00 (LB/FT) 10.80	TUBULAR STEEL Ø (IN) 5.00 (LB/FT) 14.60	SIGN FRAME REQUIRED	REMARKS	SIGN DETAIL LOCATION SHSM	SIGN DETAIL LOCATION PROJECT SHEET #	SIGN DETAIL LOCATION STANDARD SHEET #
BERKSHIRE VT-108 SB							FY-FLUORESCENT YELLOW FYG-FLUORESCENT YELLOW GREEN																				"SHSM"-STANDARD HIGHWAY SIGNS AND MARKINGS			
		F	W11-4	30	30			4/26	6.25								1		14.50 X									X		
SB	0.718	F	W1-10	30	30		MODIFIED LEFT CURVE	5/4						1		X													
		F	W13-1P	18	18		35 MPH	5/4						1															
		F	W2-2R	30	30			5/4	6.25								1		15.00 X									X		
SB	0.653	G	VR-017	24	30		LLL 24,000 LBS	4/26						1		X													
		G	VR-017	24	30			4/26	5.00								1		15.75 X								NOBLE RD (TH-7)		9	
SB	0.646	C/D	D3-1	UNK.	UNK.		W BERKSHIRE RD	5/4						1		X													
		A/B	D3-1	UNK.	UNK.		NOBLE RD	5/4						1															
		H	R1-1	30	30		STOP	4/26						1															
		G	VD-700	6	10		MILE MARKER	4/26				1	1	1													SALVAGE AND MOUNT ON NEW POST BELOW STOP SIGN			
		H	R1-1	30	30			4/26	6.25								1		14.75 X								NOBLE RD (TH-7)	X		
SB	0.646	C/D	D3-1	62	12			5/4	5.17								2		26.50 X								NOBLE RD (TH-7); MOUNT TO STREET SIGN WITH BRACKET		14	
		E/F	D3-1	42	12			5/4	3.50																	NOBLE RD (TH-7)		14	
SB	0.617	F	W1-2L	30	30		 TRIM 6/28	4/26	6.25								1		12.50 X								INSTALL 153 FT SOUTH OF NOBLE RD STREET NAME SIGN	X		
SB	0.124	F	W3-5	36	36		SPEED REDUCTION SPEED LIMIT 35	5/4						1		X													
SIGN SUMMARY SHEET							SHEET TOTALS		38.67	0.00	0	1	1	8	0	0	7		99.00 ~~105.0~~		0	0.0	0.0	0.0	0.0					
									SF	SF	EA	EA	EA	EA	EA	EA	EA		FT		EA	LB	LB	LB	LB					
VERMONT AGENCY OF TRANSPORTATION							TOWN DIRECTIONAL TOTALS		328.8	0.0	6	4	4	66	0	0	56		840.0		0	0.0								

PROJECT NAME: **STOWE - BERKSHIRE**
PROJECT NUMBER: **STPG SIGN (49)**
FILE NAME: **10 BERKSHIRE VT-108 SB TSS** PLOT DATE: **6/25/2015**
PROJECT MANAGER: **D. BRYANT** DRAWN BY: **J. BLANCHARD**
DESIGNED BY: **J. BLANCHARD** CHECKED **K. KERN**
BERKSHIRE SB SHEET 9 SHEET **129** OF **131**

DIRECTION	MILEPOINT	LOCATION CODE (SHEET 2)	SIGN CODE	WIDTH (IN)	HEIGHT (IN)	SHEETING REMARKS	SIGN LEGEND	NEW SIGNS "A"	NEW SIGNS "B"	EXISTING SIGNS RETAIN	EXISTING SIGNS SALVAGE FROM	EXISTING SIGNS SALVAGE TO	EXISTING SIGNS REMOVE	EXIST POST RETAIN	EXIST POST REMOVE	NUMBER OF NEW POSTS	SQUARE STEEL (IN) 1.75 (LB/FT) 1.88	SQUARE STEEL (IN) 2.00 (LB/FT) 2.42	SQUARE STEEL (IN) 2.50 (LB/FT) 3.35	TUBULAR STEEL Ø (IN) FOUNDATION	TUBULAR STEEL Ø (IN) 3.00 (LB/FT) 7.60	TUBULAR STEEL Ø (IN) 3.50 (LB/FT) 9.00	TUBULAR STEEL Ø (IN) 4.00 (LB/FT) 10.80	TUBULAR STEEL Ø (IN) 5.00 (LB/FT) 14.60	SIGN FRAME REQUIRED	REMARKS	SIGN DETAIL LOCATION SHSM	SIGN DETAIL LOCATION PROJECT SHEET #	SIGN DETAIL LOCATION STANDARD SHEET #
BERKSHIRE VT-108 SB							FY-FLUORESCENT YELLOW FYG-FLUORESCENT YELLOW GREEN																				"SHSM"-STANDARD HIGHWAY SIGNS AND MARKINGS			
SB	0.101	F	W3-5	36	36		 5/4	9.00								2		30,50 X								INSTALL 121 FT SOUTH OF EXISTING	X		
SB	0.064	F	VD-018	30	18		ENOSBURG FALLS JCT VT 105 5/4						1		X														
		F	VD-018	30	18		 5/4	3.75								1		13,00 X										6	
SB	0.000	F	VR-038	24	18		STATE HIGHWAY ENDS TRIM 5/4			1				X															
		F	R2-1	24	30		SPEED LIMIT 35 5/4			1																	REQUIRES VEGETATION CLEARING			
SIGN SUMMARY SHEET							SHEET TOTALS	12.75	0.00	2	0	0	1	0	0	3		43,50 ~~45.0~~		0	0.0	0.0	0.0	0.0					
								SF	SF	EA	EA	EA	EA	EA	EA	EA		FT		EA	LB	LB	LB	LB					
VERMONT AGENCY OF TRANSPORTATION							TOWN DIRECTIONAL TOTALS	328.8	0.0	6	4	4	66	0	0	56		840.0		0	0.0								

PROJECT NAME: **STOWE - BERKSHIRE**
PROJECT NUMBER: **STPG SIGN (49)**
FILE NAME: **10 BERKSHIRE VT-108 SB TSS** PLOT DATE: **6/25/2015**
PROJECT MANAGER: **D. BRYANT** DRAWN BY: **J. BLANCHARD**
DESIGNED BY: **J. BLANCHARD** CHECKED **K. KERN**
BERKSHIRE SB SHEET 10 SHEET **130** OF **131**

TOWN TOTAL SIGN SUMMARY SHEET

STOWE-BERKSHIRE STPG SIGN(49)

Town Name - Route	County	Town Mileage	NEW SIGNS (SF)		EXISTING SIGNS (EA)				EXIST POST (EA)		NUMBER OF NEW POSTS (EA)				SQUARE STEEL (FT) NOTE 1				TUBULAR STEEL (LB) Ø (IN)				
											1.75	2.00	2.50		1.75	2.00	2.50			3.00	3.50	4.00	5.00
											(LB / FT)				(LB / FT)					(LB / FT)			
			"A"	TRIMS "B"	RETAIN	SALVAGE FROM	SALVAGE TO	REMOVE	RETAIN	REMOVE	1.88	2.42	3.35	TOTAL POSTS	1.88	2.42	3.35	TOTAL POSTS	FOUNDATION	7.60	9.00	10.80	14.60
Stowe VT-108 NB	Lamoille	8.634	~~418.6~~ 428.11	~~0.00~~ 12	36	15	~~6~~ 8	84 ~~85~~	~~23~~	~~59~~	0	~~76~~	~~3~~	~~79~~	0	~~1140~~	~~45~~	~~1185~~ 1053.75	0	0	0	0	0
Stowe VT-108 SB	Lamoille	8.634	515.25	~~0.00~~ 11	18	11	9	108 ~~110~~	~~11~~	~~69~~	0	~~81~~	~~4~~	~~85~~	0	~~1215~~	~~60~~	~~1275~~ 1246.75	0	0	0	0	0
Cambridge VT-108 NB	Lamoille	9.005	~~611.0~~ 646.63	~~0.00~~ 29	29	~~13~~ 16	~~10~~ 13	148 ~~140~~	~~15~~	~~88~~	0	~~96~~	~~14~~	~~110~~	0	~~1440~~	~~210~~	~~1650~~ 1574.25	0	0	0	0	0
Cambridge VT-108 SB	Lamoille	9.005	~~624.4~~ 666.63	~~0.00~~ 28	23	7	7	144 ~~134~~	~~11~~	~~80~~	0	~~92~~	~~7~~	~~99~~	0	~~1380~~	~~105~~	1448.50 ~~1485~~	2	0	0	313.12 ~~324~~	0
Bakersfield VT-108 NB	Franklin	4.552	191.42	~~0.00~~ 12	6	~~4~~ 14	~~4~~ 15	48	~~5~~	~~24~~	0	~~27~~	~~3~~	~~30~~	0	~~405~~	~~45~~	426.75 ~~450~~	0	0	0	0	0
Bakersfield VT-108 SB	Franklin	4.552	~~235.0~~ 234.98	~~0.00~~ 10	6	~~11~~ 10	11	59 ~~58~~	~~4~~	~~25~~	0	~~36~~	~~7~~	~~43~~	0	~~540~~	~~105~~	595.75 ~~645~~	0	0	0	0	0
Enosburgh VT-108 NB	Franklin	4.530	~~198.6~~ 198.58	~~0.00~~ 3	2	5	5	42	~~2~~	~~24~~	0	~~37~~	~~1~~	~~38~~	0	~~555~~	~~15~~	546.75 ~~570~~	0	0	0	0	0
Enosburgh VT-108 SB	Franklin	4.530	153.5	~~0.00~~ 3	2	2	2	39	~~2~~	~~23~~	0	~~30~~	~~0~~	~~30~~	0	~~450~~	~~0~~	417.25 ~~450~~	0	0	0	0	0
Berkshire VT-108 NB	Franklin	6.905	332.51	~~0.00~~ 29	5	6	5	65 ~~68~~	~~3~~	~~37~~	0	~~55~~	~~2~~	~~57~~	0	~~825~~	~~30~~	802.75 ~~855~~	0	0	0	0	0
Berkshire VT-108 SB	Franklin	6.905	~~328.8~~ 333.81	~~0.00~~ 26	6	4	4	75 ~~66~~	~~3~~	~~37~~	0	~~50~~	~~6~~	~~56~~	0	~~750~~	~~90~~	807.50 ~~840~~	0	0	0	0	0
ESTIMATED ADDITIONAL DAMAGED SIGNS NOTE 2			~~70.0~~	0.0				~~14~~		~~13~~	0	~~13~~	~~0~~	~~13~~	0	~~195~~	~~0~~	~~195~~	0	0	0	0	0
SUBTOTAL =			~~3679.0~~ 3701.72	~~0.0~~ 163	133	~~78~~ 90	~~63~~ 79	~~804~~ 812	~~79~~	~~479~~	0	~~593~~	~~47~~	~~640~~	0	~~8895~~	~~705~~	~~9600~~ 8909.50	2	0	0	313.12 ~~324~~	0
ROUNDING =			~~11.0~~	~~0.0~~			0	~~6~~										~~20~~	0			0	
TOTAL		33.626	~~3690.0~~ 3701.72	~~0.0~~ 163	133	~~78~~ 90	~~63~~ 79	~~810~~ 812	~~79~~	~~479~~	0	~~593~~	~~47~~	~~640~~	0	~~8895~~	~~705~~	~~9620~~ 8909.50	2	0	0	324	0

NOTES:

1. FINAL POST LENGTHS ARE TO BE DETERMINED IN THE FIELD. POST SIZES ARE COMPUTED BASED ON INFORMATION ON THE STANDARD SHEETS AND THE VTRANS "SIGN POST DESIGN GUIDELINE".
2. ESTIMATED ADDITIONAL DAMAGED SIGNS TO BE REMOVED/REPLACED AND MOUNTED ON NEW POSTS (SEE GENERAL NOTE 6, SHEET 2)

TYLIN INTERNATIONAL

PROJECT NAME: STOWE-BERKSHIRE
PROJECT NUMBER: STPG SIGN(49)

FILE NAME: z13b620TownTotal.dgn
PROJECT LEADER: D. BRYANT
DESIGNED BY: J. BLANCHARD
TOWN TOTAL SIGN SUMMARY SHEET

PLOT DATE: 7/29/2015
DRAWN BY: J. BLANCHARD
CHECKED BY: K. KERN
SHEET 131 OF 131