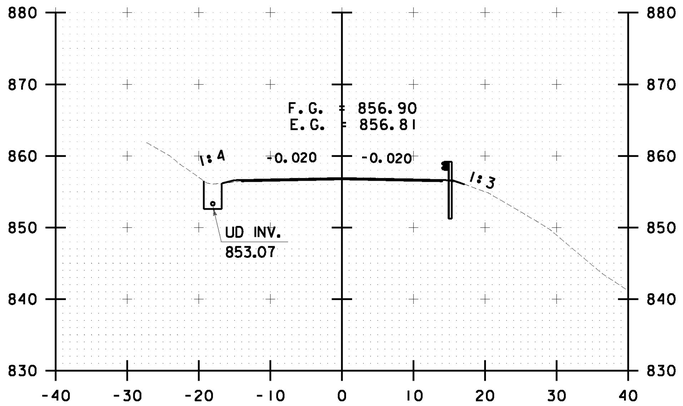

R 431+50.00

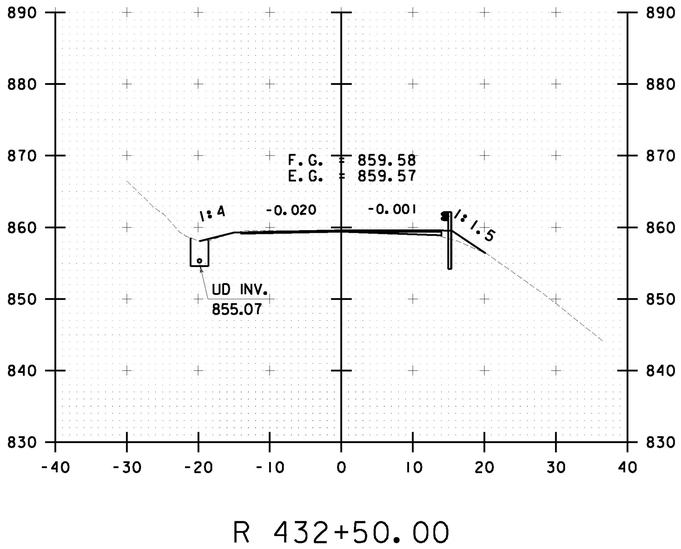

R 432+50.00

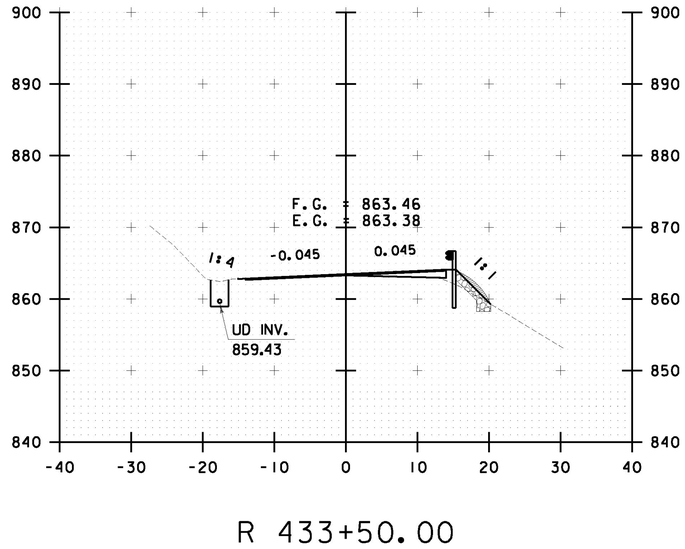

R 433+50.00

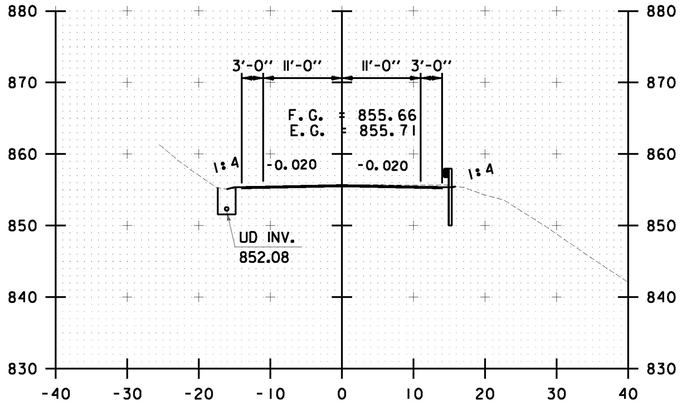

R 431+00.00

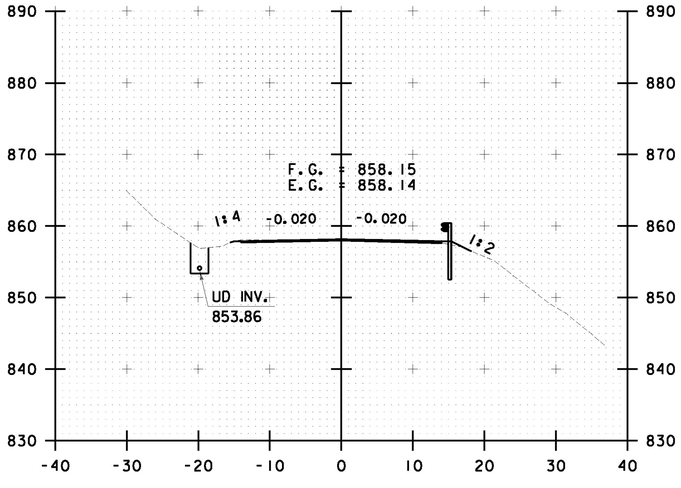

R 432+00.00

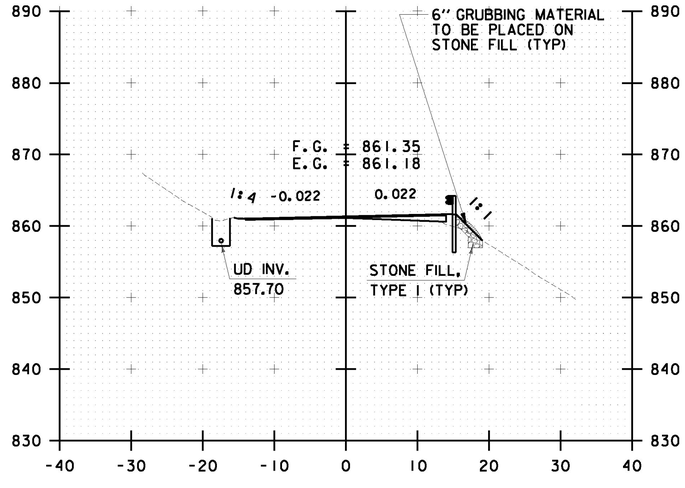

R 433+00.00

10 0 10
SCALE IN FEET

CHA

PROJECT NAME: ROCHESTER	
PROJECT NUMBER: ER STP 0162(21)	
FILE NAME: z13cl76xc.dgn	PLOT DATE: 1/12/2017
PROJECT LEADER: D. GOZALKOWSKI	DRAWN BY: J. HEALD
DESIGNED BY: J. OLSEN	CHECKED BY: J. SHIELDS
ROCHESTER CROSS SECTION SHEET #149	SHEET 338 OF 360