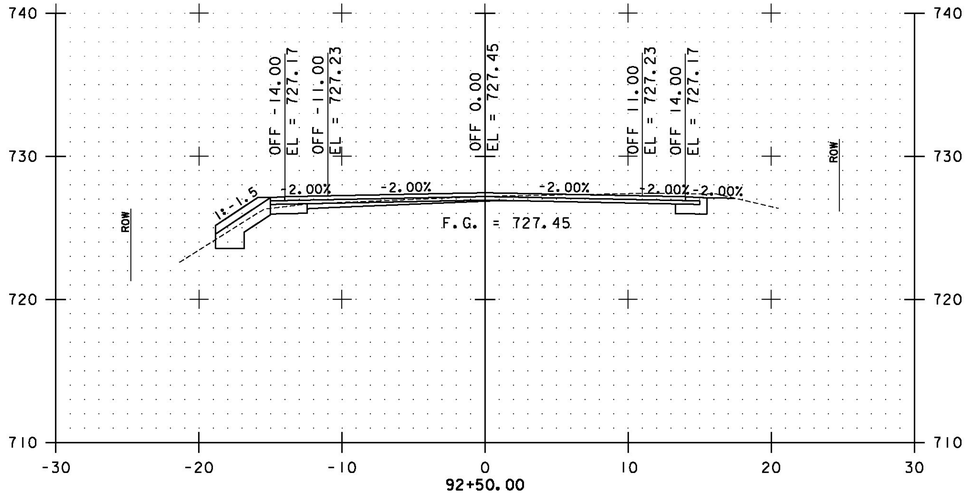


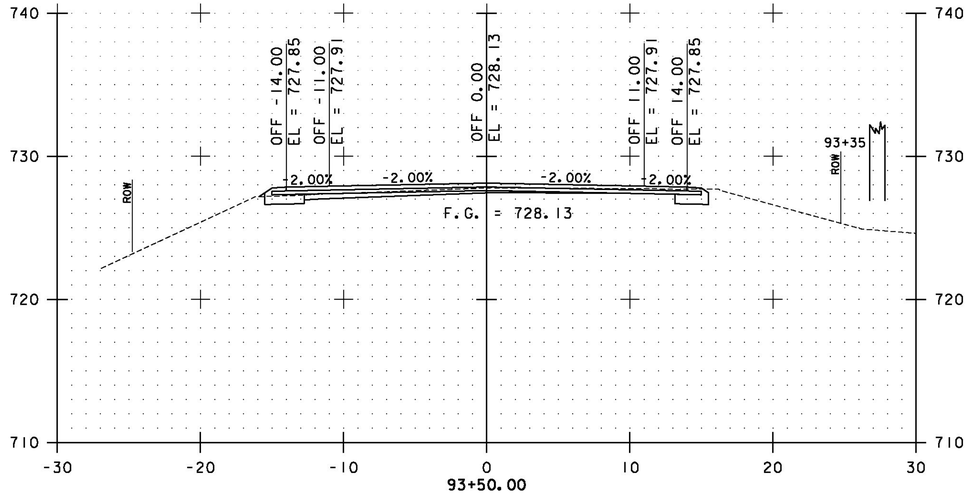


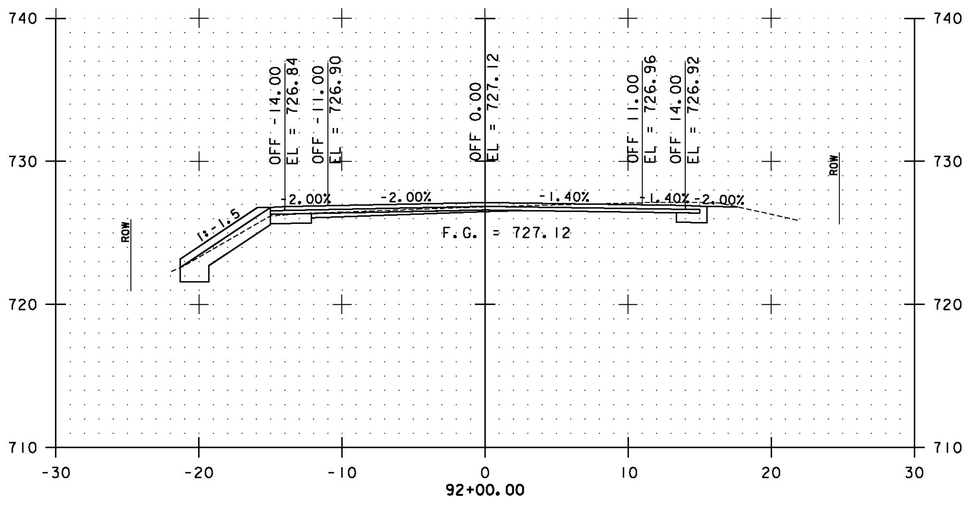


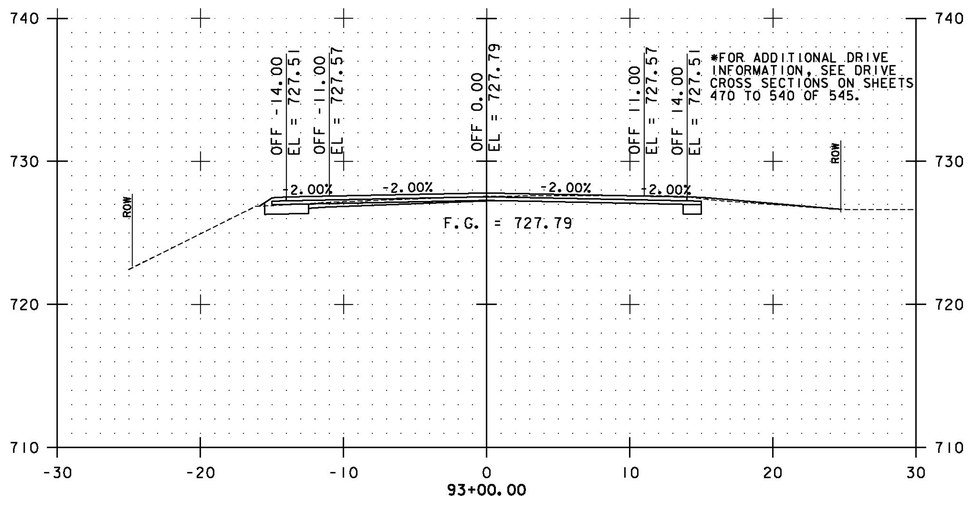


*FOR ADDITIONAL DRIVE INFORMATION, SEE DRIVE CROSS SECTIONS ON SHEETS 470 TO 540 OF 545.

STA. 92+00 TO STA. 93+50

Stantec

PROJECT NAME: RANDOLPH-ROXBURY
PROJECT NUMBER: ER STP 0187(11)

FILE NAME: z13c182xs.dgn
PROJECT LEADER: M. FOISY
DESIGNED BY: I. MAYNARD
**BRAINTREE CROSS SECTIONS SHEET 45**

PLOT DATE: 11/17/2014
DRAWN BY: G. BURGMEIER
CHECKED BY: M. FOISY
SHEET 274 OF 545