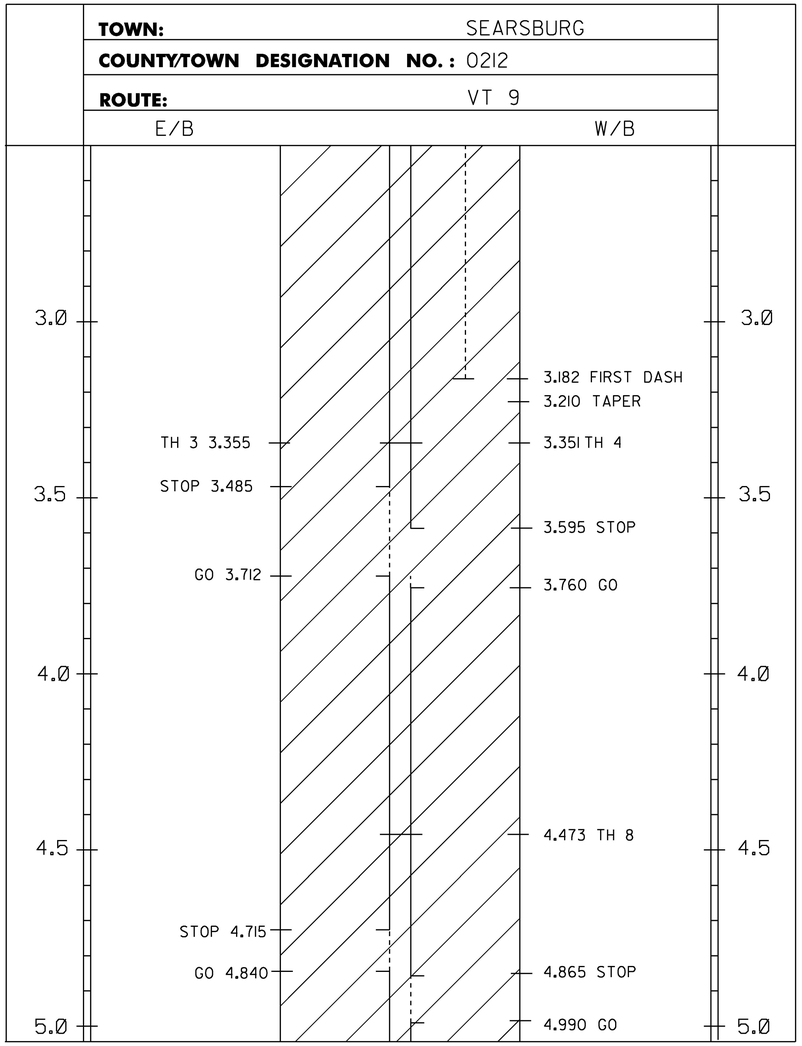

DURABLE 4 INCH WHITE LINE (OPTION BID ITEM)
(ALL LINES WILL INCLUDE EDGE LINE BREAKS AND RADIUS FOR TOWN HIGHWAYS)
MM 2.500 - MM 5.526 LT & RT
MM 2.500 - MM 3.182 DASHED LT

DURABLE 4 INCH YELLOW LINE (OPTION BID ITEM)
(ALL LINES WILL INCLUDE C/L BREAKS FOR TOWN HIGHWAYS)
MM 2.500 - MM 3.485 SOLID LT & RT
MM 3.485 - MM 3.959 DASHED RT & SOLID LT
MM 3.959 - MM 3.172 DASHED RT
MM 3.172 - MM 3.760 DASHED LT & SOLID RT
MM 3.760 - MM 4.715 SOLID LT & RT
MM 4.715 - MM 4.840 SOLID LT & DASHED RT
MM 4.840 - MM 4.865 SOLID LT & RT
MM 4.865 - MM 4.990 DASHED LT & SOLID RT
MM 4.990 - MM 5.320 SOLID LT & RT
MM 5.320 - MM 5.430 SOLID LT & DASHED RT
MM 5.430 - MM 5.520 DASHED RT
MM 5.520 - MM 5.526 DASHED LT & SOLID RT)

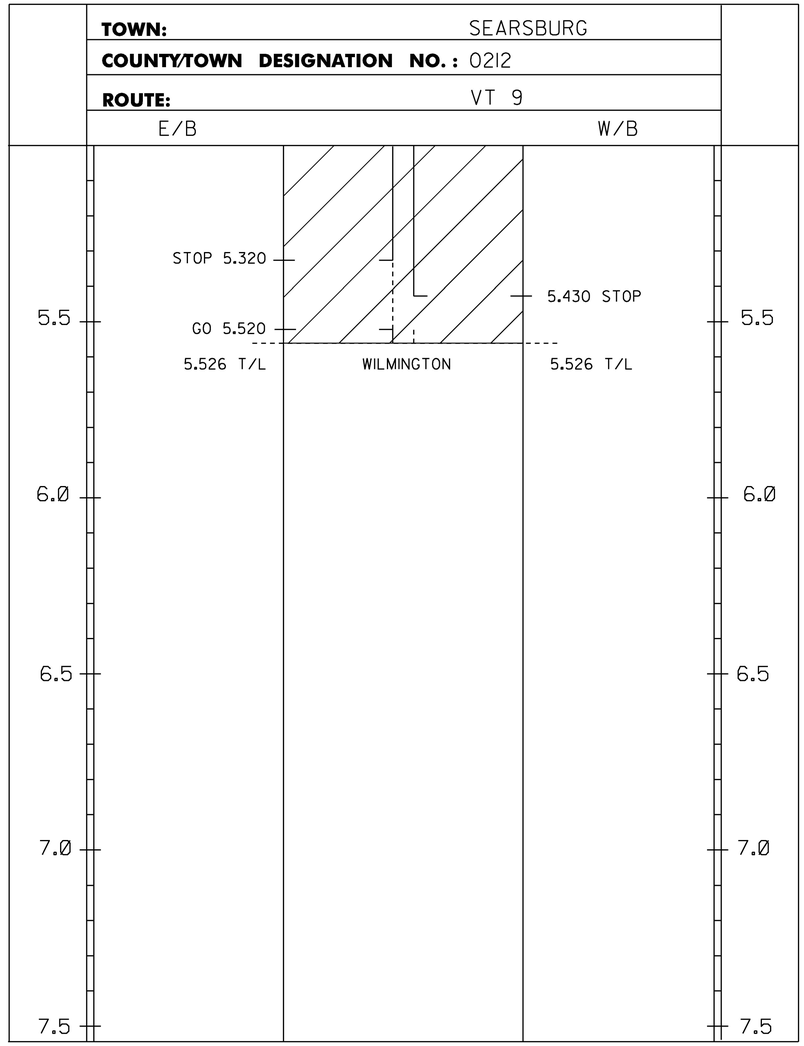

LEGEND
TWBH-THROUGHWAY BEGINS HERE
TWEH-THROUGHWAY ENDS HERE
SHB-STATE HIGHWAY BEGINS
SHE-STATE HIGHWAY ENDS
SL-SPEED LIMIT
T/L-TOWN LINE
SM-SPECIAL MARKINGS

PROJECT AREA

NOTES:
1. THIS SHEET TO BE USED FOR THE LAYOUT OF ALL CENTERLINE PAVEMENT MARKINGS. THE ENGINEER MAY CONTACT KEITH SWEET, PAVEMENT MARKING SUPERVISOR AT (802) 828-5573 FOR ASSISTANCE LAYING OUT THE CENTERLINE DURING CONSTRUCTION.

NOT TO SCALE

PROJECT NAME:	BENNINGTON-WILMINGTON
PROJECT NUMBER:	NH SURF (51)

FILE NAME: pl4v201 Bennington-Wilmington.dgn PLOT DATE: 28-MAR-2017
PROJECT LEADER: M. FOWLER DRAWN BY: N. PAPPAS
DESIGNED BY: N. PAPPAS CHECKED BY: M. FOWLER
LAYOUT SHEET 4 SHEET 23 OF 64