| DIRECTION | MILEPOINT | LOCATION CODE (SHEET 4) | SIGN CODE | WIDTH (IN) | HEIGHT (IN) | SHEETING REMARKS | SIGN LEGEND | NEW SIGNS "A" | NEW SIGNS "B" | EXISTING SIGNS RETAIN | EXISTING SIGNS SALVAGE FROM | EXISTING SIGNS SALVAGE TO | EXISTING SIGNS REMOVE | EXIST POST RETAIN | EXIST POST REMOVE | NUMBER OF NEW POSTS | SQUARE STEEL (IN) 1.75 (LB / FT) 1.88 | SQUARE STEEL (IN) 2.00 (LB / FT) 2.42 | SQUARE STEEL (IN) 2.50 (LB / FT) 3.35 | FOUNDATION | TUBULAR STEEL Ø (IN) 3.00 (LB / FT) 7.60 | TUBULAR STEEL Ø (IN) 3.50 (LB / FT) 9.00 | TUBULAR STEEL Ø (IN) 4.00 (LB / FT) 10.80 | TUBULAR STEEL Ø (IN) 5.00 (LB / FT) 14.60 | SIGN FRAME REQUIRED | REMARKS | SIGN DETAIL LOCATION SHSM | SIGN DETAIL LOCATION SIGN DETAILS SHEET # | SIGN DETAIL LOCATION STANDARD SHEET # |
|---|---|---|---|---|---|---|---|---|---|---|---|---|---|---|---|---|---|---|---|---|---|---|---|---|---|---|---|---|---|
| **WB WALLINGFORD VT RTE 140** | | | | | | | FY-FLUORESCENT YELLOW<br>FYG-FLUORESCENT YELLOW GREEN | | | | | | | | | | | | | | | | | | | "SHSM"-STANDARD HIGHWAY SIGNS AND MARKINGS BOOK | | | |
| | | G | VM5-1 | | | | VERMONT 155 | | | 1 | | | | | | | | | | | | | | | | | | | |
| | | G | M6-1L | | | | LEFT ARROW | | | 1 | | | | | | | | | | | | | | | | | | | |
| | | G | M3-2 | | | | EAST | | | 1 | | | | | | | | | | | | | | | | | | | |
| | | G | VM5-1 | | | | VERMONT 140 | | | 1 | | | | | | | | | | | | | | | | | | | |
| | | G | M6-1R | | | | RIGHT ARROW | | | 1 | | | | | | | | | | | | | | | | | | | |
| | | G | M4-5 | | | | TO | | | 1 | | | | | | | | | | | | | | | | | | | |
| | | G | VM5-1 | | | | VERMONT 103 | | | 1 | | | | | | | | | | | | | | | | | | | |
| | | G | M6-1R | | | | RIGHT ARROW | | | 1 | | | | | | | | | | | | | | | | | | | |
| WB | 6.244 | F | R2-1 | | | | SPEED LIMIT 30 | | | | | | 1 | X | | | | | | | | | | | | | | | |
| | | F | VD-701 | | | | BRIDGE / 10 / VT 140 | | | | | | 1 | | | | | | | | | | | | | | | | |
| | | F | R2-1 | 24 | 30 | | 10/31/17 | 5.00 | | | | | | | | | | | | | | | | | | INSTALL NEW SIGN ON RETAINED POST | X | | |
| WB | 6.243 | F | VD-701 | 6 | 10 | | 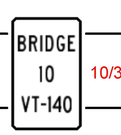 10/31/17 | 0.42 | | | | | | | | 1 | 7'-6" X | | | | | | | | | | | | T-42 |
| WB | 6.204 | F | VD1-1A | | | | (UP) Wallingford 6 | | | 1 | | | | X | | | | | | | | | | | | | | | |
| | | F | M3-4 | | | | WEST | | | 1 | | | | | | | | | | | | | | | | | | | |
| | | F | VM5-1 | | | | VERMONT 140 | | | 1 | | | | | | | | | | | | | | | | | | | |
| **SIGN SUMMARY SHEET** | | | | | | | SHEET TOTALS | 5.42 | 0.00 | 11 | 0 | 0 | 2 | 0 | 0 | 1 | 10.0 | | | 0 | 0.0 | 0.0 | 0.0 | 0.0 | | | | | |
| | | | | | | | | SF | SF | EA | EA | EA | EA | EA | EA | EA | FT | | | EA | LB | LB | LB | LB | | | | | |
| VERMONT AGENCY OF TRANSPORTATION | | | | | | | TOWN DIRECTIONAL TOTALS | 572.0 | 0.0 | 35 | 2 | 2 | 128 | 0 | 0 | 93 | 1325.0 | | | 2 | 183.0 | | | | | | | | |

PROJECT NAME: STATEWIDE-SOUTH REGION
PROJECT NUMBER: STPG SIGN(57)
FILE NAME: z16t041Wallingford140WB.xls
PROJECT MANAGER: D. MUNRO
DESIGNED BY: P. MCKECHNIE
WALLINGFORD VT-140 WB 2
PLOT DATE: 2/27/2017
DRAWN BY: W. GORDON
CHECKED BY: BRZEZOWSKI
SHEET 216 OF 264