DIRECTION	MILEPOINT	LOCATION CODE (SHEET 4)	SIGN CODE	WIDTH (IN)	HEIGHT (IN)	SHEETING REMARKS	SIGN LEGEND	NEW SIGNS "A"	NEW SIGNS "B"	EXISTING SIGNS RETAIN	EXISTING SIGNS SALVAGE FROM	EXISTING SIGNS SALVAGE TO	EXISTING SIGNS REMOVE	EXIST POST RETAIN	EXIST POST REMOVE	NUMBER OF NEW POSTS	SQUARE STEEL (IN) 1.75 (LB / FT) 1.88	SQUARE STEEL (IN) 2.00 (LB / FT) 2.42	SQUARE STEEL (IN) 2.50 (LB / FT) 3.35	TUBULAR STEEL Ø (IN) FOUNDATION	TUBULAR STEEL Ø (IN) 3.00 (LB / FT) 7.60	TUBULAR STEEL Ø (IN) 3.50 (LB / FT) 9.00	TUBULAR STEEL Ø (IN) 4.00 (LB / FT) 10.80	TUBULAR STEEL Ø (IN) 5.00 (LB / FT) 14.60	SIGN FRAME REQUIRED	REMARKS	SIGN DETAIL LOCATION SHSM	SIGN DETAIL LOCATION SIGN DETAILS SHEET #	SIGN DETAIL LOCATION STANDARD SHEET #
SB MOUNT HOLLY VT 103							FY-FLUORESCENT YELLOW FYG-FLUORESCENT YELLOW GREEN																			"SHSM"-STANDARD HIGHWAY SIGNS AND MARKINGS BOOK			
		F	M6-1R				RIGHT ARROW						1																
		F	M3-3	24	12			2.00																	2C	INSTALL ON RETAINED POSTS	X		
		F	VM1-5	30	24		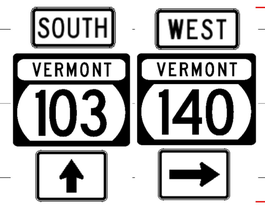 10/25/17	5.00																				E-136
		F	M6-3	21	15			2.19																			X		
		F	M3-4	24	12			2.00																			X		
		F	VM1-5	30	24			5.00																				E-136
		F	M6-1R	21	15			2.19																			X		
SB	7.457	F	R2-1				8/25/17 SPEED LIMIT 50						1	X															
		F	R2-1	24	30			5.00																		INSTALL ON RETAINED POST	X		
SB	7.418	F	VD2-1				MOUNT HOLLY 2						1		X														
		F	VD2-1				LUDLOW 11						1																
		F	VD2-1	72	12		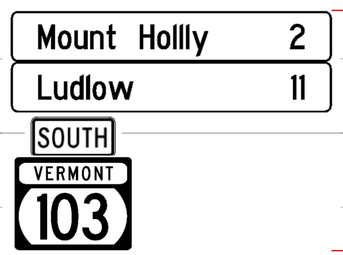 8/25/17	6.00								2	16'-3" 15'-6" X											T-93
		F	VD2-1	72	12			6.00																				T-93
		F	M3-3	24	12			2.00																		SOUTH, GREEN ON WHITE INSTALL ON LEFT POST	X		
		F	VM1-5	30	24			5.00																		INSTALL ON LEFT POST			E-136
							SHEET TOTALS	42.38	0.00	0	0	0	4	0	0	2	30.0			0	0.0	0.0	0.0	0.0					
								SF	SF	EA	EA	EA	EA	EA	EA	EA	FT			EA	LB	LB	LB	LB					
							TOWN DIRECTIONAL TOTALS	367.7	0.0	11	4	5	82	0	0	41	585.0			0	0.0								

SIGN SUMMARY SHEET

VERMONT AGENCY OF TRANSPORTATION

PROJECT NAME: **STATEWIDE-SOUTH REGION**
PROJECT NUMBER: **STPG SIGN(57)**
FILE NAME: **z16t041Mt Hollv103 SB.xls**
PROJECT MANAGER: **D. MUNRO**
DESIGNED BY: **P. MCKECHNIE**
MOUNT HOLLY VT-103 SB 2
PLOT DATE: **2/27/2017**
DRAWN BY: **W. GORDON**
CHECKED **BRZEZOWSK**
SHEET **98** OF **264**