
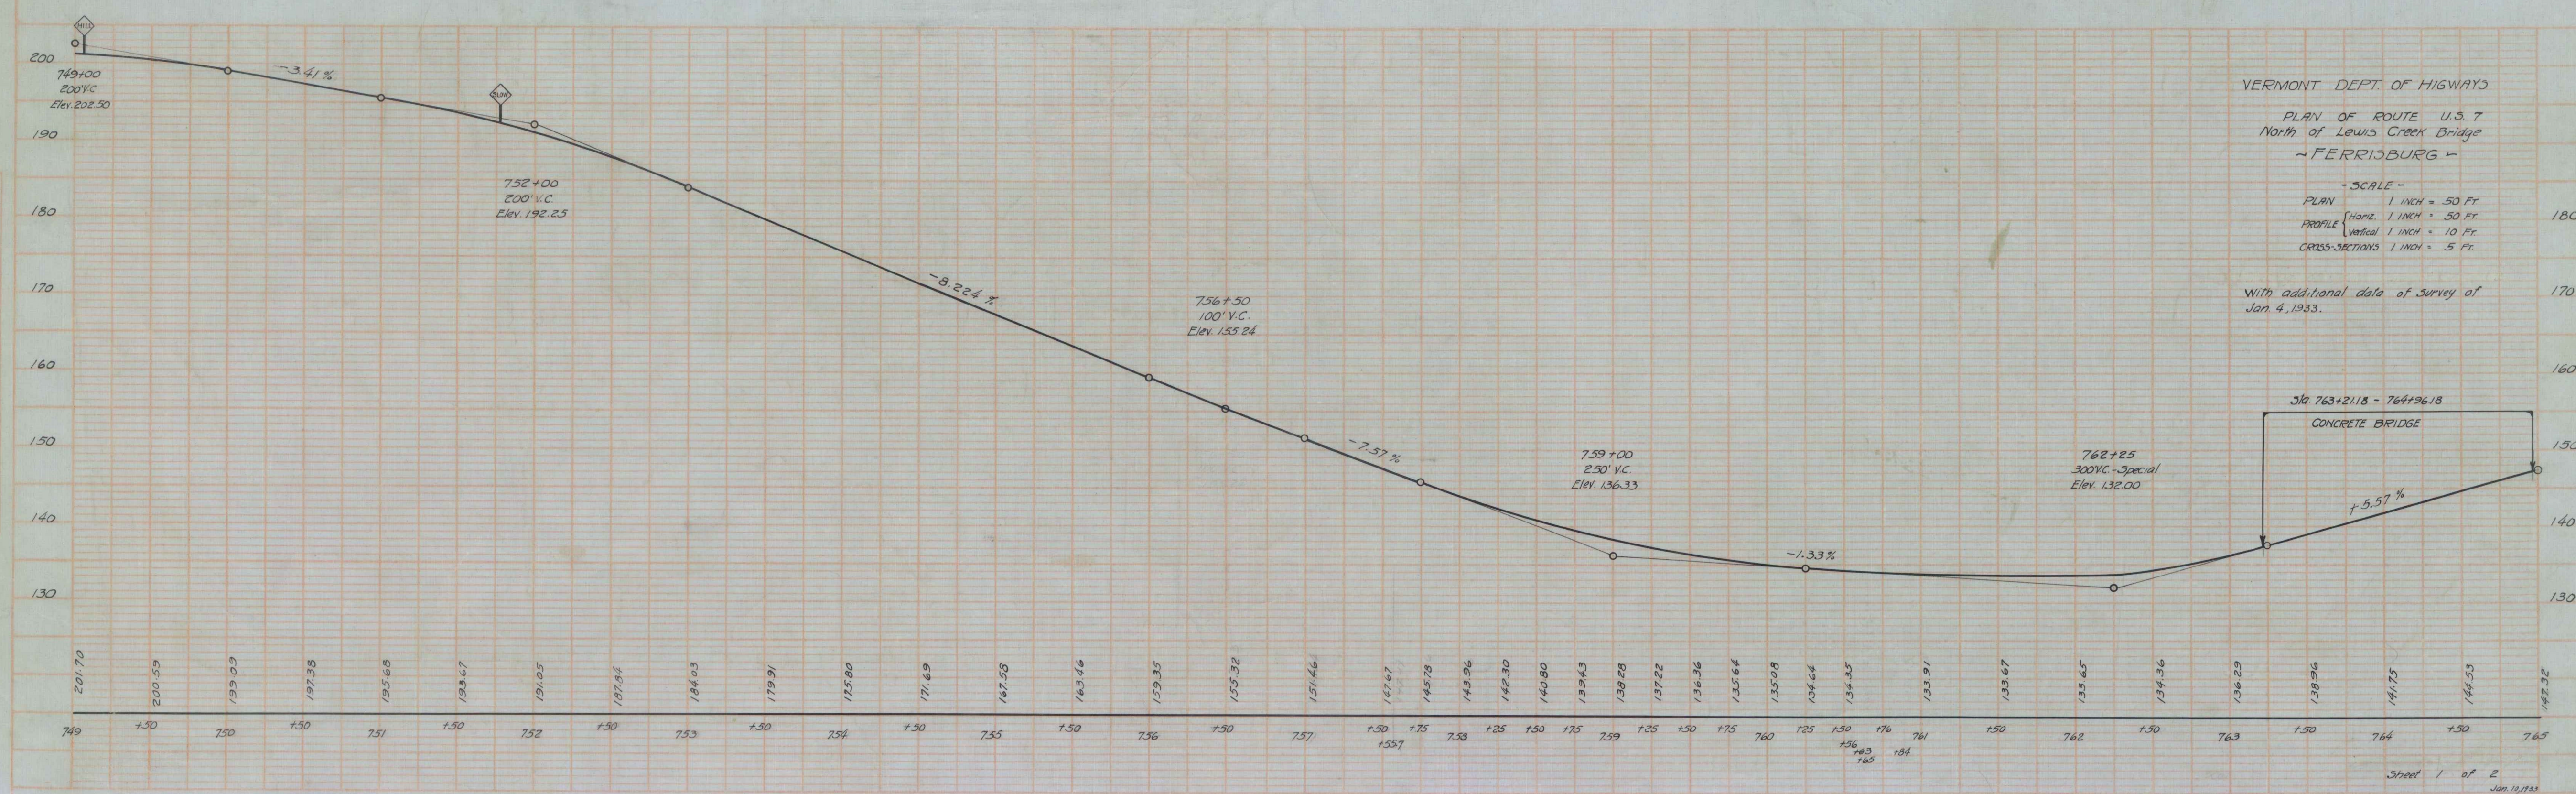


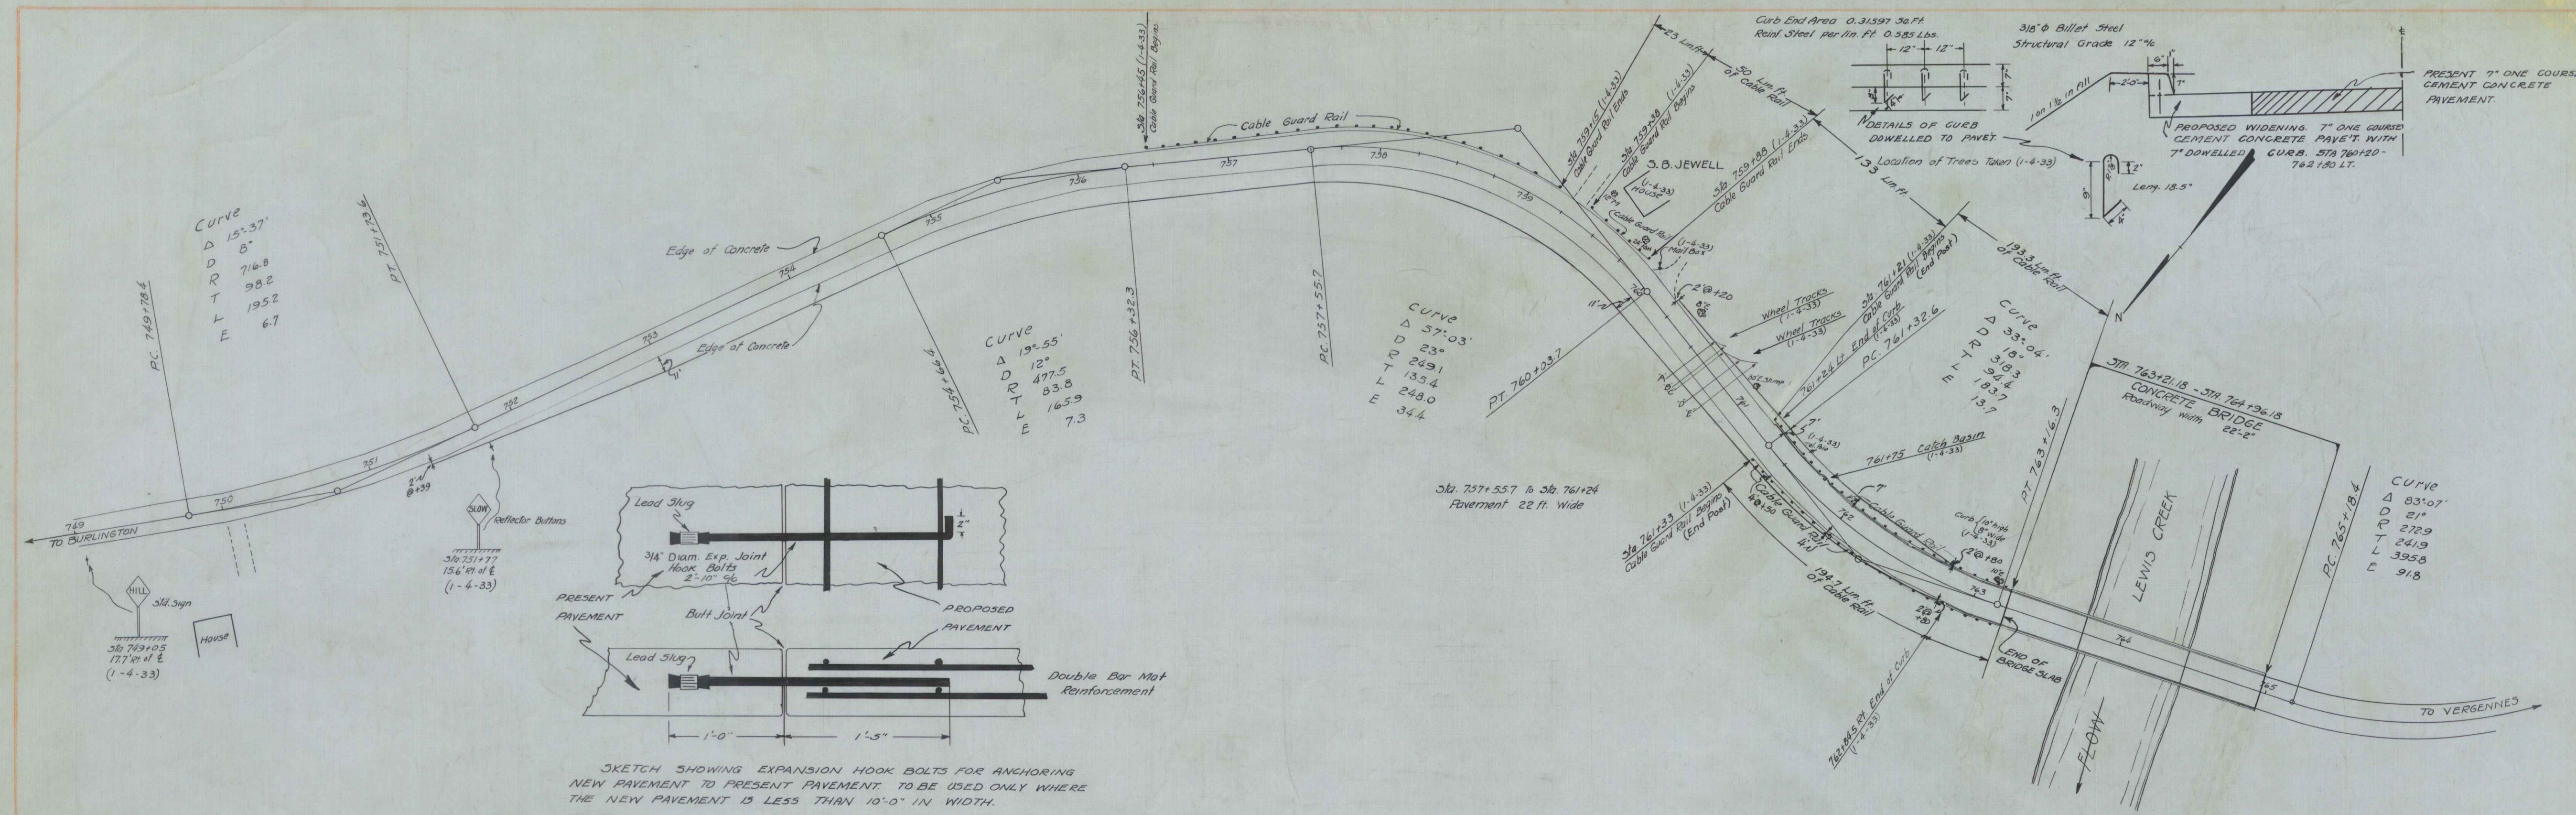

VERMONT DEPT. OF HIGHWAYS
 PLAN OF ROUTE U.S. 7
 North of Lewis Creek Bridge
 - FERRISBURG -

- SCALE -
 PLAN 1" = 50 FT.
 PROFILE Vertical 1" = 10 FT.
 CROSS-SECTIONS 1" = 5 FT.

With additional data of survey of Jan. 4, 1933.