FED. ROAD DIST. NO.	STATE	FED. AID PROJ. NO.	FISCAL YEAR	SHEET NO.	TOTAL SHEETS
9	VT.	72 B.	1928	10	104

WOOD GUARD RAIL REQUIRED

LEFT

Sta.	560+00	to	560+04	Length	4 ft. ✓
"	564+67	"	564 91	"	24 ft. ✓
"	568+52	"	568+76	"	24 ft. ✓

RIGHT

Sta.	560+00	to	560+04	Length	4 ft. ✓
Sta	564+67	"	564+91	"	24 "
"	568+52	"	568+76	"	24 "

NEW CULVERTS REQUIRED.

Sta. 564+79 - 18" Reinf. Concrete Pipe Culvert 32 ✓ Lin ft.
Concrete Class A ~~B~~ (1-2½-4) 2.4 ~~2.7~~ Cu. yds
Reinforcing Steel 54 ~~33~~ pounds.

Sta. 568+64 - 18" Reinf. Concrete pipe Culvert 32 ✓ Lin. ft.
Concrete Class A ~~B~~ (1-2½-4) 2.4 ~~2.7~~ Cu. yds.
Reinforcing Steel 54 ~~32~~ pounds.

SUB-BASE OF GRAVEL REQUIRED. ✓ ✓

Sta. 560+00 to 561+00 ~~Gravel Shaping Course~~ 100 Lin ft.
561+00 " 562+00 6" Subbase of Gravel

Cable Guard Rail

Sta 565+73 To 567+65 - Right - length 192 lin. ft.

1 DRIVEWAY CULVERTS

~~Sta. 562+10 - on left - New headwalls required. 1.1 cu. yds.~~

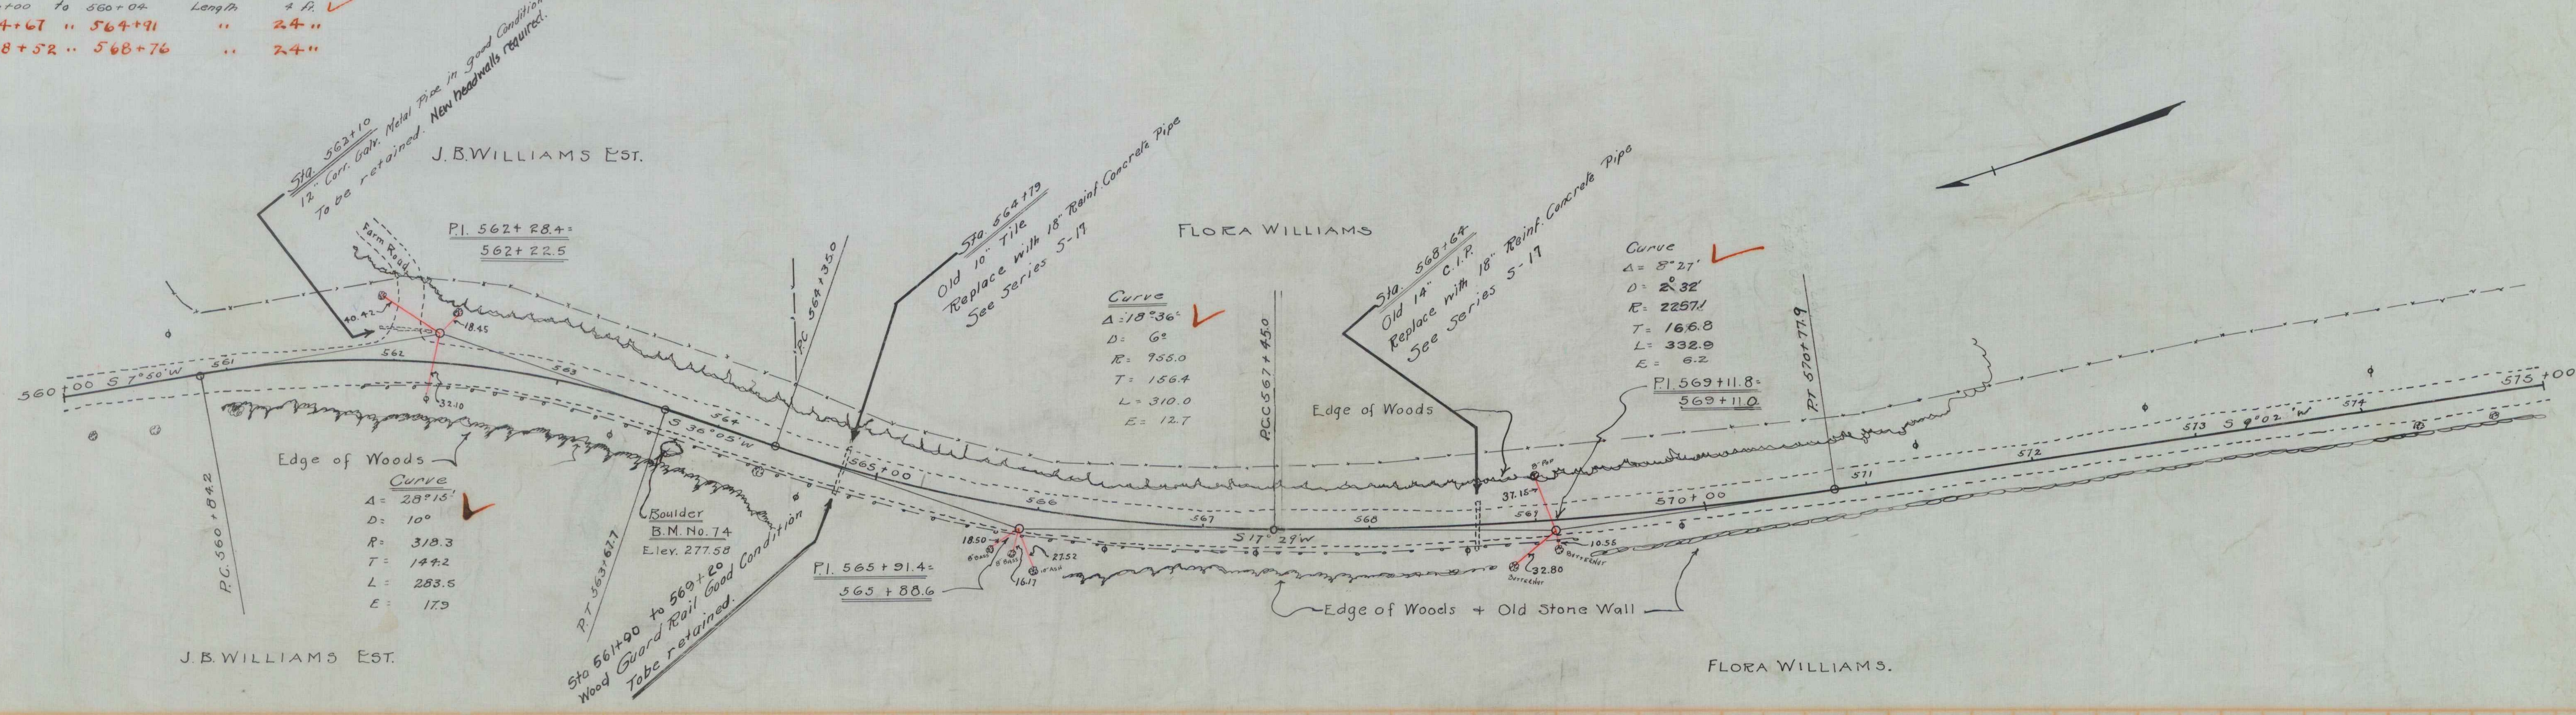

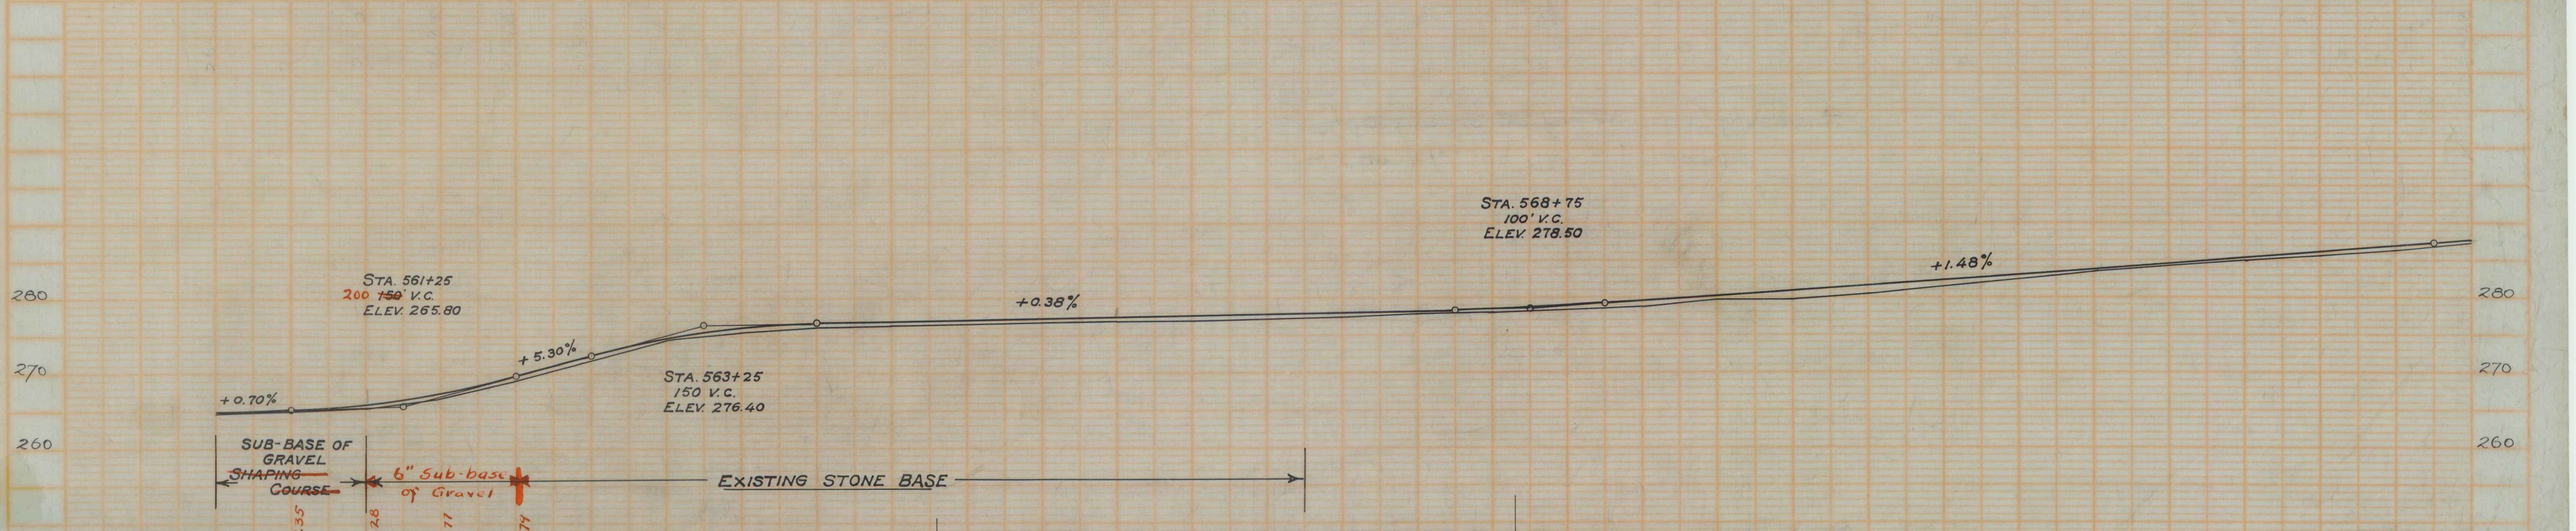

Station		
560+00	264.6	264.93 ✓
+50		~~265.28~~ 265.35
561+00	265.4	~~266.01~~ 266.28
+50	266.9	~~267.50~~ 267.77
562+00	269.1	~~269.72~~ 269.74
+50	271.9	272.37 ✓
563+00	274.5	274.61
+50	275.5	276.08
564+00	276.1	276.68
+50	276.3	276.87
+79		276.98
565+00	276.5	277.06
+50	276.8	277.25
566+00	277.0	277.44
+50	277.0	277.63
567+00	277.1	277.82
+50	277.4	278.01
568+00	277.9	278.20
+50	278.0	278.44
+64		278.54
569+00	278.3	278.91
+50	278.9	279.61
570+00	279.7	280.35
+50	279.9	281.09
571+00	280.5	281.83
+50	281.3	282.57
572+00	282.4	283.31
+50	283.4	284.05
573+00	284.2	284.79
+50	285.0	285.53
574+00	285.7	286.27
+50	286.4	287.01
575+00	287.2	287.71

B.M. No. 74, Boulder on right of Sta. 563+79, Elev. 277.58

Series F. No. 72 B.
Sheet 10 of 104