| FED. ROAD DIST. NO. | STATE | FED. AID PROJ. NO. | FISCAL YEAR | SHEET NO. | TOTAL SHEETS |
|---|---|---|---|---|---|
| | | 728 | 1928 | 12 | 104 |

## DRIVEWAY CULVERTS REQUIRED

Sta. 591+90 Right, 12" Corr. Galv. Metal Pipe 32 Lin. ft.
Concrete Class B (1-2¼-3) 1.4 Cu. yd.
" 593+60 Right 12" Corr. Galv. Metal Pipe 20 Lin. ft.
Concrete Class B (1-2¼-3) 1.4 Cu. yds.

## SUB-BASE OF GRAVEL REQUIRED

Sta 590+00 to 595+00 - 6" Sub-base of gravel 500 Lin ft

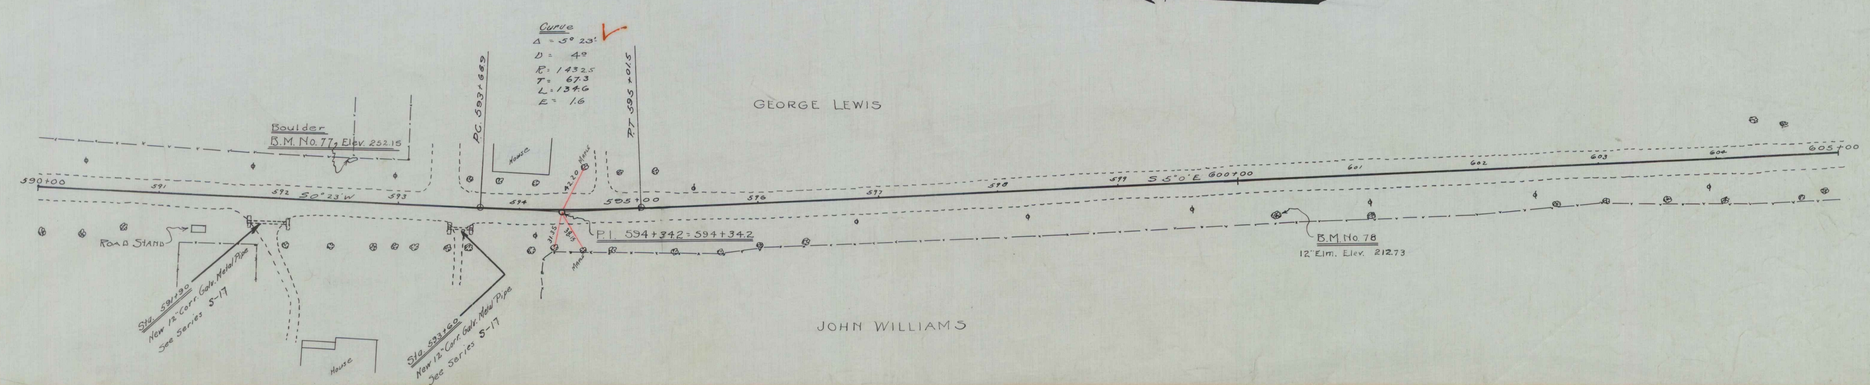


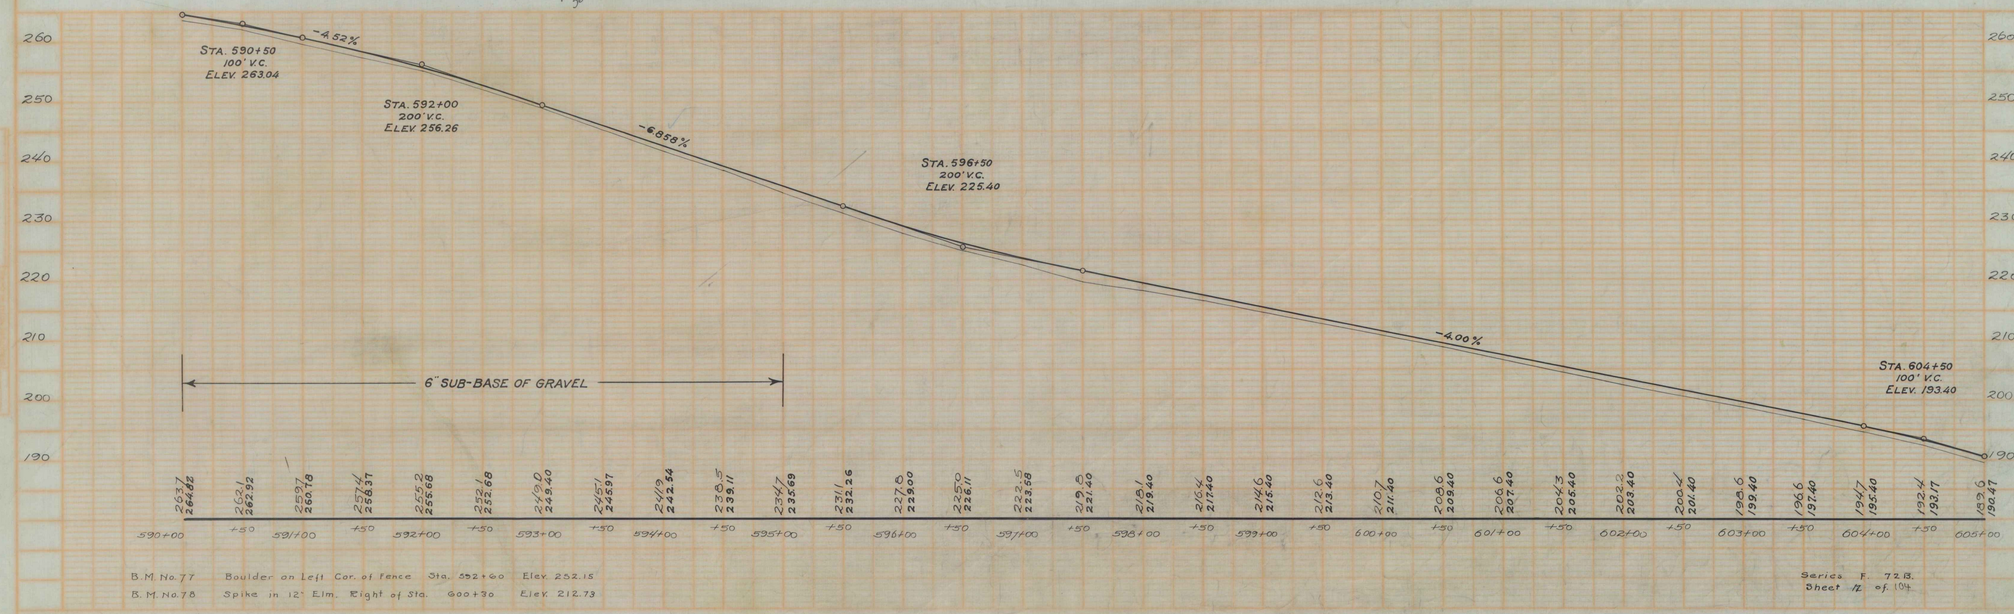


B.M. No. 77 Boulder on Left Cor. of fence Sta. 592+60 Elev. 252.15
B.M. No. 78 Spike in 12" Elm. Right of Sta. 600+30 Elev. 212.73

Series F. 72.13.
Sheet 12 of 104