## DRIVEWAY CULVERTS REQUIRED.

Sta. 693+75 Right, 12" Corr. galv. Metal Pipe ~~44~~ Lin. ft. 32
Concrete Class B (1-2½-5) ~~1.1~~ Cu. yds. 1.4

| FED. ROAD DIST. NO. | STATE | FED. AID PROJ. NO. | FISCAL YEAR | SHEET NO. | TOTAL SHEETS |
|---|---|---|---|---|---|
| 9 | VT. | 72 B | 1928 | 18 | 104 |

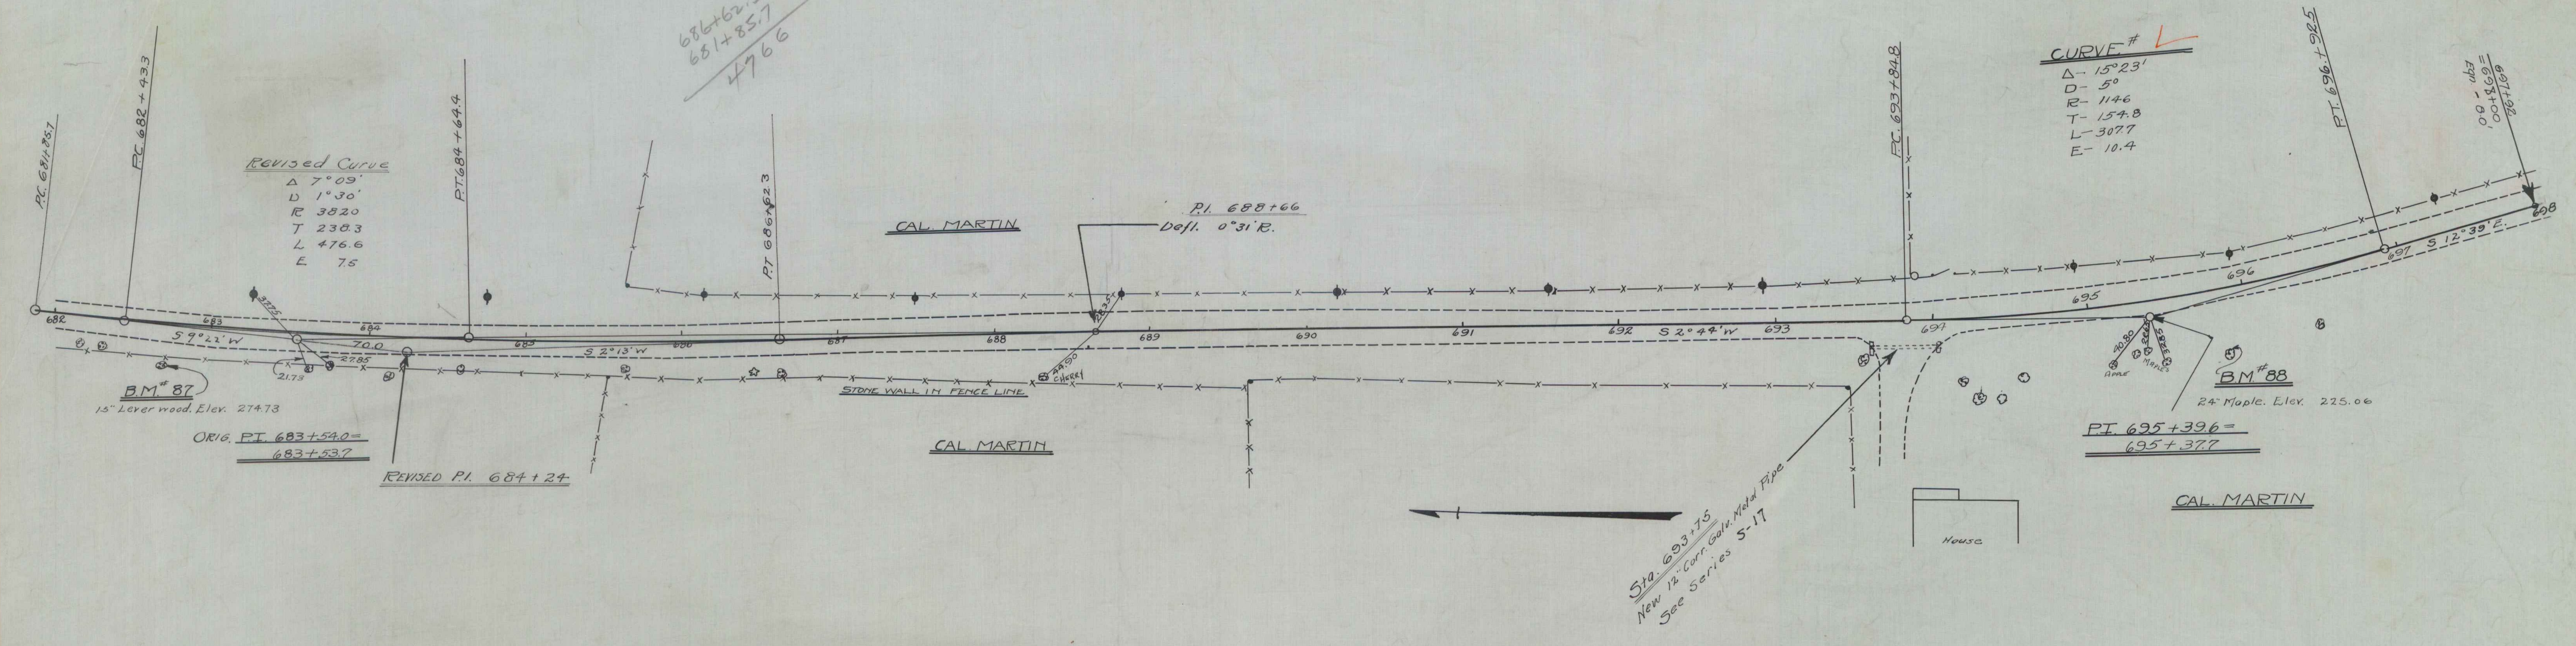

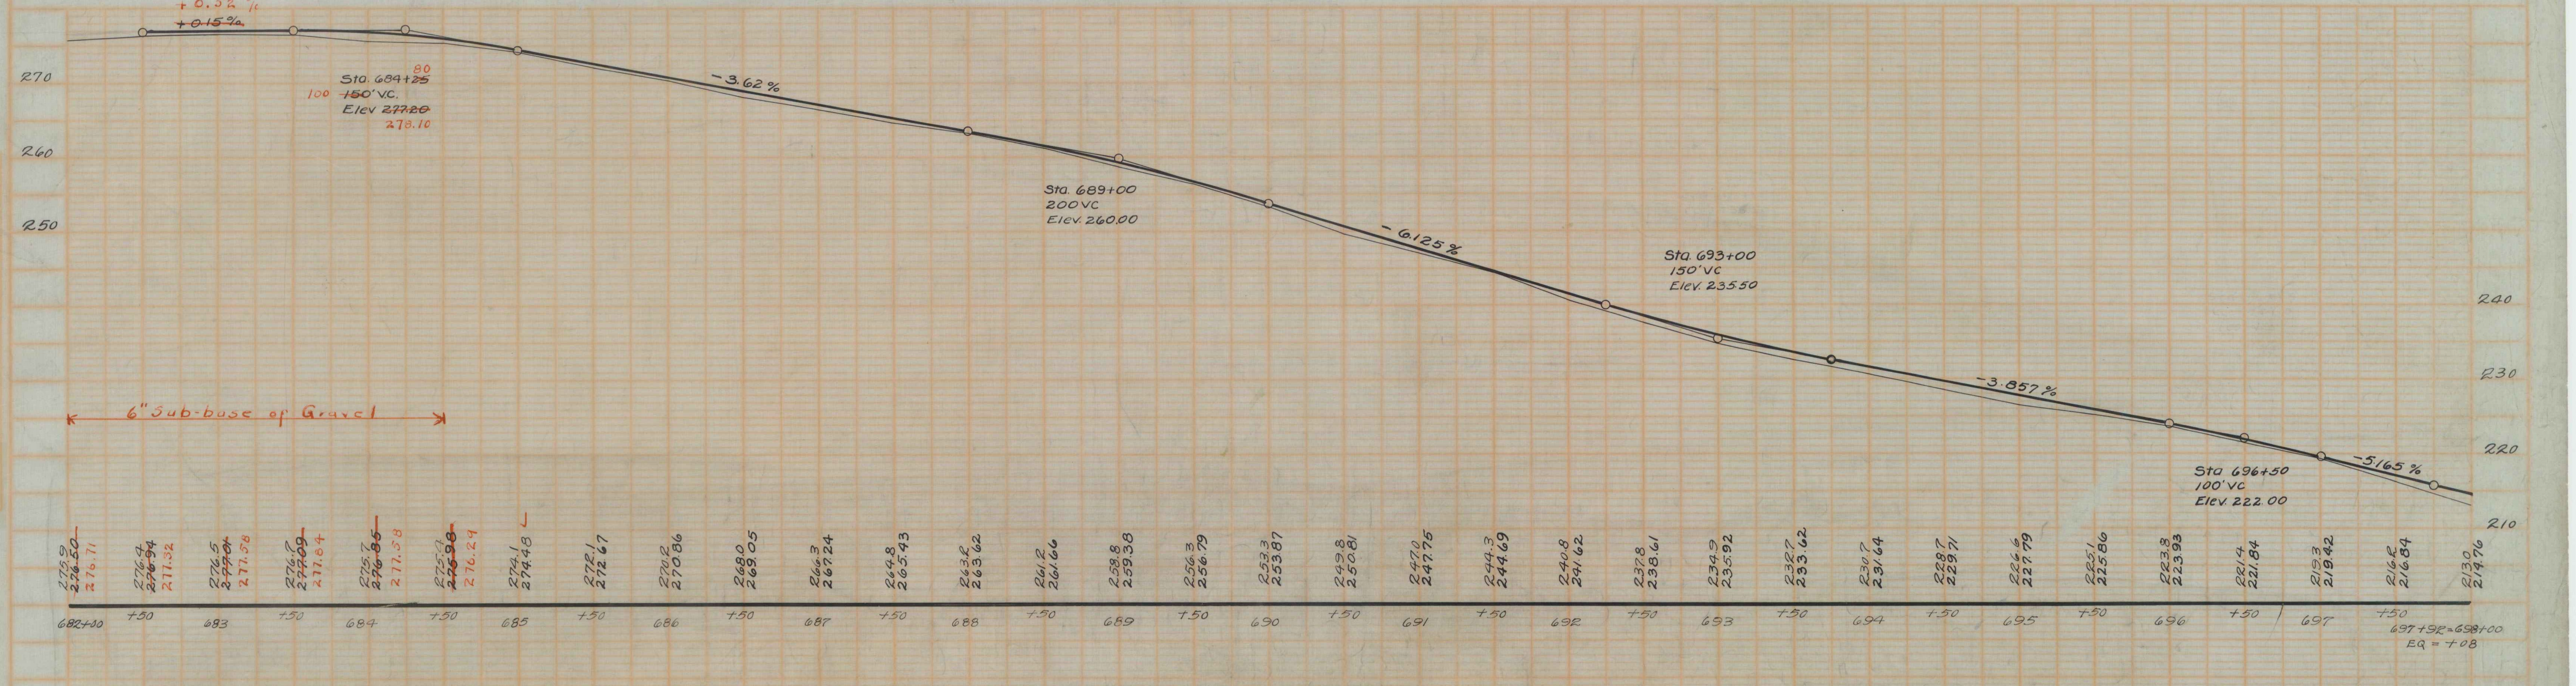

B.M. NO. 87 ∞ SPIKE IN 15" LEVER WOOD, 18' RIGHT OF STA. 682+32 ELEV. 274.73
B.M. NO. 88 ∞ SPIKE IN 24" MAPLE, 43' RIGHT OF STA. 695+86 ELEV. 225.06

SERIES F No 72B
SHEET 18 of 104