WOOD GUARD RAIL REQUIRED.

LEFT

Sta. 754+32 to 754+56 Length 24 ft.
" 764+91 " 765+39 " 48 "

RIGHT

754+32 to 754+56 Length 24 ft.
764+91 " 765+39 " 48 "

CABLE GUARD RAIL REQUIRED

LEFT

Sta. 756+~~20~~ 42 to ~~763+64~~ 759+22 Length
" ~~764+50~~ 761+29 to ~~765+94~~ 763+21 "

RIGHT

Sta. ~~760+60~~ 761+29 to 763+~~64~~ 21 Length
~~" 764+50 to 765+94~~

[redacted]

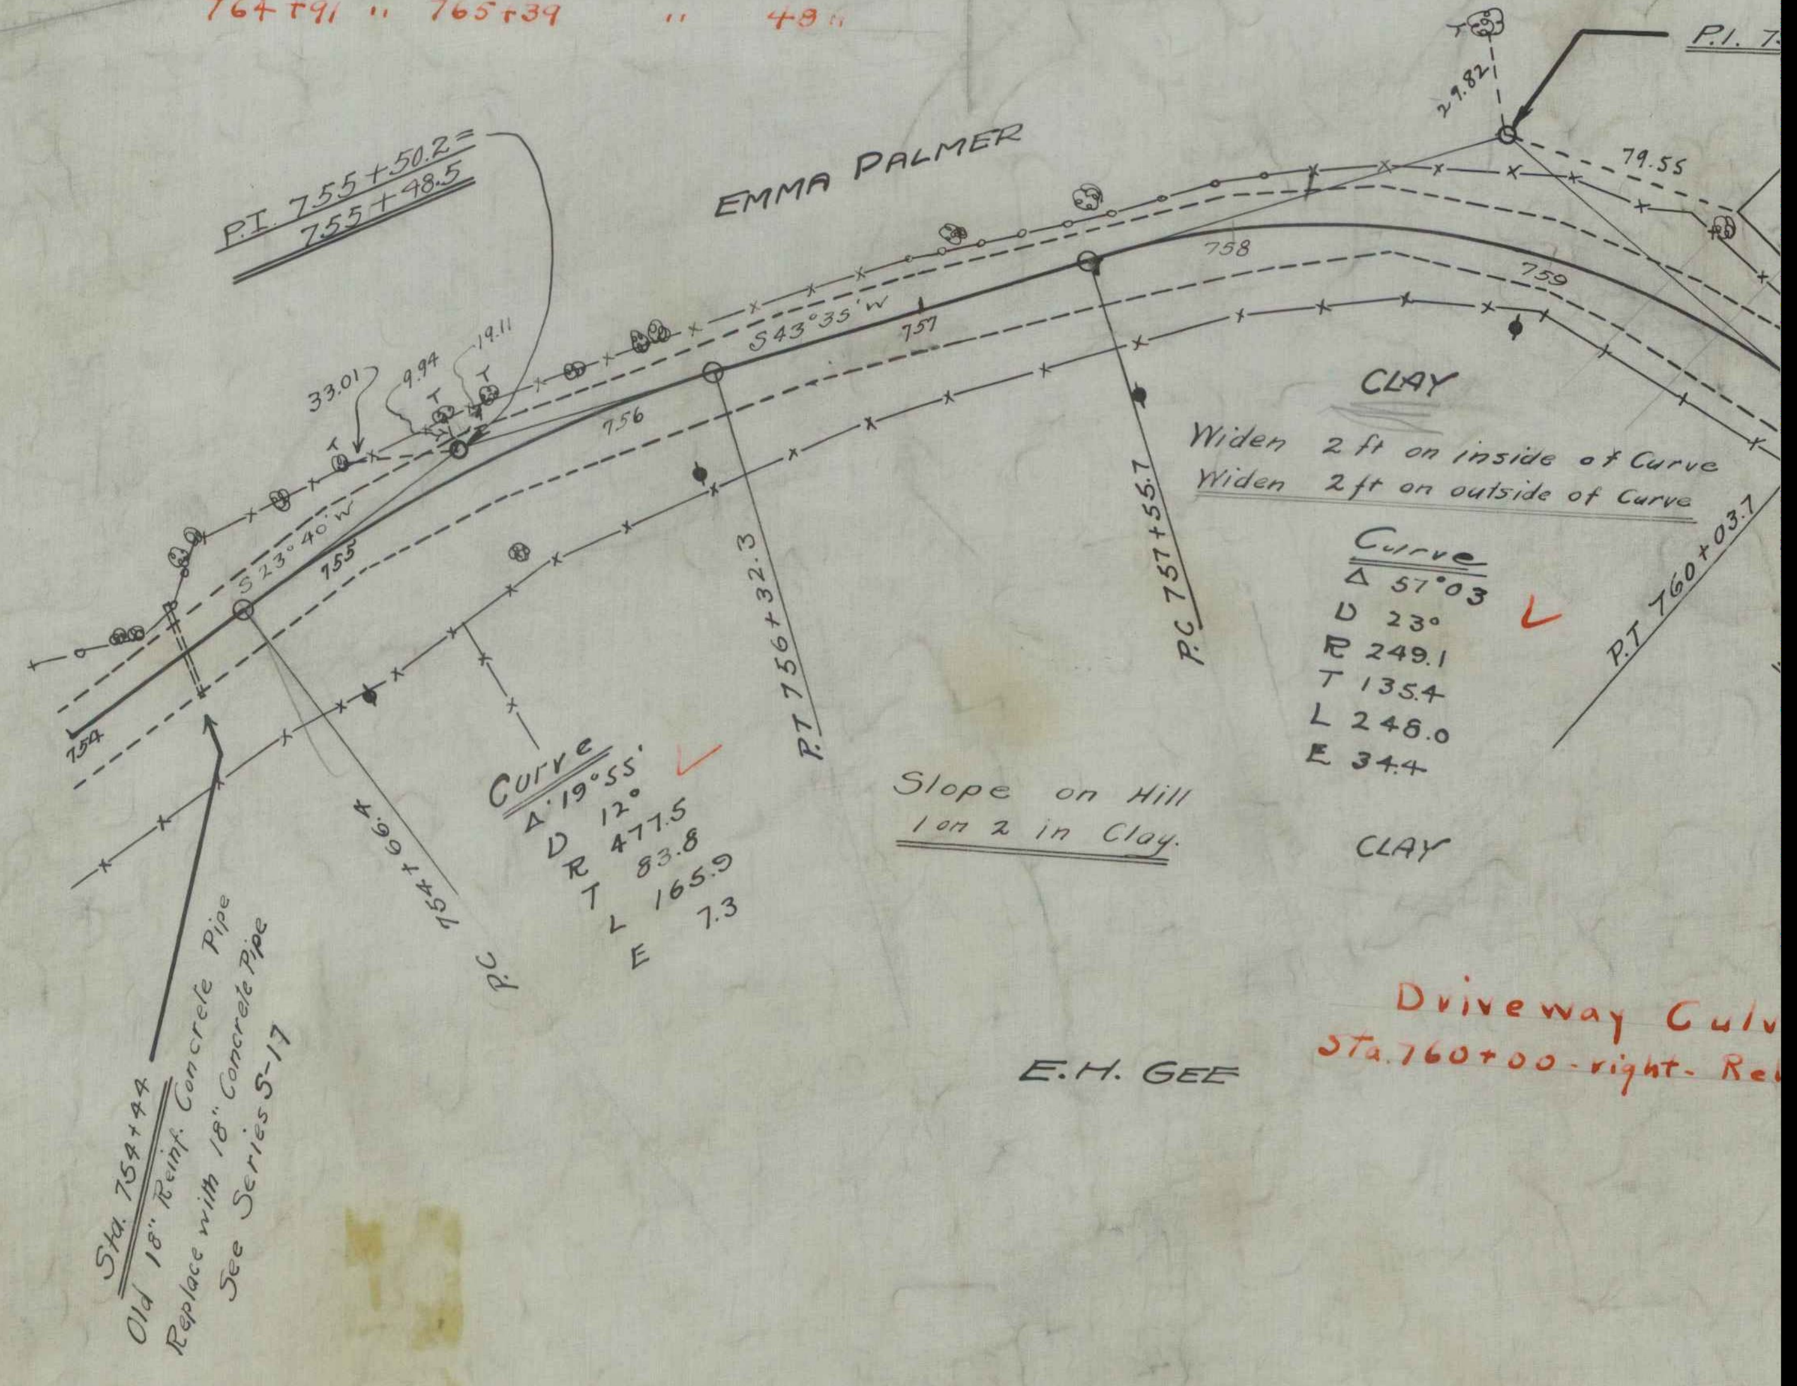
P.I.
29.82
79.55
P.T. 755+50.2 = 755+48.5
EMMA PALMER
33.01
9.94
19.11
S 23°40' W
S 43°35' W
754
755
756
757
758
759
CLAY
Widen 2 ft on inside of Curve
Widen 2 ft on outside of Curve
Curve
Δ 57°03
D 23°
R 249.1
T 135.4
L 248.0
E 34.4
P.T. 760+03.7
P.C. 757+55.7
P.T. 756+32.3
Curve
Δ 19°55'
D 12°
R 477.5
T 83.8
L 165.9
E 7.3
P.C. 754+66
Slope on Hill
1 on 2 in Clay.
CLAY
Driveway Culv
Sta. 760+00 - right - Re
E. H. GEE
Sta. 754+44
Old 18" Reinf. Concrete Pipe
Replace with 18" Concrete Pipe
See Series 5-17

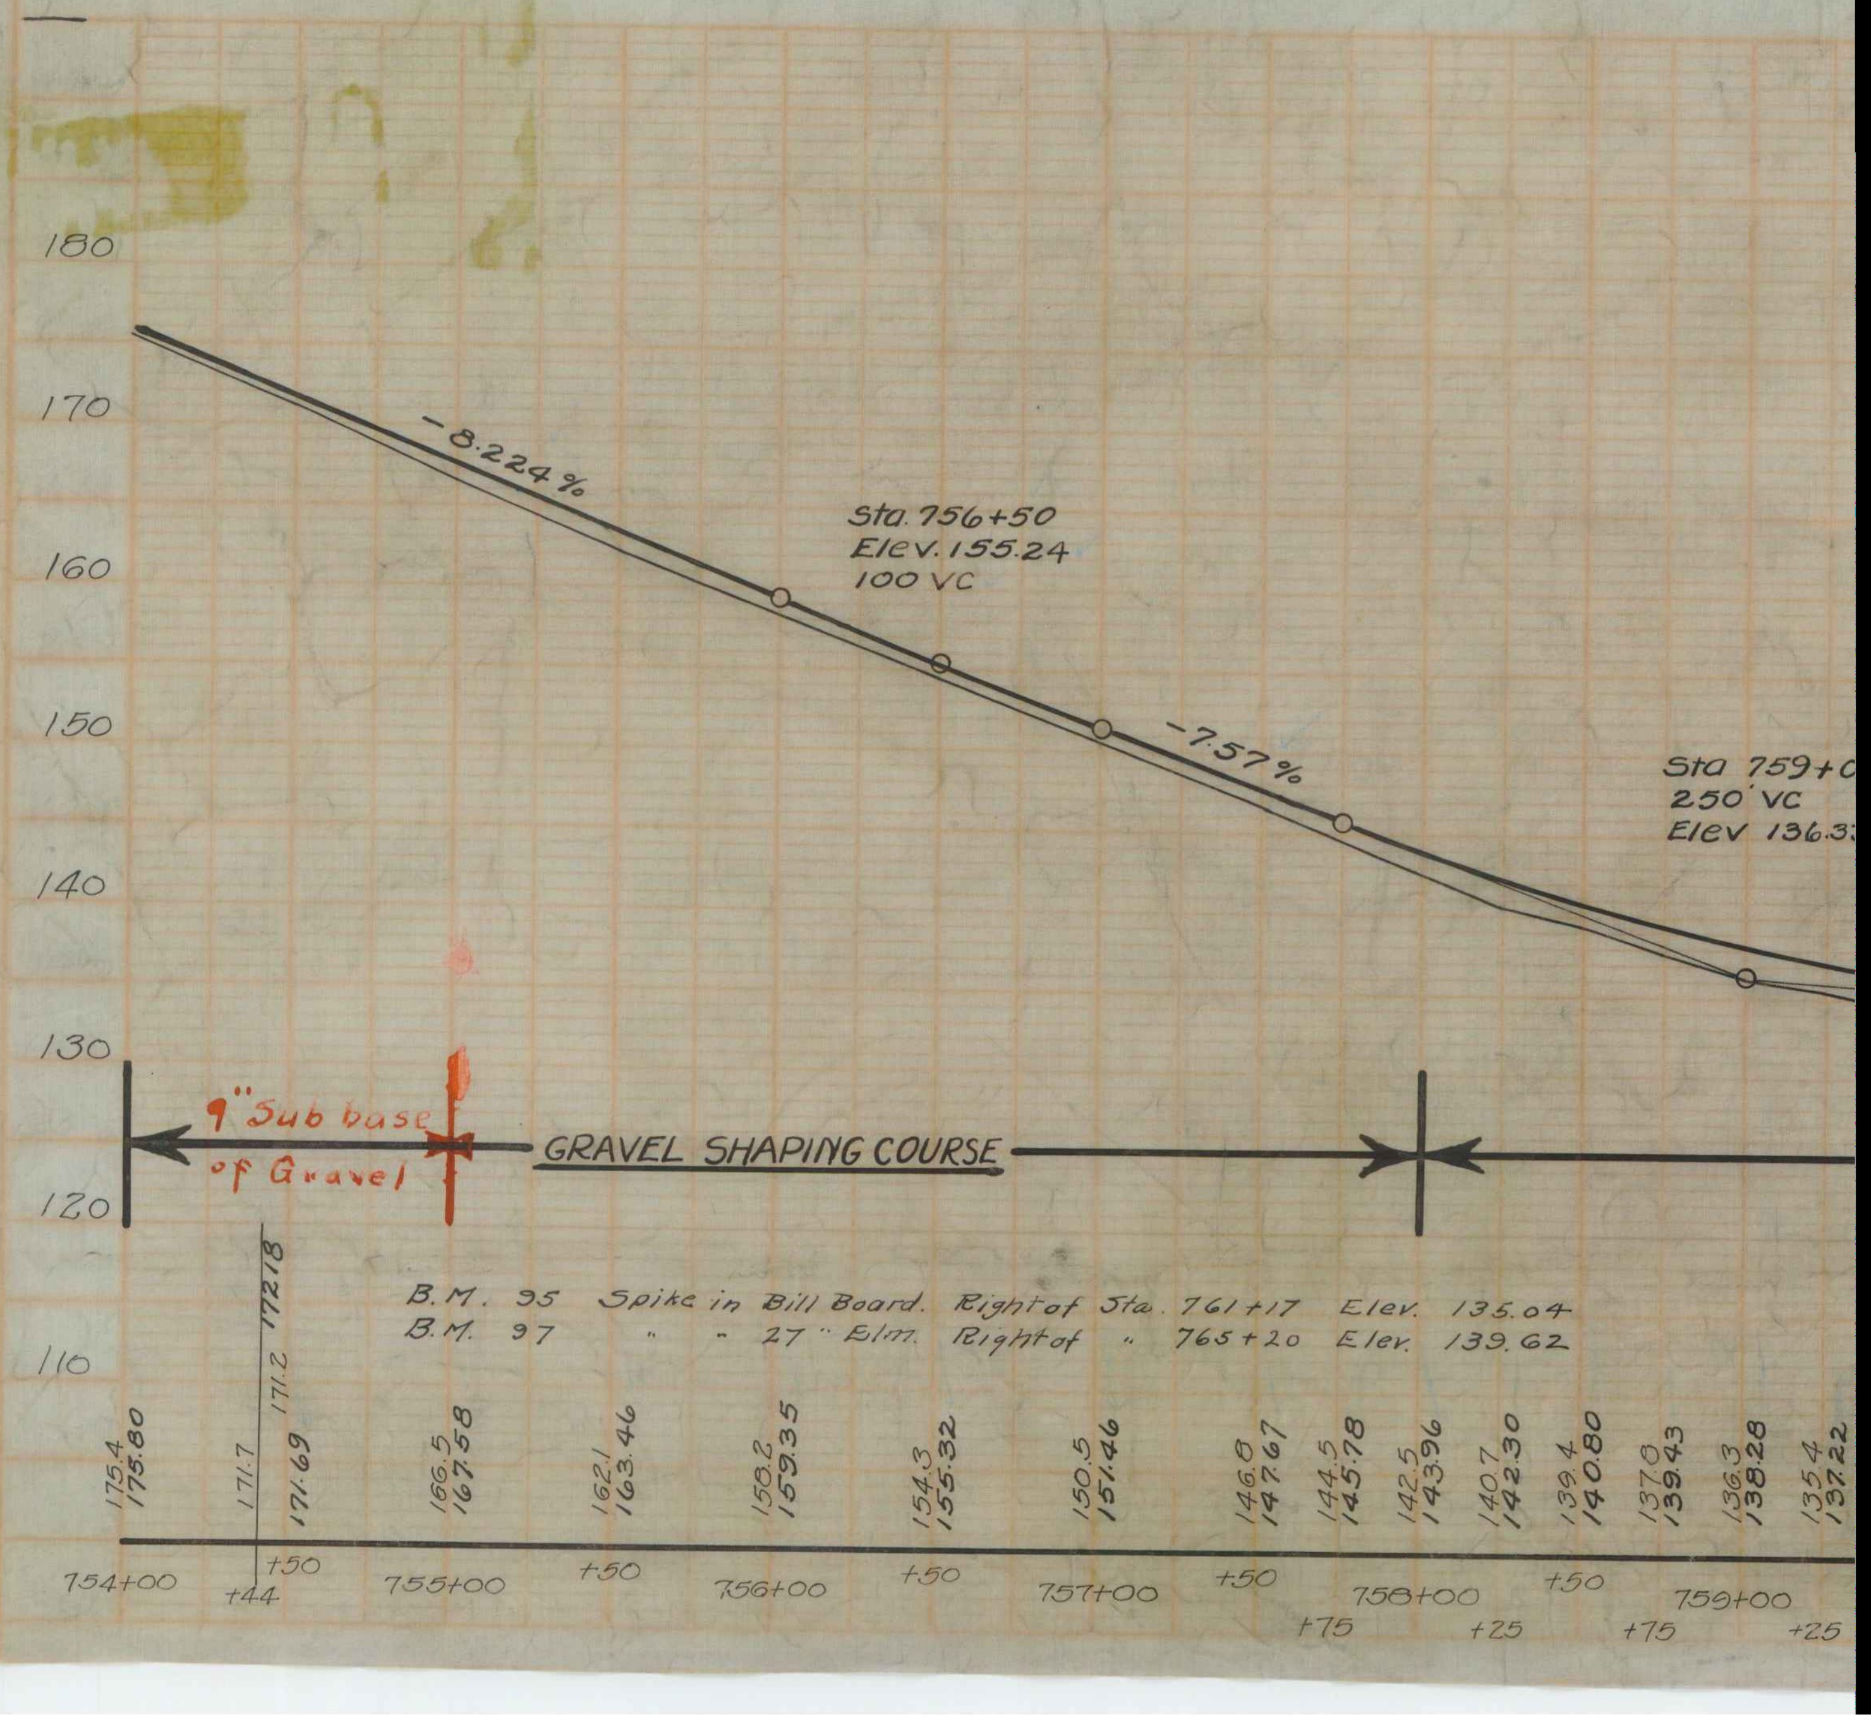

B.M. 95 Spike in Bill Board. Right of Sta. 761+17 Elev. 135.04
B.M. 97 " " 27" Elm. Right of " 765+20 Elev. 139.62