DRIVEWAY

~~Sta. 792+65 B~~

~~Concre~~

[redacted]

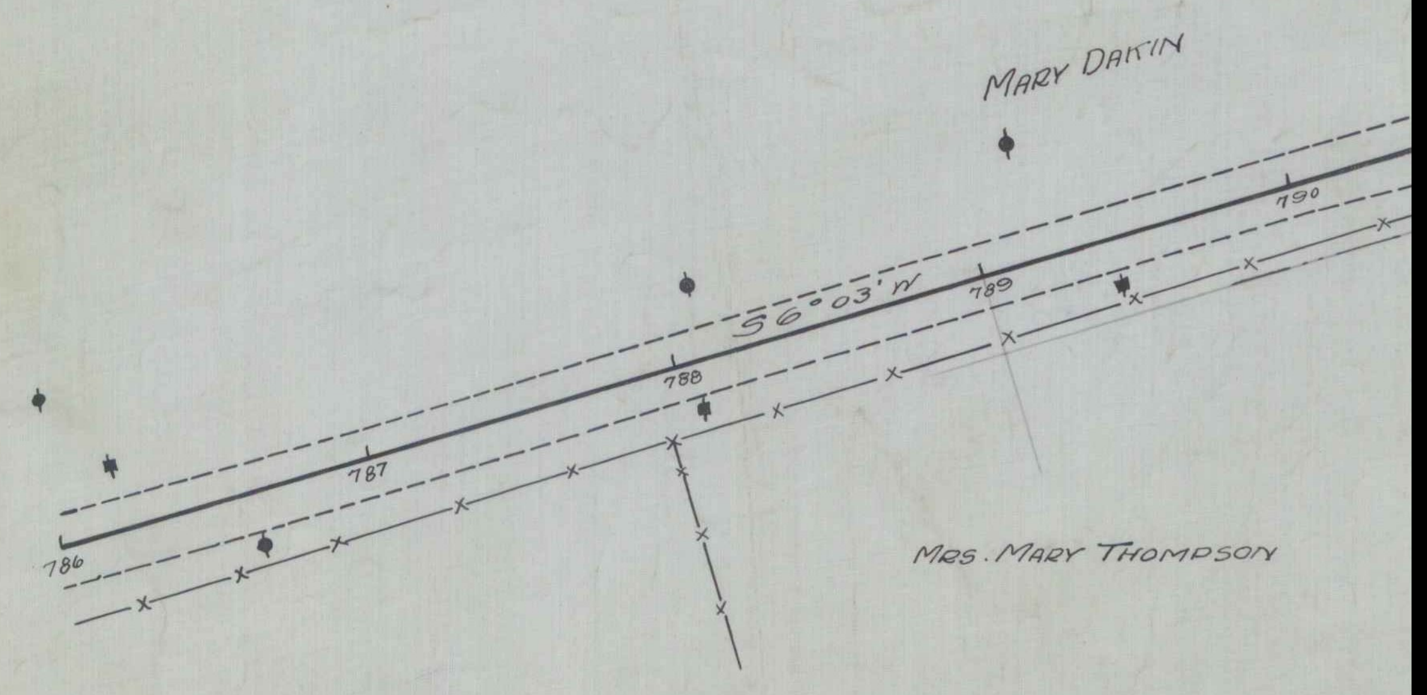
MARY DAKIN
S 56° 03' W
786
787
788
789
790
MRS. MARY THOMPSON

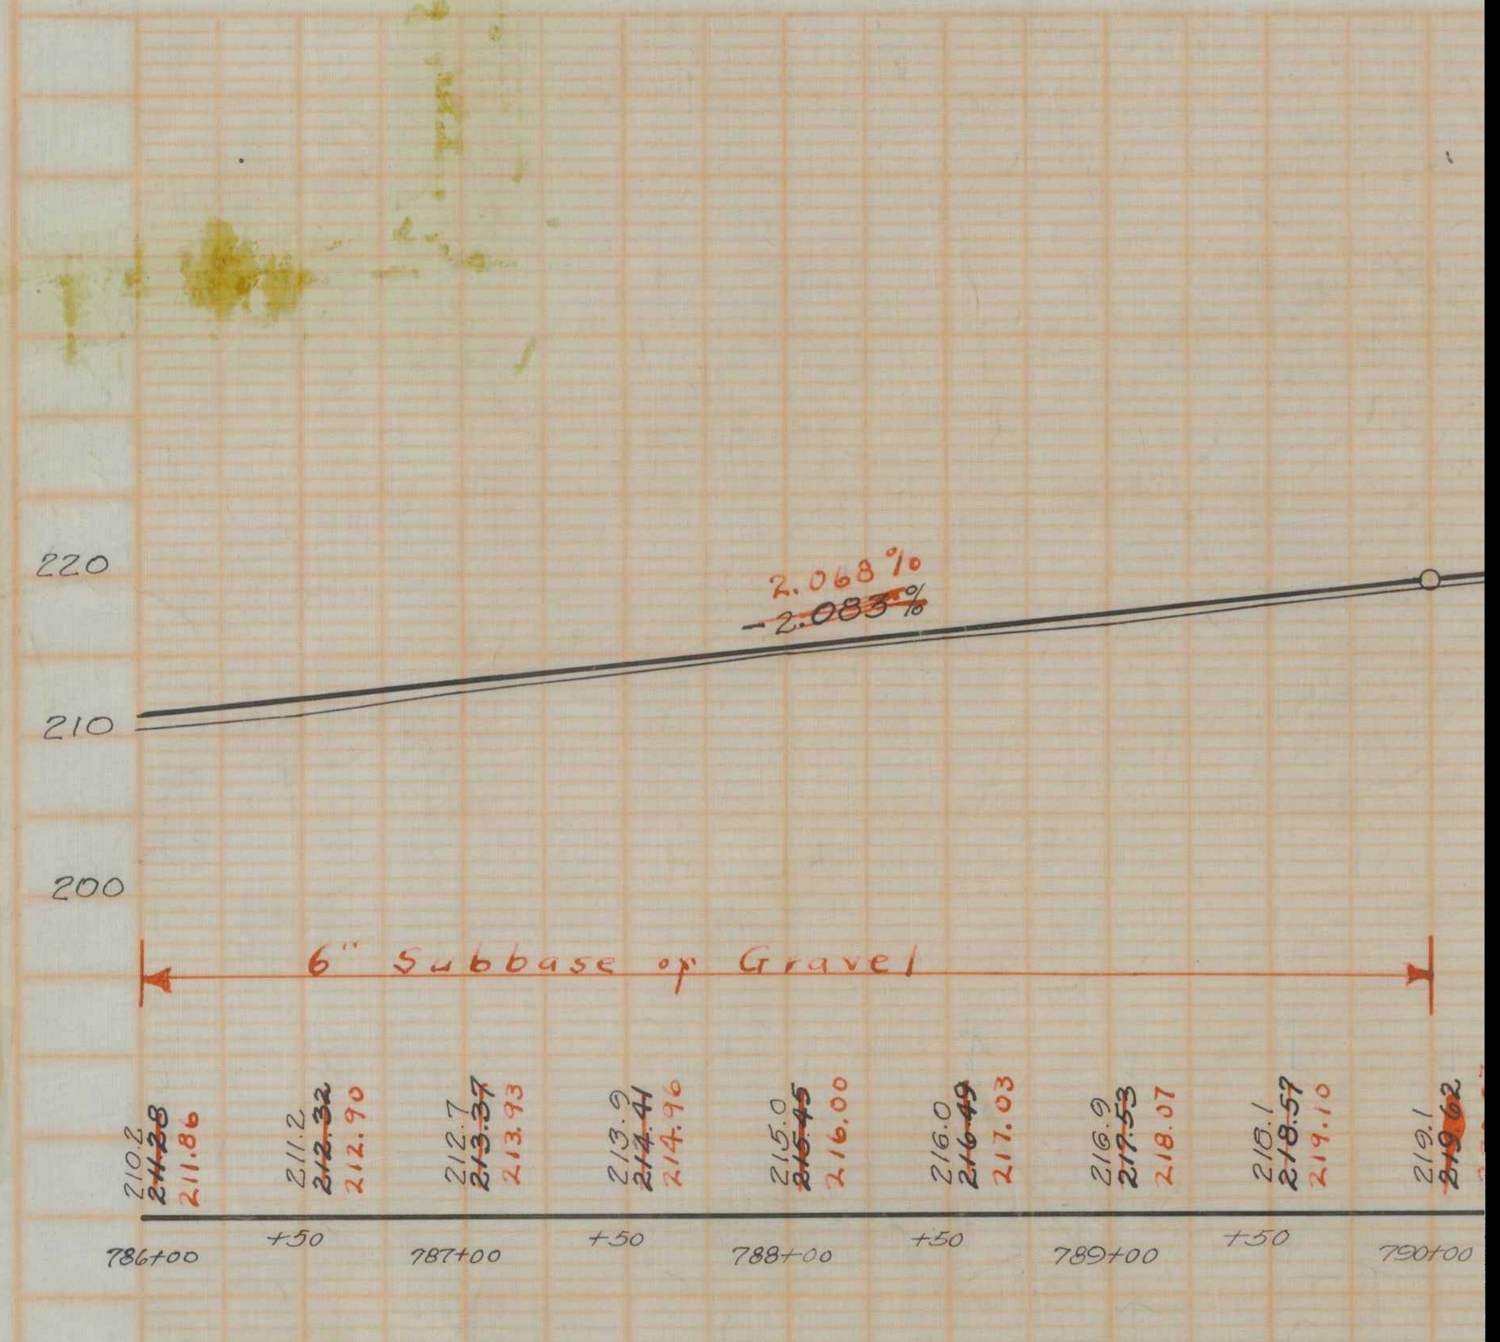
220
210
200
2.068 %
~~2.083 %~~
6" Subbase of Gravel
210.2
~~211.28~~
211.86
211.2
~~212.32~~
212.90
212.7
~~213.37~~
213.93
213.9
~~214.41~~
214.96
215.0
~~215.45~~
216.00
216.0
~~216.49~~
217.03
216.9
~~217.53~~
218.07
218.1
~~218.57~~
219.10
219.1
~~219.62~~
786+00
+50
787+00
+50
788+00
+50
789+00
+50
790+00

B.M. 100 Spike in 48" Poplar Left of Sta. 792+86 Elev. 22