Wood

CABLE GUARD RAIL

		LEFT		
Sta.	804+00 to	805+00		Length
	12	60		
		RIGHT		
Sta.	804+48 to	805+80		Length
	48	60		

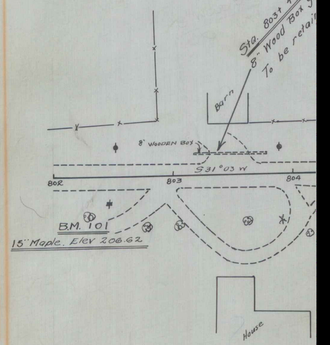

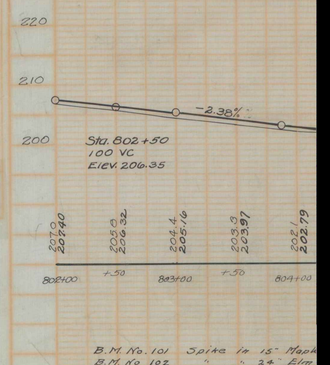

B.M. No. 101 Spike in 15" Maple
B.M. No. 102 " " 24" Elm