WOOD GUARD RAIL REQUIRED

LEFT

Sta.	842+67	to 842+93	Length	24 ft.
"	835+88	" 836+12	"	24 "
"	841+05	" 841+29	"	24 "

RIGHT

Sta.	842+67	to 842+93	Length	24 ft.
	835+88	" 836+12	"	24"
	841+05	" 841+29	"	24

CABLE GUARD RAIL REQUIRED

LEFT

~~Sta 846+80 to 847+44 Length 64 ft.~~

RIGHT

~~Sta 846+80 to 847+44 Length 64 ft.~~

Sta. 84

Sta. 834

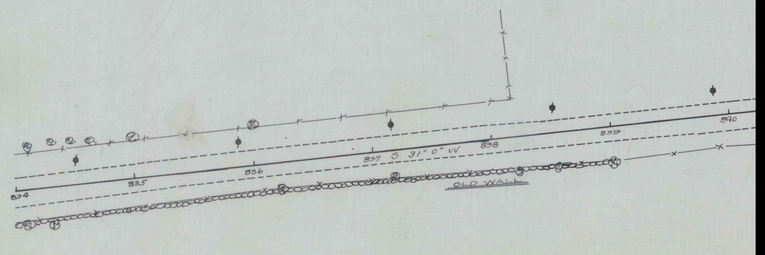

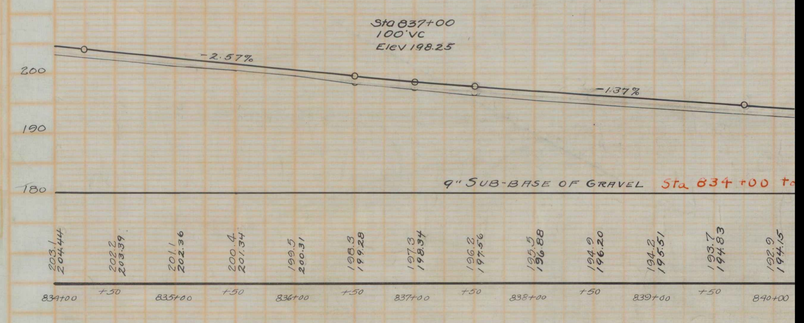

B. M. No. 105 Spike in 15" Elm Right of Sta. 841+16 Elev. 190.03