WOOD GUARD RAIL REQUIRED.

LEFT

Sta. 926+95 to 927+13 Length 24 ft.

RIGHT

Sta. 926+35 to 927+13 Length 24 ft.

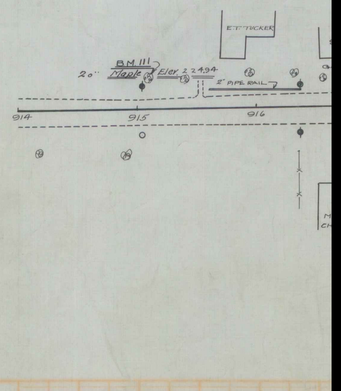

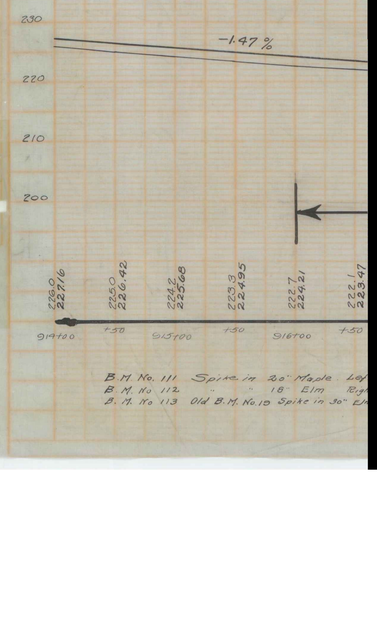

B.M. No. 111 Spike in 20" Maple Lef
B.M. No 112 " " 18" Elm Rig
B.M. No 113 Old B.M. No 10 Spike in 30" El