FED. ROAD DIST. NO.	STATE	FED. AID PROJ. NO.	FISCAL YEAR	SHEET NO.	TOTAL SHEETS
1	VT.	72 B	1928	5	104

WOOD GUARD RAIL REQUIRED

LEFT

Sta. ~~490+28 to 490+52 Length 24 ft.~~
" 492+22 " 492+46 " 24 " ✓
" 499+91 " 500+00 " 9 " ✓

RIGHT

Sta. 490+28 to 490+52 Length 24 ft ✓
" 492+22 " 492+46 " 24 " ✓
" 499+91 " 500+00 " 9 " ✓
486+24 486+48 24 " ✓

CABLE GUARD RAIL REQUIRED.

LEFT

Sta. 485+00 to 488+~~50~~ 42 Length ~~350~~ 342 ft.

NEW CULVERTS REQUIRED.

Sta. 490+40 18" Reinf. Concrete Pipe Culvert ~~32~~ 36 ft.
Concrete Class ~~B~~ A (1-2½-5) 2.4 ~~2.7~~ Cu. Yds.
Reinforcing Steel 54 ~~33~~ pounds.

Sta. 492+34 30" Reinf. Concrete Pipe Culvert 36 ft. ✓
Concrete Class ~~B~~ A (1-2½-~~5~~ 4) 4.1 ~~5.9~~ Cu Yds
Reinforcing Steel 58 ~~33~~ pounds.

DRIVE WAY PIPE CULVERTS REQUIRED.

Sta. 497+80 Right. 12" Corr. Galv. Metal Pipe ~~30~~ 40 Lin. ft.
Concrete Class B. (1-2½-5) 1.4 ~~1~~ Cu Yds.

SUB-BASE OF GRAVEL REQUIRED.

Sta. 485+00 to 491+50 6" Sub-base of gravel
793 Lin ft. Eq. + 143 ft.
Sta. 491+50 to 500+00 Gravel Shaping Course 850 Lin ft.
(as (Sub-base of Gravel)

NEW CULVERTS REQUIRED ✓
STA. 486+~~36~~ 79 18" Reinf. Conc. Pipe Leng. 36 ft.
Conc. Class ~~B~~ A (1-2½-~~5~~ 4) 2.7 cu yds 2.4
Reinf. Steel 54 ~~33~~ #

Relaying Pipe Culverts
Sta 491+75 - right - Relay 16 ft pipe
Concrete Class B (1-2½-5) 1.4 cu yds
Sta 486+50 - right - Relay 28 ft pipe

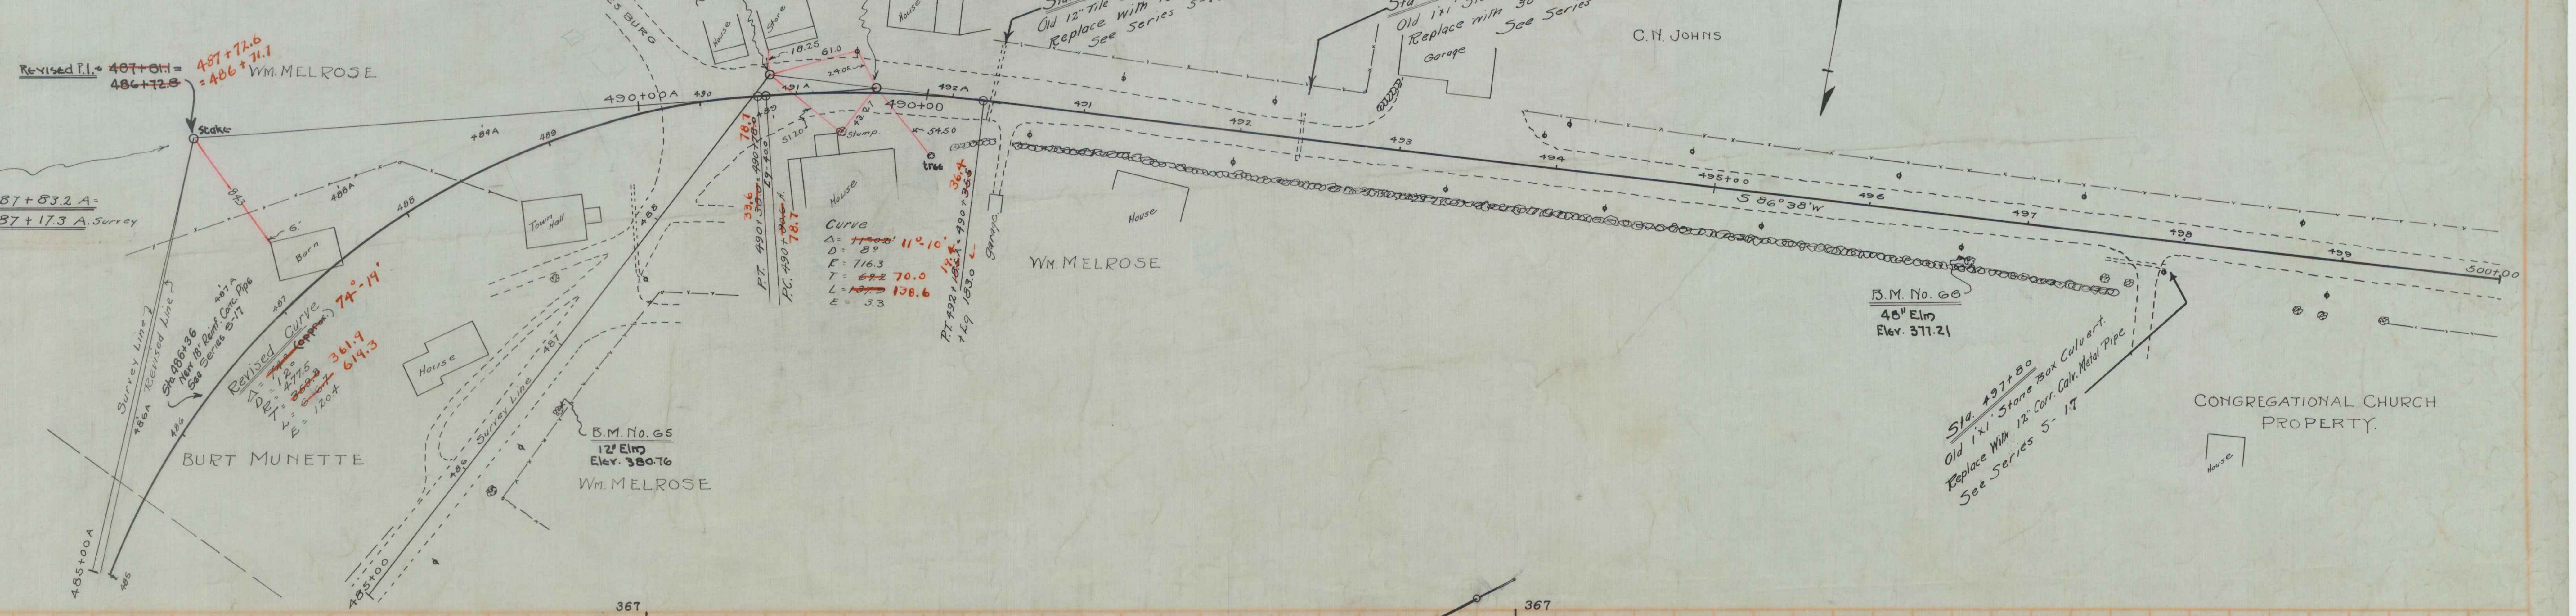

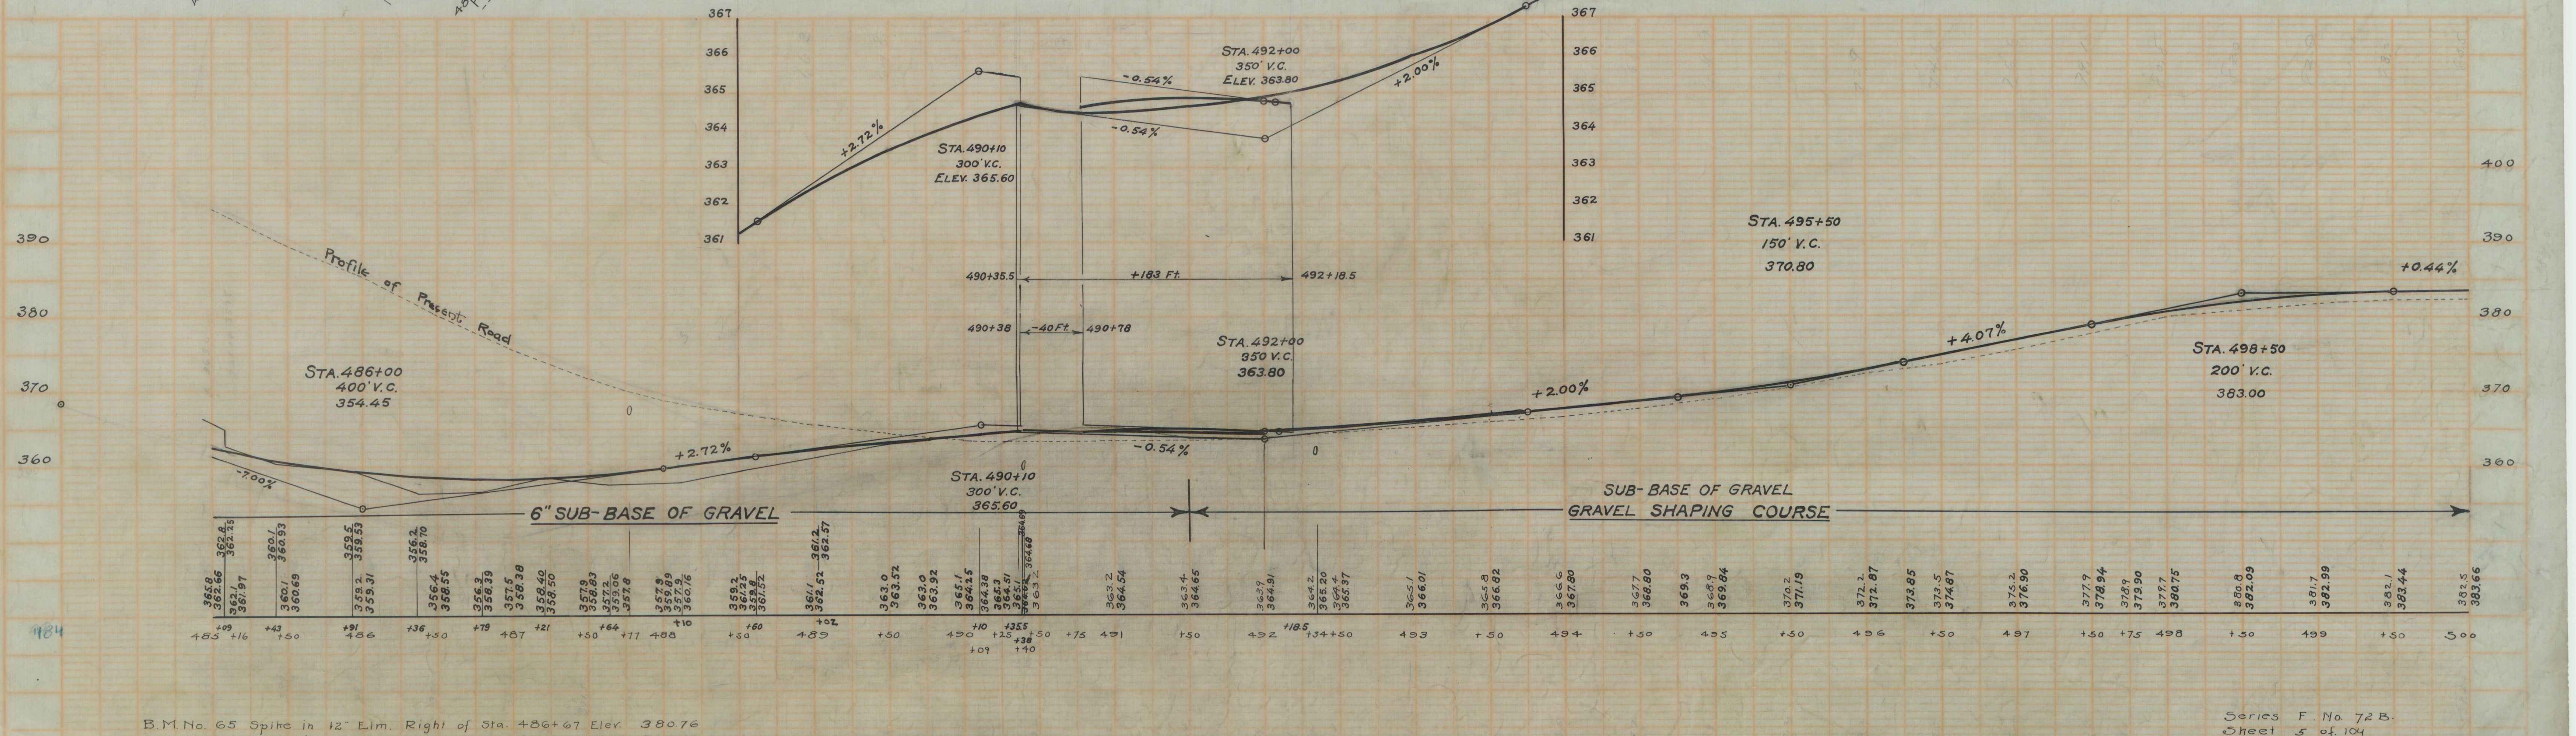

H.W.M. G.H.C. 12/26

H.W.M. 12/26

984

B.M. No. 65 Spike in 12" Elm. Right of Sta. 486+67 Elev. 380.76
B.M. No. 66 Spike in 48" Elm. Right of Sta. 496+67 Elev. 377.21

Series F. No. 72 B.
Sheet 5 of 104