 
DRIVEWAY CU
Sta 744+25 Left - Re
Concrete cl
P.I. 740+42 =
740+41.1
Δ = 7° 35' Rt
D = 2° .04'
T = 184.4
L = 367.9
PC = 738+57.6
PT = 742+31.3
ORCHARD
S 11° 09' W
740
741
PUMP
BARN
P.C. 740+52.2
220
210
200
190
180
170
Sta 740+50
300' V.C.
Elev. 217.90
216.6 217.29
216.8 217.37
216.8 217.32
216.4 217.16
740+00
+50
741+00
+98
+50
+47
B.M. No. 34 Spike in 27" Elm