WOOD GUARD RAIL REQUIRED.

LEFT
Sta. 820+69 to 820+93 Length 24 ft.

RIGHT
Sta 820+69 to 820+93 Length 24 ft.

NEW CULVERTS REQUIRED.

Sta. 820+81 - 24" Reinf. Concrete Pipe Culvert 32 ft.
Concrete Class A (1-2-4)) 4.7 ~~5.6~~ Cu. Yds.
Reinforcing Steel 54 ~~60~~ pounds.

DRIVEWAY CULVERT REPAIRS REQUIRED.

Sta. 827+20 Build New Head walls Relay 14 ft Pipe
Concrete Class B (1-2½-5) 1.4 ~~1.6~~ Cu Yds.

~~Sta 823+50 - New Headwalls to be constructed~~
~~Concrete Class B - 1-2½-5 .11 Cu Yds~~

SUB BASE OF GRAVEL REQUIRED.

Sta. 818+00 to 819+50 - 6" Sub-base of gravel 150 Lin ft.
~~819+50 to 820+50 Gravel Shaping Course 100~~
" 825+00 to 834+00 9" Sub-base of gravel 900 Lin ft.

FED. ROAD DIST. NO.	STATE	FED. AID PROJ. NO.	FISCAL YEAR	SHEET NO.	TOTAL SHEETS
8	VT.	723	1928	27	104

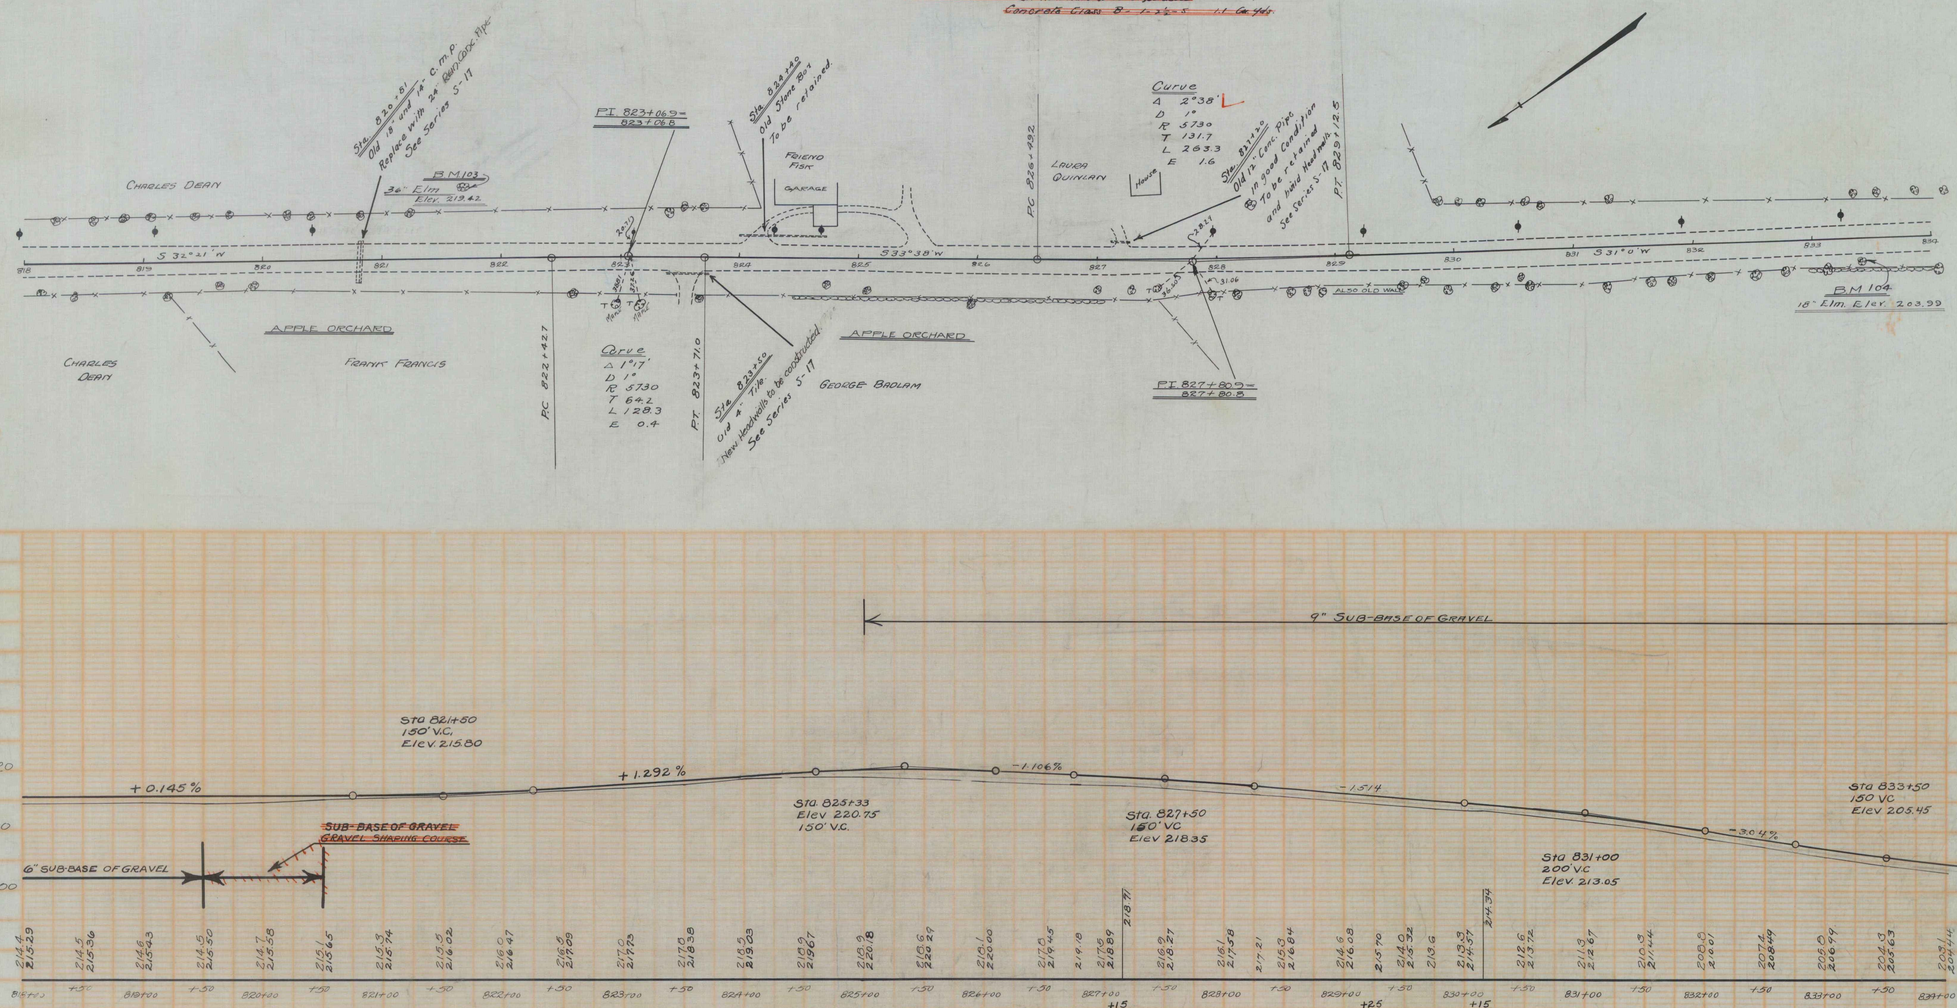

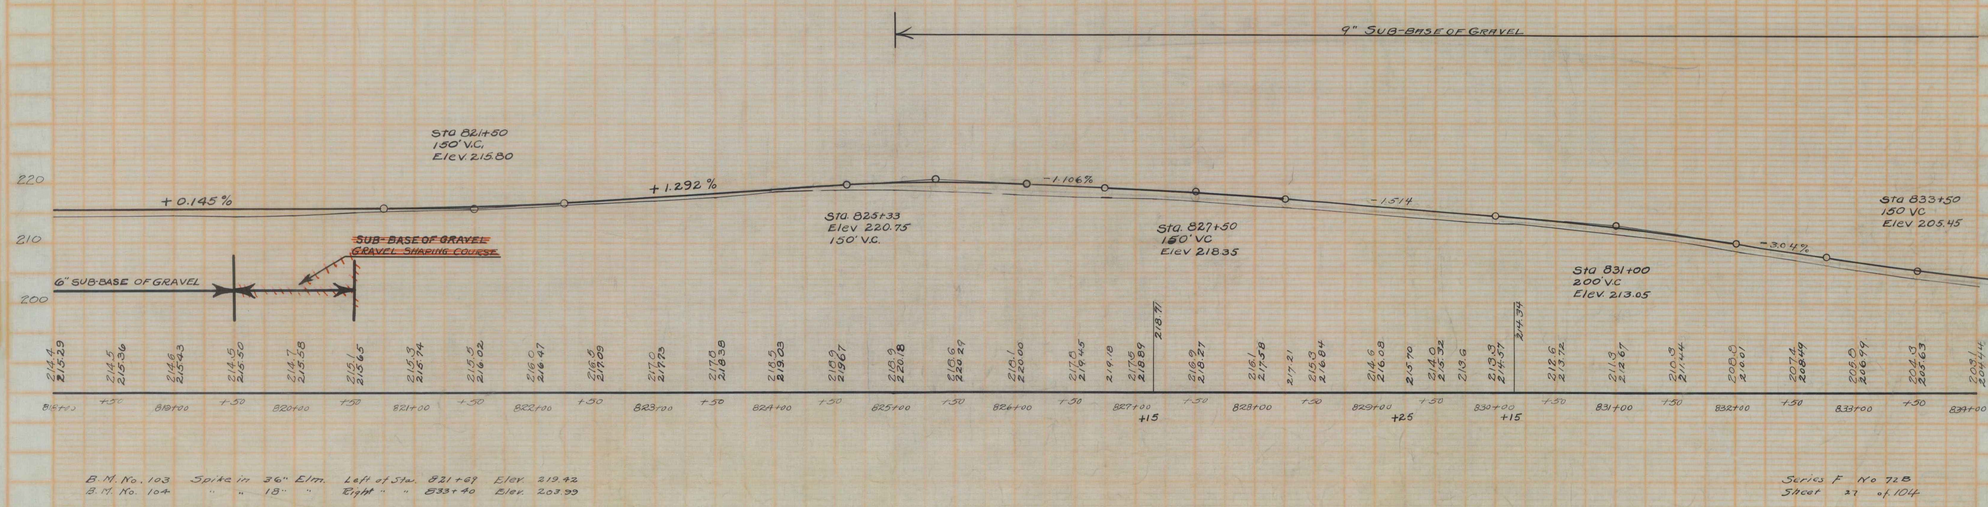

B. M. No. 103 Spike in 36" Elm. Left of Sta. 821+67 Elev. 219.42
B. M. No. 104 " " 18" " Right " " 833+40 Elev. 203.99

Series F No 728
Sheet 27 of 104